



- 16-BRIDGE
- 16-CLINE
- 16-CMUP
- 16-KALN
- 16-ODOT_EXPAN
- 16-PROP
- 16-PSIM
- 16-PWTR
- 16-SBAR
- 16-SBOT
- 16-SSDW
- 16-TXT20
- 16A-BASE1
- 16A-BASE2
- 16A-CHTC
- 16A-CRDY
- 16A-GCLM
- 16A-XUTL
- 16B-ARCH
- 16B-BASE
- 16B-BASEC
- 16B-CHTC
- 16B-CRDY
- 16B-GCLM
- 16B-XUTL
- 16B-22

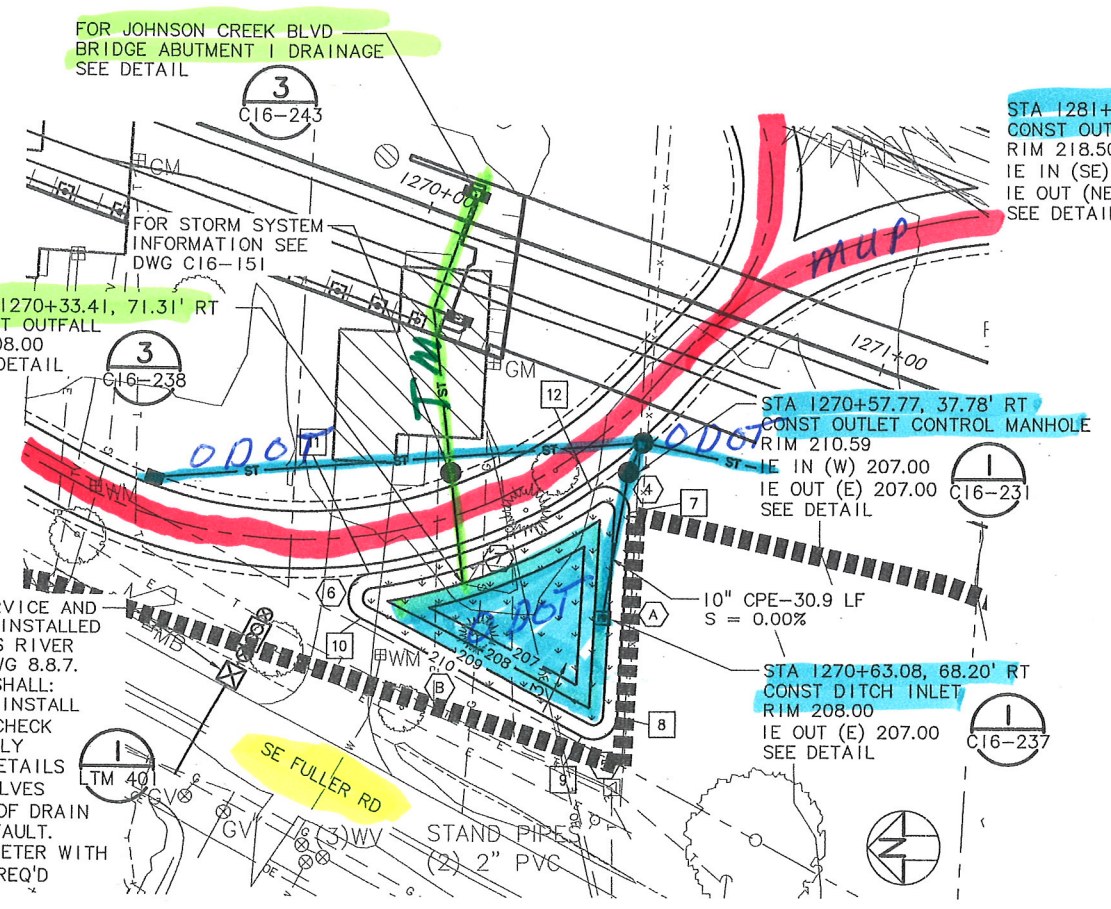

STA 1270+00 WATER QUALITY AND QUANTITY PLAN
SCALE: 1" = 20'-0"

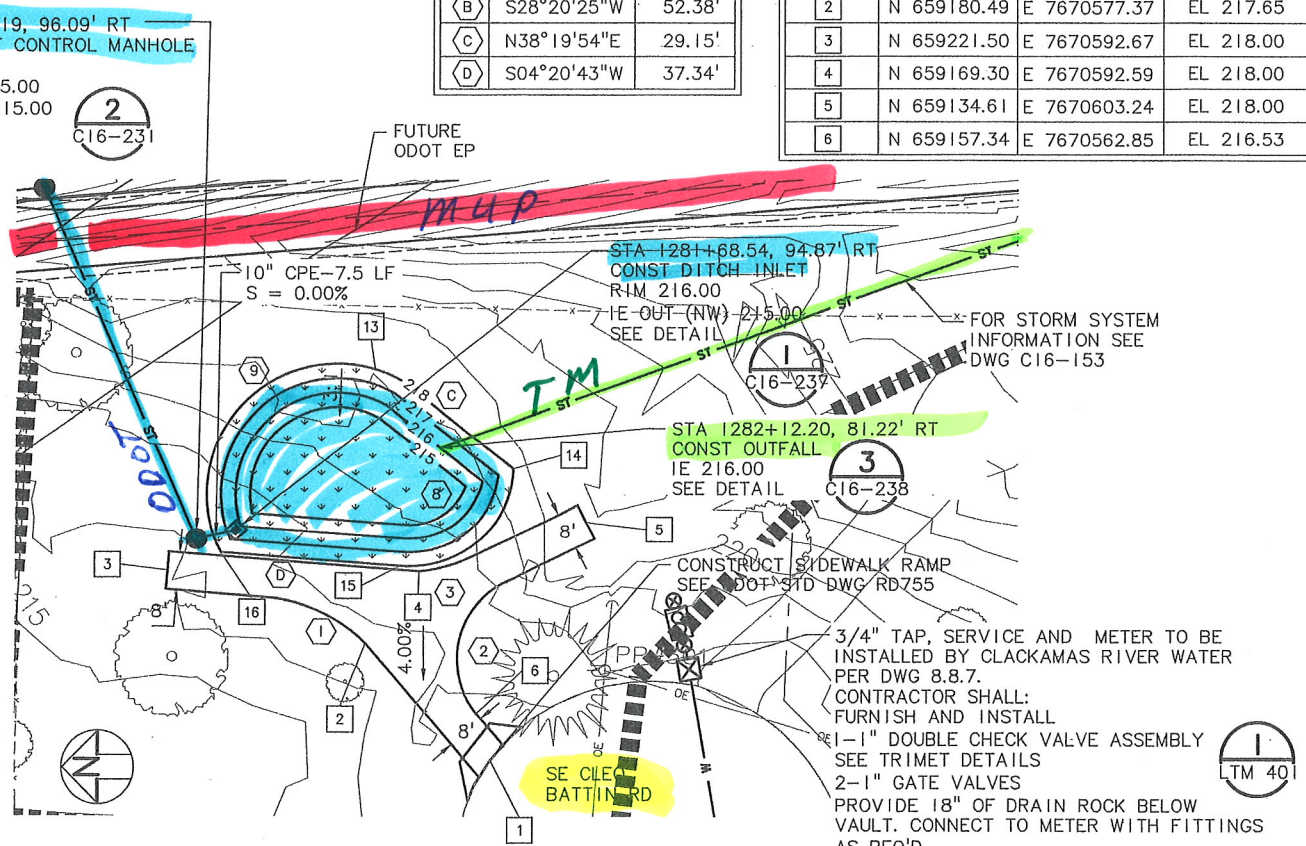

STA 1283+00 WATER QUALITY AND QUANTITY PLAN
SCALE: 1" = 20'-0"

LINE DATA

NO.	BEARING	LENGTH
(A)	S87°07'07"E	43.32'
(B)	S28°20'25"W	52.38'
(C)	N38°19'54"E	29.15'
(D)	S04°20'43"W	37.34'

COORDINATE TABLE


NO.	NORTHING	EASTING	NOTES
1	N 659154.38	E 7670553.20	EL 216.19
2	N 659180.49	E 7670577.37	EL 217.65
3	N 659221.50	E 7670592.67	EL 218.00
4	N 659169.30	E 7670592.59	EL 218.00
5	N 659134.61	E 7670603.24	EL 218.00
6	N 659157.34	E 7670562.85	EL 216.53

COORDINATE TABLE CONT

NO.	NORTHING	EASTING
7	N 660306.46	E 7670847.91
8	N 660284.43	E 7670808.98
9	N 660316.01	E 7670800.50
10	N 660362.11	E 7670825.36
11	N 660360.40	E 7670834.72
12	N 660314.26	E 7670852.31
13	N 659172.68	E 7670632.43
14	N 659147.81	E 7670614.35
15	N 659173.23	E 7670593.76
16	N 659210.46	E 7670596.59



CURVE DATA

NO.	RADIUS	DELTA	LENGTH
1	32.00'	37°43'21"	21.07'
2	18.00'	107°49'25"	35.06'
3	31.00'	20°28'45"	11.08'
4	5.00'	126°57'43"	11.08'
5	5.00'	115°27'32"	10.08'
6	5.00'	144°00'35"	12.57'
7	108.00'	26°25'50"	49.82'
8	21.52'	92°54'23"	34.88'
9	27.11'	147°46'12"	69.90'

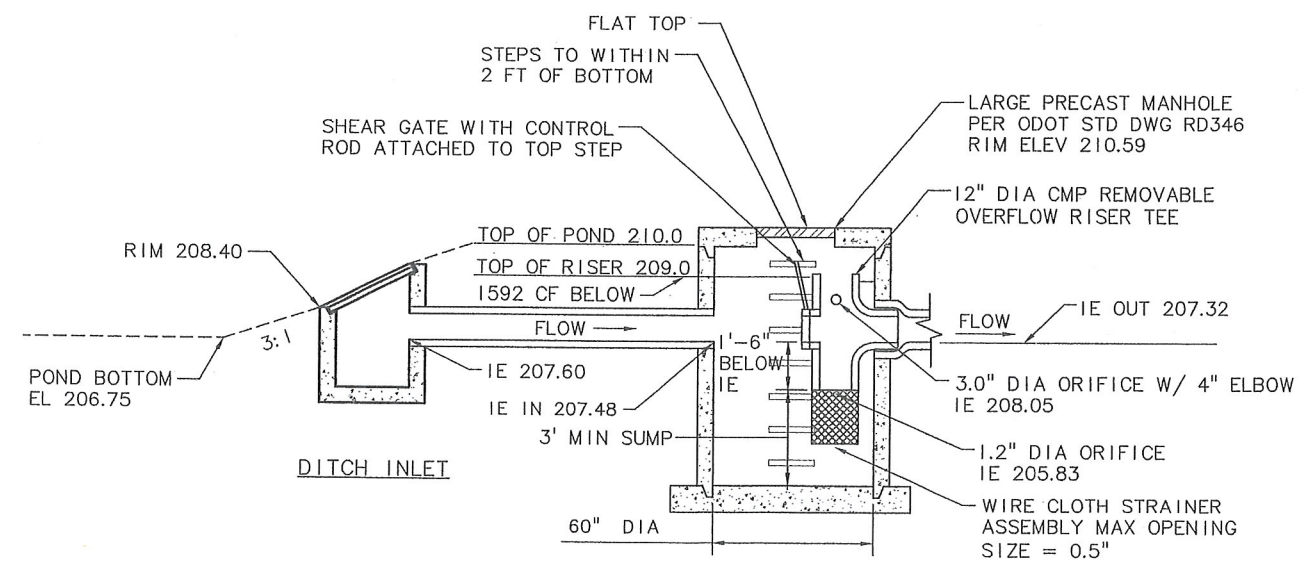

OUTLET CONTROL MANHOLE
SCALE: NTS

NOTE
WIRE CLOTH STRAINER-
STAINLESS STEEL WIRE CLOTH:
SECURE TO PIPE WITH HOSE
CLAMP. SECURE TO MANHOLE WALL
WITH STAINLESS STEEL BANDS
(MIN 2" WIDE) AND 1/2" BOLTS

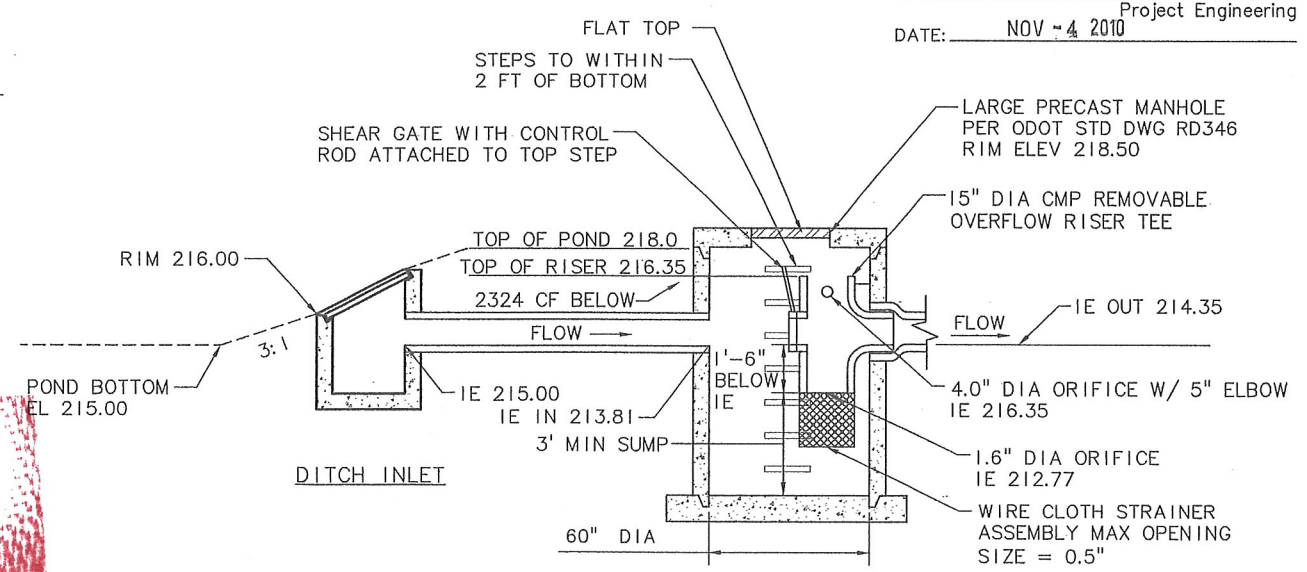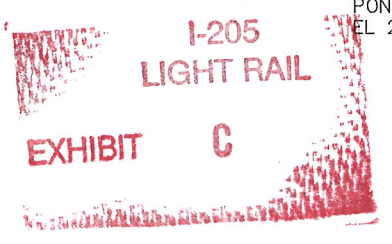

OUTLET CONTROL MANHOLE
SCALE: NTS

NOTE: THESE RECORD DRAWINGS REPRESENT THE BEST KNOWN INFORMATION ABOUT CONSTRUCTED FACILITIES. LOCATIONS SHOWN ARE NOT WARRANTED. UNDERGROUND UTILITIES MUST BE FIELD VERIFIED FOR ACTUAL LOCATION.

NO.	DATE	BY	APPD.	REVISIONS

LGS	5-24-06
DESIGNED	DATE
KRN	5-24-06
DRAWN	DATE
MMR	12-12-06
CHECKED	DATE
SBM	12-12-06
APPROVED	DATE

TRI-COUNTY METROPOLITAN TRANSPORTATION DISTRICT OF OREGON



SOUTH CORRIDOR CONSTRUCTORS
Stacy and Wilbeck
GRANITE
WILDISH

DAVID EVANS
AND ASSOCIATES INC.
2100 Southwest River Parkway
Portland Oregon 97201
Phone: 503.223.6663

TRIMET
CAPITAL PROJECTS
AND
FACILITIES DIVISION
710 N.E. HOLLADAY STREET
PORTLAND, OREGON 97232

SOUTH CORRIDOR PROJECT
I-205 SEGMENT
STA 1270+00 & STA 1283+00
WATER QUALITY AND QUANTITY PLANS & DETAILS

SCALE: 1" = 20'-0"
DRAWING NO.: C16-231-BX
CONTRACT NO.: RH040161LE
SHEET NO.: 213

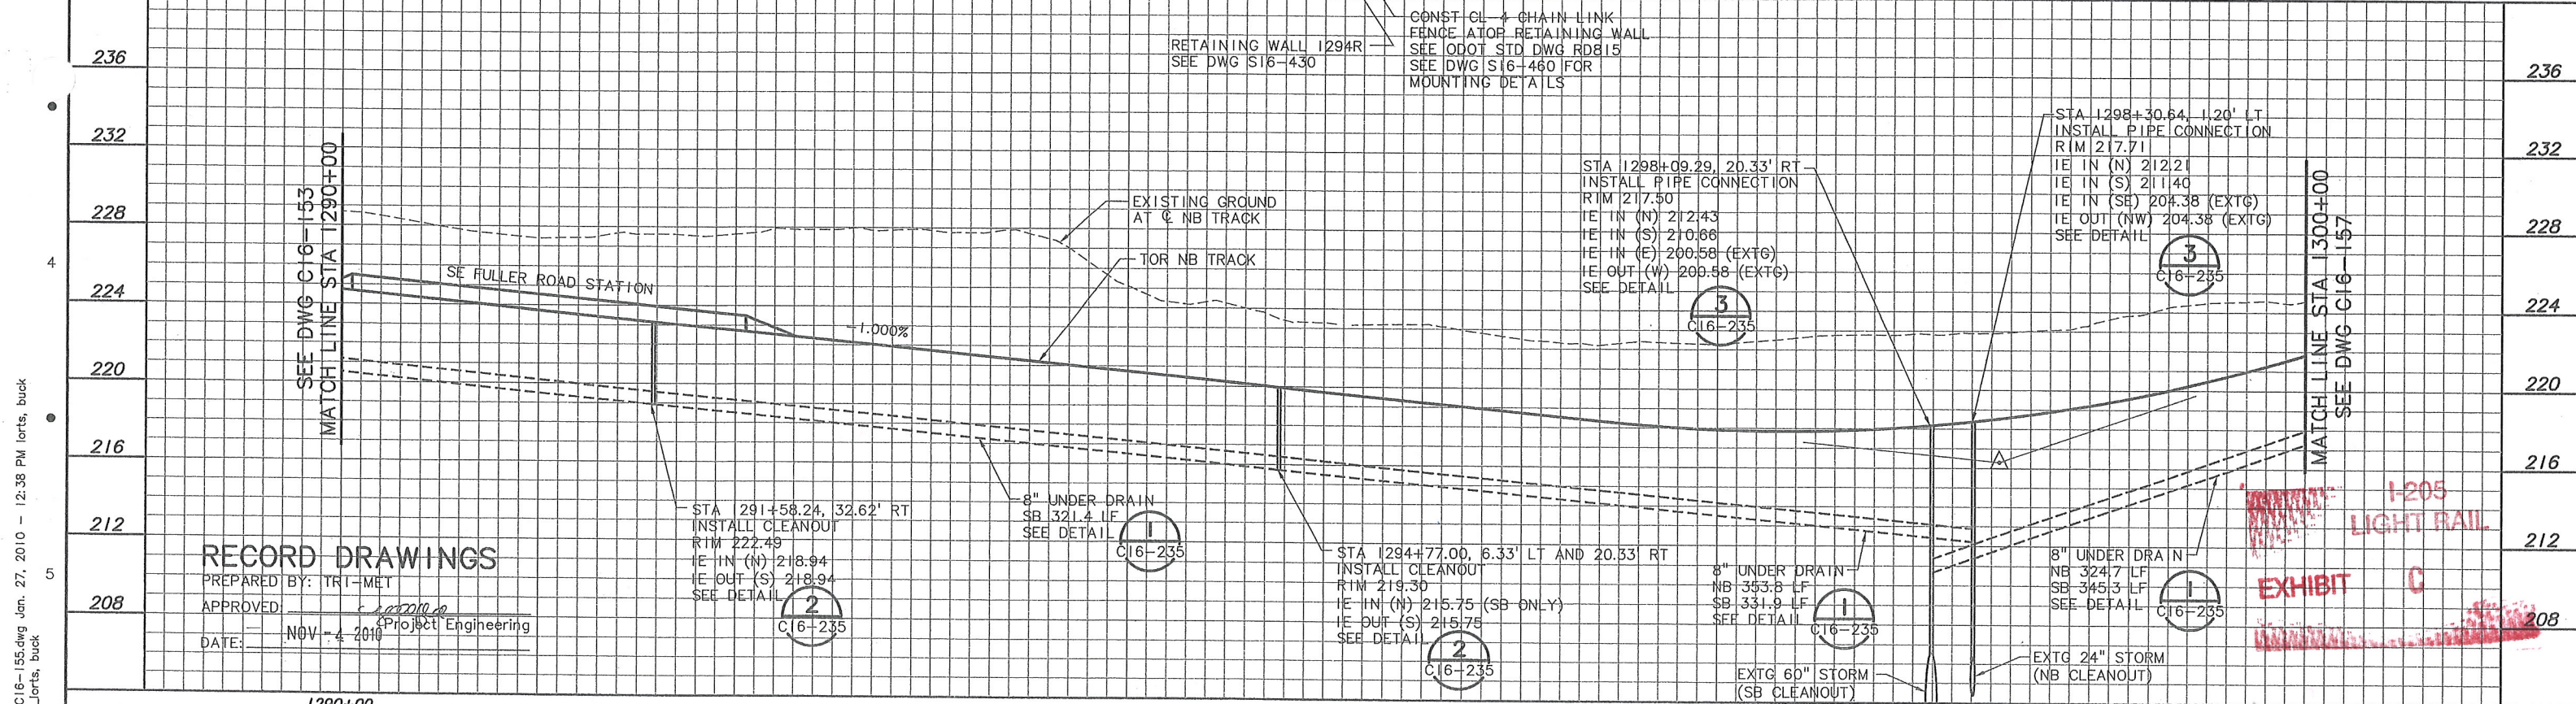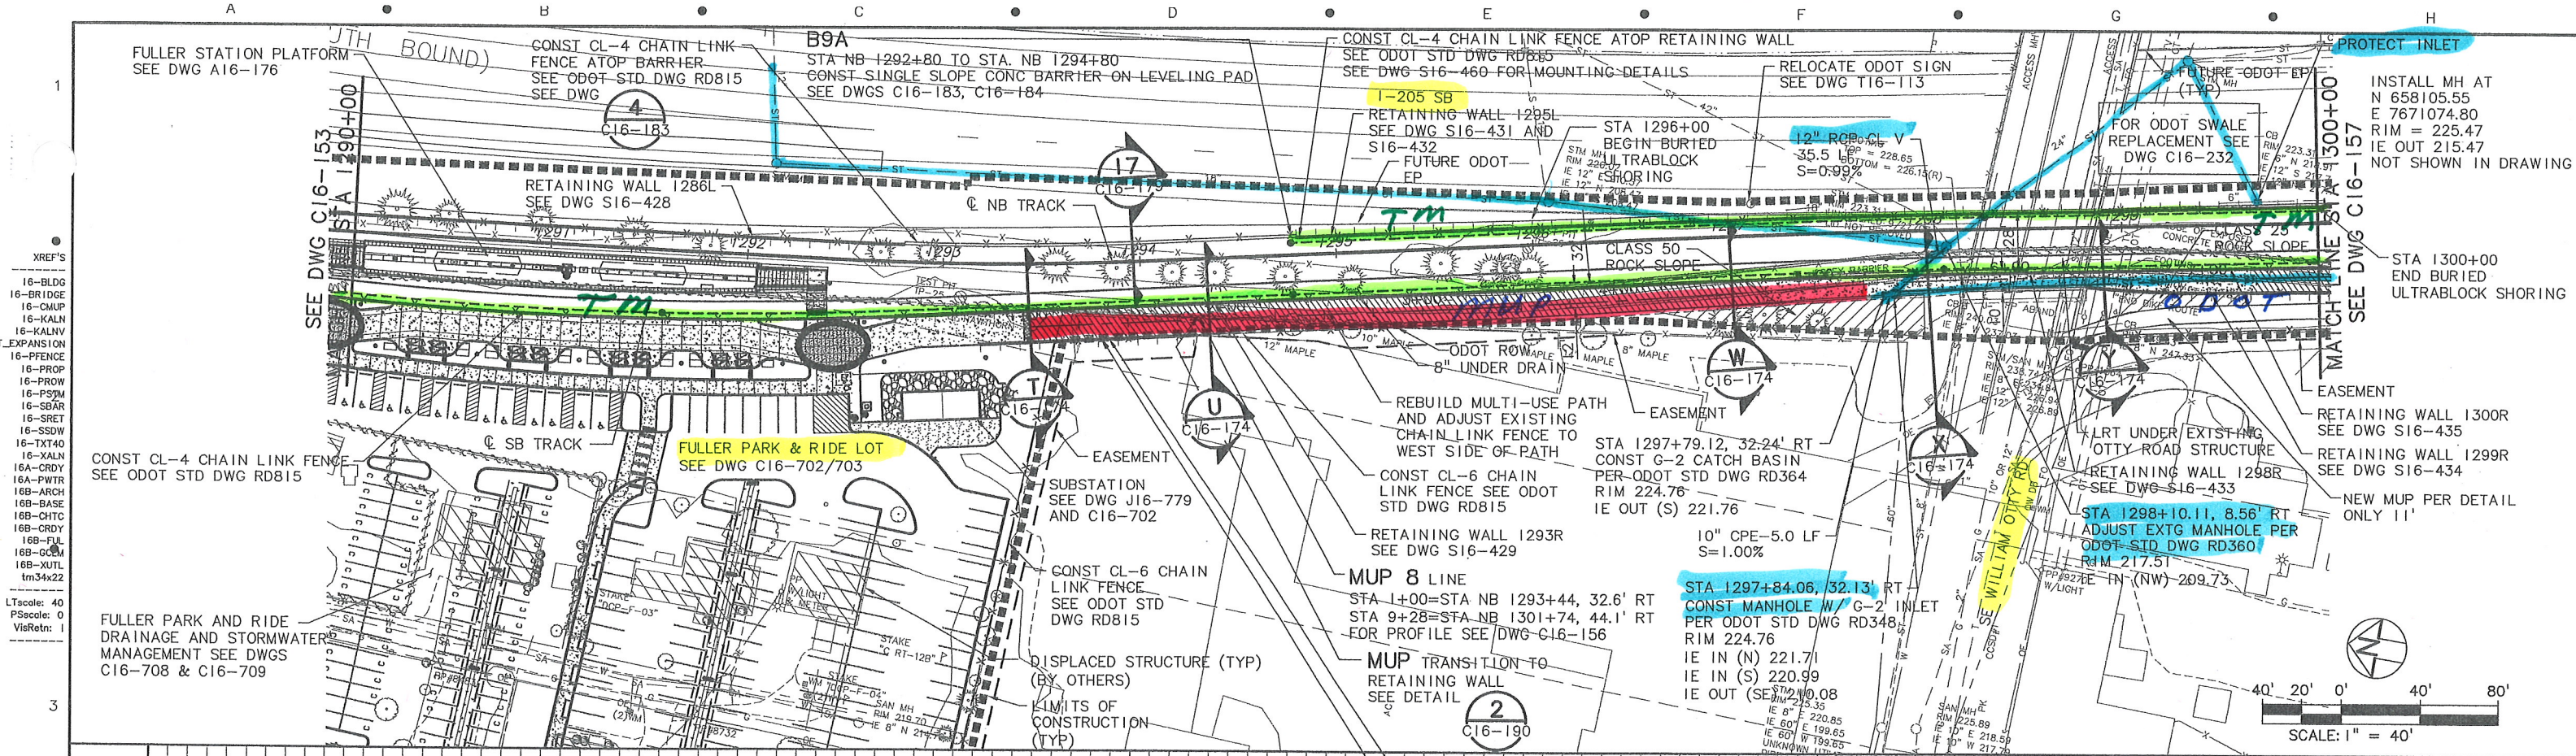

NOTE: THESE RECORD DRAWINGS REPRESENT THE BEST KNOWN INFORMATION ABOUT CONSTRUCTED FACILITIES. LOCATIONS SHOWN ARE NOT WARRANTED. UNDERGROUND UTILITIES MUST BE FIELD VERIFIED FOR ACTUAL LOCATION.

NO.	DATE	BY	CHK.	APPD.	REVISIONS
1	12-17-06	JTH	DESIGNED		
2	12-19-06	JTH	DRAWN		
3	12-11-06	STD	CHECKED		
4	12-12-06	SBM	APPROVED		

RECORD DRAWING

TRI-COUNTY METROPOLITAN TRANSPORTATION DISTRICT OF OREGON

SOUTH CORRIDOR CONSTRUCTORS
Stacy and Wilbeck
GRANITE
WILDISH



DAVID EVANS AND ASSOCIATES INC.
2100 Southwest River Parkway
Portland Oregon 97201
Phone: 503.223.6663

TRI-MET
CAPITAL PROJECTS
AND
FACILITIES DIVISION
710 N.E. HOLLADAY STREET
PORTLAND, OREGON 97232

SOUTH CORRIDOR PROJECT
I-205 SEGMENT
CIVIL PLAN & PROFILE
STA 1290+00 TO STA 1300+00

SCALE:	1" = 40'-0"	DRAWING NO.:	C16-155-BX	CONTRACT NO.:	RH040161LE	SHEET NO.:	150
--------	-------------	--------------	------------	---------------	------------	------------	-----

R: I-205 AS-BUILTS
Plot Date: 3/16/2010 8:41 AM
C16-155.dwg Jan. 27, 2010 - 12:38 PM lorts, buck
AM_lorts, buck

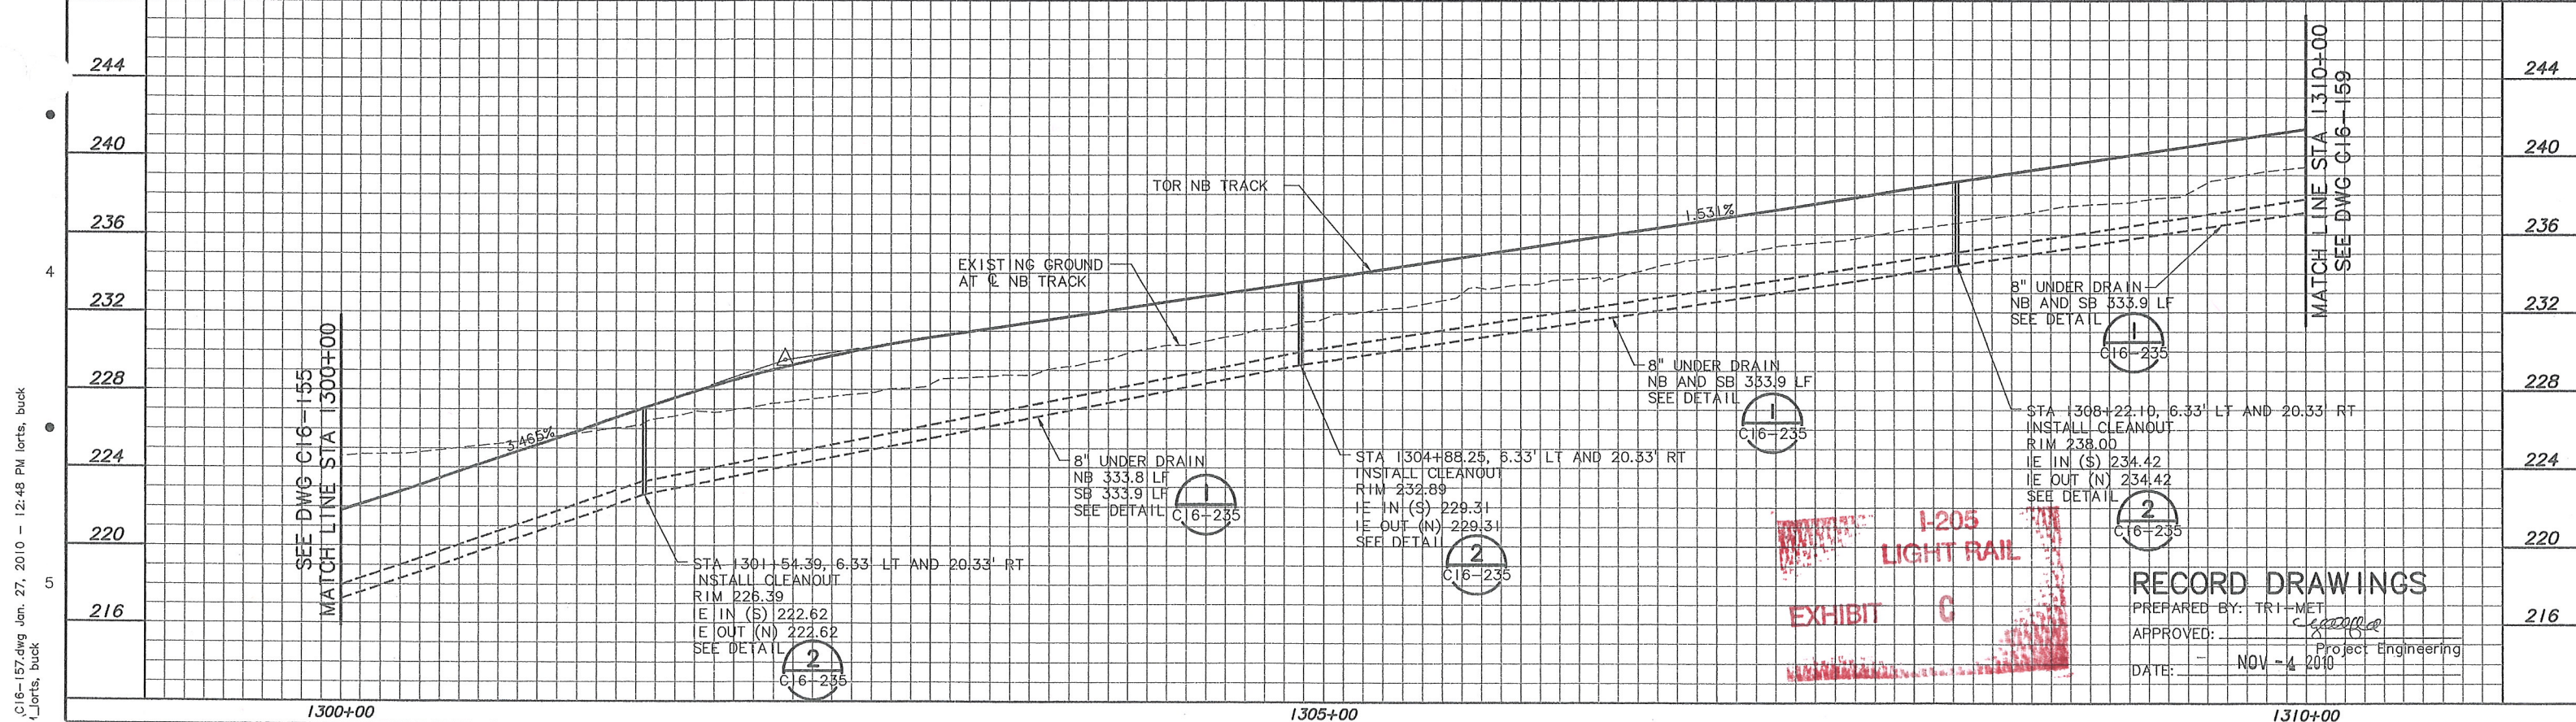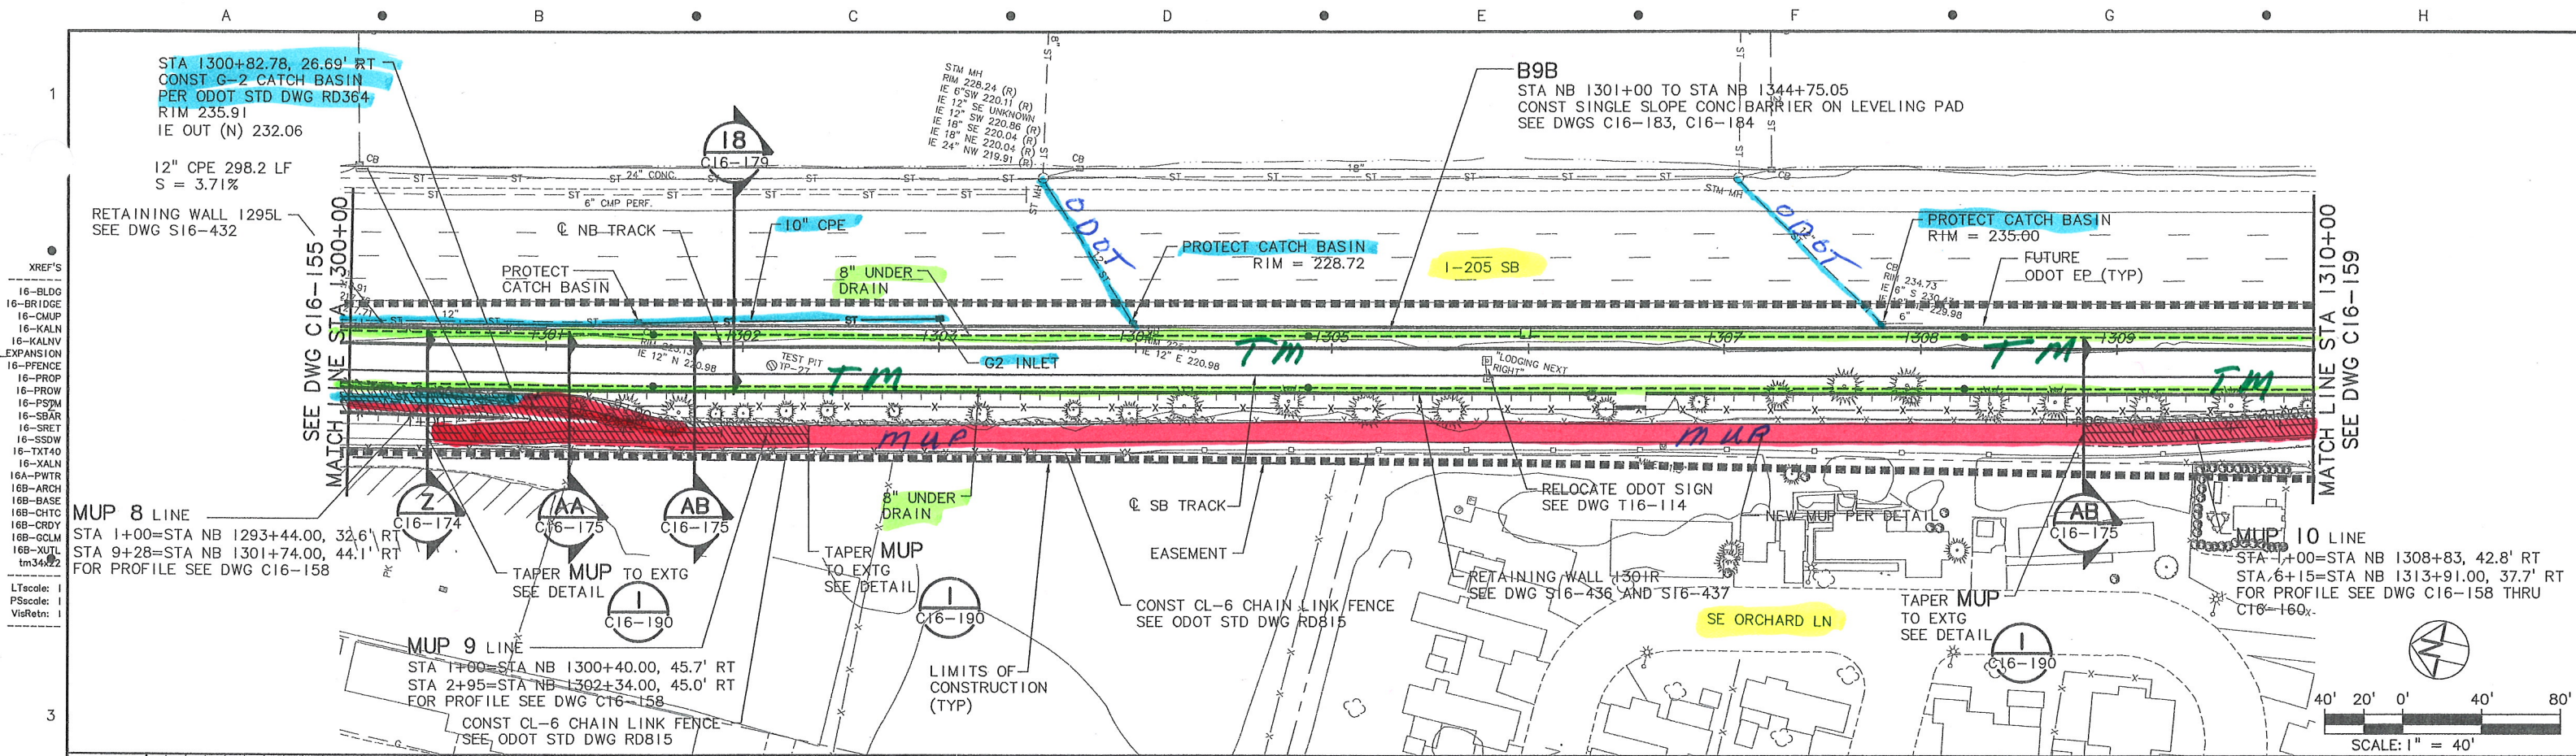

NOTE: THESE RECORD DRAWINGS REPRESENT THE BEST KNOWN INFORMATION ABOUT CONSTRUCTED FACILITIES. LOCATIONS SHOWN ARE NOT WARRANTED. UNDERGROUND UTILITIES MUST BE FIELD VERIFIED FOR ACTUAL LOCATION.

NO.	DATE	BY	APPD.	REVISIONS
		CHK.		

DRAWN	2-17-06
DATE	
JTH	2-19-06
DRAWN	DATE
CHECKED	DATE
APPROVED	DATE

TRI-COUNTY METROPOLITAN TRANSPORTATION DISTRICT OF OREGON

SOUTH CORRIDOR CONSTRUCTORS
Stacy and Wilbeck
GRANITE
WILDISH



DAVID EVANS AND ASSOCIATES INC.
2100 Southwest River Parkway
Portland Oregon 97201
Phone: 503.223.6663

TRI-MET
CAPITAL PROJECTS AND FACILITIES DIVISION
710 N.E. HOLLADAY STREET
PORTLAND, OREGON 97232

SOUTH CORRIDOR PROJECT
I-205 SEGMENT
CIVIL PLAN & PROFILE
STA 1300+00 TO STA 1310+00

SCALE:	DRAWING NO.:	CONTRACT NO.:	SHEET NO.:
1" = 40'-0"	C16-157-AX	RH040161LE	152

R:\I-205 AS-BUILTS\C16-157.dwg Jan. 27, 2010 - 12:48 PM lorts, buck
Plot Date: 3/16/2010 9:00 AM lorts, buck

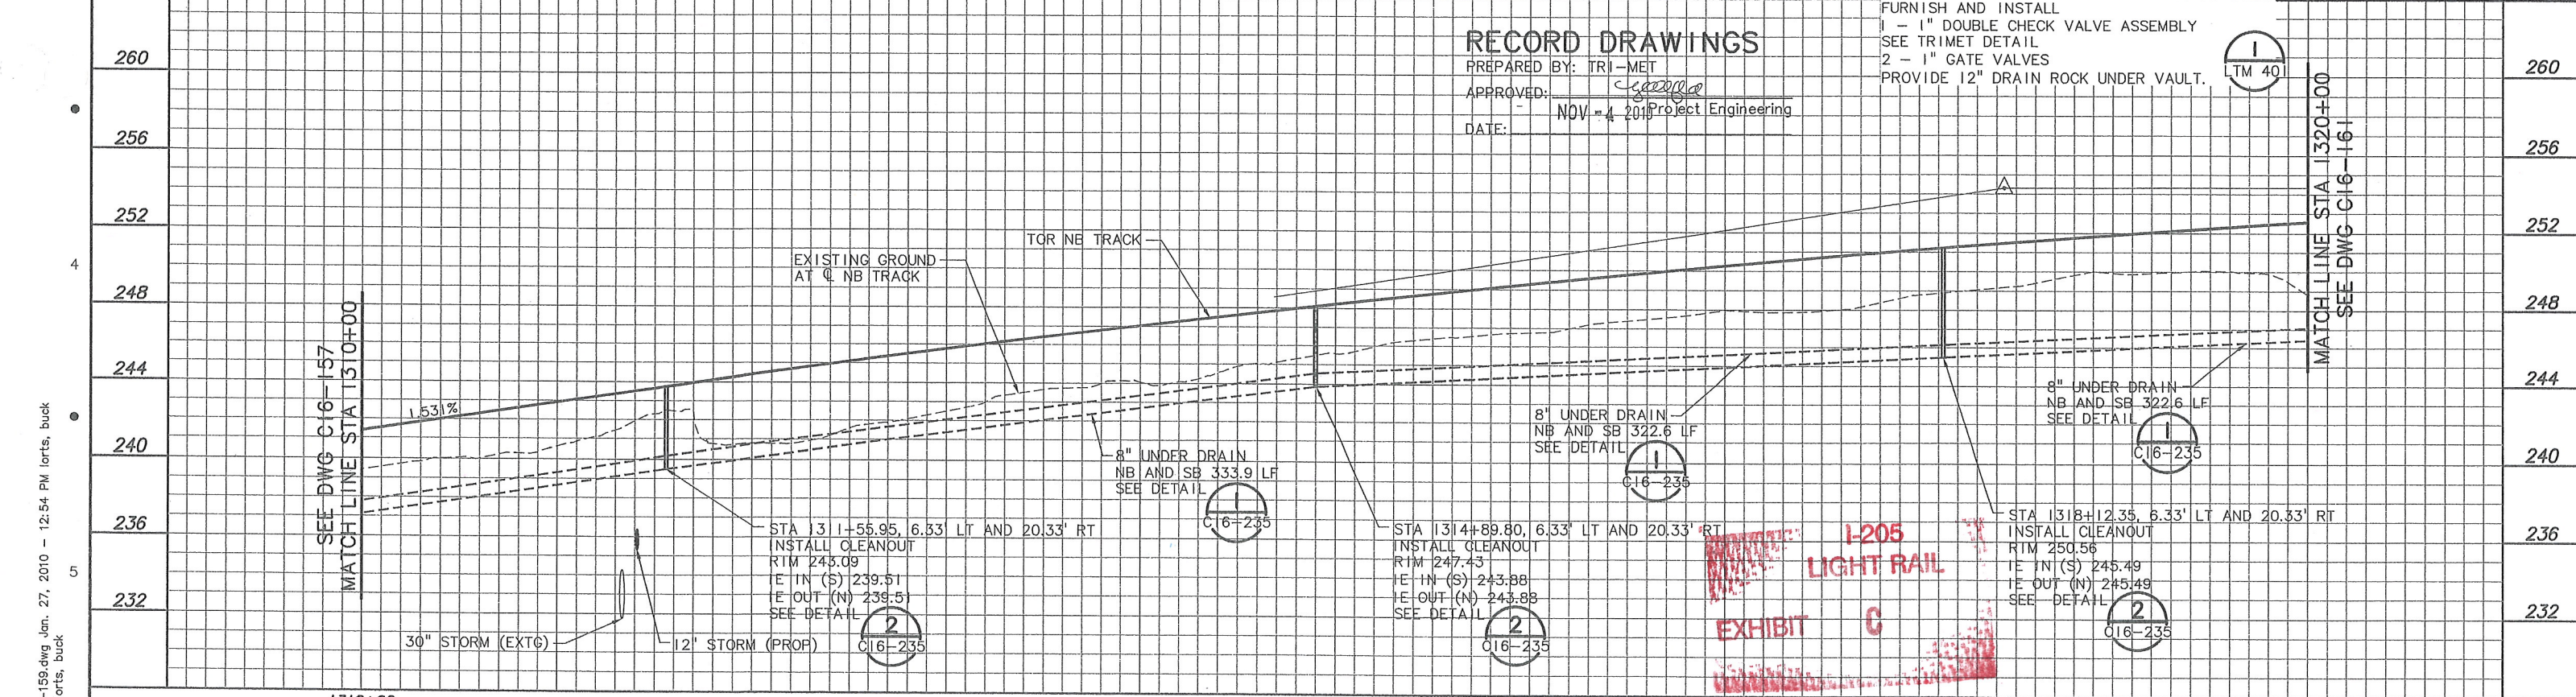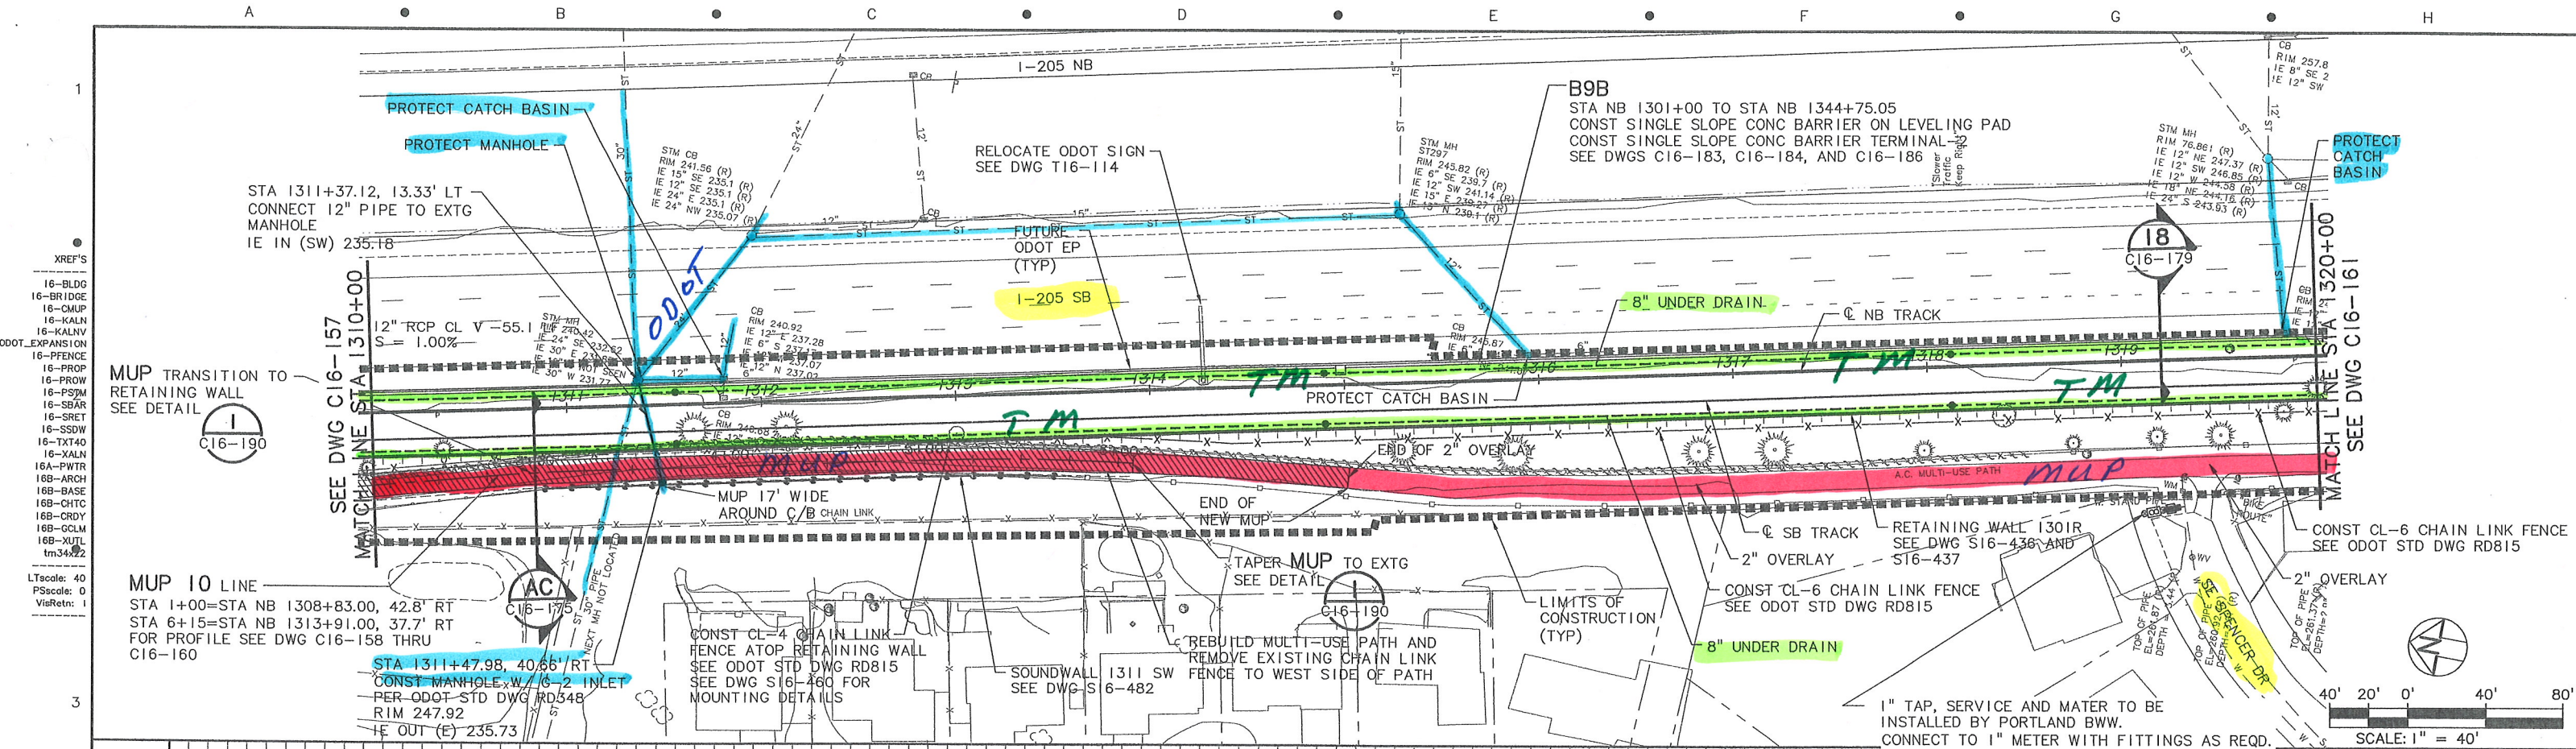

NOTE: THESE RECORD DRAWINGS REPRESENT THE BEST KNOWN INFORMATION ABOUT CONSTRUCTED FACILITIES. LOCATIONS SHOWN ARE NOT WARRANTED. UNDERGROUND UTILITIES MUST BE FIELD VERIFIED FOR ACTUAL LOCATION.

NO.	DATE	BY	APPD.	REVISIONS

DRA/KRN DESIGNED	2-17-06 DATE
JTH DRAWN	2-19-06 DATE
CHECKED	DATE
APPROVED	DATE

TRI-COUNTY METROPOLITAN TRANSPORTATION DISTRICT OF OREGON

SOUTH CORRIDOR CONSTRUCTORS
Stacy and Witbeck
GRANITE
WILDISH




DAVID EVANS AND ASSOCIATES INC.
2100 Southwest River Parkway
Portland Oregon 97201
Phone: 503.223.6663

TRI-MET
CAPITAL PROJECTS
AND
FACILITIES DIVISION
710 N.E. HOLLADAY STREET
PORTLAND, OREGON 97232

SOUTH CORRIDOR PROJECT
I-205 SEGMENT
CIVIL PLAN & PROFILE
STA 1310+00 TO STA 1320+00

SCALE: 1" = 40'-0"	DRAWING NO.: C16-159	CONTRACT NO.: RH040161LE	SHEET NO.: 154
--------------------	----------------------	--------------------------	----------------

R:\205 AS-BUILTS\01-159.dwg Jan. 27, 2010 - 12:54 PM lorts, buck
Plot Date: 3/16/2010 9:10 lorts, buck

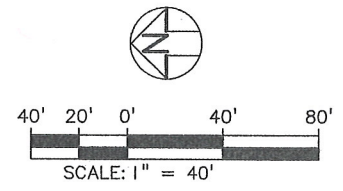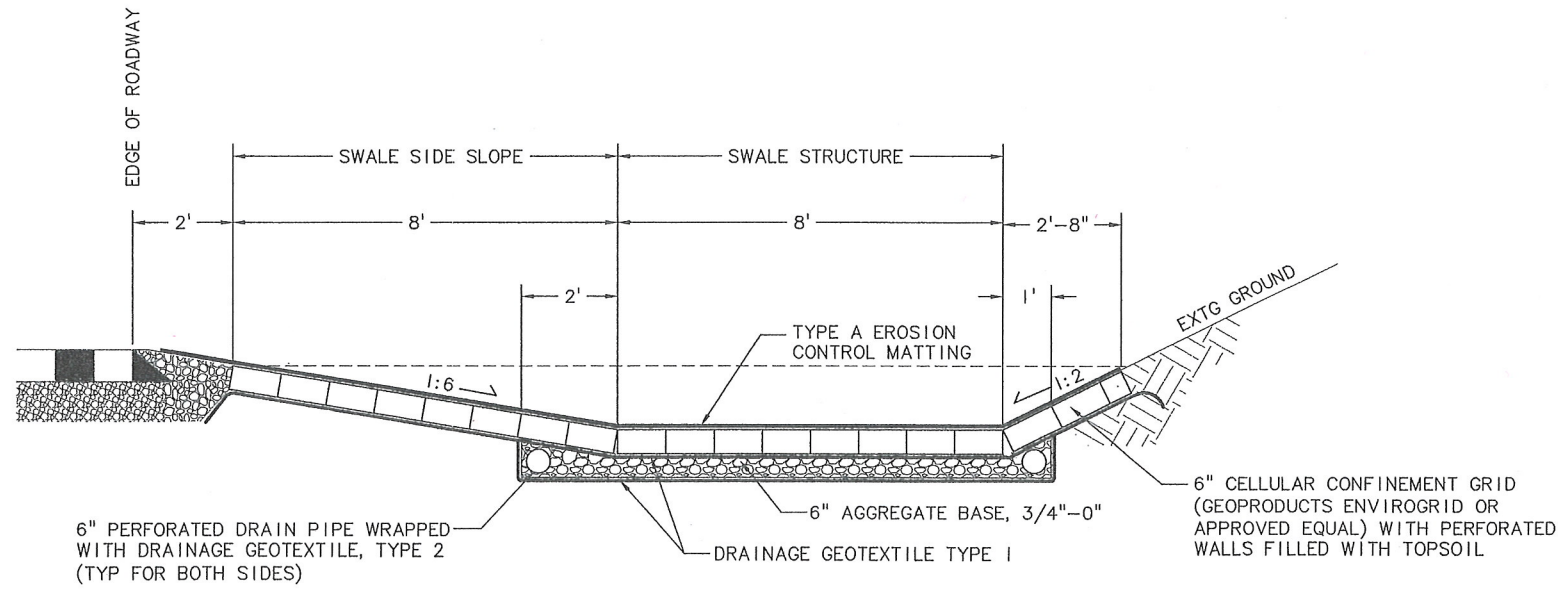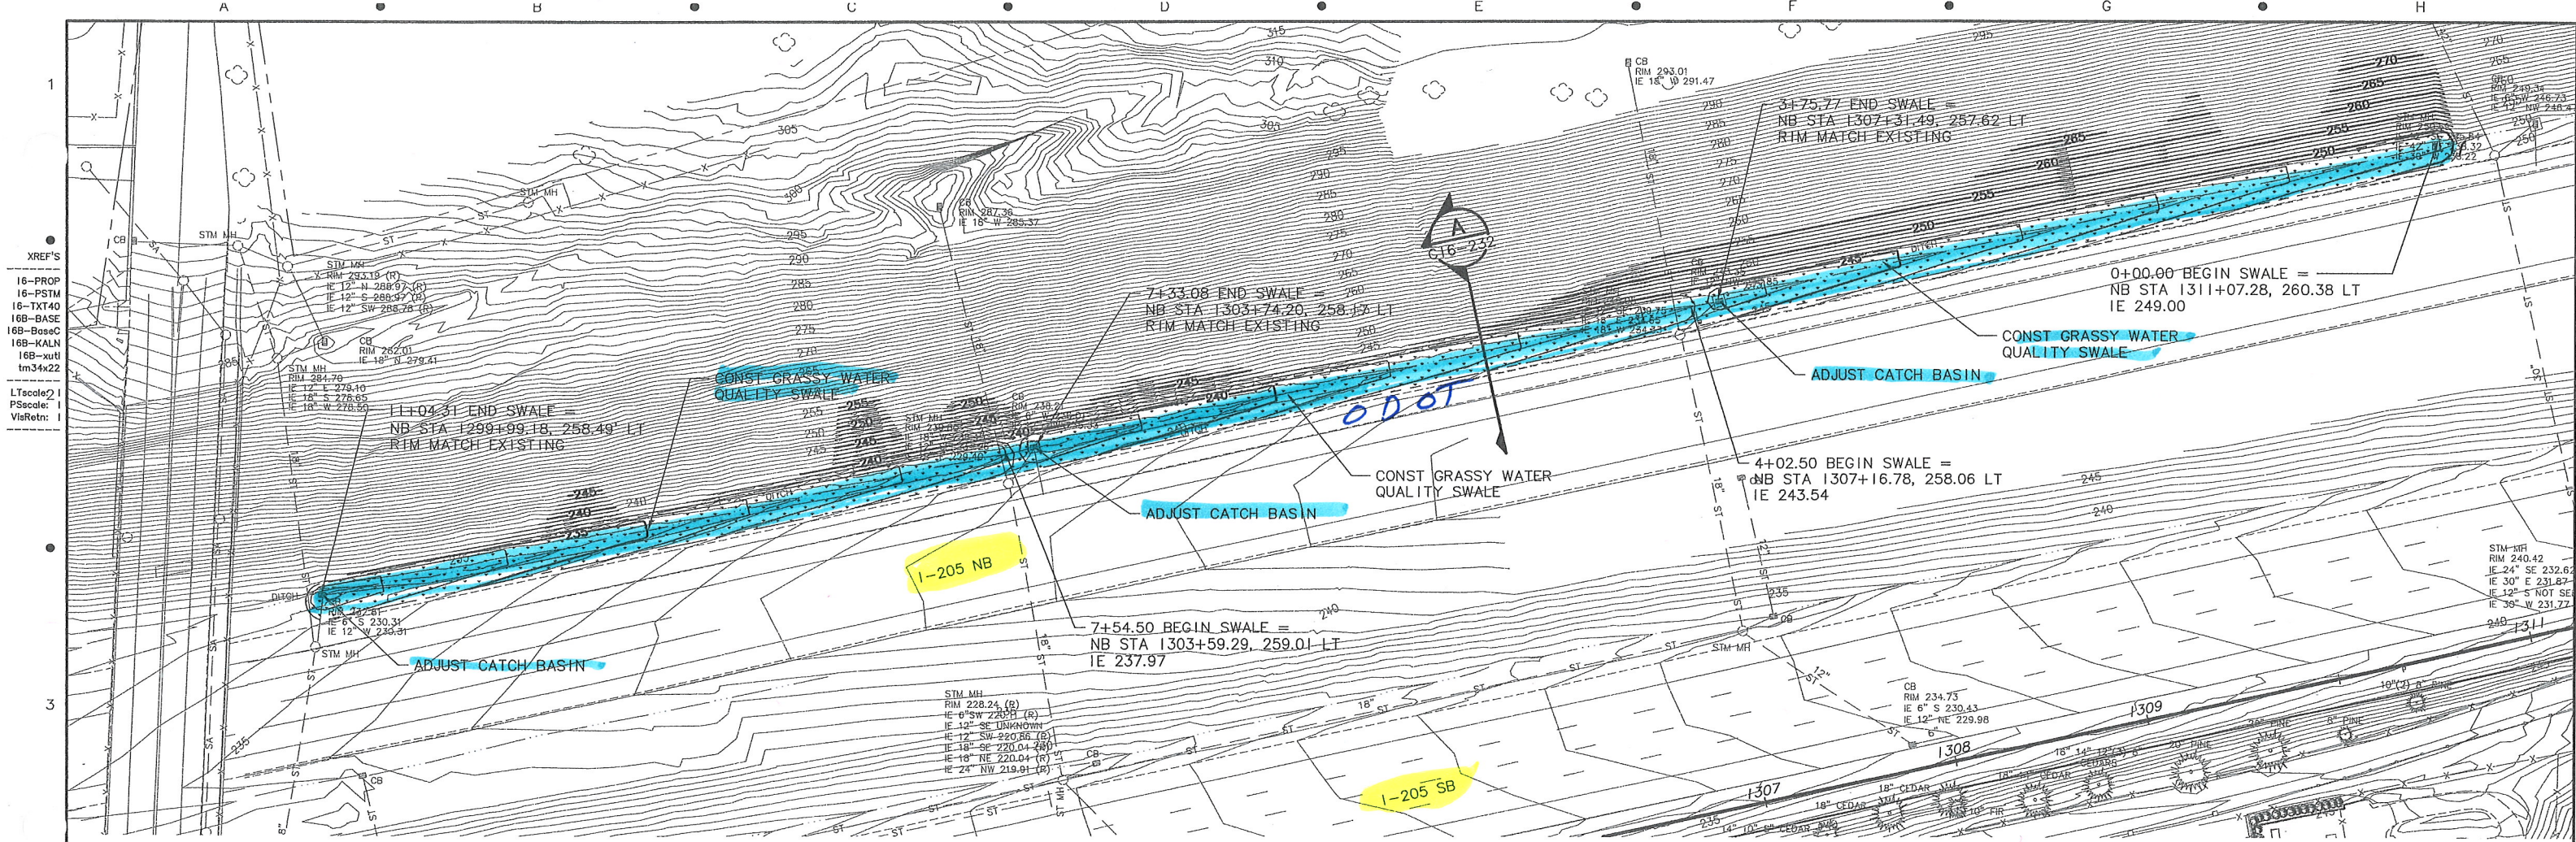


PLANTING NOTES

BIOFILTER GRASS SEED MIX PER SPECIFICATIONS

RECORD DRAWINGS

PREPARED BY: TRI-MET
APPROVED: *[Signature]*
DATE: NOV -4 2010 Project Engineering

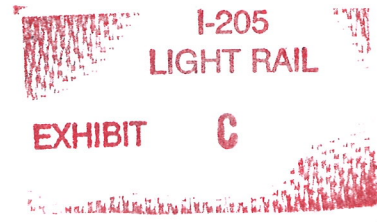

NOTE: THESE RECORD DRAWINGS REPRESENT THE BEST KNOWN INFORMATION ABOUT CONSTRUCTED FACILITIES. LOCATIONS SHOWN ARE NOT WARRANTED. UNDERGROUND UTILITIES MUST BE FIELD VERIFIED FOR ACTUAL LOCATION.

RECORD DRAWING

NO.	DATE	BY	APPD.	REVISIONS
		CHK.		

CJH DESIGNED	3-18-06 DATE
KRN DRAWN	3-18-06 DATE
CHECKED	DATE
APPROVED	DATE

TRI-COUNTY METROPOLITAN TRANSPORTATION DISTRICT OF OREGON

SOUTH CORRIDOR CONSTRUCTORS
Stacy and Wilbeck
GRANITE
WILDISH

DAVID EVANS AND ASSOCIATES INC.
2100 Southwest River Parkway
Portland Oregon 97201
Phone: 503.223.6663

TRI-MET
CAPITAL PROJECTS AND FACILITIES DIVISION
710 N.E. HOLLADAY STREET
PORTLAND, OREGON 97232

SUBMITTED: 12/15/06

DATE: 12/15/06

APPROVED: 12/15/06

DATE: 12/15/06

SOUTH CORRIDOR PROJECT
I-205 SEGMENT
ODOT SWALE REPLACEMENT
PLAN & DETAIL

SCALE: 1" = 40'-0"	DRAWING NO.: C16-232	CONTRACT NO.: RH040161LE	SHEET NO.: 214
--------------------	----------------------	--------------------------	----------------