EXHIBITF

I-205 LRT, SOUTH CORRIDOR LANDSCAPE RESPONSIBILITY MATRIX

TRI MET GREEN

ODOT BLUE


CITY OF PORTLAND YELLOW

CLACKAMAS CO. PURPLE

MUP RED

I-205 LRT South Corridor Landscape Responsibility Matrix F

Plan Drawing Number	Begin Station	End Station	Landmarks	East / West / Track	Туре	Ownership	Maintain
100 100	1007	4007	Lincoln Cubatation	East	Trees	ODOT	IODOT
16P-130	1087		Lincoln Substation	West	Landscape	Tri Met	Tri Met
16P-131	1099		Division Platform	West	Swale	ODOT	ODOT
16P-140	1126		Powell Ped Bridge	La Proposition	Swale	Tri Met	Tri Met
16P-141	1129		Powell P&R Access Road	West	P&R	Tri Met	Tri Met
16P-142	1129		Powell P&R Access Road	West		ODOT	ODOT
16P-160	1180		Harold	West	Landscape	ODOT	Tri Met
16P-161	1186	The proof that the last the second and the second s	Foster Station at Ramona	West	Landscape	ODOT	ODOT
16P-162	1195		Woodstock	West	Landscape		ODOT
16P-162	1199		Henry	West	Swale	ODOT	ODOT
16P-163 to 170	1203		Duke to Springwater Trail	West	Landscape		COP
16P-170	1217		Springwater Trail	West	Specialty	COP	
16P-171 to 172	1218	1230	Springwater Trail to Johnson Creek	West	Swale	ODOT	ODOT
16P-173	1231	1235	Flavel Station	Both	Landscape	Tri Met	Tri Met
16P-175	1238	1241	North of 92nd	East	Swale	Tri Met	Tri Met
16P-176 to 177	1247	1270	Crystal Springs Blvd to south	West	Landscape	ODOT	ODOT
16P-177	1270		North end JCB Structure	West	Swale	Tri Met	ODOT
16P-178	1282		Cleo Battin Rd	West	Swale	ODOT	ODOT
16P-190 to 195	1300	1344		West	Landscape	ODOT	ODOT
	3						
	-			*			
5			-				

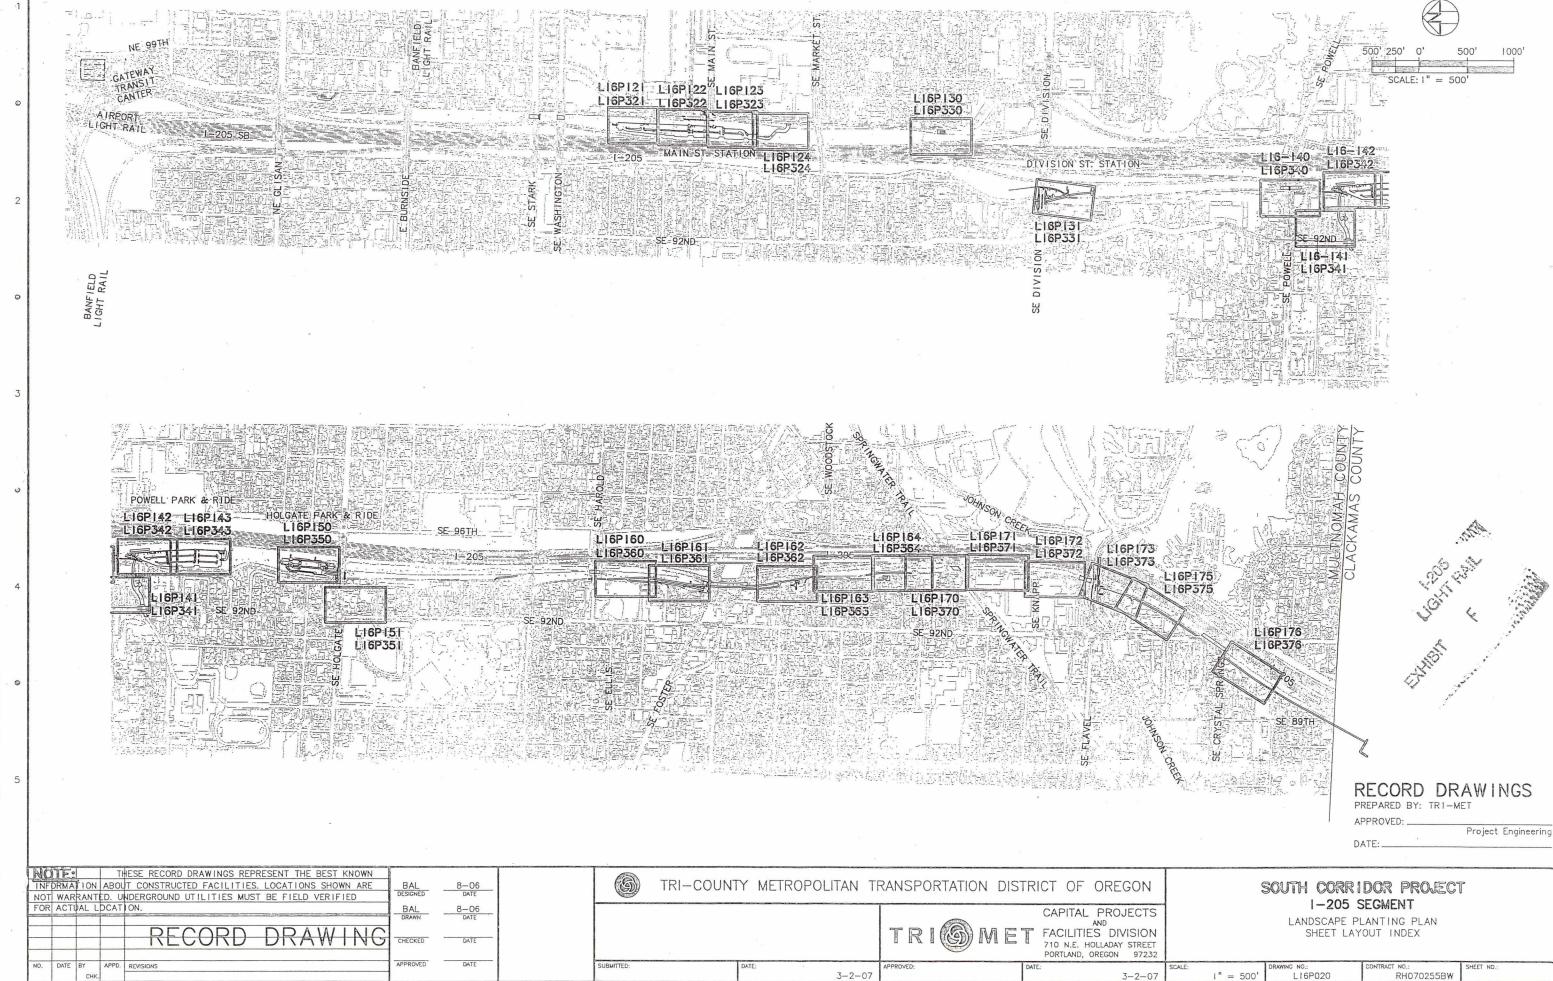

AS-BUIL: ... ADSCAPE\L16P020.dwg, 2/23/2010 1:17:07 PM, MCBRIE

GENERAL NOTES

- A. SEE DRAWING NOS. LIGPOOI THROUGH LIGPOIL FOR PLANTING LEGENDS.
- B. SEE DRAWING NO. LI6P300 FOR IRRIGATION LEGEND AND NOTES.
- C. SEE DRAWING NOS. LI6P321 THROUGH LI6P398 FOR IRRIGATION PLANS.
- D. SEE LIGP300 SERIES DRAWINGS FOR IRRIGATION DETAILS.
- E. REFER TO DRAWING LI6P020 AND LI6P022 FOR PLANTING & IRRIGATION SHEET LOCATIONS.
- F. REFER TO SPECIFICATION SECTION 02810, 02900 AND 02910 FOR LANDSCAPE SPECIFICATIONS
- G. PROVIDE QUANTITY OF PLANT MATERIALS INDICATED ON THE DRAWINGS. THE PLANT SPACING INDICATED IN THE LEGEND IS ONLY APPROXIMATE AND IS ONLY TO BE USED TO DETERMINE PLANT QUANTITIES WHEN NO SPECIFIC QUANTITY IS INDICATED ON THE DRAWING.
- H. NUMBERS IN CIRCLES ((XXXX)) REFER TO PLANTING AND IRRIGATION NOTES. SEE IRRIGATION LEGEND FOR NOTE CONTENT.
- INSTALL AND MAINTAIN TREES FURNISHED BY TRIMET ("OWNER-FURNISHED TREES").
 SEE LEGENDS FOR SPECIES AND QUANTITIES THAT WILL BE PROVIDED. COORDINATE DELIVERY AND RECEIPT THROUGH RESIDENT ENGINEER (RE).
- J. PRESERVE, PROTECT, AND MAINTAIN ALL IMPROVEMENTS WITHIN WORK AREAS, INCLUDING EXISTING TREES AND VEGETATION.
 THROUGHLY CLEAN ALL IMPROVEMENTS AFTER COMPLETION OF WORK.
- K. SEE SHEET LI6P601 FOR TYPICALPLANTING PLANS AT WATER QUALITY SWALES. CALCULATE PLANT QUANTITIES FROM THESE DETAILS. QUANTITIES OF PLANTS IN THESE AREAS ARE NOT INCLUDED ON LEGEND SHEETS.

PLANTING KEY NOTES

- STREET TREE IN PLANTER STRIP OR BACK OF SIDEWALK. COORDINATE WITH RE AND CITY OF PORTLAND FORESTRY STAFF. FORESTRY STAFF TO MARK TREE INSTALLATION LOCATION WITH WHITE PAINT MARK ON CURB. DO NOT PROCEED WITH INSTALLATION UNTIL MARK PROVIDED.
- 2 STREET TREE IN TREE WELL. CENTER TREE TRUNK, BOTH DIRECTIONS, IN WELL. CONFIRM CITY OF PORTLAND FORESTRY STAFF APPROVAL OF LOCATION WITH RE PRIOR TO PROCEEDING WITH INSTALLATION.
- (3) TREE IN TREE WELL. CENTER TREE TRUNK, BOTH DIRECTIONS, IN WELL.
- (4) LRT PLATFORM TREE. SEE #3/L16P901
- (5) EXISTING TREE TO REMAIN. PRESERVE AND PROTECT. NO STAGING OR WORK ALLOWED INSIDE DRIPLINE WITHOUT SPECIFIC RE APPROVAL.
- 6 POCKET PLANT TREE. EXCAVATE TREE PIT 2 TIMES DIAMETER OF ROOTBALL. REMAINDER OF DETAIL SIM. TO #1/L16P901 OR #2/L16P901. FINISH POCKET PLANTED AREA WITH BARK MULCH ONLY. MINIMUM RADIUS OF AREA IS 3'-0" UNLESS DRAWN OTHERWISE.
- 7) TREE NOT IN CONTRACT (N.I.C). PROVIDED BY CITY OF PORTLAND BES. PROVIDE IMPORTED TOPSOIL ONLY IN THIS AREA. COORDINATE TOPSOIL INSTALLATION WITH BES PLANTING SCHEDULE.
- B) PROVIDE TREE AND IMPORTED TOPSOIL ONLY THIS AREA. PLANTING AND MAINTENANCE PROVIDED BY CITY OF PORTLAND BES. COORDINATION TOPSOIL AND TREE INSTALLATION WITH BES PLANTING SCHEDULE.
- 9 SPECIFIC TREE LAYOUT RELATIONSHIP. CONSULT WITH RE REGARDING INTENT PRIOR TO MARKING TREE LOCATIONS FOR INSTALLATION. SEE KEYNOTE (9) ON SHEET FOR DETAILED DESCRIPTION OF LAYOUT INTENT.
- (10) WORK SCHEDULE RESTRICTIONS IN THIS AREA. SEE SPECIAL PROVISIONS.
- (II) BARK MULCH ONLY IN THIS AREA. CLEAN AND GRUB AS NEEDED TO ELIMINATE WEEDS/PLANTS PRIOR TO BARK INSTALL.

DETAIL REFERENCES

PLANTING DETAILS APPLY TO ALL PLANTS SHOWN ON LEGENDS AND LAYOUT SHEETS AS FOLLOWS:

TREE PLANTING AND STAKING



APPLIES TO ALL TREES, CONIFEROUS AND DECIDUOUS, PLANTED ON SLOPES LESS STEEP THAN 4 UNITS HORIZONTAL TO ONE UNIT VERTICAL

TREE PLANTING ON SLOPE



APPLIES TO ALL TREES, CONIFEROUS AND DECIDUOUS, PLANTED ON SLOPES STEEPER THAN 4 UNITS HORIZONTAL TO ONE UNIT VERTICAL

LRT PLATFORM TREE



APPLIES TO ALL TREES INSTALLED ON LRT PLATFORMS. AS INDICATED BY KEY NOTE

PLANTING BED GRADING



APPLIES TO ALL PROJECT PLANTING AREAS

PLANTING



APPLIES TO ALL PLANTS, EXCEPT TREES, INSTALLED ON THE PROJECT ON SLOPES LESS STEEP THAN 4 UNITS HORIZONTAL TO ONE UNIT VERTICAL

PLANTING AT SLOPE

PLANT SPACING



APPLIES TO ALL PLANTS, EXCEPT TREES AND PLANTS IN CONTAINERS SMALLER THAN I GALLON, INSTALLED ON SLOPES STEEPER THAN 4 UNITS HORIZONTAL TO ONE UNIT VERTICAL

VERTICAL

APPLIES TO ALL PLANTS EXCEPT TREES AND THOSE SHOWN OTHERWISE ON PLANTING PLAN ENLARGEMENTS, SHEETS LIGP501 THROUGH LIGP701

DRAWING SYMBOLS AND ABBREVIATIONS (SEE ALSO LEGEND SHEETS)

O.C.

ON-CENTER

L.F.

SF

LINEAR FOOT SQUARE FOOT

LB/LBS

POUND(S)

RE

TRIMET'S RESIDENT ENGINEER

×---×

EXISTING FENCE
PROPOSED FENCE

PROPOSED RETAINING WALL

ПППП.

PROPOSED RETAINING WALL

• • •

PROPOSED SOUND WALL

I-205 LIGHT RAIL

EXHIBIT

RECORD DRAWINGS

PREPARED BY: IKI-M

APPROVED: _____

Project Engineering

NO	150		TH	ESE RECORD DRAWINGS REPRESENT THE BEST KNOWN		CHICAGO CONTRACTOR CON
	DRMA		ABOL		SB	10-06 DATE
FOR	WAR		DCAT	NDERGROUND UTILITIES MUST BE FIELD VERIFIED ON.	BAL DRAWN	10-06 DATE
		Per al		RECORD DRAWING	SB	3-07 DATE
NO.	DATE	BY	APPD.	REVISIONS	JJ APPROVED	3-2-07 DATE
		снк.				

5 TRI

SUBMITTED:


TRI-COUNTY METROPOLITAN TRANSPORTATION DISTRICT OF OREGON

3-2-07

CAPITAL PROJECTS
AND
FACILITIES DIVISION
710 N.E. HOLLADAY STREET
PORTLAND, OREGON 97232

SOUTH CORRIDOR PROJECT I-205 SEGMENT

OVERALL PLANTING LEGEND, NOTES, AND DETAIL REFERENCES

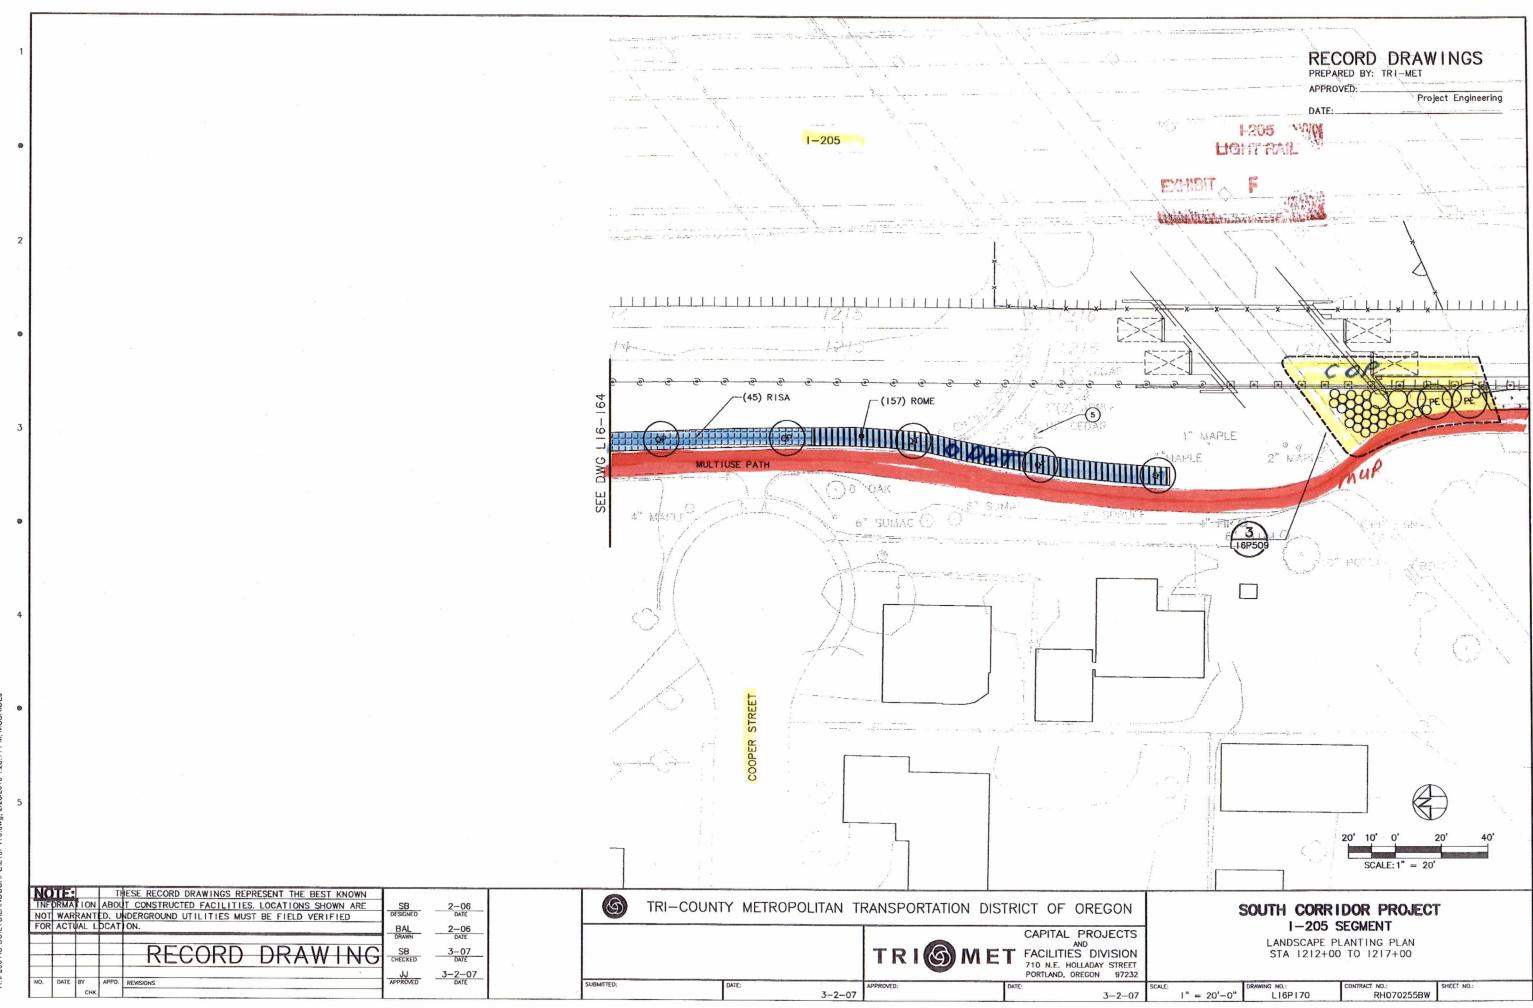

241-205 AS-RUILTS\ ANDSCAPE\\ 16P170 dwd 2/23/2010 1-28-11 PM MCBRIDE