

Deis, Fred

From: Deis, Fred
Sent: Thursday, January 31, 2013 10:05 AM
To: 'rgvandy@regence.com'
Cc: Keogan, Thomas
Subject: 100 SW market St - 10-191669 FA - Regence 1st Floor TI

Rick,

A review of our files indicates that the above referenced permit has not been closed. The last inspection performed was for wallboard attachment on 12/2/10. Please contact Tom Keogan (823-0637) to perform a final inspection.

Thank you

Fred C. Deis
Section Manager, Facilities Permit Program
Bureau of Development Services, City of Portland
Phone: 503-823-7543
Email: Fred.Deis@portlandoregon.gov



CITY OF PORTLAND, OREGON - BUREAU OF DEVELOPMENT SERVICES

1900 SW Fourth Avenue, Suite 5000 • Portland, Oregon 97201 • www.portlandonline.com/bds • Fax 503-823-7425



Facility Permit Plan Intake Form

FOR INTAKE, STAFF USE ONLY		Building/Mechanical	<u>TOM</u> <u>Ⓞ</u>
Date Received	_____	Electrical	<u>LEE</u> <u>Ⓟ</u>
Building Registration #	_____	Plumbing	_____
Fixed Bid	<u>NO</u>	Fire	<u>GARY</u> <u>Ⓞ</u>
Bin #	<u>F13</u>	Planning	_____
Building Permit #	<u>10-1916de9 FA</u>	BES	_____
Mechanical #	_____	PDOT	_____
Plumbing Permit #	_____	Structural	_____
Electrical Permit #	_____	Other	_____

APPLICANT: Complete all sections below that apply to the project. Please print legibly.

Print Name NICOLE BEKIKEN Sign Name Nicole Pm
 Street Address 1515 SE Water Ave. Ste 100
 City Portland State OR Zip Code 97214
 Day Phone 503.224.9500 FAX 503.228.1285 email nbekiken@grpmark.com

Plans / permits available for pick up at 1900 SW 4th Avenue, 2nd floor between 8:00 am to 5:00 pm

Contact Name for plan/permit pick up Nicole Bekiken
 Day Phone 503.224.9500 email nbekiken@grpmark.com

Project Building Name / # 100 SW Market
 Project Address or Location 100 SW Market
 Project Name and Description Regence first floor Tenant Improvement with New interior store front door
 Total Project Value \$7,500 Project Reference #/Billing ID # 1st Floor
 Building Contractor Folcrum CCB # 131358
 Mechanical Contractor _____ CCB # _____
 Electrical Contractor _____ CCB# _____ License # _____
 Plumbing Contractor _____ CCB# _____ License # _____

Building Permit
 No. of Stories 7
 Const. Type I-B
 [Y] [N] Alarms Required
 [Y] [N] Smoke Det. Req'd
 [Y] [N] Sprinklers Req'd
 [Y] [N] Struct. Eng / Calcs Submitted

Electrical Permit
 Please provide a completed standard electrical permit application form. You may mail or deliver it to 1900 SW 4th Avenue, Portland, Oregon 97201 or FAX to 503-823-7425.

Mechanical Permit
 Mechanical Valuation _____
 Description _____

Plumbing Permit
 Number of Fixtures _____
 Back Flow Devices _____
 Water Service (# of Feet) _____
 Medical Gas _____
 Other _____

REGENCE BLUECROSS BLUESHIELD

FIRST FLOOR TENANT IMPROVEMENT

DESIGN TEAM

OWNER

REGENCE BLUECROSS BLUESHIELD OF OREGON

100 SW Market
PO Box 1271
Portland, Oregon 97207-1271
PHONE: (503) 450-1763
Contact: Robin Klein
PHONE: (503) 721-4031
Contact: Rick Van Dyke


ARCHITECT / INTERIOR DESIGN

GROUP MACKENZIE


1515 SE Water Ave, Suite 100
PO Box 14310
Portland, Oregon 97214
PHONE: 503-224-9560
FAX: 503-228-1285
Contact: Lynne Ingram
E-MAIL: lfi@grpmack.com

LEGEND

- EXISTING WALL TO REMAIN
- NEW WALL TO UNDERSIDE OF GRID, SEE 2/A8.1
- EXISTING FIRE EXTINGUISHER TO REMAIN
- NEW OR RELOCATED FIRE EXTINGUISHER
- REQUIRED EXIT
- EGRESS PATH
- NOT IN SCOPE
- B OCCUPANCY, TABLE 1004.1.1 ASSEMBLY FUNCTION UNCONCENTRATED TABLES AND CHAIRS
- NEW SURFACE MOUNTED FIRE EXTINGUISHER

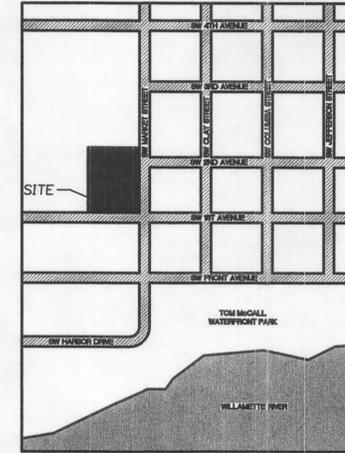

2 SITE MAP
T1.0 NTS

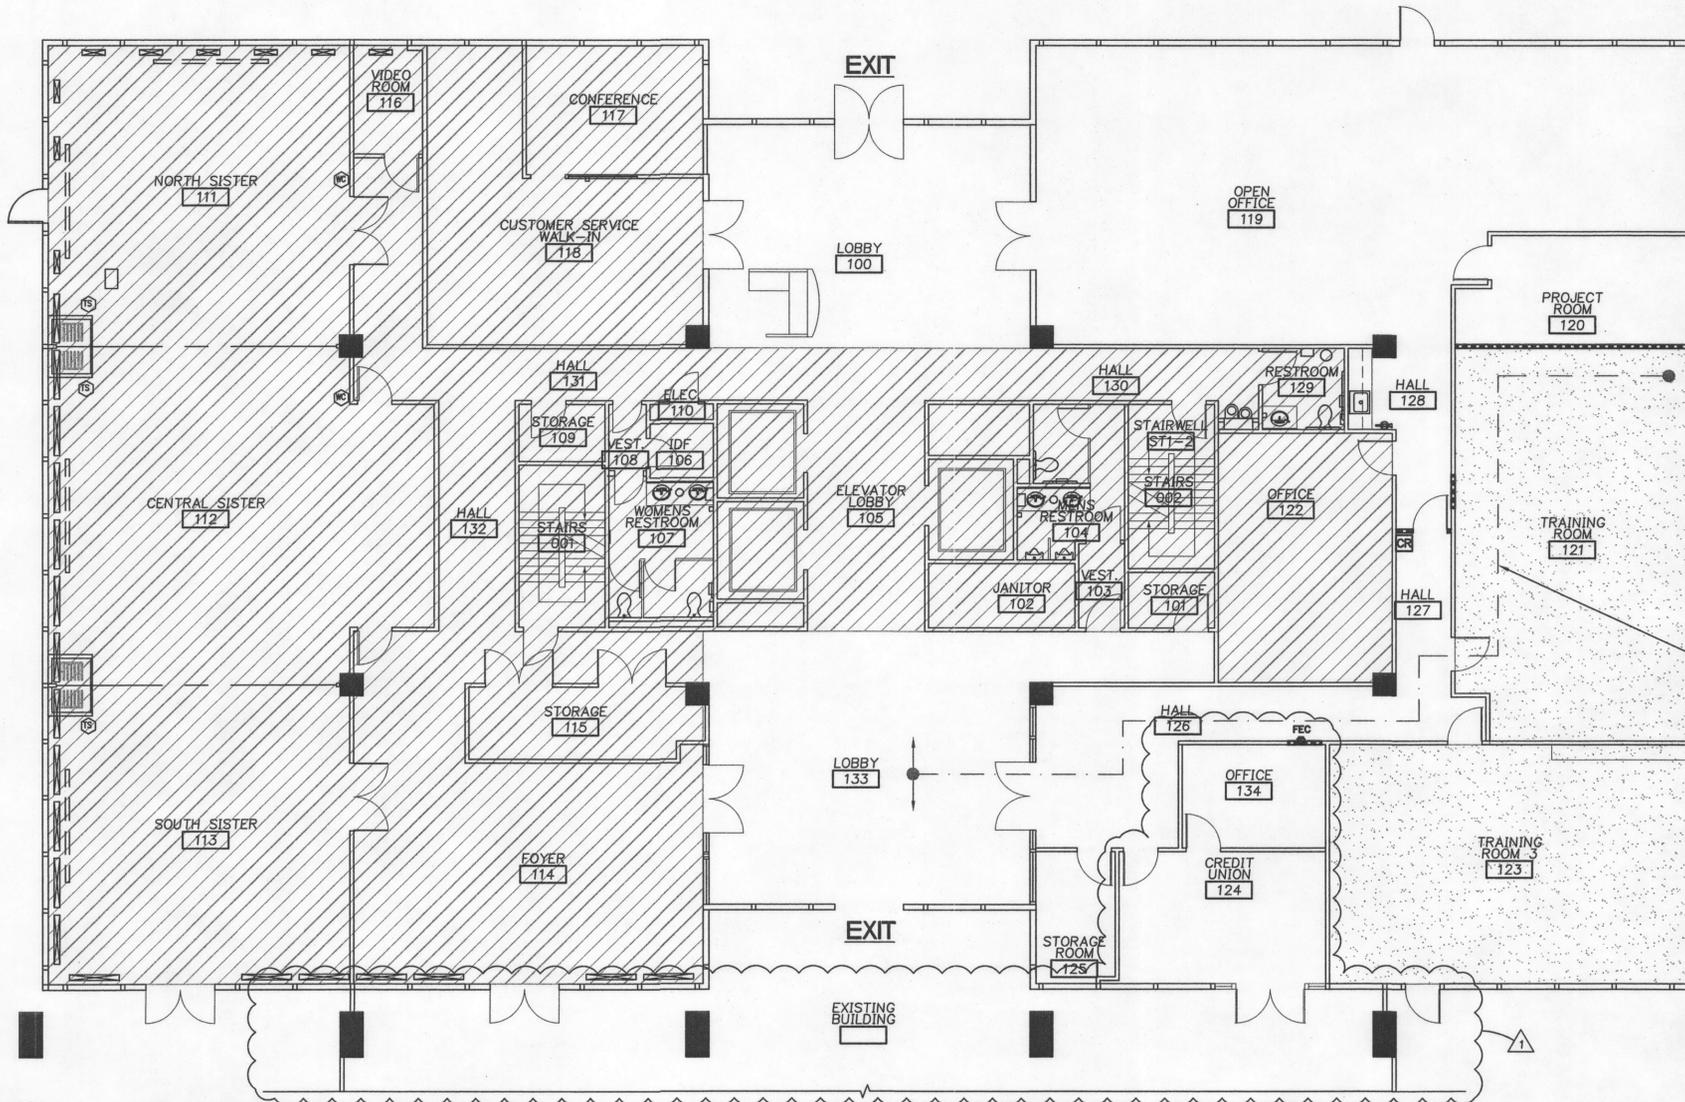

1 CODE SUMMARY PLAN
T1.0 1/8"=1'-0"

SCOPE OF WORK

THE SCOPE OF WORK FOR THE PROJECT INCLUDES AN INTERIOR TENANT IMPROVEMENT FOR AN APPROXIMATELY 3,810 SQUARE FOOT TENANT ON THE FIRST FLOOR.

DESIGN/CODE DATA

GOVERNING CODE: 2010 OSSC
OCCUPANCY: B
CONSTRUCTION TYPE: TYPE I-B
TOTAL TENANT AREA (APPROX): APPROX. 11,453 S.F.
EFFECTED TENANT AREA: APPROX. 3,778 S.F.
ASSEMBLY FUNCTION: 1,369 S.F. /15 = 92 OCCUPANTS
BUSINESS FUNCTION: 2,409 S.F. /100 = 25 OCCUPANTS
TOTAL OCCUPANCY LOAD: 117
TWO REQUIRED EXITS, TWO EXITS PROVIDED
ALL EXITS ARE EXISTING. BUILDING IS FULLY SPRINKLED AND HAS NFPA SMOKE DETECTION THROUGHOUT

DEFERRED SUBMITTAL

OSSC SECTION 106.3.4.2 (by separate permit)
MECHANICAL NOTE: DESIGN BUILDERS FOR M.E.P. AND FP. ARE FULLY RESPONSIBLE FOR THE DESIGN OF THESE SYSTEMS/COMPONENTS.
ELECTRICAL THESE SYSTEMS/COMPONENTS SHOWN ON DOCUMENTS ARE SCHEMATIC ONLY; THEY ARE NOT INTENDED TO REPRESENT FINAL/CODE COMPLIANT DESIGN. PROVIDE DESIGN DOCUMENT SUBMITTAL TO ARCHITECT OF RECORD FOR REVIEW PRIOR TO SUBMITTAL.
FIRE SPRINKLER
FIRE ALARM

VALUATION OF WORK = \$5,000

INDEX OF DRAWINGS

ARCHITECTURAL DRAWINGS

- T1.0 TITLE SHEET AND CODE SUMMARY PLAN
- A2.1 FIRST FLOOR PLAN AND NOTES
- A6.1 FIRST FLOOR REFLECTED CEILING PLAN AND NOTES
- A8.1 DETAILS
- A9.1 SCHEDULES

GROUP MACKENZIE
Architecture
Interior Design
Land Use Planning
Civil Engineering
Structural Engineering
Transportation Planning
Landscape Architecture
Vancouver WA 360.865.7879
Seattle WA 206.7.9993



Project
100 MARKET
FIRST FLOOR
TENANT IMPROVEMENT

100 SW MARKET ST.
PORTLAND, OR



© GROUP MACKENZIE 2010
ALL RIGHTS RESERVED
THESE DRAWINGS ARE THE PROPERTY OF GROUP MACKENZIE AND ARE NOT TO BE USED OR REPRODUCED IN ANY MANNER, WITHOUT PRIOR WRITTEN PERMISSION

REVISION	REVISIONS	REVISION	DELTA	CLOSING DATE
1	X			11/09/2010

SHEET TITLE:
TITLE SHEET
AND CODE
SUMMARY PLAN

DRAWN BY: NMB
CHECKED BY: LFI, PPA
SHEET:


T1.0

JOB NO. 2070057.04

REVISED PERMIT SET: 11/9/2010



D-191669-FA Micro FA

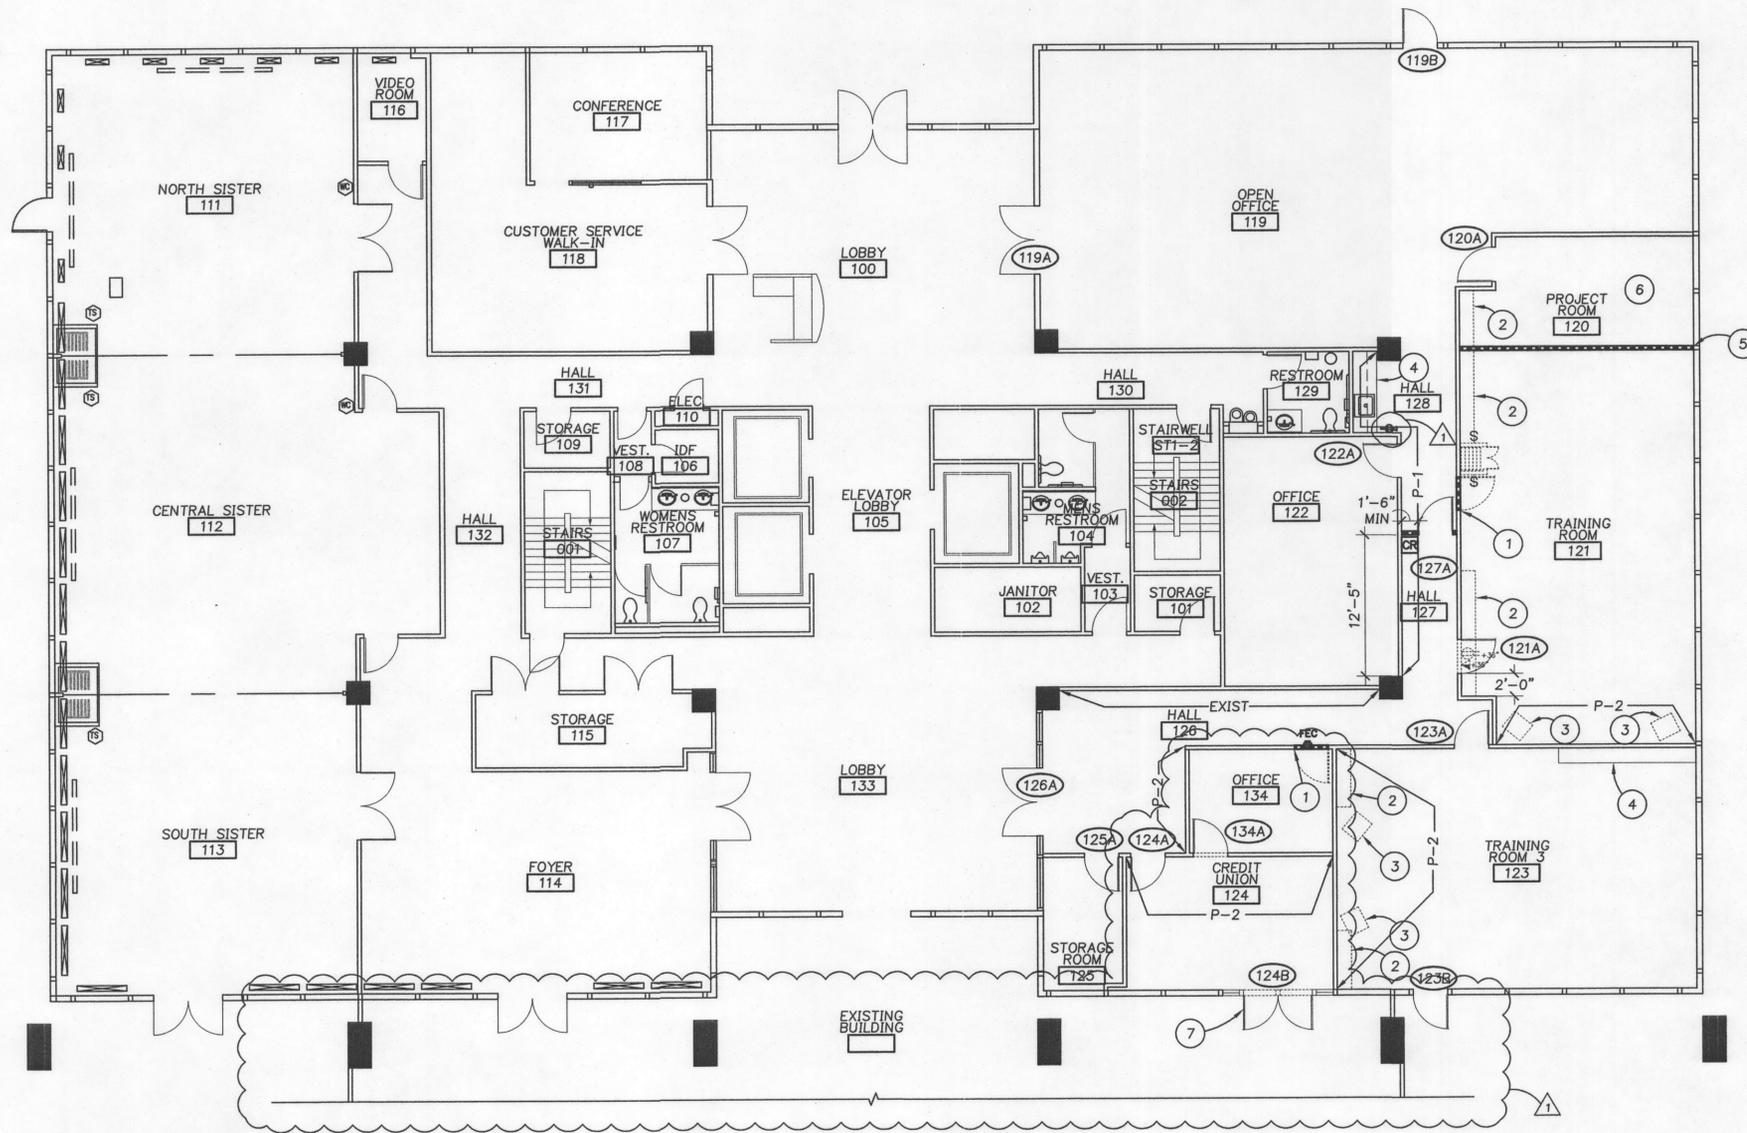

1 FIRST FLOOR PLAN
A2.1 1/8"=1'-0"

KEYNOTES

1. ALIGN NEW WALL WITH EXISTING WALL OR COLUMN
2. DEMOLISH EXISTING CASEWORK
3. DEMOLISH EXISTING TELEVISION WALL MOUNT BRACKETS AND PATCH WALLS
4. EXISTING CASEWORK TO REMAIN
5. CENTER NEW WALL ON EXISTING WINDOW MULLION, SEE 6/A8.1
6. CONTRACTOR TO PROVIDE PRICING FOR CARPET AND MARMOLEUM OPTIONS IN THIS ROOM
7. MODIFY EXISTING STOREFRONT TO ACCOMMODATE NEW DOORS. STOREFRONT DOORS TO MATCH EXISTING BUILDING STANDARD. APPLY WINDOW FILM, SEE 7/A8.1

GENERAL NOTES

- A. DIMENSIONS REFLECT FACE OF FINISH TO FACE OF FINISH, UNLESS NOTED OTHERWISE.
- B. WALL THICKNESS ARE NOMINAL, UNLESS NOTED OTHERWISE.
- C. ALL NEW INTERIOR WALLS TO GO TO UNDERSIDE OF GRID UNLESS NOTED OTHERWISE.
- D. EXISTING INTERIOR DOORS AND FRAMES TO BE REUSED WHERE REQUIRED.
- E. LOWER VOC PAINT SYSTEMS TO BE UTILIZED, TO INCLUDE PRIMERS AS WELL AS FINISH PRODUCTS.
- F. VERIFY AND CONFIRM ALL DIMENSIONS AND CONDITIONS PRIOR TO START OF WORK. NOTIFY ARCHITECT/ENGINEER OF ANY DISCREPANCIES PRIOR TO START OF WORK. PATCH AND REPAIR EXISTING WORK DAMAGED DURING CONSTRUCTION TO NEW CONDITION.
- G. MECHANICAL, ELECTRICAL, AND PLUMBING DESIGN/BUILD BY OTHERS.
- H. THE CONTRACTOR IS RESPONSIBLE FOR ANY DAMAGE OR REQUIRED CLEANING THROUGHOUT THE STRUCTURE, DEEMED TO BE THE RESULT OF THEIR WORK. THE CONTRACTOR WILL CLEAN UP ALL AREAS AFFECTED BY DUST OR ANY MATERIALS, BOTH DURING CONSTRUCTION AND UPON COMPLETION OF THE PROJECT.
- J. ALL DIMENSIONS SHOWN AS PLUS/MINUS (±) ARE FOR GENERAL LAYOUT AND REFERENCE ONLY.
- K. REPAIR & PREP ALL EXISTING WALLS FOR NEW FINISH AS REQUIRED.
- L. CONTRACTOR TO COORDINATE CONSTRUCTION ISSUES WITH THE CITY OF PORTLAND SO THAT ALARMS ARE NOT INADVERTANTLY SET OFF.
- M. CONTRACTOR TO PROVIDE CLIENT WITH ALL MSDS SHEETS FOR GLUE AND ADHESIVES PRIOR TO START OF PROJECT.
- N. SUBSTITUTIONS ARE NOT ALLOWED.
- O. REPLACE ALL OUTLET COVERPLATES AND SWITCH PLATES WITH NEW MATTE BLACK PLATES.
- P. ALL WALLS TO BE PAINTED P-1 UNLESS NOTED OTHERWISE.
- Q. NEW MECO SHADES TO BE PROVIDED BY OWNER, NIC. CONTRACTOR TO COORDINATE INSTALLATION WITH OWNER.
- R. COORDINATE ELECTRICAL REQUIREMENTS WITH TENANT, ALL ELECTRICAL DRAWINGS WILL BE BY DEFERRED SUBMITTAL.
- S. OUTLETS INDICATED ARE EXISTING UNLESS NOTED OTHERWISE. SITE VERIFICATION HAS BEEN PERFORMED AND PLAN, ELECTRICAL AND CEILING INFORMATION HAS BEEN UPDATE (OBSERVATION IS LIMITED TO VISIBLE/ACCESSIBLE AREAS). CONTRACTOR TO FIELD VERIFY AND CONFIRM ADDITIONAL REQUIREMENTS WITH TENANT.
- T. REFINISH EXISTING WOOD DOORS AS REQUIRED TO 'LIKE NEW' APPEARANCE.
- U. CONTRACTOR RESPONSIBLE TO RECYCLE AND/OR DISPOSE OF DEMO'D DOORS AND FRAMES.
- V. CONSTRUCTION SPACE TO BE KEPT BROOM CLEAN AT ALL TIMES EXCEPT DURING ACTUAL DEMOLITION.
- W. RECYCLE DEMOLITION DEBRIS WHERE POSSIBLE IN ACCORDANCE WITH AND SUPPORTING THE CLIENT'S GREEN BUILDING PRACTICES. COORDINATE WITH CITY OF PORTLAND REQUIREMENTS FOR RECYCLING DEMOLITION DEBRIS.

LEGEND

- EXISTING CONSTRUCTION TO BE DEMOLISHED
- EXISTING WALL TO REMAIN
- NEW WALL TO UNDERSIDE OF GRID, SEE 2/A8.1
- NEW CARD READER
- NEW SURFACE MOUNTED FIRE EXTINGUISHER
- NEW BUILDING STANDARD RECESSED FIRE EXTINGUISHER CABINET

GROUP MACKENZIE
 Architecture
 Interior Design
 Land Use Planning
 Civil Engineering
 Structural Engineering
 Transportation Planning
 Landscape Architecture
 Client
 Vancouver WA 360.696.7879
 Portland OR 503.224.9560
 Seattle WA 206.749.9993



Project
100 MARKET FIRST FLOOR TENANT IMPROVEMENT

100 SW MARKET ST.
 PORTLAND, OR



GROUP MACKENZIE 2010 ALL RIGHTS RESERVED
 THESE DRAWINGS ARE THE PROPERTY OF GROUP MACKENZIE AND ARE NOT TO BE USED OR REPRODUCED IN ANY MANNER, WITHOUT PRIOR WRITTEN PERMISSION



REVISIONS:

REVISION	REVISIONS THIS SHEET	REVISION CLOSING DATE	DELTA
1	X	11/09/2010	

SHEET TITLE:
FIRST FLOOR PLAN AND NOTES


DRAWN BY: NMB
 CHECKED BY: LFI, PPA
 SHEET:

A2.1
 JOB NO. 2070057.04

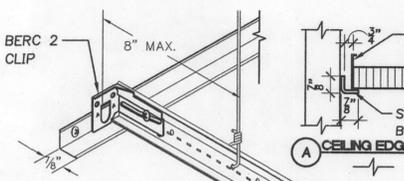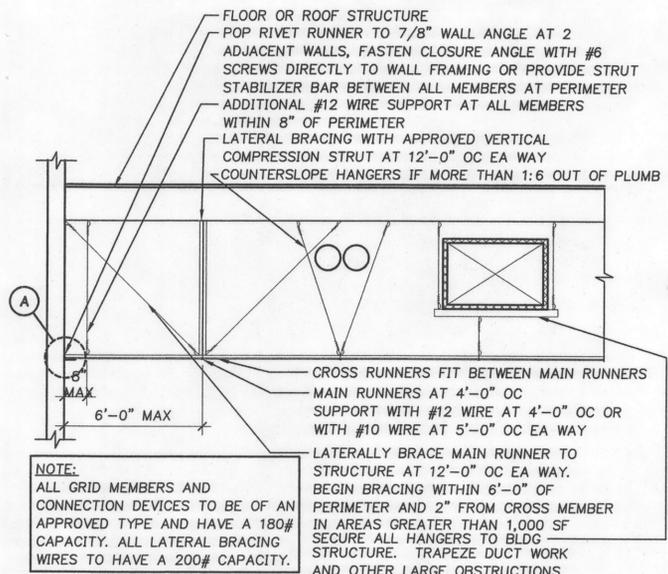

NOTE: FOR UNATTACHED WALLS PROVIDE A 1/2" TO 3/4" GAP BETWEEN EDGE OF ANGLE AND CLIP
 --- DO NOT SCREW BERC 2 CLIP TO TRACK

TABLE	MAX. LENGTH
1/2" DIA CONDUIT (EMT)	5'-10"
3/4" DIA CONDUIT (EMT)	7'-8"
1" DIA CONDUIT (EMT)	9'-9"
SGL 162S125-33 MTL STUD (1-5/8"x20GA)	12'-0"
BACK TO BACK 162S125-33 MTL STUDS (1-5/8"x20GA)	15'-0"
SGL 250S125-33 MTL STUD (2-1/2"x20GA)	13'-6"
BACK TO BACK 250S125-33 MTL STUDS (2-1/2"x20GA)	15'-0"

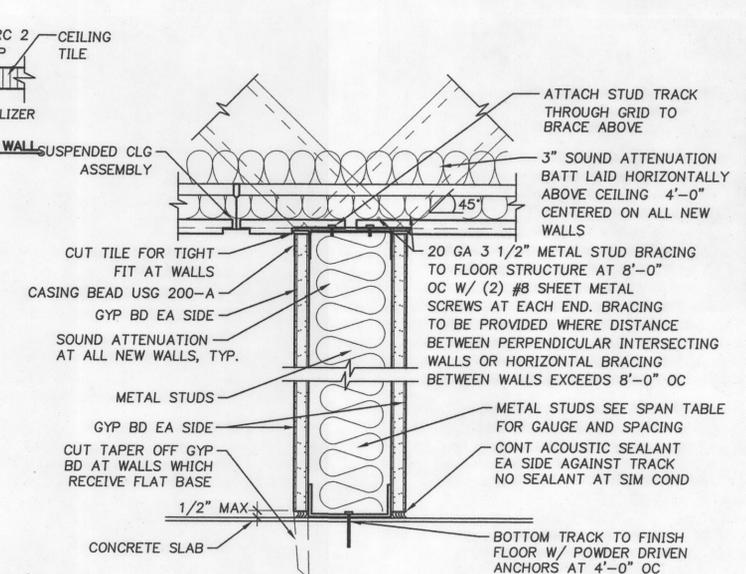


DESIGNATION	STUD CONDITIONS - INTERIOR PARTITIONS
362S125-18	ALL WALLS 11'-0" TO 12'-0" IN HEIGHT - 16" OC
362S125-18	ALL WALLS UNDER 11'-0" IN HEIGHT - 24" OC
362S162-43	ALL WALLS 12'-0" TO 16'-0" IN HEIGHT - 16" OC ALL WALLS WITH TILE FINISH ALL MIRRORED WALLS IN TOILET ROOMS
362S162-68	ALL WALLS 16'-0" TO 24'-0" IN HEIGHT - 12" OC


1 SUSPENDED CEILING BRACING
 A8.1 NOTE: PROVIDE SEISMIC SEPARATION JOINTS IN CEILINGS GREATER THAN 2,500 SF. PROVIDE HEAVY DUTY GRID SYSTEM.

2 NON-BEARING WALL
 A8.1 AT FLOOR AND SUSPENDED CEILING


3 SPAN TABLE FOR METAL STUDS
 A8.1

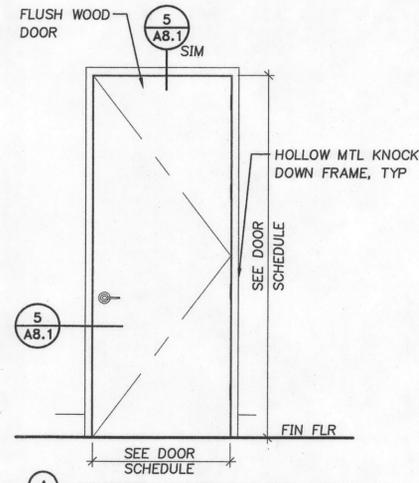


4 DOOR ASSEMBLY
 A8.1

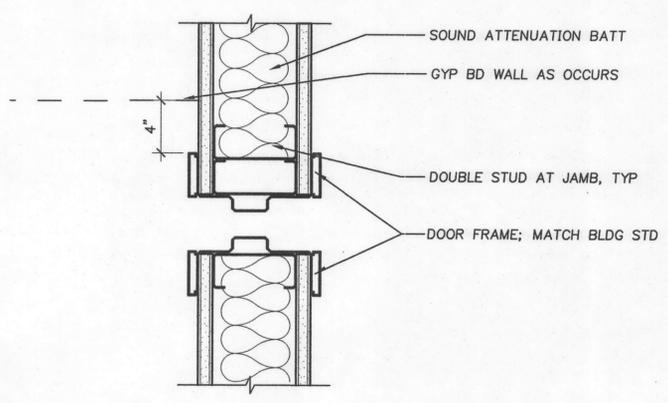

5 TYP INTERIOR DOOR
 A8.1 HEAD SIMILAR

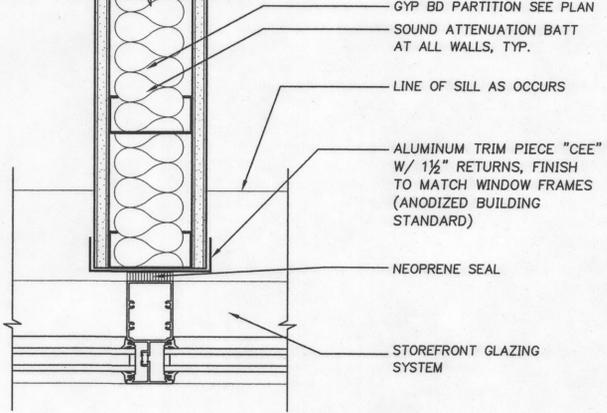

6 WALL AT EXTERIOR MULLION
 A8.1

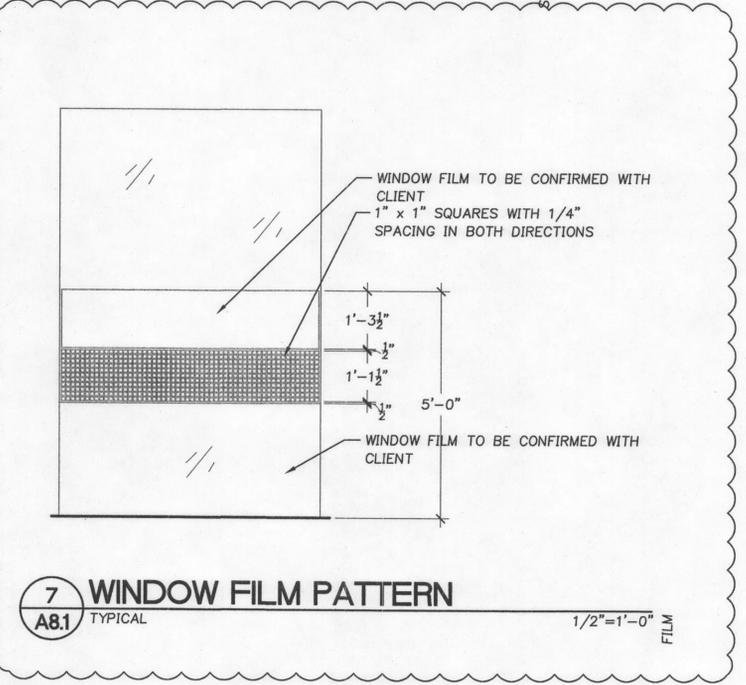

7 WINDOW FILM PATTERN
 A8.1 TYPICAL

GROUP MACKENZIE
 Architecture
 Interior Design
 Land Use Planning
 Civil Engineering
 Structural Engineering
 Transportation Planning
 Landscape Architecture
 Client
 Seattle WA 206.746.9893
 Vancouver WA 360.695.7676
 Portland OR 503.224.9560



Project
100 MARKET FIRST FLOOR TENANT IMPROVEMENT

100 SW MARKET ST. PORTLAND, OR



© GROUP MACKENZIE 2010 ALL RIGHTS RESERVED
 THESE DRAWINGS ARE THE PROPERTY OF GROUP MACKENZIE AND ARE NOT TO BE USED OR REPRODUCED IN ANY MANNER, WITHOUT PRIOR WRITTEN PERMISSION

REVISIONS:

REVISION	REVISIONS THIS SHEET	REVISION DELTA	REVISION CLOSING DATE
1	X		11/09/2010

SHEET TITLE:
DETAILS

DRAWN BY: NMB
 CHECKED BY: LFI, PPA
 SHEET:

A8.1

JOB NO. **2070057.04**

REVISED PERMIT SET: 11/9/2010

DOOR SCHEDULE

DOOR	DOOR		DOOR		DOOR		FRAME	DETAILS	HDWR GROUP	RATING	COMMENTS
	OPENING SIZE	THK	TYPE	MAT'L	FINISH	MAT'L FINISH					
119A	PR 3'-0"x8'-3"±	EXISTING	DOOR								
119B	3'-0"x7'-0"±	EXISTING	DOOR								
120A	3'-0"x8'-4"±	EXISTING	DOOR								
121A	3'-0"x8'-4"±	1 3/4"	FL	SC	S	HMK	FF	4/AB.1	H-1	---	
122A	3'-0"x8'-4"±	EXISTING	DOOR								
123A	3'-0"x8'-4"±	EXISTING	DOOR								
123B	3'-0"x8'-4"±	EXISTING	DOOR								
124A	3'-0"x8'-4"±	EXISTING	DOOR						H-3	---	
124B	PR 3'-0"x8'-4"±	---	SF	GL	GL	SF	FF	---	H-4	---	2
125A	3'-0"x8'-4"±	EXISTING	DOOR								
126A	PR 3'-0"x8'-4"±	EXISTING	DOOR								
127A	3'-0"x8'-4"±	1 3/4"	FL	SC	S	HMK	FF	4/AB.1	H-2	---	
134A	3'-0"x8'-4"±	1 3/4"	FL	SC	S	HMK	FF	4/AB.1	H-3	---	

HARDWARE GROUPS:
H-1: PASSAGE LATCHSET F75 GRADE 1, BUTTS, SEAL, STOPS
H-2: HALLWAY ELECTRONIC STRIKE, CARD READER, BUTTS, SEAL, STOPS, CLOSER
H-3: LOCKING OFFICE LOCKSET F82 GRADE 1, BUTTS, SEAL, STOPS
H-4: STOREFRONT BY DOOR MANUFACTURER, MATCH WITH EXISTING, COMET DOOR PULLS, LOCKING EXTERIOR HARDWARE AT FLOOR, PASSAGE FROM INTERIOR

ABBREVIATIONS (REFER TO 4/AB.1 FOR DOOR ELEVATIONS):
BG BUTT GLAZED
EXIST EXISTING
FF FACTORY FINISH
FL FLUSH
FL/R FLUSH W/RELITE
HMK HOLLOW METAL KNOCKDOWN
S STAIN
SC SOLID CORE WOOD
SF STOREFRONT
GL GLAZING

DOOR SCHEDULE COMMENTS:
1. CARD READER AT THIS LOCATION.
2. APPLY WINDOW FILM TO DOOR, SEE 7/AB.1. CONFIRM EXACT LOCATIONS WITH OWNER

DOOR SCHEDULE NOTES:
A. ALL DOORS/CLOSURES TO BE CHECKED, ADJUSTED, AND/OR REPLACED TO BE IN COMPLIANCE WITH ADA
B. ALL DOORS AND HARDWARE TO MATCH TENANT BUILDING STANDARDS, SCHLAGE, RHODES 626.
C. REUSE DOORS FROM DEMOLITION AS POSSIBLE.

ROOM FINISH SCHEDULE

ROOM NO	ROOM NAME	FLOOR MAT'L FINISH	BASE MAT'L FINISH	N. WALL MAT'L FINISH	E. WALL MAT'L FINISH	S. WALL MAT'L FINISH	W. WALL MAT'L FINISH	CEILING HT.	CEILING FINISH MAT'L	COMMENTS
100	LOBBY	EXIST	EXIST	EXIST	EXIST	EXIST	EXIST	EXIST	EXIST	1
101	STORAGE	EXIST	EXIST	EXIST	EXIST	EXIST	EXIST	EXIST	EXIST	
102	JANITOR	EXIST	EXIST	EXIST	EXIST	EXIST	EXIST	EXIST	EXIST	
103	VESTIBULE	EXIST	EXIST	EXIST	EXIST	EXIST	EXIST	EXIST	EXIST	
104	MEN'S REST.	EXIST	EXIST	EXIST	EXIST	EXIST	EXIST	EXIST	EXIST	
105	ELEV. LOBBY	EXIST	EXIST	EXIST	EXIST	EXIST	EXIST	EXIST	EXIST	
106	IDF	EXIST	EXIST	EXIST	EXIST	EXIST	EXIST	EXIST	EXIST	
107	WOMEN'S REST.	EXIST	EXIST	EXIST	EXIST	EXIST	EXIST	EXIST	EXIST	
108	VESTIBULE	EXIST	EXIST	EXIST	EXIST	EXIST	EXIST	EXIST	EXIST	
109	STORAGE	EXIST	EXIST	EXIST	EXIST	EXIST	EXIST	EXIST	EXIST	
110	ELECTRICAL	EXIST	EXIST	EXIST	EXIST	EXIST	EXIST	EXIST	EXIST	
111	NORTH SISTER	EXIST	EXIST	EXIST	EXIST	EXIST	EXIST	EXIST	EXIST	
112	CENT. SISTER	EXIST	EXIST	EXIST	EXIST	EXIST	EXIST	EXIST	EXIST	
113	SOUTH SISTER	EXIST	EXIST	EXIST	EXIST	EXIST	EXIST	EXIST	EXIST	
114	FOYER	EXIST	EXIST	EXIST	EXIST	EXIST	EXIST	EXIST	EXIST	1
115	STORAGE	EXIST	EXIST	EXIST	EXIST	EXIST	EXIST	EXIST	EXIST	
116	VIDEO ROOM	EXIST	EXIST	EXIST	EXIST	EXIST	EXIST	EXIST	EXIST	
117	CONFERENCE	EXIST	EXIST	EXIST	EXIST	EXIST	EXIST	EXIST	EXIST	
118	CUST. SERVICE	EXIST	EXIST	EXIST	EXIST	EXIST	EXIST	EXIST	EXIST	1
119	OPEN OFFICE	EXIST	EXIST	EXIST	EXIST	EXIST	EXIST	EXIST	EXIST	1
120	PROJECT RM.	EXIST	RB-1	EXIST	EXIST	GB/P	P	EXIST	EXIST	
121	TRAINING	EXIST	RB-1	GB/P	EXIST	P	GB/P	EXIST	EXIST	
122	OFFICE	EXIST	EXIST	EXIST	EXIST	EXIST	EXIST	EXIST	EXIST	
123	TRAINING	EXIST	RB-1	R	EXIST	R	EXIST	EXIST	EXIST	
124	CREDIT UNION	EXIST	EXIST	P	P	GL	P	EXIST	EXIST	
125	STORAGE	EXIST	EXIST	EXIST	EXIST	EXIST	EXIST	EXIST	EXIST	
126	HALL	EXIST	RB-1	EXIST	P	GB/P	EXIST	EXIST	EXIST	
127	HALL	EXIST	RB-1	GB/P	P	P	EXIST	EXIST	EXIST	
128	HALL	EXIST	RB-1	---	GB/P	GB/P	P	EXIST	EXIST	
129	RESTROOM	EXIST	EXIST	EXIST	EXIST	EXIST	EXIST	EXIST	EXIST	
130	HALL	EXIST	EXIST	EXIST	EXIST	EXIST	EXIST	EXIST	EXIST	
131	HALL	EXIST	EXIST	EXIST	EXIST	EXIST	EXIST	EXIST	EXIST	
132	HALL	EXIST	EXIST	EXIST	EXIST	EXIST	EXIST	EXIST	EXIST	
133	LOBBY	EXIST	EXIST	EXIST	EXIST	EXIST	EXIST	EXIST	EXIST	
134	OFFICE	EXIST	RB-1	GB/P	P	P	P	EXIST	EXIST	

FINISH SCHEDULE NOTES:
A. PATCH AND REPAIR ALL EXISTING WALLS WHERE AFFECTED BY NEW WORK. PAINT NEW WALLS AND EXISTING WALLS AS NOTED.
B. PROVIDE NEW PAINT, RUBBER BASE, AND FLOOR FINISH AS NOTED.
C. PROVIDE A LEVEL 4 FINISH ON NEW WALLS, UNO.

ABBREVIATIONS:
CPT CARPET
EXIST EXISTING
GB GYPSUM BOARD
GL GLAZING
LIN LINOLEUM
P PAINT
RB RUBBER BASE
WT WALLTALKERS

FINISH SCHEDULE COMMENTS:
1. CONTRACTOR TO FILL AND PAINT EXISTING METAL HEADER

SCHEDULE OF INTERIOR FINISHES

SECTION 09650 - RESILIENT FLOORING

- RESILIENT FLOORING
LIN-1: FORBO, MARMOLEUM, REAL AUTHENTIC, 3164 INDIAN SUMMER

- NOTE: HEAT WELD SEAMS
2. RUBBER BASE
RB-1: ROPPE, BLACK, 4" COVE BASE

SECTION 09685 - CARPET TILE

- CARPET TILE
CPT-1: SALVAGED FROM STORAGE ROOM 125

SECTION 09900 - PAINT AND COATINGS

- INTERIOR PAINT
P-1: MILLER, 0006 LITTLE DOVE (GENERAL WALL PAINT)
P-2: MILLER, 0619 HONKY TONK BLUE (ACCENT PAINT)

SECTION 08810 - GLASS DOOR HARDWARE

FORMS + SURFACES: COMET DOOR PULL, MODEL HDCMT1208, SATIN STAINLESS STEEL US32D

GROUP MACKENZIE
Architecture
Interior Design
Land Use Planning
Civil Engineering
Structural Engineering
Transportation Planning
Landscape Architecture
Vancouver WA 360.966.7679
Seattle WA 206.746.9993
Portland OR 503.224.9660

Client



Project

100 MARKET FIRST FLOOR TENANT IMPROVEMENT

100 SW MARKET ST.
PORTLAND, OR



© GROUP MACKENZIE 2010
ALL RIGHTS RESERVED
THESE DRAWINGS ARE THE PROPERTY OF GROUP MACKENZIE AND ARE NOT TO BE USED OR REPRODUCED IN ANY MANNER, WITHOUT PRIOR WRITTEN PERMISSION

REVISIONS:

REVISION	REVISIONS THIS SHEET	REVISION DELTA CLOSING DATE
1	X	11/09/2010

SHEET TITLE:

SCHEDULES

DRAWN BY: NMB

CHECKED BY: LFI, PPA

SHEET:

A9.1

JOB NO. **2070057.04**