

930

SW HALL

REV-01

FA06-110384

FA.06.110384REV.01.

X

JUL 07 2006
MICROFILMED

5

TRANSMITTAL

06-110384-Rev-0

Date: 3/6/06

To:

KATHY DAVIS
CITY OF PORTLAND
FACILITIES PERMITS
BLDG. INSPECTOR

Fax #

From: Tom Arnich
725-4306

PSU Facilities, Architectural Services
RM 102, 225-575

Re: PSU STOP INTERIOR
REMODEL PERMIT # 06-110

Job #: PSC R2 688

Sent Via

Mail

Messenger

Blueprinter

Hand
Carried

Fax

E-Mail

Other

Page 384 FA
Total

Transmitted Herewith:

3 SETS

(1) 11 X 17 REV. ...

Remarks:

REVSHEET 11

NEW LOAST @ 24B-249
REV. 2/20/06

PLEASE ADD THIS REVISION
TO PERMIT SET

CC:

PORTLAND STATE UNIVERSITY FACILITIES
617 SW MONTGOMERY STREET-2ND FLOOR
PO BOX 751, MAIL STOP FAC
PORTLAND OREGON 97207-0751

TEL: (503) 725-3738

FAX: (503) 725-4329

503-823-0653

503-823-3447

503-823-0642

503-823-3778

ivis 1 7

Gary Uryles 2


FD1

Plans 225, 228, 235 office remodel

notes

Peter Stott Center

Refer to 8-1/2 x 11 plan notes

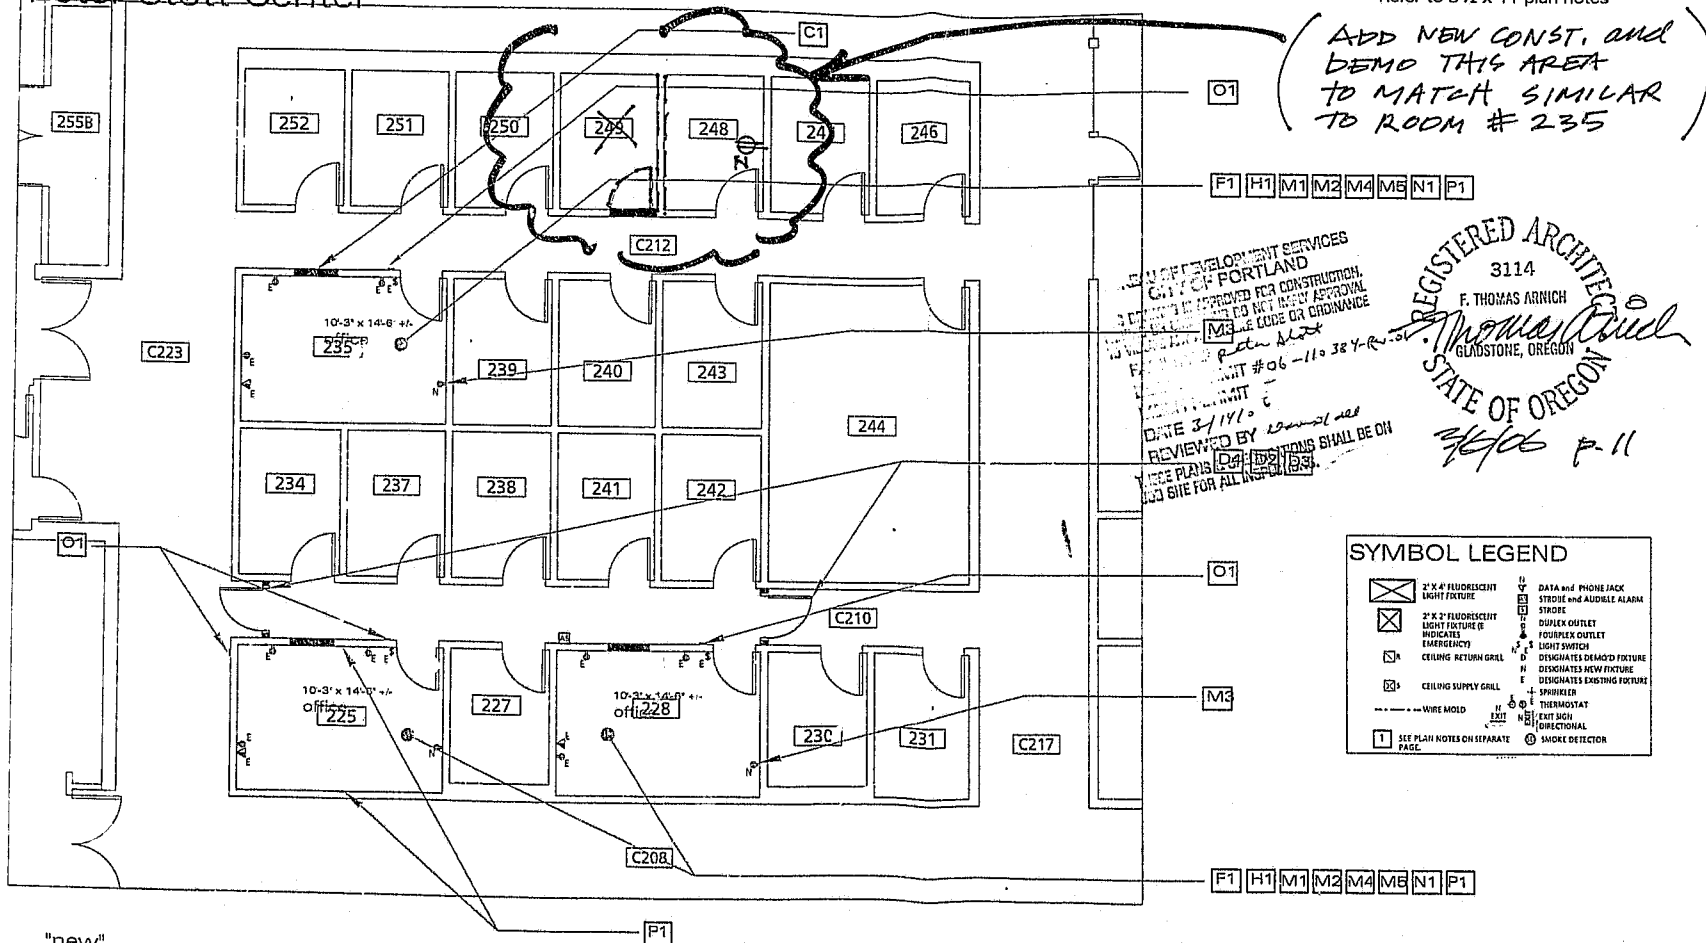

DEVELOPMENT SERVICES
CITY OF PORTLAND
DATE 3/14/10
REVIEWED BY
DATE 3/14/10
DATE 3/14/10

REGISTERED ARCHITECT
3114
F. THOMAS ARNICH
GLADSTONE, OREGON
2/6/06 p. 11

SYMBOL LEGEND

	2' x 4' FLUORESCENT LIGHT FIXTURE		DATA and PHONE JACK
	2' x 2' FLUORESCENT LIGHT FIXTURE		STROBE and AUDIBLE ALARM
	EMERGENCY LIGHT FIXTURE		STROBE
	CEILING RETURN GRILL		DUPLEX OUTLET
	CEILING SUPPLY GRILL		FOURPLEX OUTLET
	WIRE MOLD		LIGHT SWITCH
	EXIT SIGN		DESIGNATES DEMAND FEATURE
	SMOKE DETECTOR		DESIGNATES NEW FIXTURE
			DESIGNATES EXISTING FIXTURE
			THERMOSTAT
			EXIT SIGN DIRECTIONAL
			SMOKE DETECTOR

"new"
floor plan
plans

scale : 1/4" = 1'-0"

REV. 2/20/06

CHANGE #1

Plans 225, 228, 235, office remodel
Peter Stott Center
PETER V. STOTT CENTER, 990 SW 3RD, FLOOR 230
PORTLAND STATE UNIVERSITY, 900 NE ORIGIN, PORTLAND, OR 97201

PORTLAND STATE UNIVERSITY

06-110387-Rev-01

2006
1 OF 3

REV. 11
FBI