



## City of Portland, Oregon - Bureau of Development Services

1900 SW Fourth Avenue • Portland, Oregon 97201 | 503-823-7300 | [www.portland.gov/bds](http://www.portland.gov/bds)




### Permit Revision Submittal Requirements and Application

A Permit Revision is required when there are proposed changes to the project after the permit has been issued. This may arise due to discrepancies between the city-approved permit drawings and actual field conditions, or the customer has changed their mind about an aspect of the project. In all cases, a revision to the existing permit must be submitted, reviewed and approved.

#### Minimum Submittal Requirements (check all boxes and sign below):

- ☐ A copy of this application.
- ☐ One PDF copy of plans for electronic submittals or three copies for paper submittals.
- ☐ All plans must clearly reflect the proposed change(s). Changes must be bubbled.
- ☐ Drawings and calculations must be stamped and signed by the Architect and/or the Engineer of Record, if applicable.
- ☐ Project narrative for extensive revisions.
- ☐ One PDF copy of calculations and other supporting documents for electronic submittals or two copies for paper submittals.
- ☐ Copy of Inspector's correction notice, if the revision is due to an inspection correction. One PDF copy for electronic submittals and two copies for paper submittals.

#### Applicant Information:

Applicant Name Dree Hayden  
Street Address 351 Nw 12th Ave City/State/ZIP Portland, Or 97209  
Email d.hayden@alliant-systems.com Phone 9712171747  
Value of Proposed Revision \$0.00 Issued Permit # IVR#:4706171  
Job Site Address 18440 Ne Portal Way City/State/ZIP Portland, Or 97230  
Description of Revision add mechanical plans to issued MT permit - 21-055455-MT  
Applicant Signature  Date 7.19.21

#### Fees:

An invoice with permit fees will be sent to the applicant once minimum submittal requirements have been verified. Permit Revisions are subject to fees associated with plan review, processing and any increase in project value.

The Bureau of Development Services fee schedule is on the BDS web site: [www.portlandoregon.gov/bds/article/102792](http://www.portlandoregon.gov/bds/article/102792)

#### Helpful Information:

Bureau of Development Services | City of Portland, Oregon  
1900 SW 4th Avenue, Portland, OR 97201  
For Hours Call 503-823-7310 or visit [www.portlandoregon.gov/bds](http://www.portlandoregon.gov/bds)

#### Important Telephone Numbers:

BDS main number	503-823-7300
DSC automated information line	503-823-7310
Building code information	503-823-1456
BDS 24-hour inspection request line	503-823-7000
Residential information for one- and two-family dwelling	503-823-7388
General Permit Processing and Fee Estimate info	503-823-7357
Zoning Information Line	503-823-7526
City of Portland TTY	503-823-6868

HYDRONIC PIPING LEGEND		
SYMBOL	ABBREVIATION	DESCRIPTION
	HWS	HEATING WATER SUPPLY
	HWR	HEATING WATER RETURN
	CND S	INDIRECT CONDENSATE DRAIN
	CHWS	CHILLED WATER SUPPLY
	CHWR	CHILLED WATER RETURN
	NG	GAS PIPING LOW PRESSURE
	IND	INDIRECT DRAIN
	G	GAS PIPING LOW PRESSURE
	HPS	HIGH PRESSURE STEAM
	MPS	MEDIUM PRESSURE STEAM
	LPS	LOW PRESSURE STEAM

GENERAL SYMBOL LEGEND		
SYMBOL	ABBREVIATION	DESCRIPTION
		SECTION TAG
		DETAIL TAG
	#	NOTE BY SYMBOL
	#	DEMOLITION NOTE BY SYMBOL
		REVISION DELTA
	POC	POINT OF CONNECTION
	#	EQUIPMENT TAG
		DEMOLITION
		RELOCATE

CONTROLS / ALARM LEGEND		
SYMBOL	ABBREVIATION	DESCRIPTION
	CO2	CARBON DIOXIDE SENSOR
	HSTAT	HYDROMETER / HUMIDITY SENSOR
	TSTAT	THERMOSTAT / TEMP SENSOR
	TSTAT	THERMOSTAT WIRELESS
	TSTAT	THERMOSTAT PENDANT MOUNT
	CO	CARBON MONOXIDE SENSOR
		WALL SWITCH / SPEED CONTROL
		WALL MOUNTED CONTROL PANEL
		DUCT MOUNTED SMOKE DETECTOR
		DUCT MOUNTED STATIC PRESSURE SENSOR
	FSD	1 1/2 & 3 HOUR COMBINATION FIRE SMOKE DAMPER

PIPING SYMBOL LEGEND		
SYMBOL	ABBREVIATION	DESCRIPTION
	AAV	AUTOMATIC AIR VENT
		CONCENTRIC REDUCER
		ECCENTRIC REDUCER
	ST	F&T STEAM TRAP
	MAV	MANUAL AIR VENT
		PIPE ANCHOR
		PIPE GUIDE
	UN	PIPE UNION
		FLEXIBLE JOINT
		FLEXIBLE PIPE CONNECTOR
		FLOW ARROW, DIRECTION OF FLOW
	TPT	PRESSURE/TEMPERATURE TEST PLUG
		PUMP
	PS	PRESSURE SWITCH OR PRESSURE SENSOR
	RPBP	REDUCED PRESSURE BACKFLOW PREVENTOR
		SLOPE PIPE DOWN IN DIRECTION OF ARROW
	STN	STRAINER
		STRAINER W/ BLOWDOWN VALVE
	VB	VACUUM BREAKER
		WALL TYPE INDICATOR ASSEMBLY
		WATER FLOW DETECTOR
		WATER HAMMER ARRESTOR
		VERTICAL PIPE DROP OR RISER
		PIPE TAKE OFF - UP
		PIPE TAKE OFF - DOWN
		90 DEGREE ELBOW UP
		90 DEGREE ELBOW DOWN
		TEE UP
		TEE DOWN
		BREAK IN LINE - SHOWN FOR CLARITY
		PIPE CAP

VALVES & GAUGES		
SYMBOL	ABBREVIATION	DESCRIPTION
		AUTOMATIC FLOW CONTROL VALVE
		AUTOMATIC TWO-WAY VALVE
		AUTOMATIC THREE-WAY VALVE
		BALL CHECK OR DRIP VALVE
	BV	BALL VALVE
	BALV	BALANCING VALVE
	BFV	BUTTERFLY VALVE
	CV	CHECK VALVE
	RV	RELIEF VALVE
	TPV	PRESSURE -TEMPERATURE RELIEF VALVE
	PRV	PRESSURE REDUCING VALVE
	PV	PLUG VALVE
	OS&Y	OUTSIDE SCREW AND YOKE VALVE
	GC	GAS COCK
	GV	GATE VALVE
	GLV	GLOBE VALVE
		HOSE END DRAIN VALVE
	FCV	FLOW CONTROL VALVE
	DDCV	DOUBLE DETECTOR CHECK VALVE
		THERMOMETER
		PRESSURE GAUGE WITH GAUGE COCK
		FLOW MEASURING DEVICE

HVAC DUCT LEGEND		
DUCT UP	DUCT DOWN	DESCRIPTION
		RECTANGULAR SUPPLY
		ROUND SUPPLY
		RECTANGULAR EXHAUST
		RECTANGULAR OUTSIDE AIR
		ROUND OUTSIDE AIR
		DESCRIPTION
		RECTANGULAR DUCT INSULATION WRAP
		ROUND DUCT INSULATION WRAP
		RECTANGULAR DUCT SOUND LINED WRAP
		RECTANGULAR DUCT K-27 SOUND INSULATED
		ROUND DUCT K-27 SOUND INSULATED
		FLEX DUCTWORK

HVAC DUCT DETAILS		
ROUND BRANCH FITTINGS		
ROUND ELBOWS AND OFFSETS		
RECTANGULAR BRANCH FITTINGS		
RECTANGULAR ELBOWS		
RECTANGULAR OFFSETS		

HVAC GENERAL NOTES - STATE OF OREGON	
1. THESE PLANS ARE SCHEMATIC AND DO NOT SHOW EXACT ROUTING OR EVERY OFFSET WHICH MAY BE REQUIRED. THE HVAC CONTRACTOR IS TO COORDINATE WITH ALL OTHER TRADES AND IS TO VERIFY ALL CLEARANCES BEFORE COMMENCING WORK.	
2. MATERIALS, METHODS, AND INSTALLATION SHALL COMPLY WITH THE PROVISIONS OF THE MOST RECENTLY ADOPTED VERSIONS OF - - THE 2019 OREGON MECHANICAL SPECIALTY CODE (2018 IMC W/ STATE OF OREGON AMENDMENTS) - THE 2019 OREGON STRUCTURAL SPECIALTY CODE (2018 IBC W/ STATE OF OREGON AMENDMENTS) - THE 2019 STATE OF OREGON ZERO ENERGY READY COMMERCIAL CODE (OZERCC) (ASHRAE 90.1 - 2016 OR 2018 IECC) - THE 2019 INTERNATIONAL FIRE CODE AND ALL OTHER APPLICABLE LOCAL CODES, AMENDMENTS, AND ORDINANCES.	
3. DUCT CONSTRUCTION AND HANGING SHALL COMPLY WITH CHAPTER 6 OF THE OMSC AND WITH CURRENT SMACNA STANDARDS. EARTHQUAKE BRACE ALL DUCTS 28" DIA AND LARGER WHICH ARE SUSPENDED MORE THAN 12" BELOW STRUCTURAL SYSTEM.	
4. DUCTS SHALL BE INSULATED AS INDICATED ON PLANS, OR AS OTHERWISE REQUIRED BY THE OZERCC. - DUCT WRAP, WHERE INDICATED, SHALL BE 2-3/16" 0.75 Lb/Cu FT FIBERGLASS DUCT INSULATION WITH A FACTORY APPLIED REINFORCED ALUMINUM FOIL VAPOR BARRIER.	
5. FLEXIBLE DUCT SHALL BE A MANUFACTURED ASSEMBLY INCLUDING: REINFORCED EXTERIOR VAPOR BARRIER, MINIMUM R-6 FIBERGLASS INSULATION, NON-PERFORATED INTERIOR LINER, AND STRUCTURAL WIRE HELIX. ASSEMBLY SHALL BE CERTIFIED AS A UL 181 LISTED, CLASS-1 AIR DUCT. FLEXIBLE DUCT SHALL BE FULLY SUPPORTED, AND SHALL ONLY BE USED WHERE SHOWN. LENGTH OF FLEX DUCT SHALL NOT EXCEED 8' UNLESS NOTED OTHERWISE.	
6. PROVIDE EARTHQUAKE RESTRAINT FOR HVAC EQUIPMENT IN ACCORDANCE WITH OSSC CHAPTER 16 AND ASCE 7-16.	
7. PROVIDE FIRE DAMPERS AND/OR FIRE/SMOKE DAMPERS WHERE INDICATED ON PLANS AND AS REQUIRED BY SECTION 717 OF THE OSSC. INSTALL FIRE DAMPERS AND FIRE/SMOKE DAMPERS IN ACCORDANCE WITH THE MANUFACTURER'S INSTRUCTIONS, THE TERMS OF THEIR LISTINGS, AND IN ACCORDANCE WITH THE REQUIREMENTS OF THE BUILDING, MECHANICAL, AND FIRE CODES AND ORDINANCES.	
8. PIPING PENETRATIONS OF FIRE RATED WALLS OR FLOORS SHALL BE SLEEVED AND FIRE STOPPED WITH LISTED MATERIALS SO AS TO MAINTAIN THE INTEGRITY AND RATING OF THE FLOOR OR WALL.	
9. PROVIDE RETURN DUCT SMOKE DETECTOR CONFIGURED TO PROVIDE AUTOMATIC SHUT DOWN OF ALL HEATING, COOLING, OR VENTILATION EQUIPMENT DELIVERING IN EXCESS OF 2000 CFM IN ACCORDANCE WITH SECTION 606 OF THE OMSC. POWER WIRING AND INTERLOCK WIRING WITH THE BUILDING FIRE ALARM SYSTEM SHALL BE BY THE ELECTRICAL CONTRACTOR.	
10. HVAC EQUIPMENT, VALVES AND DAMPERS SHALL BE LOCATED IN EASILY ACCESSIBLE LOCATIONS. ACCESS PANELS REQUIRED FOR MECHANICAL EQUIPMENT SHALL BE IDENTIFIED AND LOCATED BY THE MECHANICAL CONTRACTOR FOR ULTIMATE INCLUSION IN ARCHITECTURAL DRAWINGS. ACCESS PANELS SHALL BE PROVIDED AND INSTALLED BY THE WALL-CEILING CONTRACTOR PER SPECIFICATIONS.	
11. HVAC TEMPERATURE SET POINTS, DEAD BANDS, AND SCHEDULES SHALL BE PROGRAMMED TO MEET SECTION 6.4.3 OF ASHRAE 90.1 - 2016	
12. ALL WIRING EXPOSED WITHIN A PLENUM SHALL MEET THE REQUIREMENTS IN SECTION 602.2.1.1 OF THE OMSC. ALL COMBUSTIBLE ELECTRICAL EQUIPMENT EXPOSED WITHIN A PLENUM SHALL MEET THE REQUIREMENTS IN SECTION 602.2.1.4 OF THE OMSC.	

GENERAL ABBREVIATIONS			
ABBV	FULL NAME	ABBV	FULL NAME
ADJ	ADJUSTABLE	GAL	GALLONS
AFF	ABOVE FINISHED FLOOR	GALV	GALVANIZED
AL	ALUMINUM	GC	GENERAL CONTRACTOR
ALT	ALTERNATE	GPH	GALLONS PER HOUR
AP	ACCESS PANEL	GPM	GALLONS PER MINUTE
AVG	AVERAGE	GSB	GYPSON WALL BOARD
BAS	BUILDING AUTOMATION SYSTEM	HP	HORSE POWER
BOTT	BOTTOM	HR	HOOR
BTU	BRITISH THERMAL UNITS	HTG	HEATING
BTUH	BRITISH THERMAL UNITS PER HOUR	HZ	HERTZ
CAP	CAPACITY	ID	INSIDE DIMENSION
CFH	CUBIC FEET PER HOUR	IN	INCHES
CFCI	CONTRACTOR FURNISHED	I/O	INPUT / OUTPUT
CFM	CUBIC FEET PER MINUTE	KW	KILOWATT
CLG	CEILING	LBS	POUNDS
CONN	CONNECTION	MAX	MAXIMUM
CP	CONTROLS PANEL	MCA	MINIMUM CIRCUIT AMPACITY
DIA	DIAMETER	MFR	MANUFACTURER
DN	DOWN	MISC	MISCELLANEOUS
E	EXISTING	MISC	MISCELLANEOUS
EFF	EFFICIENCY	MIN	MINIMUM
ELEV	ELEVATION	MT	MOUNT
EXST	EXISTING	MISC	MISCELLANEOUS
F	FAHRENHEIT	N	NEW
FLA	FULL LOAD AMPS	NIC	NOT IN CONTRACT
FLEX	FLEXIBLE	NOM	NOMINAL
FPM	FEET PER MINUTE	NTS	NOT TO SCALE
FUT	FUTURE		

HVAC ABBREVIATIONS			
ABBV	FULL NAME	ABBV	FULL NAME
AC	AIR CONDITIONING UNIT	FD	FIRE DAMPER
APD	AIR PRESSURE DROP	FOB	FLAT ON BOTTOM
BDD	BACKDRAFT DAMPER	FOT	FLAT ON TOP
BOD	BOTTOM OF DUCT	FPB	FAN POWERED BOX
BSB	BRANCH SELECTOR BOX	FSD	FIRE SMOKE DAMPER
BWG	BOTTOM WALL GRILLE	GR	GRILLE
BWR	BOTTOM WALL REGISTER	GRD	GRILLE/DIFFUSER
COMB	COMBUSTION	HG	HOT GAS LINE
CND S	CONDENSATE	HVAC	HEATING VENTILATION AND AIR
COND	CONDENSER		CONDITIONING
CU	CONDENSING UNIT	LAT	LEAVING AIR TEMPERATURE
DB	DUCT BOARD	LIQ	LIQUID INSIDE
DDC	DIRECT DIGITAL CONTROL	MD	MOTORIZED DAMPER
DIFF	DIFFUSER	MUA	MAKE-UP AIR
DMPR	DAMPER	NG	NATURAL GAS
DX	DIRECT EXPANSION	OA	OUTSIDE AIR
EAT	ENTERING AIR TEMPERATURE	OAF	OUTSIDE AIR FAN
EGR	EGGGRATE	OB	OPPOSED BLADE DAMPER
EER	ENERGY EFFICIENCY RATIO	PLBG	PLUMBING
EF	EXHAUST FAN	RA	RETURN AIR
ESP	EXTERNAL STATIC PRESSURE	REG	REGISTER (GRILLE WITH DAMPER)
EXH	EXHAUST	RH	RELATIVE HUMIDITY
RL	REFRIGERANT LIQUID		
RTU	ROOF TOP UNIT		
SA	SUPPLY AIR		
SAT	SUPPLY AIR TEMPERATURE		
SEER	SEASONAL ENERGY EFFICIENCY RATIO		
SL	SOUND LINING		
SM	SHEET METAL		
SP	STATIC PRESSURE		
SUC	SUCTION LINE		
TOD	TOP OF DUCT		
TSP	TOTAL STATIC PRESSURE		
TV	TURN VANES		
TWG	TOP WALL GRILLE		
TWR	TOP WALL REGISTER		
UC	UNDER CUT		
UH	UNIT HEATER		
VAV	VARIABLE AIR VOLUME		
VD	VOLUME DAMPER		
VFD	VARIABLE FREQUENCY DRIVE		
VRV	VARIABLE REFRIGERANT VOLUME		
Ø	DUCT DIAMETER		

FITTING ABBREVIATIONS			
ABBV	FULL NAME	ABBV	FULL NAME
A	COMPRESSED AIR LINE	EWT	ENTERING WATER TEMPERATURE
CHWR	CHILLED WATER RETURN	HWR	HEATING WATER RETURN
CHWS	CHILLED WATER SUPPLY	HWS	HEATING WATER SUPPLY
CWR	CONDENSER WATER RETURN	LWT	LEAVING WATER TEMPERATURE
CWS	CONDENSER WATER SUPPL		



JOBSITE LOCATION

PROJECT SHEET INDEX	
M0.00	MECHANICAL COVER SHEET
M0.01	MECHANICAL SCHEDULES
M0.02	MECHANICAL SCHEDULES
M2.01	MECHANICAL FIRST FLOOR HVAC PLANS
M2.02	MECHANICAL ROOF HVAC PLANS
M3.00	MECHANICAL DETAILS

DEFERRED SUBMITTAL - SEISMIC ANALYSIS	
THE FOLLOWING ITEMS ARE PROPOSED TO BE COMPLETED, DOCUMENTED, AND SUBMITTED FOR REVIEW TO CODE AUTHORITIES AS A DEFERRED SUBMITTALS:	
1. STRUCTURAL ANALYSIS AND CONSTRUCTION DETAILING FOR HVAC COMPONENT SUPPORT/ANCHORAGE AND SEISMIC RESTRAINT	
MINIMUM MECHANICAL ITEMS SUBJECT TO SEISMIC ANALYSIS/DETAILING TO INCLUDE THE FOLLOWING:	
- ALL GRADE OR ROOF MOUNTED EQUIPMENT >400 LBS	
- ALL SUSPENDED COMPONENTS OR EQUIPMENT >75 LBS	
- ALL SUSPENDED DUCT W/ > 6 SF CROSS SECTION	
- TYPE-1 GREASE EXHAUST DUCTWORK SYSTEMS	

ALLIANT SYSTEMS, LLC  
351 NW 12th AVE  
PORTLAND, OR 97209  
PHONE: 503/619-4000  
FAX: 503/230-9238  
WWW.ALLIANT-SYSTEMS.COM  
CCB# 153420

21-055455-REV-01-MT

DESIGNER CONTACT:  
K. PETERSON  
503-619-4000  
K.PETERSON@ALLIANT-SYSTEMS.COM

CAD:  
K. PETERSON

PLOT DATE:  
05/11/21

MECHANICAL COVER SHEET

PROJECT NUMBER:  
C-0444-31270

PERMIT ISSUE  
05/11/21  
Reviewed for Code Compliance

SHEET NUMBER:  
M0.00  
Permit # 21-055455-REV-01-MT

PROJECT THERMAL DESIGN CONDITIONS				
PROJECT LOCATION		PORTLAND, OREGON		
ASHRAE WEATHER STATION REFERENCE		PORTLAND, OREGON (WMO #726980)		
ASHRAE 2017 FUNDAMENTALS WEATHER DATA BASIS		COOLING 0.4%	HEATING 99.6%	
SPACE	SUMMER		WINTER	
	TEMPERATURE	HUMIDITY	TEMPERATURE	HUMIDITY
OUTDOOR	91.7° F. DB / 67.3° F. MCWB	63.2° F. DP / 84.7 HR / 75.1° F. MCWB	21.7° F. DB	9.6° F. DP / 9.0 HR / 29.8° F. MCWB

ROOM INTERNAL LOADS																
ROOM NAME	ROOM DESIGN CONDITIONS (DRY BULB TEMP (F)/ RELATIVE HUMIDITY (%))								LOAD DESCRIPTION		HEAT GAIN	UNITS	QTY	HEAT GAIN (BTU/H)	NOTES	
									LAUNDRY (200 LB @ 140F EVERY 2 HOURS, ALMOST DRY)		4,900	BTU/H	1	4,900		
									LIGHT TABLES X 6 (86W/BULB, 4 BULBS/TABLE)		344	W	3	3,519	50% DIVERSITY, HALF OF TABLES USED ON AVERAGE	
									DOOR OPEN/CLOSE (10x PER HOUR)		5,746	BTU/H	1	5,746		
									LIGHTING		1,040	W	-	3,546		
									MISC LOAD		260	W	-	887		
									PEOPLE		250	BTU/H	4	1,000		
CLEAN ROOM	COOLING: 72F/55% RH, HEATING 70F/35%RH				1,040	SF	1.0	W/SF	0.3	W/SF	4	PPL	HEAT LOAD TO ROOM TOTAL (BTU/H) ->			19,598
NOTE: CODE ACCEPTABLE RANGE 68F-73F, 30%-60% RH																
DESIGN PARAMETERS/CONTINGENCIES																
- DESIGN IS TO MEET 2016 HLAC STANDARDS FOR "SURGICAL PACK ASSEMBLY ROOM", MINIMUM 10 ACH OF RECIRCULATED AIR.																
- ROOM DIMENSIONS ARE 44' x 26' x 9'6"																
- ROOF IS ASSUMED TO BE INSULATED.																
- MAIN WAREHOUSE AREA IS ASSUMED TO BE 100F ON A DESIGN DAY. WALLS BETWEEN WAREHOUSE AND CLEANROOM ARE UNINSULATED 2X4 STUD WALLS W/ DRYWALL ON BOTH SIDES.																
- AIR FROM MAIN WAREHOUSE TO CLEAN ROOM MAY CAUSE HUMIDITY ISSUES. TUNE UP OF DOORS MAY BE REQUIRED.																

CLEANROOM AIRFLOW COMPLIANCE SCHEDULE																								
			HLAC REQUIREMENTS														TOTAL AIRFLOW CALCULATIONS						OSA %	REMARKS
			PRESSURE RELATIONSHIP TO ADJACENT AREAS			MIN OUTSIDE AIR AC/HR		MIN TOTAL CIRCULATED AC/HR		RECIRCULATED BY MEANS OF ROOM UNITS		OUTDOOR AIR TOTALS												
ROOM NAME	AREA SF	HEIGHT FT.	OCCUPANCY TYPE			ASHRAE 170	ACTUAL	PRESSURIZATION CFM	CODE MIN OSA AC/HR	ACTUAL OSA AC/HR	CODE MIN AC/HR	ACTUAL AC/HR	ASHRAE 170	ACTUAL	REQD OSA CFM	ACTUAL OSA CFM	ACTUAL SUPPLY	ACTUAL RETURN	ACTUAL EXHAUST	ACTUAL RECIRC CFM	REQD TOTAL CFM	ACTUAL TOTAL CFM		
LAUNDRY CLEAN ROOM	1040	9.50	SURGICAL PACK ASSEMBLY ROOM			POSITIVE	POSITIVE	350	2	2.1	10	16.7	NO	NO	329	338	2750	2400	0	0	1647	2750	12%	


ROOFTOP AIR HANDLING UNIT - DX COOL & GAS HEAT																																										
UNIT TAG	AREA SERVED	CONFIGURATION	MANUFACTURER & MODEL	DX COOLING										HOT GAS REHEAT		NATURAL GAS HEAT					SUPPLY FAN					POWER EXHAUST FAN					ECONOMIZER	VENTILATION	HUMIDIFIER	PRE-FILTER	FINAL FILTER		ELECTRICAL			DIMENSIONS LxWxH (IN)	WEIGHT (LBS)	NOTES
				NOM TONS	COOLING (MBH)		ENTERING DB/WB (F)	COIL LEAVING DB/WB (F)	UNIT LEAVING DB/DP	EER/IEER (ARI)	HEAT (MBH)	LEAVING DB (F)	HEAT (MBH)		MIN EFFIC (%)	TURN DOWN	ENTERING DB (F)	LEAVING DB (F)	CFM	ESP (IN WC)	BHP	HP	DRIVE	CFM	ESP (IN WC)	BHP	HP	DRIVE	(Y/N)	MIN OA (CFM)	SEE HUMIDIFIER SCHEDULE	MERV/ RATING	DEPTH (IN)	MERV/ RATING	DEPTH (IN)	VOLT/ PH	MCA	MROPD				
					TOTAL	SENS							INPUT	OUTPUT																												
RTU-CR	CLEAN ROOM	SINGLE ZONE CONSTANT VOLUME	AAON RN	10	109	81	75.7/62.6	50/50	52/50	11.7/13.8	65	70	90	73	81%	10:1	62	86	2,850	1.6	2.22	3	DIRECT	2,850	0.75	1.90	3	DIRECT	Y	350	HU-CR	8	2"	14	4	460/3	32	45	83X79X43	1,500	1-14, A-I	
ACCEPTABLE ALTERNATE MANUFACTURERS: AAON, TRANE																																										
ACCESSORIES/OPTIONS: 1. ELEVATION 0 FT ABOVE SEA LEVEL. 2. DISCONNECTS INTEGRAL TO UNIT FROM FACTORY. (CONFIRM VOLTAGE PRIOR TO ORDERING UNIT). 3. ECONOMIZER UNIT - FURNISH COMPLETE WITH THE FOLLOWING FACTORY INSTALLED OPTIONS - NON-FUSED DISCONNECT SWITCH - MODULATING 100% OA ECONOMIZER COMPLIANT W/ 2019 OREGON ENERGY CODE (ASHRAE 90.1 2016 / TITLE 24 COMPLIANT: LOW LEAKAGE DAMPERS, FAULT DETECTION DIAGNOSTICS, AND ONBOARD AHU CONTROLLER) - COMPARATIVE ENTHALPY BASED ECONOMIZER CONTROL 5. FIELD INSTALLED HUMIDIFIER GENERATOR AND DISPERSION ARRAY HOUSED ABOVE CLEAN ROOM CEILING. SEE HUMIDIFIER SCHEDULE. 6. COMPRESSOR OPTIONS: VARIABLE SPEED COMPRESSOR 7. PROVIDE WITH FACTORY INSTALLED, WIRED AND MOUNTED VFDs ON BOTH SUPPLY AND POWER EXHAUST 8. SMOKE DETECTOR W/ CENTRAL FIRE ALARM - UNIT REQUIRES RETURN AIR SMOKE DETECTOR TO BE INTERLOCKED WITH BUILDING FIRE ALARM SYSTEM. UNIT TO BE SHUTDOWN, AND FIRE ALARM SYSTEM TO BE NOTIFIED IN THE EVENT OF SMOKE DETECTOR ALARM. INSTALLATION RESPONSIBILITIES: - FIRE ALARM CONTRACTOR TO COORDINATE INSTALL REQUIREMENTS AND PROVIDE SMOKE DETECTOR - MECHANICAL CONTRACTOR TO INSTALL SMOKE DETECTOR - FIRE ALARM CONTRACTOR TO INTEGRATE WITH FIRE ALARM SYSTEM AND EXTEND WIRES TO UNIT CONTROL PANEL - CONTROLS CONTRACTOR TO CONNECT INTERLOCK WIRING FROM FIRE ALARM FOR UNIT SHUTDOWN - ELECTRICAL CONTRACTOR TO PROVIDE POWER WIRING FOR SMOKE DETECTOR OPERATION 9. BOTTOM OF OUTDOOR AIR INTAKE TO BE MINIMUM OF 3 FT ABOVE ROOF DECK. 10. FACTORY INSTALLED MAGNAHELIC PRESSURE GAGE ON FILTERS. 11. OUTDOOR AIR INTAKE LOUVERS TO PREVENT ENTRAINMENT OF WIND DRIVEN RAIN AND DRAIN AWAY PRECIPITATION. BIRDScreen MESH TO BE NO SMALLER THAN 0.5". 12. SURFACES ON INSIDE OF AIR HANDLER ARE TO BE VAPOR IMPERMEABLE. NO EXPOSED LINER ON INTERIOR OF UNIT. CASING TO BE ASHRAE 62.1 COMPLIANT CONSTRUCTION. 13. PROVIDE WITH MANUFACTURED, SEISMIC CURB OF SUFFICIENT HEIGHT TO MEET REQUIREMENT OF OUTDOOR AIR INTAKE AT MINIMUM 36" HEIGHT ABOVE ADJACENT ROOF SURFACE. 14. PROVIDE WITH MOTORIZED DAMPERS FOR OUTDOOR AND RELIEF AIR. DAMPERS TO MEET LEAKAGE RATES PER ASHRAE 90.1 2016 TABLE 6.4.3.4.3																																										
CONTROL NOTES: A. MANUFACTURER'S STAND ALONE CONTROLS. CONTROL UNIT TO PRIORIZE HUMIDITY SETPOINT BASED ON THERMOSTAT/HUMIDISTAT IN ROOM. B. PROVIDE SUPPLY AND POWER EXHAUST FAN WITH VFD C. PROVIDE WITH OFF HOUR CONTROLS WITH AUTOMATIC SHUTDOWN AND OPTIMUM START PER ASHRAE 90.1 2016 SECTION 6.4.3.3 PROVIDE OFF HOUR CONTROLS WITH OVERRIDE FOR TEMPORARY OPERATION AS REQUIRED FOR MAINTENANCE. D. PROVIDE WITH ECONOMIZER WITH FAULT DETECTION DIAGNOSTICS PER ASHRAE 90.1 2016, SECTION 6.4.3.12 E. CONTROL POWER EXHAUST FAN VIA ROOM PRESSURE. F. OUTDOOR AIR AND RELIEF AIR DAMPERS TO CLOSE WHEN UNIT IS NOT IN USE. G. ZONE TEMPERATURE CONTROLS TO HAVE SETPOINT OVERLAP RESTRICTIONS. H. CONTROLS ARRANGED SUCH THAT SIMULTANEOUS DEHUMIDIFICATION AND HUMIDIFICATION TO NOT OCCUR. I. CONTROLS TO BE TESTED TO ENSURE THAT CONTROL ELEMENTS ARE CALIBRATED, ADJUSTED, AND IN PROPER WORKING CONDITION.																																										

ELECTRIC STEAM HUMIDIFIER SCHEDULE																							
UNIT TAG			UNIT SERVED			MANUFACTURER & MODEL			DISPERSION				GENERATOR				DIMENSIONS (IN)		WEIGHT (LBS)	NOTES			
									AIR HUMIDIFICATION			DUCT SIZE	DISPERSION		WATER						ELECTRICAL		
									HUMIDIFICATION (LB/H)	ENTERING DB(F)/RH(%)	LEAVING DB(F)/RH(%)	W X H (IN)	RTU AIRFLOW (CFM)	ABSORPTION DIST (FT)	HEAT INPUT (KW)	MIN PSI					MAX PSI	VOLT/PH	FLA
HU-CR			RTU-CR			PURE HUMIDIFIER EC-15			45.0	50F/28%	50F/72%	20X20	2,850	2'	15.0	35.0	60.0	460/3	18.1	30"X17"X24"		225	1-10
ACCEPTABLE ALTERNATE MANUFACTURERS:																							
ACCESSORIES/OPTIONS NOTES:																							
1. ELEVATION: 0 FT																							
2. GENERATOR INSTALLED IN CEILING SPACE AND DISPERSION HOUSED IN SUPPLY AIR DUCT.																							
3. ROOM CONDITION 70F DB & 35% RH																							
4. PROVIDE MODULATING SCR HEATER CONTROL FOR 0-100% STEAM OUTPUT MODULATION.																							
5. PROVIDE WITH MANUFACTURER'S STAND ALONE CONTROLLER FOR DUAL HUMIDITY SENSOR CONTROL. HUMIDITY SENSOR IN SPACE FOR SPACE HUMIDITY CONTROL. HIGH LIMIT HUMIDITY SENSOR IN DUCT DOWNSTREAM OF HUMIDIFIER. MAXIMUM DUCT RELATIVE HUMIDITY TO BE 90%.																							
6. HUMIDIFICATION DISPERSION TUBE HOT SURFACES IN AIRSTREAM TO BE INSULATED WITH MINIMUM R-5 INSULATION. INSULATION AND JACKETING TO BE RATED FOR PLENUM INSTALLATION.																							
7. PREHEATING JACKETS MOUNTED IN AIRSTREAM TO BE PROVIDED WITH AN AUTOMATIC VALVE TO SHUTOFF PREHEAT WHEN HUMIDIFICATION IS NOT REQUIRED.																							
8. PROVIDE WITH DRAIN TEMPERING KIT. INSTALL COPPER OR STAINLESS DRAIN PIPE UPSTREAM OF TEMPERING KIT.																							
9. INSTALL IN STRICT ACCORDANCE TO MANUFACTURER'S INSTALLATION INSTRUCTIONS.																							
10. DISCONNECTS INTEGRAL TO UNIT FROM FACTORY. (CONFIRM VOLTAGE PRIOR TO ORDERING UNIT).																							

GRILLE REGISTER & DIFFUSER SCHEDULE						
SYMBOL	DEVICE TYPE AND SERVICE	MANUFACTURER & MODEL NUMBER	BORDER TYPE	FACE SIZE	FINISH	NOTES
⊙ SIZE CFM	SUPPLY - LOUVERED FACE LAY-IN CEILING DIFFUSER	TITUS TMS	TYPE-3 (LAY-IN)	24 x 24	WHITE POWDER COAT UNLESS OTHERWISE NOTED	SEE FLOOR PLANS FOR NECK SIZE.
⊙ SIZE CFM	RETURN - PERF FACE LAY-IN CEILING GRILLE	TITUS PAR	TYPE-3 (LAY-IN)	24 x 24	WHITE POWDER COAT UNLESS OTHERWISE NOTED	SEE FLOOR PLANS FOR NECK SIZE.
ACCEPTABLE ALTERNATE MANUFACTURERS (SUBJECT TO ENGINEERING APPROVAL) - PRICE, KREUGER						



ALLIANT SYSTEMS, LLC  
351 NW 12th AVE  
PORTLAND, OR 97209  
PHONE: 503/619-4000  
FAX: 503/230-9238  
WWW.ALLIANT-SYSTEMS.COM  
CCB# 153420

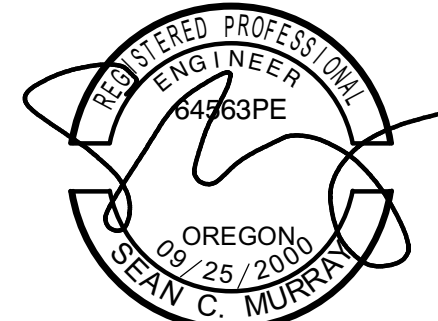

EXPIRES 12-31-22

REVISIONS: DATE

PORTLAND HOSPITAL  
CLEAN ROOM RTU

18440 NE PORTAL WAY  
PORTLAND, OR

DESIGNER CONTACT:  
K. PETERSON  
503-619-4000  
K.PETERSON@ALLIANT-SYSTEMS.COM  
CAD:  
K. PETERSON  
PLOT DATE:  
05/11/21

MECHANICAL  
SCHEDULES

PROJECT NUMBER:  
C-0444-31270

PERMIT ISSUE  
05/11/21

Reviewed for  
Code Compliance

SHEET NUMBER:

M0.01  
21/05/25 REV.

DUCTWORK SCHEDULE						
NOTE: ALL SYSTEMS AND PIPING MATERIALS MAY NOT BE USED ON EVERY PROJECT						
SERVICE / USAGE	LOCATION	MATERIAL	WORKING PRESSURE (IN. WC)	SMACNA PRESSURE CLASS (IN. WC)	SMACNA SEAL CLASS	NOTES
LOW PRESSURE SUPPLY AIR	FROM RTU TO GRD'S	GALV. STEEL UNLESS NOTED OTHERWISE	LOW PRESSURE	1	A	1,2,3
FLEXIBLE DUCT	CONN TO GRD'S	PREINSUL. FLEX	LOW PRESSURE	RATED +6", -1"	NA	4
RETURN AIR	FROM GRD'S TO AHU	GALV. STEEL	LOW PRESSURE	1	A	1,2,3
NOTES: 1. SHEET METAL GAGES AND FITTINGS PER SMACNA AND ALLIANT DUCT CONSTRUCTION STANDARDS 2. SEAL ALL LONGITUDINAL AND TRANSVERSE DUCT JOINTS WITH WELDS, GASKETS, MASTICS, TAPES, OR OTHER APPROVED SYSTEMS 3. INSTALL PER MANUFACTURER'S GUIDELINES AND INSTRUCTIONS 4. PROVIDE FLEX DUCT WITH R-6 MIN INSUL AND MAX INSTALL LENGTH 7 FT. PRODUCT: ATCO UPC, THERMAFLEX "GKM", OR EQUIVALENT.						

DUCTWORK INSULATION SCHEDULE			
NOTE: ALL SYSTEMS AND INSULATION TYPES MAY NOT BE USED ON EACH PROJECT			
SERVICE:	DUCT LOCATION/TYPE:	FIBERGLASS INSULATION TYPE:	NOTES:
INSIDE BUILDING ENVELOPE			
INSULATED FLEXIBLE SUPPLY DUCT	CONCEALED LOW PRESSURE DUCT	MANUF ASSEMBLY W/ REINFORCED VAPOR BARRIER, MINIMUM R-6 FIBERGLASS INSULATION, NON-PERFORATED INTERIOR LINER W/ STRUCTURAL WIRE HELIX	FLEXIBLE DUCT SHALL BE CERTIFIED AS A UL 181 LISTED, CLASS-1 AIR DUCT.
LOW PRESSURE SUPPLY AIR	CONCEALED LOW PRESSURE DUCT	INSULATION WRAP (MIN R-6)	
RETURN AIR	CONCEALED FROM GRD TO AHU	INSULATION WRAP (MIN R-6)	
INSULATION SPECIFICATION: KNAUF, CERTAINTEED, OWENS CORNING, OR APPROVED EQUAL. 1. SUPPLY AIR FIBERGLASS DUCT WRAP INSULATION: 1.5 PCF - MINIMUM R-6, EXTERIOR FOIL SCRIM REINFORCED VAPOR BARRIER COVERING 2. DUCTWORK INSULATION SHALL BE INSTALLED AS INDICATED ON DRAWINGS, AND AS REQUIRED PER CODE.			

MECHANICAL PIPING SCHEDULE									
NOTE: ALL SYSTEMS AND PIPING MATERIALS MAY NOT BE USED ON EVERY PROJECT									
SERVICE	LOCATION	SIZE	PIPE	PIPE MATL STANDARD	FITTINGS	JOINTS	WORKING PRESSURE	TEST PRESSURE	NOTES
NATURAL GAS	INTERIOR ABOVE GRADE (EXPOSED, NON-PLENUM)	1/2" - 2"	BLACK STEEL SCH 40	ASTM A53-B	BLACK STEEL SCH 40	THREADED	≤ 2 PSI	60 PSI	
		1/2" - 2"	BLACK STEEL SCH 40	ASTM A53-B	PRESS-CONNECT	MECHANICAL PRESS-CONNECT	≤ 2 PSI	60 PSI	8
	INTERIOR ABOVE GRADE (IN-PLENUM OR CONCEALED)	1/2" - 2"	BLACK STEEL SCH 40	ASTM A53-B	BLACK STEEL SCH 40	WELDED	≤ 5 PSI	60 PSI	
	EXTERIOR ABOVE GRADE	1/2" - 2"	BLACK STEEL SCH 40	ASTM A53-B	BLACK STEEL SCH 40	WELDED	≤ 2 PSI	60 PSI	1
		1/2" - 2"	BLACK STEEL SCH 40	ASTM A53-B	BLACK STEEL SCH 40	THREADED	≤ 2 PSI	60 PSI	4
NOTES: 1. EXPOSED, EXTERIOR, ABOVE-GRADE NATURAL GAS PIPING SHALL BE PAINTED WITH CORRSION RESISTANT PAINT, OR APPROVED PIPING WRAP									



ALLIANT SYSTEMS, LLC  
351 NW 12th AVE  
PORTLAND, OR 97209  
PHONE: 503/619-4000  
FAX: 503/230-9238  
WWW.ALLIANT-SYSTEMS.COM  
CCB# 153420



EXPIRES 12-31-22

REVISIONS: DATE

PORTLAND HOSPITAL  
CLEAN ROOM RTU

18440 NE PORTAL WAY  
PORTLAND, OR

DESIGNER CONTACT:  
K. PETERSON  
503-619-4000  
K.PETERSON@ALLIANT-SYSTEMS.COM  
CAD:  
K. PETERSON  
PLOT DATE:  
05/11/21

MECHANICAL  
SCHEDULES

PROJECT NUMBER:  
C-0444-31270


PERMIT ISSUE  
05/11/21  
Reviewed for  
Code Compliance

SHEET NUMBER:  
M0.02  
21/055455-REV-01-MT


A.	UNLESS OTHERWISE NOTED, BRANCH DUCT TO DIFFUSER TO MATCH DIFFUSER NECK SIZE.
B.	NO SOUND LINED SHEET METAL OR OTHER VAPOR PERMIABLE MATERIAL ON INTERIOR OF DUCTS.

**ALLIANT**  
**SYSTEMS**


**ALLIANT SYSTEMS, LLC**  
351 NW 12th AVE  
PORTLAND, OR 97209  
PHONE: 503/619-4000  
FAX: 503/230-9238  
[WWW.ALLIANT-SYSTEMS.COM](http://WWW.ALLIANT-SYSTEMS.COM)  
CCB# 153420

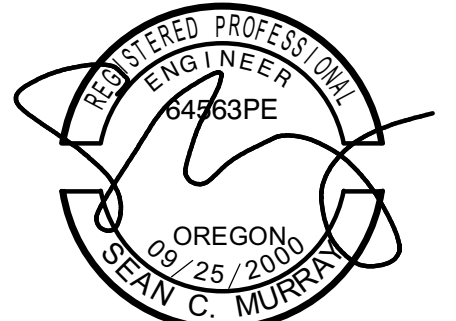


EXPIRES 12-31-22

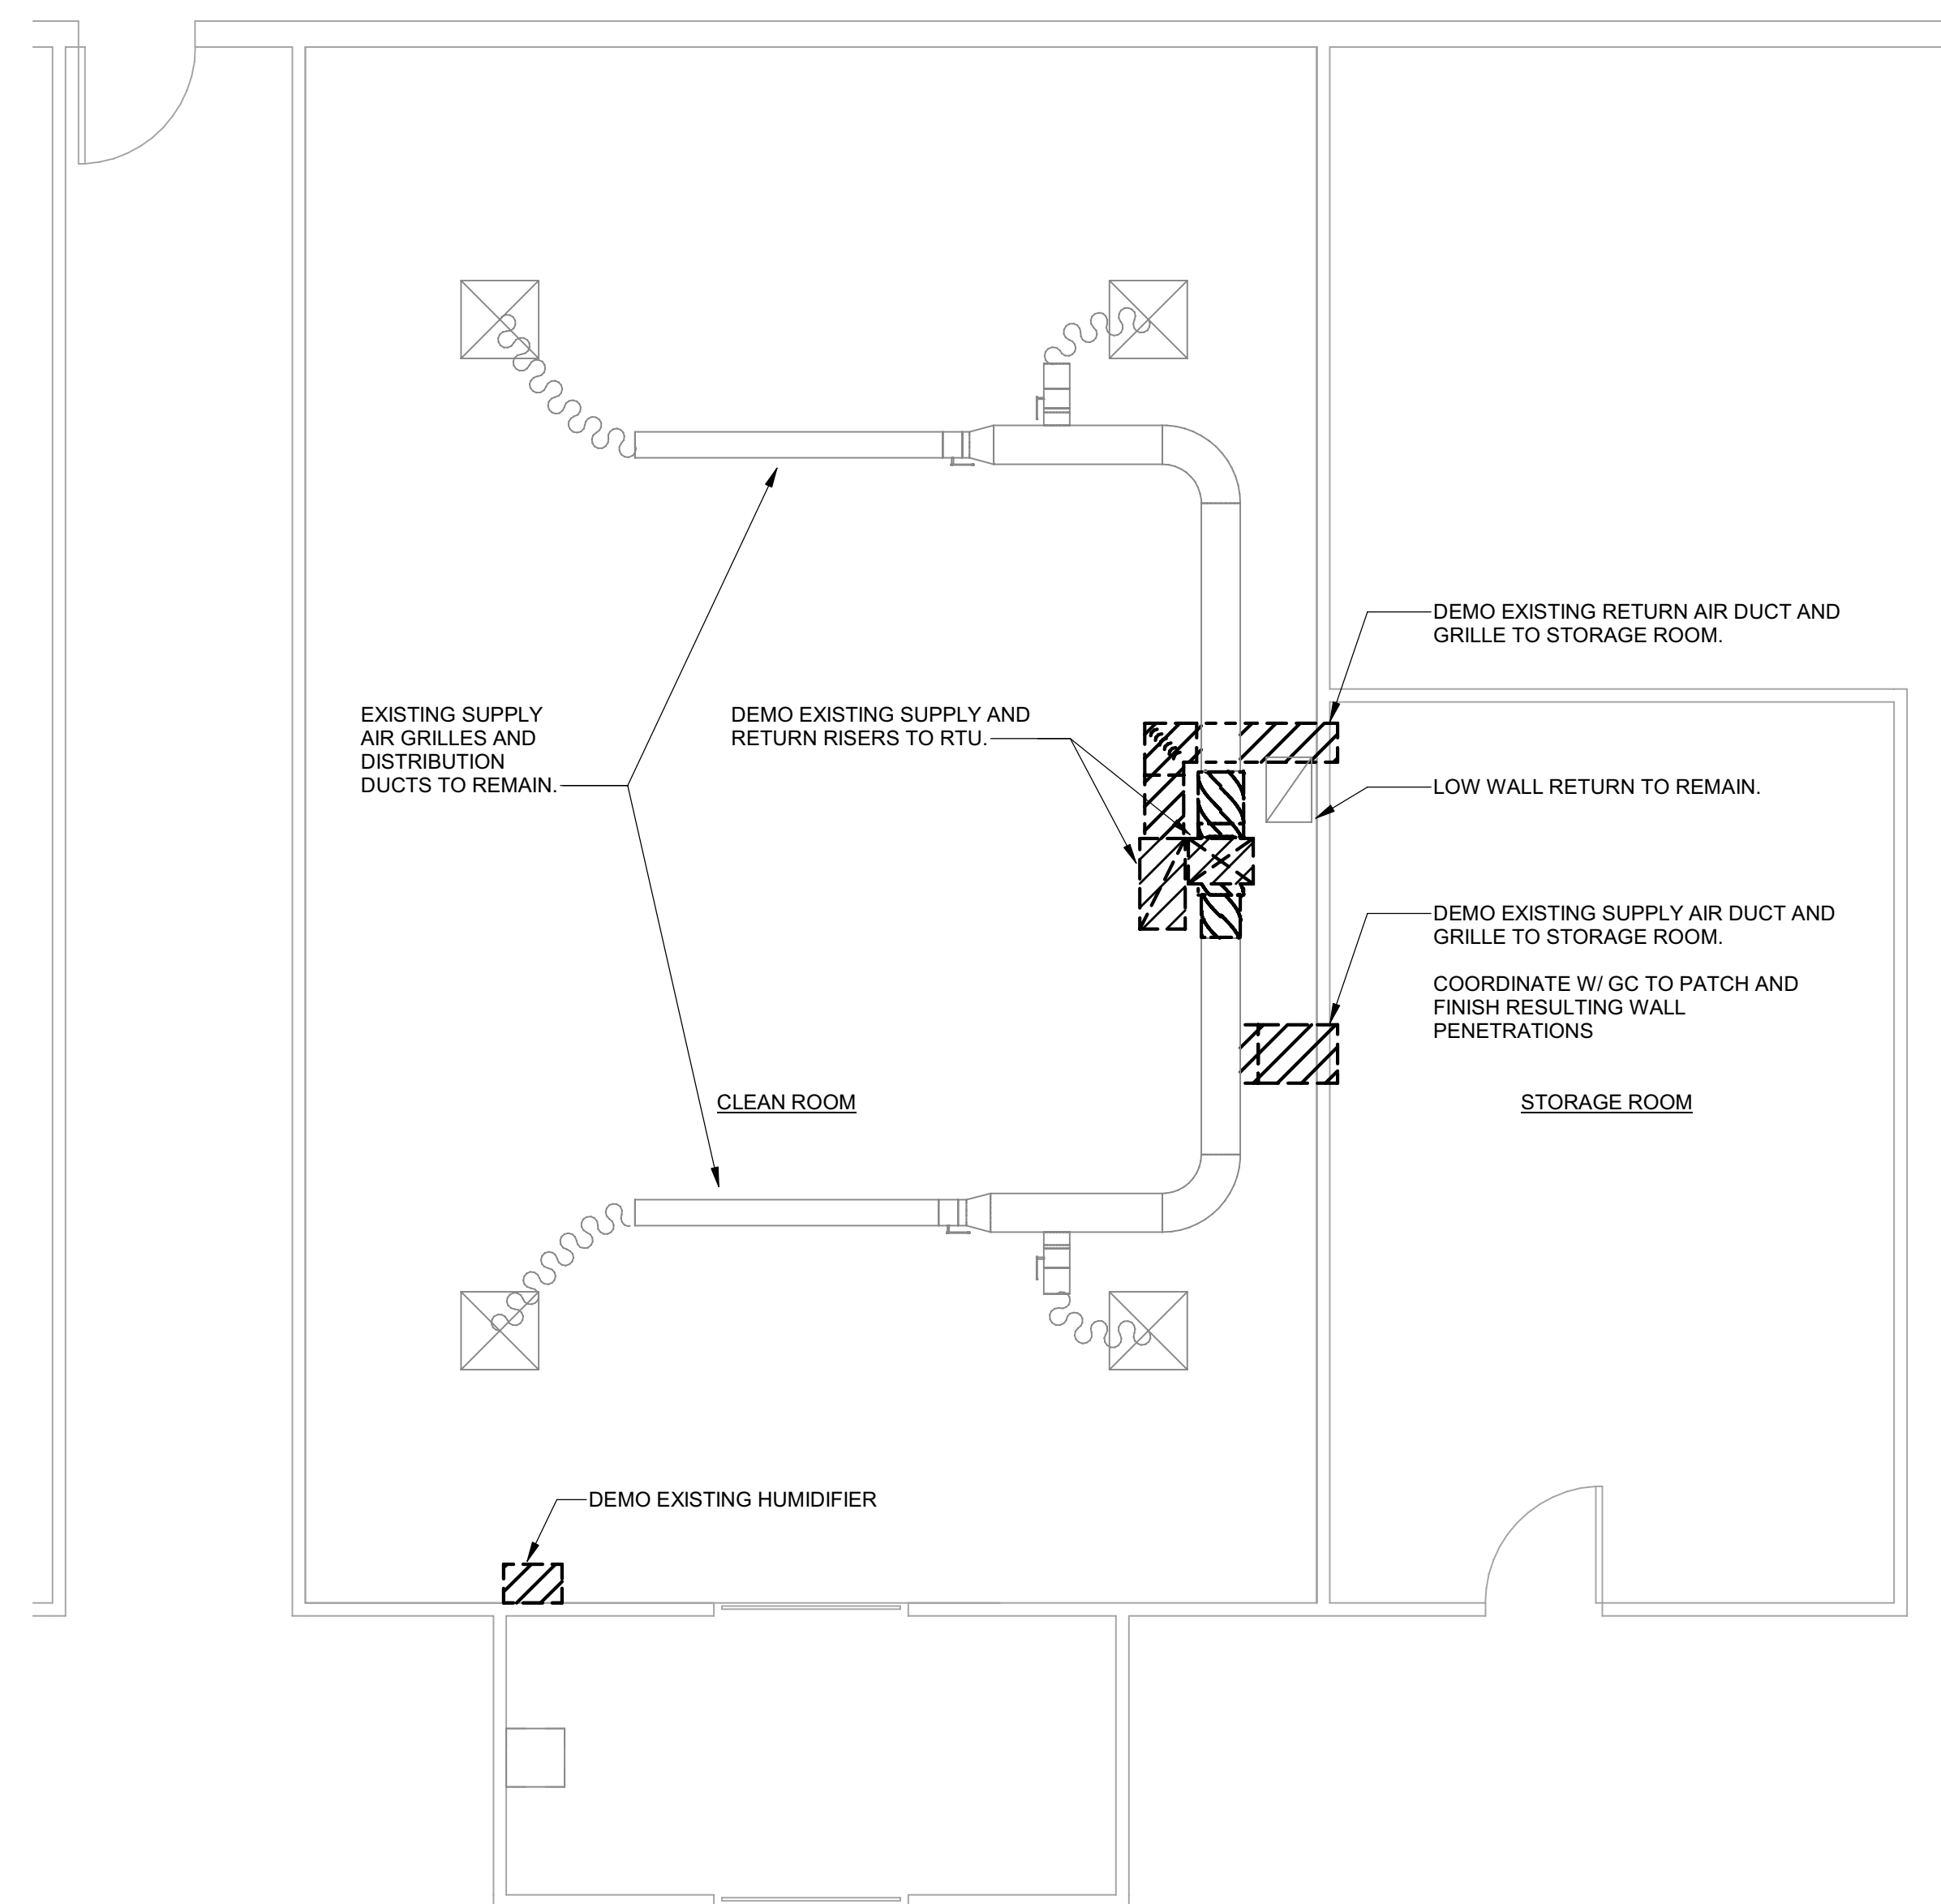

1 MECHANICAL FIRST FLOOR HVAC DEMO PLAN  
M2.01 1/4" = 1'-0" 0 4' 8' 16'

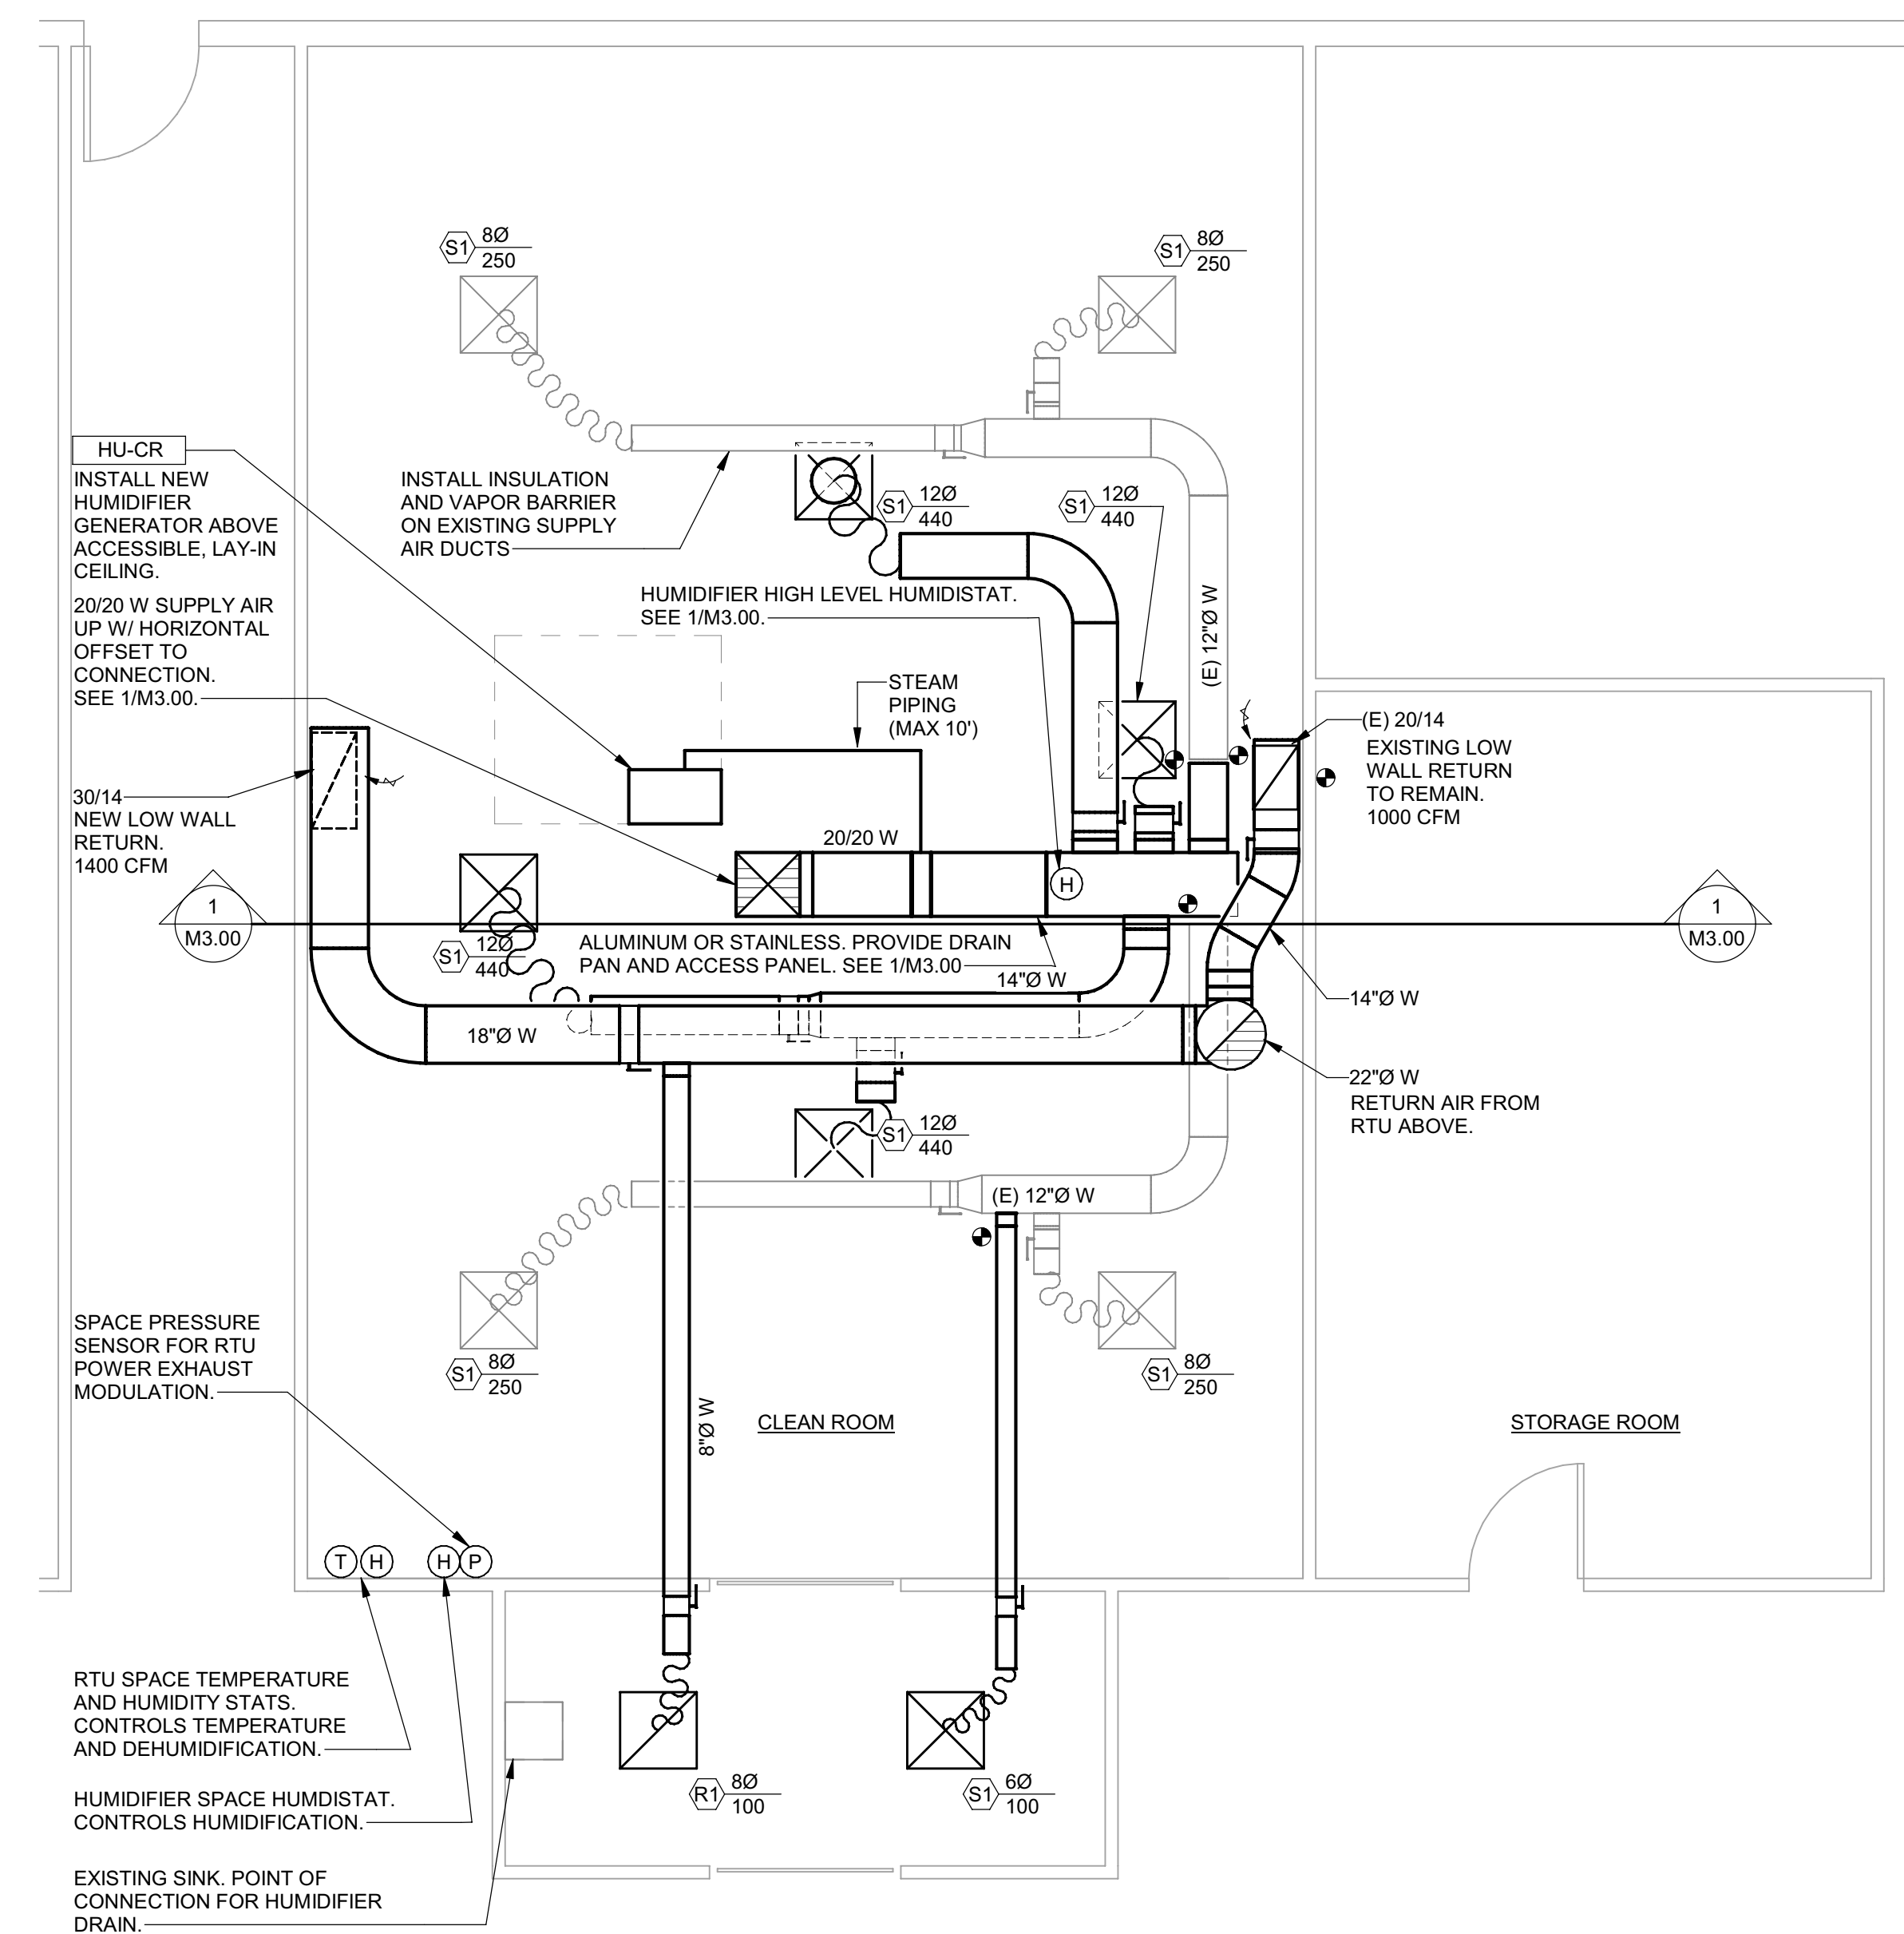

MECHANICAL FIRST FLOOR HVAC PLAN

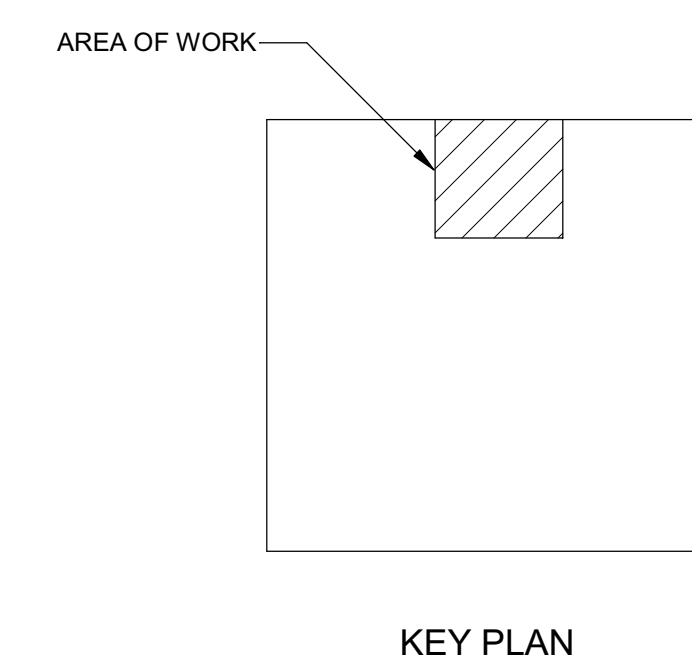

REVISIONS:	DATE
------------	------

## PORTLAND HOSPITAL CLEAN ROOM RTU

18440 NE PORTAL WAY  
PORTLAND, OR

DESIGNER CONTACT:  
K. PETERSON  
503-619-4000  
K.PETERSON@ALLIANT-SYSTEMS.COM

CAD:  
K. PETERSON

PLOT DATE:  
05/11/21


MECHANICAL FIRST  
FLOOR HVAC PLANS

PROJECT NUMBER:  
C-0444-31270


PERMIT ISSUE  
05/11/24  
City of Portland  
Reviewed for  
Code Compliance

SHEET NUMBER:


**M2.01**  
Date: 08/16/21  
Permit #:  
21-055455-REV-01-MT

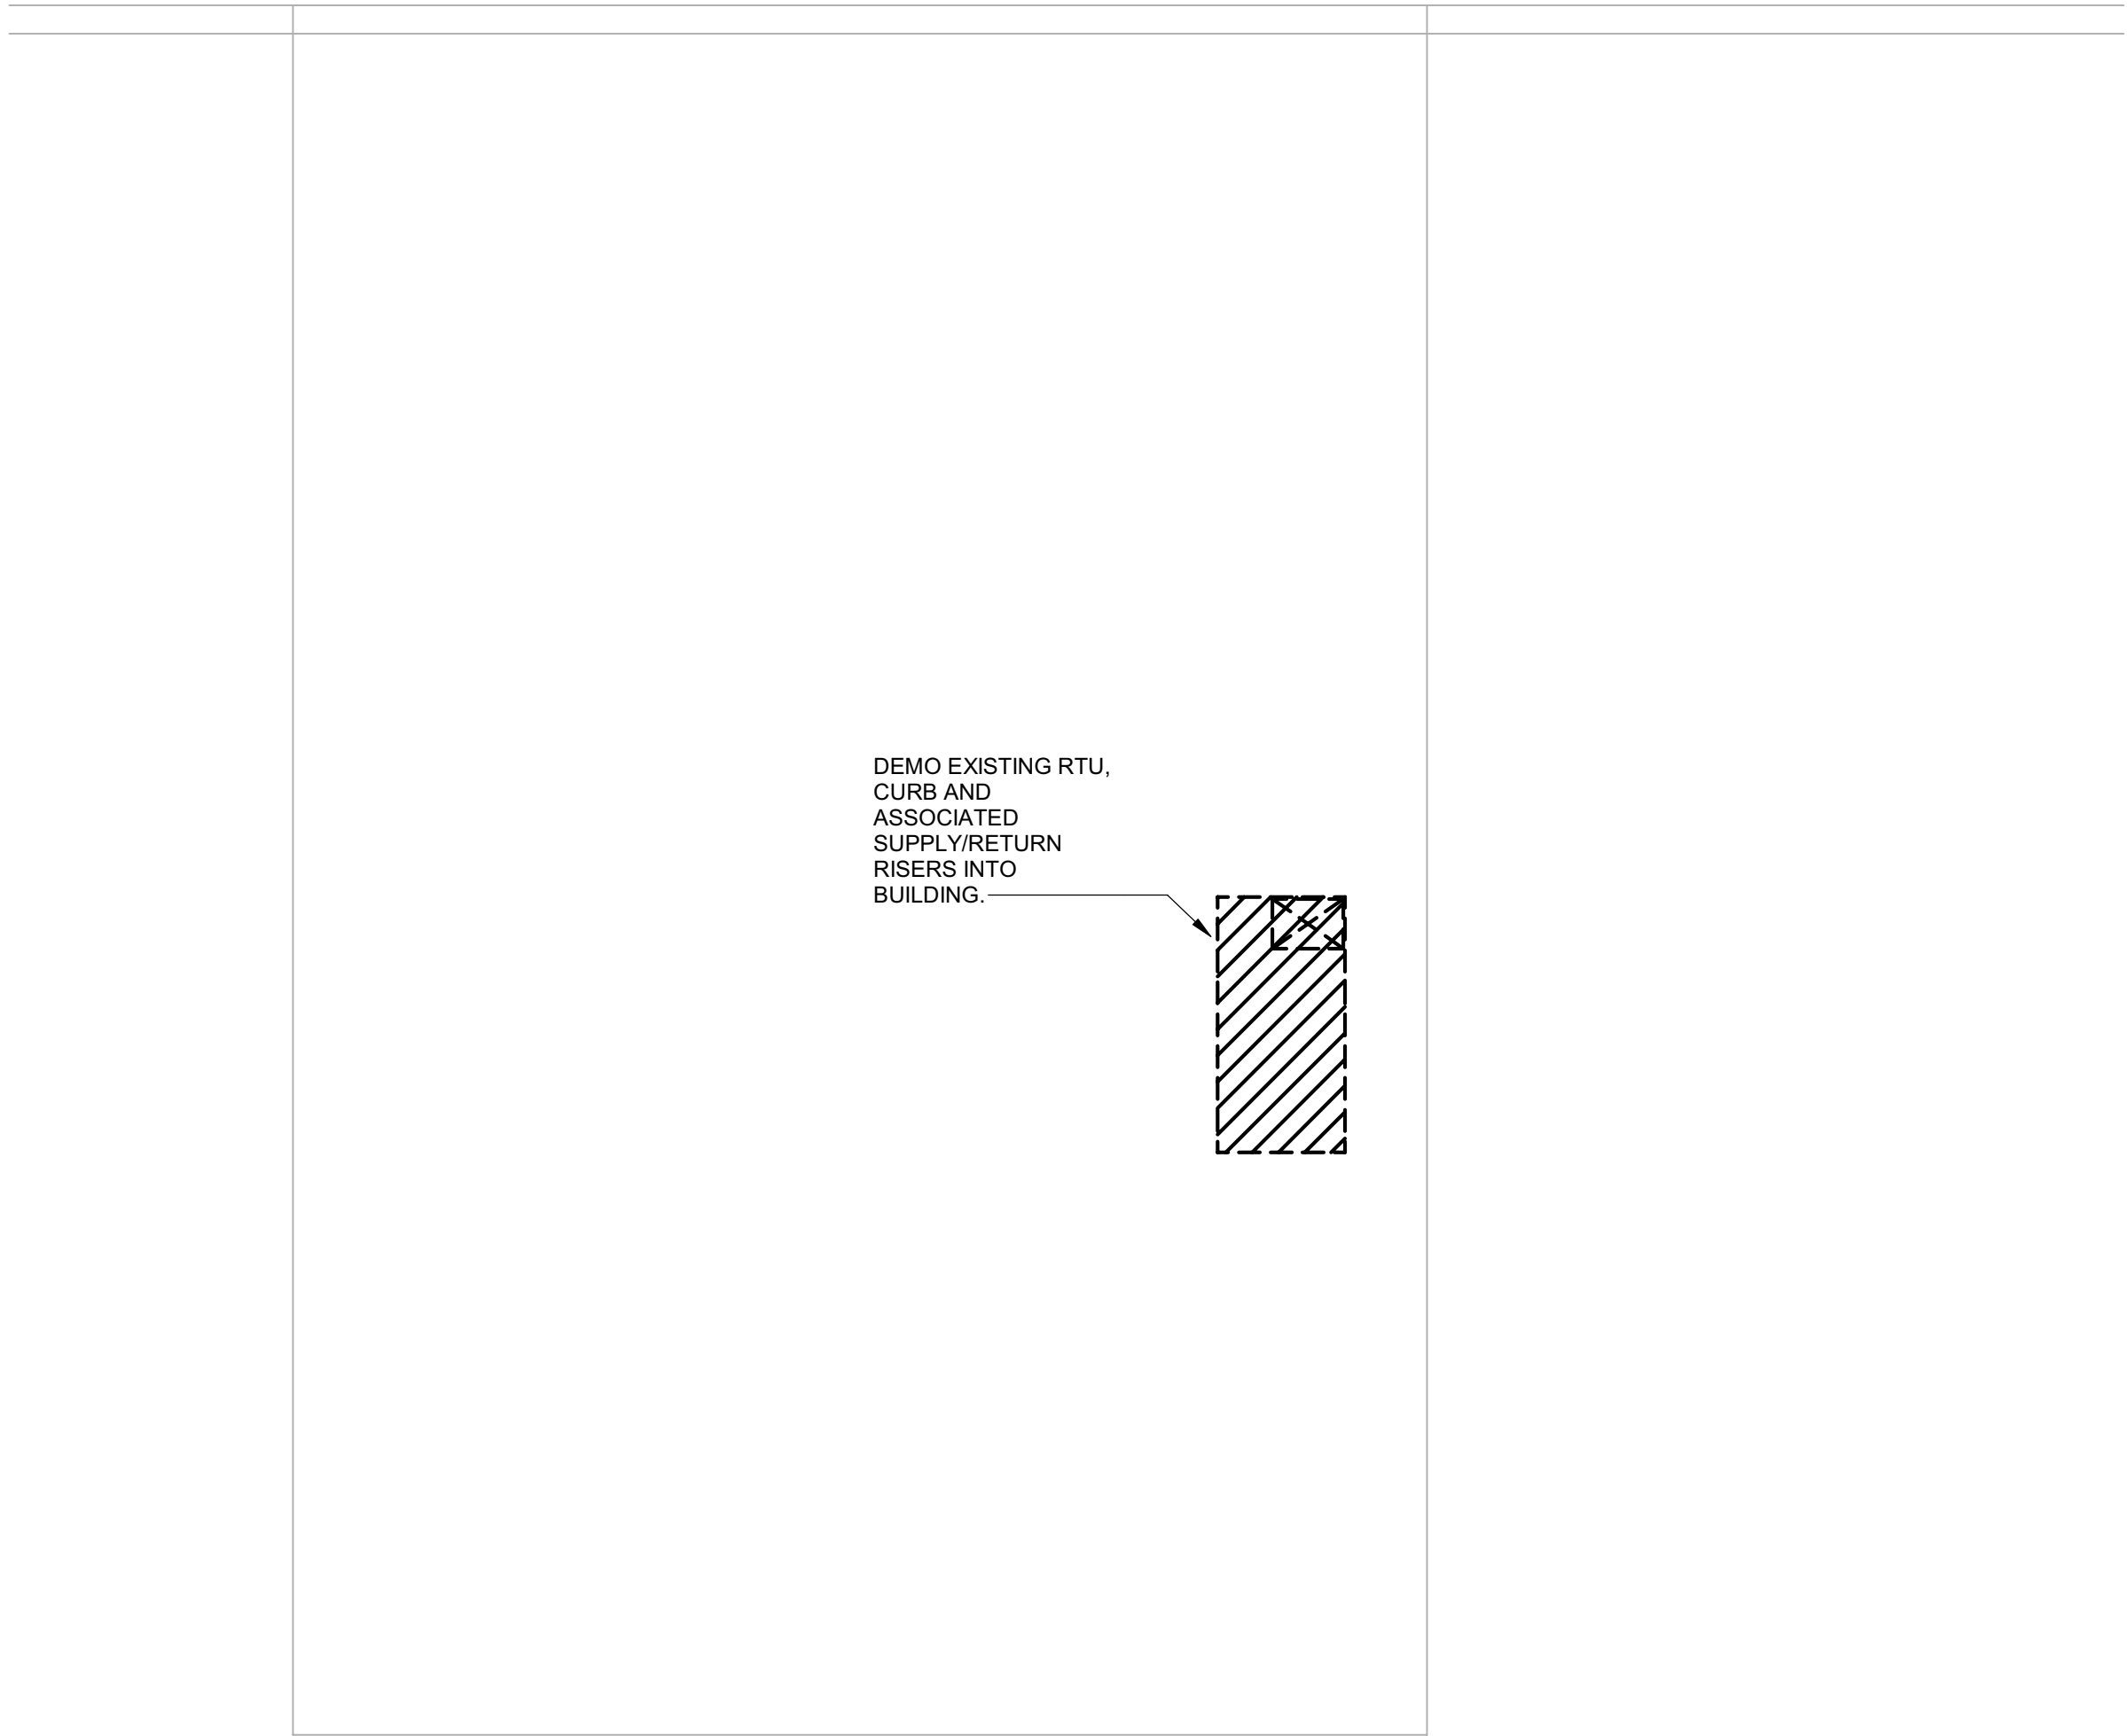


1 MECHANICAL ROOF HVAC DEMO PLAN  
1/4" = 1'-0"  
0 4' 8' 16'

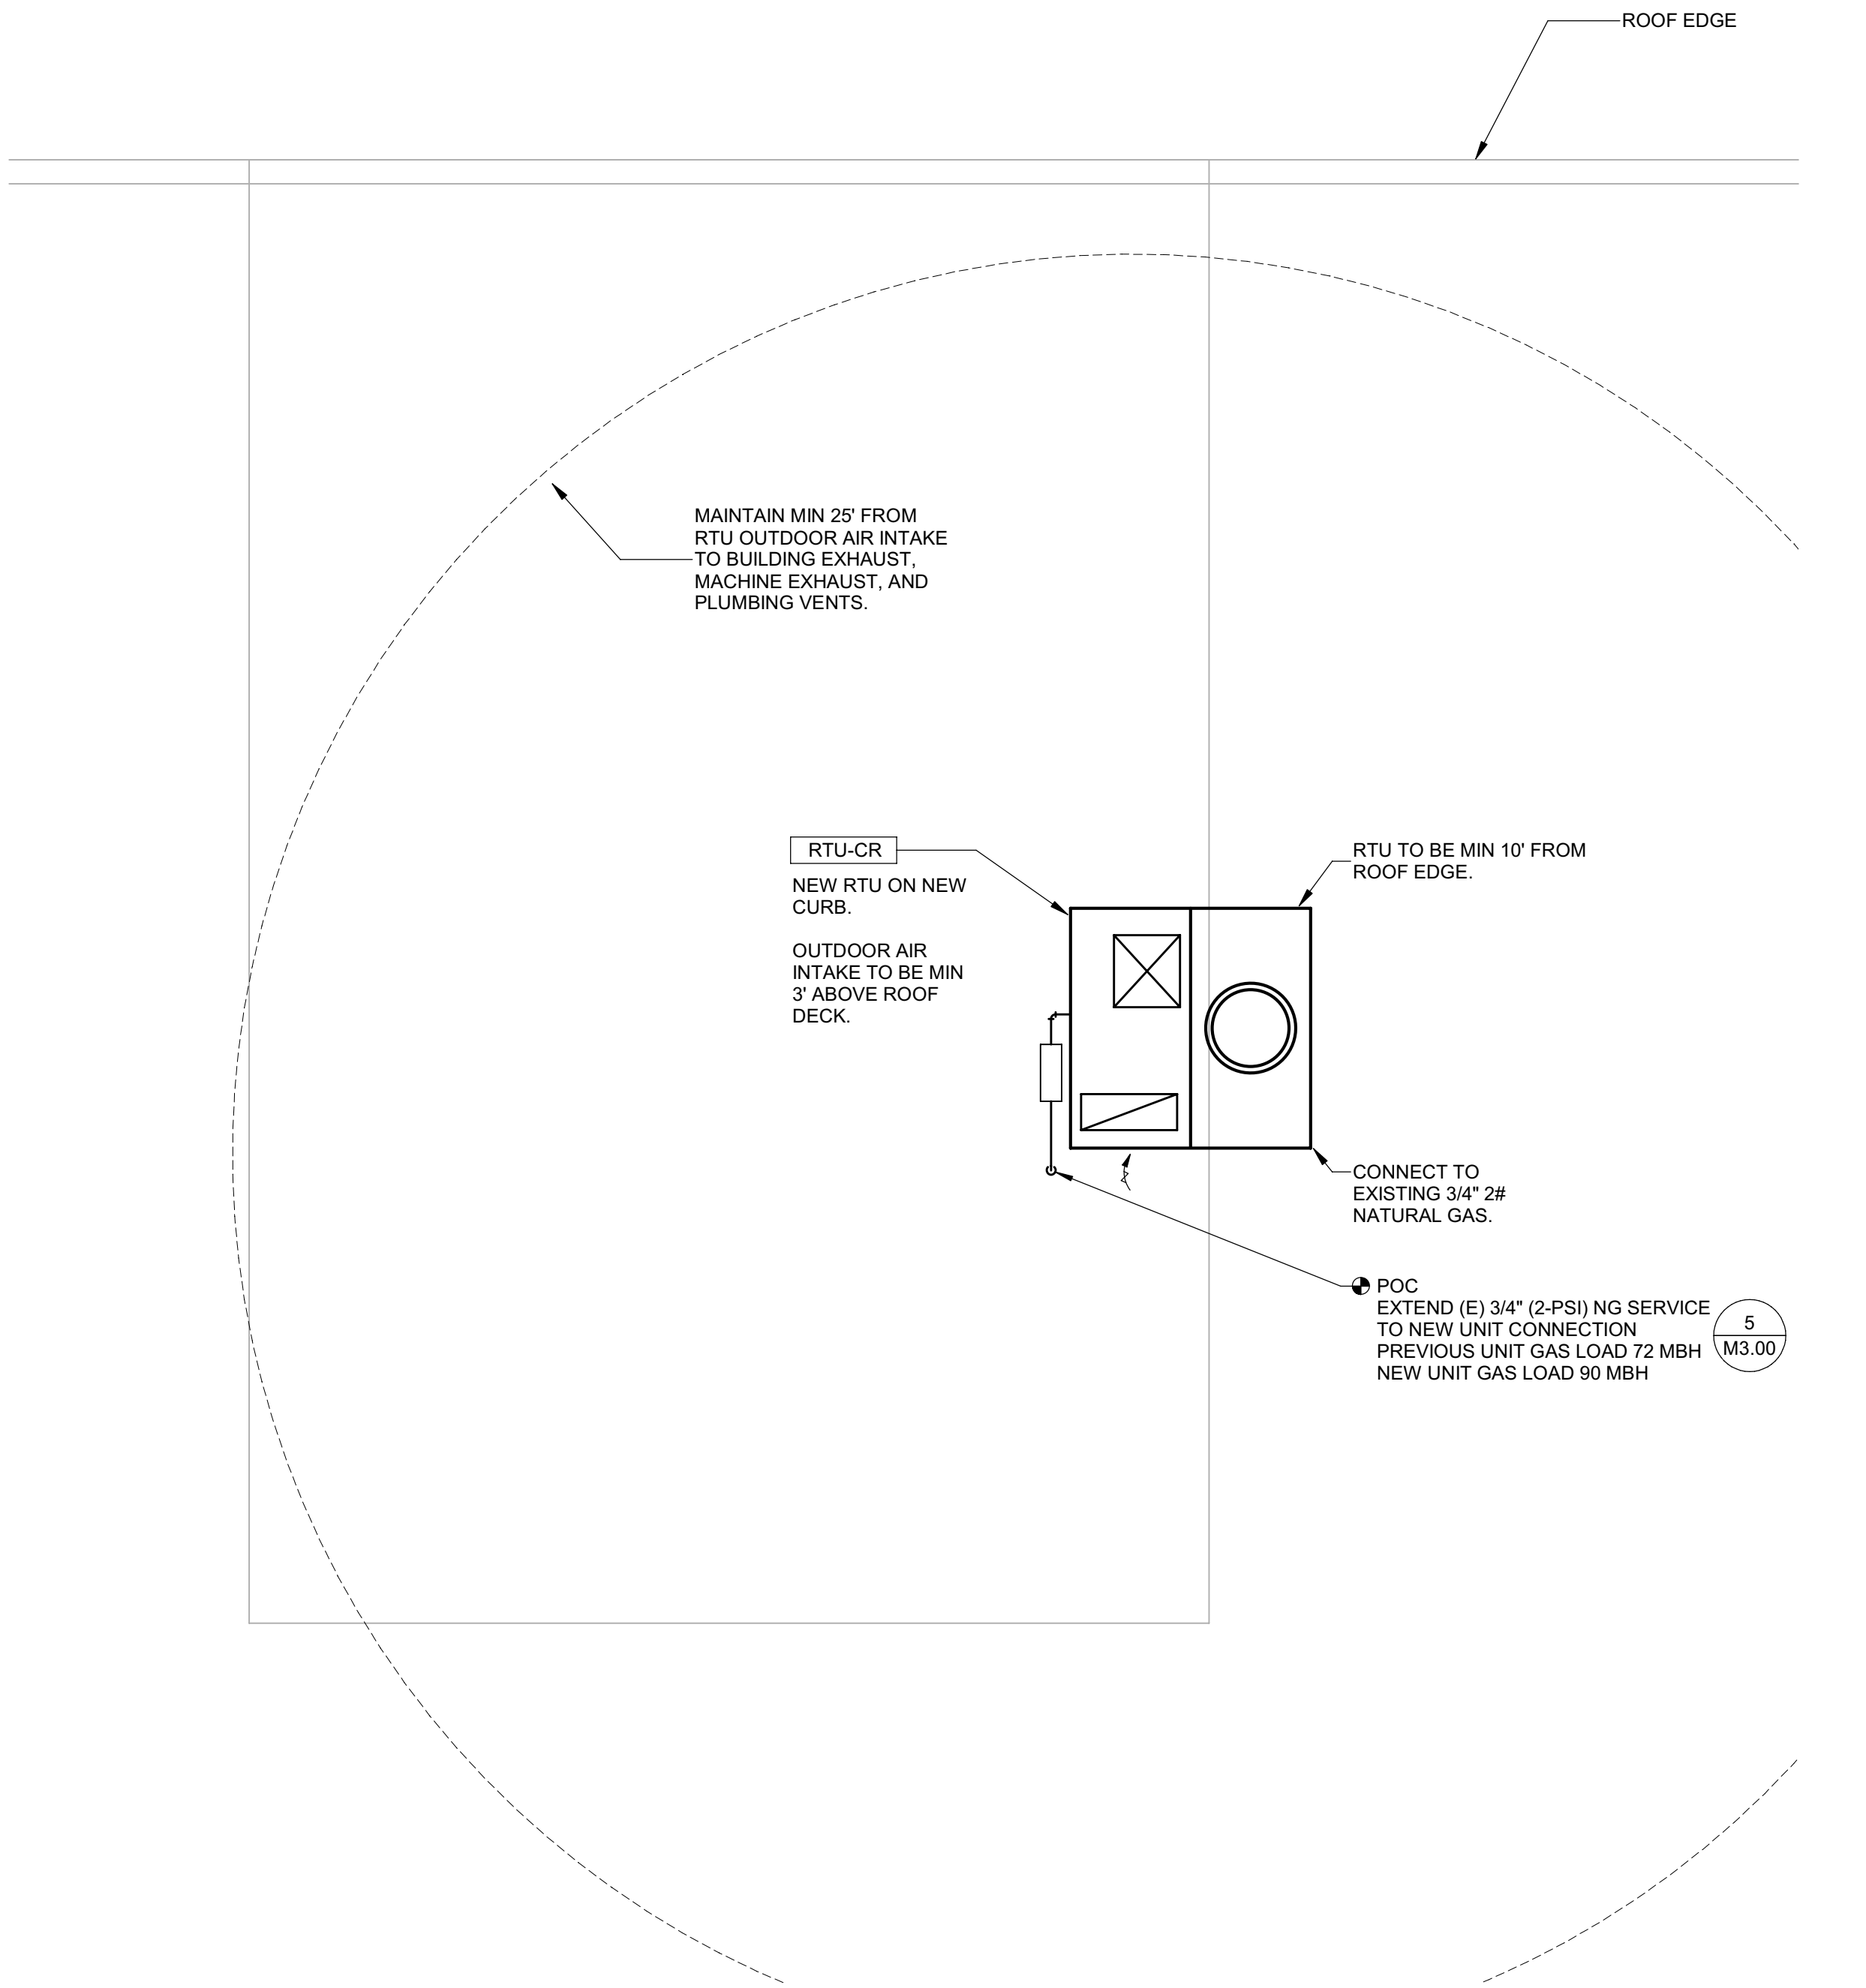

2 MECHANICAL ROOF HVAC PLAN  
1/4" = 1'-0"  
0 4' 8' 16'

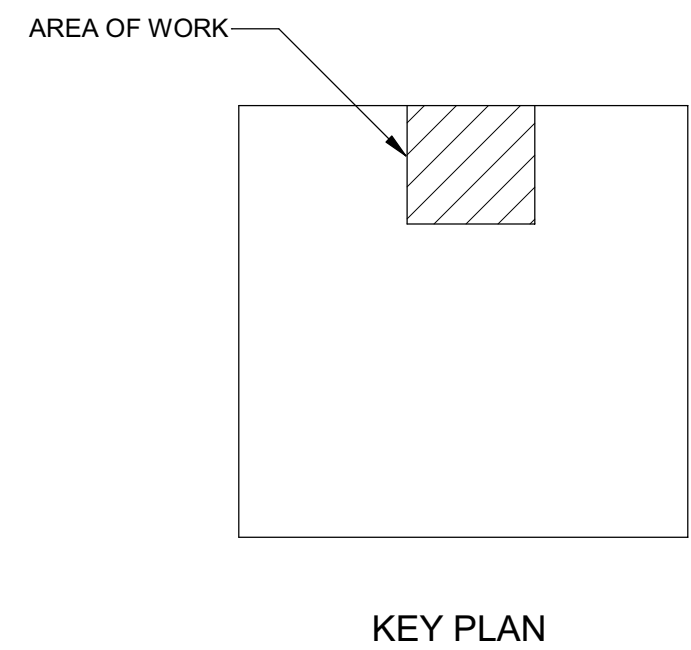

ALLIANT SYSTEMS, LLC  
351 NW 12th AVE  
PORTLAND, OR 97209  
PHONE: 503/619-4000  
FAX: 503/230-9238  
WWW.ALLIANT-SYSTEMS.COM  
CCB# 153420

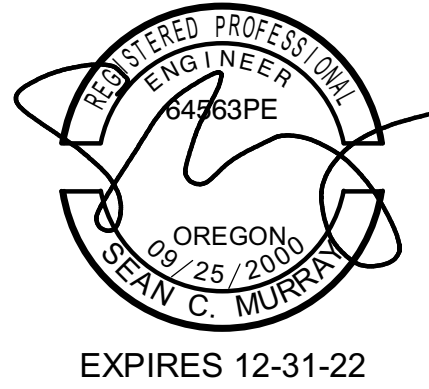

REVISIONS: DATE

PORTLAND HOSPITAL  
CLEAN ROOM RTU

18440 NE PORTAL WAY  
PORTLAND, OR


DESIGNER CONTACT:  
K. PETERSON  
503-619-4000  
K.PETERSON@ALLIANT-SYSTEMS.COM  
CAD:  
K. PETERSON  
PLOT DATE:  
05/11/21

MECHANICAL ROOF  
HVAC PLANS


PROJECT NUMBER:  
C-0444-31270

PERMIT ISSUE  
05/11/21  
Reviewed for  
Code Compliance


SHEET NUMBER:  
M2.02  
21/055455-REV-01-MT

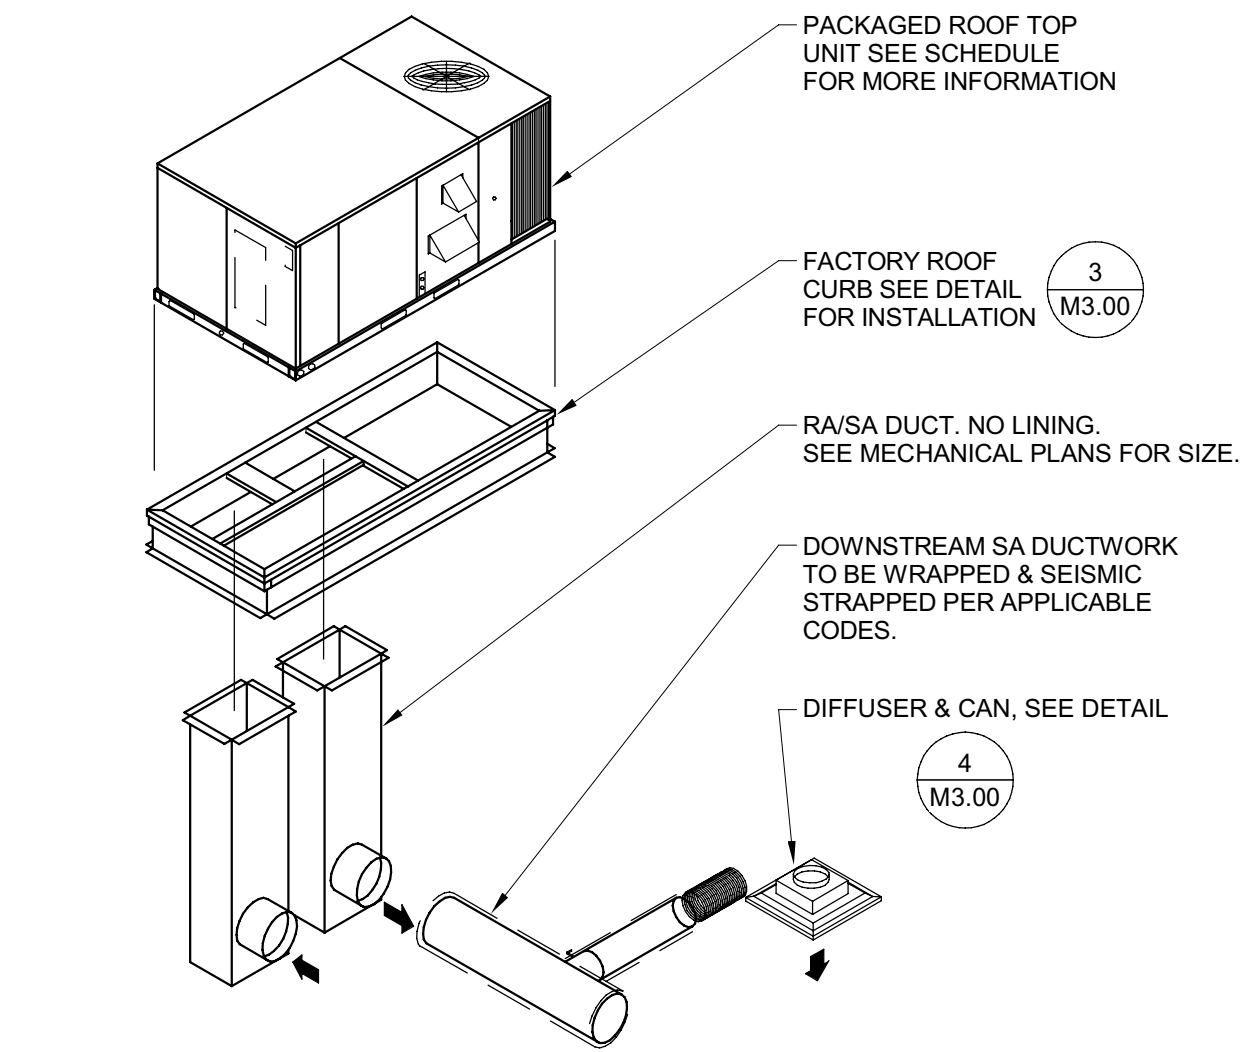


2 1-15 TON GAS-ELECTRIC RTU SYSTEM - DUCTED  
M3.00 NO SCALE

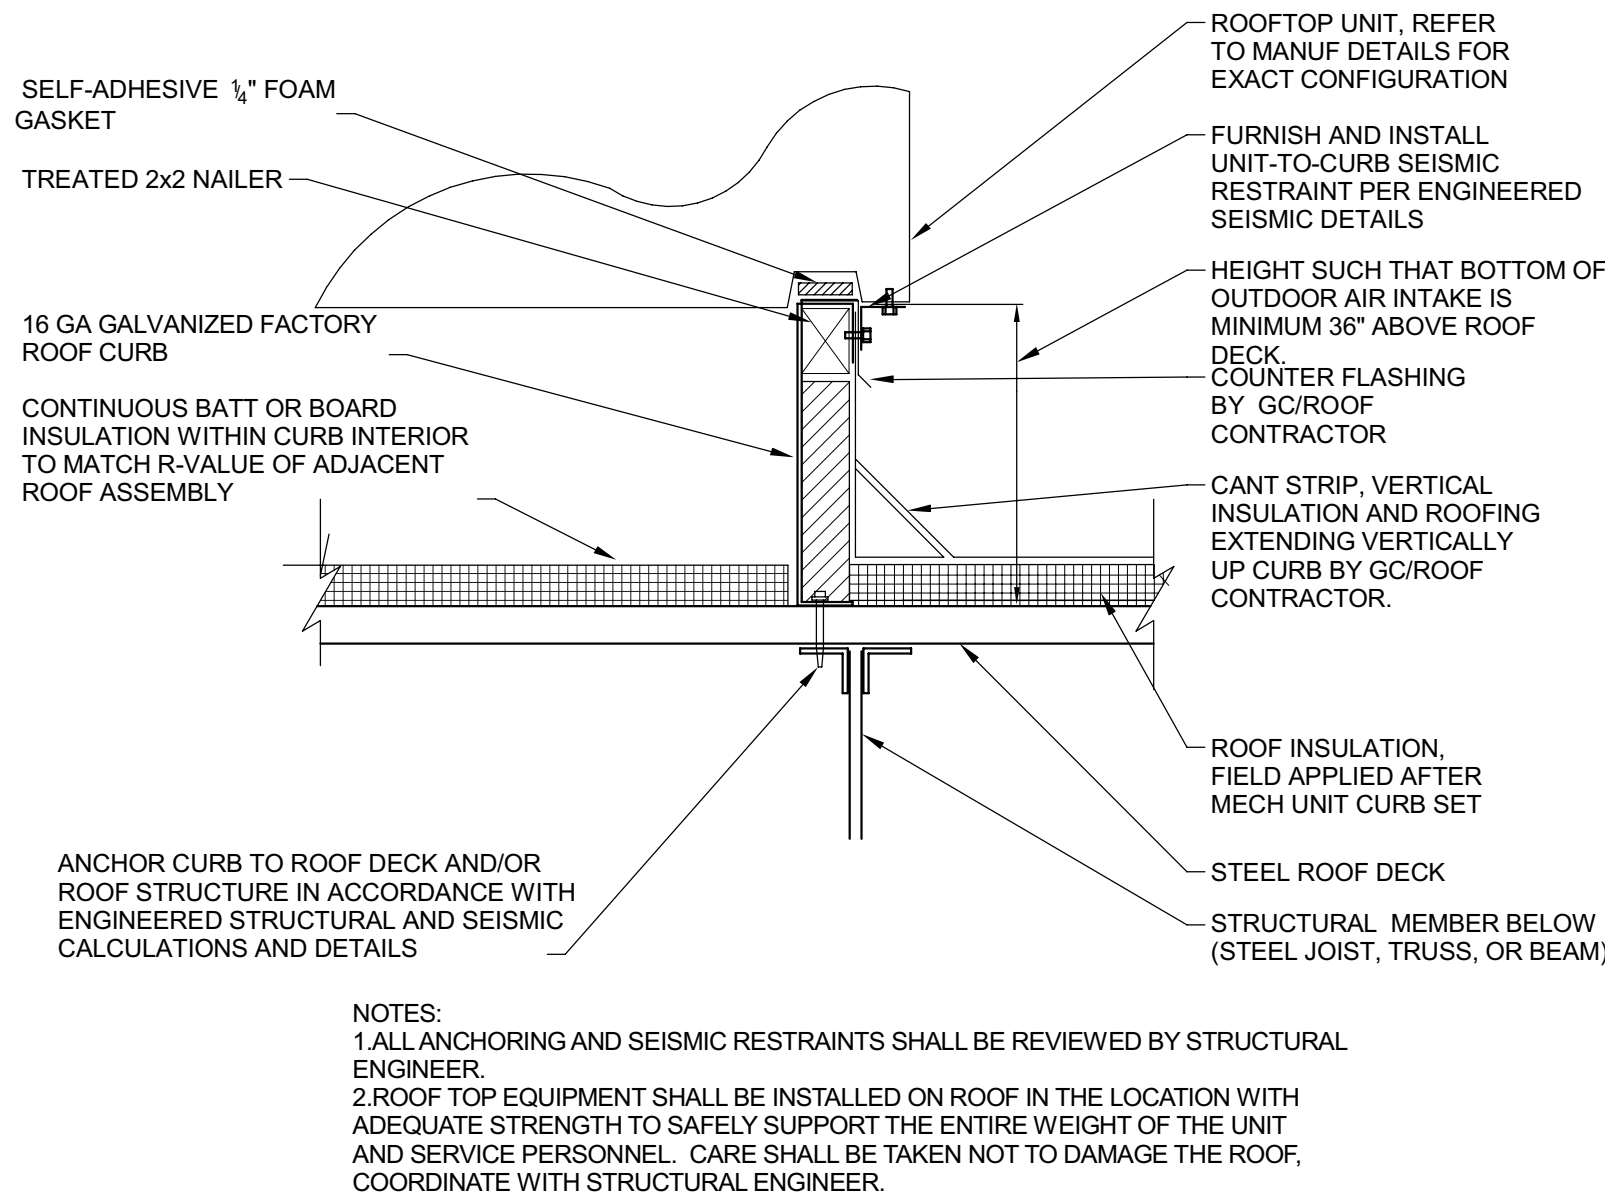


3 1-15 TON RTU CURB DETAIL W SEISMIC RESTRAINT (STEEL DECK)  
M3.00 NO SCALE

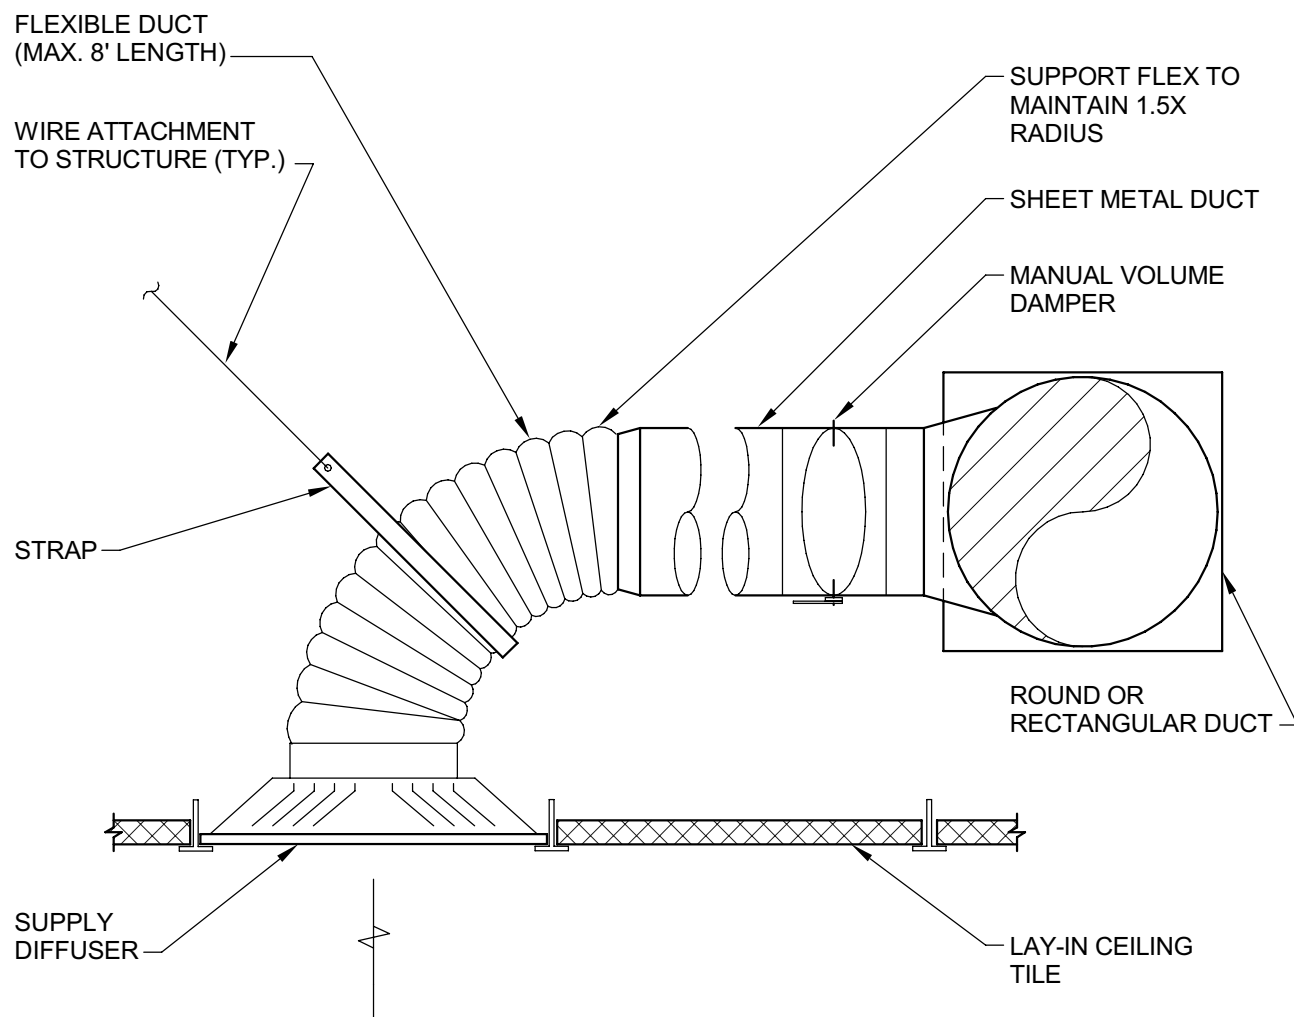

4 LAY-IN SUPPLY DIFFUSER INSTALL  
M3.00 NO SCALE

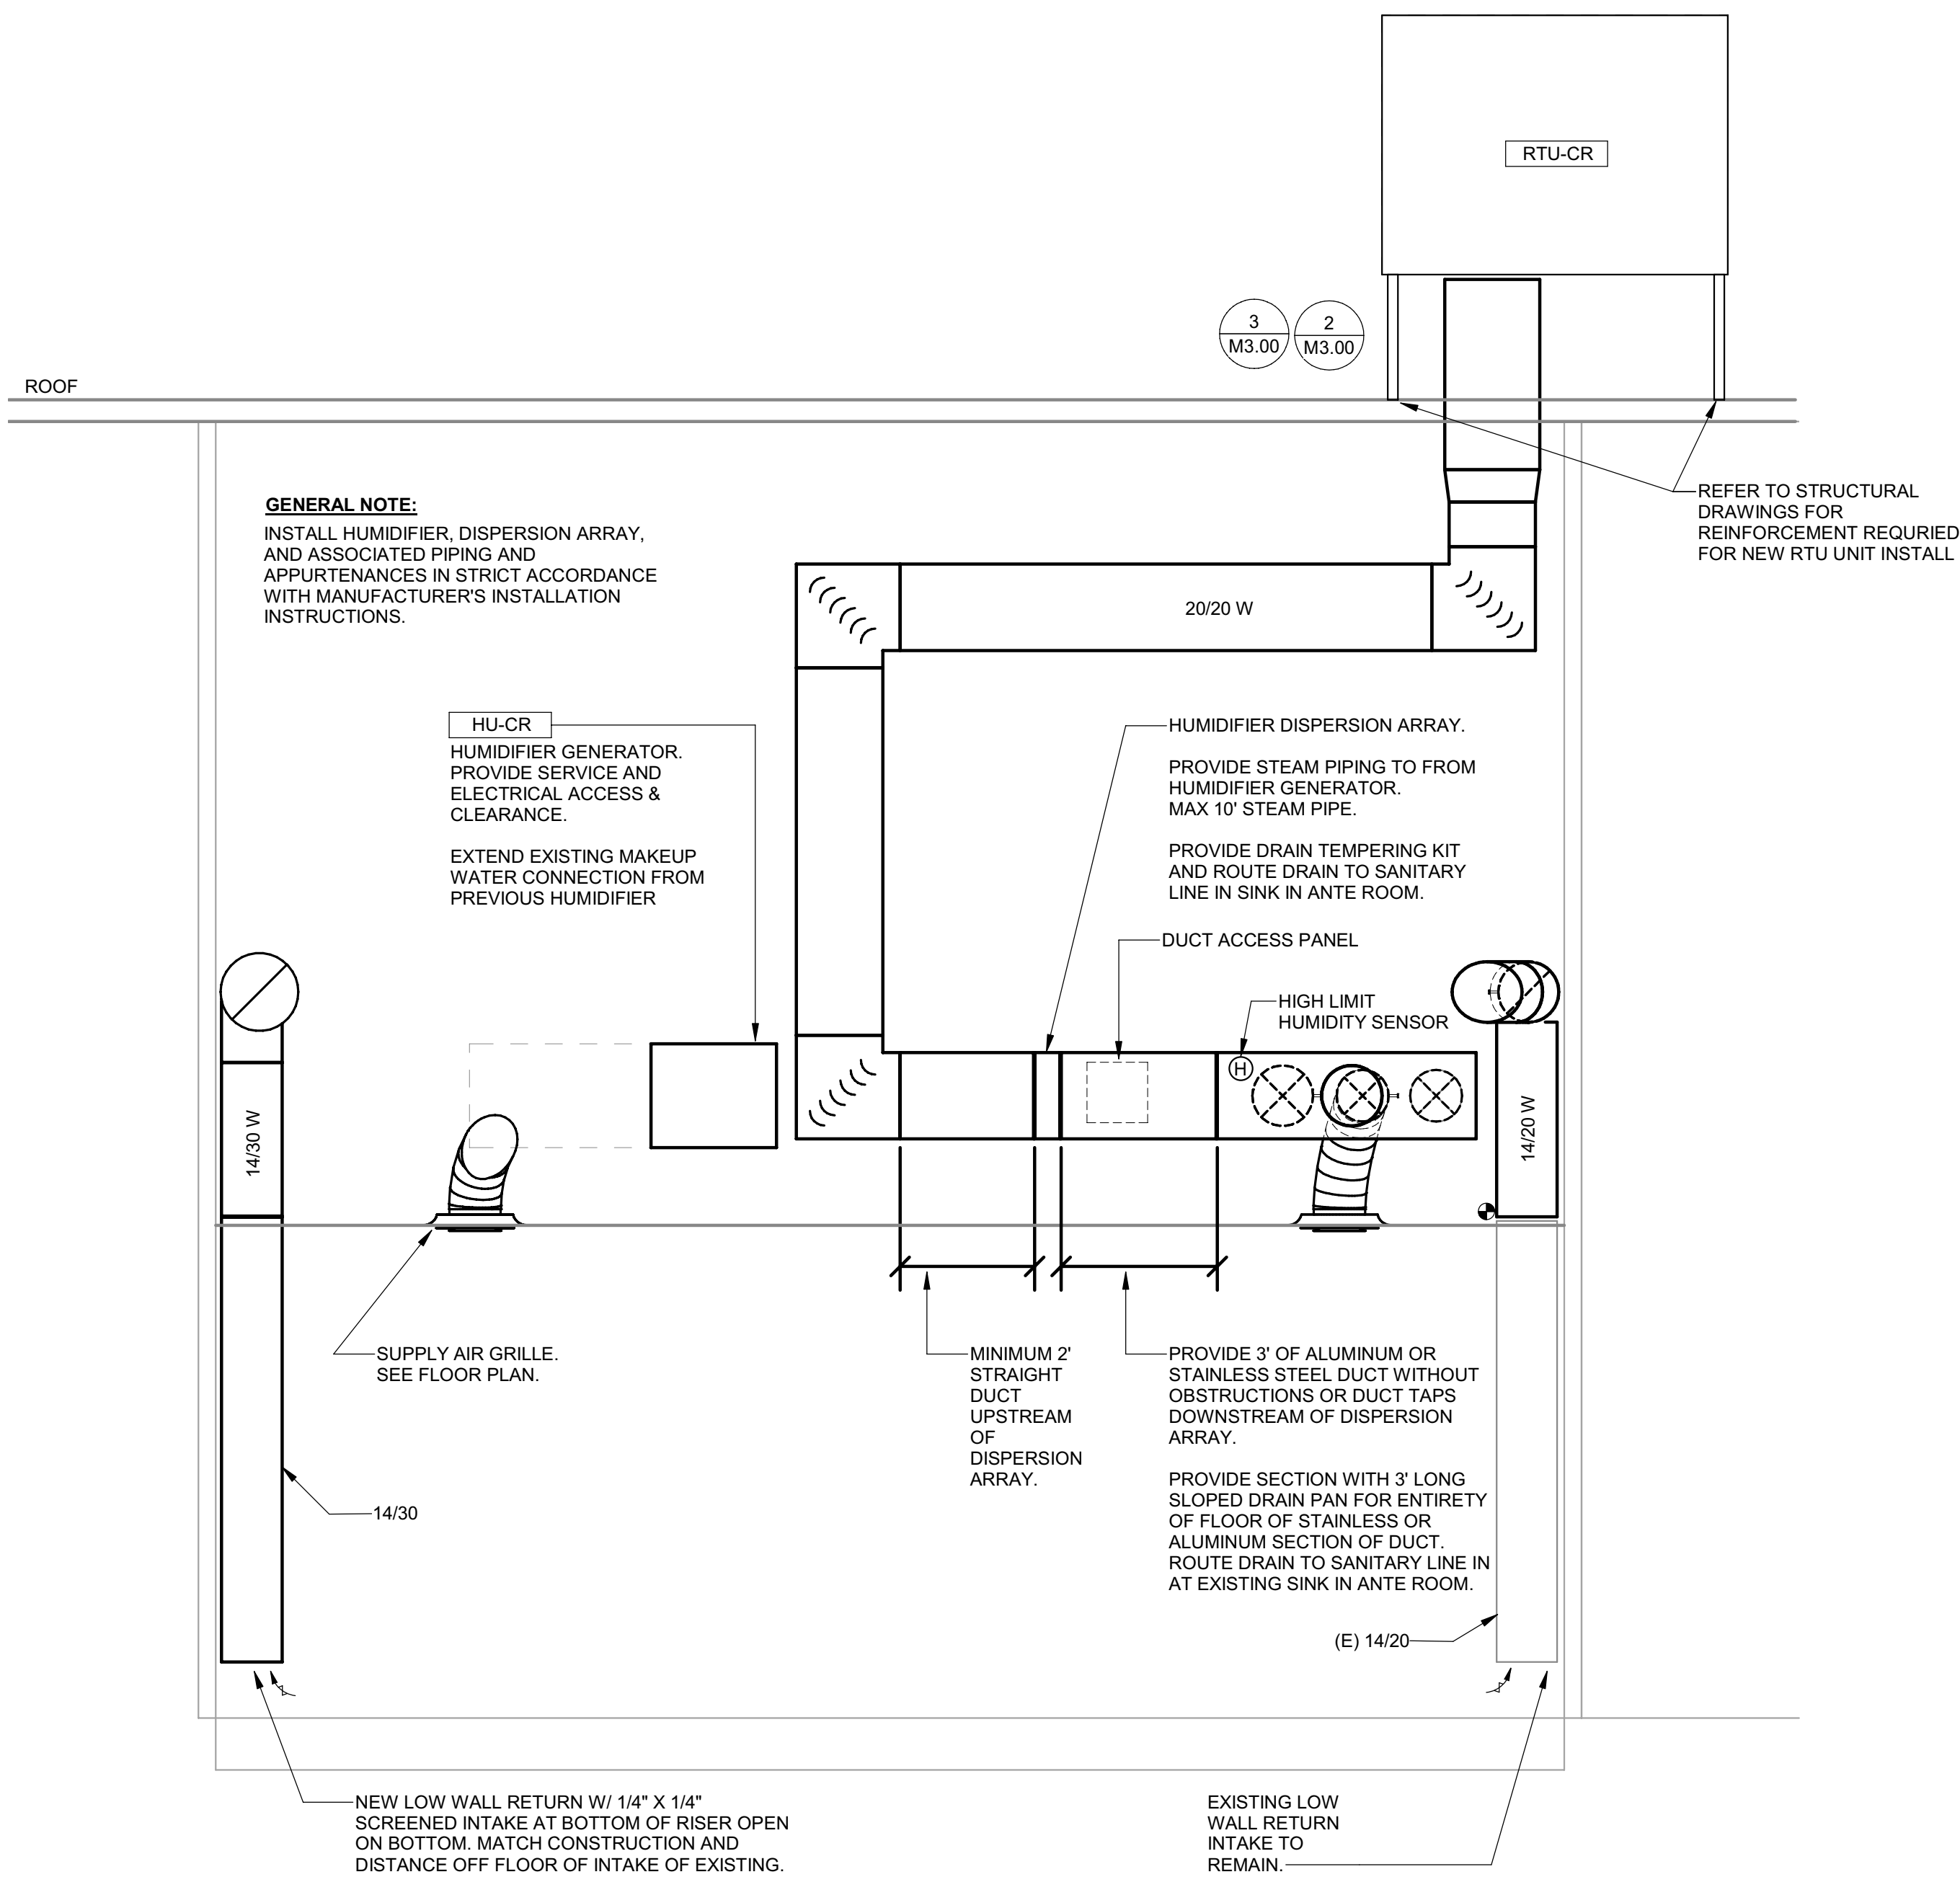

1 SECTION  
M3.00 3/8\"/>

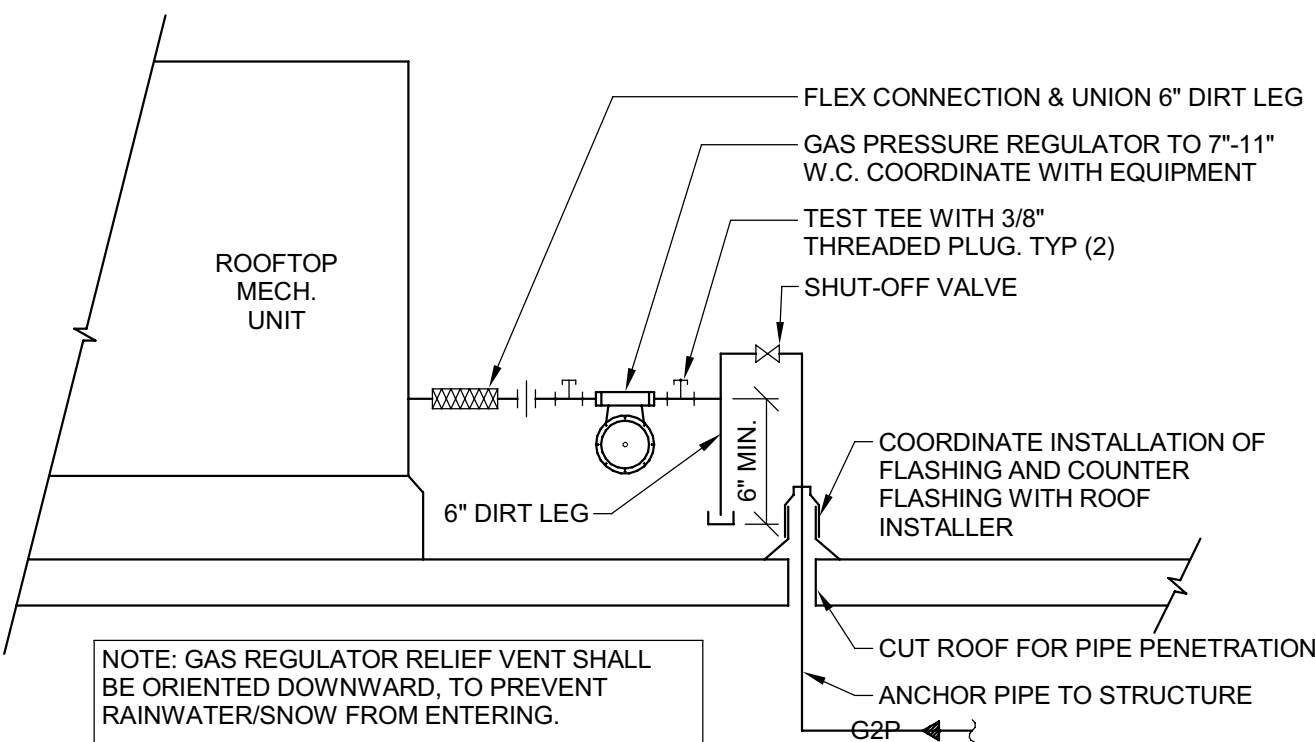

5 ROOFTOP NATURAL GAS EQUIPMENT CONNECTION  
M3.00 NO SCALE


STRUCTURAL NOTES

**GENERAL**  
THE CONTRACTOR IS RESPONSIBLE FOR CHECKING THE PLANS PRIOR TO THE START OF CONSTRUCTION AND SHALL NOTIFY THE ENGINEER OF ANY ERRORS OR INCONSISTANCY WITH THE ARCHITECTURAL OR SUPPLIER DRAWINGS. SHOULD QUESTIONS ARISE REGARDING THE INFORMATION SHOWN ON THESE DRAWINGS THE CONTRACTOR SHALL CONTACT THE ENGINEER BEFORE PROCEEDING. THE ENGINEER IS NOT RESPONSIBLE FOR IMPROPER CONSTRUCTION PRACTICES DUE TO MISUNDERSTANDING OR MISUSE OF THE INFORMATION ON THESE DRAWINGS.  
THE CONTRACTOR SHALL BE SOLELY AND COMPLETELY RESPONSIBLE DURING THE CONSTRUCTION PERIOD FOR ALL CONDITIONS AT THE CONSTRUCTION SITE, INCLUDING SAFETY OF PROPERTY AND PERSONS. THE ENGINEER'S VISITS TO THE SITE AREA ARE NOT INTENDED, NOR SHALL THEY BE CONSTRUED TO INCLUDE A REVIEW OF THE ADEQUACY OF THE CONTRACTOR'S SAFETY MEASURES.  
THE CONTRACTOR SHALL BE RESPONSIBLE FOR THE STRENGTH AND STABILITY OF ALL LIFTING EQUIPMENT, SHORING, BRACING, SCAFFOLDING AND TEMPORARY SUPPORTS.  
THE CONTRACTOR SHALL BE RESPONSIBLE FOR THE WATERPROOFING AND FLASHING DETAILS OF ALL STRUCTURAL & MECHANICAL ELEMENTS INDICATED ON THESE DRAWINGS.  
WRITTEN DIMENSIONS SHALL TAKE PRECEDENCE OVER SCALE DIMENSIONS. DO NOT SCALE DRAWINGS. ALL STRUCTURAL DIMENSIONS ARE TO FACE OF FRAMING, UNLESS NOTED OTHERWISE.  
CONTRACTOR SHALL REVIEW DRAWINGS WITH RESPECT TO MATERIALS, LAYOUT, ELEVATIONS, AND DIMENSIONS BEFORE STARTING WORK. ANY APPARENT DISCREPANCY, AMBIGUITY, OR CONFLICT IN THESE DRAWINGS SHALL BE BROUGHT TO THE ENGINEER'S ATTENTION. ANY REVISION TO THESE DRAWINGS SHALL BE COMPLETED BEFORE PROCEEDING WITH THE WORK AFFECTED.

**CODES AND STANDARDS**  
2019 OREGON STRUCTURAL SPECIALTY CODE  
**DESIGN LOADS**  
SEISMIC LOADING: Ss= 0.880 S1= .371g (SITE SPECIFIC)  
  
RTU-CR REPLACEMENT ROOF TOP HVAC UNIT. MAX OPERATING WEIGHT = 1500 LBS. (W/ CURB)  
  
EF-7 REPALCEMENT EXHAUST FAN. MAX OPERATING WEIGHT = 500 LBS (W/ CURB)  
  
ORIGINAL ROOF PLAN SPECIFIES THE MECHANICAL UNIT WEIGHT ALLOWANCE OF 2000 LBS


STRUCTURAL ABBREVIATIONS

BOT	BOTTOM	LG	LIGHT GAGE
BTWN	BETWEEN	MAX	MAXIMUM
CL	CENTER LINE	MIN	MINIMUM
COL	COLUMN	(N)	NEW
CTR	CENTER	NTS	NOT TO SCALE
DBL	DOUBLE	OC	ON CENTER
DIA	DIAMETER	REQ	REQUIRED
DWG	DRAWING	SCH	SCHEDULE
DTL	DETAIL	SHT	SHEET
(E)	EXISTING	SIM	SIMILAR
EA	EACH	SMS	SHEET METAL SCREW
EQ	EQUAL	TYP	TYPICAL
EXT	EXTERIOR	UNO	UNLESS NOTED OTHERWISE
INT	INTERIOR	VERT	VERTICAL
		W/	WITH

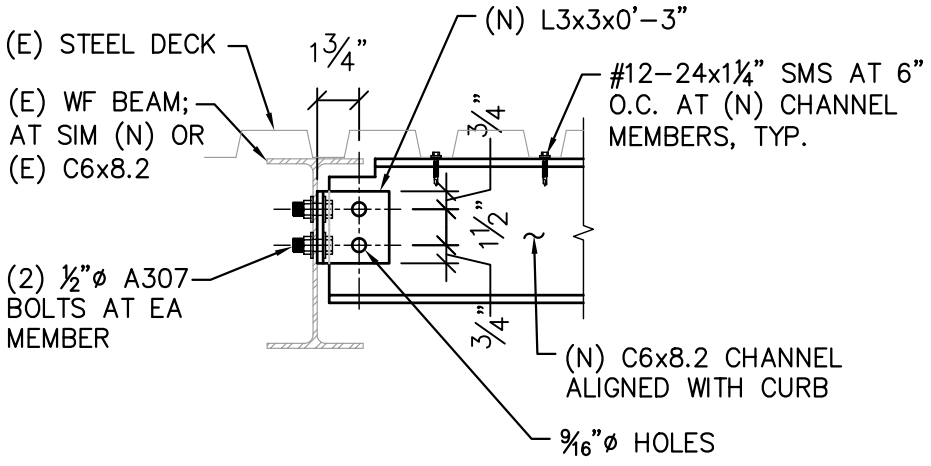

1 CONNECTION DETAIL  
S1



C TO WF

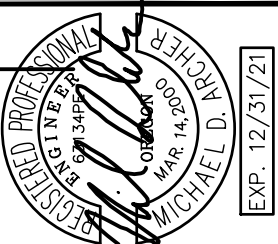

ROOF-TOP HVAC UNIT INSTALL  
PORTLAND HOSPITAL SERVICES  
18440 NE PORTAL WAY, PORTLAND, OR


ARCHER ENGINEERING L.L.C.  
2345 NE 37th Ave., Portland, OR 97212 P 503.2816441 F 503.2816441 C 503.730.3357 E archereng@comcast.net

CLIENT
ALLIANT SYSTEMS 351 SW 12TH AVE. PORTLAND, OR 97209
SHEET CONTENTS STRUCTURAL NOTES
DESIGNED BY MDA
SCALE AS NOTED
DATE 5/18/2021
JOB NUMBER AE2132
SHEET NUMBER S1
City of Portland Reviewed for Code Compliance Date: 08/16/21

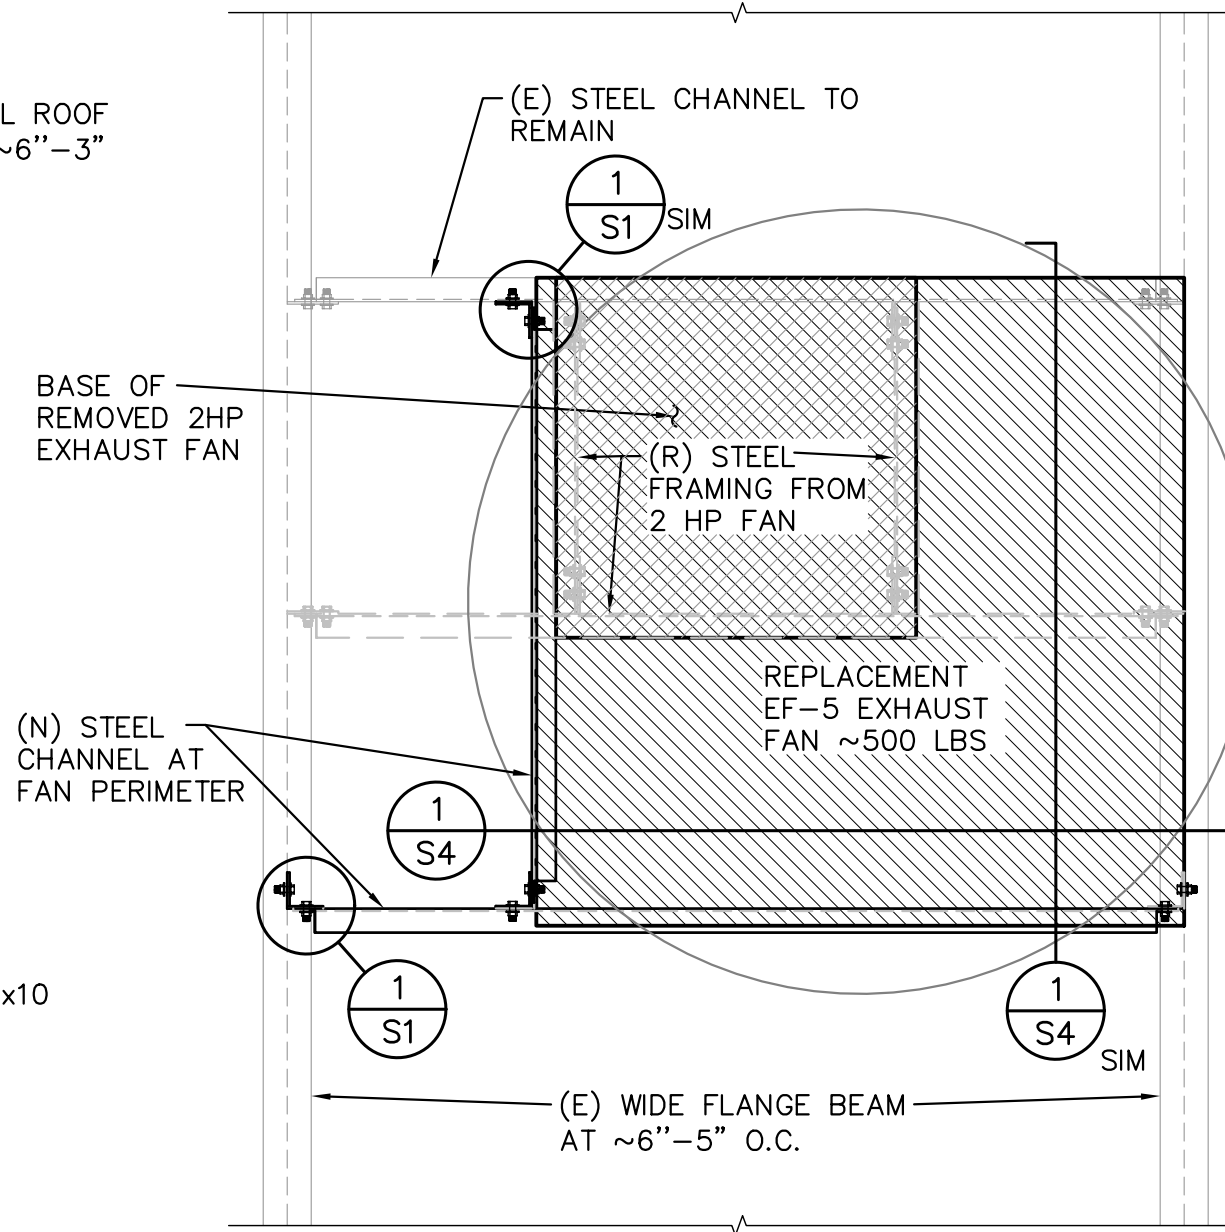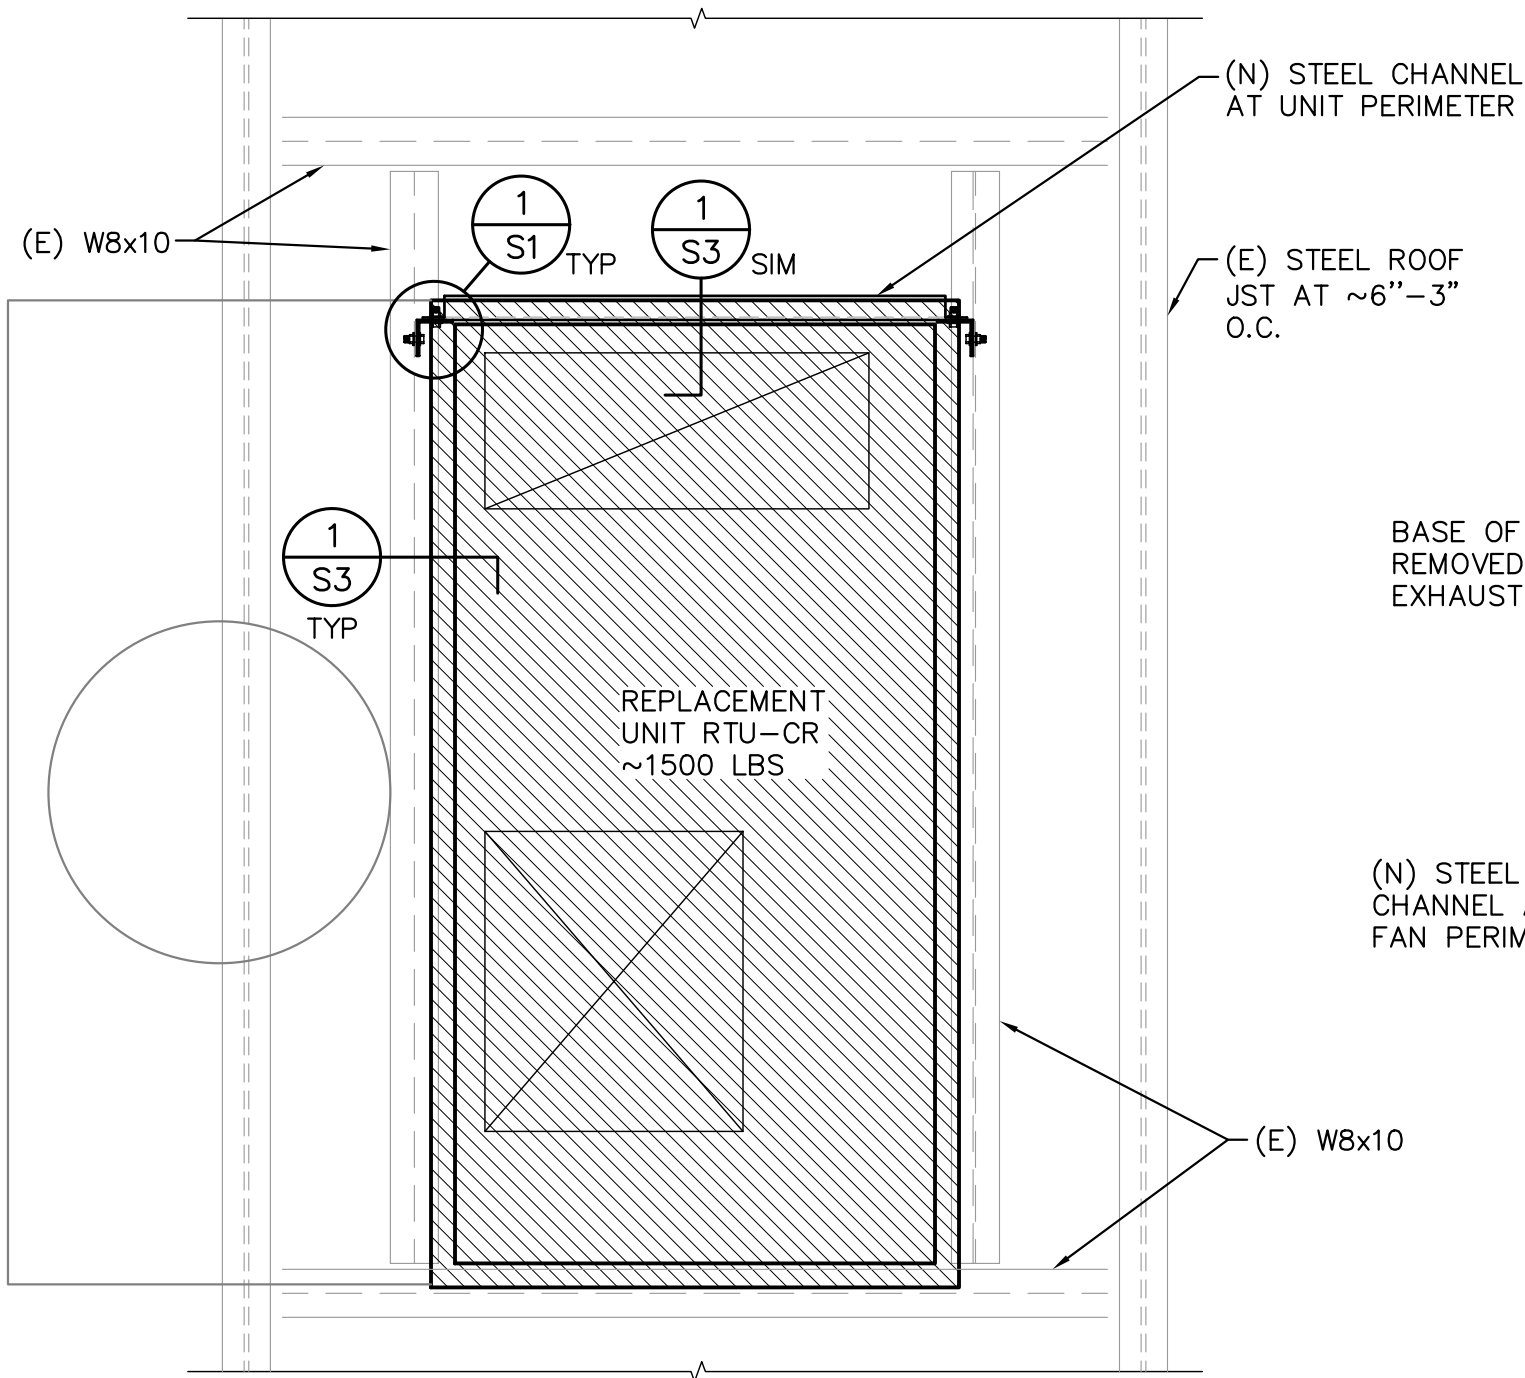

**1**  
**S2** **STEEL FRAMING AT HVAC UNIT**  
3/4" = 1'-0" RTU-CR

**2**  
**S2** **STEEL FRAMING AT FAN**  
3/4" = 1'-0" EF-7

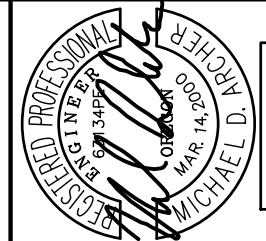

# ROOF-TOP HVAC UNIT INSTALL

PORTLAND HOSPITAL SERVICES  
18440 NE PORTAL WAY, PORTLAND, OR

**ARCHER ENGINEERING L.L.C.**  
2345 NE 37th Ave., Portland, OR 97212 P 503.2816441 F 503.2816441 C 503.730.3357 E archereng@comcast.net

CLIENT  
ALLIANT SYSTEMS  
351 SW 12TH AVE.  
PORTLAND, OR 97209

SHEET CONTENTS  
PARTIAL PLANS

DESIGNED BY  
MDA

SCALE  
AS NOTED

DATE  
5/18/2021

JOB NUMBER  
AE2132

**City of Portland**  
SHEET NUMBER

**S2**  
Reviewed for Code Compliance

Date: 08/16/21

Permit #:  
21-055455-REV-01-MT

NEW MECHANICAL UNIT  
RTU-CR  
MAX OPERATING WEIGHT  
= 1500 LBS

(8) 12 GAGE 'L' CLIPS (SIMP  
ML24 OR EQUIV) W/ (6) #12-14  
SELF TAPPING SHEET METAL  
SCREWS; MAY BE 4"x4"x12 GAGE  
FLAT STRAPS IF EDGES OF CURB  
AND UNIT ALIGN. (3) CLIPS AT  
LONG SIDES OF UNIT; (2) CLIPS  
AT ENDS

(N) ROOF CURB BY SUPPLIER

#12-14x1" SMS AT 12" O.C. AT  
CURB PERIMETER

(E) STEEL ROOF DECK

(E) STEEL JOIST

(E) W8x10 BEAM; CURB  
ALIGNED TO BEAR ON BEAM;  
AT SIM (N) C6x8.2 CHANNEL  
BELOW CURB EDGE

'L' CLIP DETAIL

ROOF TOP  
MECHANICAL  
UNIT

ROOF CURB

'L' CLIP LOCATIONS

12"  
TYP.

(2) 'L'  
CLIPS AT  
EA SIDE OF  
UNIT, TYP




NOTES:

1. DESIGN AND INSTALLATION OF INSULATION, FLASHING  
AND ROOFING MEMBRANE BY CONTRACTOR.
2. ORIGINAL ROOF FRAMING PLAN INDICATES 2000 LB  
CAPACITY FOR MECHANICAL UNIT INSTALLATION

1  
S3


ROOF CURB CONNECTIONS

CURB4

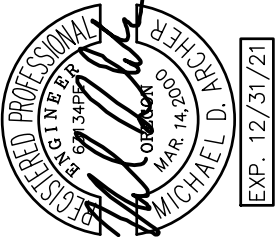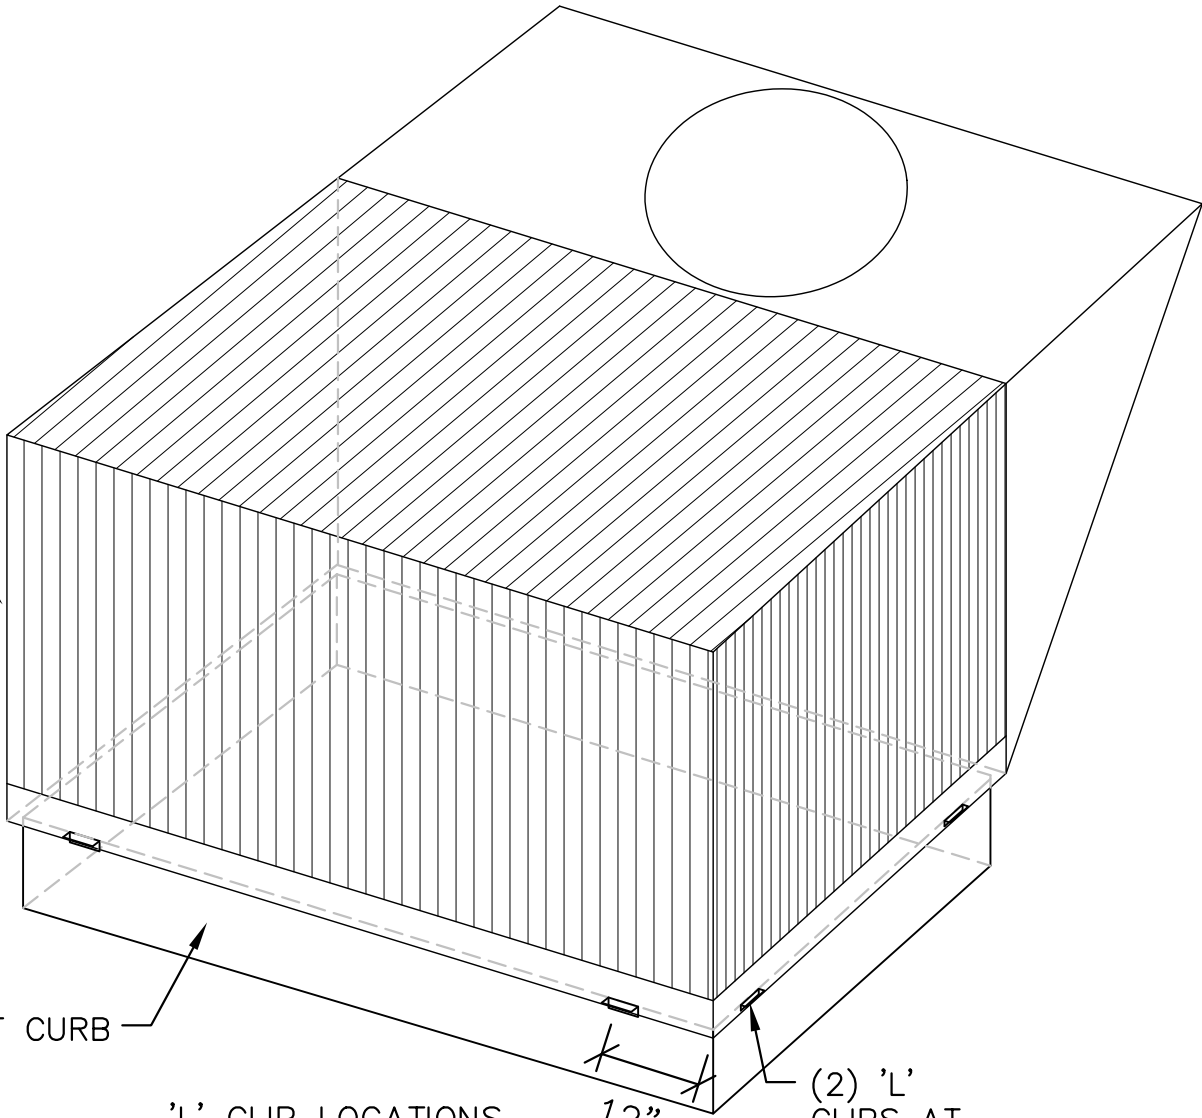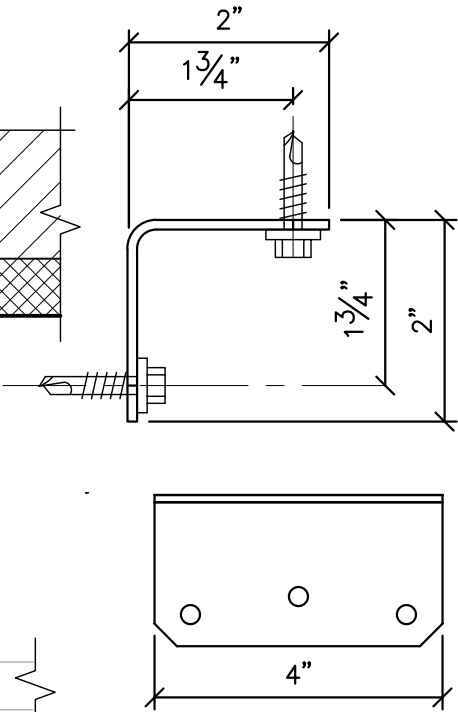

ROOF-TOP HVAC UNIT INSTALL

PORTLAND HOSPITAL SERVICES  
18440 NE PORTAL WAY, PORTLAND, OR

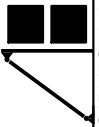

ARCHER ENGINEERING L.L.C.

2345 NE 37th Ave., Portland, OR 97212 P 503.2816441 F 503.2816441 C 503.730.3357 E archereng@comcast.net

CLIENT

ALLIANT SYSTEMS  
351 SW 12TH AVE.  
PORTLAND, OR 97209

SHEET CONTENTS  
DETAILS

DESIGNED BY  
MDA

SCALE  
AS NOTED

DATE  
5/18/2021

JOB NUMBER


AE2132

City of Portland  
SHEET NUMBER


Reviewed for Code Compliance

Date: 08/16/21

Permit #:  
21-055455-REV-01-MT

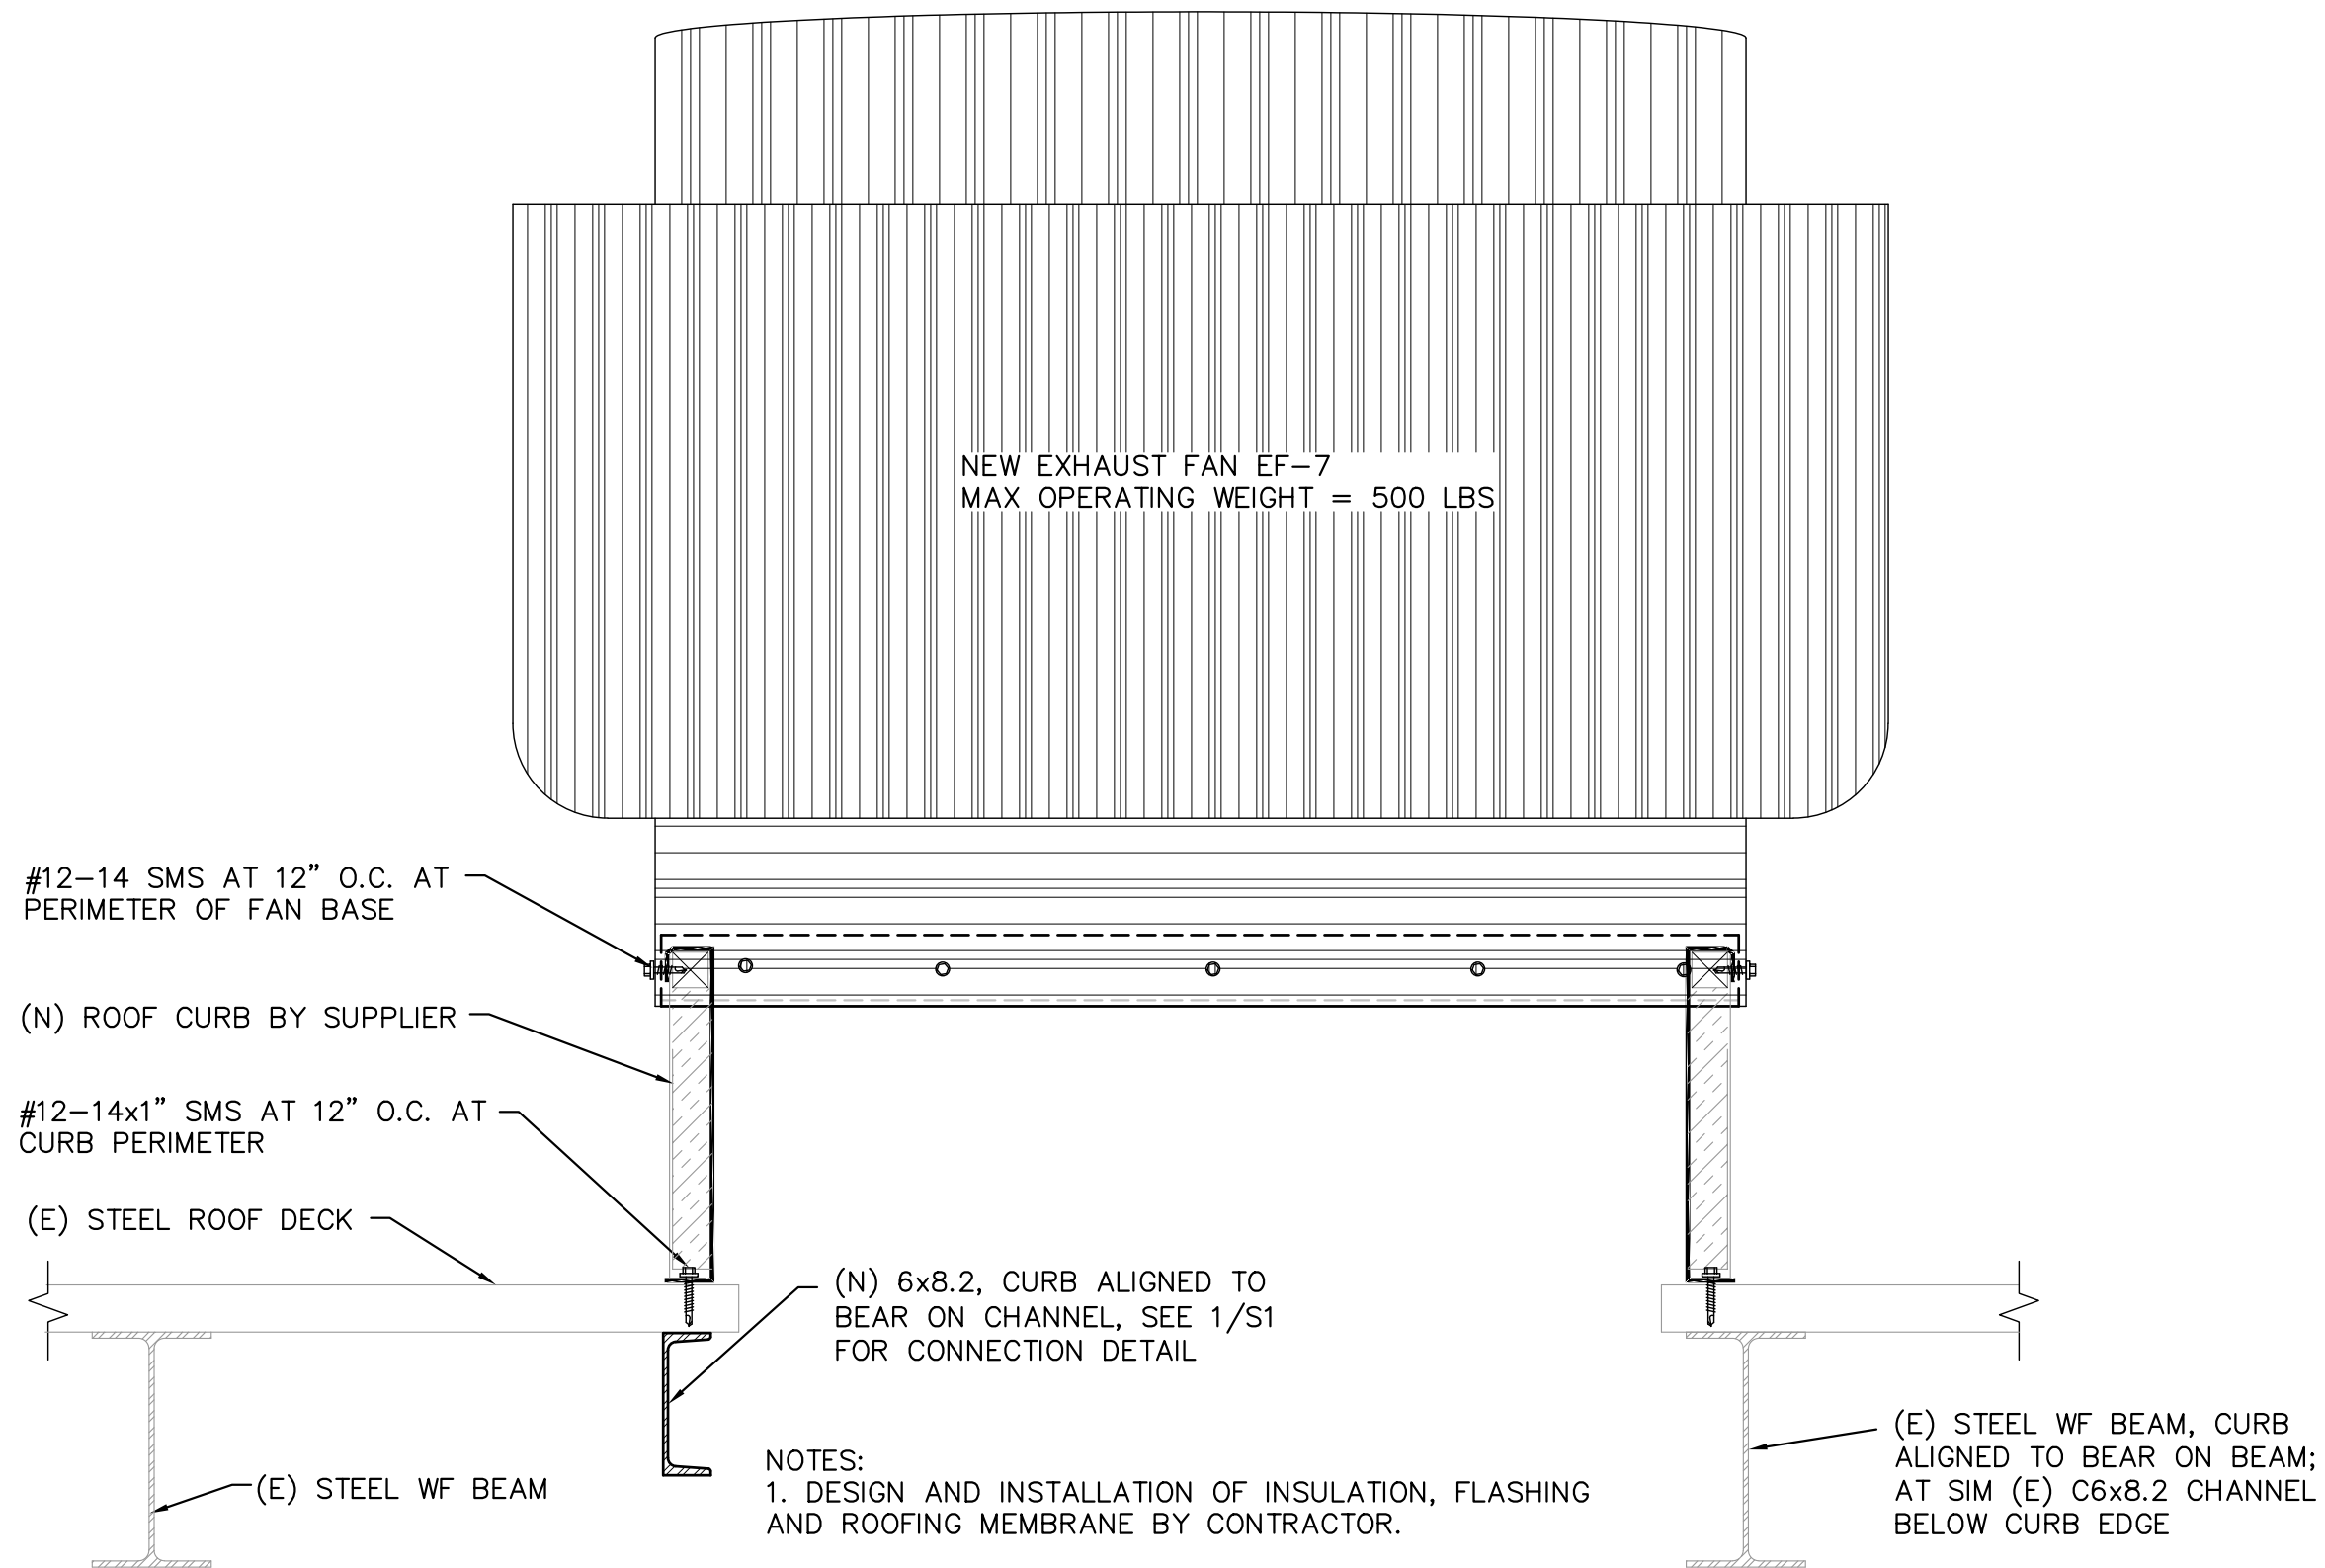

1  
S4 EXHAUST FAN CONNECTION DETAIL  
FAN

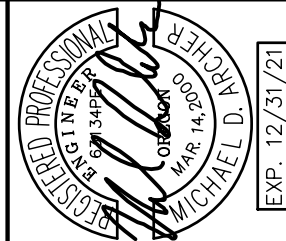

ROOF-TOP HVAC UNIT INSTALL  
PORTLAND HOSPITAL SERVICES  
18440 NE PORTAL WAY, PORTLAND, OR

ARCHER ENGINEERING L.L.C.  
2345 NE 37th Ave., Portland, OR 97212 P 503.2816441 F 503.2816441 C 503.730.3357 E archereng@comcast.net

CLIENT  
ALLIANT SYSTEMS  
351 SW 12TH AVE.  
PORTLAND, OR 97209

SHEET CONTENTS  
DETAILS

DESIGNED BY  
MDA

SCALE  
AS NOTED

DATE  
5/18/2021

JOB NUMBER  
AE2132

SHEET NUMBER  
S4

City of Portland  
Reviewed for Code Compliance  
Date: 08/16/21

Permit #:  
21-055455-REV-01-MT