



City of Portland, Oregon - Bureau of Development Services

1900 SW Fourth Avenue • Portland, Oregon 97201 | 503-823-7300 | www.portland.gov/bds



Permit Revision Submittal Requirements and Application

A Permit Revision is required when there are proposed changes to the project after the permit has been issued. This may arise due to discrepancies between the city-approved permit drawings and actual field conditions, or the customer has changed their mind about an aspect of the project. In all cases, a revision to the existing permit must be submitted, reviewed and approved.

Minimum Submittal Requirements (check all boxes and sign below):

- ☐ A copy of this application.
- ☐ One PDF copy of plans for electronic submittals or three copies for paper submittals.
- ☐ All plans must clearly reflect the proposed change(s). Changes must be bubbled.
- ☐ Drawings and calculations must be stamped and signed by the Architect and/or the Engineer of Record, if applicable.
- ☐ Project narrative for extensive revisions.
- ☐ One PDF copy of calculations and other supporting documents for electronic submittals or two copies for paper submittals.
- ☐ Copy of Inspector's correction notice, if the revision is due to an inspection correction. One PDF copy for electronic submittals and two copies for paper submittals.

Applicant Information:

Applicant Name _____

Street Address _____ City/State/ZIP _____

Email _____ Phone _____

Value of Proposed Revision _____ Issued Permit # _____

Job Site Address _____ City/State/ZIP _____

Description of Revision _____

Applicant Signature _____ Date _____

Fees:

An invoice with permit fees will be sent to the applicant once minimum submittal requirements have been verified. Permit Revisions are subject to fees associated with plan review, processing and any increase in project value.

The Bureau of Development Services fee schedule is on the BDS web site: www.portlandoregon.gov/bds/article/102792

Helpful Information:

Bureau of Development Services | City of Portland, Oregon
1900 SW 4th Avenue, Portland, OR 97201
For Hours Call 503-823-7310 or visit www.portlandoregon.gov/bds

Important Telephone Numbers:

BDS main number	503-823-7300
DSC automated information line	503-823-7310
Building code information	503-823-1456
BDS 24-hour inspection request line	503-823-7000
Residential information for one- and two-family dwelling	503-823-7388
General Permit Processing and Fee Estimate info	503-823-7357
Zoning Information Line	503-823-7526
City of Portland TTY	503-823-6868

City of Portland

REVIEWED FOR CODE COMPLIANCE

Date: 03/14/22

Permit #: 22-101076-REV 01-RS

ABBREVIATIONS

A AMPERE AC ALTERNATING CURRENT BLDG BUILDING CONC CONCRETE DC DIRECT CURRENT EGC EQUIPMENT GROUNDING CONDUCTOR (E) EXISTING EMT ELECTRICAL METALLIC TUBING FSB FIRE SET-BACK GALV GALVANIZED GEC GROUNDING ELECTRODE CONDUCTOR GND GROUND HDG HOT DIPPED GALVANIZED I CURRENT Imp CURRENT AT MAX POWER Isc SHORT CIRCUIT CURRENT kVA KILOVOLT AMPERE kW KILOWATT LBW LOAD BEARING WALL MIN MINIMUM (N) NEW NEUT NEUTRAL NTS NOT TO SCALE OC ON CENTER PL PROPERTY LINE POI POINT OF INTERCONNECTION PV PHOTOVOLTAIC SCH SCHEDULE S STAINLESS STEEL STC STANDARD TESTING CONDITIONS TYP TYPICAL UPS UNINTERRUPTIBLE POWER SUPPLY V VOLT Vmp VOLTAGE AT MAX POWER Voc VOLTAGE AT OPEN CIRCUIT W WATT 3R NEMA 3R, RAINTIGHT

ELECTRICAL NOTES

1. THIS SYSTEM IS GRID-INTERTIED VIA A UL-LISTED POWER-CONDITIONING INVERTER.
2. A NATIONALLY-RECOGNIZED TESTING LABORATORY SHALL LIST ALL EQUIPMENT IN COMPLIANCE WITH ART. 110.3.
3. WHERE ALL TERMINALS OF THE DISCONNECTING MEANS MAY BE ENERGIZED IN THE OPEN POSITION, A SIGN WILL BE PROVIDED WARNING OF THE HAZARDS PER ART. 690.17.
4. EACH UNGROUNDED CONDUCTOR OF THE MULTI-WIRE BRANCH CIRCUIT WILL BE IDENTIFIED BY PHASE AND SYSTEM PER ART. 210.5.
5. CIRCUITS OVER 250V TO GROUND SHALL COMPLY WITH ART. 250.97, 250.92(B).
6. DC CONDUCTORS EITHER DO NOT ENTER BUILDING OR ARE RUN IN METALLIC RACEWAYS OR ENCLOSURES TO THE FIRST ACCESSIBLE DC DISCONNECTING MEANS PER ART. 690.31(E).
7. ALL WIRES SHALL BE PROVIDED WITH STRAIN RELIEF AT ALL ENTRY INTO BOXES AS REQUIRED BY UL LISTING.
8. MODULE FRAMES SHALL BE GROUNDED AT THE UL-LISTED LOCATION PROVIDED BY THE MANUFACTURER USING UL LISTED GROUNDING HARDWARE.
9. MODULE FRAMES, RAIL, AND POSTS SHALL BE BONDED WITH EQUIPMENT GROUND CONDUCTORS.

JURISDICTION NOTES

22-101076 REV 01 RS

LICENSE

OR # 180498
RGC, CGC1

MODULE GROUNDING METHOD: ZEP SOLAR


AHJ: Portland

UTILITY: Portland General Electric

GENERAL NOTES

1. ALL WORK TO BE DONE TO THE 2019 OSSC AND 2018 IBC.
2. ALL ELECTRICAL WORK SHALL COMPLY WITH THE CURRENT NATIONAL ELECTRIC CODE AS AMENDED BY THE OREGON ELECTRICAL SPECIALTY CODE.

VICINITY MAP

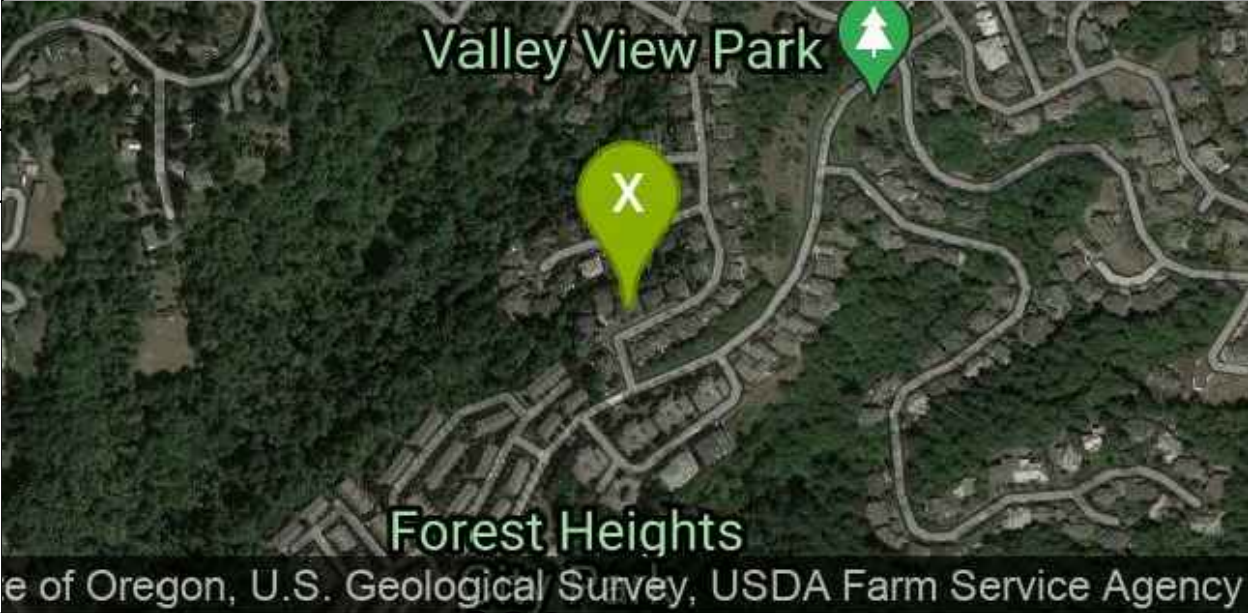

INDEX

Sheet 1	COVER SHEET
Sheet 2	PROPERTY PLAN
Sheet 3	SITE PLAN
Sheet 4	STRUCTURAL VIEWS
Sheet 5	UPLIFT CALCULATIONS
Sheet 6	ELEVATION
Sheet 7	THREE LINE DIAGRAM
Sheet 8	ELECTRICAL CALCULATIONS
Cutsheets Attached	

REV	BY	DATE	COMMENTS
REV A	RE	1/06/2022	Revised formatting details
REV B	IFT	1/24/2022	Mp tags on site plan now showing MP tags on sideviews
REV C	RE	2/13/22	Updated FSB
REV D	RE	4/13/22	SWAPPED MODULES/UPDATED TIE-IN
*	*	*	*

CONFIDENTIAL - THE INFORMATION HEREIN CONTAINED SHALL NOT BE USED FOR THE BENEFIT OF ANYONE EXCEPT TESLA INC., NOR SHALL IT BE DISCLOSED IN WHOLE OR IN PART TO OTHERS OUTSIDE THE RECIPIENT'S ORGANIZATION, EXCEPT IN CONNECTION WITH THE SALE AND USE OF THE RESPECTIVE TESLA EQUIPMENT, WITHOUT THE WRITTEN PERMISSION OF TESLA INC.

JOB NUMBER: JB-9725833 00

MOUNTING SYSTEM: ZS Comp V4 w Flashing-Insert

MODULES: (27) Tesla # T400H

INVERTER: Powerwall 1 (240V) #1850000-00-C / PVI Assy. 1538000-25-F

CUSTOMER: David Valdovinos
3035 NW Spencer St
Portland, OR 97229

15037039168

DESCRIPTION: 10.8 KW PV ARRAY
27 KWH ENERGY STORAGE SYSTEM

PAGE NAME: COVER SHEET

DESIGN: Rodrigo Elvira


SHEET: 1 REV: d DATE: 4/13/2022

TESLA

City of Portland
REVIEWED FOR CODE COMPLIANCE



Date: 05/24/22

Permit #: 22-101076-REV-01-RS

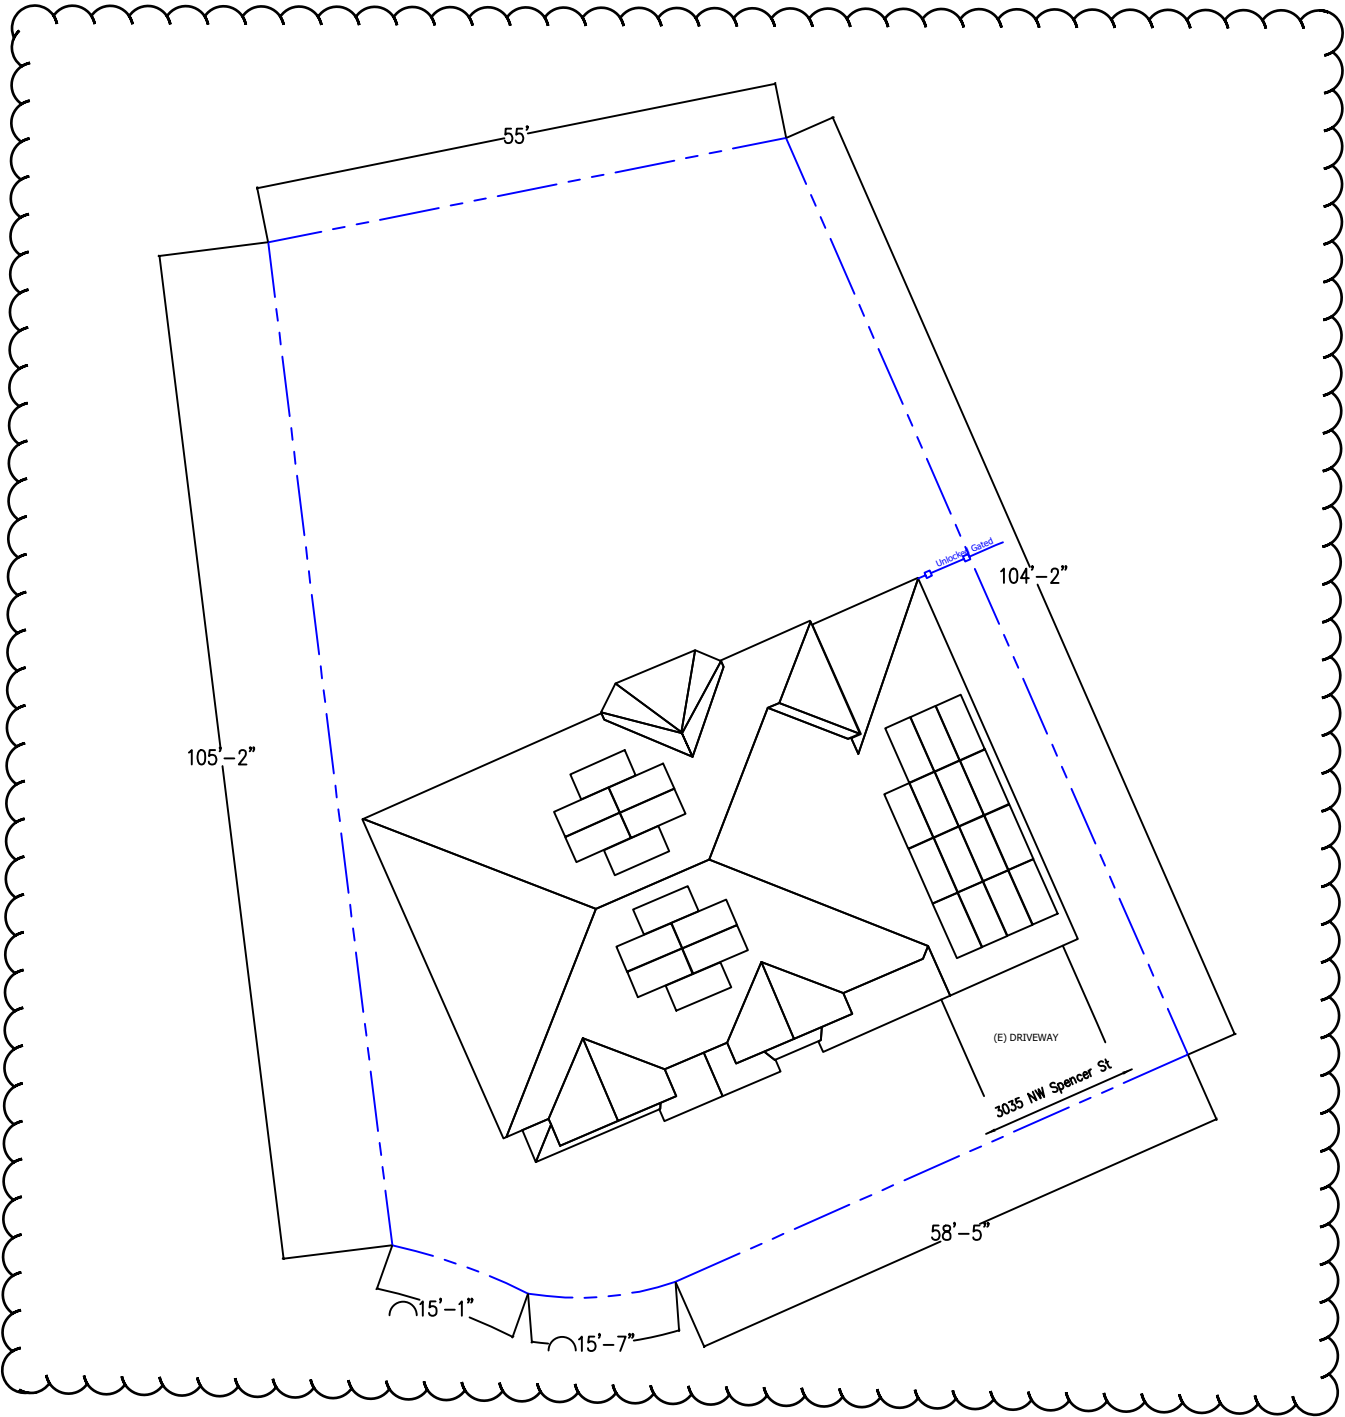

PROPERTY PLAN

Scale: 1" = 20'-0"

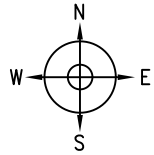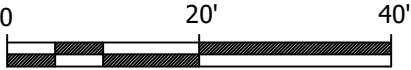

CONFIDENTIAL – THE INFORMATION HEREIN CONTAINED SHALL NOT BE USED FOR THE BENEFIT OF ANYONE EXCEPT TESLA INC., NOR SHALL IT BE DISCLOSED IN WHOLE OR IN PART TO OTHERS OUTSIDE THE RECIPIENT'S ORGANIZATION, EXCEPT IN CONNECTION WITH THE SALE AND USE OF THE RESPECTIVE TESLA EQUIPMENT, WITHOUT THE WRITTEN PERMISSION OF TESLA INC.

JOB NUMBER: JB-9725833 00
MOUNTING SYSTEM: ZS Comp V4 w Flashing-Insert
MODULES: (27) Tesla # T400H
INVERTER: Powerwall+ [240V] #1850000-00-C / PVI Assy. 1538000-25-F

CUSTOMER: David Valdovinos
3035 NW Spencer St
Portland, OR 97229

15037039168

DESCRIPTION: 10.8 KW PV ARRAY
27 KWH ENERGY STORAGE SYSTEM

PAGE NAME: PROPERTY PLAN

DESIGN: Rodrigo Elvira


SHEET: 2 REV: DATE: d 4/13/2022



City of Portland
REVIEWED FOR CODE COMPLIANCE

Date: 05/24/22

Permit #: 22-101076-REV-01-RS

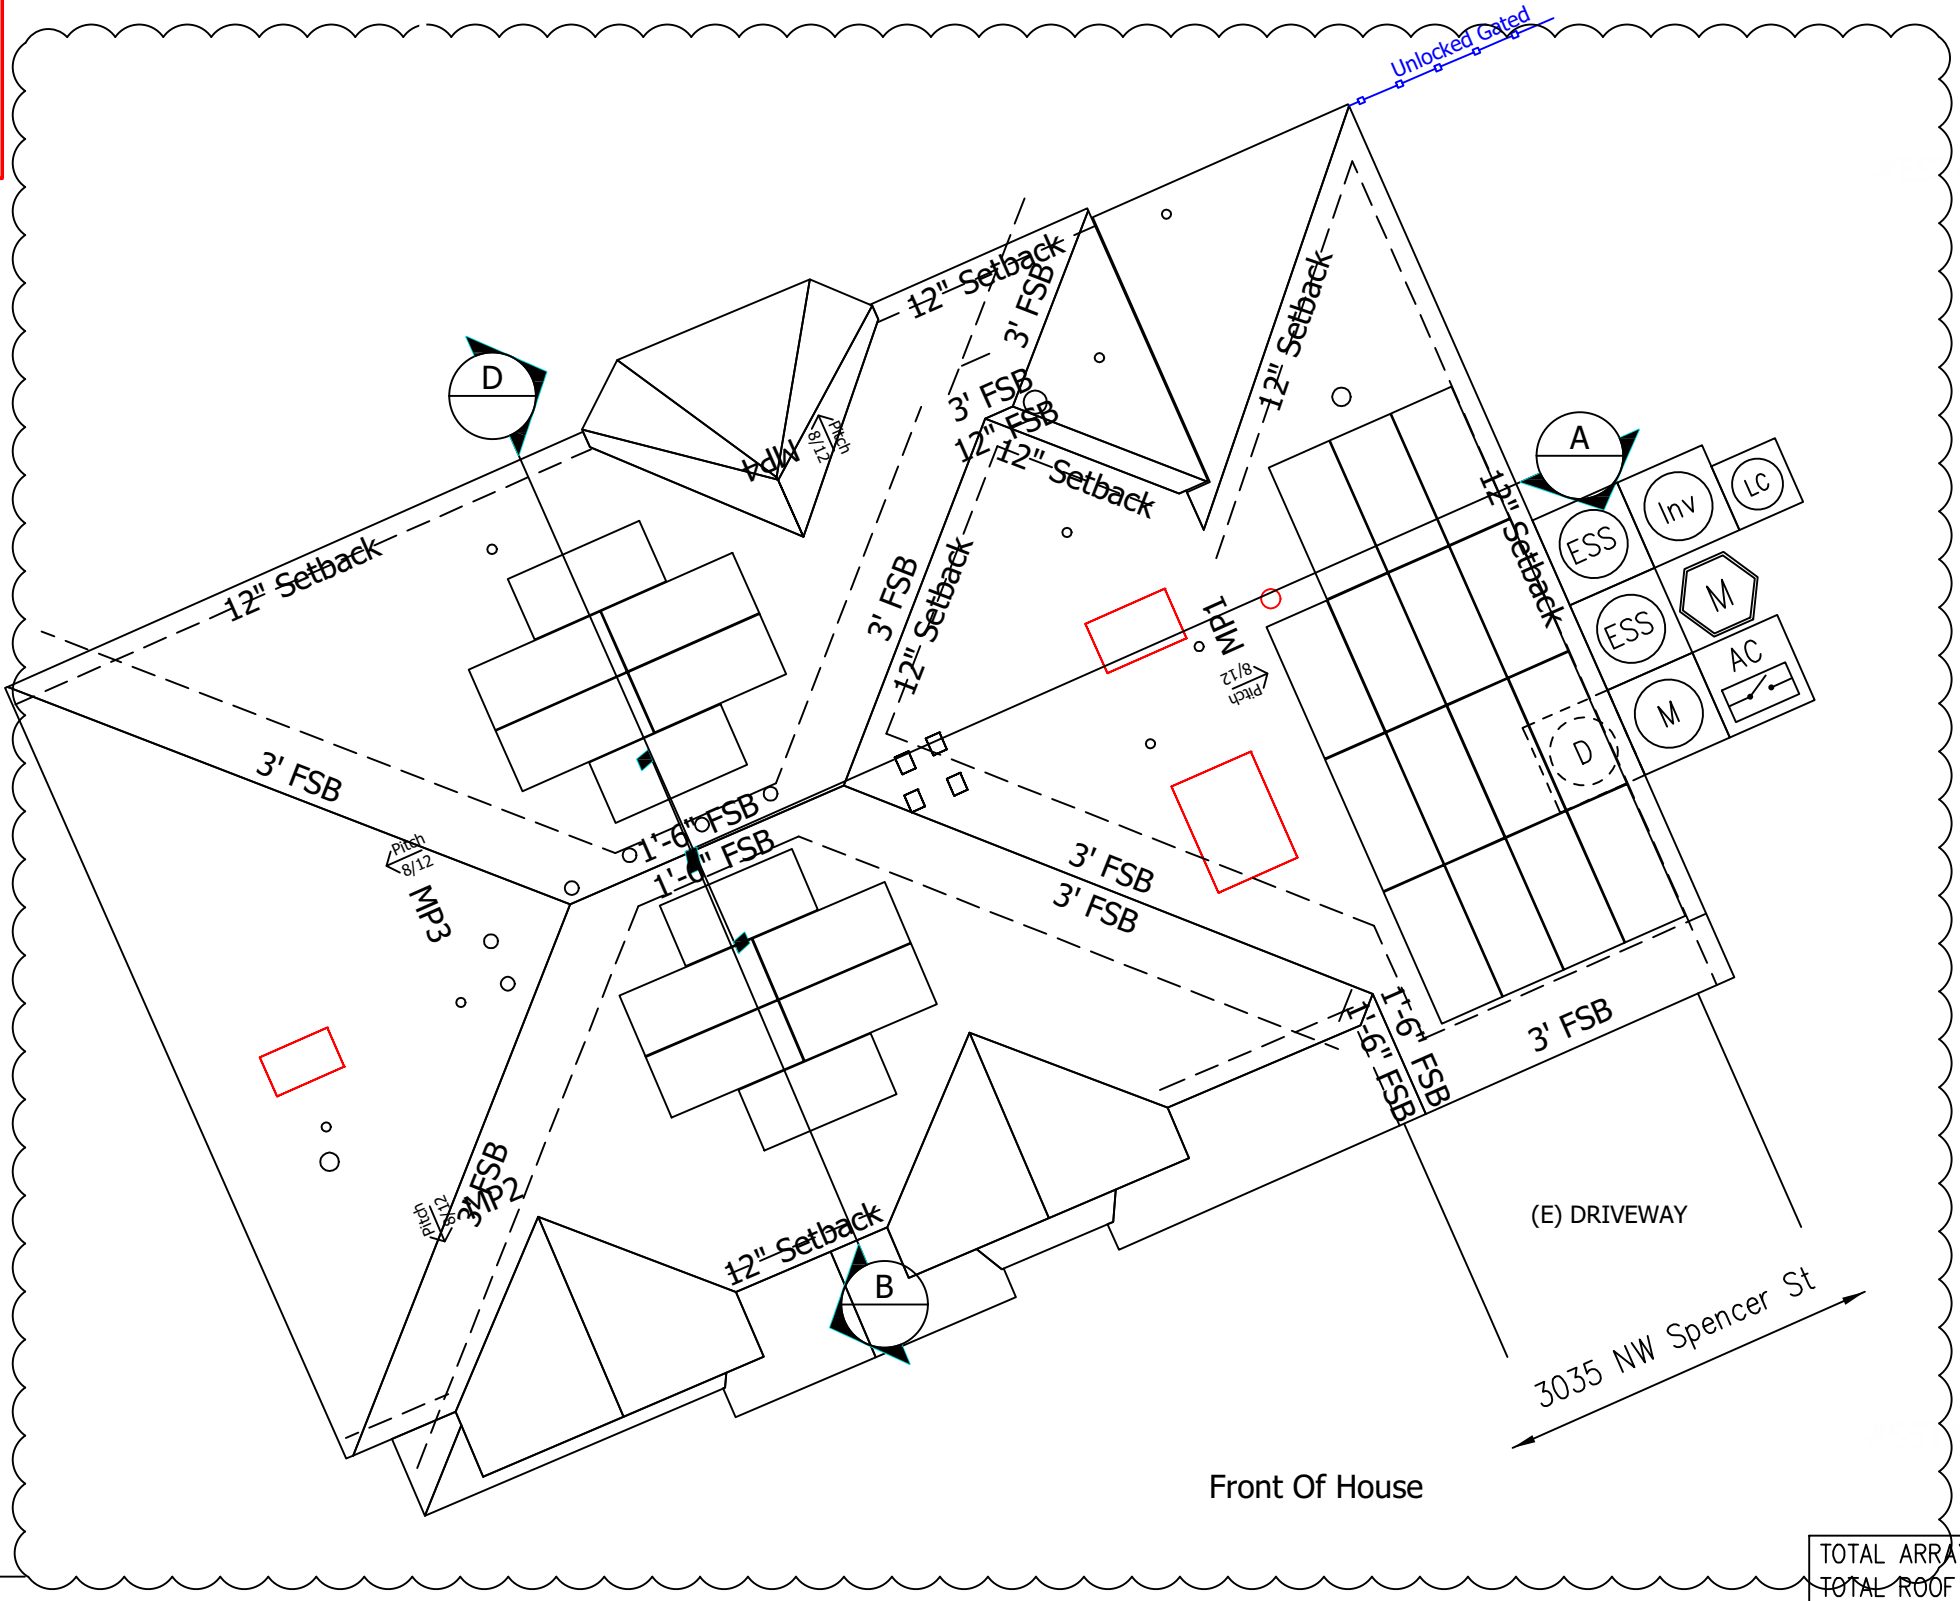


MP1	PITCH: 34° (8:12) ARRAY PITCH: 34° (8:12) AZIMUTH: 66 ARRAY AZIMUTH: 66 MATERIAL: Comp Shingle STORY: 2 Stories
MP2	PITCH: 34° (8:12) ARRAY PITCH: 34° (8:12) AZIMUTH: 157 ARRAY AZIMUTH: 157 MATERIAL: Comp Shingle STORY: 2 Stories
MP3	PITCH: 34° (8:12) ARRAY PITCH: 34° (8:12) AZIMUTH: 246 ARRAY AZIMUTH: 246 MATERIAL: Comp Shingle STORY: 2 Stories
MP4	PITCH: 34° (8:12) ARRAY PITCH: 34° (8:12) AZIMUTH: 336 ARRAY AZIMUTH: 336 MATERIAL: Comp Shingle STORY: 2 Stories

LEGEND

- (E) UTILITY METER & WARNING LABEL
- INVERTER W/ INTEGRATED DC DISCO & WARNING LABELS
- AUTOMATIC RELAY
- DC DISCONNECT & WARNING LABELS
- AC DISCONNECT & WARNING LABELS
- DC JUNCTION/COMBINER BOX & LABELS
- ENERGY STORAGE SYSTEM FOR STAND ALONE OPERATION
- DISTRIBUTION PANEL & LABELS
- LOAD CENTER & WARNING LABELS
- DEDICATED PV SYSTEM METER
- RAPID SHUTDOWN
- STANDOFF LOCATIONS
- CONDUIT RUN ON EXTERIOR
- CONDUIT RUN ON INTERIOR
- GATE/FENCE
- HEAT PRODUCING VENTS ARE RED
- INTERIOR EQUIPMENT IS DASHED

SITE PLAN

Scale: 3/32" = 1'

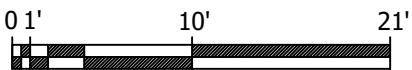

TOTAL ARRAY AREA (SF): 585
TOTAL ROOF AREA (SF): 3132
TOTAL ARRAY AREA IS ~ 18.69
PERCENT OF TOTAL ROOF AREA

CONFIDENTIAL – THE INFORMATION HEREIN CONTAINED SHALL NOT BE USED FOR THE BENEFIT OF ANYONE EXCEPT TESLA INC., NOR SHALL IT BE DISCLOSED IN WHOLE OR IN PART TO OTHERS OUTSIDE THE RECIPIENT'S ORGANIZATION, EXCEPT IN CONNECTION WITH THE SALE AND USE OF THE RESPECTIVE TESLA EQUIPMENT, WITHOUT THE WRITTEN PERMISSION OF TESLA INC.

JOB NUMBER: JB-9725833 00
MOUNTING SYSTEM: ZS Comp V4 w Flashing-Insert
MODULES: (27) Tesla # T400H
INVERTER: Powerwall+ [240V] #1850000-00-C / PVI Assy. 1538000-25-F

CUSTOMER: David Valdovinos
3035 NW Spencer St
Portland, OR 97229
15037039168


DESCRIPTION: 10.8 KW PV ARRAY
27 KWH ENERGY STORAGE SYSTEM
PAGE NAME: SITE PLAN

DESIGN: Rodrigo Elvira

SHEET: 3
REV: d
DATE: 4/13/2022



MAIN PANEL SPECS		GENERAL NOTES	PRODUCT SPECS	MODULE SPECS	LICENSE
Panel Number: Meter Number: 24 314 872 Underground Service Entrance		Inv 1: DC Ungrounded	1 - (1) Powerwall+ [240V] #1850000-00-C / PVI Assy. 1538000-25-F	- (27) Tesla # T400H PV Module, 400W, 371.5 PTC, 40MM, Black Frame, MC4/MC4-EV02, ZEP, 1000V Voc: 45.3 Vpmax: 37.13 Isc AND Imp ARE SHOWN IN THE DC STRINGS IDENTIFIER	OR # 180498 RGC, CGC1
			2		
			3		

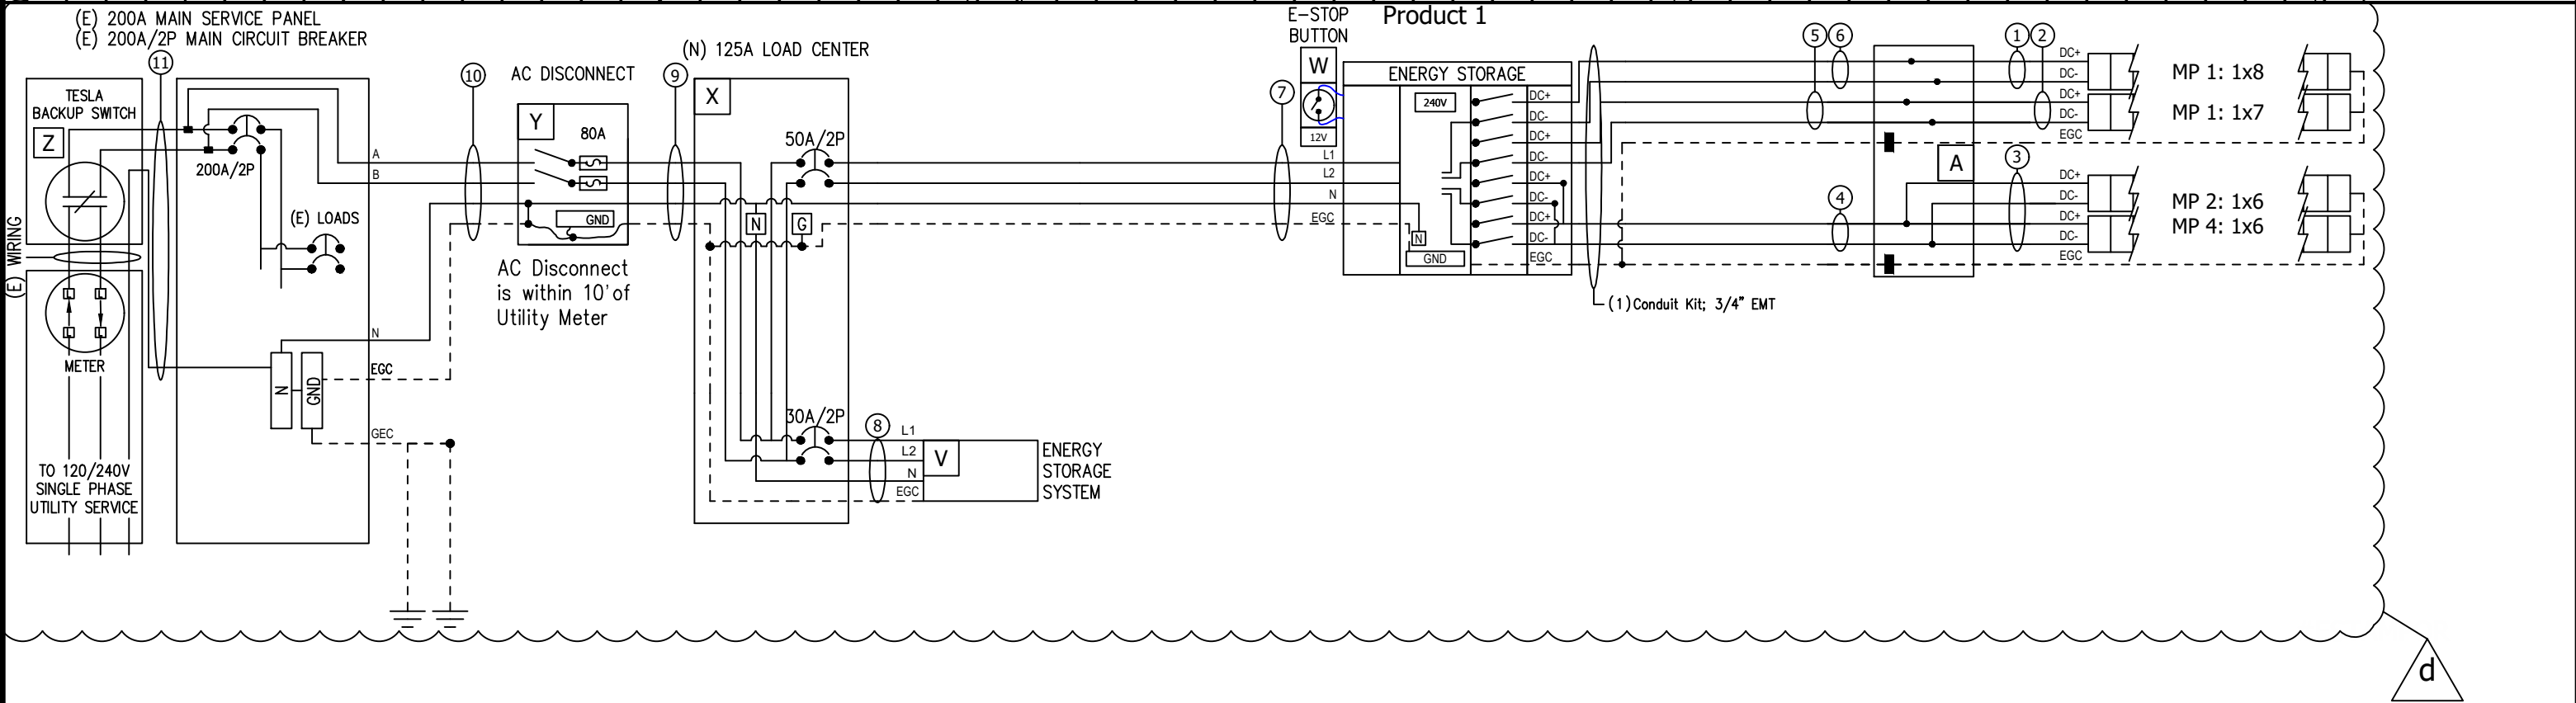

Voc* = MAX VOC AT MIN TEMP

POI	(2) Ground Rod 5/8" x 8", Copper	7	(1) AWG #8, THWN-2, Black	(1) AWG #8, THWN-2, White	AC	V	(1) 3012170-10-B ASY, AC POWERWALL 2.1, 5KW, 13.5KWH, M48	A	(1) Tesla 4J 4-STRING JUNCTION BOX UNFUSED, GROUNDED, Black, Diag DIN Rail with Bracket/ Cord Grip	DC				
	(2) ILSCO # IPC 4/0-2/0 Insulation Piercing Connector; Main 4/0-2, Tap 2/0-6		(1) AWG #8, THWN-2, Red	(1) AWG #10, THWN-2, Green			EGC Vmp = 240 VAC Imp= 32 AAC		PV		(10) Tesla MCI, 650V, 12A			
Z	(1) 1624171-00-G Backup Switch	8	(1) AWG #10, THWN-2, Black											
Y	(1) Eaton 204 MS68 B-Line Meter Socket, 200A, AW Hub top, Overhead, 4 jaws, Ring type		(1) AWG #10, THWN-2, Red											
	(1) CUTLER-HAMMER # DS36FK Class R Fuse Kit	9	(1) AWG #10, THWN-2, White	(1) Conduit Kit; 3/4" EMT										
X	(2) FERRAZ SHAWMUT # TR80R Fuse; 80A, 250V, Class RK5		(1) AWG #4, THWN-2, Black											
	(1) CUTLER-HAMMER # DG100NB Ground/Neutral Kit; 60-100A, General Duty (DG)	10	(1) AWG #4, THWN-2, Red	(1) Conduit Kit; 1-1/4" EMT			4	50FT	(1) AWG #8, THWN-2, Black	Voc* = 299.93VDC Isc = 22.28 ADC	1	50FT	(2) PV Wire, AWG 10	Voc* = 399.91 VDC Isc = 11.14 ADC
W	(1) CUTLER-HAMMER # DG223NRB Disconnect; 100A, 240Vac, Fusible, NEMA 3R		(1) AWG #8, THWN-2, Green						(1) AWG #8, THWN-2, Red	Vmp = 222.78VDC Imp= 21.54 ADC			(1) AWG #10, THHN/THWN-2, Green	EGC (1) Conduit Kit; 3/4" EMT
	(1) SQUARE D # HOM1224L125PRB Load Center; 125A, Convertible, NEMA 3R, 12sp/24Cir, 120v/240v, 10kAIC, Surface	11	(1) AWG #4, THWN-2, Black				5	50FT	(1) AWG #10, THWN-2, Black	Voc* = 349.92VDC Isc = 11.14 ADC	2	50FT	(2) PV Wire, AWG 10	Voc* = 349.92VDC Isc = 11.14 ADC
(1) SQUARE D # HOM250 Breaker; 50A/2P, 2 Spaces	(1) AWG #4, THWN-2, Red			(1) AWG #10, THWN-2, Red					Vmp = 259.91 VDC Imp= 10.77 ADC	(1) AWG #10, THHN/THWN-2, Green			EGC (1) Conduit Kit; 3/4" EMT	(1) AWG #10, Solid Bare Copper
	(1) SQUARE D # HOM230 Breaker; 30A/2P, 2 Spaces		(1) AWG #4, THWN-2, White	(1) Conduit Kit; 1" EMT			6	50FT	(1) AWG #10, THWN-2, Black	Voc* = 399.91 VDC Isc = 11.14 ADC	3	50FT	(4) PV Wire, AWG 10	Voc* = 299.93VDC Isc = 11.14 ADC
			(1) AWG #8, THWN-2, Green						(1) AWG #10, THWN-2, Red	Vmp = 297.04VDC Imp= 10.77 ADC			(1) AWG #10, THHN/THWN-2, Green	EGC (1) Conduit Kit; 3/4" EMT
	(1) UL 508 Emergency Stop Device - NEMA 4X		(3) AWG #3/0, THWN-2, Black											
			(1) AWG #6, THWN-2, Green											
			(1) Conduit 2" PVC; Schedule 80											

CONFIDENTIAL - THE INFORMATION HEREIN CONTAINED SHALL NOT BE USED FOR THE BENEFIT OF ANYONE EXCEPT TESLA INC., NOR SHALL IT BE DISCLOSED IN WHOLE OR IN PART TO OTHERS OUTSIDE THE RECIPIENT'S ORGANIZATION, EXCEPT IN CONNECTION WITH THE SALE AND USE OF THE RESPECTIVE TESLA EQUIPMENT, WITHOUT THE WRITTEN PERMISSION OF TESLA INC.	JOB NUMBER: JB-9725833 00	CUSTOMER: David Valdovinos 3035 NW Spencer St Portland, OR 97229 15037039168	DESCRIPTION: 10.8 KW PV ARRAY 27 KWH ENERGY STORAGE SYSTEM PAGE NAME: THREE LINE DIAGRAM	DESIGN: Rodrigo Elvira SHEET: 7 REV: d DATE: 4/13/2022	TESLA
	MOUNTING SYSTEM: ZS Comp V4 w Flashing-Insert				
	MODULES: (27) Tesla # T400H				
	INVERTER: Powerwall+ [240V] #1850000-00-C / PVI Assy. 1538000-25-F				

ELECTRICAL CALCULATIONS

Module:27Tesla:T400H371.5Inv PowerWPTC

Inverter 1:1Tesla Powerwall+ (Controller)0.9876009779.74

Module: Tesla:T400H371.5

Inverter 2:

Module: Tesla:T400H371.5

Inverter 3:

Module: Tesla:T400H371.5

Inverter 4:

Total:27ModulesTotal Inv Pwr:76009779.74PTC

Photovoltaic Module Electrical Specifications:

Voc:45.3Vdeg Fdeg C

Vmp:37.13V

Isc:11.14ARecord Low Temp:8-13.33

Imp:10.77AMax Average Hi Temp:8127.22

Tvoc:-0.12V/deg CRecord Hi Temp:10842.22

Tisc:4.46mA/deg C

String Type A and 2 Combined Strings Type A

Voc Correction Method:Manuf TVoc Data

Tesla Powerwall+ (Controller)

8Tesla:T400H

Voc=362.4

Vmp=297.04

Isc=11.14

Imp=10.77

Icont=13.92

Voc Correction Factor:

Inverter Min Vdc Input:57

Min Vmp at Max Temp:259.45

Max Voc at Min Temp:399.91

Inverter Max Vdc Input:600

Max String Size:12

1-way wire length:50

Art 690.8(A)(1)

1.aConductor:AWG #10PV Wire

Icont * 1.25 = (Amps)

30 deg C ampacity =

17.41

40

1.bIcont= (Amps)13.92

Start ampacity

Temperature derate (%=F)

Conduit fill derate (%=#)

Derated ampacity

40

0.82

1

32.8

1.cIcont * 1.25 = (Amps)17.41

Ampacity

40

1.dIcont * 1.25 = (Amps)17.41

OCP Size =

20

Inverter Type A Output

Tesla Powerwall+ (Controller)

1 way wire length:10ft

Icont =32A

Art 690.8(A)(1)

3.aIcont * 1.25 = (Amps)40

OCP Size =

40

Art 690.8(B)(1)

Art 240.6(A)

3.bConductor:AWG #8THWN-2 at 90 deg C: Table 310.16

Icont * 1.25 = (Amps)

30 deg C ampacity =

40

55

3.cIcont = (Amps)32

Start ampacity

Temperature derate (%=F)

Conduit fill derate (%=#)

Derated ampacity

55

0.91

1

50.05

3.dIcont * 1.25 = (Amps)40

Ampacity

50

Branch Circuit Type A

1 way wire length:50

2strings per branch 1

1strings per branch 2

6modules per series string

8modules per series string

Voc=271.8V

Vmp=222.78V

Isc=22.28A

Imp=21.54A

Icont=27.85A

Voc=362.4V

Vmp=297.04V

Isc=11.14A

Imp=10.77A

Icont=13.92A

Art 690.8(A)(1)

2.aConductor 1:AWG #8

Conductor 2:AWG #10

Conductor 1

Conductor 2

Icont * 1.25 = (Amps)

30 deg C ampacity =

34.81

17.41

55

40

2.bIcont= (Amps)27.85

Start ampacity

Temperature derate (%=F)

Conduit fill derate (%=#)

Derated ampacity

55

0.82

0.8

36.08

26.24

2.cTemp table90 °C: Table 310.15(B)(1)

Icont*1.25= (Amps)

Ampacity

34.81

17.41

55

40

2.dOCP Size =3520

Combined Inverter Output

Service Voltage=

Total Inverter Power=

Icont = # of inverters*max inverter current

Icont = (Amps)

1 way wire length=10

Art 690.8(A)(1)

4.aIcont*1.25 = (Amps)40

OCP size =

40

Art 690.8(B)(1)

Art 240.6(A)

4.bConductor:AWG #8THWN-2 at 90 deg C: Table 310.16

Icont * 1.25 = (Amps)

30 deg C ampacity =

40

55

4.cIcont = (Amps)32

Start ampacity

Temperature derate (%=F)

Conduit fill derate (%=#)

Derated ampacity

55

0.91

1

50.05

4.dIcont * 1.25 = (Amps)40

Ampacity

50

Version 5_8.0

Voltage Drop Calculations

Vdrop = (Imp) * (2 * Length) * (Resistance) / (Vmp)

Imp (A)

Max. Length (ft)

Wire

10.77

20

AWG #10

String: at Max Ave Hi:81deg F

Vdrop = (10.77 40 0.00124 Ohms) / 259.45 0.21

Branch: (10.77 50 0.00124 Ohms) / 297.04 0.51deg F

Vdrop = (10.77 100 0.00124 Ohms) / 297.04 0.51

Total voltage drop in DC conductors =0.72

Inverter: (32 10 AWG #8) at 240V

Vdrop = (32 20 0.00078 Ohms) / 240 V 0.07

Combined: at 240V

Vdrop = Ohms) / 240 V

Total voltage drop in AC conductors =0.07

Total voltage drop in AC and DC conductors =

CONFIDENTIAL – THE INFORMATION HEREIN CONTAINED SHALL NOT BE USED FOR THE BENEFIT OF ANYONE EXCEPT TESLA INC., NOR SHALL IT BE DISCLOSED IN WHOLE OR IN PART TO OTHERS OUTSIDE THE RECIPIENT'S ORGANIZATION, EXCEPT IN CONNECTION WITH THE SALE AND USE OF THE RESPECTIVE TESLA EQUIPMENT, WITHOUT THE WRITTEN PERMISSION OF TESLA INC.

JOB NUMBER: JB-9725833 00

MOUNTING SYSTEM:
ZS Comp V4 w Flashing-Insert

MODULES:
(27) Tesla # T400H

INVERTER:
Powerwall+ [240V] #1850000-00-C / PVI Assy. 1538000-25-F

CUSTOMER:
David Valdovinos
3035 NW Spencer St
Portland, OR 97229

15037039168

DESCRIPTION:
10.8 KW PV ARRAY
27 KWH ENERGY STORAGE SYSTEM

PAGE NAME:
ELECTRICAL CALCULATIONS

DESIGN:
Rodrigo Elvira

SHEET: 8
REV: d
DATE: 4/13/2022





POST IN CLEAR VIEW AND IN ACCESSIBLE LOCATION

Request an inspection call: 503-823-7000 for automated inspection request line. TTY: 503-823-6868

Residential Inspection Record Card

DO NOT POUR ANY CONCRETE UNTIL THE NEEDED INSPECTIONS BELOW HAVE BEEN SIGNED

Building	IVR#	App by	Date	Inspector's Notes	App By	Date	Plbg/Elec/Mech/Spec	IVR#
Tree Preservation	507						Grounding Electrode	227
Erosion Control	200						Radon Mitigation	238
Setbacks	215						Waterproofing	245
Footings	220						Reinforcing/Masonry	250
Foundation Wall	225						Underslab Plumbing	305
Reinforcing/Concrete	230						Oil Tank Pad	670
Concrete Slab	235						Electrical Temp. Service	115
BES Storm Eval	487							

For Demolition Permits - below inspections must be signed before Demo Permit can be Finaled

Demolition	288						Decomm. Septic Sys.	842
Sewer Cap	360						Other	295

POST & BEAM - Do not install sub floor until the needed inspections have been Approved and Signed

Post & Beam Struct.	240						Post & Beam Plbg.	300
Other	295						Post & Beam Mec.	600

Rough Inspections must be inspected and approved prior to Framing Inspection requested

Interim EC	205						Perm. Electrical Service	120
Shearwall	260						Rough Electrical	105
Firewall	265						Rough Plumbing	310
Fire Sprinklers	320						Shower Pan	315
Framing	270			<input type="checkbox"/> M.C.			Gas Line	605
Fireplace	255						Green Tag	615
Roofing	285						Rough Mech.	620

Insulation - Do not cover until Insulation is Approved and Signed

Insulation	280							
------------	-----	--	--	--	--	--	--	--

Ground Utilities

Sanitary Sewer	350						Storm Sewer	355
Water Service	345						Rain Drains	365
Backflow Device	335						Other	295

Final Inspections - Have all other Final Inspections approved and signed prior to requesting 999

Permanent EC	210						Mechanical Final	699
Electrical Final	199						Grading Final	990
Structural Final	299			<input type="checkbox"/> H.E.L			Final Permit	999
Plumbing Final	399							

☐ Okay to Occupy ☐ Do Not Occupy until the needed inspections above have been approved and signed

IVR #:

Address:

Notes:

Development Services Approval:

For a Stormwater Treatment Facility inspection call 503-823-7761 or use IVR # 487.

Contact Us:

1900 SW 4th Avenue
Portland, OR 97201

Phone: 503-823-7300
TTY: 503-823-6868

www.portlandoregon.gov/bds

Residential Inspections: 503-823-7388

Urban Forestry: 503-823-8733

Permitting Services: 503-823-7357

Planning and Zoning: 503-823-7526

Mechanical, Electrical, Plumbing
Sign Permits: 503-823-7363

Permit Status via voicemail: 503-823-7000 (4)

Work related to this Building Permit may be subject to regulations governing the removal, handling, and/or disposal of asbestos and/or lead-based paint. For Asbestos concerns: Contact DEQ: **1-888-997-7888**; Lead-base paint concerns: Contact Oregon Health Authority: **971-673-0440**.

BEFORE YOU DIG

ATTENTION: Oregon law requires you to follow rules adopted by the Oregon Utility Notification Center. Those rules are set forth in OAR 952-001-0010 through OAR 952-001-0090. Call 1-800-332-2344 for locates.

Homeowner:

This is your Record of Permits and Inspections and should be kept with your permanent records.

This permit will expire if 180 days pass without an approved inspection. A permit can be extended one time only. Call for questions 503-823-7388.

If Special Inspections (i.e. adhesive anchors, soils, concrete construction) are required, a Special Inspection Final Summary Report must be submitted and approved prior to requesting a Final Permit Inspection #999.

To help ensure equal access to City programs, services and activities, the City of Portland will provide translation, reasonably modify policies/procedures and provide auxiliary aids/services/alternative formats to persons with disabilities. For accommodations, translations, complaints, and information, call 503-823-7300, TTY 503-823-6868, use Oregon Relay Service: 711, come to 1900 SW 4th Ave, 5th Floor, Portland, OR 97201, or email bds@portlandoregon.gov.

Subcontractor Permit Information Process

A Message to the Home Owner and General Contractor about Trade Work Associated with this Project:

As of February 1, 2016 if residential building permit applicants do not have completed/signed trade permit applications (mechanical, electrical, plumbing) for sub-contractors when submitting their building permit application, the trade work will not be included under that permit number and is not eligible to be added to the permit at a later date. The required trade permits must be applied for separately when sub-contractors are hired.

If this is the case for your project BDS recommends you use the space below to record the trade permit number(s) obtained in association with the project. You may also show this card to the BDS inspector who comes to inspect these trade permits and request they note on this record inspection results.

Permit Number	Issued Date	Approved by (Inspector name & date)	Notes

This record of permits and inspection should be kept with your permanent records.

Instructions about the following are available at www.portlandoregon.gov/bds/67391

1. How to request an inspection using the (IVR) system.

2. Accessing and viewing daily on-line Residential Inspection Route slips.

Inspection Request (IVR) Pocket Reference

Dial: 503-823-7000 TTY: 503-823-6868 Press:
1 Schedule an Inspection
2 Cancel or Reschedule an Inspection
(1 & 2 Don't hang up without a confirmation number)
3 Obtain Inspection Results
4 Obtain Plan Review Status via FAX
5 Obtain Fax Back Documents
6 Obtain a List of Scheduled Inspections by IVR Number
0 Speak with Inspection Section regarding your inspection or to obtain your IVR number
* Listen to General Information
Hang Up

If tree preservation is required on your approved plans, approval of inspection #507 is required before requesting further inspections.

Inspection #200 must be in place prior to any ground disturbance activities, and must be requested first when requesting inspection for setbacks, footings and foundation inspections.

Inspection #210 must be approved before permit final approval.

Building	
507	Tree Preservation
200	Pre-Construction Erosion Control
205	Interim Erosion Control
210	Permanent Erosion Control Measures
215	Setbacks
220	Footings
225	Foundation
226	Foundation Drain
227	Grounding Electrode (RS only)
230	Concrete/Reinforcing
235	Slab/Flatwork
238	Radon Mitigation
240	Underfloor/Post & Beam
245	Waterproofing (RS Only)
250	Masonry/Reinforcing
255	Masonry Fireplace
260	Shearwalls (use 270 for CO permits)
261	Reinspection Shearwall (RS Only)
265	Firewall Nailing (use 275 for CO permits)
270	Framing
271	Reinspection Framing (CO & MG Only)
275	Wallboard Attachment
277	Ceiling Grid
280	Insulation/Vapor Barrier
285	Roofing
288	Demolition
290	Temporary Occupancy
295	Other/Consultation
299	Final - Structural (RS Only)
487	BES On-Site Stormwater Facility Eval
510	Tree Preservation/Env Zone
990	Final - Grading (RS Only)
992	Final - Subsurface (RS Only)
999	Final Permits (CO, RS - to final job)

Development Review	
507	Tree Preservation
200	Pre-Construction Erosion Control
210	Permanent EC Measures
487	BES ON-Site Stormwater Facility Eval
555	Code Compliance Inspection
842	Decommission System (Pumped & Filled)
999	Final Permit

Electrical	
105	Rough-in - Electrical
107	Cover Electric In-Floor Heat
110	Underground-Electrical

Electrical, continued	
111	Electrical Service Reconnect
115	Temporary Electrical Service
120	Permanent Electrical Service
125	Low Voltage/Alarm
135	Hot Tub/Spa/Swimming Pool
140	Industrial Plant
145	Circuits/Feeders
150	Generator/Transfer Switch
155	Other/Consultation - Electrical
199	Final - Electrical

Mechanical	
600	Underfloor/Post & Beam, Mechanical
605	New Gas Piping/Pressure Test
610	Extend Gas Piping/Pressure Test
615	Gas Line Tag
617	Hydronic Piping (Closed/Open Loop)
620	Rough-in Mechanical
625	Wood Stove/Pellet Stove/Decorative Appl
630	AC/Furnace/Heat Pump/HVAC
635	Kitchen Exhaust/Commercial Hood
640	Oil Tank
645	Vent/Chimney Liner
650	Other/Consultation- Mechanical
670	Oil Tank Pad
699	Final - Mechanical

Plumbing (RS and PT Permits only)	
300	Post and Beam - Plumbing
305	Underslab/Ground Work - Plumbing
310	Rough-In/Top Out Plumbing
312	Hydronic Piping (Open Loop Only)
315	Shower Pan/Bathtub Test
320	Fire Sprinklers
325	Fixture Cap
330	Drain Reversal
335	Backflow Device (Water Supply)
337	Backwater Valve (Drainage)
340	Water Heater
345	Water Service
350	Sanitary Sewer
355	Storm Sewer
360	Sewer Cap
365	Rain Drains
370	Catch Basin
375	Manhole
380	Detention Facility
390	Dry Well
392	Sewer Connection
395	Soakage Trench
396	Medical Gas/Vacuum System
397	Other/Consultation-Plbg
399	Final - Plumbing

Sanitation Permits

On-Site Sewage Disposal Permit	
800	Initial Advanced Treatment Technology
802	Secondary Adv. Treatment Technology
804	Final Advanced Treatment Technology
806	Alternative System
808	Initial Capping Fill
810	Secondary Capping Fill
812	Final Capping Fill
814	Drainfield
816	Gray Water Sump
818	Initial Holding Tank
820	Secondary Holding Tank
822	Final Holding Tank
824	Pressure Distribution
826	Pumping System
828	Redundant System
830	Initial Sand Filter
832	Secondary Sand Filter
834	Final Sand Filter
836	Septic Tank
838	Steep Slope System/Disposal
840	Tile Dewatering
842	Decommission System (Pumped & Filled)
999	Final Permit

On-Site Sewage Evaluation/Services	
842	Decommission System (Pumped & Filled)
844	Sep. Sys. Pumped/Drain Lines Staked
846	Septic System Staked
848	Test Pits Dug and Flagged

Sewer Permits (UC)	
350	Sanitary Sewer
842	Decommission System (pumped & filled)
399	Final Plumbing

Site Development Permits	
507	Tree Preservation
200	Pre-Construction Erosion Control
205	Interim Erosion Control Inspection
210	Permanent Erosion Control Inspections
487	BES On-Site Stormwater Facility Eval
500	Site Development Inspection
510	Tree Preservation/Env Zone
512	Clearing Limits
514	Landscape Mitigation/Env. Zone Planting
516	Pedestrian Pathway/Trail
518	Retaining Wall Footing
520	Retaining Wall Forms/Reinforcing
522	Site Grading
524	Stormwater Culvert/Riprap
526	Trench Backfill Compaction
530	Private Street Curb Setback
532	Private Street Subgrade
534	Private Street Base Rock
536	Private Street Base Lift
538	Private Street Top Lift
540	Private Street Sidewalk/ADA Ramps
542	Private Street Signage
544	Street Light Base
546	Street Light Pole
550	Private Street Final Inspection
990	Final - Grading
999	Final Permit

Manufactured Homes	
120	Permanent Electrical Service
200	Pre-Construction Erosion Control
210	Permanent Erosion Control measures
227	Grounding Electrode
337	Backwater Valve (Drainage)
487	BES On-Site Stormwater Facility Eval
605	New Gas Piping/Pressure Test
625	Wood Stove/Pellet Stove/Decorative Appl
630	AC/Furnace/Heat Pump/HVAC
700	Footing Form/Okay to Pour
706	Foundation Blocking
708	Tie Downs
710	Sewer Connection Outside
714	Water Service
716	Electrical Feeder
722	Heating Duct
728	Enclose/Install Perimeter Foundation
730	Perimeter Foundation
740	Rain Drain System
742	Stormwater Disposal
756	Garage/Carport Final
299	Final - Building
199	Final - Electrical
699	Final - Mechanical
399	Final - Plumbing
999	Final Permit

Zoning (ZP Permits)	
487	BES On-Site Stormwater Facility Eval
555	Final - Code Compliance Inspection

Sign Permits	
400	Sign Footings
405	Electrical Service - Sign
410	Sign Structure
999	Final Permit

Miscellaneous	
440	Adult Care License