

Development Services

From Concept to Construction

Phone: 503-823-7300 Email: bds@portlandoregon.gov 1900 SW 4th Ave, Portland, OR 97201

More Contact Info (<http://www.portlandoregon.gov/bds/article/519984>)



APPEAL SUMMARY

Status: Hold for Additional Information

Appeal ID: 18780	Project Address: 7759 NE Mary Olson Way
Hearing Date: 12/19/18	Appellant Name: Wesley Tafoya
Case No.: B-002	Appellant Phone: 650-874-8592
Appeal Type: Building	Plans Examiner/Inspector: Terry Whitehill
Project Type: commercial	Stories: 1 Occupancy: S-1 Construction Type: II-B
Building/Business Name: United Air Lines	Fire Sprinklers: Yes - in service areas, foam in hangar area
Appeal Involves: other: Acceptance of existing building constructed as maintenance hangar for national guard	LUR or Permit Application No.: Acceptance of existing building constructed as maintenance hangar for national guard
Plan Submitted Option: pdf [File 1]	Proposed use: Maintenance Hangar

APPEAL INFORMATION SHEET

Appeal item 1

Code Section	OSSC
Requires	Proposal to accept the existing construction as code compliant structure.
Proposed Design	<p>Proposal to accept the existing construction as code compliant structure. See attached PDF scans of original design drawings.</p> <p>Shell construction is precast concrete walls with metal siding finish, metal siding walls and standing seam roofing.</p>
Reason for alternative	Building was constructed as a National Guard Facility. It was not processed through the city permit process.

APPEAL DECISION

Determination of existing construction of National Guard hangar as code compliant structure: Hold for additional information.

Appellant may contact John Butler (503 823-7339) with questions.

ABBREVIATIONS	TITLE	EDITION
AISC	SEISMIC PROVISIONS FOR STRUCTURAL STEEL BUILDINGS	
ASCE 7-98	MINIMUM DESIGN LOADS FOR BUILDINGS AND OTHER STRUCTURES	
NFPA 10	STANDARD FOR PORTABLE FIRE EXTINGUISHERS	2010
NFPA 13	STANDARD FOR THE INSTALLATION OF SPRINKLER SYSTEMS	2010
NFPA 72	NATIONAL FIRE ALARM AND SIGNALING CODE	2017
IBC	INTERNATIONAL BUILDING CODE	2000
TI 800-1	CORPS OF ENGINEERS DESIGN CRITERIA	
TI 809-04	SEISMIC DESIGN FOR BUILDINGS	
TI 809-07	DESIGN OF COLD-FORMED LOAD BEARING STEEL SYSTEMS AND MASONRY VENEER/ STEEL STUD WALLS	
TI 809-26	WELDING - DESIGN PROCEDURES AND INSPECTIONS	
TI 809-27	CONCRETE FLOOR SLAB ON GRADE SUBJECTED TO HEAVY LOADS	
TI 809-29	STRUCTURAL CONSIDERATIONS FOR METAL ROOFING	
TI 809-30	METAL BUILDING SYSTEMS	
TI 809-52	COMMENTARY ON SNOW LOADS	
TI 809-53	SELECTION CONSIDERATION FOR ROOFING SYSTEMS	
UFC 3-310-01	LOAD ASSUMPTIONS FOR BUILDINGS	
UFC 4-211-01	AIRCRAFT MAINTENANCE HANGARS	

BUILDING ELEMENT	TYPE OF CONSTRUCTION	FIRE RESISTANCE RATING
PRIMARY STRUCTURAL FRAME	II B. SPRINKLERED	0 HR ***
BEARING EXTERIOR WALL	II B. SPRINKLERED	0 HR **
BEARING INTERIOR WALL	II B. SPRINKLERED	0 HR *
NON-BEARING EXTERIOR WALL	II B. SPRINKLERED	0 HR **
NON-BEARING INTERIOR WALL	II B. SPRINKLERED	0 HR *
FLOOR CONSTRUCTION INCLUDING SUPPORTING BEAMS AND JOISTS	II B. SPRINKLERED	0 HR *
ROOF CONSTRUCTION INCLUDING SUPPORTING BEAMS AND JOISTS	II B. SPRINKLERED	0 HR

* EXCEPT AS REQUIRED FOR OCCUPANCY SEPARATION, INCIDENTAL USE, AND OTHER PASSIVE FIRE PROTECTION.
 ** EXCEPT AS REQUIRED FOR BUILDING SEPARATION.
 *** EXCEPT AS REQUIRED TO SUPPORT HORIZONTAL ASSEMBLY (IBC 714.4)

AREAS	OCCUPANCY	IBC
OFFICE, CIRCULATION, RESTROOMS, LOBBY, TRAINING	BUSINESS, GROUP B	304.1
AIRCRAFT HANGAR, STORAGE, PAINT SHOP, FUEL FOAM/STORAGE, JANITOR, TOOL, MECHANICAL ELECTRICAL, TELECOM AND REPAIR	MODERATE-HAZARD STORAGE, GROUP S-1	311.2

FLOOR	FLOOR AREA (SF)	ACCESSORY BUSINESS, GROUP B	ACCESSORY AREA (SF)	PERCENTAGE OF AREA (SUM < 10%)	IBC AREA LIMITATION (SF)
1	33,675		830	3%	3,367

OCCUPANCY	*ALLOWABLE AREA (SF)	FRONTAGE INCREASE (SF)	SPRINKLER INCREASE (SF)	MODIFIED ALLOWABLE AREA (SF)
S-1	17,500	0	52,500	70,000
H-2	7,000	0	21,000	70,000

* FOR NONSEPARATED OCCUPANCIES THE MOST RESTRICTIVE OCCUPANCY LIMITATIONS ARE USED.

FLOOR	FLOOR AREA (SF)	RESTRICTING OCCUPANCY	RESTRICTING OCCUPANCY MODIFIED ALLOWABLE AREA (SF)
LEVEL 1	33,675	S-1	70,000

* FOR NONSEPARATED OCCUPANCIES THE MOST RESTRICTIVE OCCUPANCY LIMITATIONS ARE USED.

OCCUPANCY	*RESTRICTING ALLOWABLE HEIGHT (FT / STORY)	SPRINKLER INCREASE (FT / STORY)	MODIFIED ALLOWABLE HEIGHT (FT / STORY)
S-1	55 / 2	20 / 1	75 / 3

AREA	REQUIRED RATING	CODE
CORRIDOR	0 HOUR BARRIER	NFPA 101 SECTION 12.3.6, 38.3.6, 40.3.6, AND 42.3.6.
HANGAR BAY / ANCILLARY SUPPORT AREAS	2 HR FIRE BARRIER	UFC 4-211-01, 3-3.1.3

OCCUPANCY	ELEVATION	RESTRICTIVE FIRE SEPARATION DISTANCE (FT)*	FIRE RESISTIVE RATING OF EXTERIOR WALL
S-1	NORTH/SOUTH/WEST/EAST	10 < X < 30	NO RATING
H-2	WEST	> 30	NO RATING

* IBC 702 - FIRE SEPARATION DISTANCE = DISTANCE FROM BUILDING'S FACE TO CLOSEST INTERIOR LOT LINE, CENTERLINE OF A STREET ALLEY OR PUBLIC WAY, OR IMAGINARY LINE BETWEEN TWO BUILDINGS.

COMPONENT	FIRE DOOR / SHUTTER ASSEMBLIES	DUCT PENETRATIONS	OTHER PENETRATIONS	IBC
2 HR FIRE BARRIER	1-1/2 HR	1-1/2 HR DAMPER	2 HR	715.4, 716.5.2

FLOOR	AREA	FUNCTION OF SPACE	AREA (SF)	OCCUPANT LOAD FACTOR (SF/PERSON)	OCCUPANTS
1	HANGAR BAY, TUG POCKET	AIRCRAFT HANGAR	27,335	500	55
1	OFFICES, BATHROOMS	BUSINESS AREAS	643	100	7
1	TRAINING ROOM	ASSEMBLY WITHOUT FIXED SEATING	228	15	16
1	PAINT SHOP	MANUFACTURING	944	200	5
1	MECH ROOM, ELEC ROOM, STORAGE, TOOL	ACCESSORY STORAGE	2,101	300	7

FLOOR	GROSS AREA (SF)	OCCUPANTS	REQUIRED EXITS (IBC 1021.1)	REQUIRED EXIT SEPARATION (IBC 1015.2)
1	33,675	90	2	1/3 DIAGONAL

FLOOR / OCCUPANCY	OCCUPANT LOAD PERMITTING ONE EXIT	OCCUPANT LOAD REQUIRING TWO EXITS
LEVEL 1 / B	49 OR LESS	50 OR GREATER
LEVEL 1 / S-1	29 OR LESS	30 OR GREATER
LEVEL 1 / H-2	3 OR LESS	30 OR GREATER

OCCUPANCY	COMMON PATH LIMIT* (IBC 1014.3) (FT)	DEAD END LIMIT* (IBC 1018.4) (FT)	TRAVEL DISTANCE LIMIT* (IBC 1016.2) (FT)
B	100	50	300
S-1	100	50	250
H-2	25	20	100

COMPONENT	REQUIREMENT	WIDTH (IN)	IBC
DOORS IN EGRESS ACCESS	PER COMPONENT	32	1008.1.1
CORRIDOR SERVING LESS THAN 50 OCCUPANTS	PER COMPONENT	36	1018.2
CORRIDOR FOR ACCESS TO ELECTRICAL/MECHANICAL SYSTEMS	PER COMPONENT	24	1018.2
OTHER EGRESS COMPONENTS	PER PERSON	0.2	1005.1

OCCUPANCY	EXIT ENCLOSURE AND EXIT PASSAGEWAYS	CORRIDORS	ROOMS AND ENCLOSED SPACES
B, S-1	CLASS C	CLASS C	CLASS C
H-2	CLASS B	CLASS B	CLASS C

SPRINKLERS (IBC 903)	STANDPIPE (IBC 905)	FIRE EXTINGUISHERS (IBC 906)
SPRINKLERS PROVIDED THROUGHOUT THE BUILDING	NOT REQUIRED	FIRE EXTINGUISHERS PROVIDED THROUGHOUT THE BUILDING

MANUAL INITIATION	AUTOMATIC INITIATION	OCCUPANT NOTIFICATION
MANUAL PULL STATIONS PROVIDED AT MAINS EXITS FROM THE BUILDING AND MANUAL FOAM RELEASING STATION ARE PRESENT	FLOW AND TAMPER SWITCHES, SPOT SMOKE DETECTORS, DUCT SMOKE DETECTORS AND HEAT DETECTORS PROVIDED	AUDIBLE AND VISUAL NOTIFICATION PROVIDED. VISUAL ONLY IN PUBLIC AND COMMON AREAS

OCCUPANCY	PRIMARY CLASSIFICATION OF FIRE AND HAZARD	MINIMUM RATING	MINIMUM FLOOR AREA PER A (SF)	MAX TRAVEL DISTANCE (FT)
B	CLASS A:B:C - ORDINARY	2-A	1,500	75
S-1, H-2	CLASS A:B:C - EXTRA HAZARD	4-A	1,000	75

SMOKE CONTROL SYSTEM (IBC 909)	SMOKE AND HEAT VENTS (IBC 910)	PASSIVE SMOKE MANAGEMENT
NOT REQUIRED	NOT REQUIRED	NOT REQUIRED

FLOOR / OCCUPANCY	OCCUPANT LOAD	WATER CLOSETS	LAVATORIES	DRINKING FOUNTAINS
LEVEL 1 / B	34	1 M 1 F	1 M 1 F	1
LEVEL 1 / S-1	55	1 M 1 F	1 M 1 F	1
LEVEL 1 / H-2	5	1 M 1 F	1 M 1 F	1
PROVIDED ON LEVEL 1		2 M 1 F	1 M 1 F	1

* NOT ADOPTED BY STATE OF OREGON

no.	date	by	ckd	description

PRELIMINARY - NOT FOR CONSTRUCTION



date	detailed
6/26/15	-

designed	checked
-	-


7759 NE Mary Olson Way, Portland, OR 97218

PDX - UNITED HANGAR MODIFICATION
 EXISTING LIFE SAFETY NARRATIVE AND BUILDING CODE ANALYSIS

project	contract
110438	CONTRACT


drawing	rev.
F-000	-

sheet	of	of	sheets

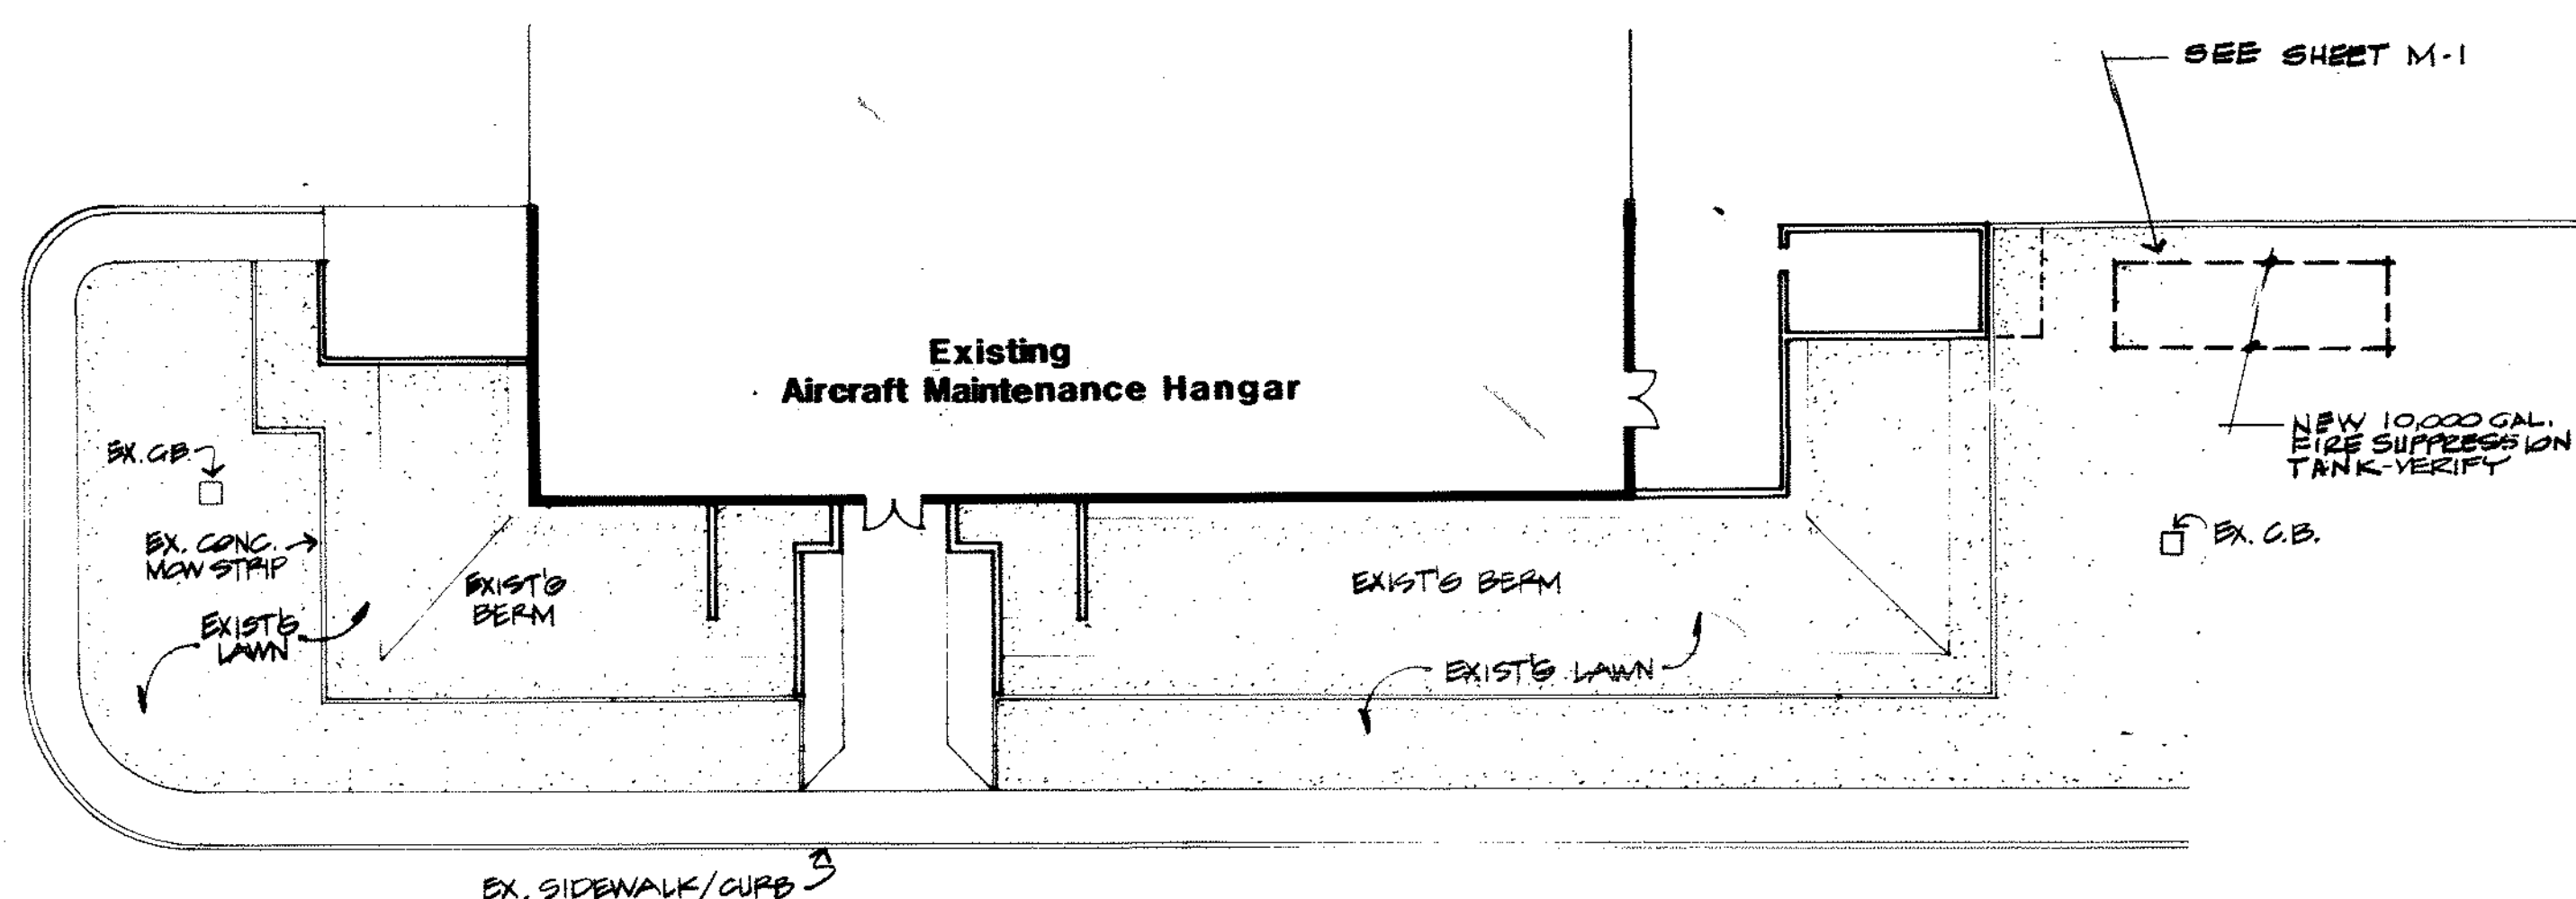


NOTE: THE AREA AFFECTED BY CONSTRUCTION OF FIRE TANK WILL BE REPAVED & RESEEDED UNDER THIS CONTRACT. FOLLOW SPEC. FOR SEEDING & SOIL PREP.

2 Fire Line Extension
1" = 20'-0"

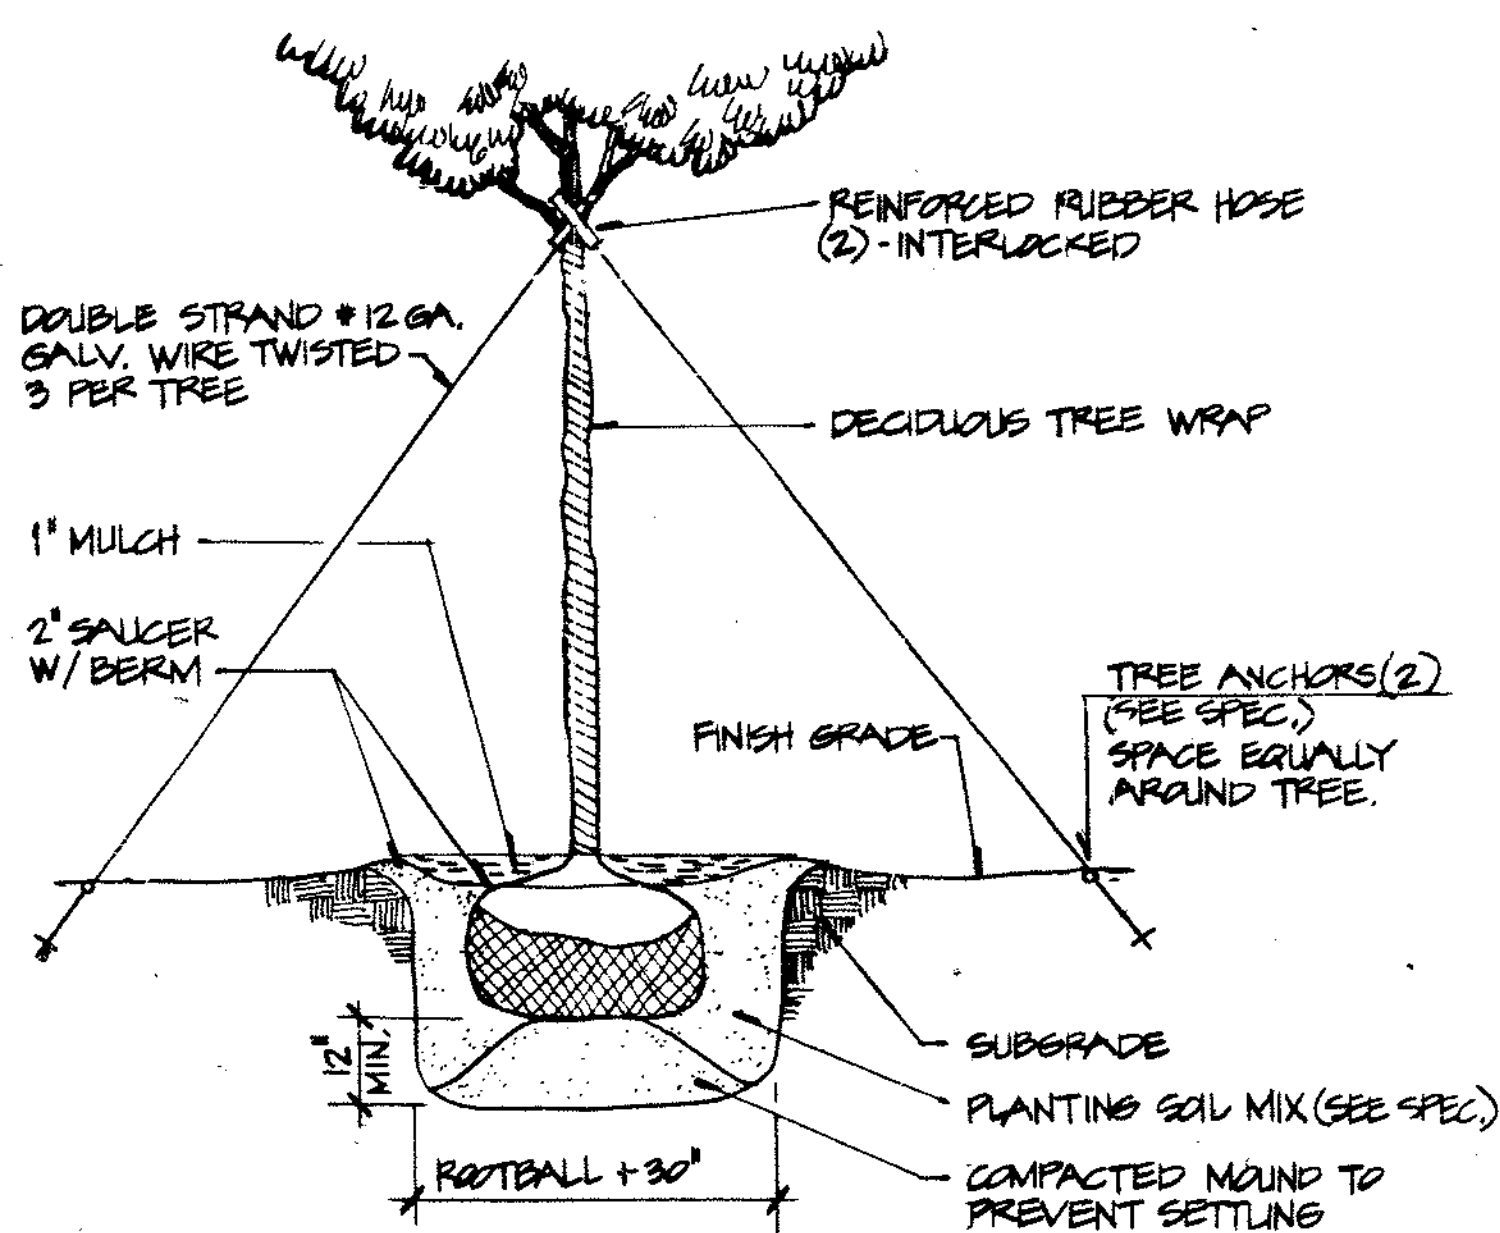

3 Tree Staking Detail
1" = 16"

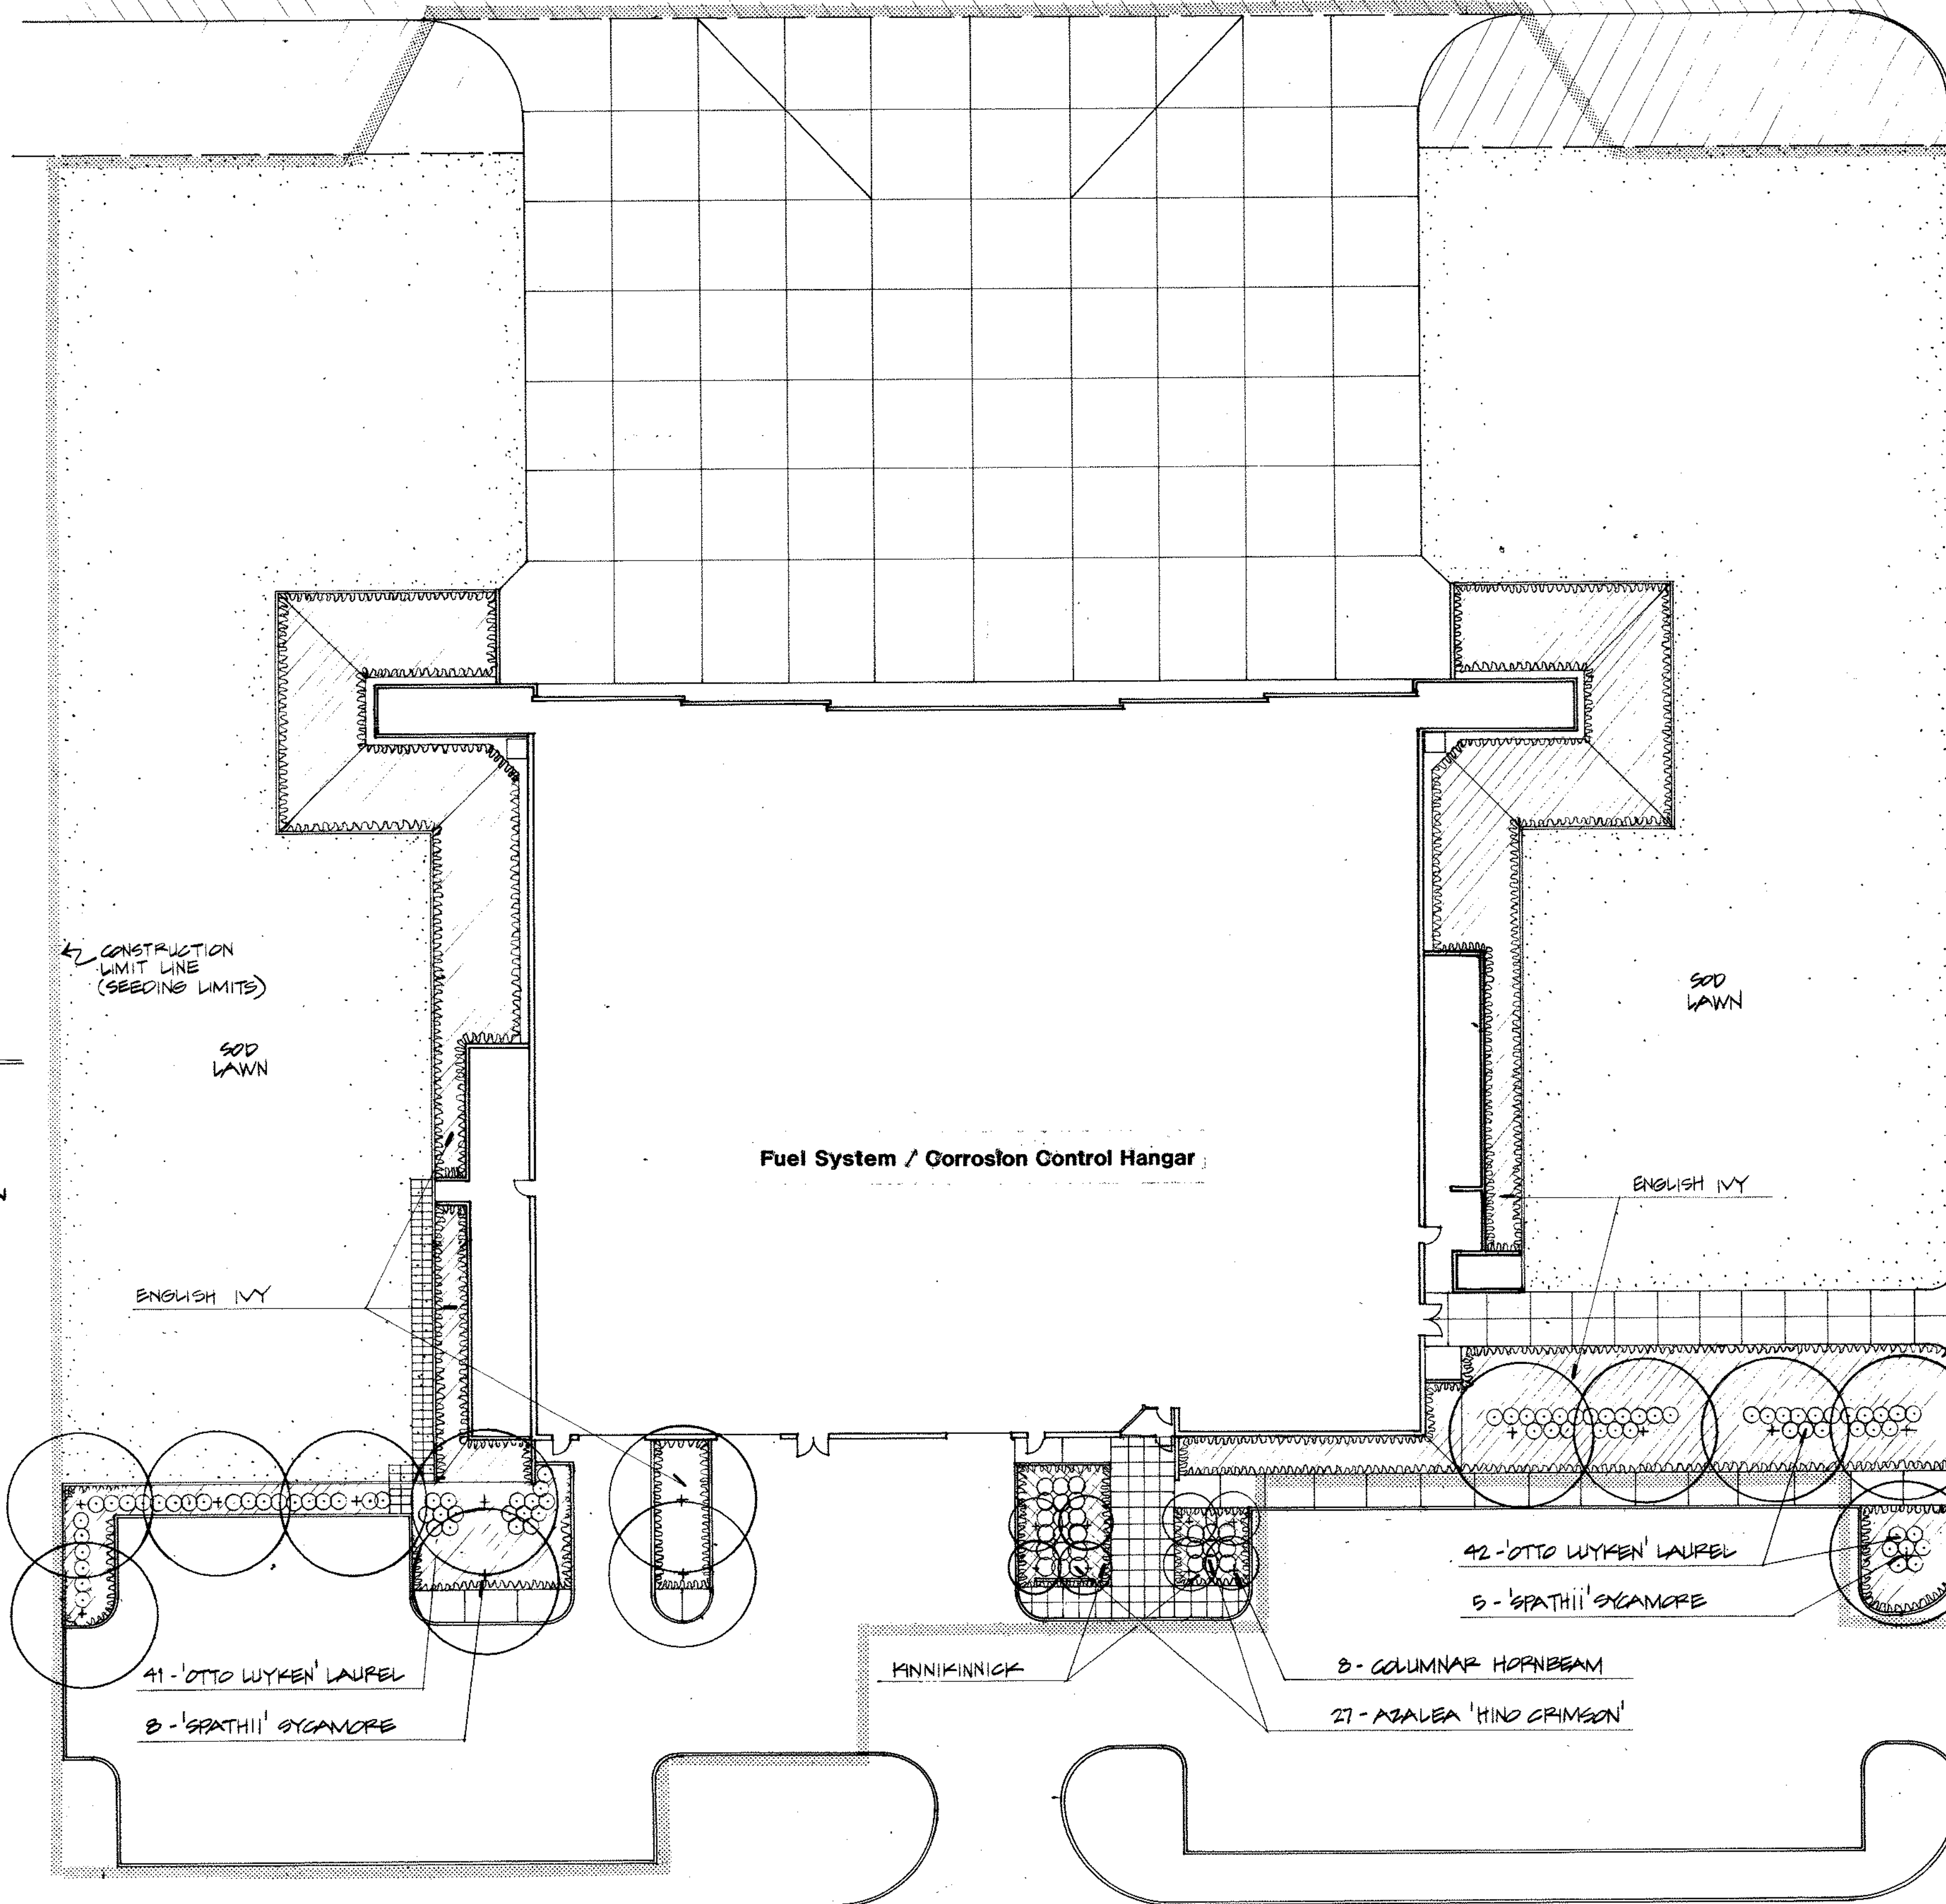

1 PLANTING PLAN
1" = 20'-0"

Notes

1. FIELD STAKE FOR APPROVAL SHRUBS & TREES SHOWN ON PLAN.
2. COORDINATE SITE ACCESS & AREAS FOR MATERIAL STOCK-PILE W/ CONTRACTING OFFICER.
3. OBTAIN APPROVAL OF FINISH GRADES PRIOR TO PLANTING MATERIALS OR SEEDING LAWN.
4. CONTRACTOR IS RESPONSIBLE FOR COMPUTING QUANTITIES OF GRAINCOVER TO BE USED.

Plant List

SYMBOL	QUAN.	COMMON NAME BOTANICAL NAME	SIZE	CONDITION
●	19	SYCAMORE MAPLE 'SPATHI' ACER PSEUDOPLATANUS 'SPATHI'	3' GAL.	B&B; WELL BRANCHED OUTED 2 DIRECTIONS
●	8	PYRAMIDAL HORNBEAM CARPINUS BETULUS 'FASTIGIATA'	3' GAL.	B&B; WELL BRANCHED OUTED 2 DIRECTIONS
○	27	'HIND CRIMSON' AZALEA AZALEA 'HIND CRIMSON'	10' SPR.	B&B; WELL BRANCHED W/ BUDS - 3/2 CC.
○	42	'OTTO WUYKEN' LAUREL PRUNUS LAURCEPRASUS 'OTTO WUYKEN'	10' SPR.	B&B; WELL BRANCHED 3/2 CC.
○	SEE NOTE 4	MINNIKINICK ARCTOSTAPHYLOS UVA URSA	1 GAL.	4 RUNNERS @ LENGTH MIN. - 3/2 CC.
○	SEE NOTE 4	ENGLISH IVY HEPPEA HELIX	2 1/2 GAL.	2 RUNNERS @ LENGTH 12 CC. TRIANGLE SPACING.


DATE: JAN. 9, 1986
JOB NO: 44-105
REVISIONS:




SHEET TITLE: PLANTING PLAN
C-130 FUEL SYSTEM / CORROSION CONTROL MAINTENANCE HANGAR
304th AIR RESCUE RECOVERY SQUADRON
PORTLAND INTERNATIONAL AIRPORT
PORTLAND, OREGON




L-1

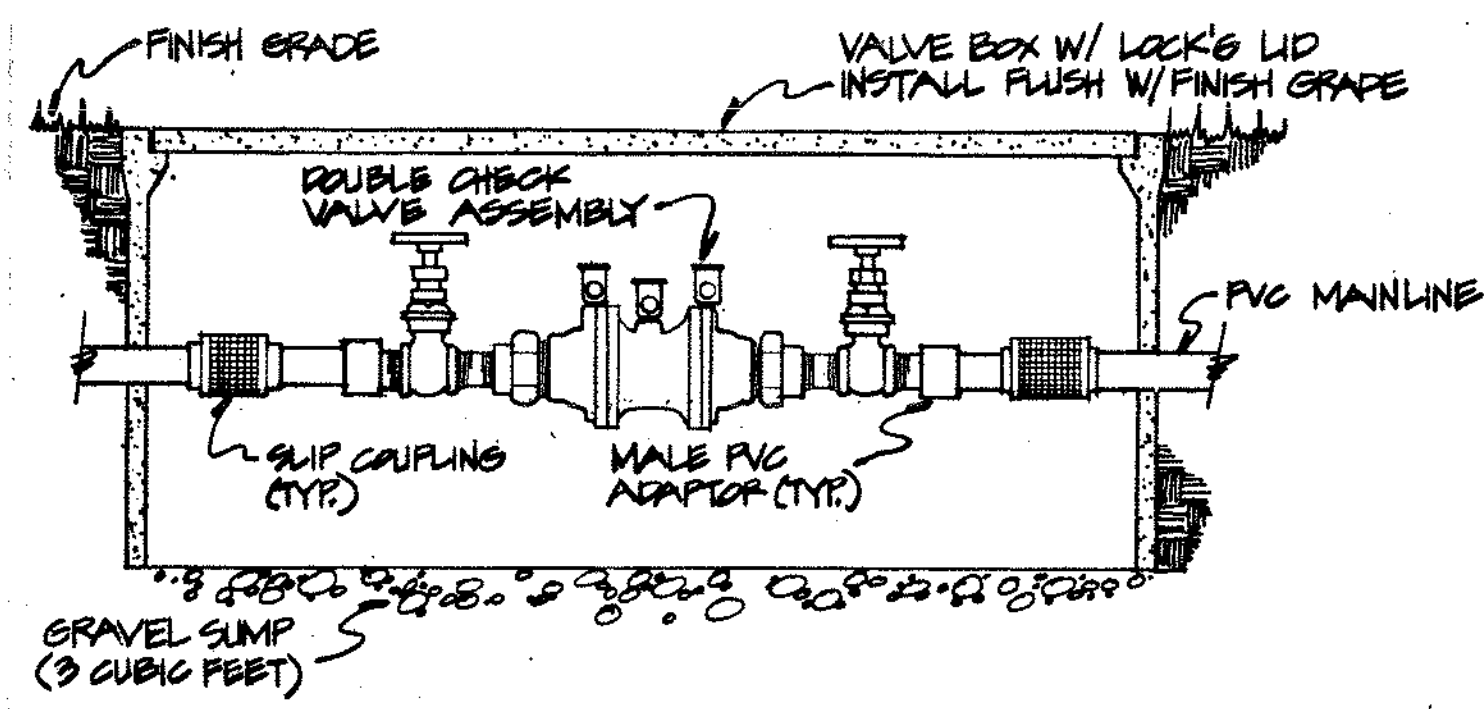


2 Double Check Valve
L2 NS

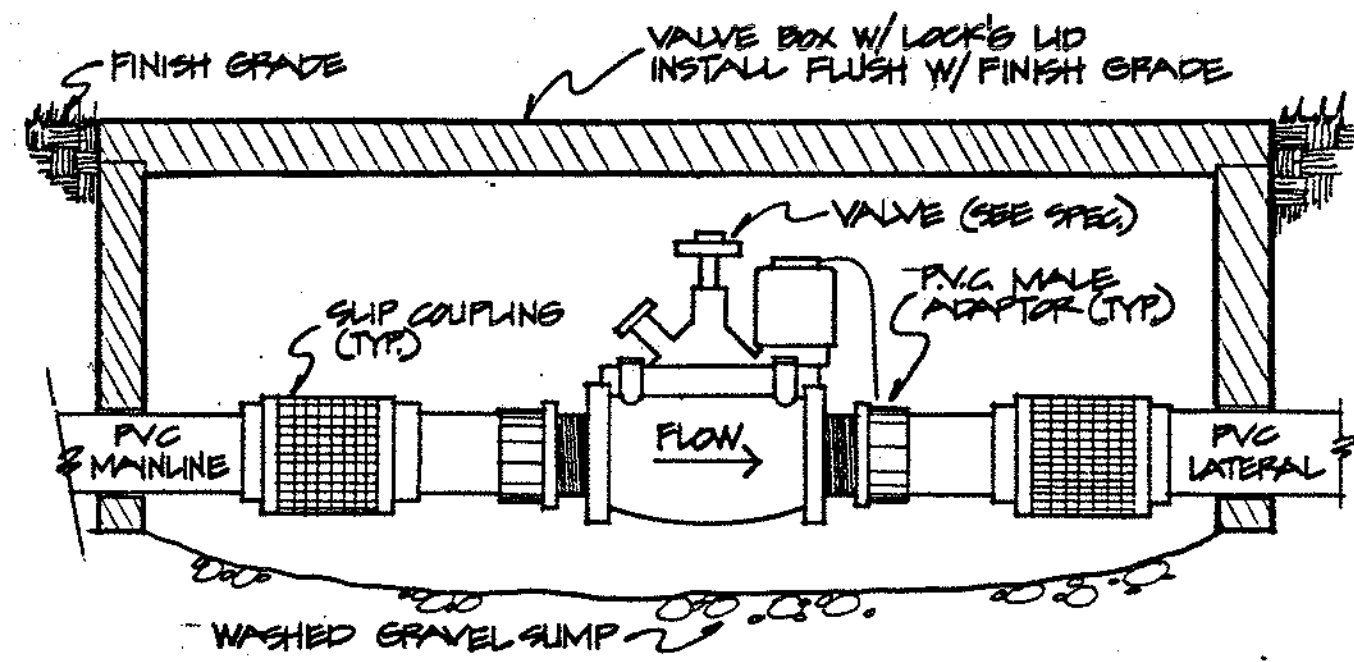


3 Automatic Control Valve
L2 NS

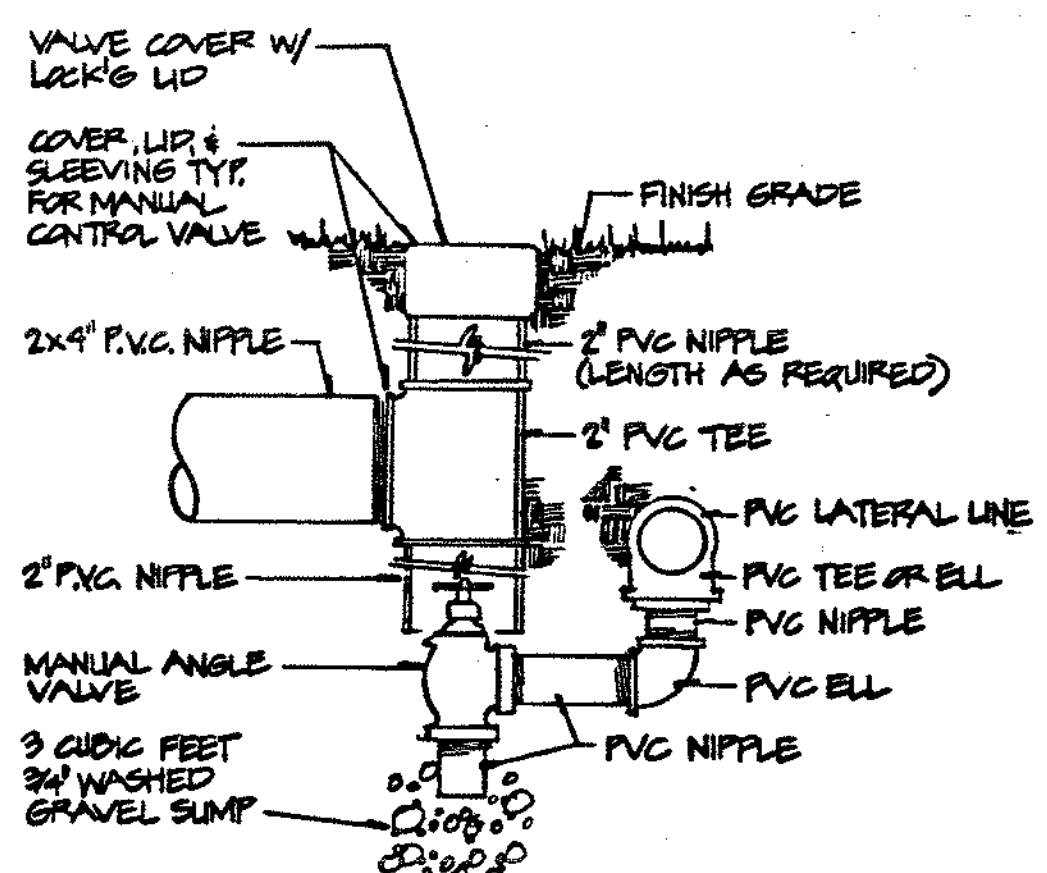

6 Manual Drain Valve
L2 NS

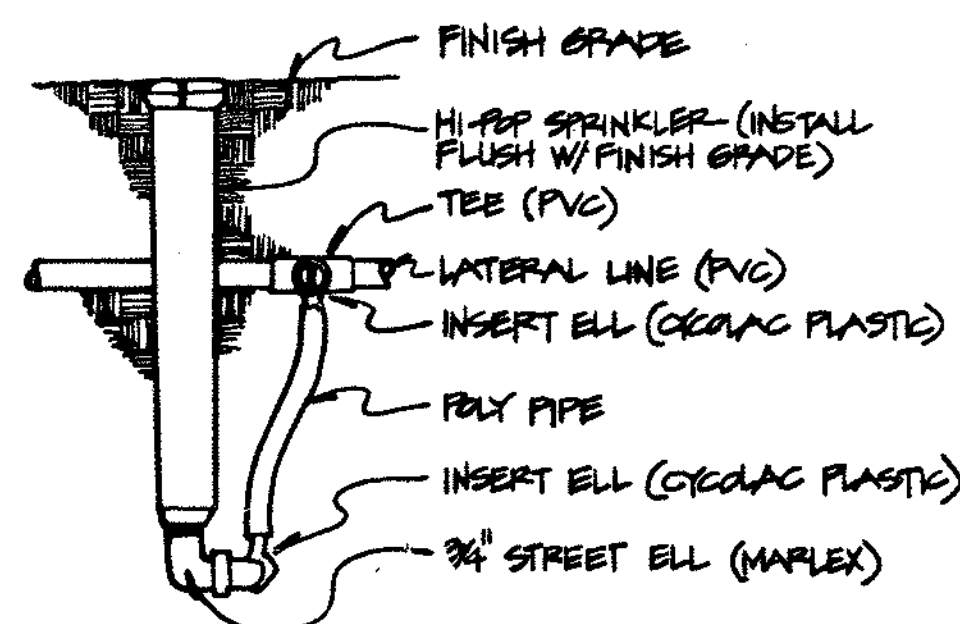


4 Pop-up Sprinkler Head
L2 NS

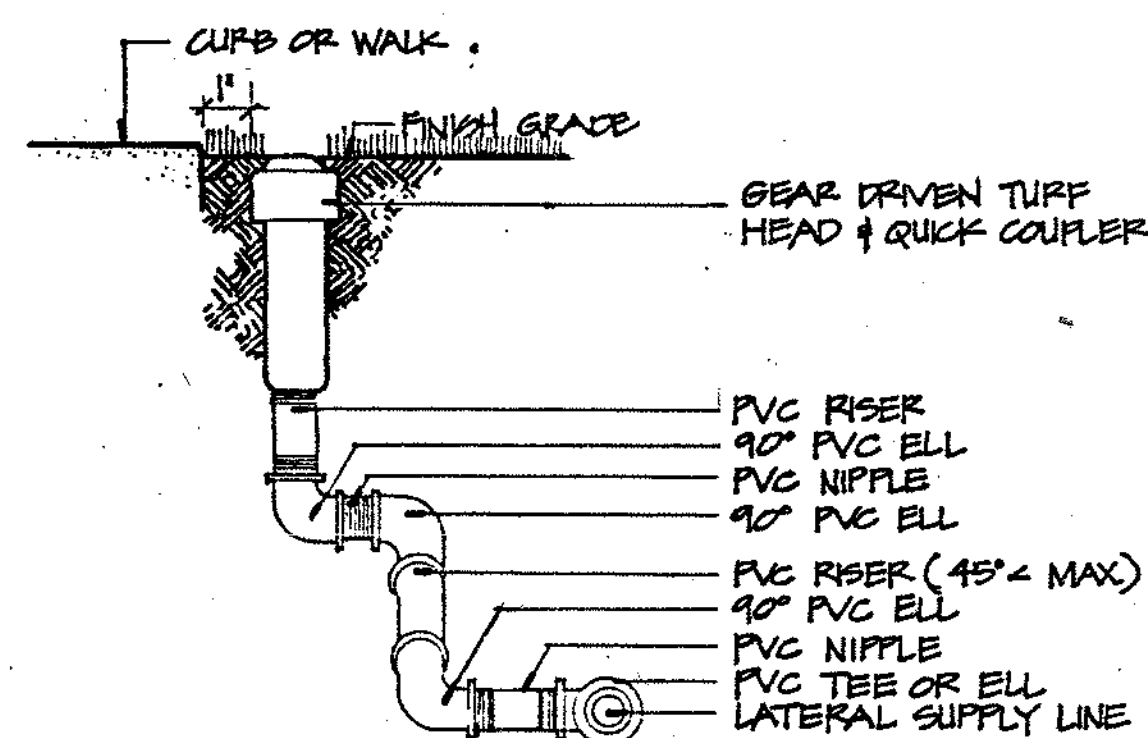

5 Swing Joint Assembly
L2 NS

Valve Key

VALVE NO.	VALVE SIZE	GPM
1	1/2"	30.6
2	1/2"	46.5
3	1/2"	43.5
4	1/2"	30.6
5	1/2"	27.5
6	1/2"	34.1
7	1/2"	41.5
8	1/2"	35.7

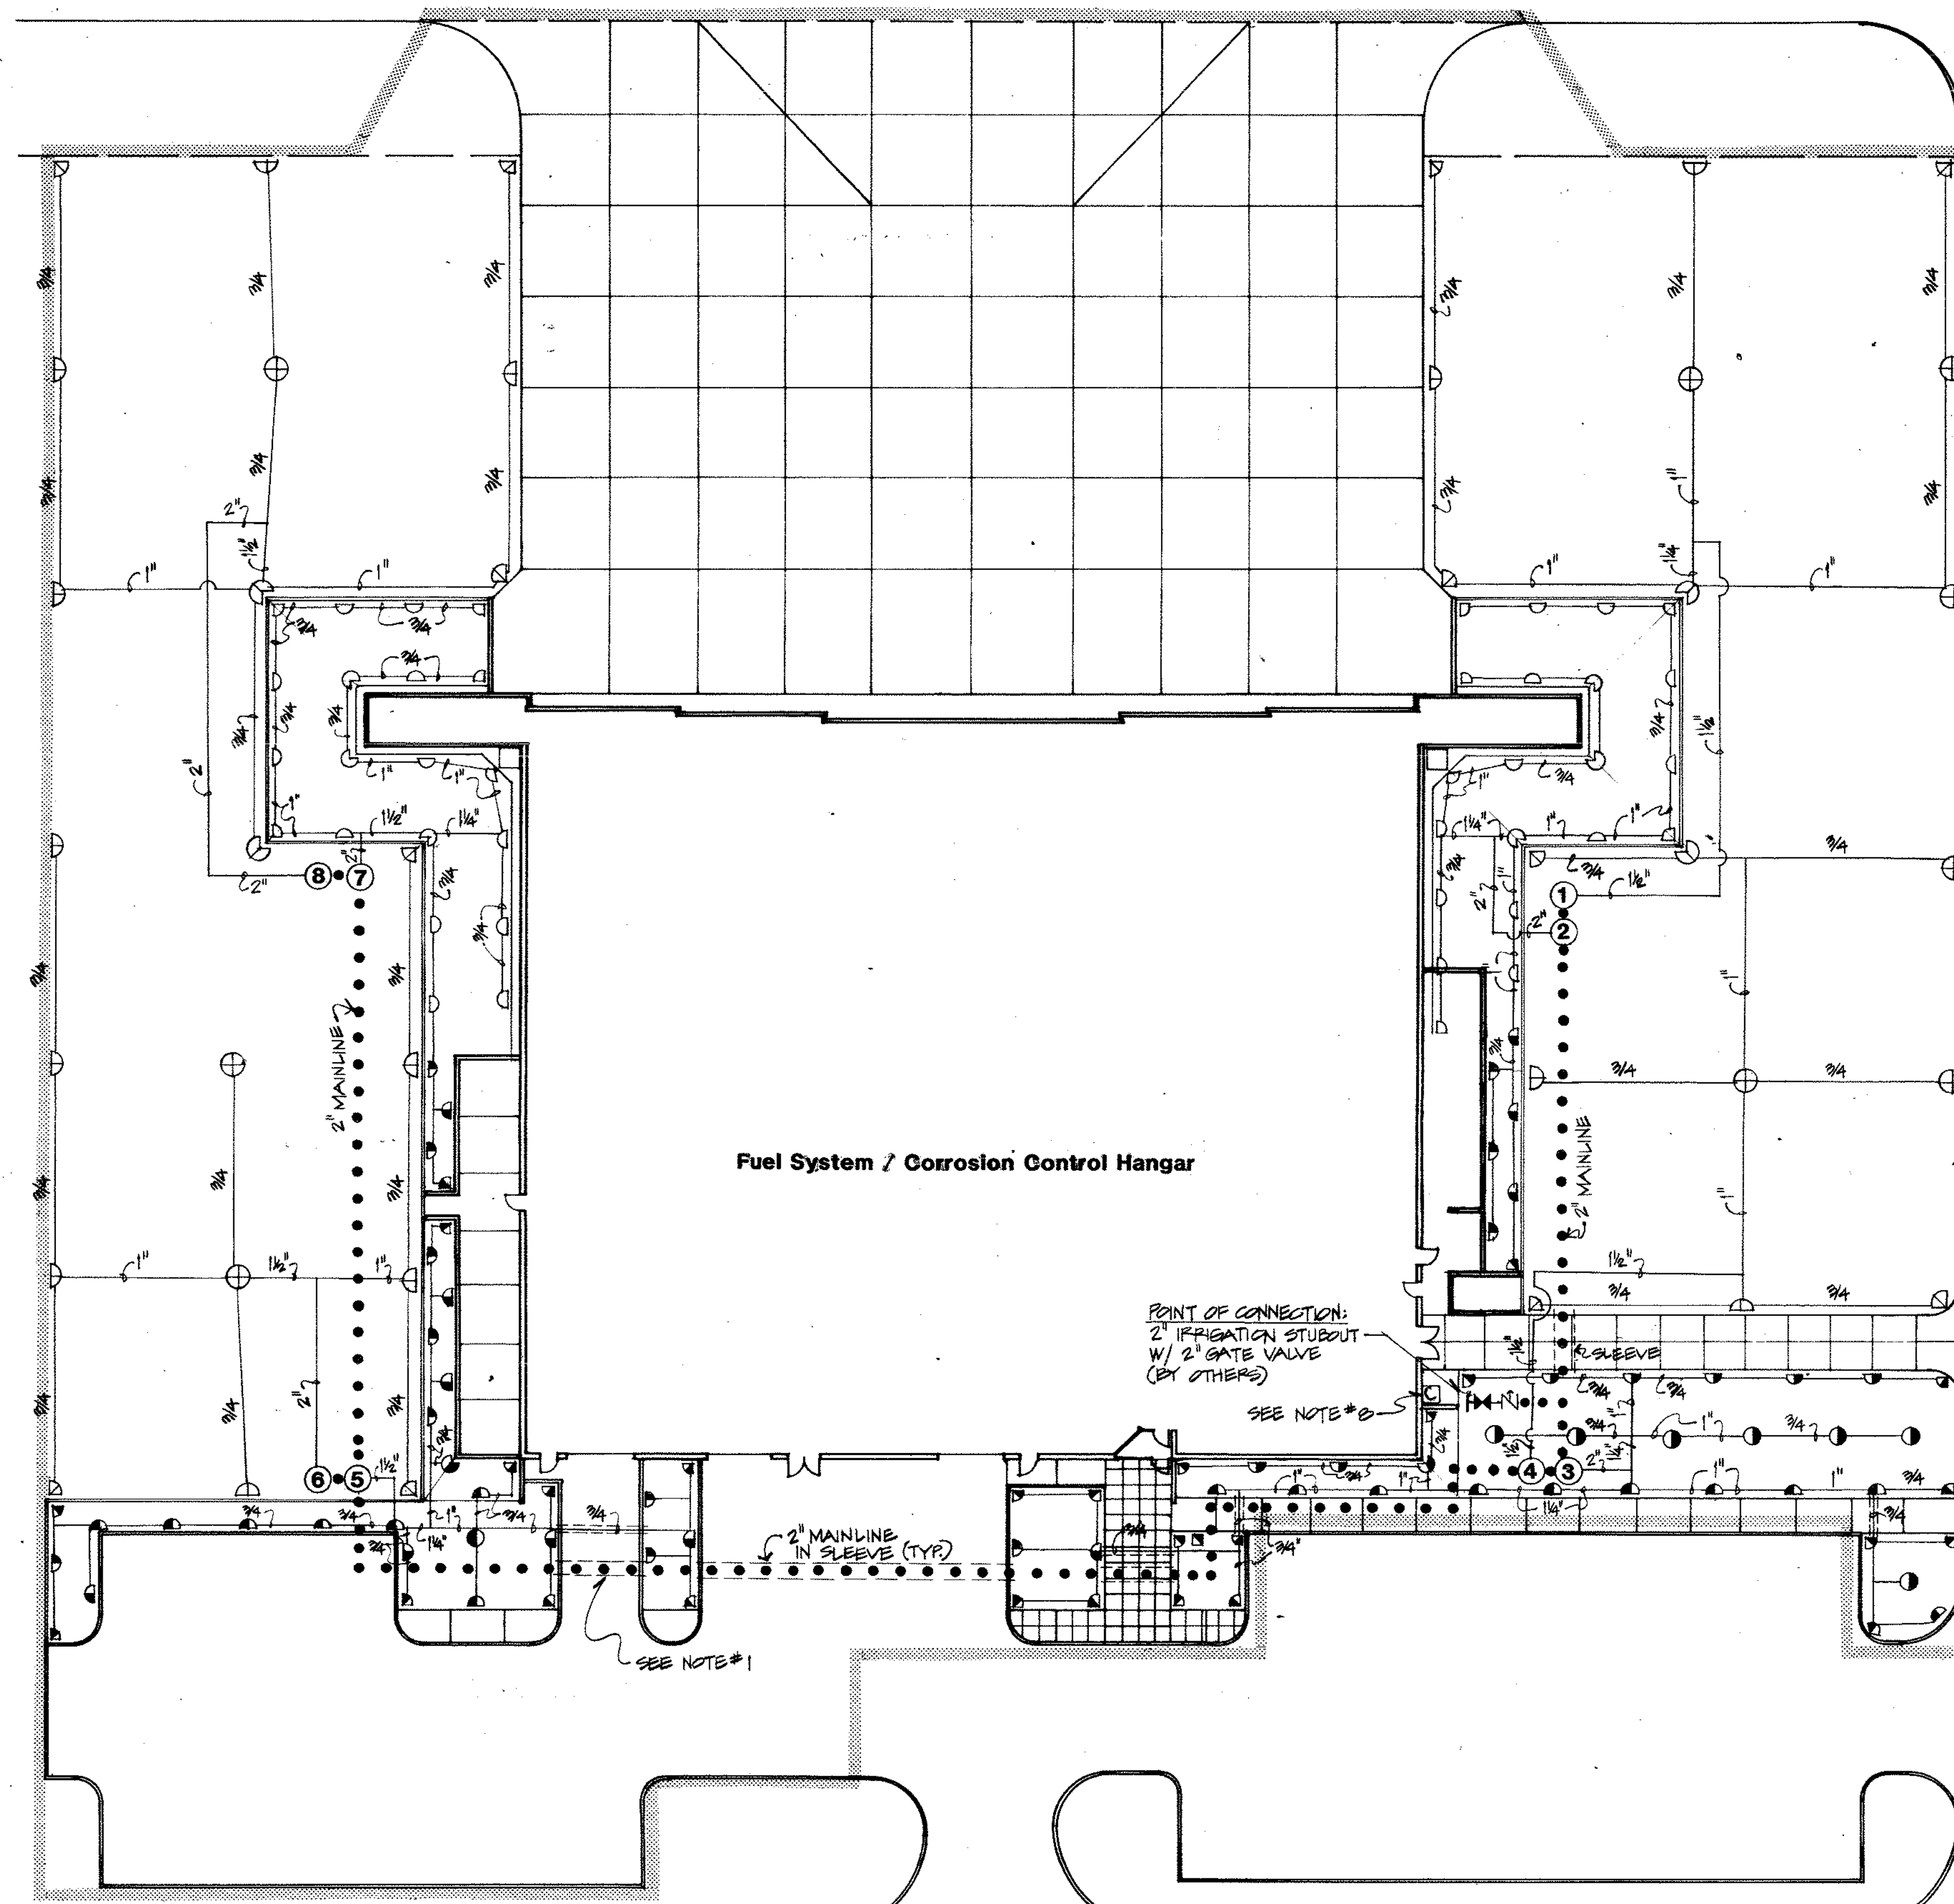

Irrigation Legend

- ⊕ 2" GATE VALVE (BY OTHER)
- 2" DOUBLE CHECK VALVE IN VALVE BOX. SEE NOTE #2.
- ⊙ 2" AUTOMATIC CONTROL VALVE IN VALVE BOX. SEE VALVE KEY FOR SIZE. SEE NOTE #2.
- 2" MAINLINE - CLASS 200 PVC.
- 1" LATERAL LINE - CLASS 200 PVC; SIZE AS SHOWN ON PLAN; SEE NOTE #4 THIS SHEET.
- QUICK COUPLER - 3/4" SINGLE LUG TYPE; CONNECT TO MAINLINE
- ⊞ IRRIGATION CONTROLLER - 11 OR 12 STATION ELECTRO-MECHANICAL CONTROLLER; WALL MOUNT IN RAIN-TIGHT HOUSING.
- ==== SLEEVES - SCHEDULE 40 PVC; SIZE 4" &.

Head Schedule

SYMBOL	HEAD DESCRIPTION	RADIUS	PSI	GPM
⊕	GEAR DRIVEN TURF HEAD	45	35	6.0
⊙	" " " "	45	35	5.1
⊖	" " " "	45	35	3.4
⊙	" " " "	45	35	1.7
⊙	POP-UP SPRAY HEAD (6") STANDARD	15	30	4.0
⊙	" " " "	15	30	3.0
⊙	" " " "	15	30	2.0
⊙	" " " "	15	30	1.0
⊙	POP-UP SPRAY HEAD (6") LOW GALLONAGE	12	30	2.0
⊙	" " " "	12	30	1.5
⊙	" " " "	12	30	1.0
⊙	" " " "	12	30	.5

IRRIGATION PLAN

1/8" = 20'-0"


Notes

1. THIS PLAN IS SCHEMATIC. PLACE LINES IN COMMON TRENCH WHEREVER POSSIBLE. FIELD ADJUST LINES TO AVOID CONFLICT W/ EX. STRUCTURES, PAVEMENT & UTILITIES. FIELD ADJUST HEADS TO INSURE PROPER COVERAGE.
2. PLACE VALVES IN VALVE BOXES IN A MANNER WHICH FACILITATES ACCESS FOR MAINTENANCE.
3. CONTRACTOR IS RESPONSIBLE FOR PROVIDING COMPLETE IRRIGATION SYSTEM INCLUDING HYDRAULICS & RELATED ELECTRIC EQUIPMENT.
4. USE 3/4" PVC PIPE WHEREVER LATERAL LINES ARE SHOWN WITH NO SIZE INDICATED.
5. USE SPRINKLER HEADS WITH MATCHED PRECIPITATION RATE.
6. SPRINKLER HEAD LAYOUT IS BASED ON DATA SHOWN IN HEAD SCHEDULE. VARIATION FROM THIS DATA WILL NECESSITATE REDESIGN OF SYSTEM.
7. SPRINKLER HEAD DATA IS BASED ON HUNTER S 75 GEAR DRIVEN HEADS USING NOZZLE #3 4, 7, 9 & 10; RAINBIRD 1800 SPRAY HEADS (BOTH STANDARD & LOW GALLONAGE).
8. ELECTRICAL STUBOUT TO BE PROVIDED BY OTHERS. COORDINATE CONTROLLER LOCATION W/ CONTRACTING OFFICER.




DATE: JAN. 4, 1986
 JOB NO: 84-125
 REVISIONS:




SHEET TITLE: PRELOAD PLAN
C-130 FUEL SYSTEM / CORROSION CONTROL MAINTENANCE HANGAR
 304th AIR RESCUE RECOVERY SQUADRON
 PORTLAND INTERNATIONAL AIRPORT
 PORTLAND, OREGON

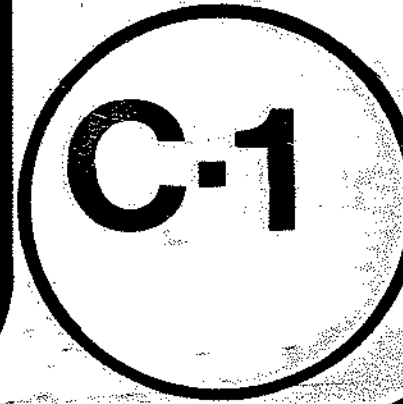


SOIL CLASSIFICATION SYSTEM			
MAJOR DIVISIONS	GROUP SYMBOLS	TYPICAL NAMES	
COARSE GRAINED SOILS (More than 50% of material is LARGER than No. 200 sieve size)	GW	Well graded gravels, gravel-sand mixtures, little or no fines.	
	GP	Poorly graded gravels or gravel-sand mixtures, little or no fines.	
	GM	Clayey gravels, gravel-sand-silt mixtures.	
	GC	Clayey gravels, gravel-sand-clay mixtures.	
	SW	Well graded sands, gravelly sands, little or no fines.	
	SP	Poorly graded sands or gravelly sands, little or no fines.	
FINE GRAINED SOILS (More than 50% of material is SMALLER than No. 200 sieve size)	ML	Inorganic silts and very fine sands, rock flour, silt or clayey fine sands or clayey silts with slight plasticity.	
	CL	Inorganic clays of low to medium plasticity, gravelly clay, sandy clay, silty clay, lean clay.	
	OL	Organic silts and organic silty clays of low plasticity.	
	MH	Inorganic silts, micaceous or diatomaceous fine sandy or silty soils, plastic silts.	
	CH	Inorganic clays of high plasticity, fat clays.	
	OH	Organic clays of medium to high plasticity, organic silts.	
HIGHLY ORGANIC SOILS			
BOUNDARY CLASSIFICATIONS: Soils possessing characteristics of two groups are designated by combinations of group symbols.			
PARTICLE SIZE LIMITS			
SILT OR CLAY			
RELATIVE DENSITY (sand-silt)			
CONSISTENCY (clay)			
KEY TO BORING LOGS			

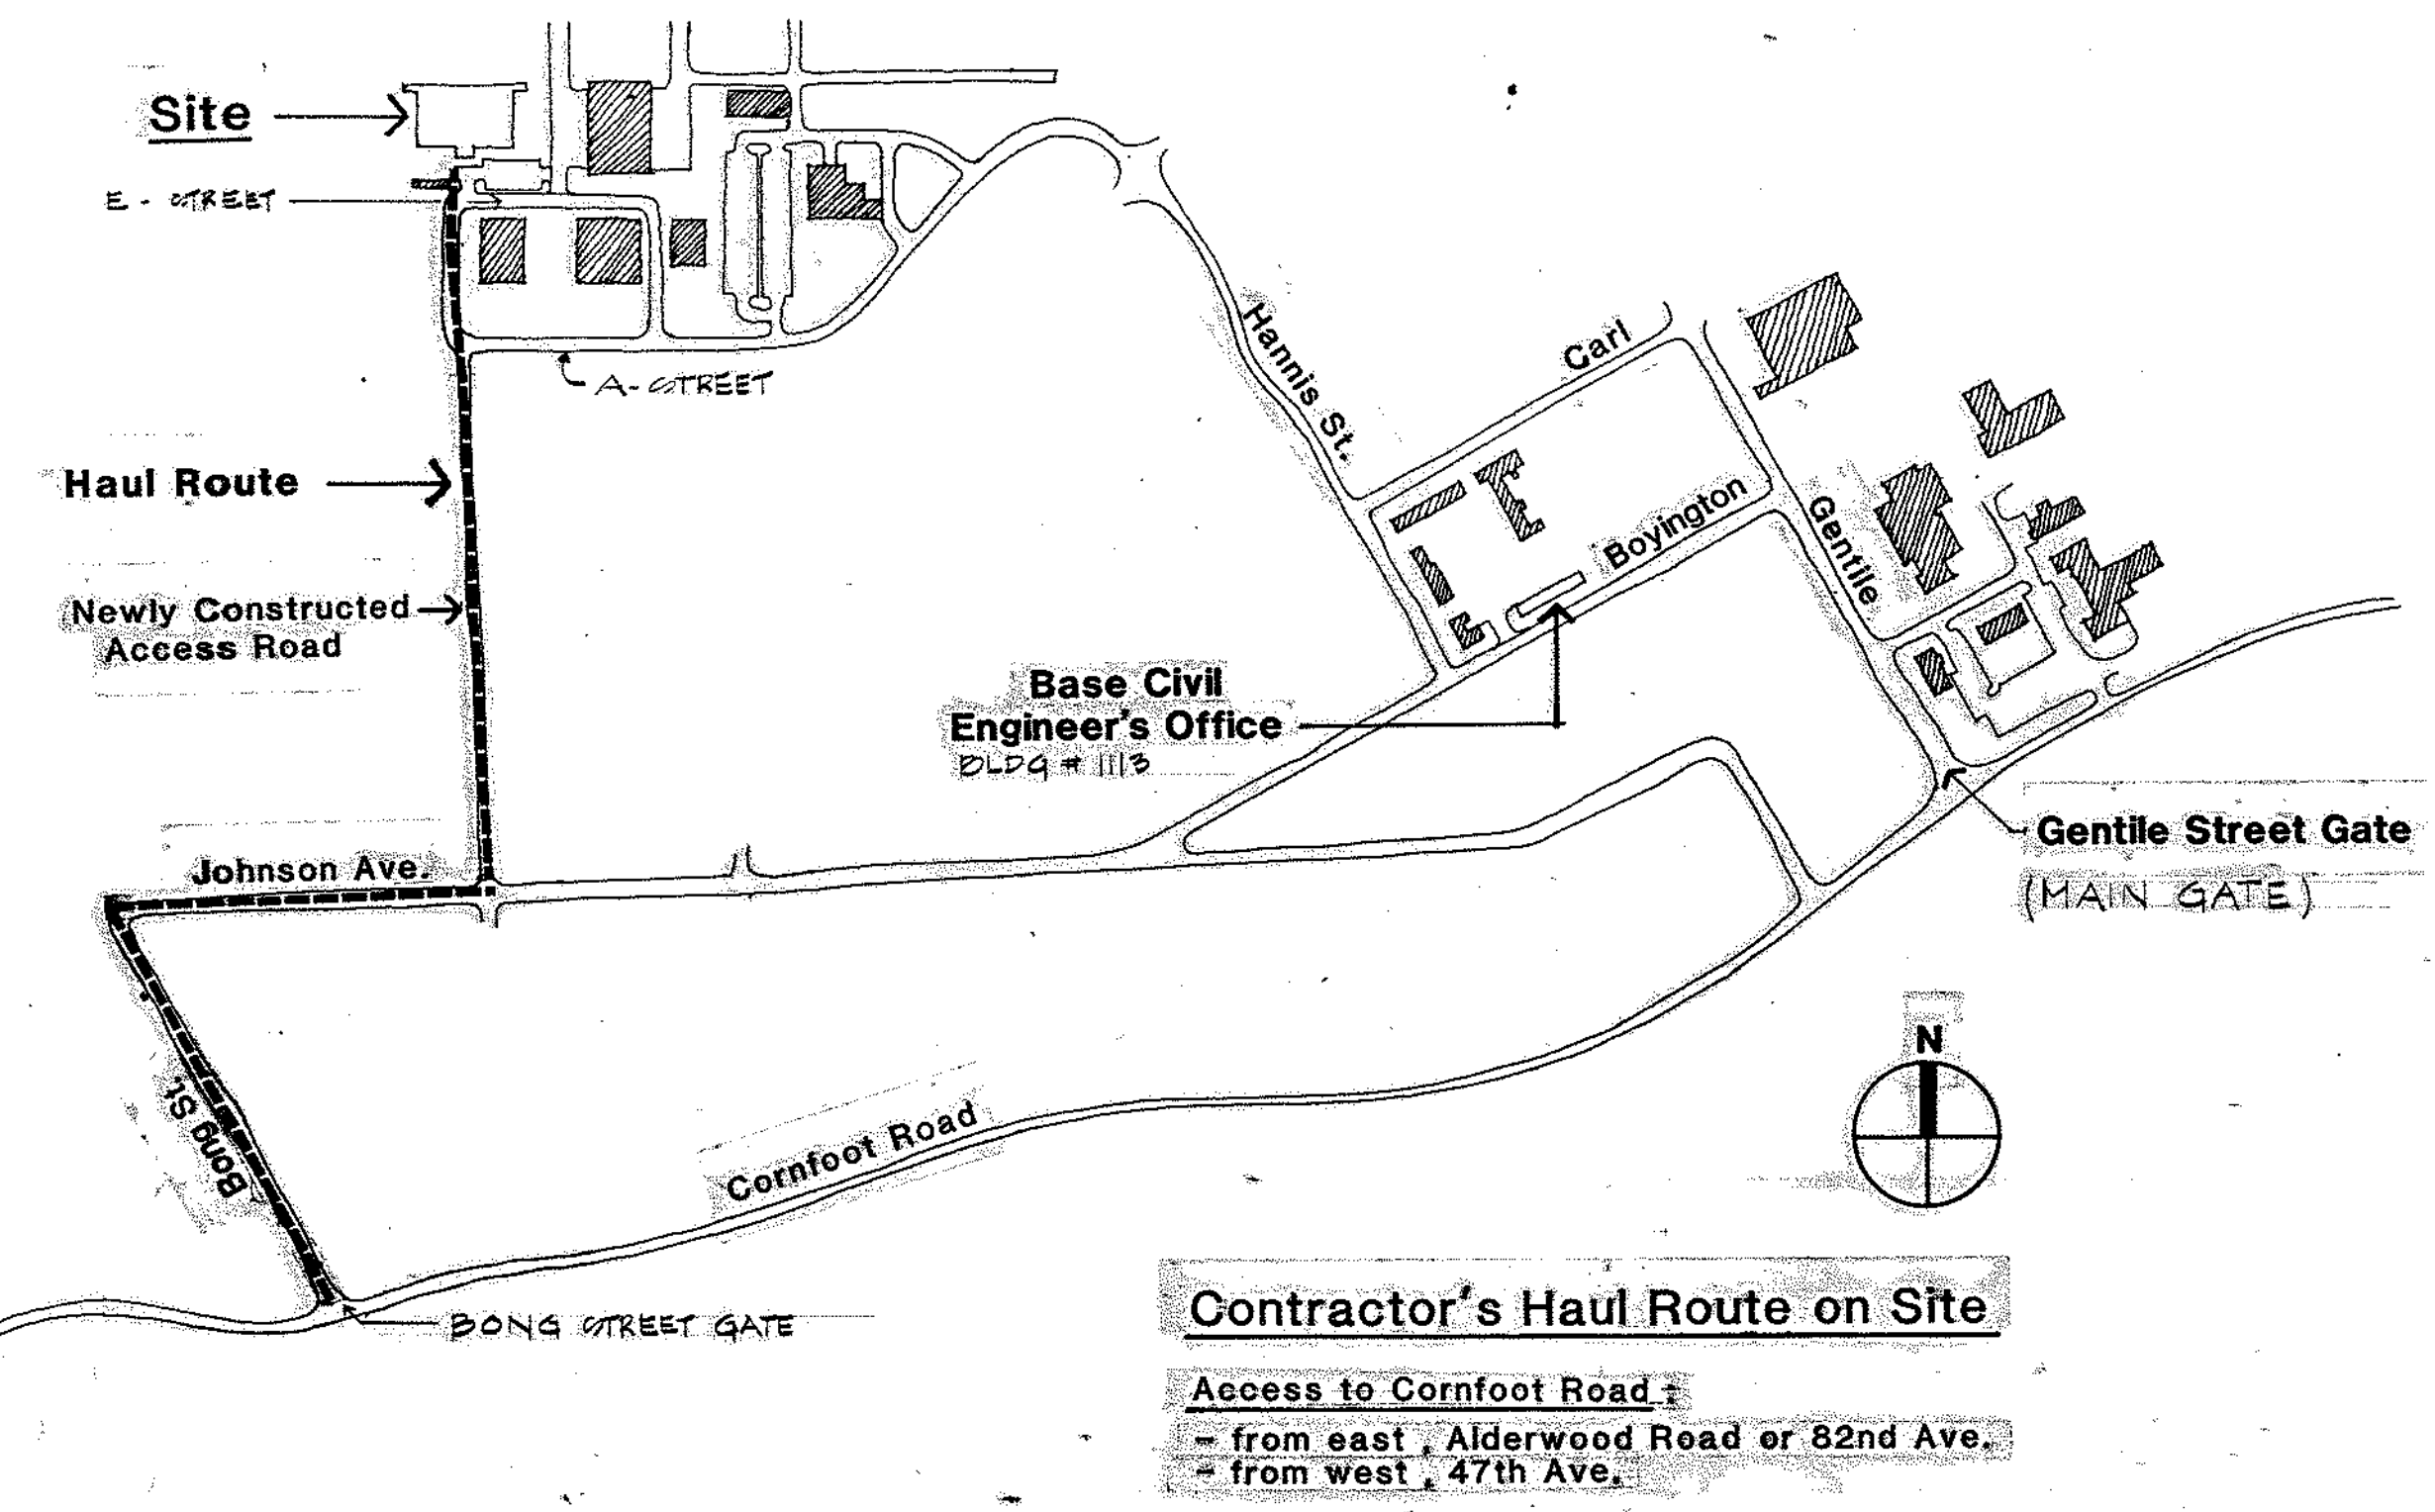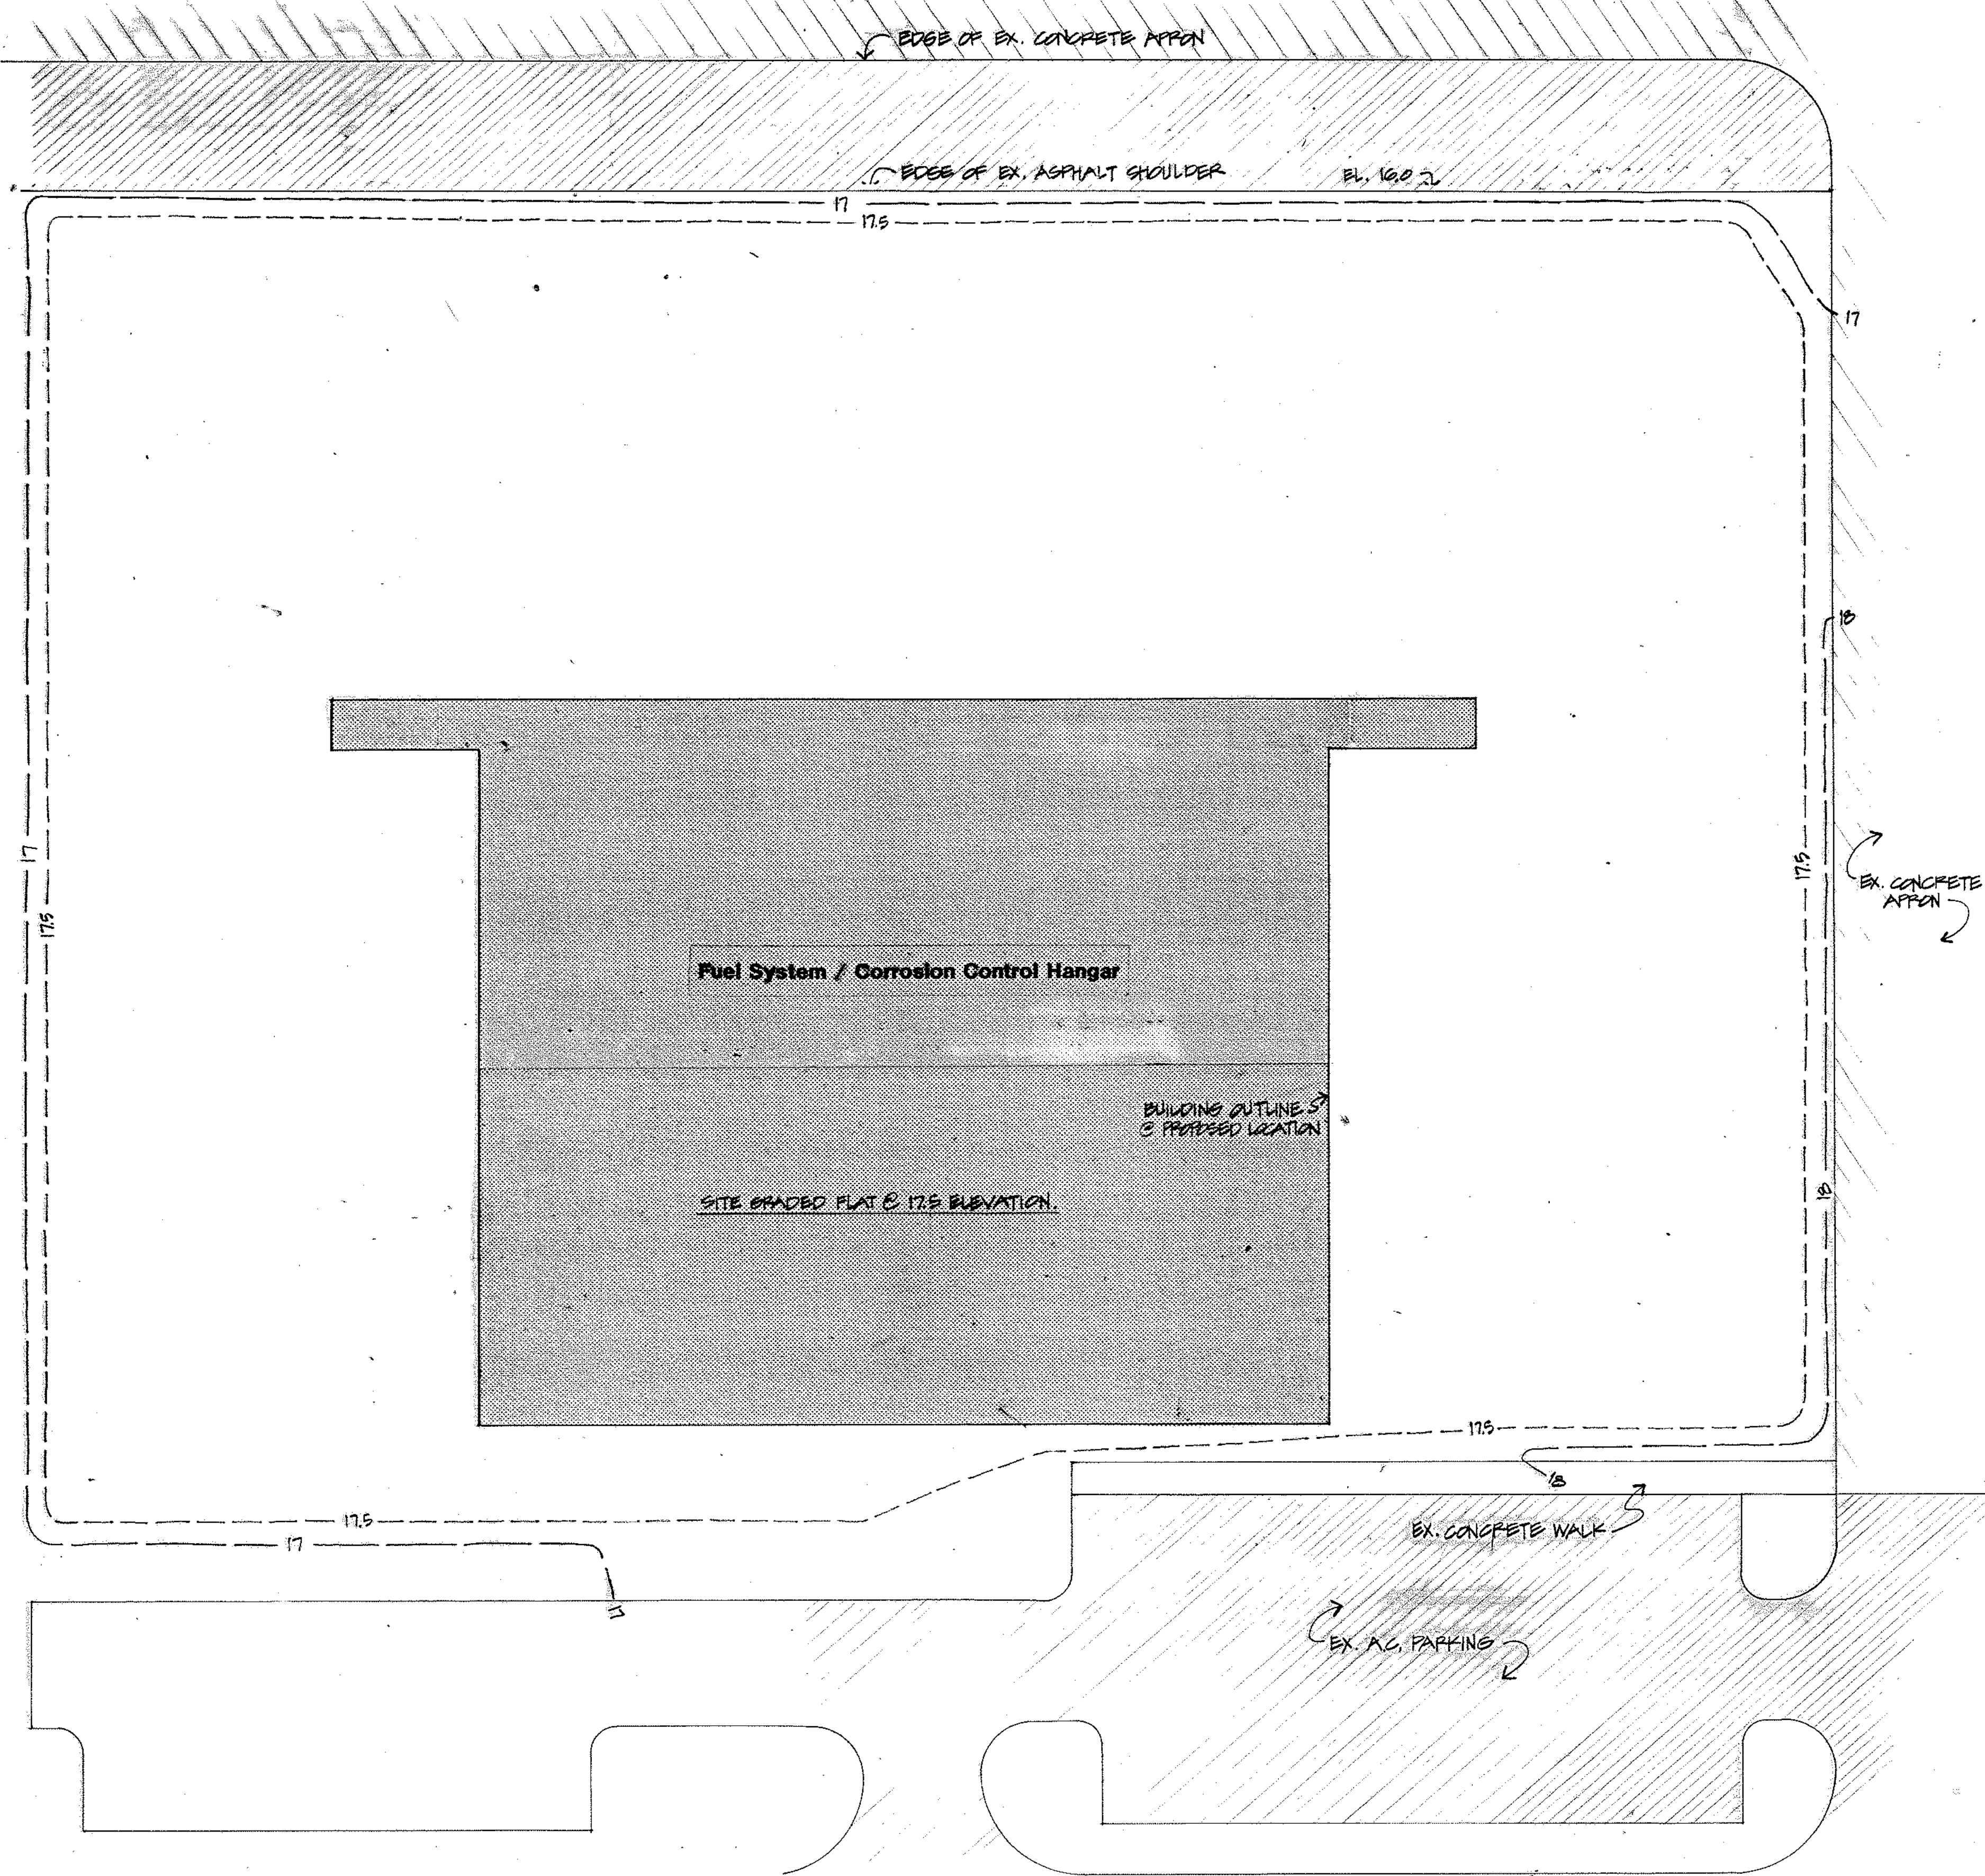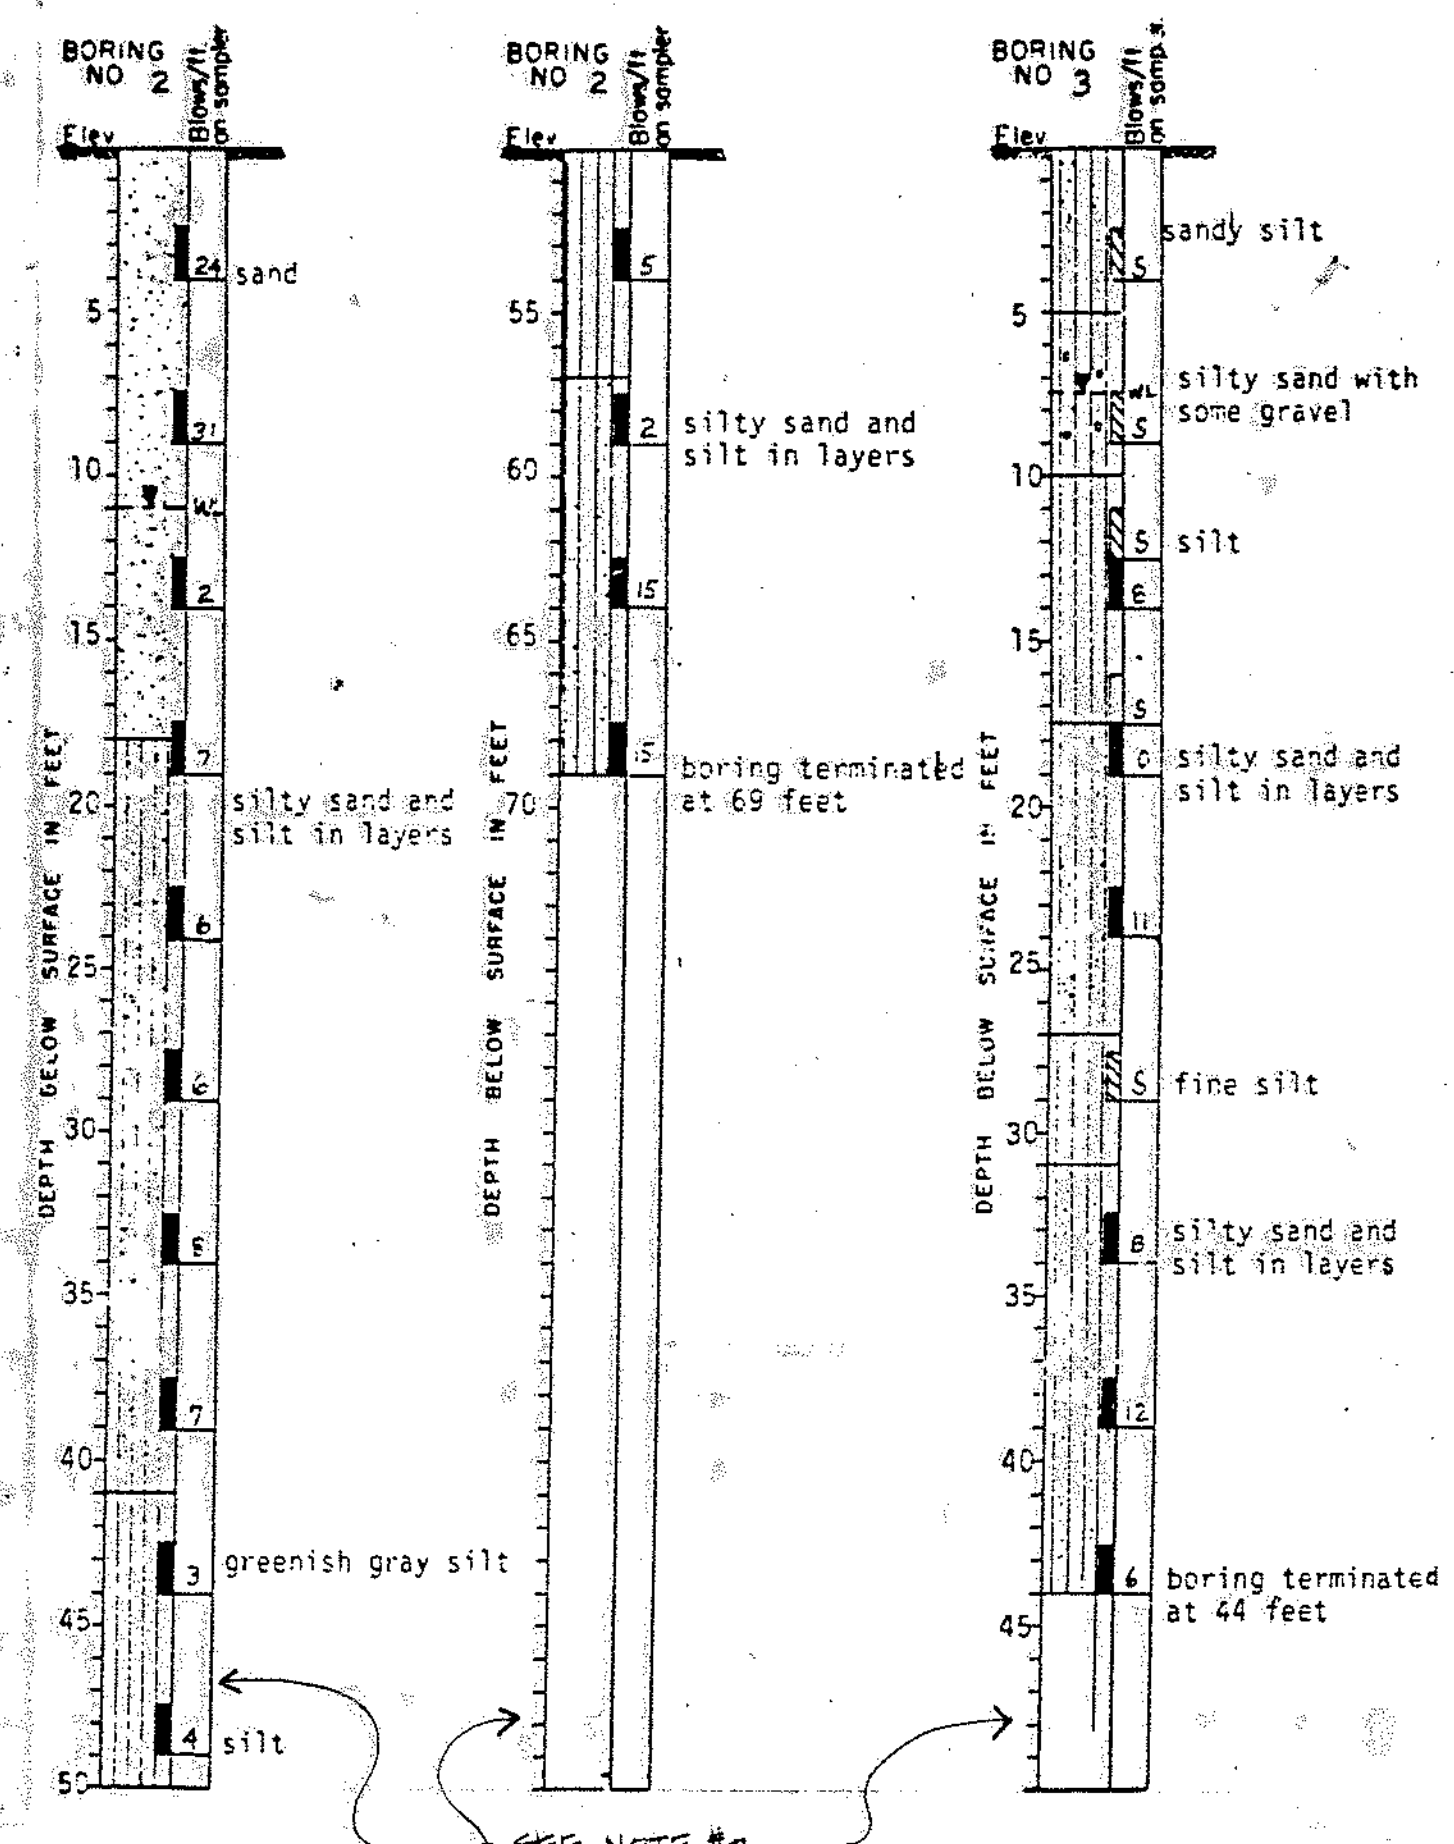


Note
 1 THIS PLAN IS AN APPROXIMATION OF EX. GRADES & TEST BORINGS SHOWN WERE TAKEN AT SITE IMMEDIATELY TO THE EAST OF PROJECT SITE.

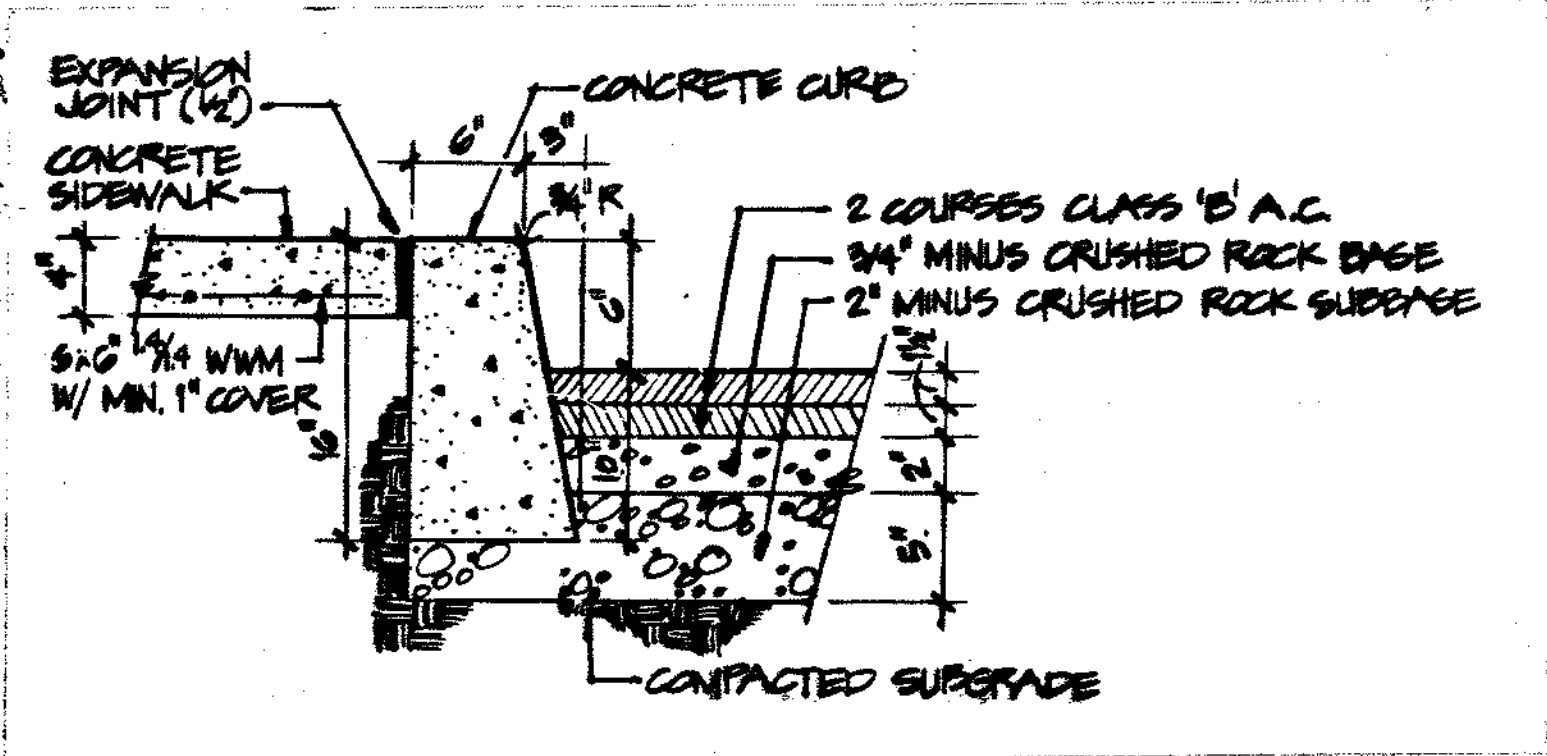


2
C2 **A.C. Paving, Conc. Walk, Conc. Curb**

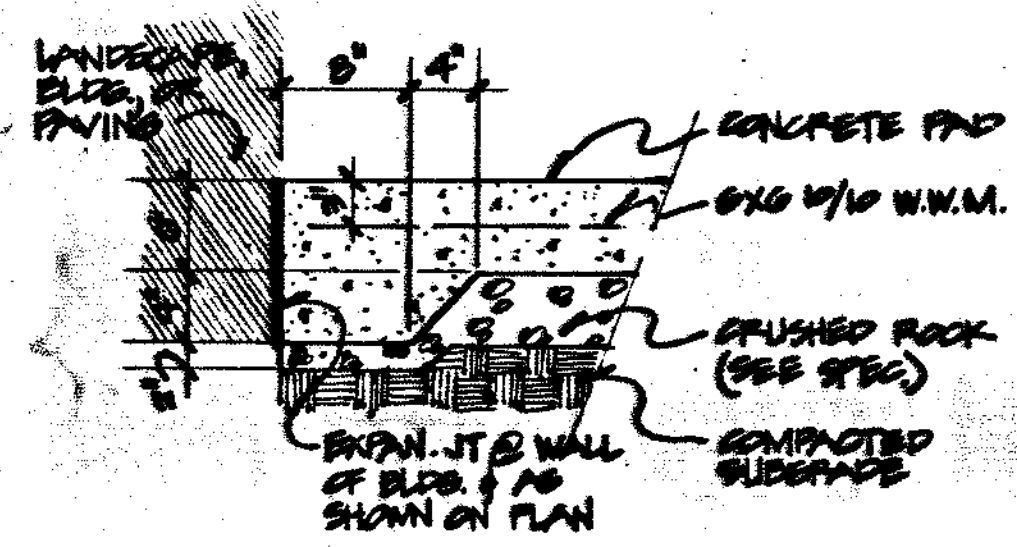


3
C2 **Concrete Paving**

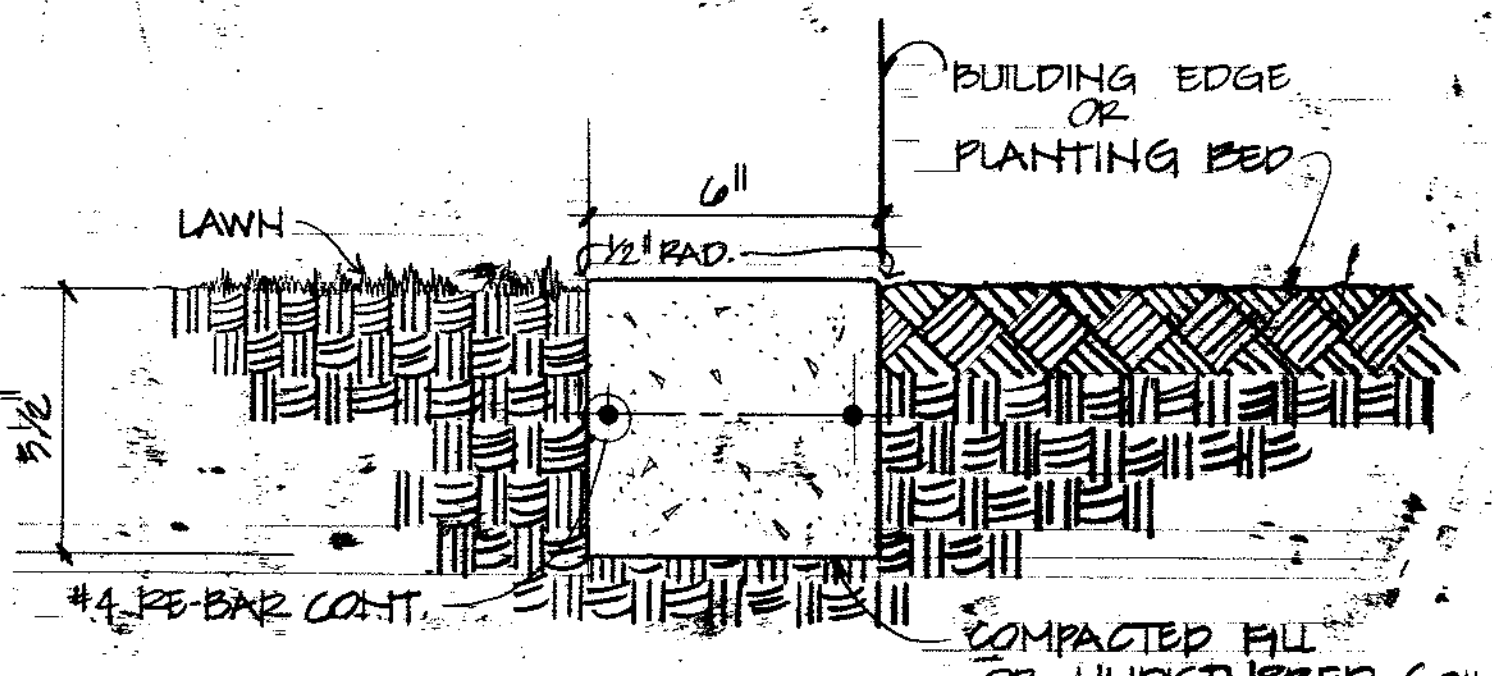


4
C2 **Concrete Mow Strip**

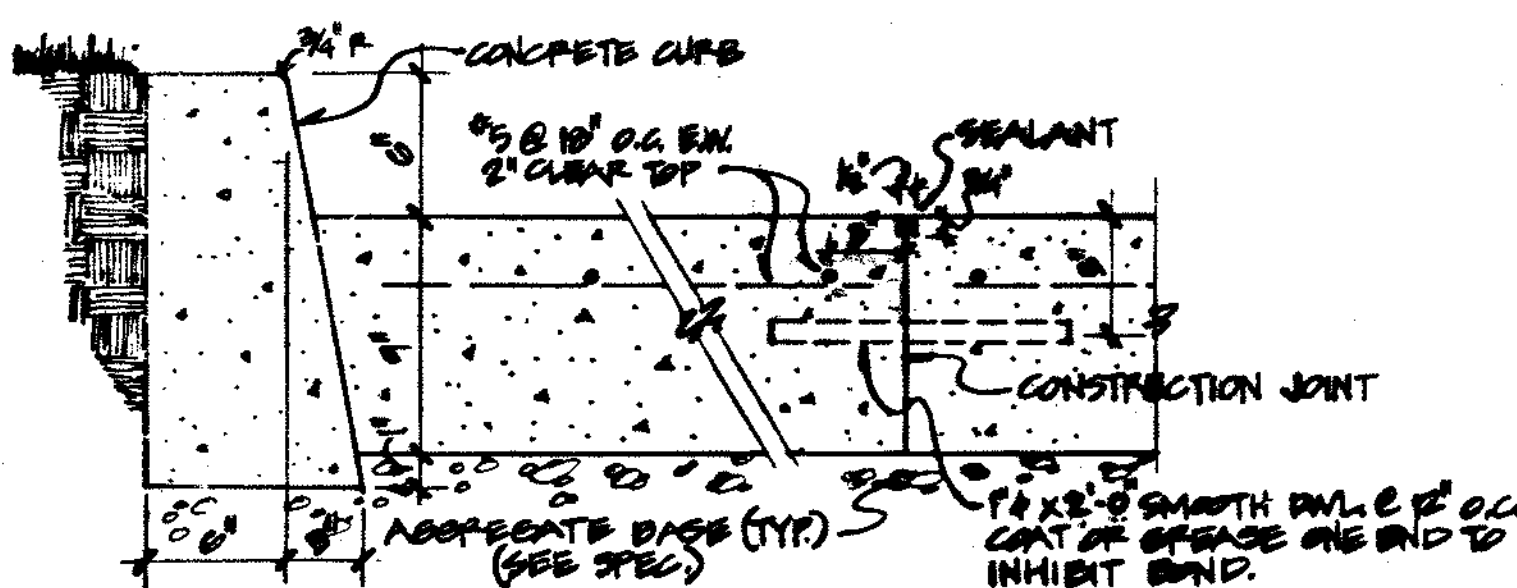


5
C2 **Apron Pavement Detail**

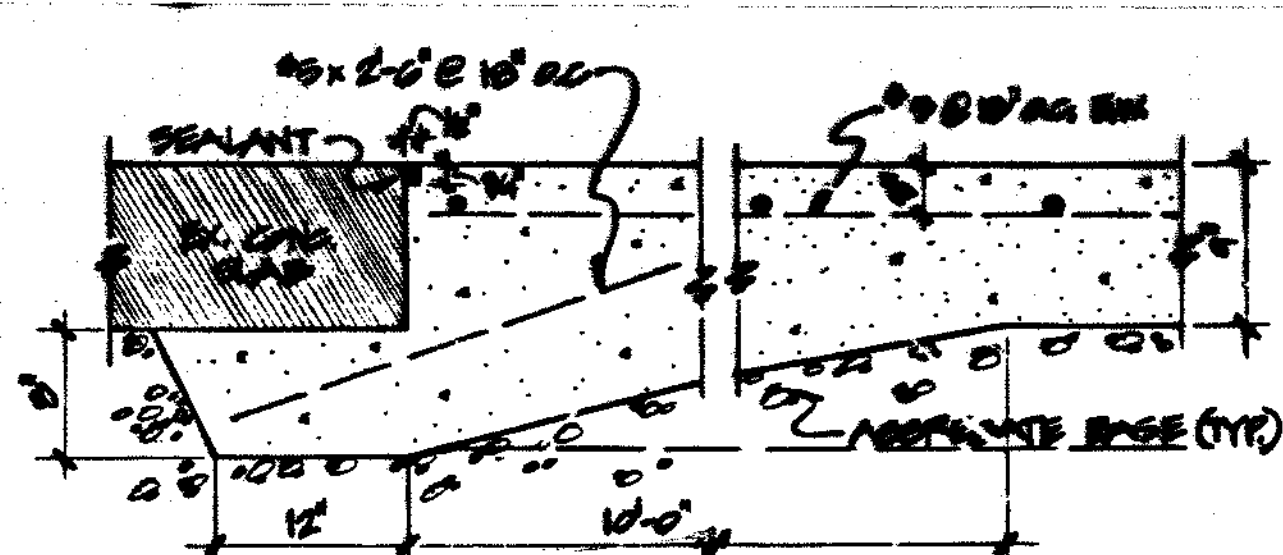


6
C2 **Apron Footing @ Existing Slab**

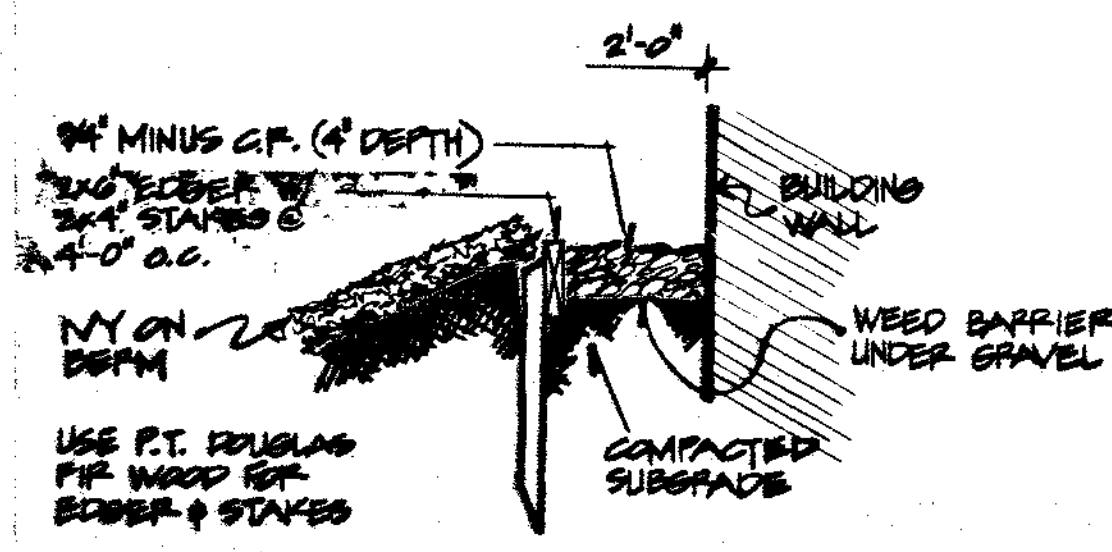


7
C2 **Gravel Strip**

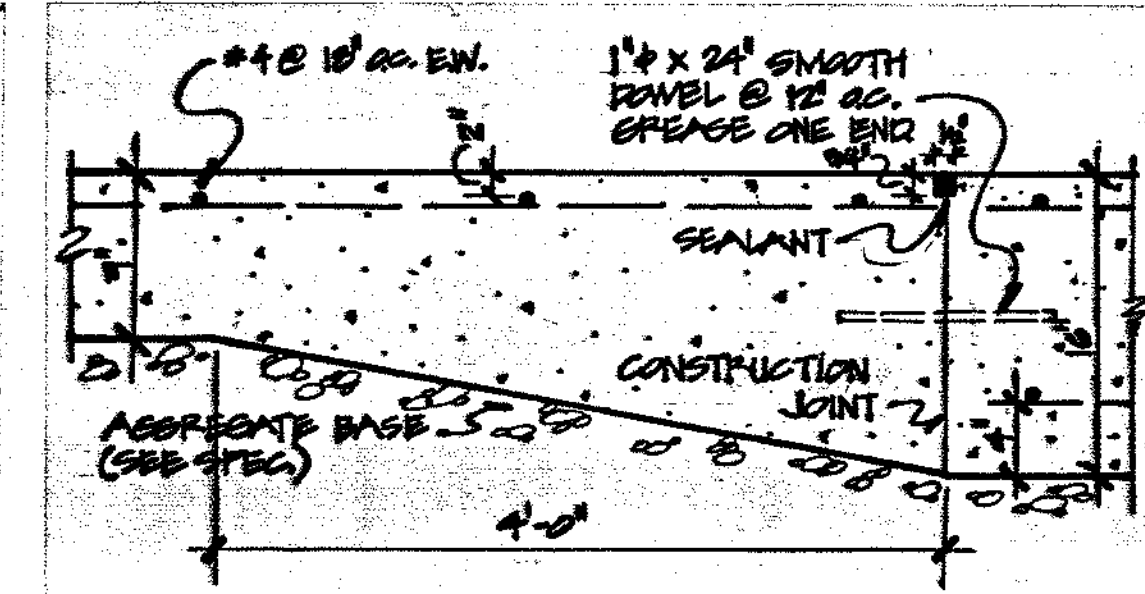


8
C2 **Transition Between Apron Pavements**

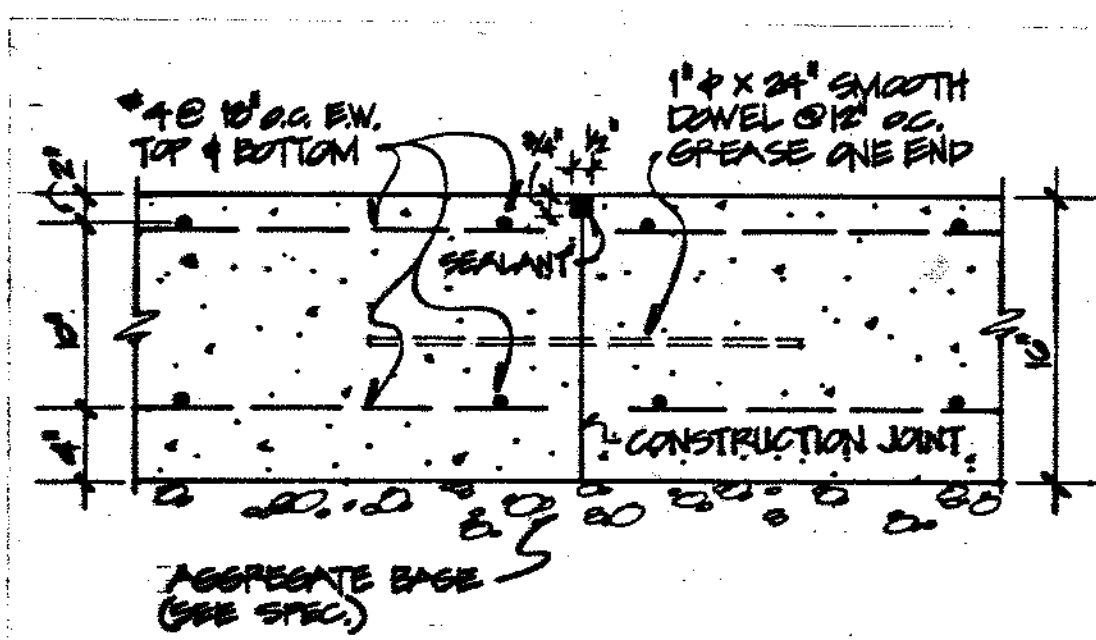

9
C2 **Thick Apron Pavement**

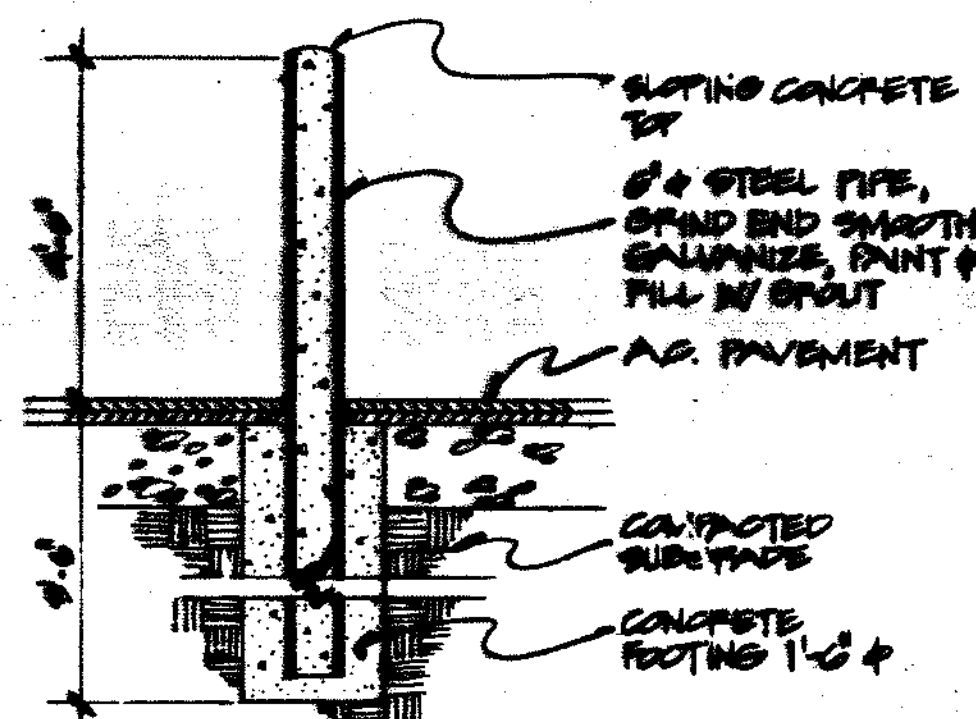

11
C2 **Bollard**

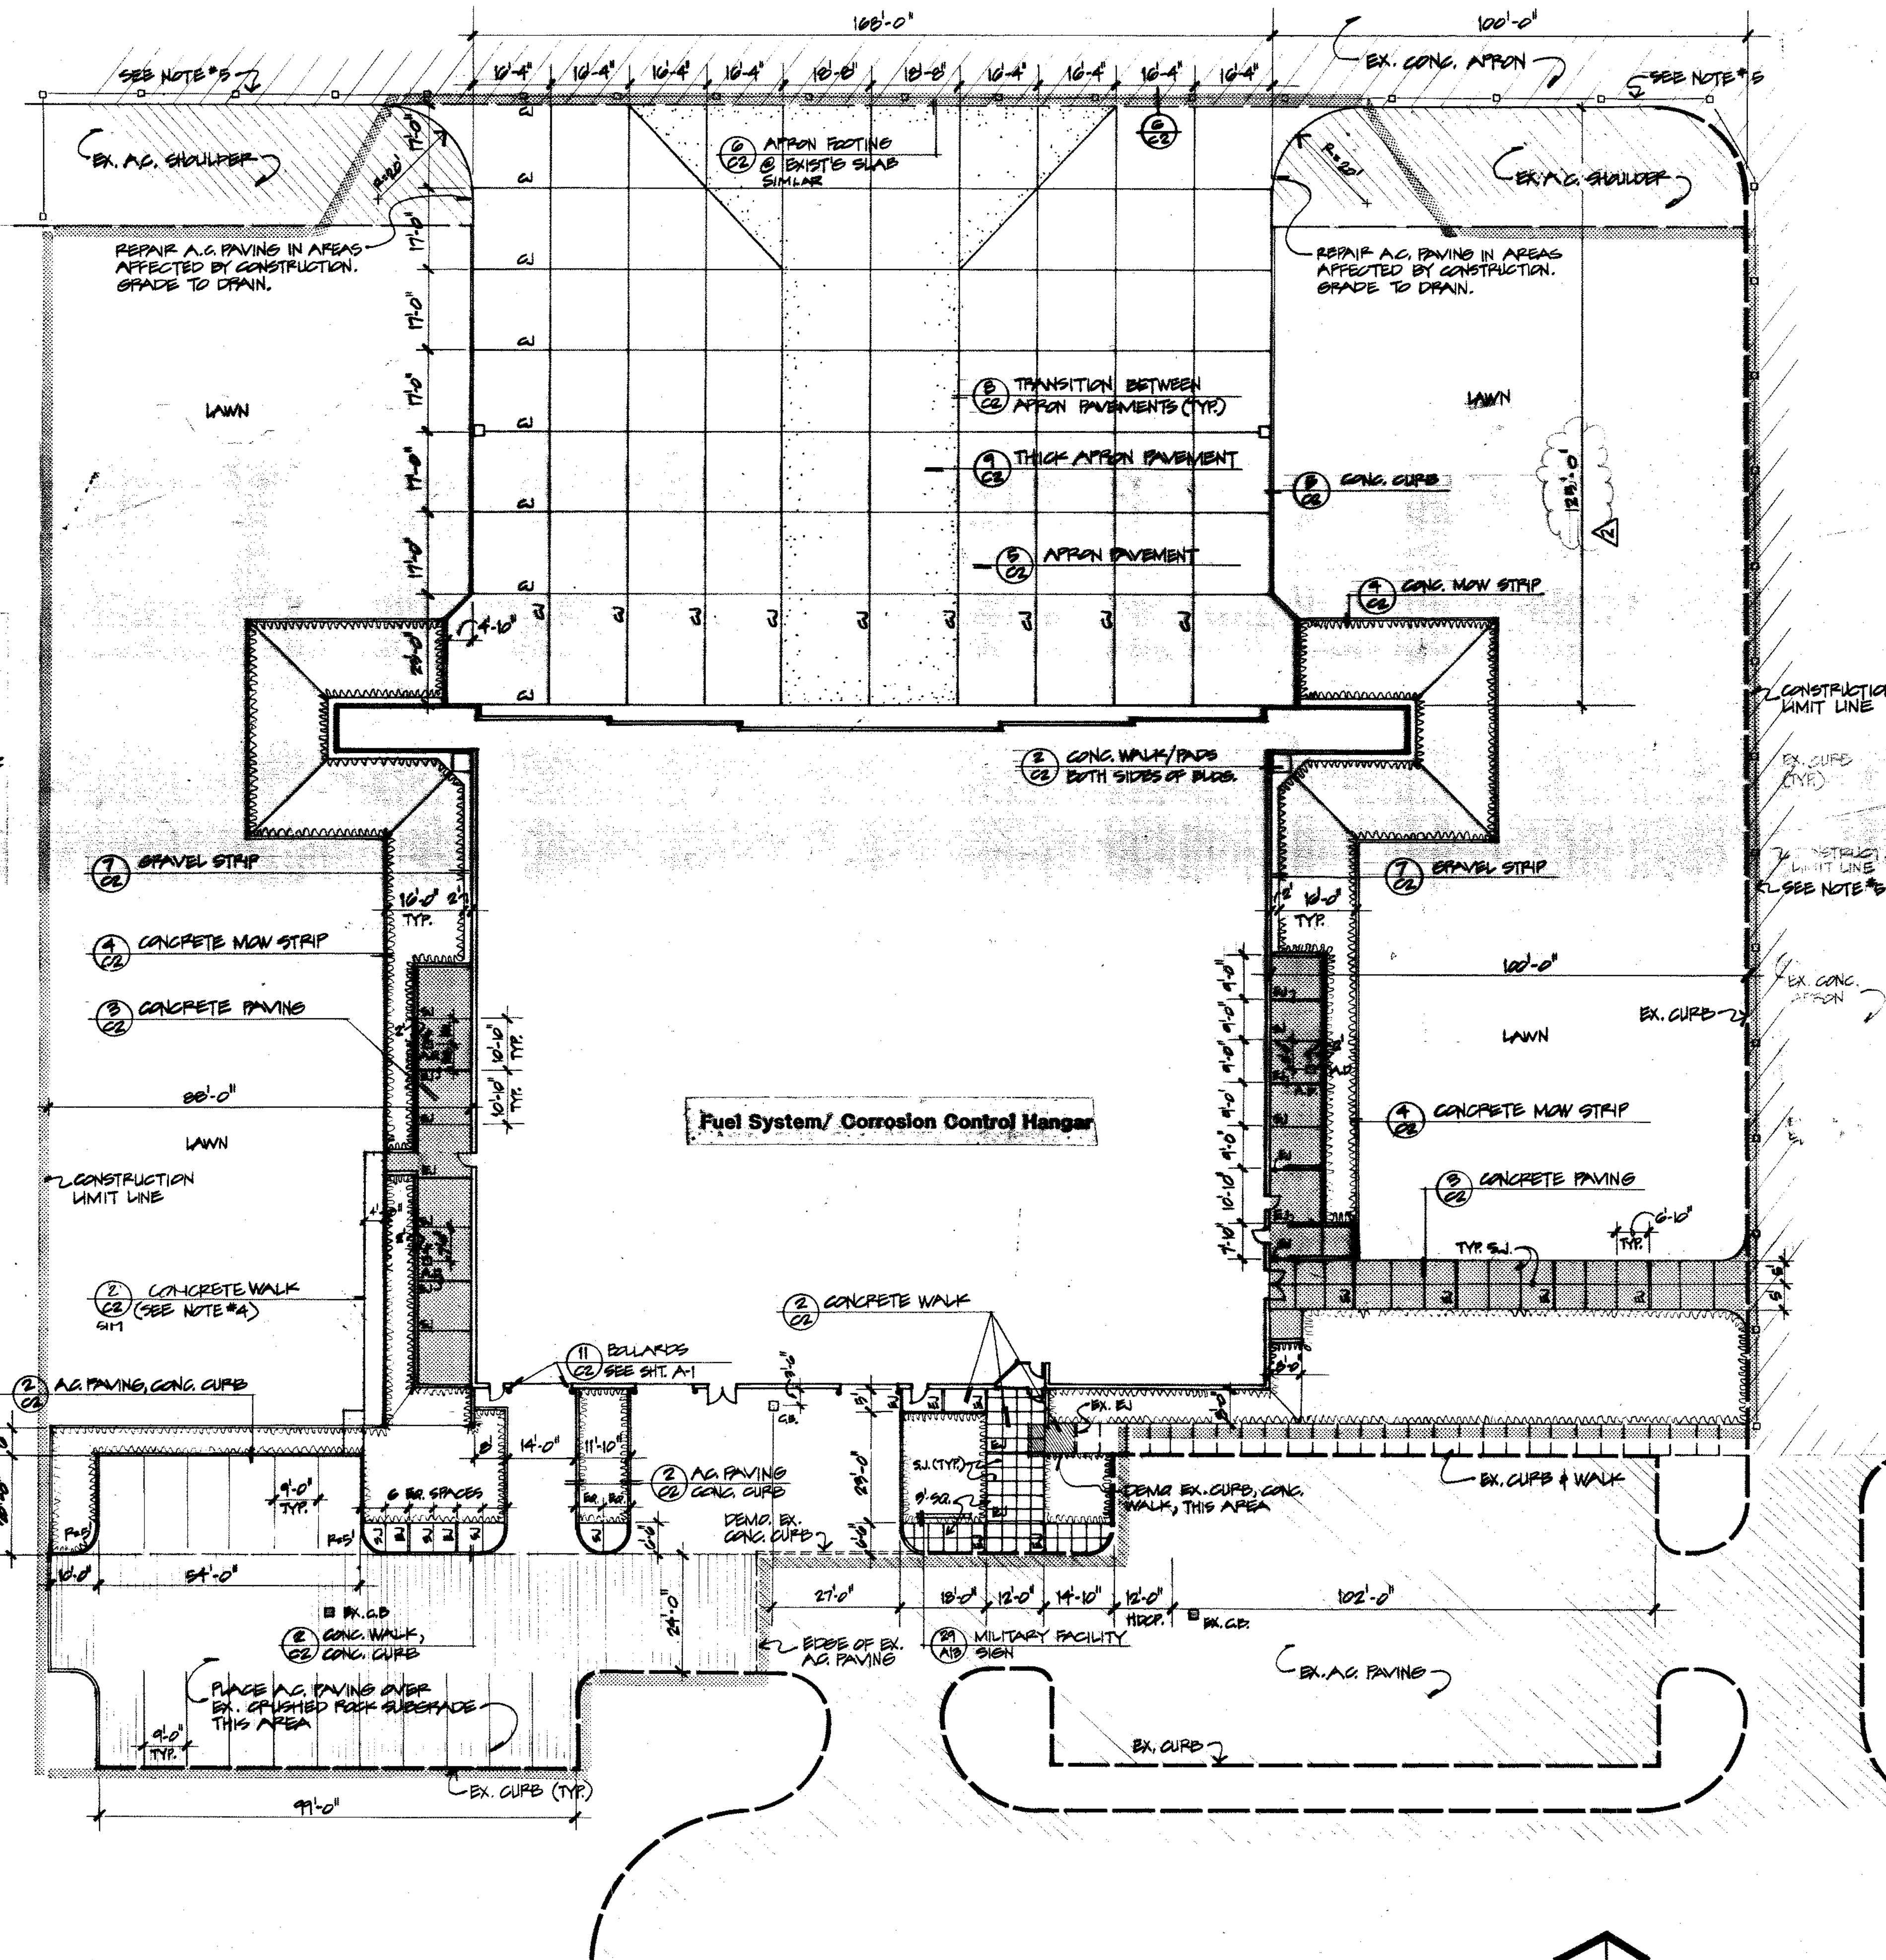

1
C2 **SITE PLAN**
1" = 20'-0"

Notes

1. DISCREPANCIES BETWEEN DWGS. & EX. SITE CONDITIONS SHALL BE BROUGHT TO THE CONTRACTING OFFICER'S ATTENTION PRIOR TO PROCEEDING.
2. DIMENSIONS ARE TAKEN @ 90° FROM FACE OF CURB OF BUILDING UNLESS NOTED OTHERWISE.
3. COORDINATE SITE ACCESS, JOB STACK LOCATION & AREAS FOR MATERIALS STOCKPILE W/ CONTRACTING OFFICER.
4. APPROXIMATE NUMBER OF BLOCKS SHOWN, CONTRACTOR TO DETERMINE EXACT QUANTITY.
5. PROVIDE TEMPORARY 6' HIGH CHAINLINK FENCING AROUND EAST & NORTH PERIMPHRY AS SHOWN.




DATE: FEB. 21, 1994
JOB NO.: 84-125
REVISIONS: 1. 11-14-87
AS BUILT




C-2

RECORD DRAWINGS FROM INFORMATION SUPPLIED BY THE GENERAL CONTRACTOR



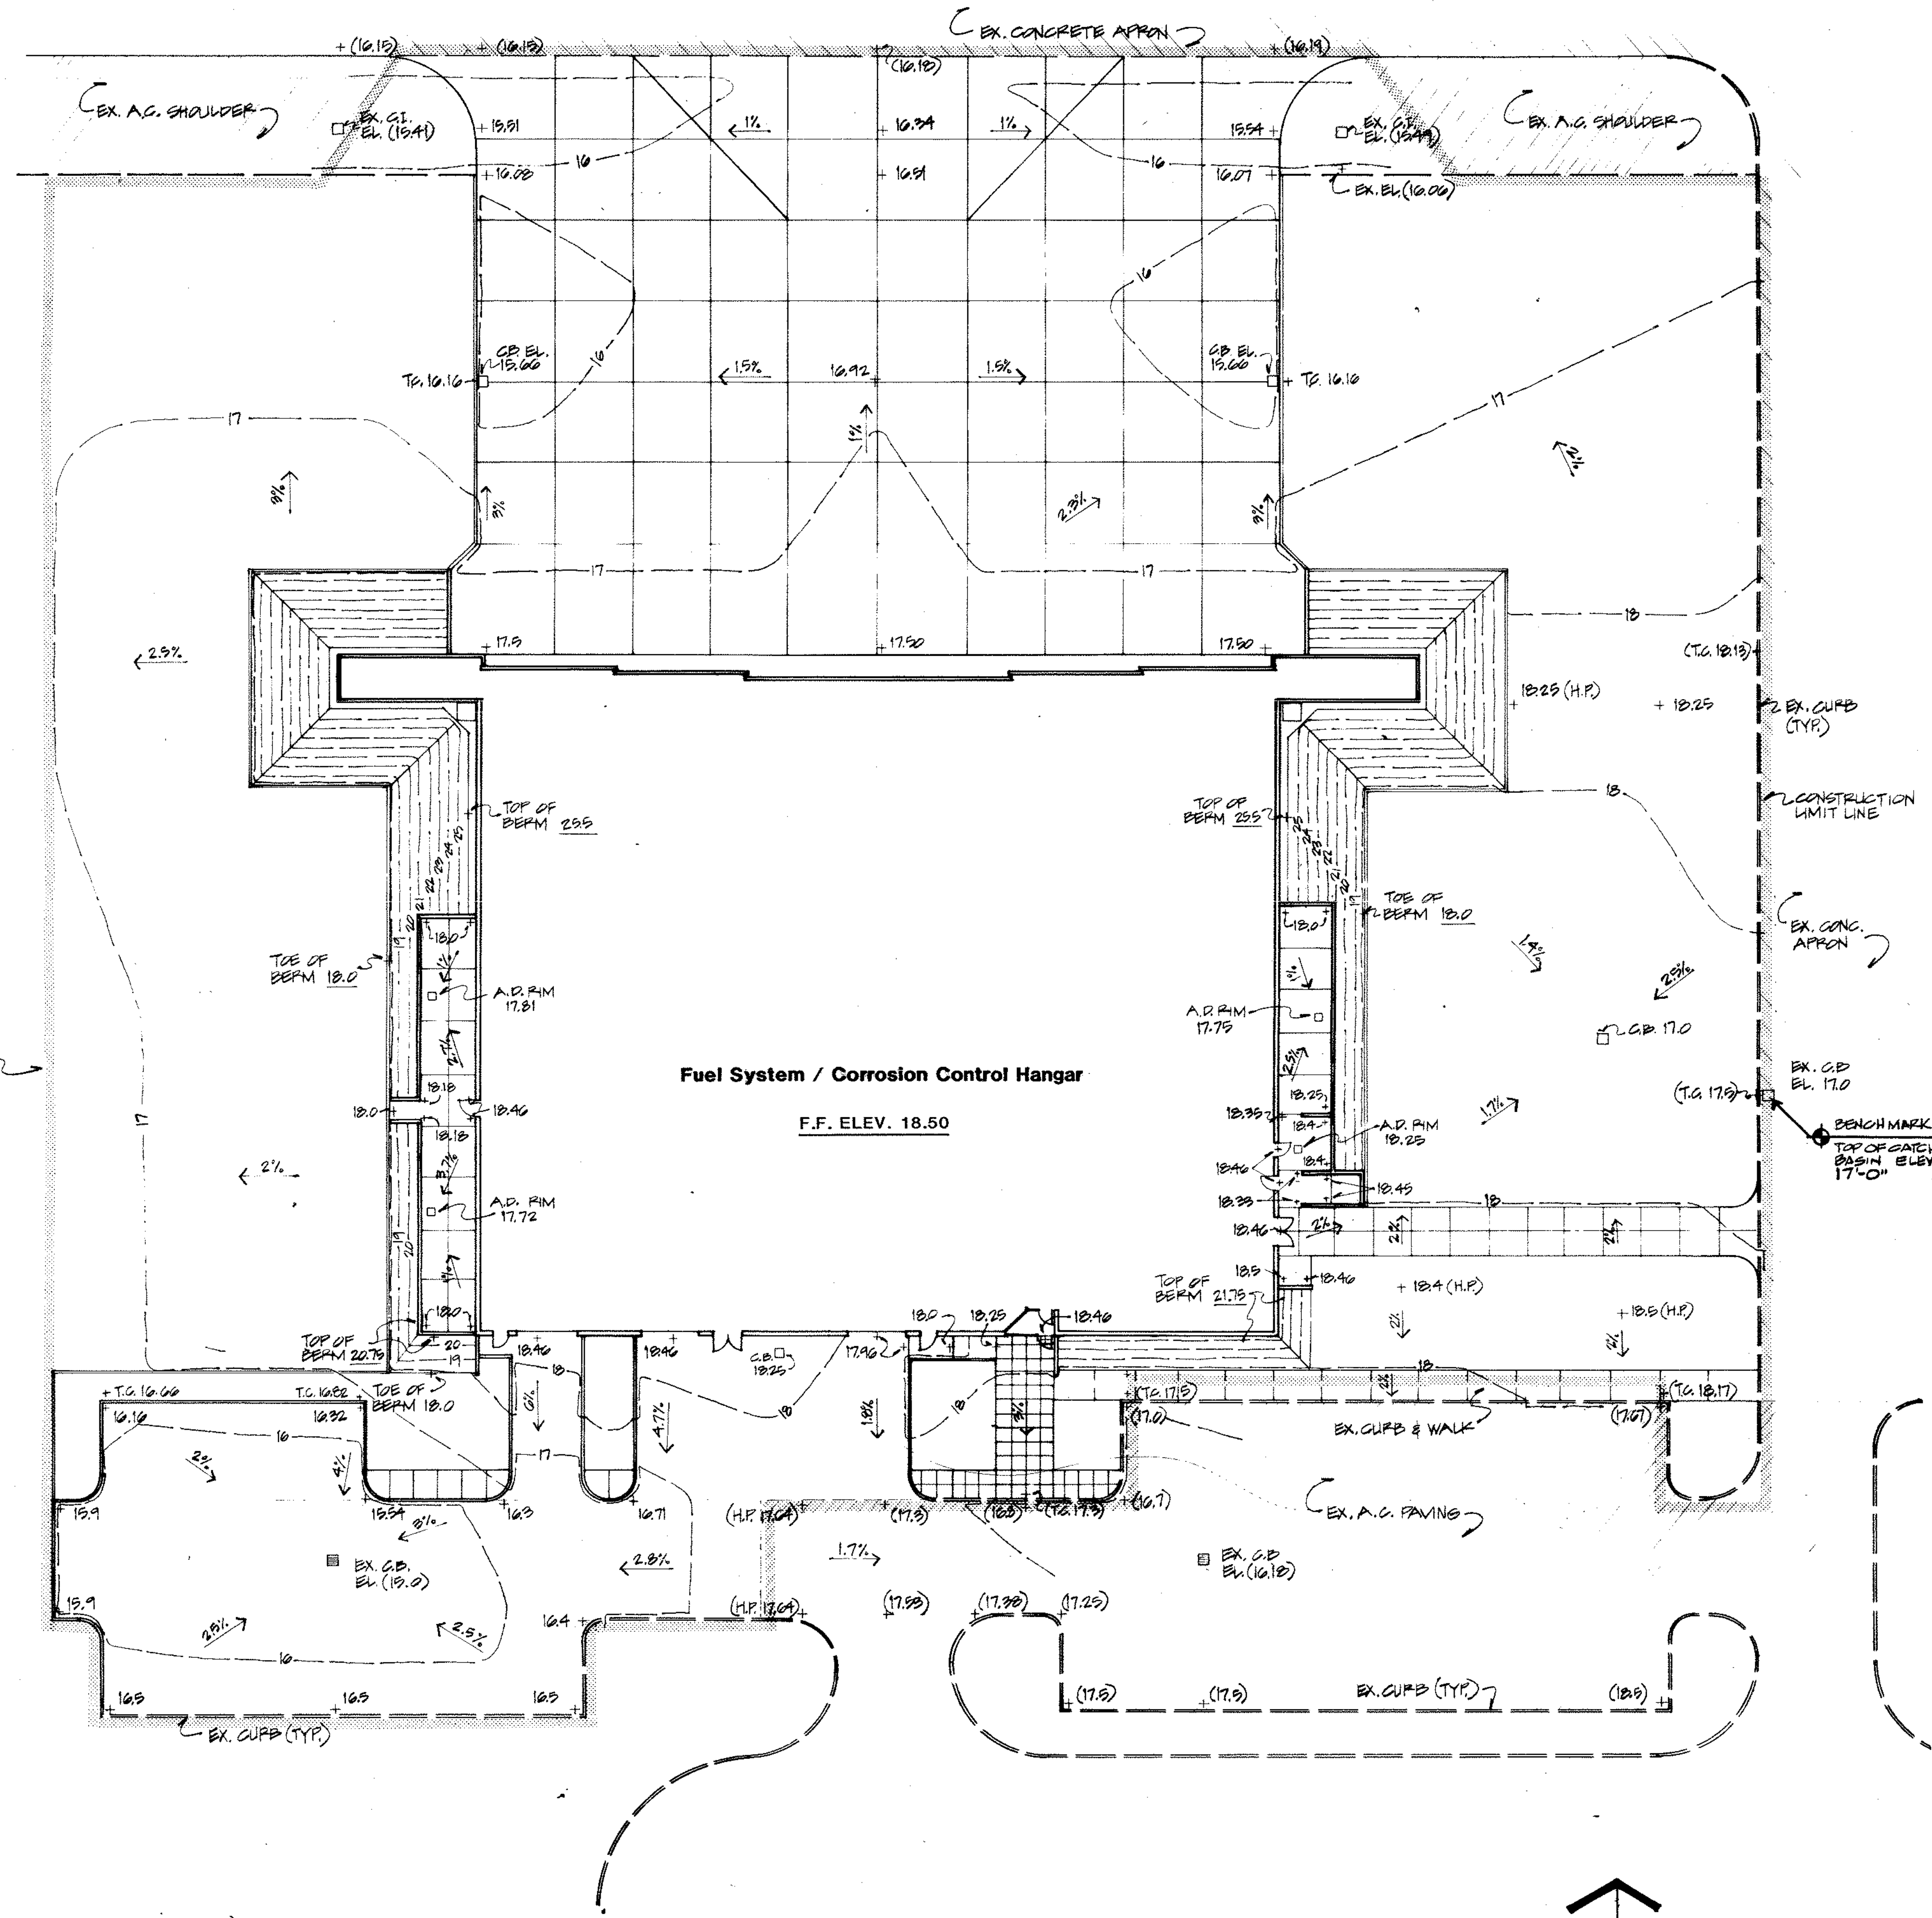

1
C-3
GRADING PLAN
1" = 20'-0"

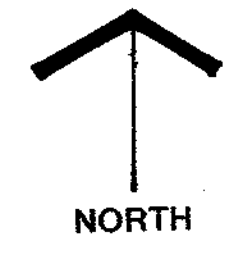


Legend


- + 17.32 SPOT ELEVATION (FINISH GRADES)
- (19.12) EXISTING GRADES
- 1.5% DIRECTION & PERCENTAGE OF SLOPE
- H.P. HIGH POINT
- A.D. AREA DRAIN
- GRADE LINES
- T.C. TOP OF CURB
- EL. ELEVATION
- EX. EXISTING
- TYP. TYPICAL

Notes

1. GRADE SMOOTH TRANSITIONS BETWEEN SPOT ELEVATIONS SHOWN & BETWEEN NEW & EXISTING GRADES.
2. WHERE APRON PAVEMENT BISECTS EX. ASPHALT SHOULDER, REGRADE ASPHALT TO DRAIN AWAY FROM APRON PAVEMENT.
3. SUBGRADES FOR LAWN AREAS SHOULD BE 4" BELOW GRADES SHOWN TO ALLOW FOR SOIL PREPARATION. SUBGRADES FOR GROUNDCOVER AREAS SHOULD BE 6" BELOW GRADES SHOWN TO ALLOW FOR SOIL PREPARATION & BARK MULCH.
4. SEE SHEET C1 FOR EXISTING PRELOAD TO BE REMOVED.
5. TOP OF CURB (T.C.) WILL BE ASSUMED 6" (8") ABOVE ADJACENT PAVED AREAS UNLESS NOTED OTHERWISE.
- 6.

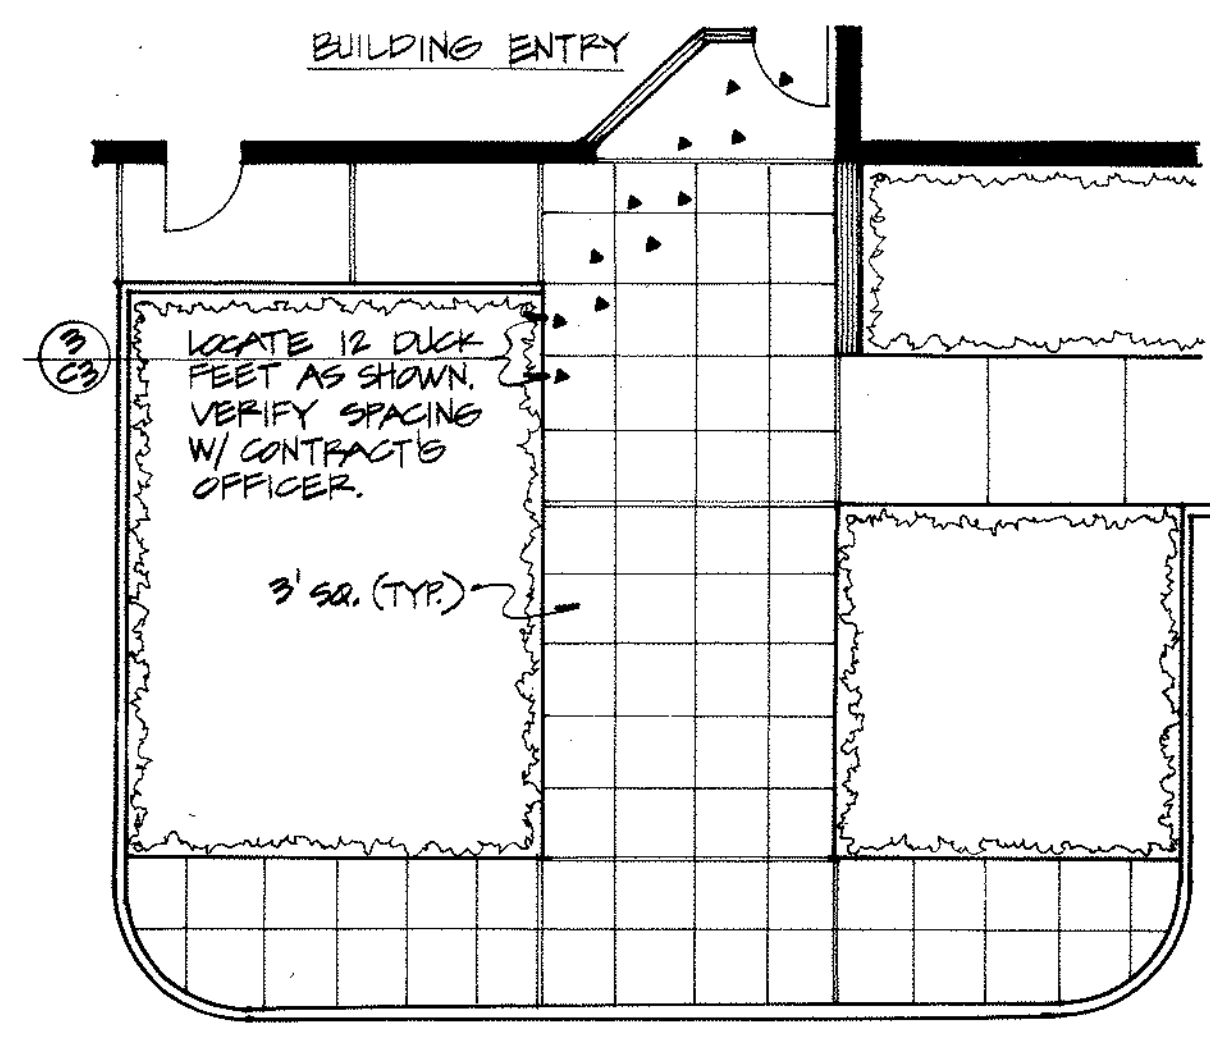


2
C-3
Duck Feet Placement

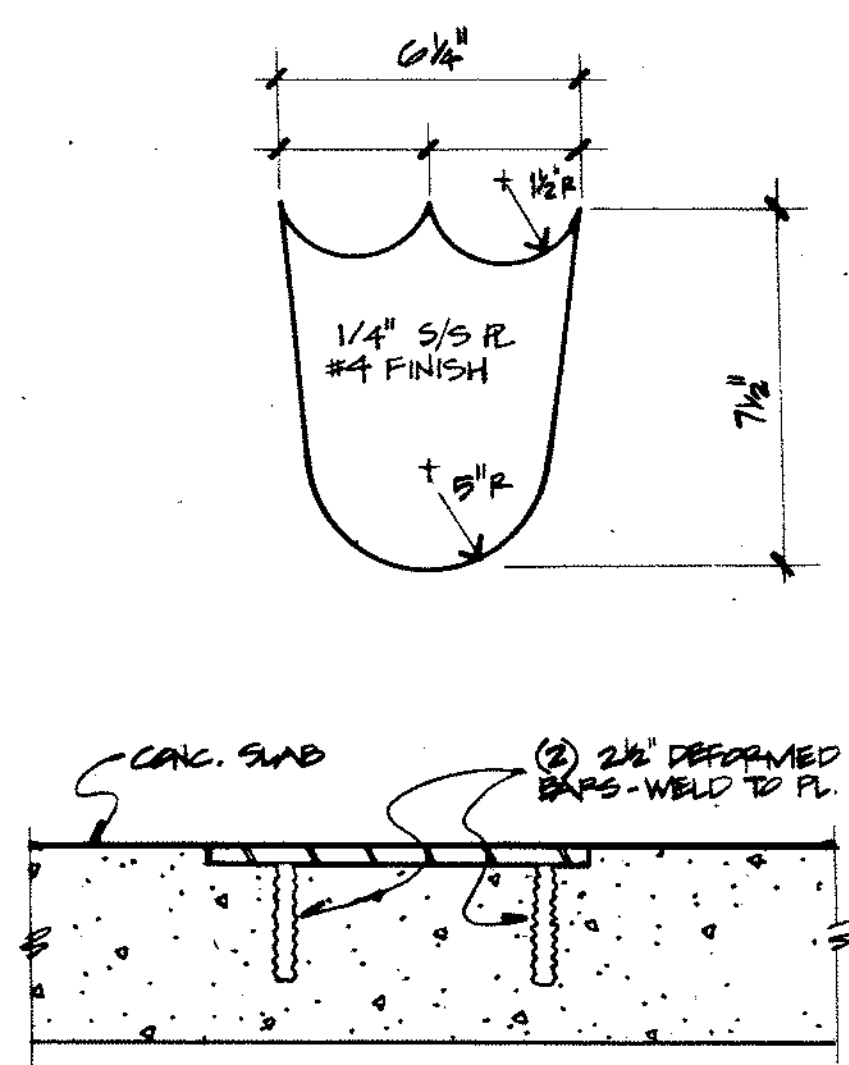

3
C-3
Duck Feet Detail

DATE: JAN. 7, 1986
JOB NO: 84-125
REVISIONS:



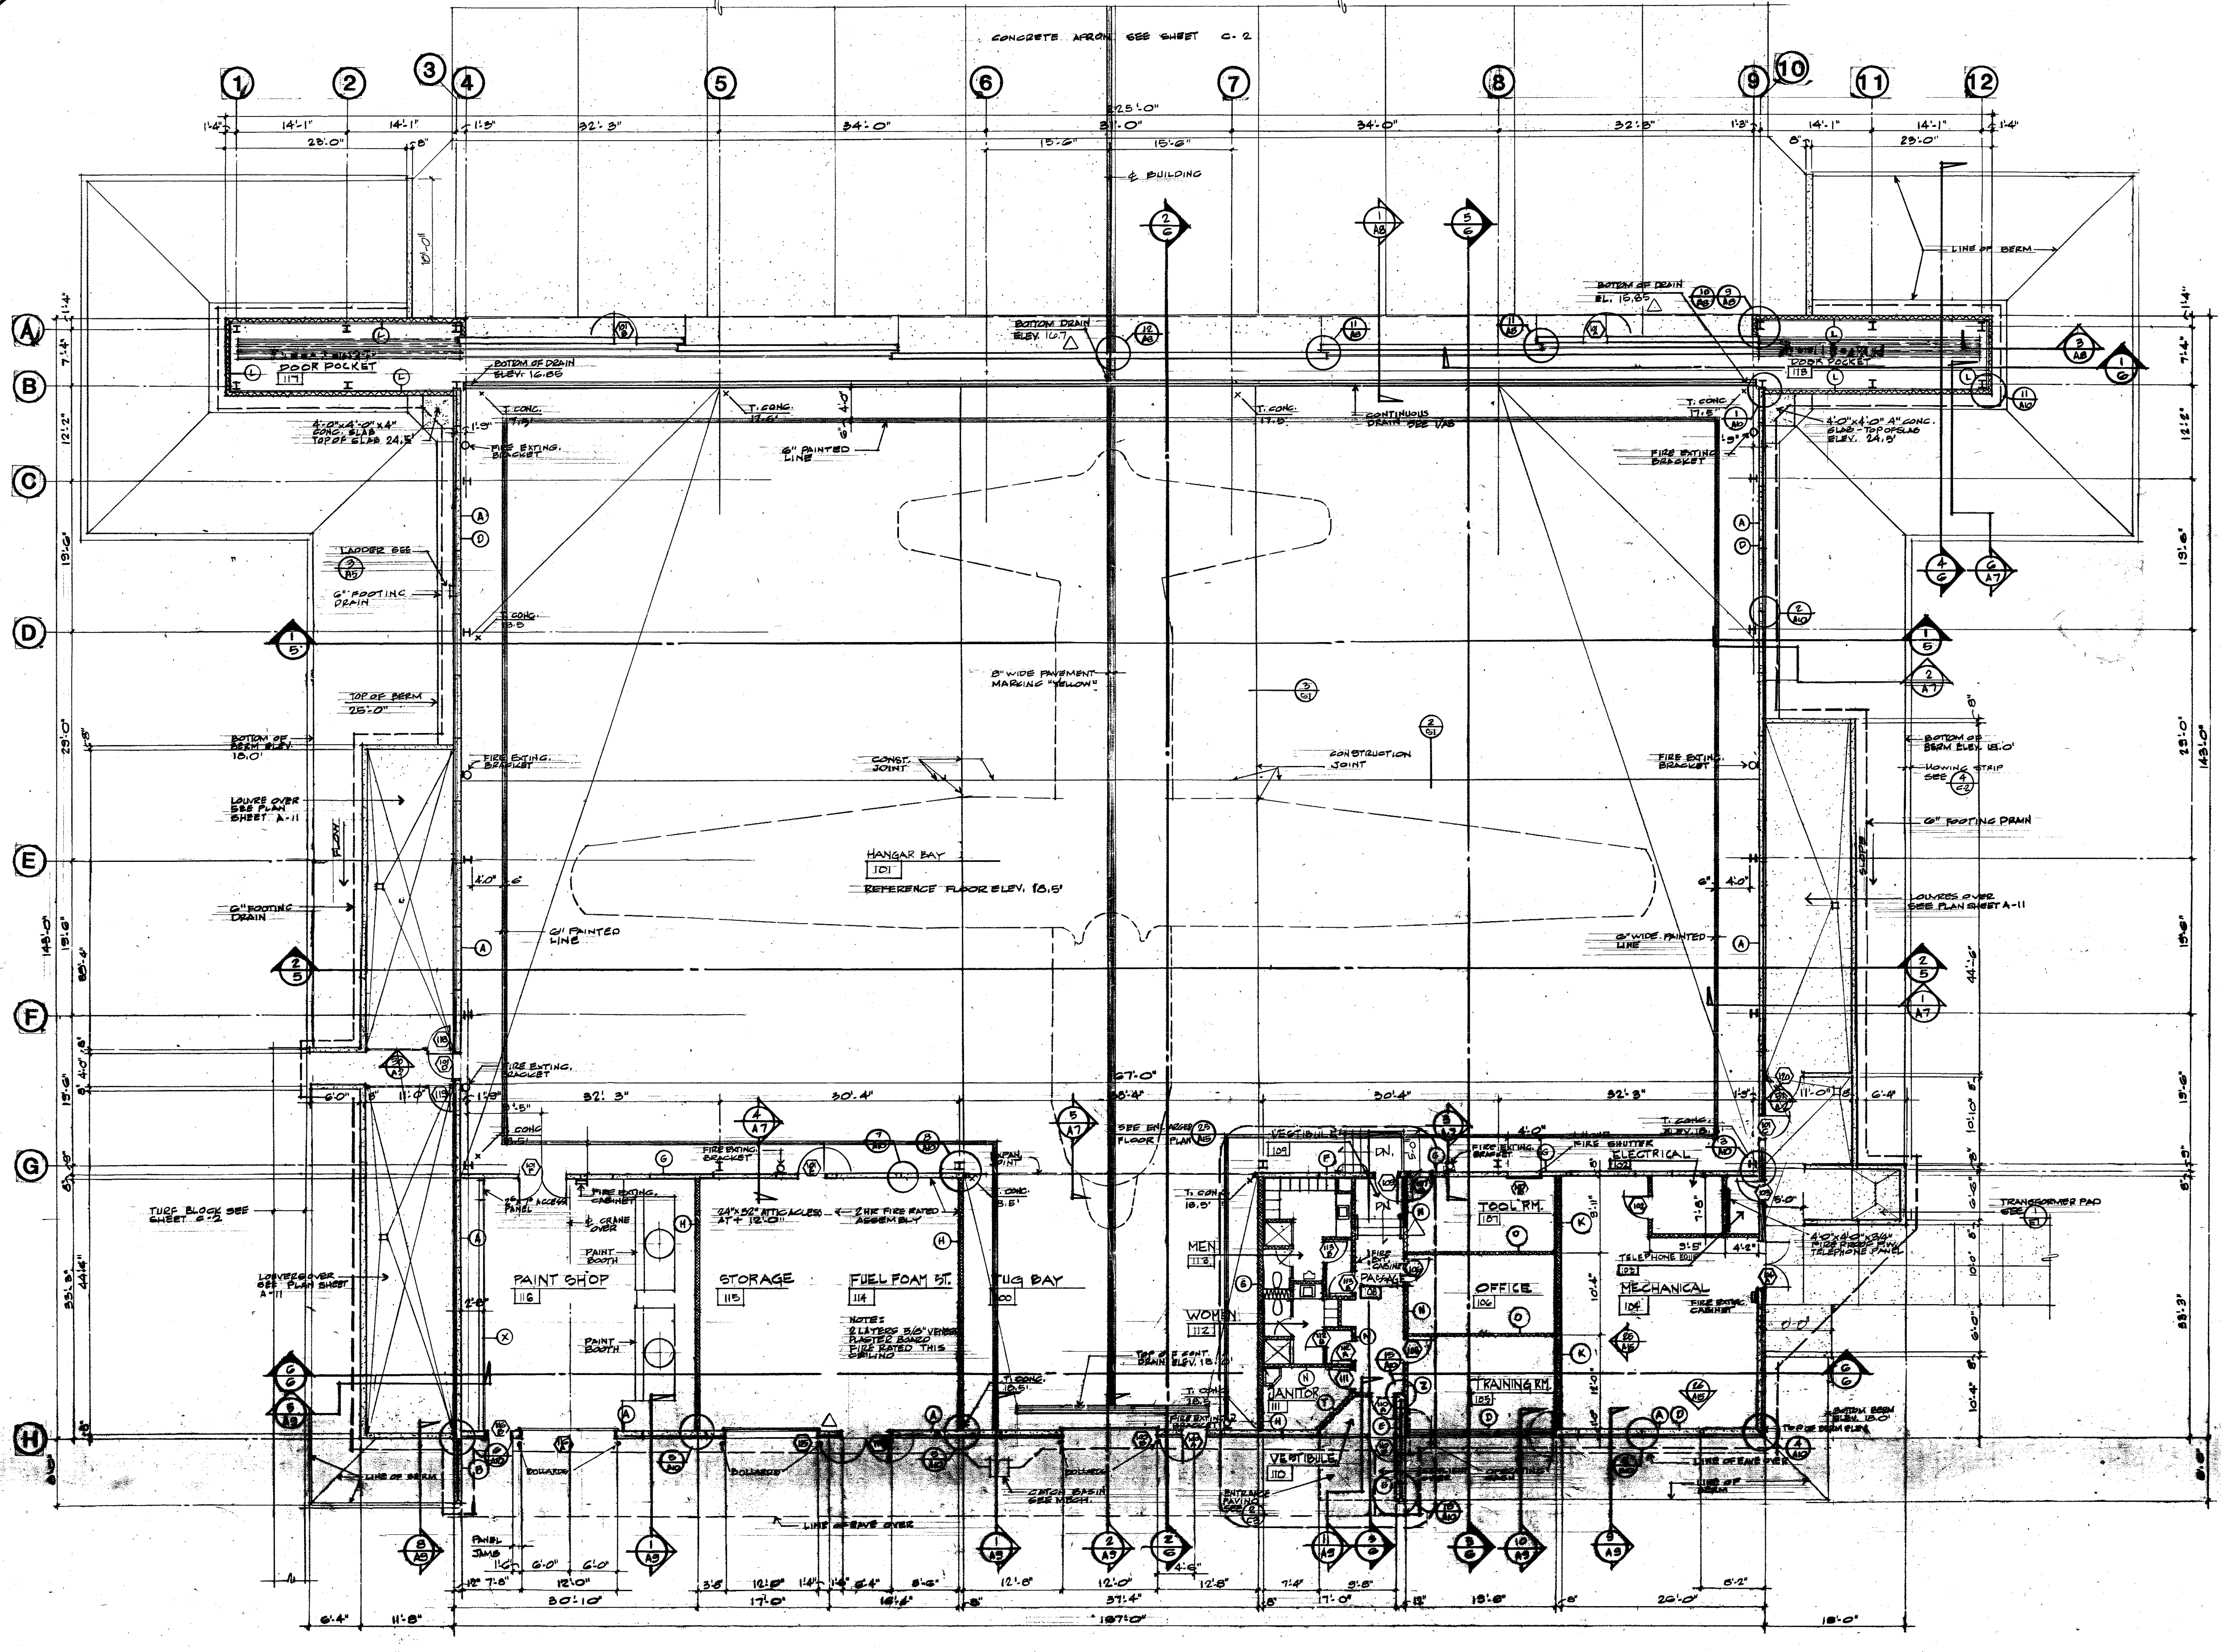

FLOOR PLAN
 SCALE: 1/8" = 1'-0"
 GRAPHIC SCALE

RECORD DRAWINGS FROM
 INFORMATION SUPPLIED BY
 THE GENERAL CONTRACTOR

miller-cook architects a.i.a.
 30 NW 7th Ave.
 PORTLAND, OREGON 97208
 (503) 228-0822

REGISTERED ARCHITECT
 J. C. MILLER
 PORTLAND, OREGON
 STATE OF OREGON

**C-130 FUEL SYSTEM / CORROSION CONTROL
 MAINTENANCE HANGAR
 304th AIR RESCUE RECOVERY SQUADRON
 PORTLAND INTERNATIONAL AIRPORT
 PORTLAND, OREGON**

DATE: FEB. 20, 1980
 JOB NO: 84-128
 REVISIONS: REVISION 1 REVISION 2 REVISION 3

A-1

DOOR SCHEDULE

NO.	SIZE	TYPE	HOUR	HARDWARE	LITE	DOOR				REMARKS			
						SUBSTRATE	FRAME	DETAIL	HEAD				
100 A	5'0" x 7'0" x 1 3/4"	A	3	B		H.M.	14	H.M.	13	14	14	26	
100 B	12'0" x 12'0"	H	11			STEEL TUBE	14	STEEL TUBE	13	16	22	28	ROLLING DOOR
101 A	3'0" x 8'0" x 1 3/4"	E	2	4x25'		H.M.	14	H.M.	13	15	21	27	
101 B	3'0" x 8'0" x 1 3/4"	E	2	4x25'		H.M.	14	H.M.	13	15	21	27	
101 C	3'0" x 7'0" x 1 3/4"	A	3			H.M.	14	H.M.	13	14	14	26	
101 D	3'0" x 7'0" x 1 3/4"	A	3			H.M.	14	H.M.	13	14	14	26	
101 E	3'0" x 7'0" x 1 3/4"	A	3			H.M.	14	H.M.	13	14	14	26	
101 F	PR. 3'0" x 7'0" x 1 3/4"	F	1 HR	B		H.M.	14	H.M.	13	19	19		
102	3'0" x 7'0" x 1 3/4"	A	3			H.M.	14	H.M.	13	13	13		
103	3'0" x 7'0" x 1 3/4"	A	3			H.M.	14	H.M.	13	14	14	26	
104	PR. 3'0" x 7'0" x 1 3/4"	F	7			H.M.	14	H.M.	13	14	14	26	
105	3'0" x 7'0" x 1 3/4"	A	1 HR	3		H.M.	14	H.M.	13	13	13		
106	3'0" x 7'0" x 1 3/4"	A	1 HR	3		H.M.	14	H.M.	13	13	13		
107 A	3'0" x 7'0" x 1 3/4"	A	1 HR	3		H.M.	14	H.M.	13	19	19		
107 B	4'0" x 4'0"	G	1 HR	11		S.S.		S.S.		17	23	29	ROLLING FIRE SHUTTER
107 C	3'0" x 7'0" x 1 3/4"	A	1 HR	3		H.M.	14	H.M.	13	13	13		
108	3'0" x 7'0" x 1 3/4"	A	1 HR	3		H.M.	14	H.M.	13	13	13		
109	PR. 3'0" x 7'0" x 1 3/4"	F	7			H.M.	14	H.M.	13	14	14	26	
110	3'0" x 7'0" x 1 3/4"	A	1 HR	3		H.M.	14	H.M.	13	13	13		
111	3'0" x 7'0" x 1 3/4"	A	1 HR	3		H.M.	14	H.M.	13	13	13		
112 A	2'0" x 7'0" x 1 3/4"	A	1 HR	12		H.M.	14	H.M.	13	13	13	25	
112 B	2'0" x 7'0" x 1 3/4"	A	1 HR	12		H.M.	14	H.M.	13	13	13	25	
113 A	2'0" x 7'0" x 1 3/4"	A	1 HR	12		H.M.	14	H.M.	13	13	13	25	
113 B	2'0" x 7'0" x 1 3/4"	A	1 HR	12		H.M.	14	H.M.	13	13	13	25	
114	PR. 3'0" x 7'0" x 1 3/4"	F	7			H.M.	14	H.M.	13	14	14	26	
115	12'0" x 12'0"	H	11			STEEL TUBE	14	STEEL TUBE	13	16	22	28	ROLLING DOOR
116 A	12'0" x 12'0"	H	11			"	14	"	13	16	22	28	ROLLING DOOR
116 B	3'0" x 7'0"	A	3			H.M.	14	H.M.	13	14	14	26	
118	3'0" x 7'0"	GATE				CHAIN LINK		CHAIN LINK					WIRE MESH GATE
119	3'0" x 7'0"	GATE				CHAIN LINK		CHAIN LINK					WIRE MESH GATE
120	3'0" x 7'0"	GATE				CHAIN LINK		CHAIN LINK					WIRE MESH GATE
121	12'0" x 12'0"	H	11			ALUMINUM		ALUMINUM		13-A-B	14-A-B	15-A-B	

ROOM FINISH SCHEDULE



NO.	NAME	FLOOR	BASE	NORTH WALL			EAST WALL			SOUTH WALL			WEST WALL			CEILING	REMARKS		
				SUBSTRATE/FIN.	COGR	TYPE	SUBSTRATE/FIN.	COGR	TYPE	SUBSTRATE/FIN.	COGR	TYPE	SUBSTRATE/FIN.	COGR	TYPE				
100	TUG ACCESS BAY	CONC./HARDNER	NOTES	NONE	-	4,5	CONC./PAINT	4,5	CONC./PAINT	4,5	CONC./PAINT	4,5	CONC./PAINT	4,5	STRUCTURE/PAINT	4	16'10 1/2"	NOTE 3	
101	HANGER BAY	CONC./HARDNER	NOTES	NONE	-	4,5	CONC./PAINT	4,5	CONC./PAINT	4,5	CONC./PAINT	4,5	CONC./PAINT	4,5	STRUCTURE/PAINT	4	16'10 1/2"	NOTE 1	
102	ELECTRICAL	CONC./HARDNER	NOTES	6" RESILIENT	7	VEN. PLAST./PAINT	4	CONC./PAINT	4	VEN. PLAST./PAINT	4	VEN. PLAST./PAINT	4	VEN. PLAST./PAINT	4	STRUCTURE/PAINT	4	17'10 1/2"	NOTES
103	TELEPHONE	CONC./HARDNER	NOTES	6" RESILIENT	7	VEN. PLAST./PAINT	4	CONC./PAINT	4	VEN. PLAST./PAINT	4	VEN. PLAST./PAINT	4	VEN. PLAST./PAINT	4	STRUCTURE/PAINT	4	17'10 1/2"	
104	MECHANICAL	CONC./HARDNER	NOTES	6" RESILIENT	7	VEN. PLAST./PAINT	4	CONC./PAINT	4	VEN. PLAST./PAINT	4	VEN. PLAST./PAINT	4	VEN. PLAST./PAINT	4	STRUCTURE/PAINT	4	17'10 1/2"	
105	TRAINING ROOM	CONC./CARPET	NOTES	6" RESILIENT	7	VEN. PLAST./PAINT	4	CONC./PAINT	4	VEN. PLAST./PAINT	4	VEN. PLAST./PAINT	4	VEN. PLAST./PAINT	4	STRUCTURE/PAINT	4	17'10 1/2"	
106	OFFICE	CONC./CARPET	NOTES	6" RESILIENT	7	VEN. PLAST./PAINT	4	CONC./PAINT	4	VEN. PLAST./PAINT	4	VEN. PLAST./PAINT	4	VEN. PLAST./PAINT	4	STRUCTURE/PAINT	4	17'10 1/2"	
107	TOOL ROOM	CONC./HARDNER	NOTES	6" RESILIENT	7	VEN. PLAST./PAINT	4	CONC./PAINT	4	VEN. PLAST./PAINT	4	VEN. PLAST./PAINT	4	VEN. PLAST./PAINT	4	STRUCTURE/PAINT	4	17'10 1/2"	
118	DOOR POCKET	CONC./HARDNER	NOTES	6" RESILIENT	7	VEN. PLAST./PAINT	4	CONC./PAINT	4	VEN. PLAST./PAINT	4	VEN. PLAST./PAINT	4	VEN. PLAST./PAINT	4	STRUCTURE/PAINT	4	17'10 1/2"	

COLOR SELECTION


1. 304 WHITE OR PAINT TO MATCH
 2. PREFINISHED METAL MICHIA
 3. RODDA 82 A-1 GRAY DRIFT
 4. RODDA 70 A-5 VANILLA
 5. RODDA 101 B-2 TOMATO SPICE
 6. RODDA 101 B-2 MUTED MESA
 7. BASE FLEXCO NO. 12 SANDWOOD
 8. PLASTIC LAMINATE WILSONART TERESA COTTA D-65-G

9. U.S. CERAMIC 3026 INDIAN RED
 10. U.S. CERAMIC 3025 MUSHROOM
 11. TOILET PARTITIONS LIST NO 220 COPPERTONE
 12. CARPET GULISTAN 1125-500 ANTIQUE COPPER
 13. RODDA 110 B-1 BEAVER
 14. PRATT AND LAMBERT 8222A BITTERSWEET


NOTES:
 1. INSTALL PREFINISHED ACOUSTICAL PANELS ON WALL SURFACES ABOVE CONCRETE WALLS IN HANGER BAY AND DOOR POCKET AREAS
 2. CERAMIC TILE ON WALL SURFACES TO 7'-0" HEIGHT
 3. TROWELED SHAKE, LIGHT REFLECTIVE FLOOR HARDNER
 4. FLOOR TO BE SPARKPROOF CONDUCTIVE FLOOR
 5. CABINETS COLOR NO. 8 TOILET PARTITIONS NO. 11
 6. BOLLARD PAINT COLOR NO. 14

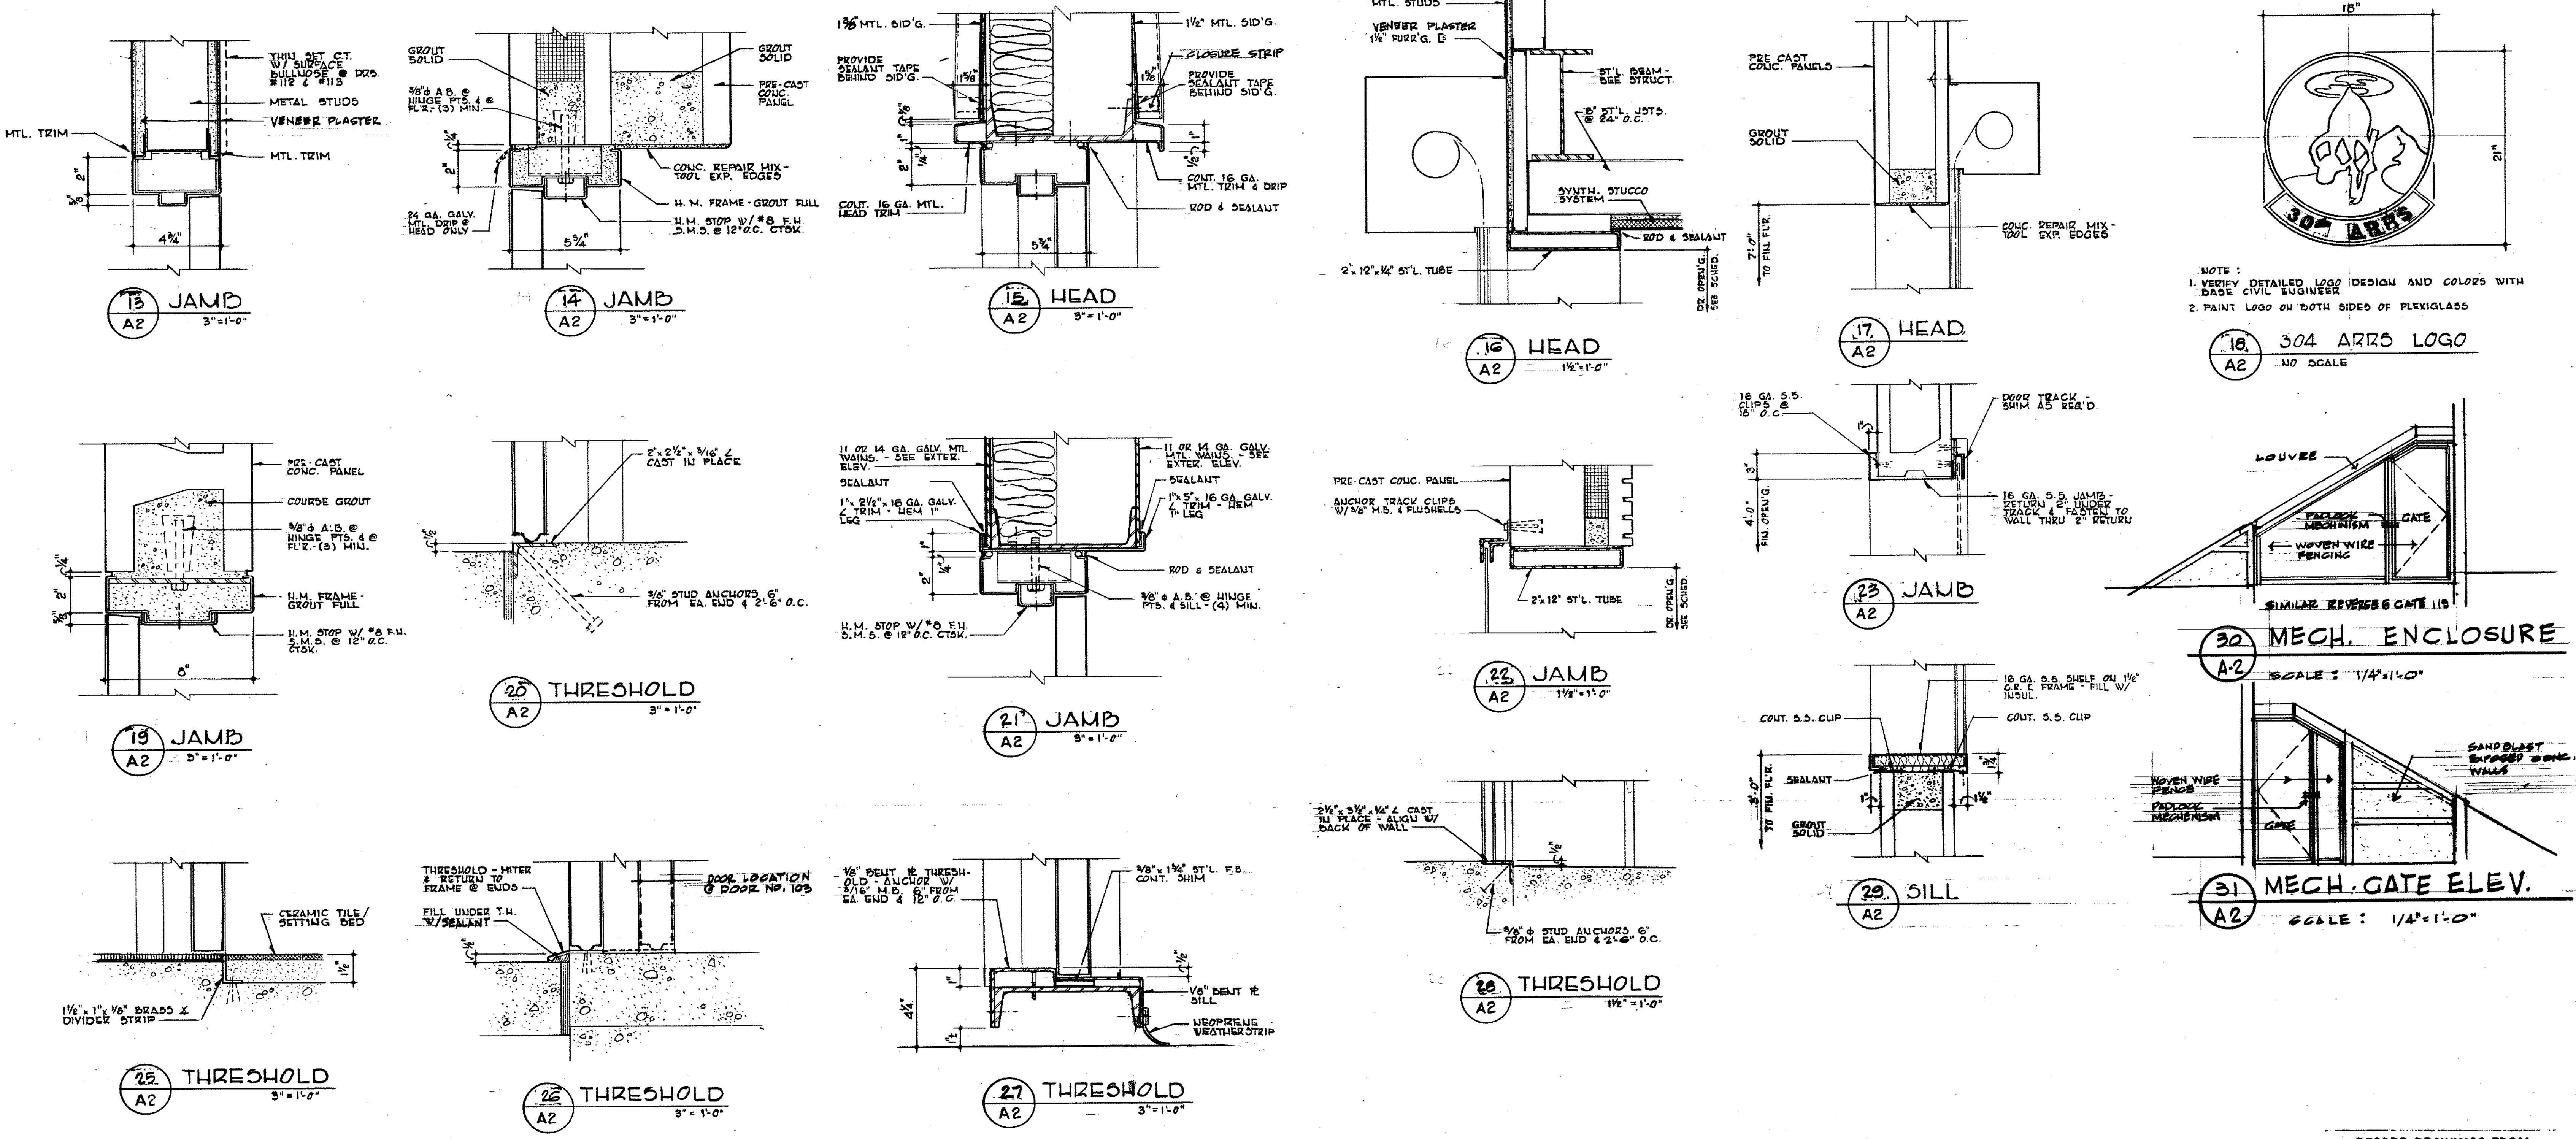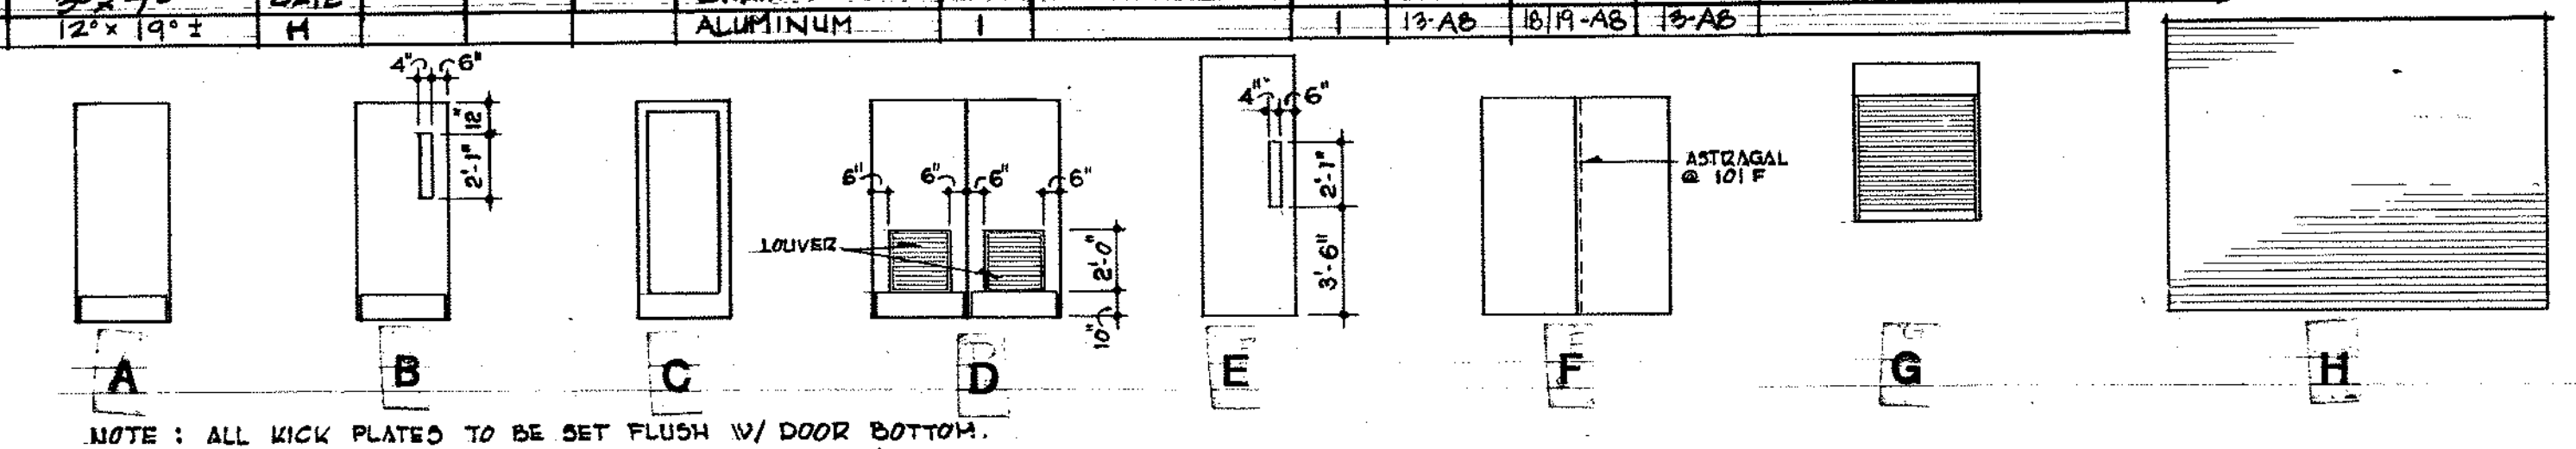


miller-cook architects a.i.a.
 30 N.W. 7th Ave. PORTLAND, OREGON 97208
 (503) 226-0828
 DATE: FEB. 20, 1980
 JOB NO: 84-129
 REVISIONS AS SHOWN 11-10-87
 REGISTERED ARCHITECT
 JACK C. MILLER
 PORTLAND, OREGON 1964
 STATE OF OREGON
 SHEET TITLE: 3008 SCHEDULE AND FINISH SCHEDULE
 C-130 FUEL SYSTEM / CORROSION CONTROL
 MAINTENANCE HANGAR
 304TH AIR RESCUE RECOVERY SQUADRON
 PORTLAND INTERNATIONAL AIRPORT
 OREGON
A-2
 RECORD DRAWINGS FROM INFORMATION SUPPLIED BY THE GENERAL CONTRACTOR
 B-LDB 375

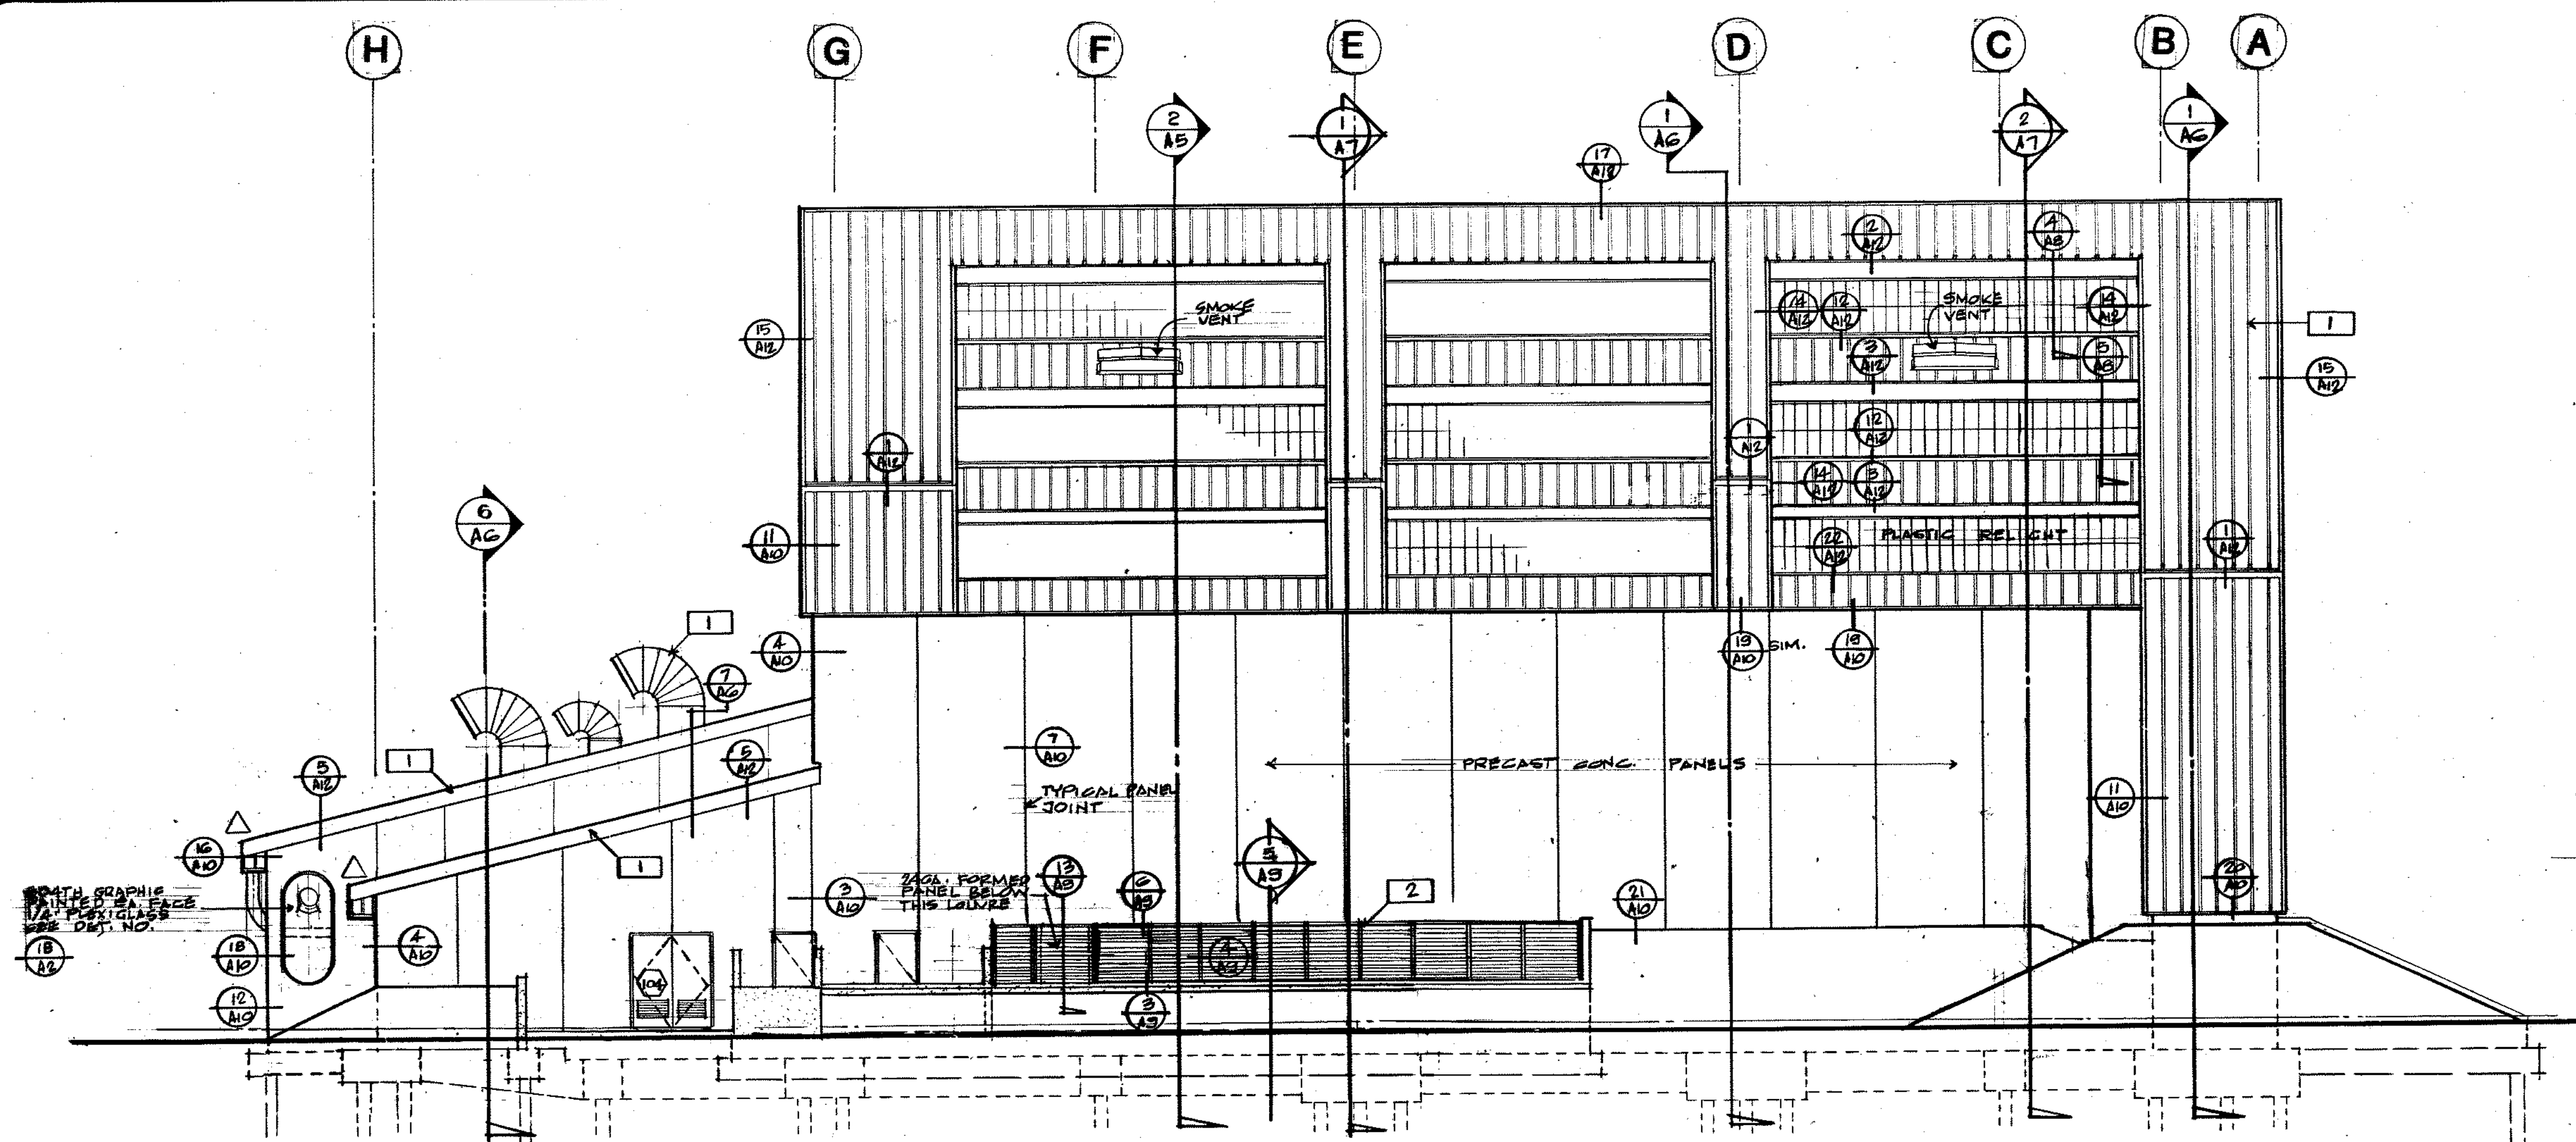

1 EAST ELEVATION
SCALE: 1/8" = 1'-0"

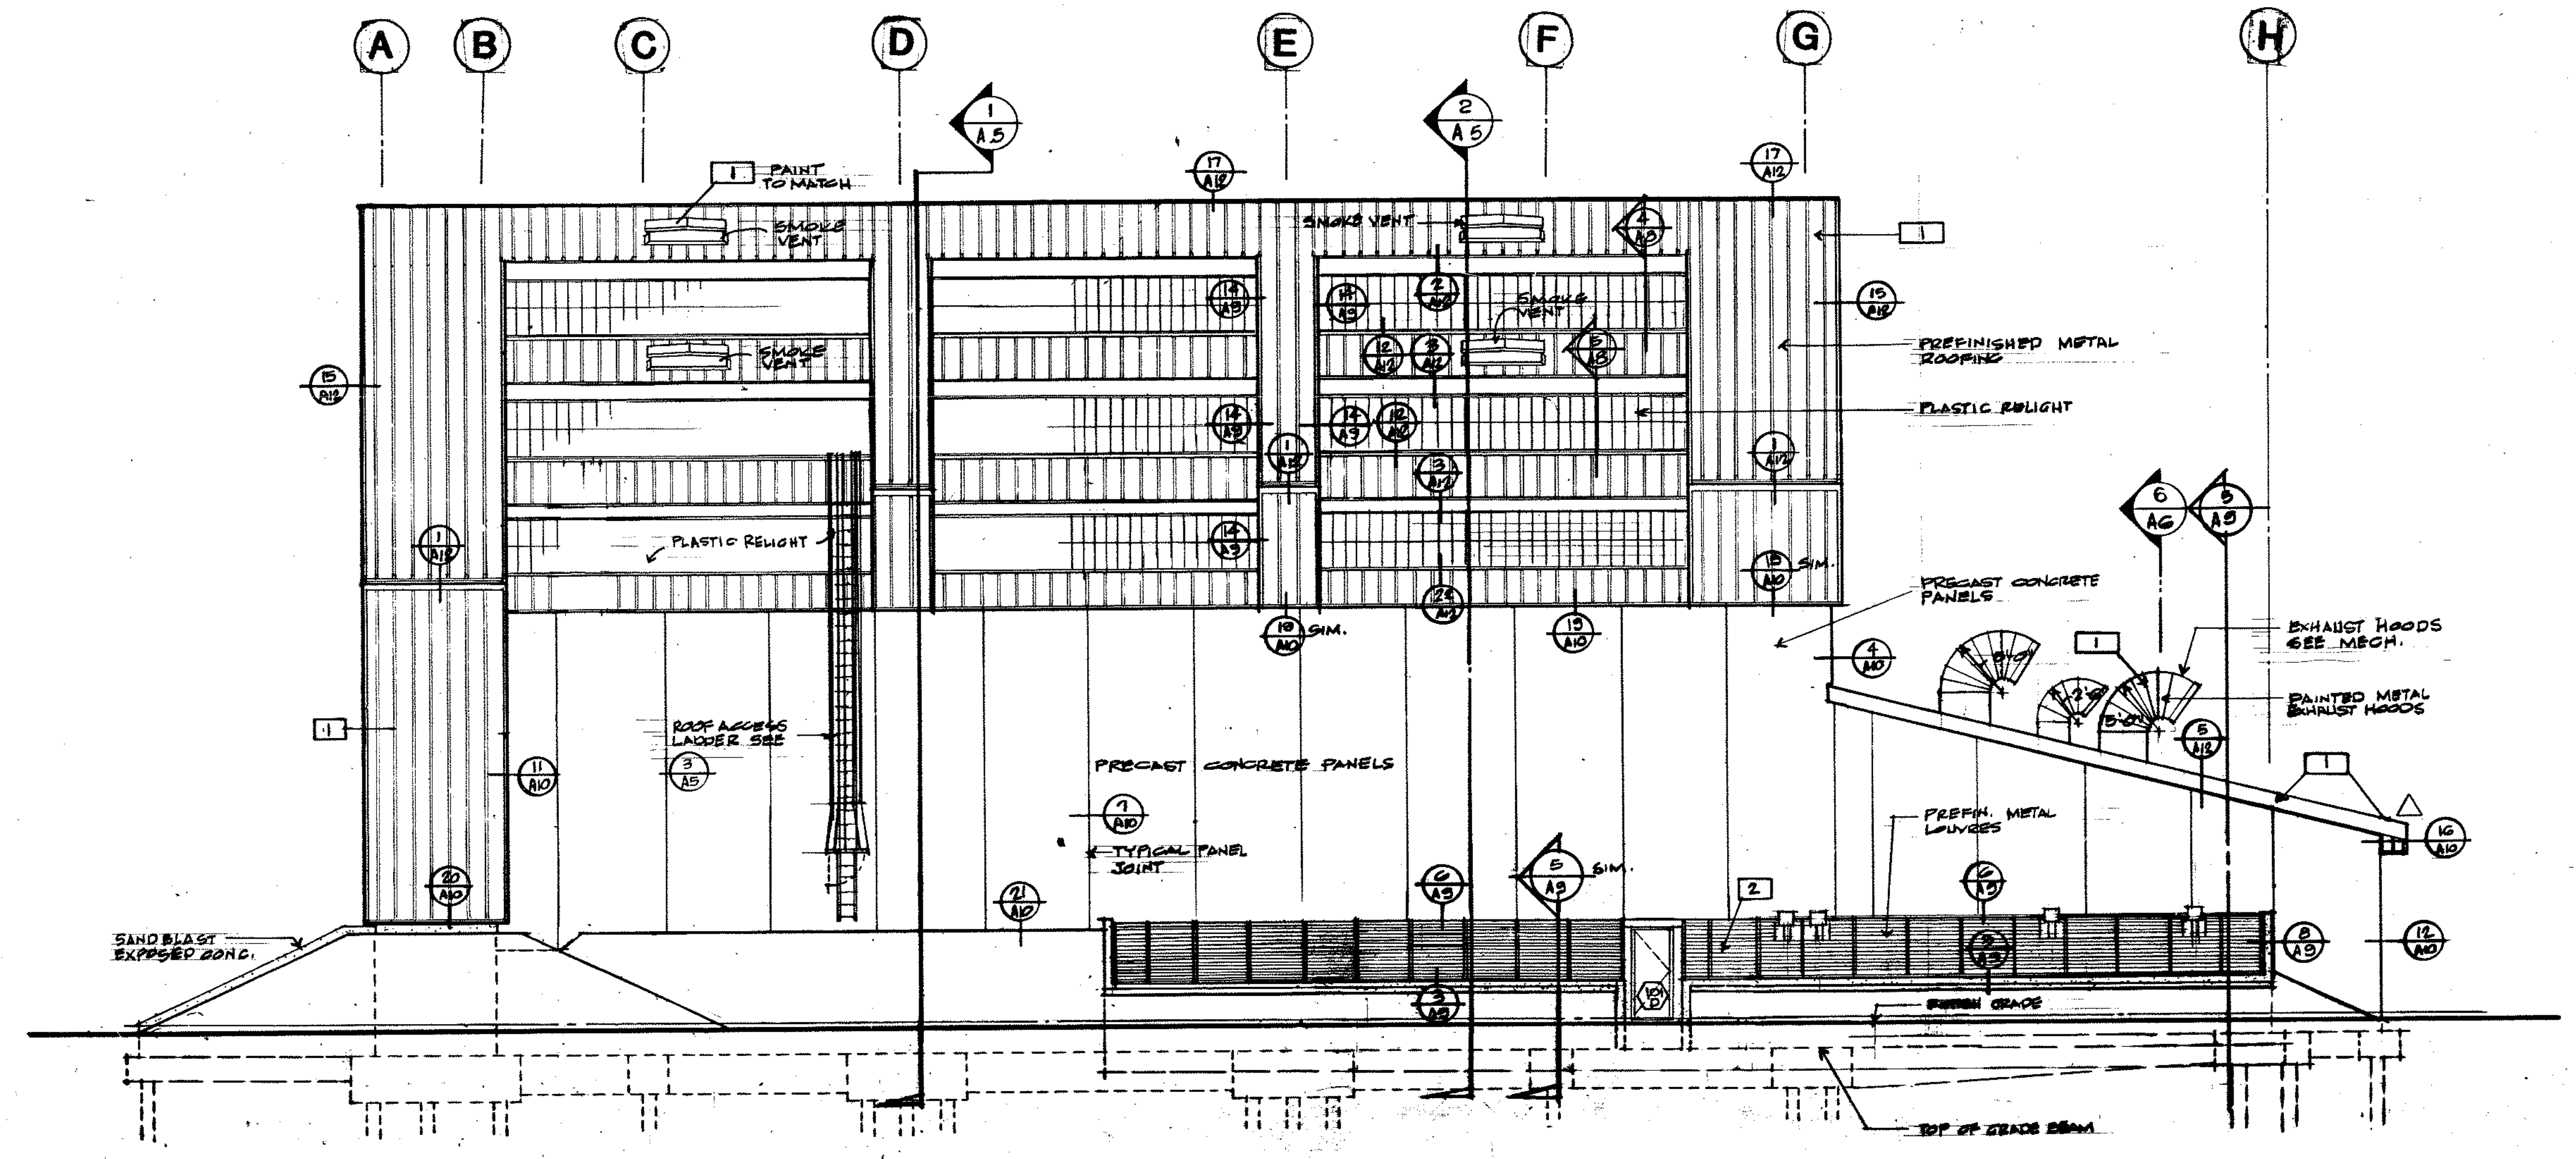

2 WEST ELEVATION
SCALE: 1/8" = 1'-0"

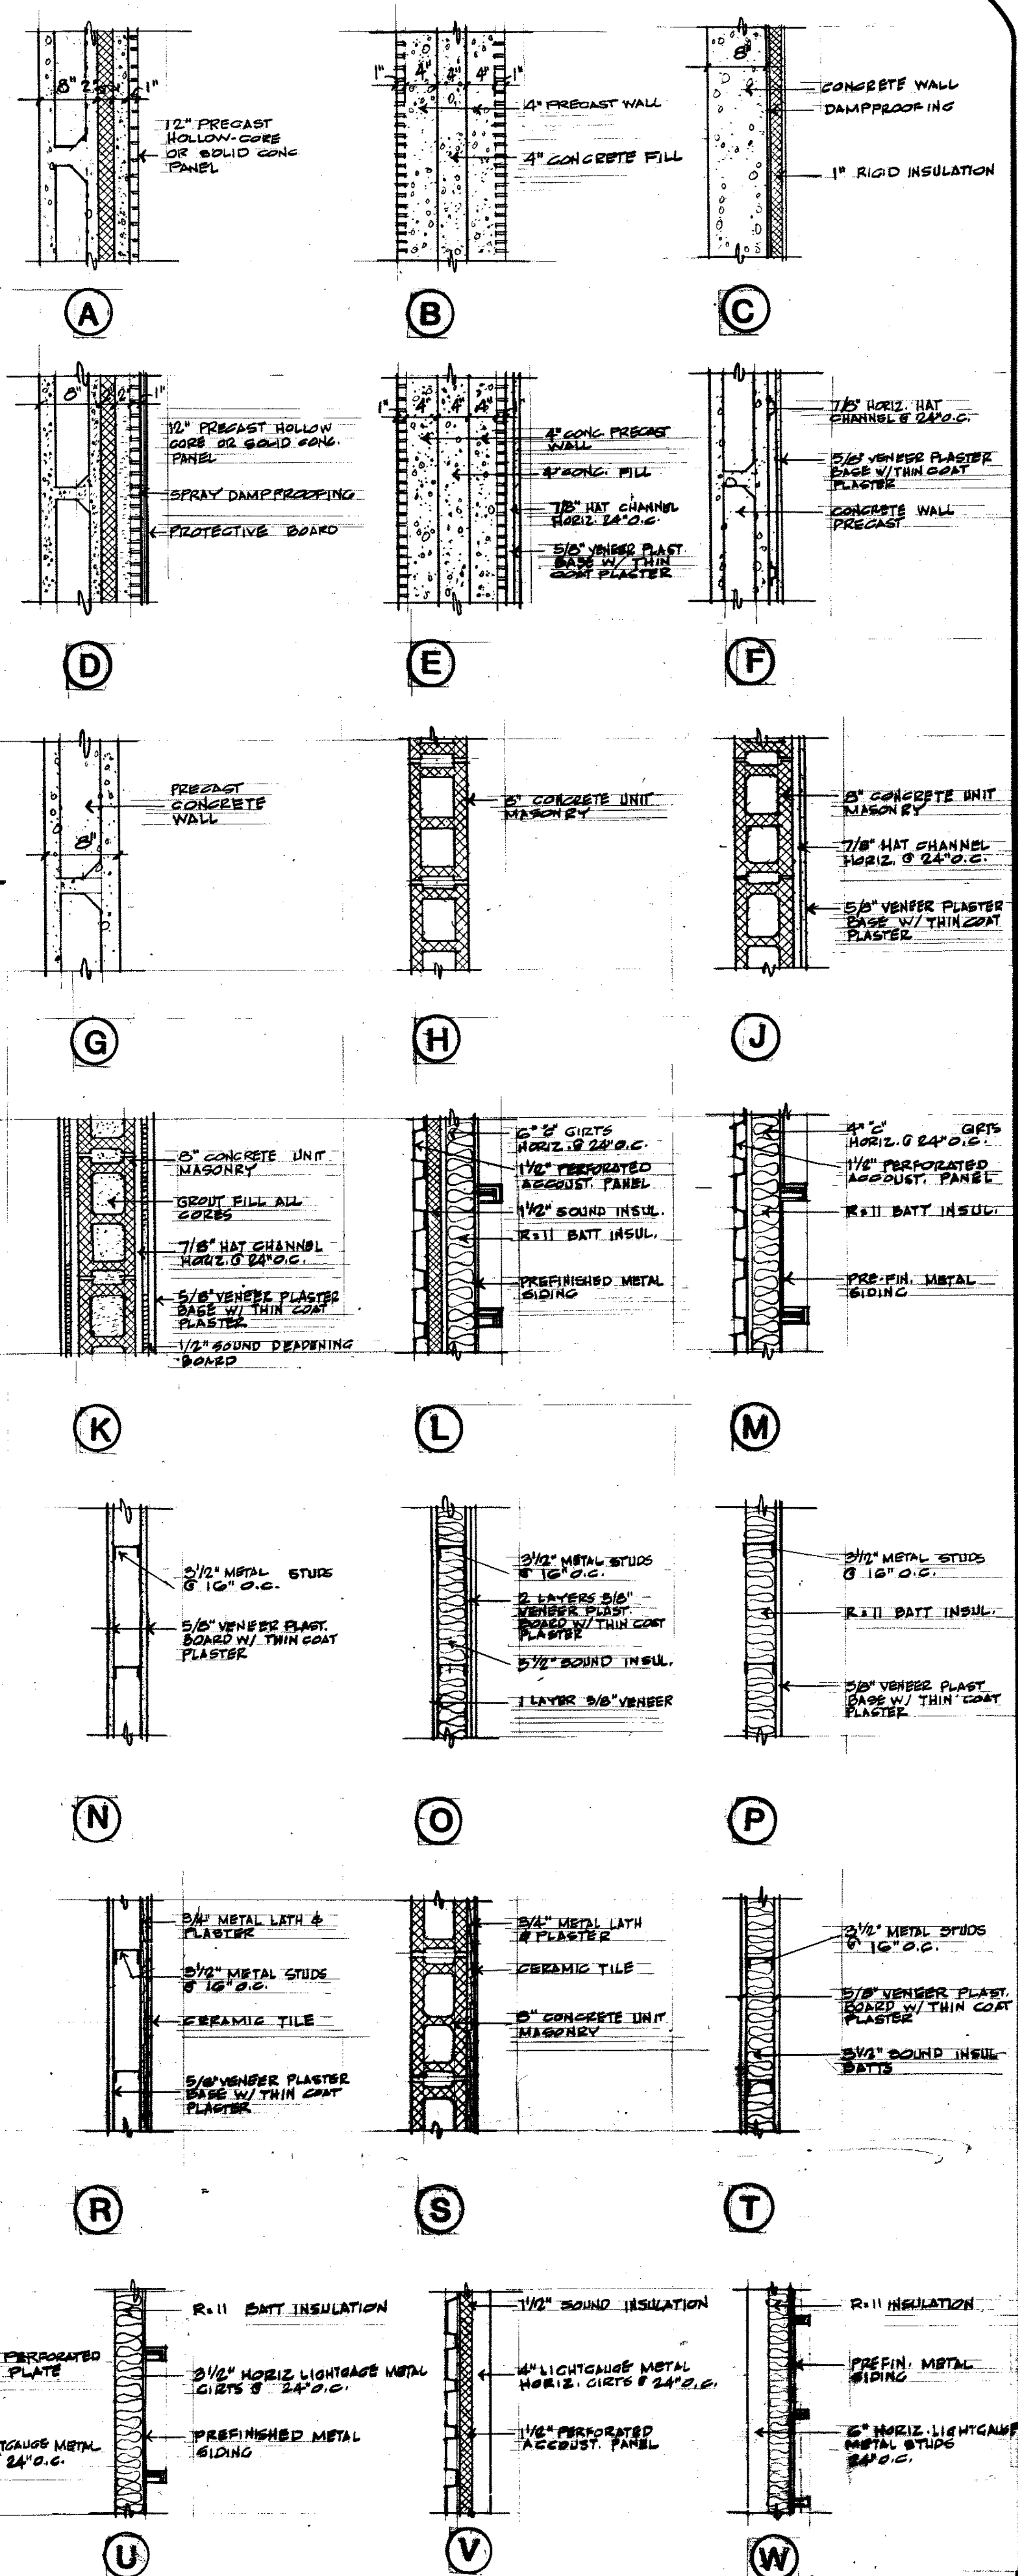

WALL TYPES SCALE: 1" = 1'-0"

miller-cook architects a.i.a.
30 N.W. 7th Ave.
Portland, Oregon
15031 888-0882
97108

DATE: FEB. 24, 1984
JOB NO: 84-129
REVISIONS: AS BUILT 11-16-87




SHEET TITLE: EAST & WEST ELEVATIONS & WALL TYPES
C-130 FUEL SYSTEM / CORROSION CONTROL
MAINTENANCE HANGAR
304th AIR RESCUE RECOVERY SQUADRON
PORTLAND INTERNATIONAL AIRPORT
OREGON


A-3

RECORD DRAWINGS FROM INFORMATION SUPPLIED BY THE GENERAL CONTRACTOR

BLDG 375

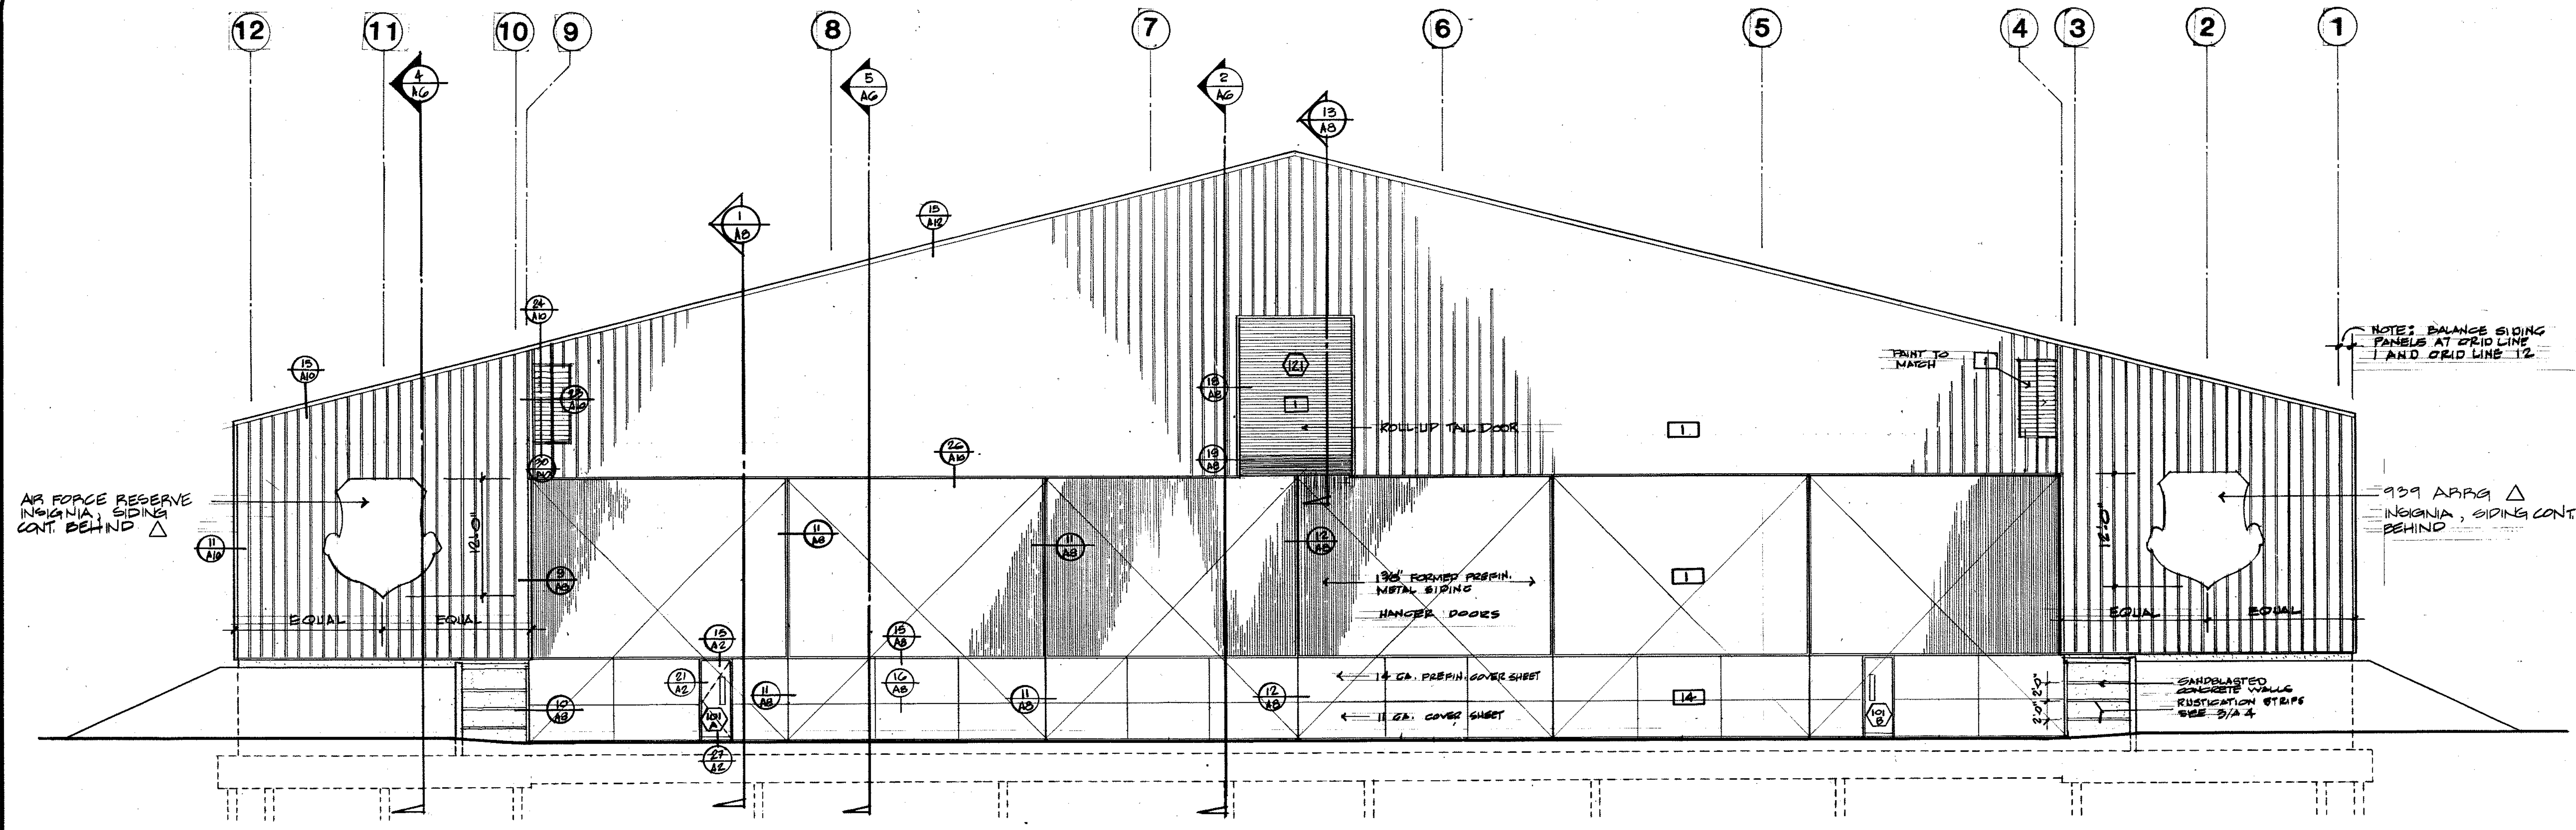

1 NORTH ELEVATION
 SCALE: 1/8" = 1'-0"

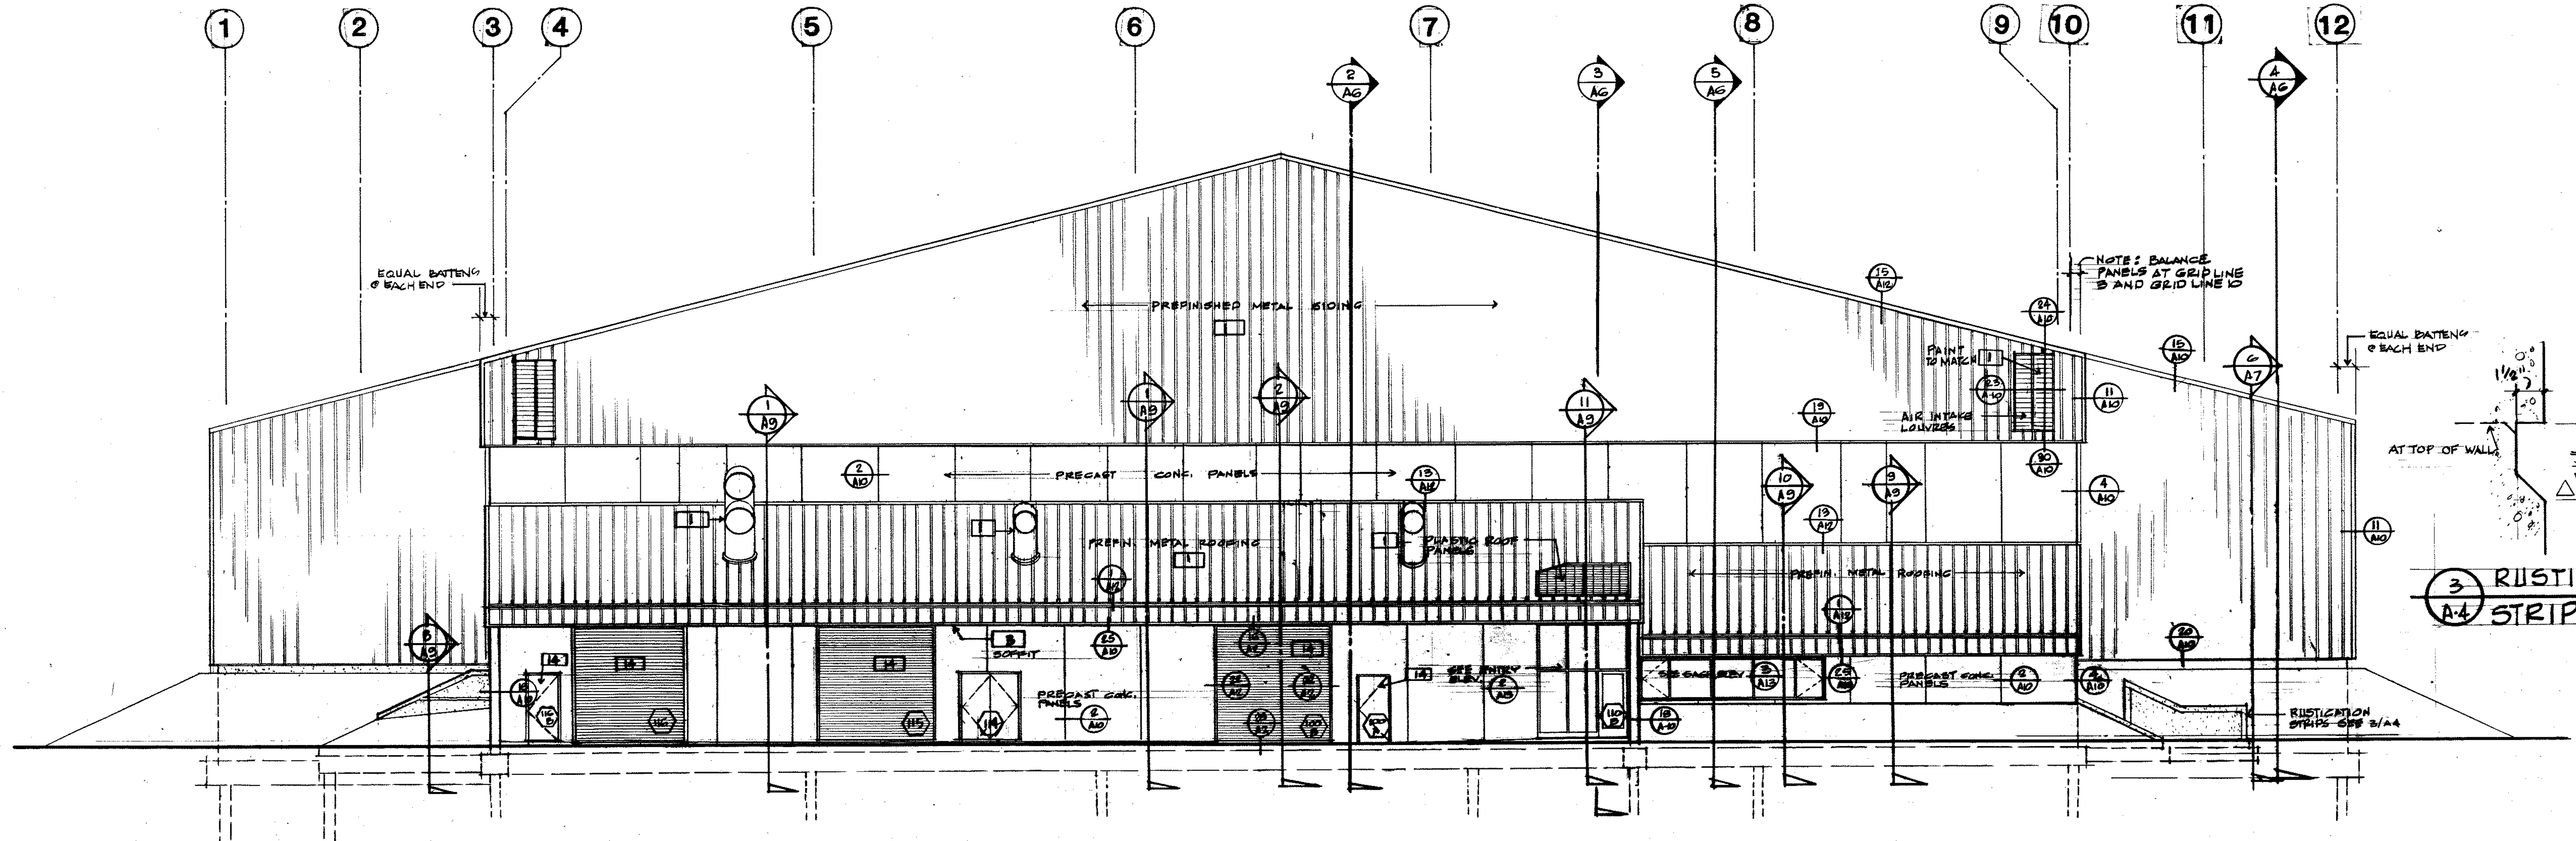

2 SOUTH ELEVATION
 SCALE: 1/8" = 1'-0"

3 RUSTICATION STRIP
 SCALE: 5/8" = 1'-0"

miller - cook architects a.i.a.
 30 N.W. 1ST AVE. PORTLAND, OREGON
 (503) 228-0822 57205
 DATE: FEB 20, 1981
 JOB NO: 84-125
 REVISIONS: AS BUILT 11-16-81




SHEET TITLE: NORTH AND SOUTH ELEVATIONS
C-130 FUEL SYSTEM / CORROSION CONTROL MAINTENANCE HANGAR
 304th AIR RESCUE RECOVERY SQUADRON
 PORTLAND INTERNATIONAL AIRPORT
 PORTLAND, OREGON

A-4

RECORD DRAWINGS FROM INFORMATION SUPPLIED BY THE GENERAL CONTRACTOR

DATE: FEB 26, 1986
 JOB NO: 84-125
 REVISIONS: 3-19-86
 AS BUILT 11-10-87

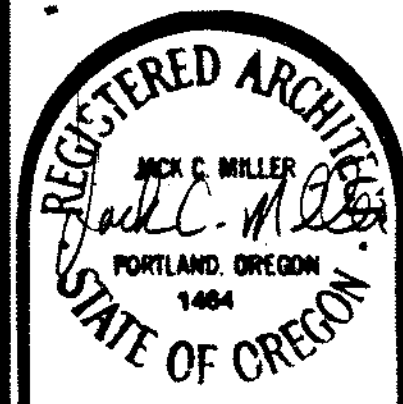


SHEET TITLE CROSS SECTIONS
C-130 FUEL SYSTEM / CORROSION CONTROL
MAINTENANCE HANGAR
304th AIR RESCUE RECOVERY SQUADRON
PORTLAND INTERNATIONAL AIRPORT
 PORTLAND OREGON


A-5

RECORD DRAWINGS FROM
 INFORMATION SUPPLIED BY
 THE GENERAL CONTRACTOR


BLD6 375

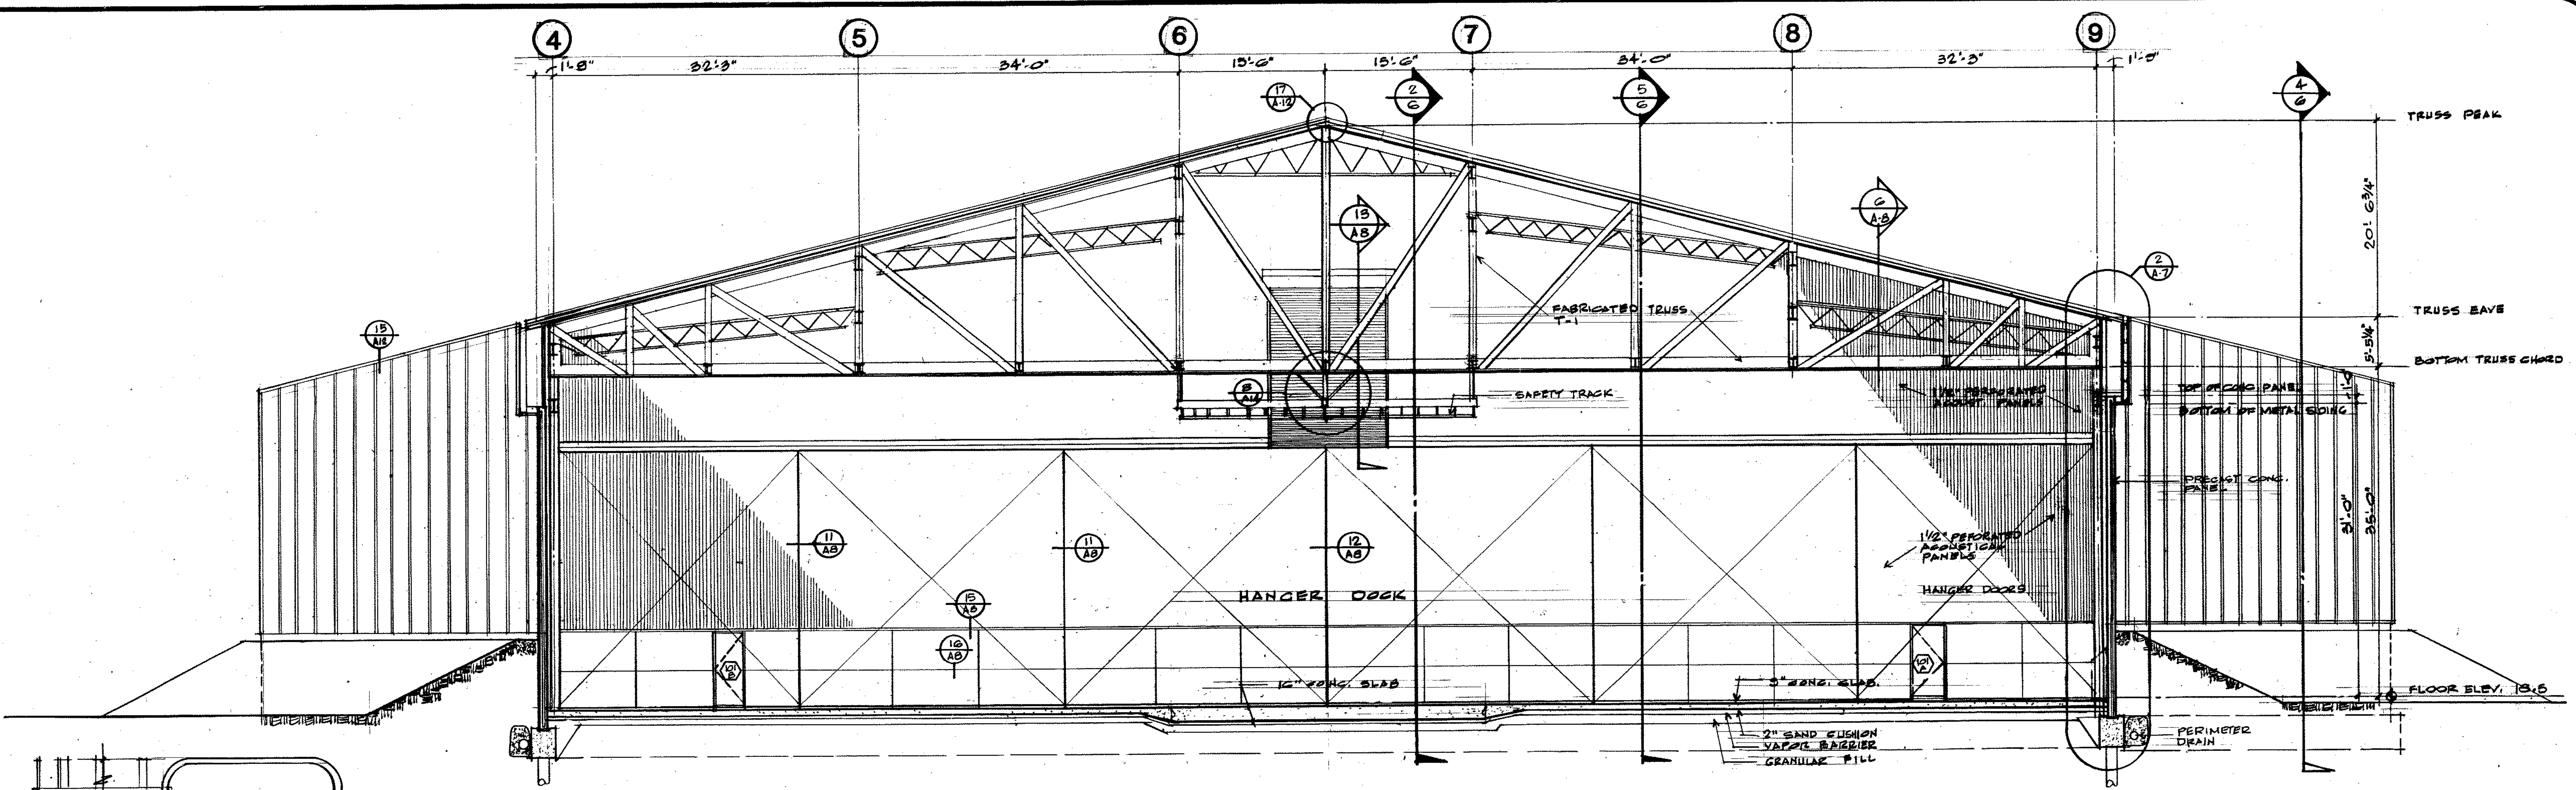


1 CROSS SECTION
 SCALE: 1/8" = 1'-0"

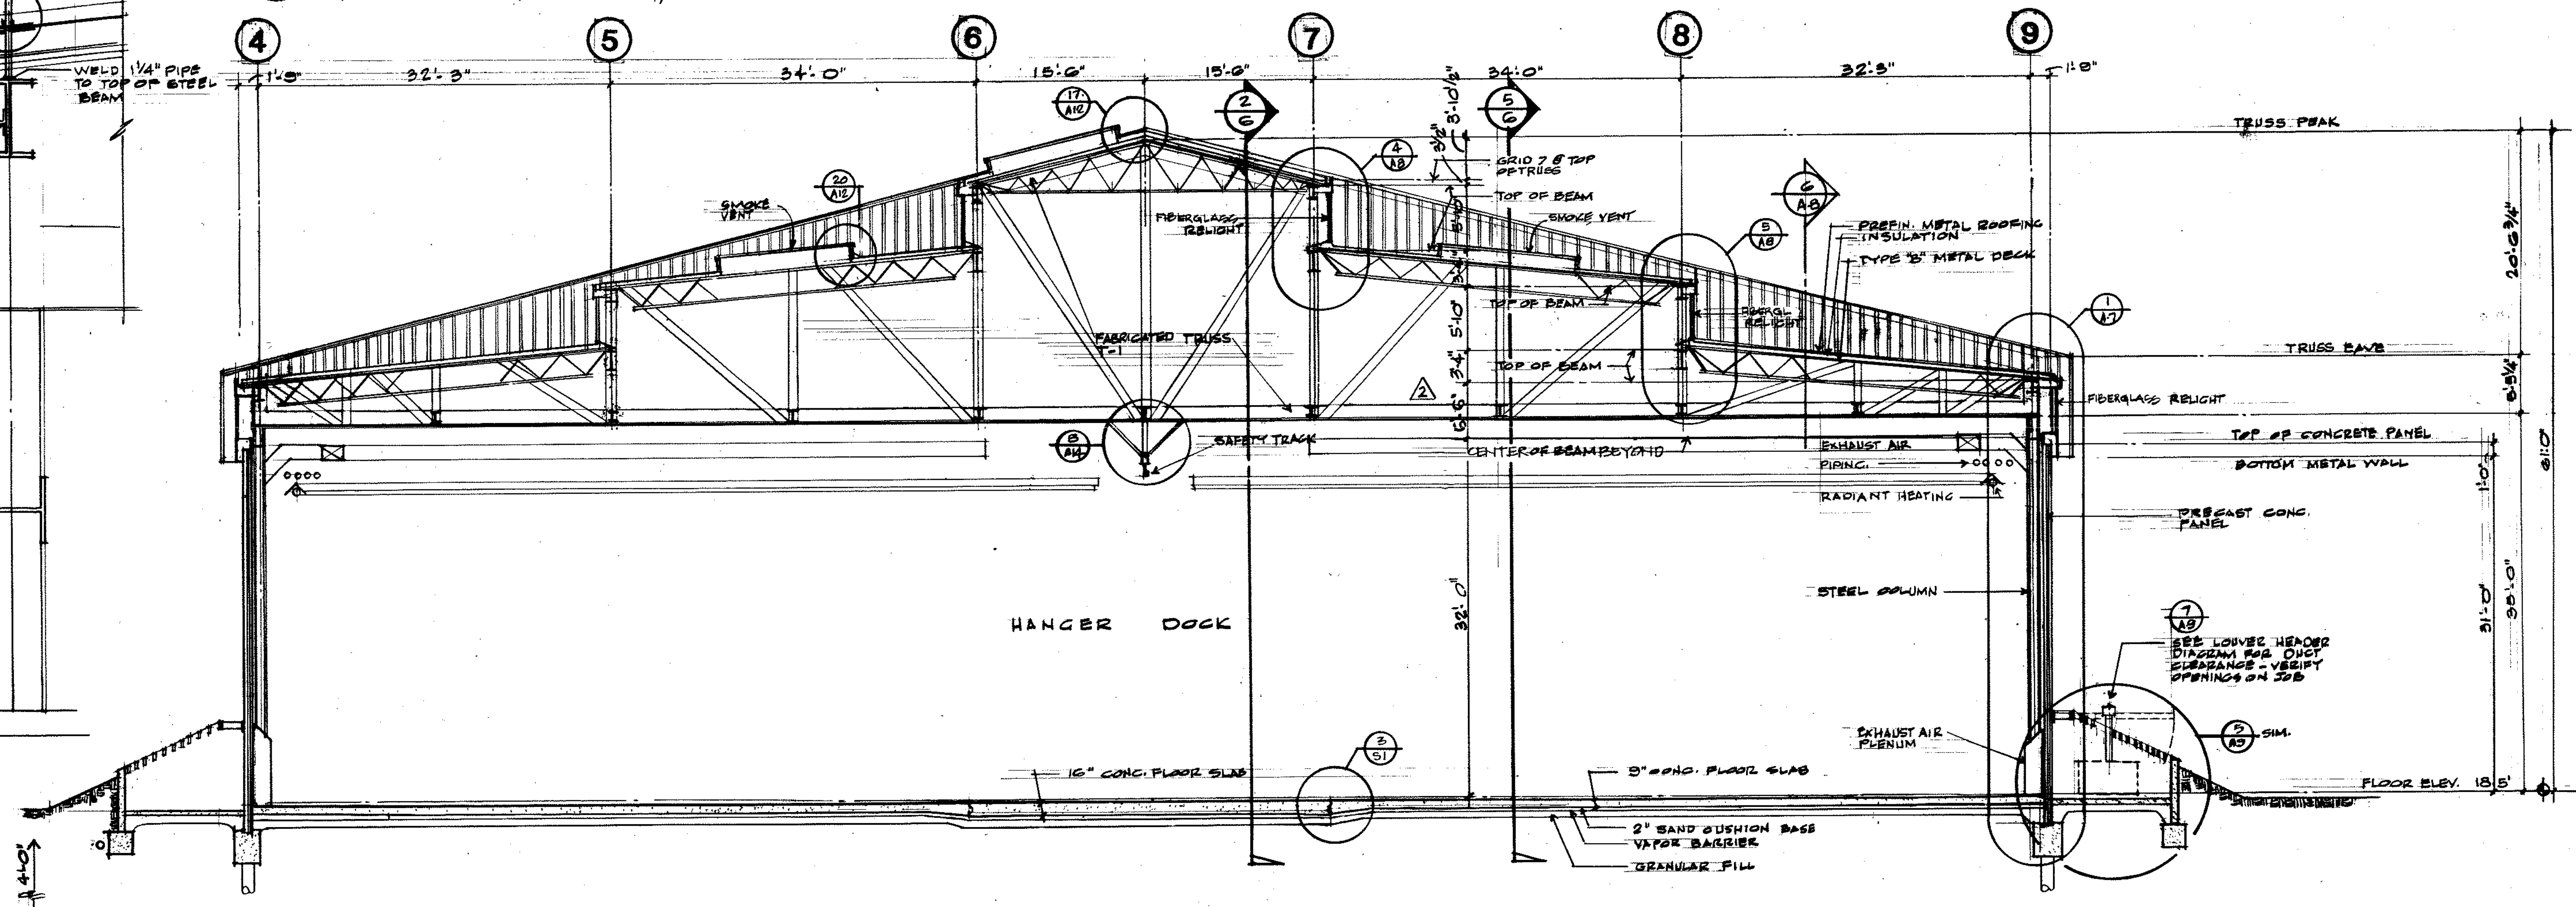


2 CROSS SECTION
 SCALE: 1/8" = 1'-0"

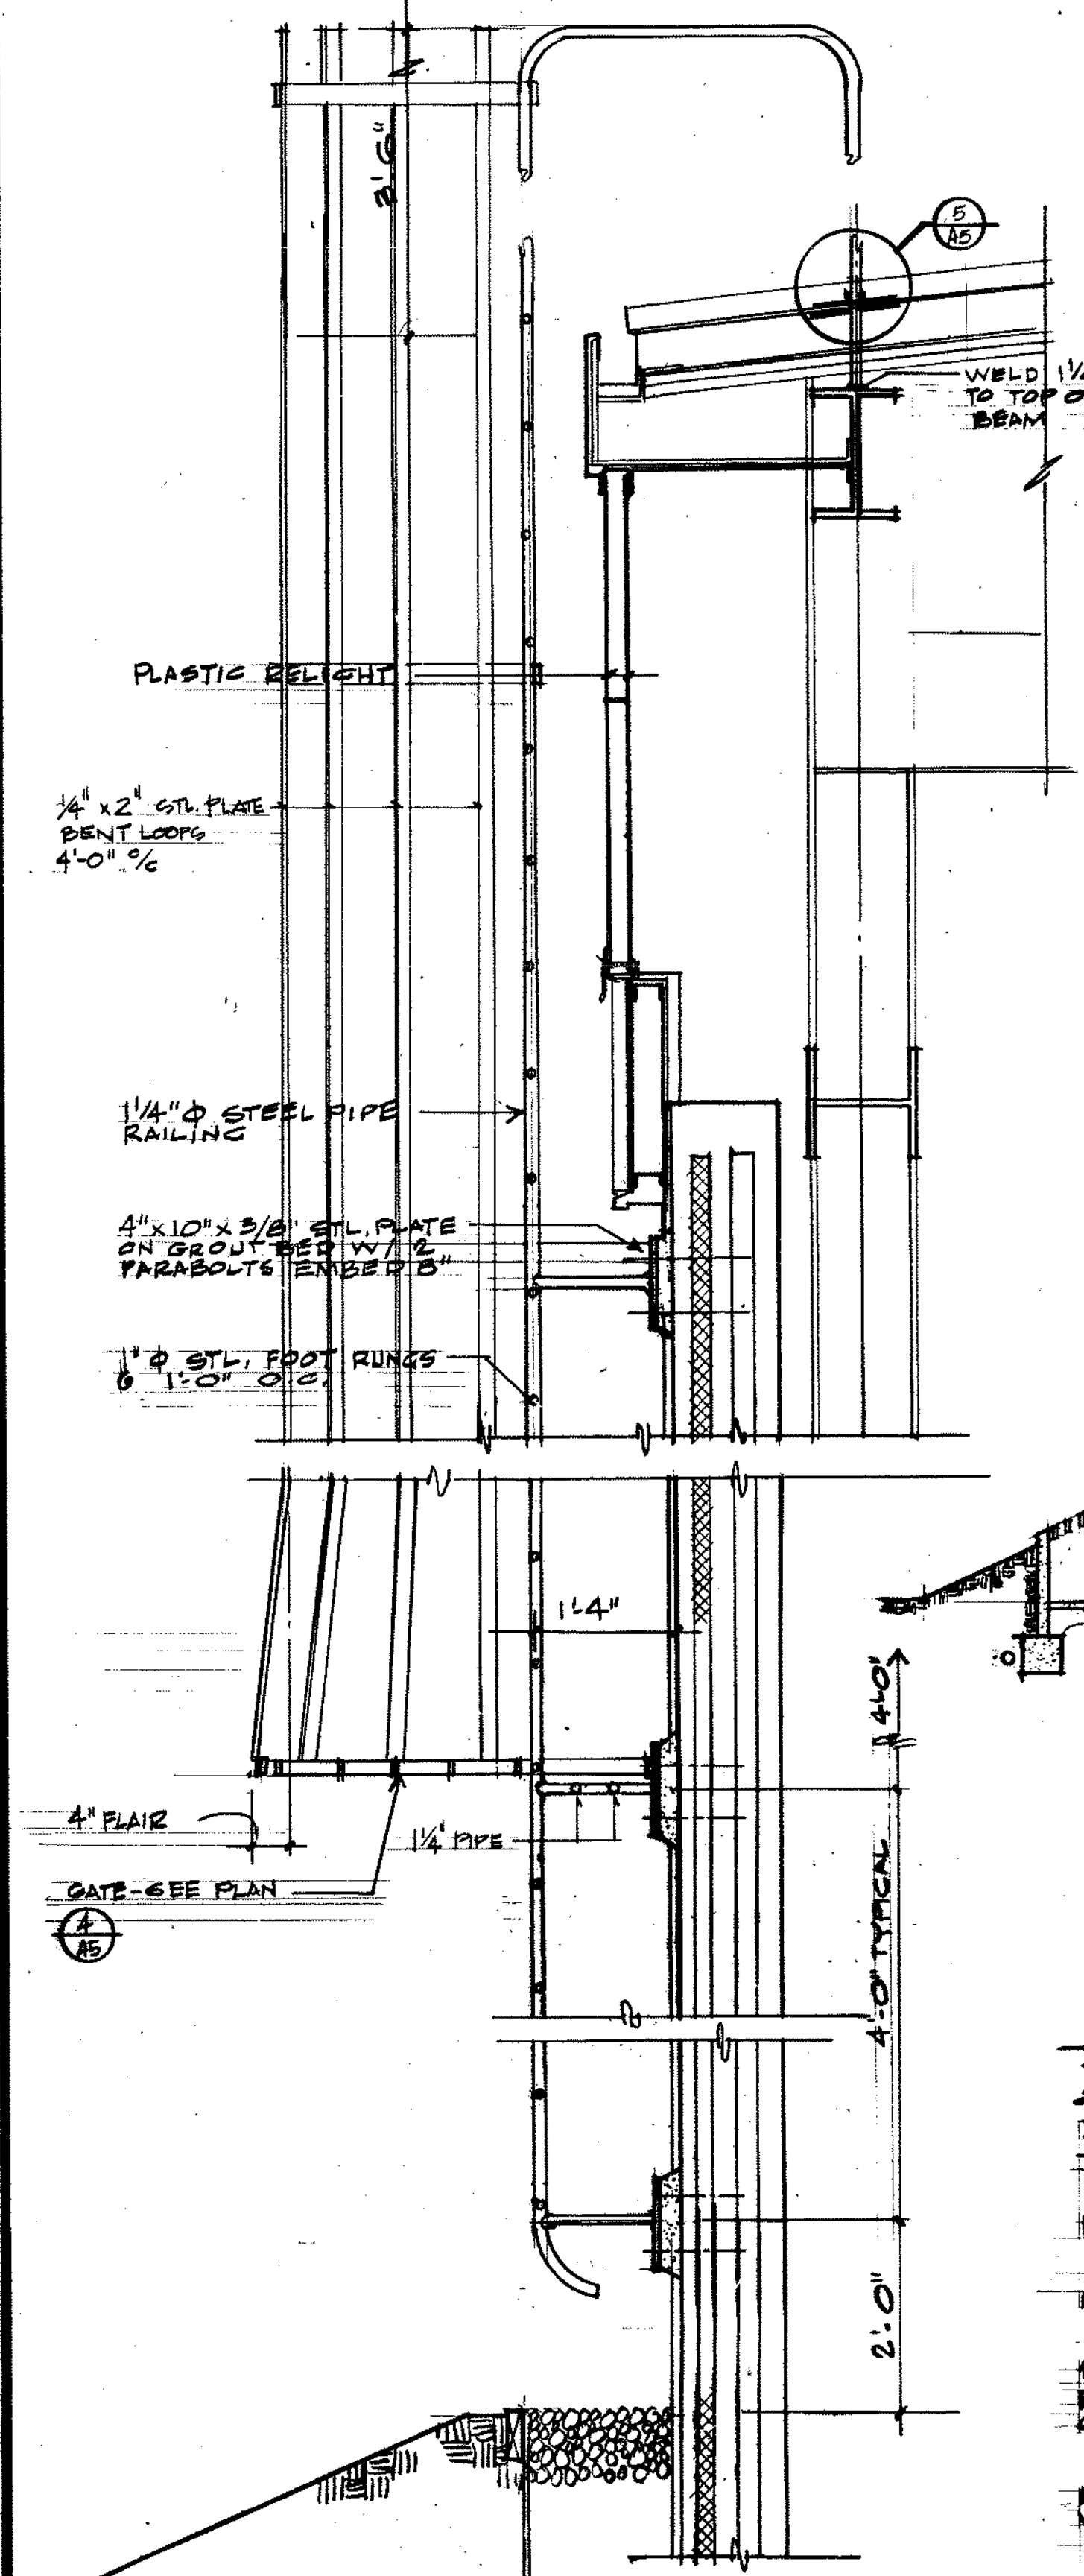

3 LADDER SECTION
 SCALE: 3/4" = 1'-0"

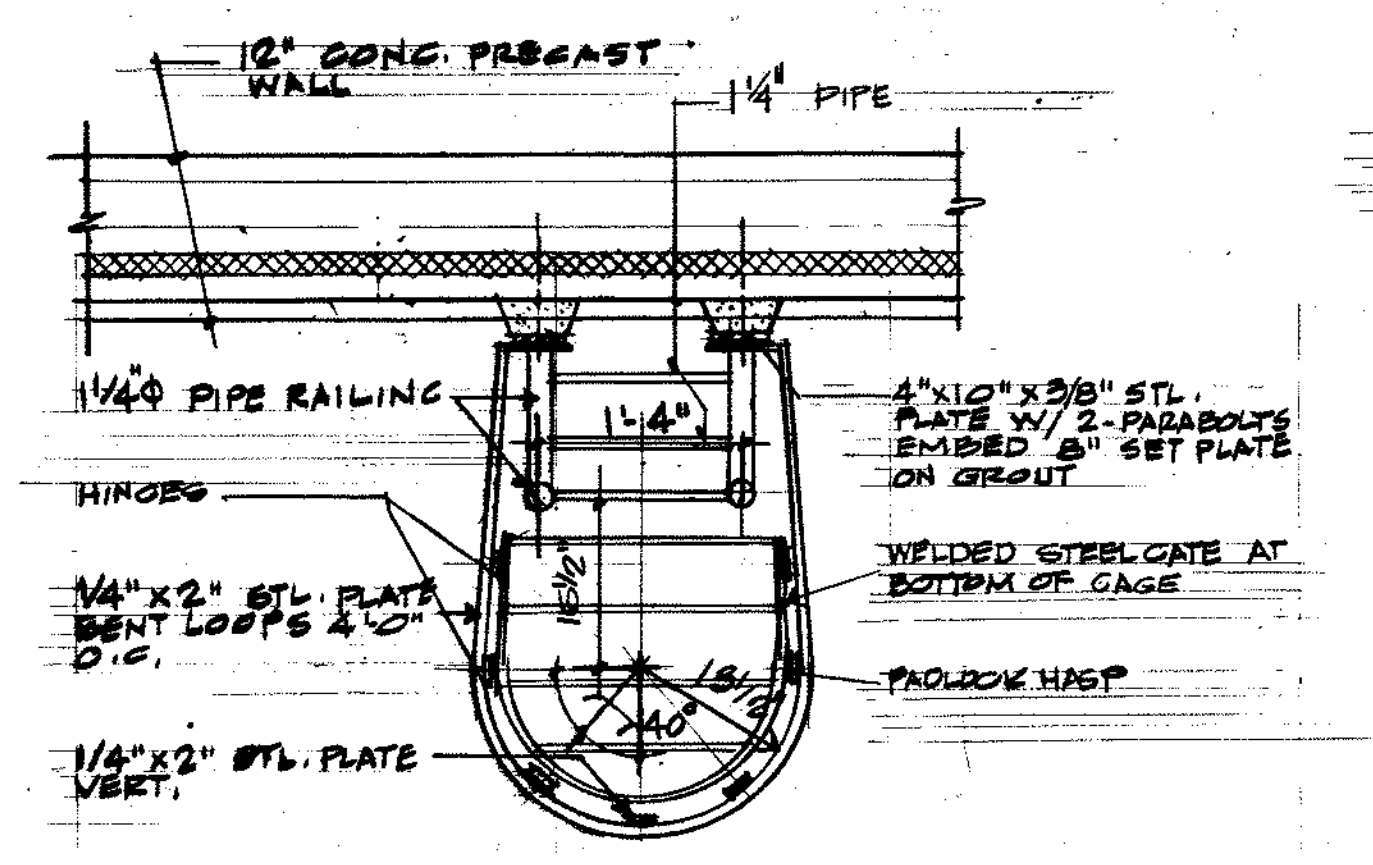


4 LADDER SECTION
 SCALE: 3/4" = 1'-0"

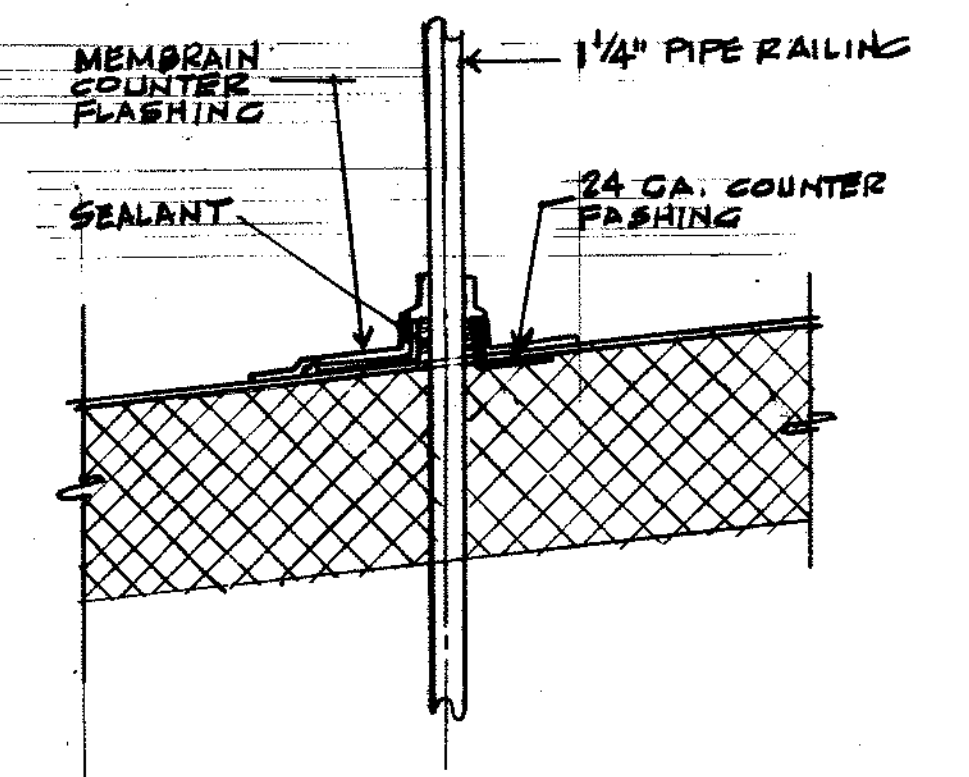


5 PIPE FLASHING
 SCALE: 3" = 1'-0"


DRAWN: SCHWABER DICK

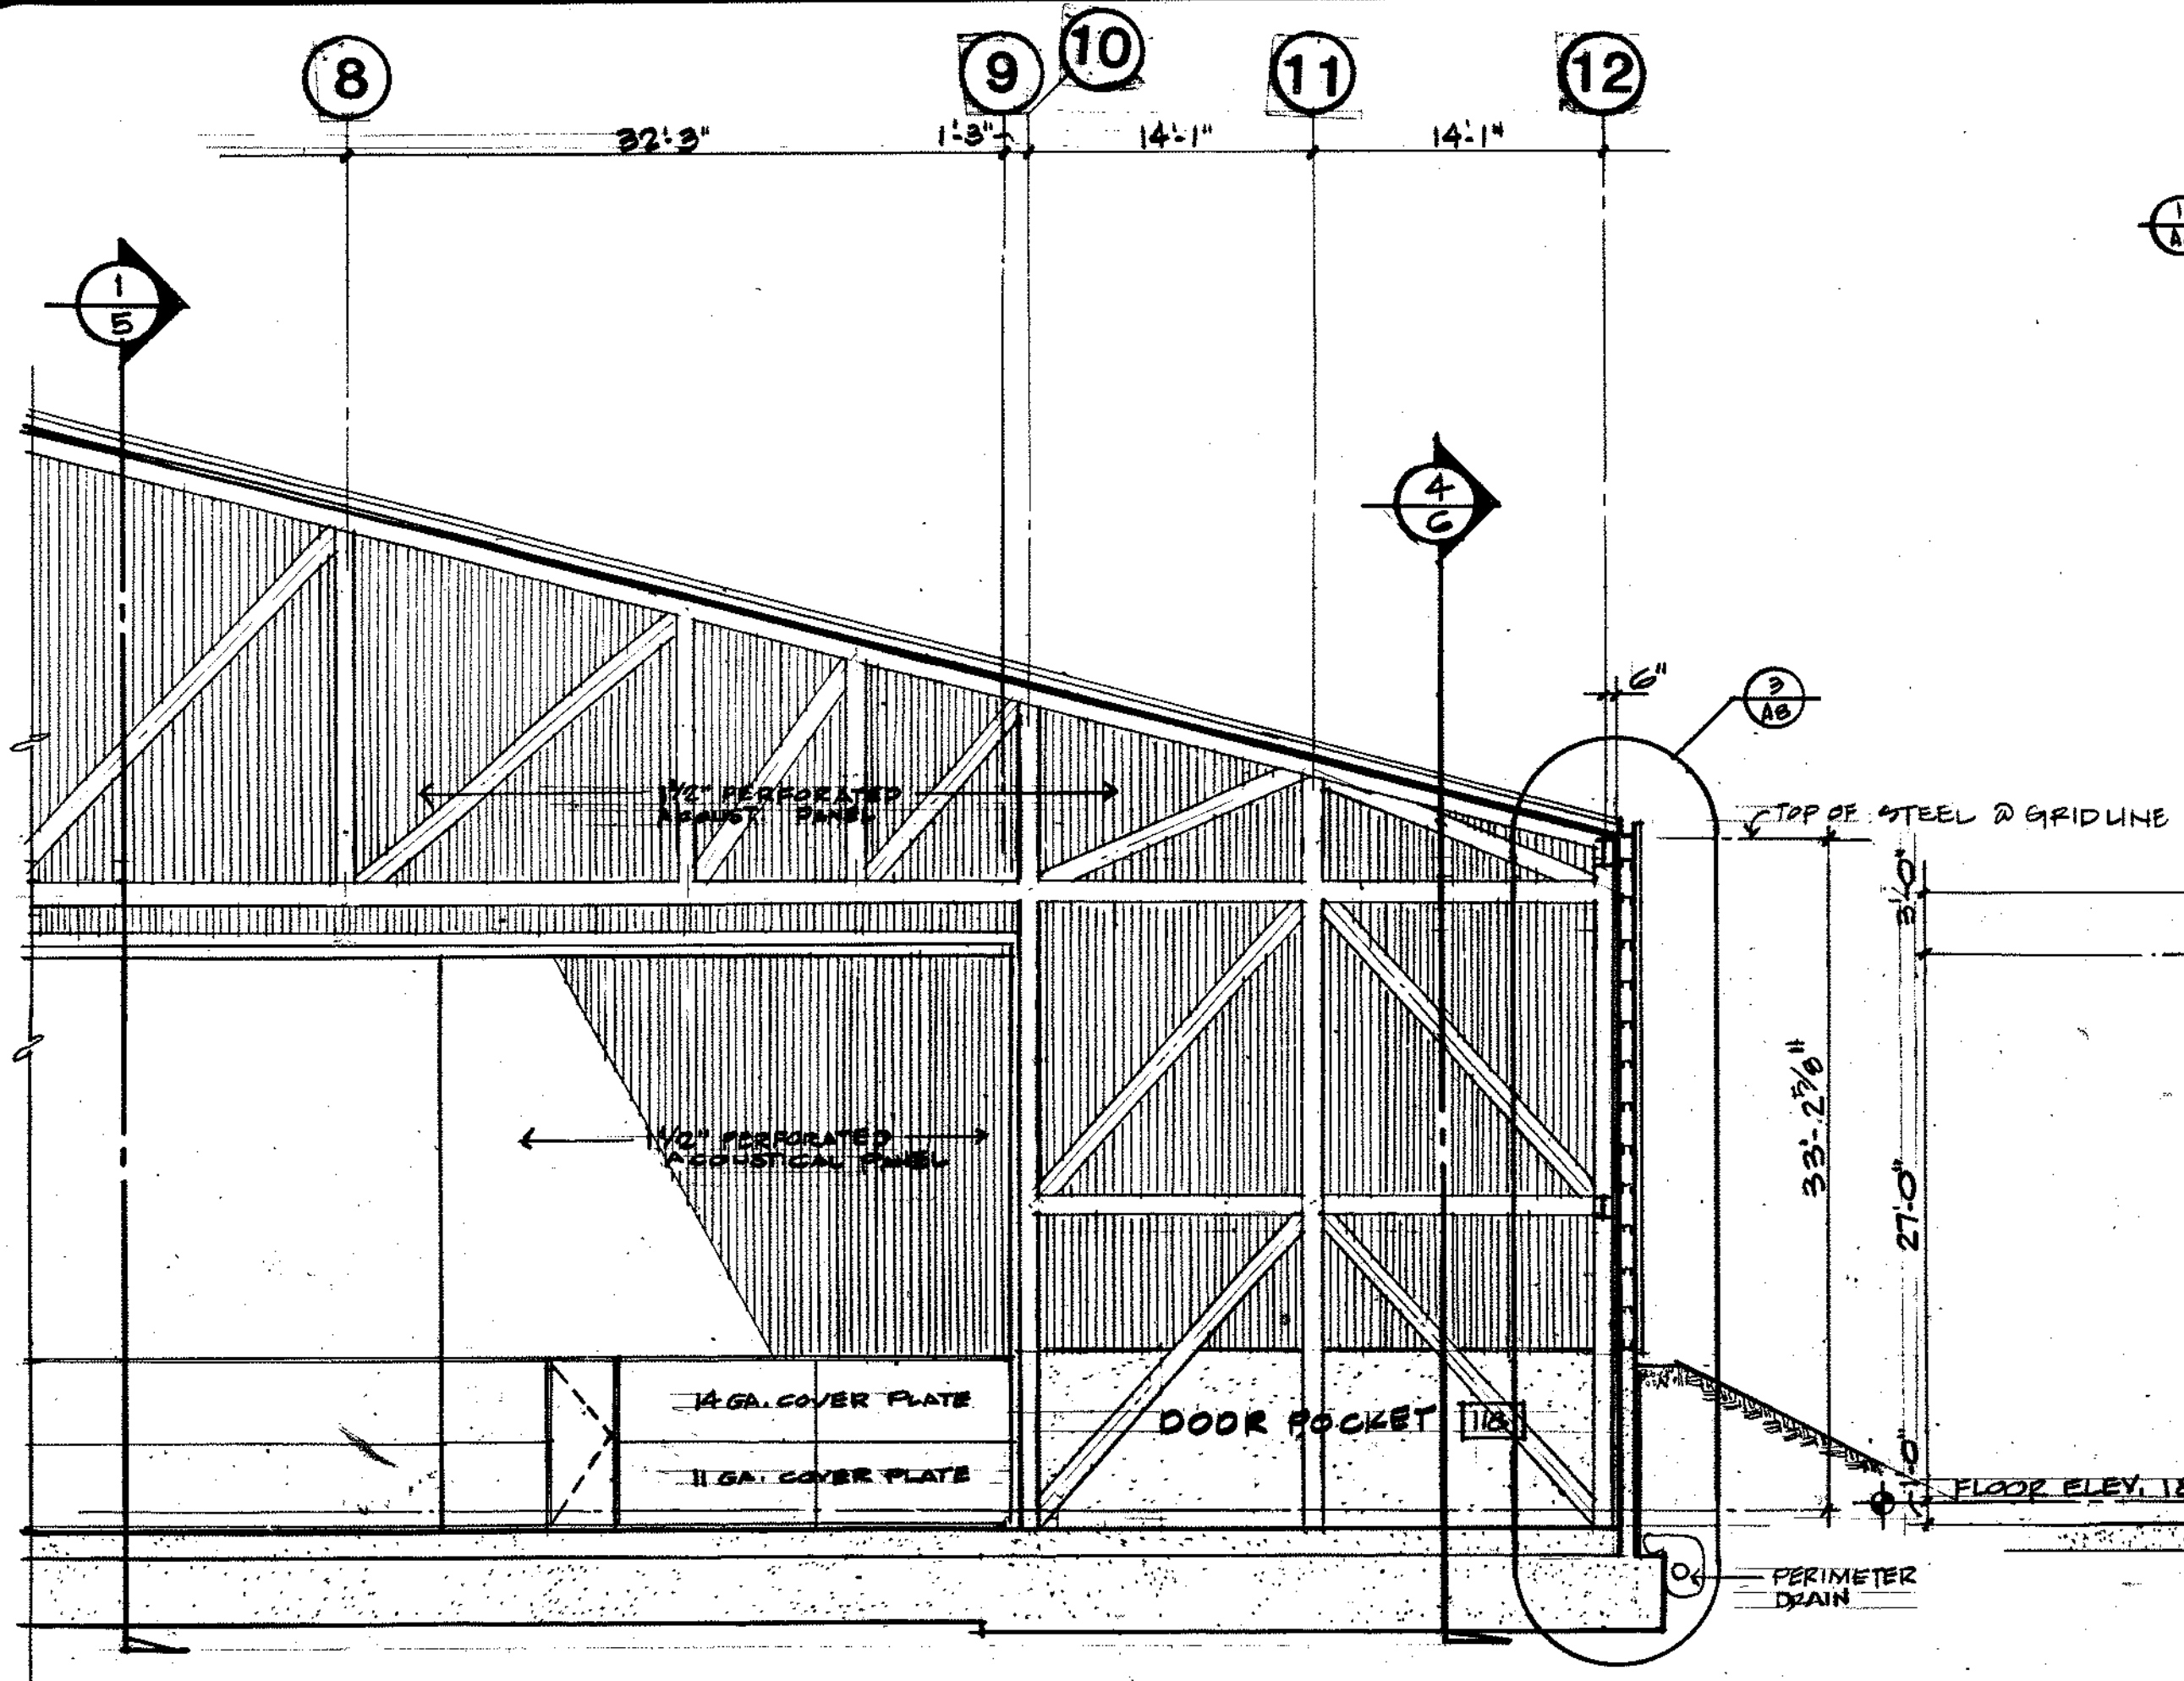


1 CROSS SECTION

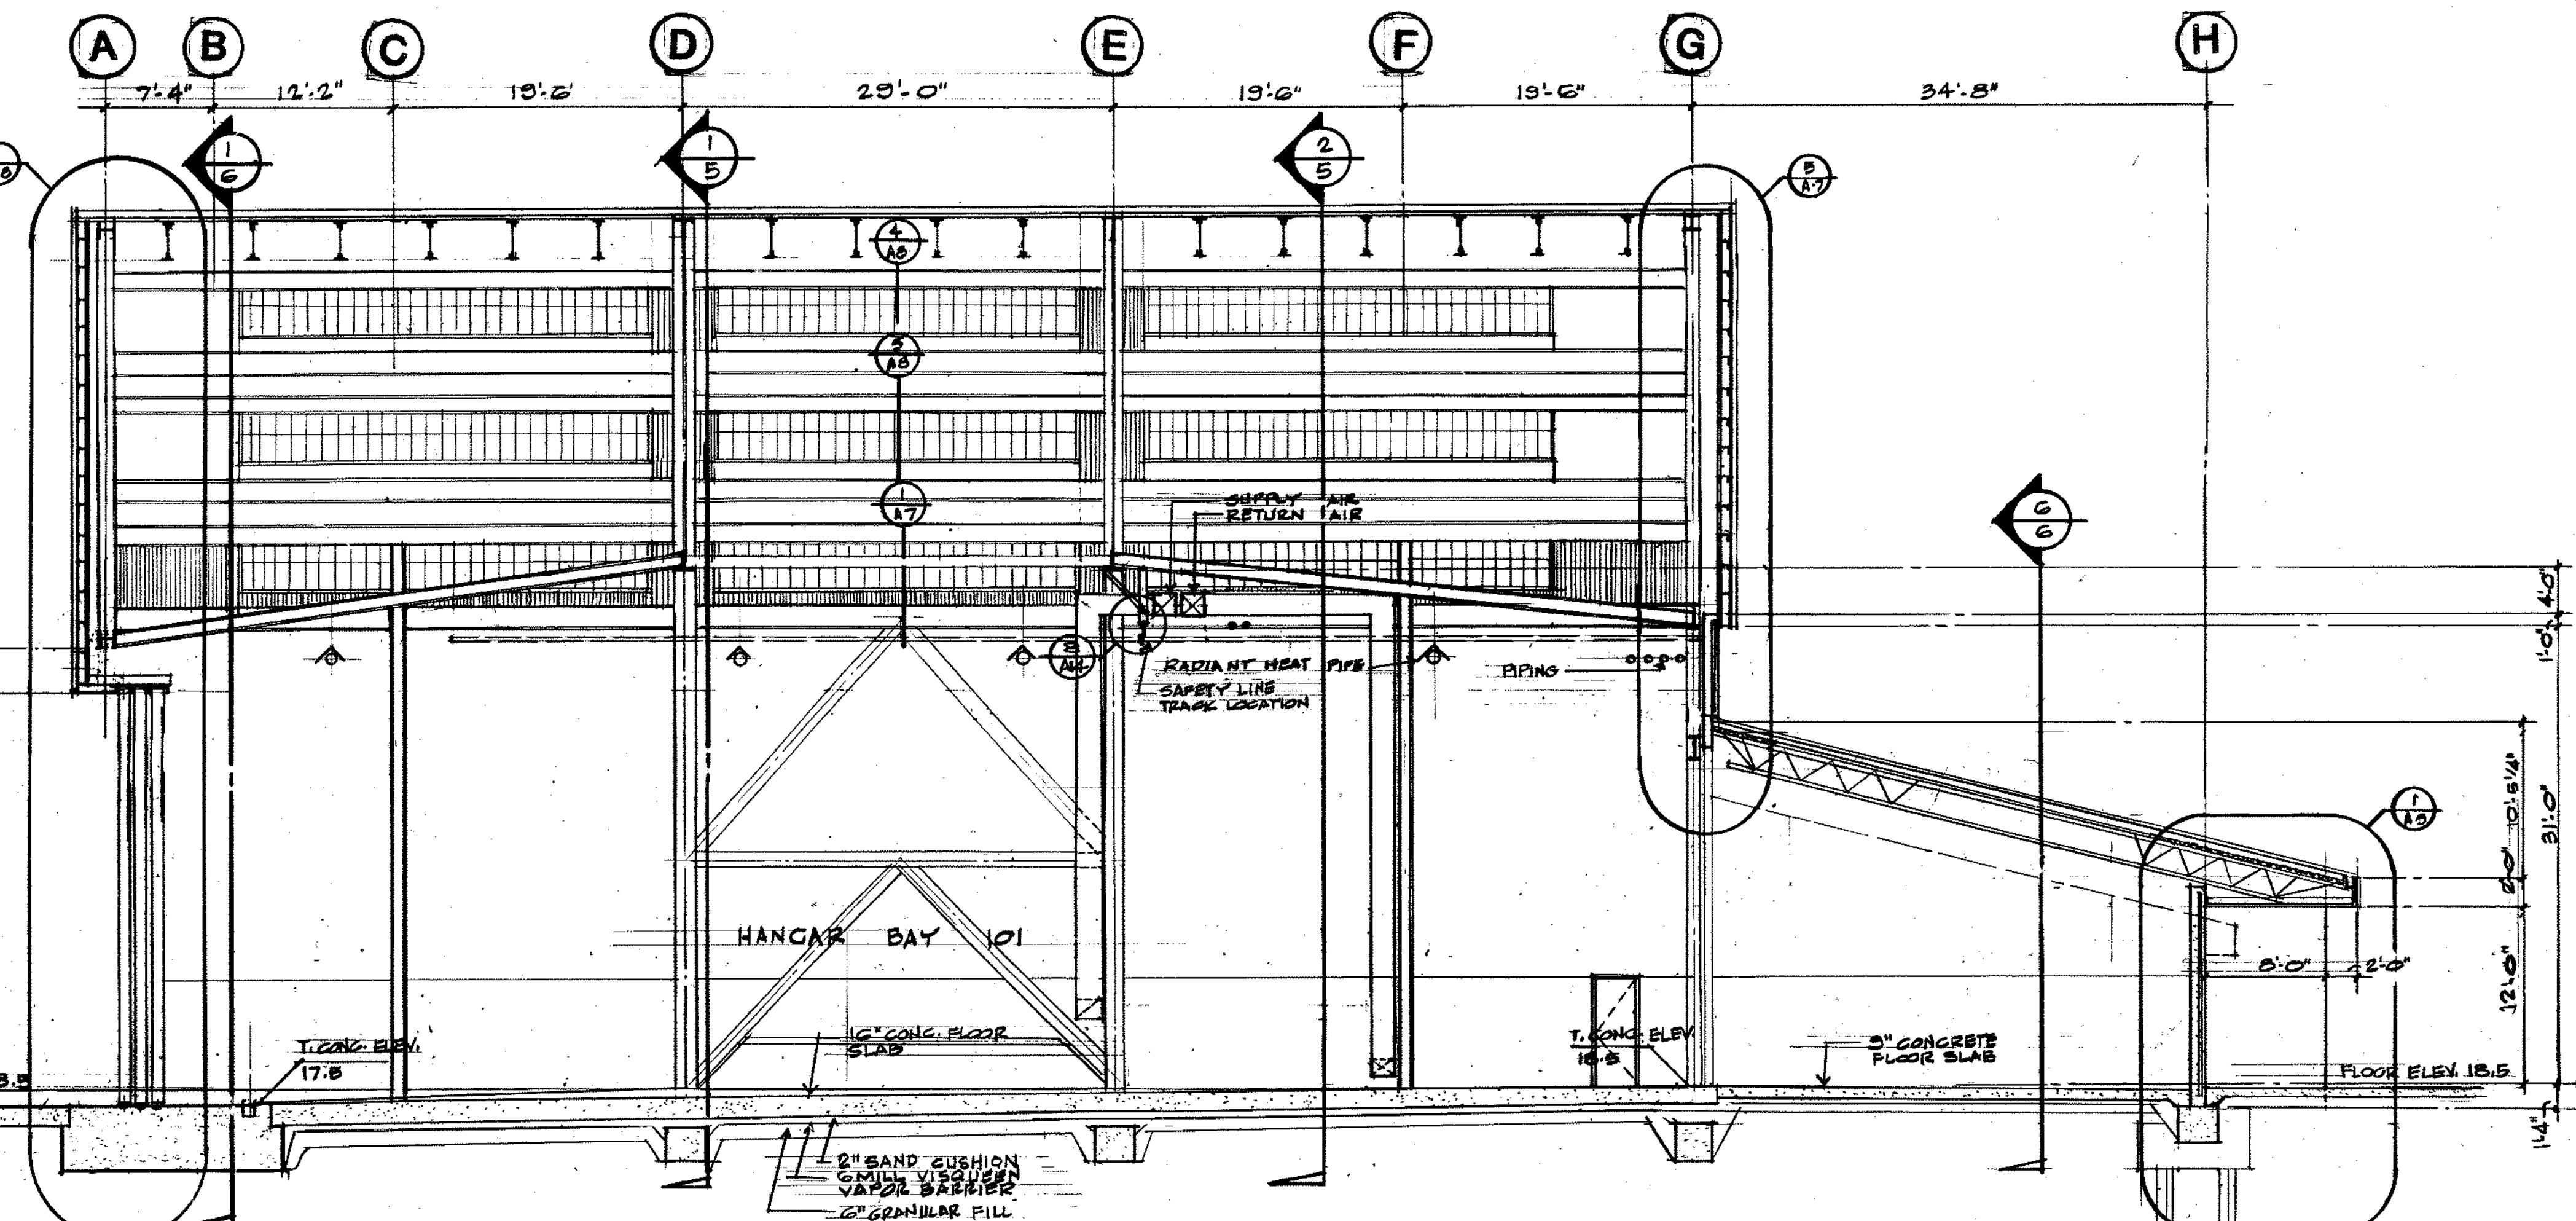


2 LONGITUDINAL SECTION

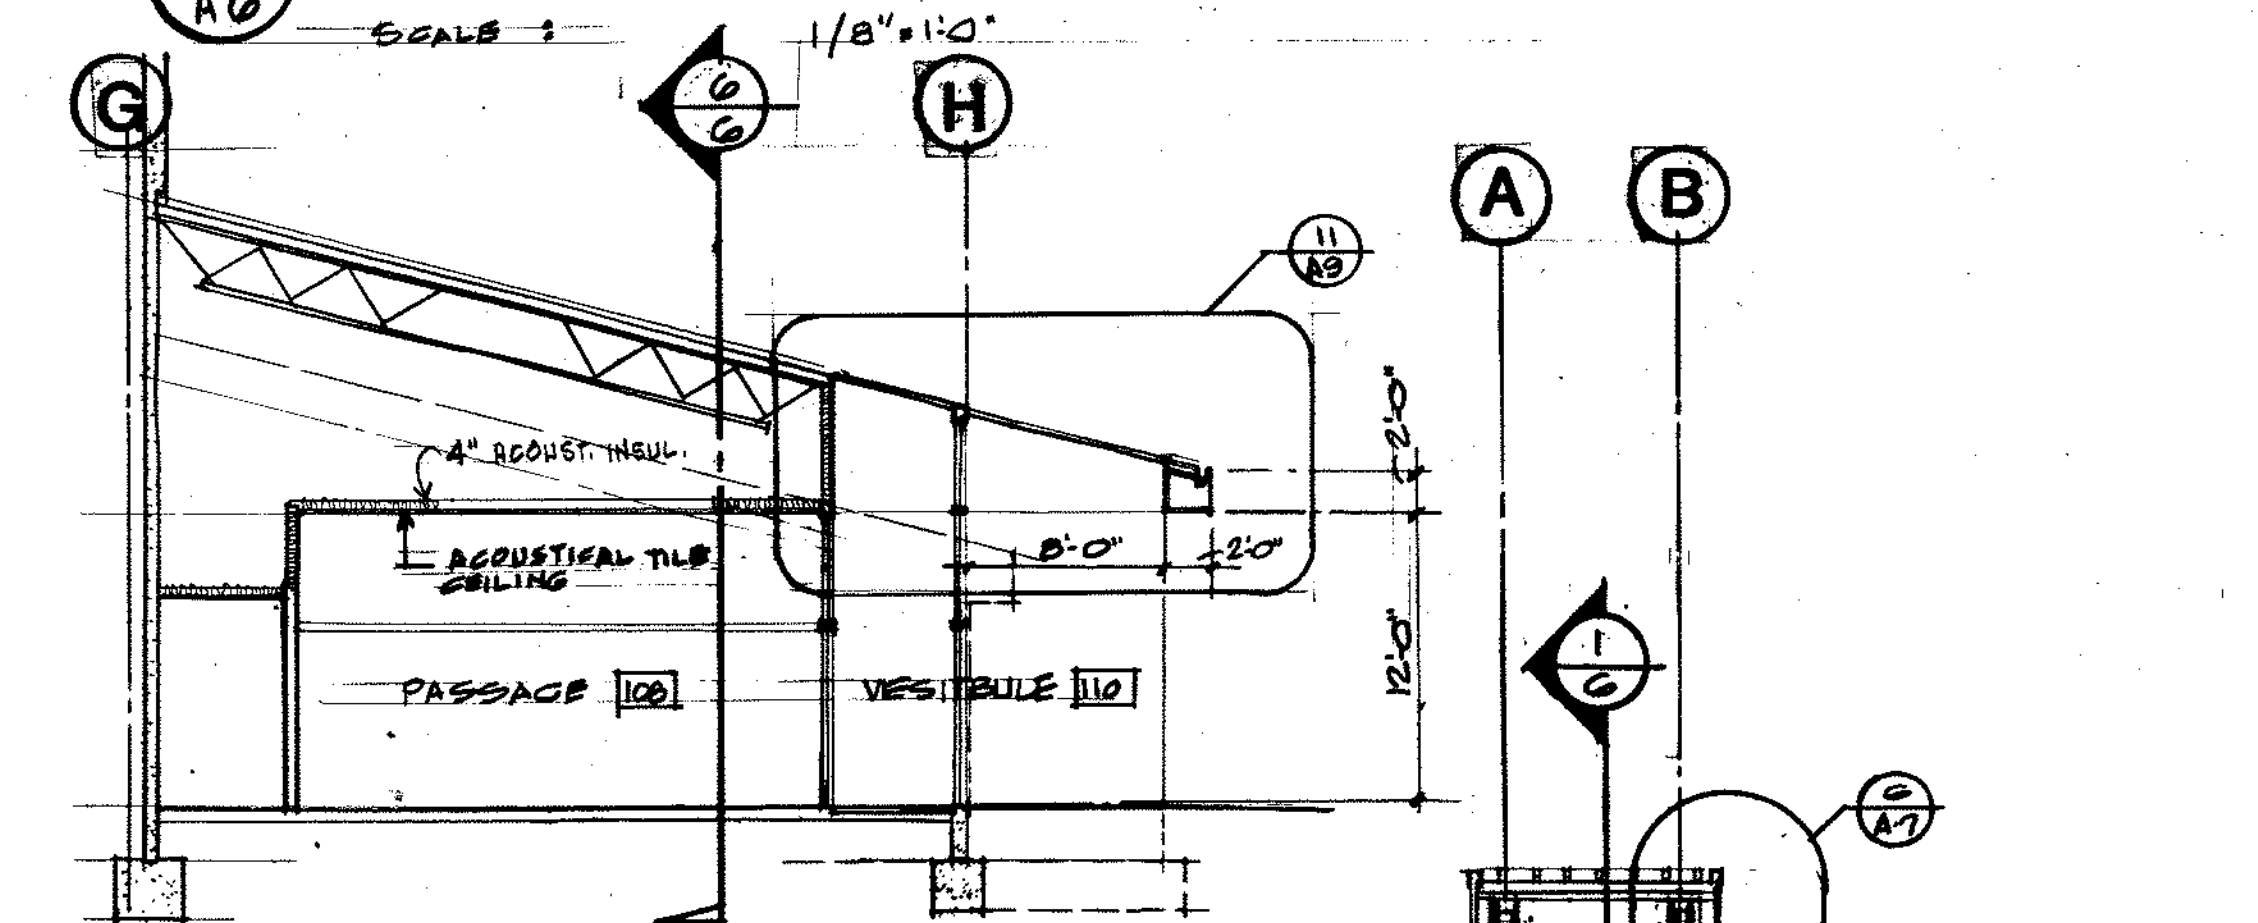

3 CROSS SECTION

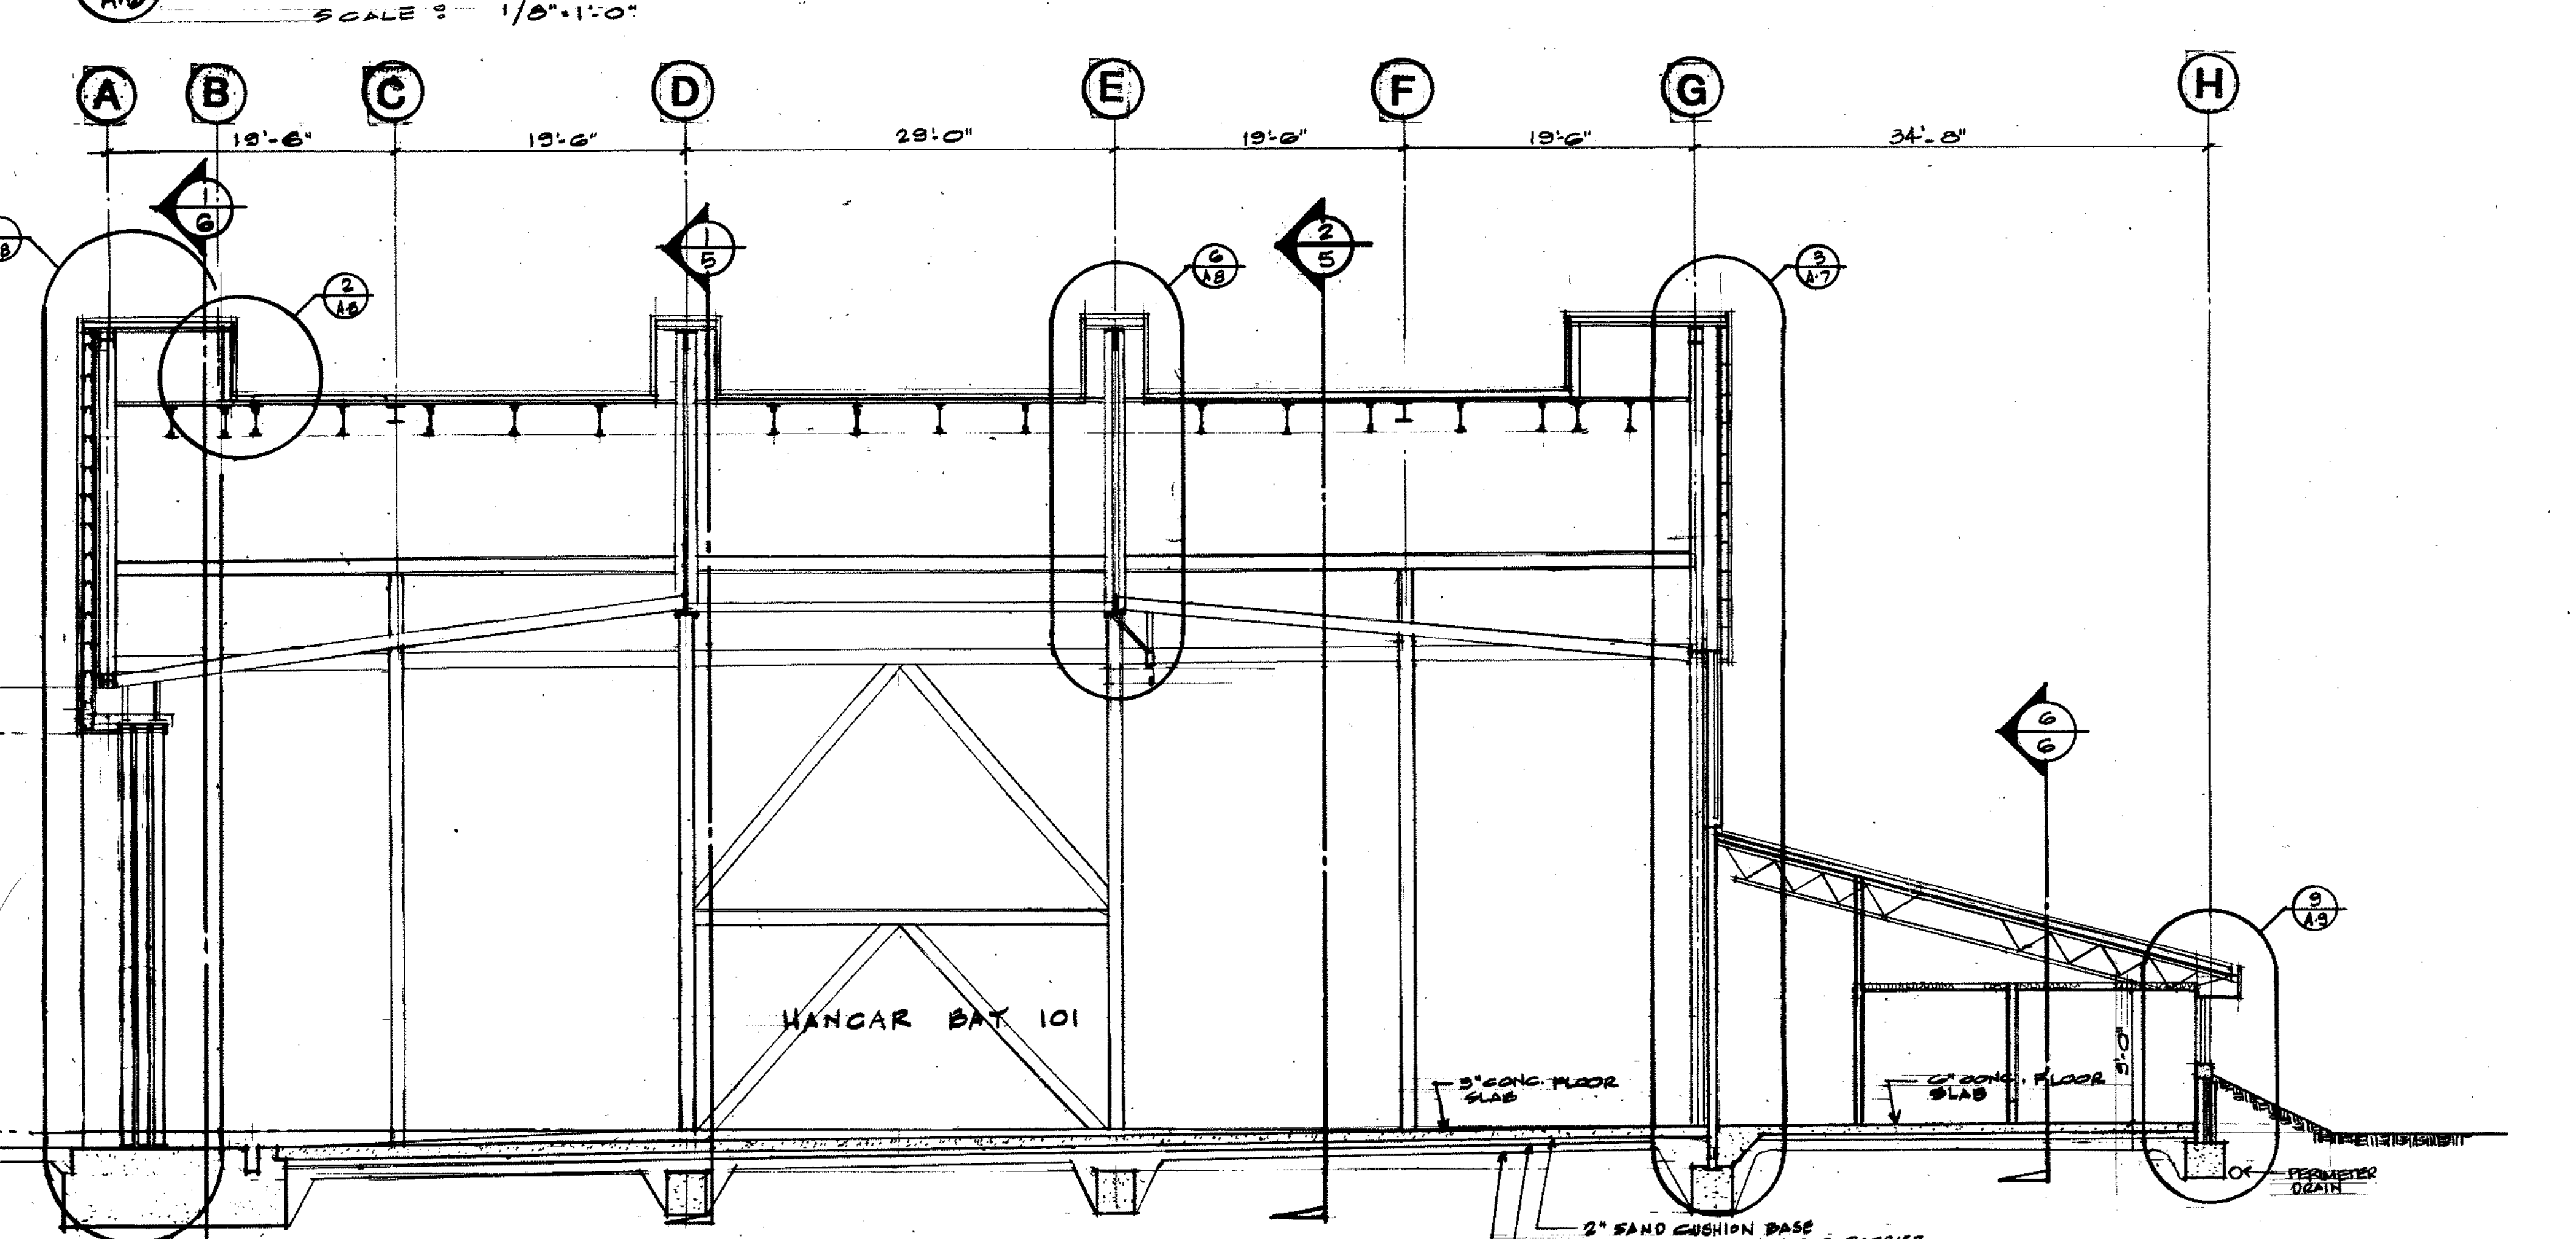


5 LONGITUDINAL SECTION

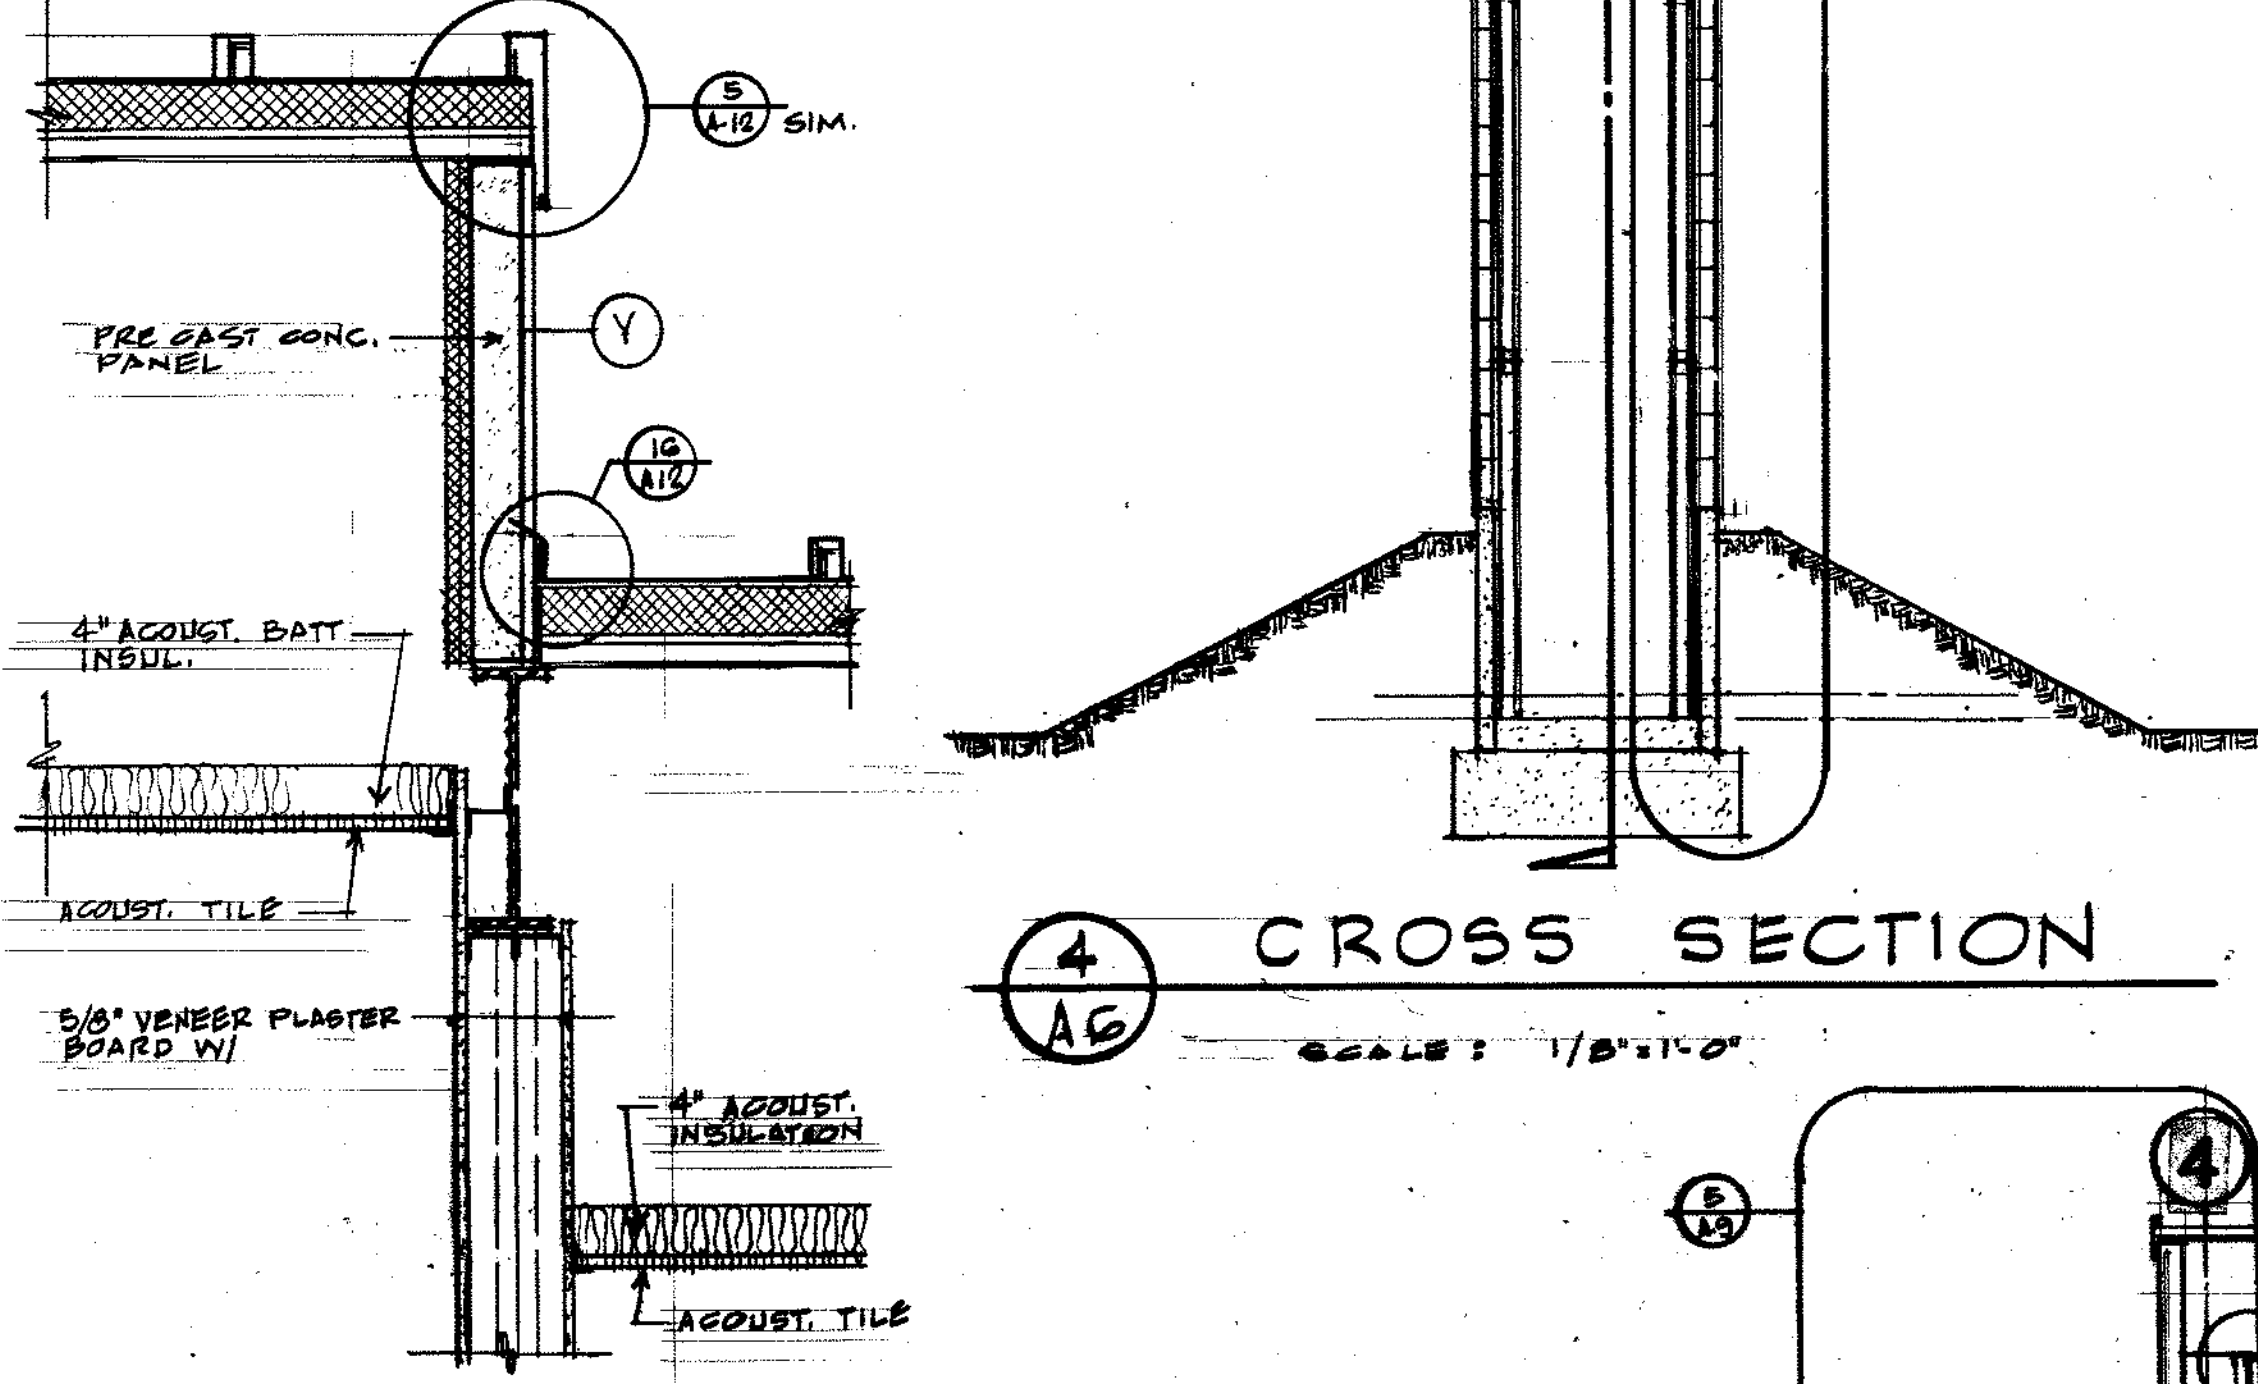

4 CROSS SECTION

7 WALL SECTION

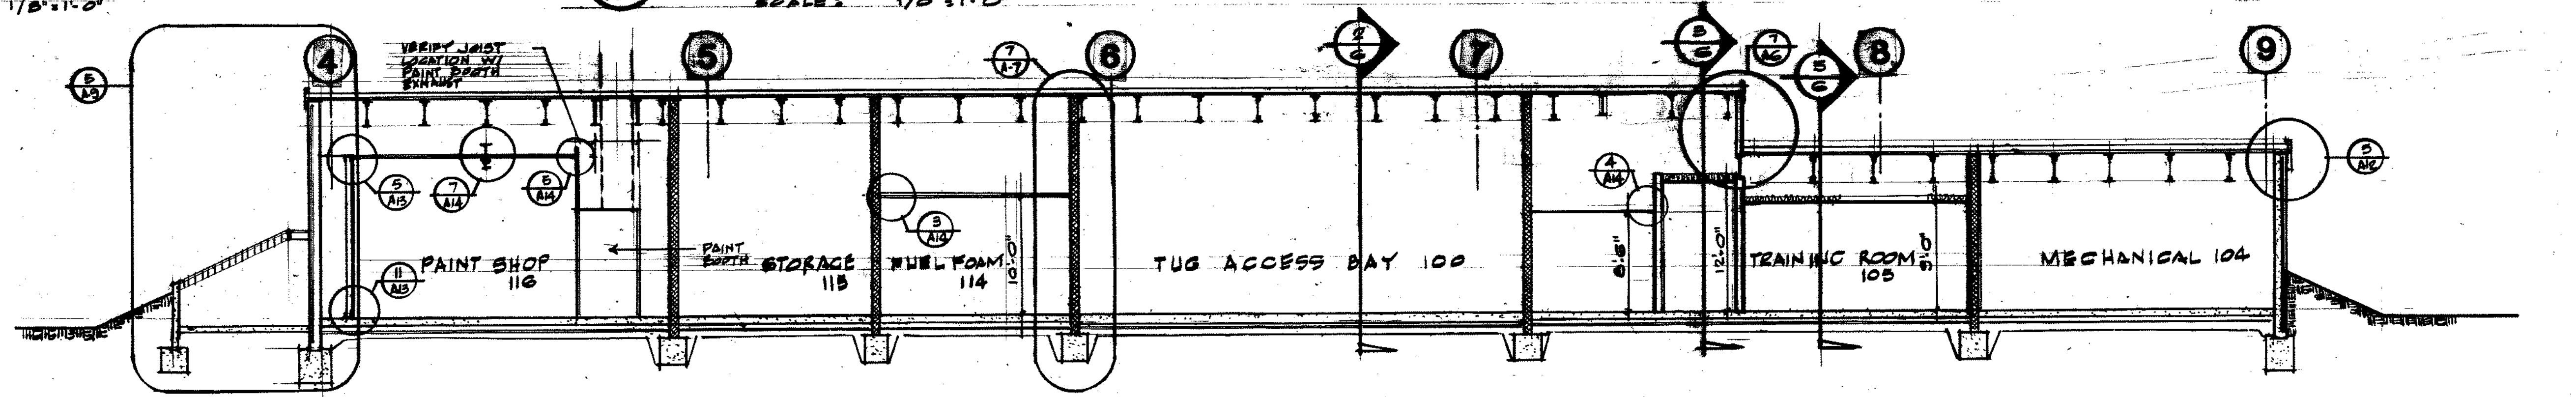

6 CROSS SECTION


DATE: FEB 26, 1970
 JOB NO: 84-123
 REVISIONS AS BUILT 11-16-87



SHEET TITLE: C-130 FUEL SYSTEM / CORROSION CONTROL
 MAINTENANCE HANGAR
 304th AIR RESCUE RECOVERY SQUADRON
 PORTLAND INTERNATIONAL AIRPORT
 PORTLAND OREGON

A-6

RECORD DRAWINGS FROM
 INFORMATION SUPPLIED BY
 THE GENERAL CONTRACTOR

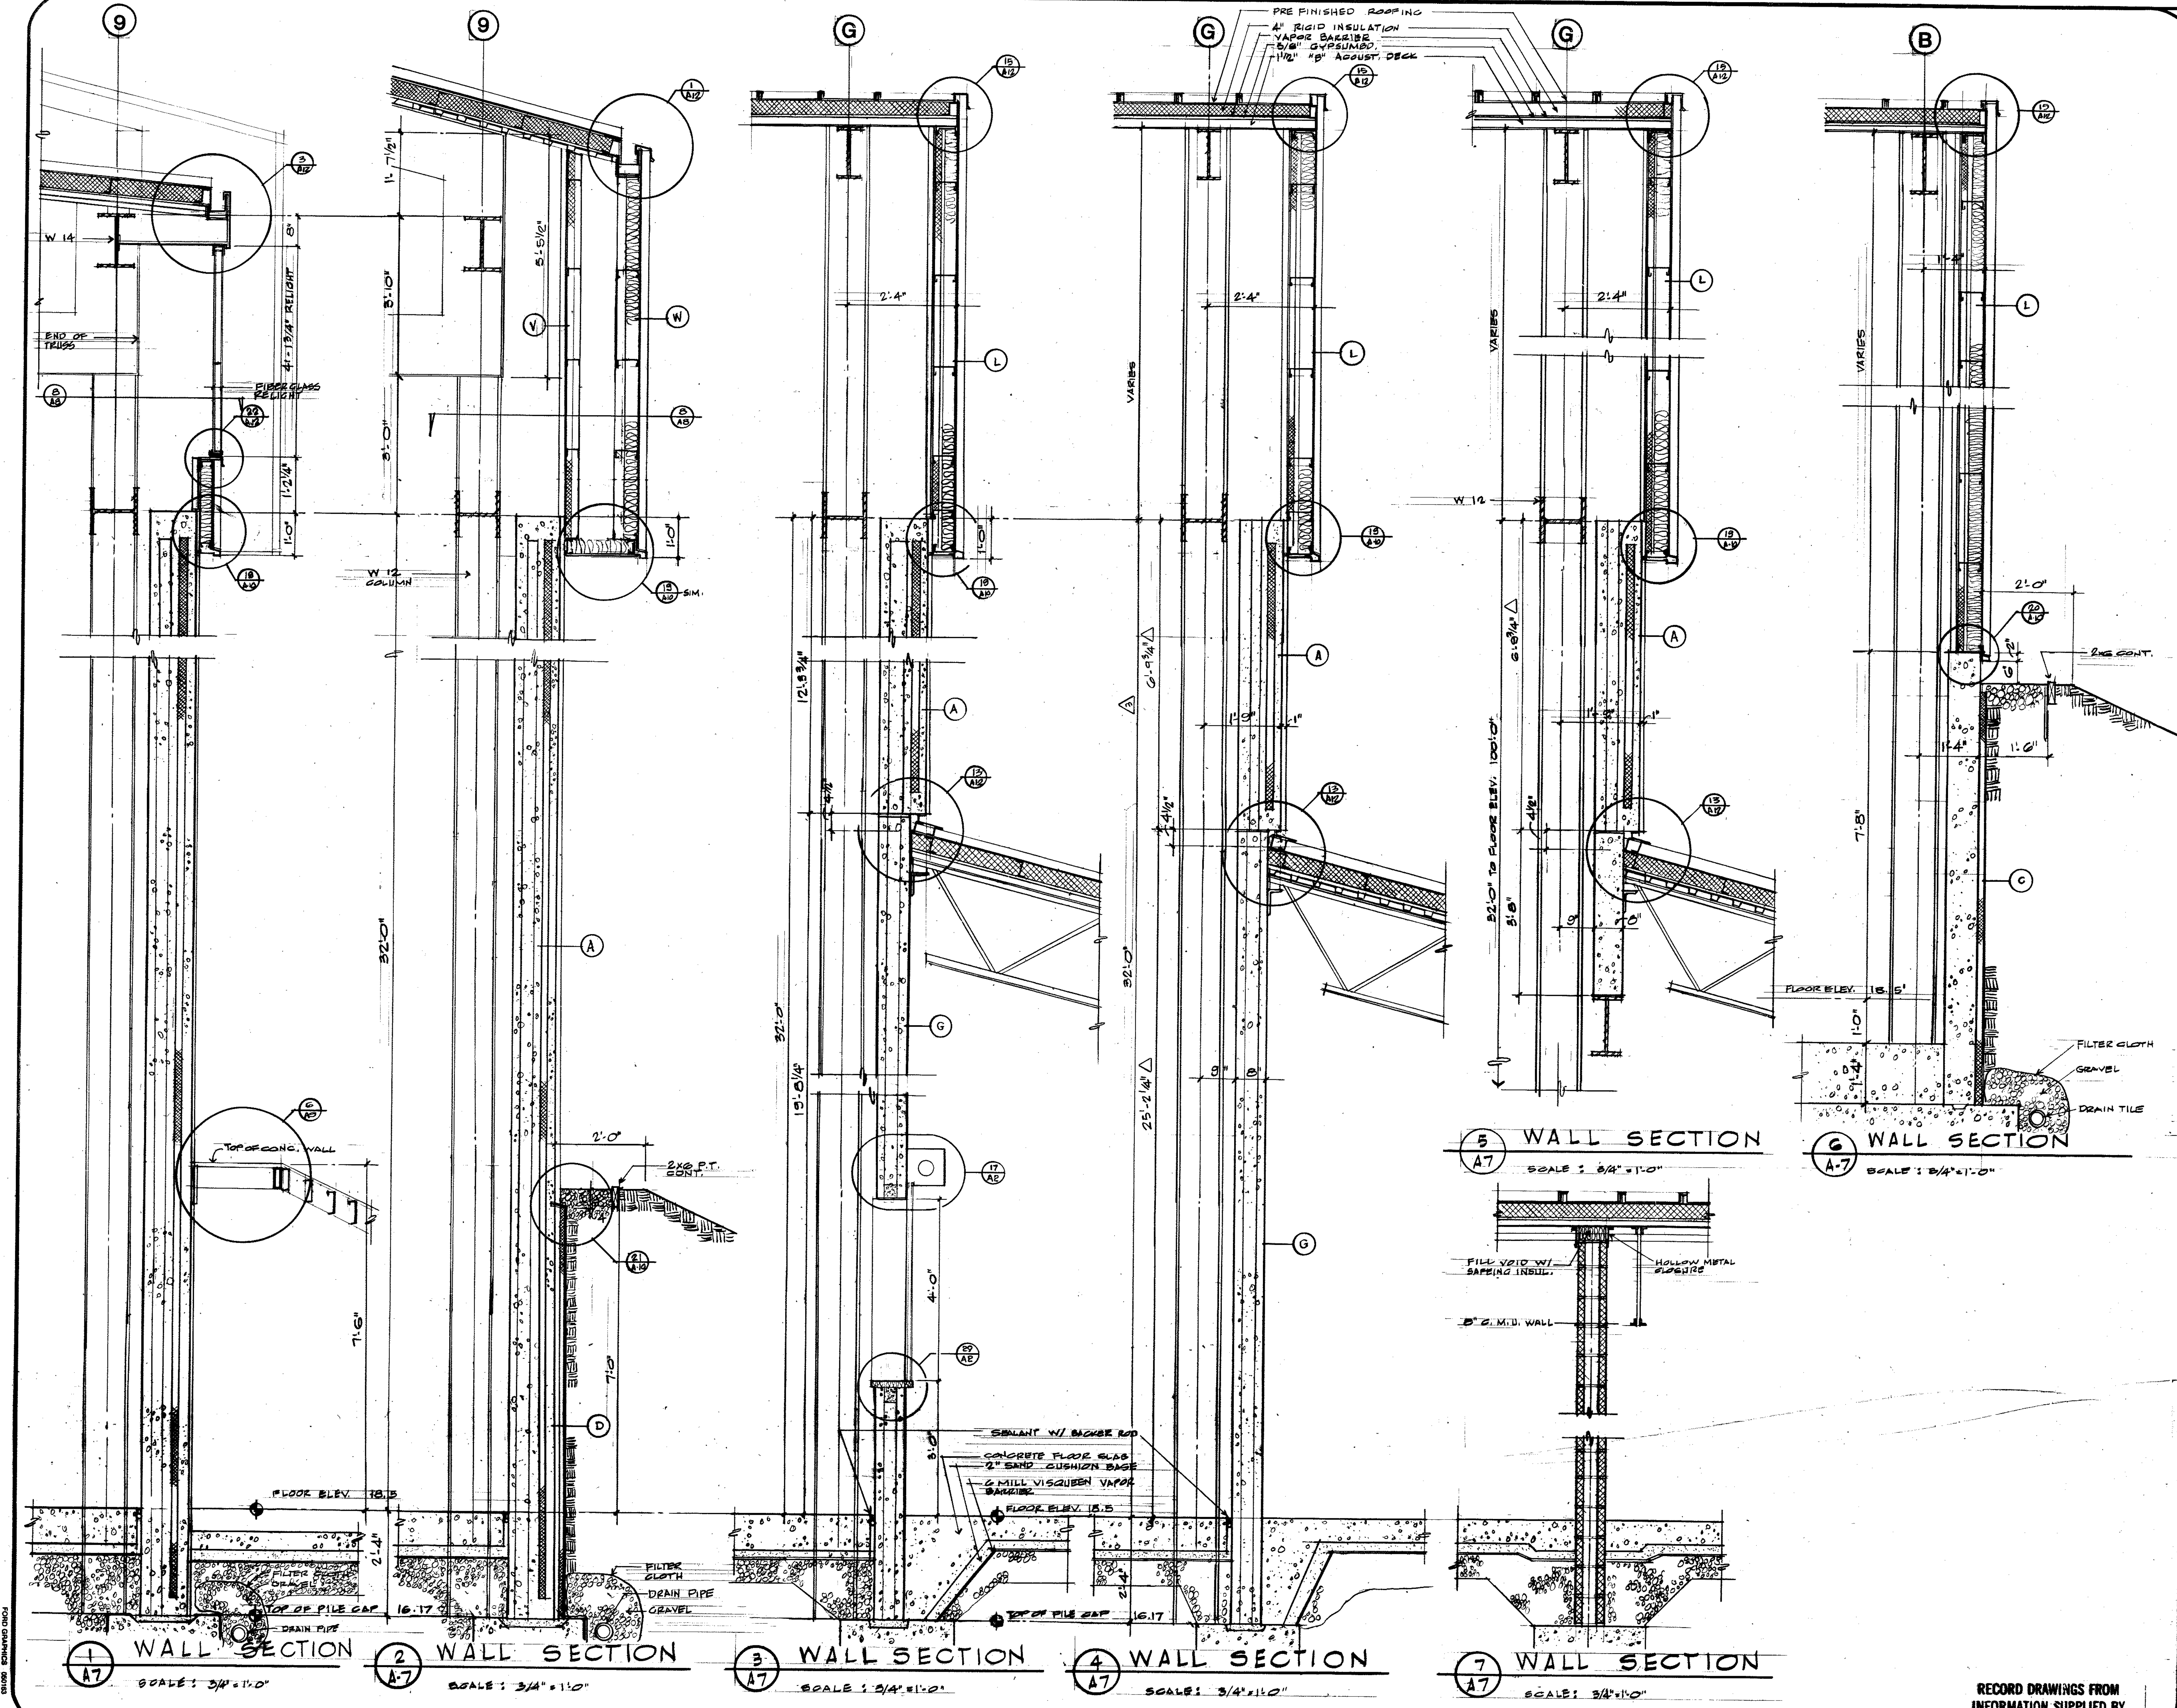


1 WALL SECTION
A-7 SCALE: 3/4"=1'-0"

2 WALL SECTION
A-7 SCALE: 3/4"=1'-0"

3 WALL SECTION
A-7 SCALE: 3/4"=1'-0"

4 WALL SECTION
A-7 SCALE: 3/4"=1'-0"

5 WALL SECTION
A-7 SCALE: 3/4"=1'-0"

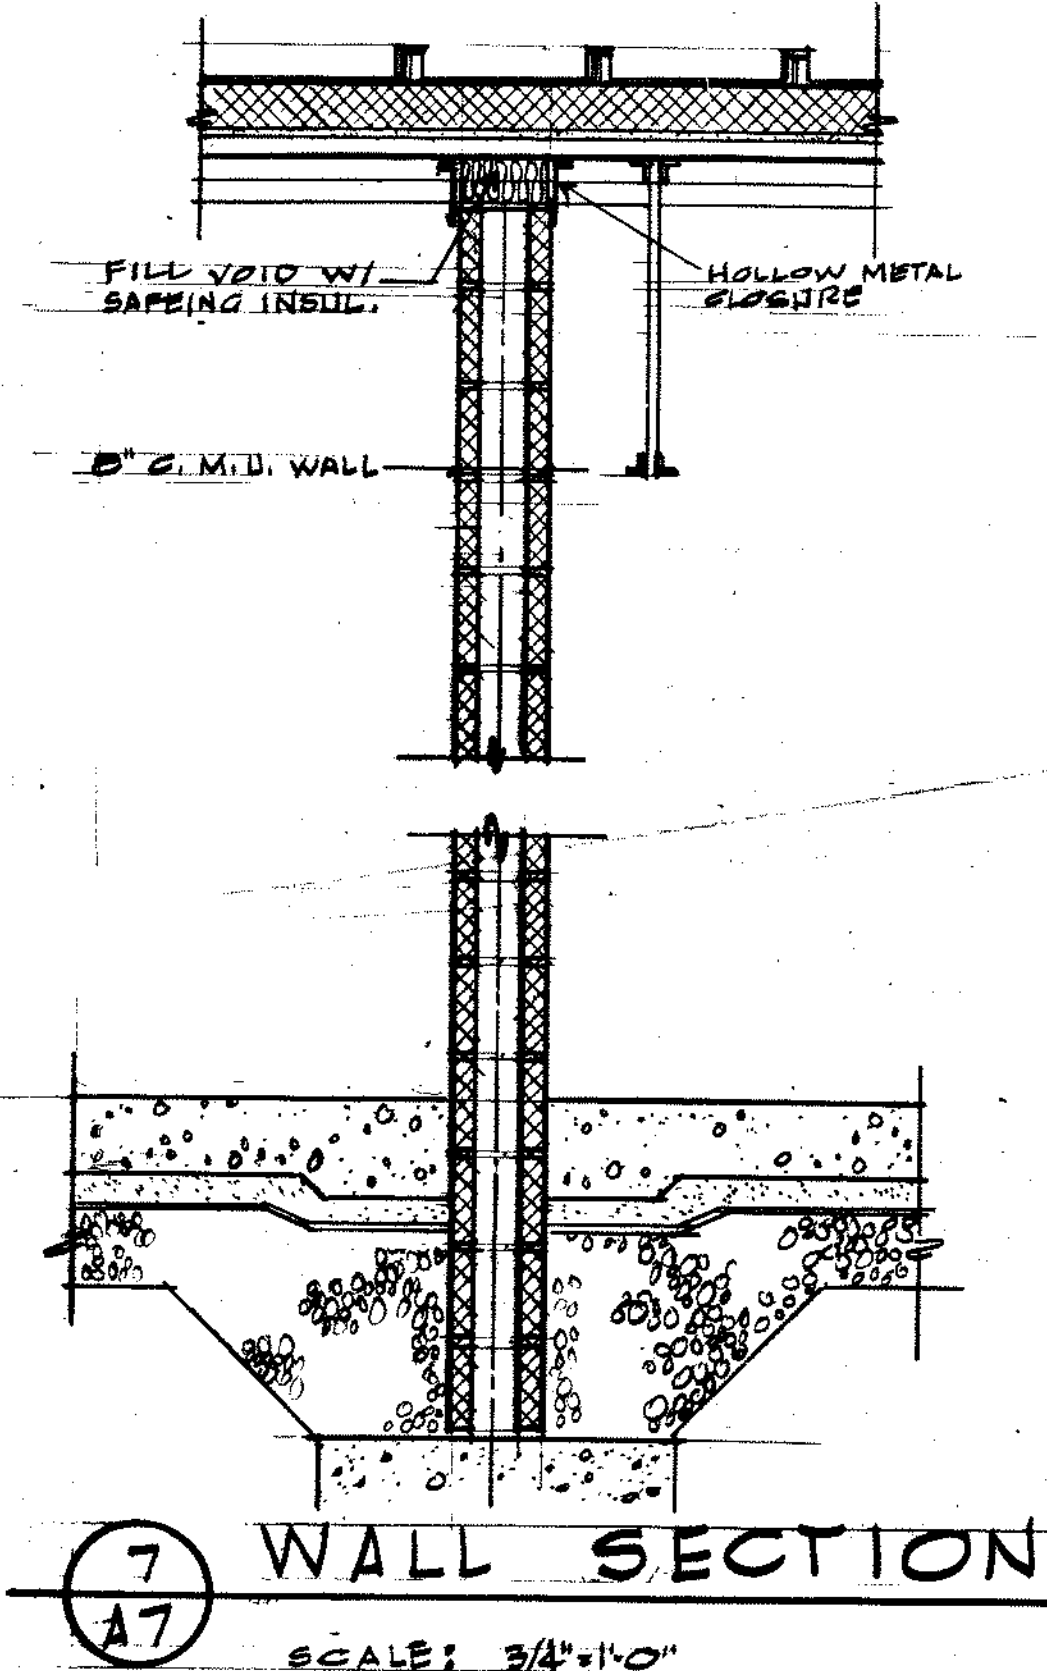

6 WALL SECTION
A-7 SCALE: 3/4"=1'-0"

miller-cook architects a.i.a.
30 N.W. 1ST AVE.
PORTLAND, OREGON
15031228-0282 97508

DATE FEB. 21, 1996
JOB NO. 94-125
REVISIONS 3-29-86
AS BUILT 11-16-87


REGISTERED ARCHITECT
JACK C. MILLER
PORTLAND, OREGON
1484
STATE OF OREGON

SHEET TITLE: WALL SECTIONS
C-130 FUEL SYSTEM / CORROSION CONTROL
MAINTENANCE HANGAR
304th AIR RESCUE RECOVERY SQUADRON
PORTLAND INTERNATIONAL AIRPORT
OREGON

A-7

RECORD DRAWINGS FROM
INFORMATION SUPPLIED BY
THE GENERAL CONTRACTOR

BLDG 375

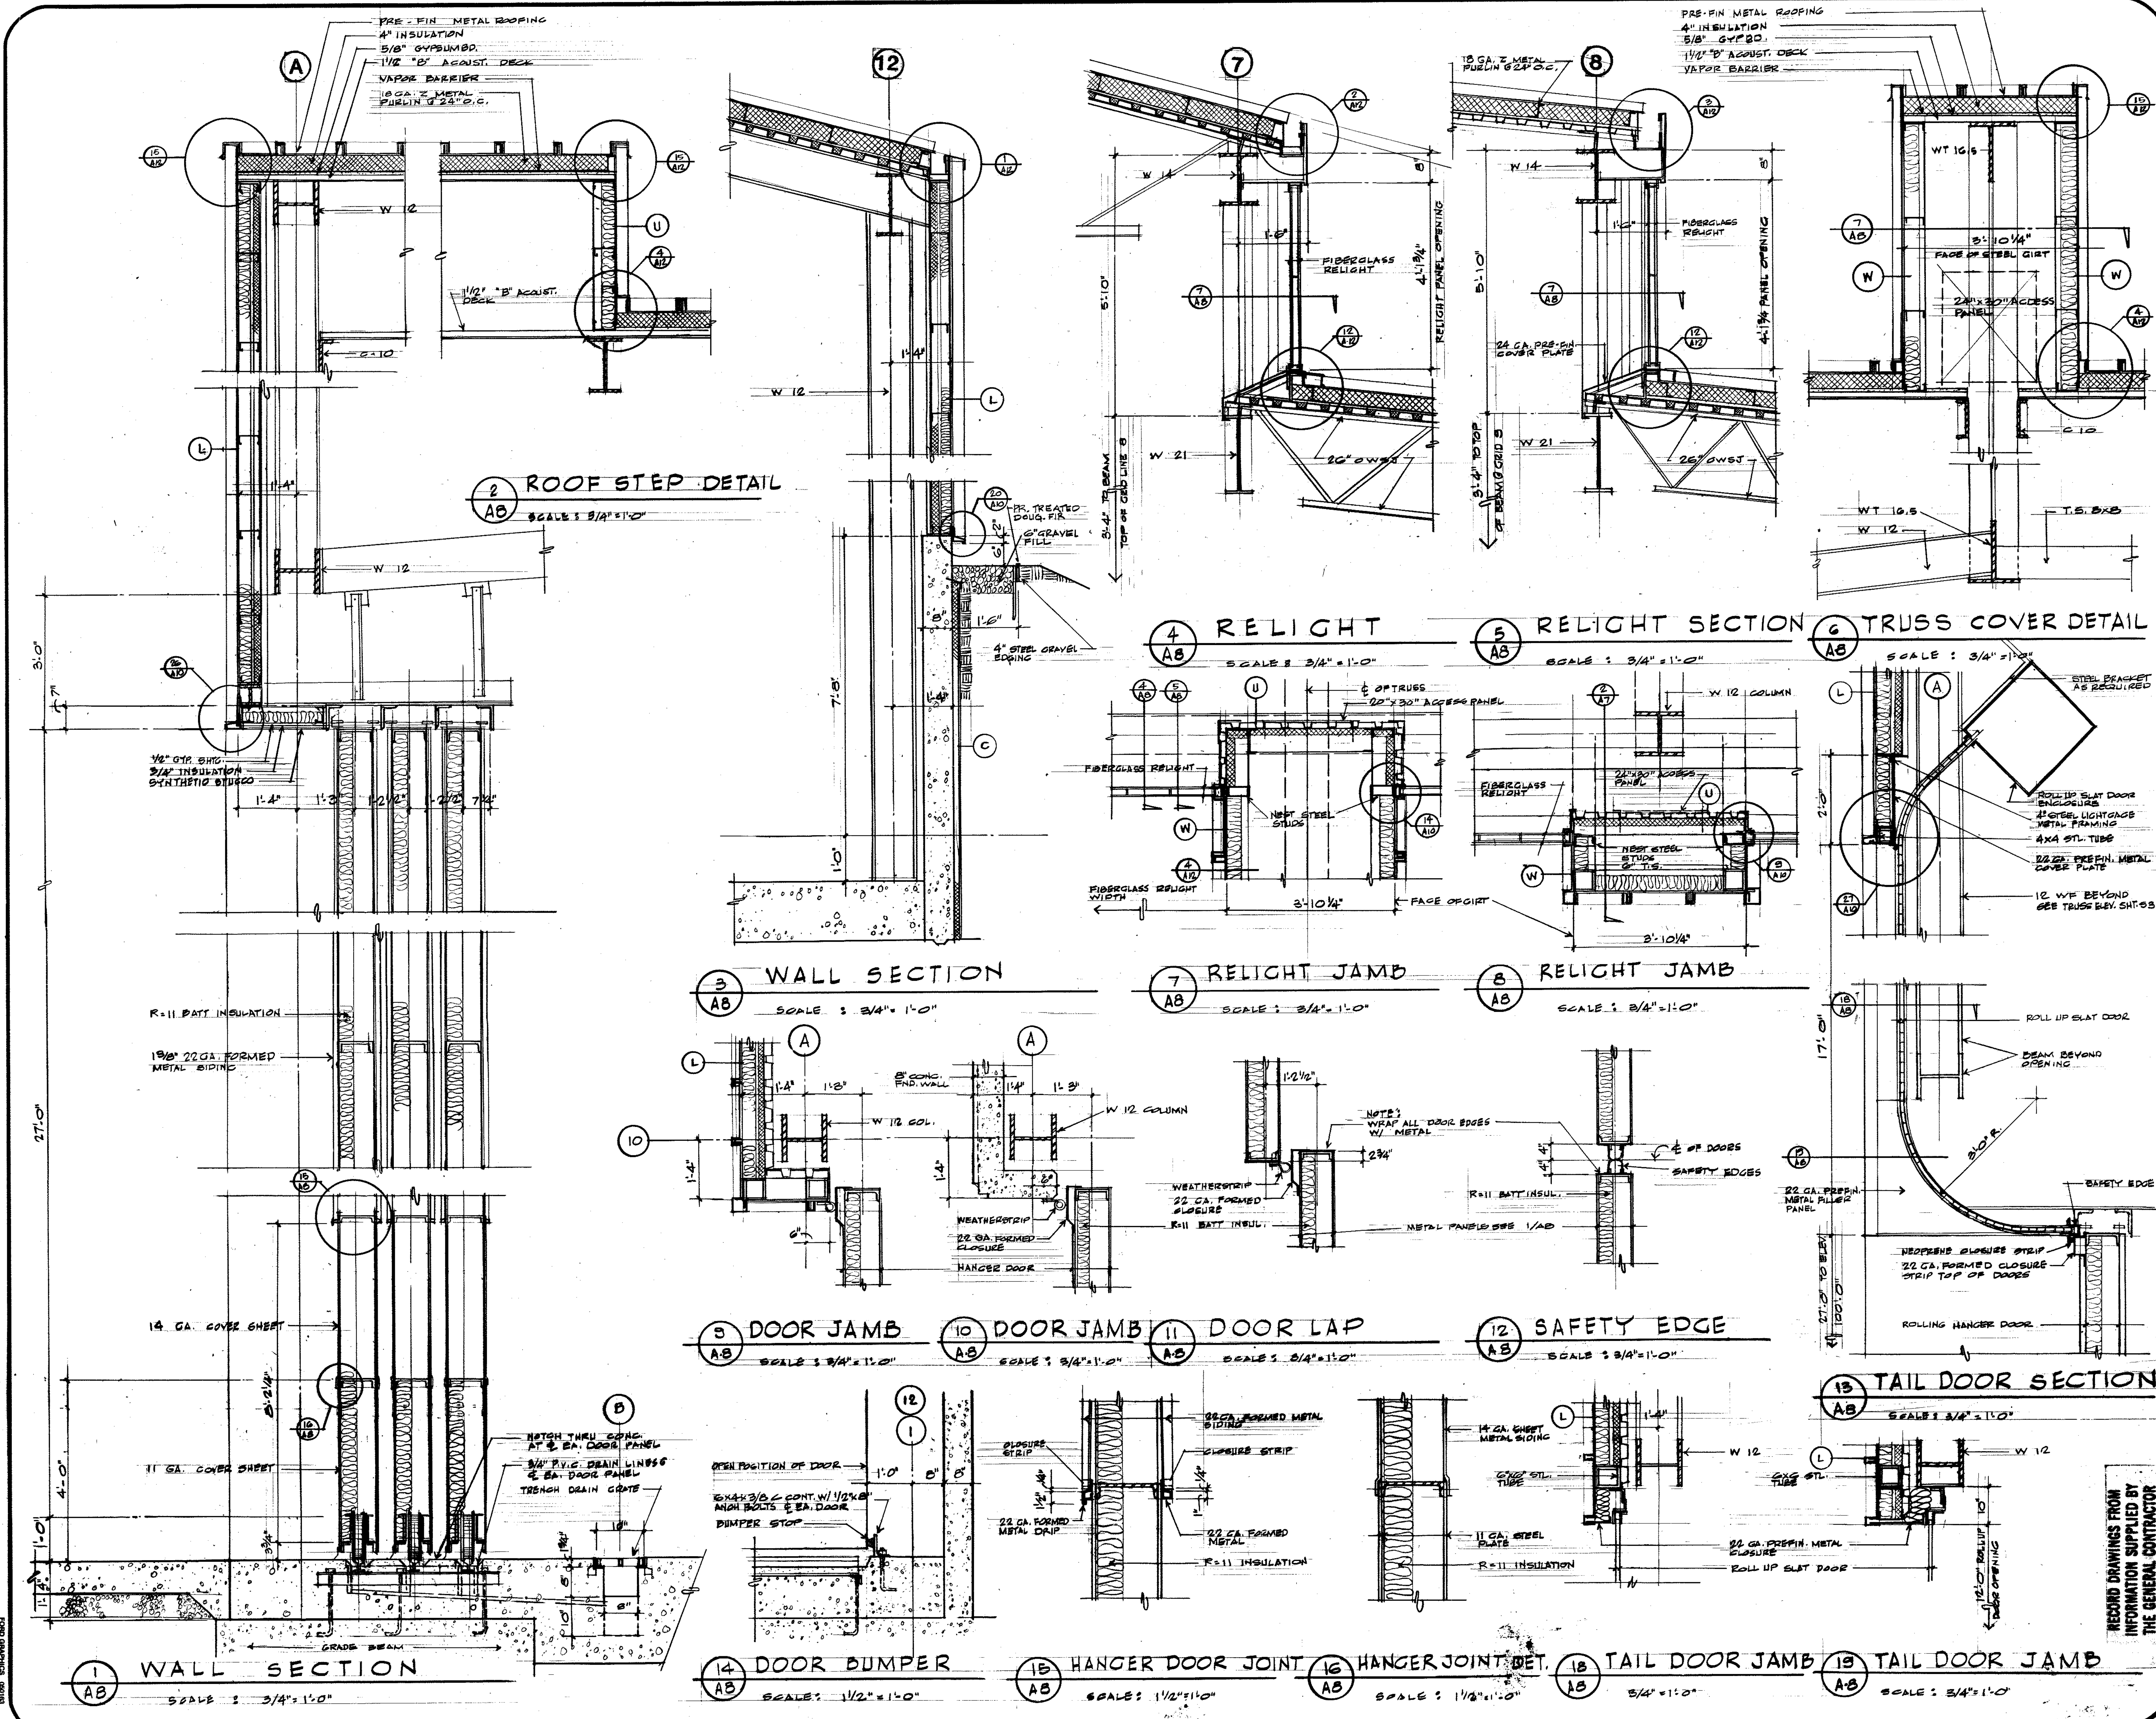

miller-cook architects a.i.a.
 30 N.W. 1st AVE. PORTLAND, OREGON
 1503 222-0222
 1503 222-0700

DATE: FEB. 21, 1980
 JOB NO: 84-125
 REVISIONS: AS BUILT 11-16-87


REGISTERED ARCHITECT
 JACK C. MILLER
 PORTLAND, OREGON
 1984
 STATE OF OREGON

SHEET TITLE: WALL SECTIONS
C-130 FUEL SYSTEM / CORROSION CONTROL MAINTENANCE HANGAR
304TH AIR RESCUE RECOVERY SQUADRON
PORTLAND INTERNATIONAL AIRPORT
 PORTLAND, OREGON

RECORD DRAWINGS FROM INFORMATION SUPPLIED BY THE GENERAL CONTRACTOR

A-8

BLDG 375

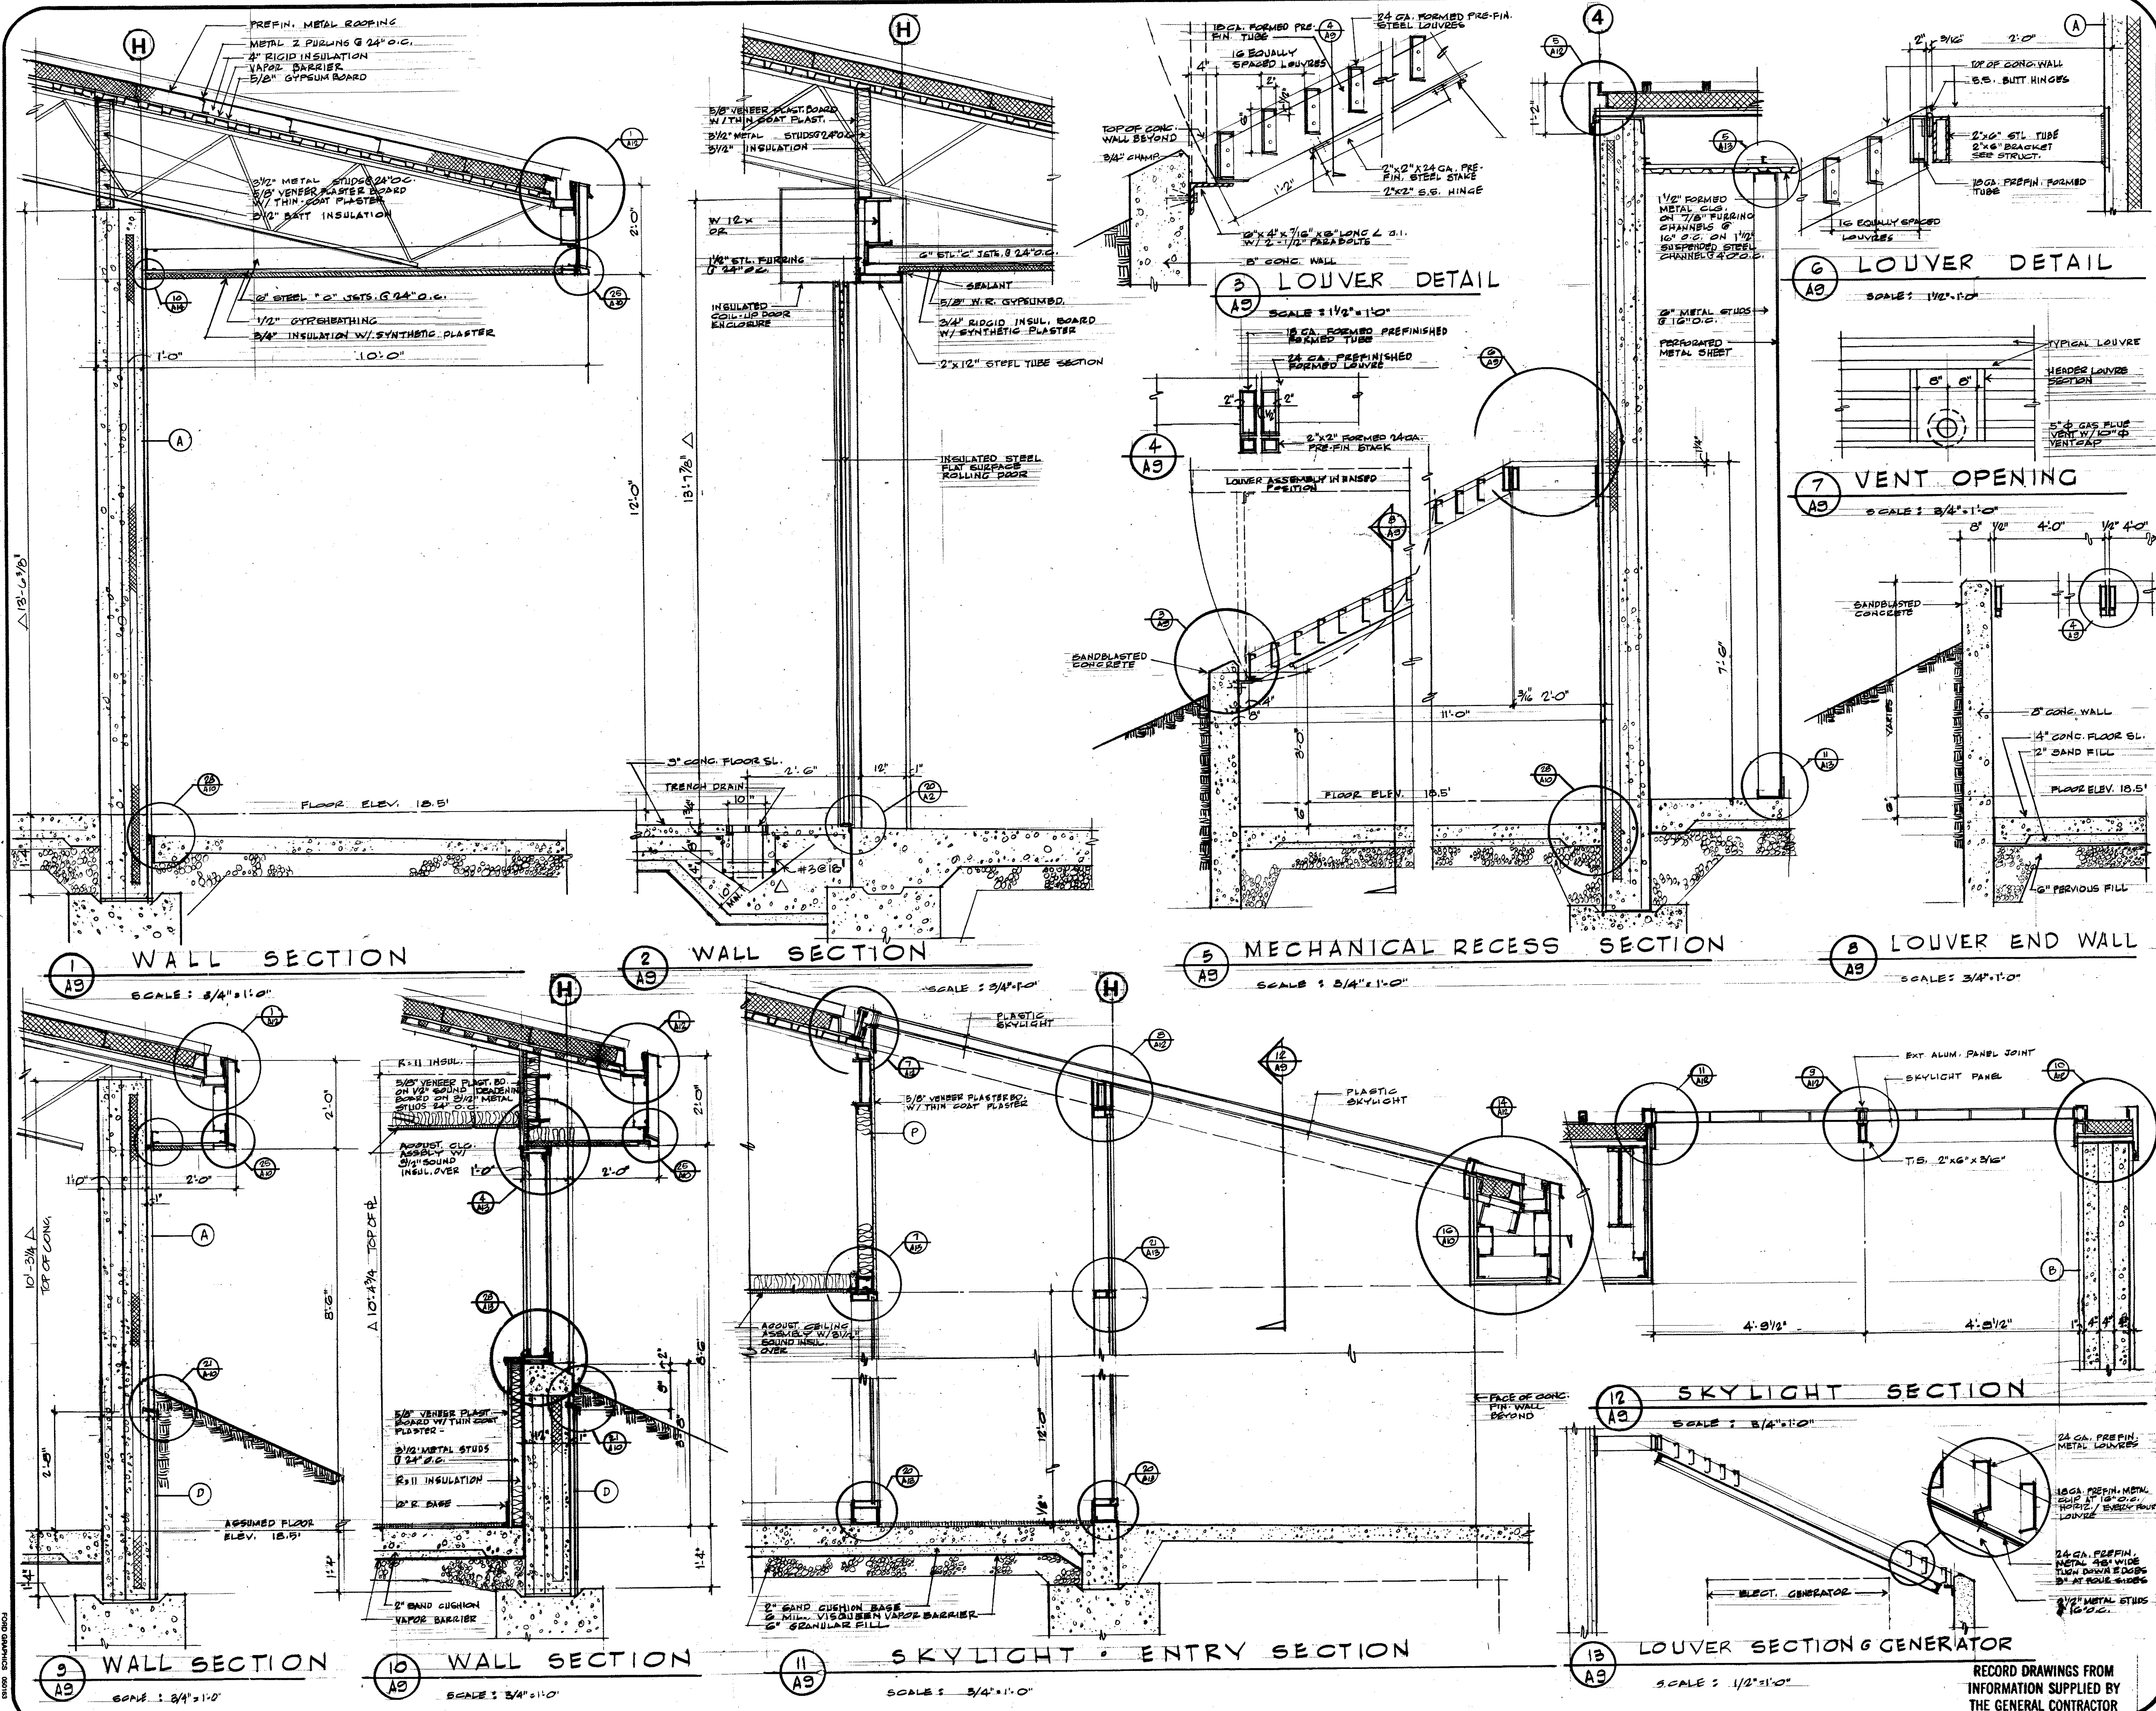

miller-cook architects a.i.a.
 30 N.W. 1st Ave.
 PORTLAND, OREGON 97208
 (503) 226-0822


REGISTERED ARCHITECT
 JACOB C. MILLER
 PORTLAND OREGON 1944
 STATE OF OREGON

SHEET TITLE: WALL SECTIONS
C-130 FUEL SYSTEM / CORROSION CONTROL MAINTENANCE HANGAR
304th AIR-RESCUE RECOVERY SQUADRON
PORTLAND INTERNATIONAL AIRPORT
 PORTLAND OREGON


DATE: FEB. 20, 1980
 JOB NO: 84-1125
 REVISIONS: AS BUILT 11-16-87

RECORD DRAWINGS FROM INFORMATION SUPPLIED BY THE GENERAL CONTRACTOR

A-9
 BLDG 375

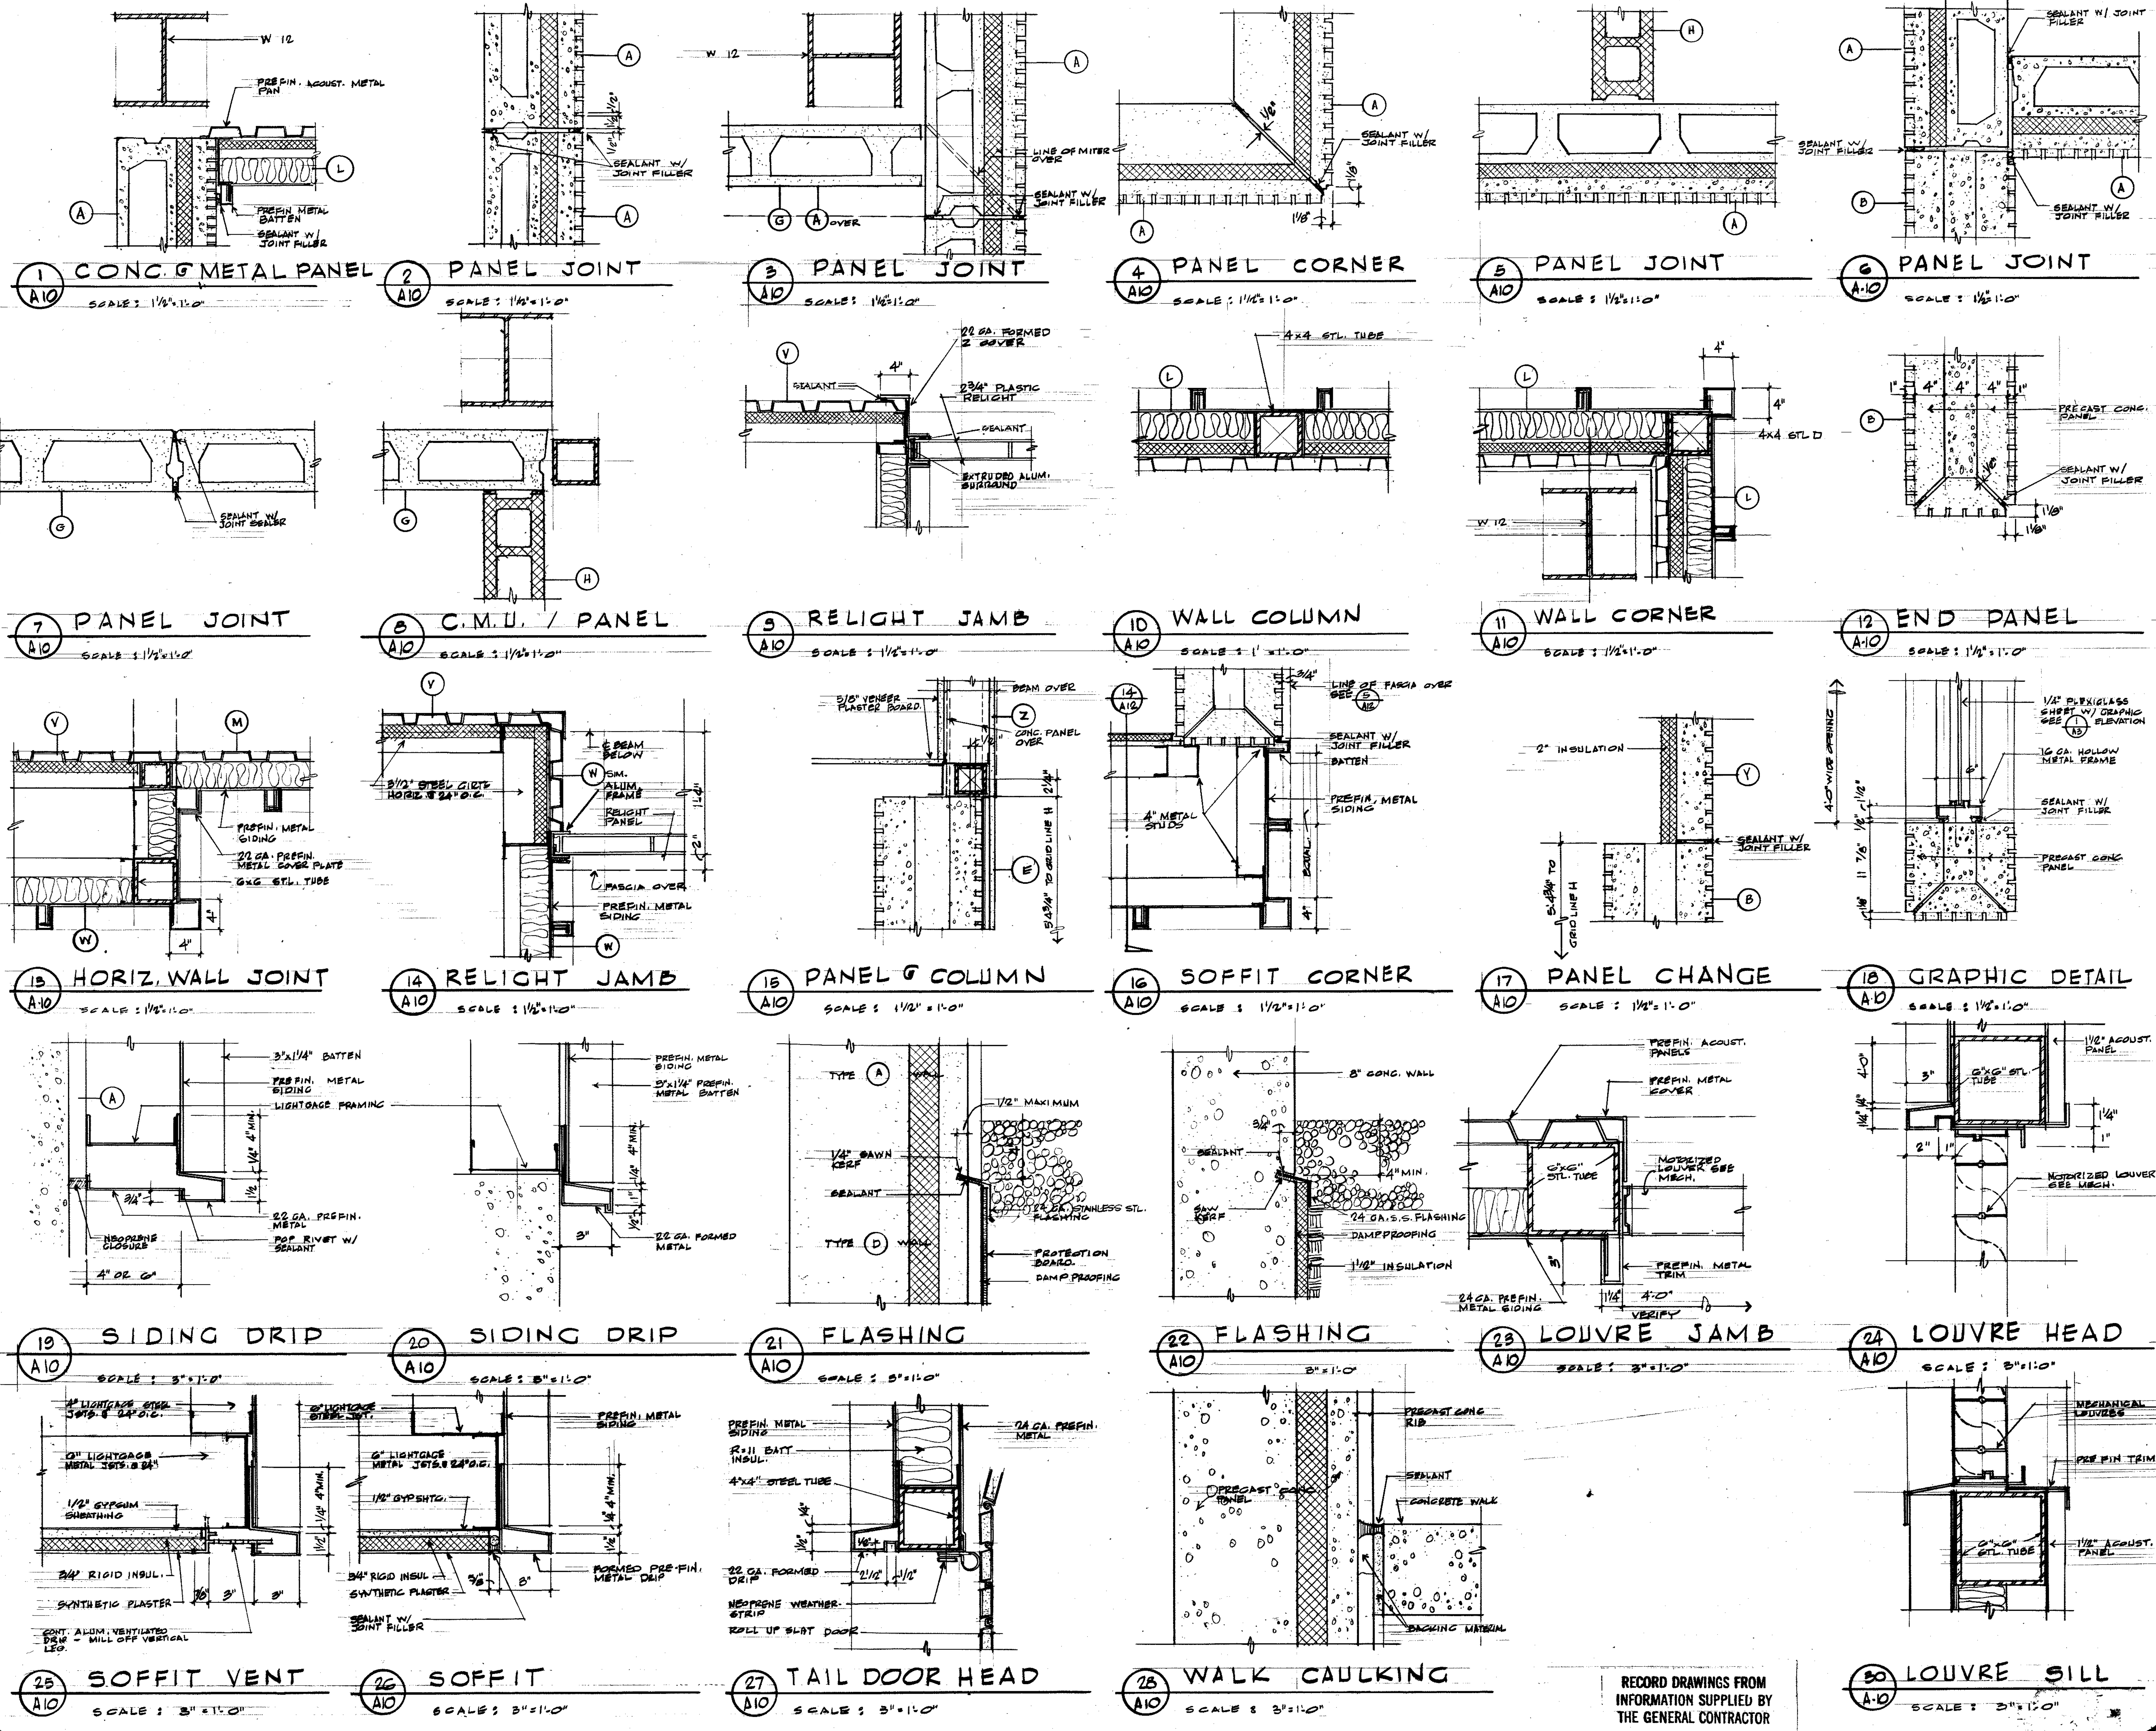

RECORD DRAWINGS FROM
 INFORMATION SUPPLIED BY
 THE GENERAL CONTRACTOR

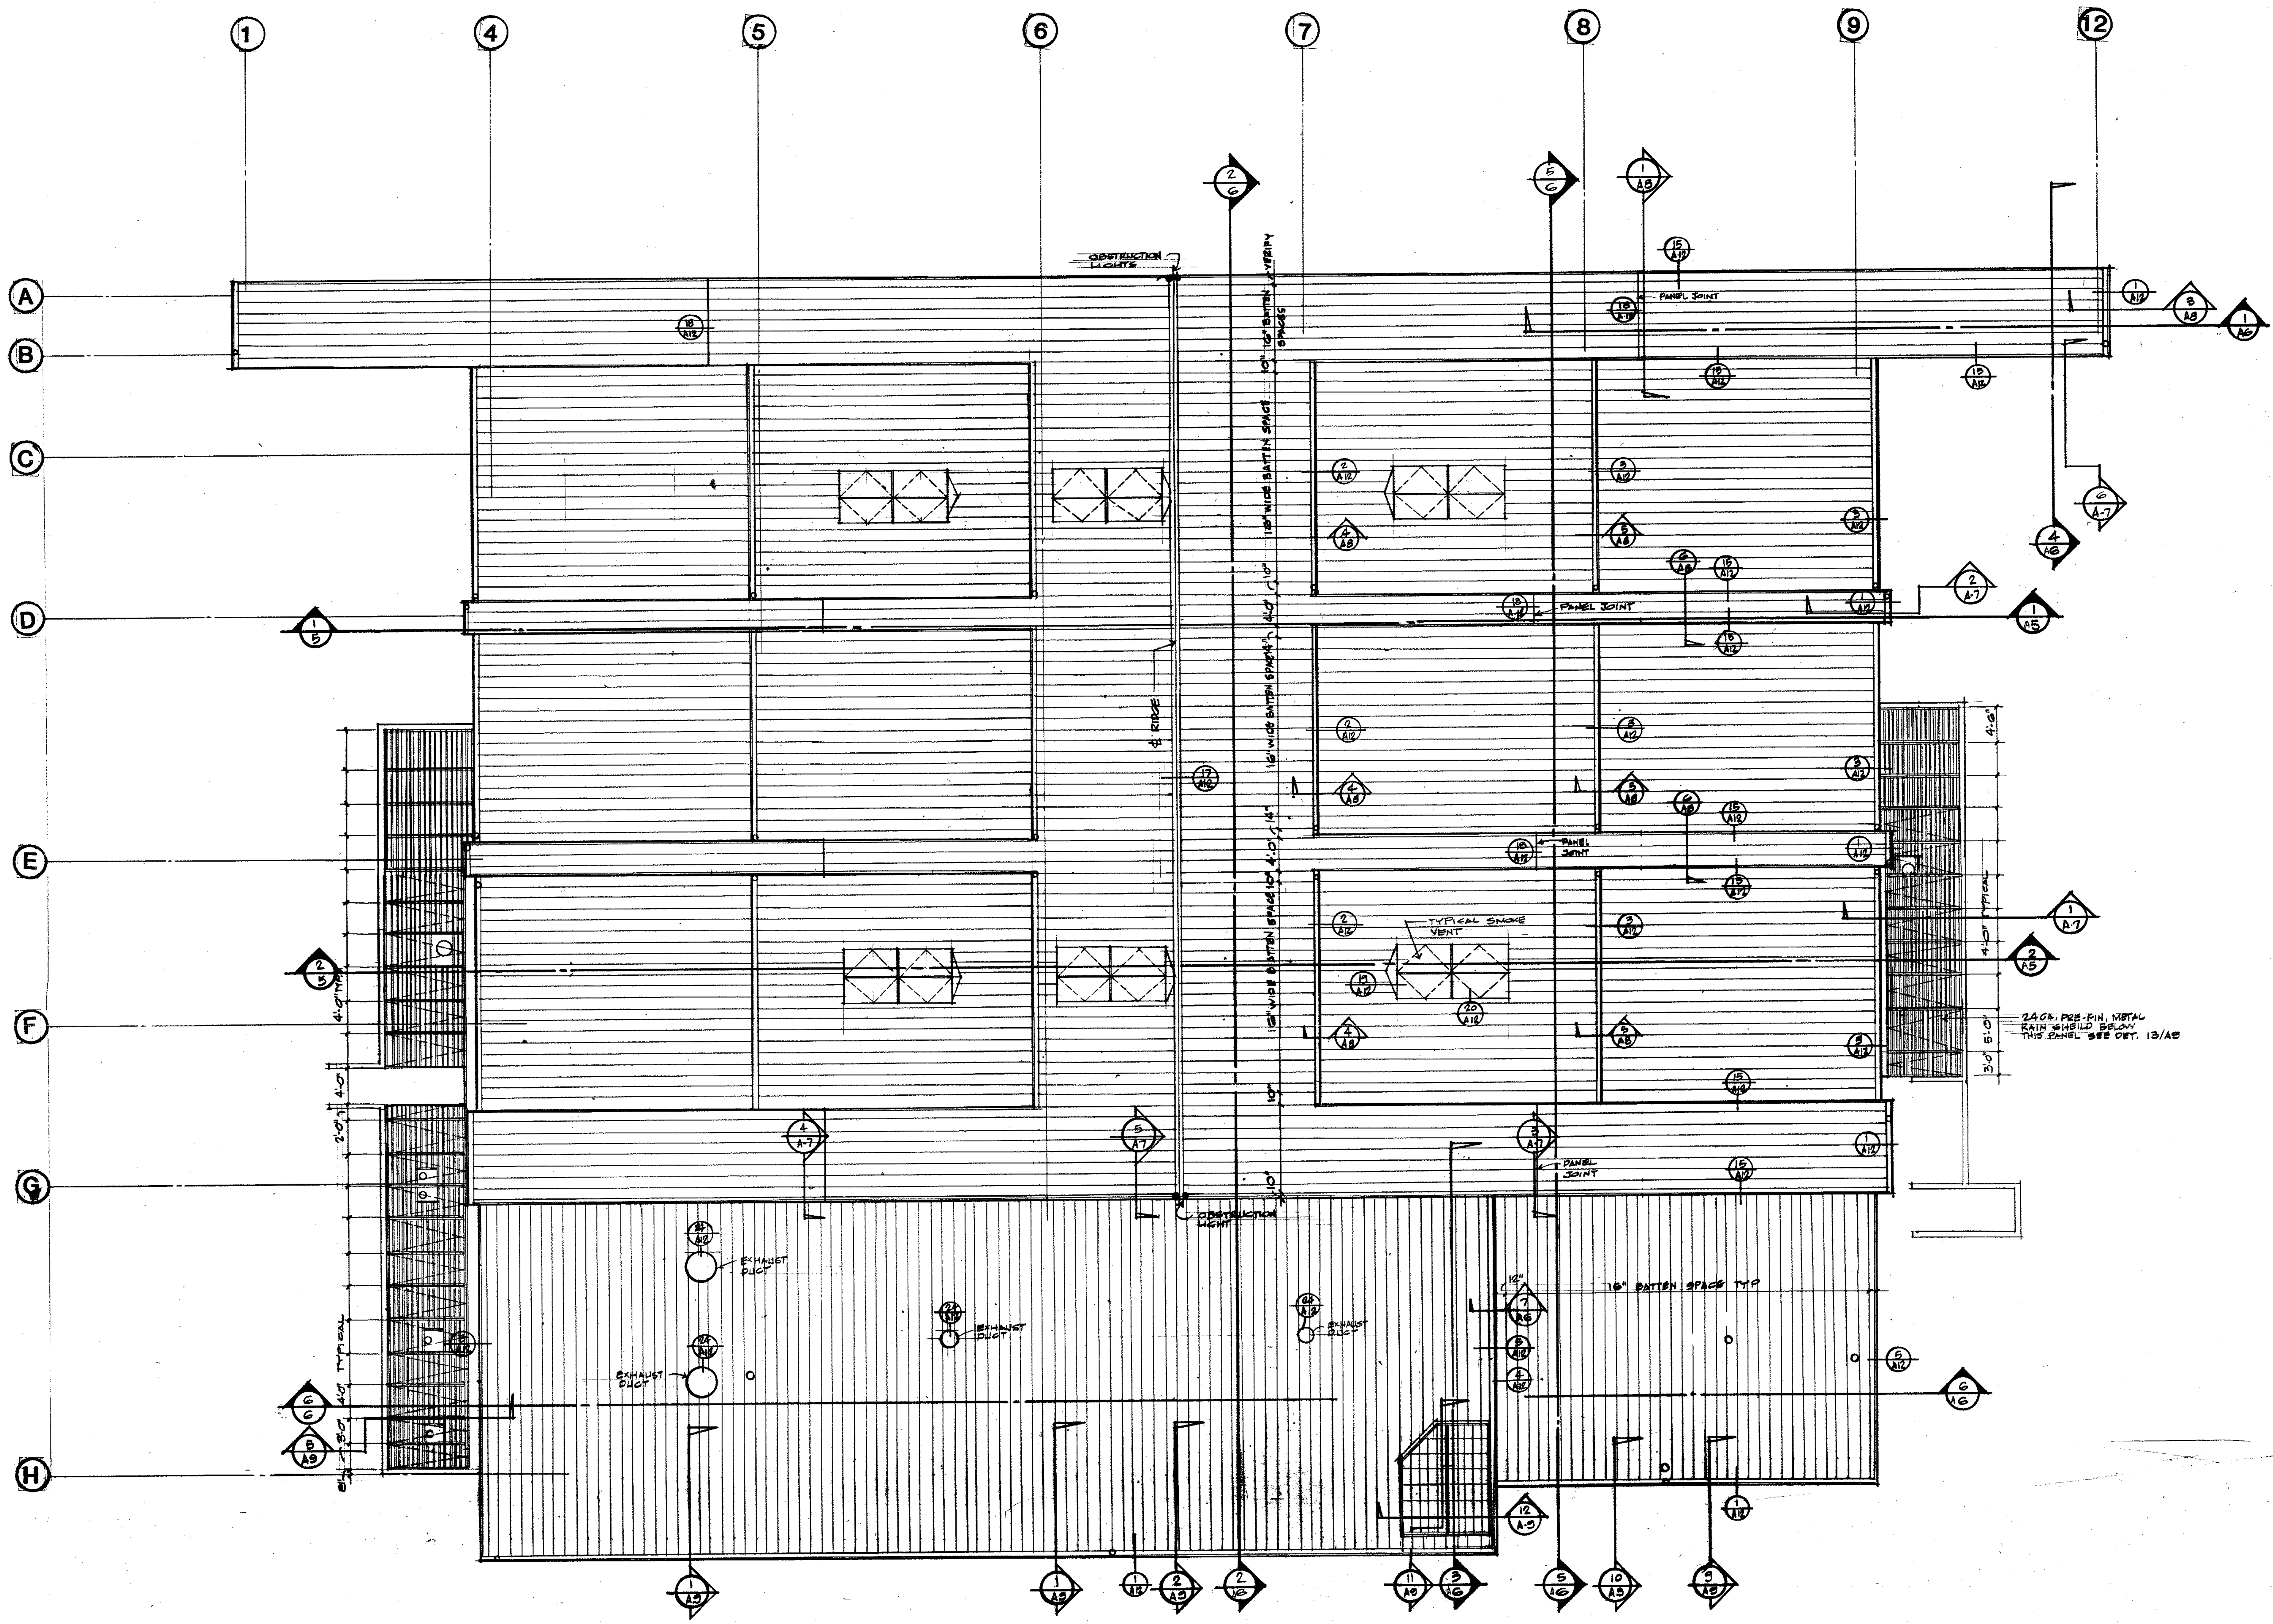


1 ALL ROOF PLAN
SCALE



miller-cook architects a.i.a.
30 N.W. 1st AVE.
PORTLAND, OREGON
(503) 585-0888
57828


DATE FEB. 21, 1980
JOB NO. 84-125
REVISIONS AS BUILT 11-16-87

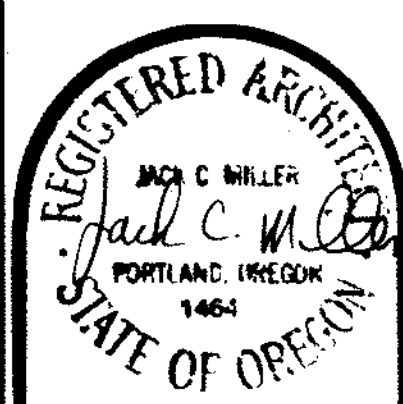

SHEET TITLE: 1980 PLAN
C-130 FUEL SYSTEM / CORROSION CONTROL
MAINTENANCE HANGAR
304th AIR RESCUE RECOVERY SQUADRON
PORTLAND INTERNATIONAL AIRPORT
OREGON

A-11

RECORD DRAWINGS FROM
INFORMATION SUPPLIED BY
THE GENERAL CONTRACTOR

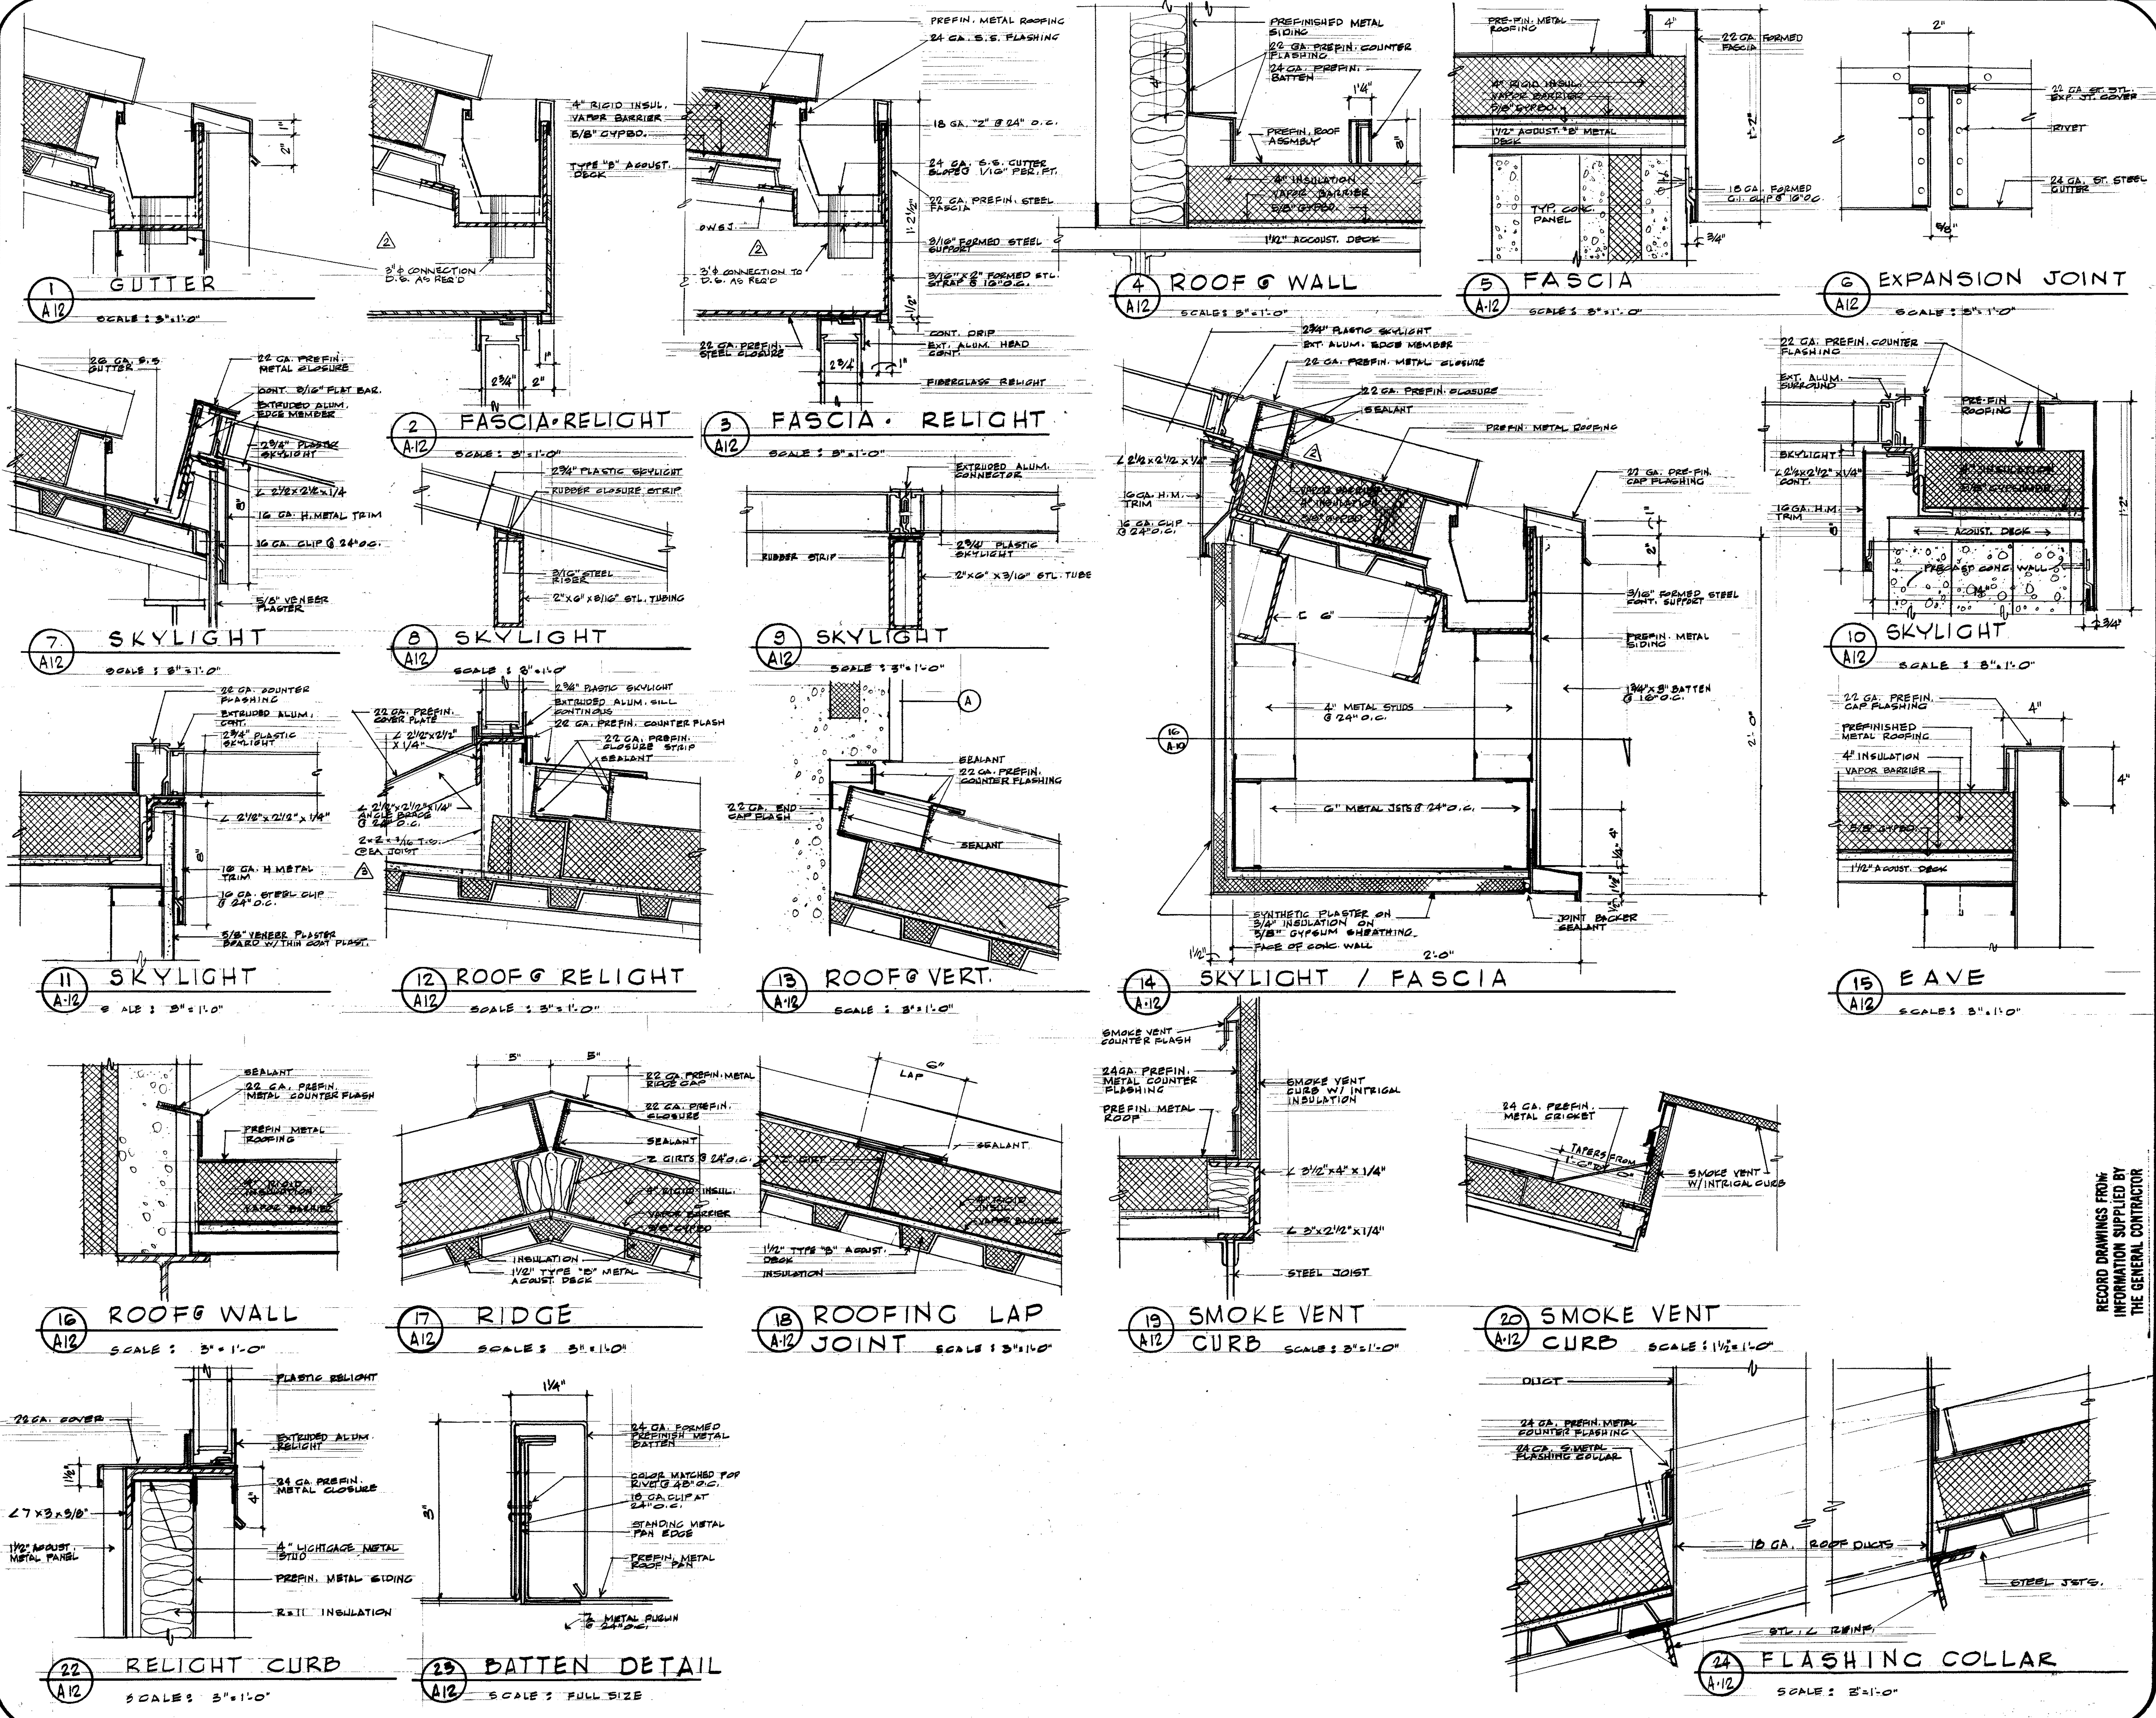

miller - cook architects a.i.a.
 30 N.W. 4th Ave.
 PORTLAND, OREGON 97209
 (503) 225-0888

























DATE: FEB. 20, 1960
 JOB NO: 84-122
 REVISIONS: 3-19-60
 ASSEMBL: 11-16-67



RECORD DRAWINGS FROM INFORMATION SUPPLIED BY THE GENERAL CONTRACTOR

SHEET TITLE: ROOF DETAILS
C-130 FUEL SYSTEM / CORROSION CONTROL MAINTENANCE HANGAR
304th AIR RESCUE RECOVERY SQUADRON
PORTLAND INTERNATIONAL AIRPORT
 PORTLAND, OREGON

A-12

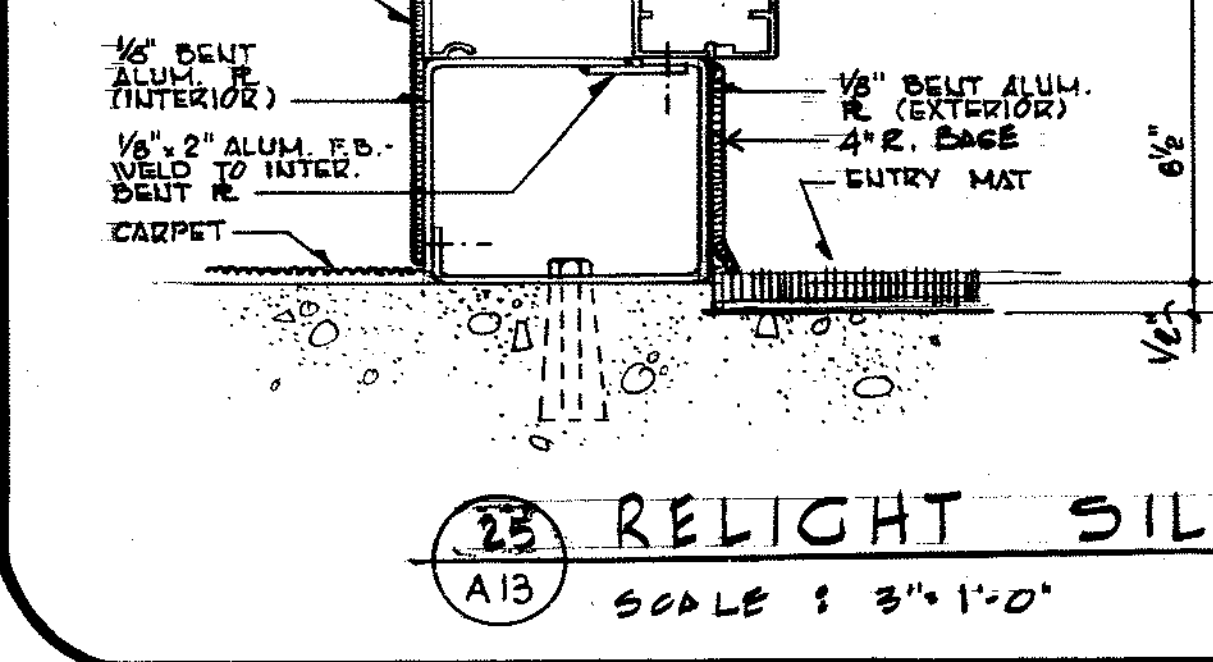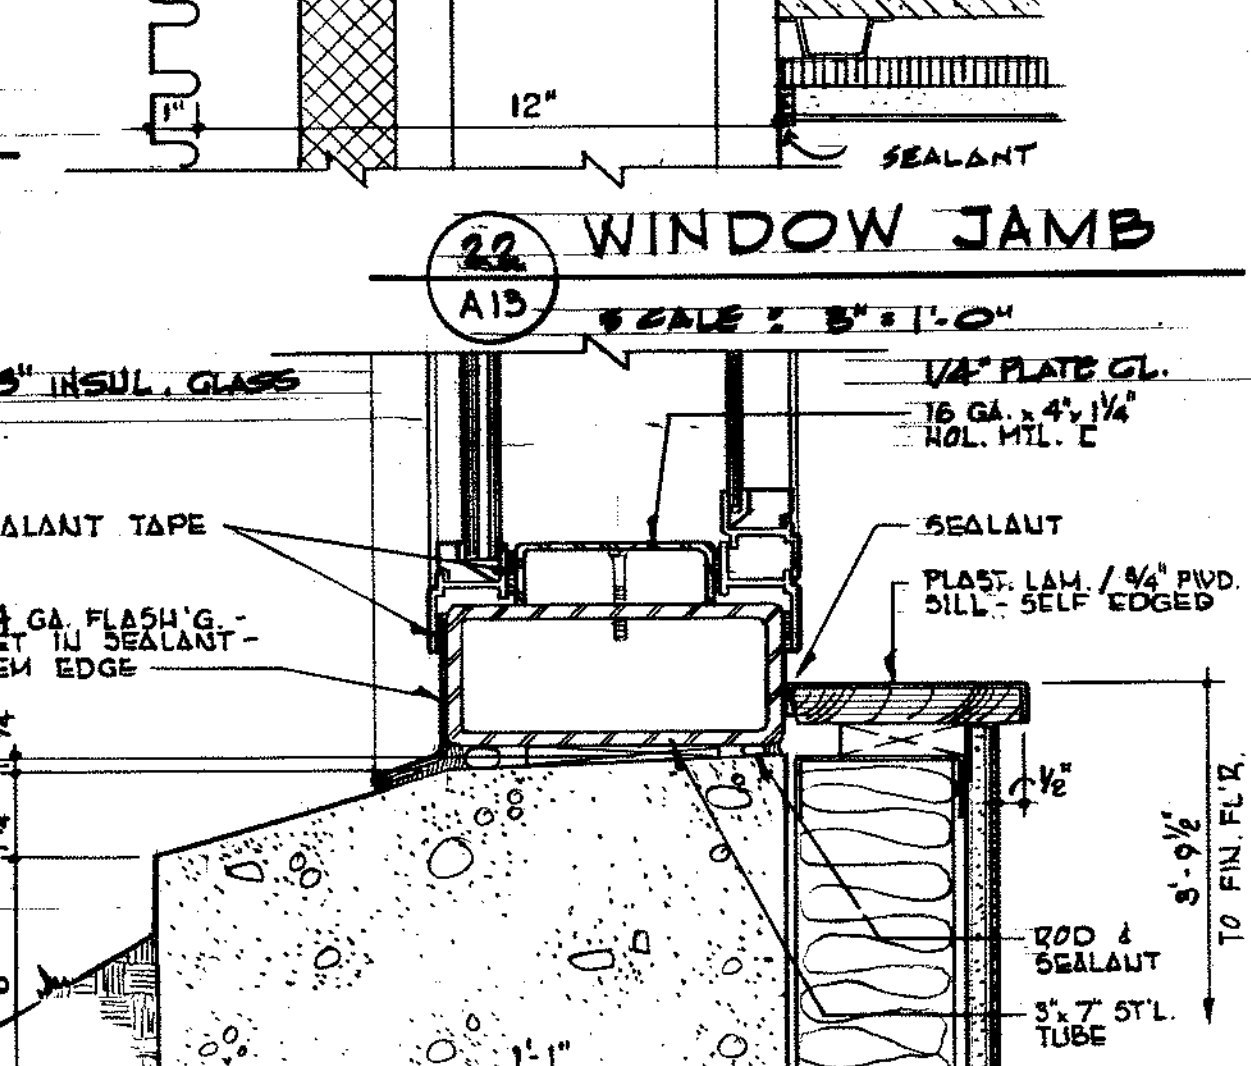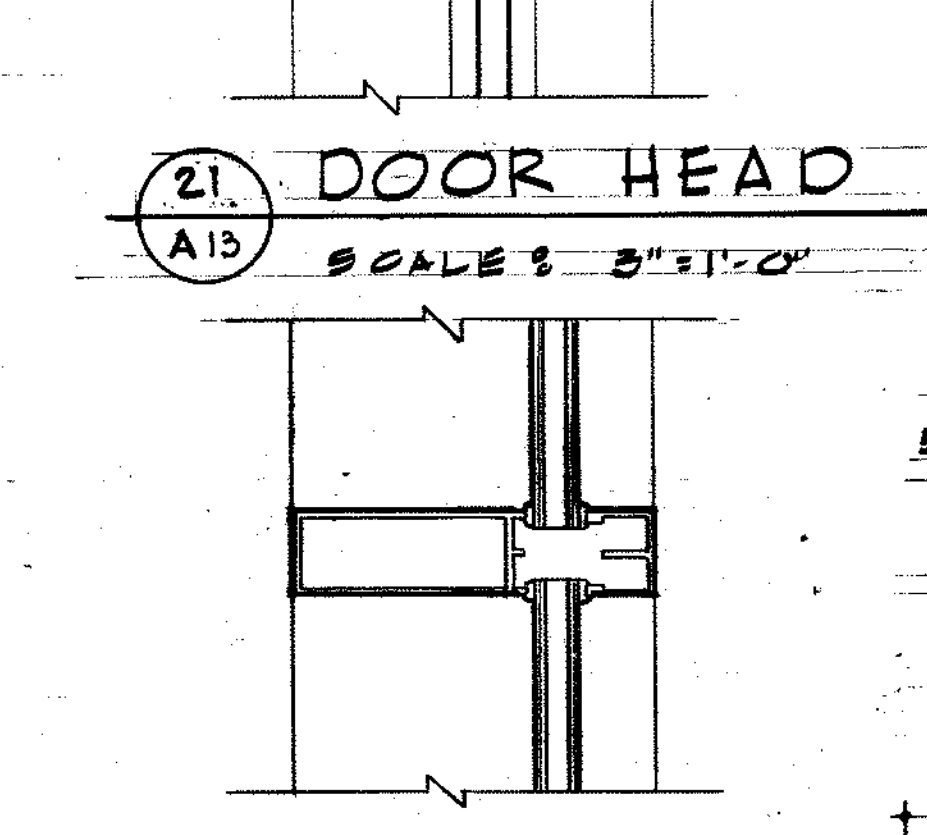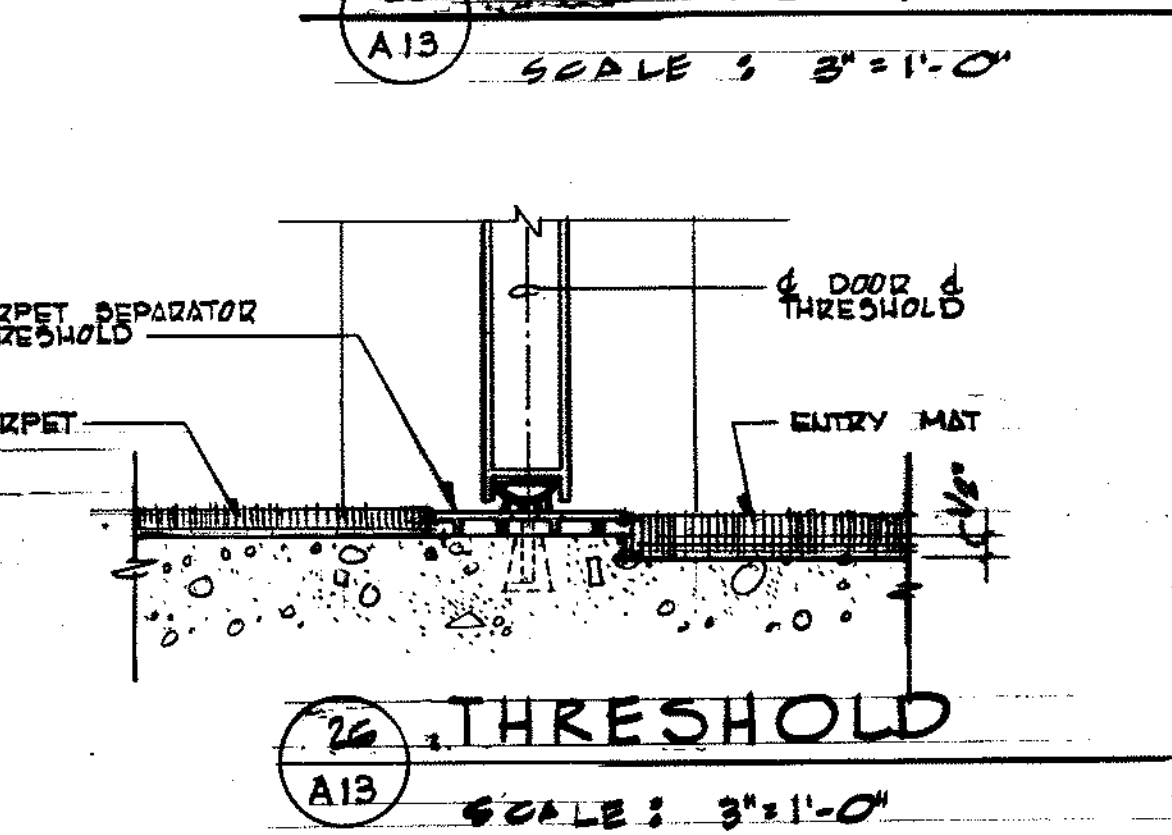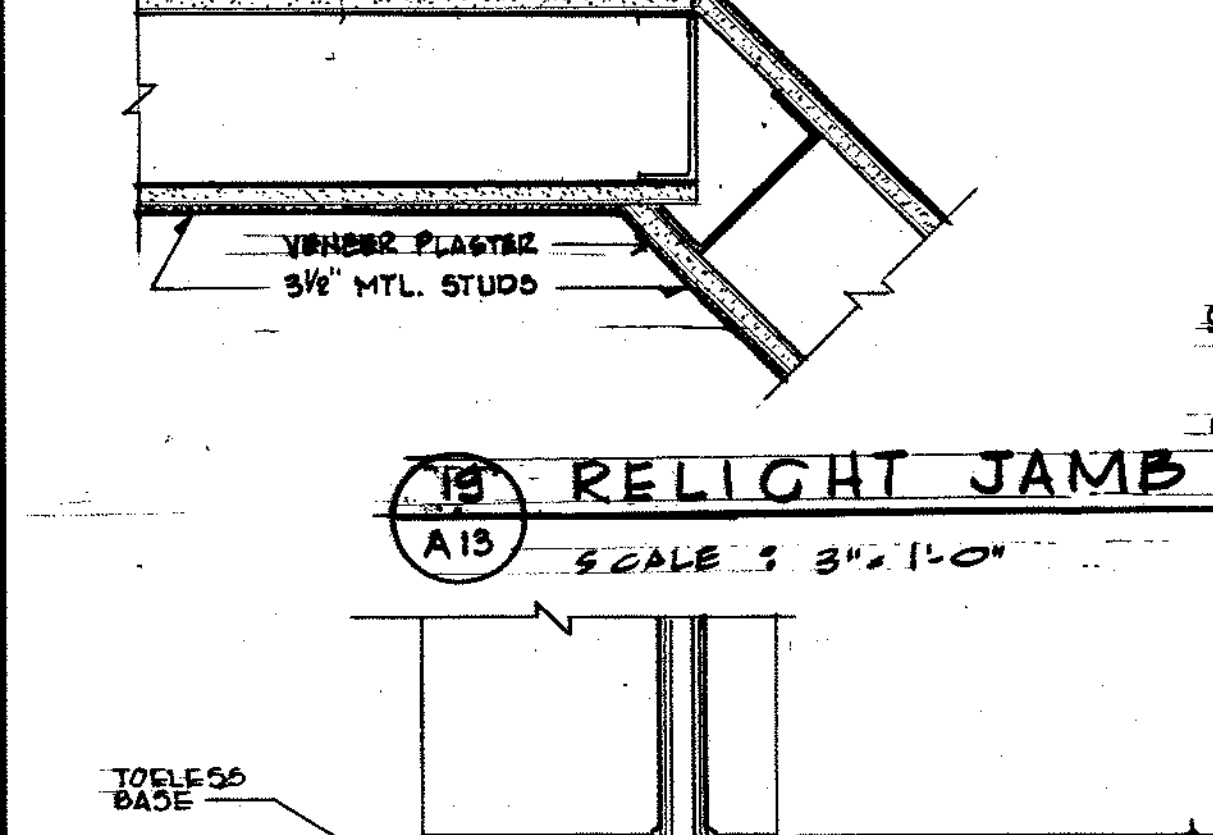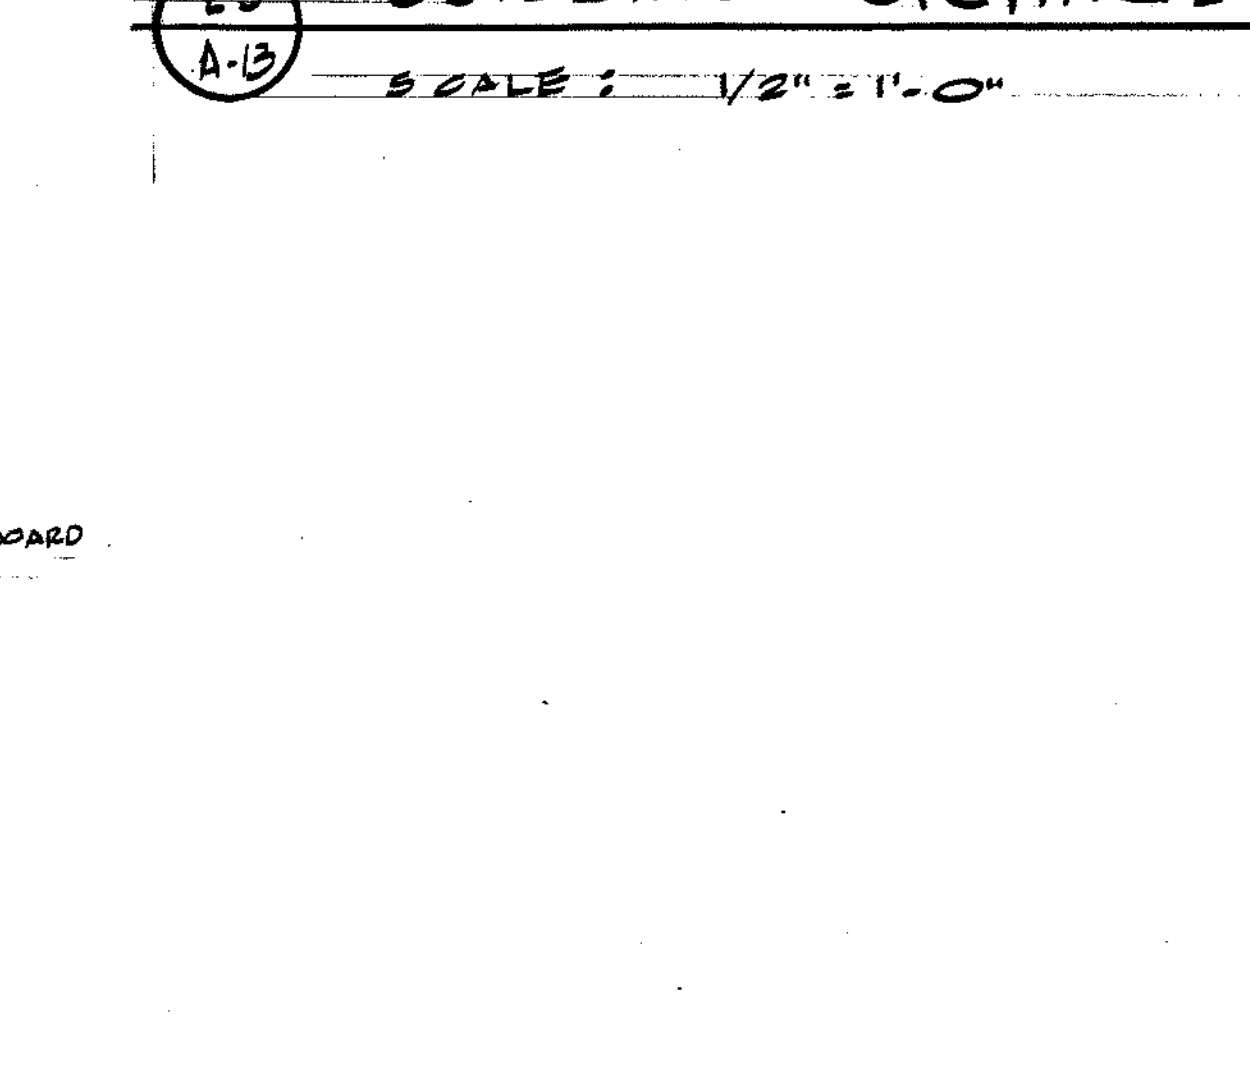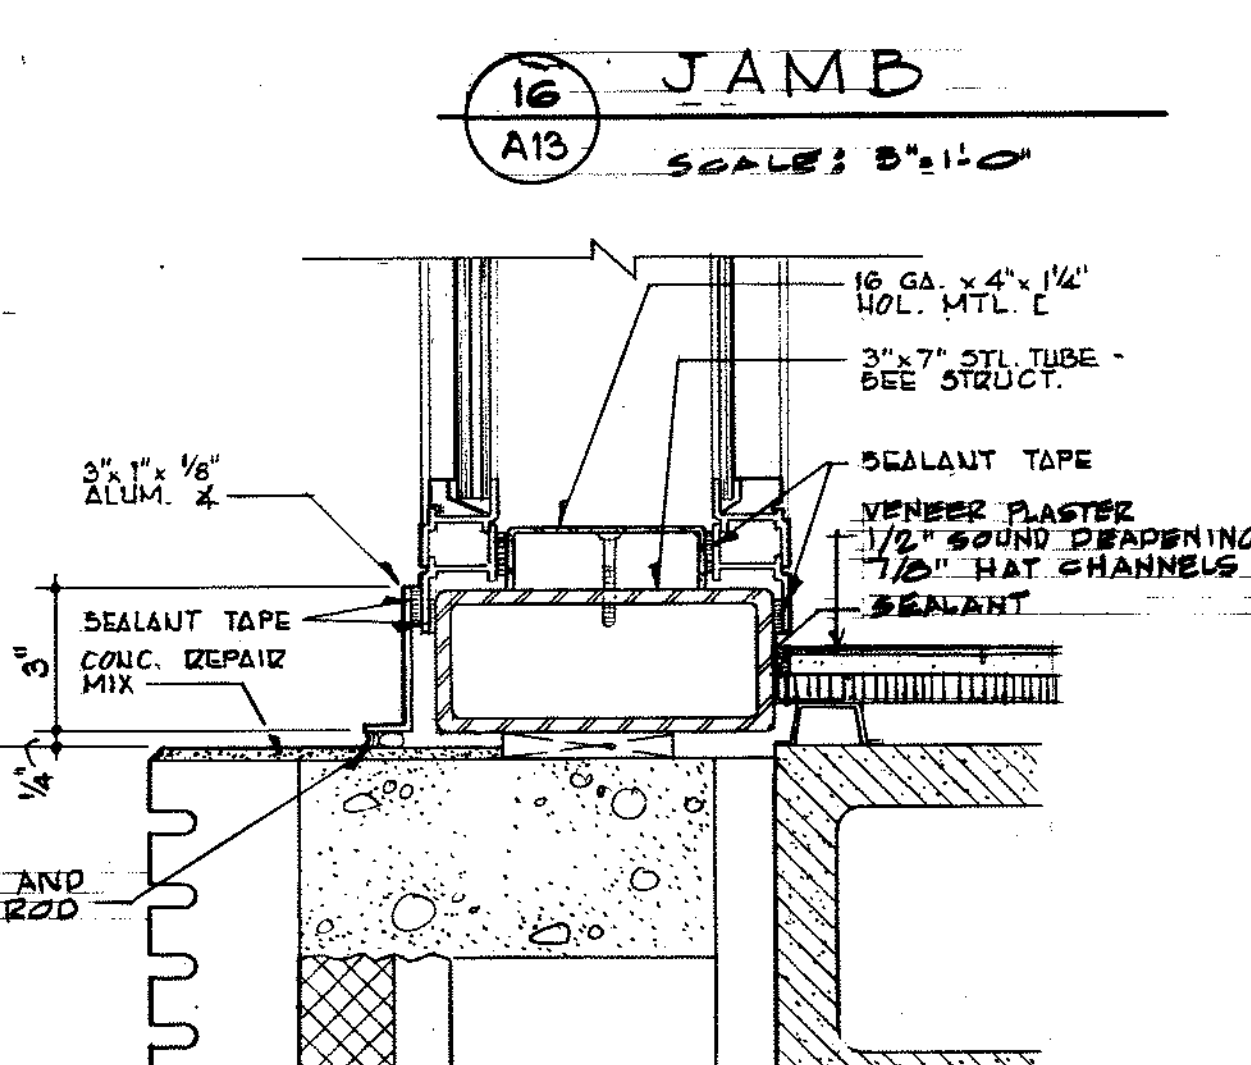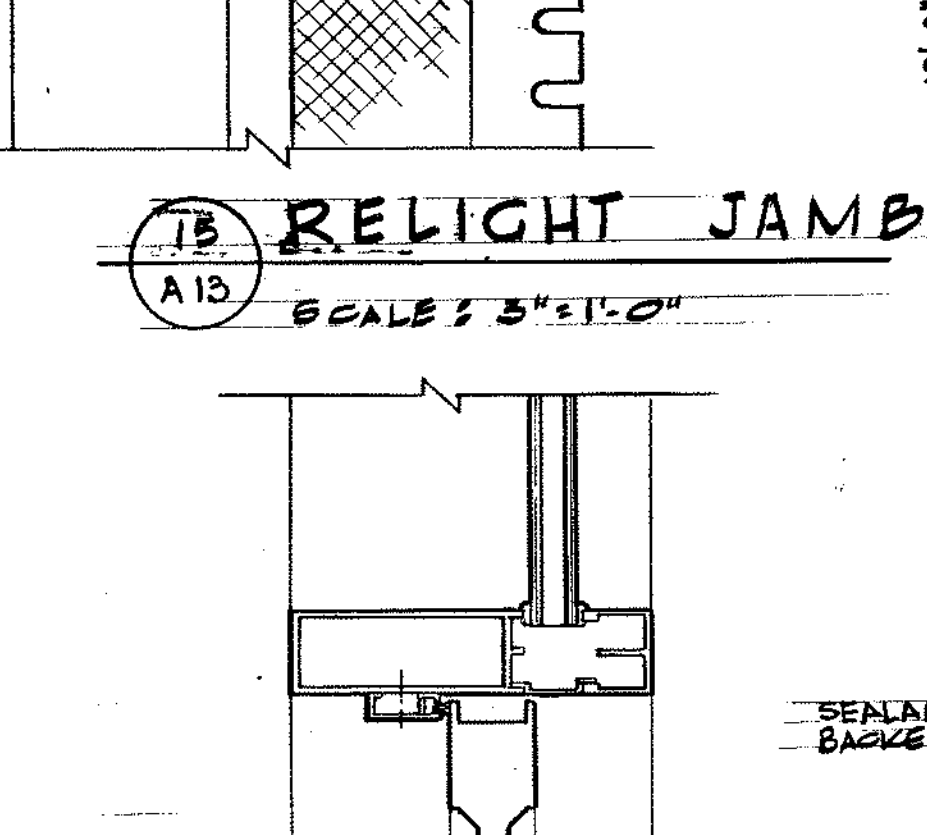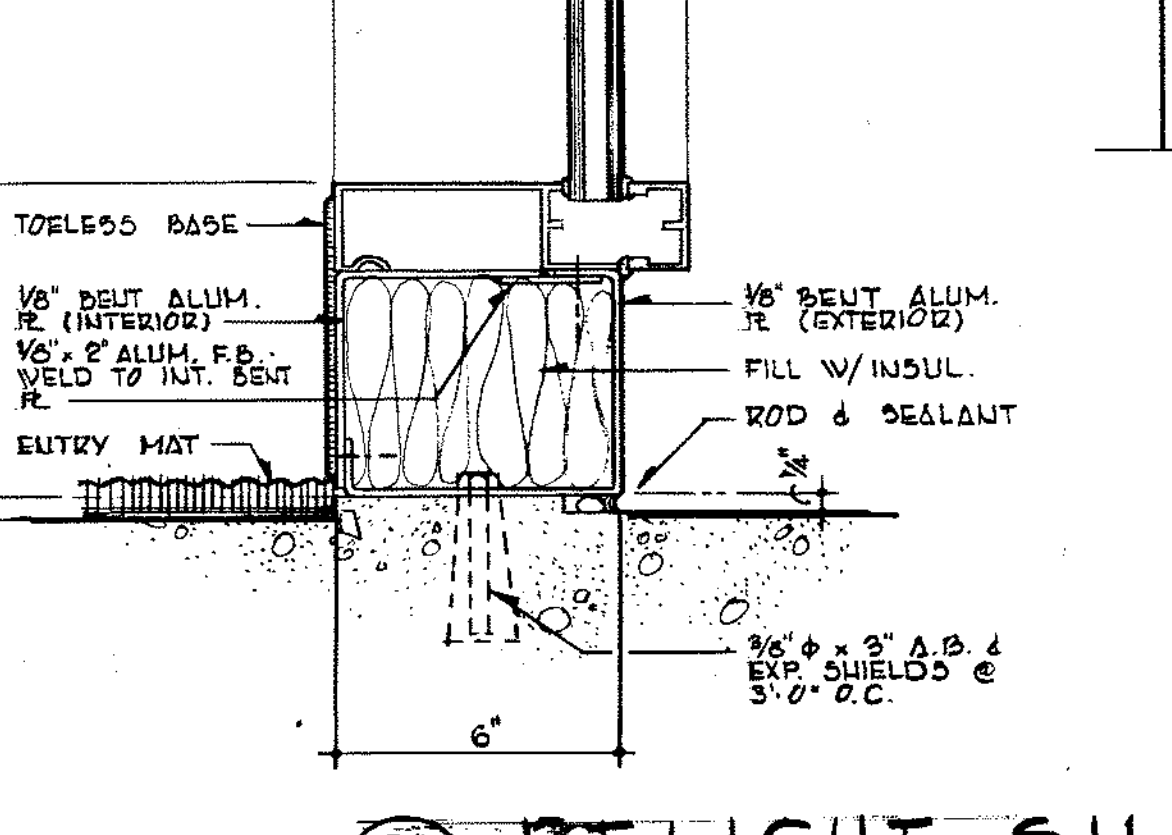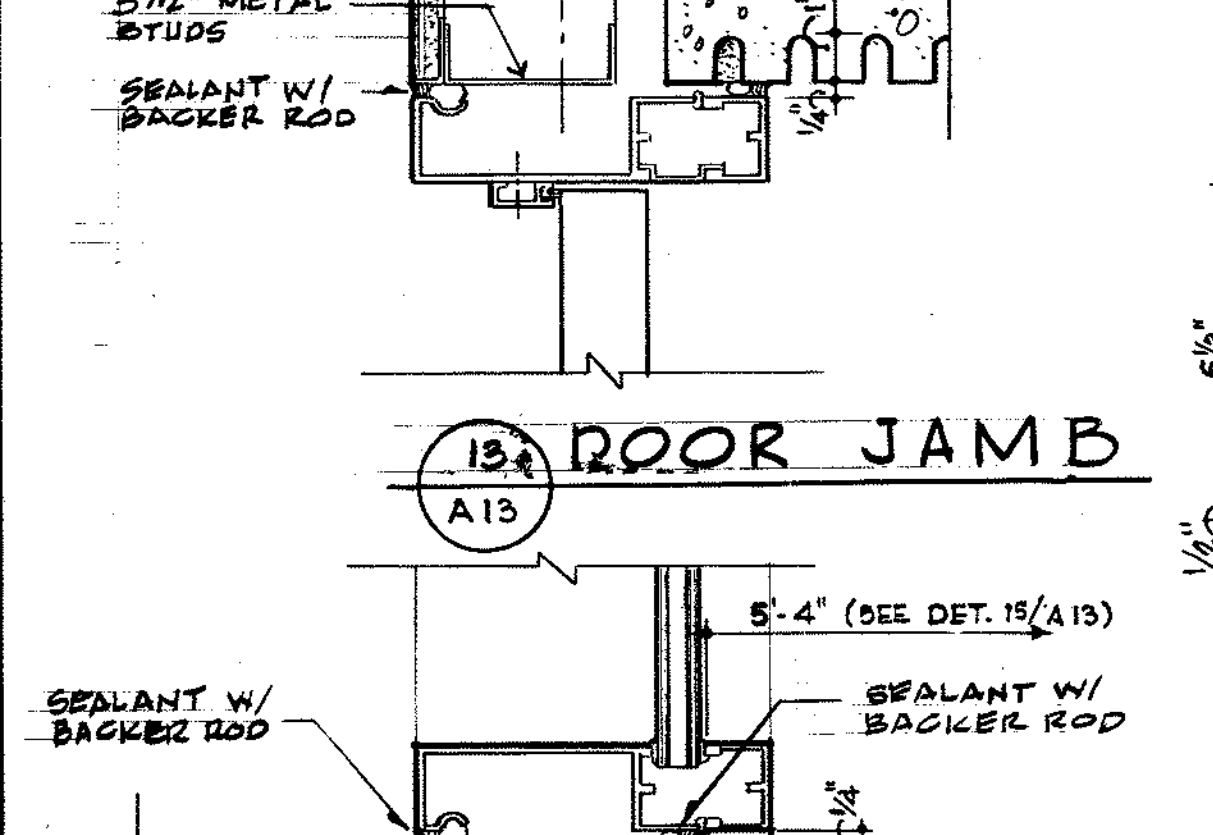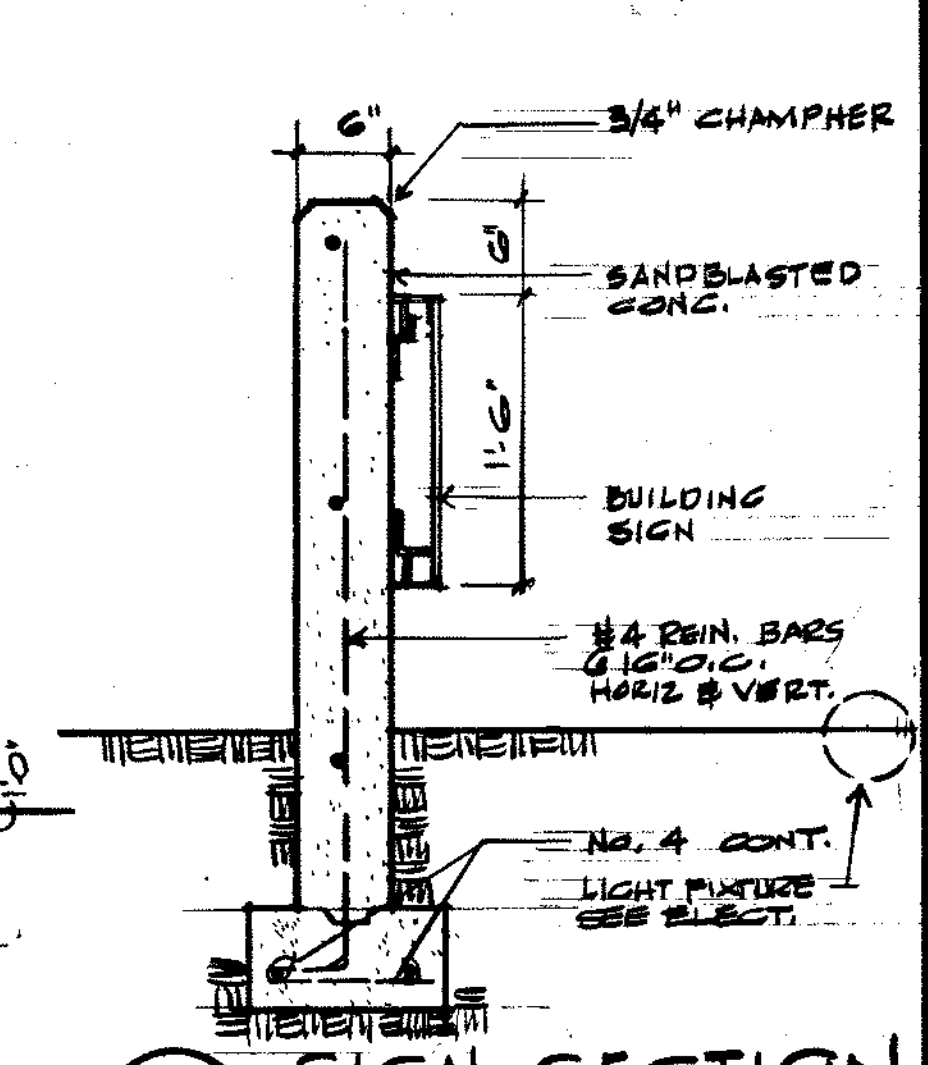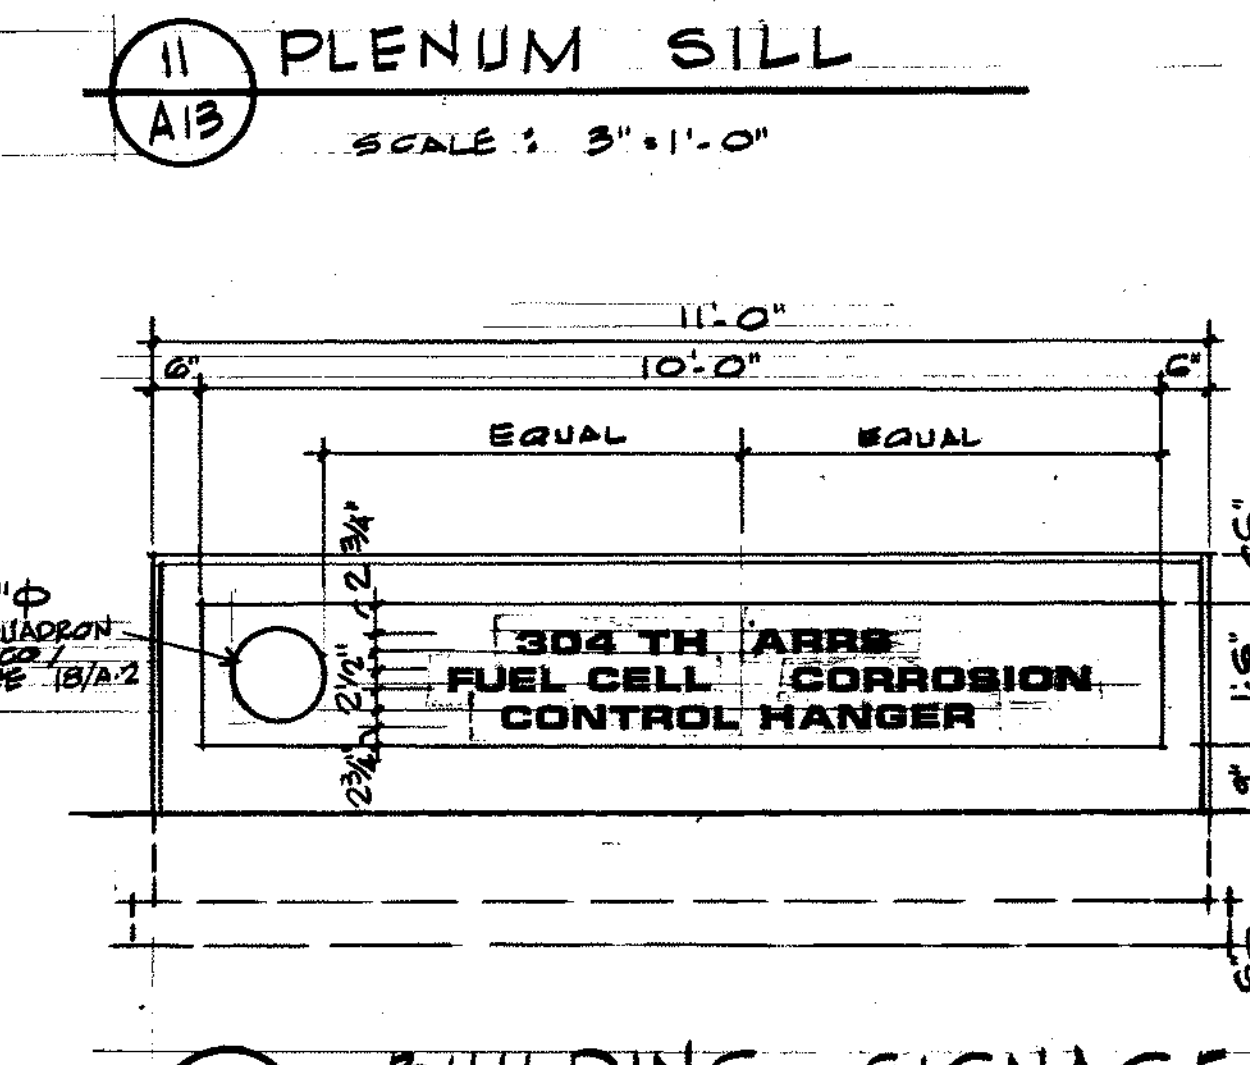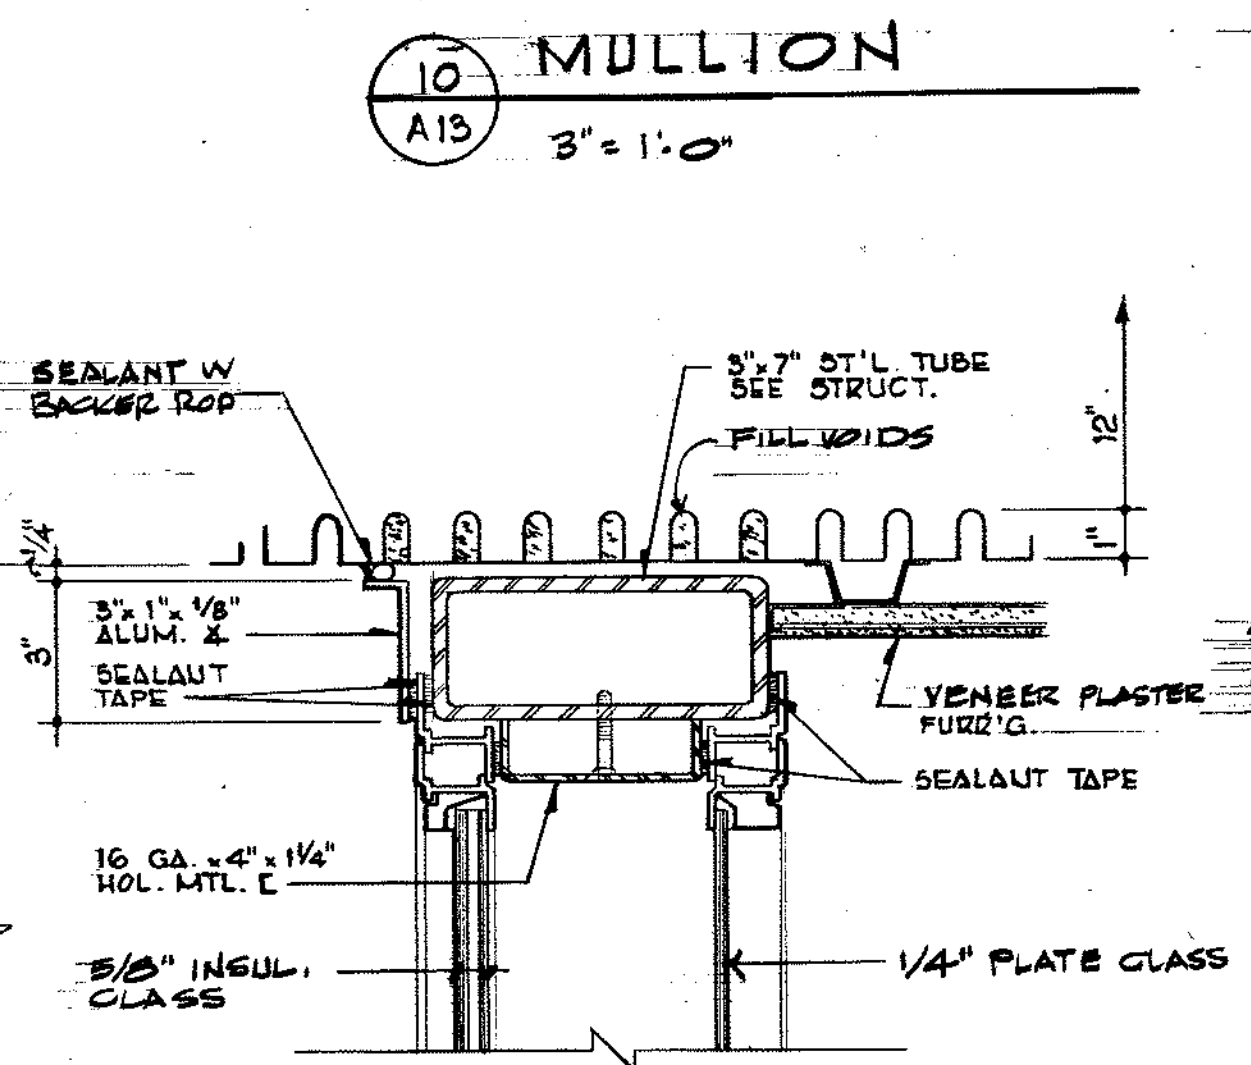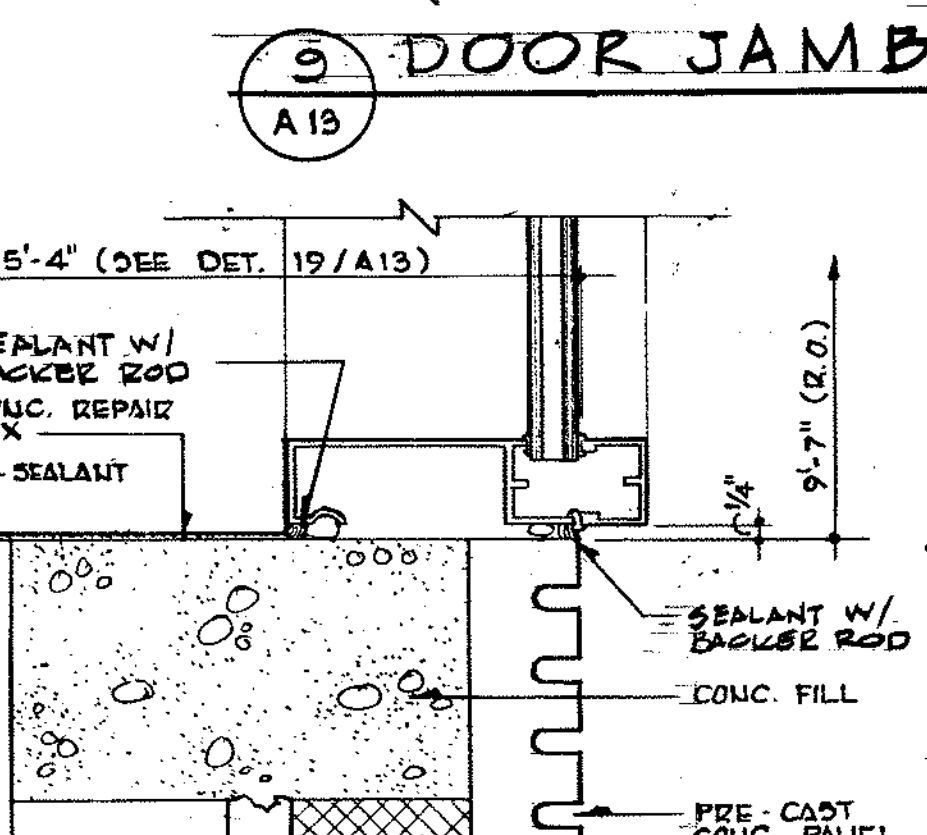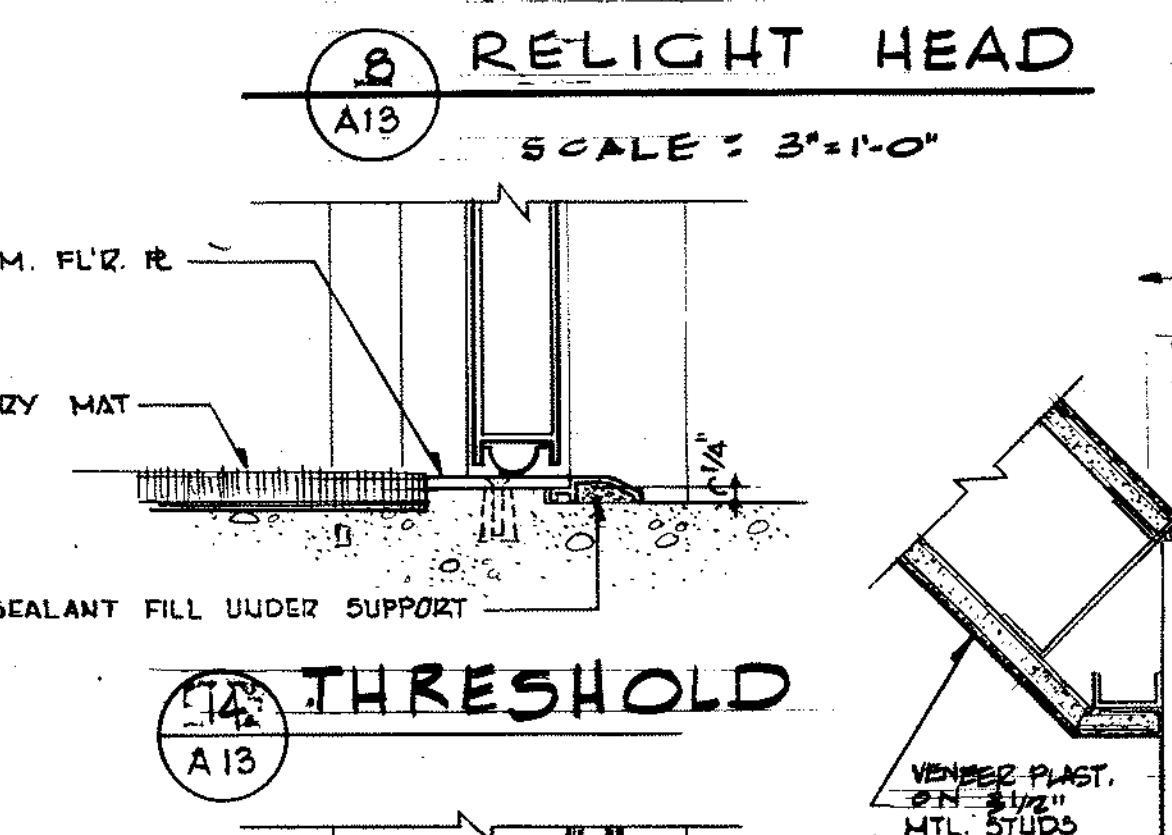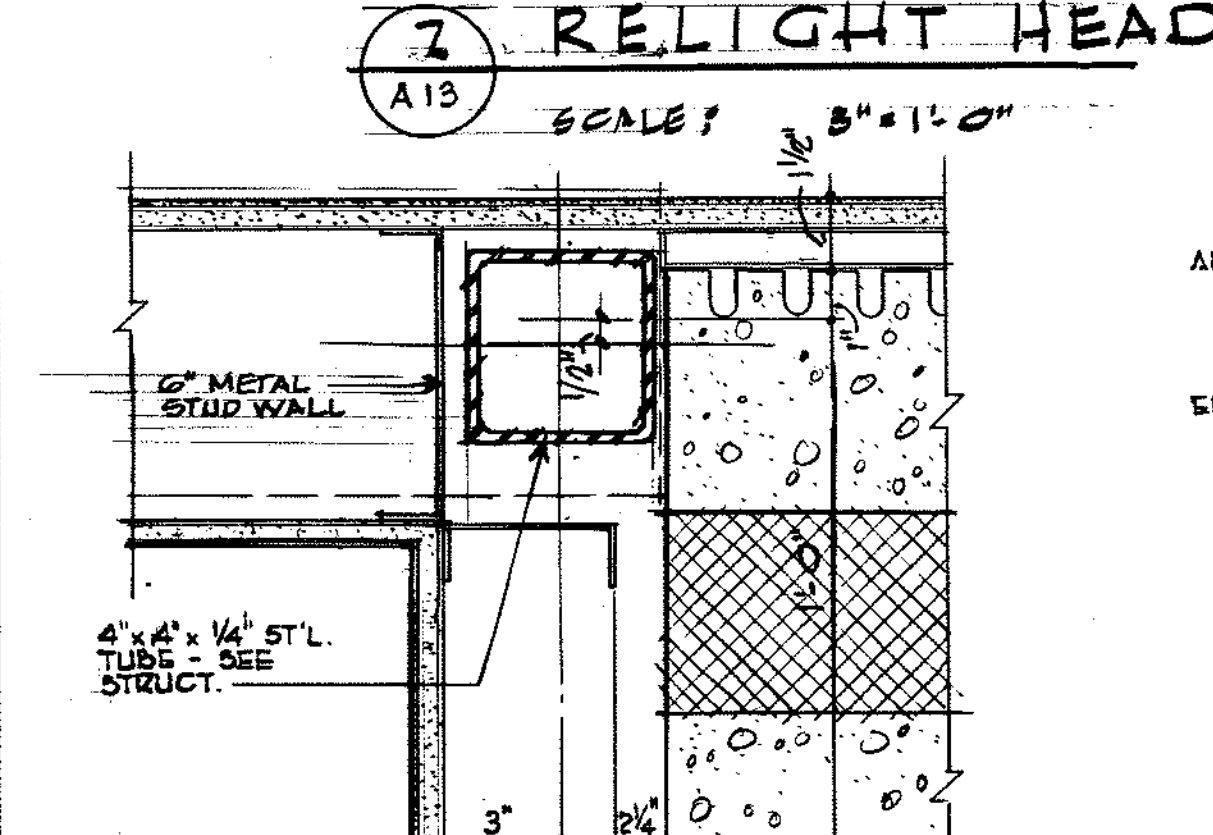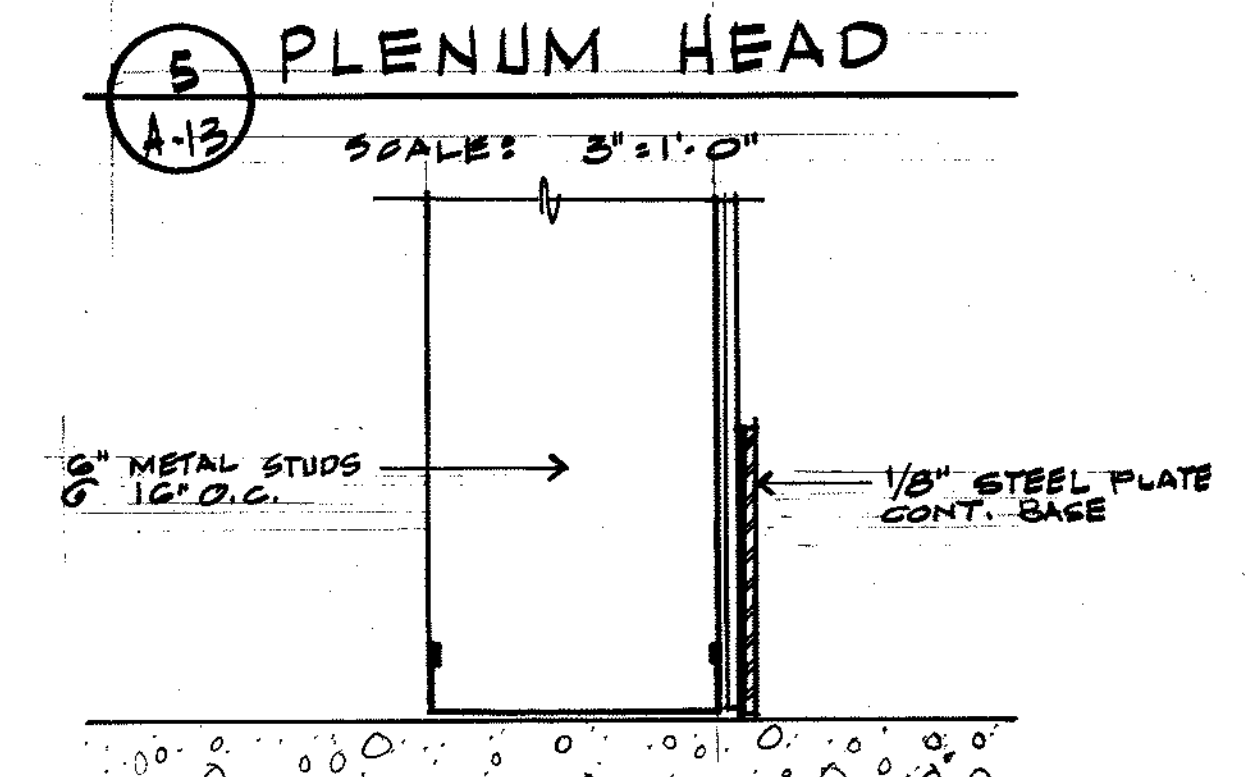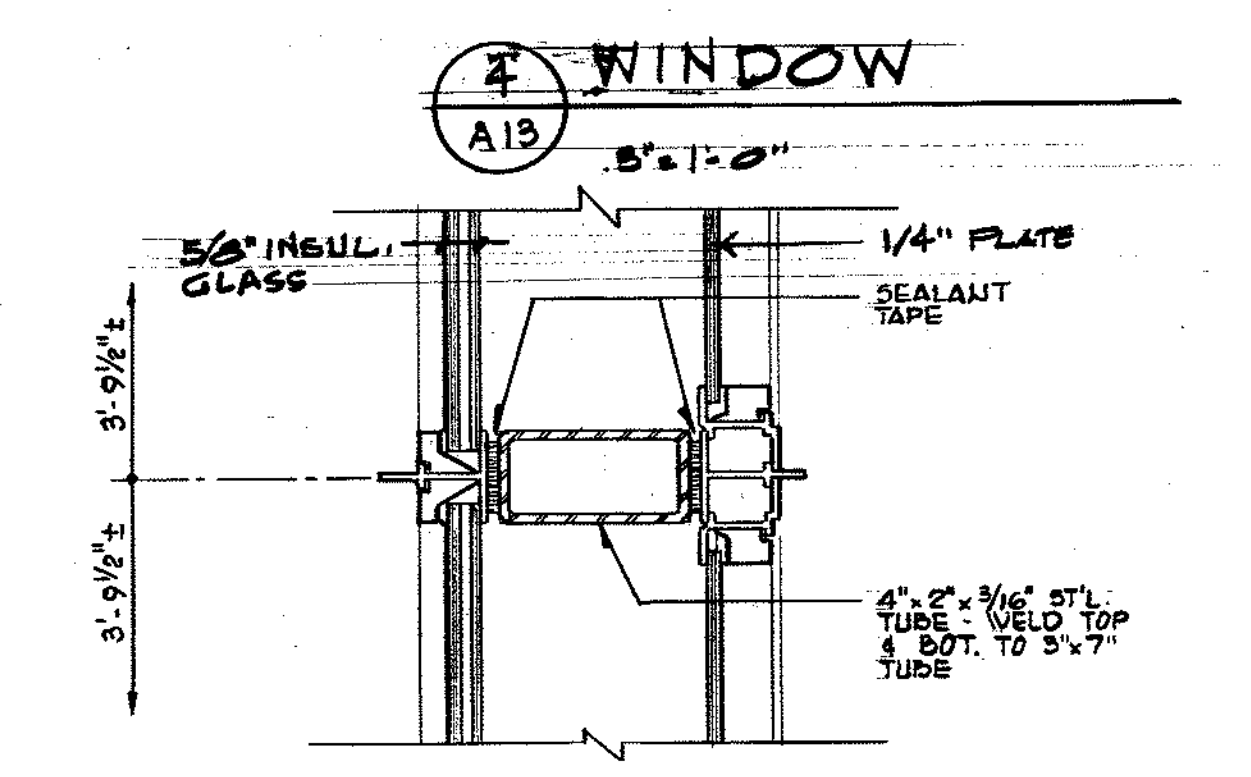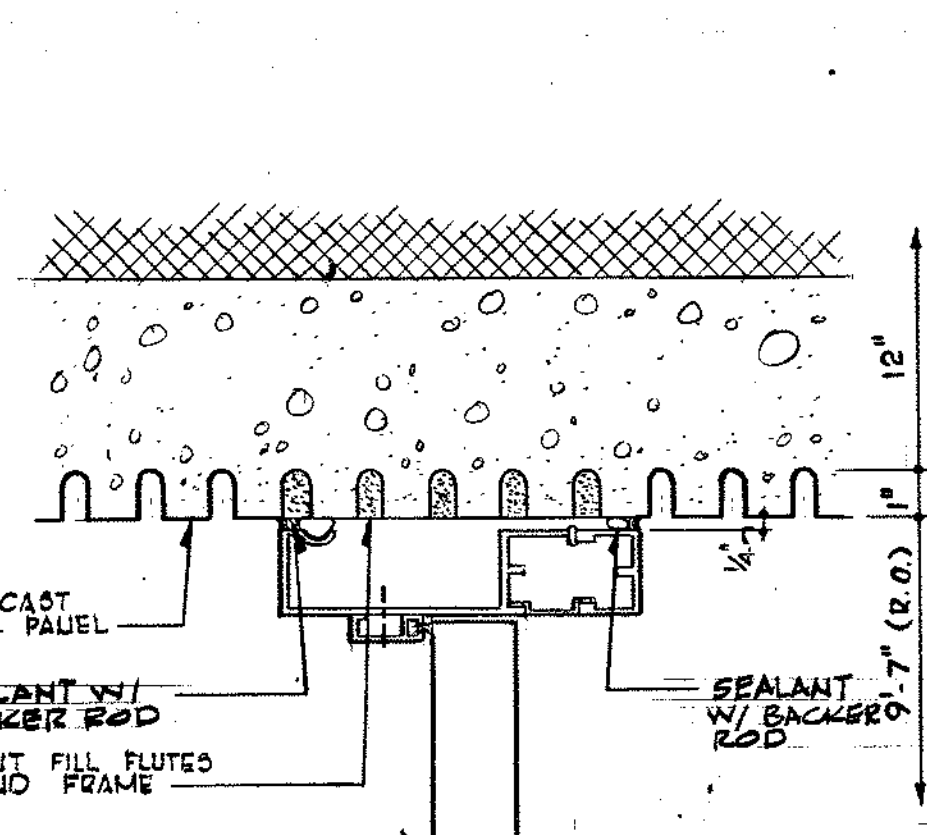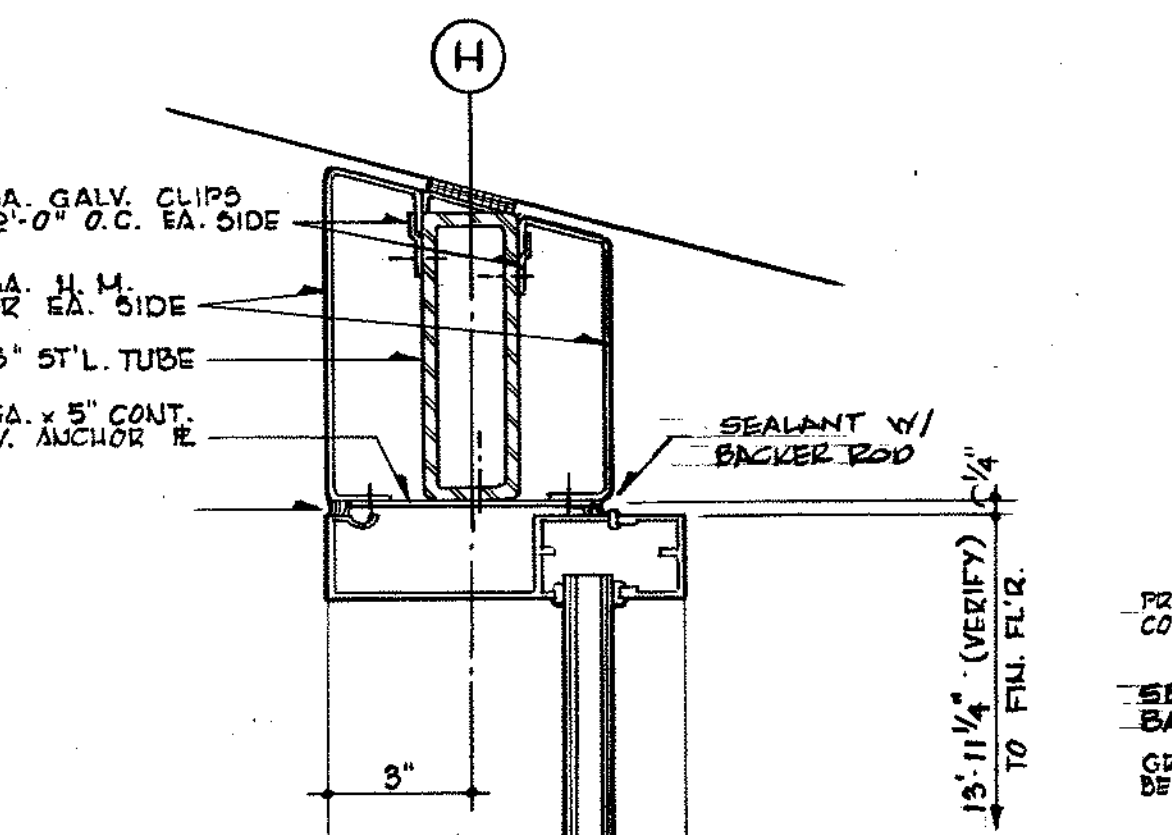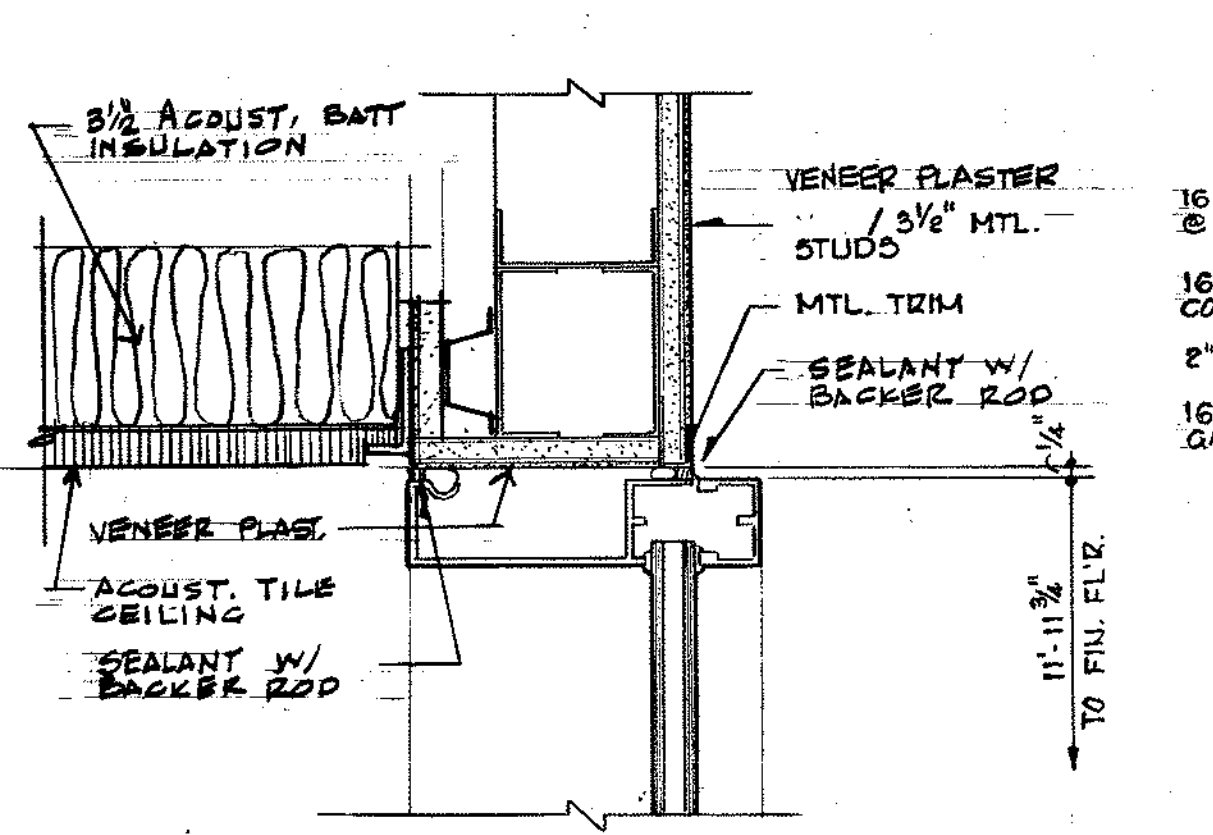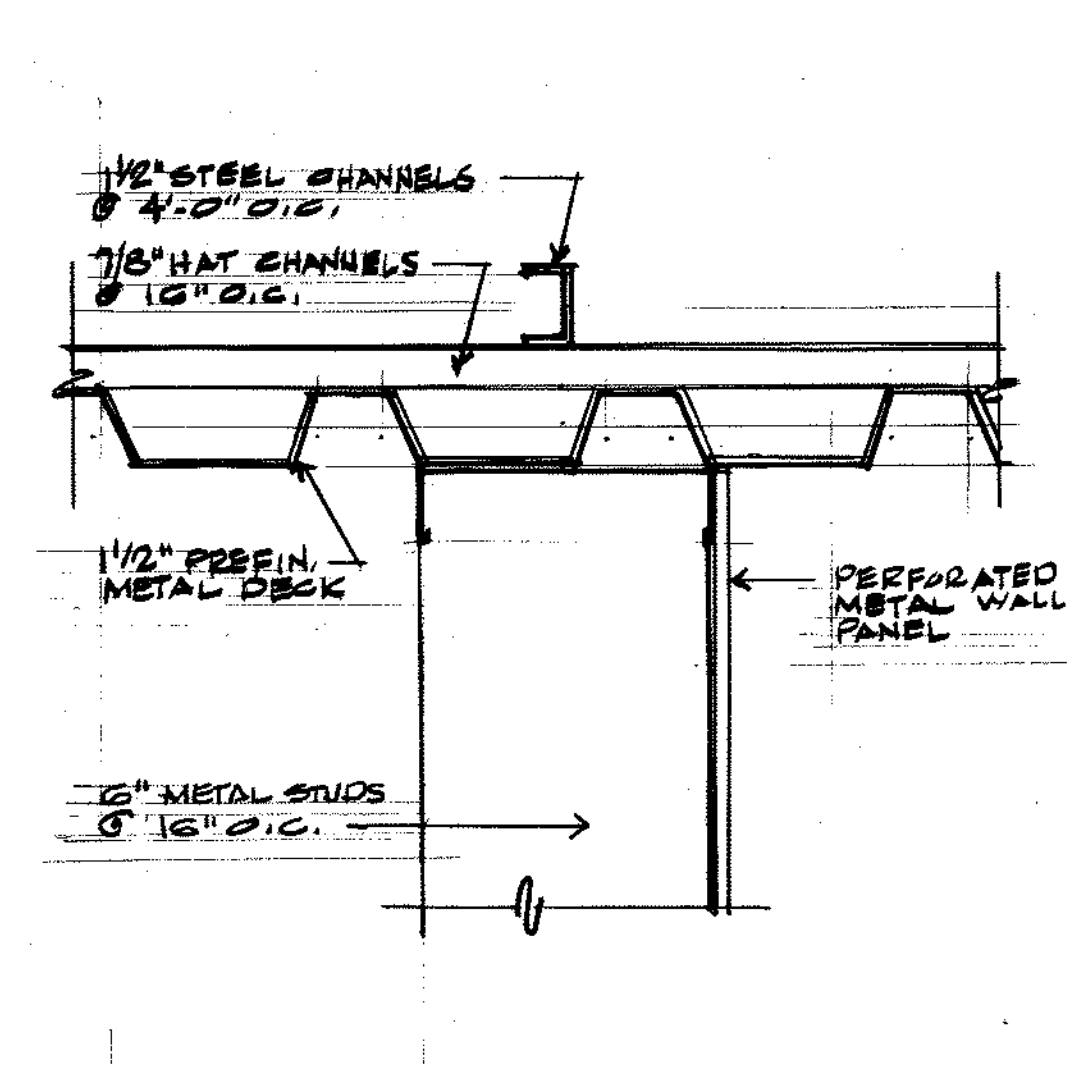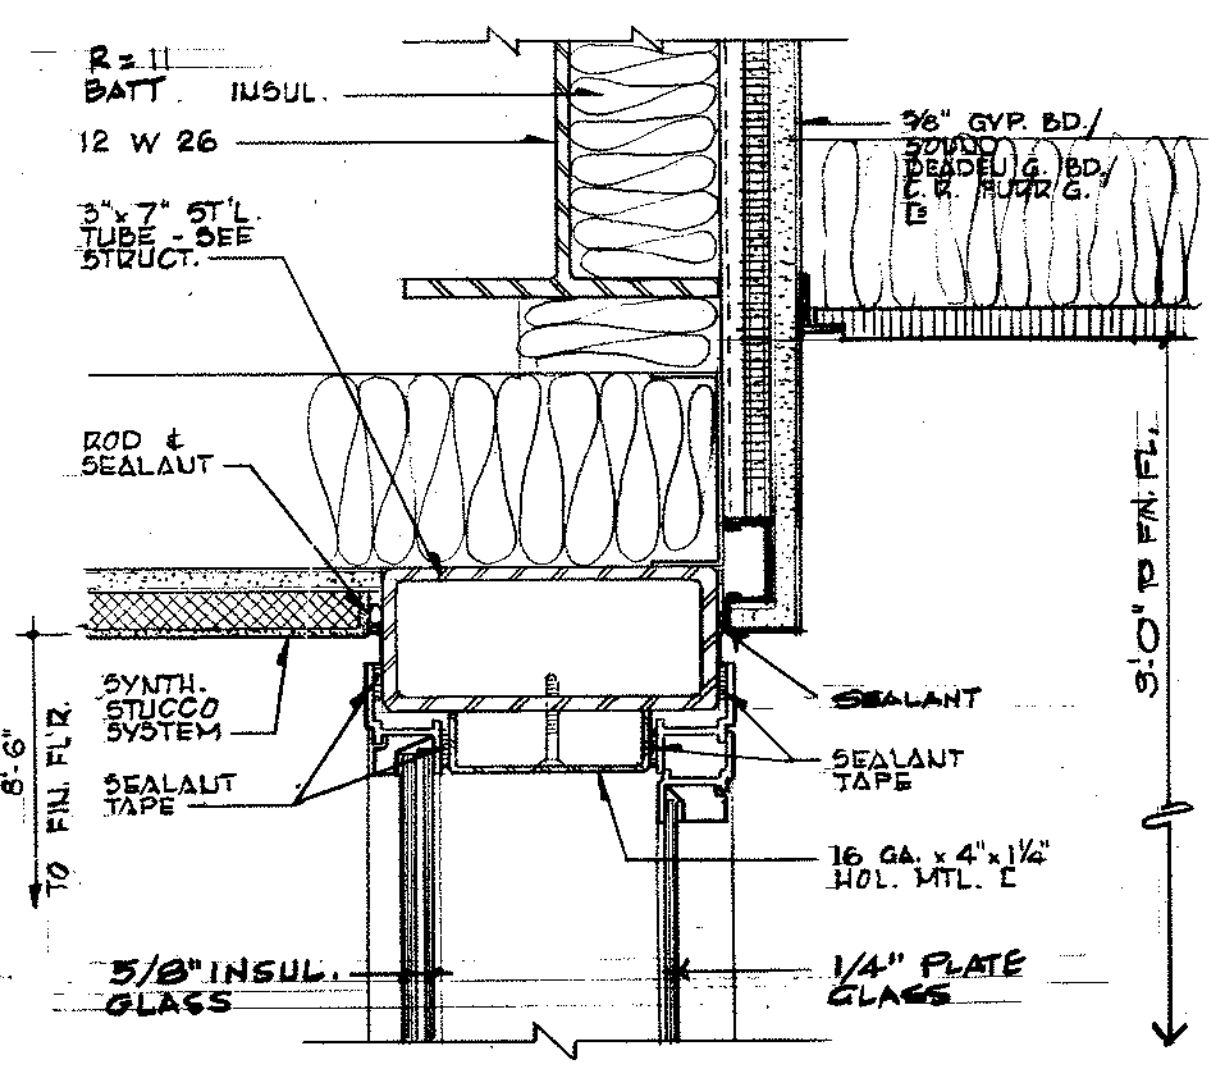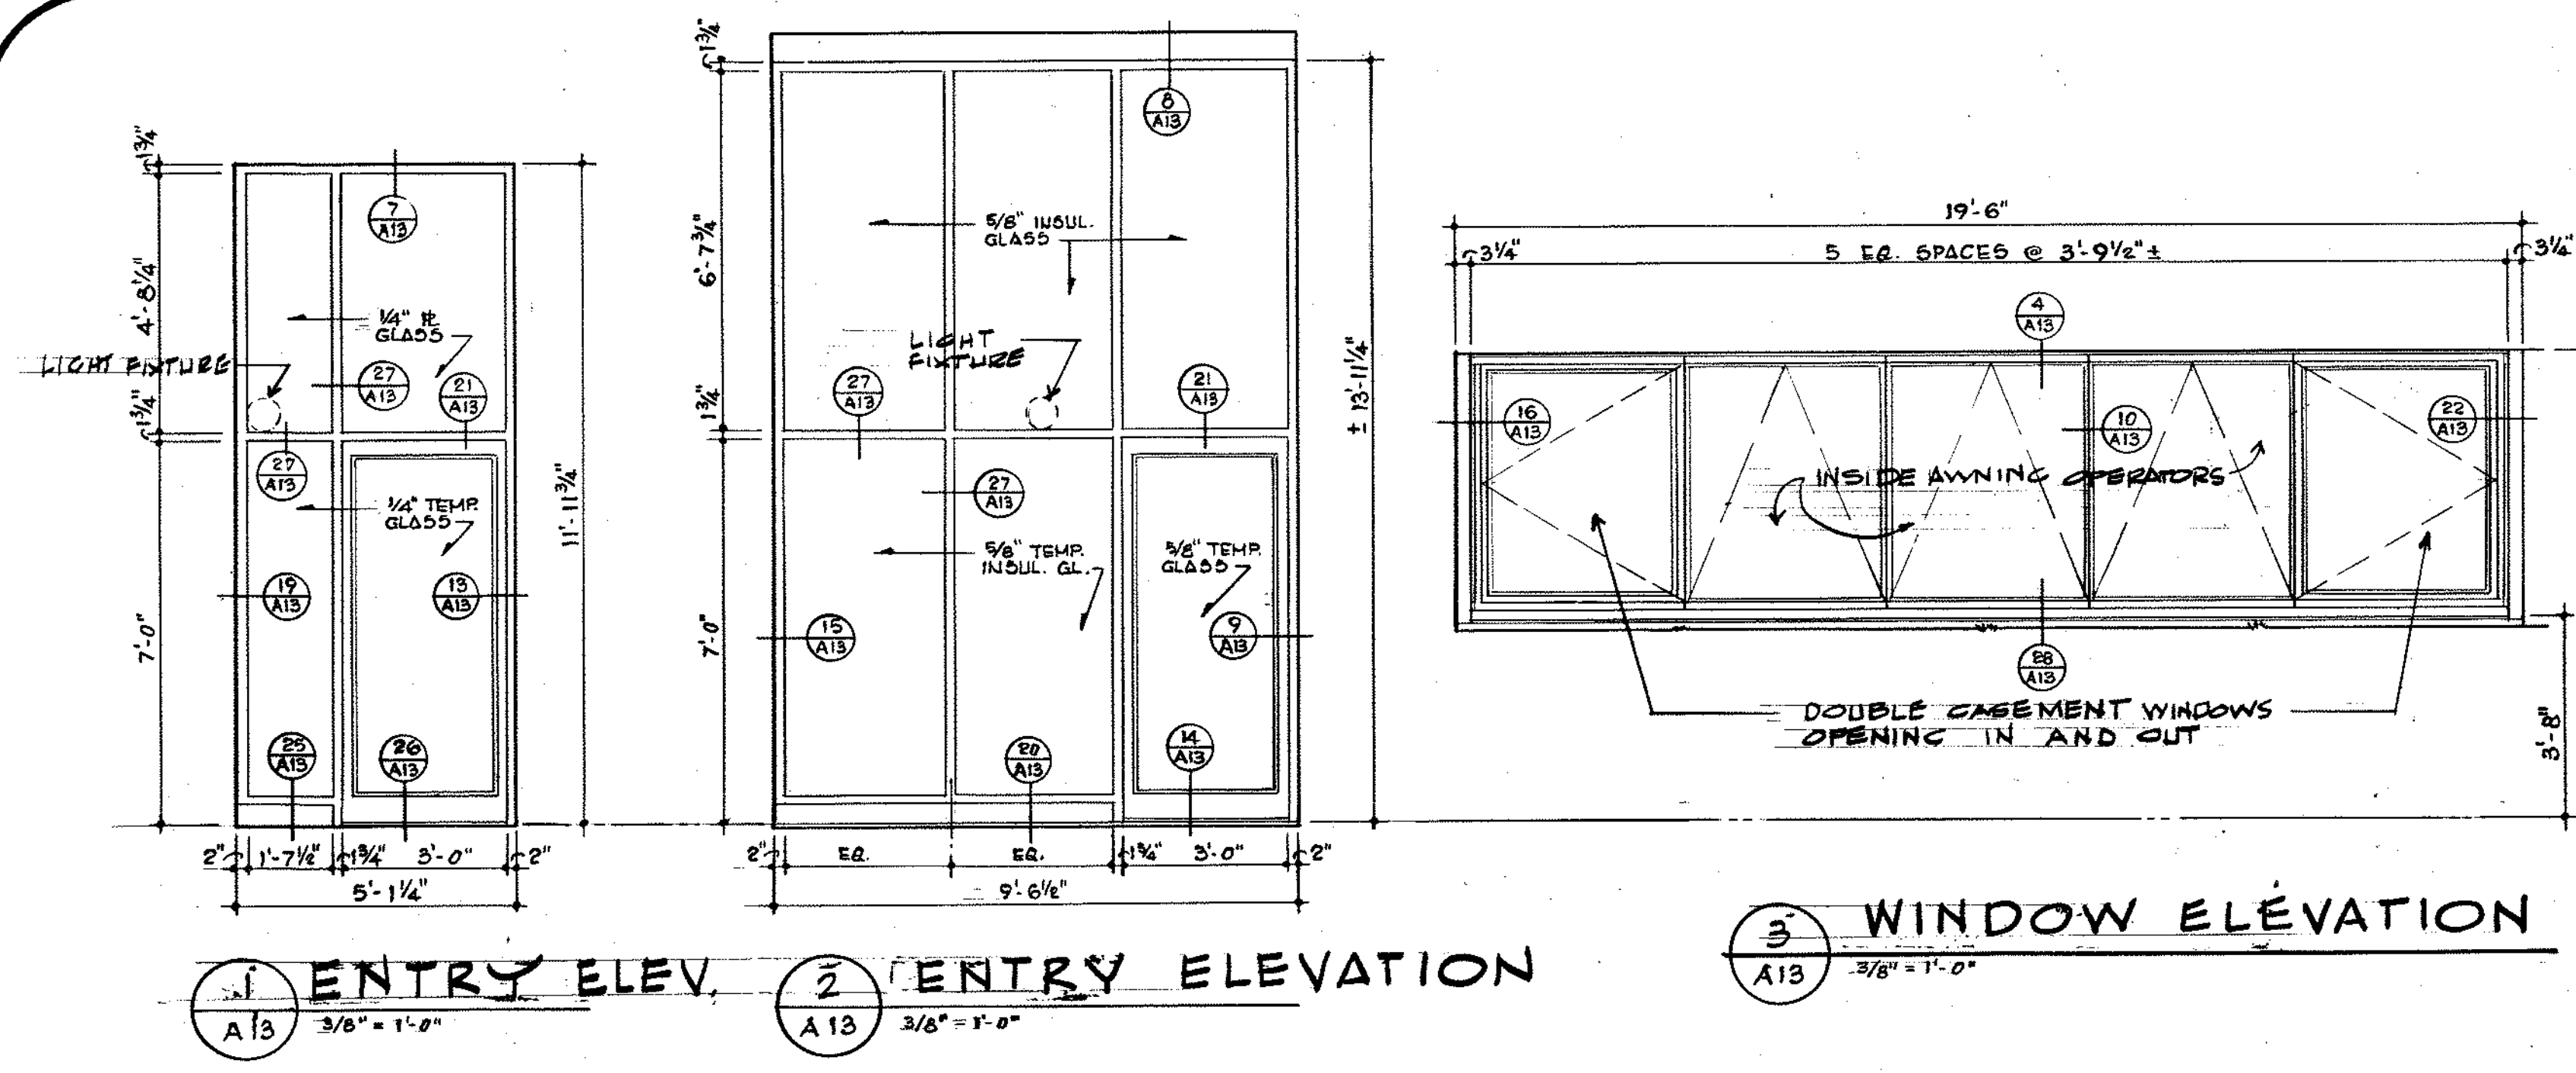

miller - cook architects a.i.a.
30 NW 4th AVE. PORTLAND, OREGON
15001 228-0822 87208



DATE: FEB. 21, 1980
JOB NO: 84-125
REVISIONS AS BUILT 11-16-87




SHEET TITLE: ENTRANCES & WINDOW DETAILS
C-130 FUEL SYSTEM / CORROSION CONTROL MAINTENANCE HANGAR
304TH AIR RESCUE RECOVERY SQUADRON
PORTLAND INTERNATIONAL AIRPORT
OREGON

A13

RECORD DRAWINGS FROM INFORMATION SUPPLIED BY THE GENERAL CONTRACTOR

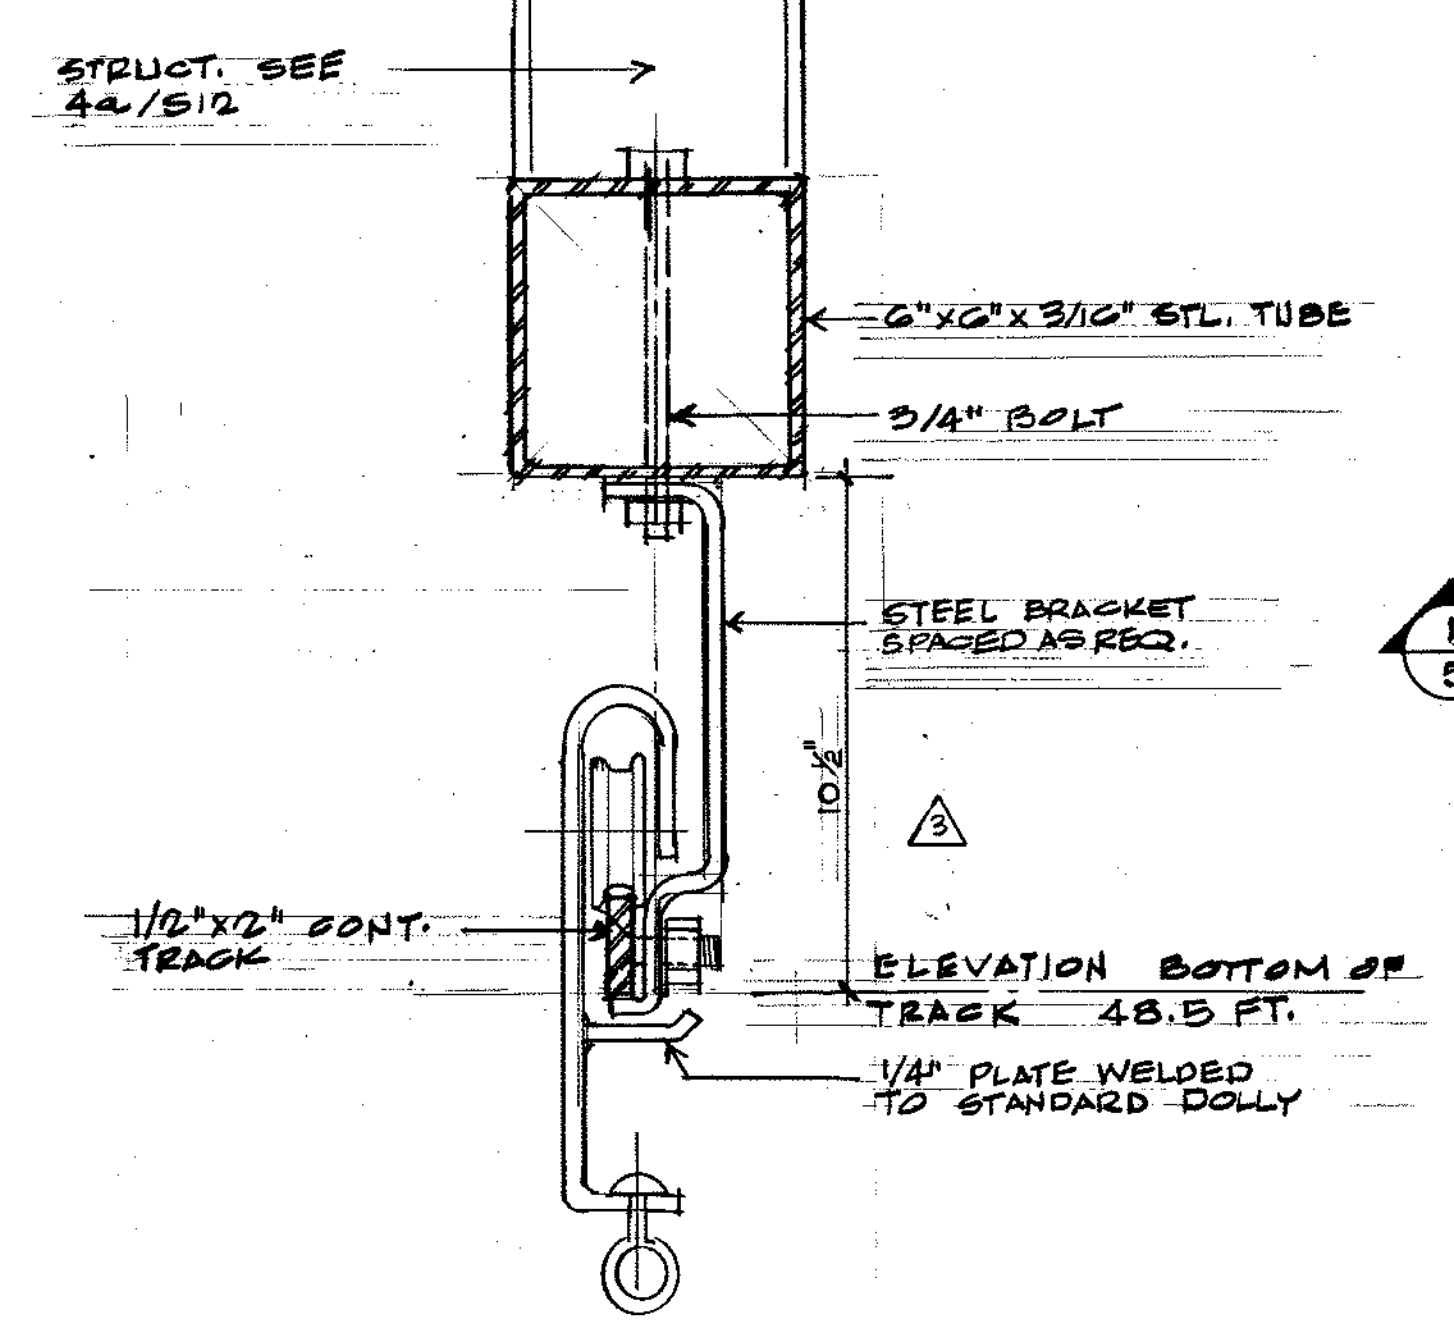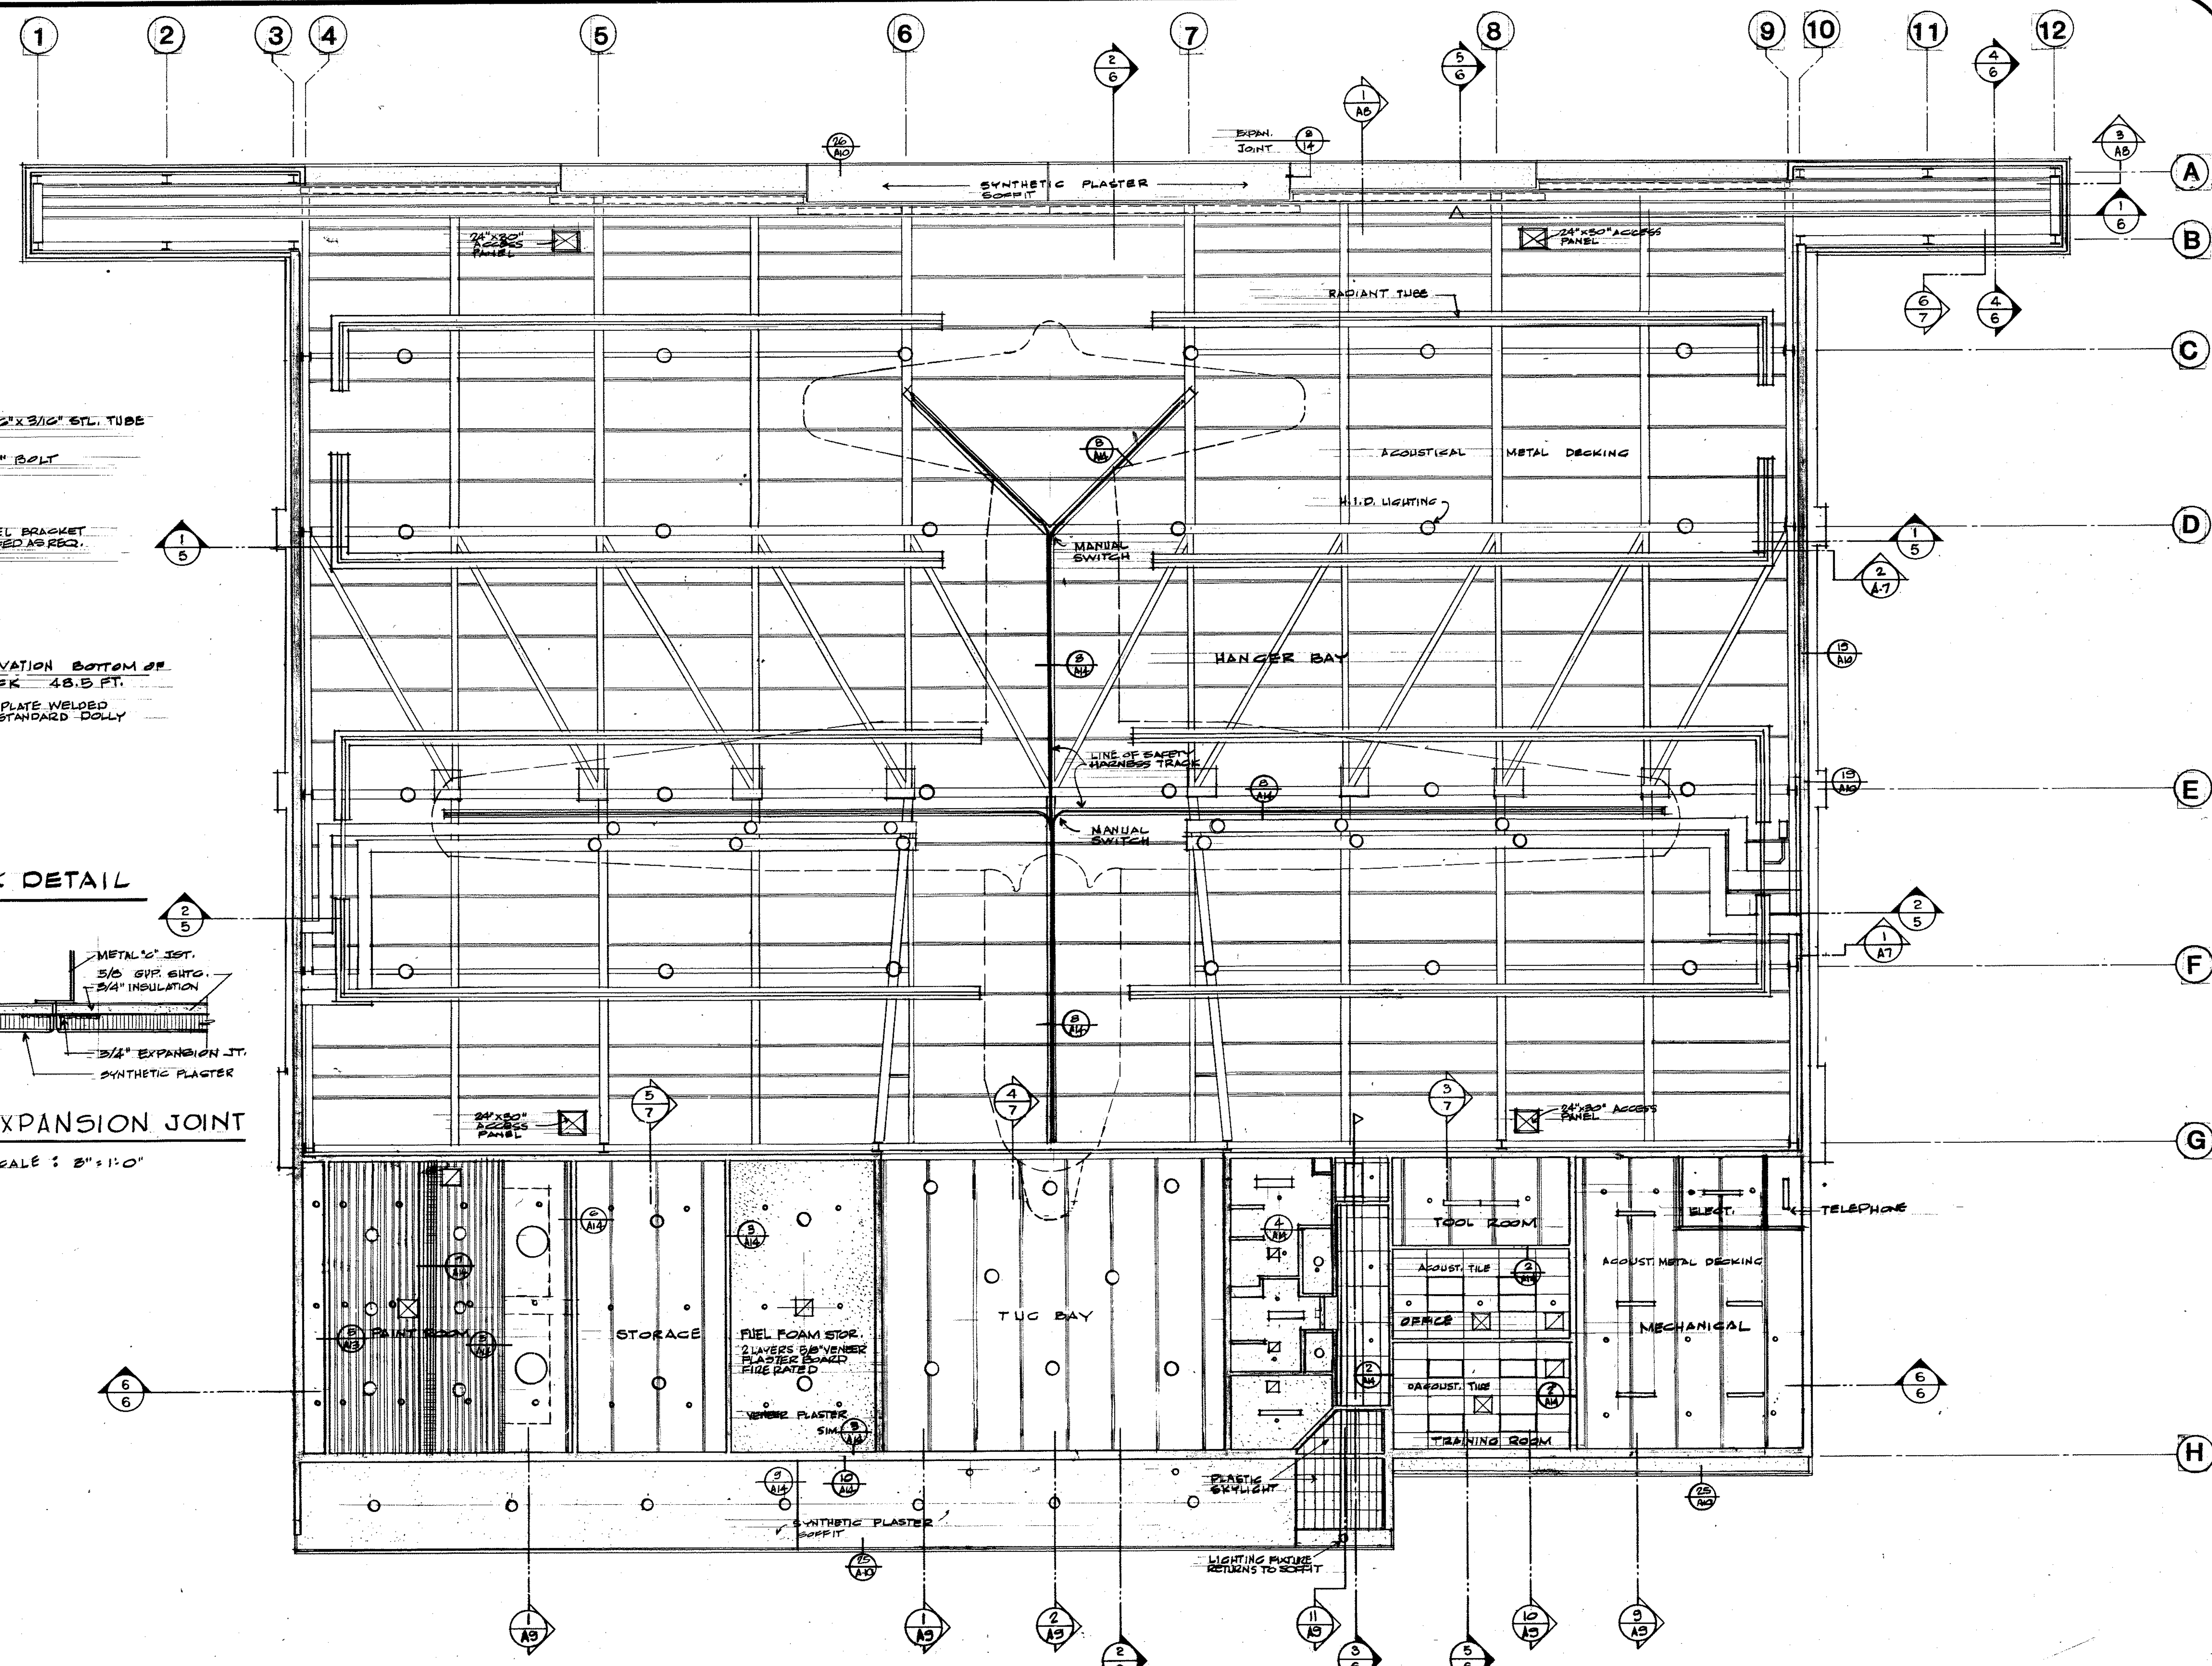

8 SAFETY TRACK DETAIL
SCALE: 3" = 1'-0"

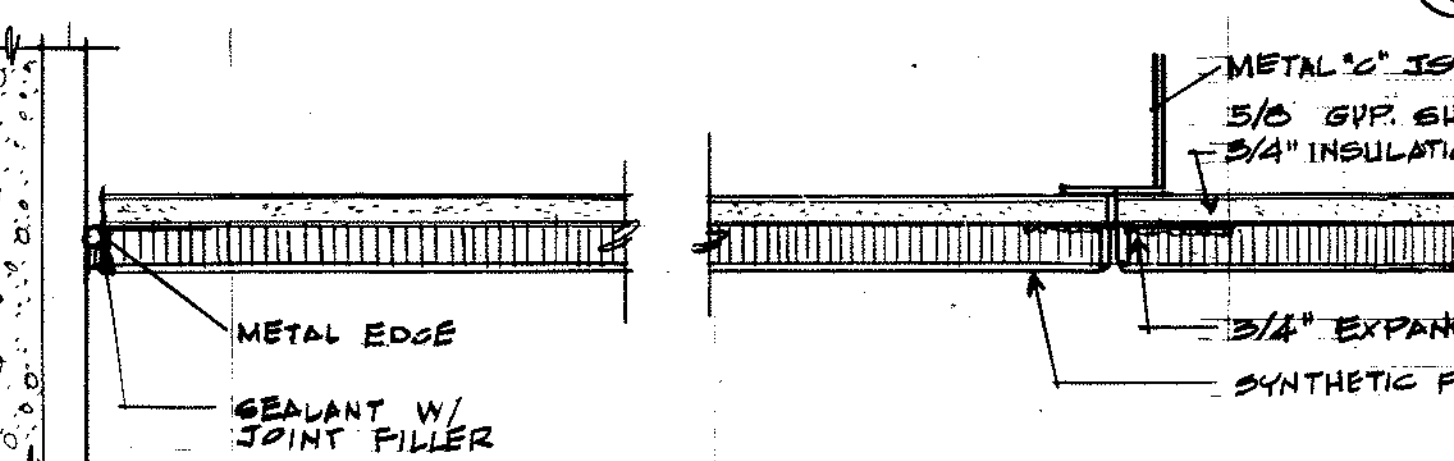


9 EXPANSION JOINT
SCALE: 3" = 1'-0"




10 SOFFIT EDGE
SCALE: 3" = 1'-0"


1 REFLECTED CEILING PLAN

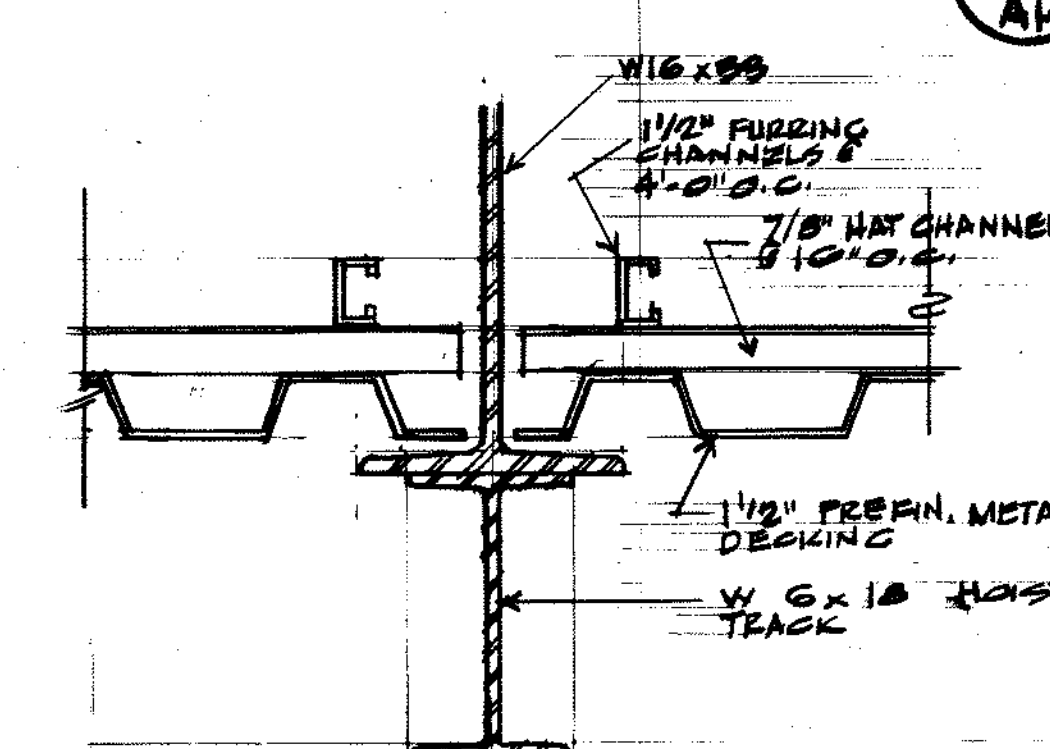


7 HOIST BEAM
SCALE: 3" = 1'-0"

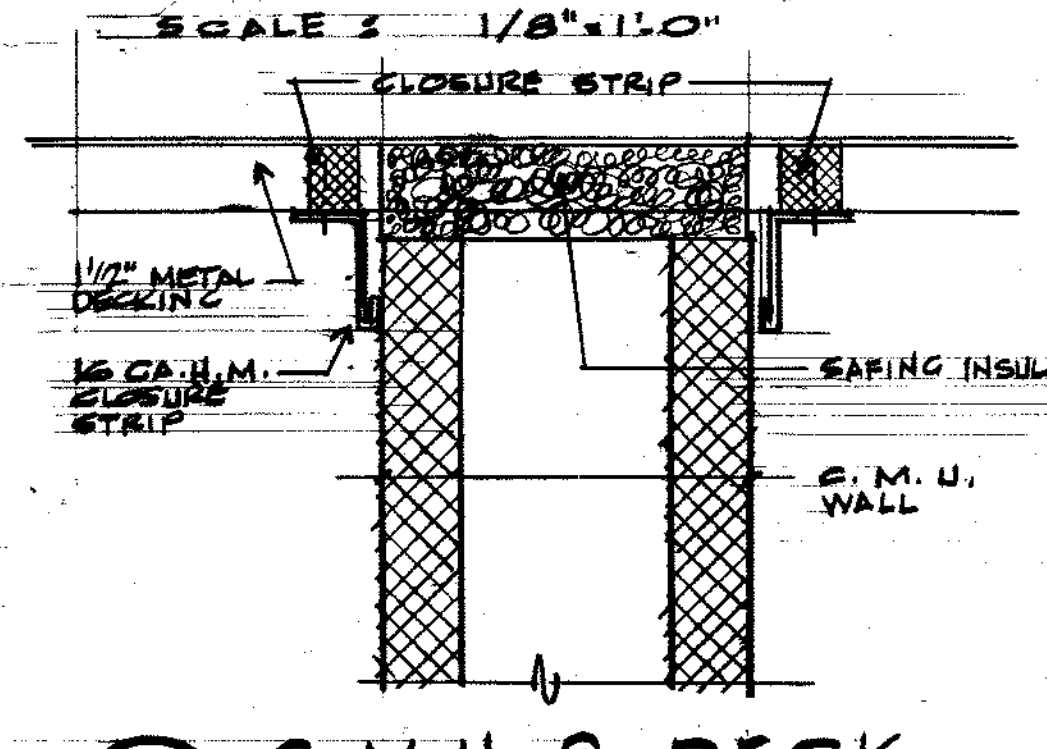


6 C.M.U. & DECK
SCALE: 3" = 1'-0"

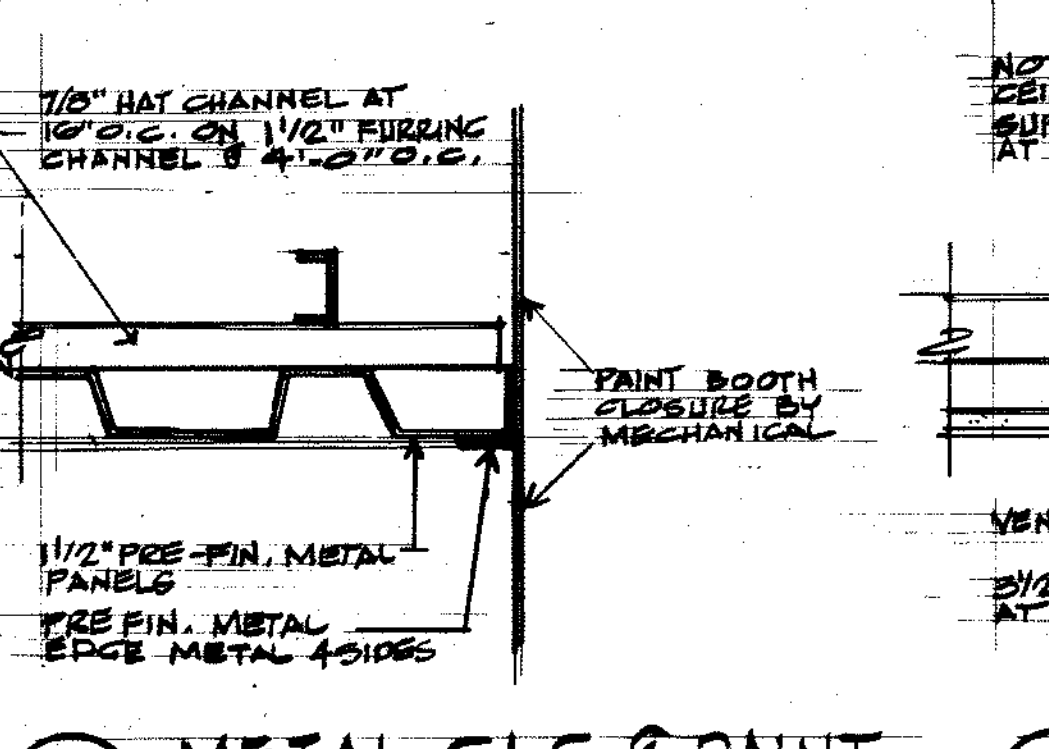


5 METAL CLG. & PAINT BOOTH
SCALE: 3" = 1'-0"

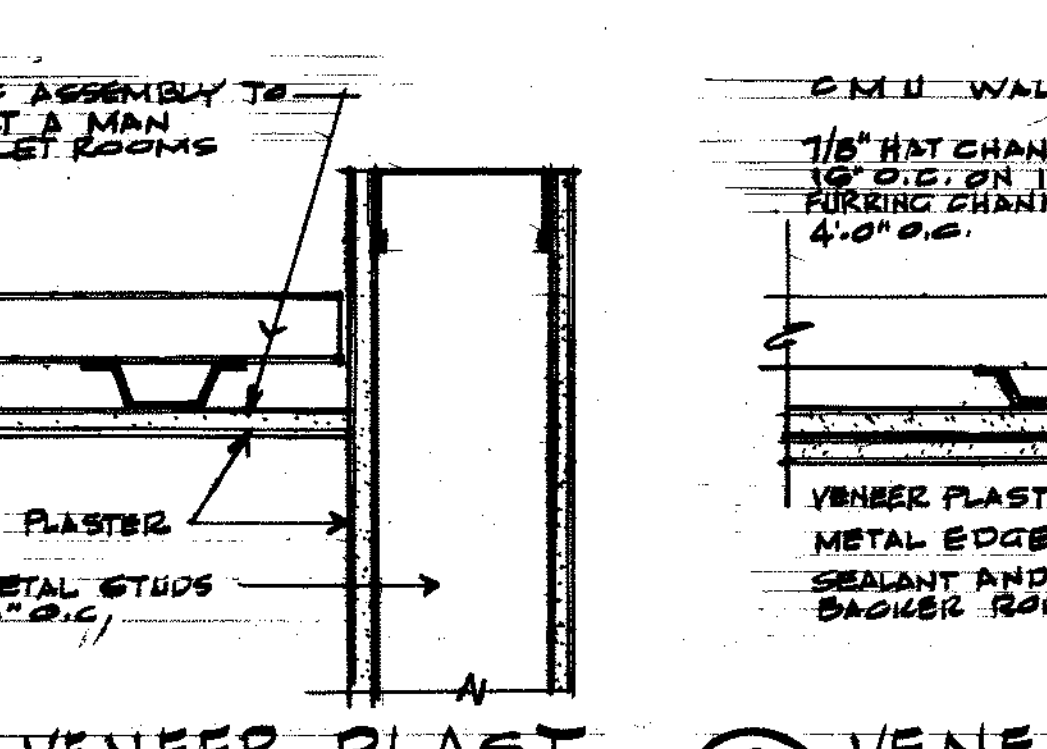

4 VENEER PLAST.
SCALE: 3" = 1'-0"

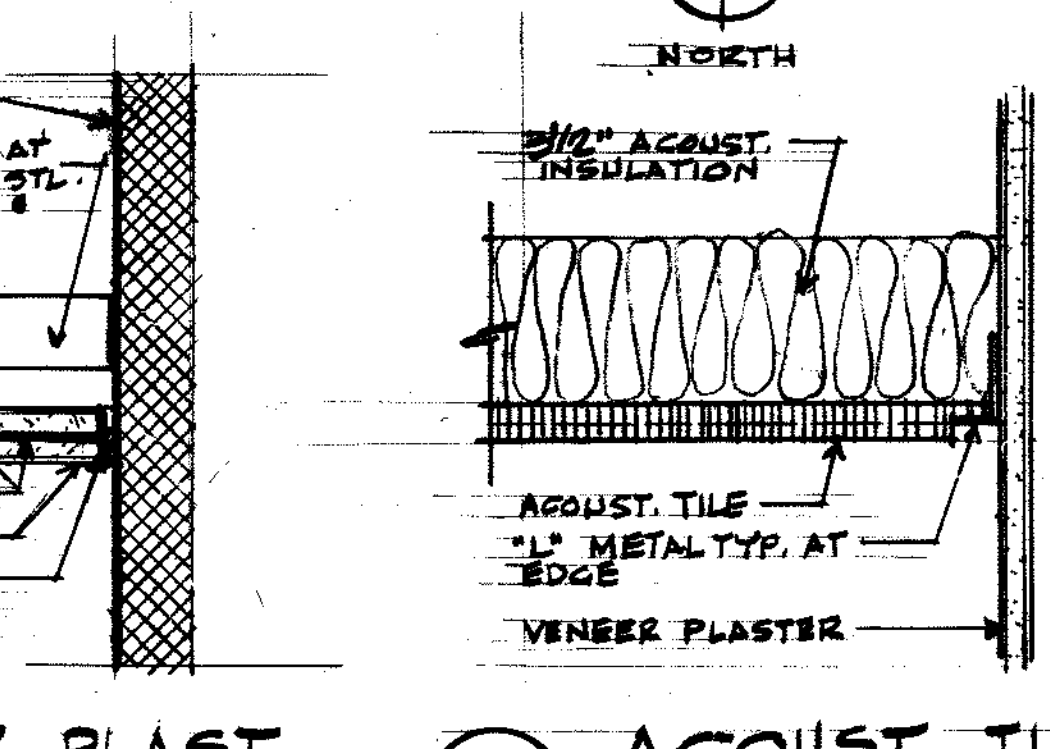

3 VENEER PLAST.
SCALE: 3" = 1'-0"

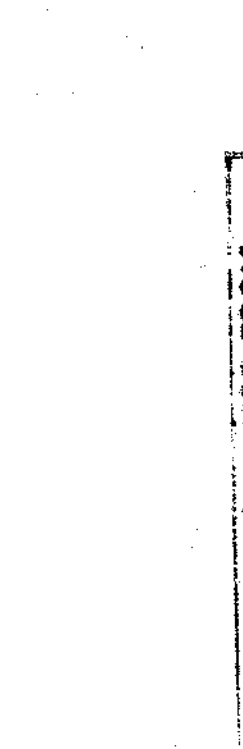

2 ACQUST. TILE
SCALE: 3" = 1'-0"

miller - cook architects a.i.a.

30 N.W. 1st AVE. PORTLAND, OREGON

DATE: FEB. 24, 1970
JOB NO: 84-125
REVISIONS: 3-23-86
AS BUILT 11-10-87















REGISTERED ARCHITECT
MAX C. MILLER
PORTLAND, OREGON
1454
STATE OF OREGON

SHEET TITLE: REFLECTED CEILING PLAN
C-130 FUEL SYSTEM / CORROSION CONTROL MAINTENANCE HANGAR
304TH AIR RESCUE RECOVERY SQUADRON
PORTLAND INTERNATIONAL AIRPORT
OREGON


RECORD DRAWINGS FROM INFORMATION SUPPLIED BY THE GENERAL CONTRACTOR

A-14


BLDG 375

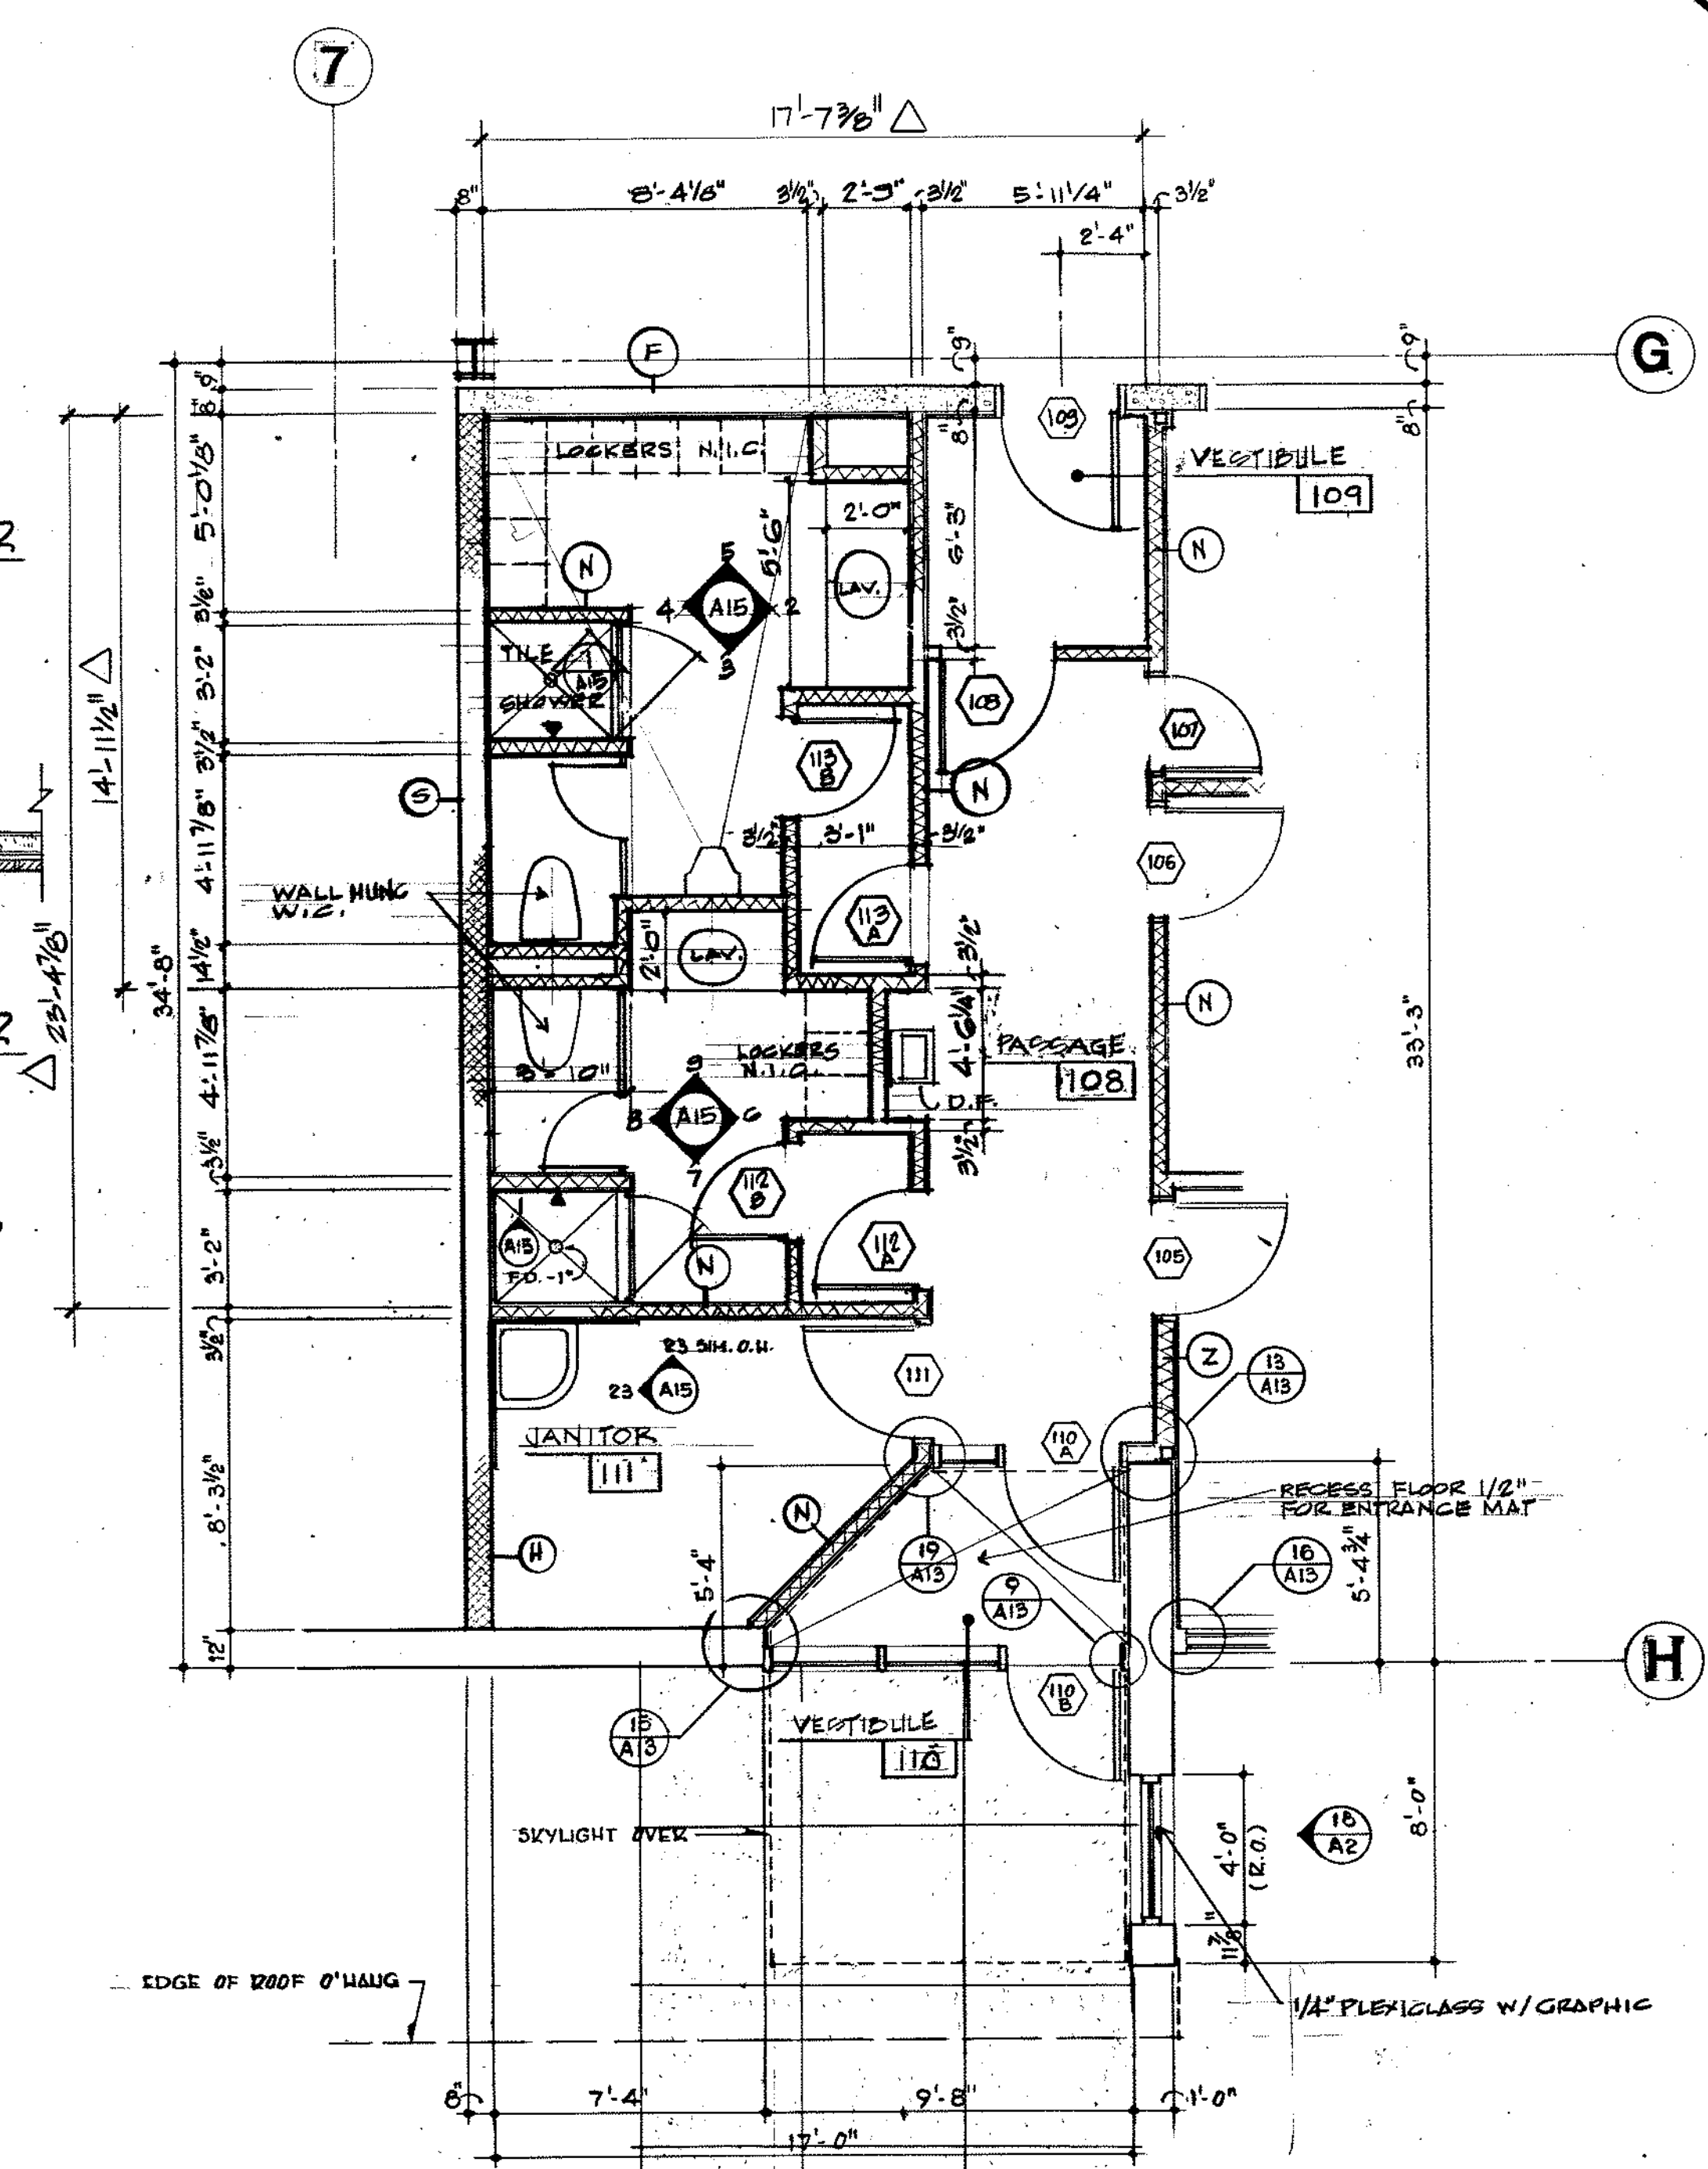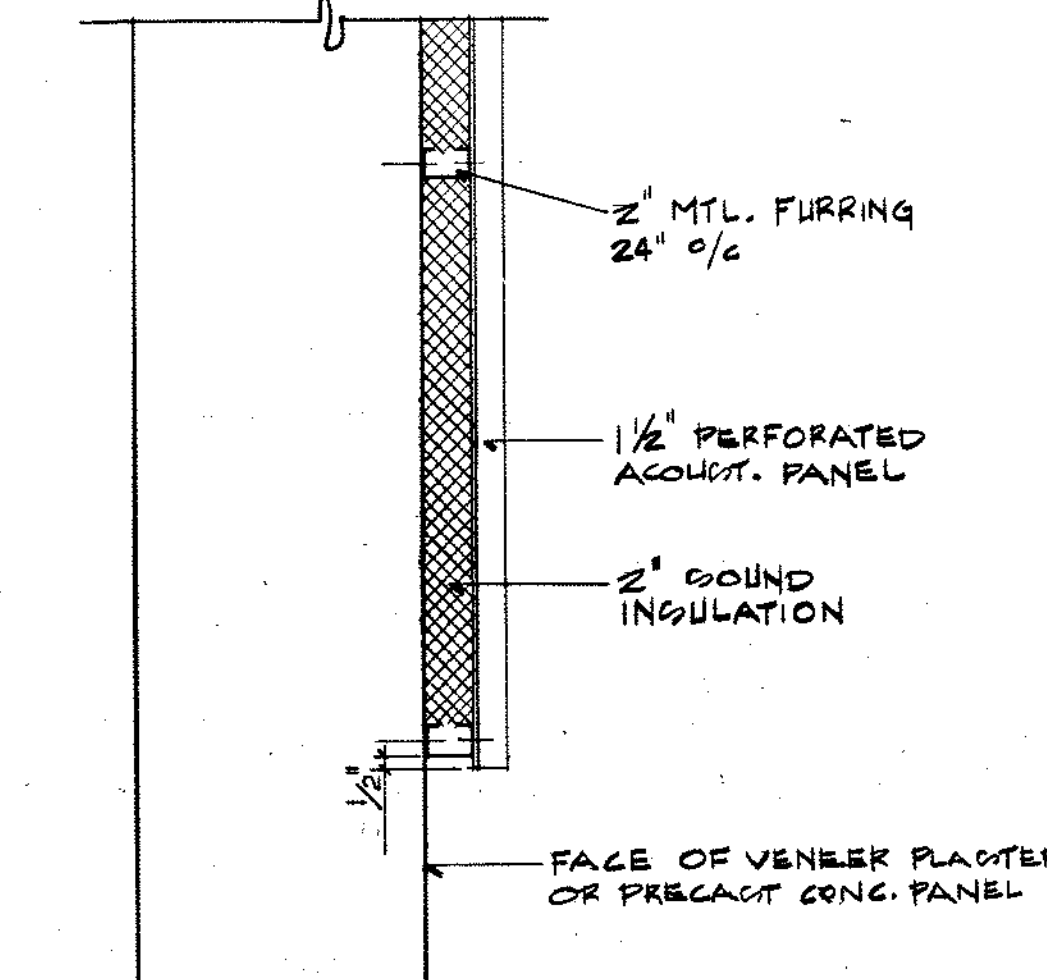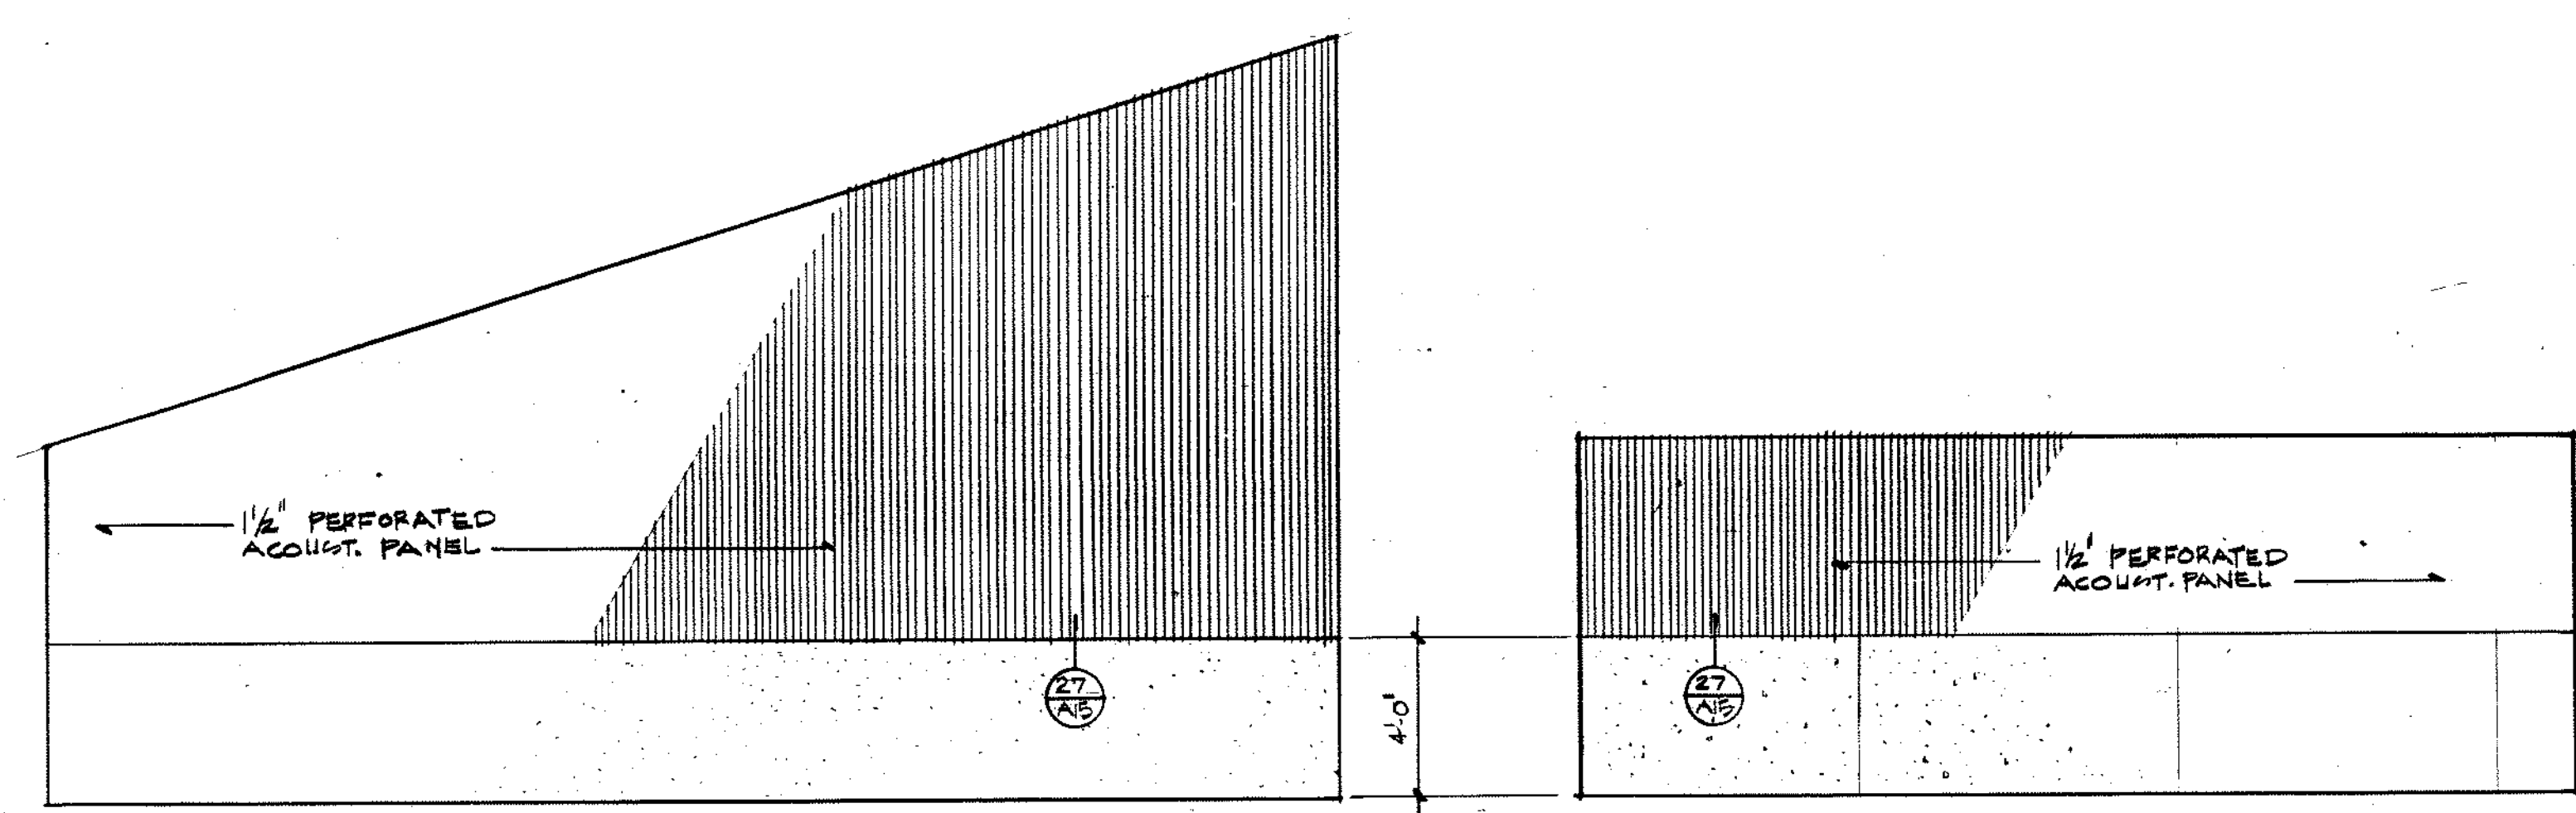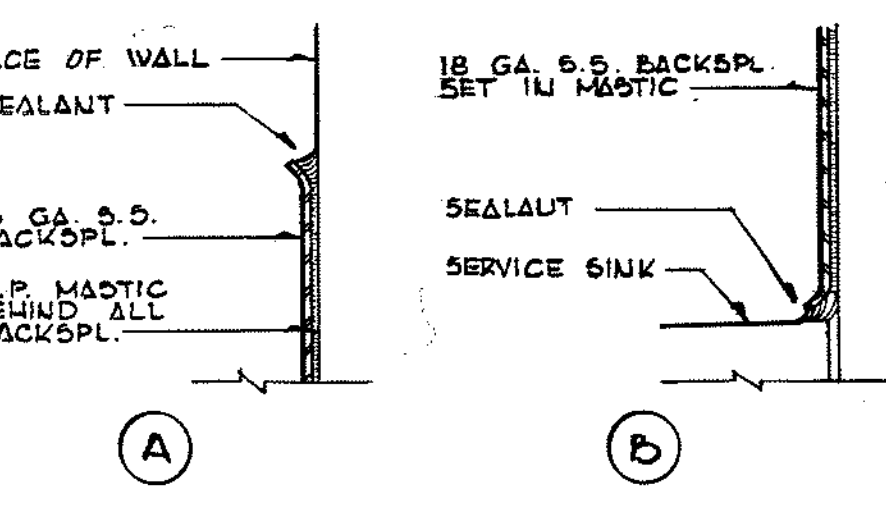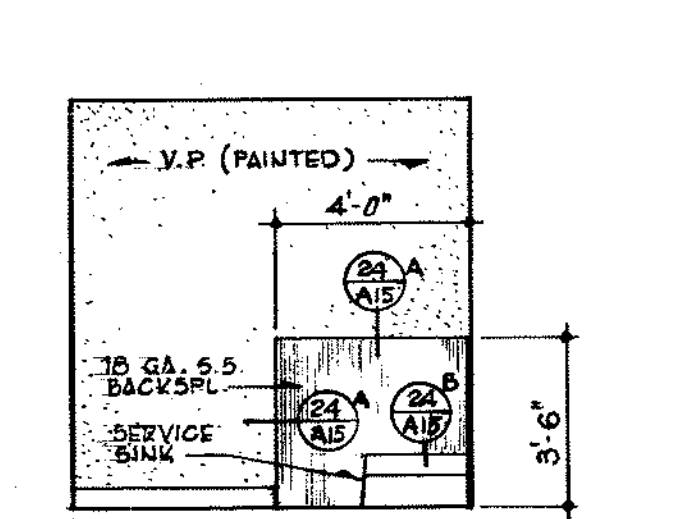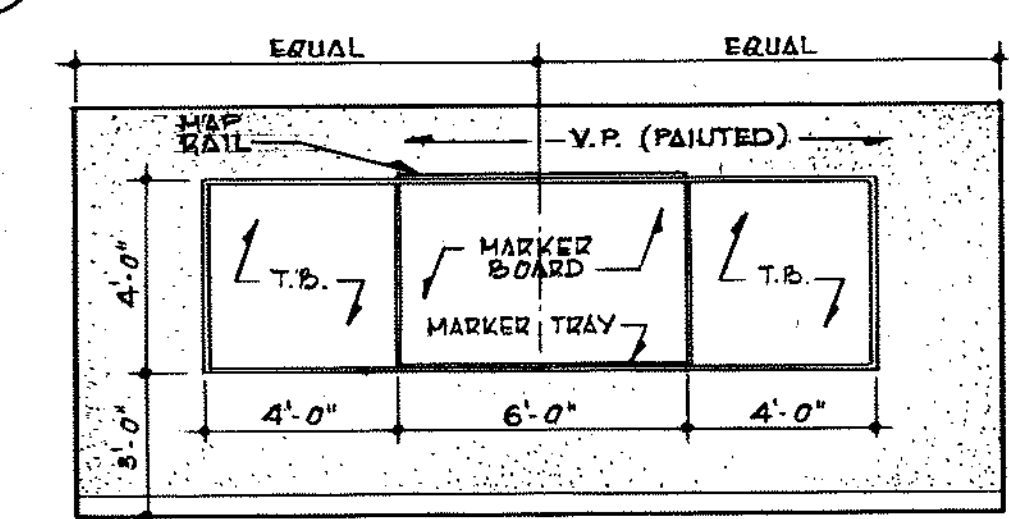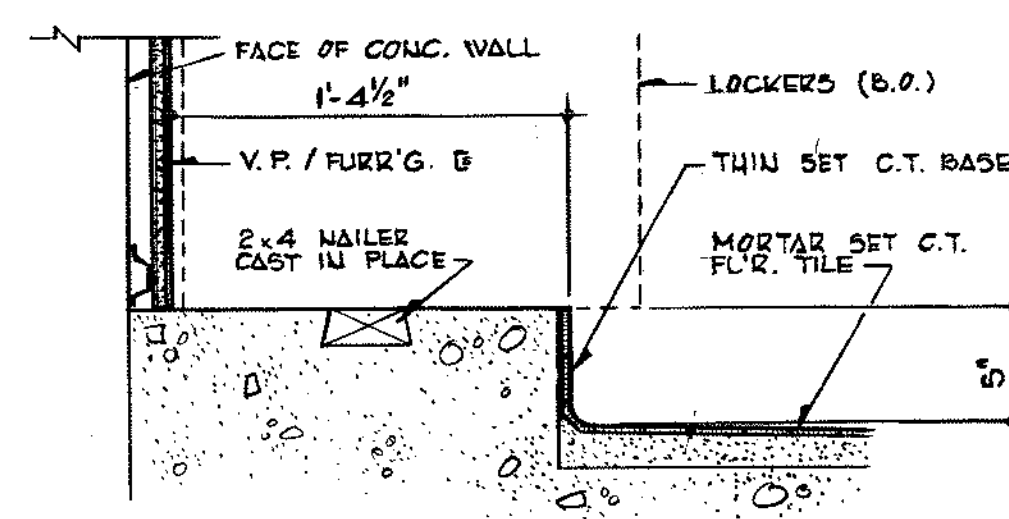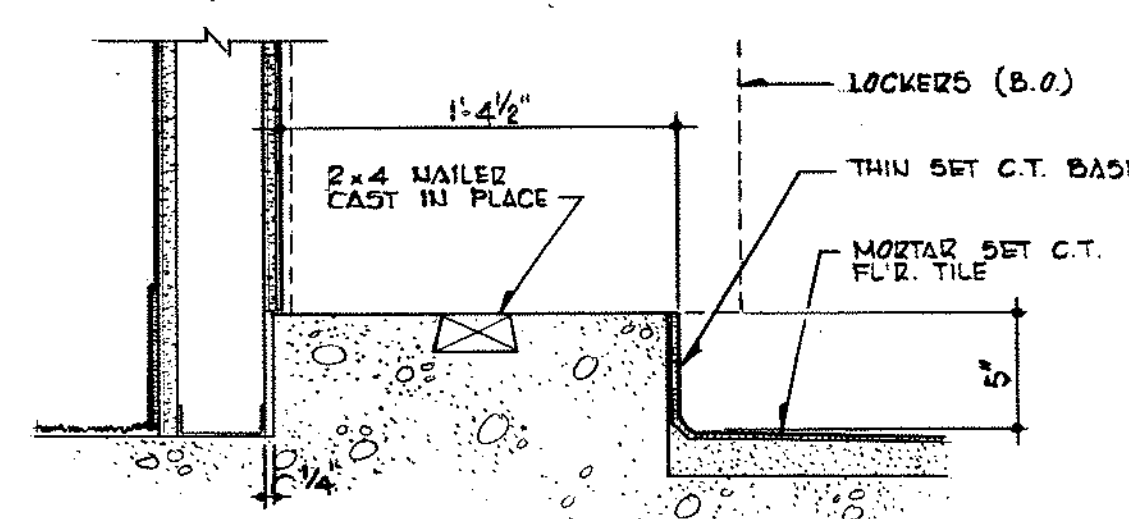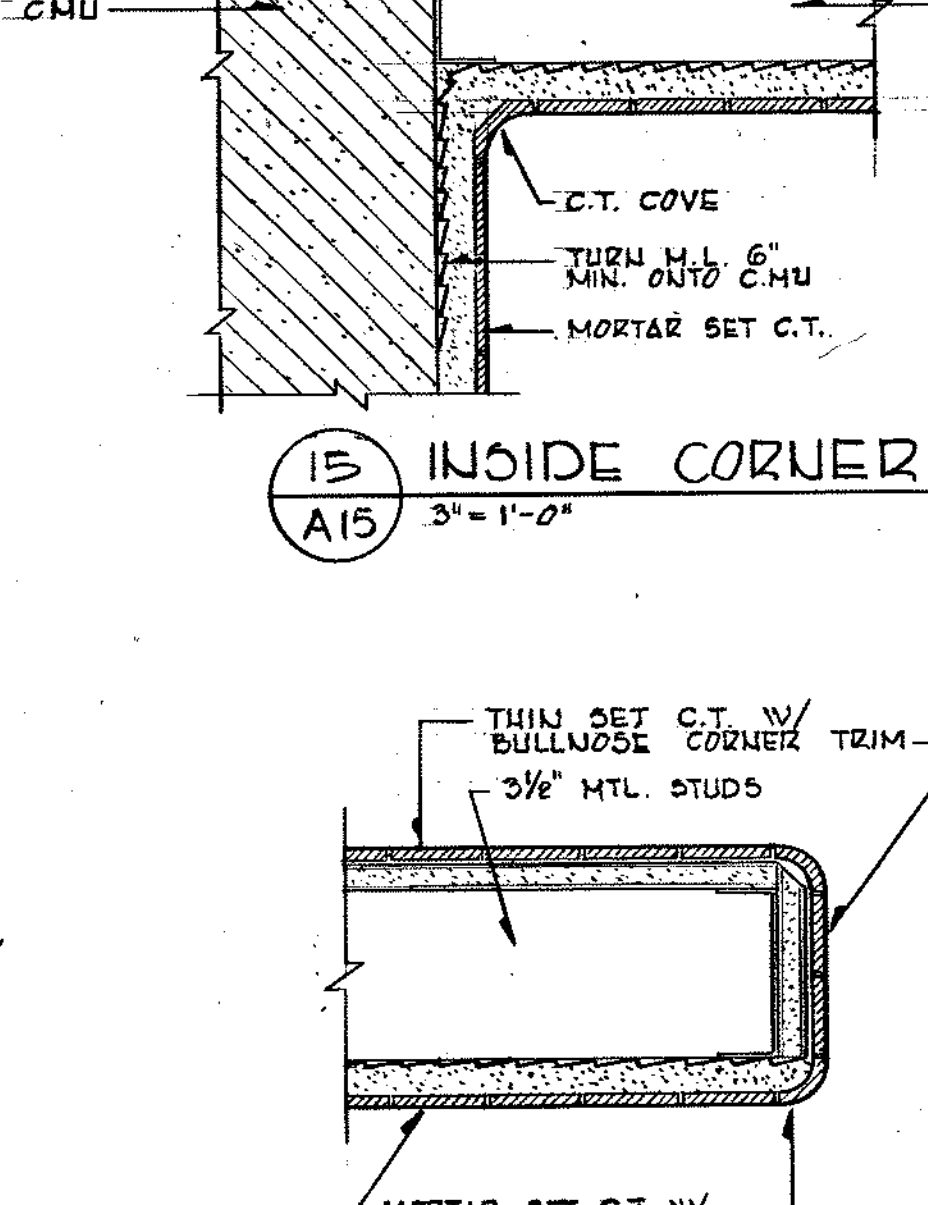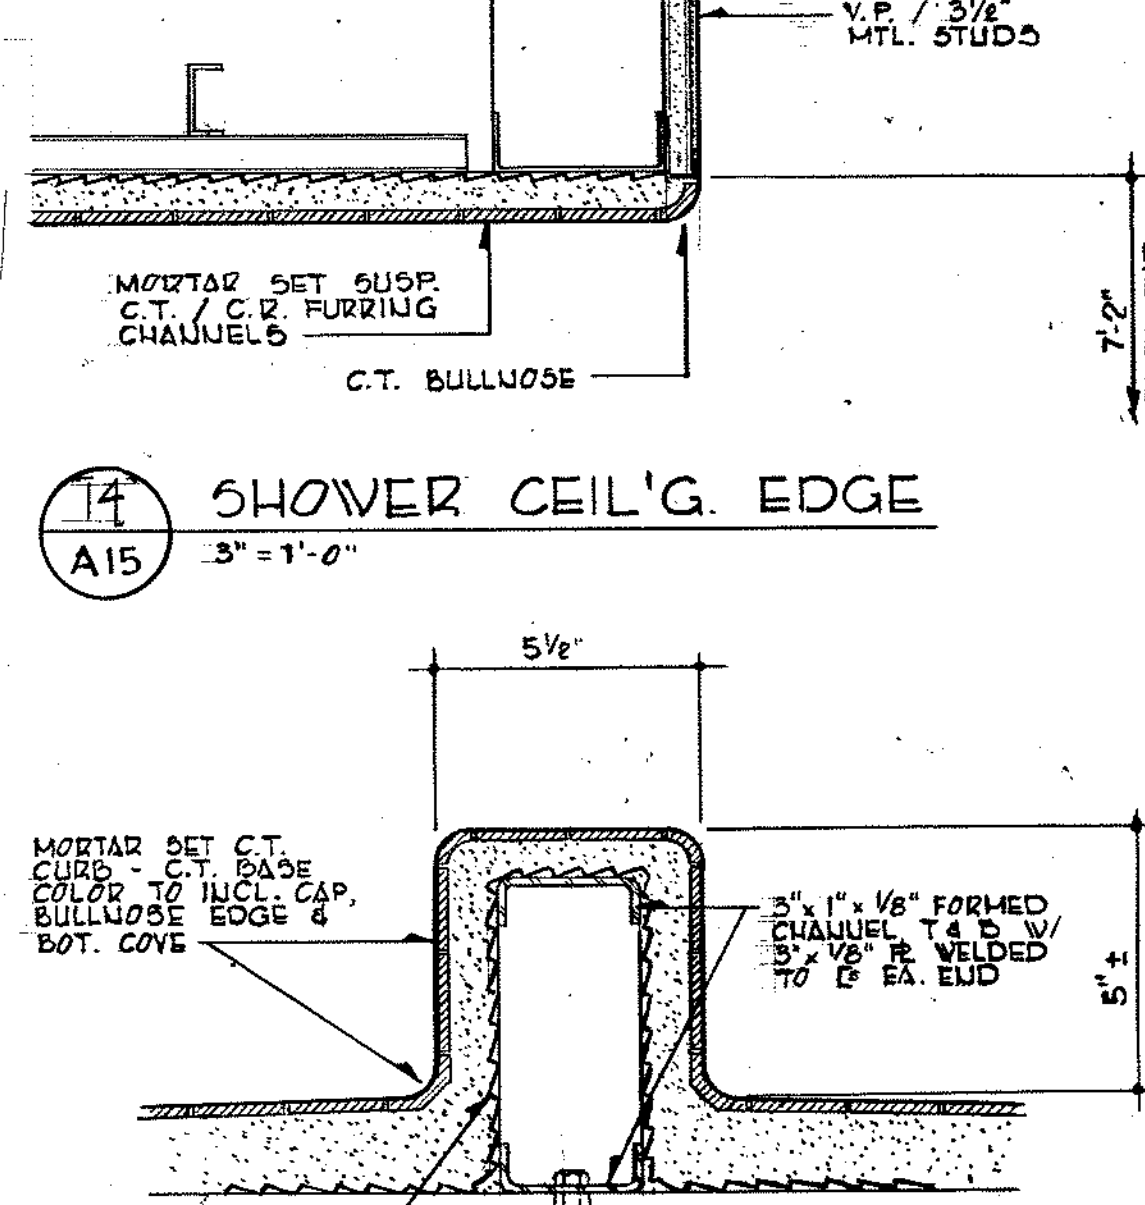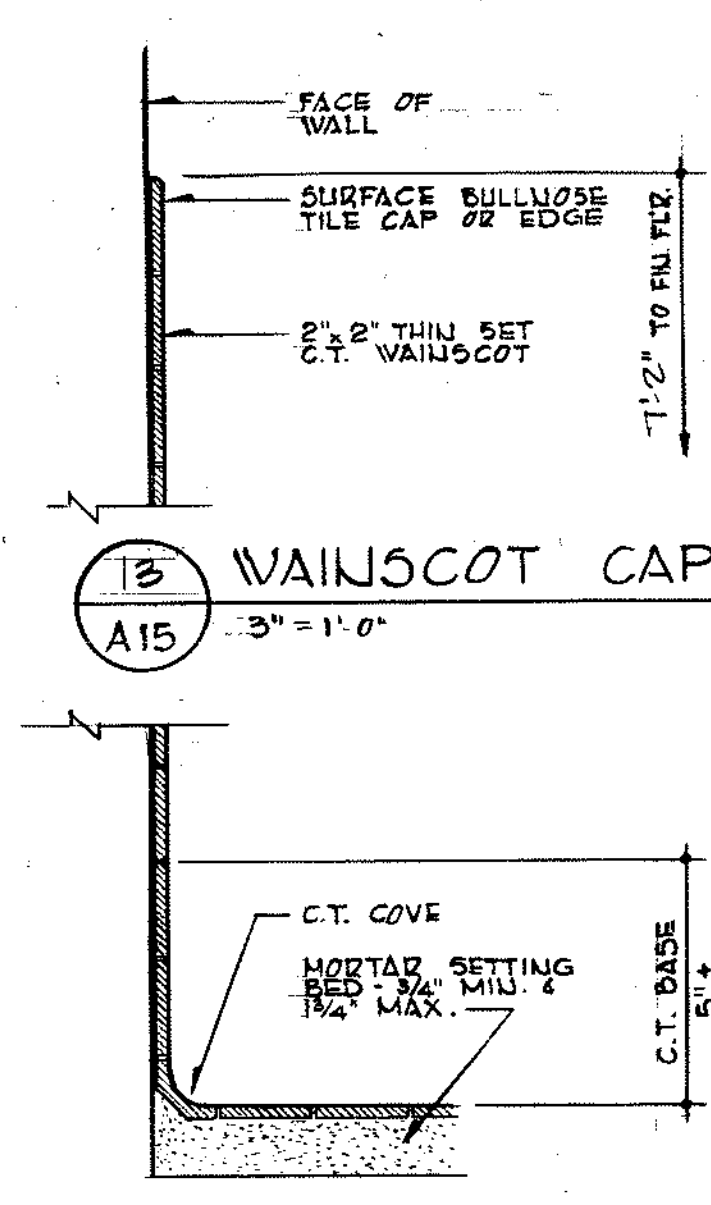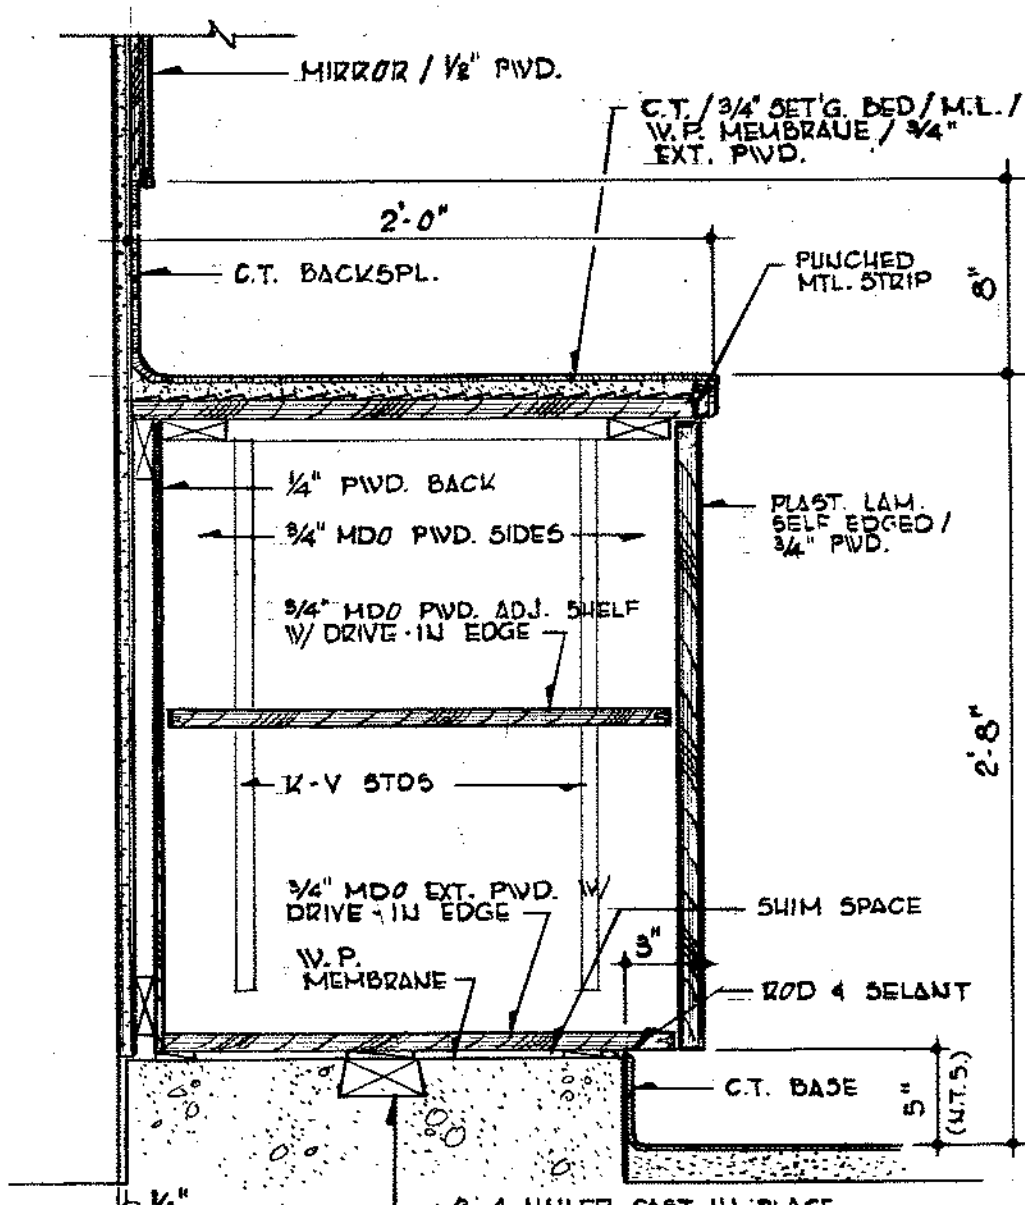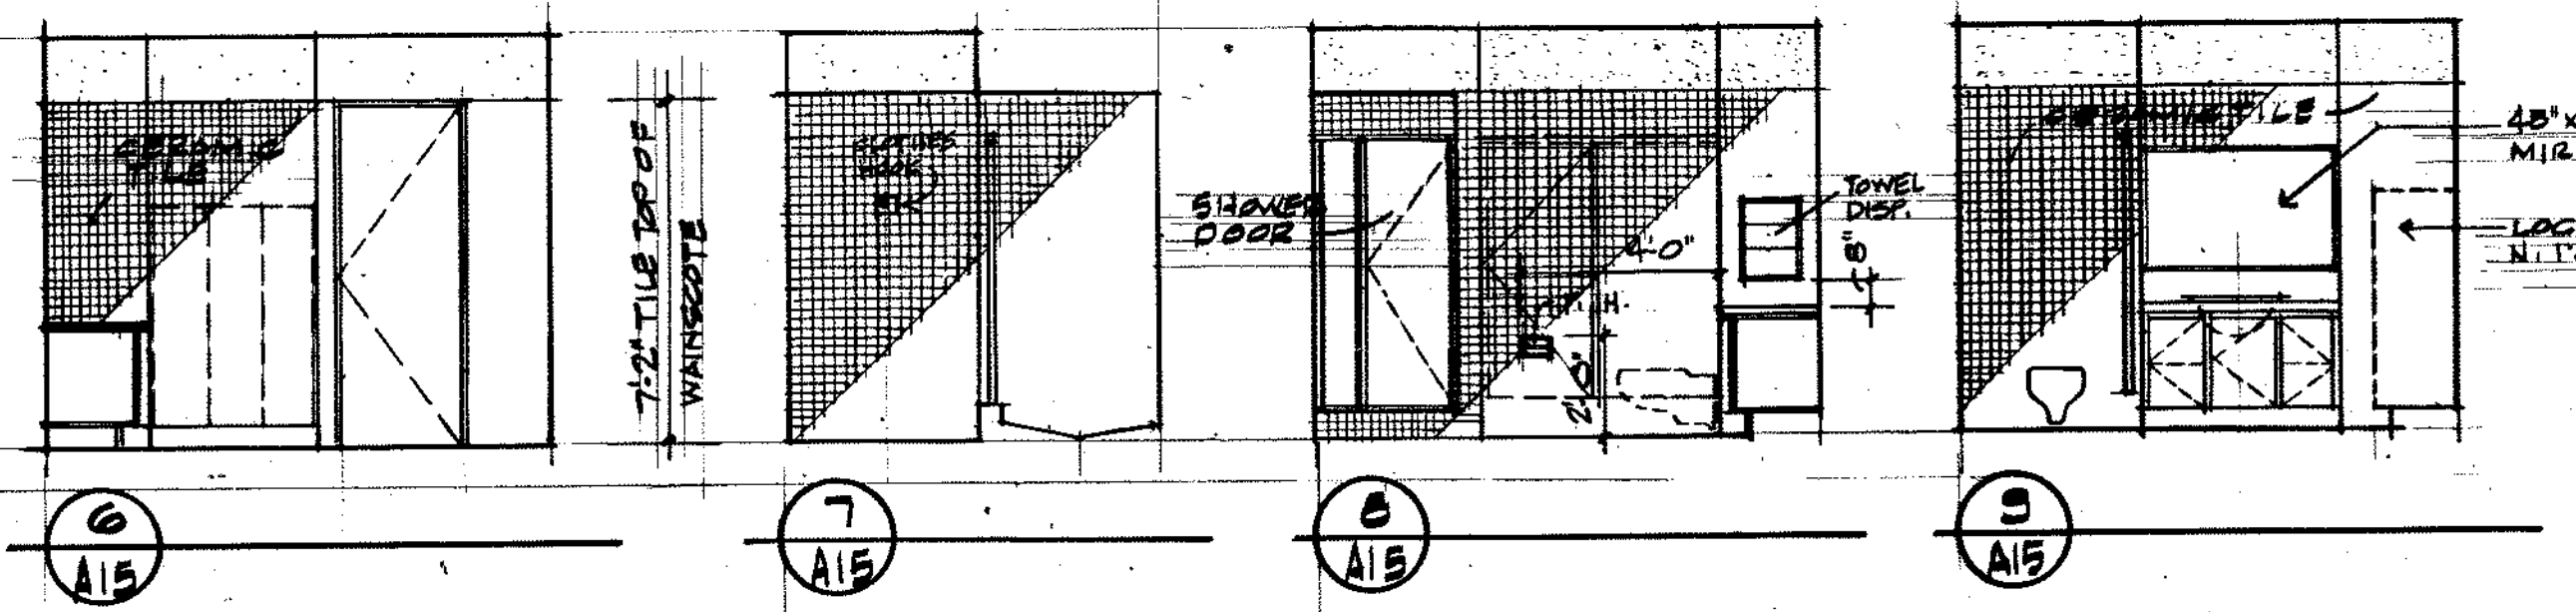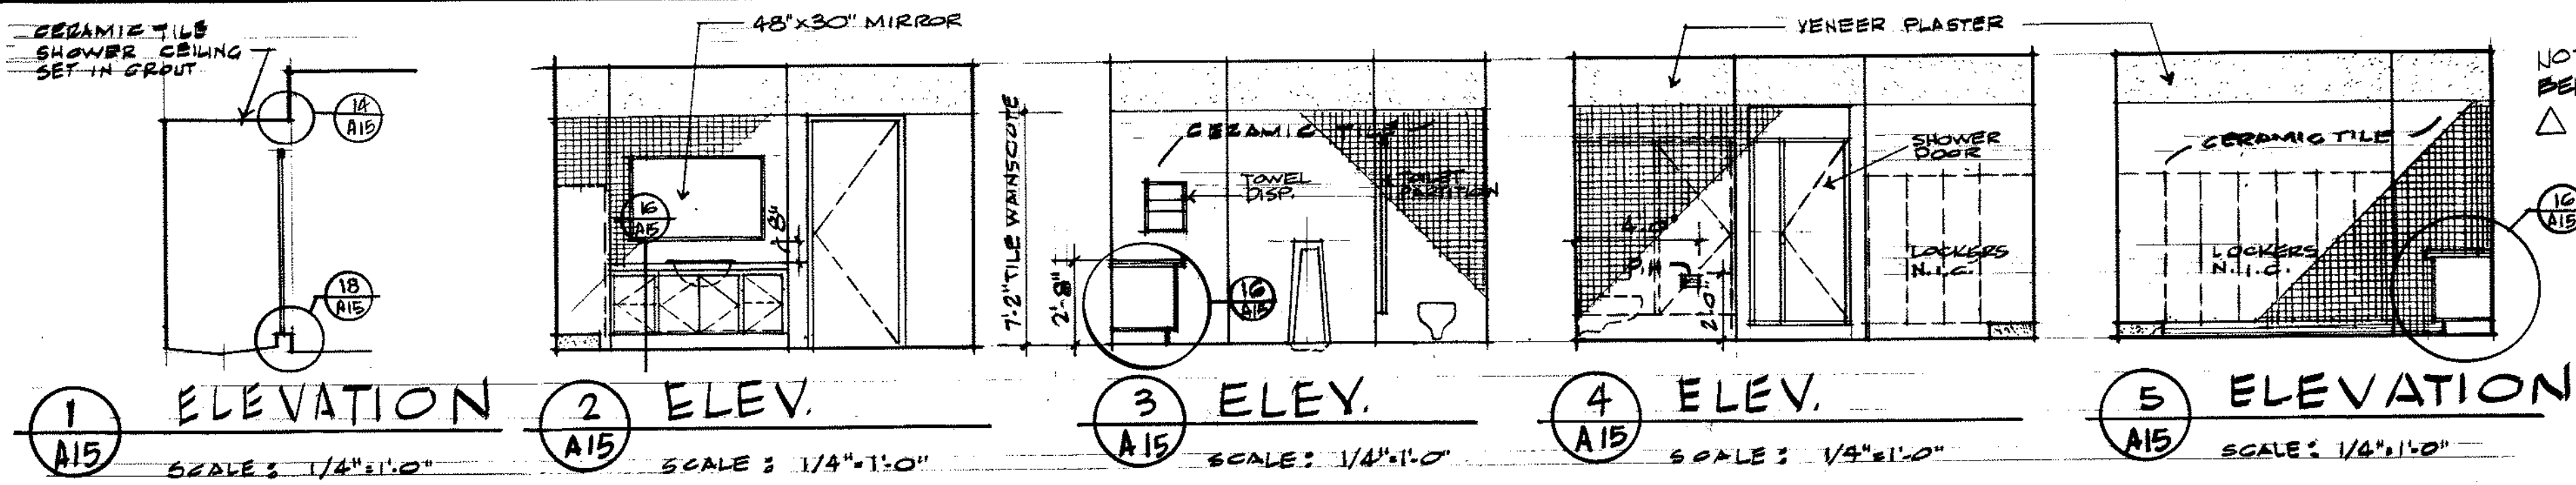


miller-cook architects a.i.a.
 30 N.W. 4th AVE. PORTLAND, OREGON 97208
 (503) 528-0822
 57208
 DATE: FEB. 20, 1980
 JOB NO: 84-125
 REVISIONS: AS BUILT (1-1-81)
 REGISTERED ARCHITECT
 STATE OF OREGON
 SHEET TITLE: TOILET ROOM PLAN AND ELEVATIONS
 C-130 FUEL SYSTEM / CORROSION CONTROL
 MAINTENANCE HANGAR
 304th AIR RESCUE RECOVERY SQUADRON
 PORTLAND INTERNATIONAL AIRPORT
 OREGON
 A15
 RECORD DRAWINGS FROM INFORMATION SUPPLIED BY THE GENERAL CONTRACTOR
 BLDG 375

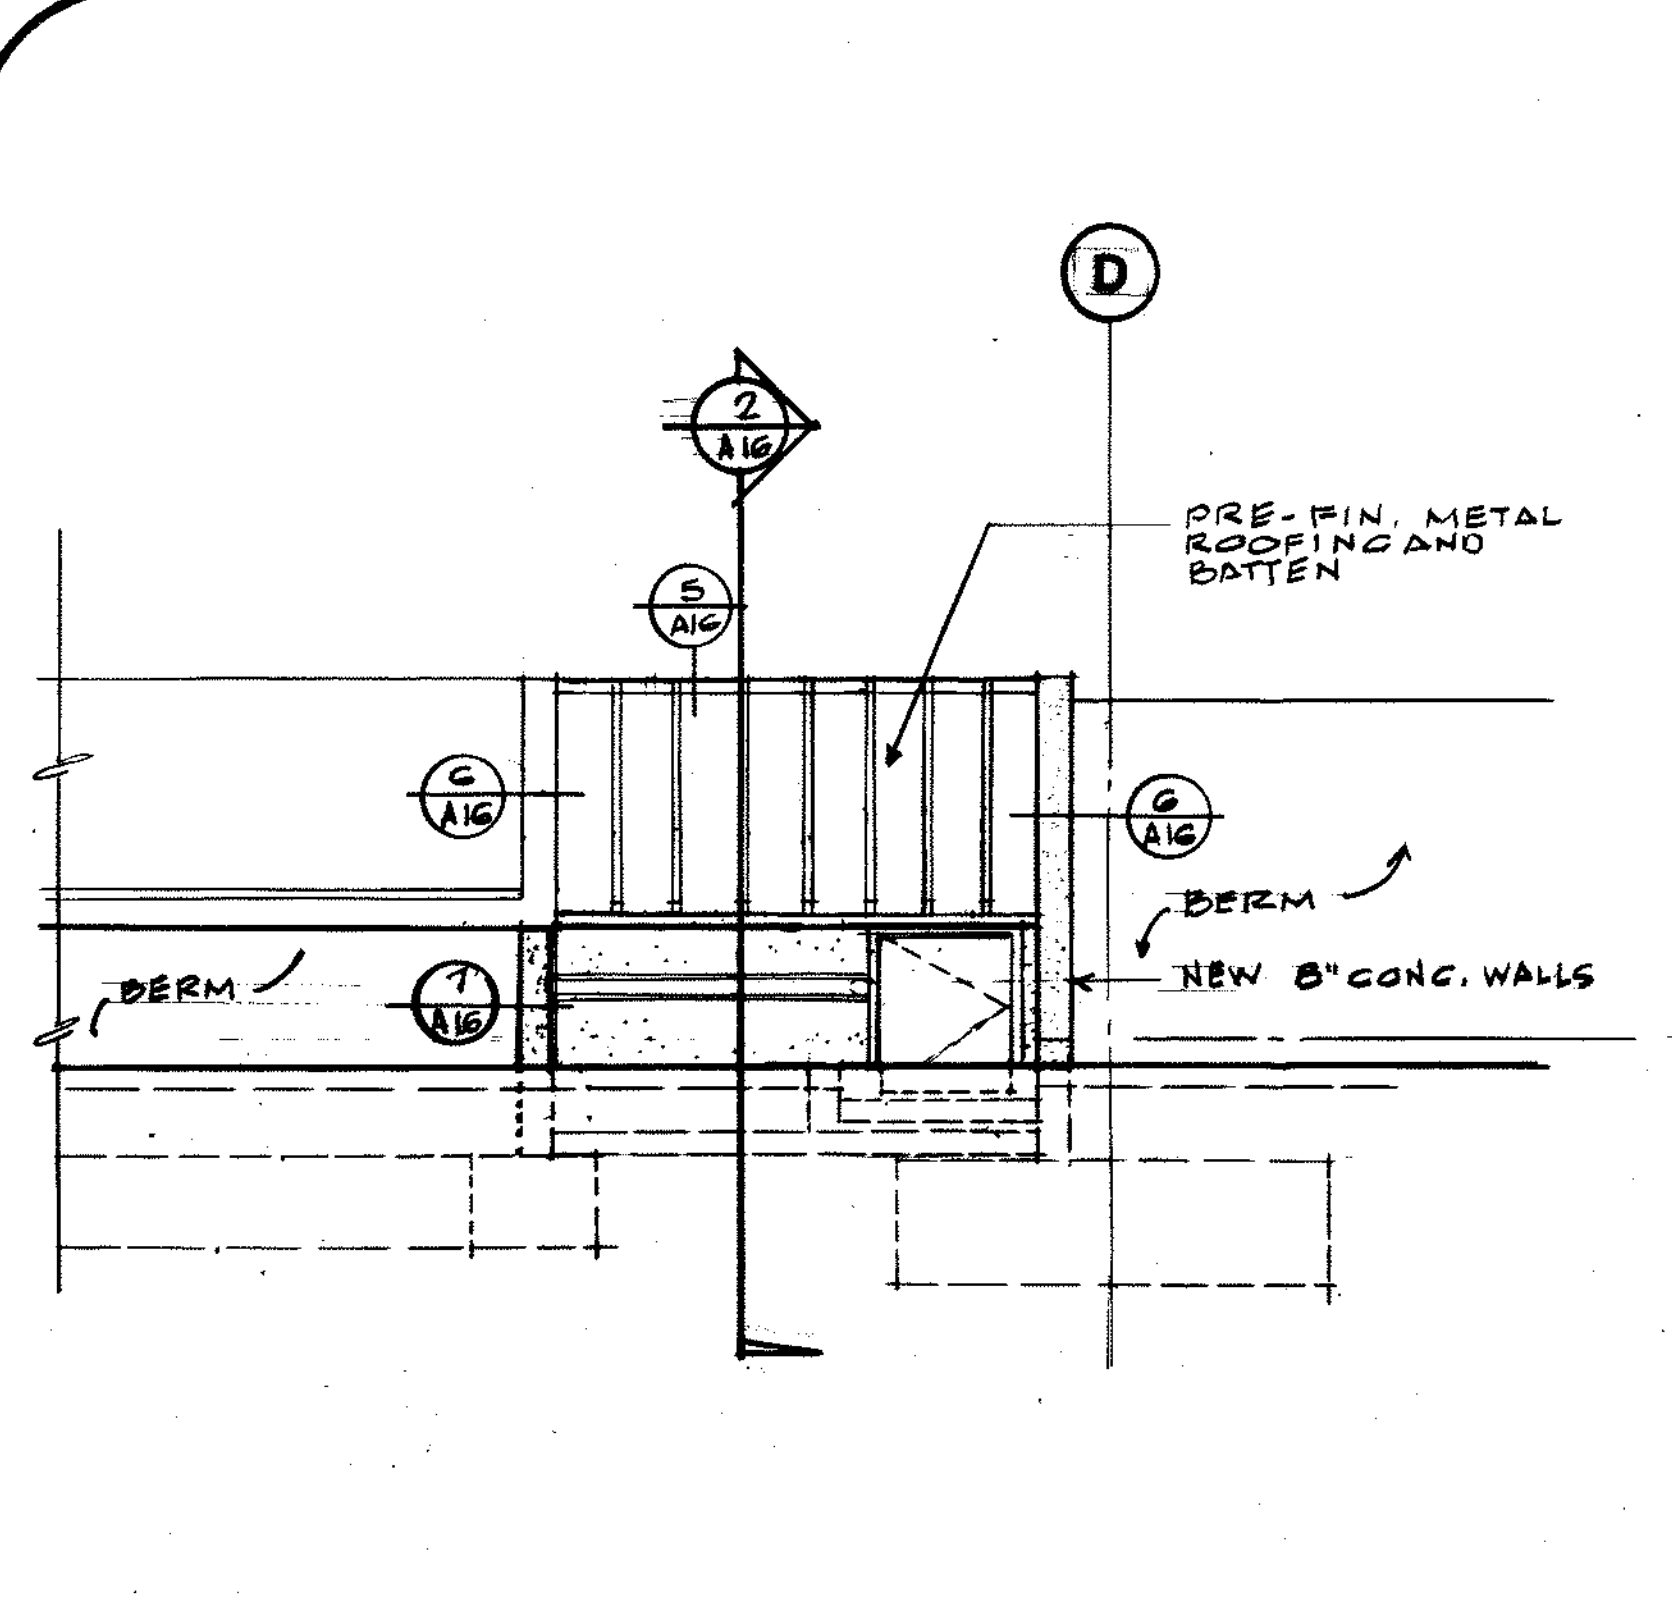


3 EAST ELEVATION
SCALE: 1/4" = 1'-0"

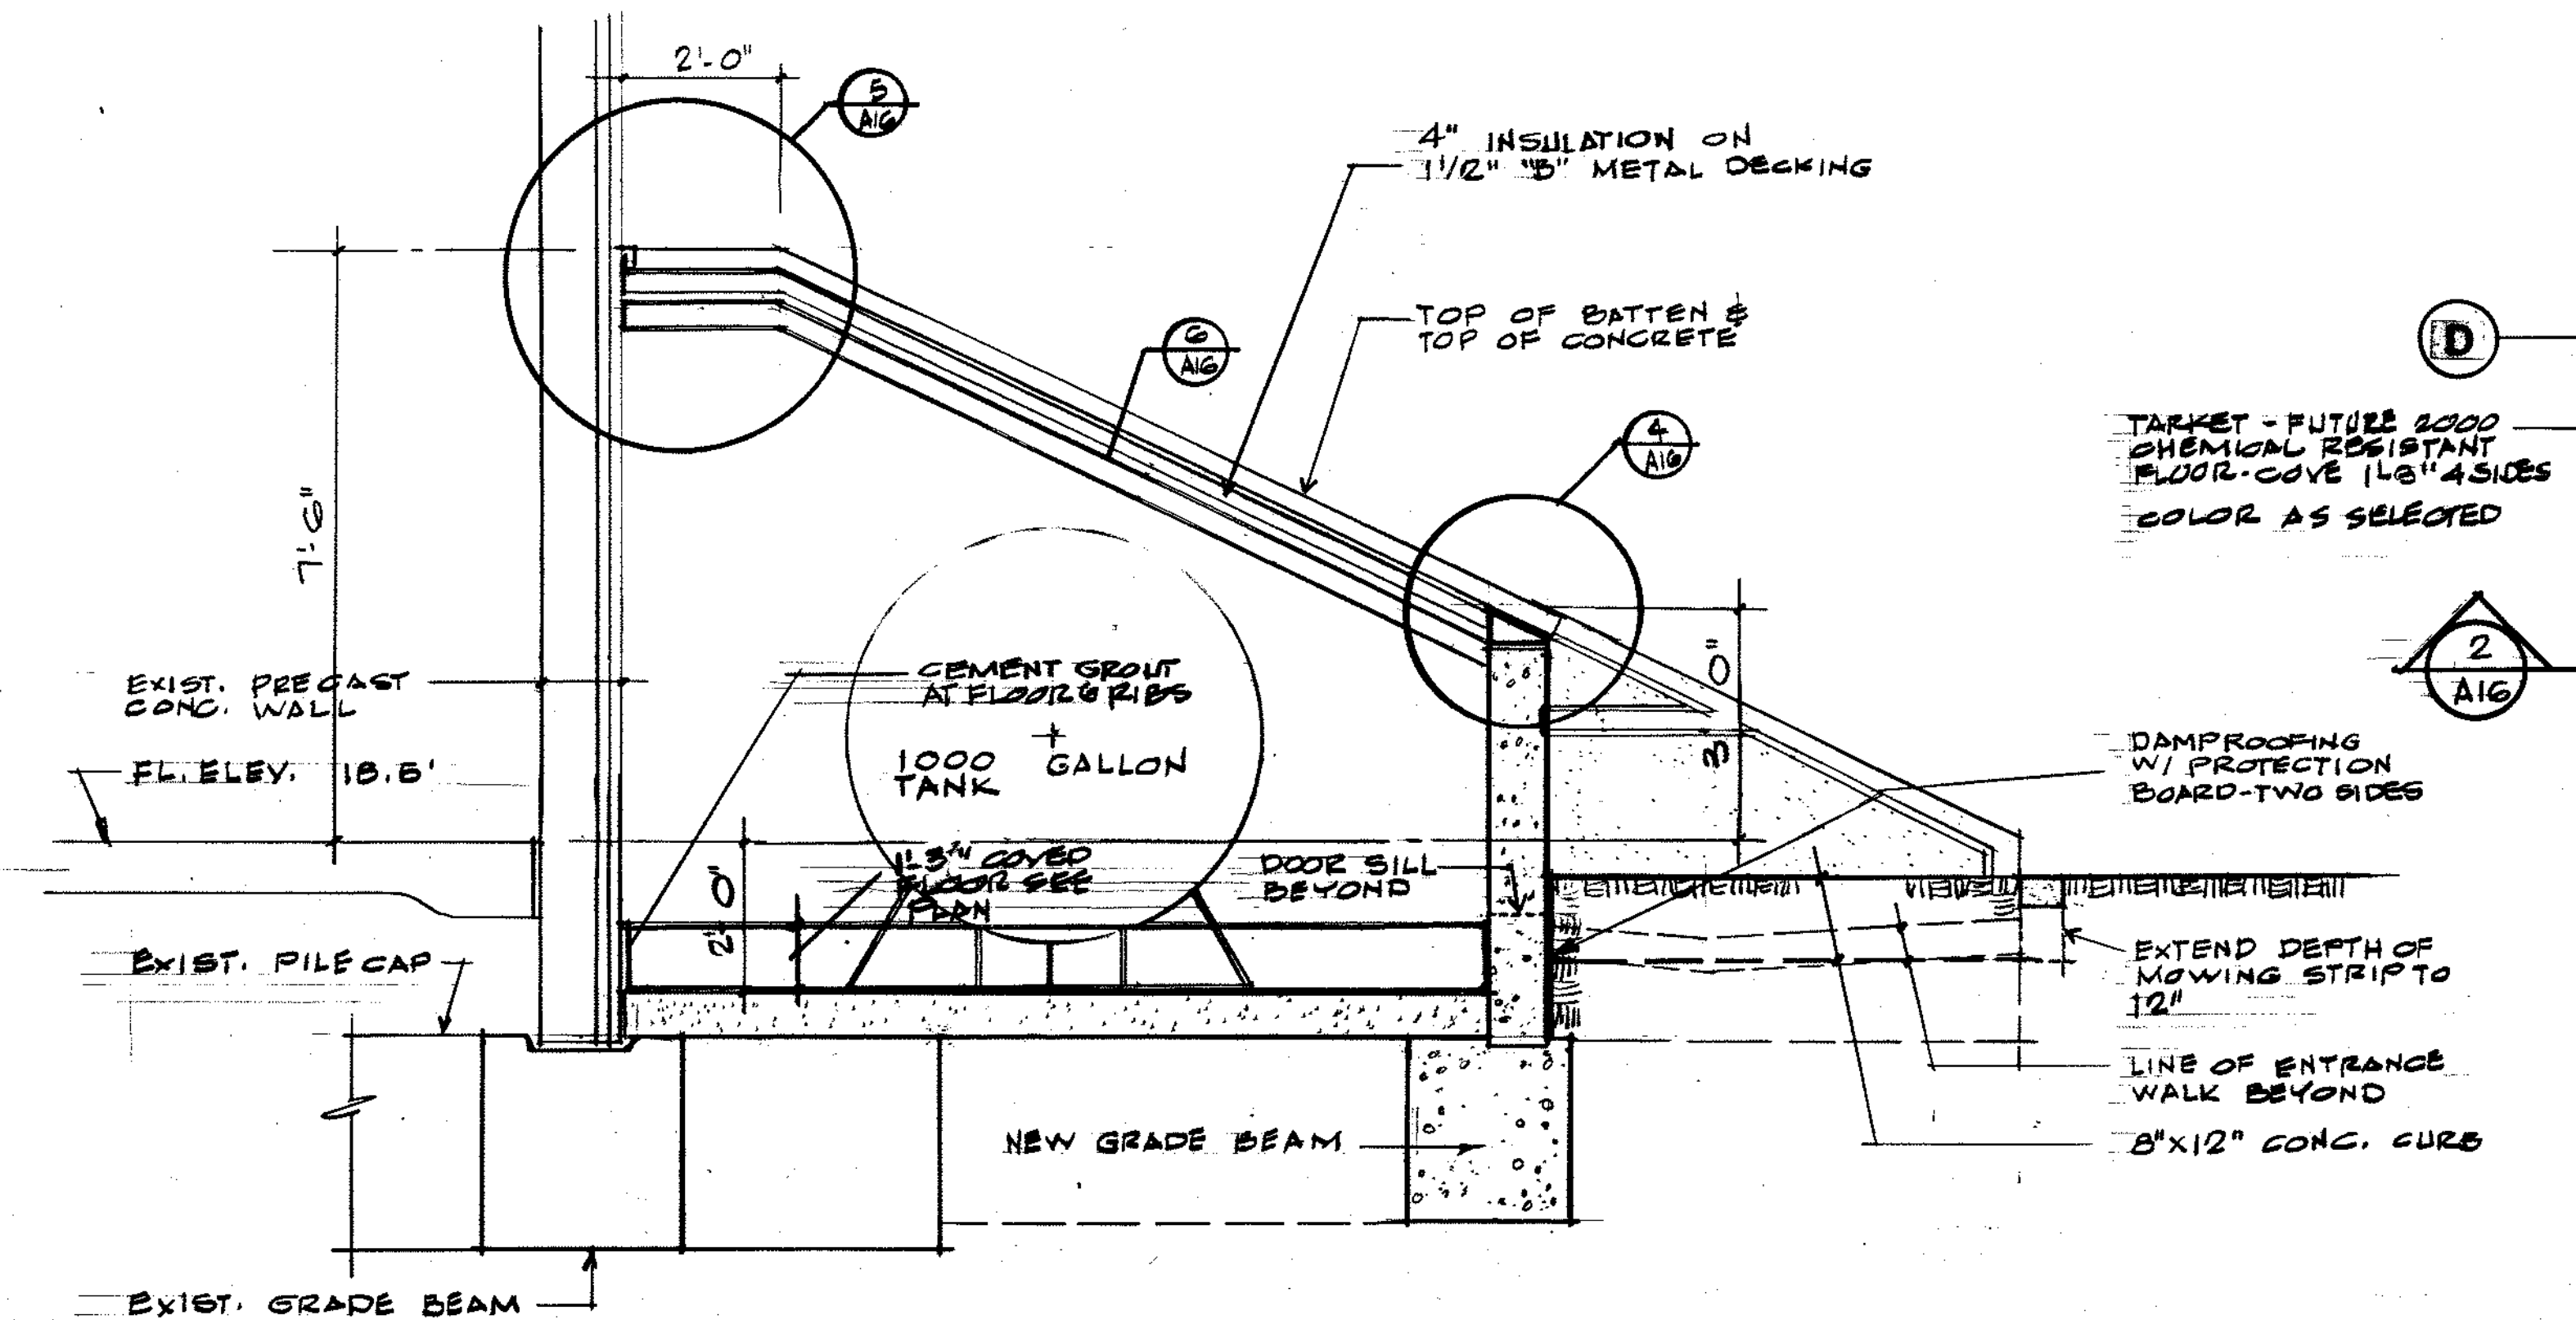


2 CROSS SECTION
SCALE: 1/2" = 1'-0"

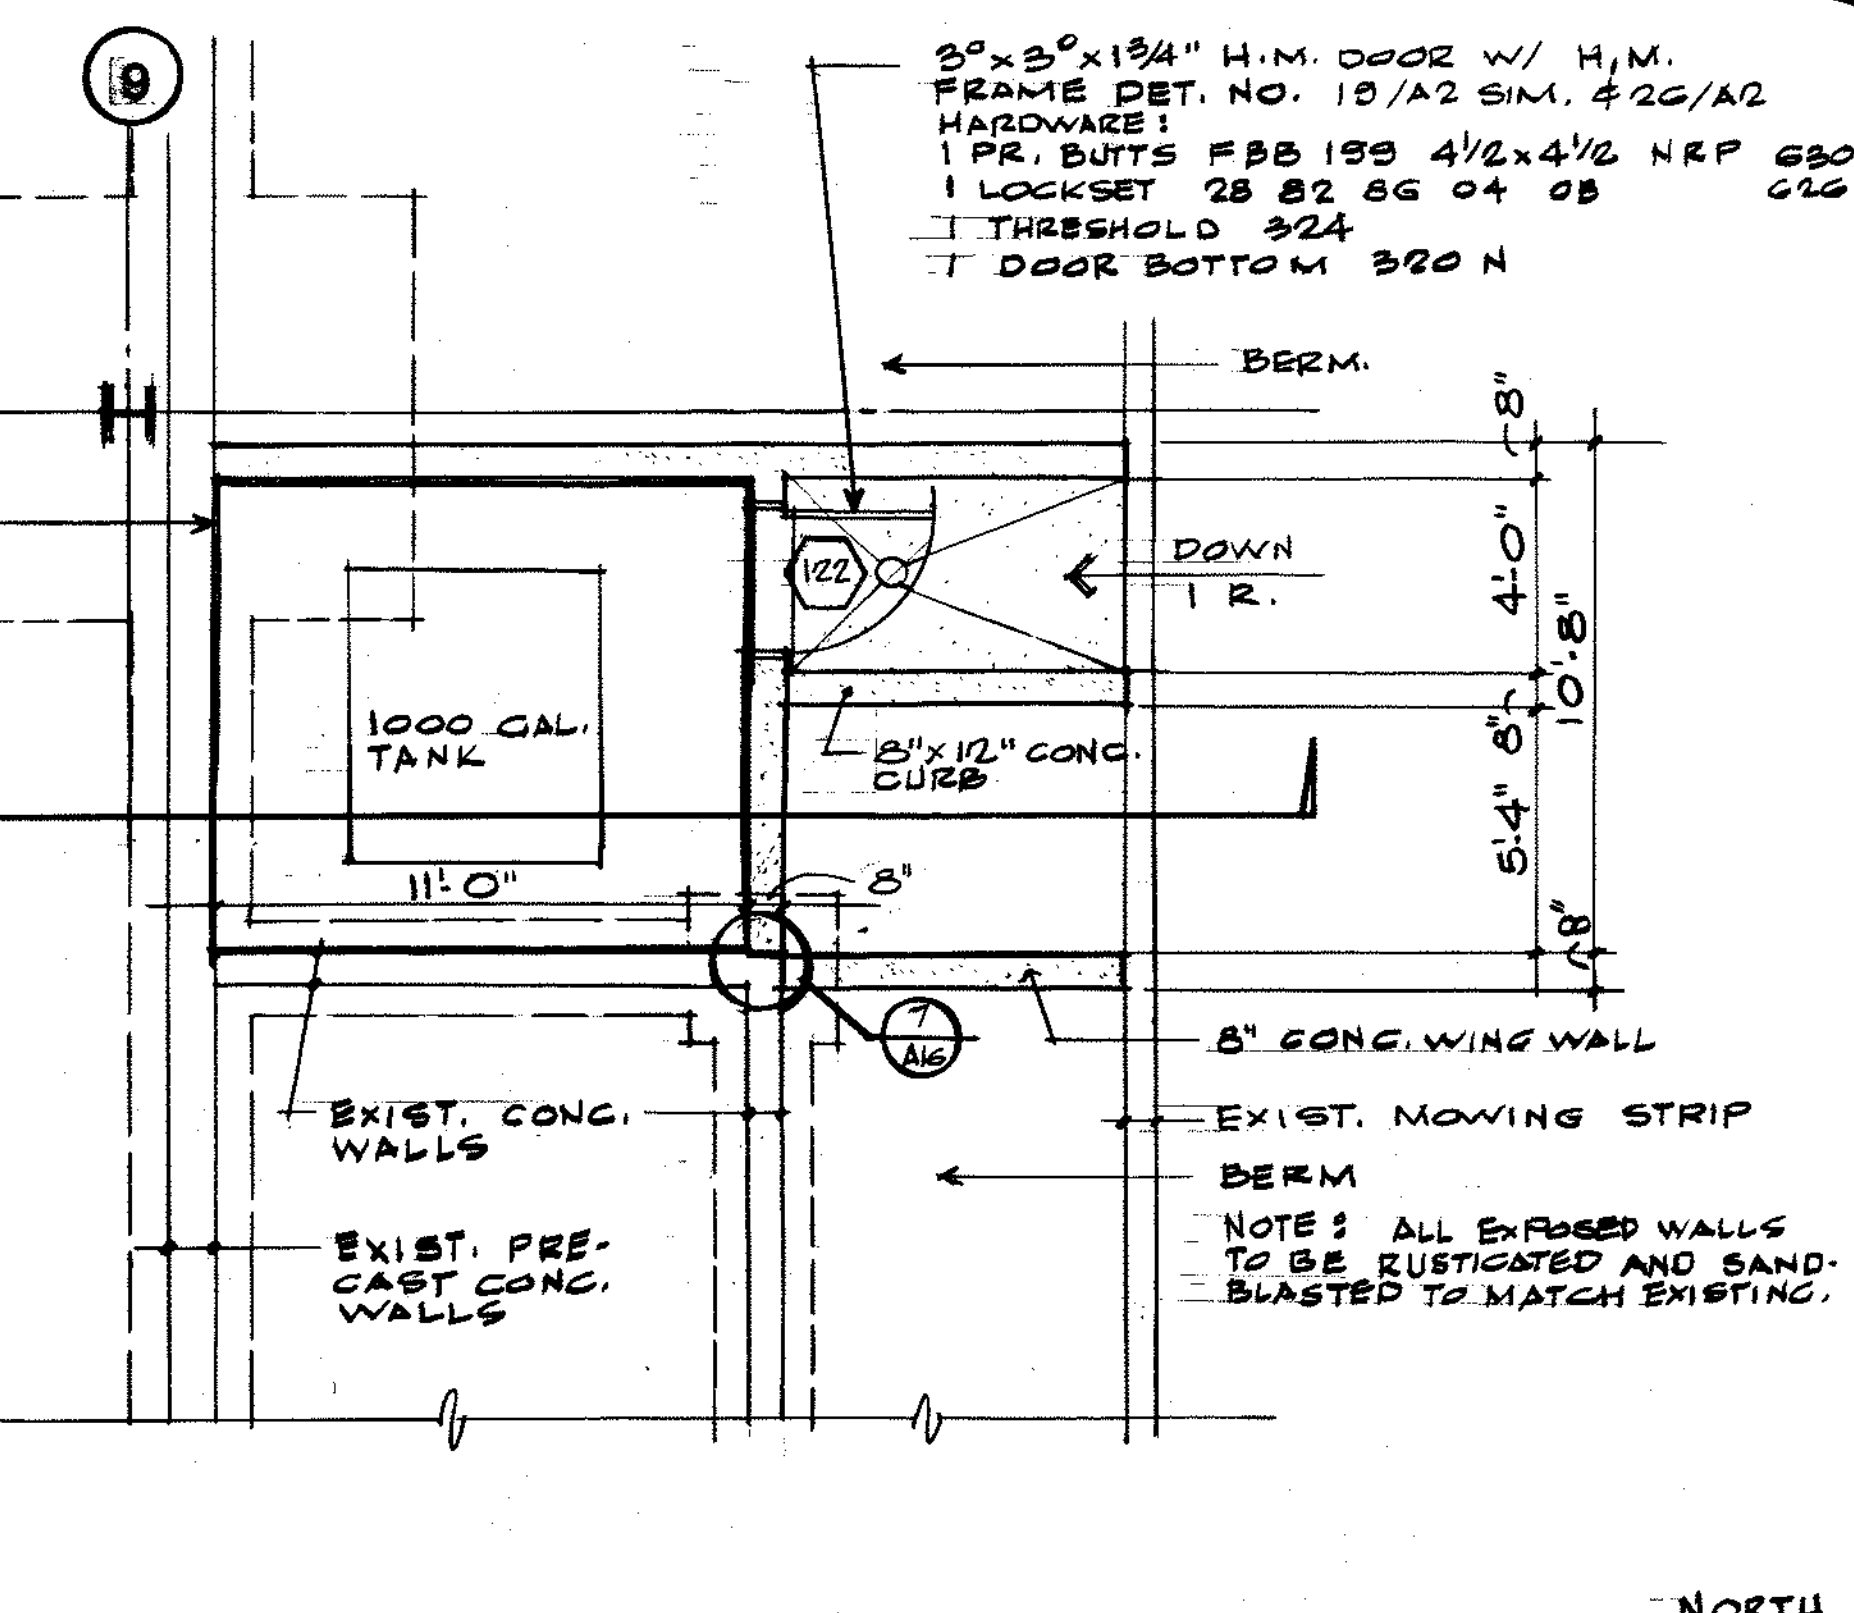


1 FLOOR PLAN
SCALE: 1/4" = 1'-0"

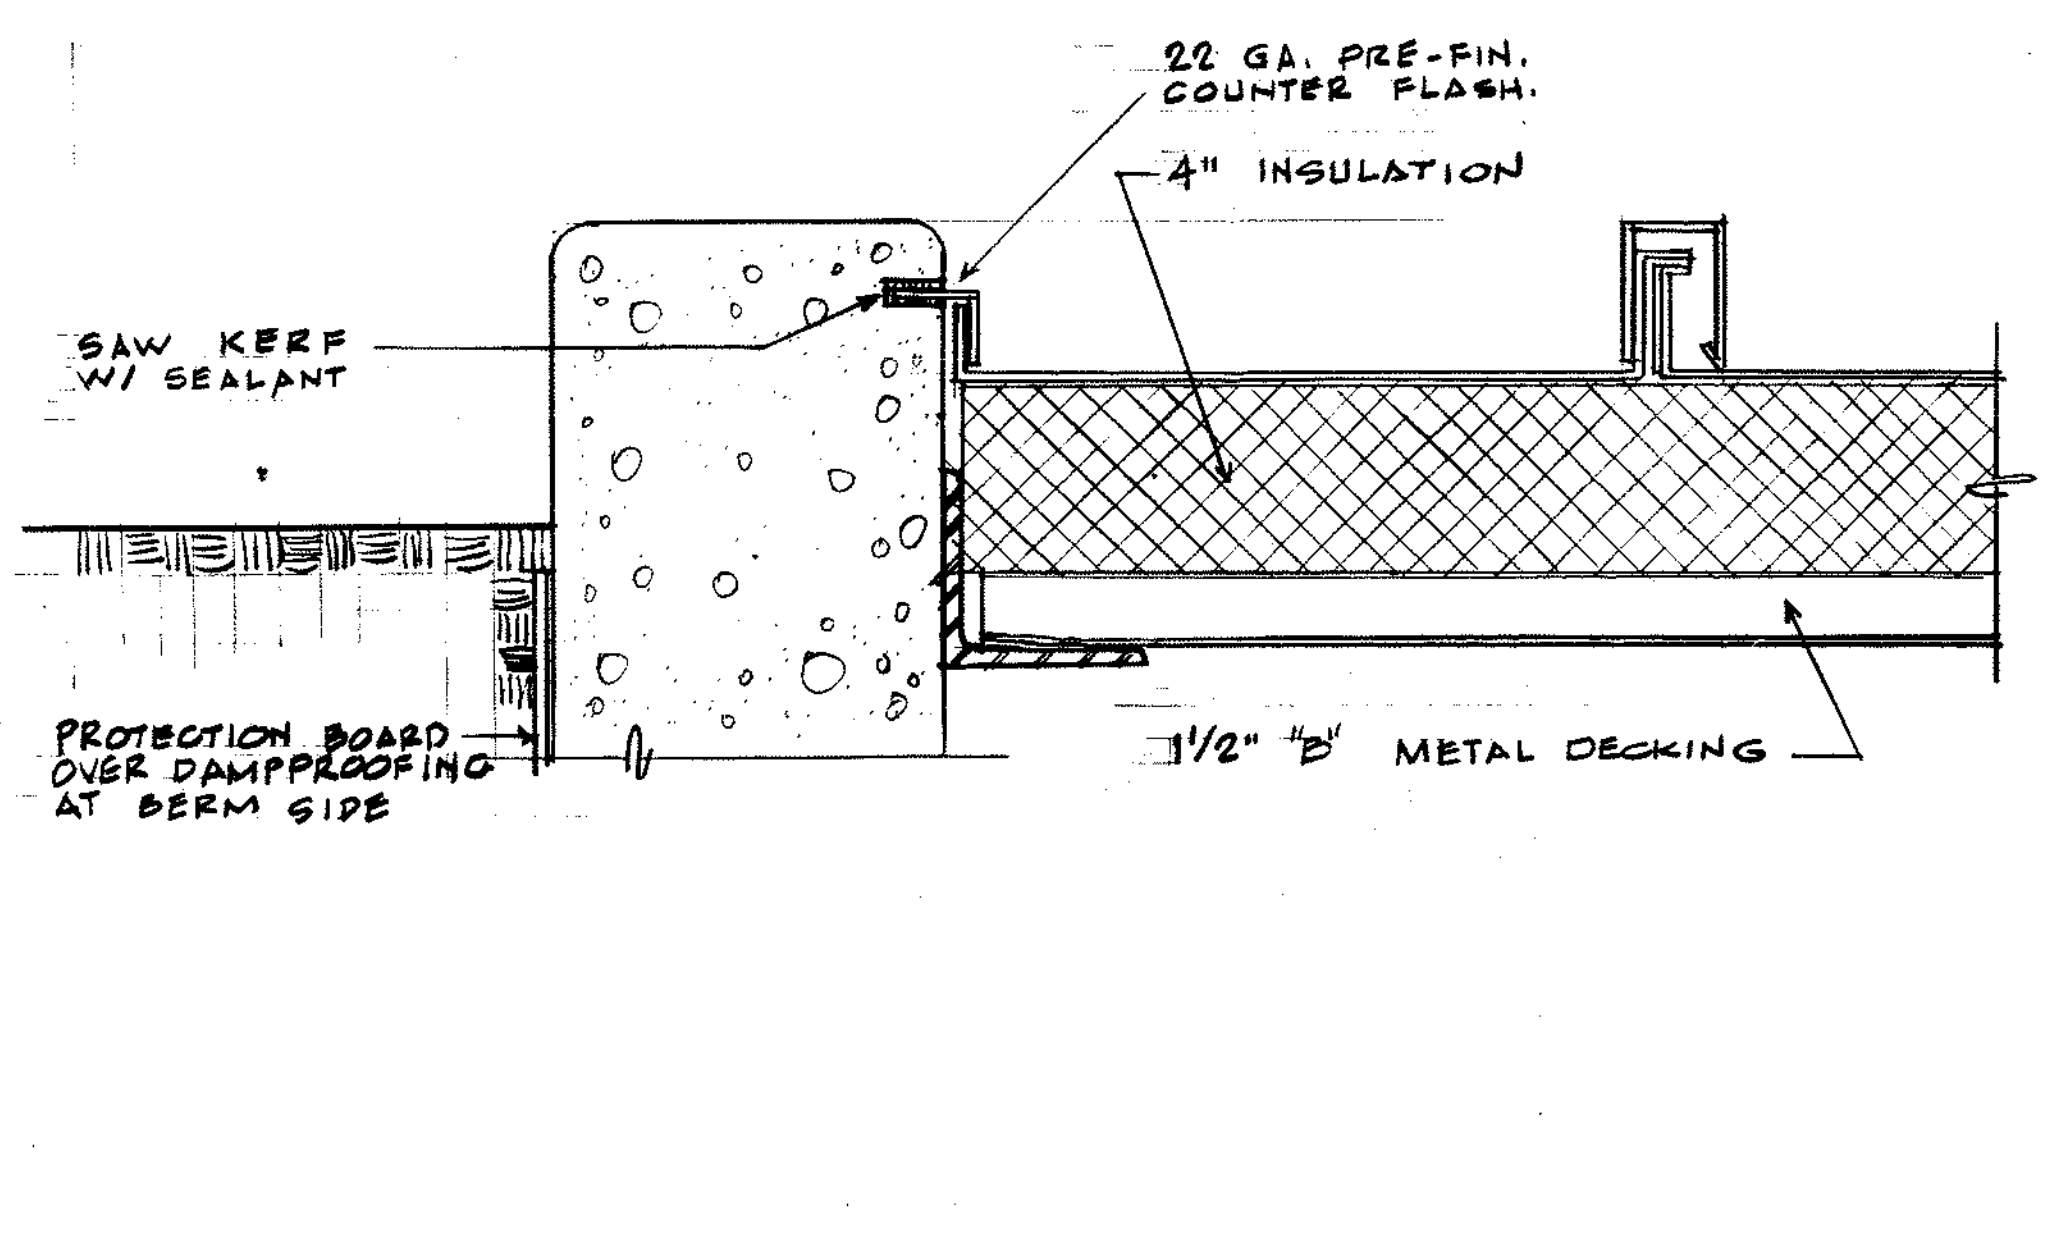


6 RAKE DETAIL
SCALE: 3" = 1'-0"

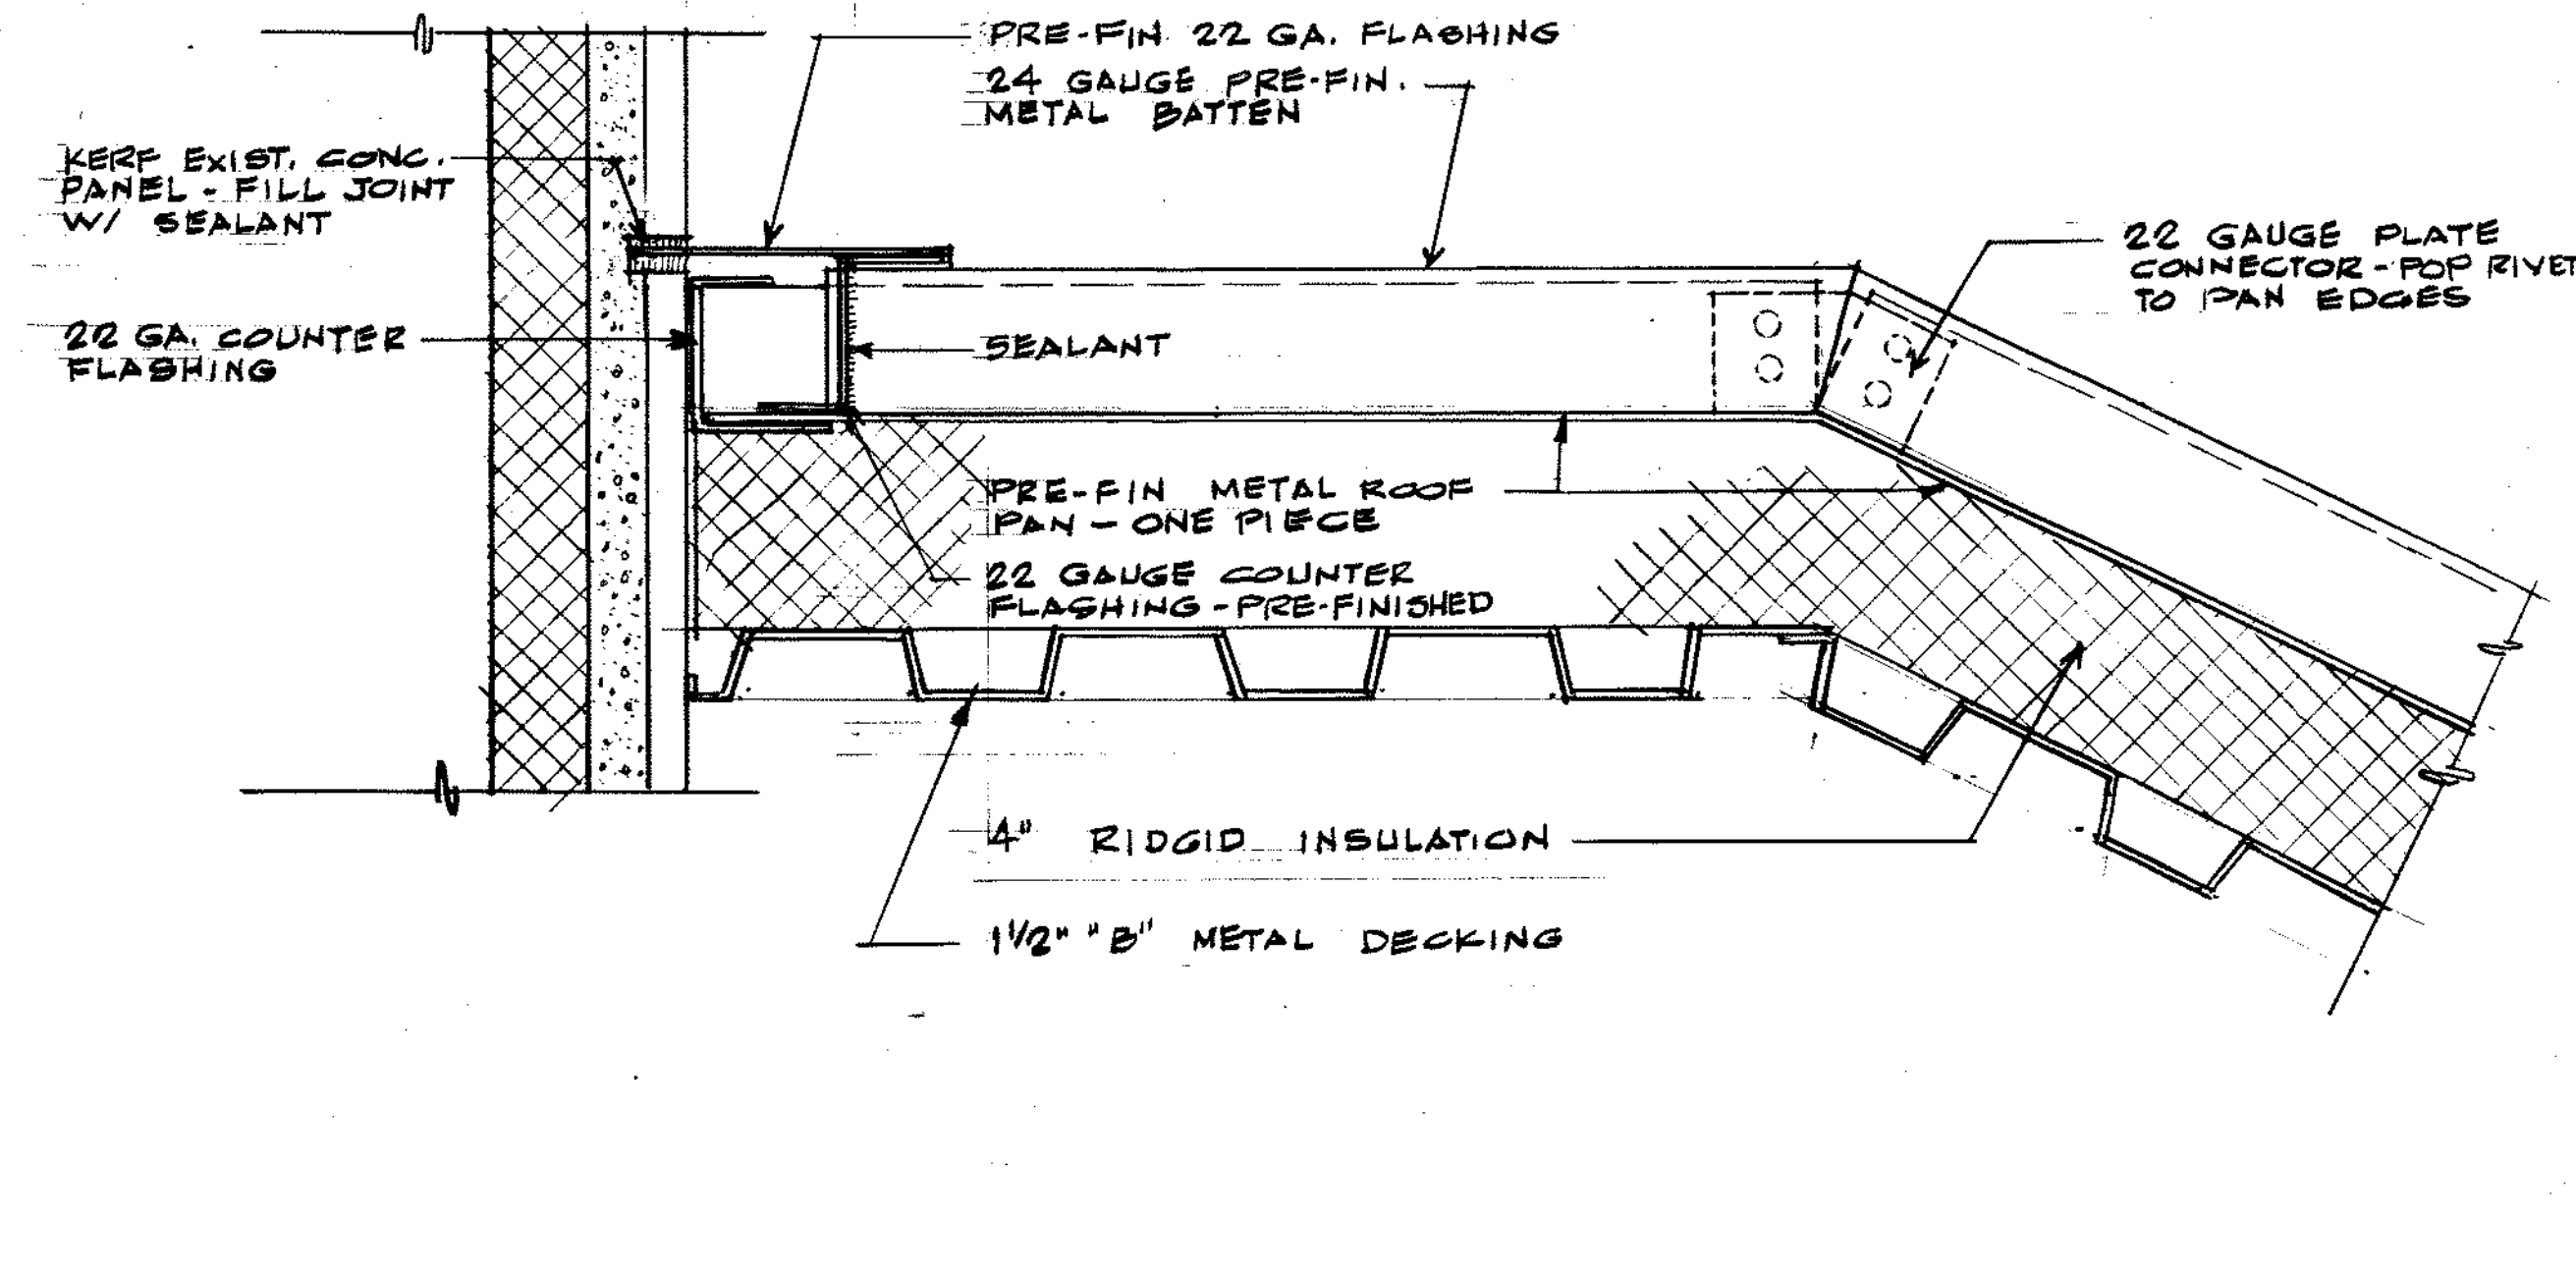

5 ROOF @ EXISTING WALL
SCALE: 3" = 1'-0"

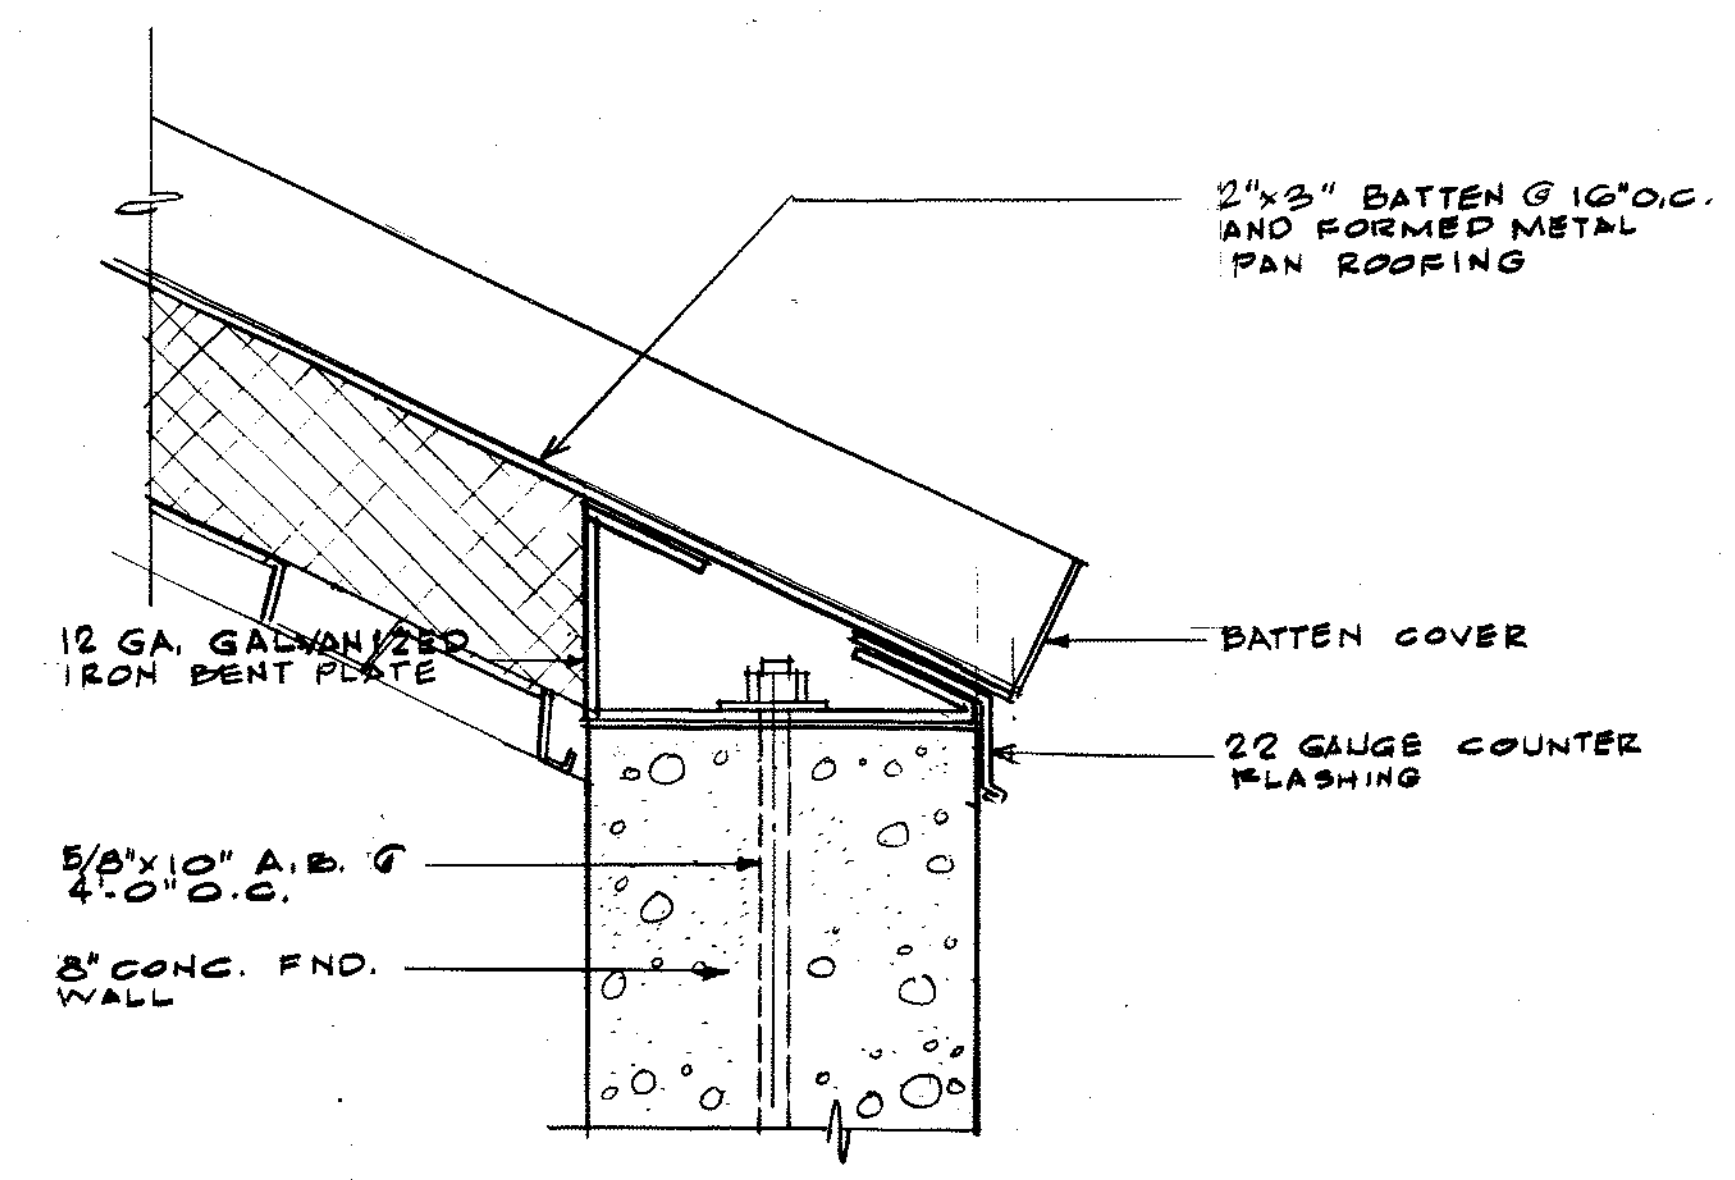


4 EAVE
SCALE: 3" = 1'-0"

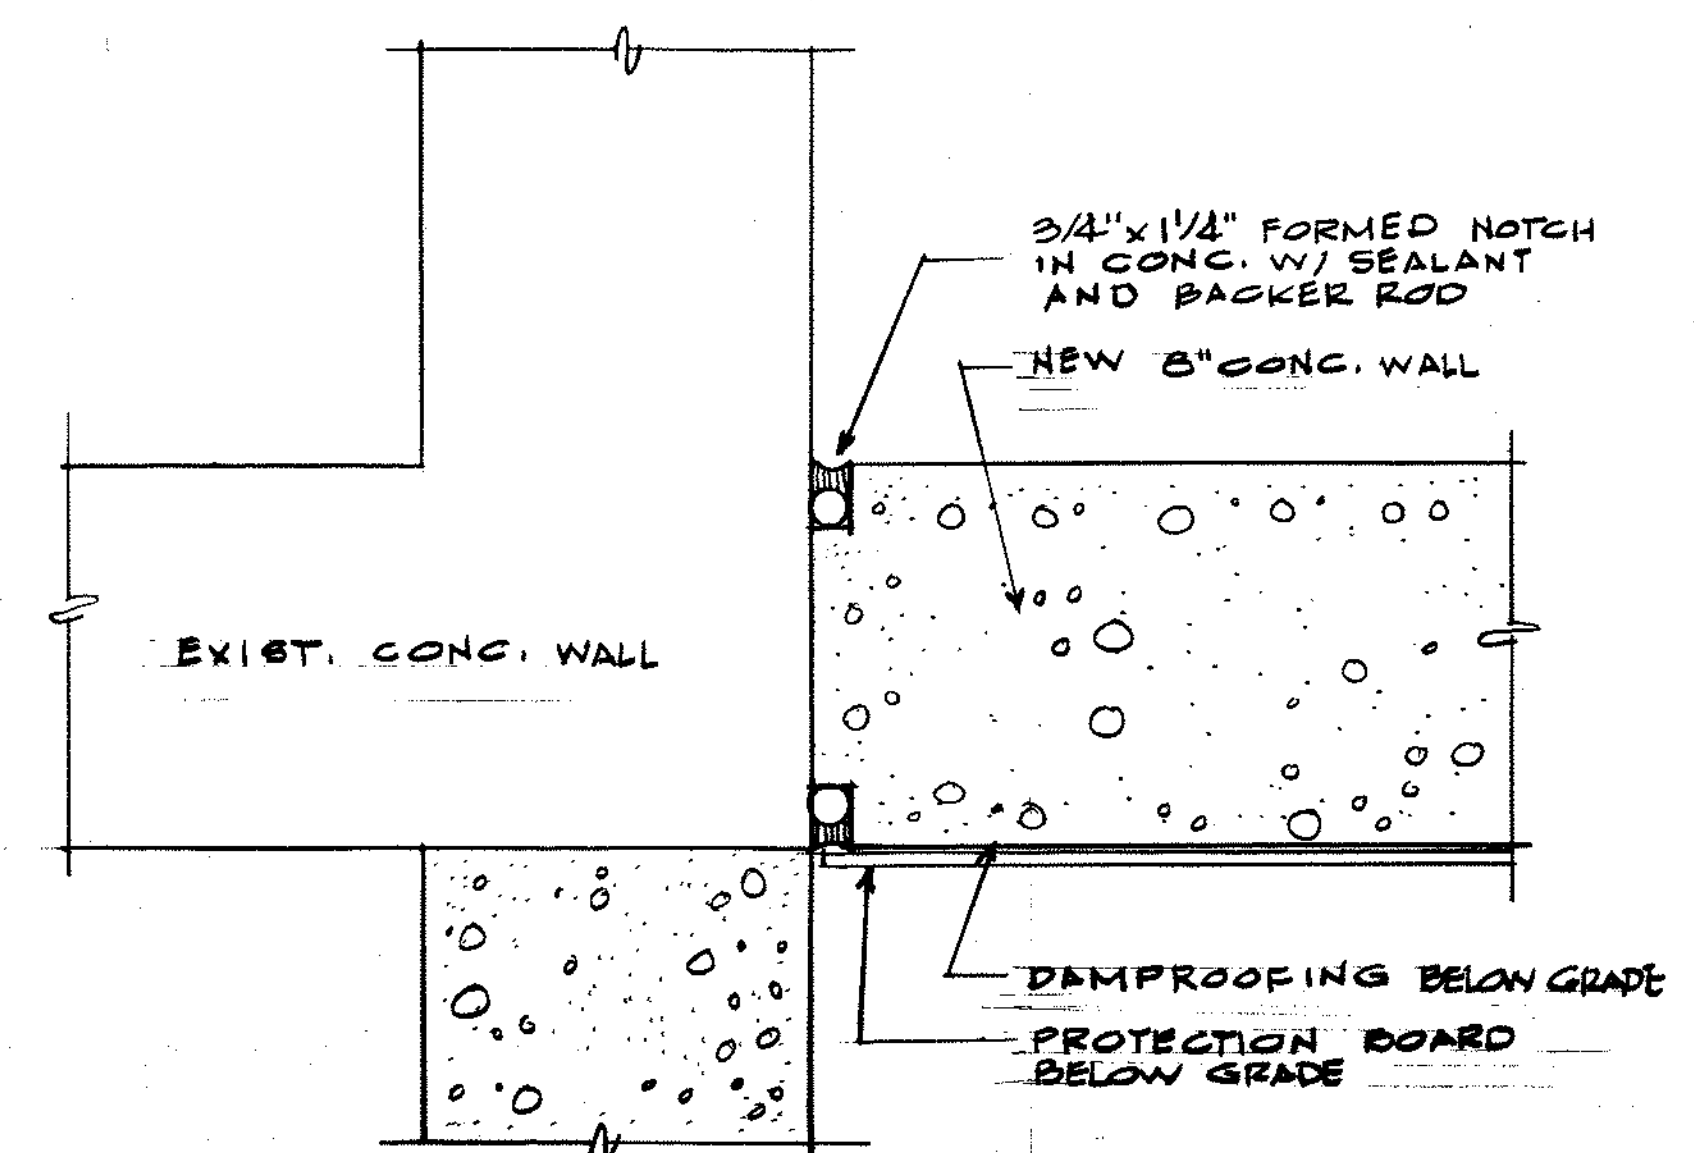


7 CONC. JUNCTURE
SCALE: 3" = 1'-0"

miller-cook architects a.i.a.
 30 N.W. 7th Ave.
 PORTLAND, OREGON 97208
 (503) 266-0822
 57208
 REGISTERED ARCHITECTS
 JACK C. MILLER
 W.C. MILLER
 PORTLAND, OREGON 97208
 STATE OF OREGON
 SHEET TITLE:
**C-130 FUEL SYSTEM / CORROSION CONTROL
 MAINTENANCE HANGAR
 304th AIR RESCUE RECOVERY SQUADRON
 PORTLAND INTERNATIONAL AIRPORT**
 DATE: MARCH 11, 1987
 JOB NO: 84-125-24
 REVISIONS: AS BUILT 11-16-87
A16
 RECORD DRAWINGS FROM
 INFORMATION SUPPLIED BY
 THE GENERAL CONTRACTOR
 BLDG 375

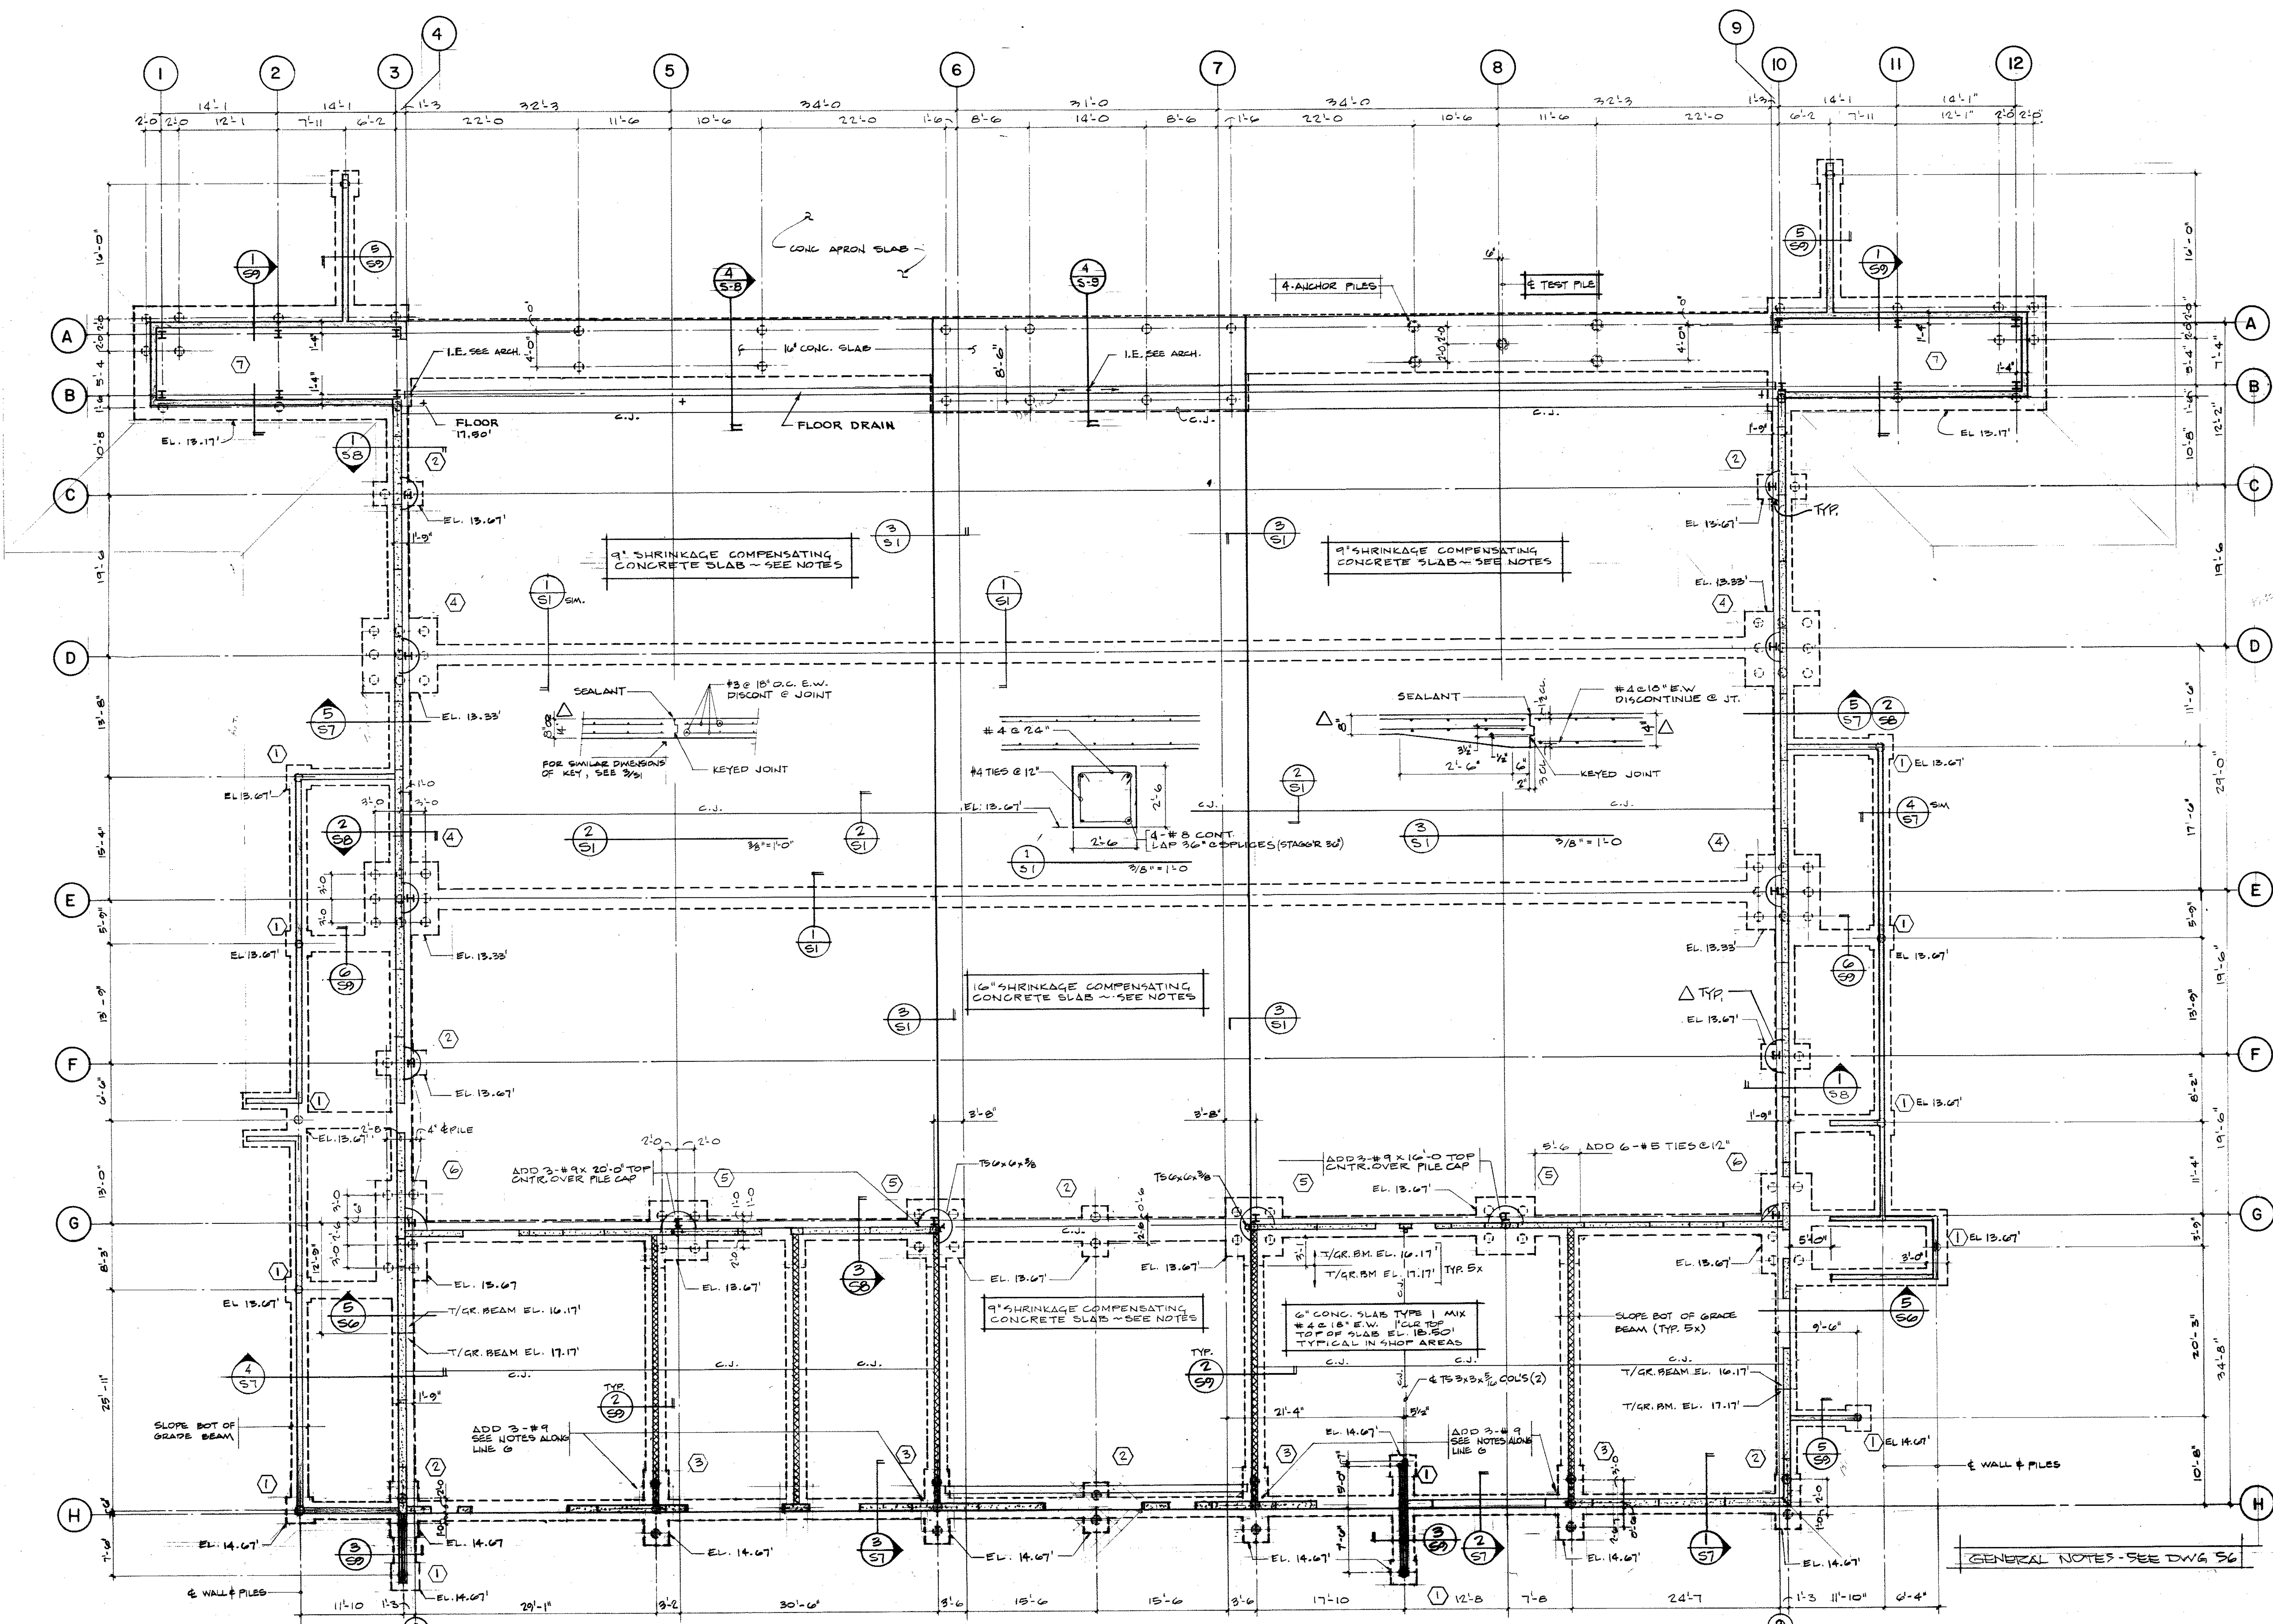

FILE CAP SCHEDULE


TYPE	SIZE: LxWxD	REINFORCING BOTTOM E.L. @	FILE ANCHORAGE	COL. BASE DET.	REMARKS
①	3'-0" x 3'-0" x 2'-6"	4-#6 x 2'-8" E.W.	SEE 7/64	-	
②	6'-0" x 3'-0" x 2'-6"	4-#8 x 5'-8" LONG 4-#4 x 2'-8" TRANS	SEE 7/64	SEE 1/68	
③	9'-0" x 4'-0" x 2'-6"	5-#8 x 8'-8" LONG 8-#4 x 2'-8" TRANS	SEE 7/64	-	
④	9'-0" x 9'-0" x 2'-9"	11-#8 x 8'-8" E.W. BOT 11-#6 x 8'-8" E.W. TOP	SEE 6/64	SEE 5/64	
⑤	7'-0" x 7'-0" x 2'-6"	3-#8 x 5'-8" E.W. BOT 3-#4 x 2'-8" E.W. TOP	SEE 6/64	SEE 2/611	
⑥	12'-0" x 6'-0" x 2'-6"	6-#6 x 11'-8" LONG 11-#4 x 5'-8" TRANS	SEE 7/64	SEE 1/68	
⑦	33'-2" x 13'-10" x 3'-0"	SEE SECTION 1/68	SEE 4/64	4 COLS - 2/611 PA1, A2, A3, A4, A12, B12 2 COLS - 1/68 EB2, B5, B10, B11	

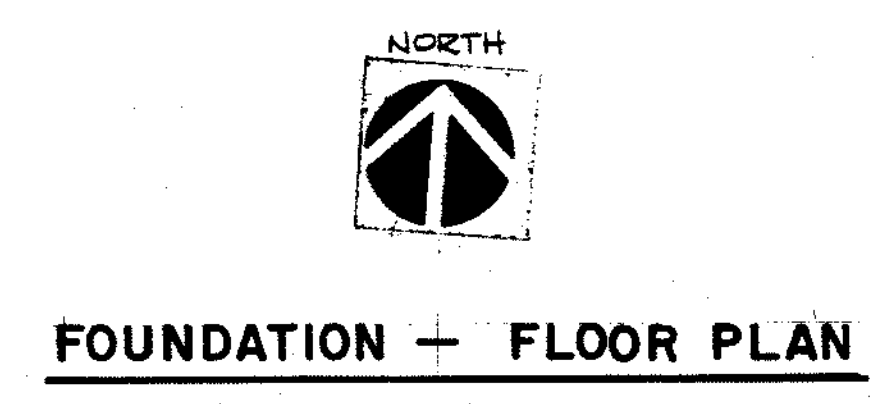







- PLAN NOTES:**
- ELEVATIONS SHOWN ARE BOTTOM OF FOOTING, FILE CAP OR GRADE BEAM UNLESS NOTED OTHERWISE
 - 10" SLABS SHALL BE REINFORCED W/ #4 @ 18" E.W. 1/4" CLR TOP & #4 @ 18" E.W. 3" CLR BOT. SEE SPECS FOR MIX TYPE.
 - 9" SLABS SHALL BE REINFORCED W/ #3 @ 18" E.W. 1/4" CLR TOP & #3 @ 18" E.W. 3" CLR BOT. SEE SPECS FOR MIX TYPE.
 - ALL 9" & 10" APRON SLABS TO BE TYPE 1 CONCRETE MIX. SEE SPECS.
 - SEE ARCHITECTURAL DRAWINGS FOR FLOOR SLOPES.

RECORD DRAWINGS FROM INFORMATION SUPPLIED BY THE GENERAL CONTRACTOR

REGISTERED PROFESSIONAL ENGINEER
 4326
 James M. Johnson
 1100 N. W. 10th St.
 PORTLAND, OREGON 97228
 1-2-76

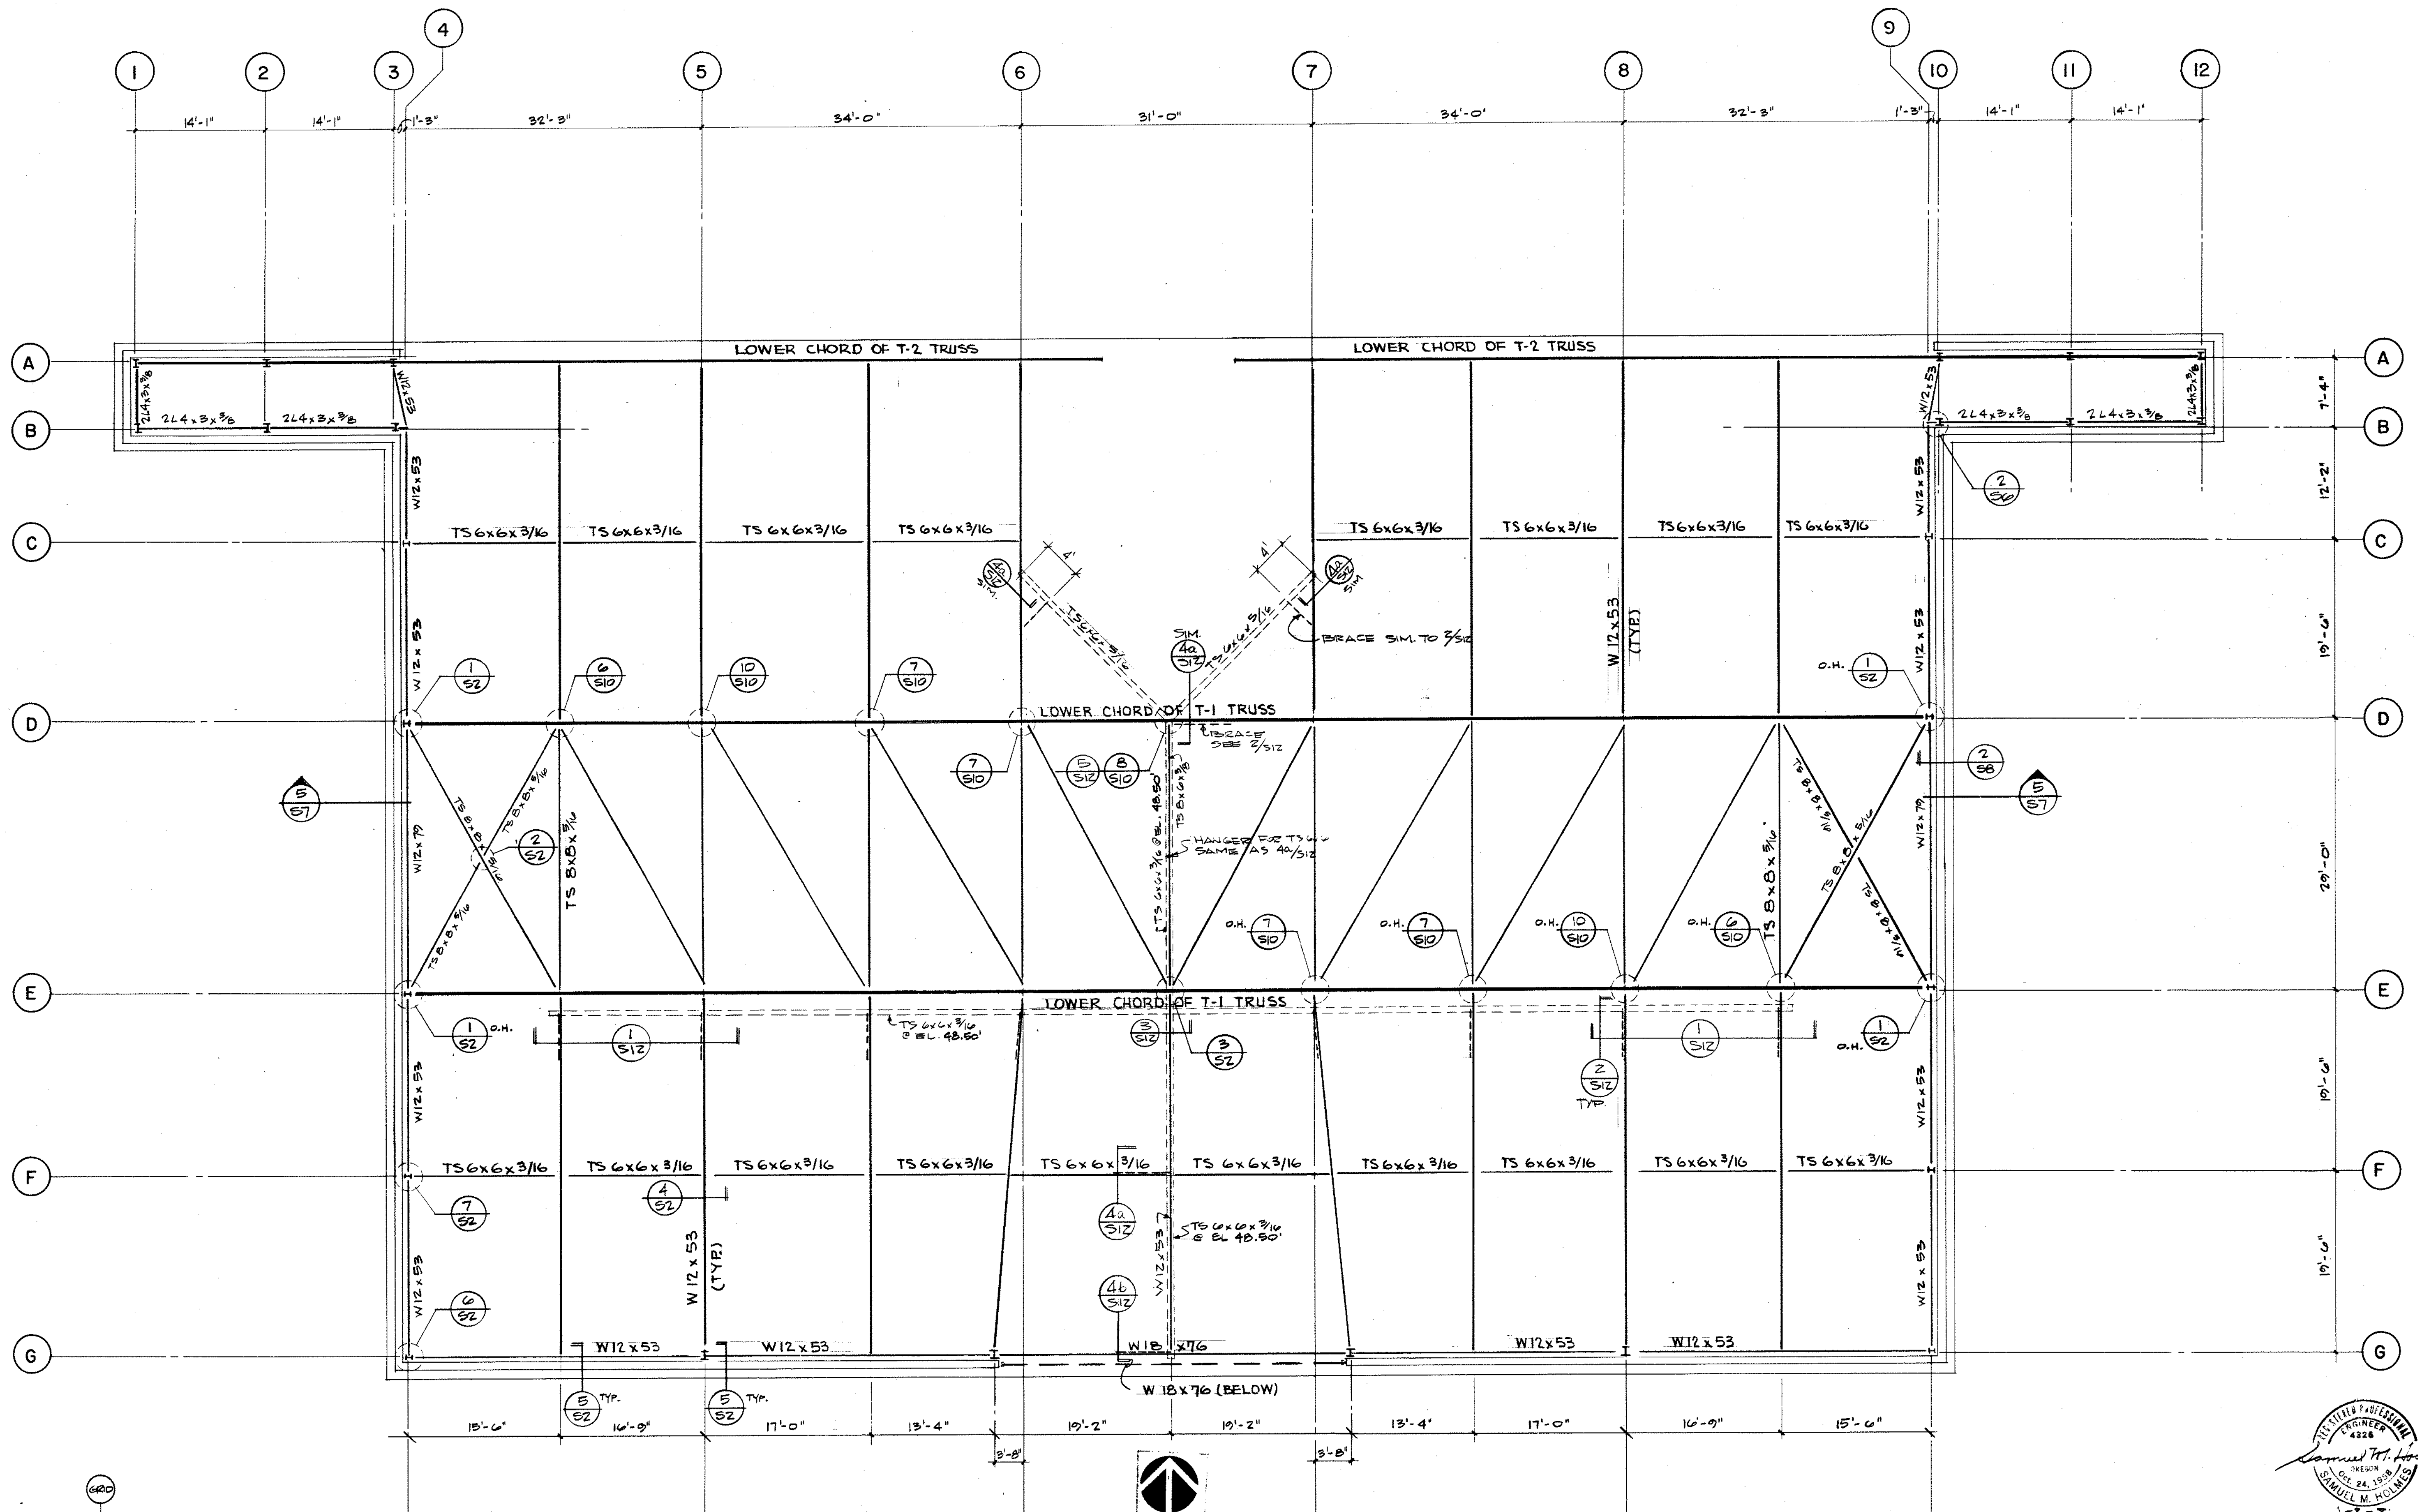

LOWER CHORD BRACING
1/8" = 1'-0"

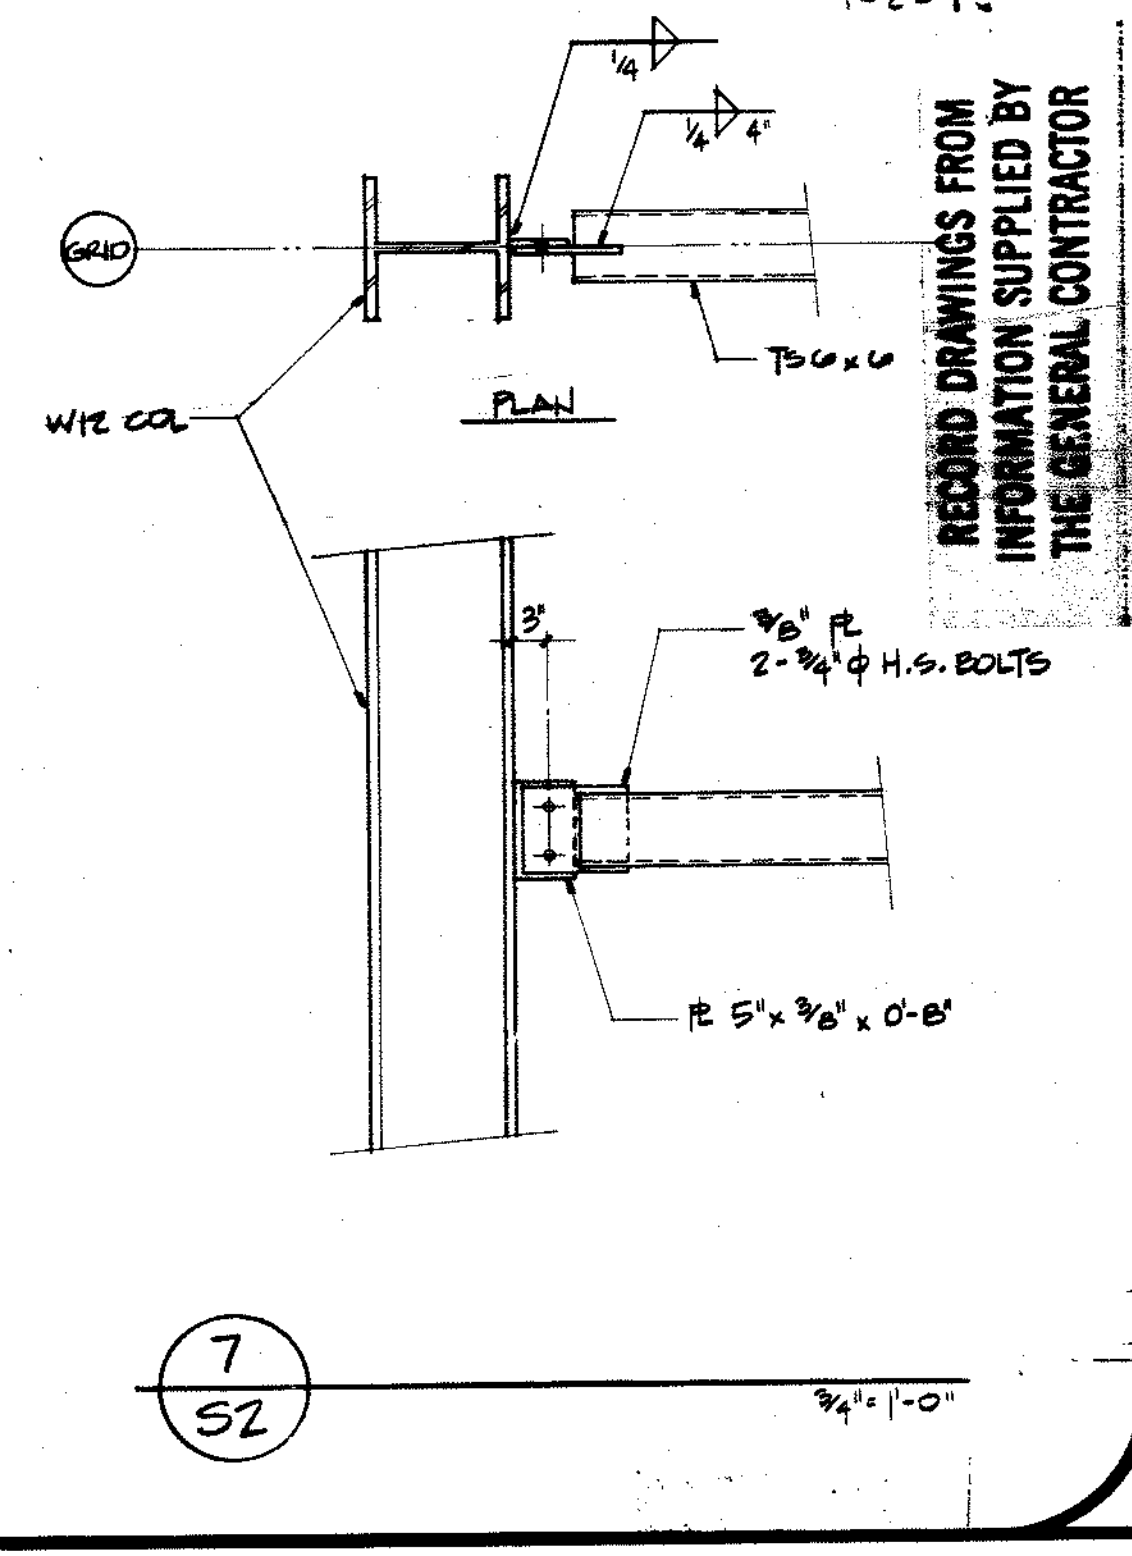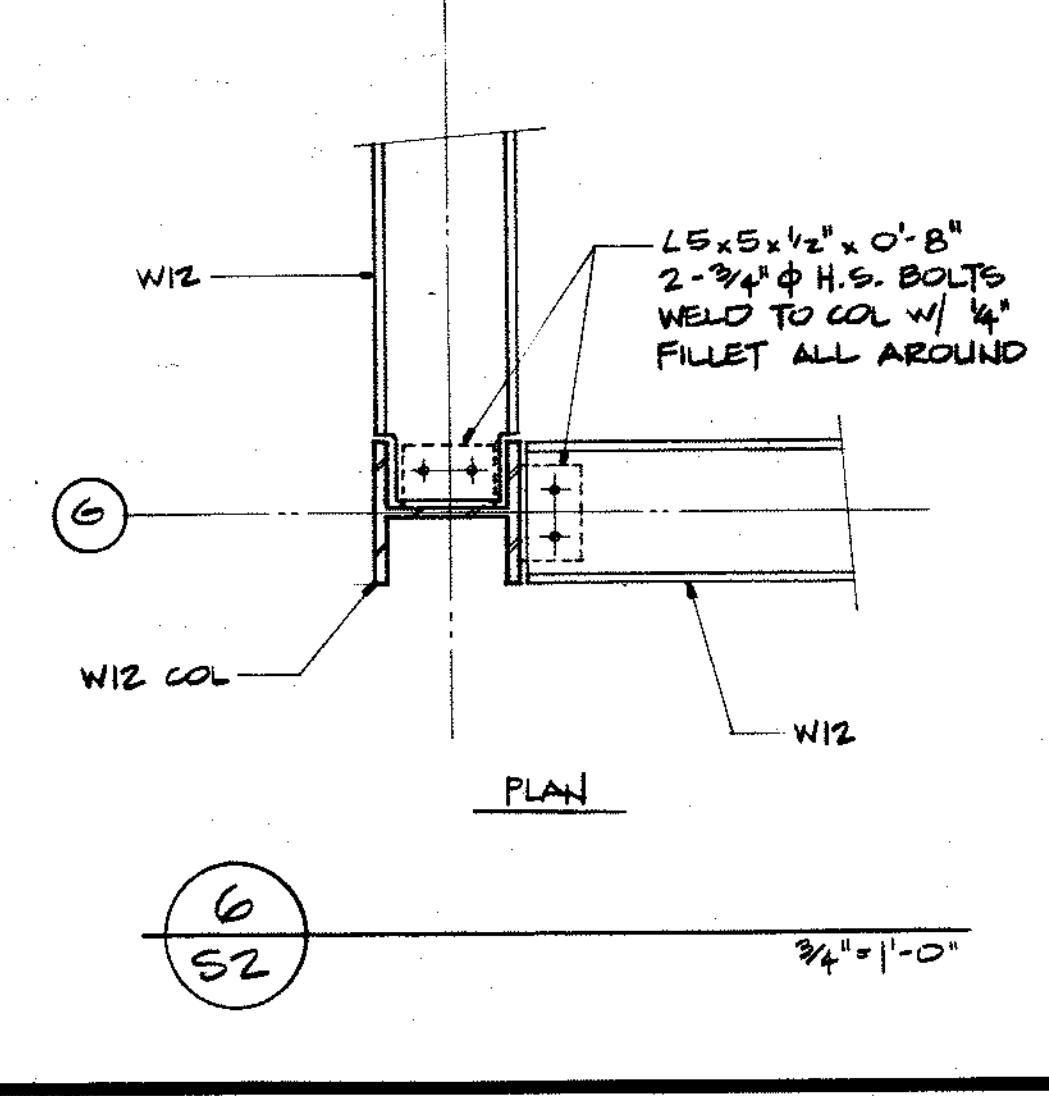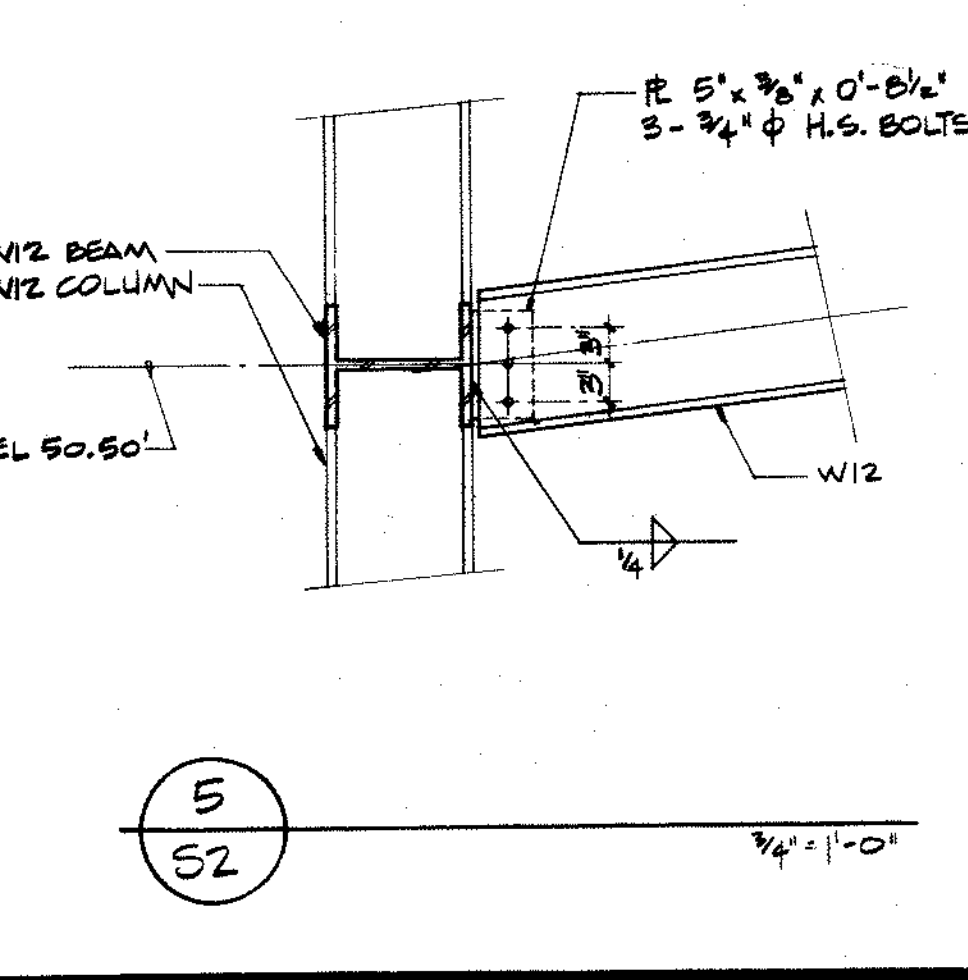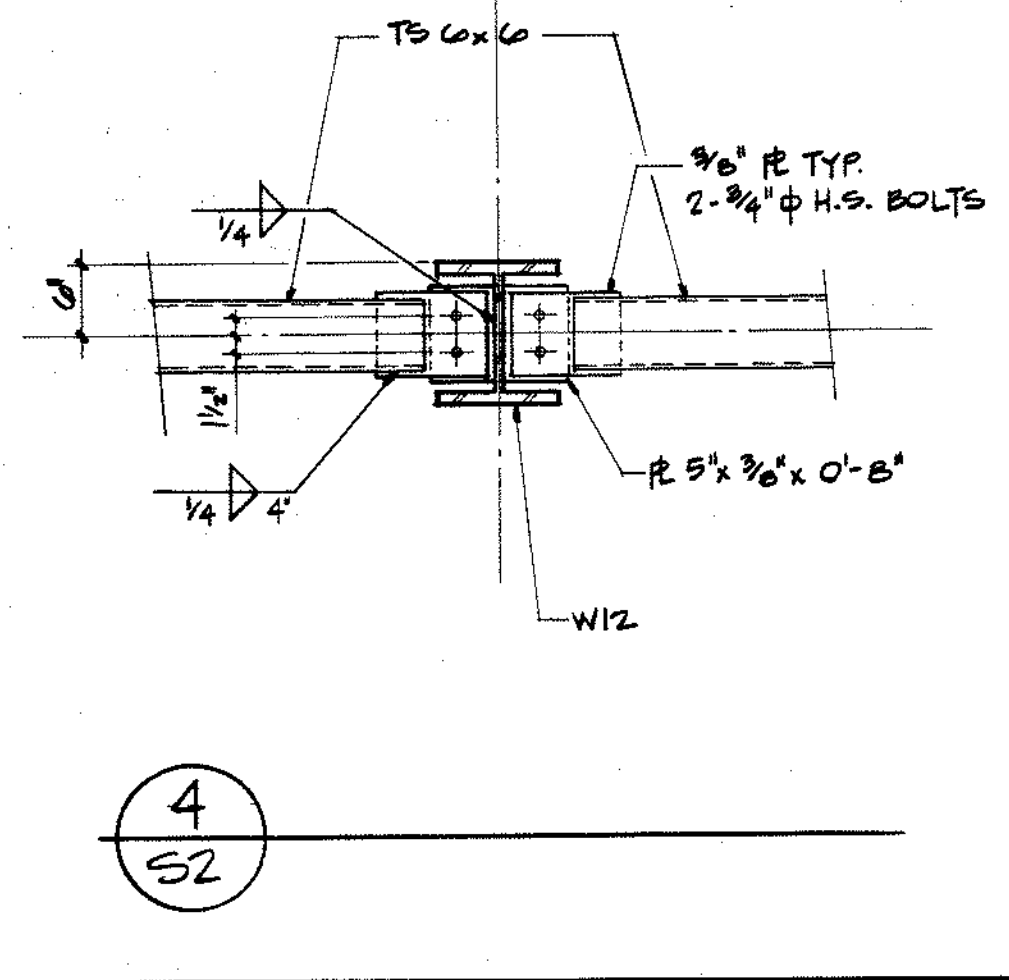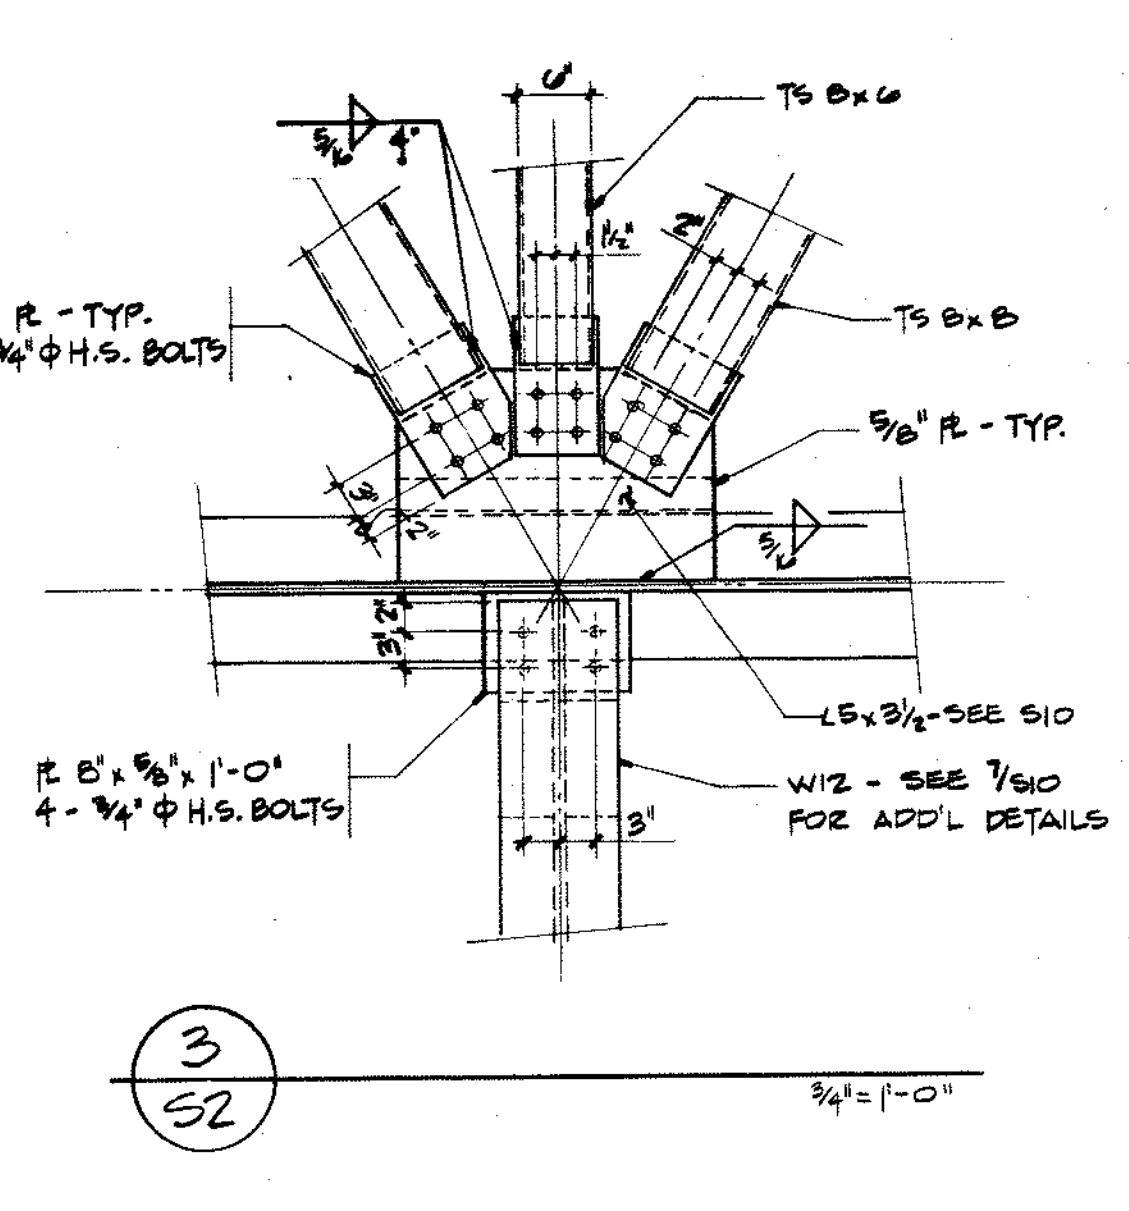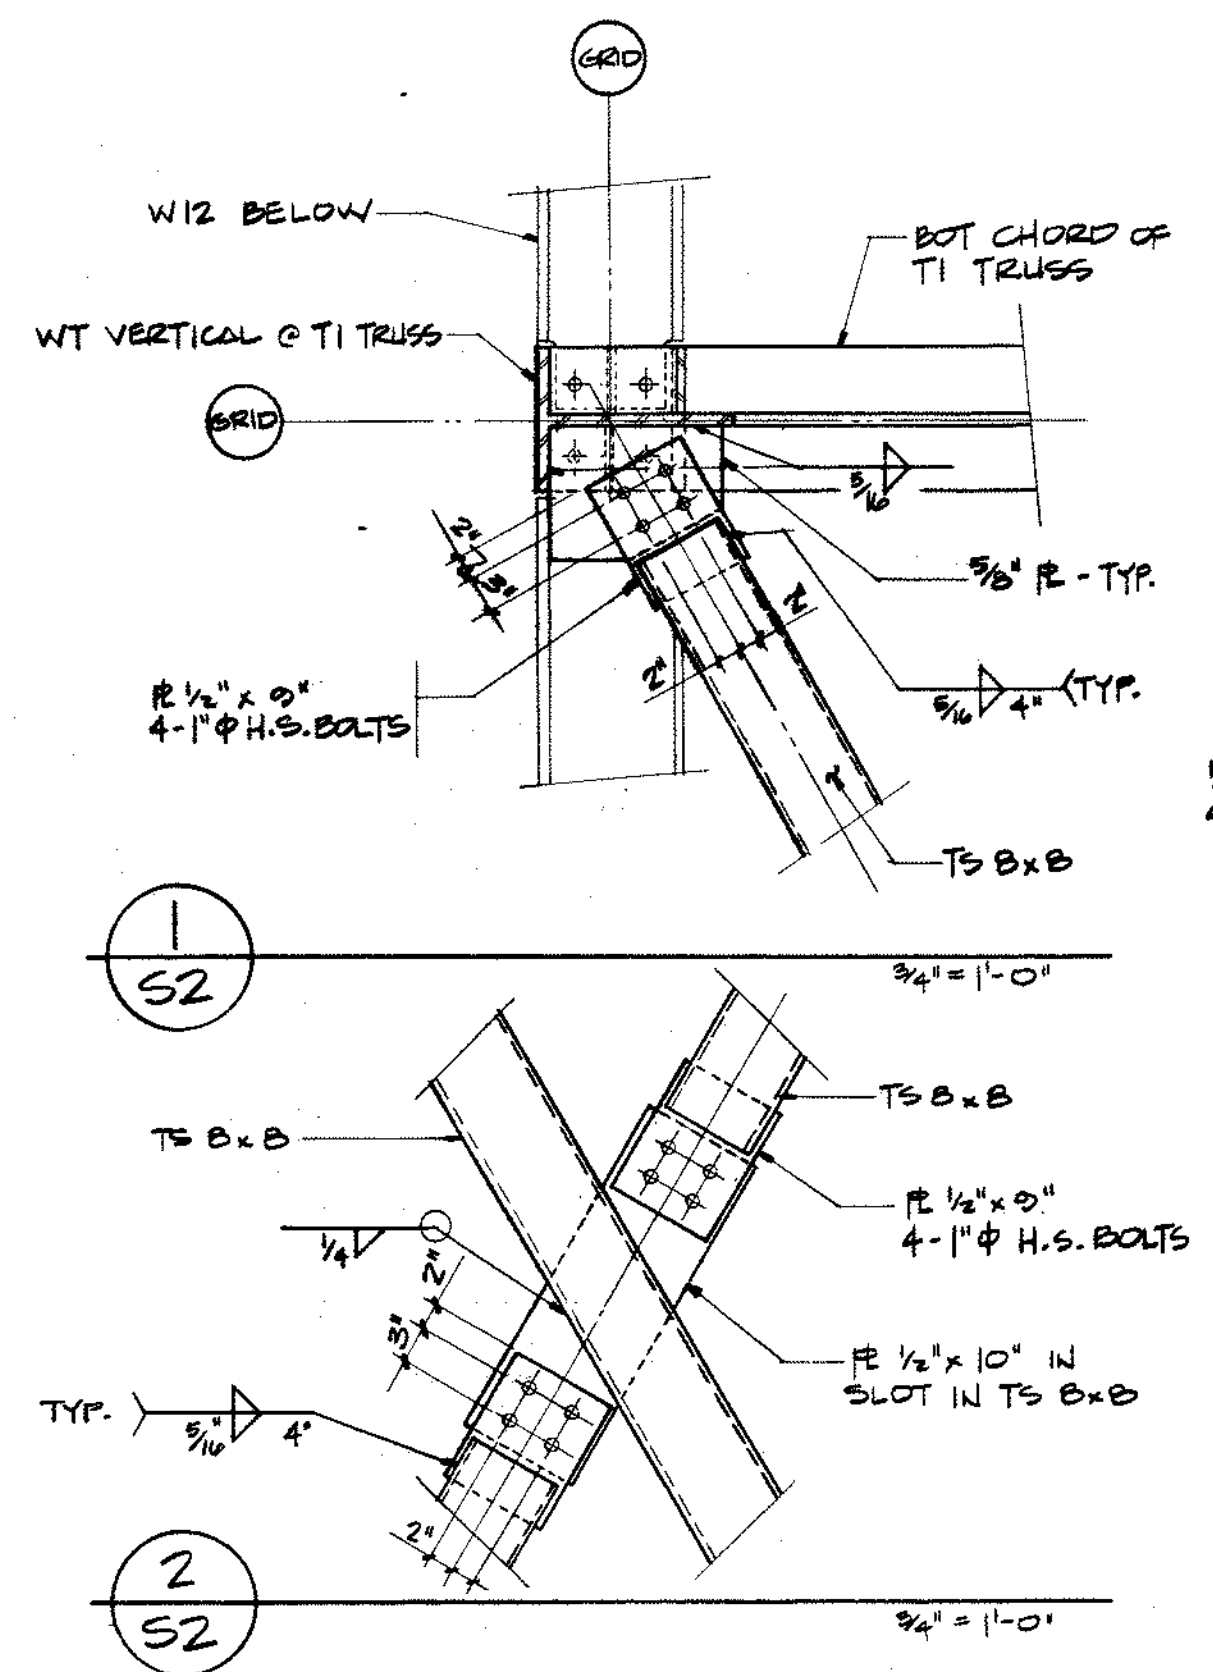

RECORD DRAWINGS FROM INFORMATION SUPPLIED BY THE GENERAL CONTRACTOR



SHEET TITLE: LOWER CHORD BRACING PLAN
C-130 FUEL SYSTEM / CORROSION CONTROL MAINTENANCE HANGAR
304TH AIR RESCUE RECOVERY SQUADRON
PORTLAND INTERNATIONAL AIRPORT
 PORTLAND OREGON

DATE: FEB. 20, 1980
 JOB NO: 84-105
 REVISIONS:

REGISTERED ARCHITECT
 JACK C. MILLER
 PORTLAND OREGON 1984
 STATE OF OREGON

miller-cook architects a.i.a.
 30 N.W. 11th AVE.
 PORTLAND, OREGON
 (503) 226-0882
 97205

S-2

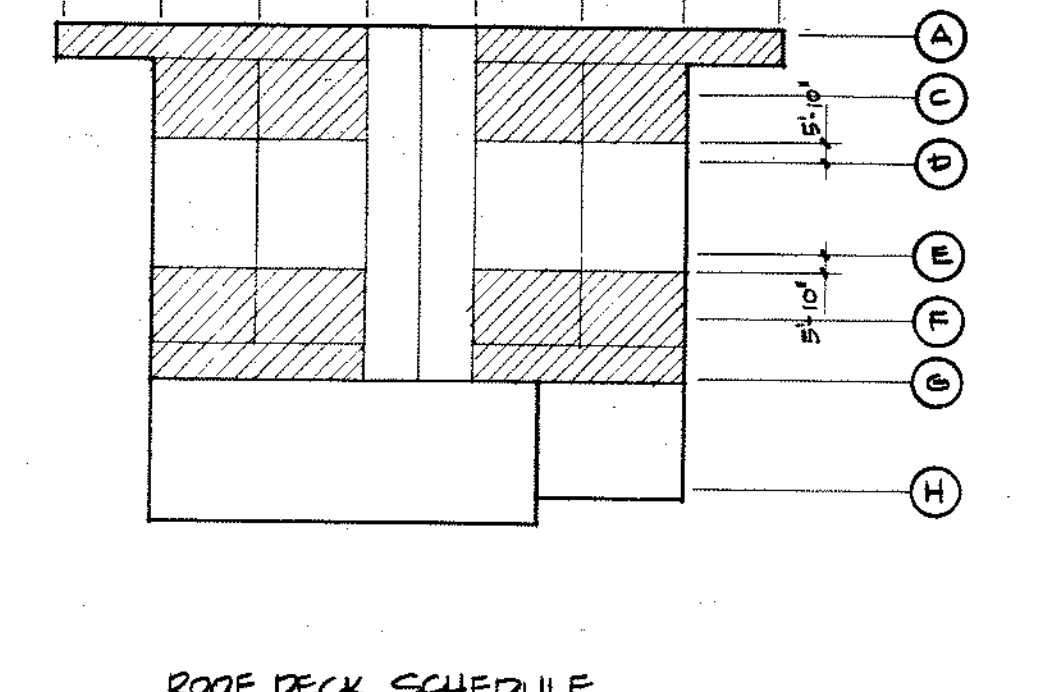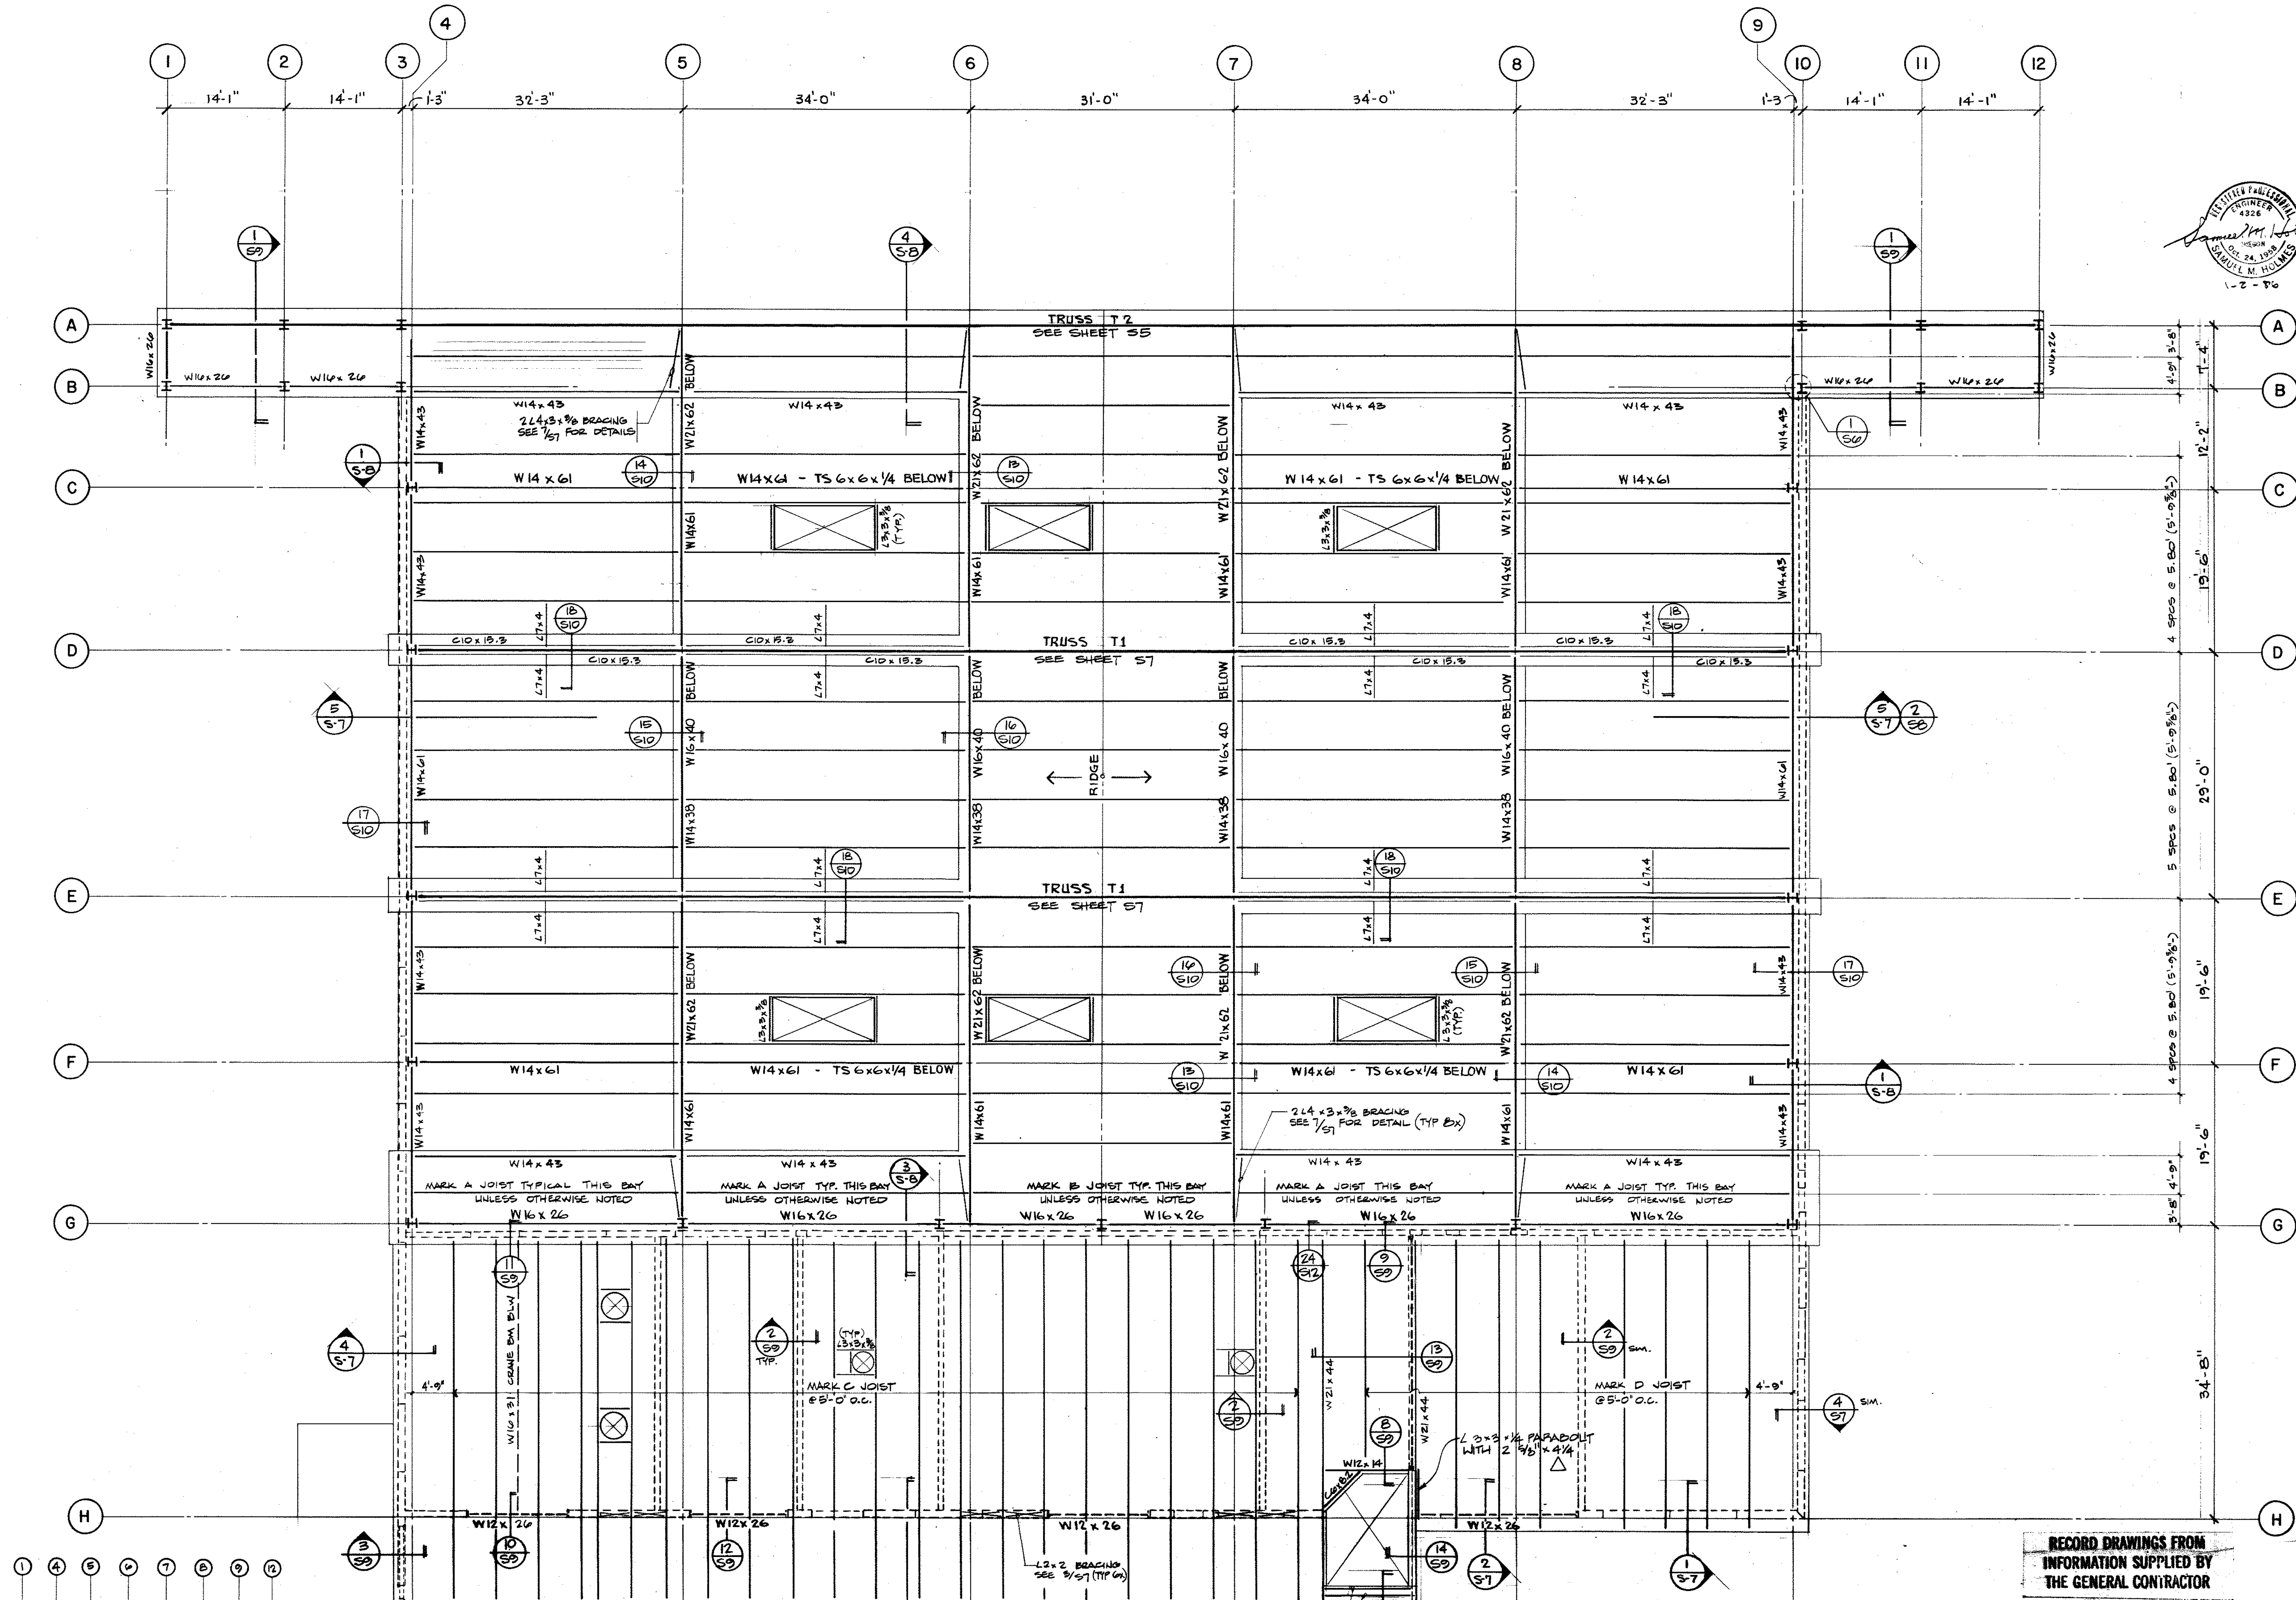

- 20 GA HSB-24 ACoustical DECKING
SEE NOTES FOR WELDING
- 18 GA HSB-24 ACoustical DECKING
SEE NOTES FOR WELDING

ROOF FRAMING PLAN
1/8" = 1'-0"

OPEN WEB STEEL JOIST SCHEDULE					
MARK	DEPTH	BEARING HEIGHT	HEAD LOAD	LIVE LOAD	LIFT (NET)
A (5x)	24" PARALLEL CHORD W/ MIN. MOM. CAP'Y = 30.3K' AND MIN. END SHEAR = 5.0K'	8" AT UPPER END 6" @ BEARING 8" AT LOWER END 6" @ BEARING	BB PLF	140 PLF	233 PLF
B (16x)	12" MIN. DEPTH CHORD 2x4 - FITTED W/ MIN. MOM. CAP'Y = 28.3K' AND MIN. END SHEAR = 4.4K'	8" AT EACH END	BB PLF	140 PLF	233 PLF
C (22x)	24" PARALLEL CHORD W/ MIN. MOM. CAP'Y = 50.4K' AND MIN. END SHEAR = 6.0K'	8" AT UPPER END 6" AT LOWER END (B)	75 PLF	125 PLF	195 PLF
D (8x)	24" PARALLEL CHORD W/ MIN. MOM. CAP'Y = 50.4K' AND MIN. END SHEAR = 6.0K'	8" AT EACH END	75 PLF	125 PLF	195 PLF

RECORD DRAWINGS FROM
INFORMATION SUPPLIED BY
THE GENERAL CONTRACTOR

miller - cook architects a.i.a.
 30 N.W. 1st AVE.
 PORTLAND, OREGON 97208
 (503) 266-0882
 57005





SHEET TITLE: **2009 FRAMING PLAN**
C-130 FUEL SYSTEM / CORROSION CONTROL
MAINTENANCE HANGAR
304TH AIR RESCUE RECOVERY SQUADRON
PORTLAND INTERNATIONAL AIRPORT
 PORTLAND, OREGON

DATE: FEB. 26, 1980
 JOB NO: 84-125
 REVISIONS: 1-16-87
 2-1-87
 2-1-87

REGISTERED ARCHITECT
 MAX C. MILLER
 PORTLAND, OREGON
 1464
 STATE OF OREGON

S-3

BLDG 375

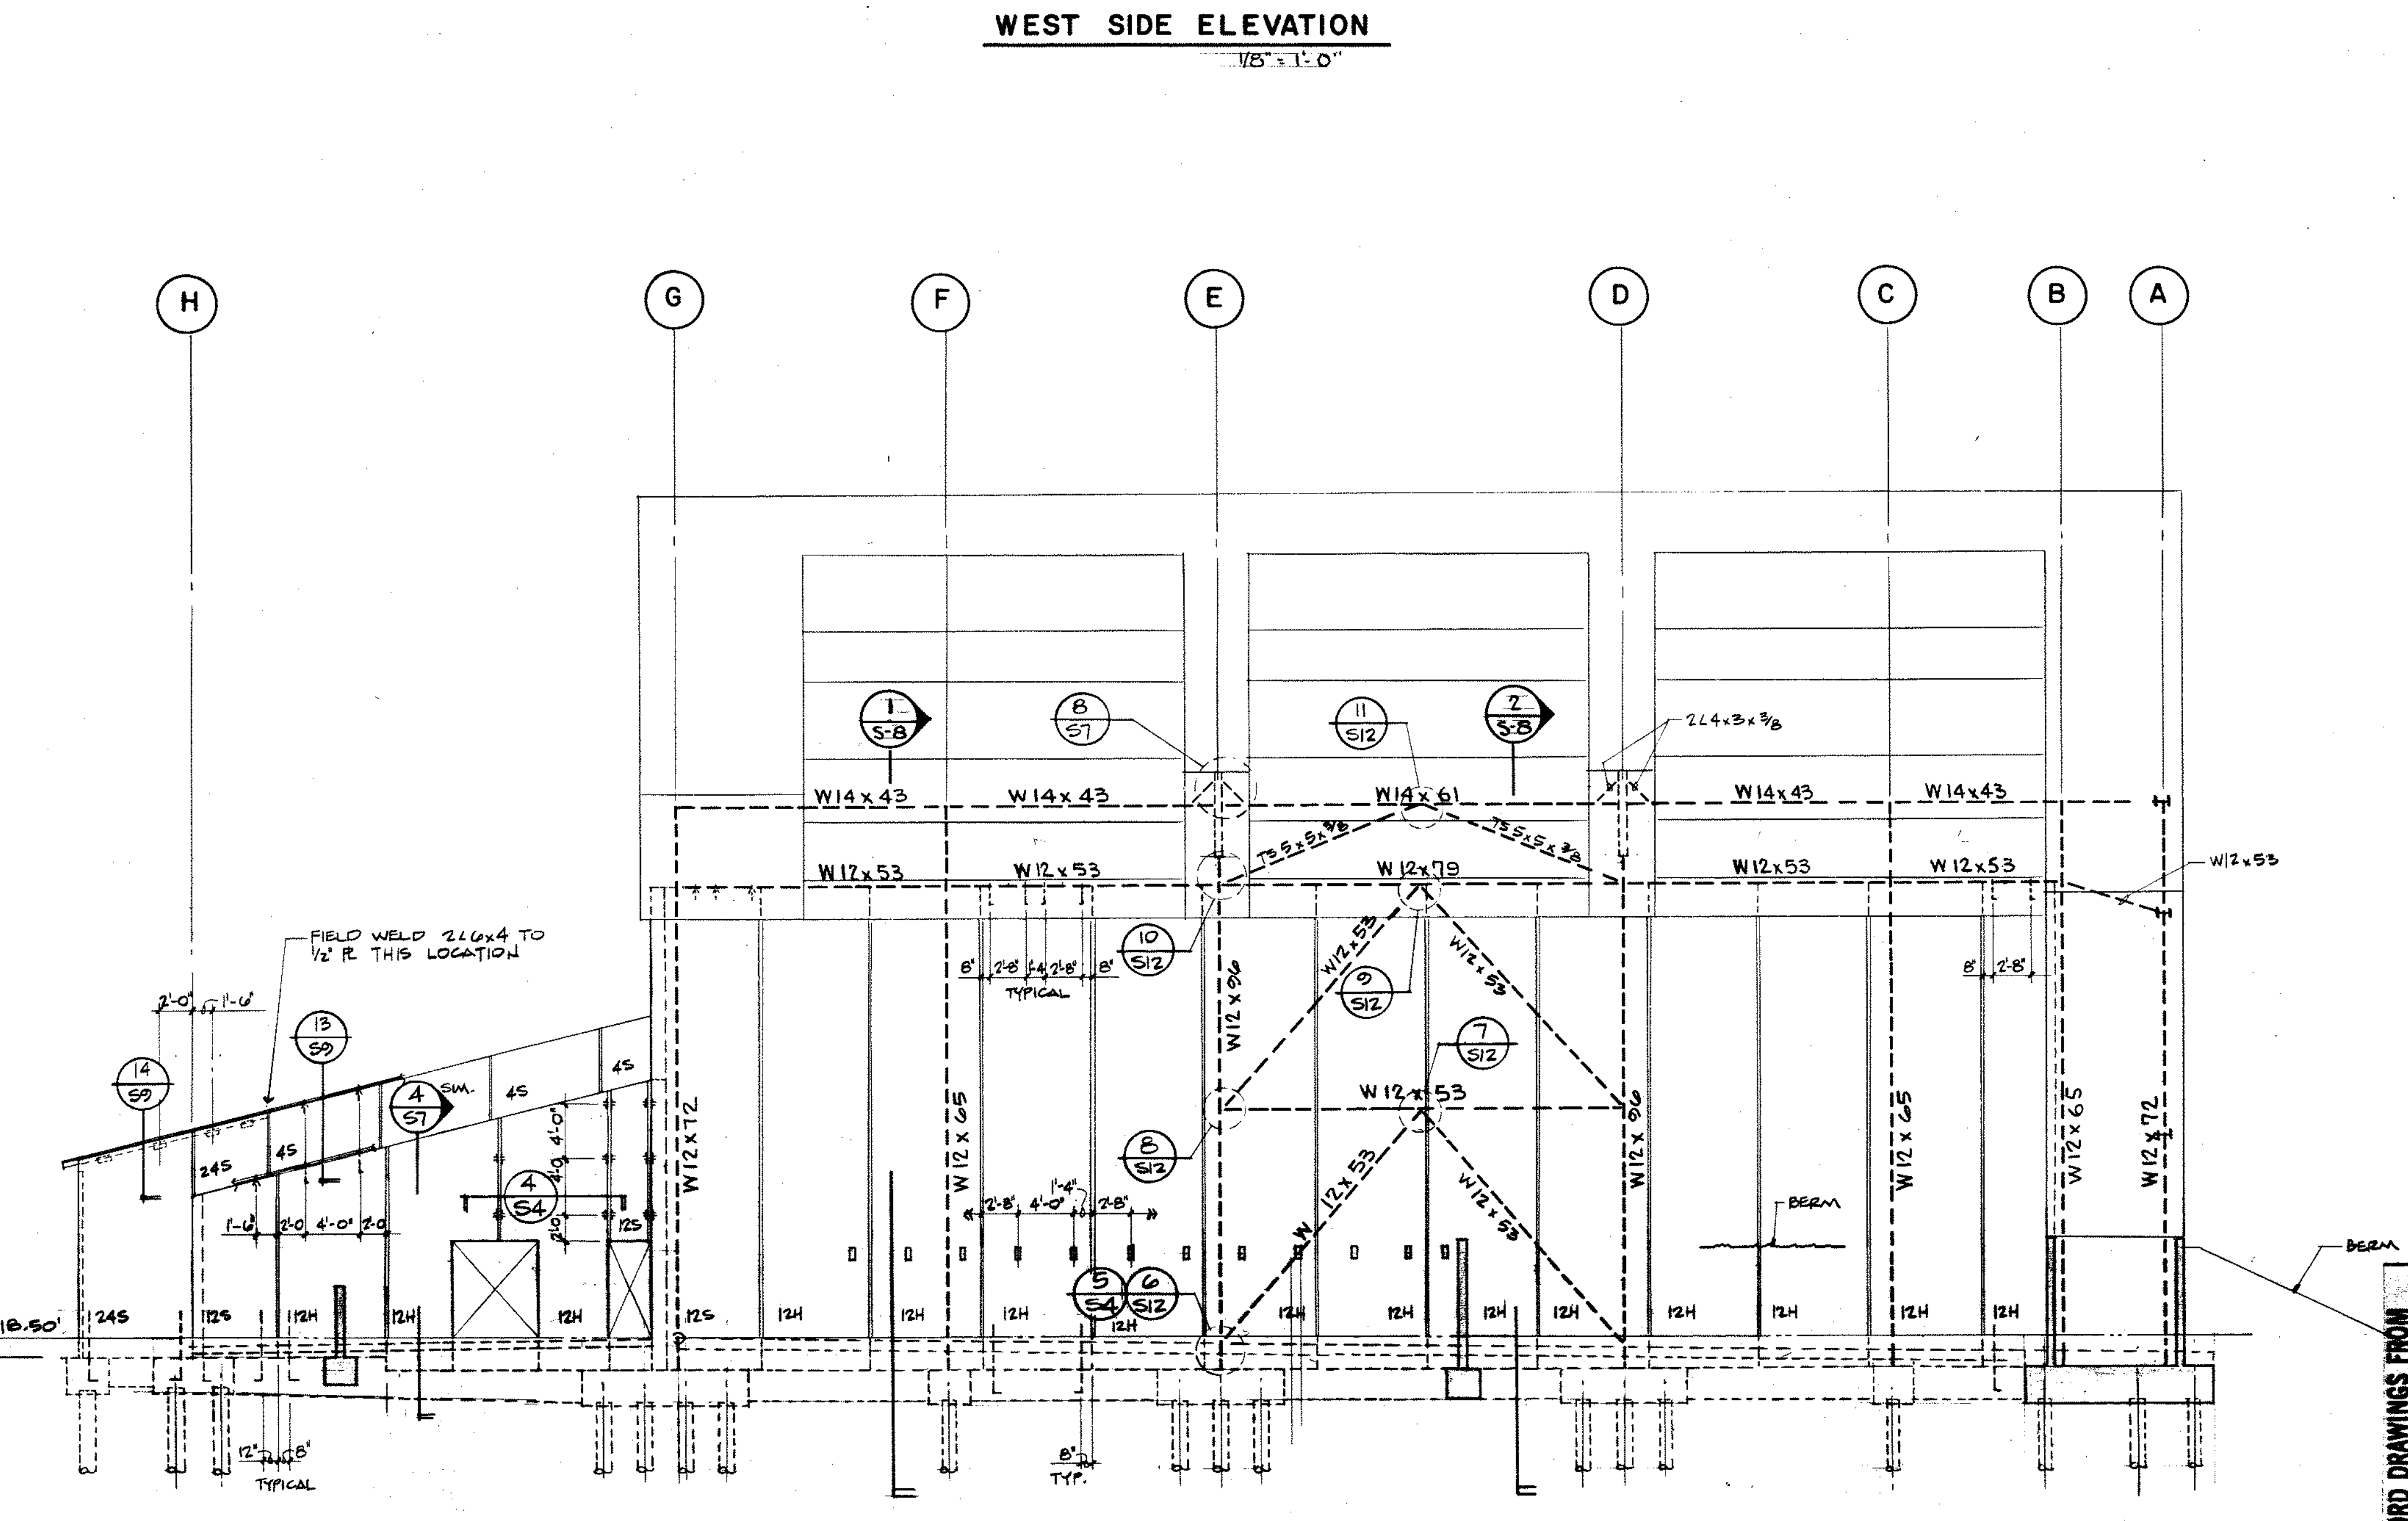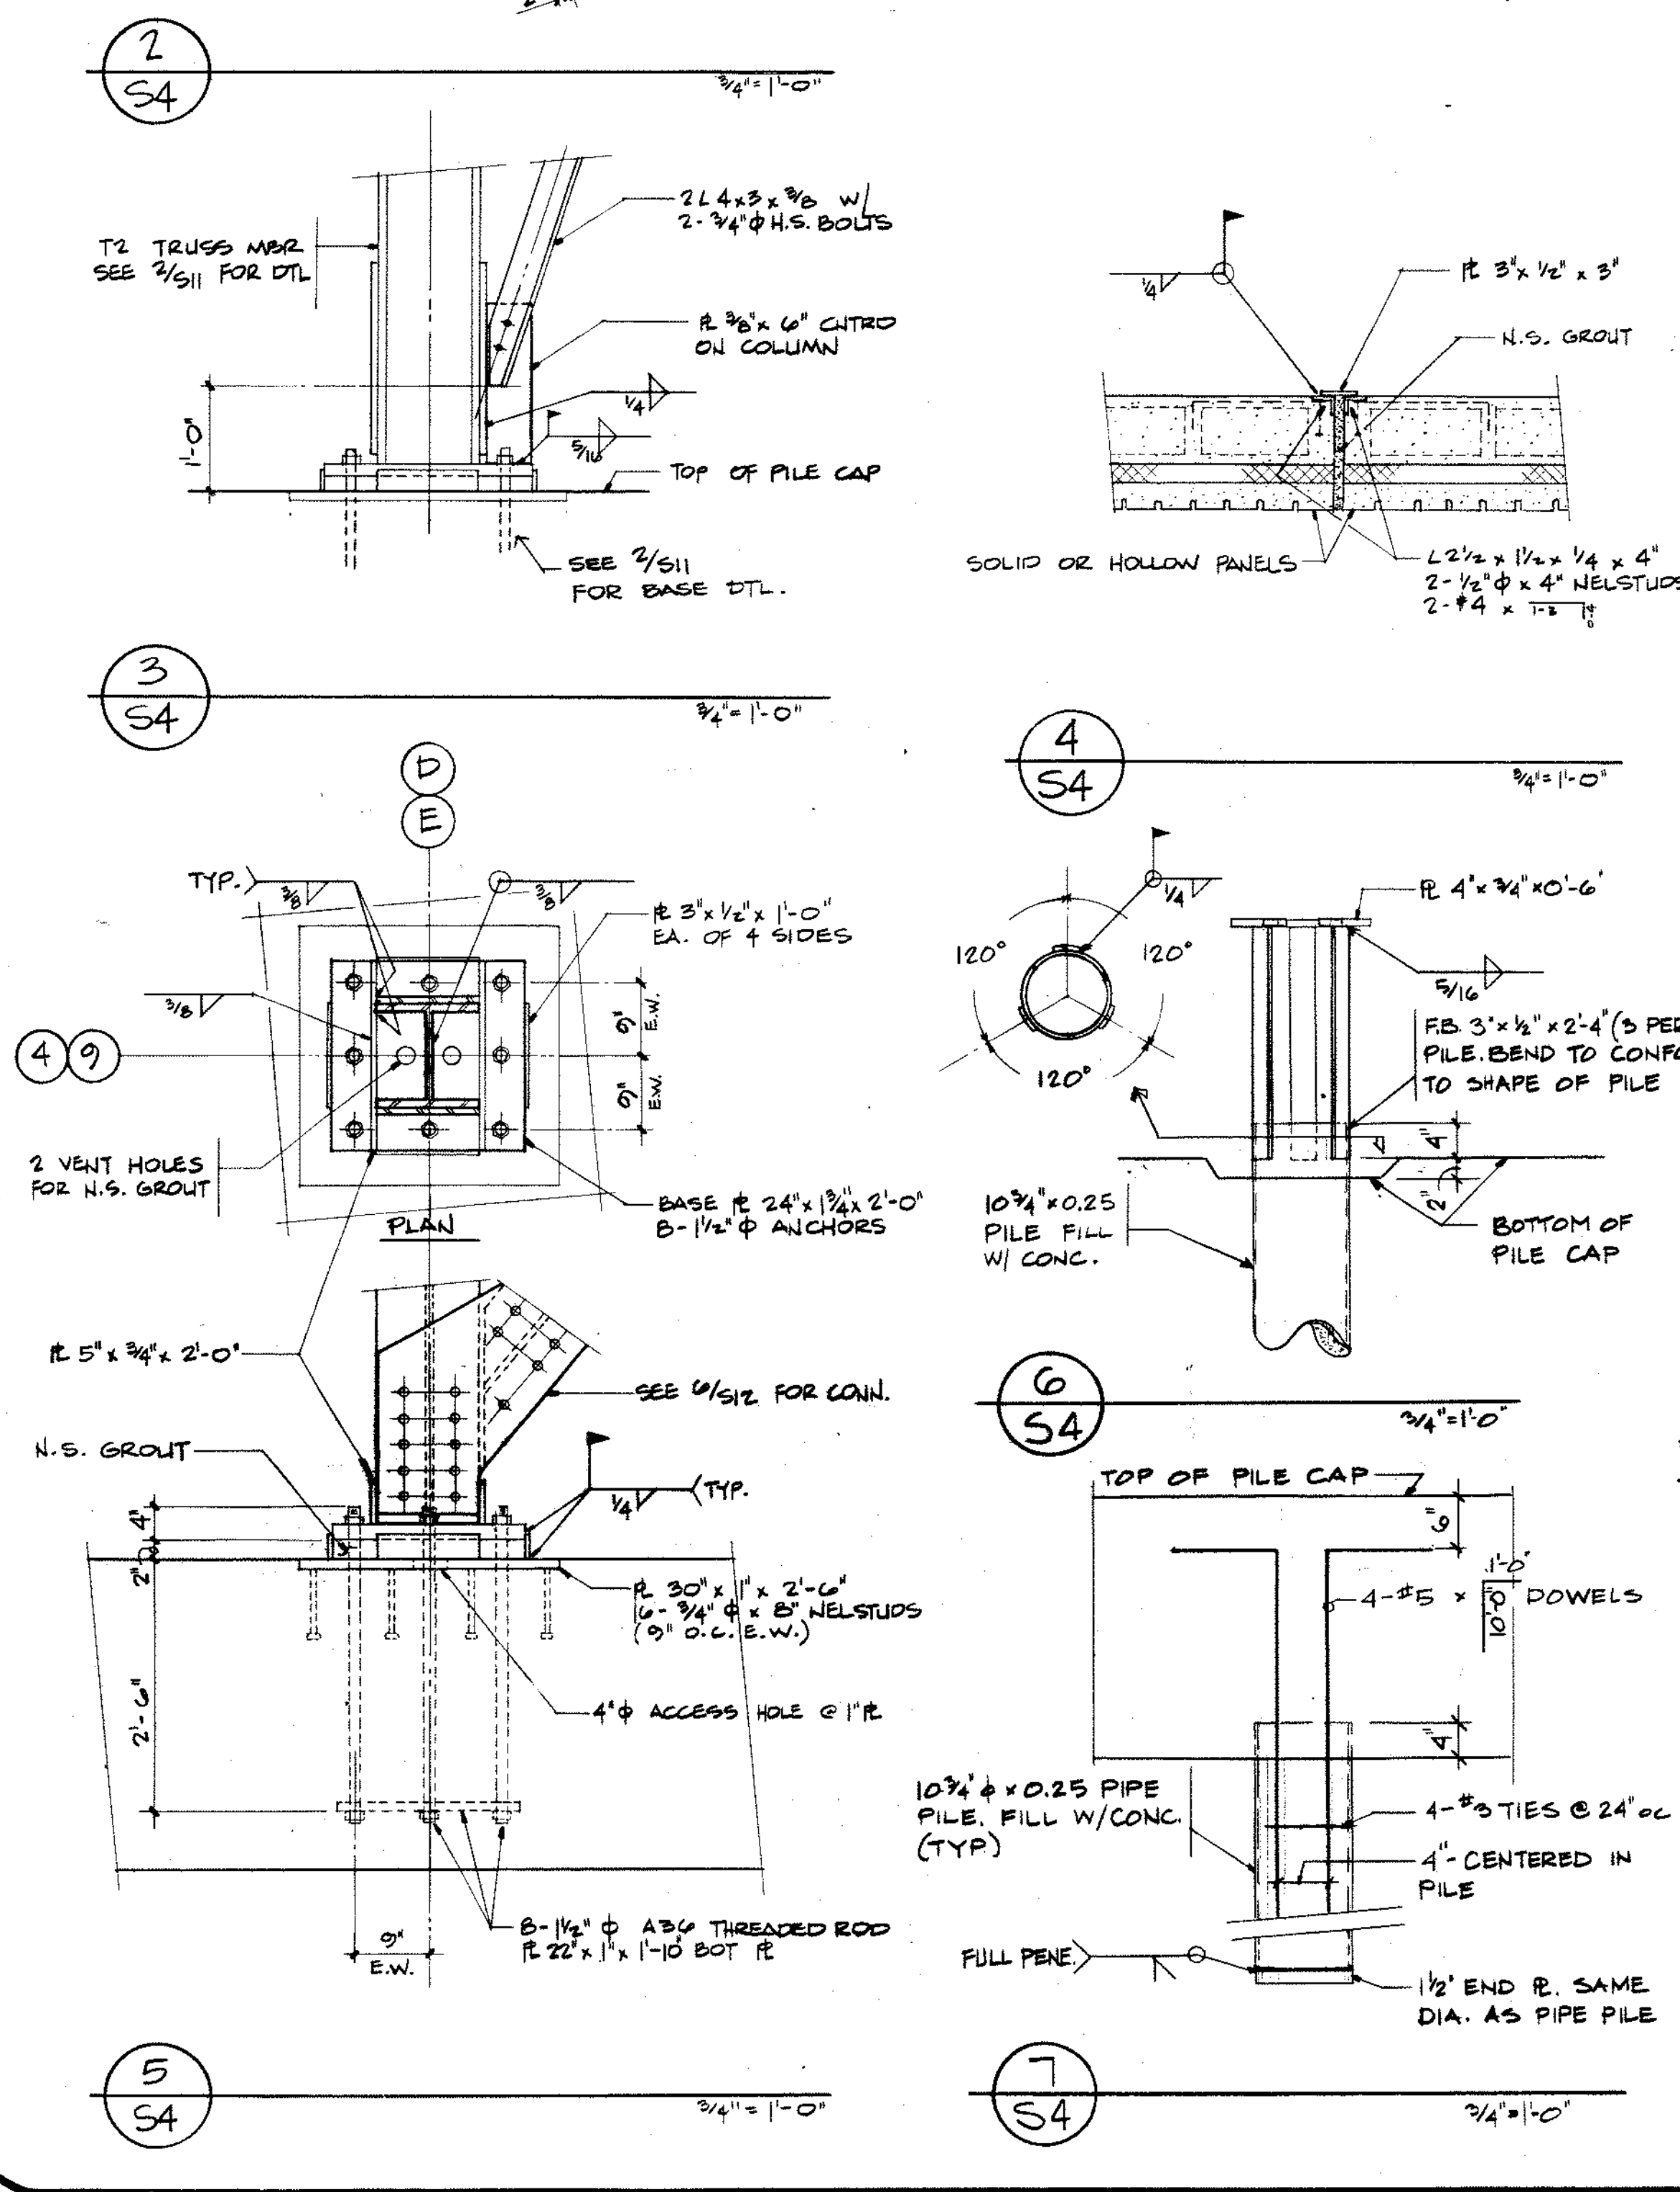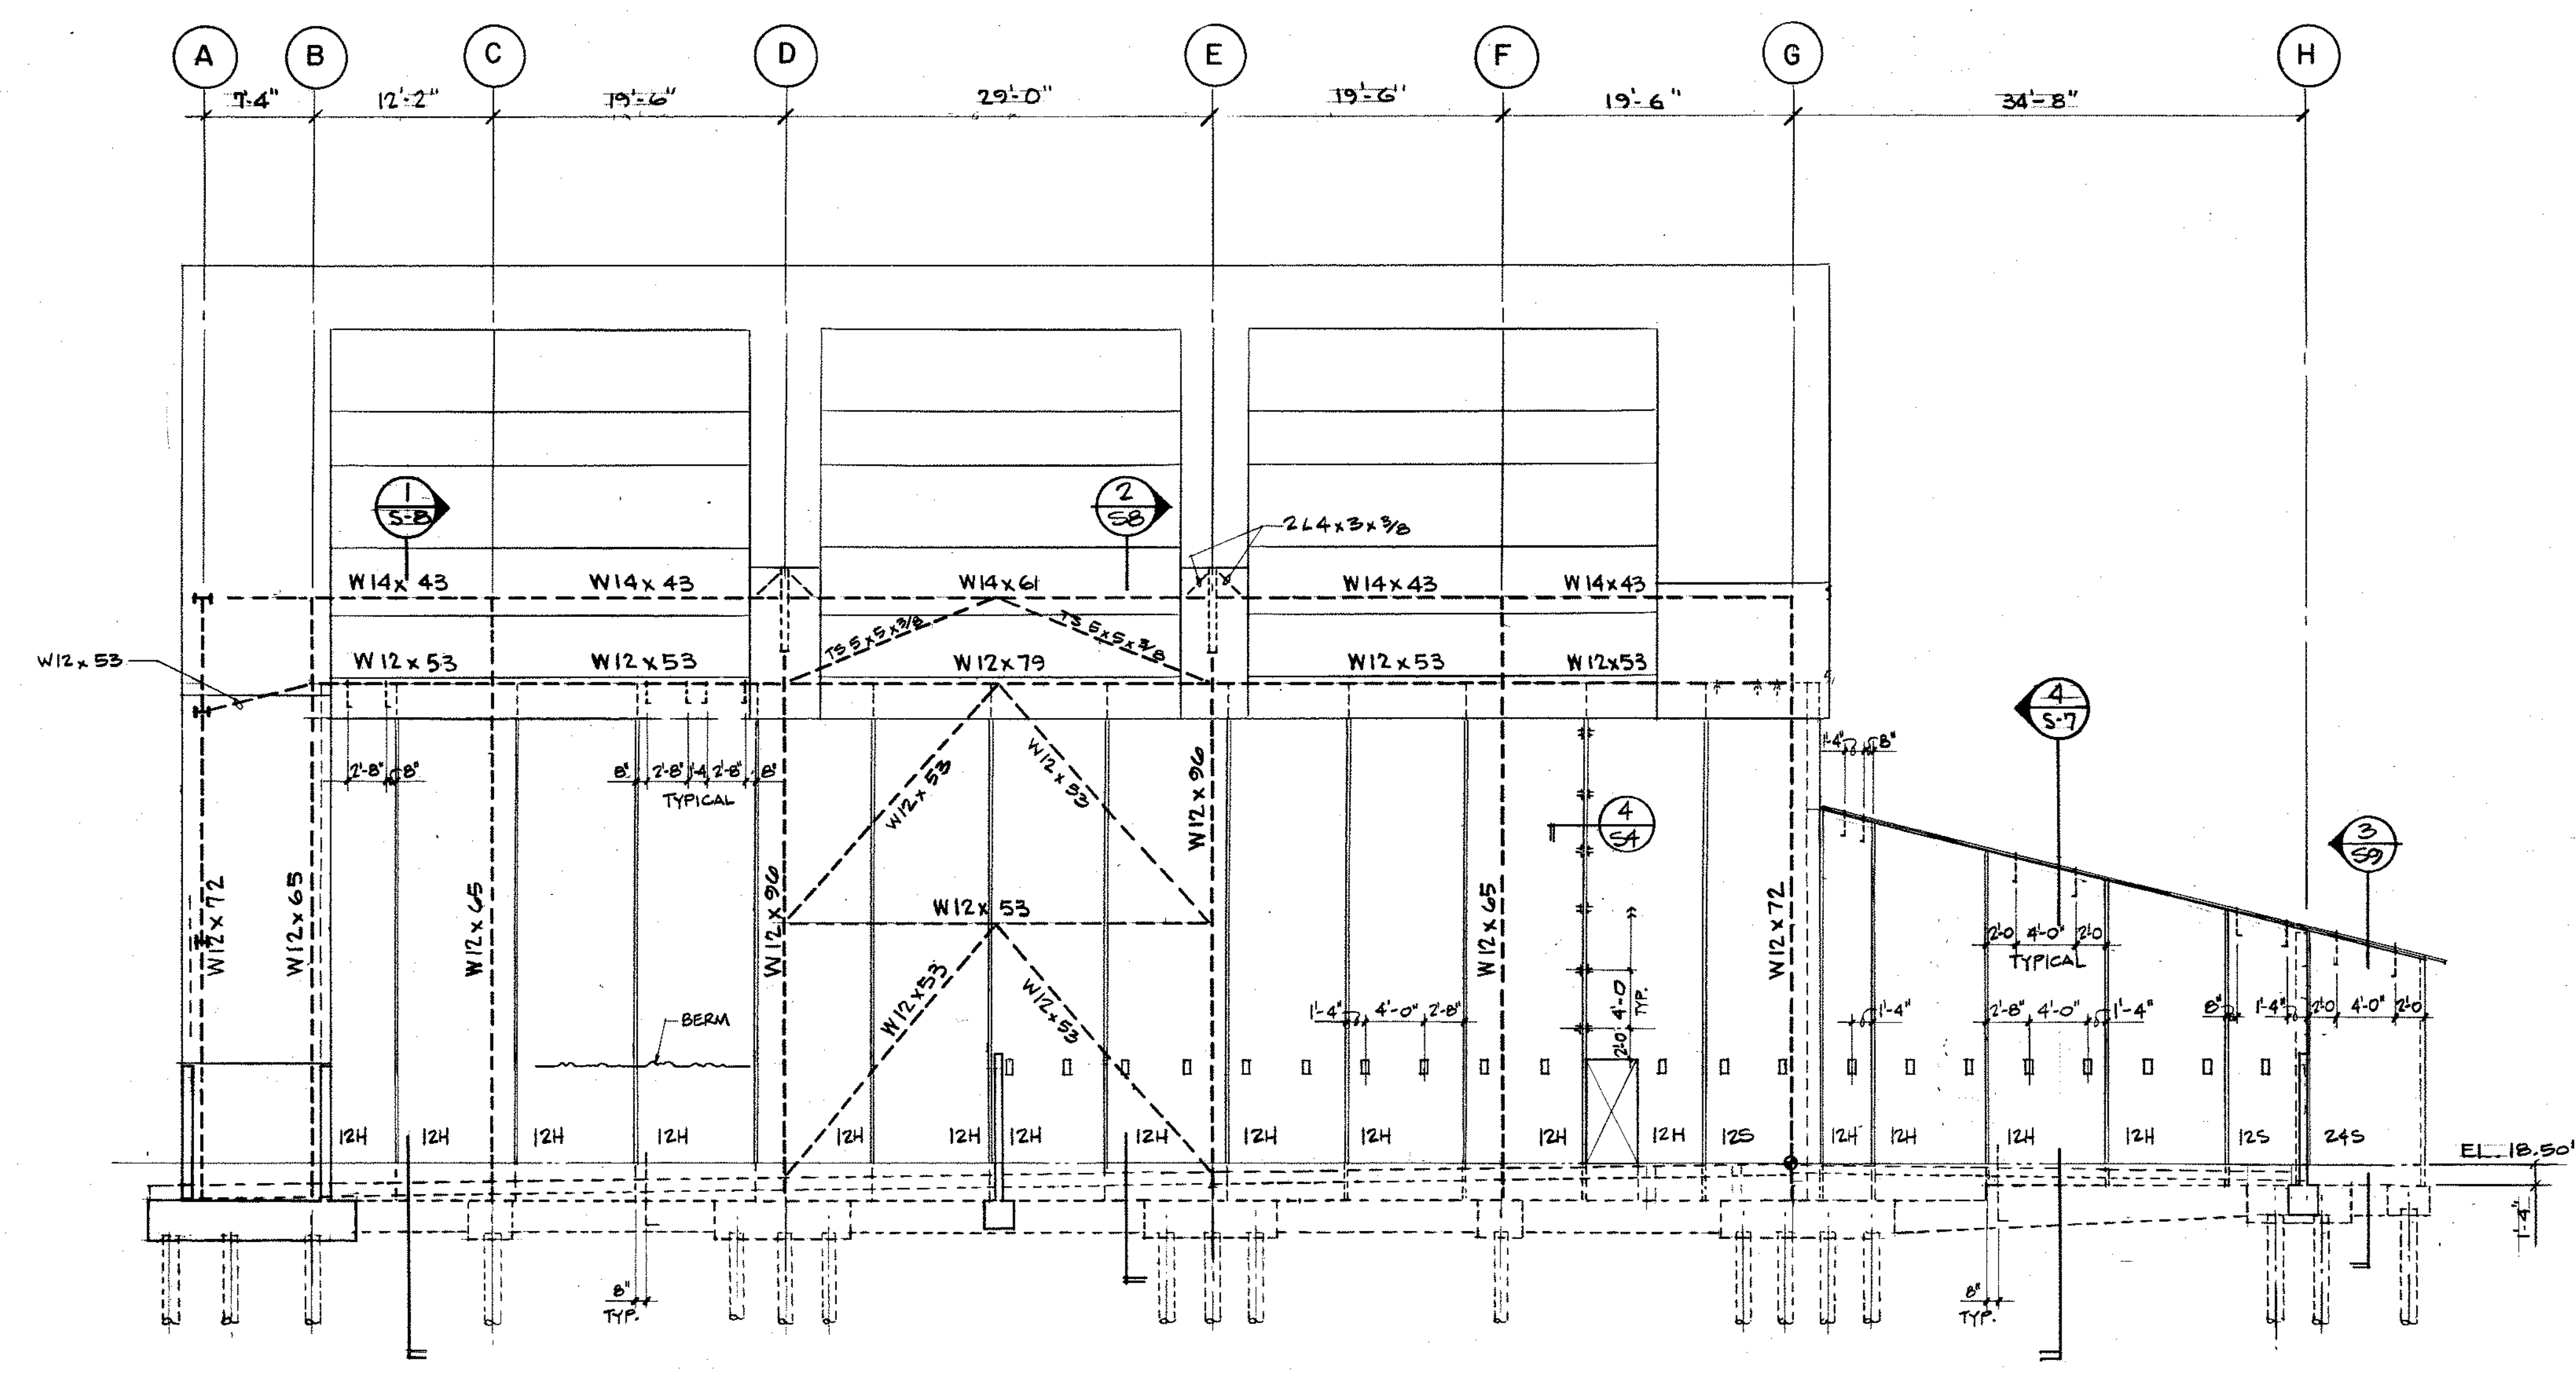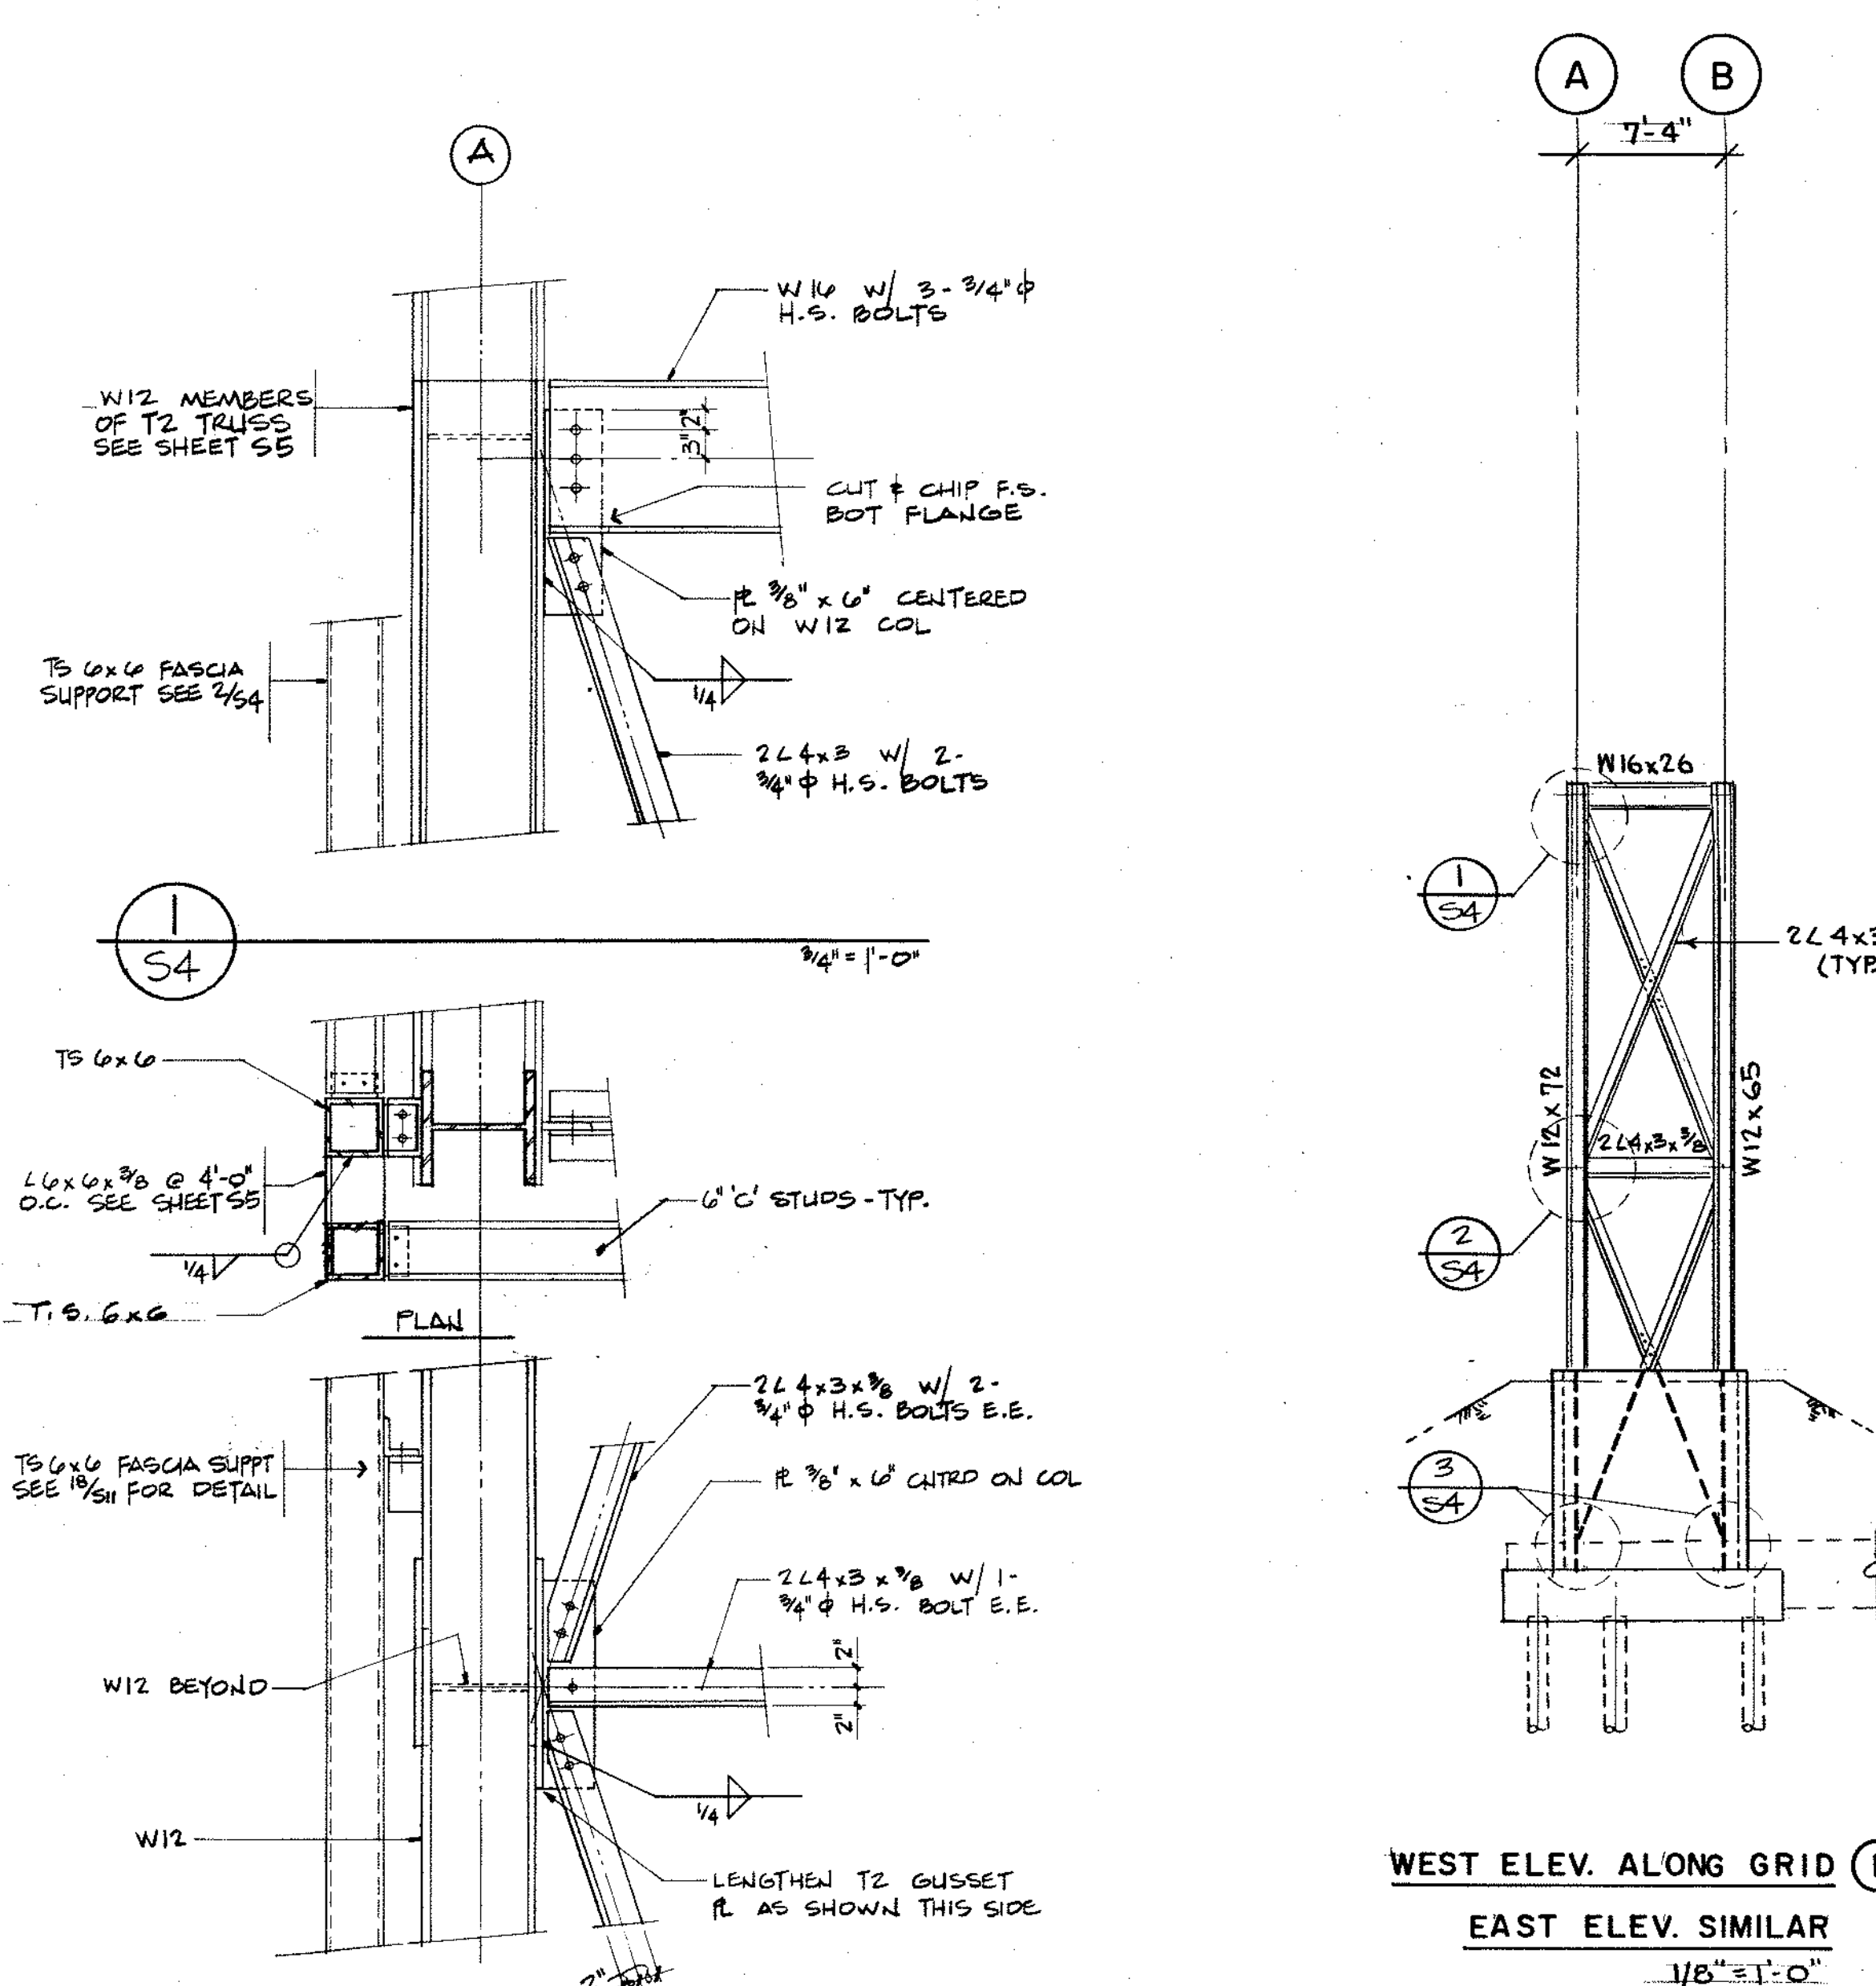

PRECAST WALL PANEL SCHEDULE

MARK	DESCRIPTION	BASE DTL. (U.N.O.)	TOP DTL. (U.N.O.)
12H	8' HOLLOW-CORE + 2" INSULATION + 2" FACE + RIBS (SANDWICH)	2/58	2/58
12S	8' SOLID + 2" INSULATION + 2" FACE + RIBS (SANDWICH)	2/58	2/58
BH	8' HOLLOW-CORE	3/58	3/58
BS	8' SOLID	3/58	3/58
4S	4' SOLID + RIBS	13/59	13/59
24S	2-4' SOLID + RIBS BACK TO BACK	3/59	3/59

miller-cook architects a.i.a.
303 NW 1st AVE. PORTLAND, OREGON 97208
(503) 268-0828

DATE: FEB. 20, 1980
JOB NO: 84-125
REVISIONS: 1-16-87
1-16-87

REGISTERED ARCHITECT
MILLER COOK
PORTLAND, OREGON
STATE OF OREGON


SHEET TITLE: EAST AND WEST ELEVATIONS
C-130 FUEL SYSTEM / CORROSION CONTROL
MAINTENANCE HANGAR
304th AIR RESCUE RECOVERY SQUADRON
PORTLAND INTERNATIONAL AIRPORT
PORTLAND, OREGON

RECORD DRAWINGS FROM INFORMATION SUPPLIED BY THE GENERAL CONTRACTOR


REGISTERED PROFESSIONAL ENGINEER
JAMES M. WILSON
1-16-87

S-4

Bld Documents

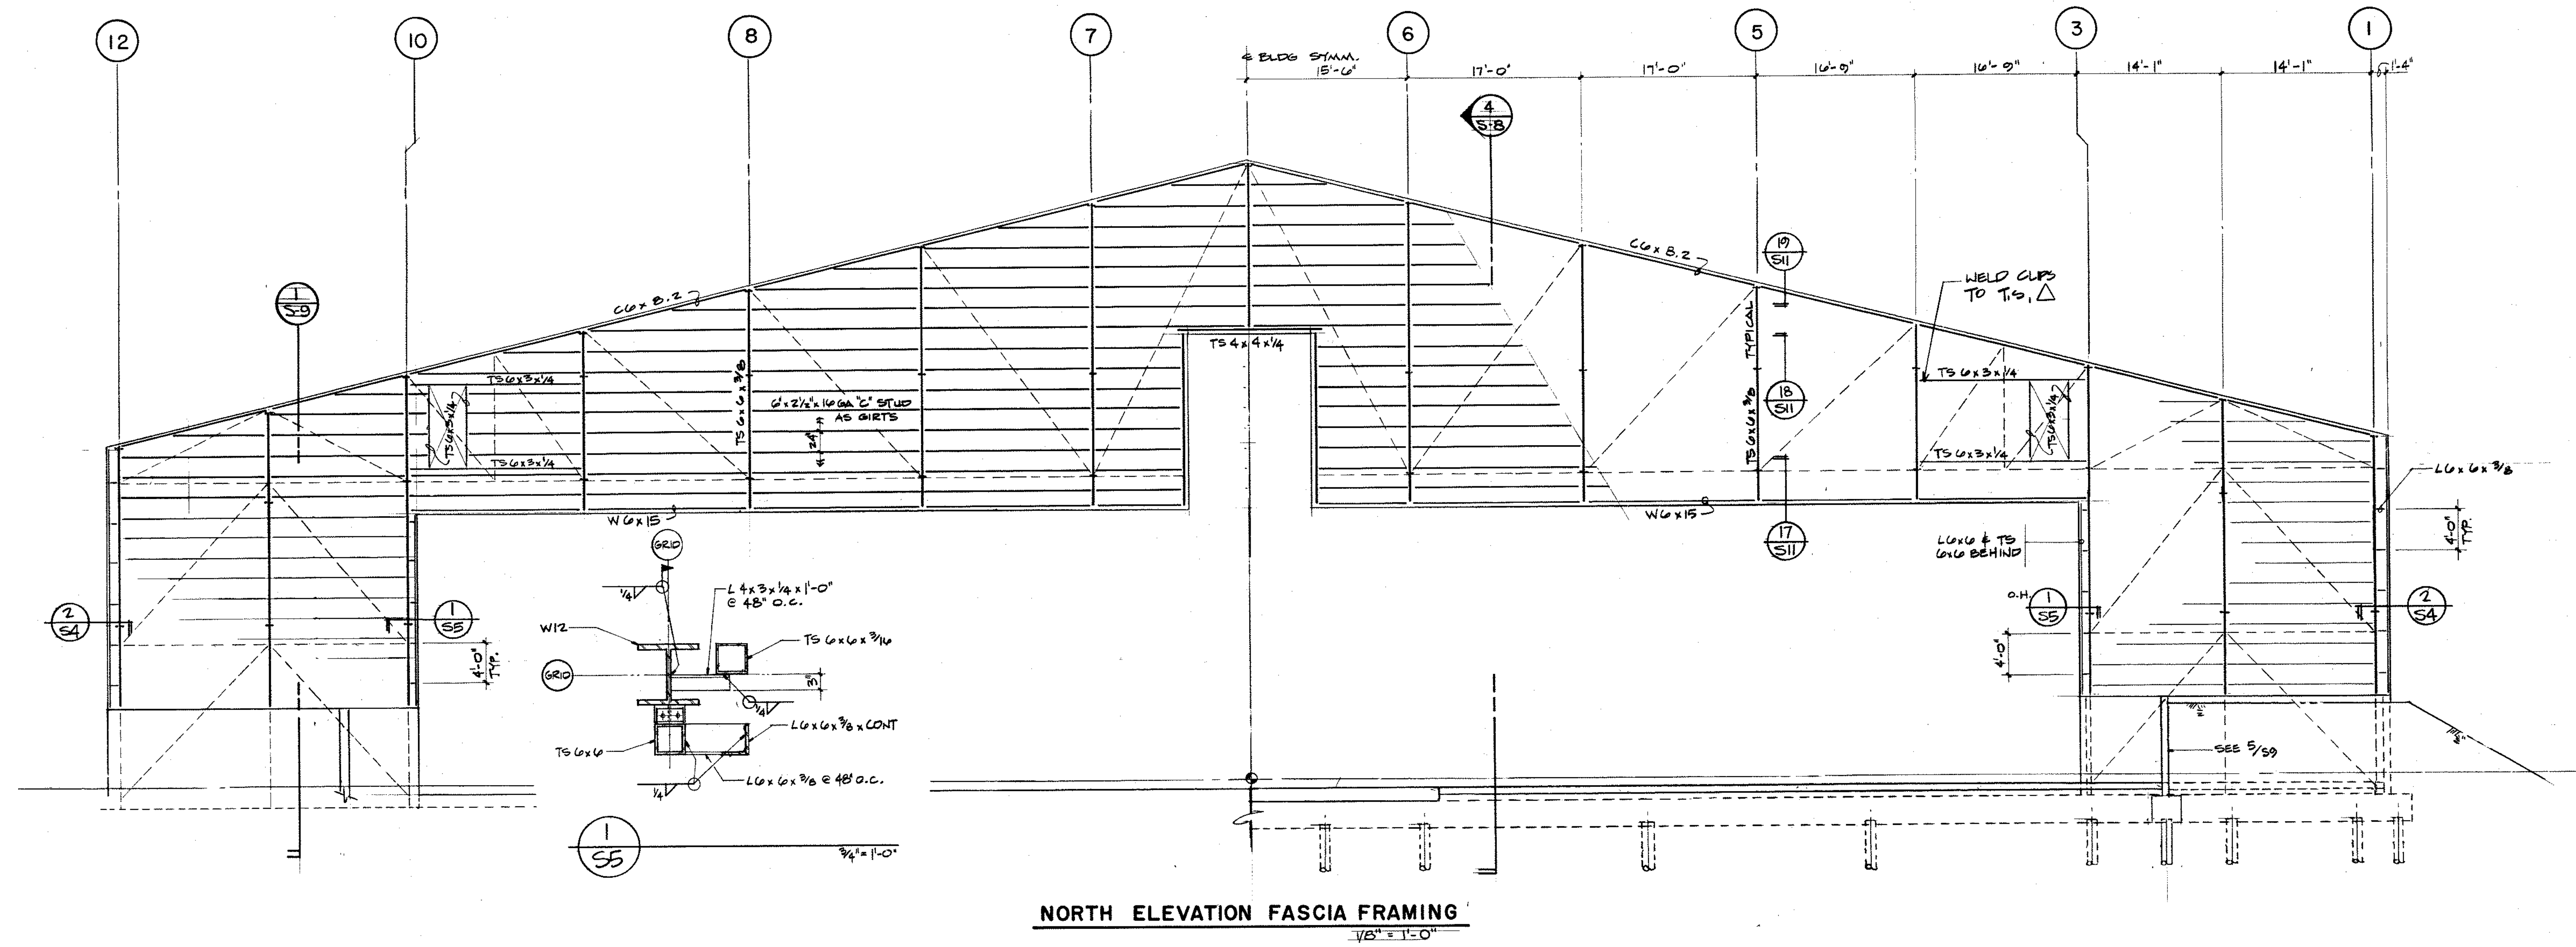


NORTH ELEVATION FASCIA FRAMING
1/8" = 1'-0"

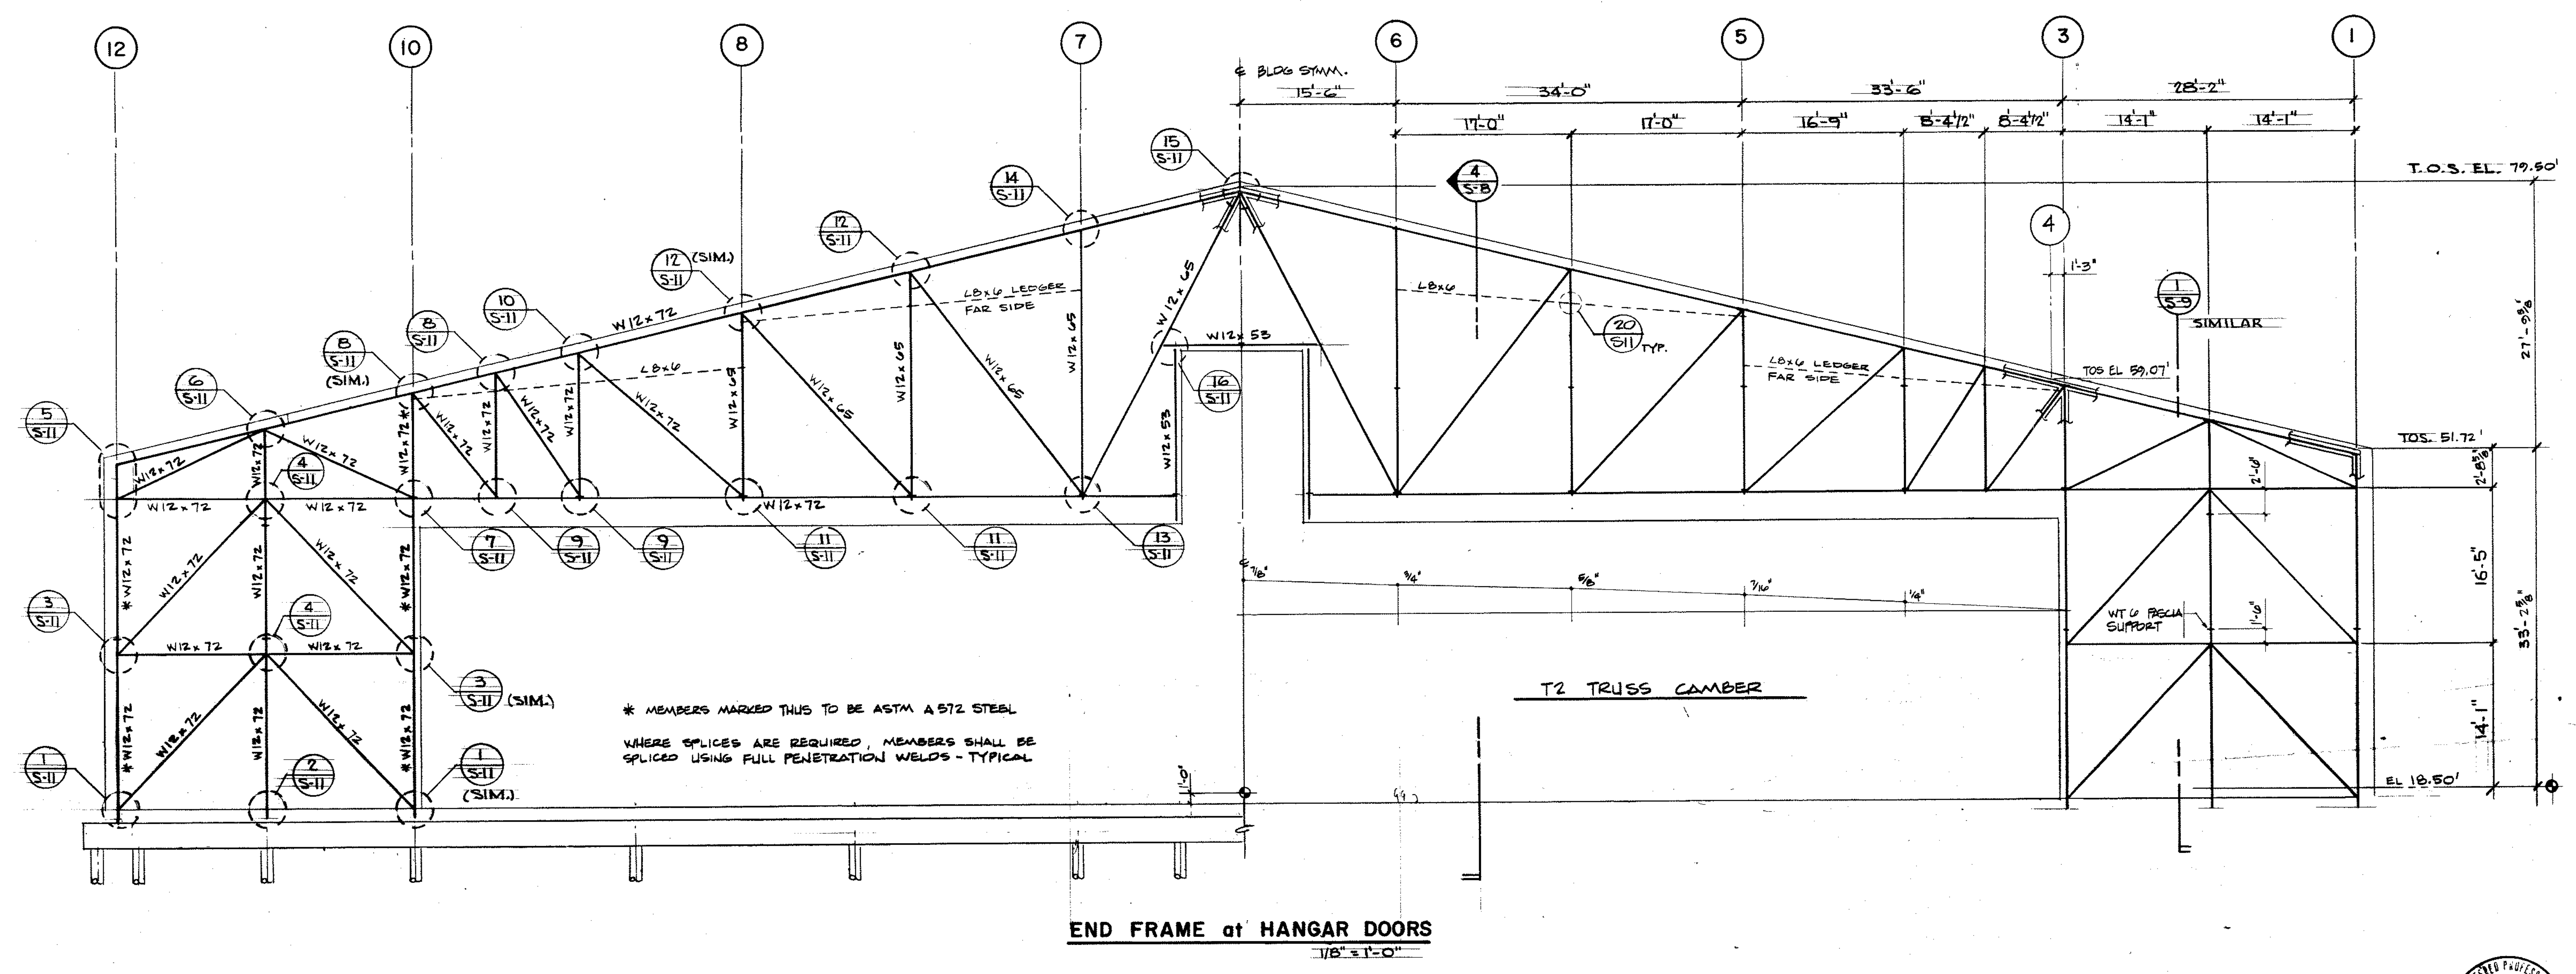

END FRAME at HANGAR DOORS
1/8" = 1'-0"

miller-cook architects a.i.a.
30 NW 4th Ave.
Portland, Oregon
(503) 228-0828
87205

DATE: FEB. 24, 1969
JOB NO: 04-125
REVISIONS: AS BUILT 11-16-89

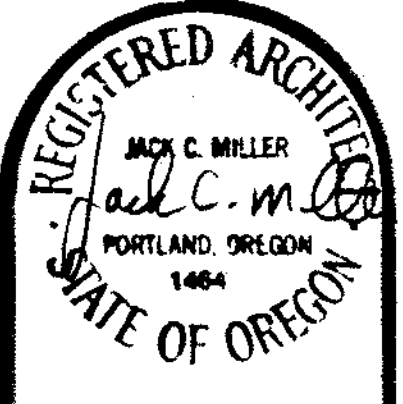


SHEET TITLE: FRAMING ELEVATIONS
C-130 FUEL SYSTEM / CORROSION CONTROL
MAINTENANCE HANGAR
304th AIR RESCUE RECOVERY SQUADRON
PORTLAND INTERNATIONAL AIRPORT
PORTLAND, OREGON

REGISTERED PROFESSIONAL ENGINEER
4326
James M. [Signature]
1-2-80



RECORD DRAWINGS FROM INFORMATION SUPPLIED BY THE GENERAL CONTRACTOR



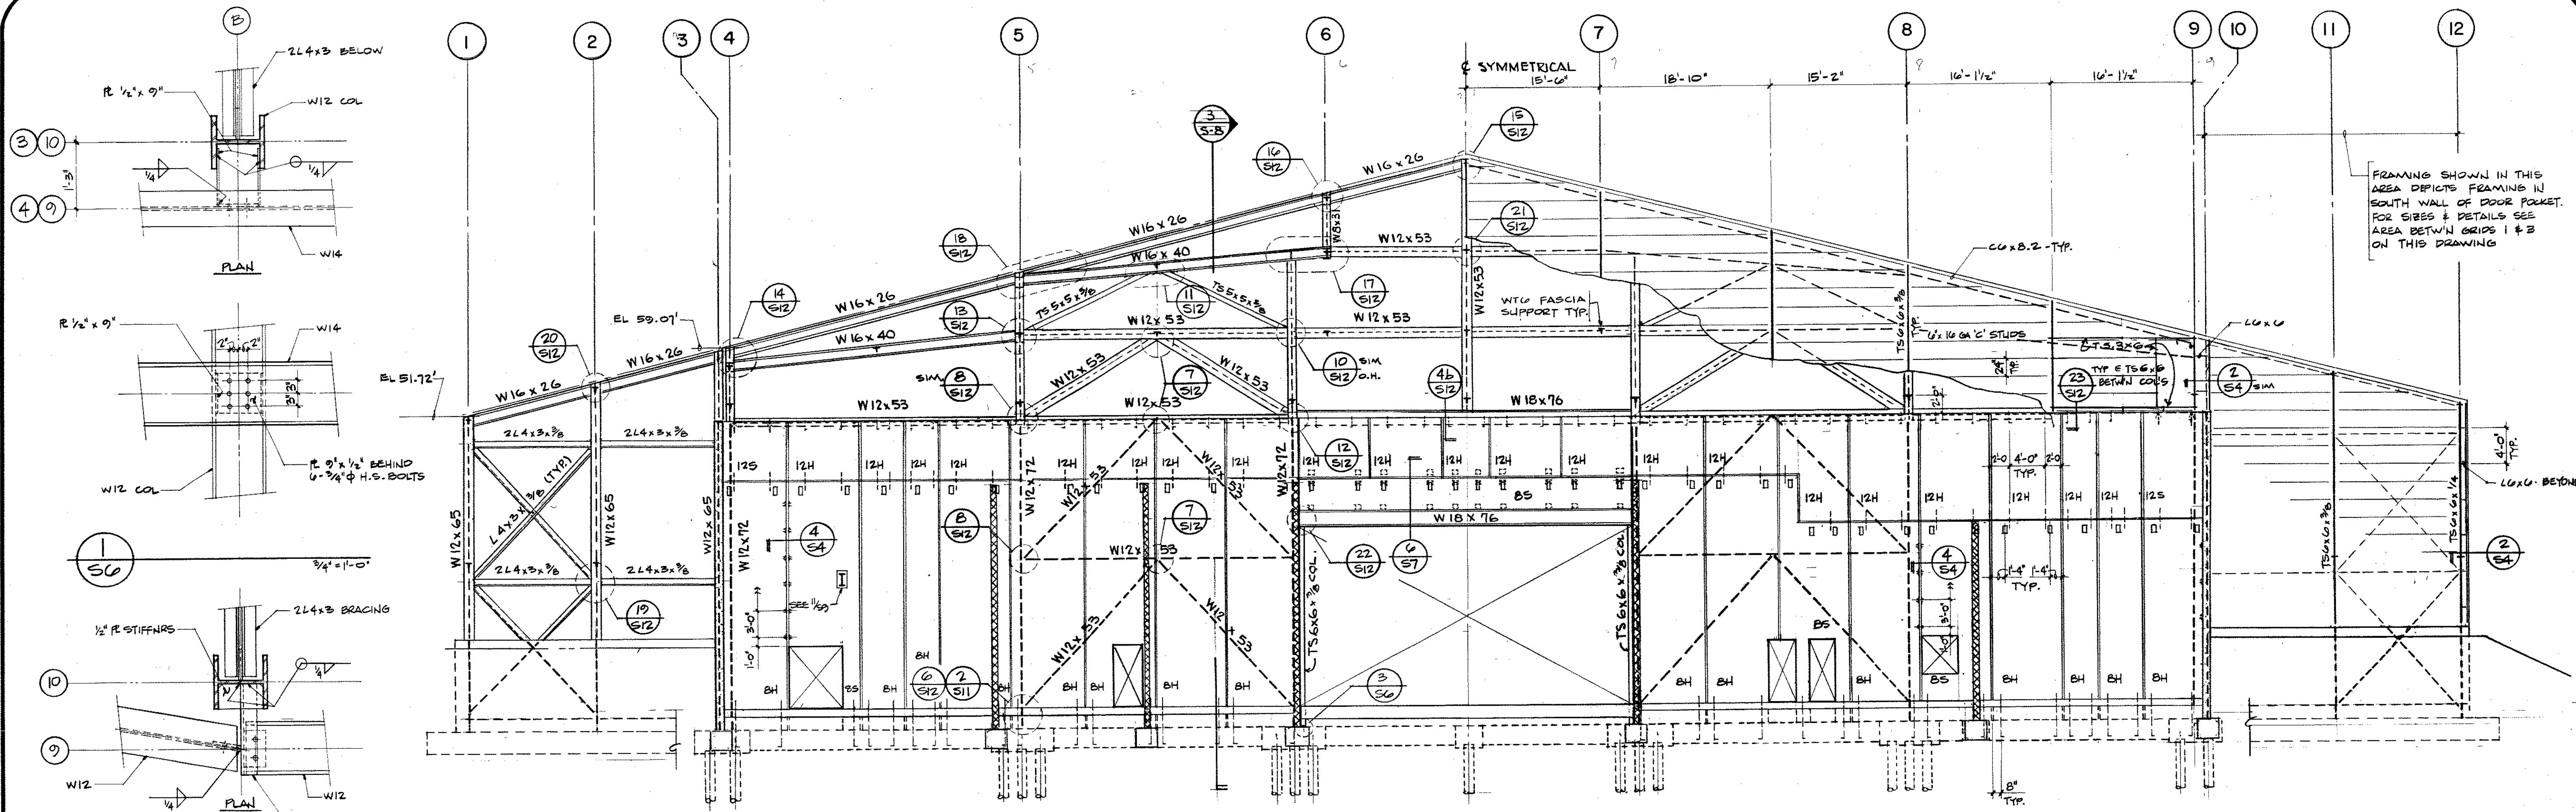


5 ELEVATION of SOUTH DOCK WALL LOOKING NORTH
1/8" = 1'-0"

NOTE
HOLLOW P.C. PANELS MAY BE SOLID PROVIDED VOIDS
ARE CAST TO ACCOMMODATE DOWEL CONNECTIONS.

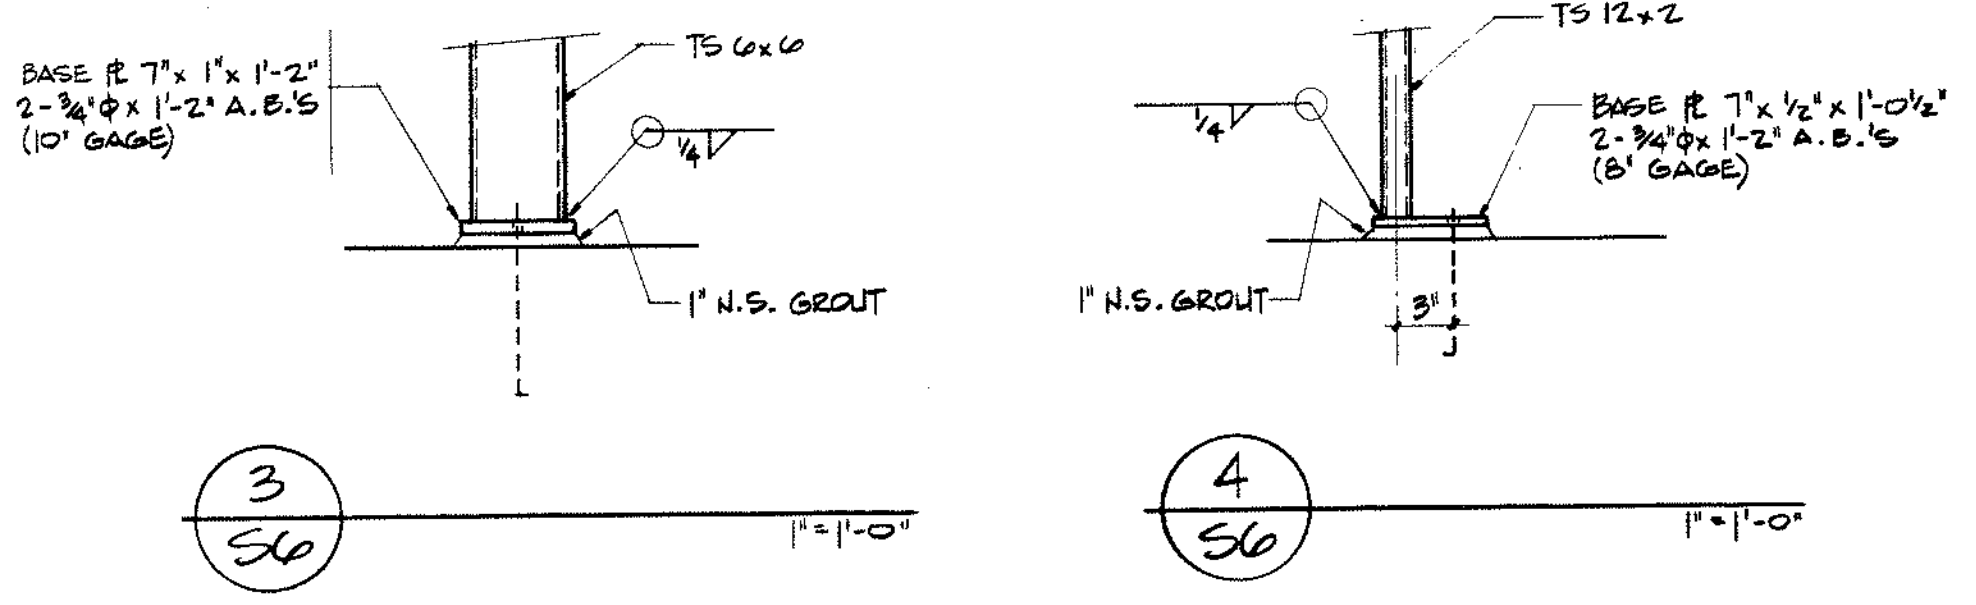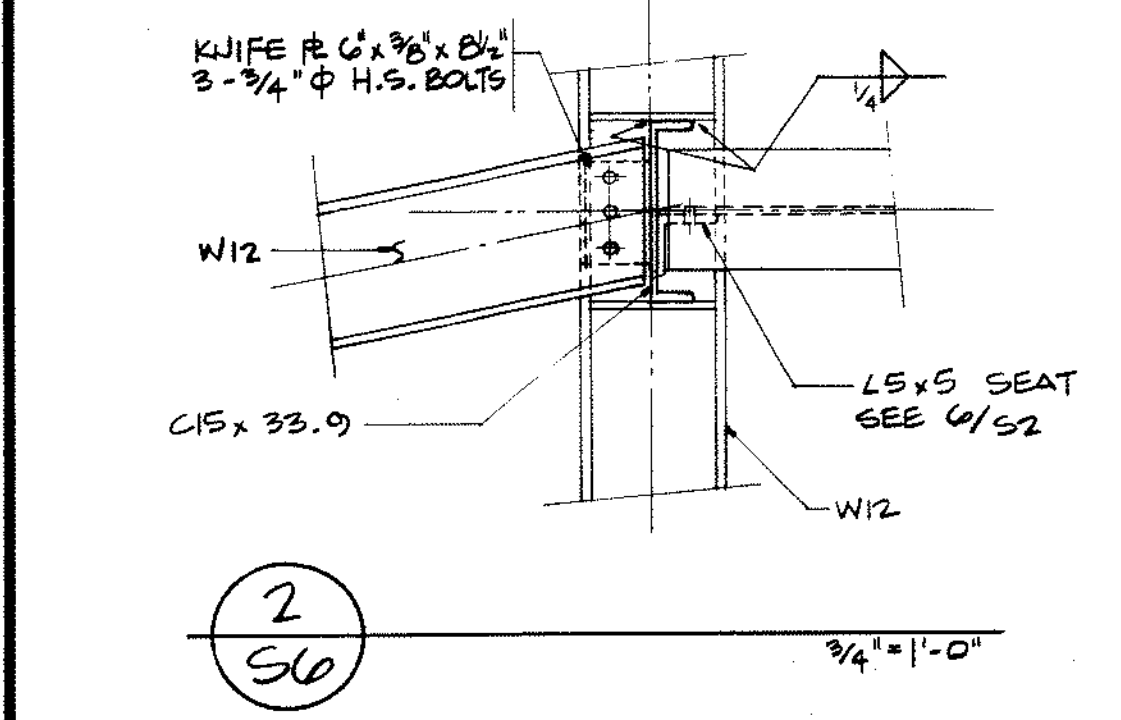

- GENERAL NOTES**
- DESIGN LOADS:
 ROOF: 25 PSF PLUS INCREASE FOR AREAS SUBJECT TO DRIFTING
 WIND: ANSI ASS. 1-1982, 90 MPH, EXPOSURE C, IMPORTANCE CLASS III, $C_{pi} = 0.25$
 SEISMIC: AEM 88-3 CHAPTER 13
 - REFER TO ARCHITECTURAL DRAWINGS FOR DIMENSIONS AND DETAILS.
 - FOUNDATION DESIGN BASED ON A SUBSURFACE SOIL INVESTIGATION DATED MAY 12, 1983 AND ADDENDUM DATED JUNE 1, 1983 PREPARED BY PITTSBURGH TESTING LABORATORY.
 - ELEVATIONS SHOWN ON PLAN ARE TO BOTTOM OF FOOTING, GRADE BEAM OR PILE CAP UNLESS OTHERWISE NOTED.
 - PILING SHALL BE CONCRETE FILLED PIPE (10 3/4" O.D. X 0.250", ASTM A252, GR. 2) CAPACITY OF PILING SHALL BE 35 TONS PLUS THE DOWNDRAG FORCE FROM SURROUNDING SOIL. DEPTH OF PILE TO ACHIEVE CAPACITY SHALL BE DETERMINED BY A LOAD TEST.
 - MINIMUM 28 DAY COMPRESSIVE STRENGTH OF CONCRETE SHALL BE 3000 PSI.
 - REINFORCING BARS SHALL BE ASTM A615, GRADE 60.
 - STRUCTURAL STEEL PLATE, BARS AND SHAPES SHALL CONFORM TO ASTM A36 AND ASTM A572, GRADE 50. TUBING SHALL CONFORM TO ASTM A500, GRADE B. BOLTS SHALL CONFORM TO ASTM A307 (DESIGNATED "A.B.") OR ASTM A325 (DESIGNATED "H.S."). USE LOAD INDICATOR WASHERS FOR ALL H.S. BOLTS.
 - STRUCTURAL STEEL MEMBERS AND CONNECTIONS SHALL BE DESIGNED IN ACCORDANCE WITH AISC SPECIFICATIONS, 8TH EDITION.
 - OPEN WEB STEEL JOISTS SHALL BE DESIGNED DETAILED AND BRACED FOR LOADS SHOWN ON THE DRAWINGS IN ACCORDANCE WITH THE STANDARD SPECIFICATIONS OF THE STEEL JOIST INSTITUTE.
 - STEEL ROOF DECK SHALL BE 1 1/2" TYPE "B" GALV. (ACOUSTICAL DECK FOR MOST OF THE BUILDING) AND SHALL HAVE MINIMUM DIAPHRAGM SHEAR CAPACITY AS FOLLOWS: 78 GAUGE, 1000#/LF; 20 GAUGE, 700 #/LF.
 - STEEL ROOF DECK LAYOUT SHALL BE SUCH THAT EACH SHEET SHALL COVER A MINIMUM OF 3 SPANS. WHERE DECK IS PARALLEL TO SUPPORT A LOW CORRUGATION SHALL BE CONTINUOUSLY IN CONTACT WITH THE SUPPORT.
 - STEEL ROOF DECK SHALL BE FASTENED TO EACH PERPENDICULAR SUPPORT WITH 7 PUDDLE WELDS PER SHEET AND TO PARALLEL SUPPORTS WITH PUDDLE WELDS AT 12" O.C. MINIMUM EFFECTIVE DIAMETER OF PUDDLE WELDS SHALL BE 1/2". LONGITUDINAL EDGES SHALL BE INTERLOCKING TYPE AND SHALL BE BUTT PUNCHED AT 12" O.C.
 - PRECAST WALL PANELS SHALL BE DESIGNED TO SUPPORT ROOF DEAD AND SNOW LOAD TRIBUTARY TO THEM AND WIND OR SEISMIC LOAD IN ACCORDANCE WITH ITEM 1 ABOVE.
 - METAL SIDING AND ROOFING (INCLUDING GIRTS, STUDS AND FASTENERS) AND HANGAR DOORS SHALL BE DESIGNED FOR WIND LOAD AND SNOW LOAD IN ACCORDANCE WITH ITEM 1 ABOVE. MAXIMUM DEFLECTION 1/180 OF SPAN.
 - SLABS ON GRADE IN THE DOCK AND APRON AREAS HAVE BEEN DESIGNED FOR A MINIMUM SUB-GRADE MODULUS (K) OF 100 WHICH SHALL BE VERIFIED, AFTER PLACEMENT OF LEVELING COURSE, BY A PLATE BEARING TEST.
 - SHRINKAGE COMPENSATING CONCRETE SLABS (CHEM-COMP) SHALL BE USED WHERE NOTED AND SHALL BE PLACED PRIOR TO ADJACENT SLABS. CONCRETE FOR THESE SLABS SHALL BE TYPE 2 MIX DESIGN (SEE SPECS.). TYPE 1 MIX DESIGN SHALL BE USED FOR ALL OTHER SLABS. TYPE 3 MIX DESIGN SHALL BE USED FOR ALL OTHER CAST-IN-PLACE CONCRETE.

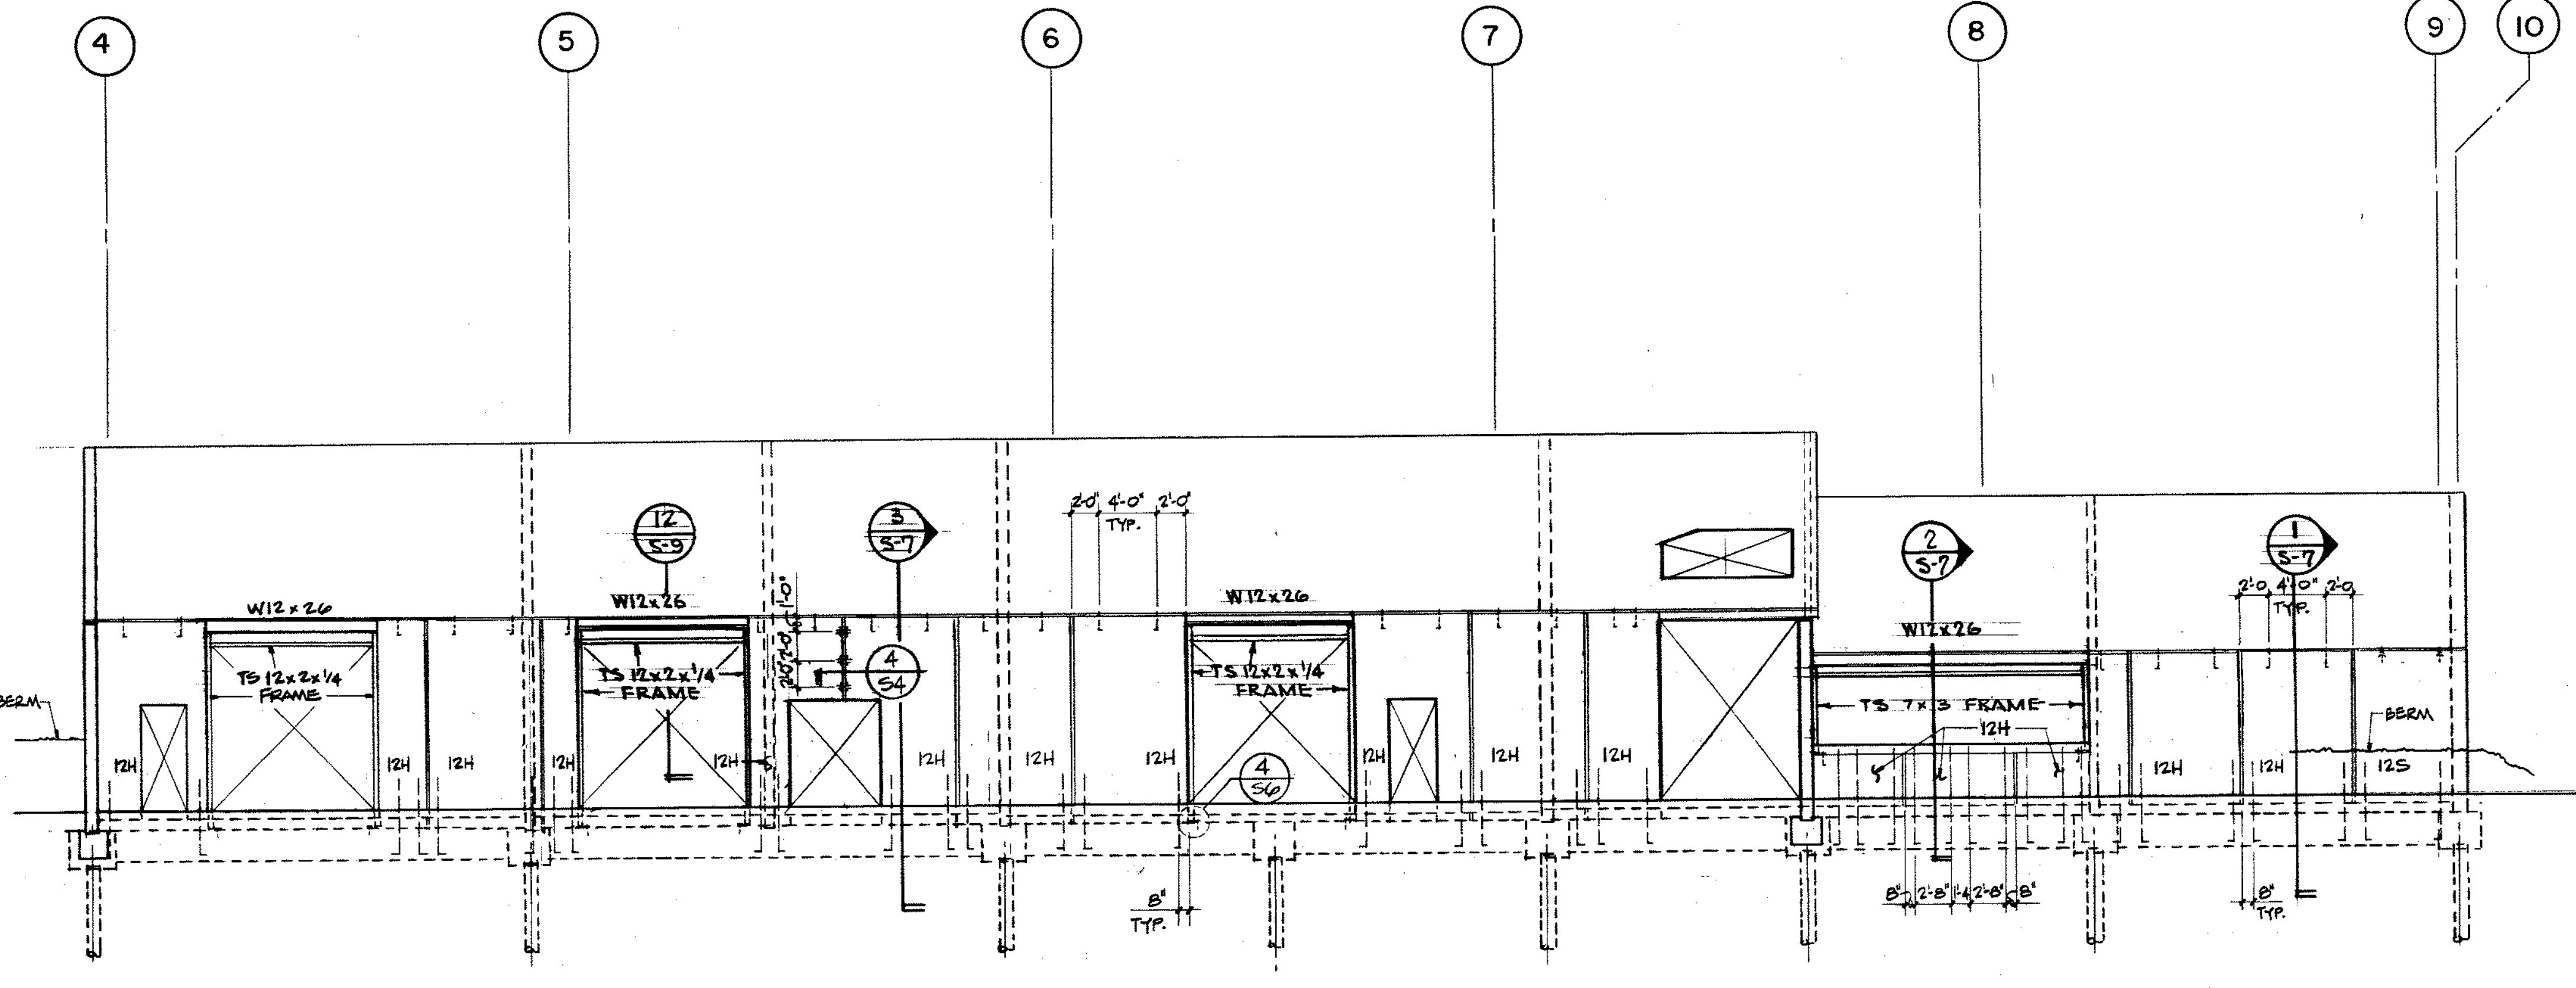

6 ELEVATION of SOUTH WALL
1/8" = 1'-0"

RECORD DRAWINGS FROM
INFORMATION SUPPLIED BY
THE GENERAL CONTRACTOR


miller-cook architects a.i.a.
30 N.W. 7th AVE
PORTLAND, OREGON
(503) 266-0882
87508

DATE: FEB. 01, 1989
JOB NO: 84-105
REVISIONS AS BUILT 11-10-87


REGISTERED ARCHITECT
JACK C. MILLER
JACK C. MILLER
PORTLAND, OREGON
1464
STATE OF OREGON

SHEET TITLE: **BRACING ELEVATIONS**
C-130 FUEL SYSTEM / CORROSION CONTROL
MAINTENANCE HANGAR
304th AIR RESCUE RECOVERY SQUADRON
PORTLAND INTERNATIONAL AIRPORT
PORTLAND OREGON


S-6

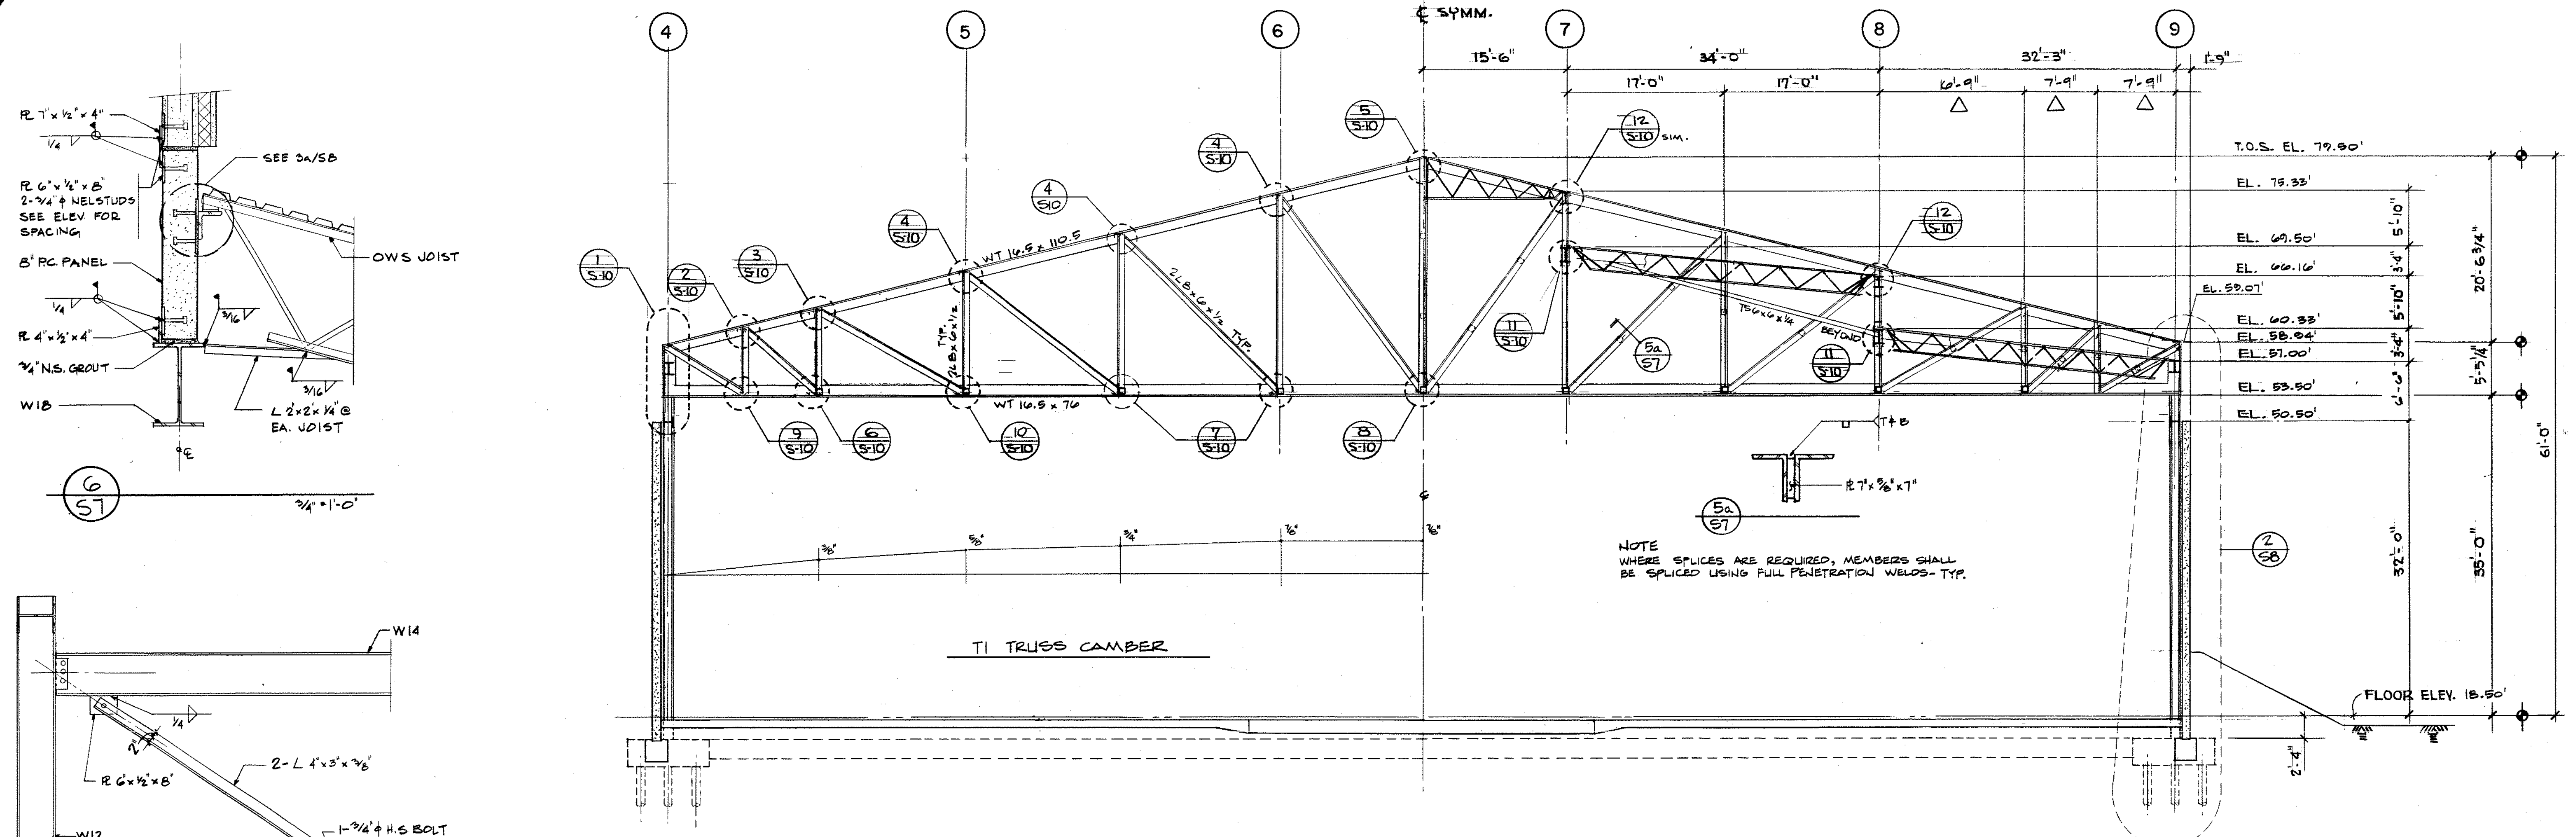


5 BUILDING CROSS SECTION and T1 TRUSS ELEVATIONS
1/8" = 1'-0"

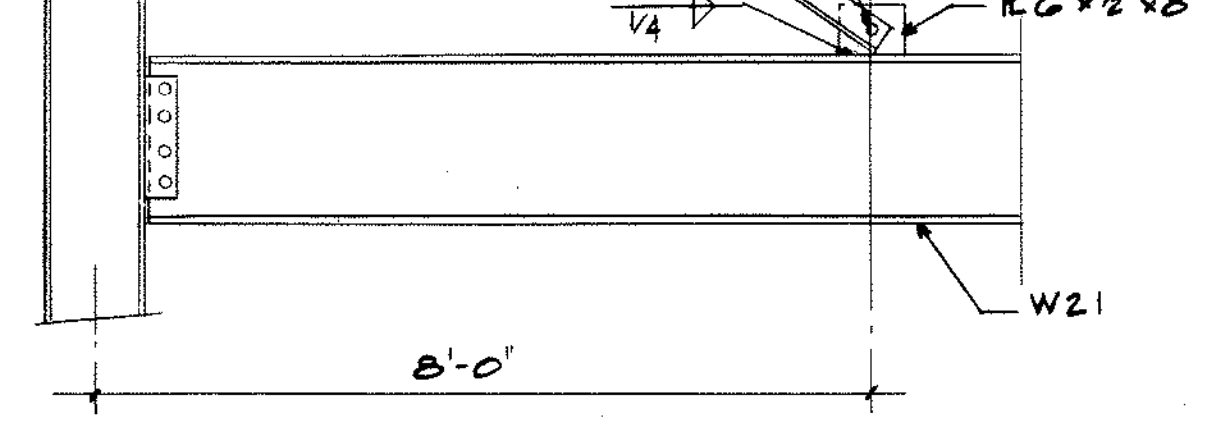



7
1/2" = 1'-0"

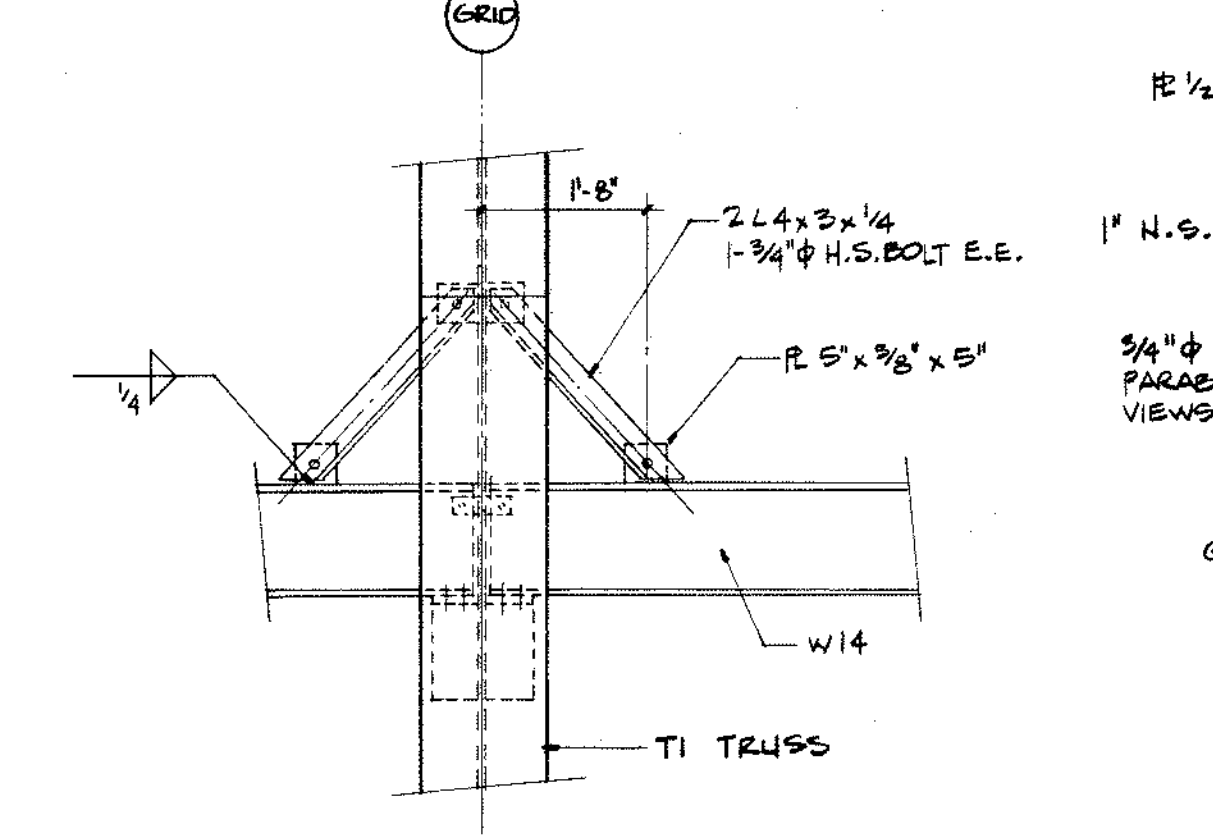


8
1/2" = 1'-0"

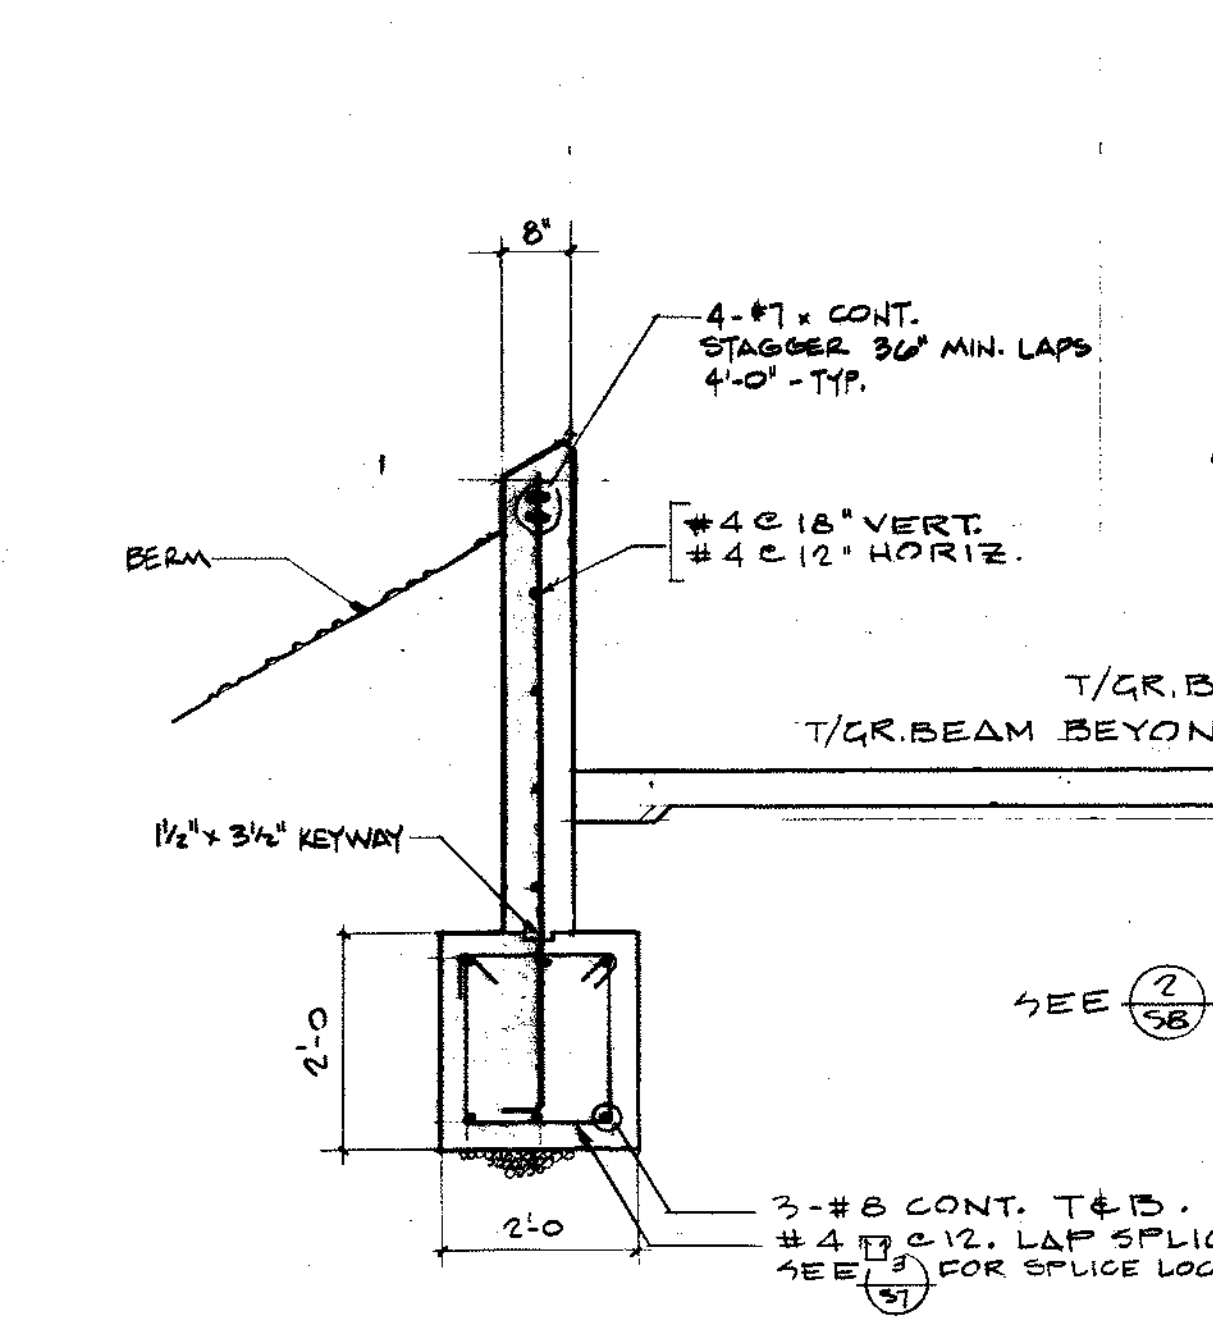


4
1/2" = 1'-0"

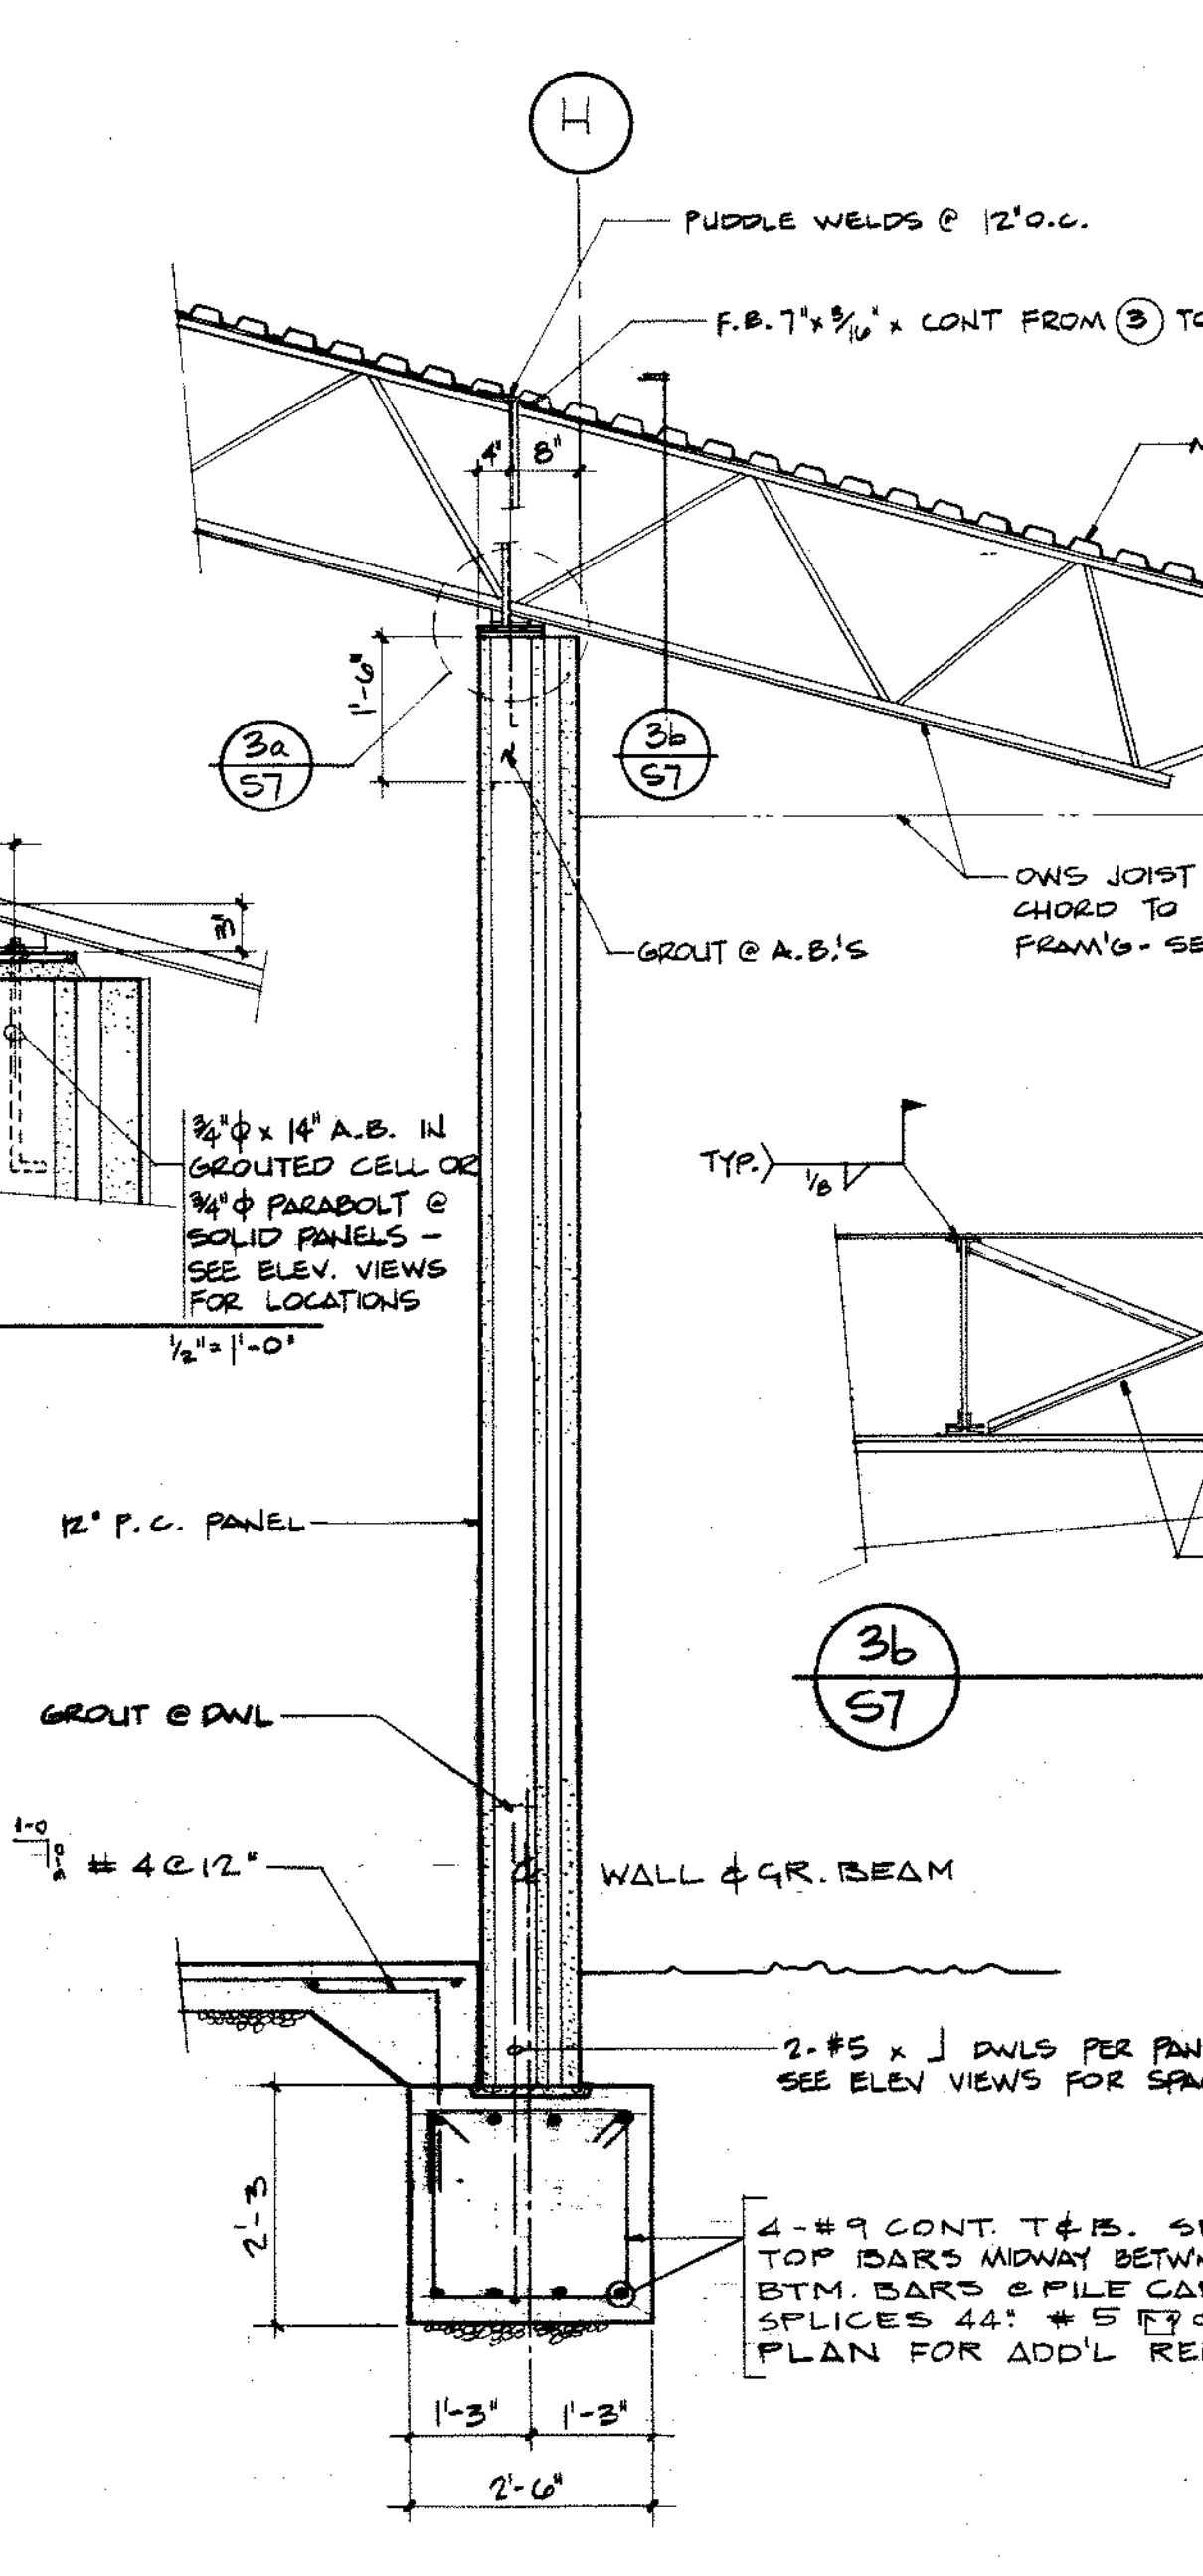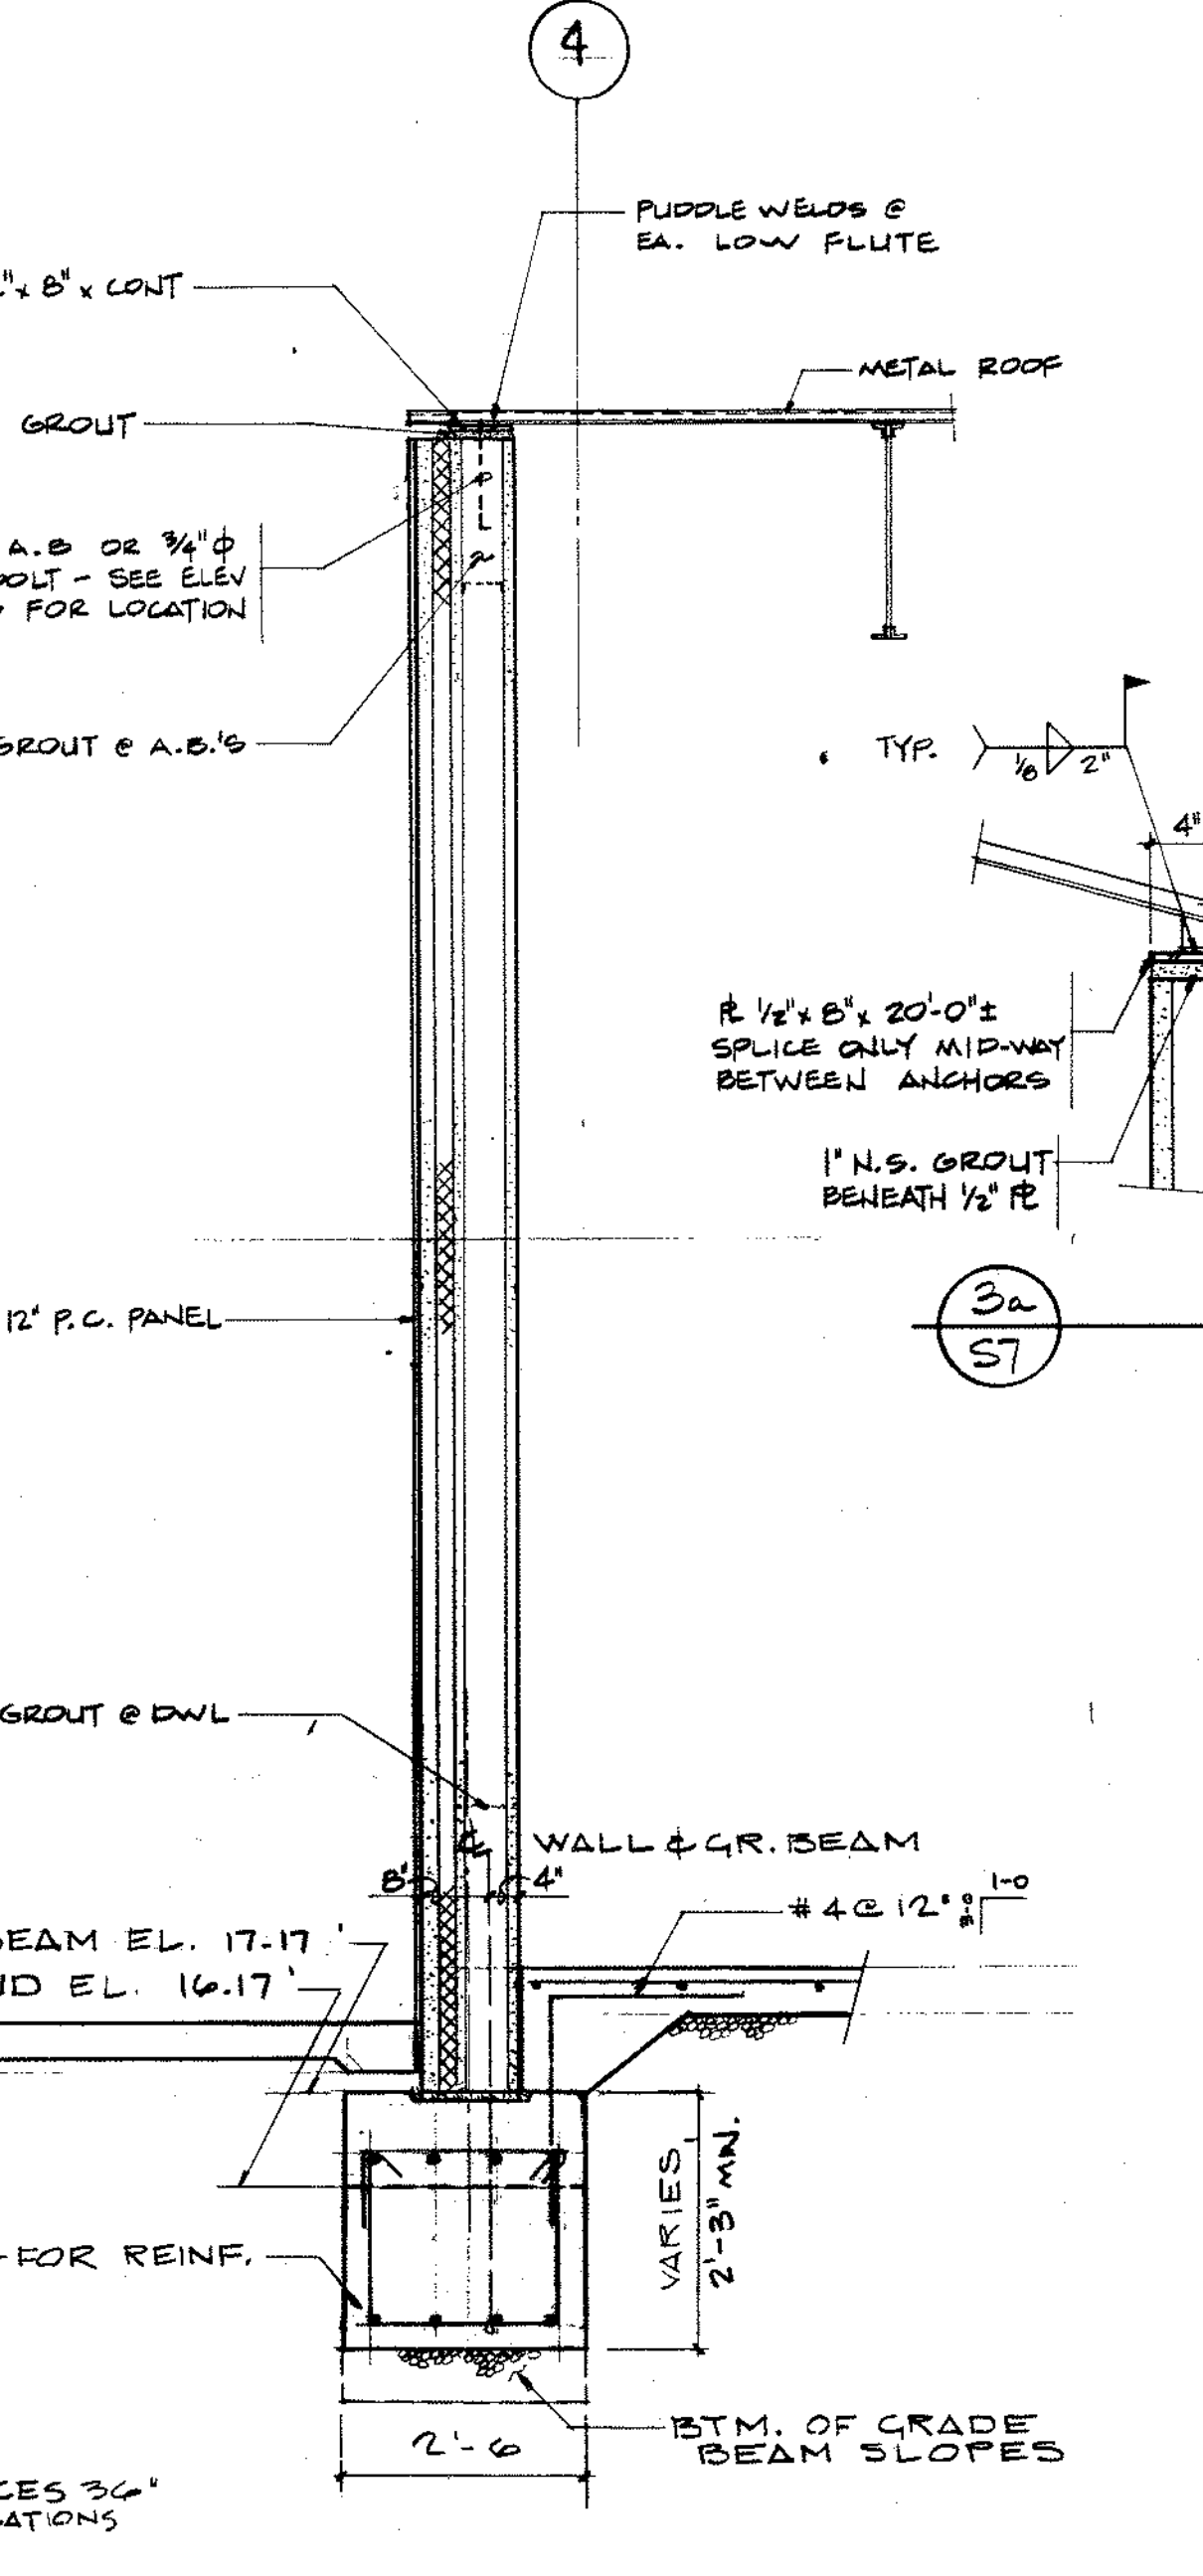

3
1/2" = 1'-0"

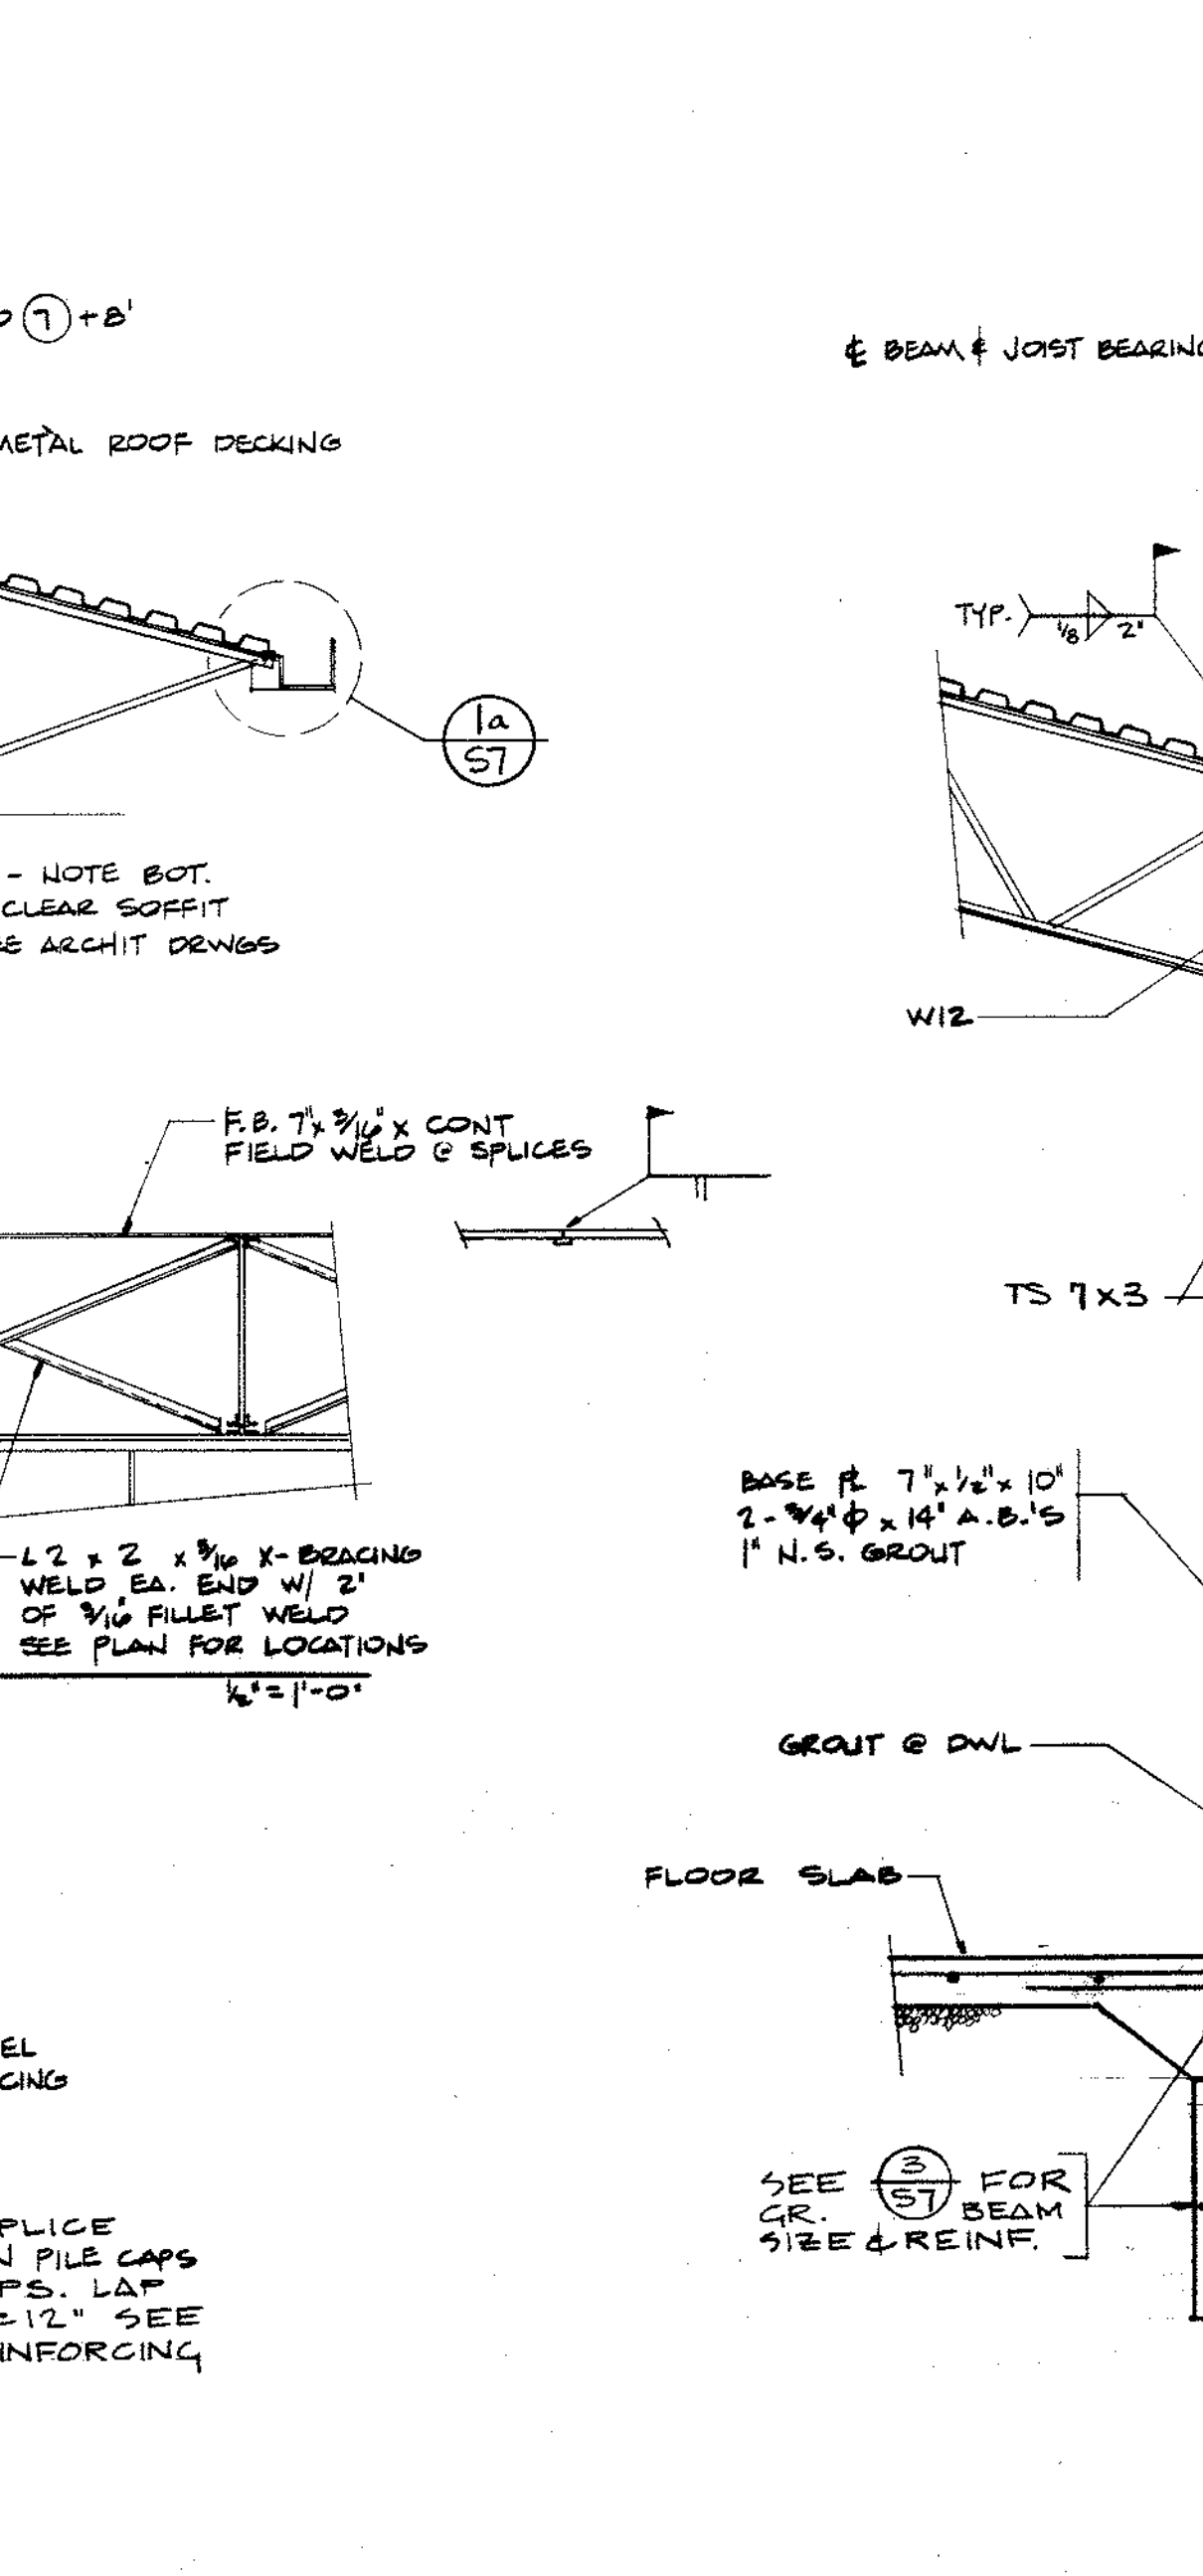

2
1/2" = 1'-0"

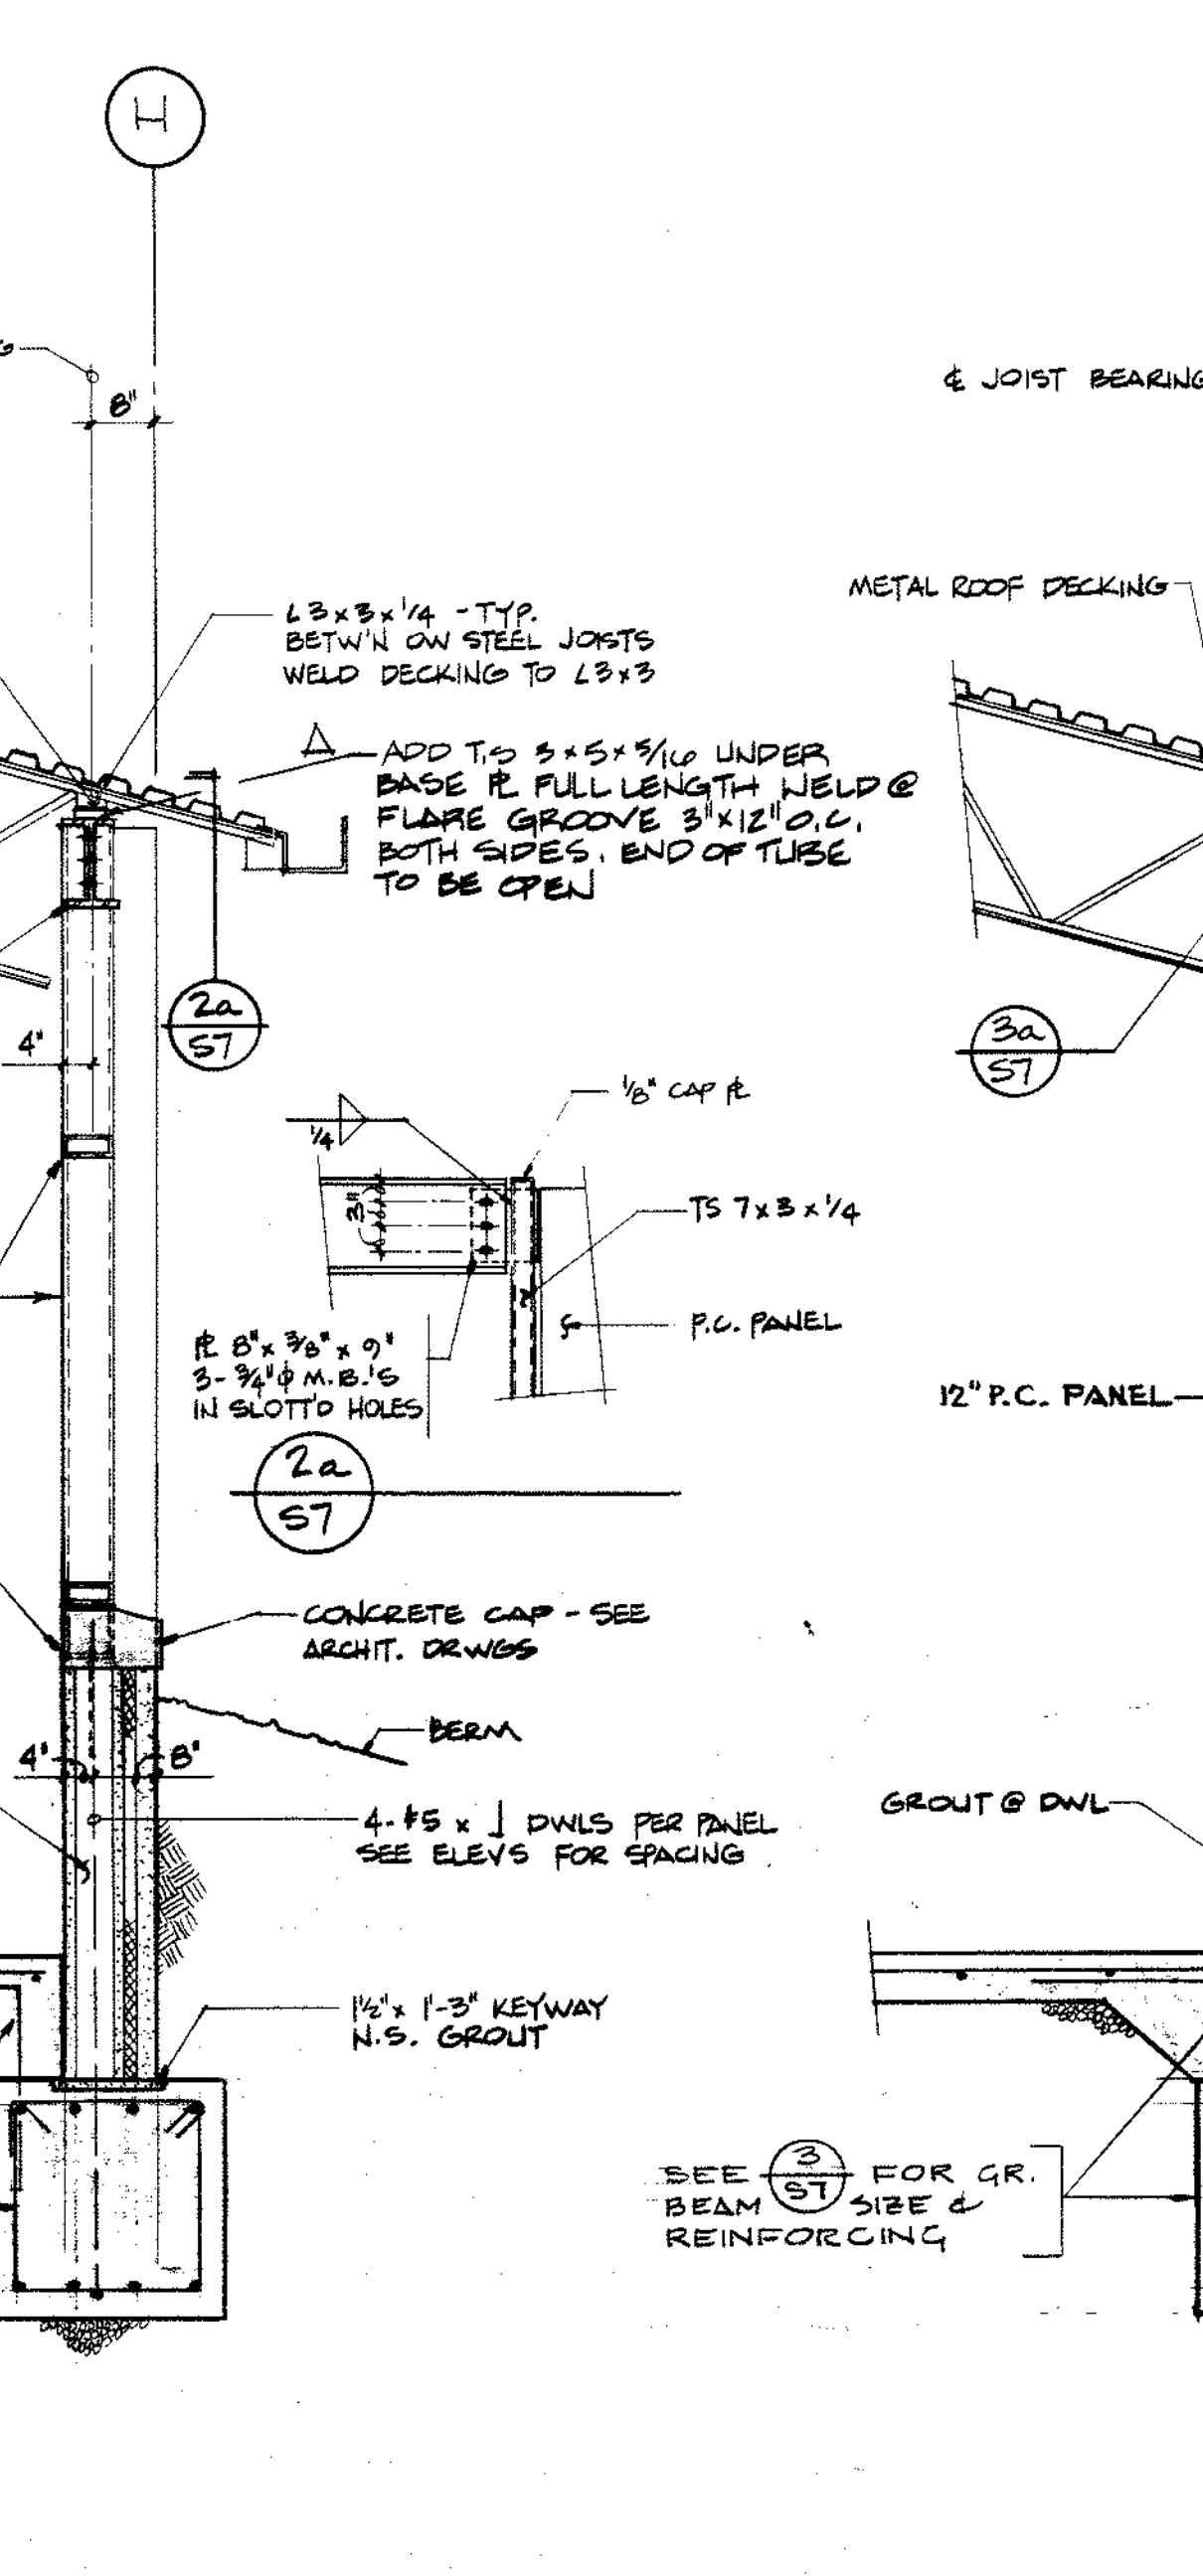

1
1/2" = 1'-0"

miller-cook architects a.i.a.
 30 BANK WAY SUITE 11-1608
 PORTLAND, OREGON 97206
 (503) 226-0828

REGISTERED ARCHITECT
 STATE OF OREGON
 JACK C. MILLER
 PORTLAND OREGON 1964


SHEET TITLE: CROSS SECTION & WALL SECTIONS / CORROSION CONTROL
C-130 FUEL SYSTEM / CORROSION CONTROL
304TH AIR RESCUE RECOVERY SQUADRON
PORTLAND INTERNATIONAL AIRPORT
 PORTLAND OREGON

RECORD DRAWINGS FROM INFORMATION SUPPLIED BY THE GENERAL CONTRACTOR

S-7

BLDG 375

DATE: FEB 26, 1990
 JOB NO: 84-125
 REVISIONS: AS BUILT 11-16-87

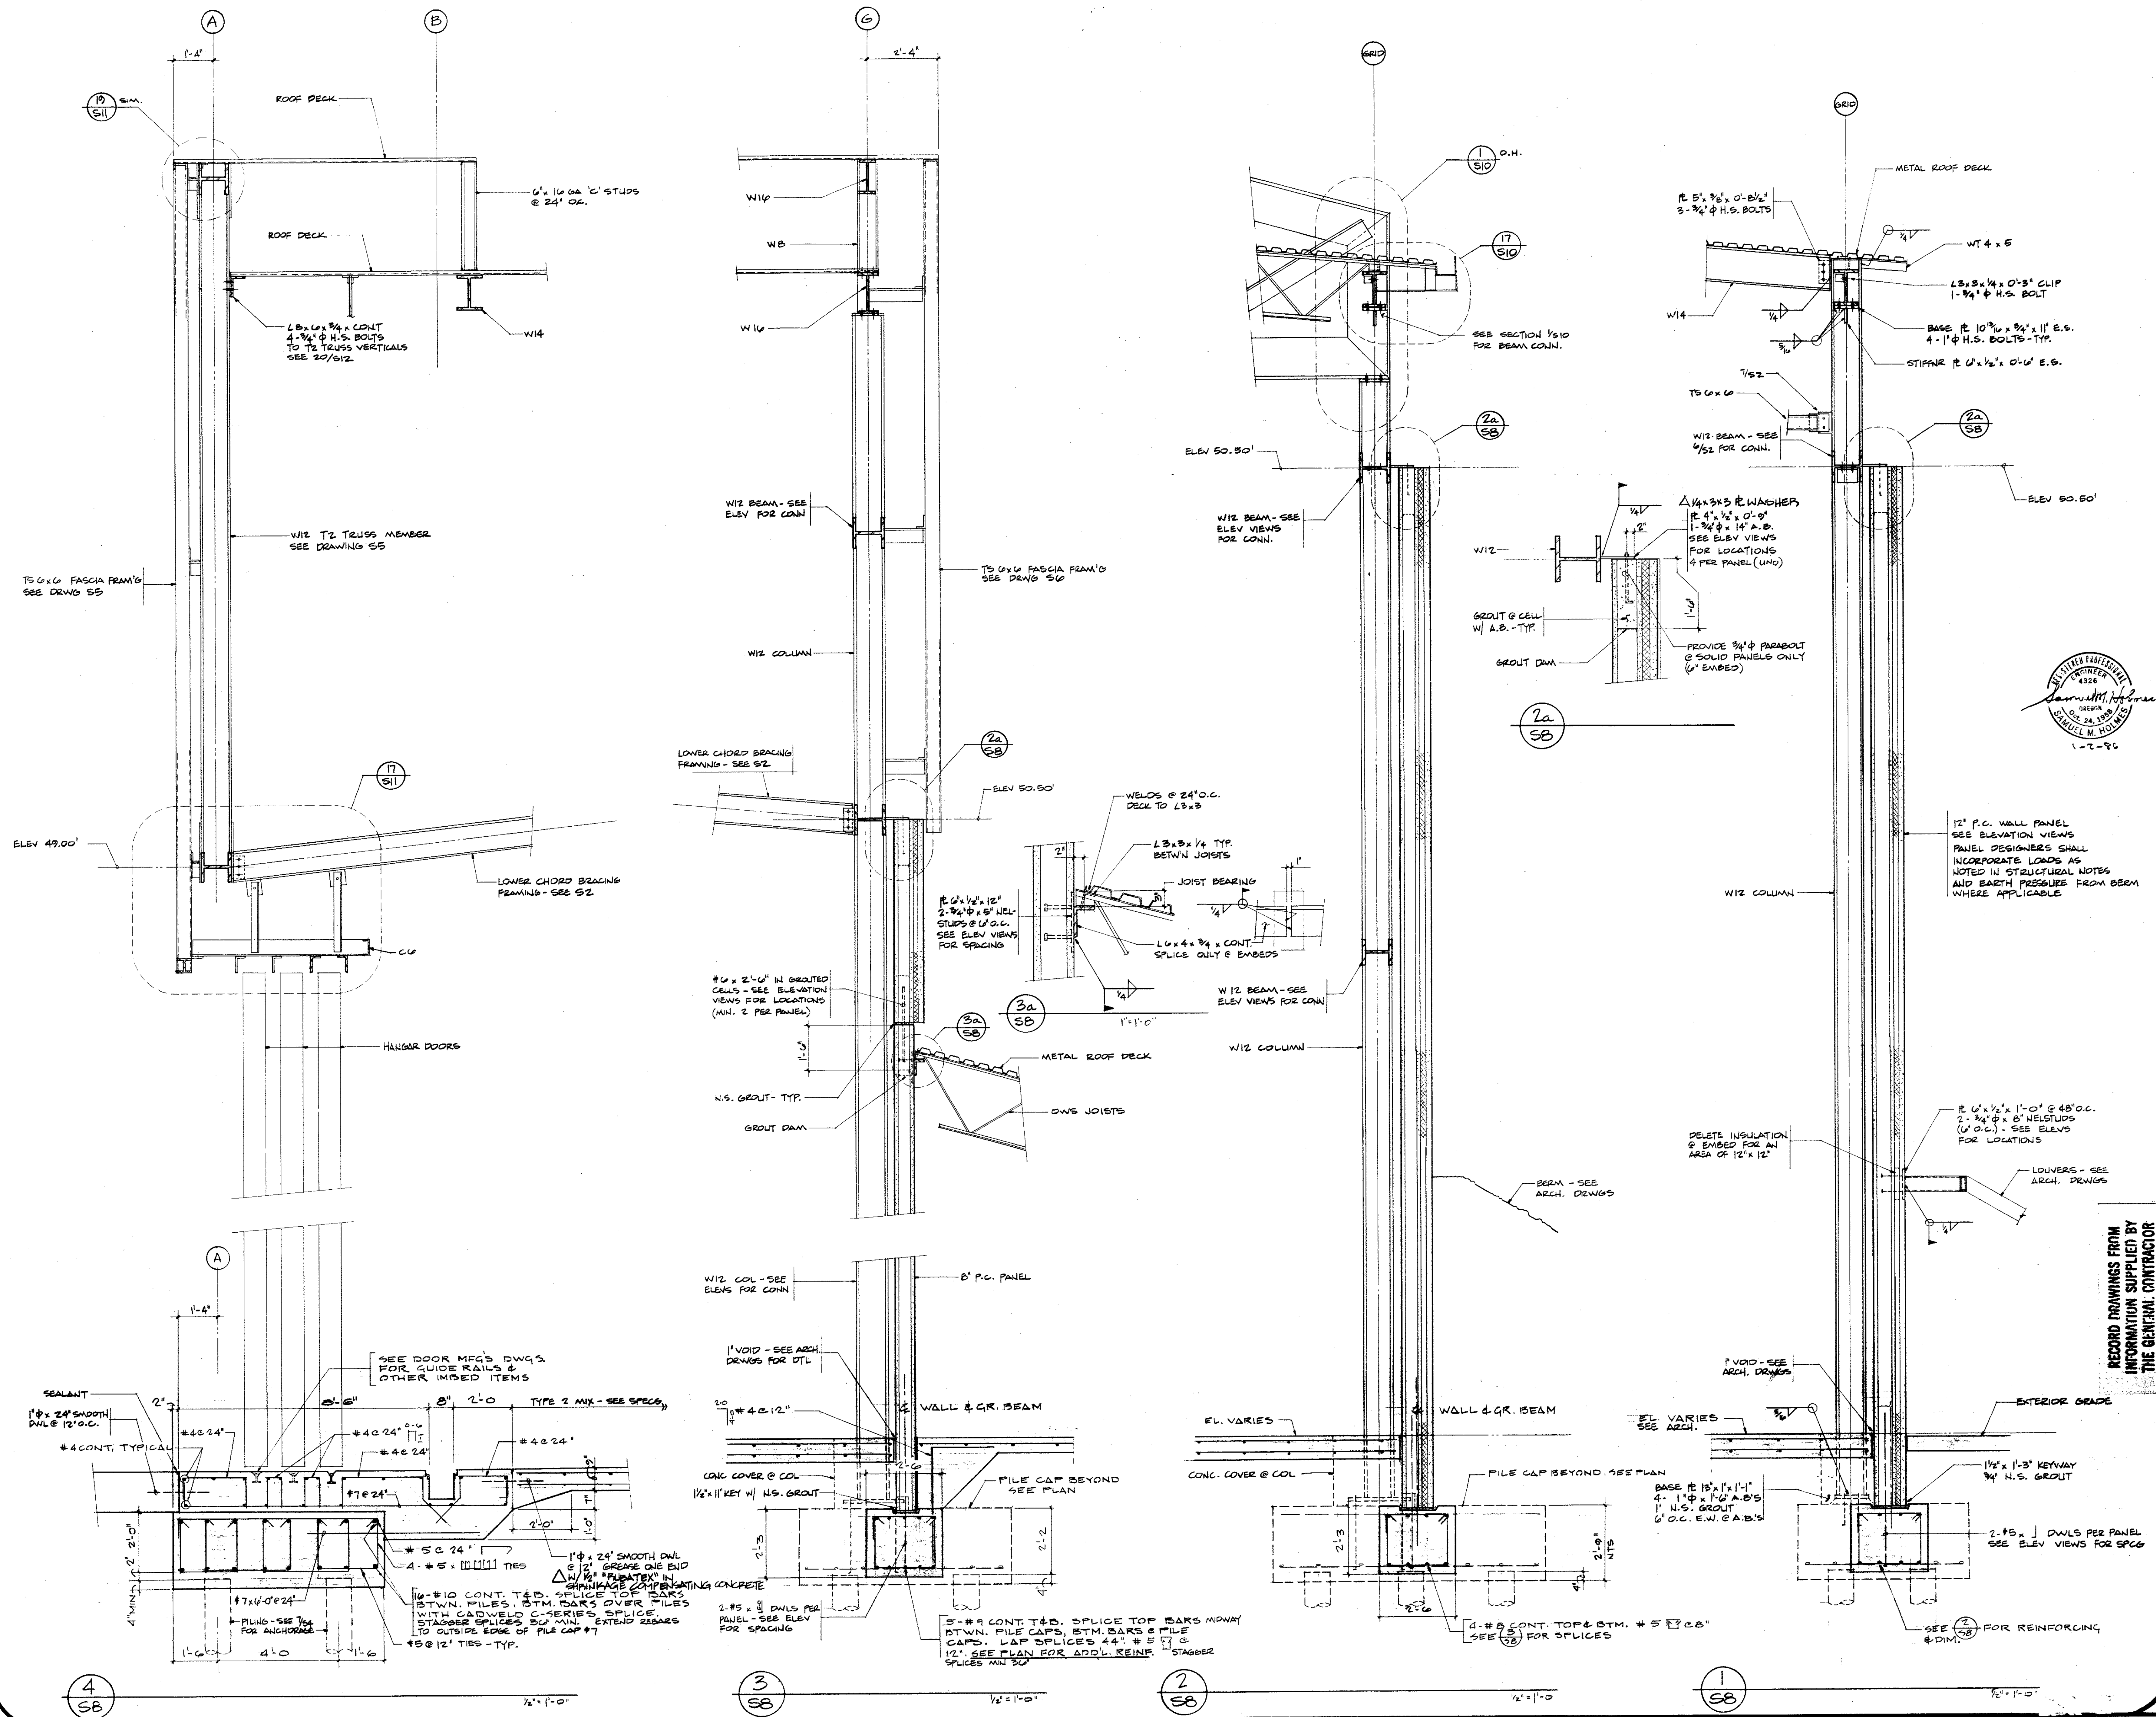


miller · cook architects a.i.a.
 300 N.W. 4th Ave.
 Portland, Oregon
 (503) 228-0828
 57208

DATE: FEB. 24, 1980
 JOB NO: 84-156
 REVISIONS: AS BUILT 11-14-81




REGISTERED ARCHITECT
 MAX C. MILLER
 Jack C. Miller
 PORTLAND, OREGON
 1964

SHEET TITLE: WALL SECTIONS
C-130 FUEL SYSTEM / CORROSION CONTROL
MAINTENANCE HANGAR
304th AIR RESCUE RECOVERY SQUADRON
PORTLAND INTERNATIONAL AIRPORT
 PORTLAND, OREGON

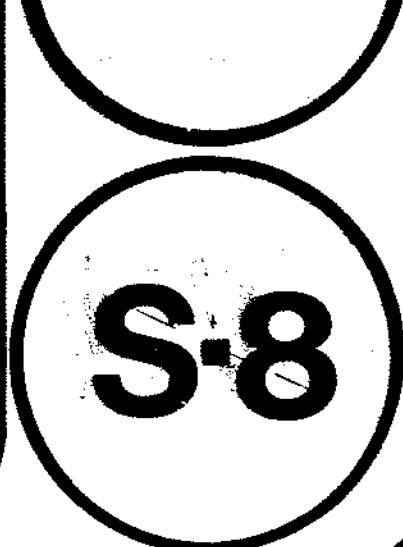


RECORD DRAWINGS FROM WALL SECTIONS INFORMATION SUPPLIED BY THE GENERAL CONTRACTOR

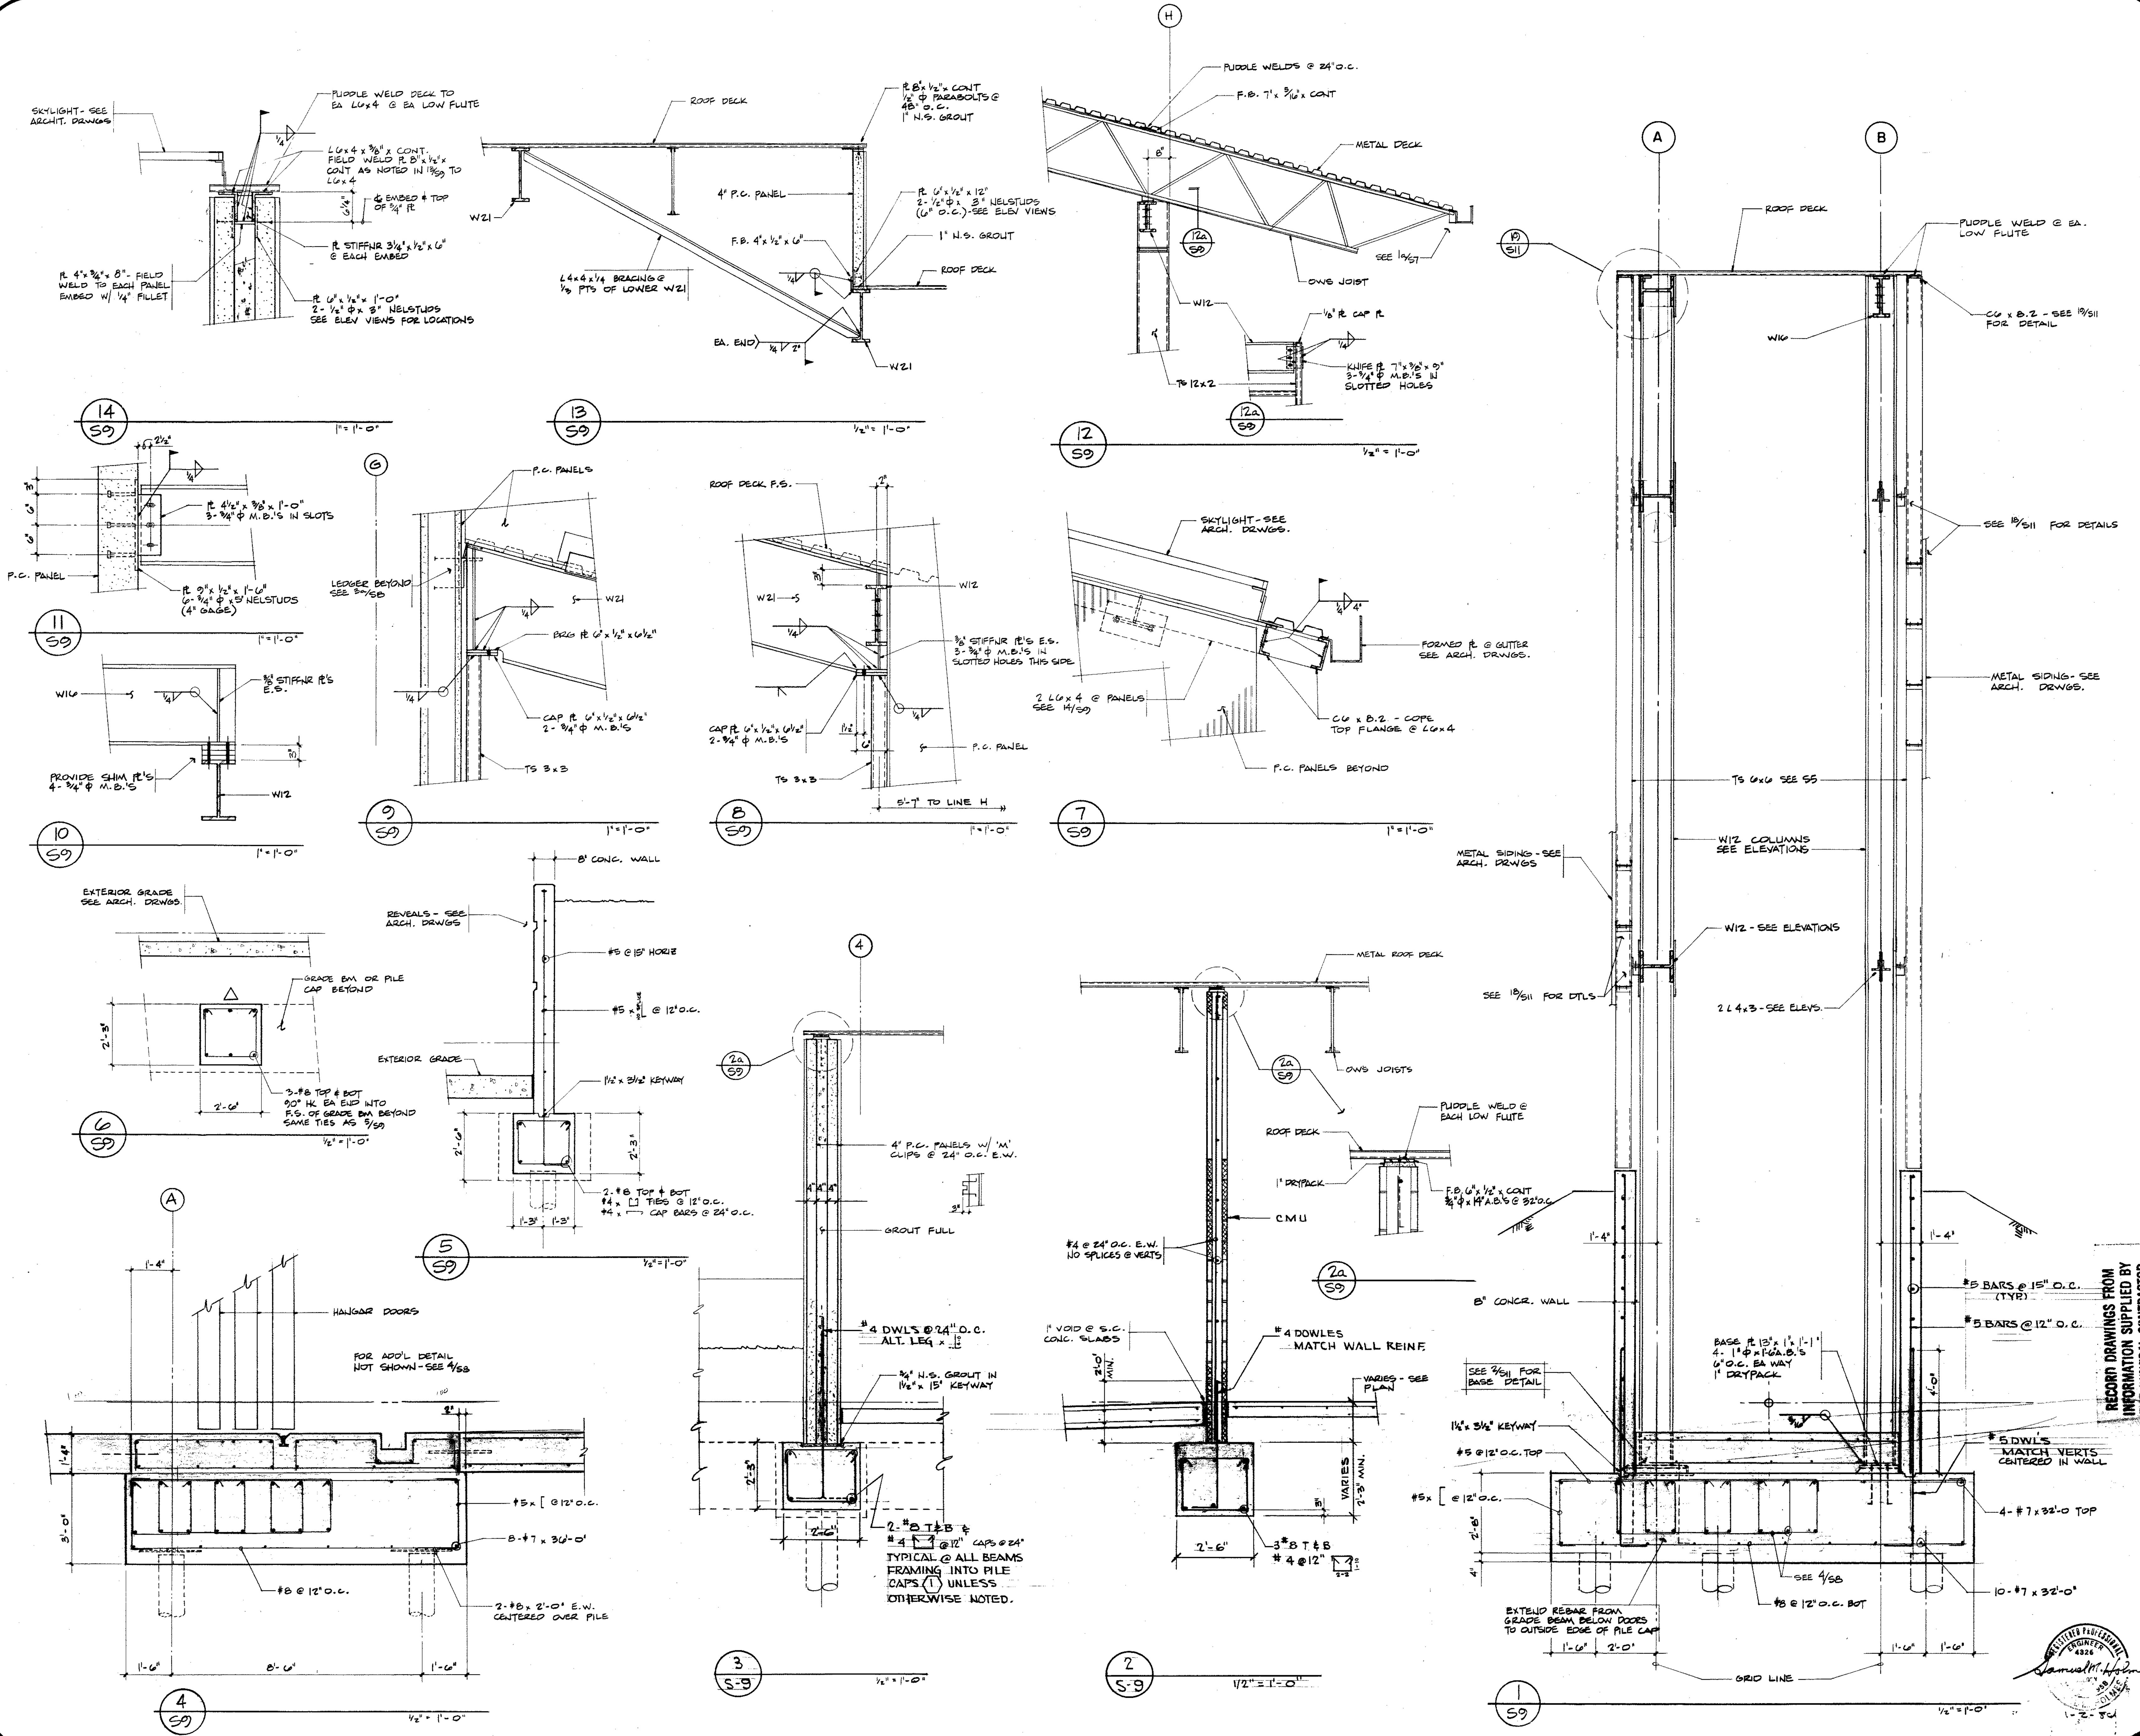

miller-cook architects a.i.a.
 30 N.W. 1st Ave.
 Portland, Oregon
 (503) 266-0828
 877605


DATE: FEB. 20, 1980
 JOB NO: 84-125
 REVISIONS: AS BUILT 11/16/87

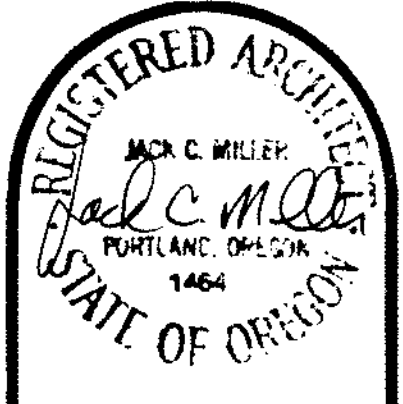


SHEET TITLE: **E-WALL SECTIONS**
C-130 FUEL SYSTEM / CORROSION CONTROL
MAINTENANCE HANGAR
304th AIR RESCUE RECOVERY SQUADRON
PORTLAND INTERNATIONAL AIRPORT
 OREGON

S-9

RECORD DRAWINGS FROM INFORMATION SUPPLIED BY THE GENERAL CONTRACTOR

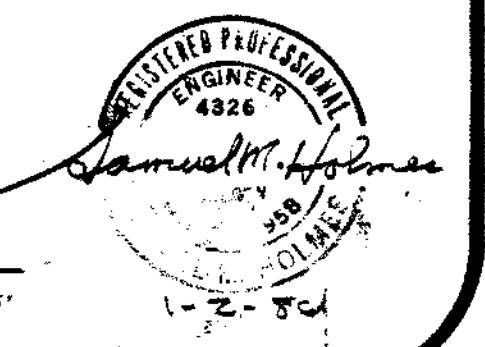

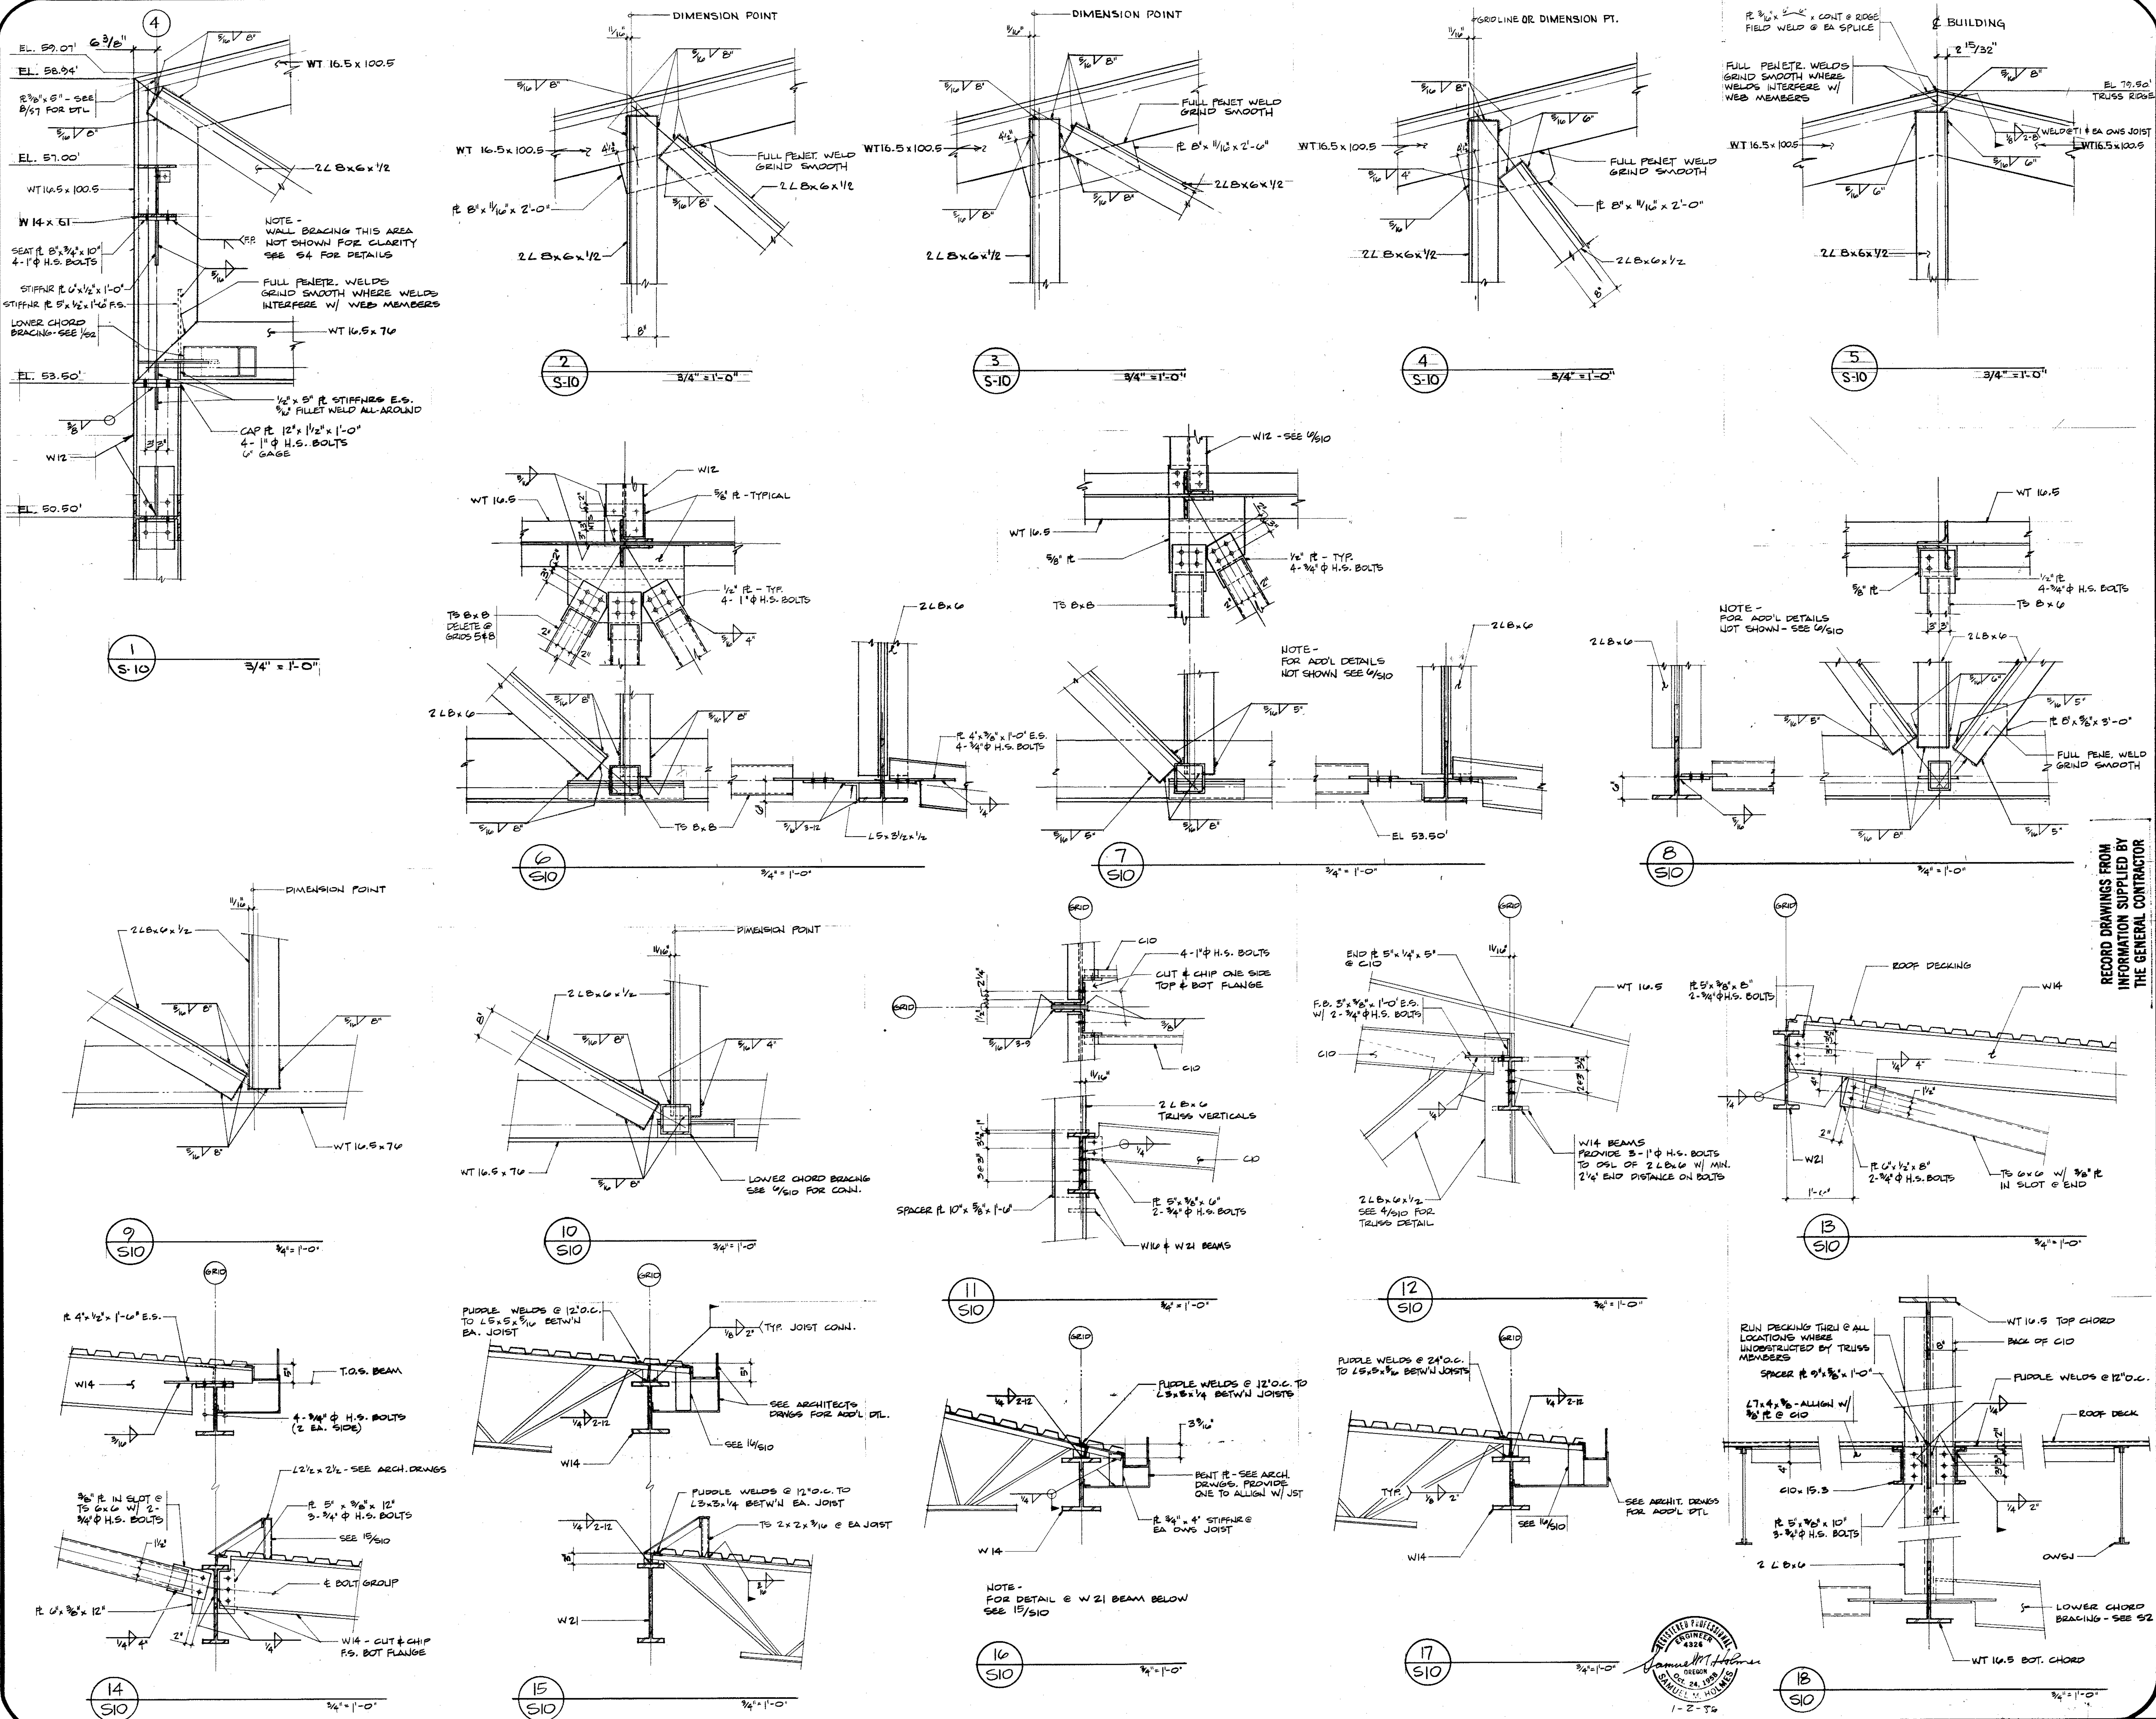

DATE FEB 21, 1980
 JOB NO 04-105
 REVISIONS AS BUILT 11-10-87




REGISTERED ARCHITECT
 JAMES C. MILLER
 PORTLAND, OREGON
 1944
 STATE OF OREGON

RECORD DRAWINGS FROM INFORMATION SUPPLIED BY THE GENERAL CONTRACTOR

SHEET TITLE
C-130 FUEL SYSTEM / CORROSION CONTROL MAINTENANCE HANGAR
304th AIR RESCUE RECOVERY SQUADRON
PORTLAND INTERNATIONAL AIRPORT
 PORTLAND, OREGON

S-10

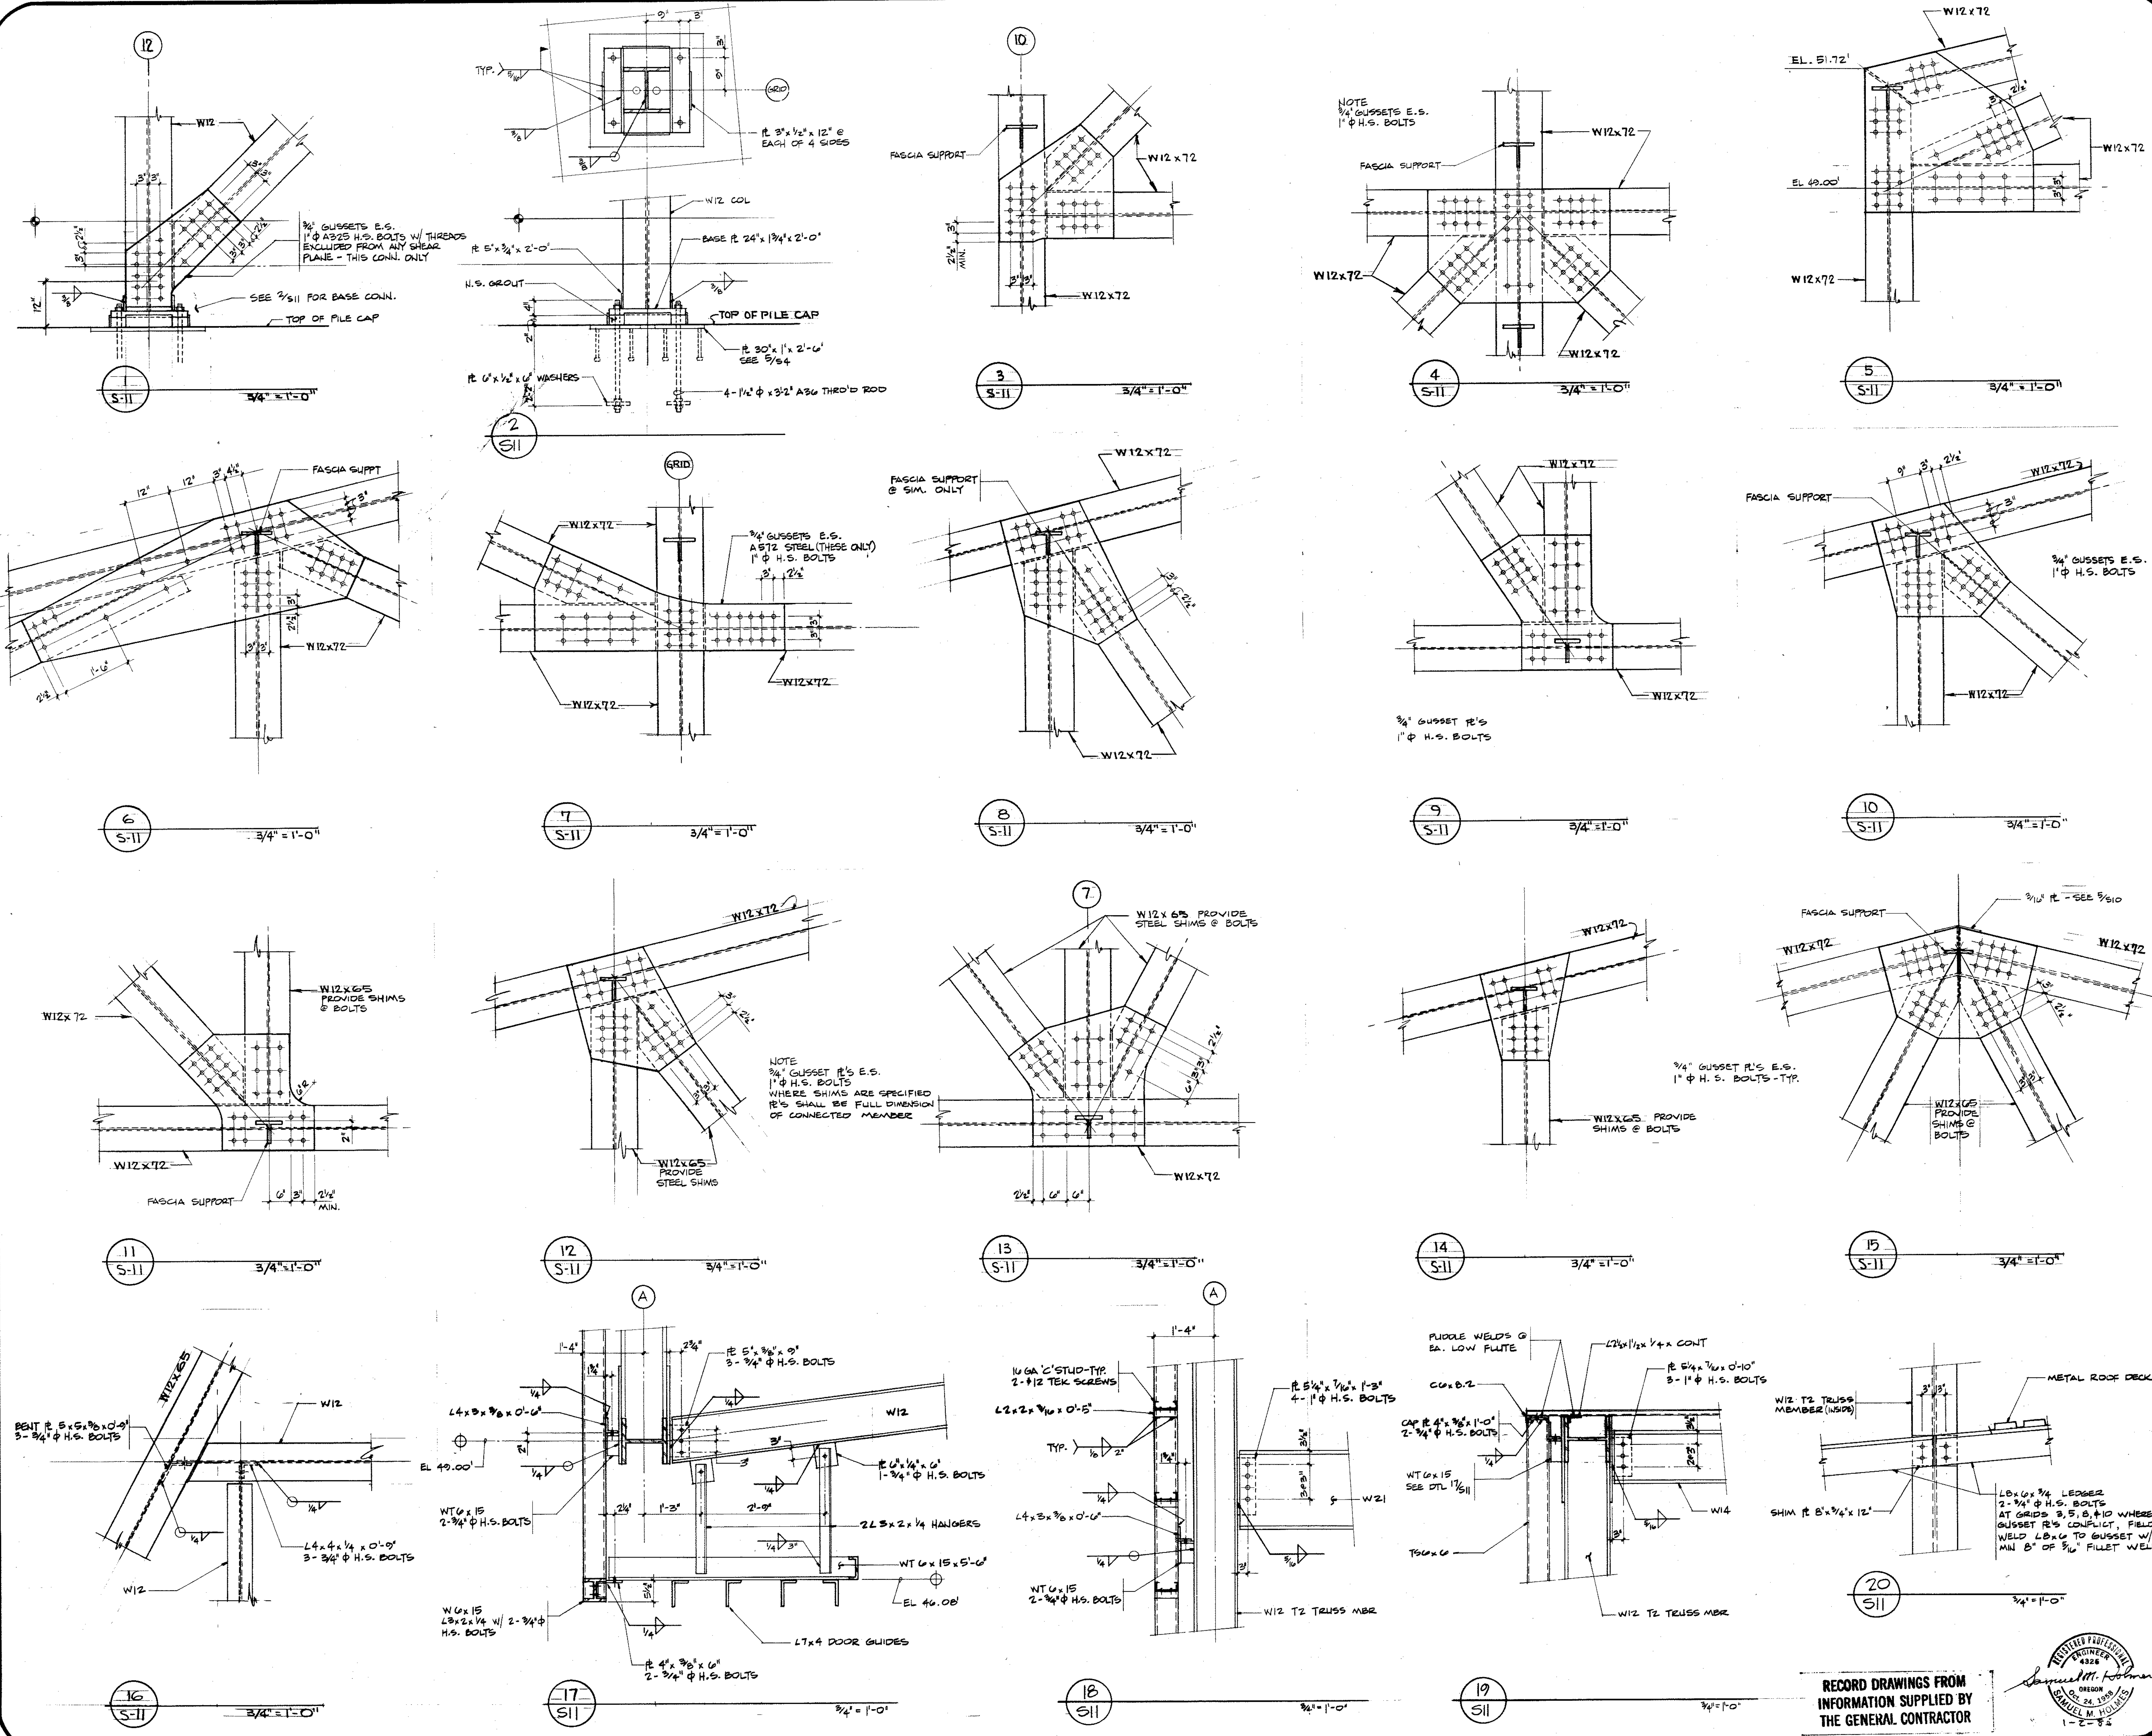

miller-cook architects a.i.a.
 30 N.W. 7th Ave.
 PORTLAND, OREGON
 (503) 228-8700


DATE FEB 20, 1970
 JOB NO 04-125
 REVISIONS AS BUILT 11-16-87




SHEET TITLE: FUEL SYSTEM / CORROSION CONTROL
C-130 FUEL SYSTEM / CORROSION CONTROL
MAINTENANCE HANGAR
304th AIR RESCUE RECOVERY SQUADRON
PORTLAND INTERNATIONAL AIRPORT
 PORTLAND OREGON

S-11


RECORD DRAWINGS FROM
 INFORMATION SUPPLIED BY
 THE GENERAL CONTRACTOR

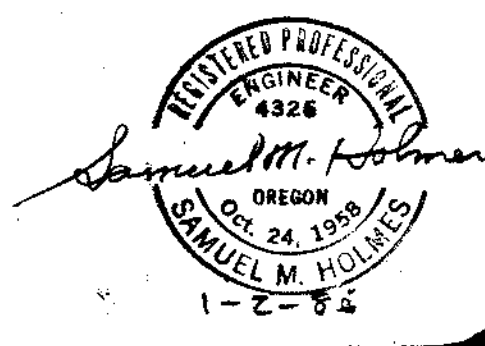

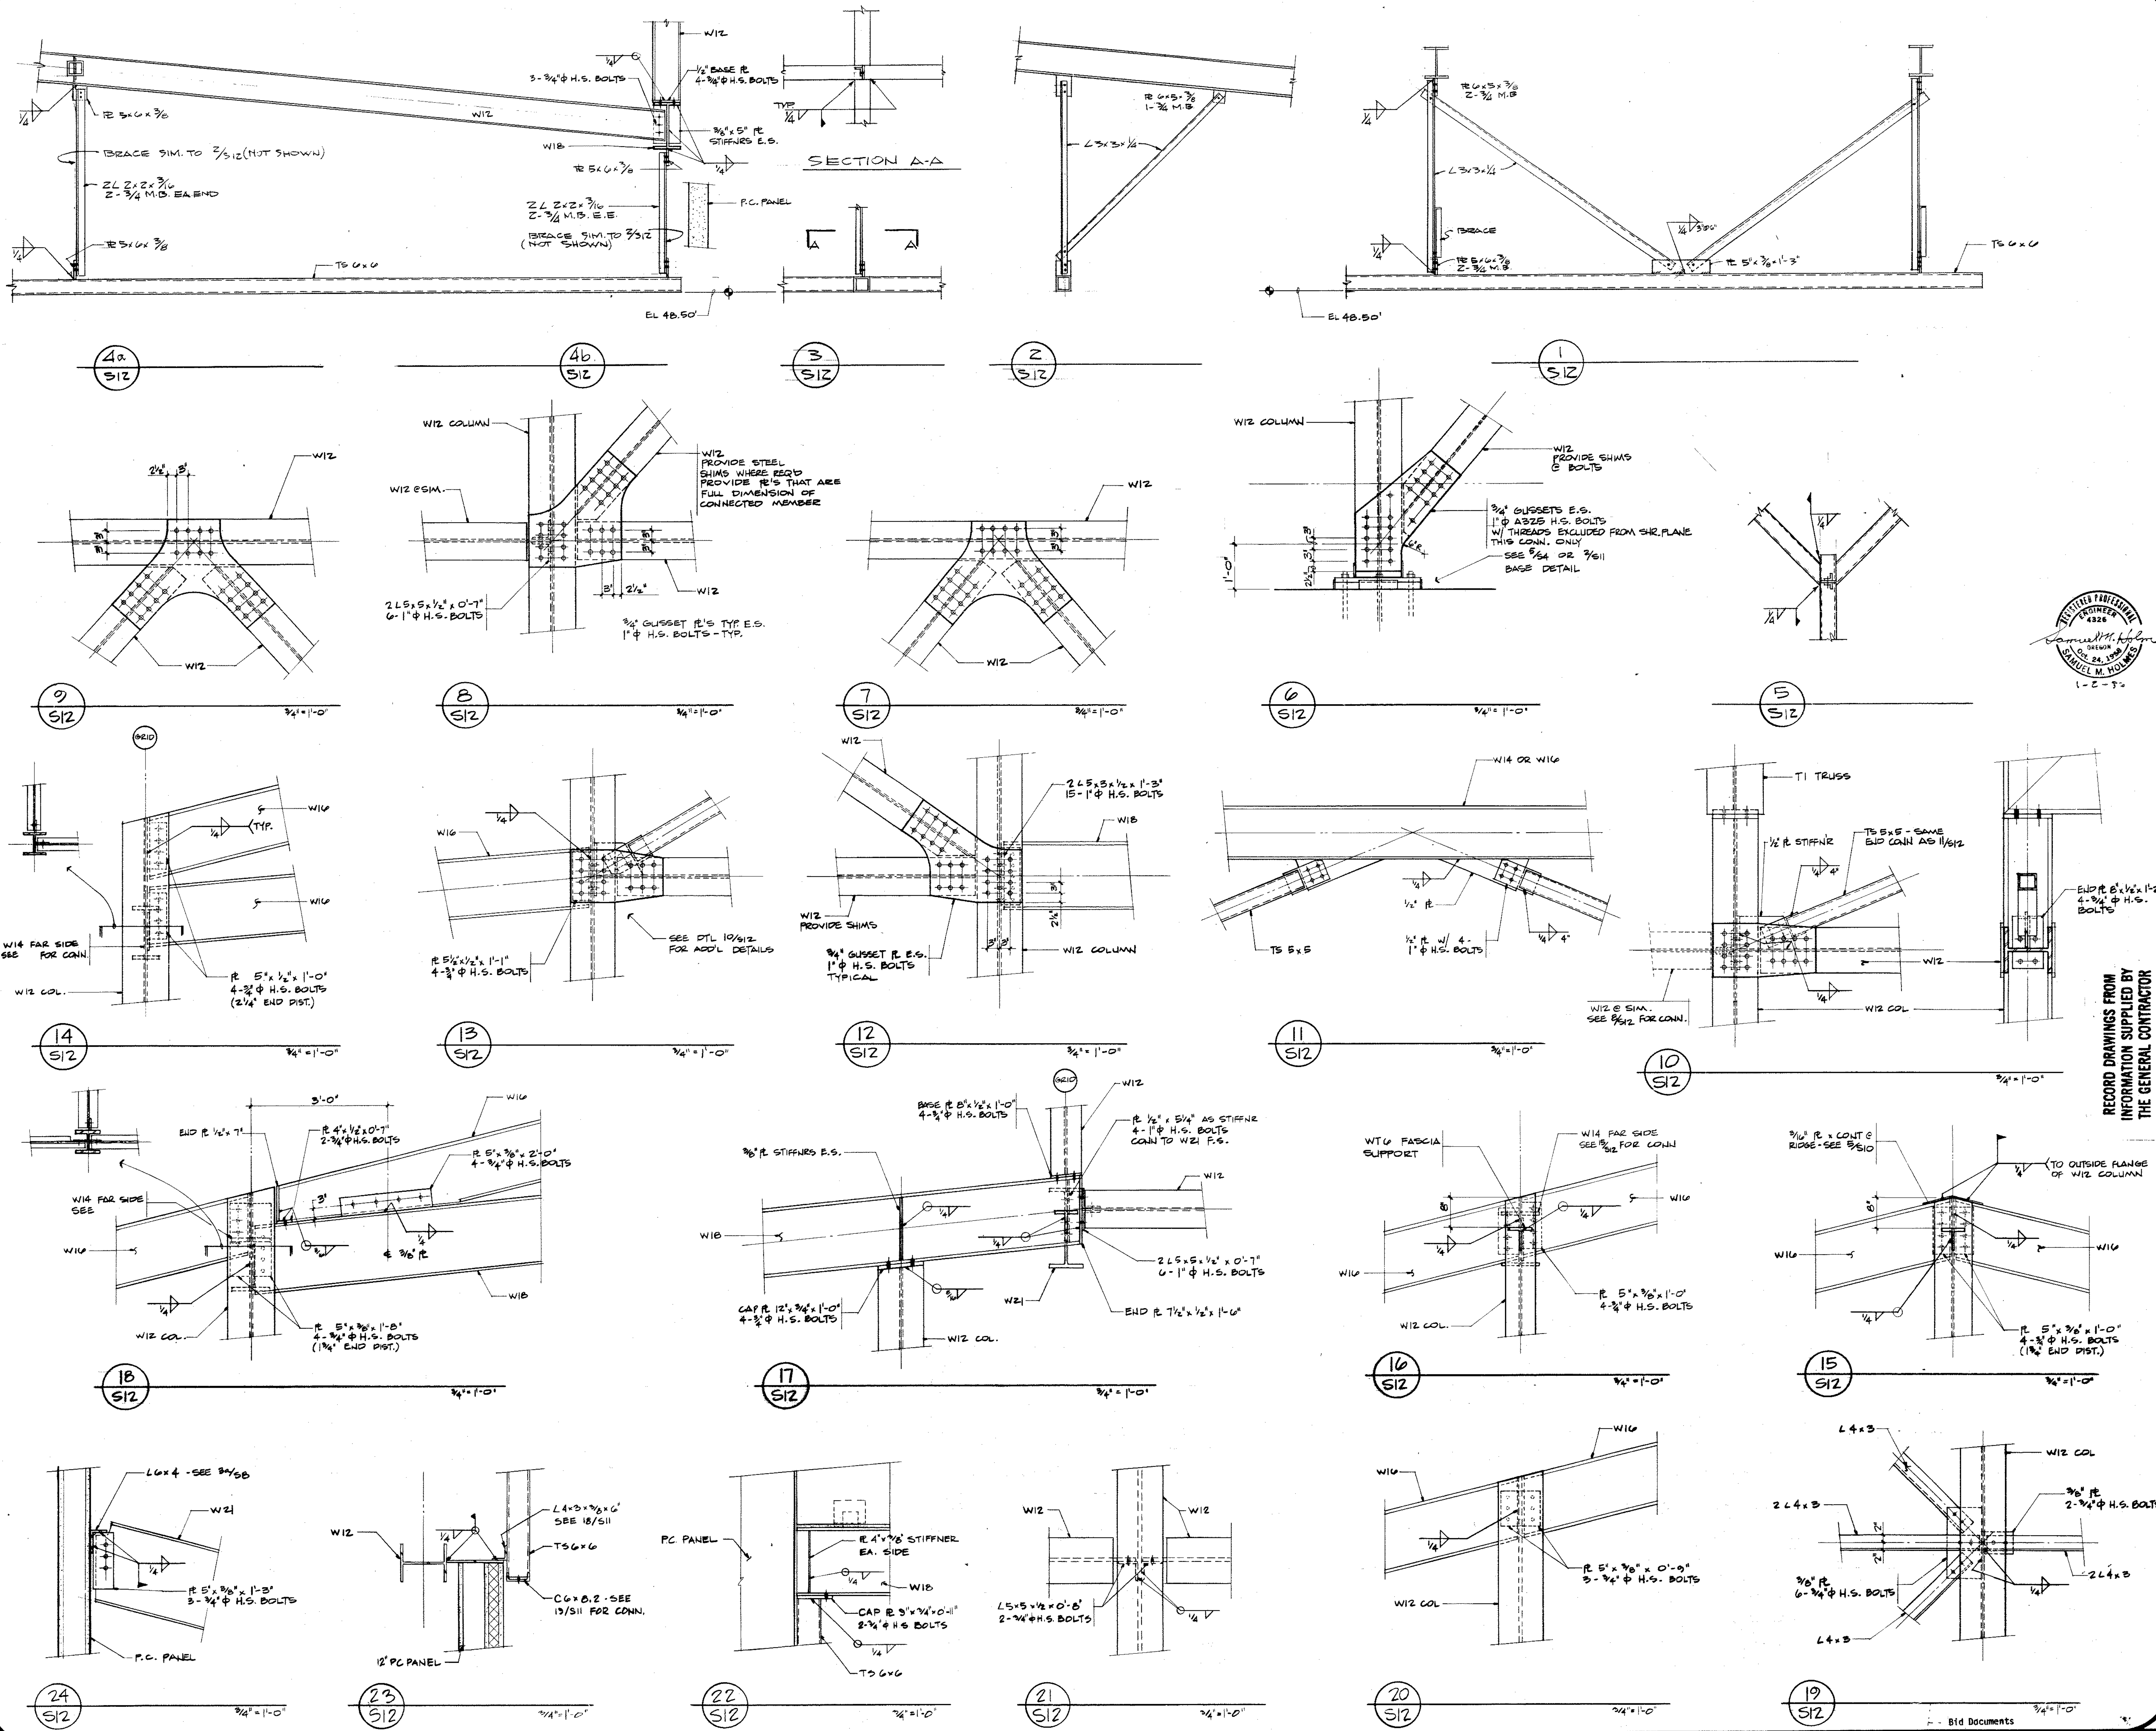

miller-cook architects a.i.a.
 30 N.W. 4th Ave.
 PORTLAND, OREGON
 (503) 228-0898
 97208











DATE FEB 20, 1970
 JOB NO 04-125
 REVISIONS AS BUILT 11-10-87

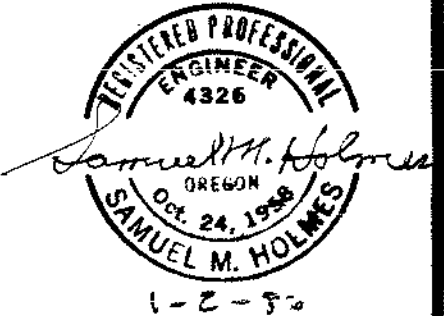

RECORD DRAWINGS FROM
 INFORMATION SUPPLIED BY
 THE GENERAL CONTRACTOR

SHEET TITLE
 G-130 FUEL SYSTEM / CORROSION CONTROL
 MAINTENANCE HANGAR
 304TH AIR RESCUE RECOVERY SQUADRON
 PORTLAND INTERNATIONAL AIRPORT
 PORTLAND, OREGON

S-12

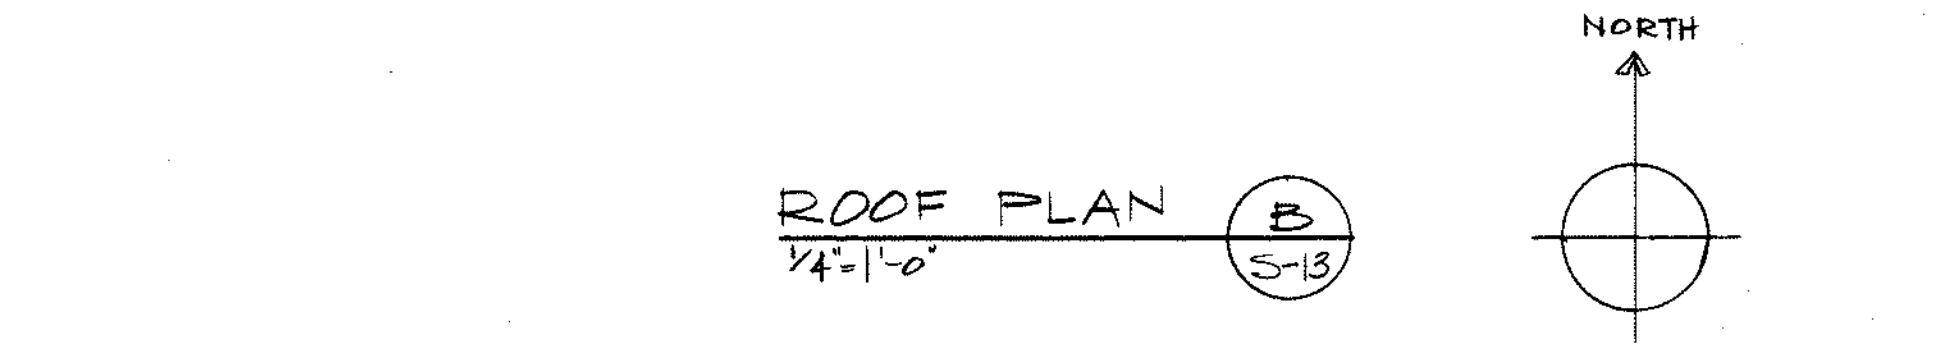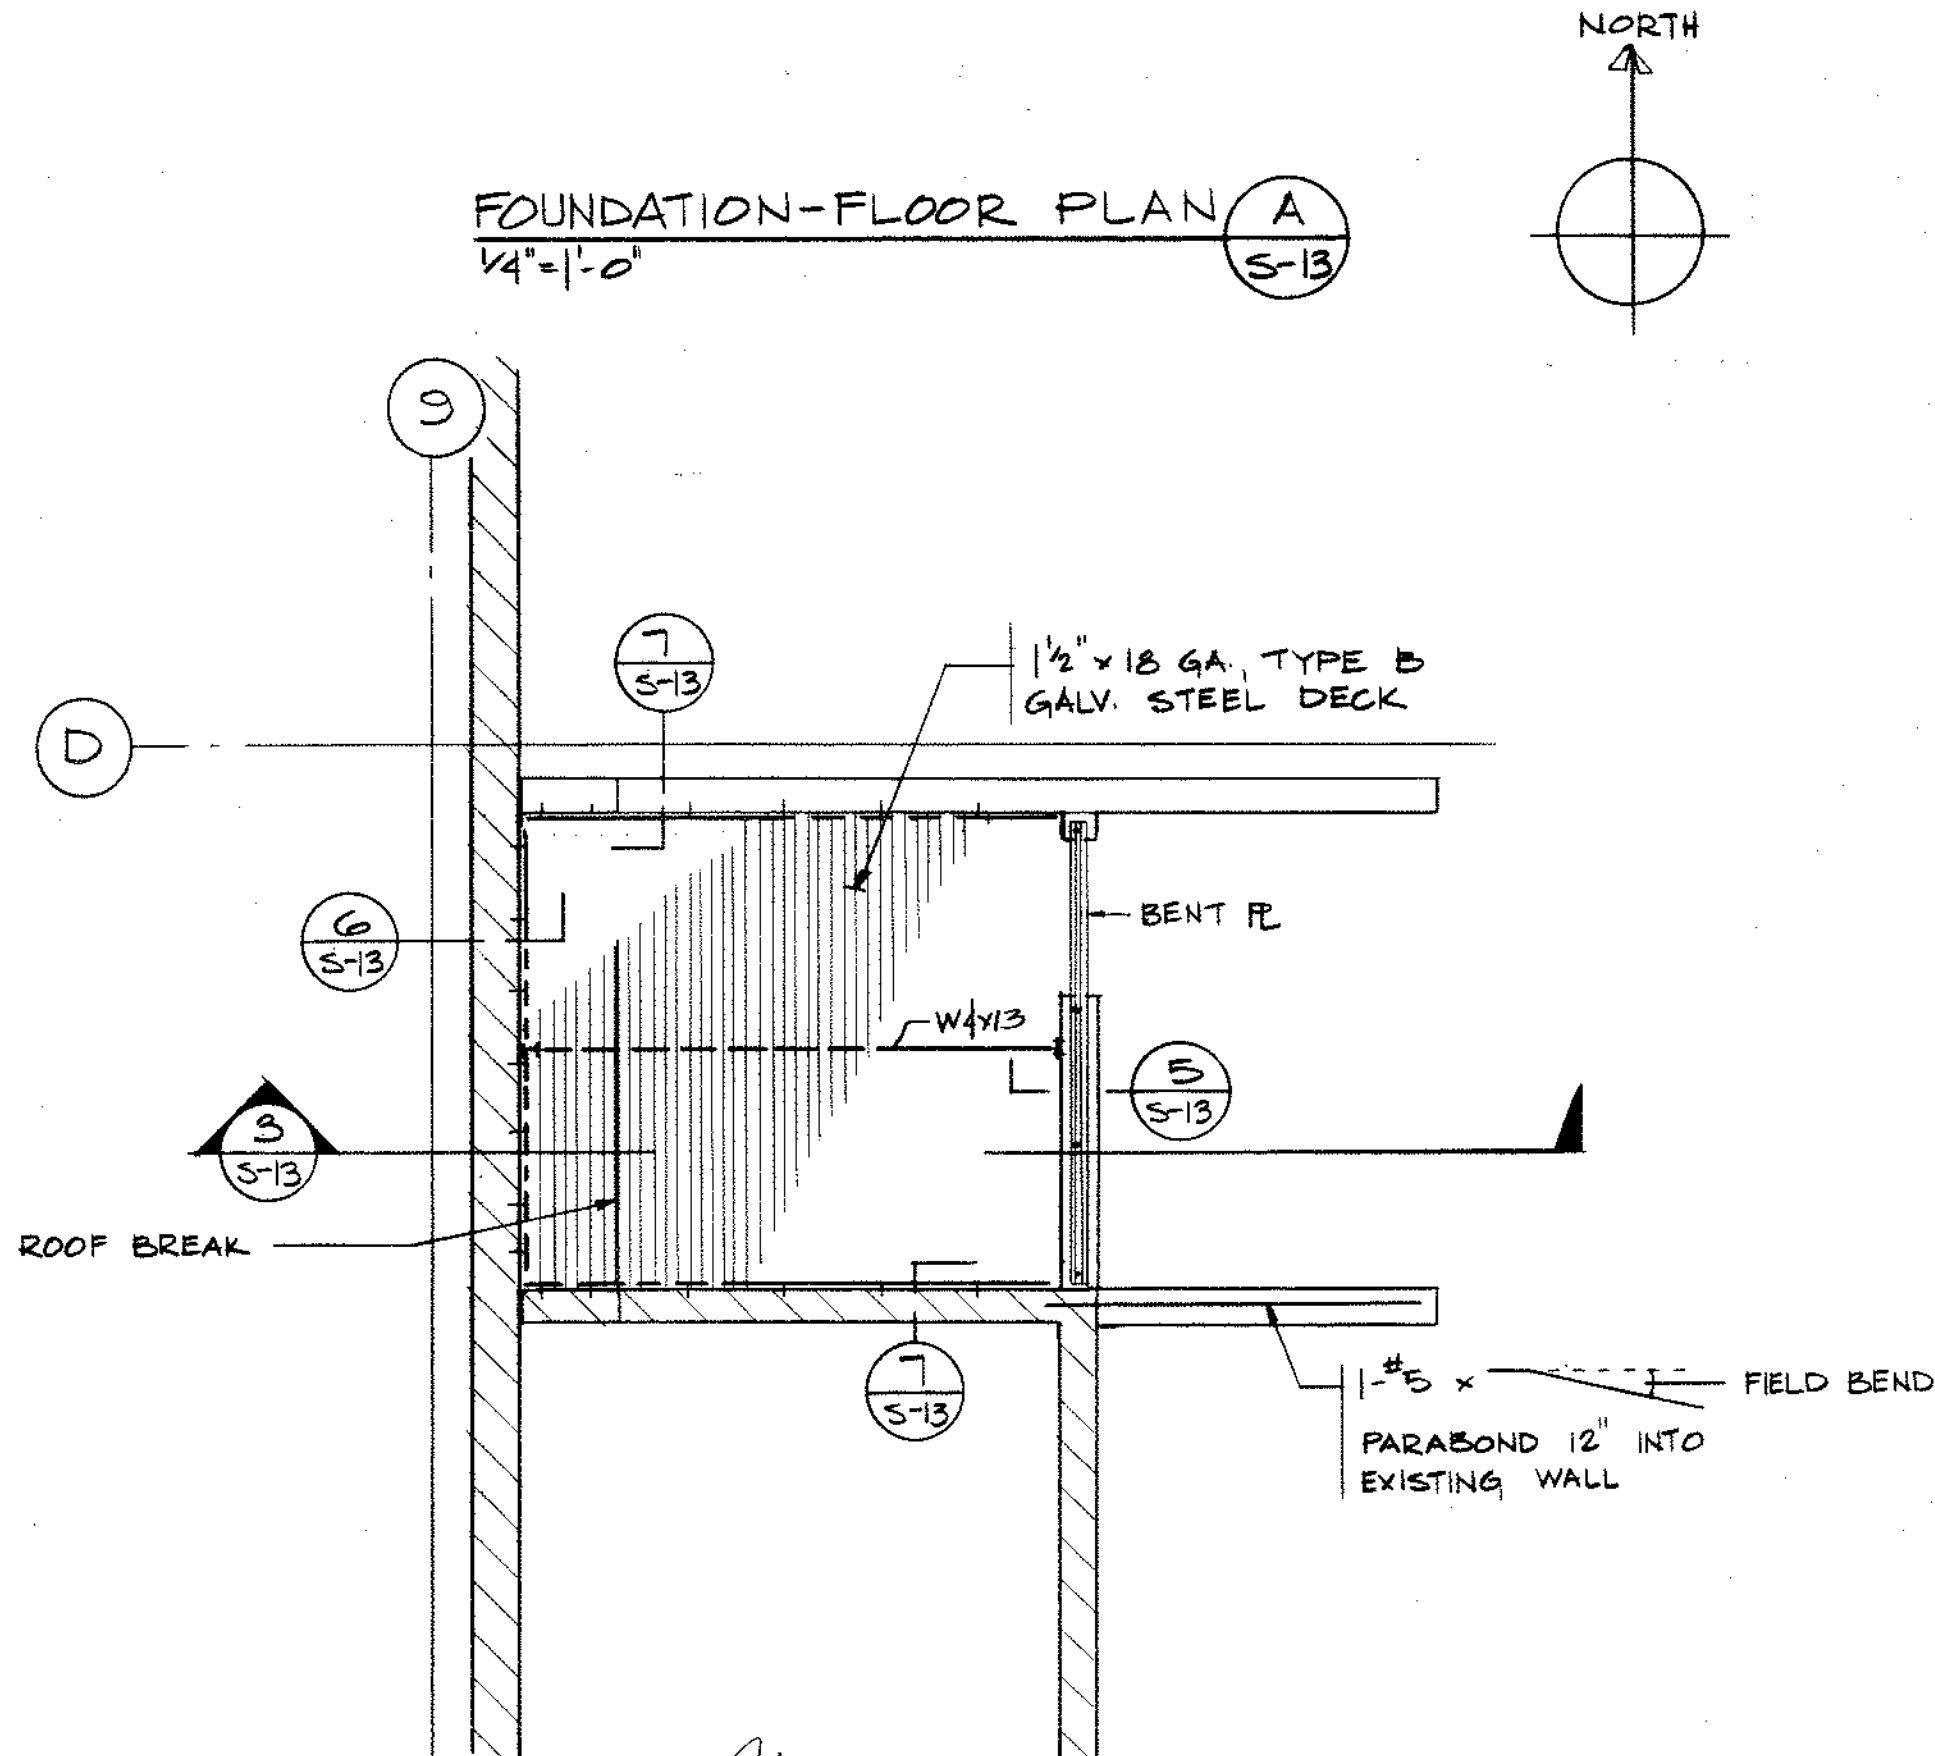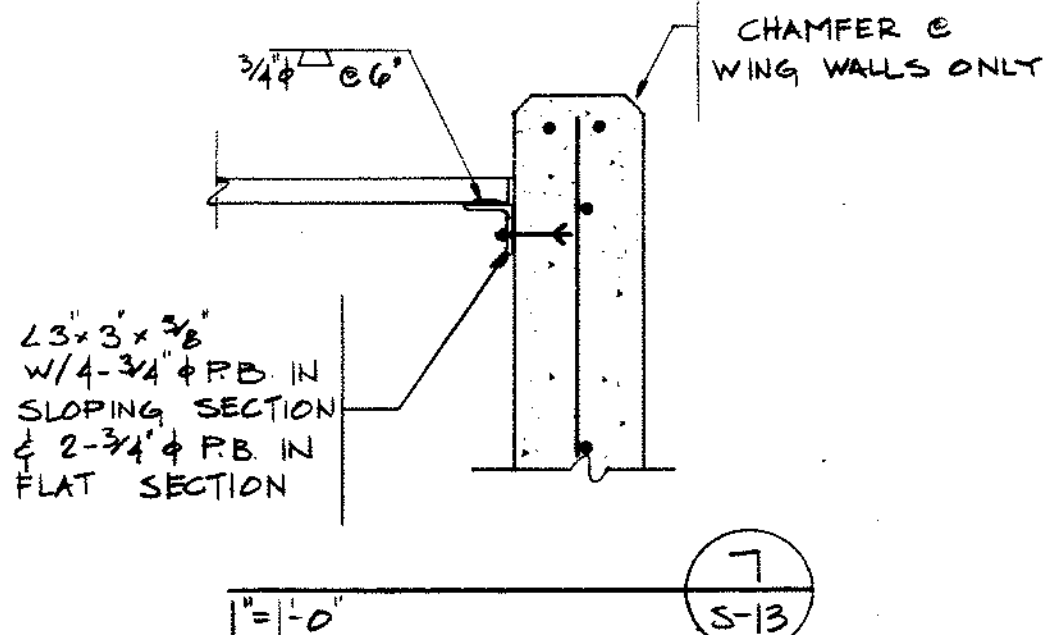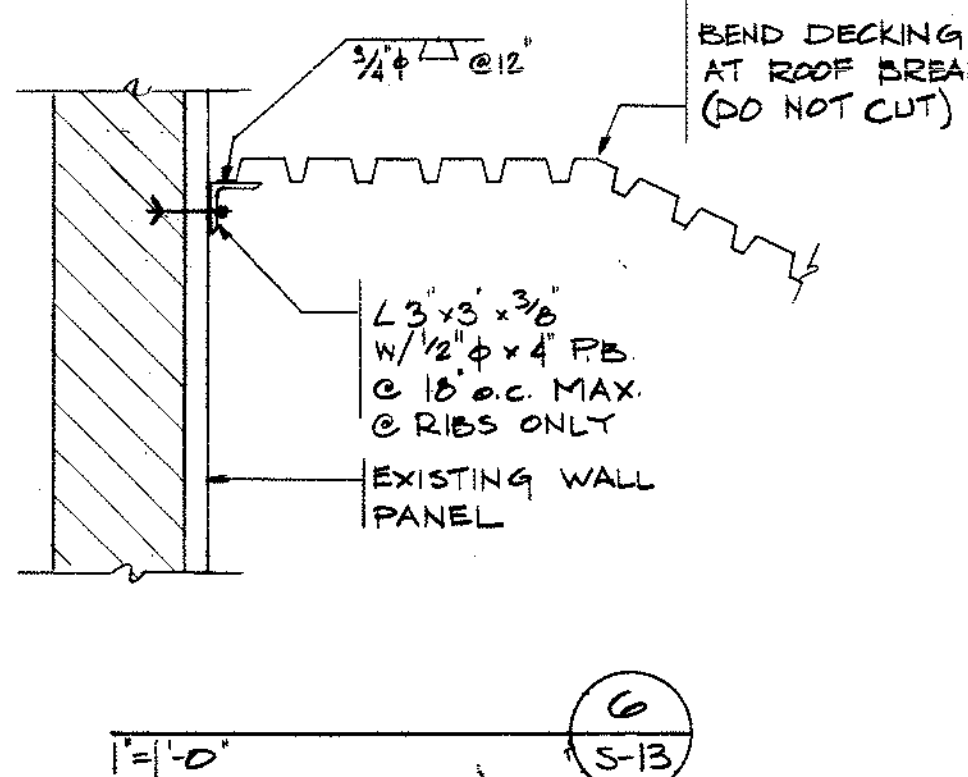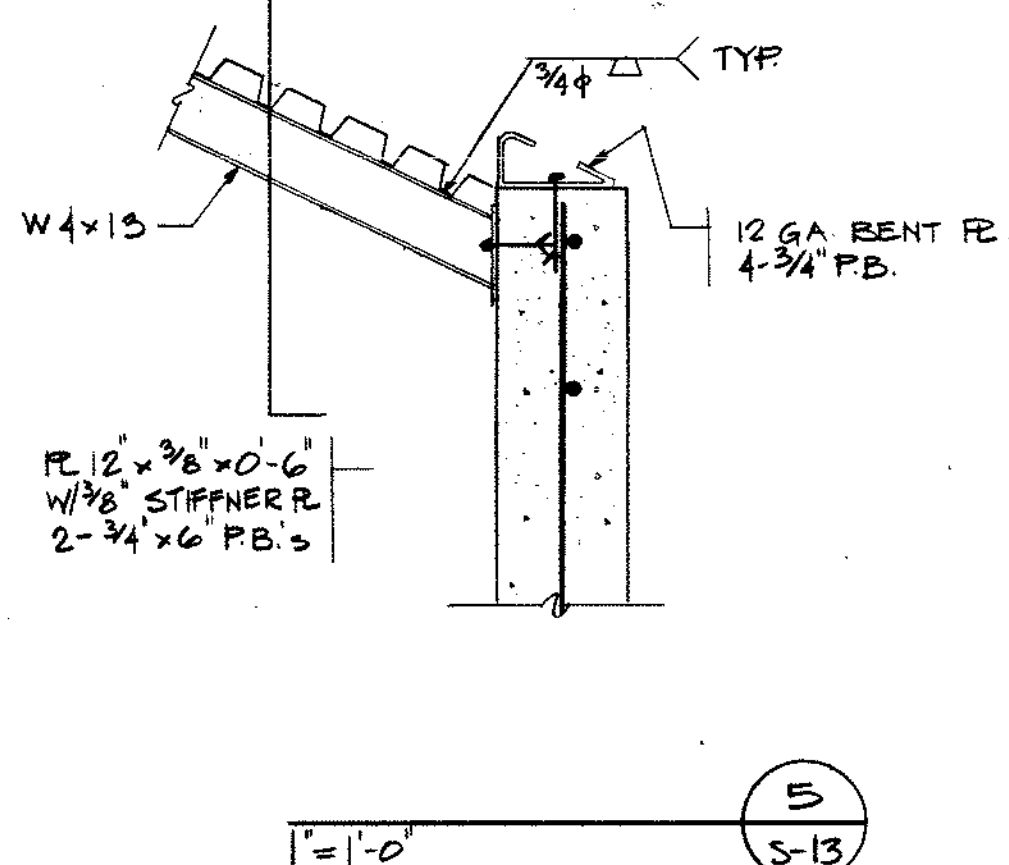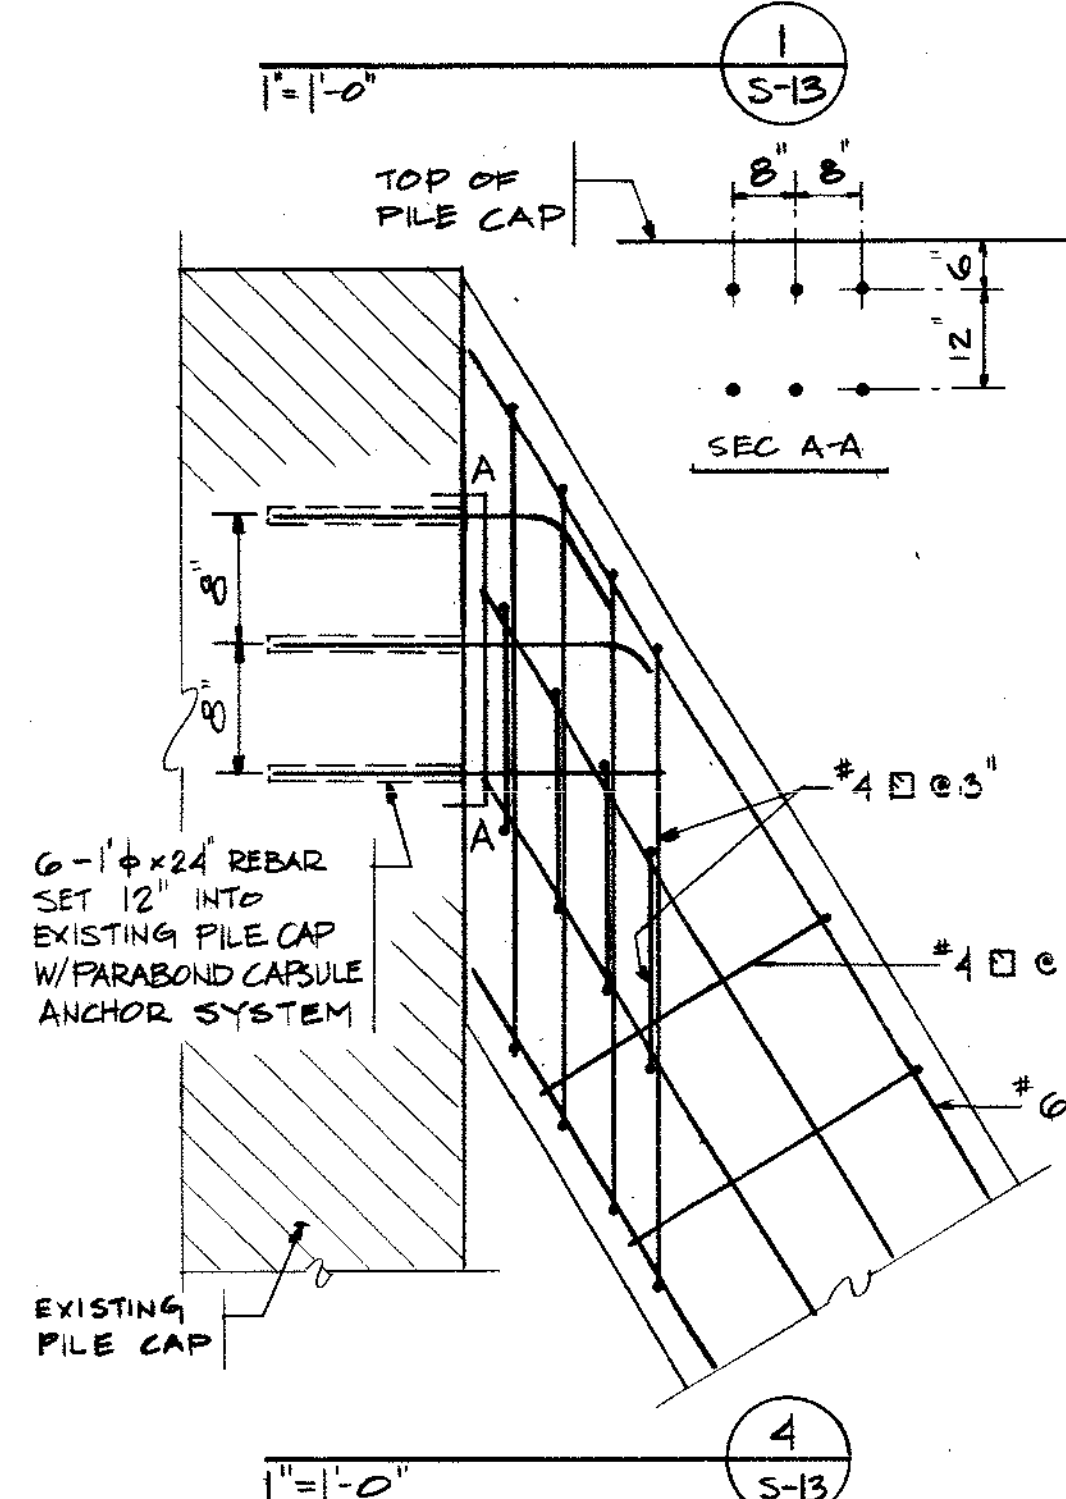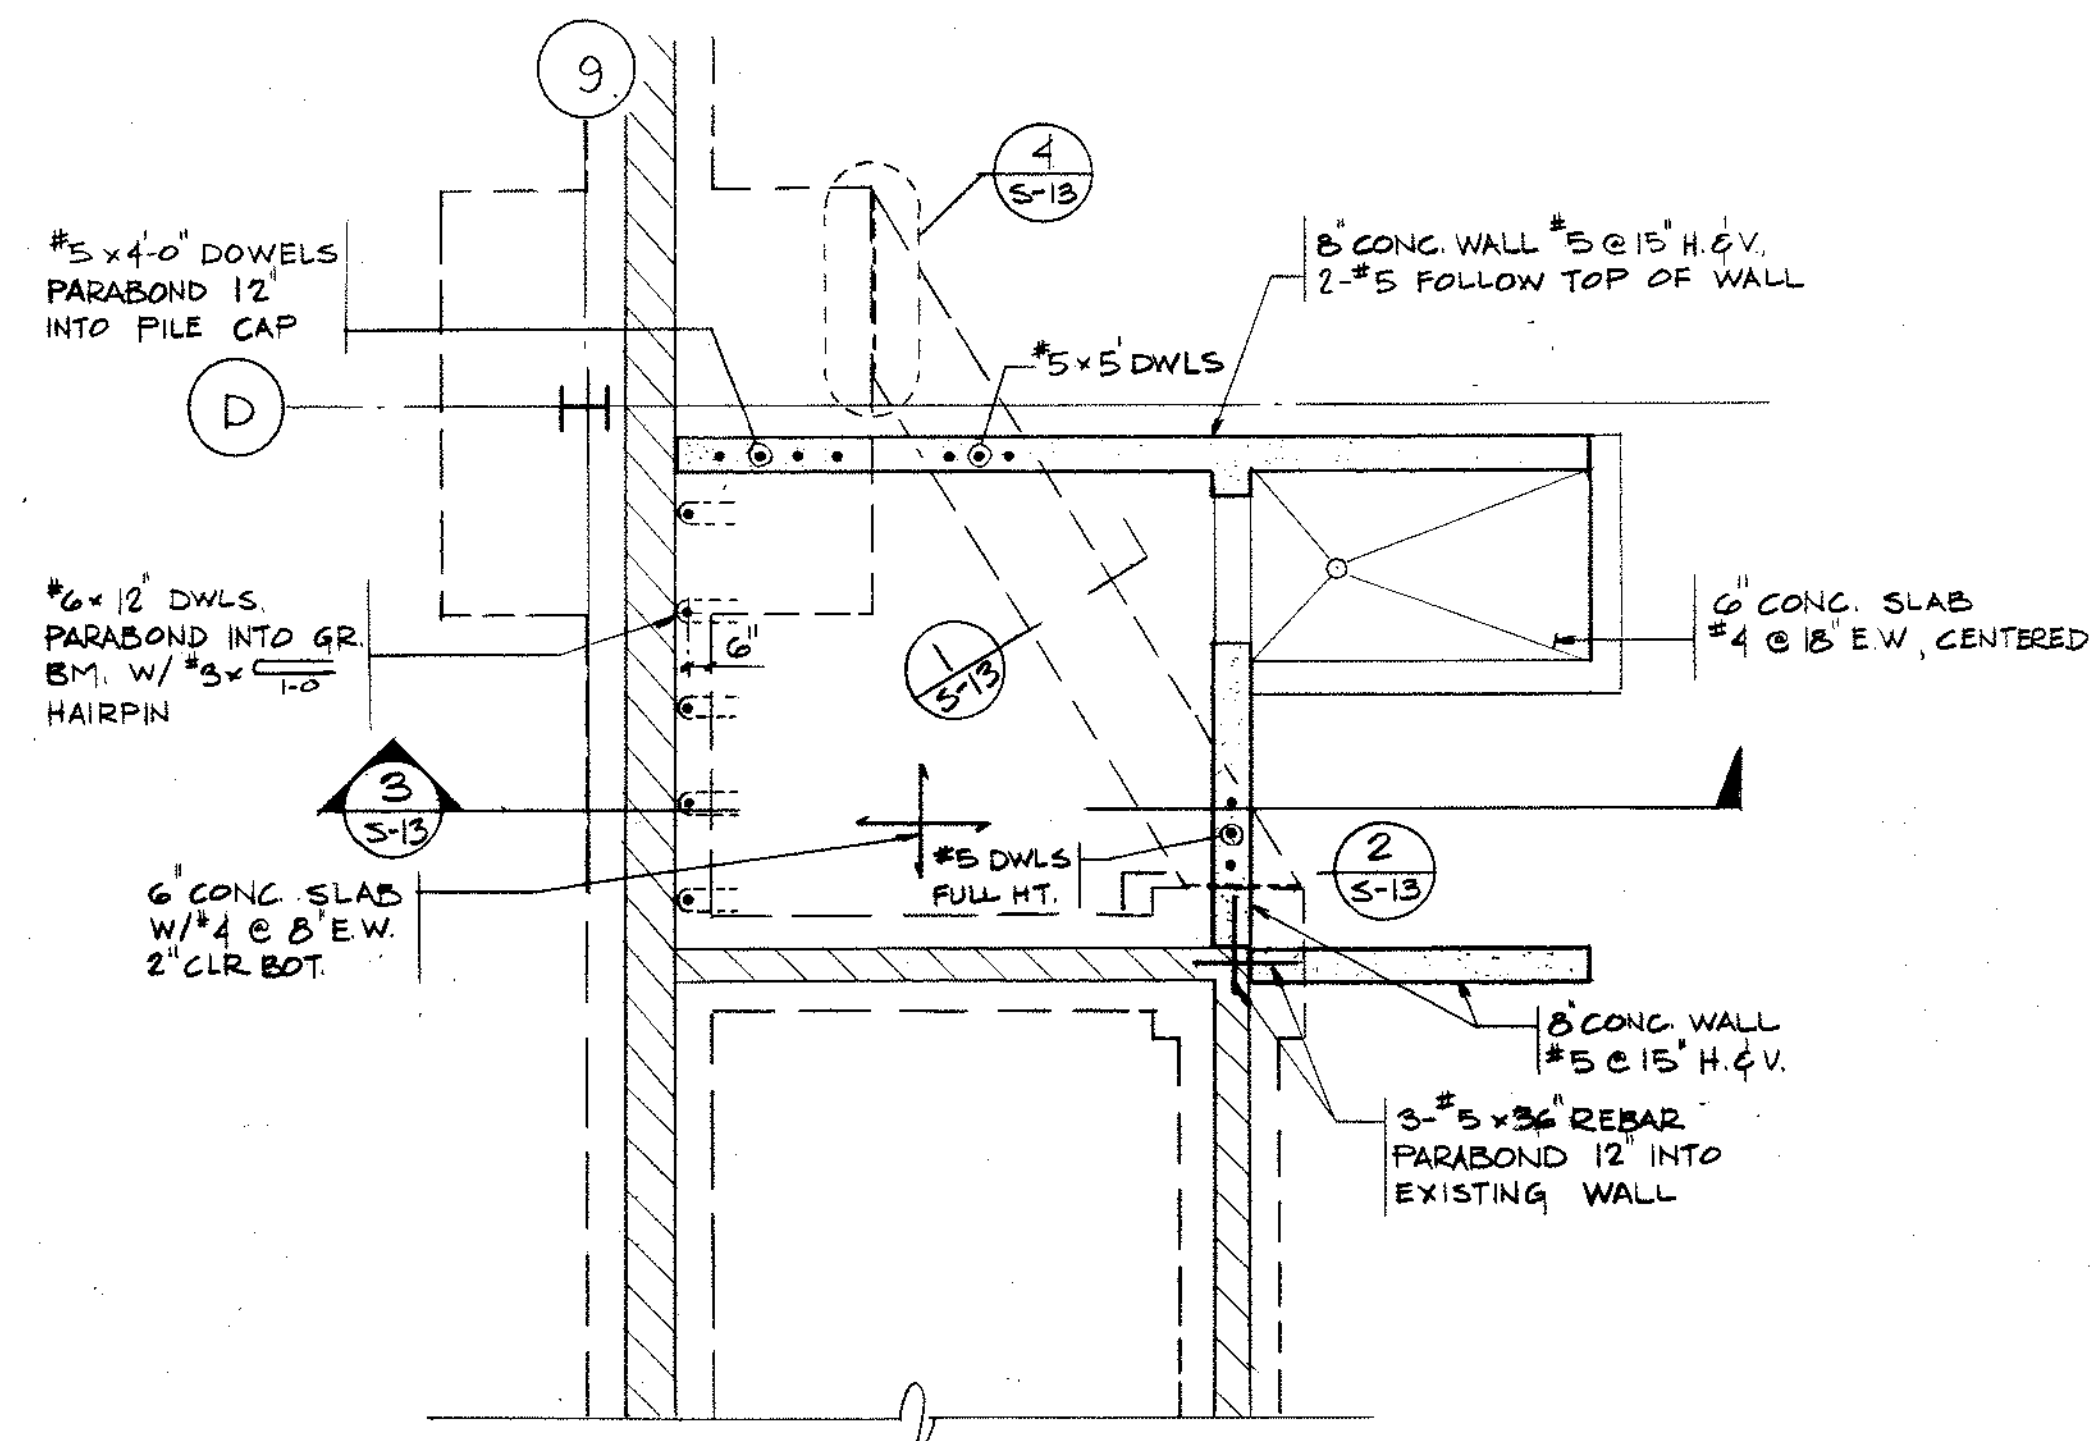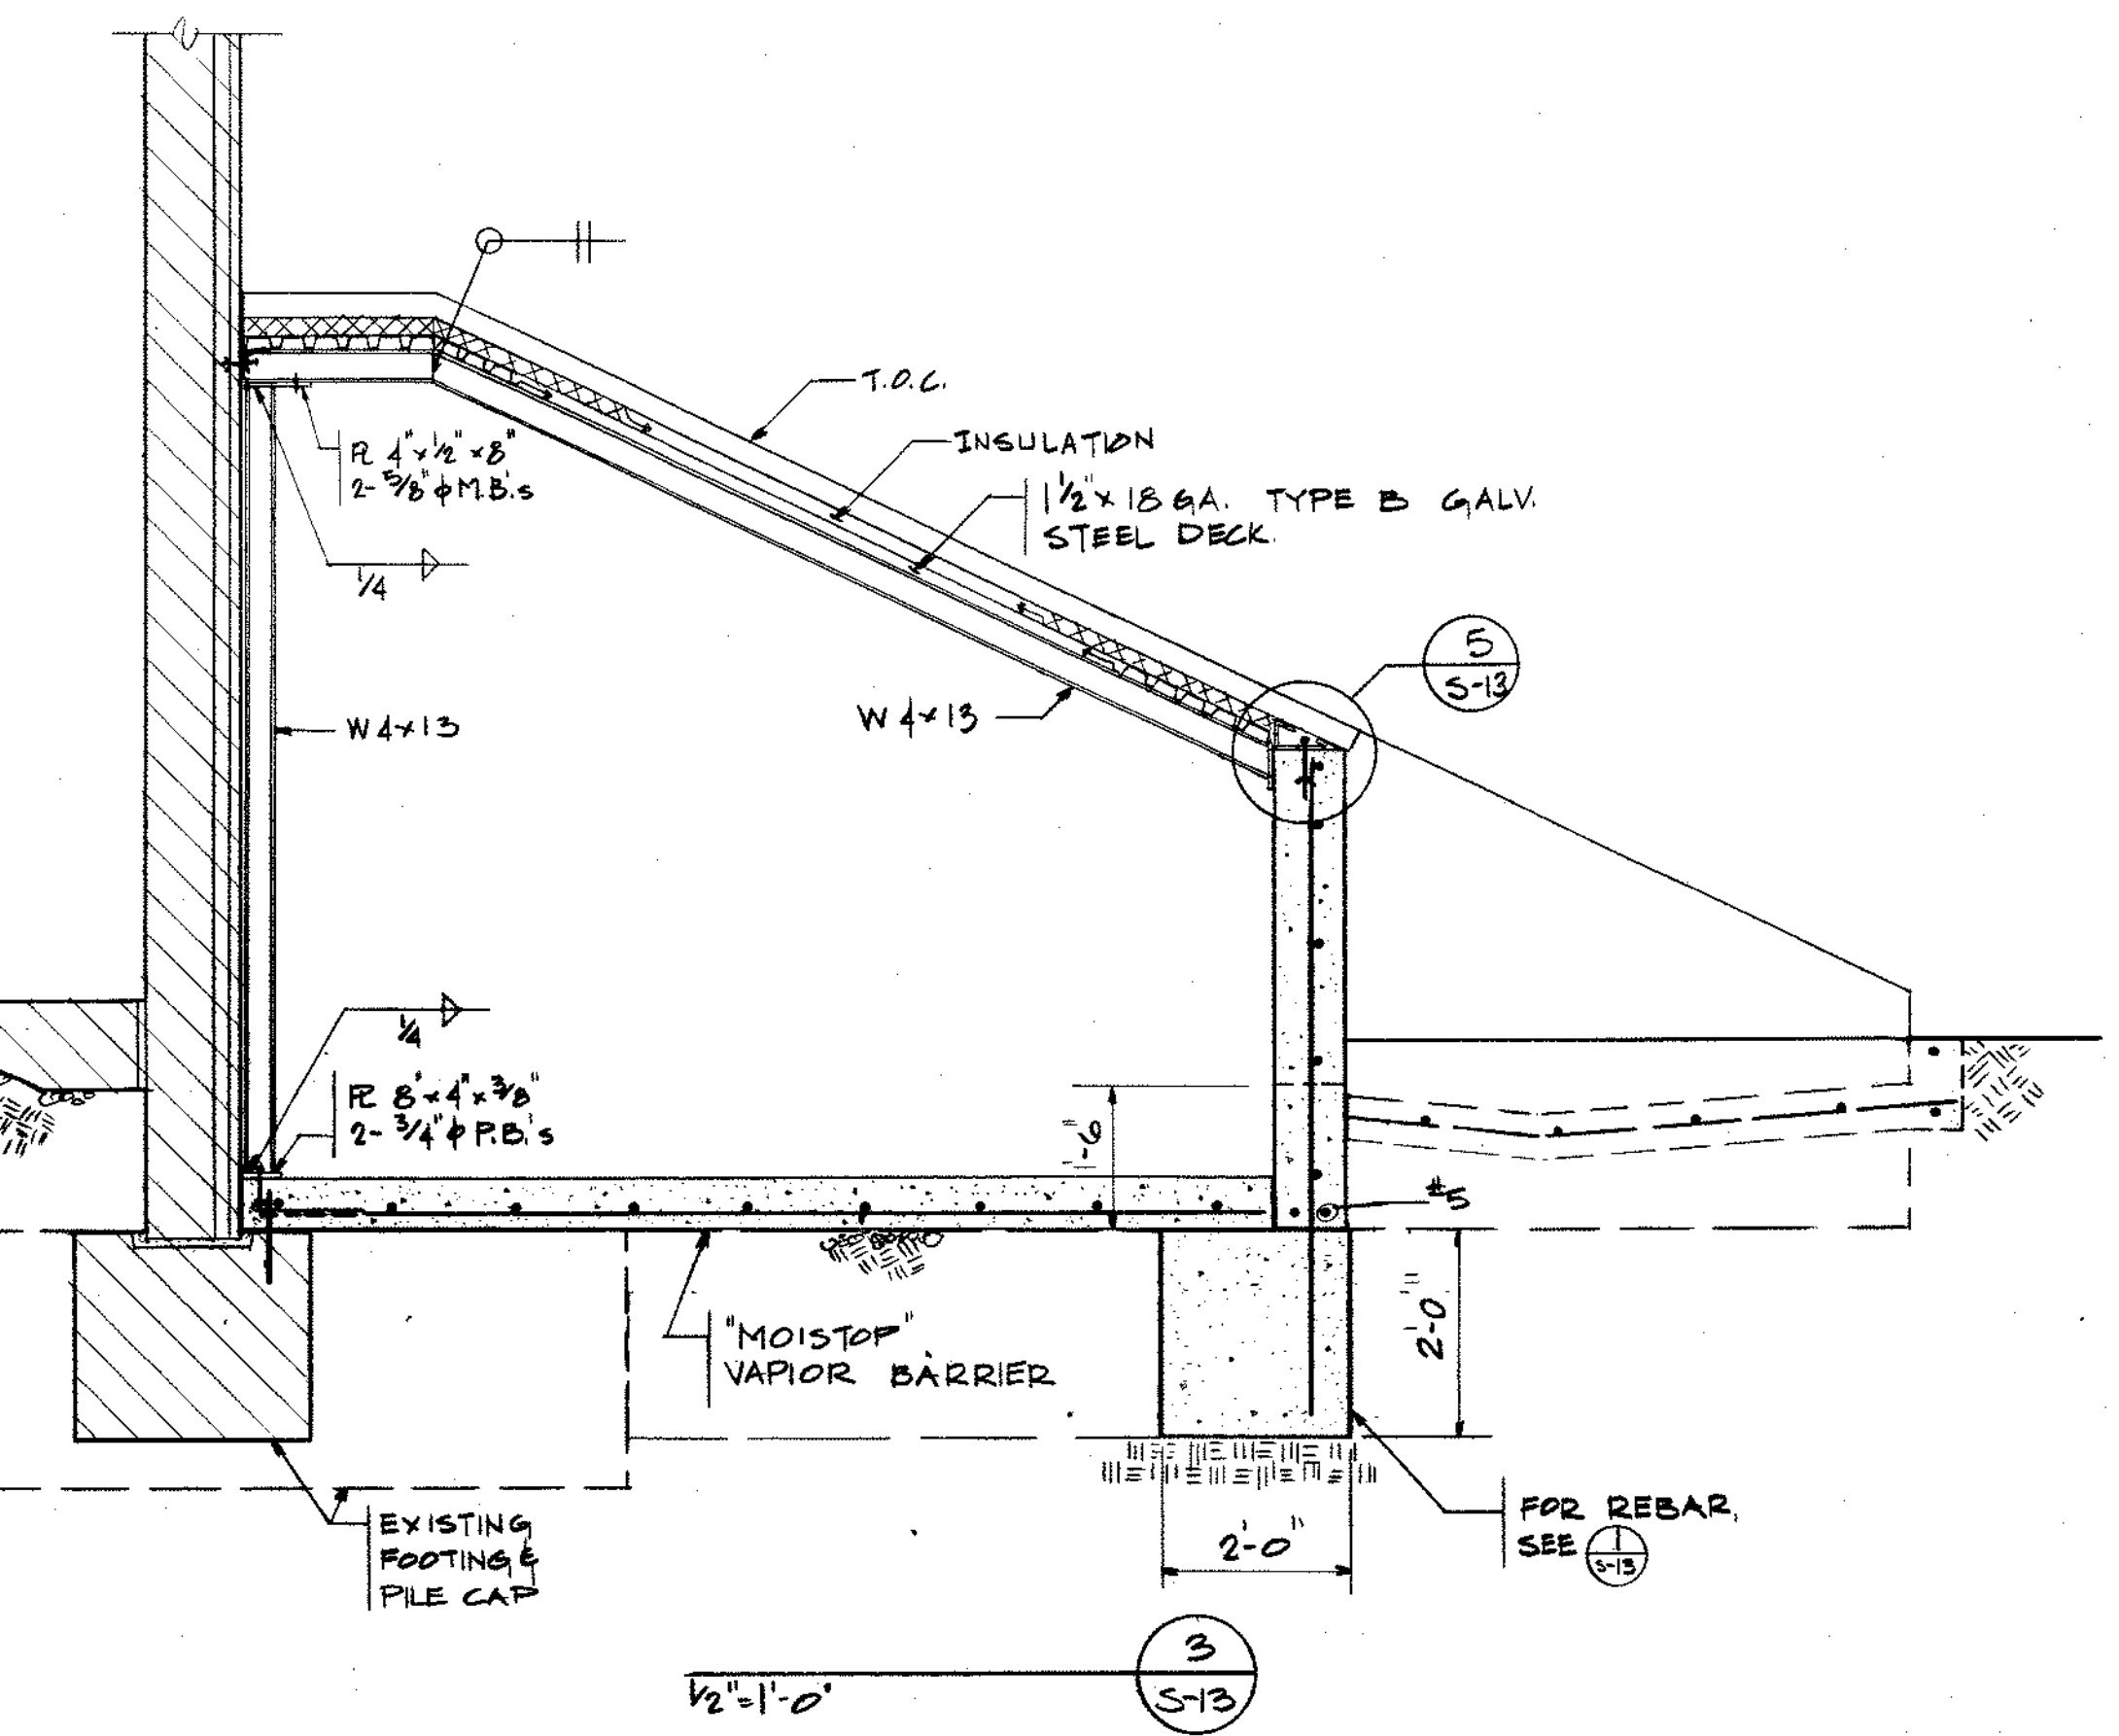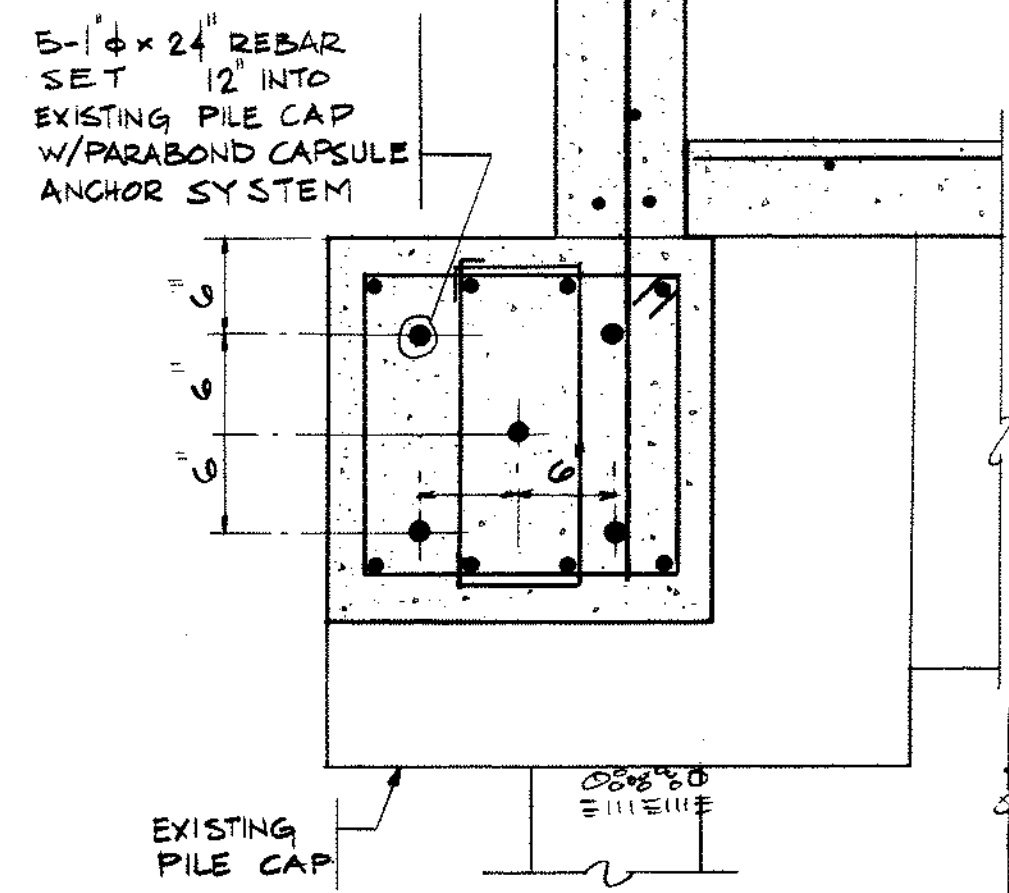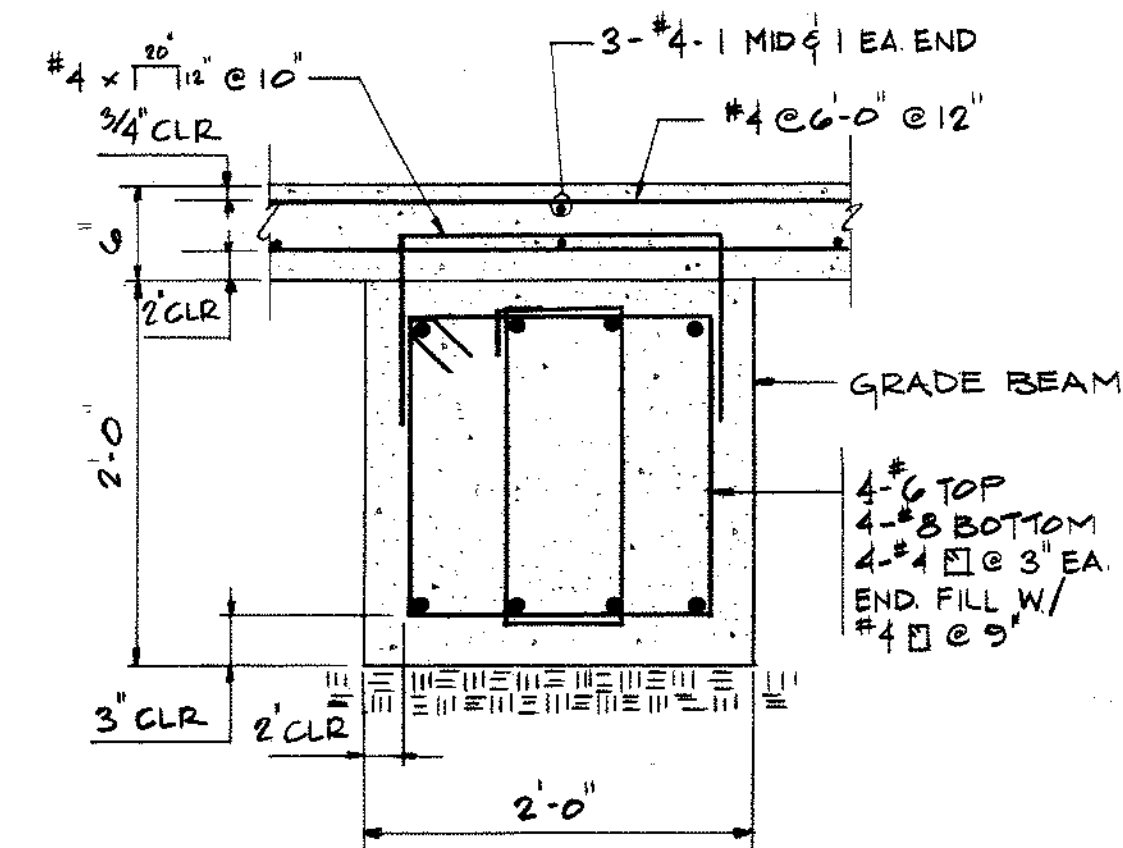

**miller-cook
architects a.i.a.**

DATE MARCH 11, 1987
JOB NO 88-1261-04
REVISIONS AS BUILT 11-16-87



SHEET TITLE :
C-130 FUEL SYSTEM / CORROSION CONTROL
MAINTENANCE HANGAR
304th AIR RESCUE RECOVERY SQUADRON
PORTLAND INTERNATIONAL AIRPORT
PORTLAND
OREGON



SAMUEL HOLMES ASSOCIATES
Structural Engineers
1410 S.W. Morrison
PORTLAND, OR 97205
(503) 226-1260

RECORD DRAWINGS FROM
INFORMATION SUPPLIED BY
THE GENERAL CONTRACTOR

S13

GENERAL NOTES

CODES AND STANDARDS

1.	T1800-01	CORPS OF ENGINEERS DESIGN CRITERIA
	UFC 3-310-01	LOAD ASSUMPTIONS FOR BUILDINGS
	T1809-02	STRUCTURAL DESIGN CRITERIA FOR BUILDINGS
	T1809-04	SEISMIC DESIGN FOR BUILDINGS
	T1809-07	DESIGN OF COLD-FORMED LOAD BEARING STEEL SYSTEMS AND MASONRY VENEER/STEEL STUD WALLS
	T1809-26	WELDING - DESIGN PROCEDURES AND INSPECTIONS
	T1809-27	CONCRETE FLOOR SLAB ON GRADE SUBJECTED TO HEAVY LOADS
	T1809-29	STRUCTURAL CONSIDERATIONS FOR METAL ROOFING
	T1809-30	METAL BUILDING SYSTEMS
	T1809-52	COMMENTARY ON SNOW LOADS
	T1809-53	SELECTIONS CONSIDERATION FOR ROOFING SYSTEMS
	AISC	SEISMIC PROVISIONS FOR STRUCTURAL STEEL BUILDINGS
	ASCE 7-98	MINIMUM DESIGN LOADS FOR BUILDINGS AND OTHER STRUCTURES

- INTERNATIONAL BUILDING CODE (IBC) 2000 EDITION.
- STRUCTURAL AND MISCELLANEOUS STEEL FABRICATION AND ERECTION THEREOF SHALL CONFORM TO THE "SPECIFICATIONS FOR THE DESIGN, FABRICATION, AND ERECTION OF STRUCTURAL STEEL FOR BUILDINGS" (AISC MANUAL OF STEEL CONSTRUCTION, LATEST EDITION).
- WELDING OF STRUCTURAL AND MISCELLANEOUS STEEL SHALL CONFORM TO THE LATEST EDITION OF "STRUCTURAL WELDING CODE - STEEL" (AWS D1.1).
- AMERICAN CONCRETE INSTITUTE (ACI). BUILDING CODE REQUIREMENTS FOR STRUCTURAL CONCRETE.
- STEEL DECK INSTITUTE (SDI). DESIGN MANUAL AND DIAPHRAGM DESIGN MANUAL.
- AMERICAN SOCIETY FOR CIVIL ENGINEERS STANDARD ASCE 7-98 MINIMUM DESIGN LOADS FOR BUILDING AND OTHER STRUCTURES.

DESIGN LOADS

- LIVE LOADS: IBC 2000
 ROOF (SNOW) 25 PSF
- DEAD LOADS
 ACTUAL WEIGHT OF ELEMENTS (ASSUMED 4.3 PSF FOR ROOF)
- WIND LOAD: ASCE 7-98
 $P = q_h [(GCpf) - (GCpi)]$
 $q_h = 0.00256 (K_z)(K_zf)V^2 I$
 $h = 50ft$
 EXPOSURE "C"
 $K_z = 1.09$
 $K_zf = 1.00$ FLAT TERRAIN
 $V =$ BASIC WIND SPEED = 90 mph
 $I = 1.00$
 $Gcpi = +/- 0.55$ (PARTIALLY ENCLOSED)

SEISMIC LOAD (T1809-04 AND IBC 2000)

- V (BASE SHEAR) = $C_s W = 0.123 W$
 $C_s = \frac{S_{ps}}{R} \leq \frac{S_{pl}}{TR}$
- $T = 0.36$ SEC SEISMIC USE GROUP = I
 $R = 5.0$
 $\Delta_o = 2.0$ SITE CLASSIFICATION = E
 $C_d = 4.5$ SEISMIC DESIGN CATEGORY = D
 $S_{ps} = 0.62$ PERFORMANCE LEVEL = LSI
 $S_{pl} = 0.58$ PERFORMANCE OBJECTIVE = IA
 $P = 1.2$ N-S
 $P = 1.0$ E-W
- $W =$ TOTAL DEAD LOAD

DESIGN CRITERIA

STRUCTURAL CONCEPT

- VERTICAL LOADS ARE CARRIED BY ROOF TRUSSES AND BEAMS TO STEEL COLUMNS AND PILE FOUNDATIONS.
- LATERAL LOADS ARE CARRIED BY ROOF DIAPHRAGM TO THE STEEL BRACED FRAMES IN N-S DIRECTIONS. IN E-W DIRECTION THE LATERAL LOAD IS CARRIED TO BRACED FRAME THROUGH BRACED TRUSS AT FRONT OF BUILDING AND ROOF DIAPHRAGM. IN BOTH DIRECTIONS, CATERAL LOADS ARE TRANSFERRED FROM BRACED FRAMES TO FOUNDATIONS (PILES & GRADE BEAMS)

GENERAL

- THESE NOTES CONTAIN GENERAL INFORMATION CONTRACTOR SHALL VERIFY INFORMATION GIVEN HERE WITH SPECIFICATIONS AND OTHER DOCUMENTS AND BRING ANY CONFLICTS TO THE ATTENTION OF THE CONTRACTING OFFICER BEFORE BEGINNING AFFECTED WORK. THE CONTRACTING OFFICER WILL RESOLVE ANY SUCH CONFLICT.
- ALL DIMENSIONS AND DETAILS SHALL BE VERIFIED BY THE CONTRACTOR PRIOR TO FABRICATION AND CONSTRUCTION. ALL DIMENSIONS OF EXISTING CONSTRUCTION SHOWN ON THE DRAWINGS ARE INTENDED AS GUIDELINES ONLY AND MUST BE VERIFIED.
- THE CONTRACTOR SHALL VERIFY SIZE AND LOCATION OF ALL OPENINGS AND INSERTS IN CONCRETE AND IN MASONRY, INCLUDING NECESSARY COORDINATION BETWEEN THE VARIOUS TRADES (ARCHITECTURAL, CIVIL, STRUCTURAL, ELECTRICAL, AND MECHANICAL.)
- THE BUILDING FRAME (FOUNDATION, WALLS, COLUMNS, FLOORS, AND ROOF SYSTEM) HAS BEEN DESIGNED TO WITHSTAND THE DESIGN LOADS IN ITS FINAL CONFIGURATION. CONTRACTOR SHALL TEMPORARILY BRACE INCOMPLETE PARTS OF STRUCTURE UNTIL SUCH TIME AS BUILDING FRAME AS A WHOLE IS COMPLETE PER PLANS.
- SHOP DRAWINGS
 A. SHOP DRAWINGS SHALL BE SUBMITTED PER THE SPECIFICATIONS. IF THE SHOP DRAWINGS ADD TO THE DESIGN OF THE STRUCTURAL DRAWINGS, THEY SHALL BEAR THE SEAL AND SIGNATURE OF THE WASHINGTON STATE REGISTERED PROFESSIONAL ENGINEER WHO IS RESPONSIBLE FOR THE DESIGN.
 B. SHOP DRAWING REVIEW: DIMENSIONS AND QUANTITIES ARE NOT REVIEWED BY THE ENGINEER OF RECORD; THEREFORE THEY MUST BE VERIFIED BY THE CONTRACTOR. CONTRACTOR SHALL REVIEW AND STAMP DRAWINGS PRIOR TO REVIEW BY ENGINEER OF RECORD. CONTRACTOR SHALL REVIEW DRAWINGS FOR CONFORMANCE WITH THE MEANS, METHODS, TECHNIQUES, SEQUENCES AND OPERATIONS OF CONSTRUCTION, AND ALL SAFETY PRECAUTIONS AND PROGRAMS INCIDENTAL THERETO. SUBMITTALS SHALL INCLUDE A REPRODUCIBLE AND TWO COPIES; REPRODUCIBLE WILL BE MARKED AND RETURNED. SHOP DRAWING SUBMITTALS PROCESSED BY THE ENGINEER ARE NOT CHANGE ORDERS. IF DEVIATIONS, DISCREPANCIES, OR CONFLICTS BETWEEN SHOP DRAWING SUBMITTALS AND THE CONTRACT DOCUMENTS ARE DISCOVERED EITHER PRIOR TO OR AFTER SHOP DRAWING SUBMITTALS ARE PROCESSED BY THE ENGINEER, THE DESIGN DRAWINGS AND SPECIFICATIONS SHALL CONTROL AND SHALL BE FOLLOWED.
 C. EACH SHOP DRAWING SHALL INCLUDE THE CONTRACT DETAIL AND SECTION NUMBER/DRAWING NUMBER FOR REFERENCE.

- INSPECTION SHALL BE PERFORMED PER THE SPECIFICATIONS.
- EARTHWORK MATERIAL, BACKFILL AND COMPACTION SHALL BE IN ACCORDANCE WITH THE SPECIFICATIONS. UNSATISFACTORY MATERIALS UNDER BUILDINGS AND STRUCTURES SHALL BE REMOVED PER THE SPECIFICATIONS.
- CONTRACTOR SHALL BE RESPONSIBLE FOR ALL SAFETY PRECAUTIONS AND THE METHODS, TECHNIQUES, SEQUENCES OR PROCEDURES REQUIRED TO PERFORM HIS WORK. THE STRUCTURAL ENGINEER HAS NO OVERALL SUPERVISORY AUTHORITY OR ACTUAL AND/OR DIRECT RESPONSIBILITY FOR THE SPECIFIC WORKING CONDITIONS AT THE SITE AND/OR FOR ANY HAZARDS RESULTING FROM THE ACTIONS OF ANY TRADE CONTRACTOR. THE STRUCTURAL ENGINEER HAS NO DUTY TO INSPECT, SUPERVISE, NOTE, CORRECT, OR REPORT ANY HEALTH OR SAFETY DEFICIENCIES OF THE OWNER, CONTRACTORS, OR OTHER ENTITIES OR PERSONS AT THE PROJECT SITE.
- CONTRACTOR-INITIATED CHANGES SHALL BE SUBMITTED IN WRITING TO THE CONTRACTING OFFICER AND STRUCTURAL ENGINEER FOR APPROVAL PRIOR TO FABRICATION OR CONSTRUCTION. CHANGES SHOWN ON SHOP DRAWINGS ONLY WILL NOT SATISFY THIS REQUIREMENT.
- DRAWINGS INDICATE GENERAL AND TYPICAL DETAILS OF CONSTRUCTION. WHERE CONDITIONS ARE NOT SPECIFICALLY INDICATED BUT ARE OF SIMILAR CHARACTER TO DETAILS SHOWN, SIMILAR DETAILS OF CONSTRUCTION SHALL BE USED, SUBJECT TO REVIEW AND APPROVAL BY THE CONTRACTING OFFICER.
- ALL STRUCTURAL SYSTEMS WHICH ARE TO BE COMPOSED OF COMPONENTS TO BE FIELD ERECTED SHALL BE SUPERVISED BY THE SUPPLIER DURING MANUFACTURING, DELIVERY, HANDLING, STORAGE AND ERECTION IN ACCORDANCE WITH INSTRUCTIONS PREPARED BY THE SUPPLIER.
- THE CONTRACTOR IS RESPONSIBLE FOR PROVIDING TEMPORARY SHORING AND SUPPORTS. CONTRACTOR ERECTOR SHALL PROVIDE PLANS FOR CONTRACTING OFFICER REVIEW. THE ERECTION PLAN SHALL BE STAMPED BY A REGISTERED PROFESSIONAL ENGINEER.

DEMOLITION

- CONTRACTOR SHALL VERIFY ALL EXISTING CONDITIONS BEFORE COMMENCING ANY DEMOLITION. SHORING SHALL BE INSTALLED TO SUPPORT EXISTING CONSTRUCTION AS REQUIRED AND IN A MANNER SUITABLE TO THE WORK SEQUENCES. EXISTING REINFORCING SHALL BE SAVED WHERE AND AS NOTED ON THE PLANS. SAW CUTTING, IF AND WHERE USED, SHALL NOT CUT EXISTING REINFORCING THAT IS TO BE SAVED. DEMOLITION DEBRIS SHALL NOT BE ALLOWED TO DAMAGE OR OVERLOAD THE EXISTING STRUCTURE. LIMIT CONSTRUCTION LOADING (INCLUDING DEMOLITION DEBRIS) ON EXISTING ROOF SYSTEM TO 25 PSF.
 A. ALL NEW OPENINGS THROUGH EXISTING WALLS, SLABS AND BEAMS SHALL BE ACCOMPLISHED BY SAW CUTTING WHEREVER POSSIBLE.
 B. CONTRACTOR SHALL VERIFY ALL EXISTING CONDITIONS AND LOCATION OF MEMBERS PRIOR TO CUTTING ANY OPENINGS.
 C. SMALL ROUND OPENINGS SHALL BE ACCOMPLISHED BY CORE DRILLING, IF POSSIBLE.
 D. WHERE NEW REINFORCING TERMINATES AT EXISTING CONCRETE, THREADED BARS INTO THREADED EXPANSION INSERTS IN EXISTING CONCRETE SHALL BE PROVIDED TO MATCH HORIZONTAL REINFORCING, UNLESS OTHERWISE NOTED ON PLANS.
- DEMOLITION MAY IMPACT HAZARDOUS BUILDING MATERIALS SUCH AS ASBESTOS, LEAD AND SILICA. A HAZARDOUS BUILDING MATERIAL SURVEY HAS BEEN PERFORMED AND INCLUDES A GOOD FAITH INSPECTION FOR ASBESTOS.

FOUNDATIONS

FOUNDATION DESIGN IS BASED ON "GEOTECHNICAL REPORT BY GRI DATED APRIL 11, 2003."

AUGER CAST PILES (16"Ø)

- ALLOWABLE PILE CAPACITIES:
 A. DOWNWARD CAPACITY: 70 TONS EACH.
 B. UPLIFT CAPACITY: 35 TONS EACH.
 C. LATERAL SINGLE PILE CAPACITY: 7 KIPS (SEISMIC) 12 KIPS (NON-SEISMIC)
- SEE CONCRETE CAST-IN-PLACE NOTES FOR CONCRETE REQUIREMENTS. SEE DETAILS FOR REINFORCING REQUIREMENTS.
- ALL DRILLING OPERATIONS ARE TO BE MONITORED BY A REPRESENTATIVE OF THE GEOTECHNICAL ENGINEER.
- INSTALL EACH PILE A MINIMUM OF 30'-0" INTO THE LOWER SAND. IDENTIFICATION OF THE APPROPRIATE SOIL STRATA FOR PILE TERMINATION SHALL BE DETERMINED BY A REPRESENTATIVE OF THE GEOTECHNICAL ENGINEER.
- SEE DRAWINGS FOR TOP OF PILE ELEVATIONS.
- EXCAVATE, REINFORCE AND PLACE CONCRETE FOR INDIVIDUAL PILES IN ONE CONTINUOUS OPERATION.
- EXCAVATE AND PLACE CONCRETE FOR PILES WITH LESS THAN 6'-6" CLEAR BETWEEN SHAFTS A MINIMUM OF 24 HOURS APART.
- IMMEDIATELY BRING ANY FIELD VARIANCES WITH THE FOUNDATION REQUIREMENTS SHOWN IN THESE DRAWINGS TO THE ATTENTION OF THE CONTRACTING OFFICER.
- PASSIVE SOIL RESISTANCE EQUIVALENT FLUID PRESSURE: 250 LBS/FT

NONSHRINK GROUT

- BASE PLATE GROUT SHALL BE NON-SHRINK NON-METALIC WITH MINIMUM $f'c = 8000$ PSI ALL OTHER NON-SHRINK GROUT SHALL HAVE MINIMUM $f'c = 5000$ PSI.
- PREGROUTING OF BASE PLATES WILL NOT BE PERMITTED.

REINFORCED CONCRETE

- REINFORCING STEEL
 A. DEFORMED BARS - ASTM A615, GRADE 60
 SMOOTH WELDED WIRE FABRIC (WWF) - ASTM A185 $f_y=65$ ksi
 DEFORMED BAR ANCHORS (DBA) - ASTM A496
 DEFORMED BARS TO BE WELDED - ASTM A706 GRADE 420 LOW ALLOY
 WELDING ELECTRODES FOR DEFORMED BARS TO STRUCTURAL STEEL, USE 70 KSI FILLER MATERIAL.
 B. SPLICING OF LONGITUDINAL REINFORCEMENT OVER IN LENGTH, EXCEPT AS SPECIFICALLY NOTED ON THE DRAWINGS, SHALL BE PERMITTED. SPLICES SHALL BE STAGGERED WITH NO MORE THAN 50% OF THE BARS BEING SPLICED AT ANY ONE LOCATION.

- REINFORCING LAP SPLICES: CONFORM TO ACI 318 "BUILDING CODE REQUIREMENTS FOR REINFORCED CONCRETE", AS SHOWN BELOW, UNLESS NOTED OTHERWISE ON DRAWINGS:

BAR SIZE	4000 PSI		5000 PSI	
	TOP BARS	OTHER BARS	TOP BARS	OTHER BARS
#3	18	16	16	16
#4	24	19	22	17
#5	30	23	27	21
#6	40	31	36	27
#7	54	42	48	37
#8	71	55	64	49
#9	90	69	81	62
#10	114	88	102	79
#11	140	108	126	97

LAP SPLICE NOTES:

- "TOP BARS" ARE DEFINED AS HORIZONTAL BARS PLACED SUCH THAT MORE THAN 12" OF CONCRETE IS PLACED BELOW THE BARS.
- SPLICE LENGTH BASIS: CLASS B SPLICE, WITH CENTER TO CENTER BAR SPACING OF GREATER THAN (3) BAR DIAMETERS.


- PROVIDE CORNER BARS IN BOTH FACES OF ALL CONTINUOUS SPREAD FOOTINGS. NUMBER, SIZE AND SPACING OF CORNER BARS SHALL BE EQUAL TO NUMBER, SIZE AND SPACING OF HORIZONTAL REINFORCING WITH WHICH THEY LAP AND SHALL EXTEND 30 BAR DIAMETERS IN EACH DIRECTION. IF REINFORCING MEETING AT THE CORNER IS OF DIFFERENT SIZE. CORNER BAR SHALL MATCH THE LARGER OF THE BARS.
- AT INTERSECTING CONTINUOUS SPREAD FOOTINGS EXTEND ALL HORIZONTAL REINFORCING OF THE INTERSECTING CONTINUOUS SPREAD FOOTINGS, BEYOND THE POINT OF INTERSECTION TO THE OPPOSITE FACE AND BEND TO A STANDARD 90° HOOK, OR PROVIDE BENT DOWELS OF EQUAL SIZE AND SPACING AND LAP AS REQUIRED BY NOTE D (BUT NOT LESS THAN 12") IN EACH DIRECTION.

MINIMUM COVER FROM CONCRETE SURFACES TO REINFORCING:

- 3" ± 1/2" TO BOTTOM OF FOOTING
 2" ± 1/4" TO EARTH FACE OF WALL
 1" ± 1/4" TO INSIDE FACE OF WALL
 2" ± 1/4" MAIN STEEL BEAMS AND COLUMNS
 3/4" ± SLAB TO TOP AND BOTTOM SURFACES AT CENTER OF SLABS-ON-GRADE

CAST-IN-PLACE CONCRETE

- MINIMUM COMPRESSIVE STRENGTH AT 28 DAYS SHALL BE 4000 PSI.
- MINIMUM ULTIMATE FLEXURAL STRENGTH AT 90 DAYS SHALL BE 750 PSI FOR ALL FLAT CONCRETE WORK.
- COVER ON REINFORCEMENT, THE CLEAR DISTANCE FROM EXPOSED SURFACE TO THE REBAR, SHALL CONFORM TO ACI 318-99.
- CONSTRUCTION JOINTS SHALL BE PROVIDED ONLY AS NOTED ON THE DRAWINGS AND AS SPECIFICALLY PERMITTED BY THE CONTRACTING OFFICER.
- REFER TO CIVIL, ARCHITECTURAL, ELECTRICAL, MECHANICAL, AND STRUCTURAL DRAWINGS FOR ALL INSERTS TO BE CAST IN CONCRETE AND FOR LOCATION OF PIPES, DUCTS, AND CONDUITS.
- ALL ANGLE FRAMES AND PLATES CAST INTO CONCRETE SLABS ON GRADE, PITS AND TRENCHES SHALL BE GALVANIZED.
- THE NORMAL AISC TOLERANCE FOR STRUCTURAL STEEL WILL NOT BE ALLOWED. THE BOTTOM DOOR GUIDES SHALL BE ERECTED, BY THE STRUCTURAL STEEL ERECTOR, AS DIMENSIONED ON THE DRAWINGS, PARALLEL AND PLUMB TO THE TOP DOOR GUIDES. THE BOTTOM RAILS SHALL HAVE A HORIZONTAL TOLERANCE OF 1/4" ± IN ANY 20 FOOT INCREMENT. THE BOTTOM RAIL JOINTS SHALL BE IN LINE AND FLUSH TO EACH OTHER AT THE TOP AND SIDE OF THE RAIL HEAD. SPLICES IN BOTTOM RAILS AND ENDS OF BOTTOM RAILS SHALL BE CENTERED OVER THE HORIZONTAL LEG OF SUPPORT ANGLES.
- THE SIZE AND LOCATION OF ALL EQUIPMENT PADS, TRENCH DRAINS AND OPENINGS FOR ALL DUCTS AND PIPES THROUGH FLOOR SLABS AND GRADE BEAMS SHALL BE VERIFIED WITH THE MECHANICAL AND ELECTRICAL CONTRACTOR'S REQUIREMENTS, PRIOR TO PLACEMENT.
- ALL JOINTS IN PITS AND TRENCHES SHALL BE KEYED. WATERSTOPS SHALL BE INSTALLED IN ALL CONSTRUCTION JOINTS UNLESS NOTED OTHERWISE.

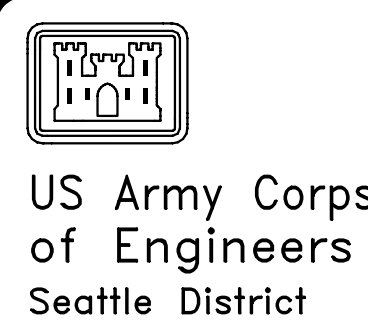

Date	Appr.
Date	Appr.
Date	Appr.

Designed by: AEW	Date: 1/25/04
Drawn by: WP	Design file no.: 3125/211-0-02
Checked by: JLF	Submitted by: JLF
Principal: JLF	Section:

ADD/ALTER FLIGHTLINE FACILITIES BLDG 304 & 375
 PORTLAND ANG. OREGON
 FY04 PN TOKD 012259

STRUCTURAL NOTES
 SHEET 1 OF 2

PLATE NUMBER:
G-S001

GENERAL NOTES

STRUCTURAL STEEL

- ALL STEEL CONSTRUCTION SHALL COMPLY WITH THE CODES AND STANDARDS CONTAINED IN THE AISC MANUAL OF STEEL CONSTRUCTION, NINTH EDITION AND CONFORM TO THE FOLLOWING:

STEEL MATERIALS:

W SHAPE	-	ASTM A992, GRADE 50
PLATES & FLAT BAR	-	ASTM 572, GRADE 50
EMBEDDED ITEMS, CHANNELS, ANGLES, AND MISC. STEEL	-	ASTM 572, GRADE 50
STRUCTURAL TUBES	-	ASTM A500, GRADE B (Fy = 46KSI)
STEEL PIPE	-	ASTM A53, GRADE B
STRUCTURAL BOLTS	-	ASTM A325-X
ANCHOR BOLTS	-	ASTM A325
ANCHOR RODS	-	F1554 GRADE 55
WELDING ELECTRODES	-	70 KSI FILLER MATERIAL
HEADED STUDS	-	ASTM A108

- BOLTED CONNECTIONS ARE TO BE OF HIGH STRENGTH ASTM A325 BOLTS WITH WASHERS AS SHOWN. A MINIMUM OF TWO BOLTS IS REQUIRED FOR ALL BEAM CONNECTIONS. BOLTS TO BE IN STANDARD ROUND HOLES.
- ALL WELDING SHALL BE IN ACCORDANCE WITH AWS D1.1-00 USING CERTIFIED WELDERS AND QUALIFIED JOINT WELDING PROCEDURES. USING ONLY E70 LOW HYDROGEN ELECTRODES, THE MINIMUM WELD SIZE SHALL BE 3/16", UNLESS NOTED OTHERWISE. CONNECTIONS ARE TO BE AS SHOWN ON THESE DRAWINGS.
- WELDERS SHALL BE CURRENTLY CERTIFIED BY THE WASHINGTON ASSOCIATION OF BUILDING OFFICIALS (WABO). SUBMIT EVIDENCE OF CERTIFICATION.
- BOLTS SET IN CONCRETE OR MASONRY SHALL TYPICALLY CONFORM TO ASTM A325 UNLESS OTHERWISE NOTED.
- TRUSSES SHOWN AS CAMBERED SHALL BE FABRICATED WITH CAMBERS UP. CAMBERS RELATE TO CENTER LINE OF TRUSS.
- CONTRACTOR SHALL SUBMIT ERECTION PLANS AND SEQUENCE FOR REVIEW AND APPROVAL PRIOR TO FABRICATION.

METAL ROOF DECKING

- ALL METAL DECKING SHALL CONFORM TO THE PROVISION OF THE AMERICAN IRON AND STEEL DECK INSTITUTE'S "SPECIFICATIONS FOR THE DESIGN OF COLD FORMED STEEL STRUCTURAL MEMBERS."
- ALL METAL DECKING AND CONNECTIONS SHALL BE DESIGNED FOR UPLIFT FORCES ACCORDING TO FIGURE A, 375-S2.
- METAL ROOF DECKING SHALL BE 1/2" DEEP x 18 GA TYPE HSB, GALVANIZED HAVING MINIMUM (SECTION PROPERTIES PER FT OF WIDTH)
 $S^+ = 0.322 \text{ IN}^3$
 $S^- = 0.335 \text{ IN}^3$
 $I = 0.302 \text{ IN}^4$
- FASTENING OF 1/2" TYPE HSB DECK TO BE:
 - STEEL ROOF DECK SHALL BE FASTENED TO EACH PERPENDICULAR SUPPORT WITH 7 PUDDLE WELDS PER SHEET AND TO PARALLEL SUPPORTS WITH PUDDLE WELDS AT 12" ON CENTER. MINIMUM EFFECTIVE DIAMETER OF PUDDLE WEDLS SHALL BE 5/8". LONGITUDINAL EDGES SHALL BE HAVE SIDE SEAM WELDS AT 12" OC.
 - ALTERNATE FASTENERS MAY BE DESIGNED FOR A WORKING DIAPHRAGM SHEAR FORCE OF 1100 LB/FT.

LIGHT GAGE STEEL FRAMING

- STEEL IS TO BE:
 - ASTM A 653, GRADE 50, CLASS 1, FOR 16 GAUGE AND HEAVIER.
 - ASTM A 653, GRADE 33, FOR 18 GAUGE AND LIGHTER.
 - GALVANIZED WITH G-60 COATING.
- ALL COMPONENTS AND CONNECTIONS SHALL BE DESIGNED FOR WIND PRESSURE AS SHOWN IN FIGURES A AND B THIS PLATE.
- DRAFT CURTAIN SHALL BE DESIGN FOR A LATERAL LOAD OF 5 PSF. SEE DETAIL ON ARCHITECTURAL DRAWINGS.
- ALL FABRICATION, ERECTION AND IDENTIFICATION OF LIGHT GAUGE STEEL FRAMING SHALL CONFORM TO AISI SPECIFICATIONS.
- FASTENING OF COMPONENTS SHALL BE WITH WELDING.
 - ALL WELDS SHALL BE OF SUFFICIENT SIZE TO ENSURE THE STRENGTH OF THE CONNECTION.
 - ALL WELDING SHALL CONFORM TO AWS SPECIFICATIONS.
 - ALL WELDERS SHALL BE CERTIFIED FOR LIGHT GAUGE STEEL AWS SPECIFICATIONS.
- STEEL STUDS OR JOISTS SHALL BE "C" STUDS OR JOISTS WITH STIFFENED LIPS. ALL LIGHT GAGE STUDS, PURLINS AND THEIR CONNECTION, CALCULATION AND DETAILS SHALL BE STAMPED AND SIGNED BY A REGISTERED PROFESSIONAL ENGINEER IN THE STATE OF WASHINGTON.
- PROVIDE ALL ACCESSORIES INCLUDING, BUT NOT NECESSARILY LIMITED TO, TRACKS, CLIPS, WEB STIFFENERS, ANCHORS, FASTENING DEVICES, AND OTHER ACCESSORIES REQUIRED FOR A COMPLETE AND PROPER INSTALLATION.
- END BLOCKING SHALL BE PROVIDED WHERE JOIST ENDS ARE NOT OTHERWISE RESTRAINED FROM ROTATION.

ABBREVIATIONS

AB	ANCHOR BOLT	LONG	LONGITUDINAL
ABT	ABOUT	MAX	MAXIMUM
AFF	AQUEOUS FOAM FORMING FILM	MECH	MECHANICAL
ALT	ALTERNATE	MIN	MINIMUM
ARCH	ARCHITECTURAL	MISC	MISCELLANEOUS
ASTM	AMERICAN SOCIETY OF TESTING AND MATERIALS	MTL	METAL
AVG	AVERAGE	NIC	NOT IN CONTRACT
AWS	AMERICAN WELDING SOCIETY	NO.	NUMBER
B/	BOTTOM OF	NTS	NOT TO SCALE
BAL	BALANCE	OC	ON CENTER
BC	BOTTOM CHORD	OPNG	OPENING
BLDG	BUILDING	OPH	OPPOSITE HAND
BM	BEAM	OWSJ	OPEN WEB STEEL JOIST
BOT	BOTTOM	PL	PLATE
BP	BASE PLATE	P/C	PRECAST
BRG	BEARING	PSF	POUNDS PER SQUARE FOOT
C	CHANNEL	PSI	POUNDS PER SQUARE INCH
COS	CENTER OF GRAVITY OF STEEL	R	RADIUS
CL	CENTERLINE	REF	REFERENCE
CIP	CAST-IN-PLACE	REIN	REINFORCE
CJ	CONSTRUCTION JOINT	REQ'D	REQUIRED
CLR	CLEAR	SCHED	SCHEDULE
COL	COLUMN	SECT	SECTION
CONC	CONCRETE	SIM	SIMILAR
CONN	CONNECTION	SFA	SPACE(S)
CONT	CONTINUOUS	SPECS	SPECIFICATIONS
CP	COMPLETE PENETRATION	SQ	SQUARE
CTR	CENTER	STD	STANDARD
DIA	DIAMETER	STIFF	STIFFENER
DIAG	DIAGONAL	STIRRUP	STIRRUP
DIR	DIRECTION	STL	STEEL
DWG	DRAWING	SYMM	SYMMETRICAL
EA	EACH	T/	TOP OF
EF	EACH FACE	T & B	TOP & BOTTOM
EL	ELEVATION	TBF	TRUSS BRACED FRAME
ELEV	ELEVATION	TC	TOP CHORD
EMBD	EMBEDMENT OR EMBEDDED	THK	THICK
EXP	EXPANSION	TOPG	TOPPING
EXT	EXTERIOR	TOS	TOP OF STEEL
FIN	FINISH	tp	THICKNESS GUSSET PLATE
FTG	FOOTING	TRANSV	TRANSVERSE
GA	GAGE	TS	STRUCTURAL TUBE
GAL	GALVANIZE	T/S	TOP SIDE
HCA	HEAD CONCRETE ANCHOR	TYP	TYPICAL
HDW	HARDWARE	UNO	UNLESS NOTED OTHERWISE
HORIZ	HORIZONTAL	U/S	UNDER SIDE
INT	INTERIOR	VERT	VERTICAL
JST	JOIST	W/	WITH
JT	JOINT	W/O	WITHOUT
K	KIP(S)	WP	WORK POINT
L	ANGLE	&	AND
LB	POUND(S)	@	AT
LL	DOUBLE ANGLE	ø	DIAMETER
LLH	LONG LEG HORIZONTAL	#	NUMBER
LLV	LONG LEG VERTICAL		

MARK	PRESSURE
①	27 PSF
②	50 PSF
③	50 PSF
④	31 PSF
⑤	37 PSF

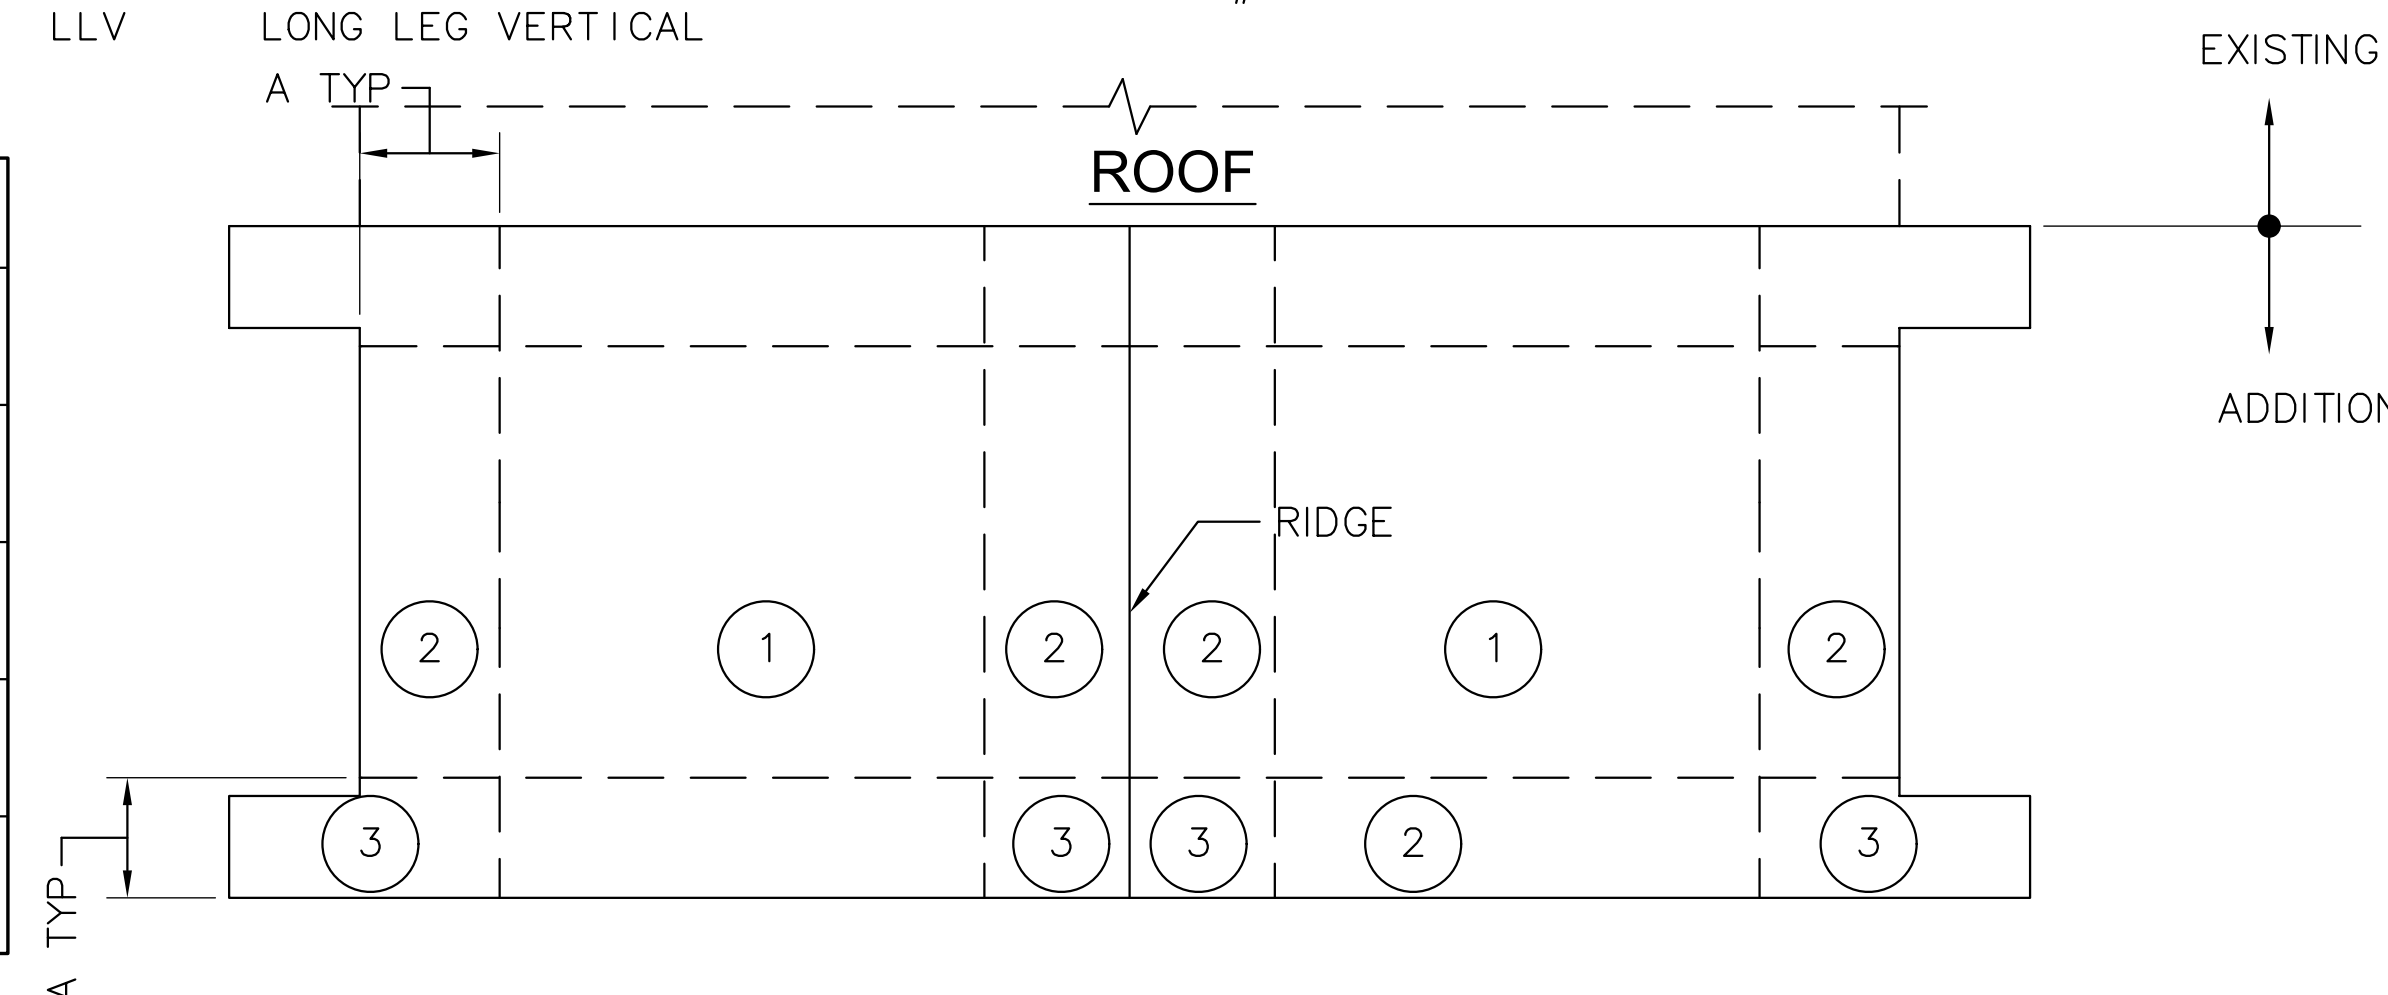


FIGURE A


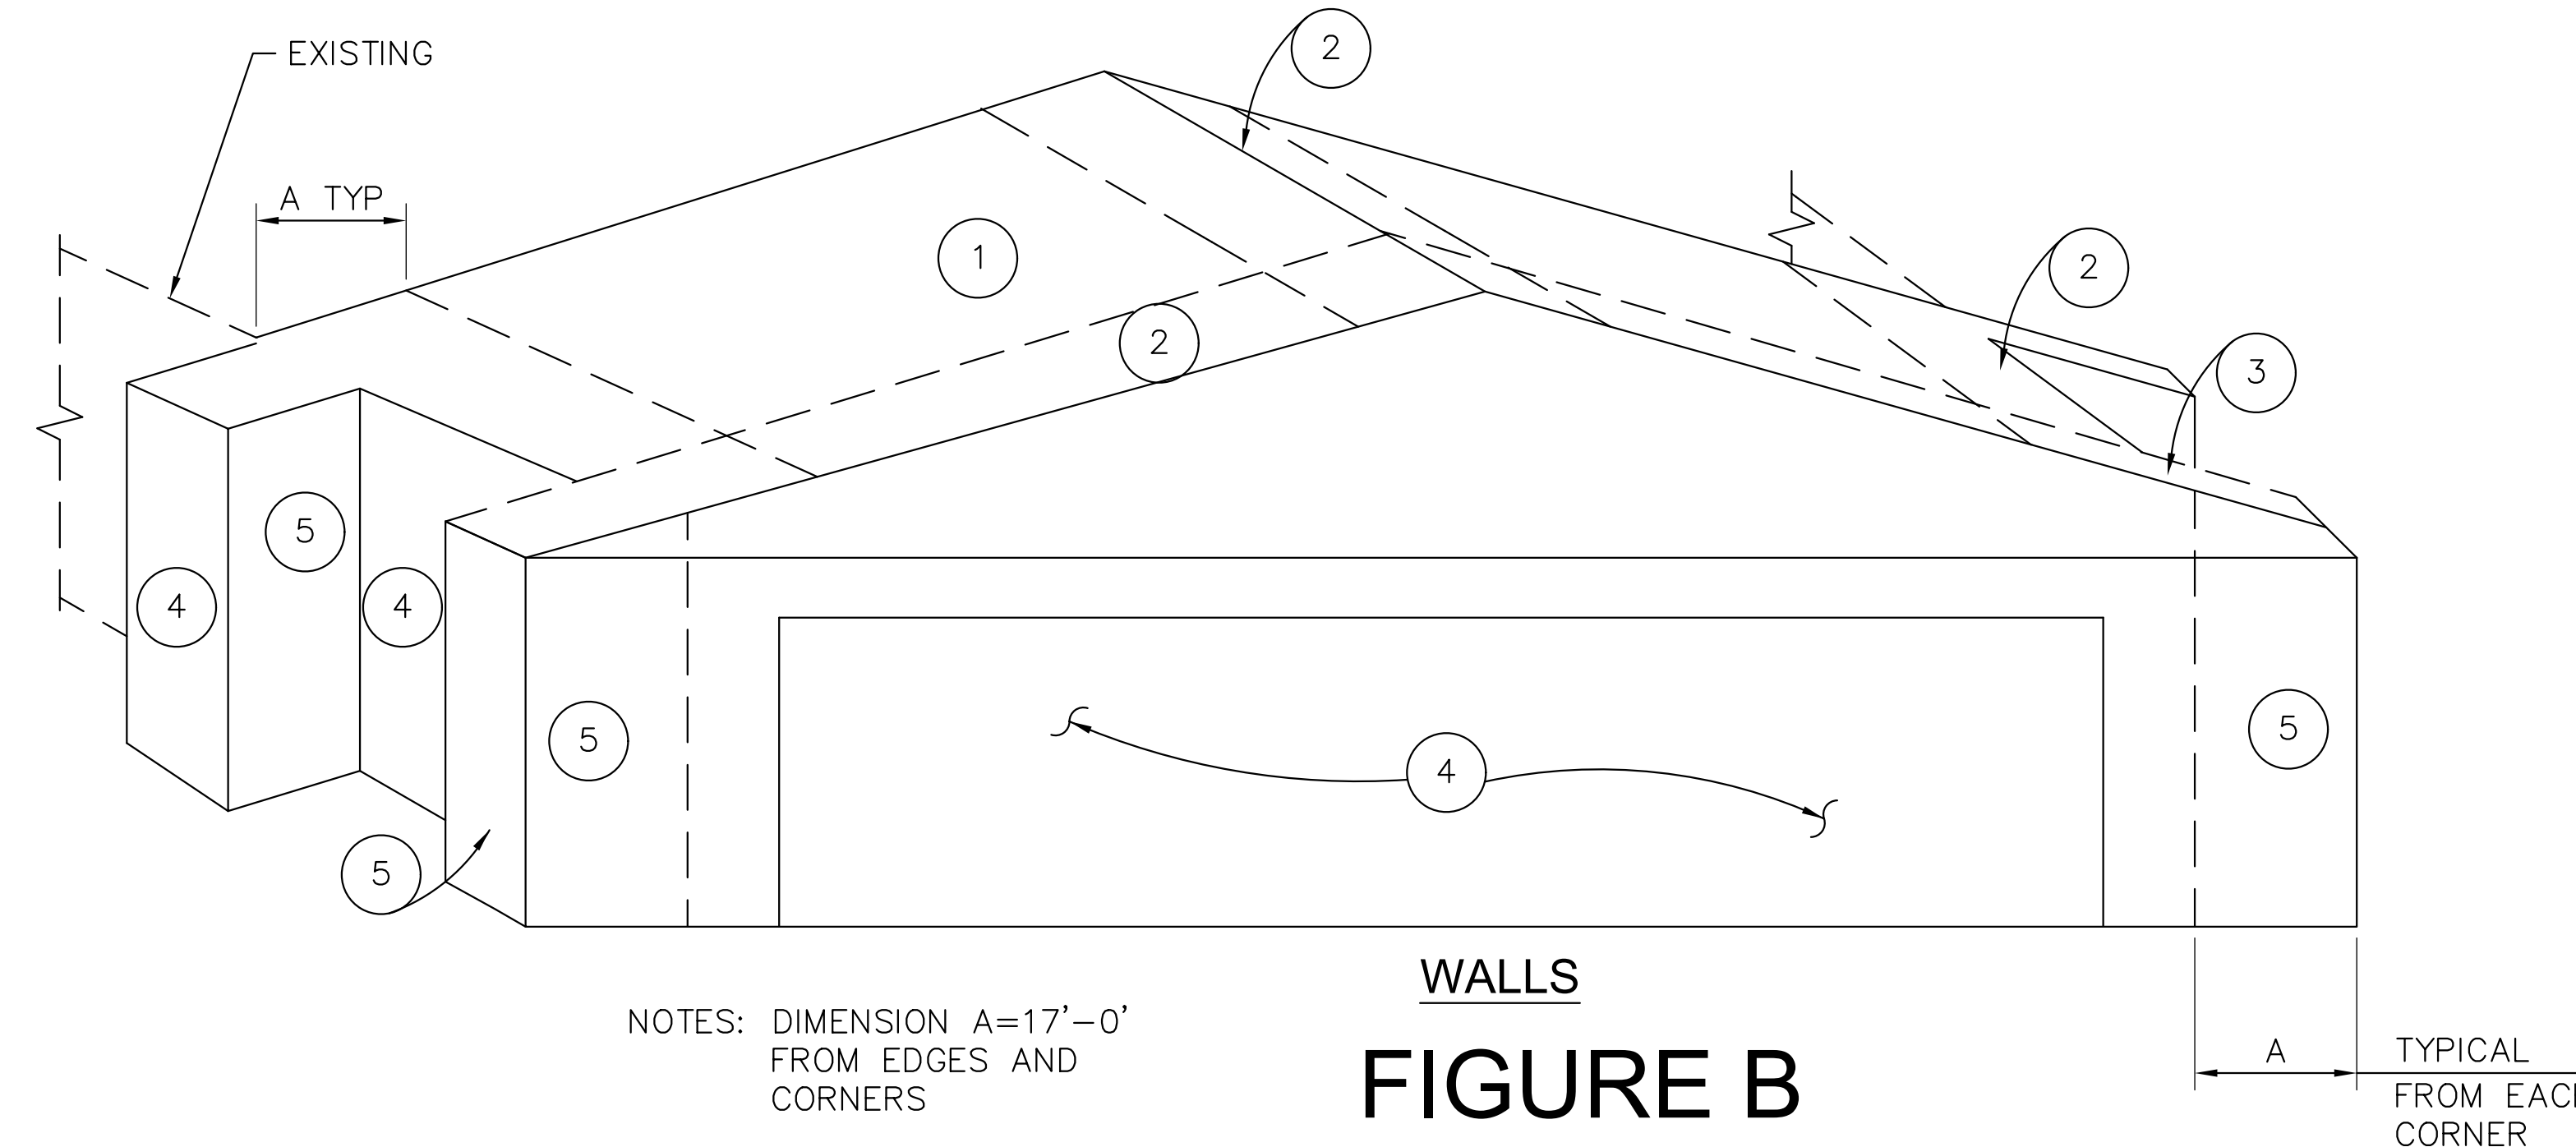


FIGURE B

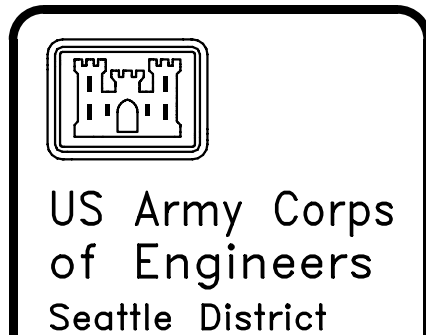

Date	Appr.
Description	Symbol
Date	Appr.
Description	Symbol

Designed by: AEW	Date: 1/29/04
Drawn by: WP	Design file no.: 3125/211-0-02
Checked by: JLF	
Submitted by: JLF	
Principal: BERGER/ABAM ENGINEERS, INC.	


ADD/ALTER FLIGHTLINE FACILITIES BLDG 304 & 375
 PORTLAND ANG. OREGON
 FY04 PN TOKD 012259

STRUCTURAL NOTES
SHEET 2 OF 2

PLATE
 NUMBER:
G-S002

6
5
4
3
2
1

A B C D E F G H

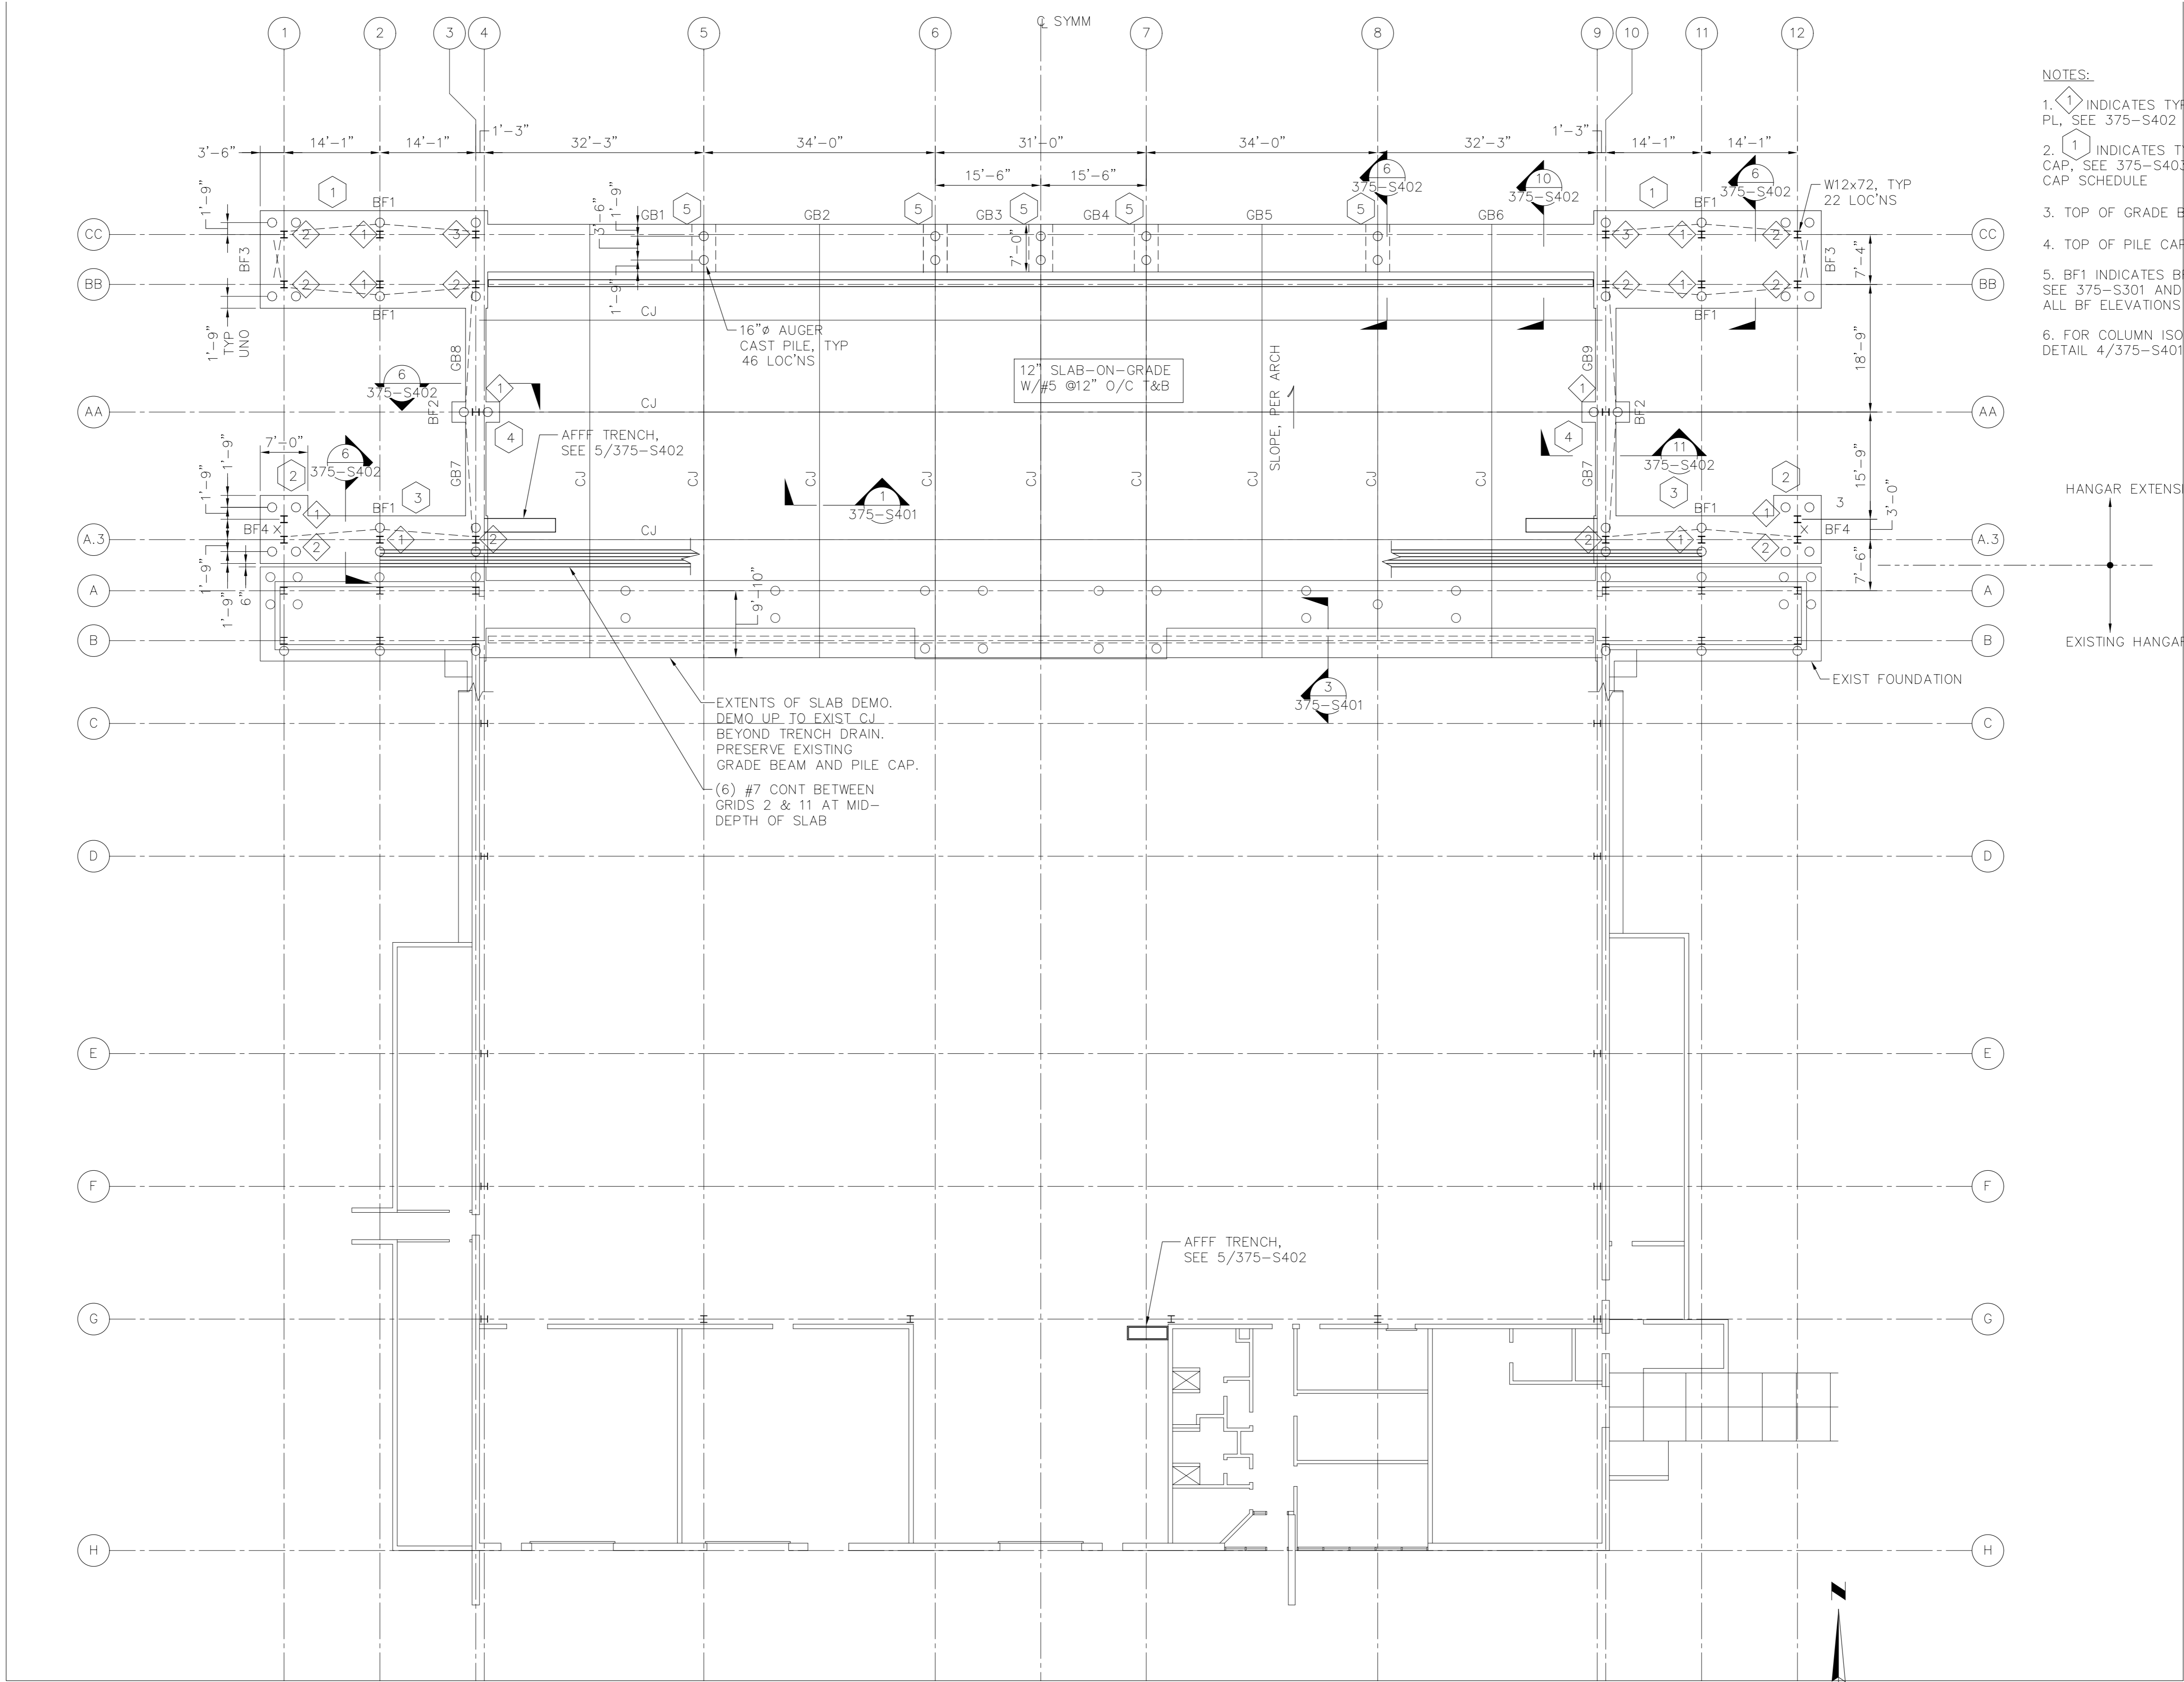


- NOTES:**
1. INDICATES TYPE OF COL BASE PL, SEE 375-S402 DETAILS.
 2. INDICATES TYPE OF PILE CAP, SEE 375-S403 FOR PILE CAP SCHEDULE
 3. TOP OF GRADE BEAM ELEV=16'-0"
 4. TOP OF PILE CAP ELEV= 16'-0"
 5. BF1 INDICATES BRACE FRAME. SEE 375-S301 AND 375-S302 FOR ALL BF ELEVATIONS
 6. FOR COLUMN ISOLATION JOINT, SEE DETAIL 4/375-S401.


EXTENTS OF SLAB DEMO. DEMO UP TO EXIST CJ. BEYOND TRENCH DRAIN. PRESERVE EXISTING GRADE BEAM AND PILE CAP.
(6) #7 CONT BETWEEN GRIDS 2 & 11 AT MID-DEPTH OF SLAB

HANGAR EXTENSION
EXISTING HANGAR


FOUNDATION PLAN
SCALE: 3/32" = 1'-0"

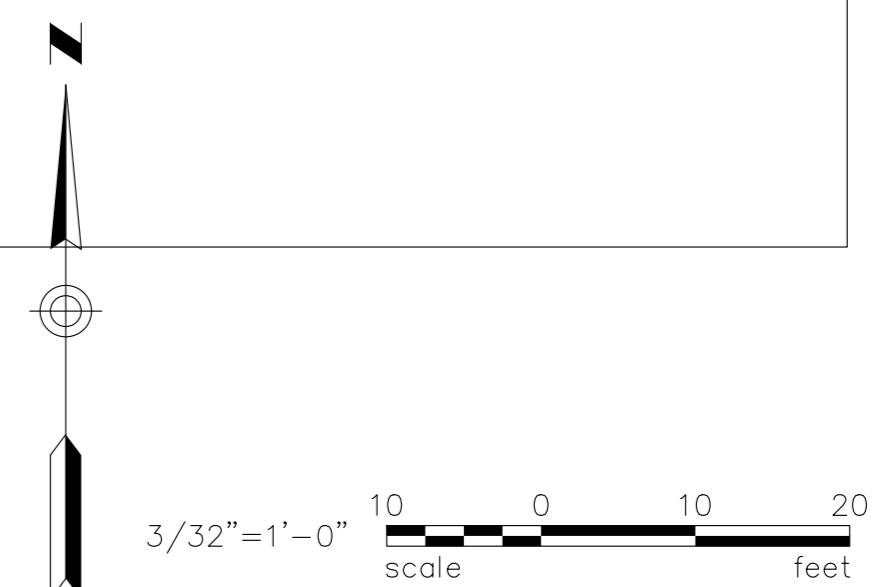

ADD/ALTER FLIGHTLINE FACILITIES BLDG 304 & 375 PORTLAND ANG, OREGON FY04 PN TOKD 012259	FOUNDATION PLAN
U.S. ARMY ENGINEER DISTRICT, SEATTLE CORPS OF ENGINEERS SEATTLE, WASHINGTON Submitted by: BERGER/ABAM ENGINEERS, INC (206) 374-9790 FAX(206) 374-9795 Principal	Date: 1/30/04 Design file no. 3125/211-10-02 Designed by: AEW Drawn by: VP Checked by: JF Submitted by: Chief
Plate Number: 375-S101	Sheet 55 of 76

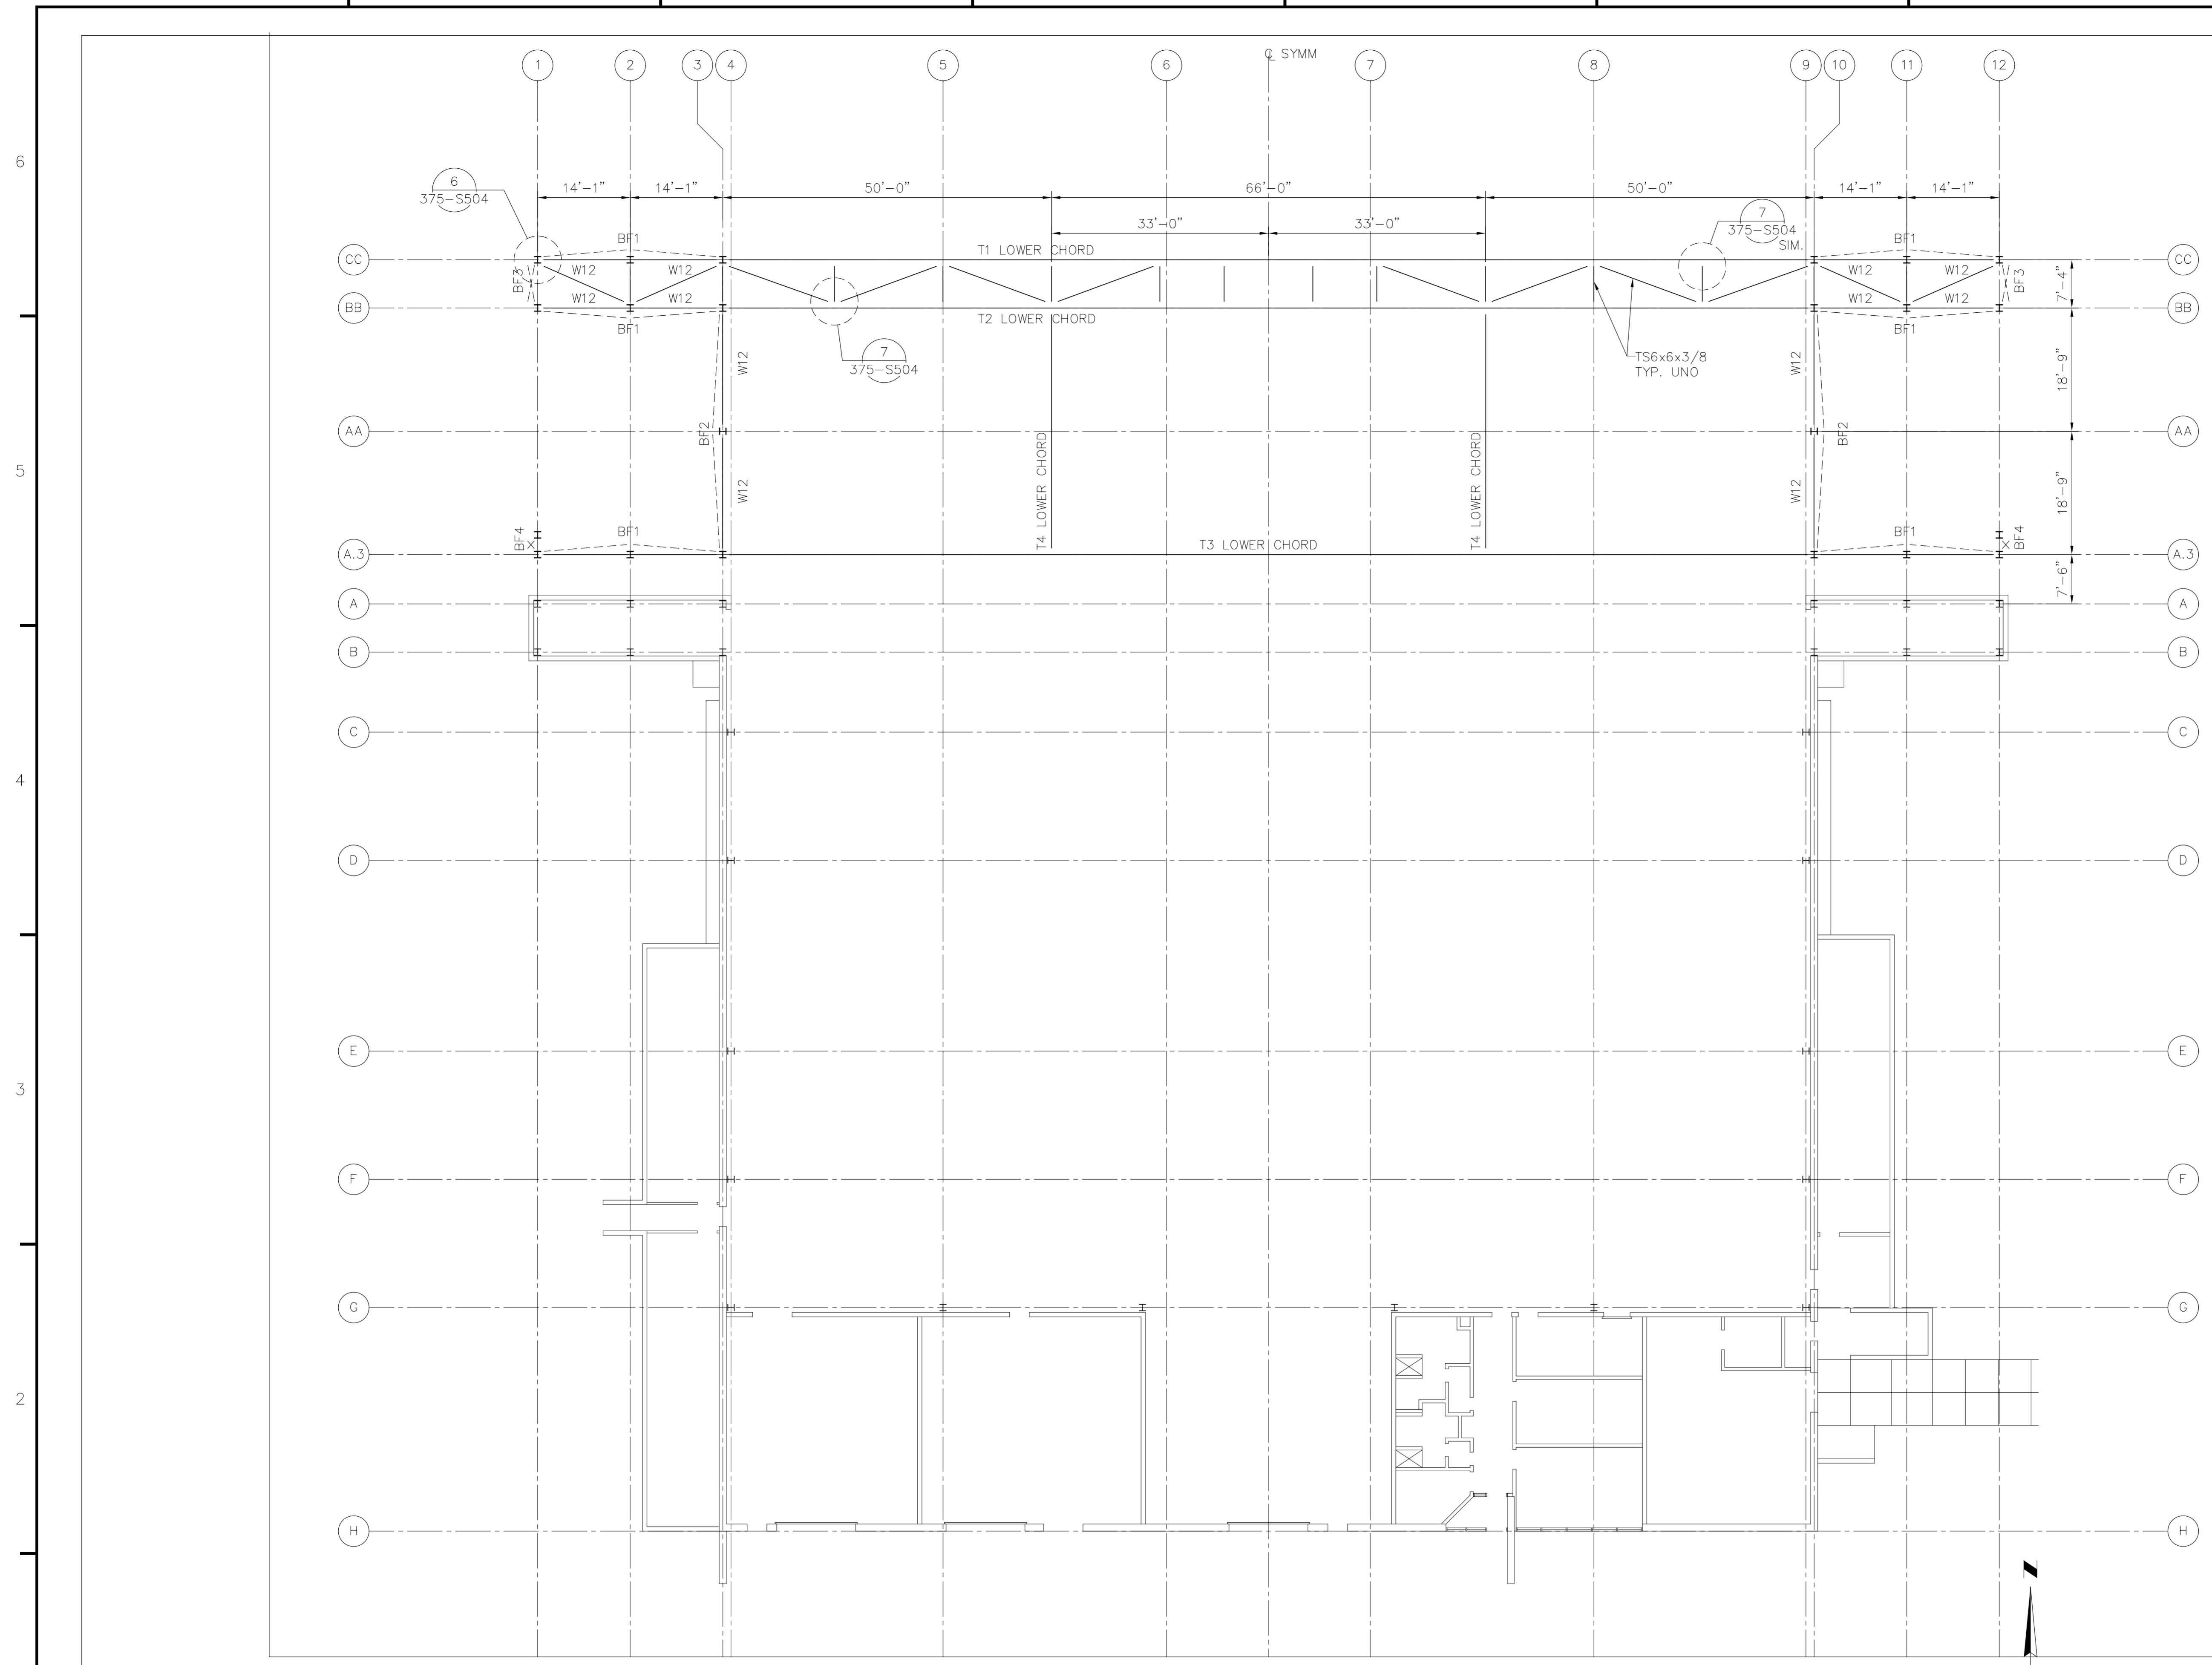

LOWER CHORD FRAMING PLAN
 SCALE: 3/32" = 1'-0"

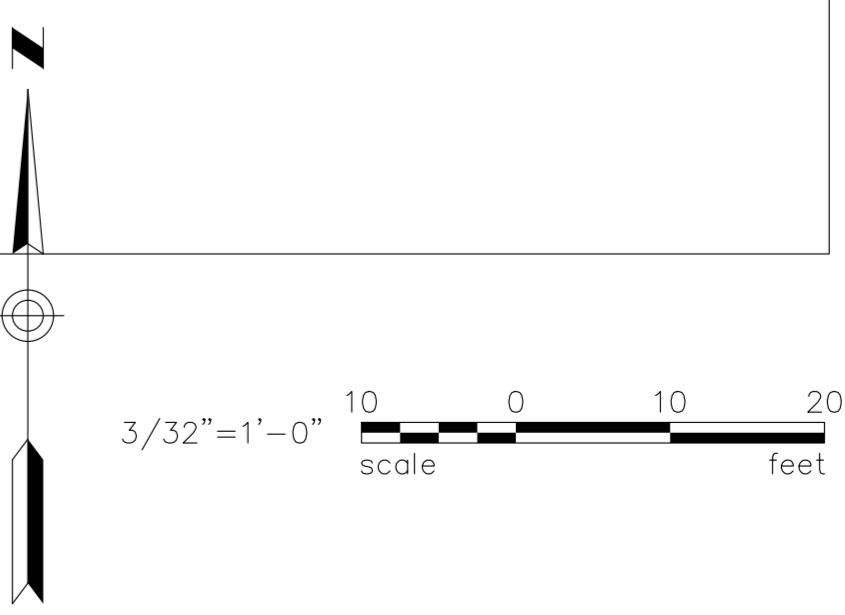

Date	Description	Symbol	Appr.


Designed by: ACW	Date: 1/20/04	Section
Drawn by: YJP	Design file no. 3125/211-10-02	
Checked by: J.J.F.		
Submitted by: 		

U.S. ARMY ENGINEER DISTRICT, SEATTLE
 CORPS OF ENGINEERS
 SEATTLE, WASHINGTON
 Submitted by:
 BERGER/ABAM
 BERGER/ABAM
 (206) 374-9790 FAX:(206) 374-9795
 Principal


ADD/ALTER FLIGHTLINE FACILITIES BLDG 304 & 375
 PORTLAND ANG, OREGON
 FY04 PN TOKD 012259

LOWER CHORD FRAMING PLAN

PLATE NUMBER:
375-S201

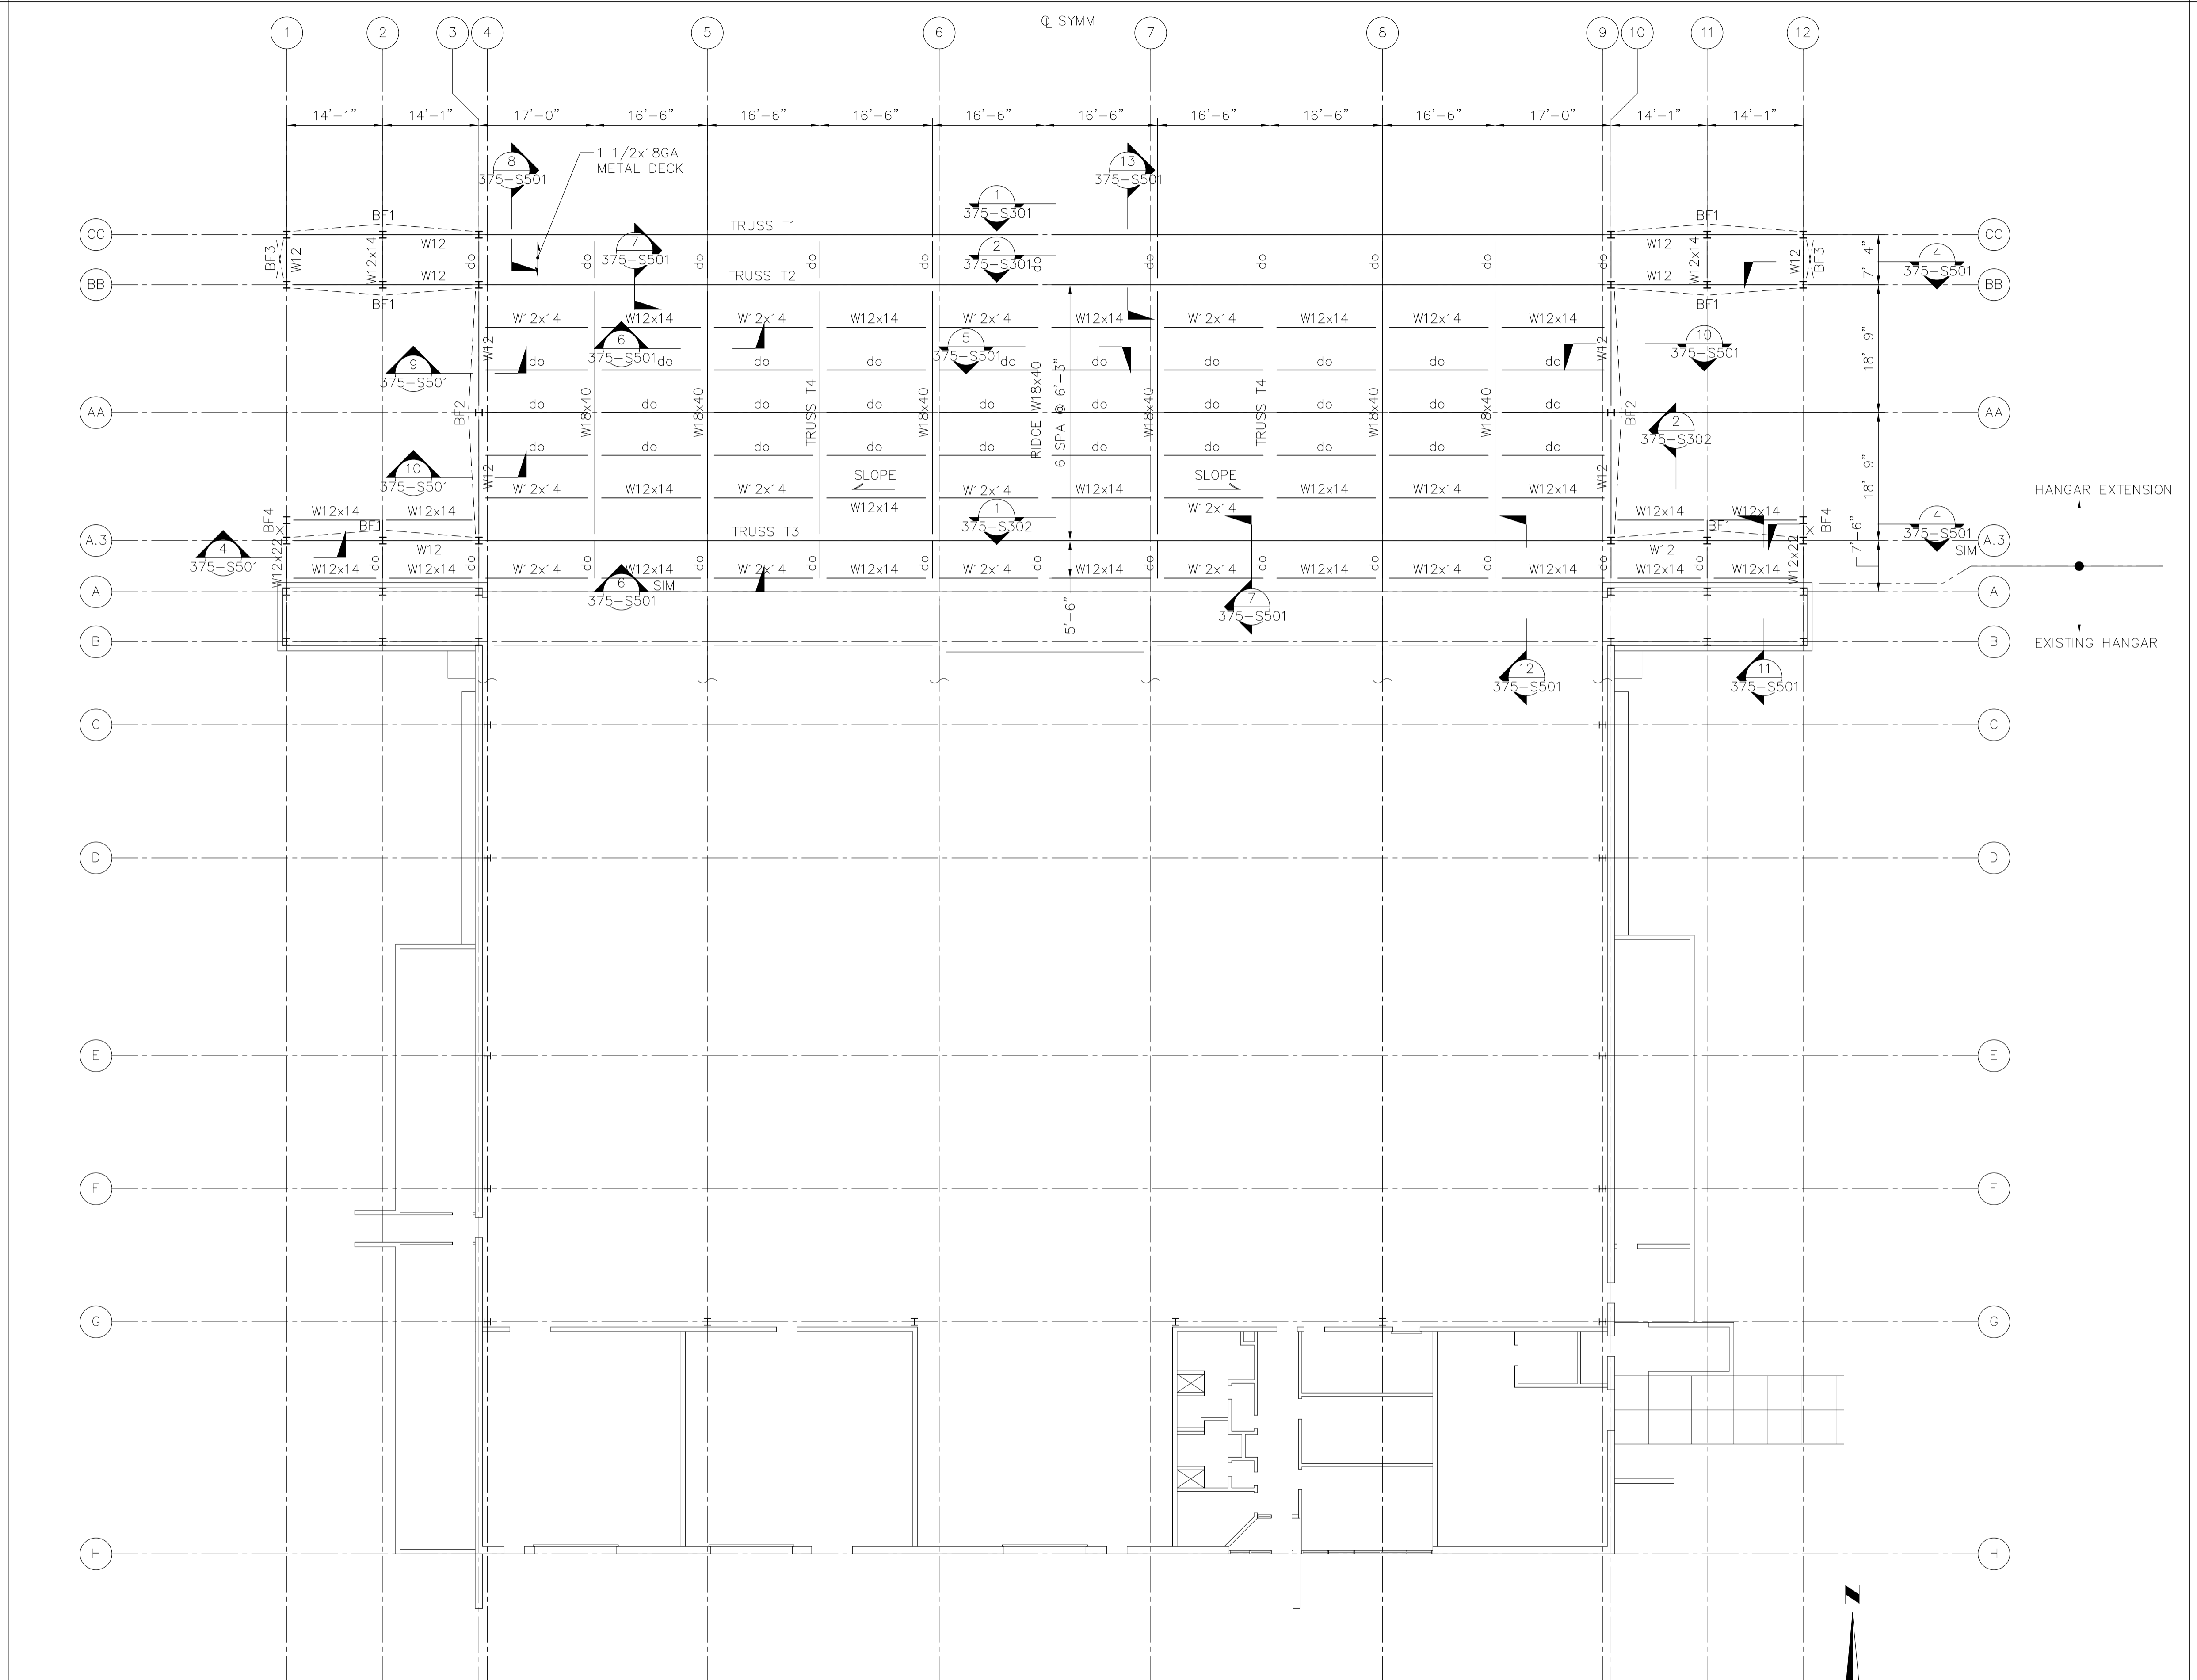

ROOF FRAMING PLAN
SCALE: 3/32" = 1'-0"

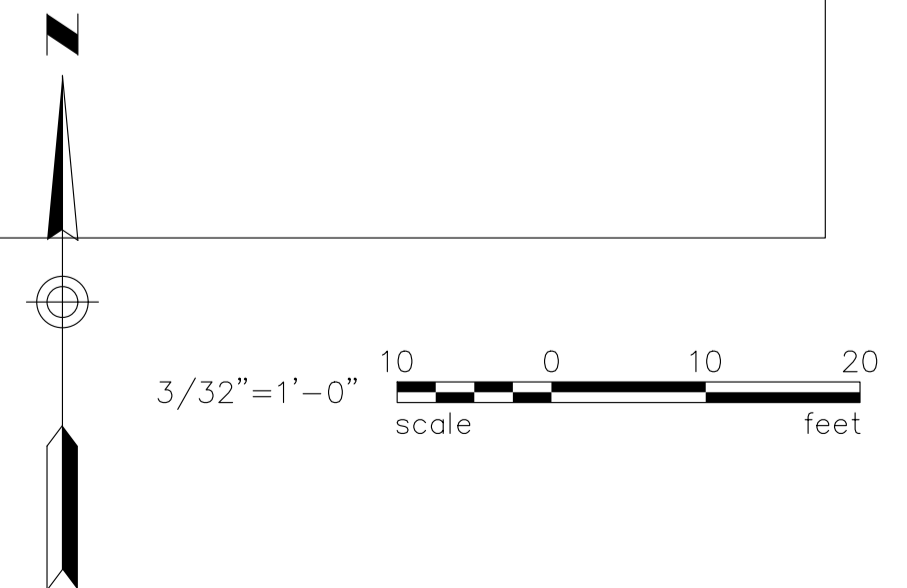


Date	Description

Designed by: XEN	Date: 1/20/04
Drawn by: WP	Design file no. 3125/211-10-02
Checked by: JLF	
Submitted by: Chief	



ADD/ALTER FLIGHTLINE FACILITIES BLDG 304 & 375
PORTLAND ANG, OREGON
F704 PN TQKD 012259

U.S. ARMY ENGINEER DISTRICT, SEATTLE
CORPS OF ENGINEERS
SEATTLE, WASHINGTON


Submitted by:
BENJAMIN R. BAIAM
ENGINEER, INC.
(206) 374-9790 FAX:(206) 374-9795
Principal

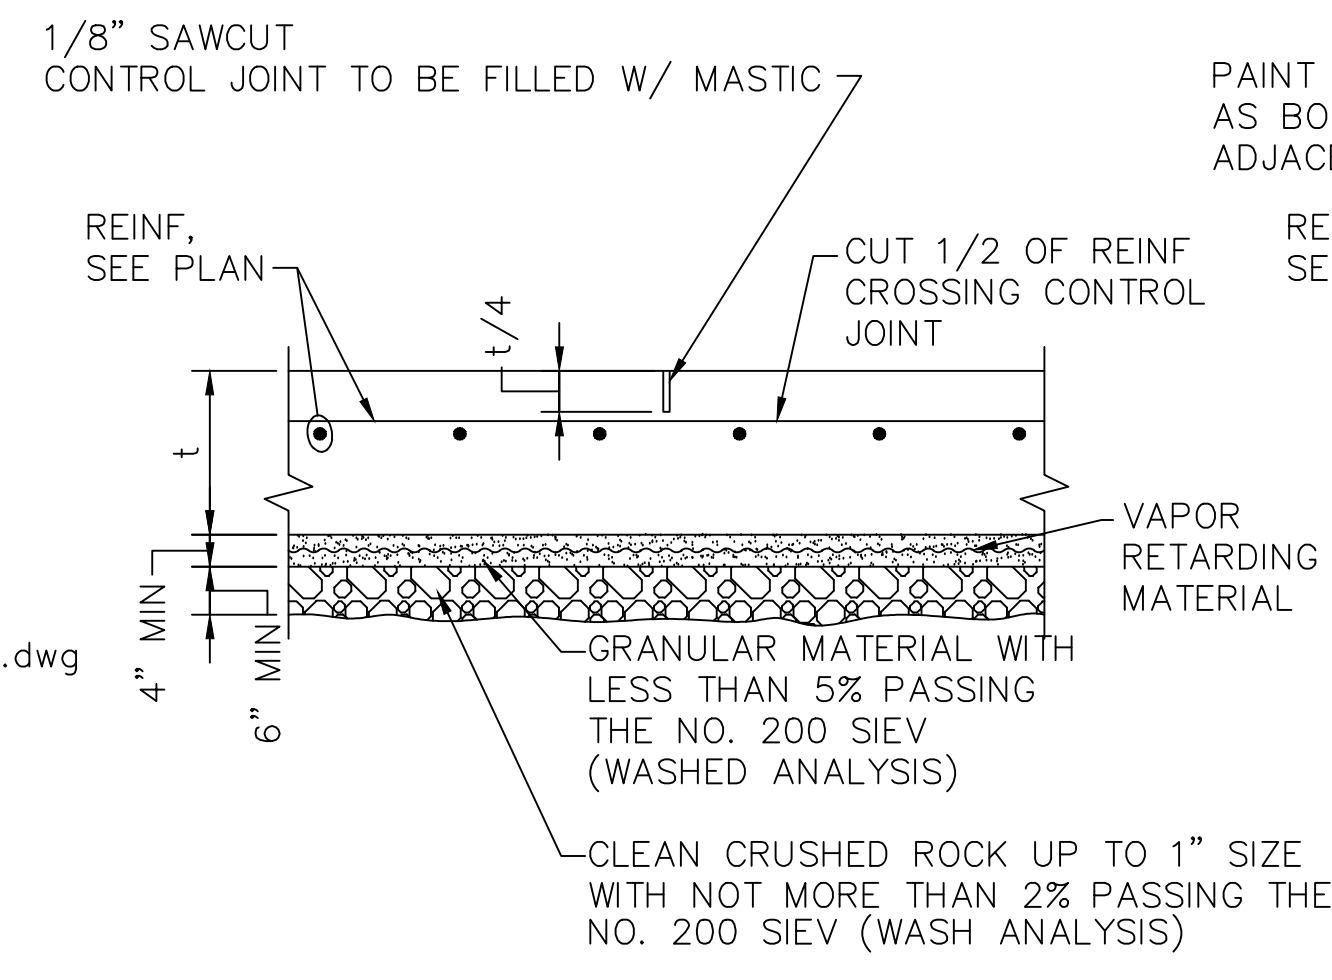


CONTROL JOINT S.J.T. CONSTRUCTION JOINT C.J.T.
1 TYPICAL SLAB-ON-GRADE CONTROL & CONSTRUCTION JOINT DETAILS
375-S401 SCALE: NTS

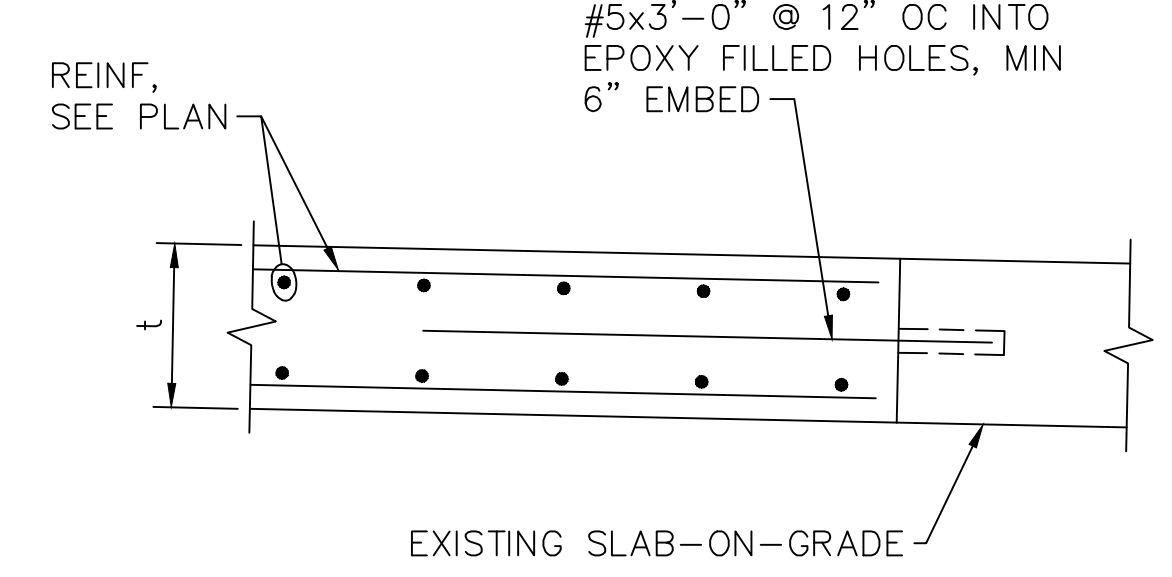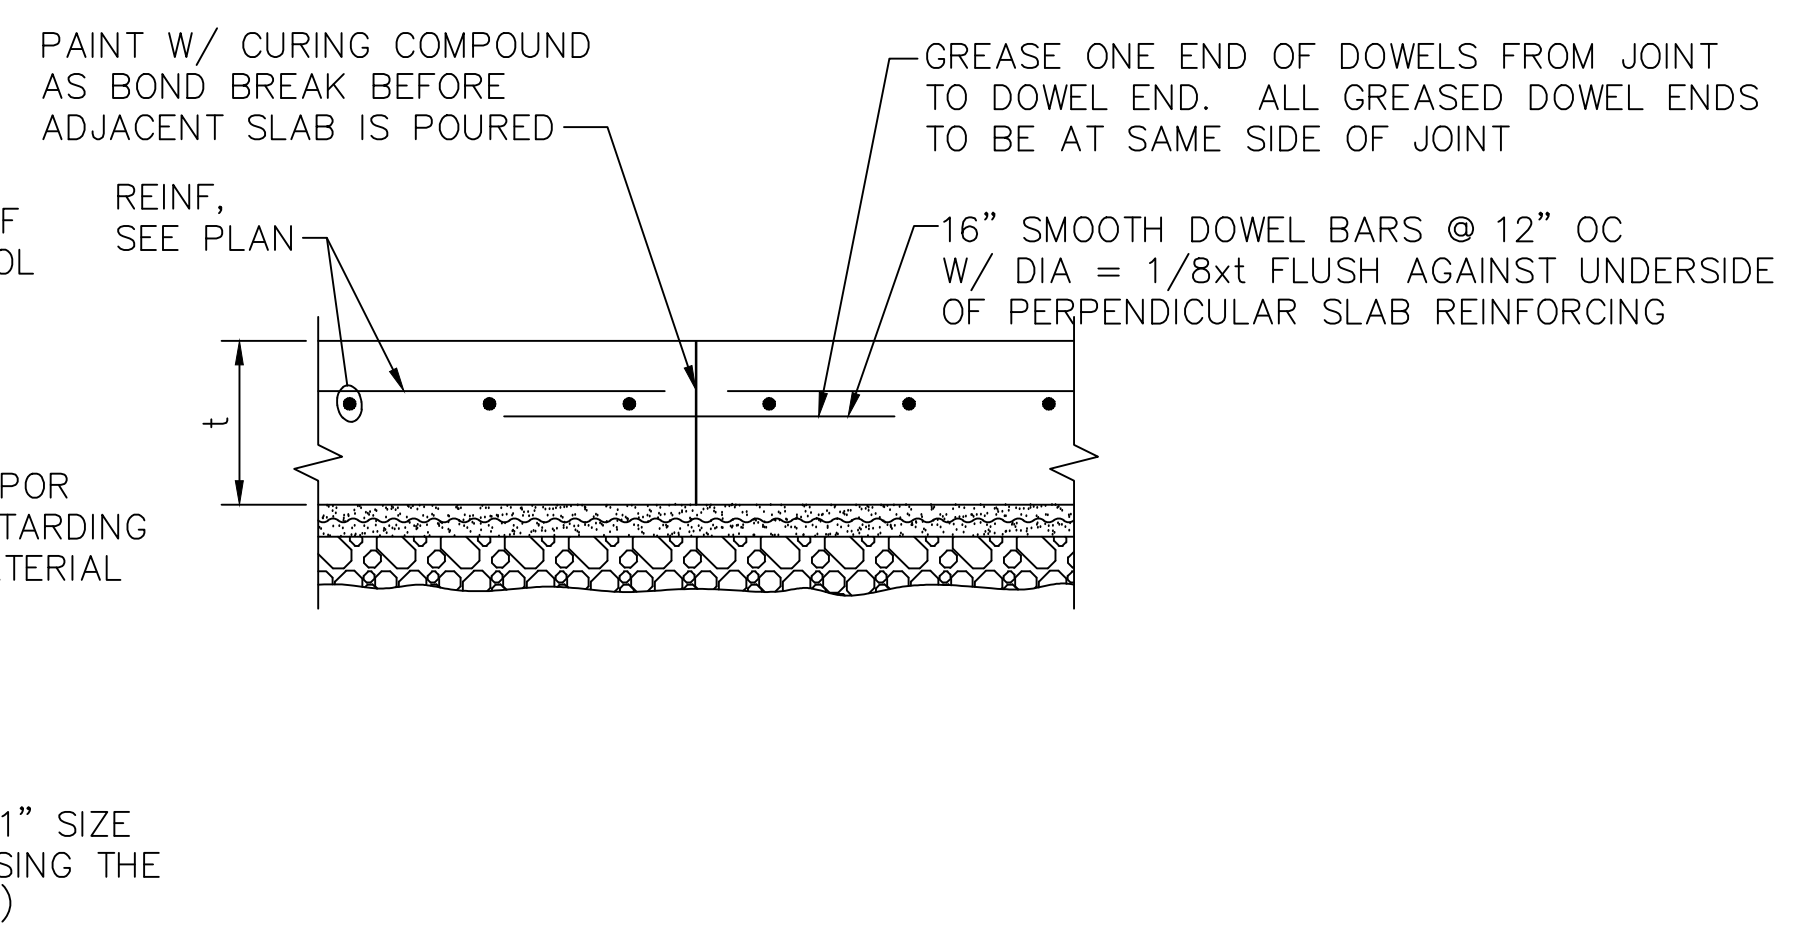


3 SLAB-ON-GRADE TO EXIST
375-S401 SCALE: NTS

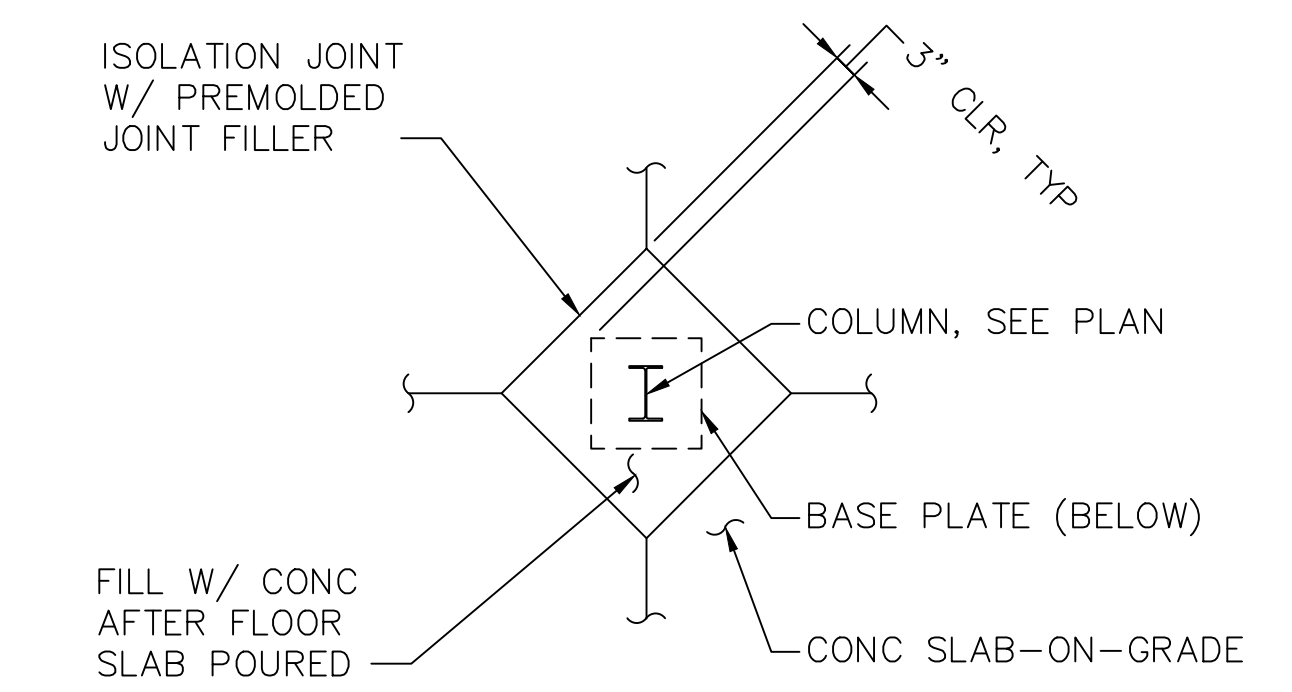


4 DETAIL - ISOLATION JOINT @ COLUMNS
375-S401 SCALE: NTS

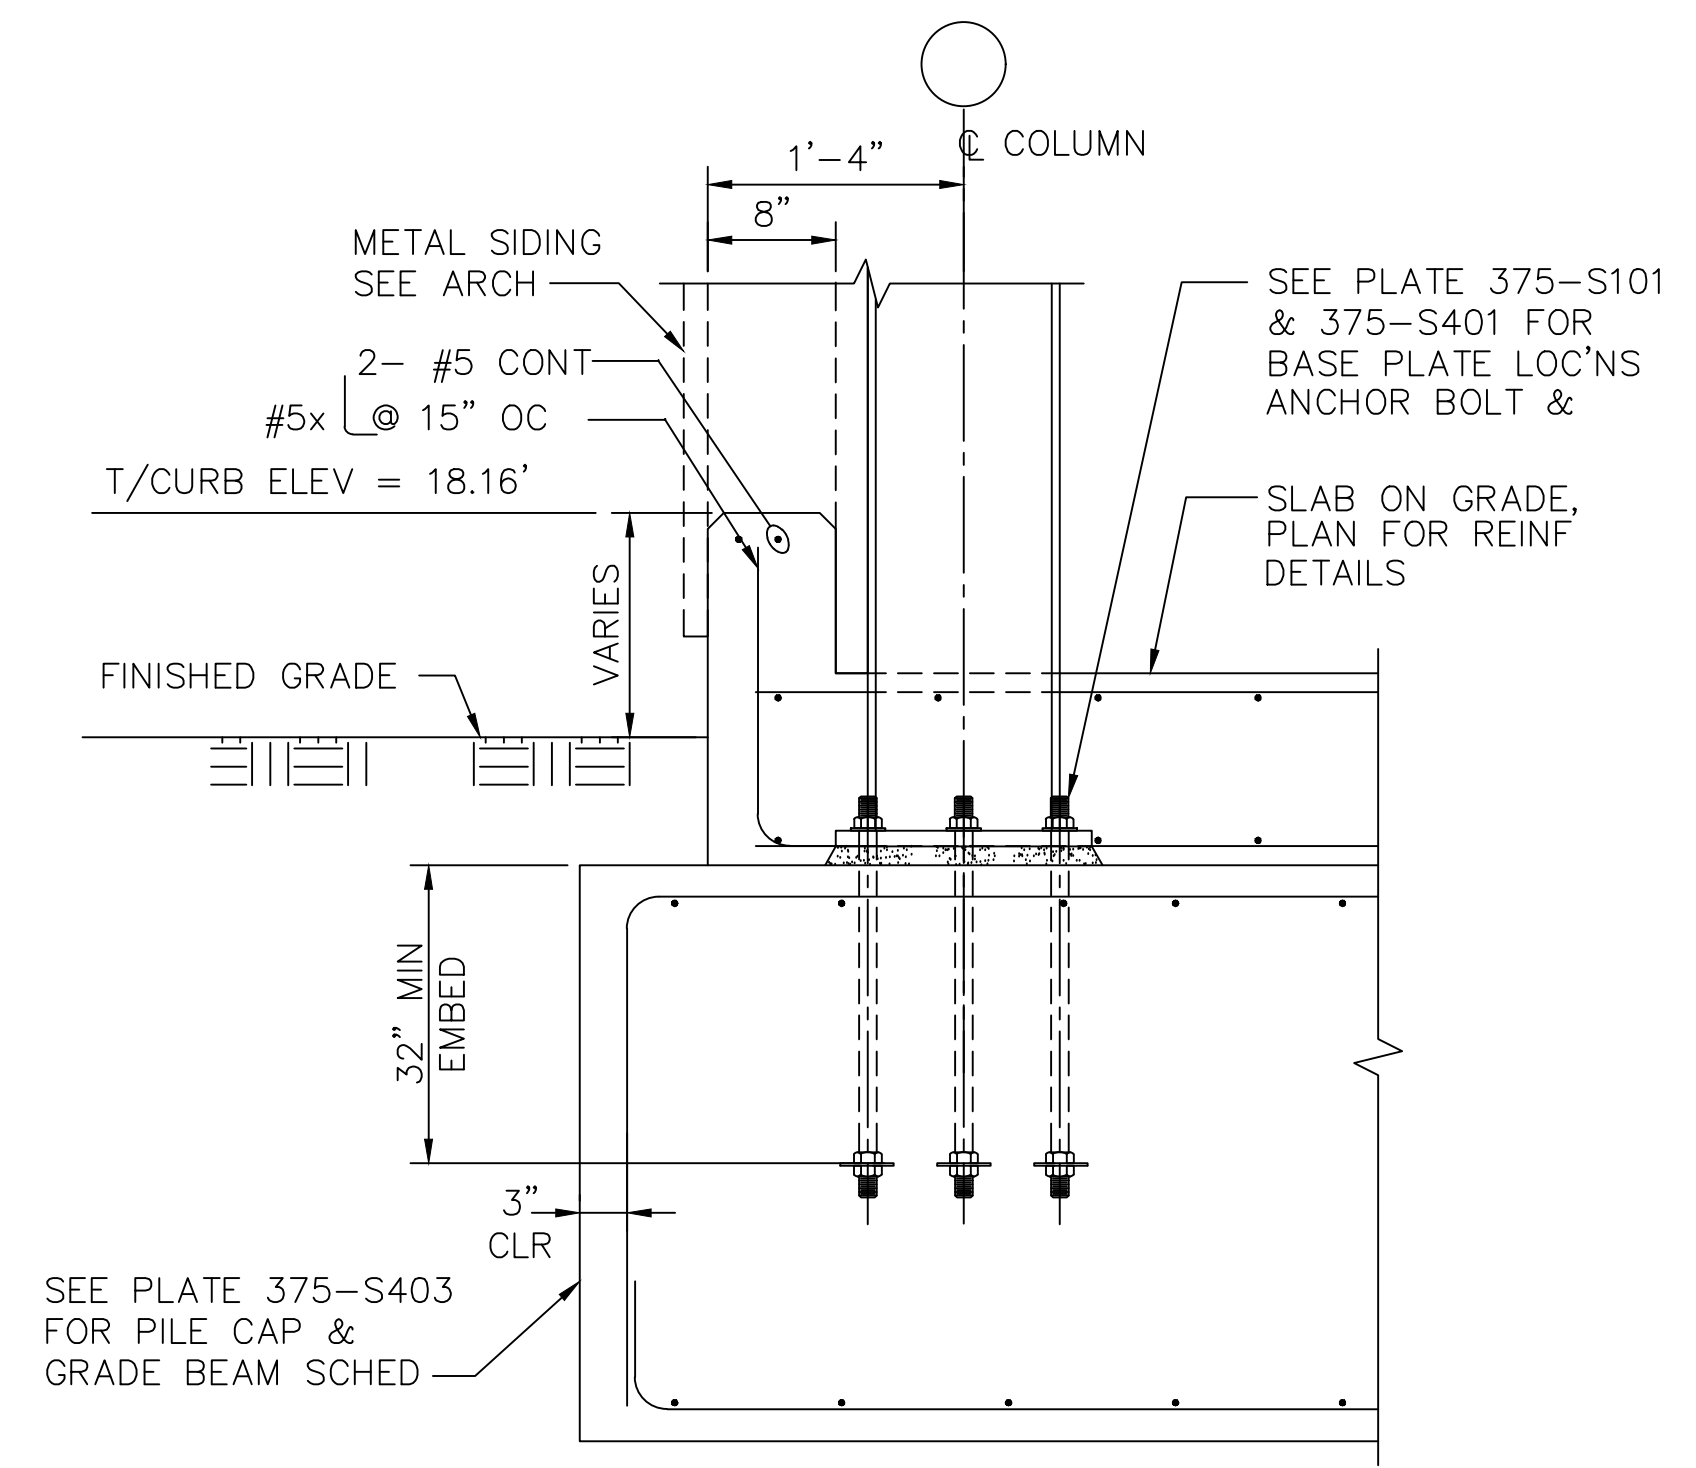


5 DETAIL - TYP EXTERIOR COL DETAIL
375-S401 SCALE: 1" = 1'-0"

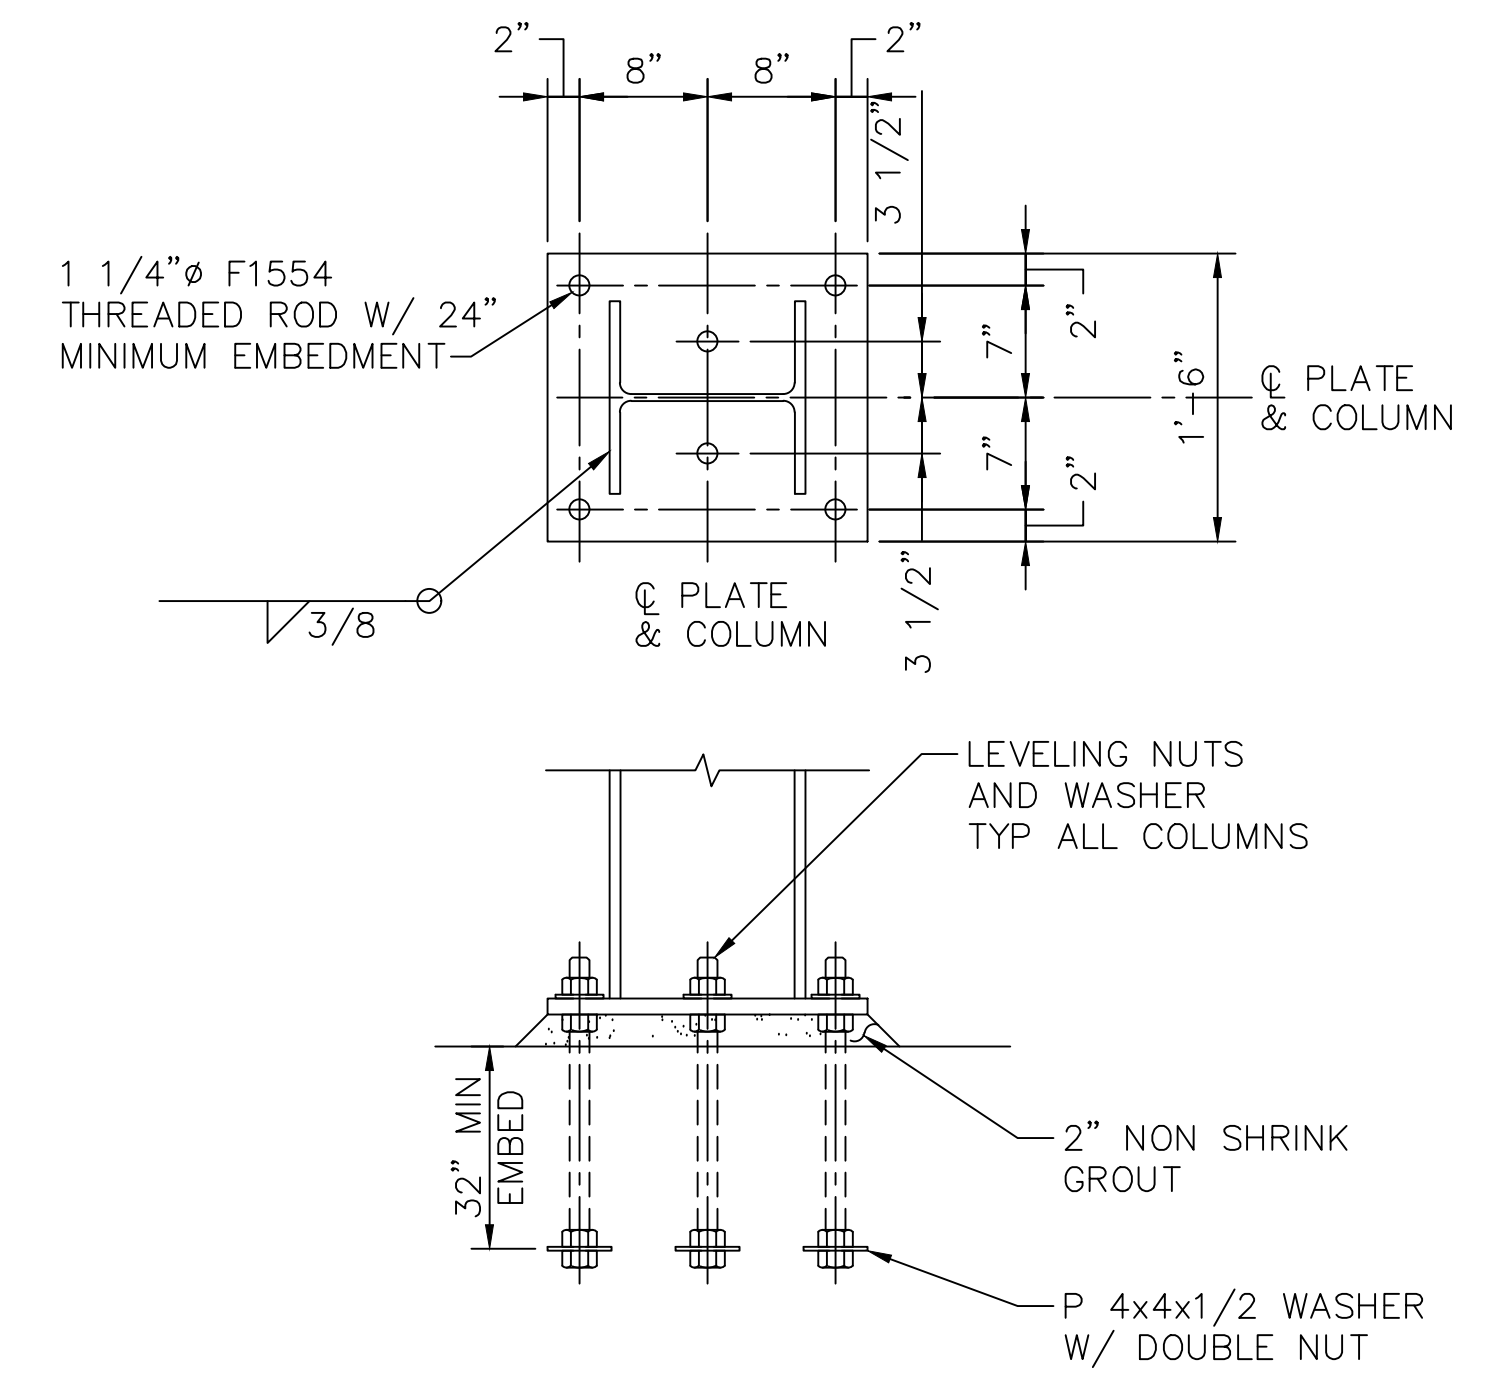


6 DETAIL-BASE PLATE TYPE 1
375-S401 SCALE: 1" = 1'-0"

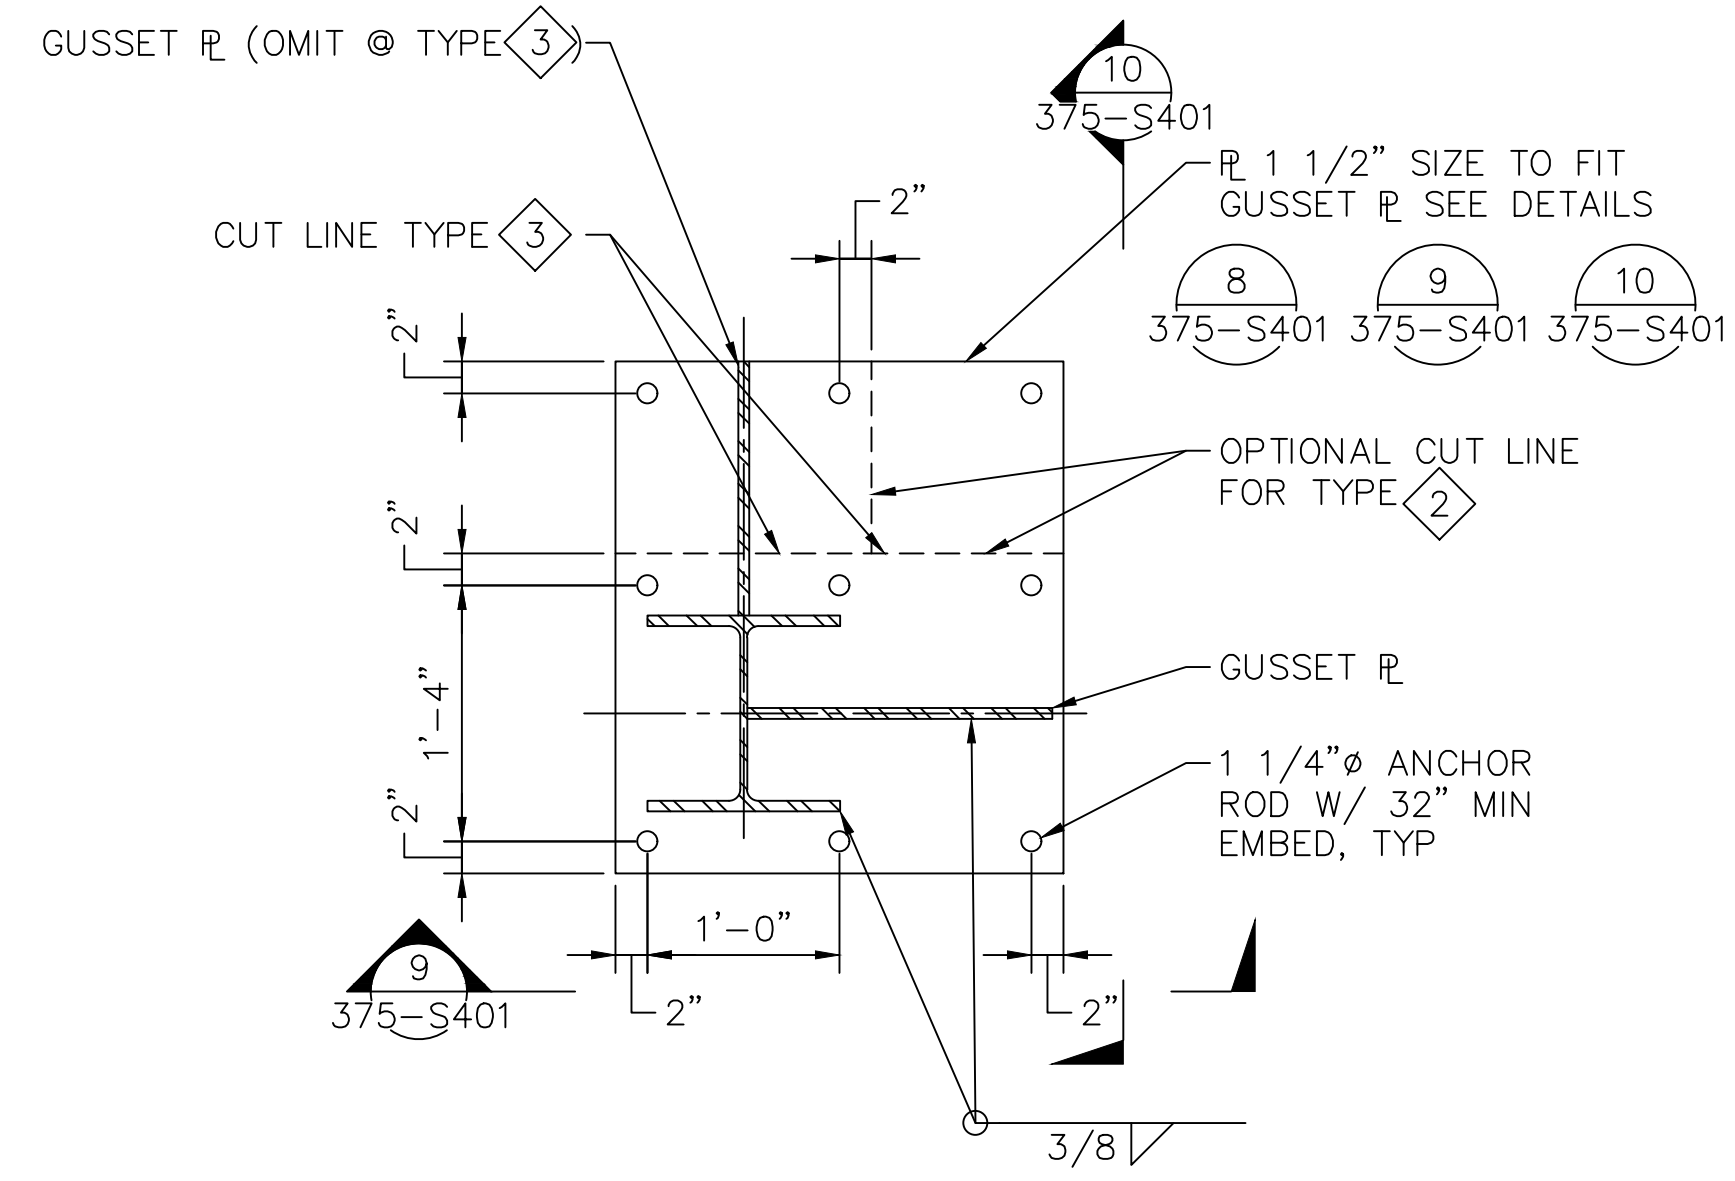


7 DETAIL-BASE PLATE TYPE 2 AND 3
375-S401 SCALE: 1" = 1'-0"

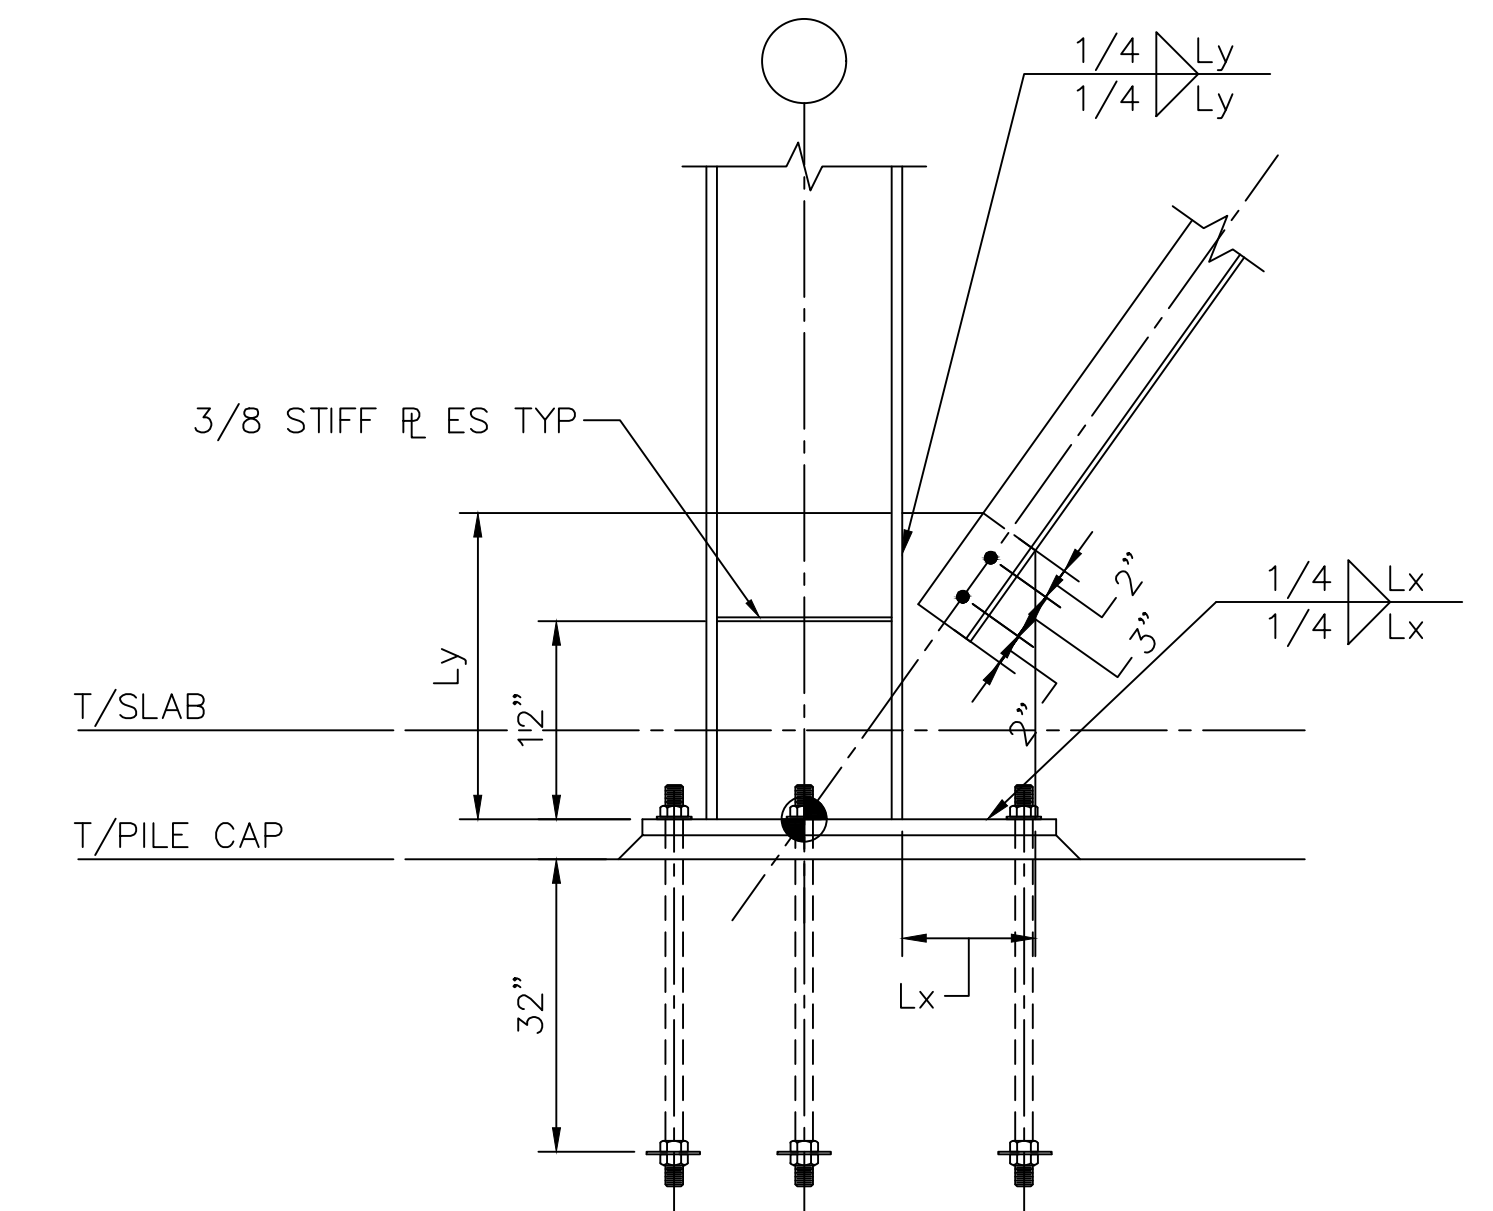


8 GUSSET PLATE DETAIL
375-S401 SCALE: 1" = 1'-0"

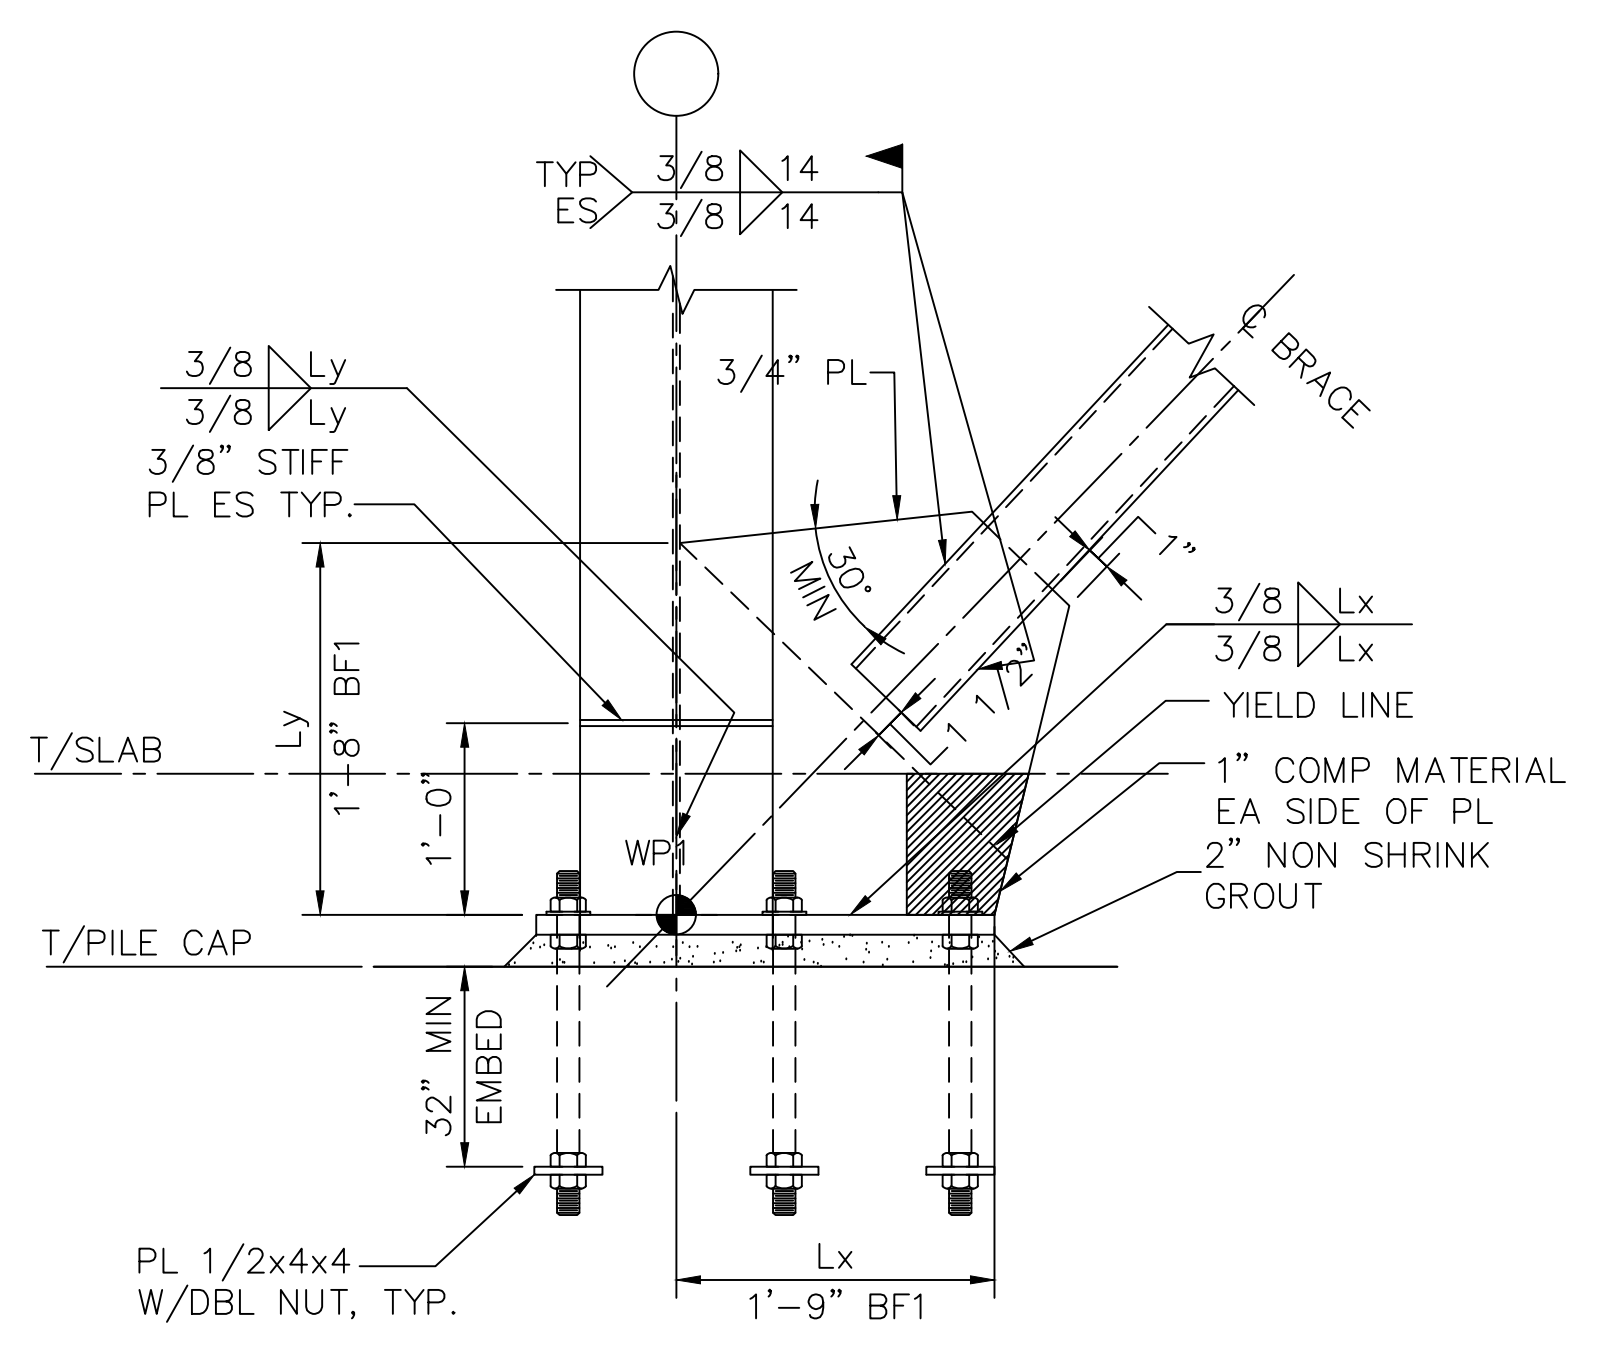


9 GUSSET PLATE DETAIL
375-S401 SCALE: 1" = 1'-0"

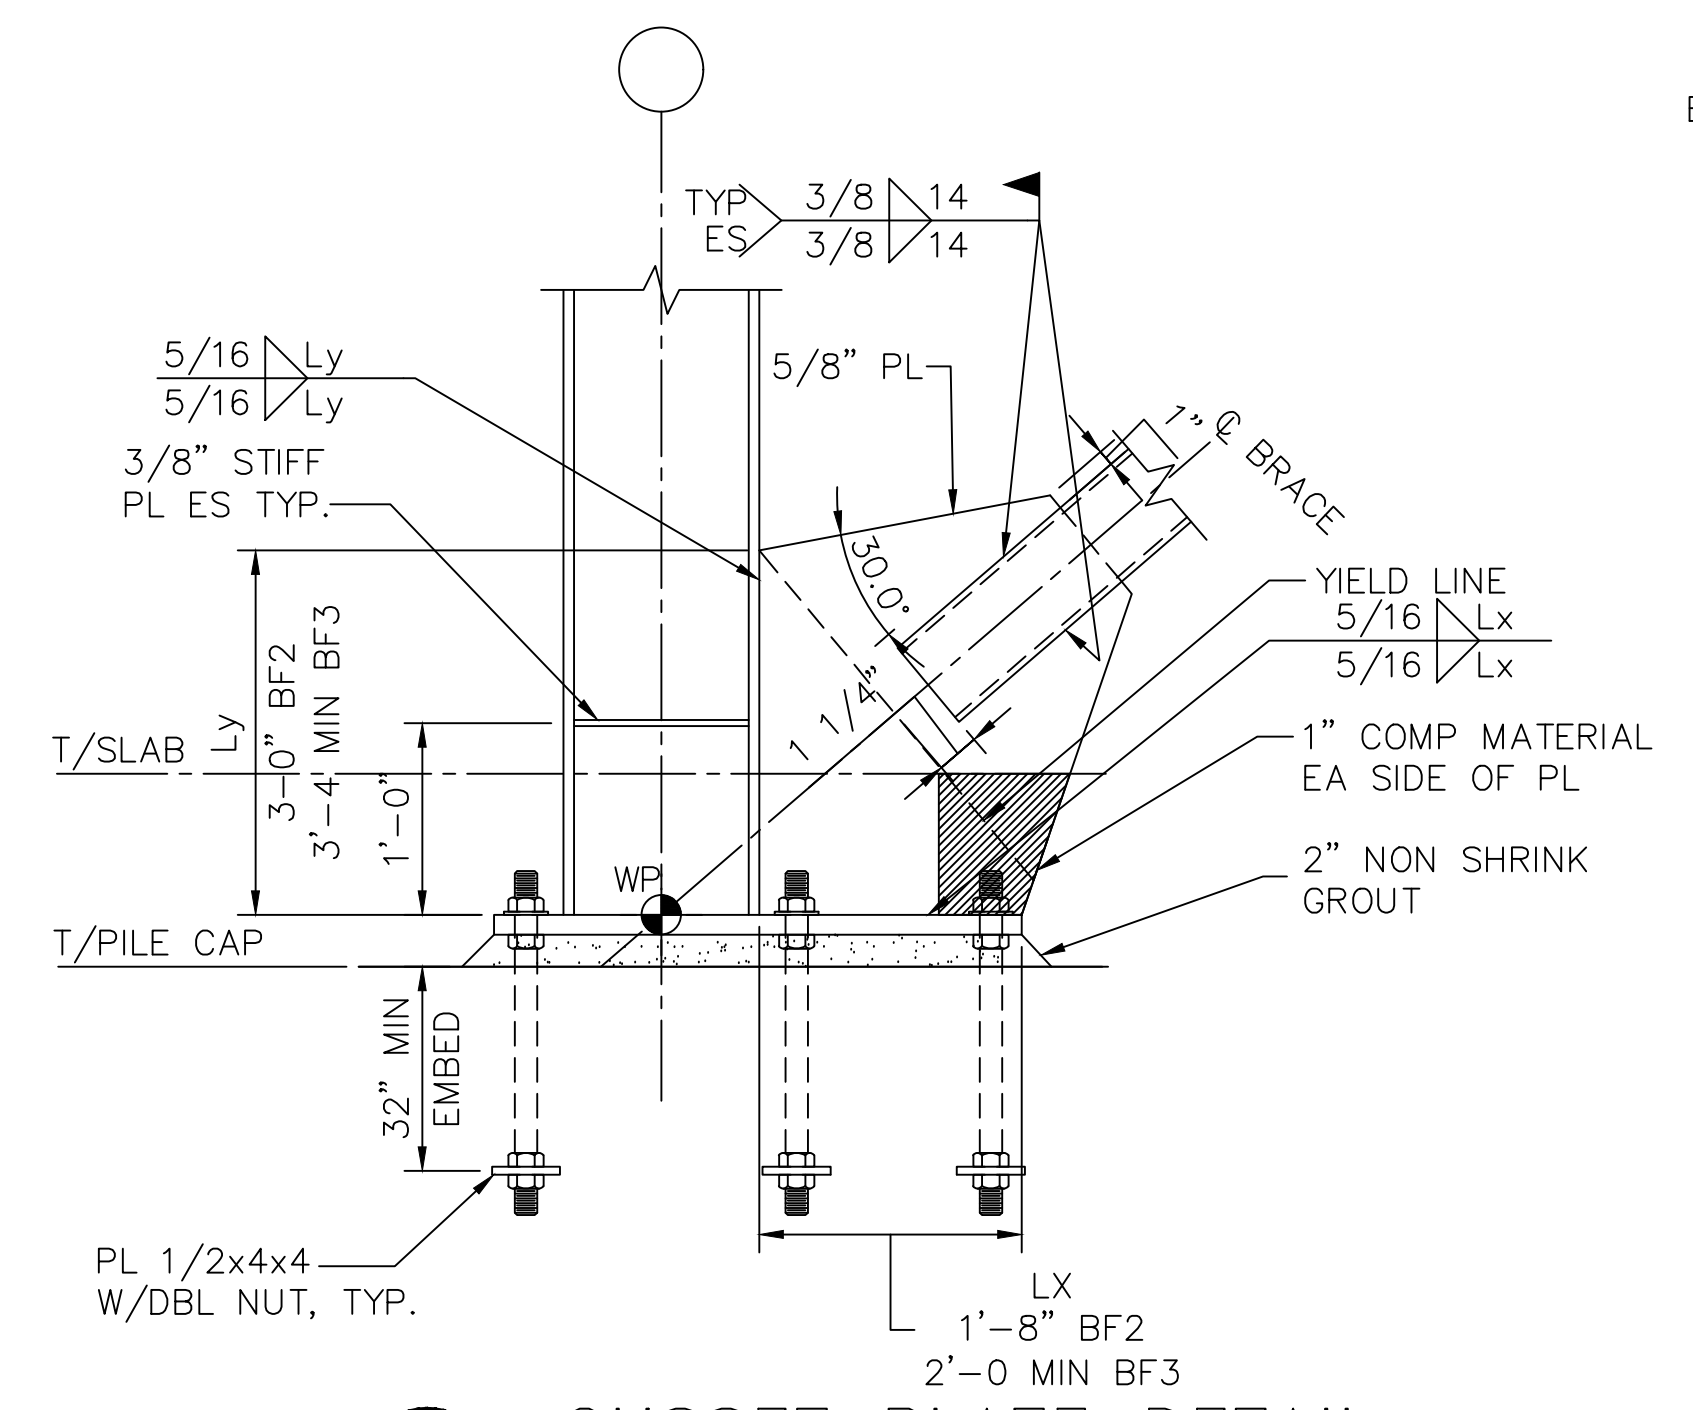

10 GUSSET PLATE DETAIL
375-S401 SCALE: 1" = 1'-0"

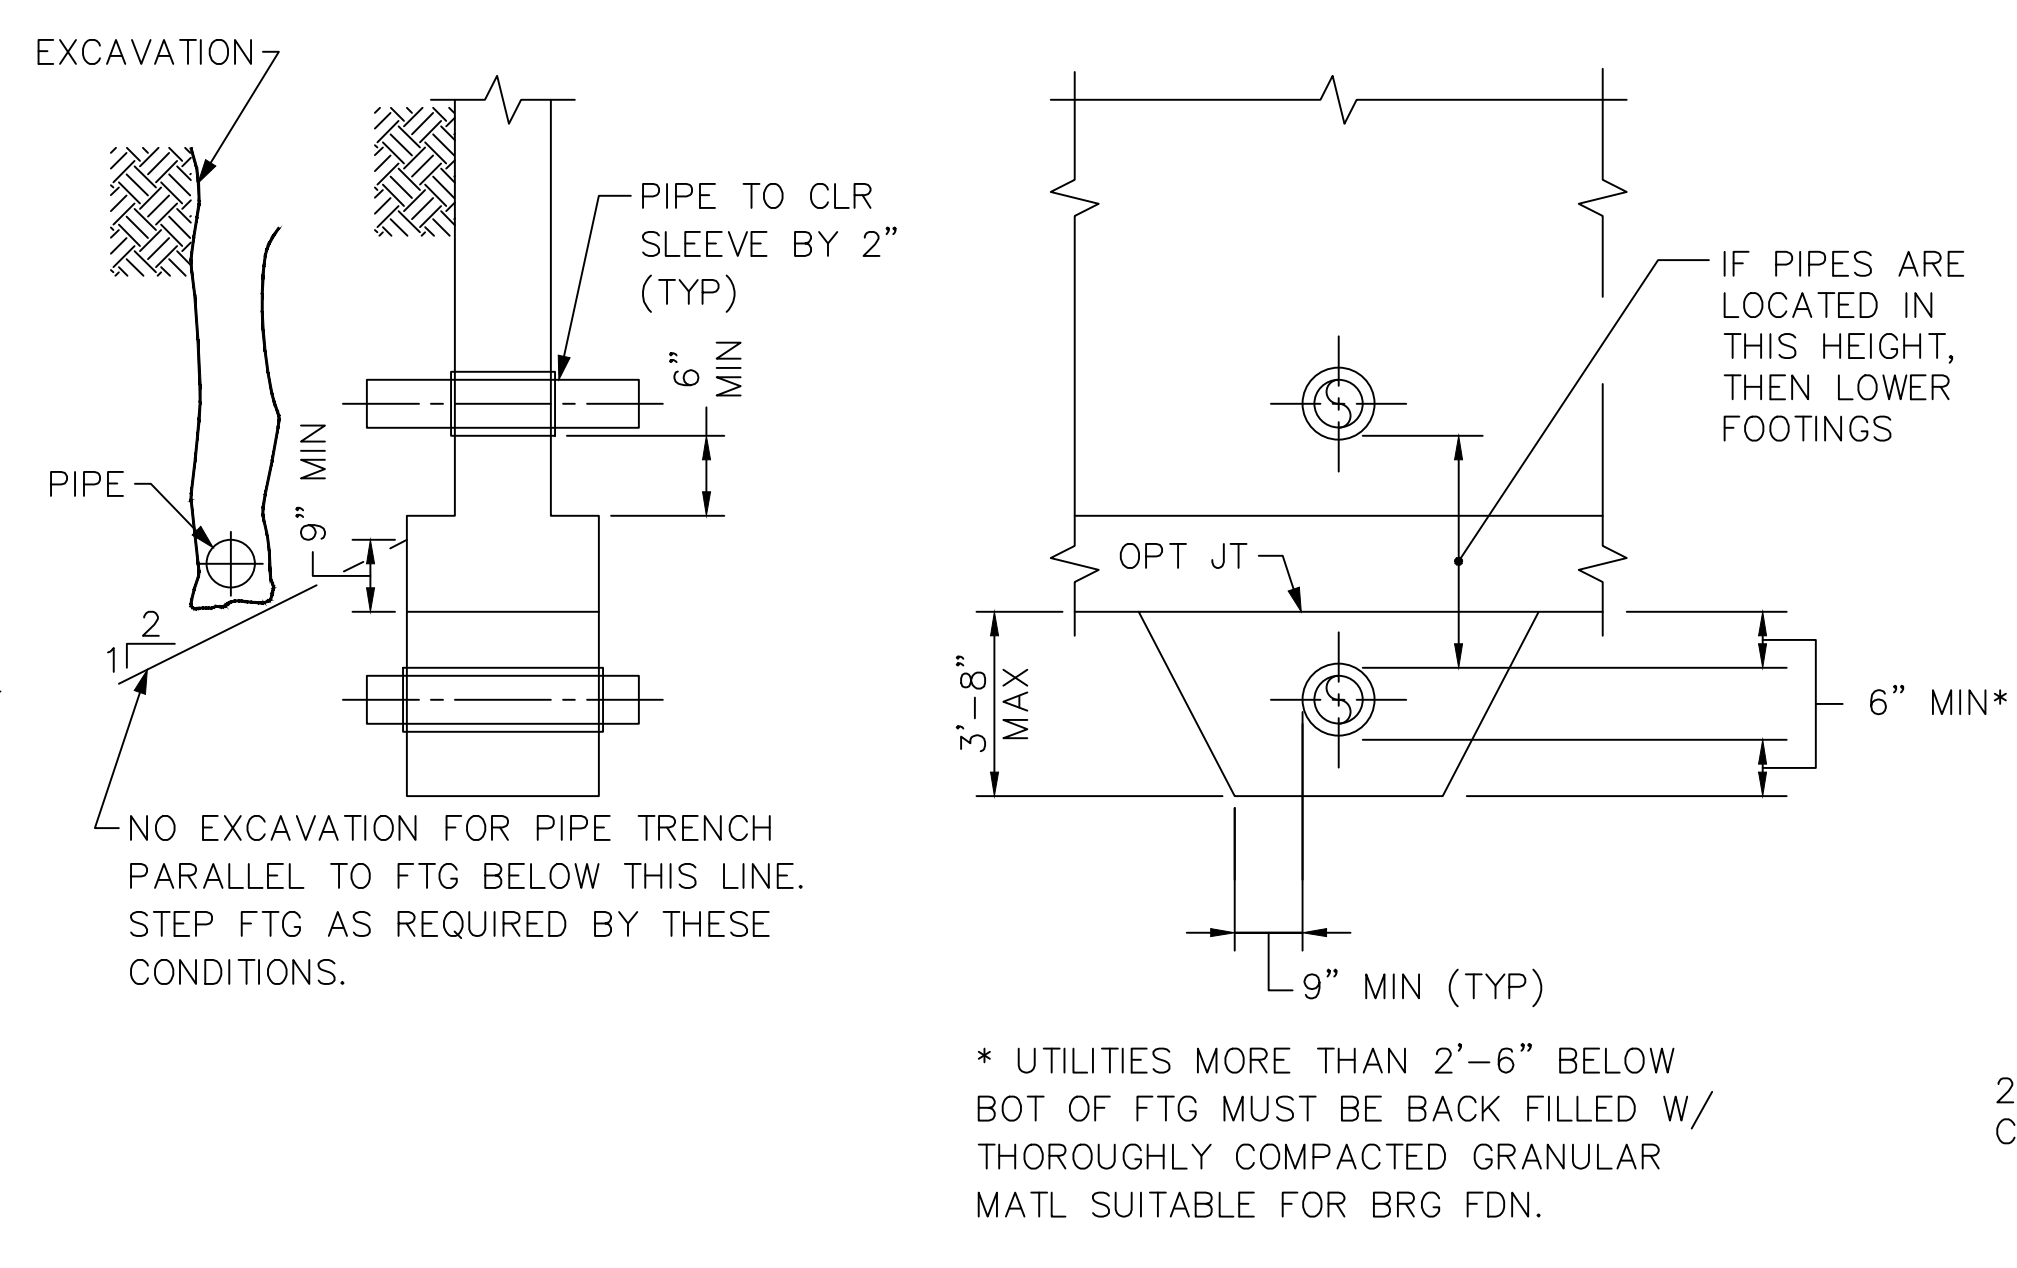

11 PIPE THROUGH CONCRETE
375-S401 SCALE: NTS

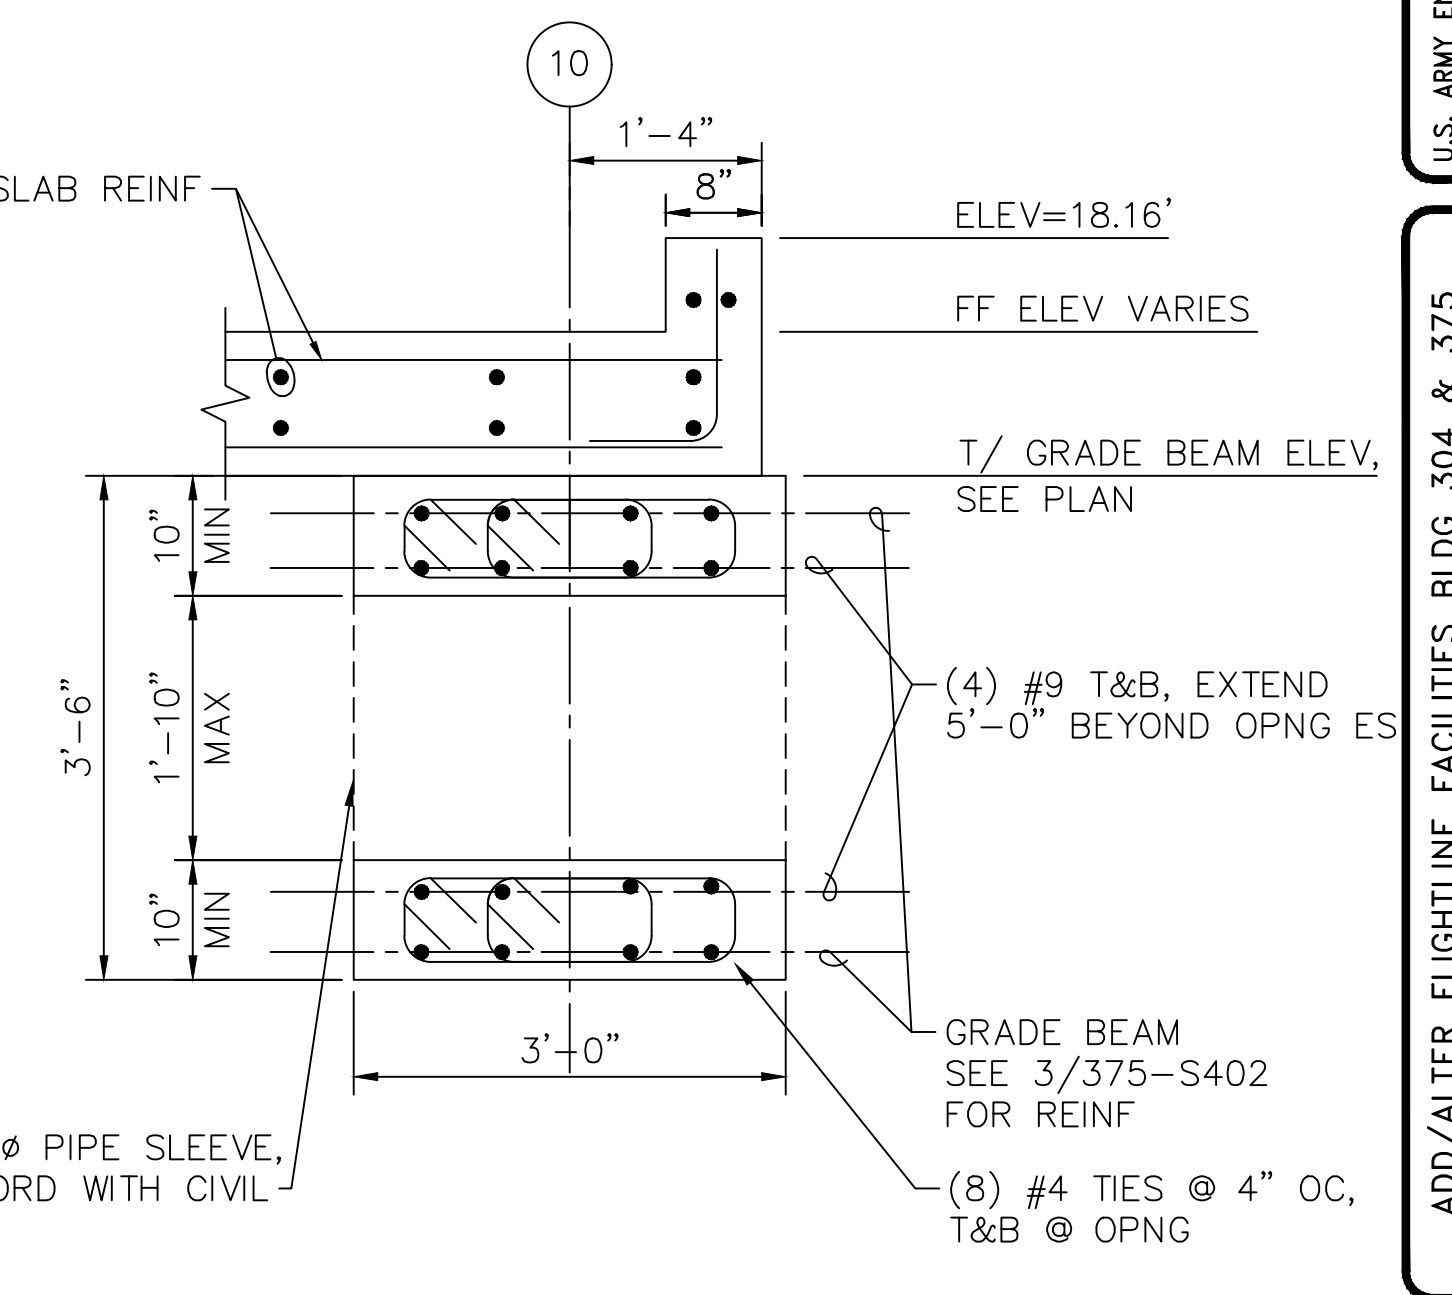

12 GRADE BEAM SECTION @ PIPE SLEEVE
375-S401 SCALE: 3/4" = 1'-0"


Date	Appr.	Symbol	Description

Date: 1/20/04	Design file no: 3122/211-10-02
Designed by: AEW	Drawn by: yip
Checked by: JUF	Submitted by: JUF
U.S. ARMY ENGINEER DISTRICT SEATTLE CORPS OF ENGINEERS	SEATTLE, WASHINGTON
Principal: BERGER/ABRAM ENGINEERS INC (206) 374-5998	Principal: (206) 374-5998


ADD/ALTER FLIGHTLINE FACILITIES BLDG 304 & 375
PORTLAND, OREGON
FY04 PN TONK 012259

FOUNDATION DETAILS

PLATE NUMBER:
375-S401

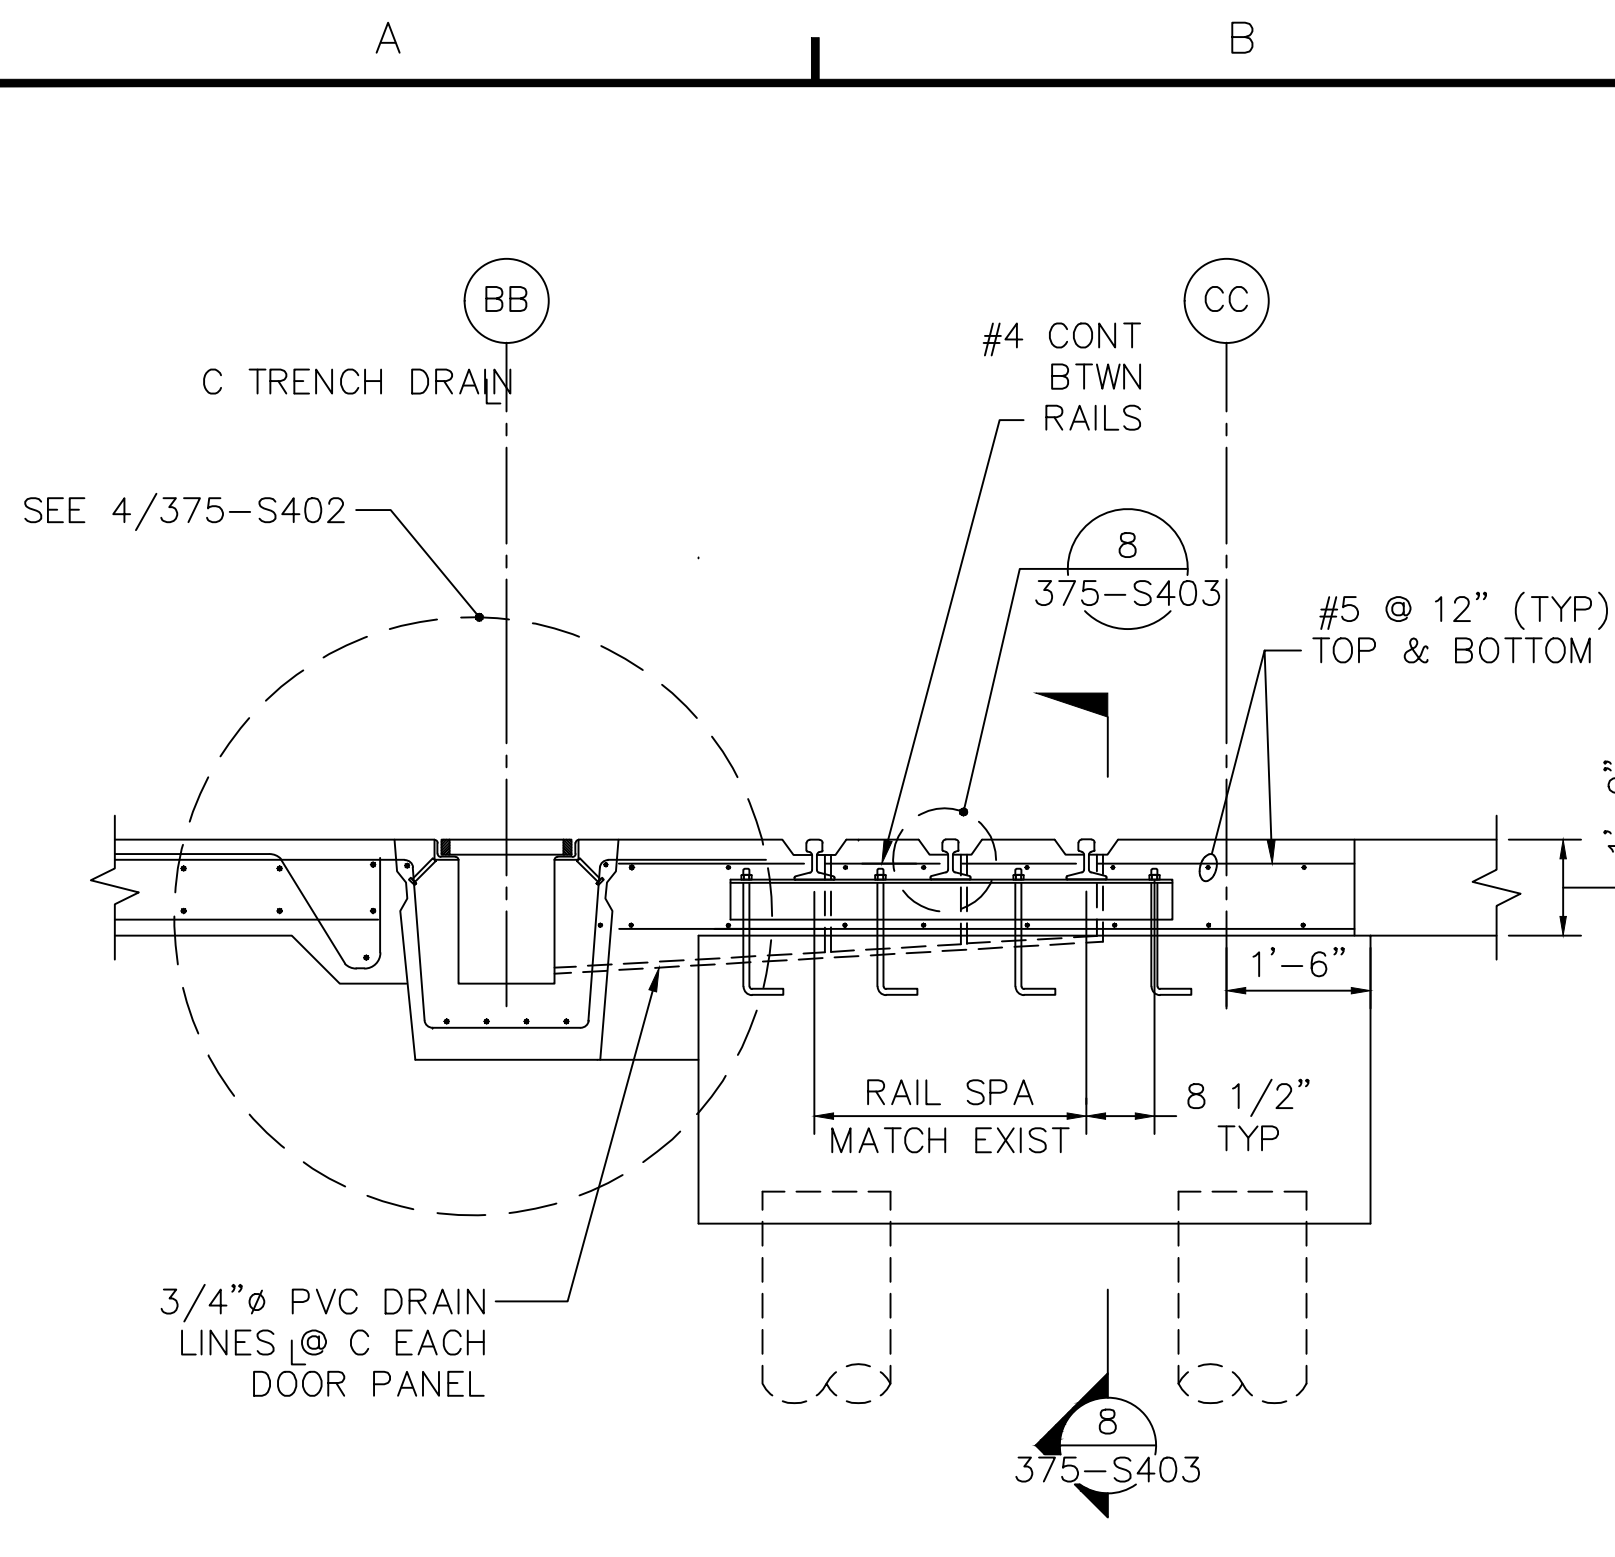


1 GRADE BEAM & TRENCH DRAIN @ GRID CC
375-S402 SCALE: 1/2"=1'-0"

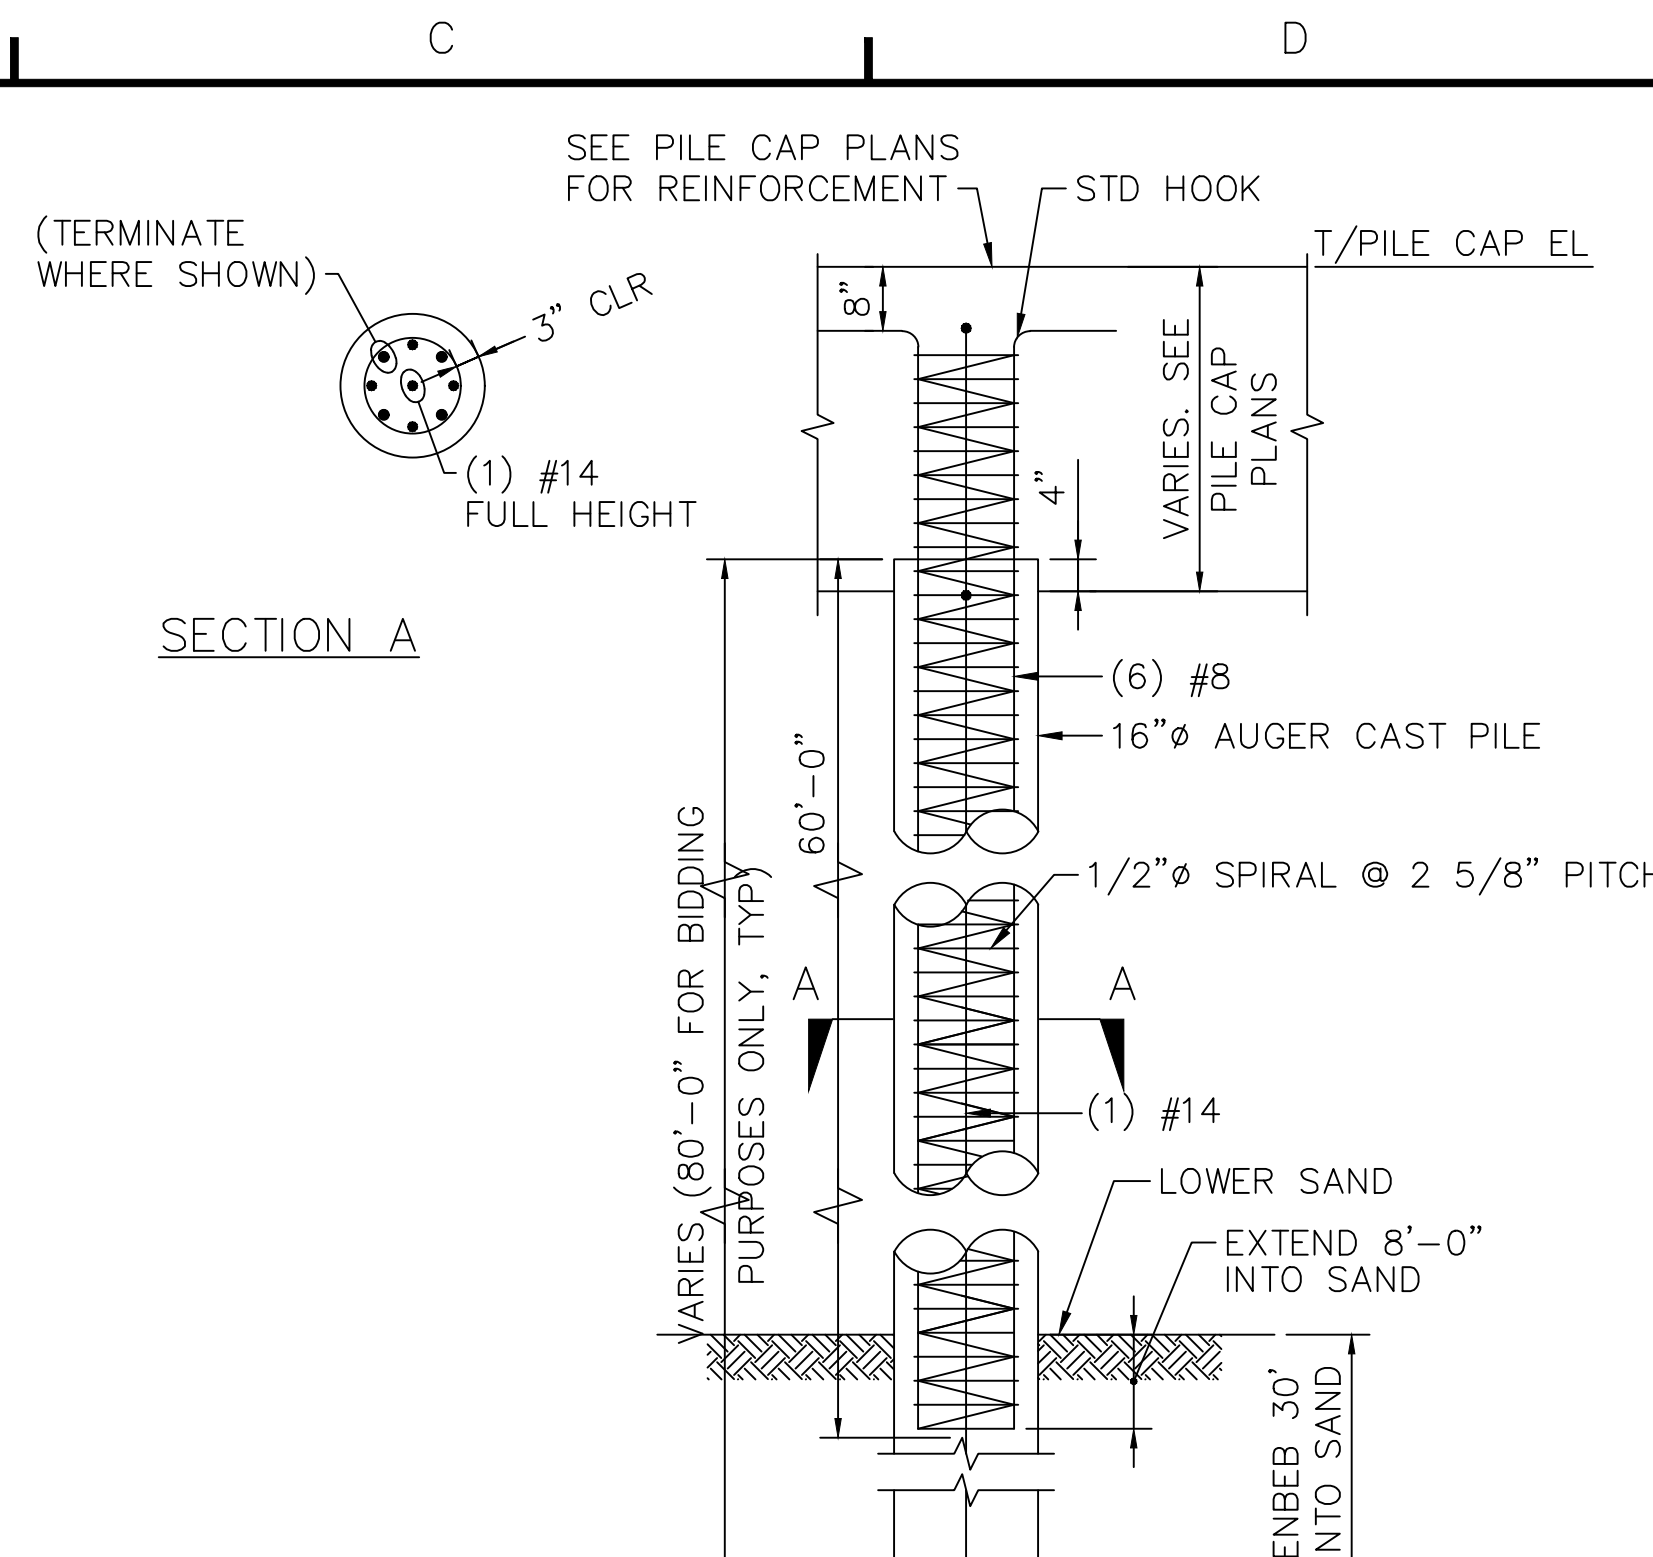


2 PILE ELEVATION (TYPICAL)
375-S402 SCALE: NONE

BEAM MARK	SIZE		REINFORCING				STIRRUPS			REMARKS	
	W	D	NO.	SIZE	LEFT SUPPORT	LOCATION	RIGHT SUPPORT	SIZE	TYPE		SPACING
GB1	7'-0"	36"	8	#10		T		#4		12" THROUGHOUT	EXTEND ALL LONG BARS TO GRID 2.
GB2	7'-0"	36"	8	#10		T		#4		12" THROUGHOUT	
GB3	7'-0"	36"	8	#10		T		#4		12" THROUGHOUT	
GB4	7'-0"	36"	-	-		T		#4		12" THROUGHOUT	
GB5	7'-0"	36"	8	#10		T		#4		12" THROUGHOUT	
GB6	7'-0"	36"	8	#10		T		#4		12" THROUGHOUT	EXTEND ALL LONG BARS TO GRID 11.
GB7	3'-0"	36"	4	#9		T		#4		6" THROUGHOUT	EXTEND ALL LONG BARS TO FAR SIDE OF PILE CAP 3.
GB8	3'-0"	36"	4	#9		T		#4		6" THROUGHOUT	EXTEND ALL LONG BARS TO FAR SIDE OF PILE CAP 1.
GB9	3'-0"	42"	4	#9		T		#4		6" THROUGHOUT, EXCEPT AT PIPE SLEEVE	EXTEND ALL LONG BARS TO FAR SIDE OF PILE CAP 1. SEE 12/S401 FOR SECTION AT PIPE SLEEVE


3 GRADE BEAM SCHEDULE
375-S402 SCALE: NONE

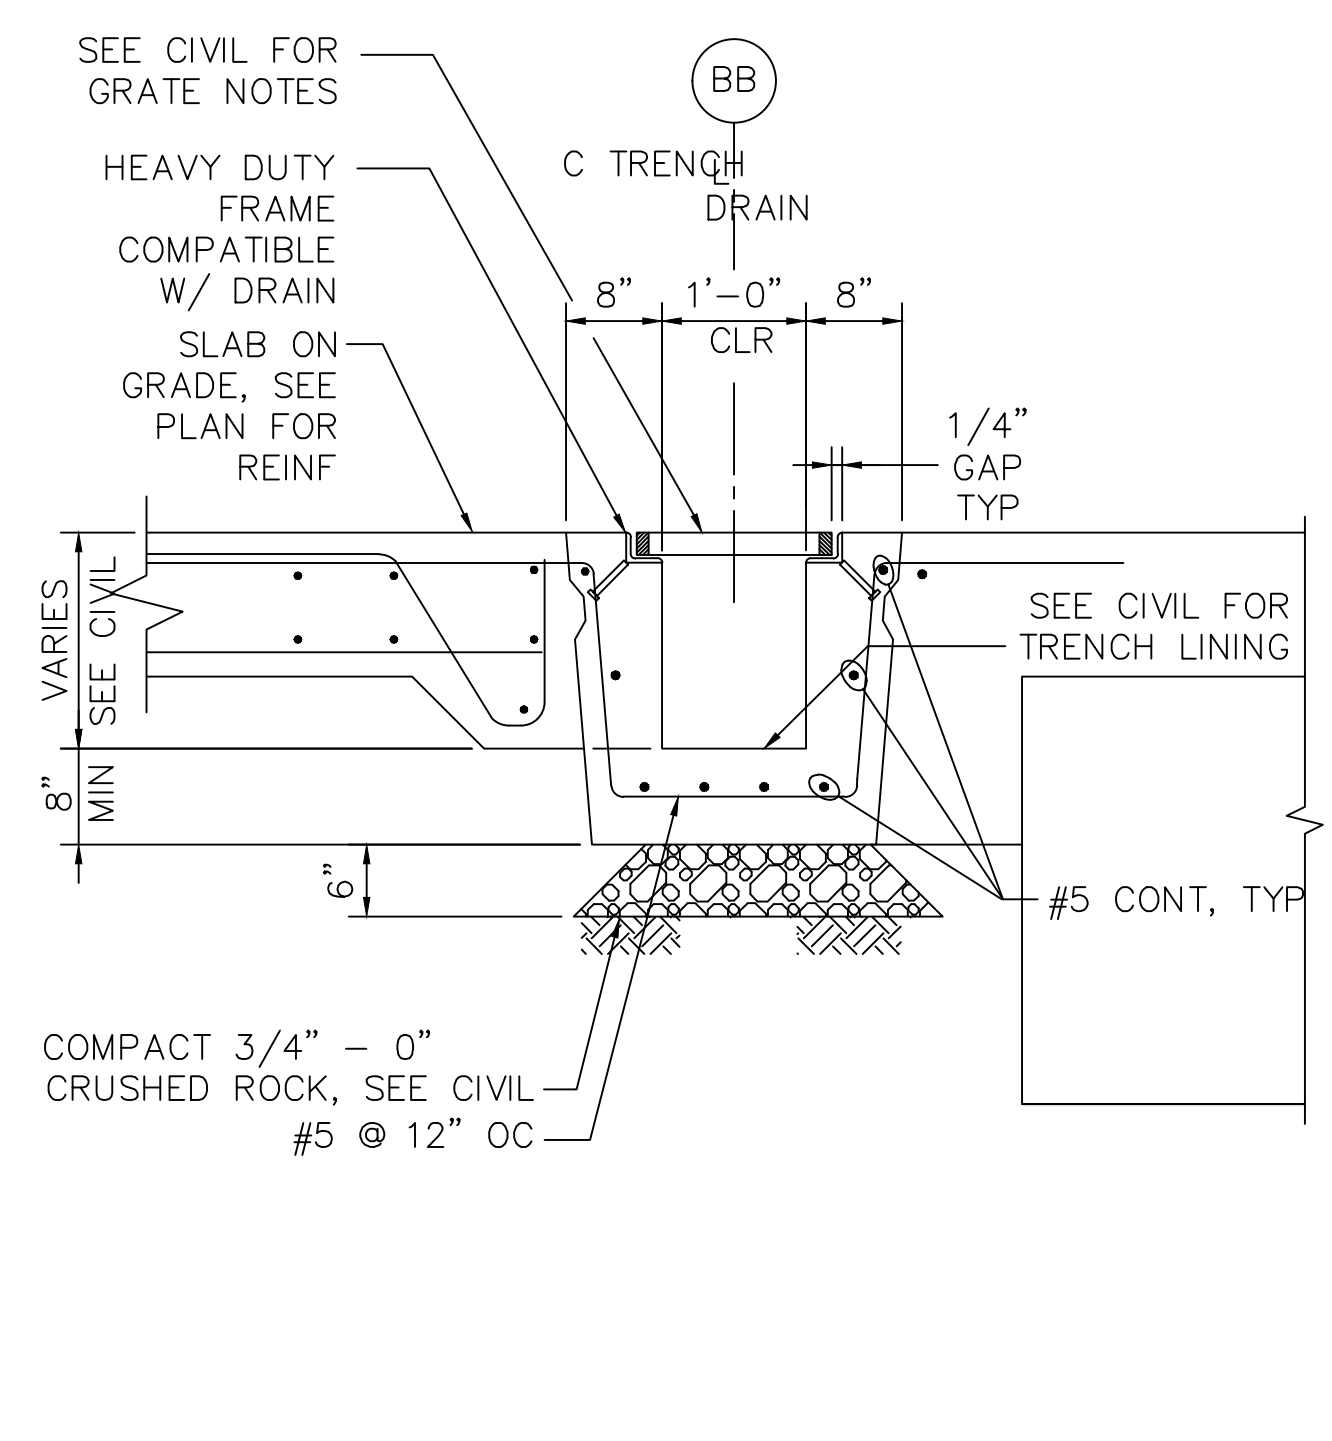


4 TRENCH DRAIN DETAIL
375-S402 SCALE: 3/4"=1'-0"

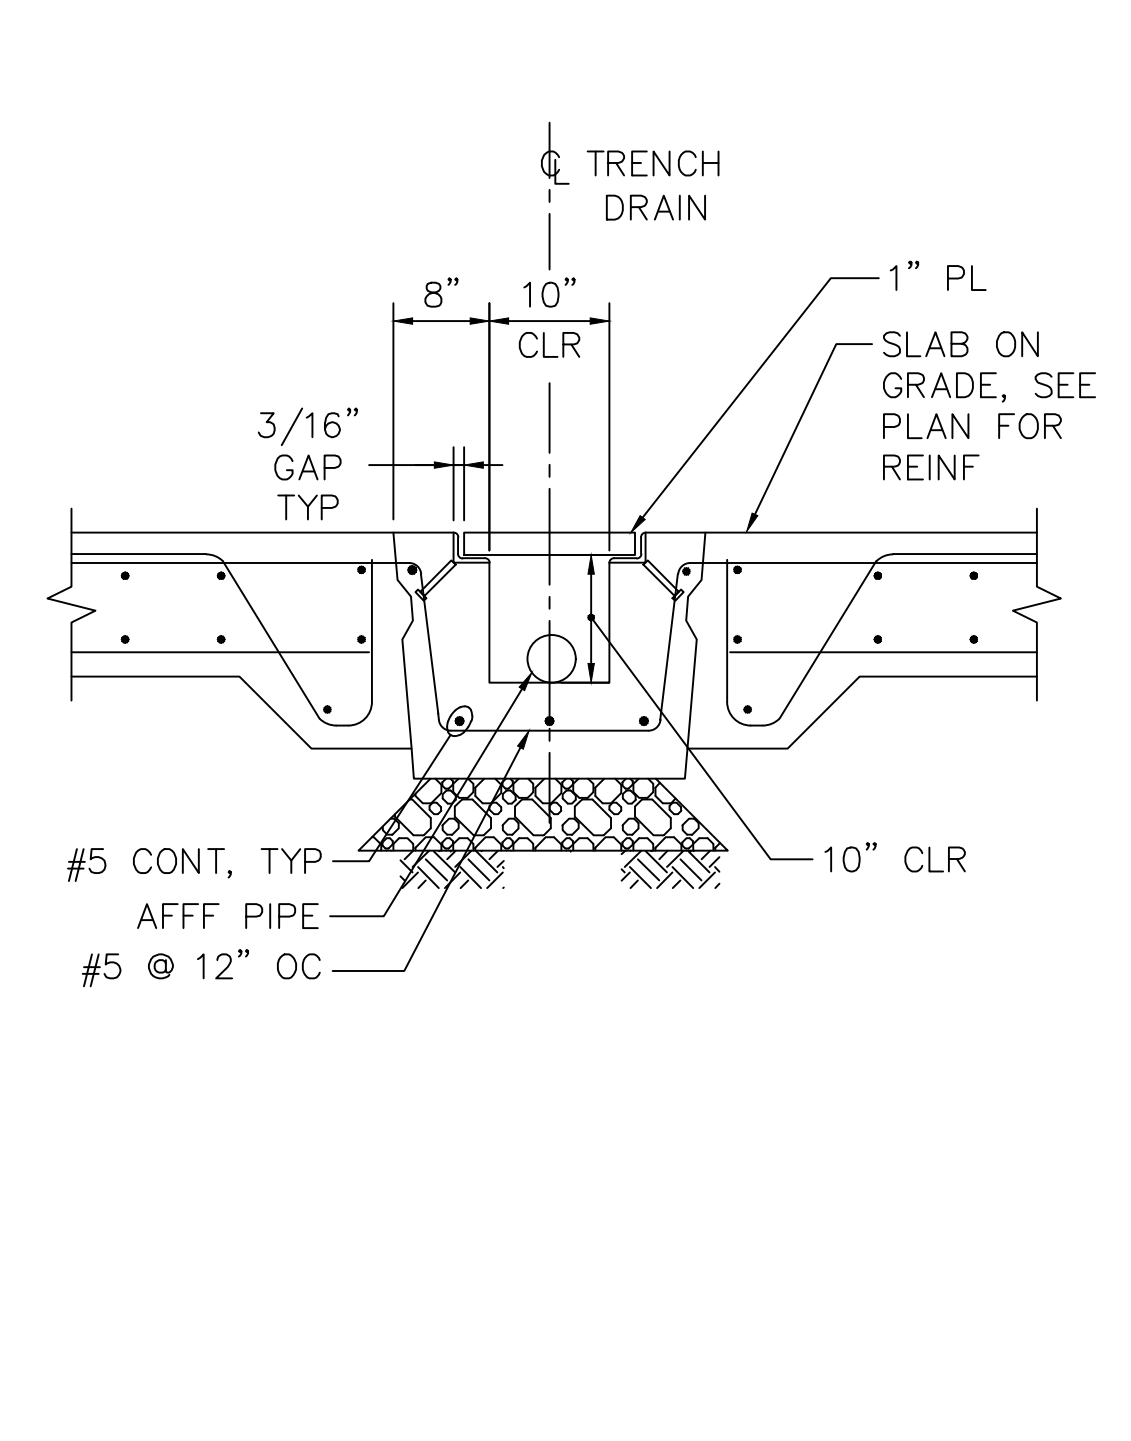


5 AFF TRENCH DETAIL
375-S402 SCALE: 3/4"=1'-0"

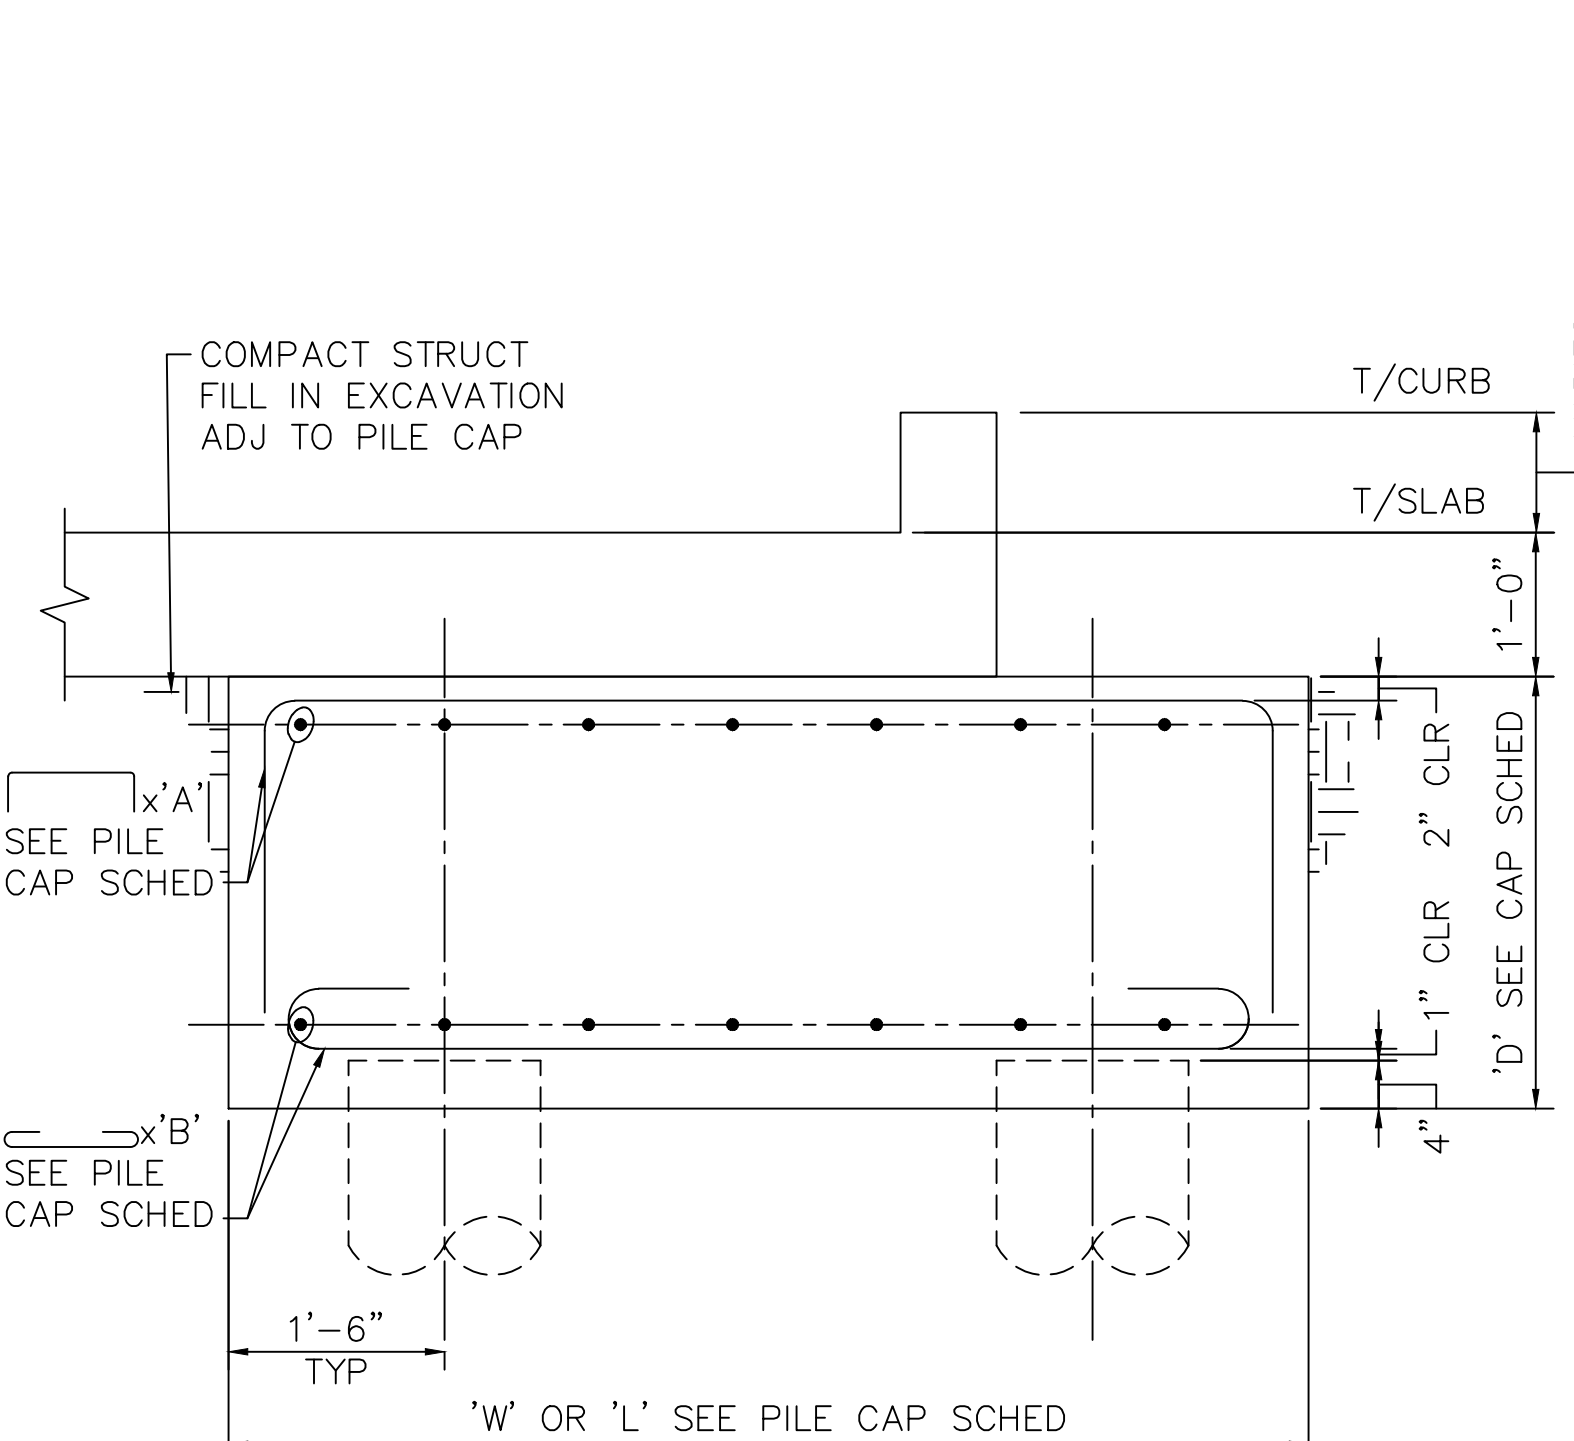

6 PILE CAP DETAIL
375-S402 SCALE: 3/4"=1'-0"

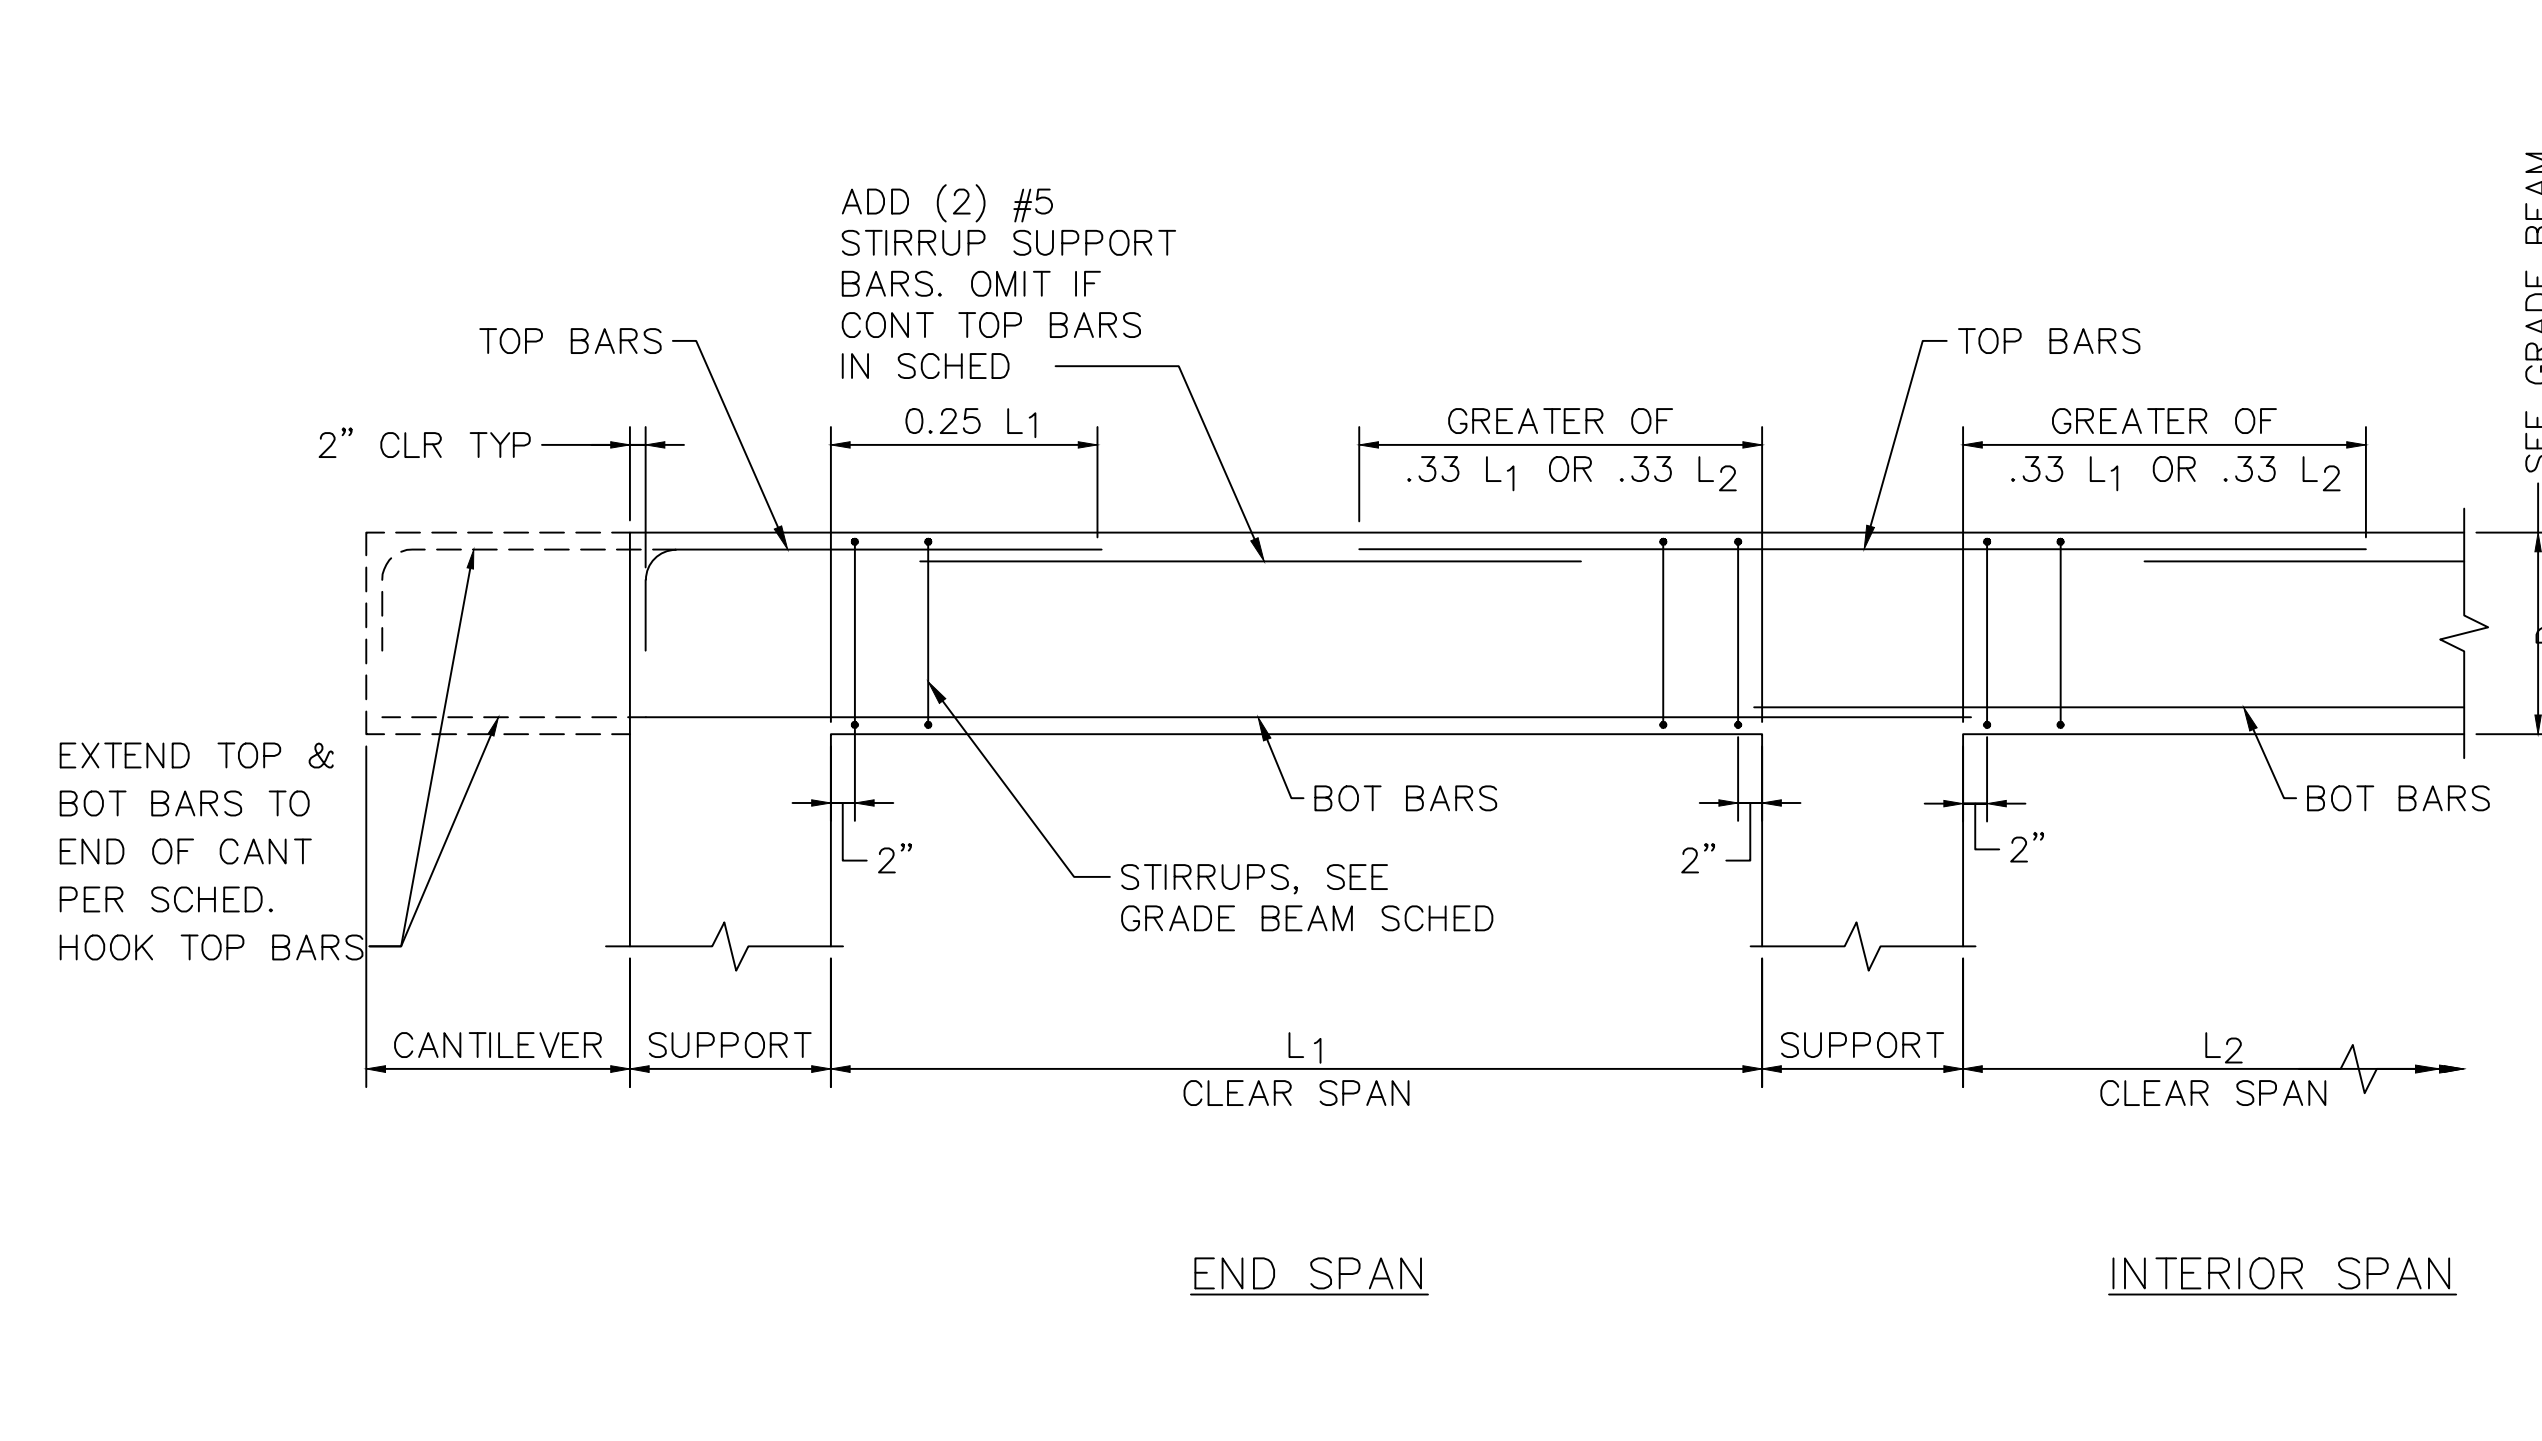


7 GRADE BEAM REINFORCING DIAGRAM
375-S402 SCALE: NONE

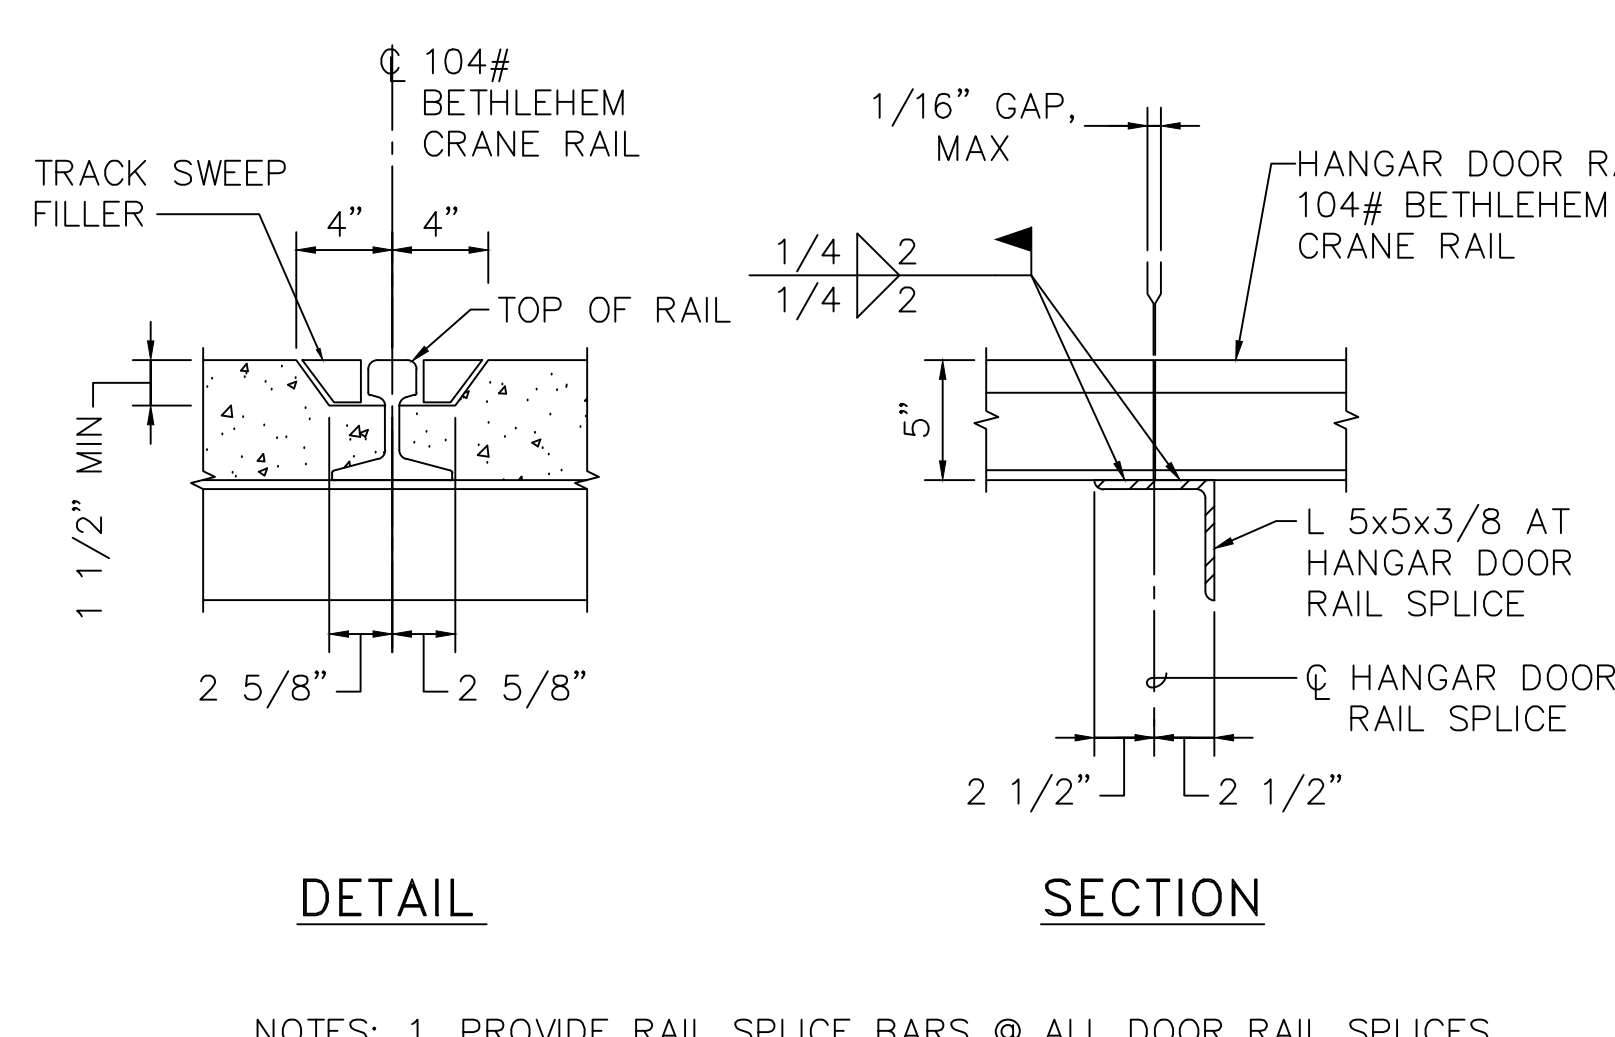


8 DOOR TRACK DETAILS
375-S402 SCALE: 1 1/2"=1'-0"

MARK	WxL	D	'A' TOP BARS	'B' BOTTOM BARS	REMARKS
1	14'-4"x33'-5"	3'-0"	(15) #9 LONG (34) #9 TRANS	(15) #9 LONG (34) #9 TRANS	FULL HEIGHT HOOK TOP 180° HOOK BOT
2	7'-0"x10'-0"	3'-0"	(8) #9 LONG (11) #6 TRANS	(8) #9 LONG (11) #6 TRANS	FULL HEIGHT HOOK TOP 180° HOOK BOT SEE NOTE 2
3	7'-0"x26'-5"	3'-0"	(8) #9 LONG (27) #6 TRANS	(8) #9 LONG (27) #6 TRANS	FULL HEIGHT HOOK TOP 180° HOOK BOT SEE NOTE 1, 2
4	3'-6"x7'-0"	3'-0"	(4) #9 LONG (8) #5 TRANS	(4) #9 LONG (8) #5 TRANS	FULL HEIGHT HOOK TOP 180° HOOK BOT
5	3'-6"x7'-0"	3'-0"	(4) #9 LONG (8) #5 TRANS	(4) #9 LONG (8) #5 TRANS	FULL HEIGHT HOOK TOP 180° HOOK BOT


9 PILE CAP SCHEDULE
375-S402 SCALE: 3/4"=1'-0"

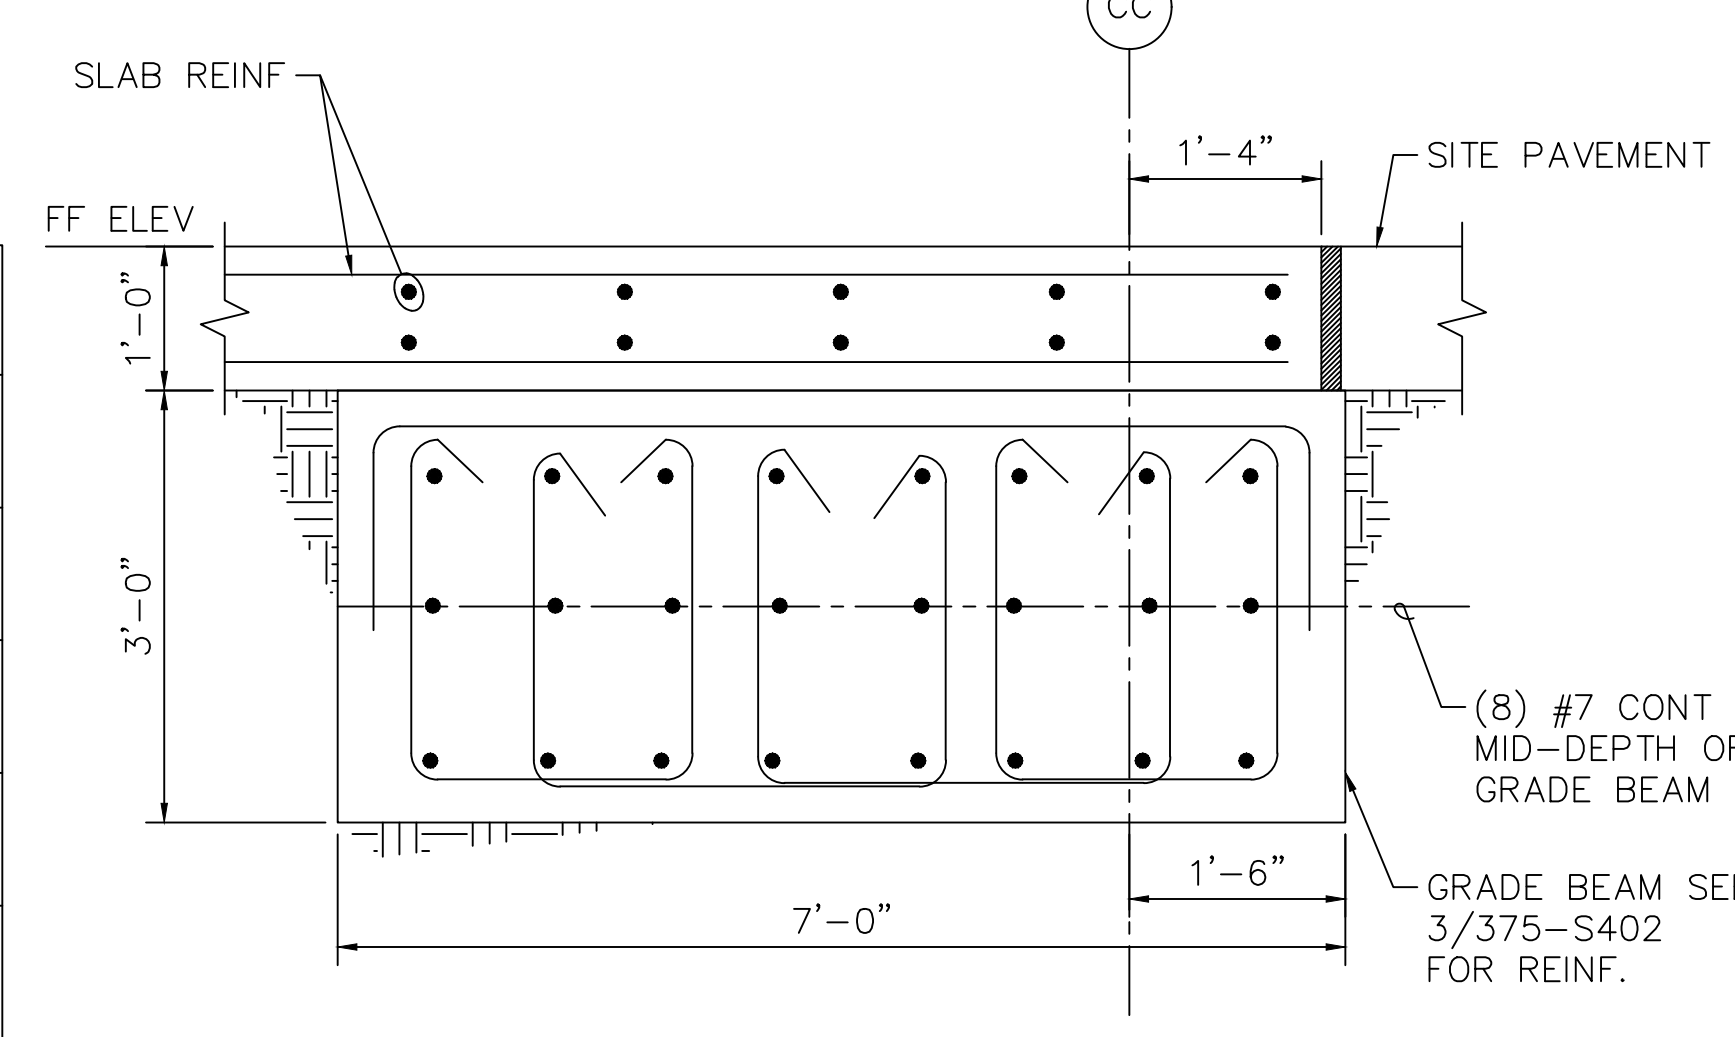

10 GRADE BEAM SECTION
375-S402 SCALE: 3/4"=1'-0"

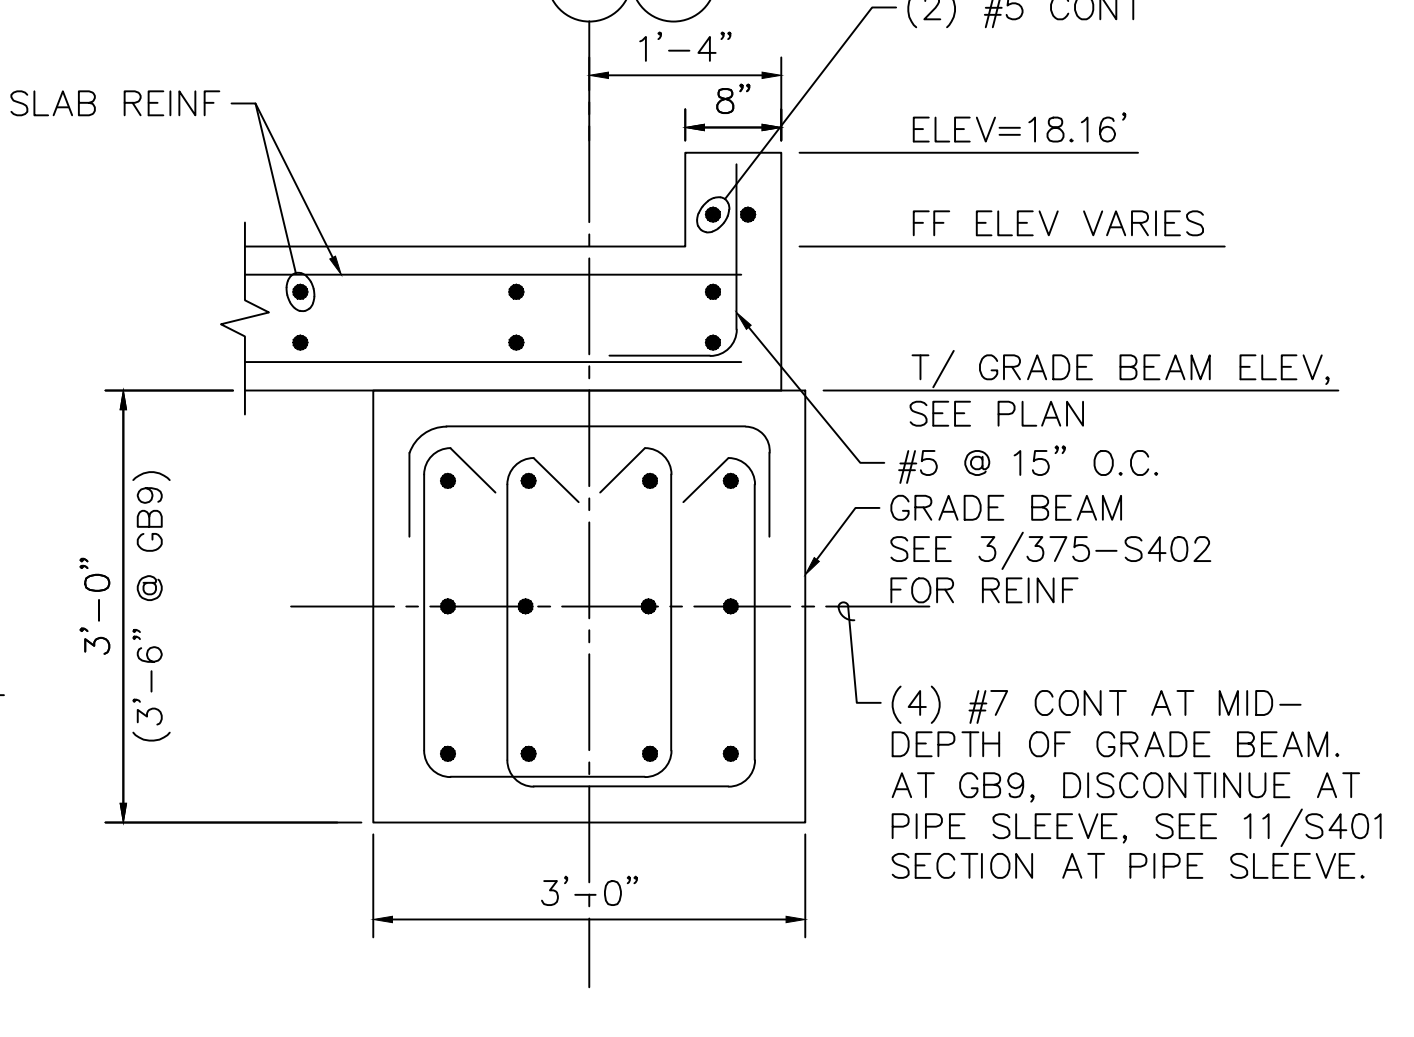

11 GRADE BEAM SECTION
375-S402 SCALE: 3/4"=1'-0"

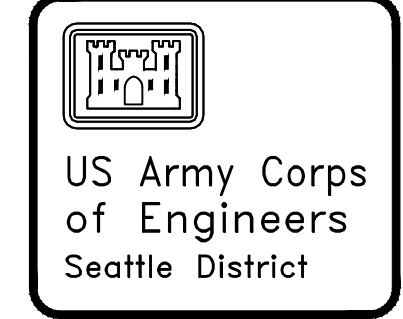

Date	Appr.	Symbol	Description

Designed by: AEW	Checked by: JUF
Drawn by: YIP	Submitted by: (206) 374-9999
Date: 1/20/04	Section: FOUNDATION DETAILS
Design file no: 3125/211-0-02	

ADD/ALTER FLIGHTLINE FACILITIES BLDG 304 & 375
PORTLAND, OREGON
FY04 PN TOKO 012259

PLATE NUMBER:
375-S402

Date	Appr.	Symbol	Description


Designed by: AEW	Checked by: JUF	Submitted by: JUF	Section
Drawn by: yp			
Date: 1/29/04	Design file no. 3125/211-0-02		

U.S. ARMY ENGINEER DISTRICT SEATTLE
CORPS OF ENGINEERS
SEATTLE, WASHINGTON

Submitted by:
BERGER/ABRAM
ENGINEERS, INC
(206) 374-5900 Fax: (206) 374-9795
Principal


ADD/ALTER FLIGHTLINE FACILITIES BLDG 304 & 375
PORTLAND, OREGON
FY04 PN TOKD 012259

PLATE NUMBER:
375-S501

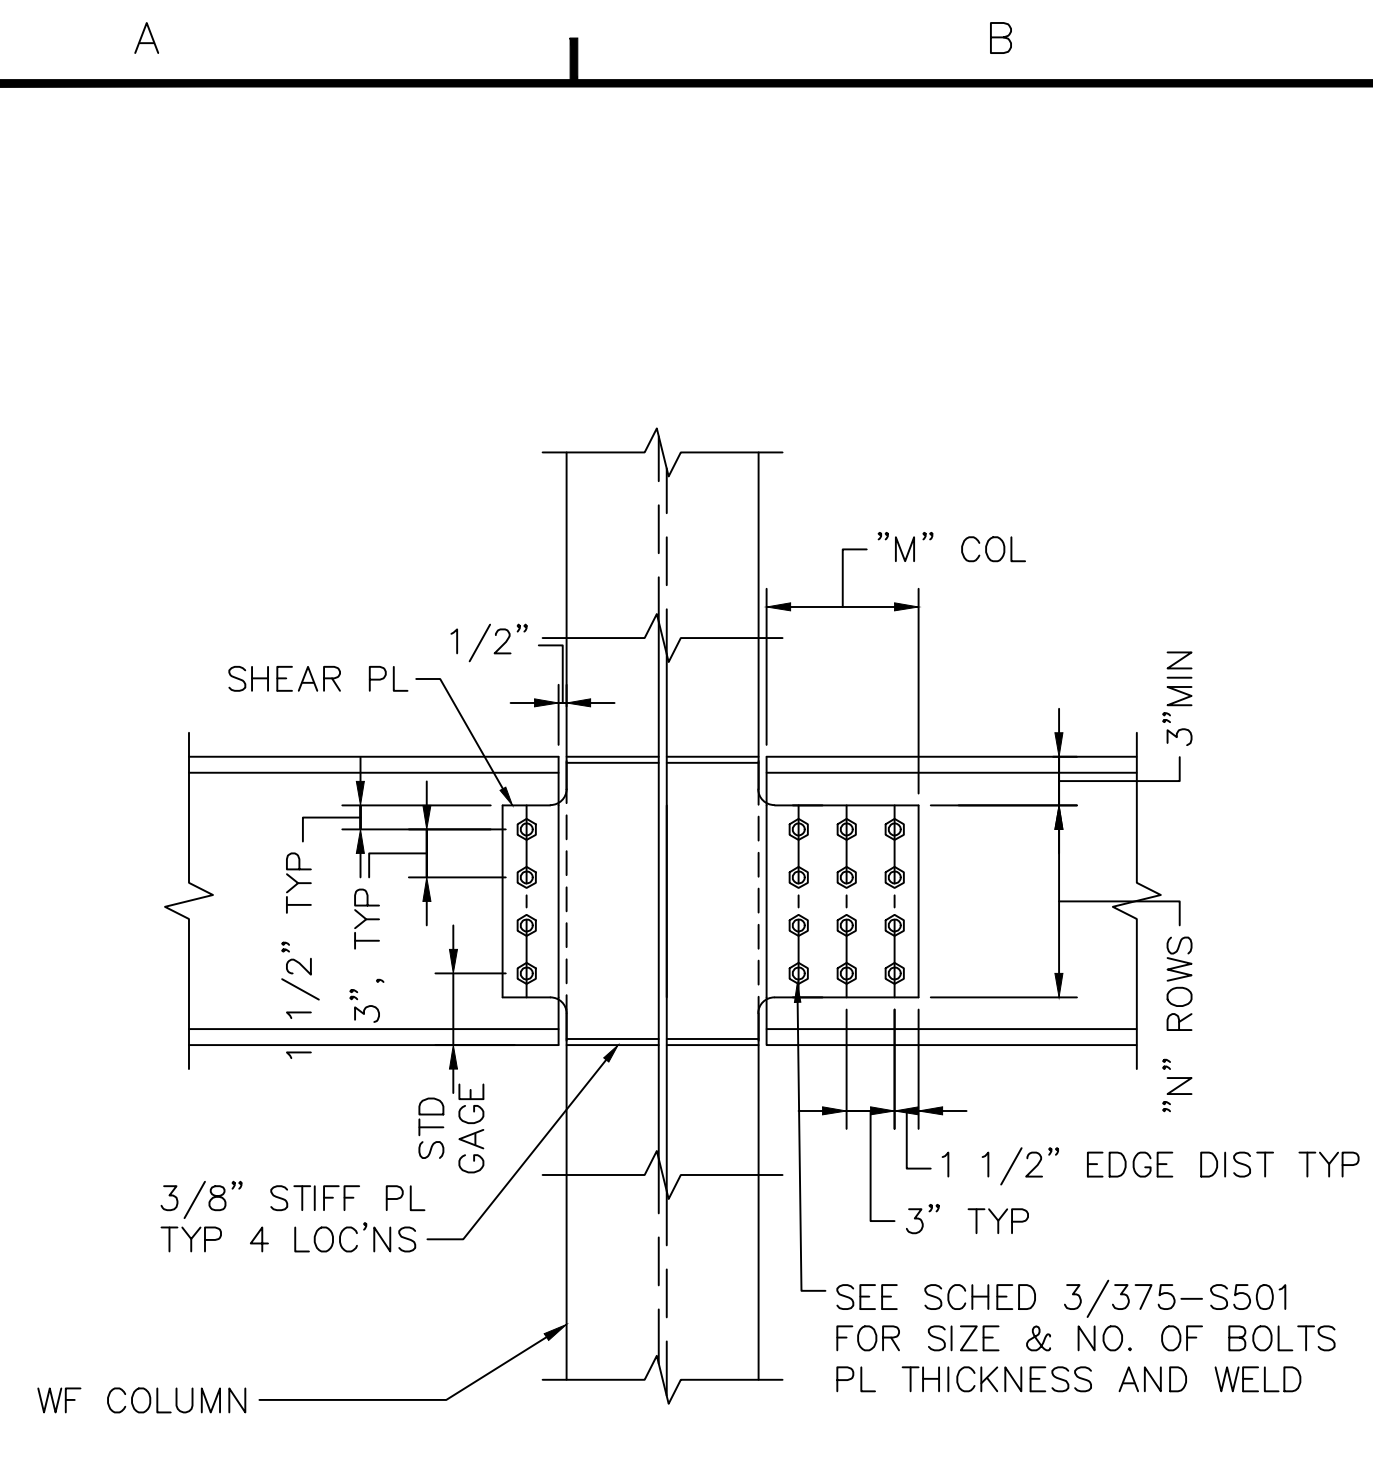

NOTE:
1. DIAGONAL BRACES NOT SHOWN FOR CLARITY.

1 TYP BEAM COL WEB CONN
375-S501 SCALE: 1" = 1'-0"

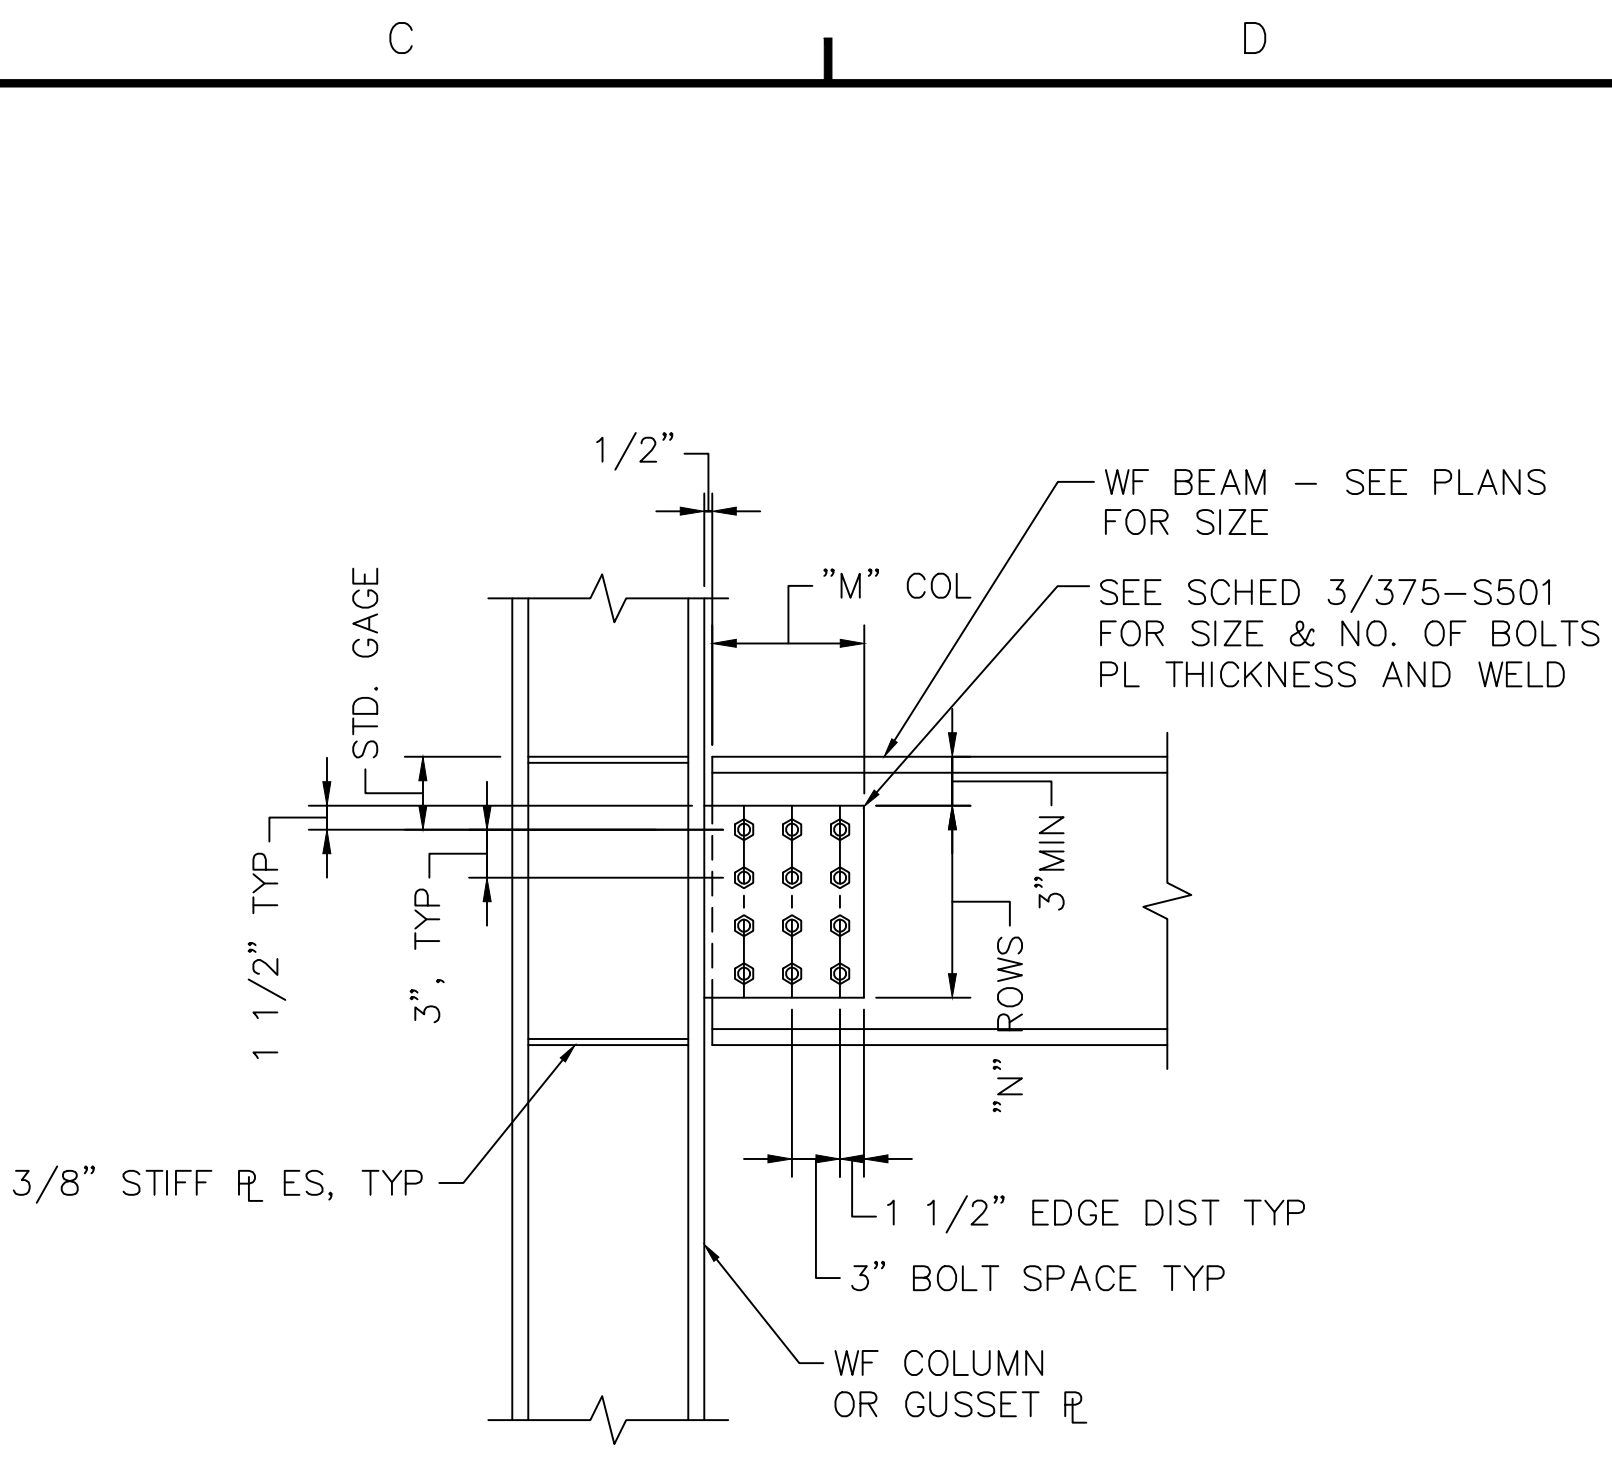


NOTE:
1. DIAGONAL BRACES NOT SHOWN FOR CLARITY.

2 TYP BEAM COL FLANGE CONN
375-S501 SCALE: 1" = 1'-0"


BOLTED CONNECTION SCHEDULE			
BEAM SIZE	BOLTS MxN	SHEAR PL THICK.	WELD SIZE (A)
W10x22	1x3	3/8	5/16
W12x14	1x2	3/8	5/16
W12x22	1x3	3/8	5/16
W12x26	1x3	3/8	5/16
W12x40 & LARGER	3x3	3/8	5/16
W18x40	1x4	3/8	5/16

NOTES:
1. ALL BOLTS TO BE FULLY TIGHTENED 3/4" A325 TYPE X BEARING TYP.
2. N INDICATED NUMBER OF BOLTS IN A ROW AND M INDICATES THE NUMBER OF ROWS OF BOLTS.
3. VERT OR HORIZ HOLE SPACING 3" MIN. EDGE DIST 1 1/2" MIN.


3 BEAM CONNECTION
375-S501 SCALE: 1" = 1'-0"

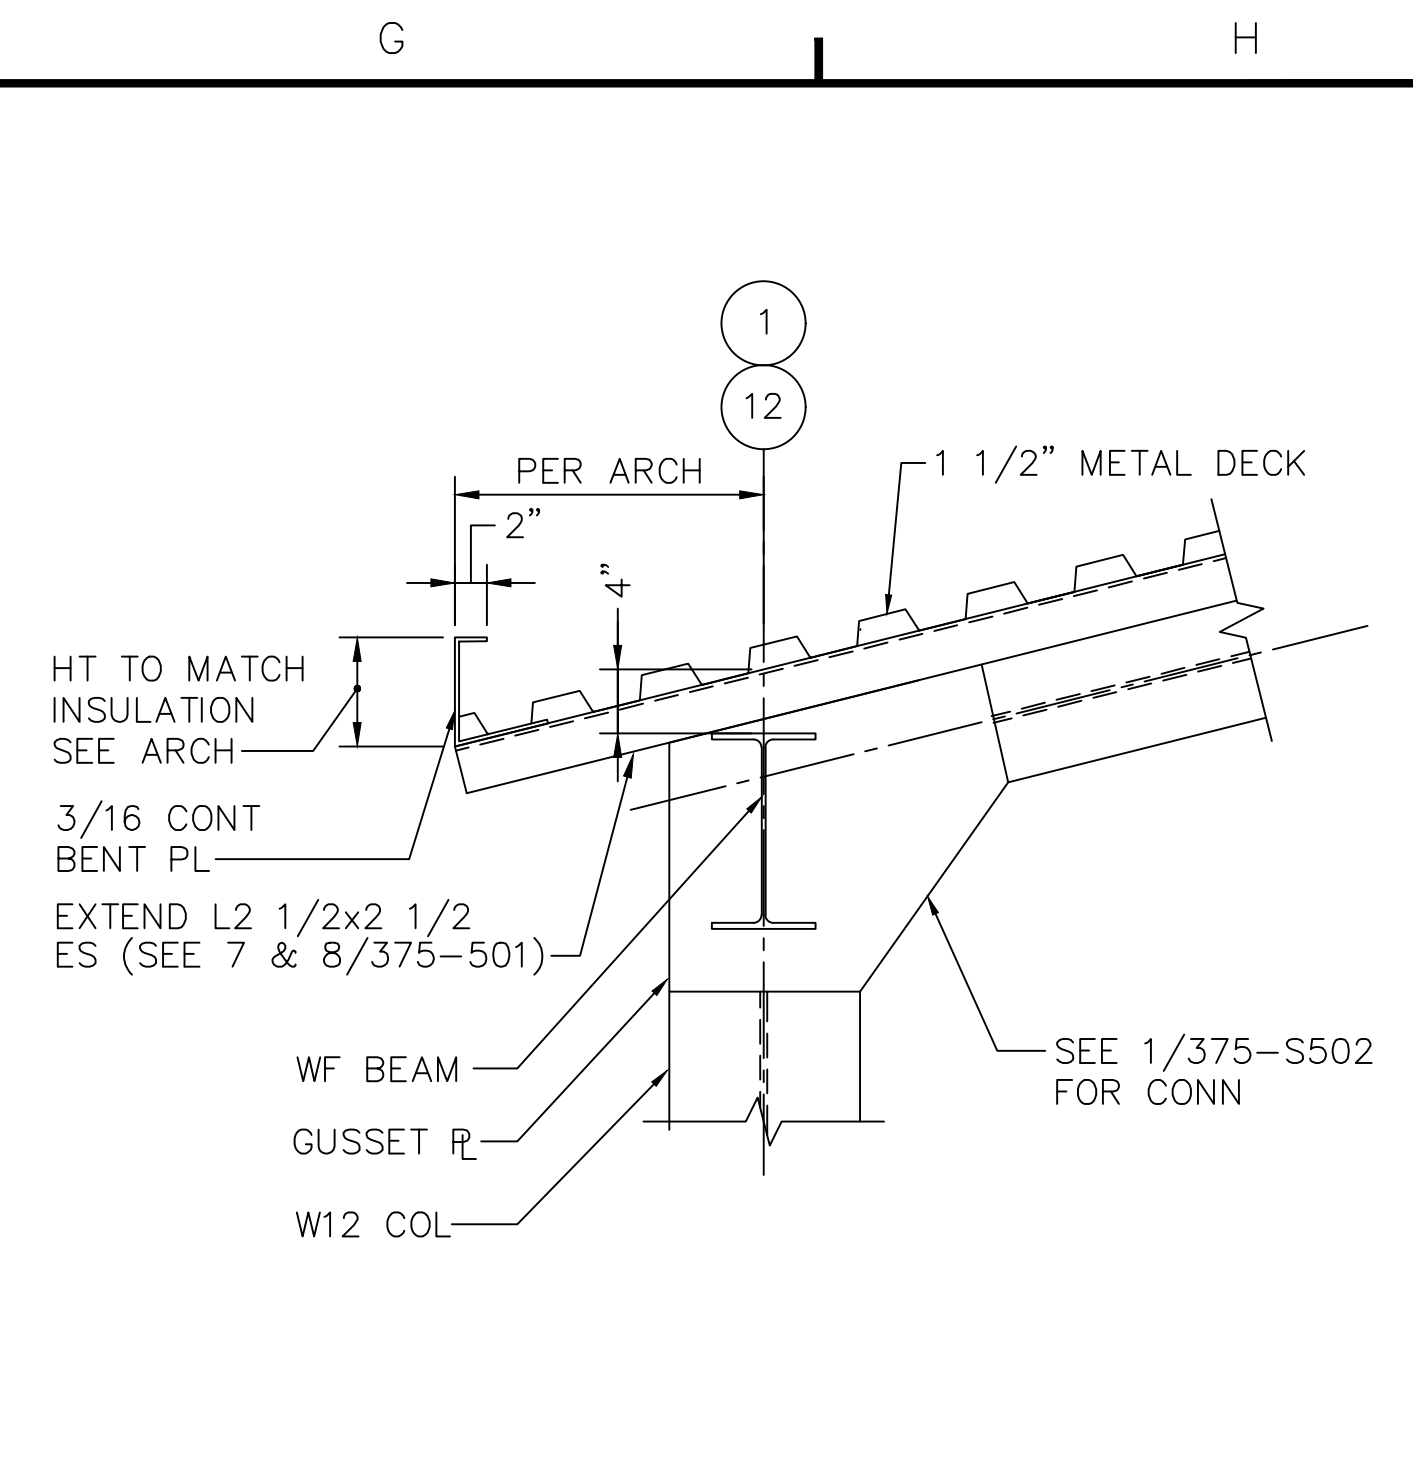


4 ROOF FRAMING DETAIL
375-S501 SCALE: 1" = 1'-0"

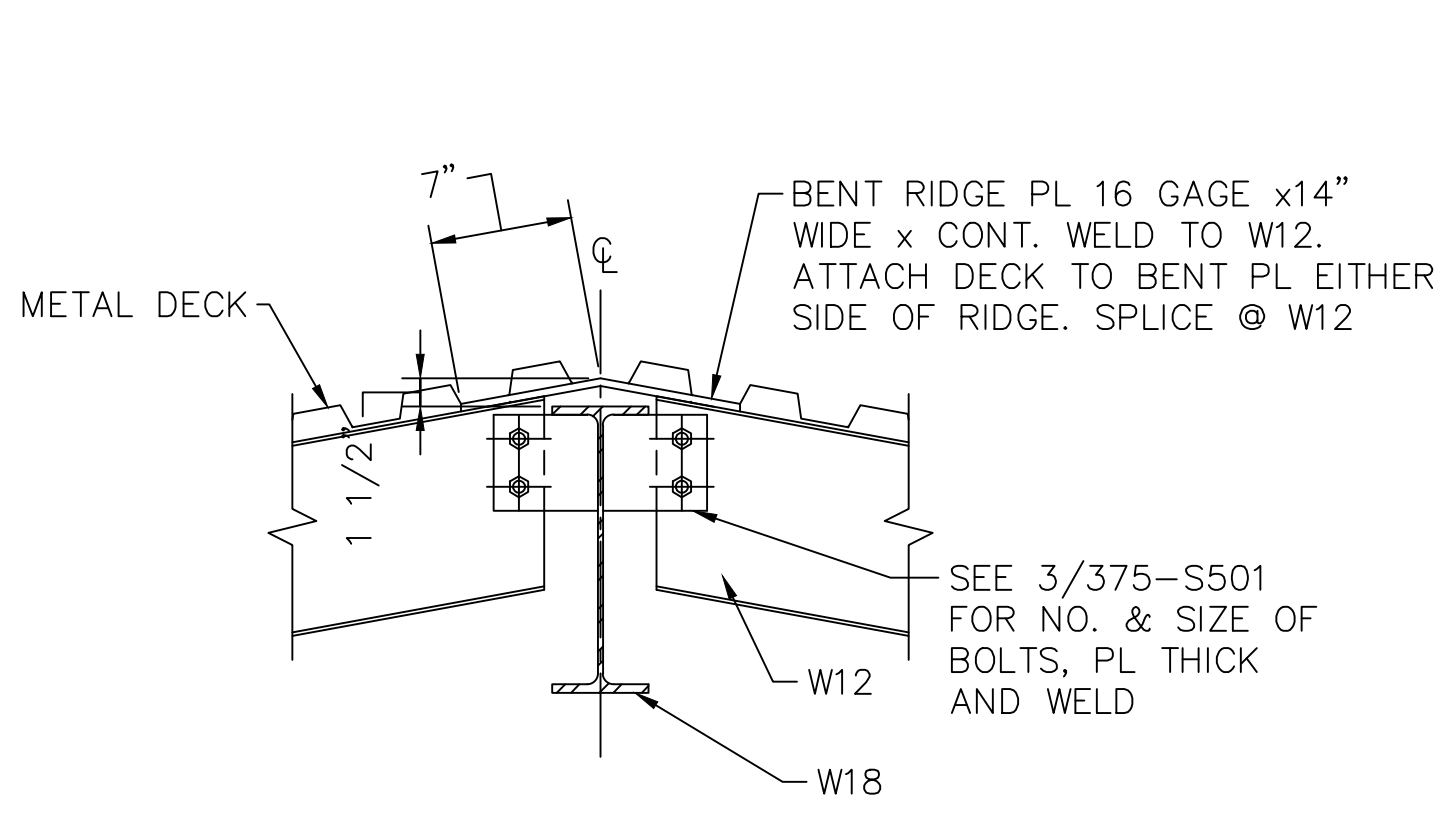

5 RIDGE DETAIL
375-S501 SCALE: 1" = 1'-0"

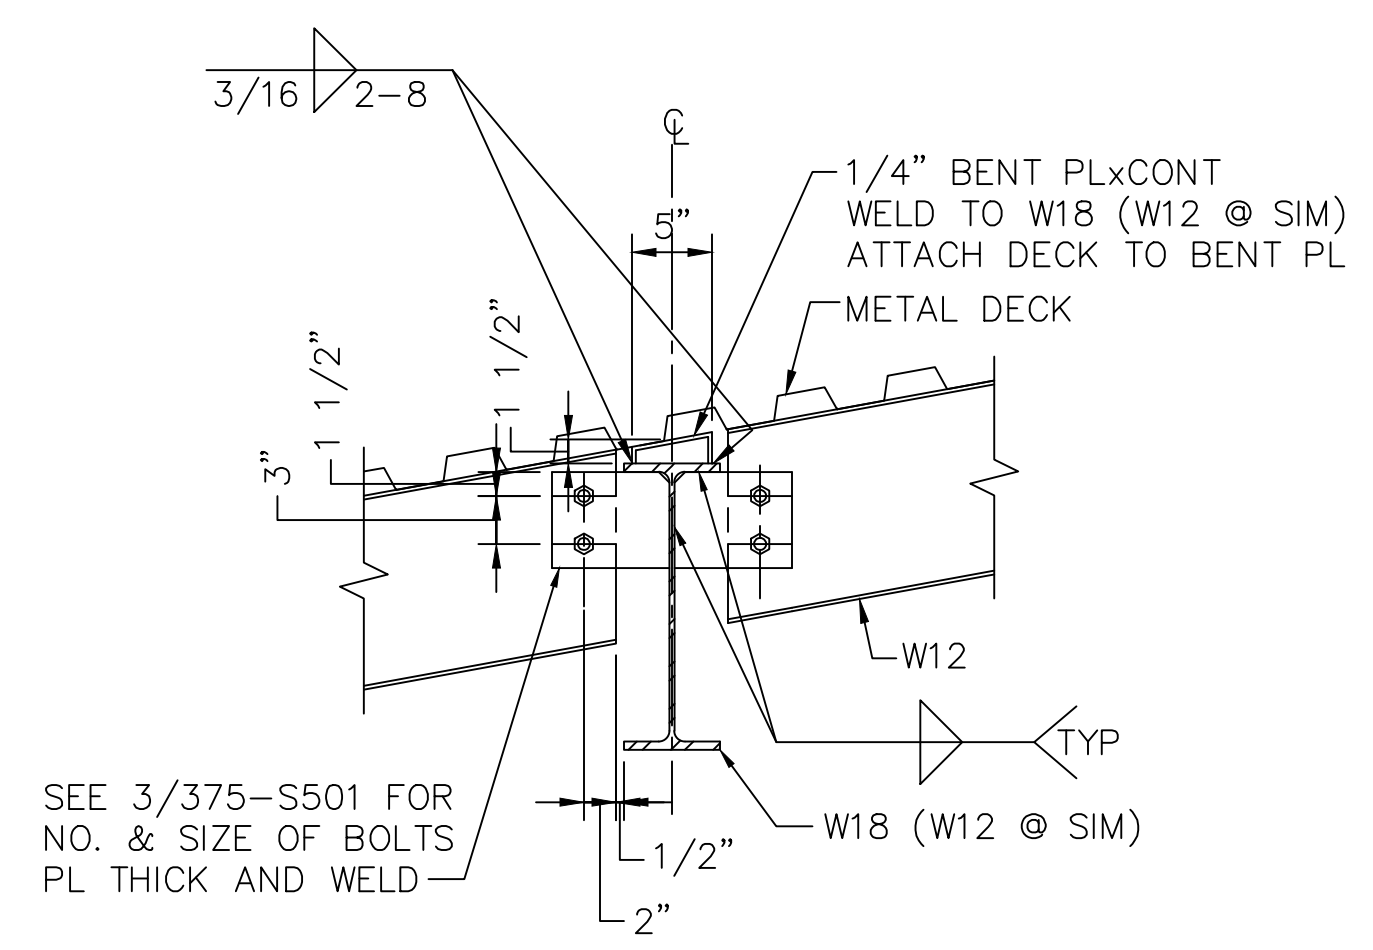


6 ROOF FRAMING DETAIL
375-S501 SCALE: 1" = 1'-0"

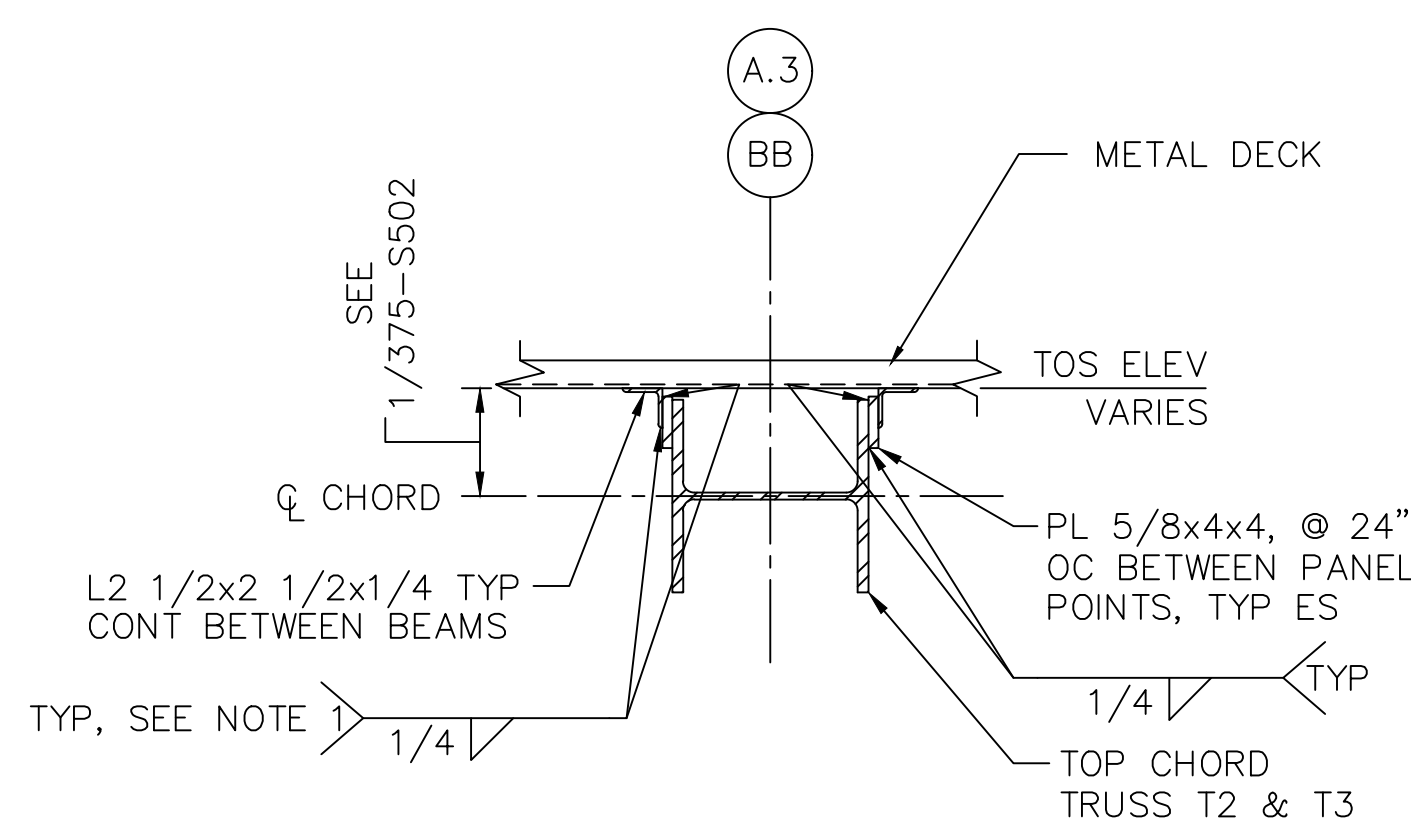


NOTES:
1. AT PANEL POINTS, WELD TO FACE OF GUSSET PL, 1/4 FILLET WELD 2" LONG @ 8" OC.

7 DECK SUPPORT AT TRUSS T2 & T3 TOP CHORD
375-S501 SCALE: 1" = 1'-0"

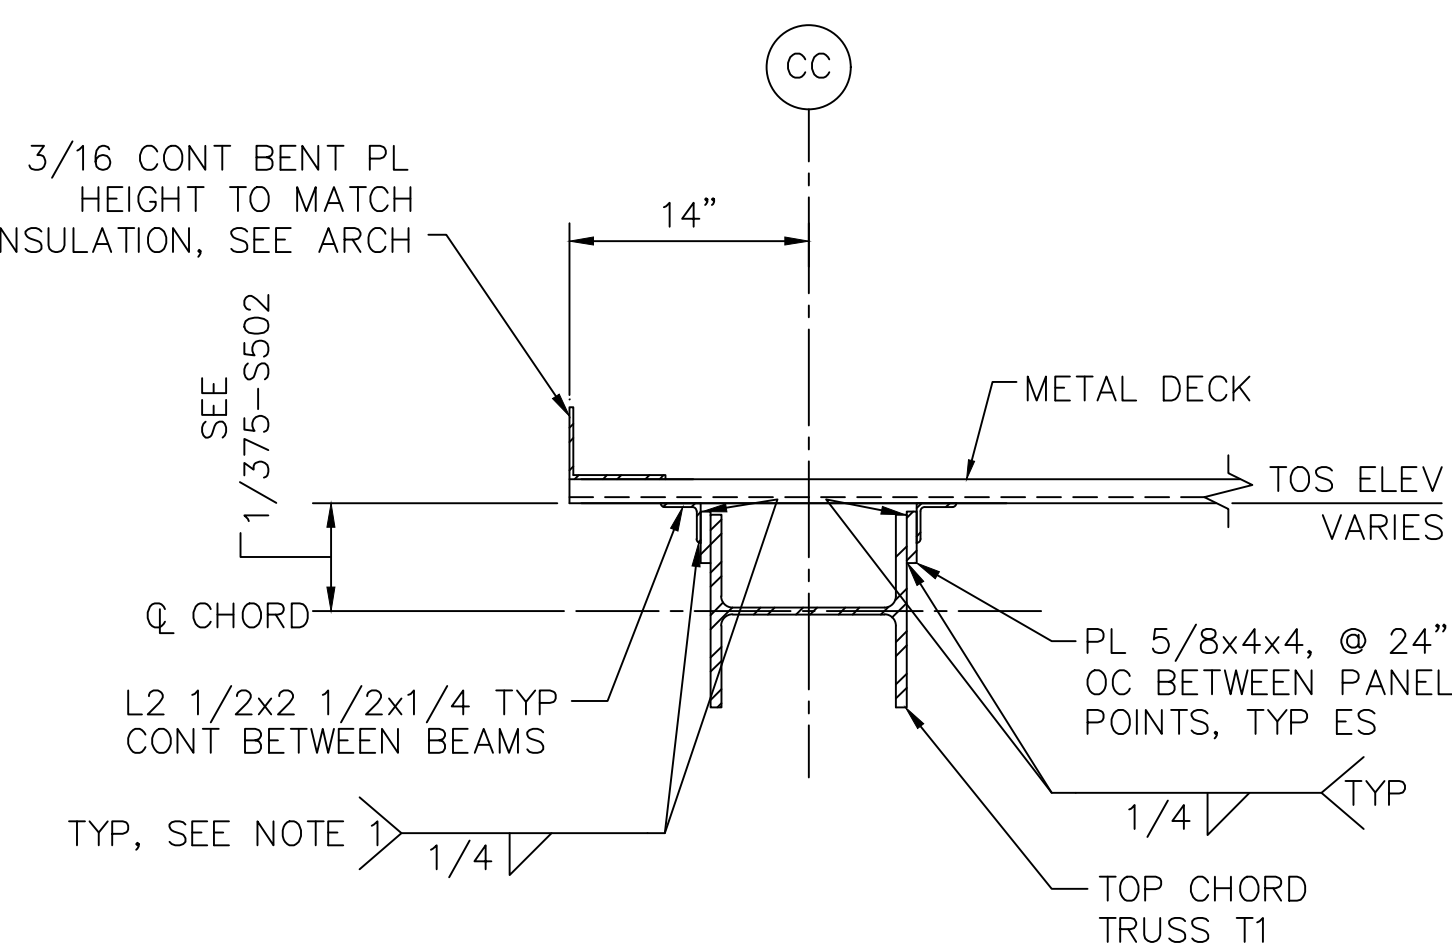


NOTES:
1. AT PANEL POINTS, WELD TO FACE OF GUSSET PL, 1/4 FILLET WELD 2" LONG @ 8" OC.


8 DECK SUPPORT AT TRUSS T1 TOP CHORD
375-S501 SCALE: 1" = 1'-0"

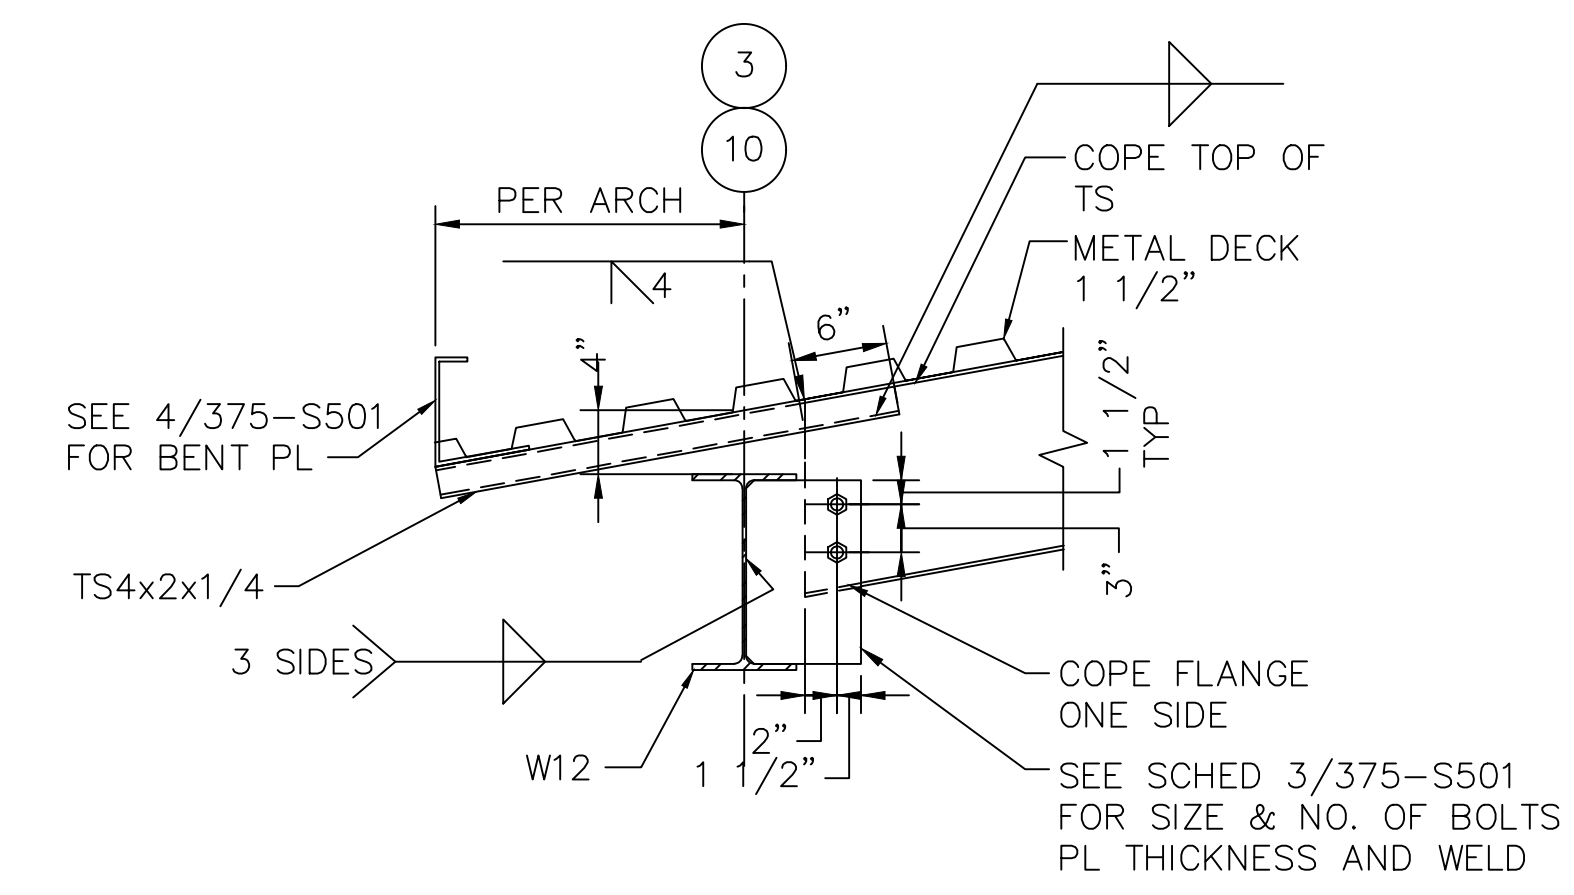


9 ROOF FRMG DETAIL GRID 3 & 10
375-S501 SCALE: 1" = 1'-0"

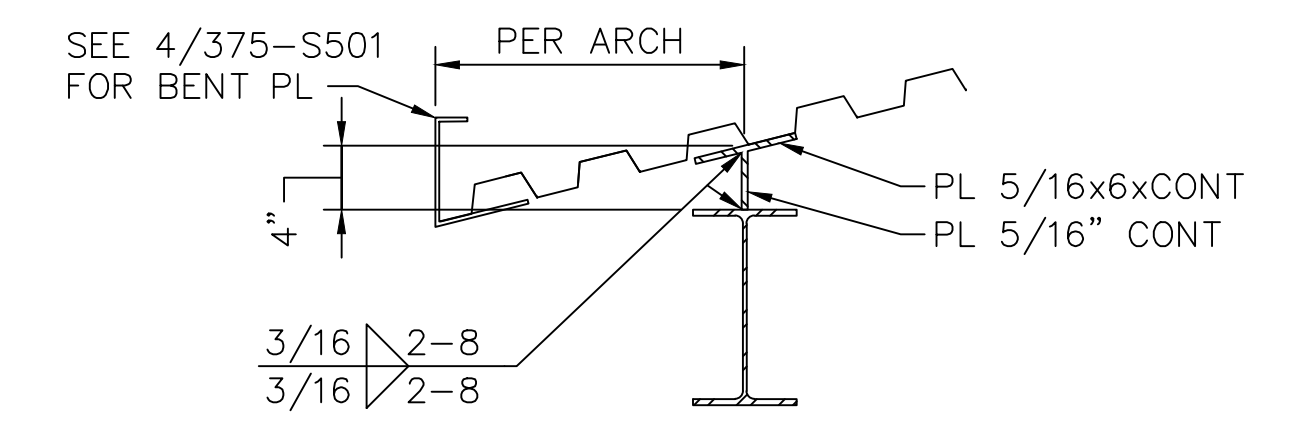


10 ROOF DECK DETAIL GRID 3 & 10
375-S501 SCALE: 1" = 1'-0"

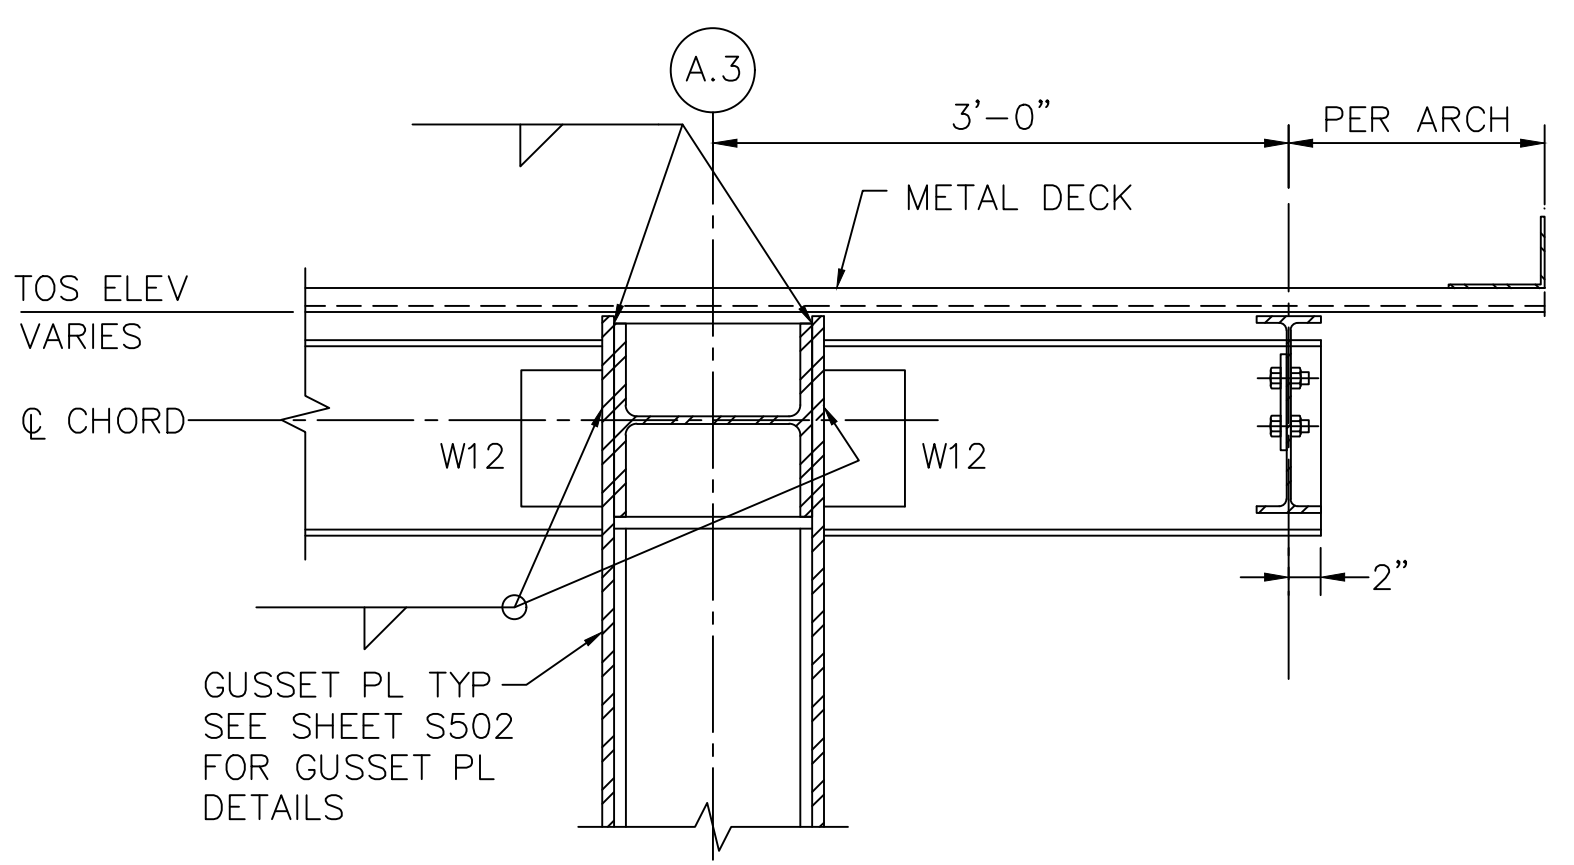

11 CANTILEVER BEAM GRID 2 & 11
375-S501 SCALE: 1" = 1'-0"

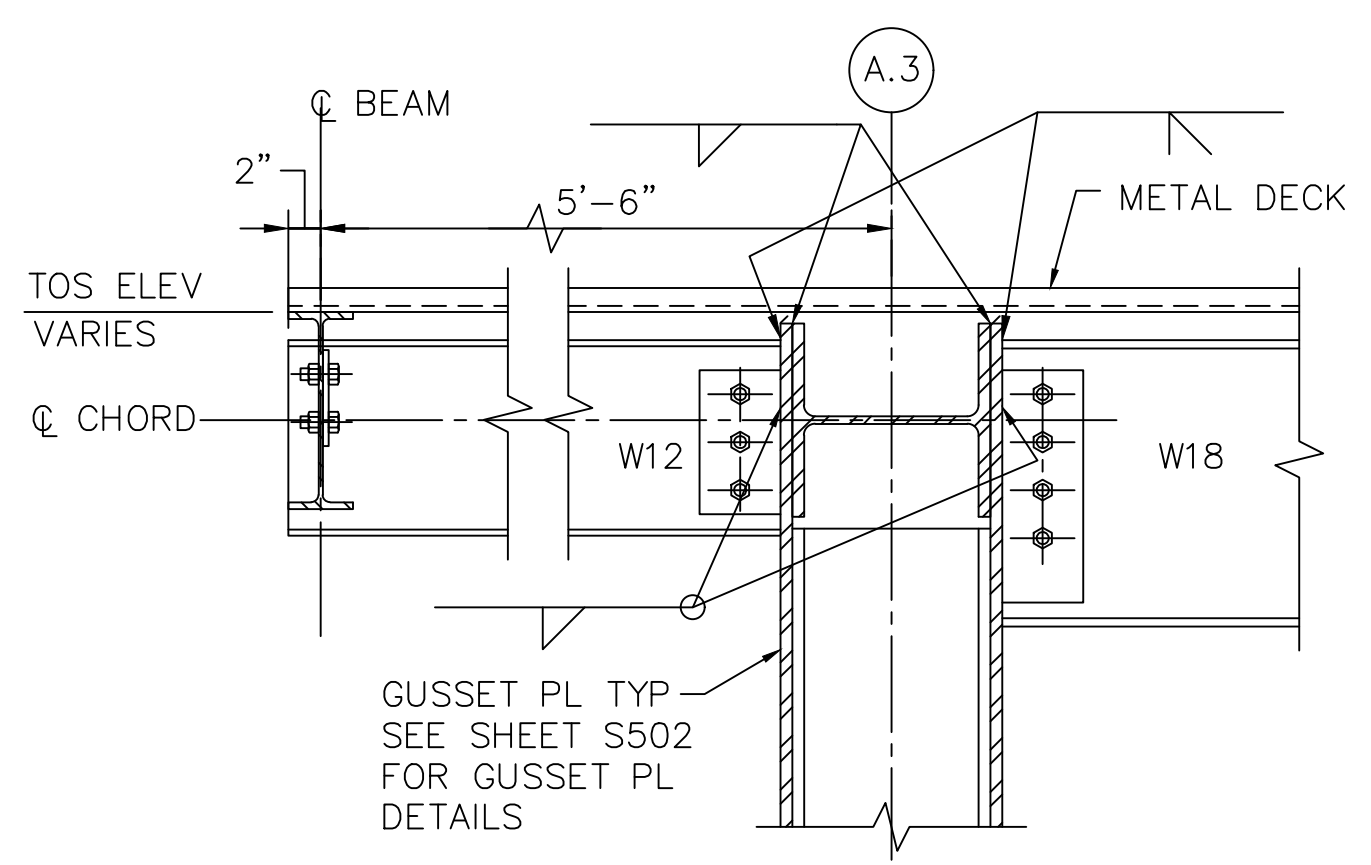

12 CANTILEVER BEAM CONNECTION
375-S501 SCALE: 1" = 1'-0"

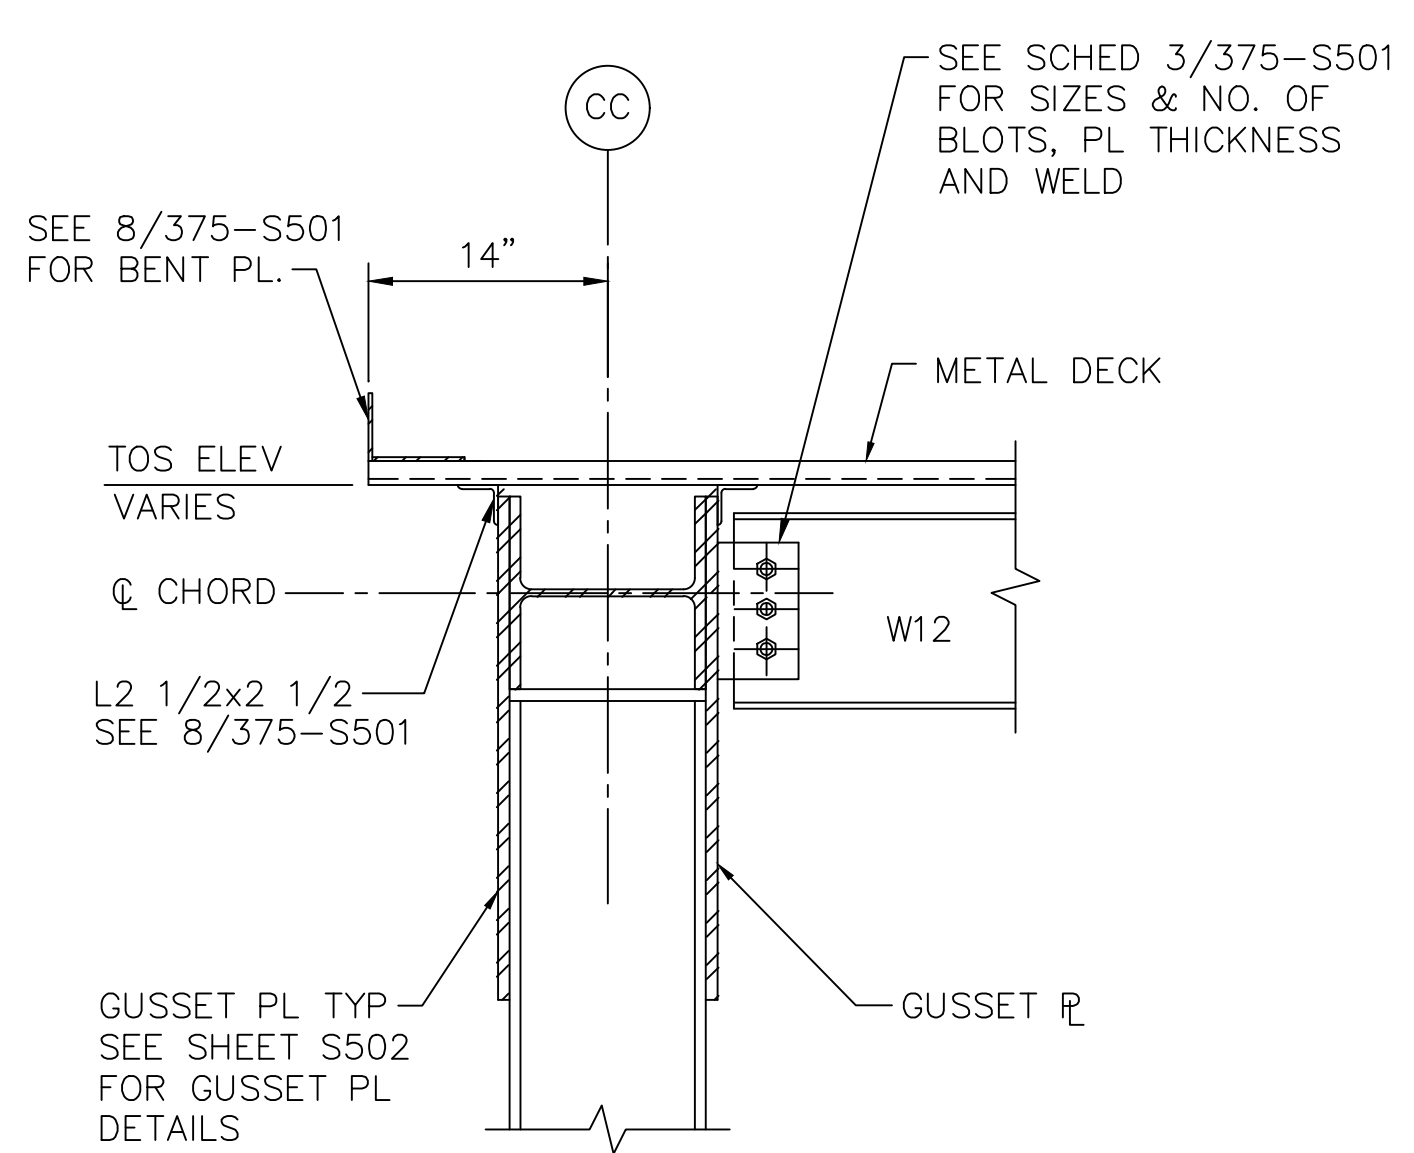

13 ROOF FRAMING DETAIL
375-S501 SCALE: 1" = 1'-0"


Date	Appr.	Symbol	Description

Date	1/26/04
Design file no.	3126/211-10-02
Designed by	AEW
Drawn by	YJP
Checked by	JUF
Submitted by	BERGER/ABAM
Section	(206) 374-5000 (Ext.207) 374-9795
Principal	

ADD/ALTER FLIGHTLINE FACILITIES BLDG 304 & 375
PORTLAND, OREGON
FY04 PN TOKD 012259

FRAMING DETAILS

PLATE NUMBER:
375-S502
Sheet 63 of 76

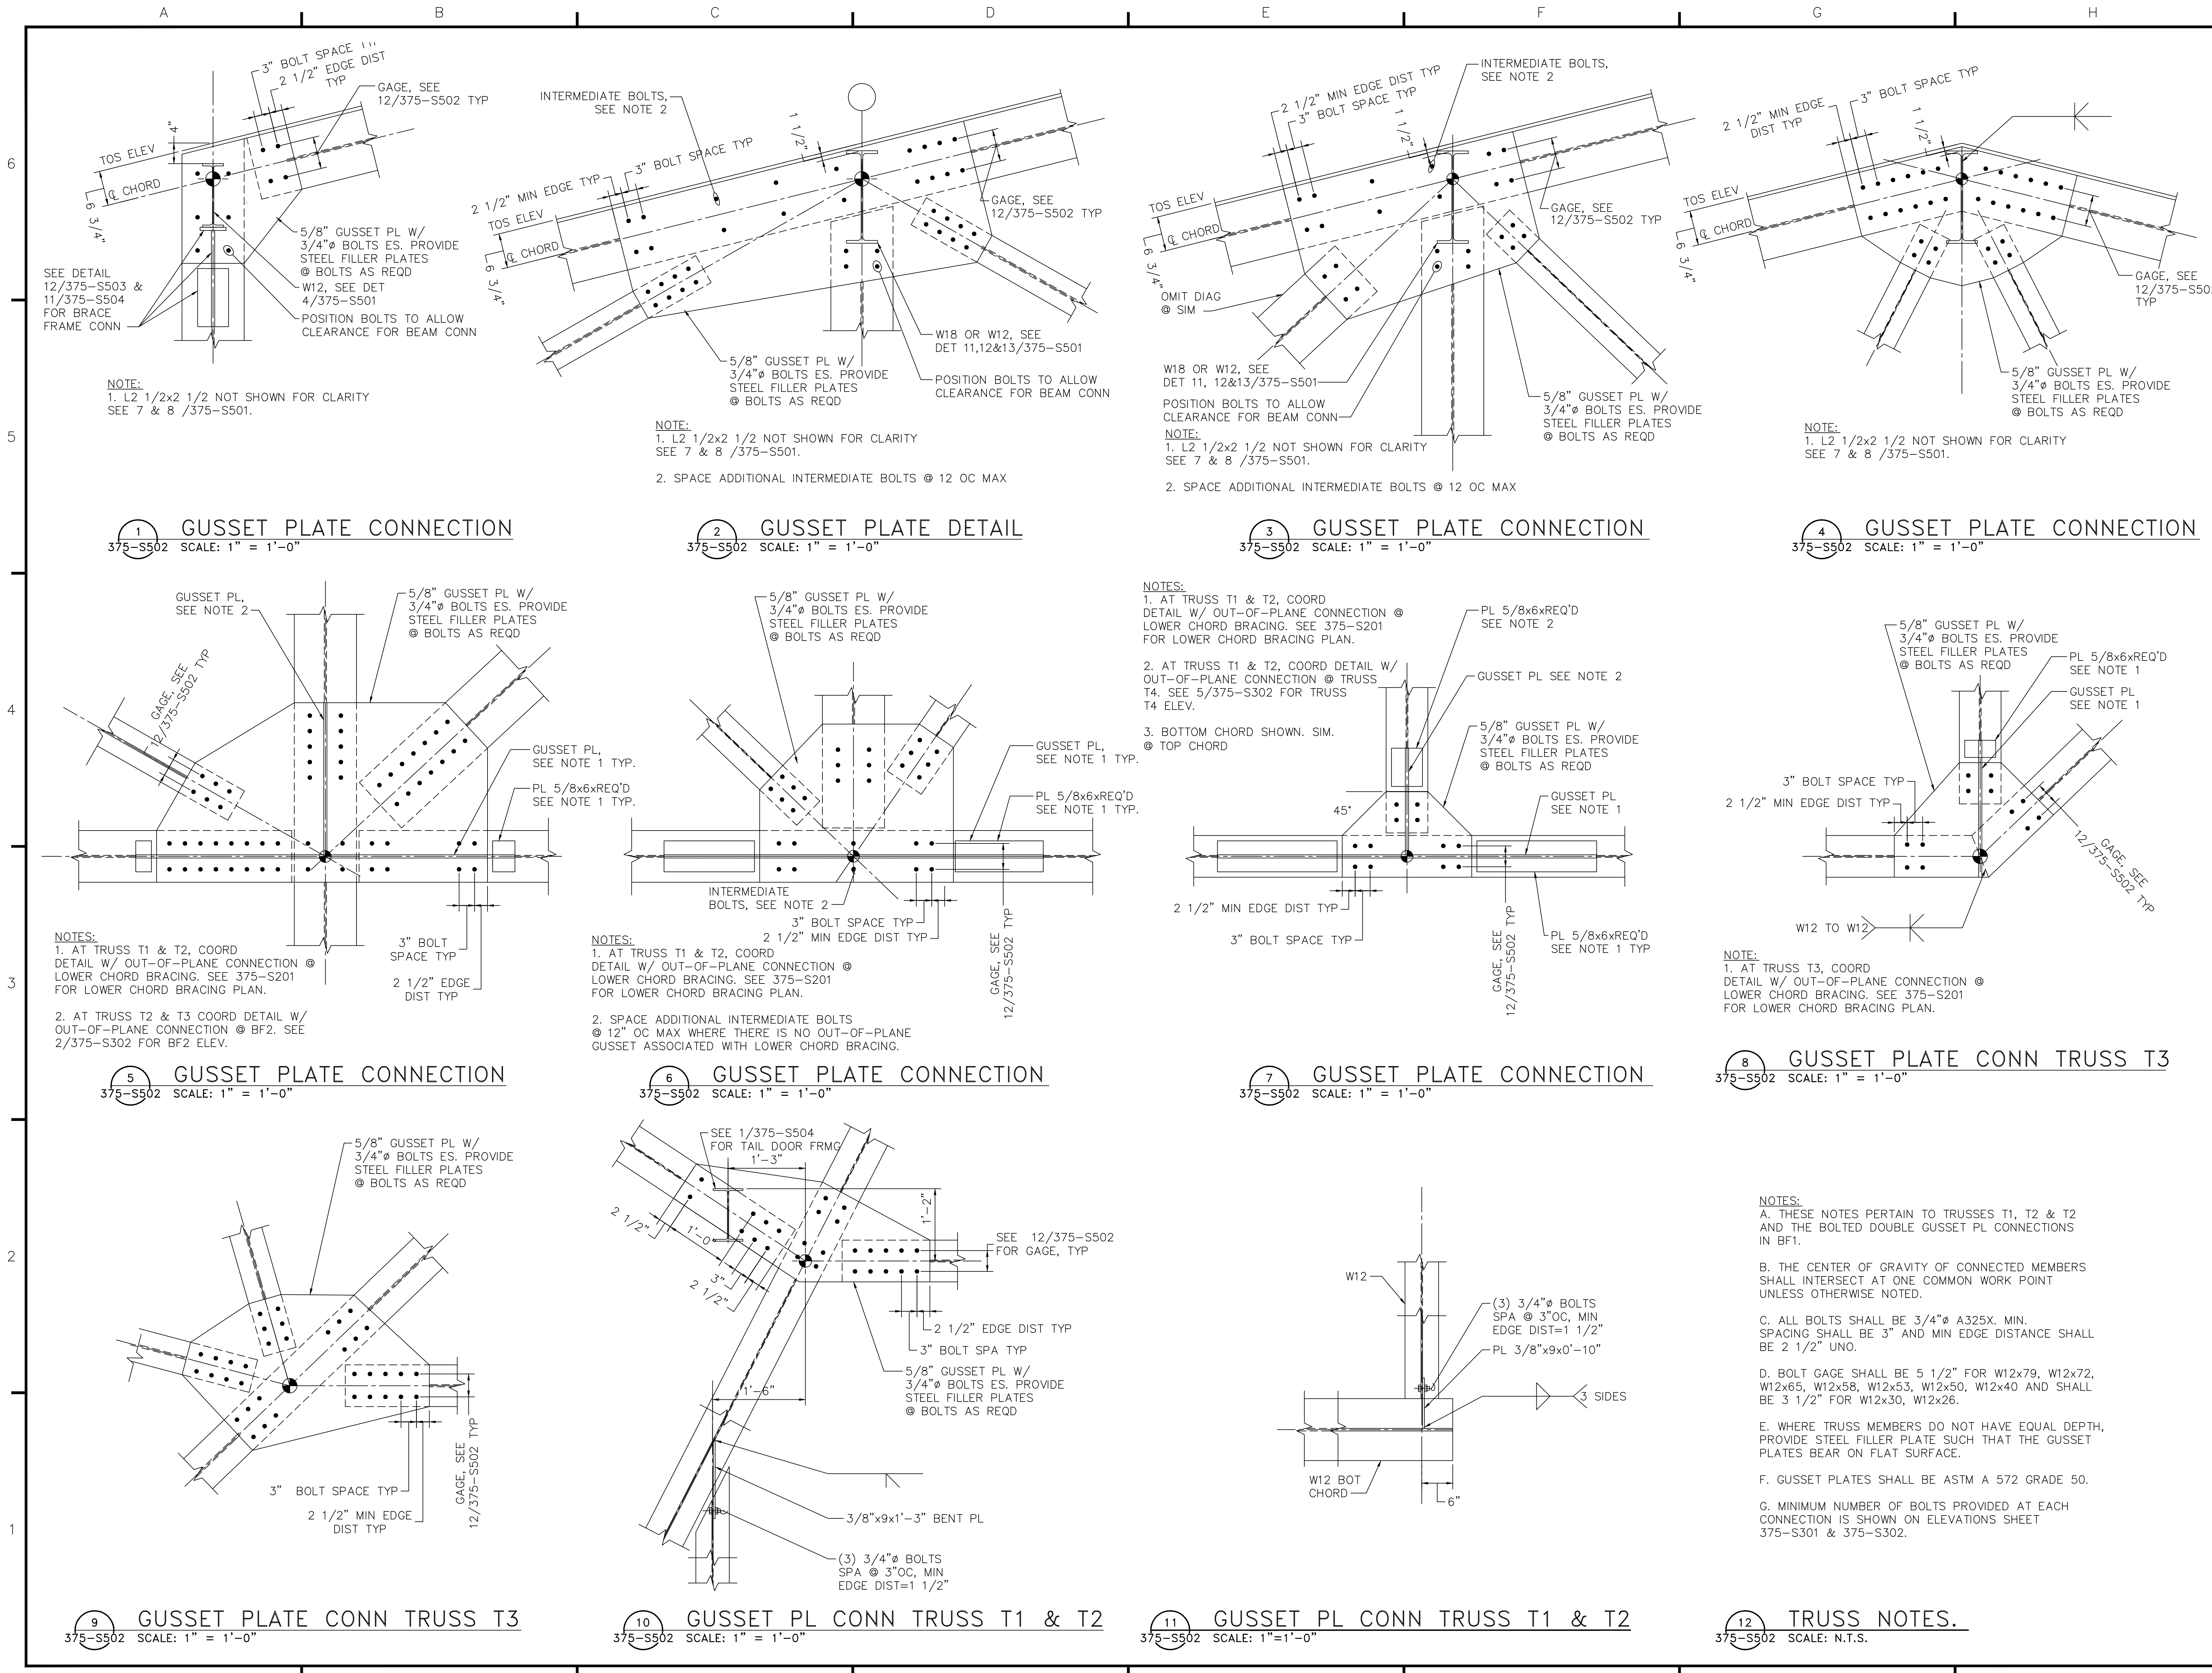



Date	Appr.	Symbol	Description

Date:	1/20/04
Design file no.:	3125/211-0-02
Designed by:	AEW
Drawn by:	yp
Checked by:	JUF
Submitted by:	JUF
Principal:	(206) 374-5000

ADD/ALTER FLIGHTLINE FACILITIES BLDG 304 & 375
PORTLAND ANG, OREGON
FY04 PN TOKD 012259

PLATE NUMBER:
375-S503

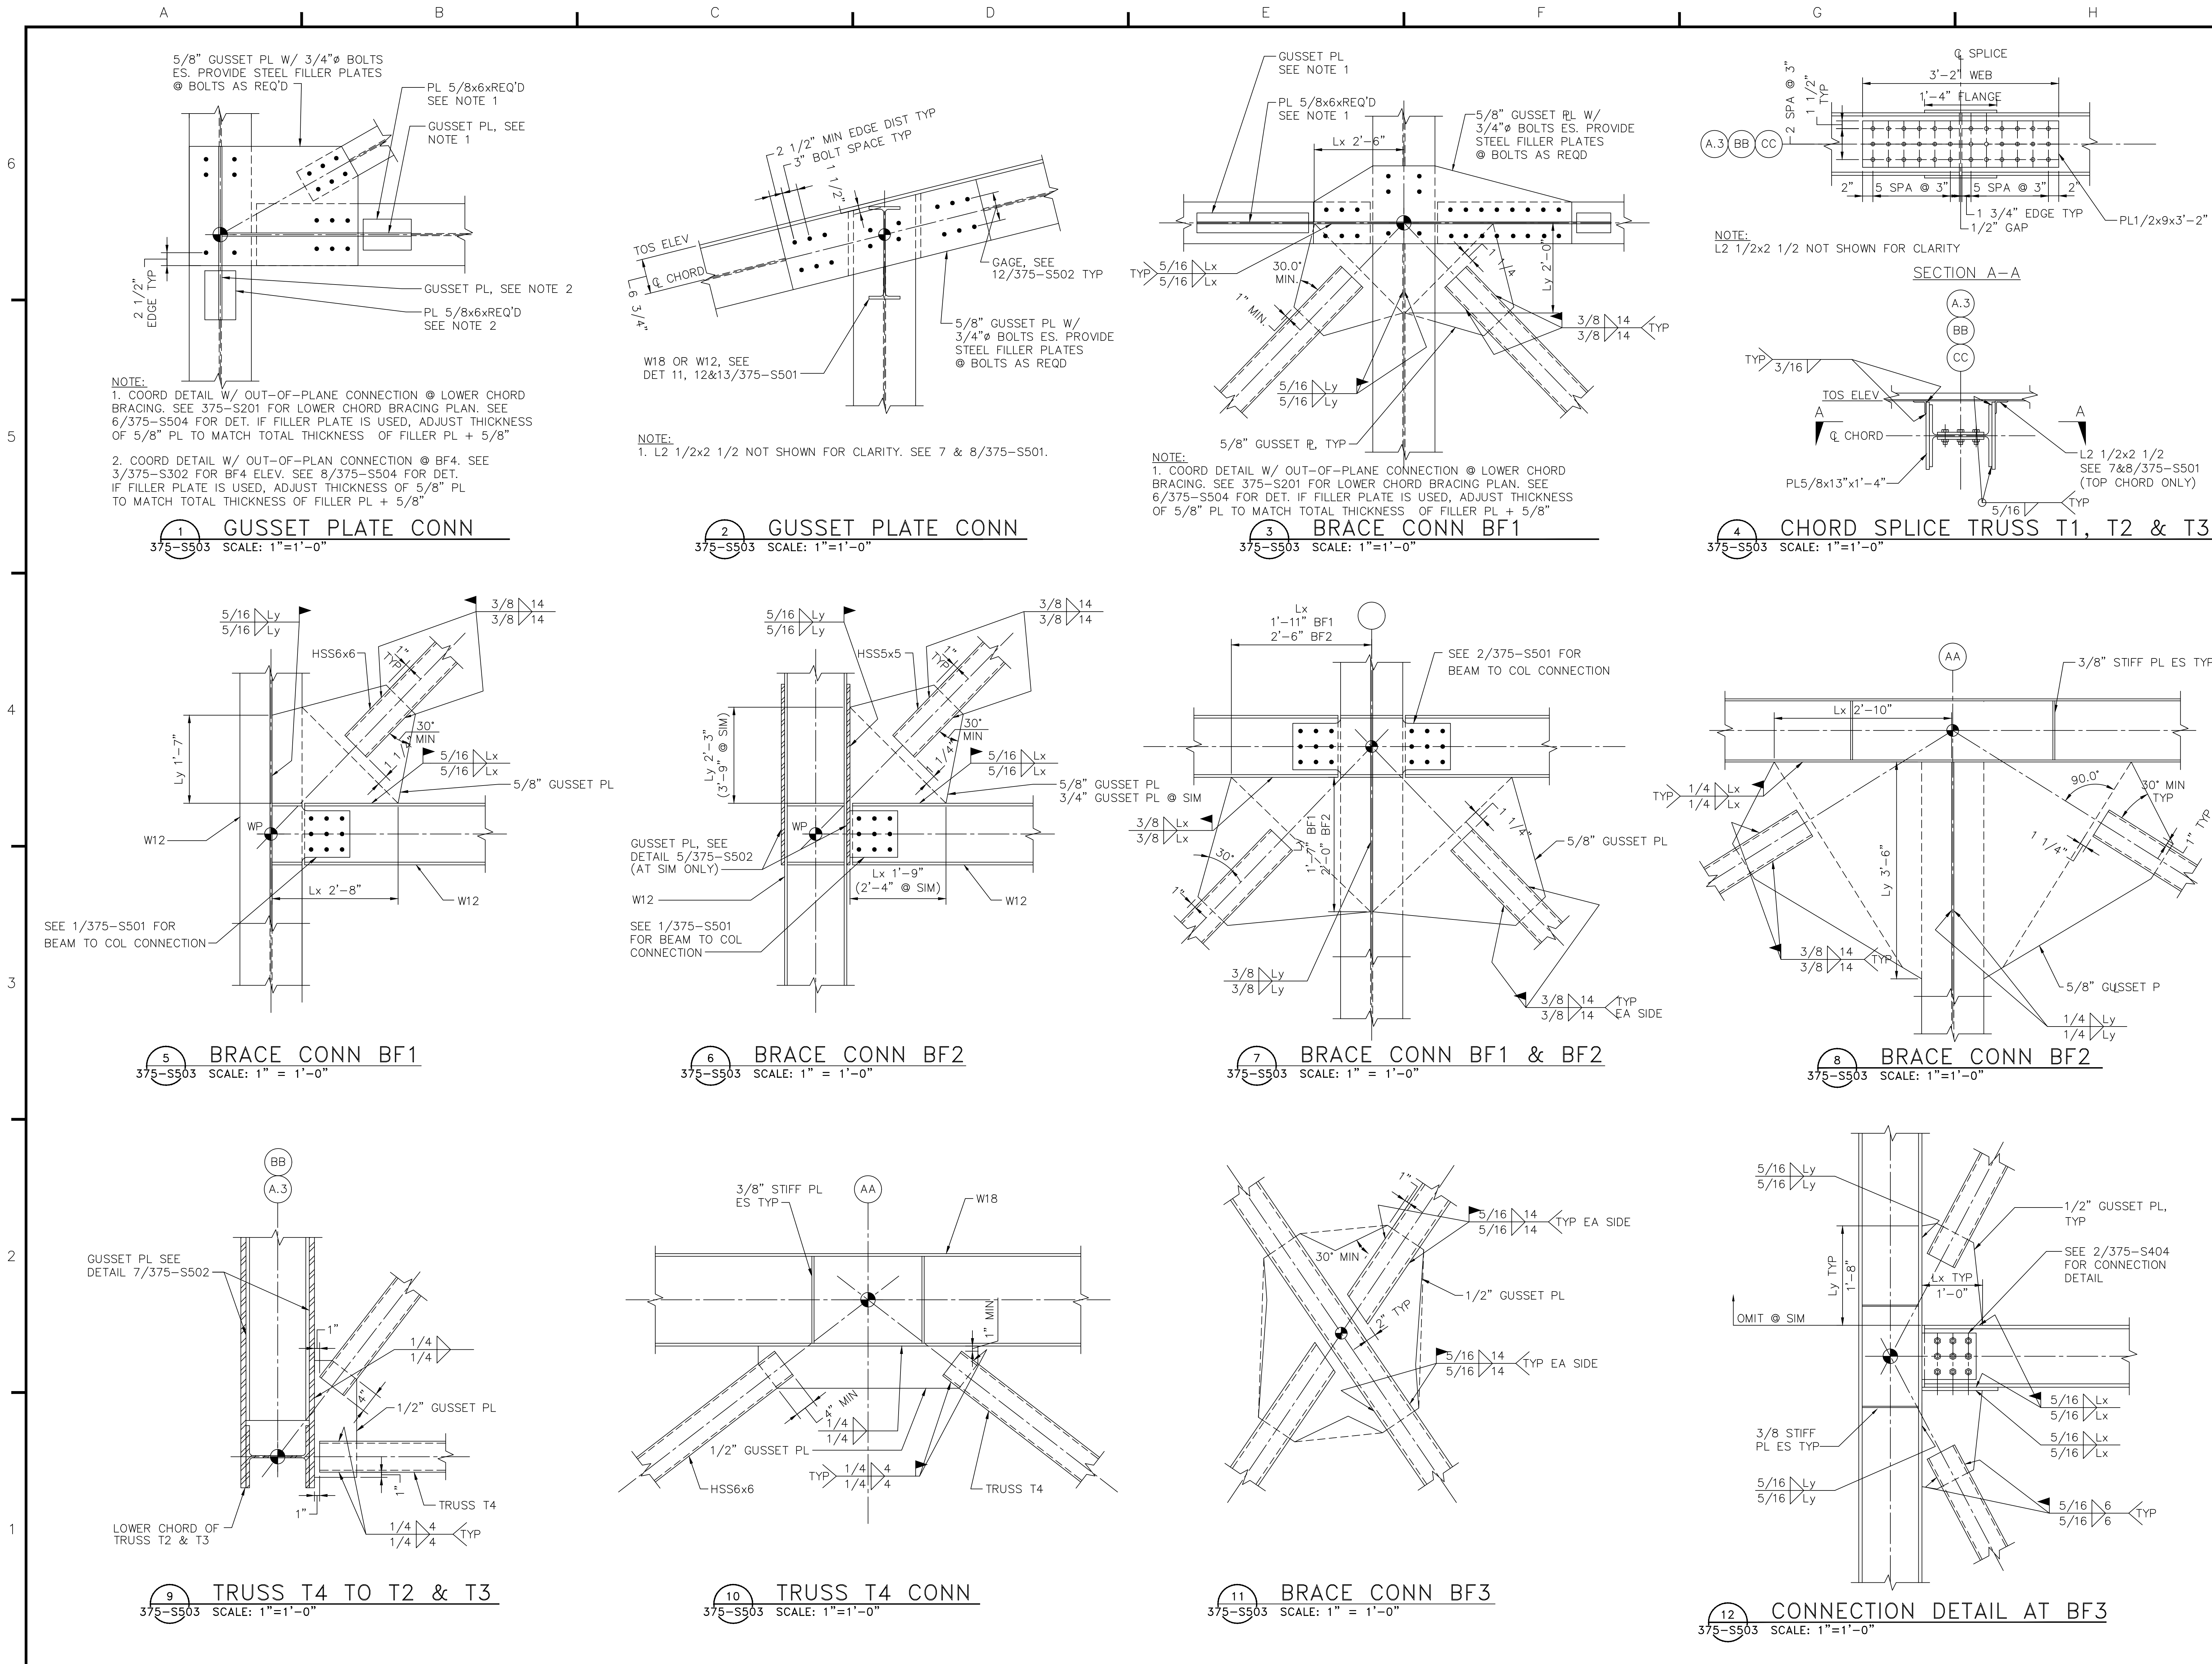

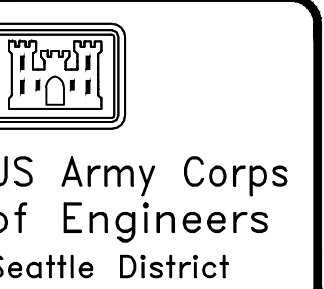

Date	Appr.	Symbol	Description


Date: 1/22/04	Design file no. 3125/211-0-02
Designed by: AEW	Drawn by: YYP
Checked by: JUF	Submitted by: JUF
U.S. ARMY ENGINEER DISTRICT SEATTLE CORPS OF ENGINEERS	SEATTLE, WASHINGTON
Submitted by: BERGER/ABRAM ENGINEERS, INC.	(206) 374-5950 (425) 374-9795
Principal	

ADD/ALTER FLIGHTLINE FACILITIES BLDG 504 & 375
PORTLAND ANG. OREGON
FY04 PN TOKD 012259


FRAMING DETAILS

PLATE NUMBER:
375-S504


Sheet 65 of 76

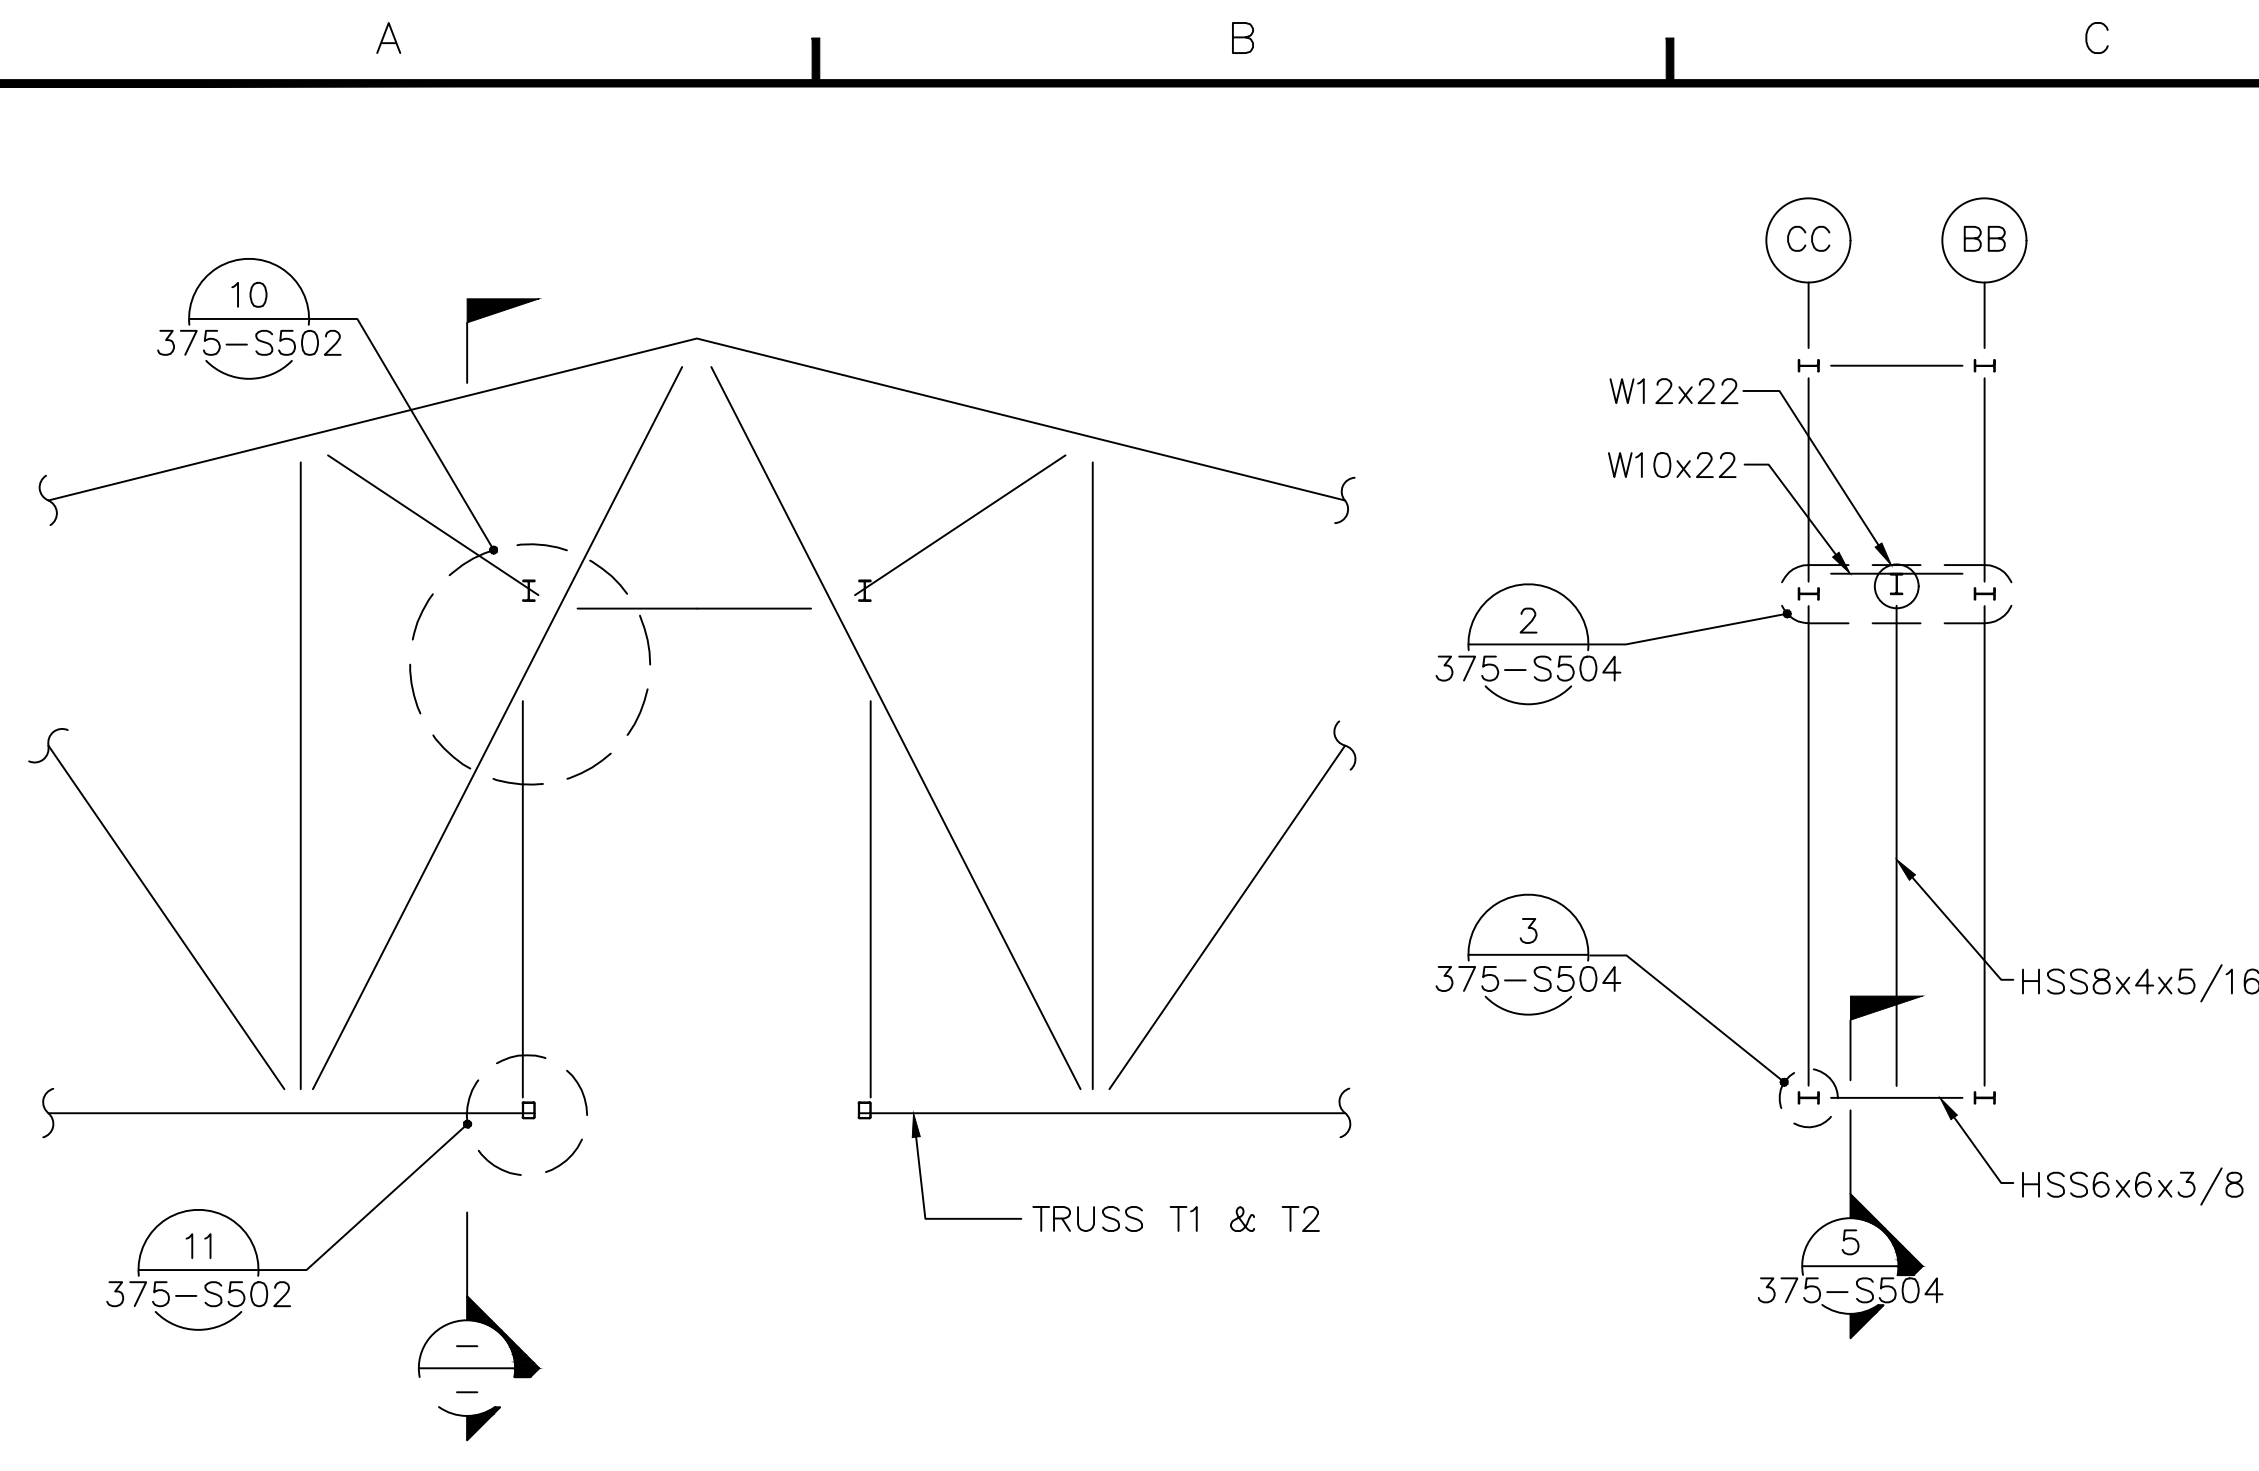


1 ELEVATION @ TAIL DOOR
375-S504 SCALE: 1/8"=1'-0"

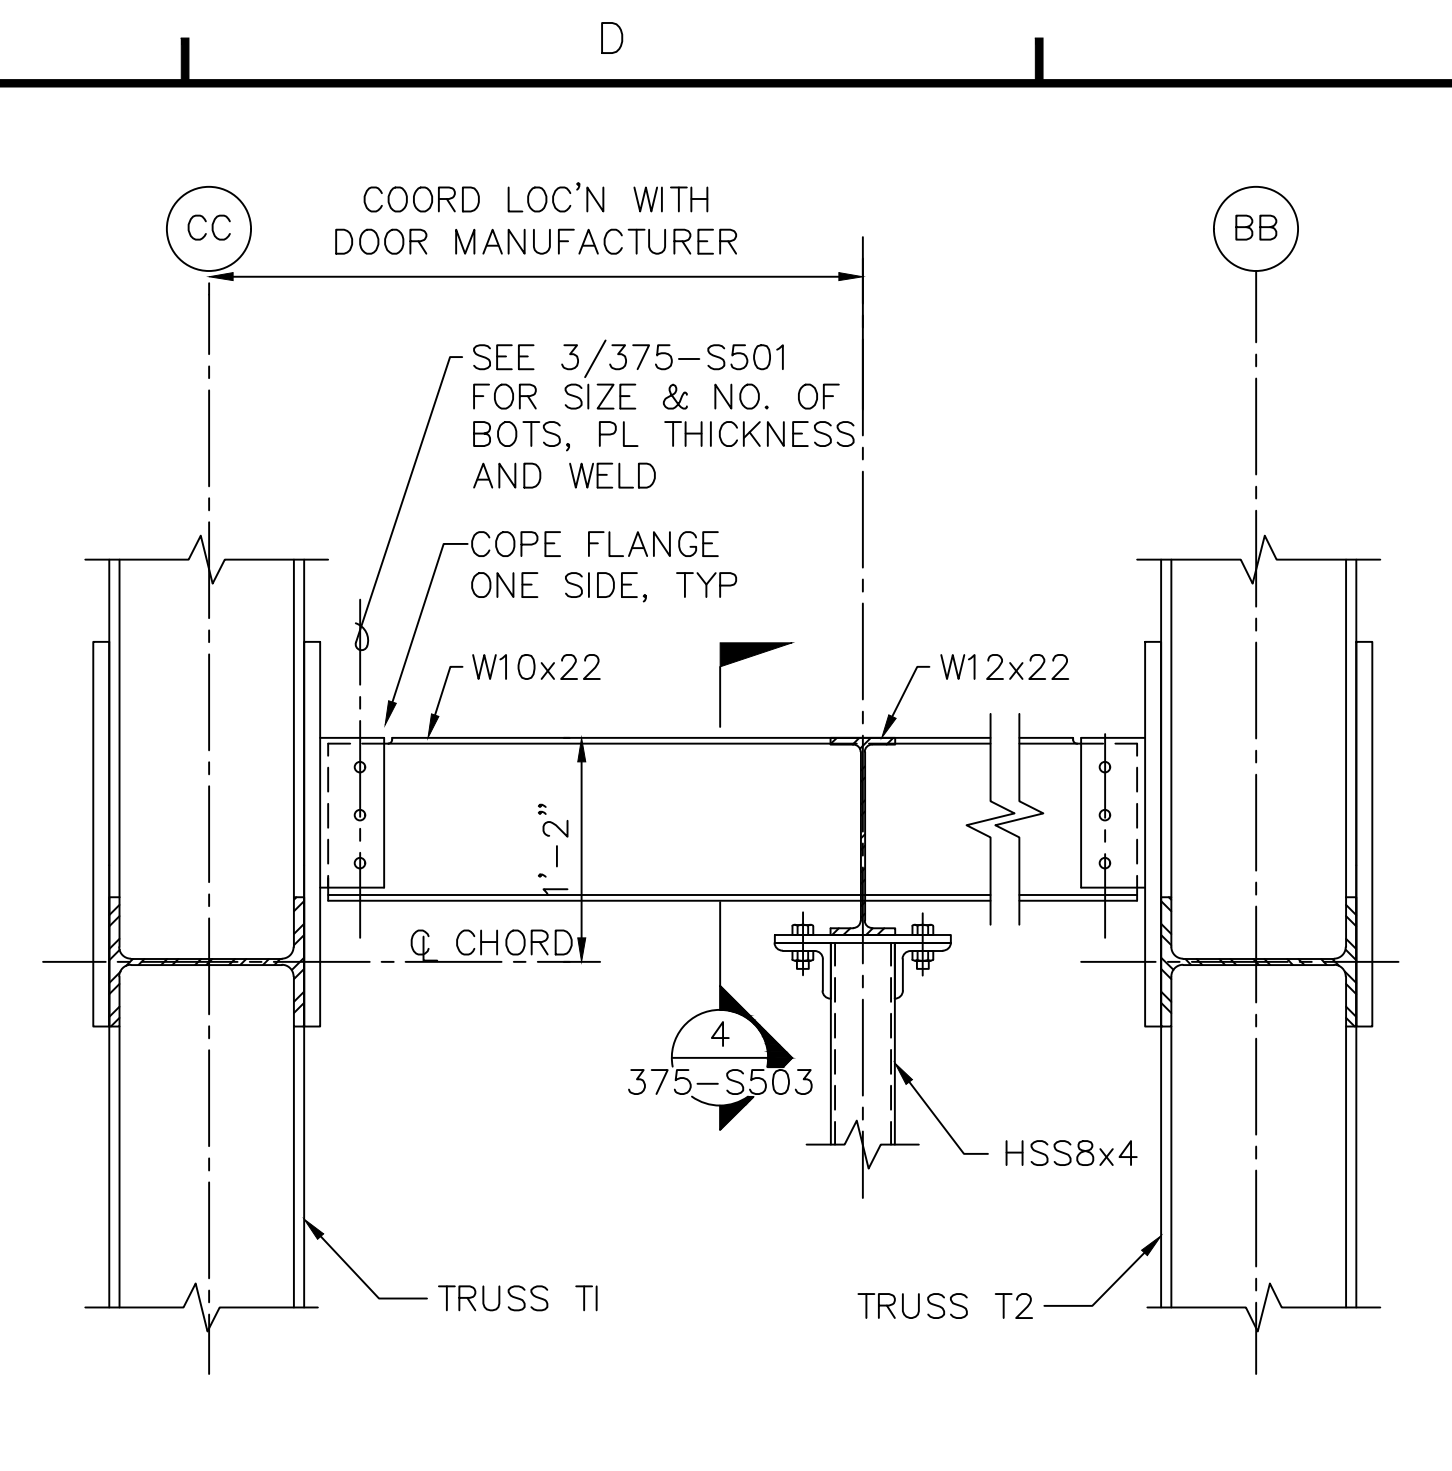


2 TAIL DOOR FRMG TO TRUSS T1 & T2
375-S503 SCALE: 1"=1'-0"

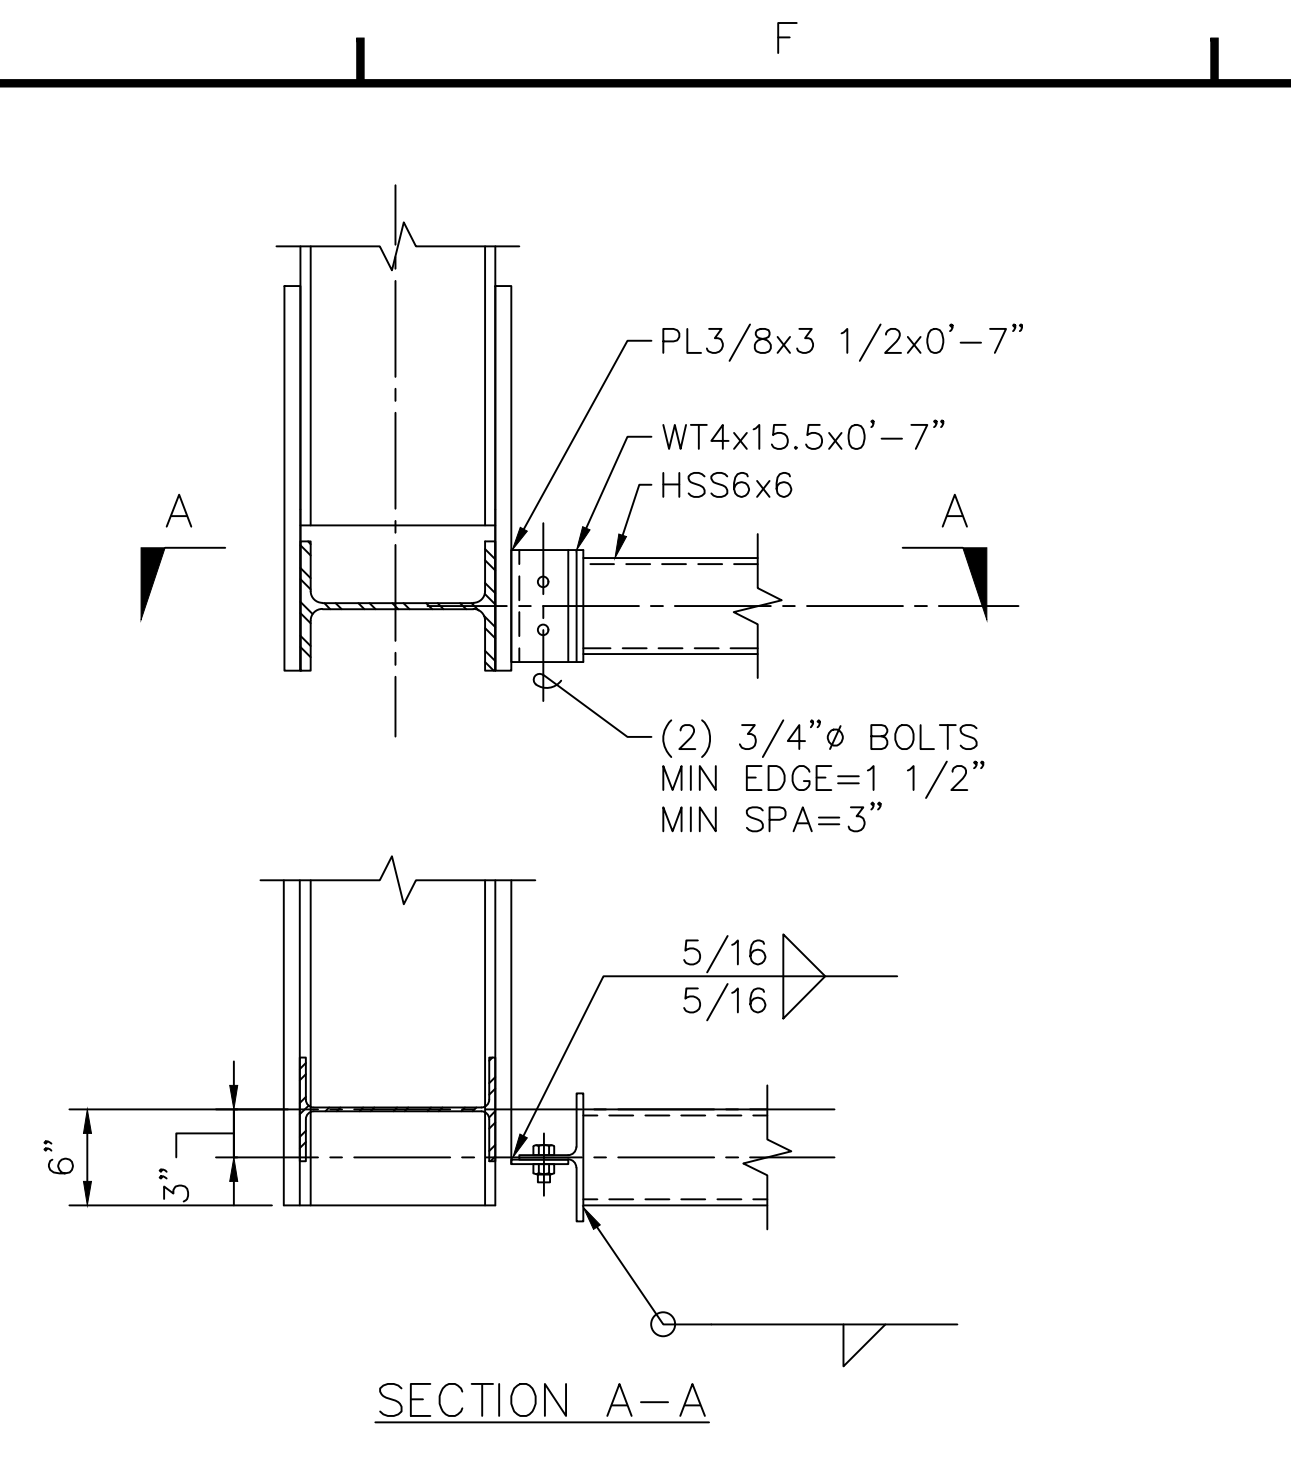


3 TAIL DOOR FRAMING
375-S503 SCALE: 1"=1'-0"

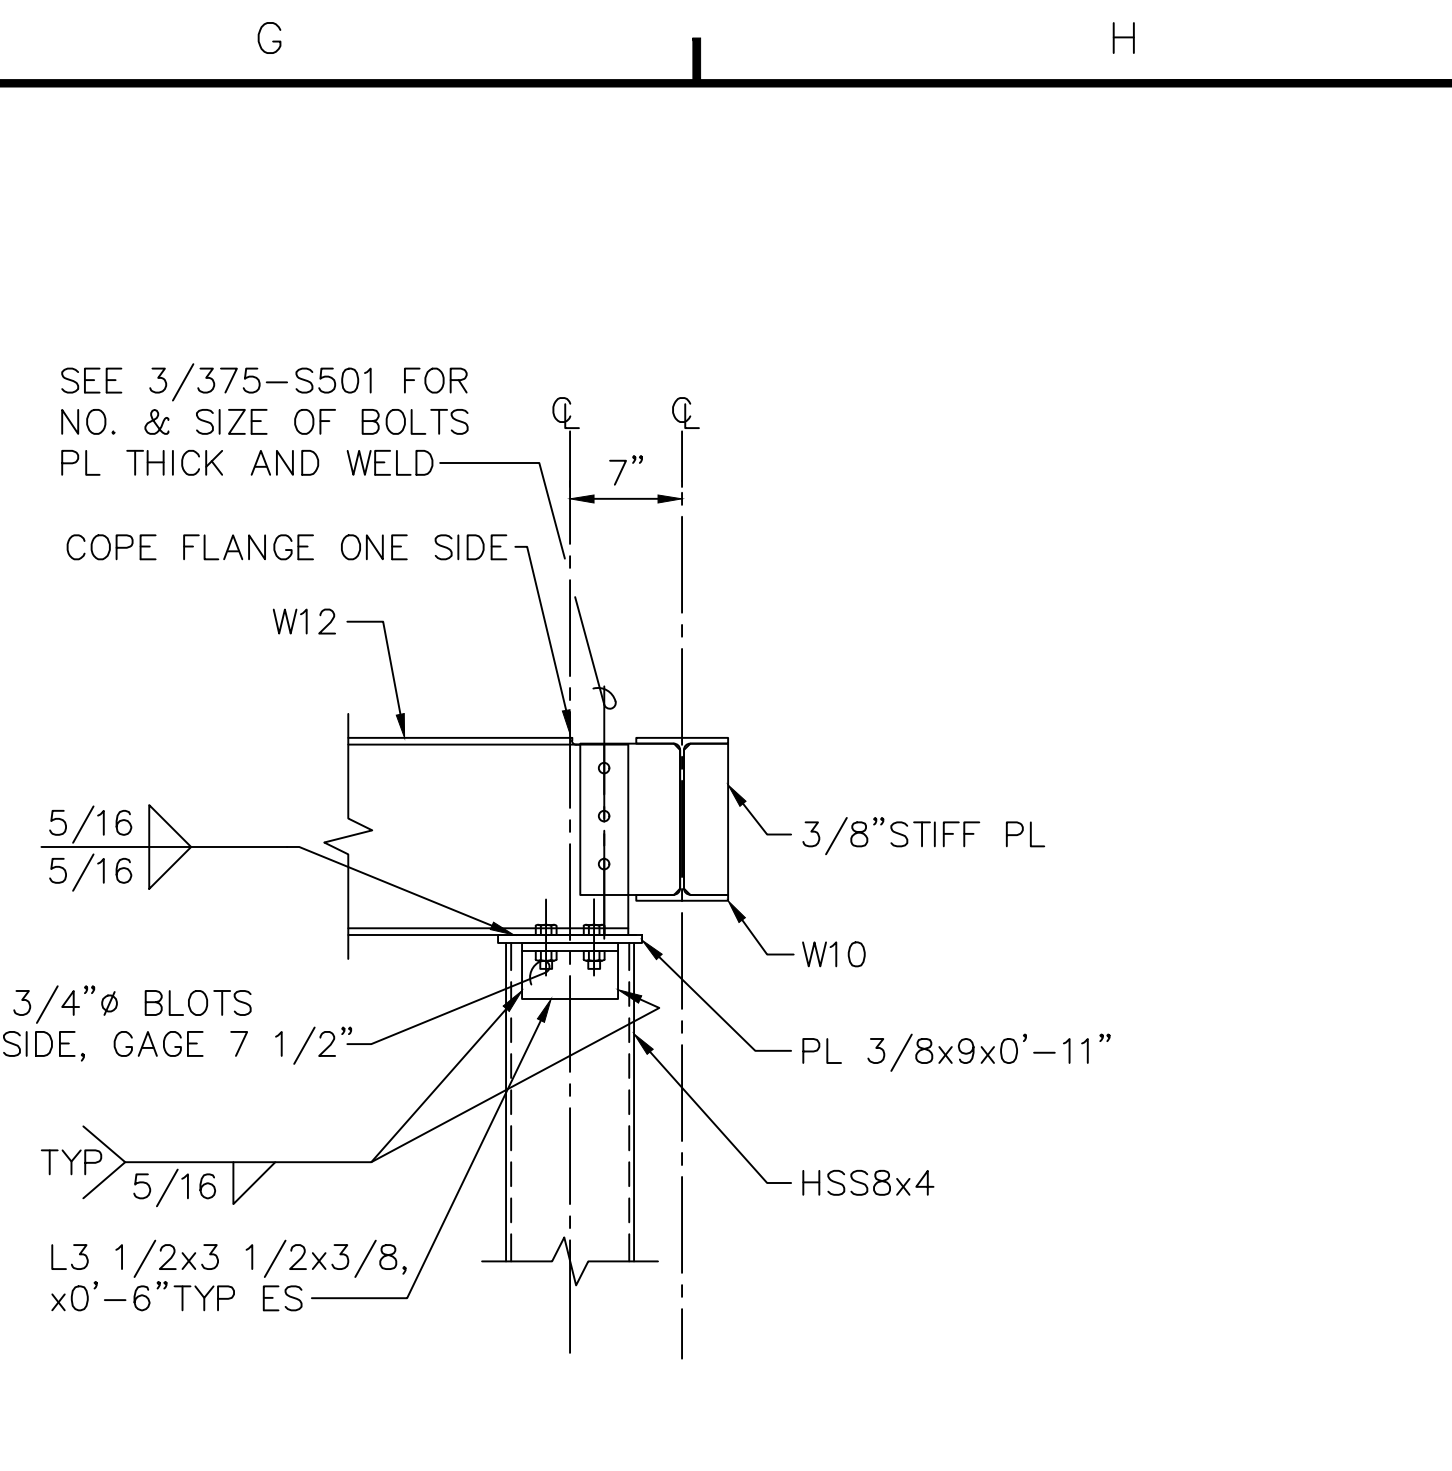


4 TAIL DOOR FRAMING
375-S503 SCALE: 1"=1'-0"

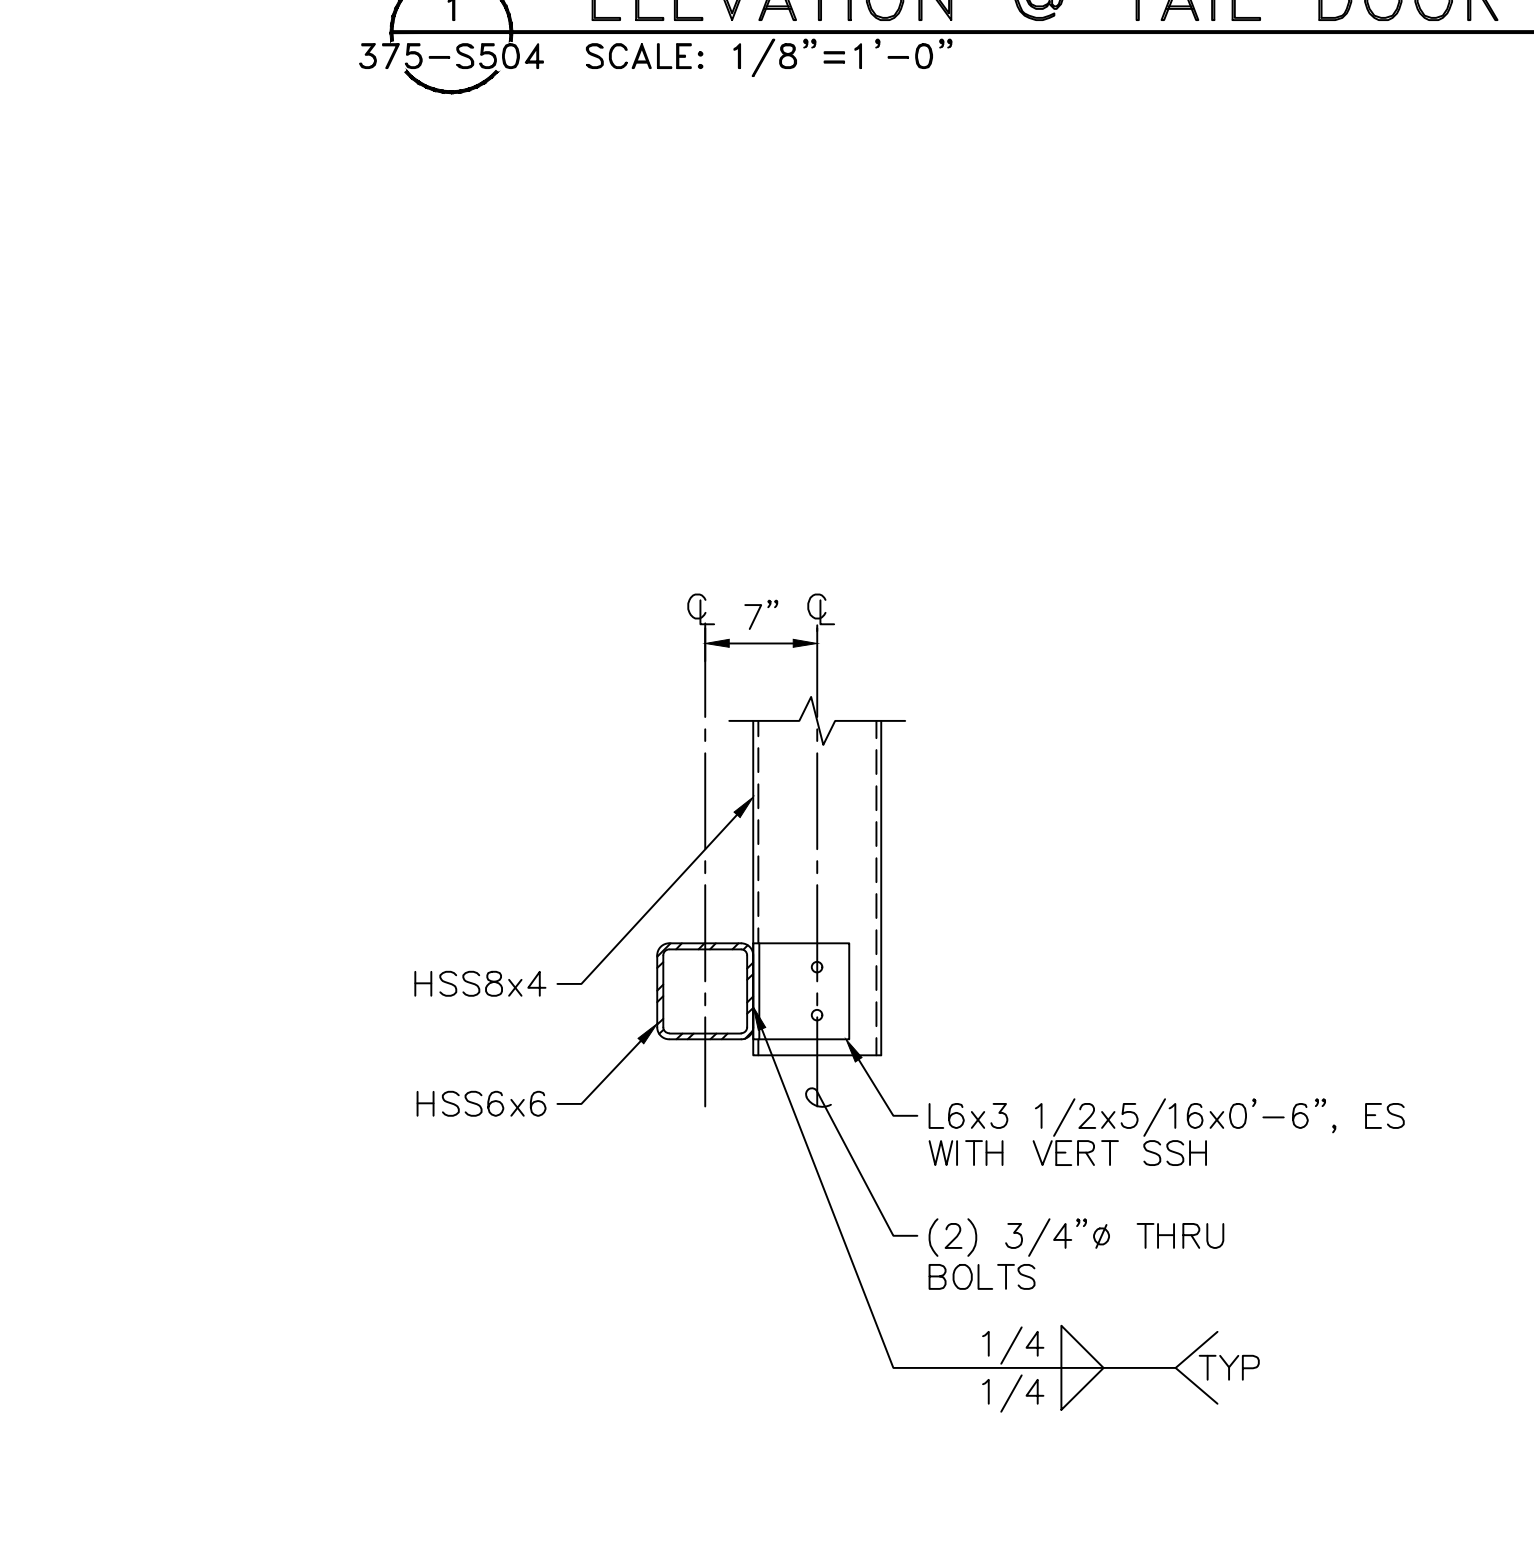


5 TAIL DOOR FRAMING
375-S504 SCALE: 1"=1'-0"

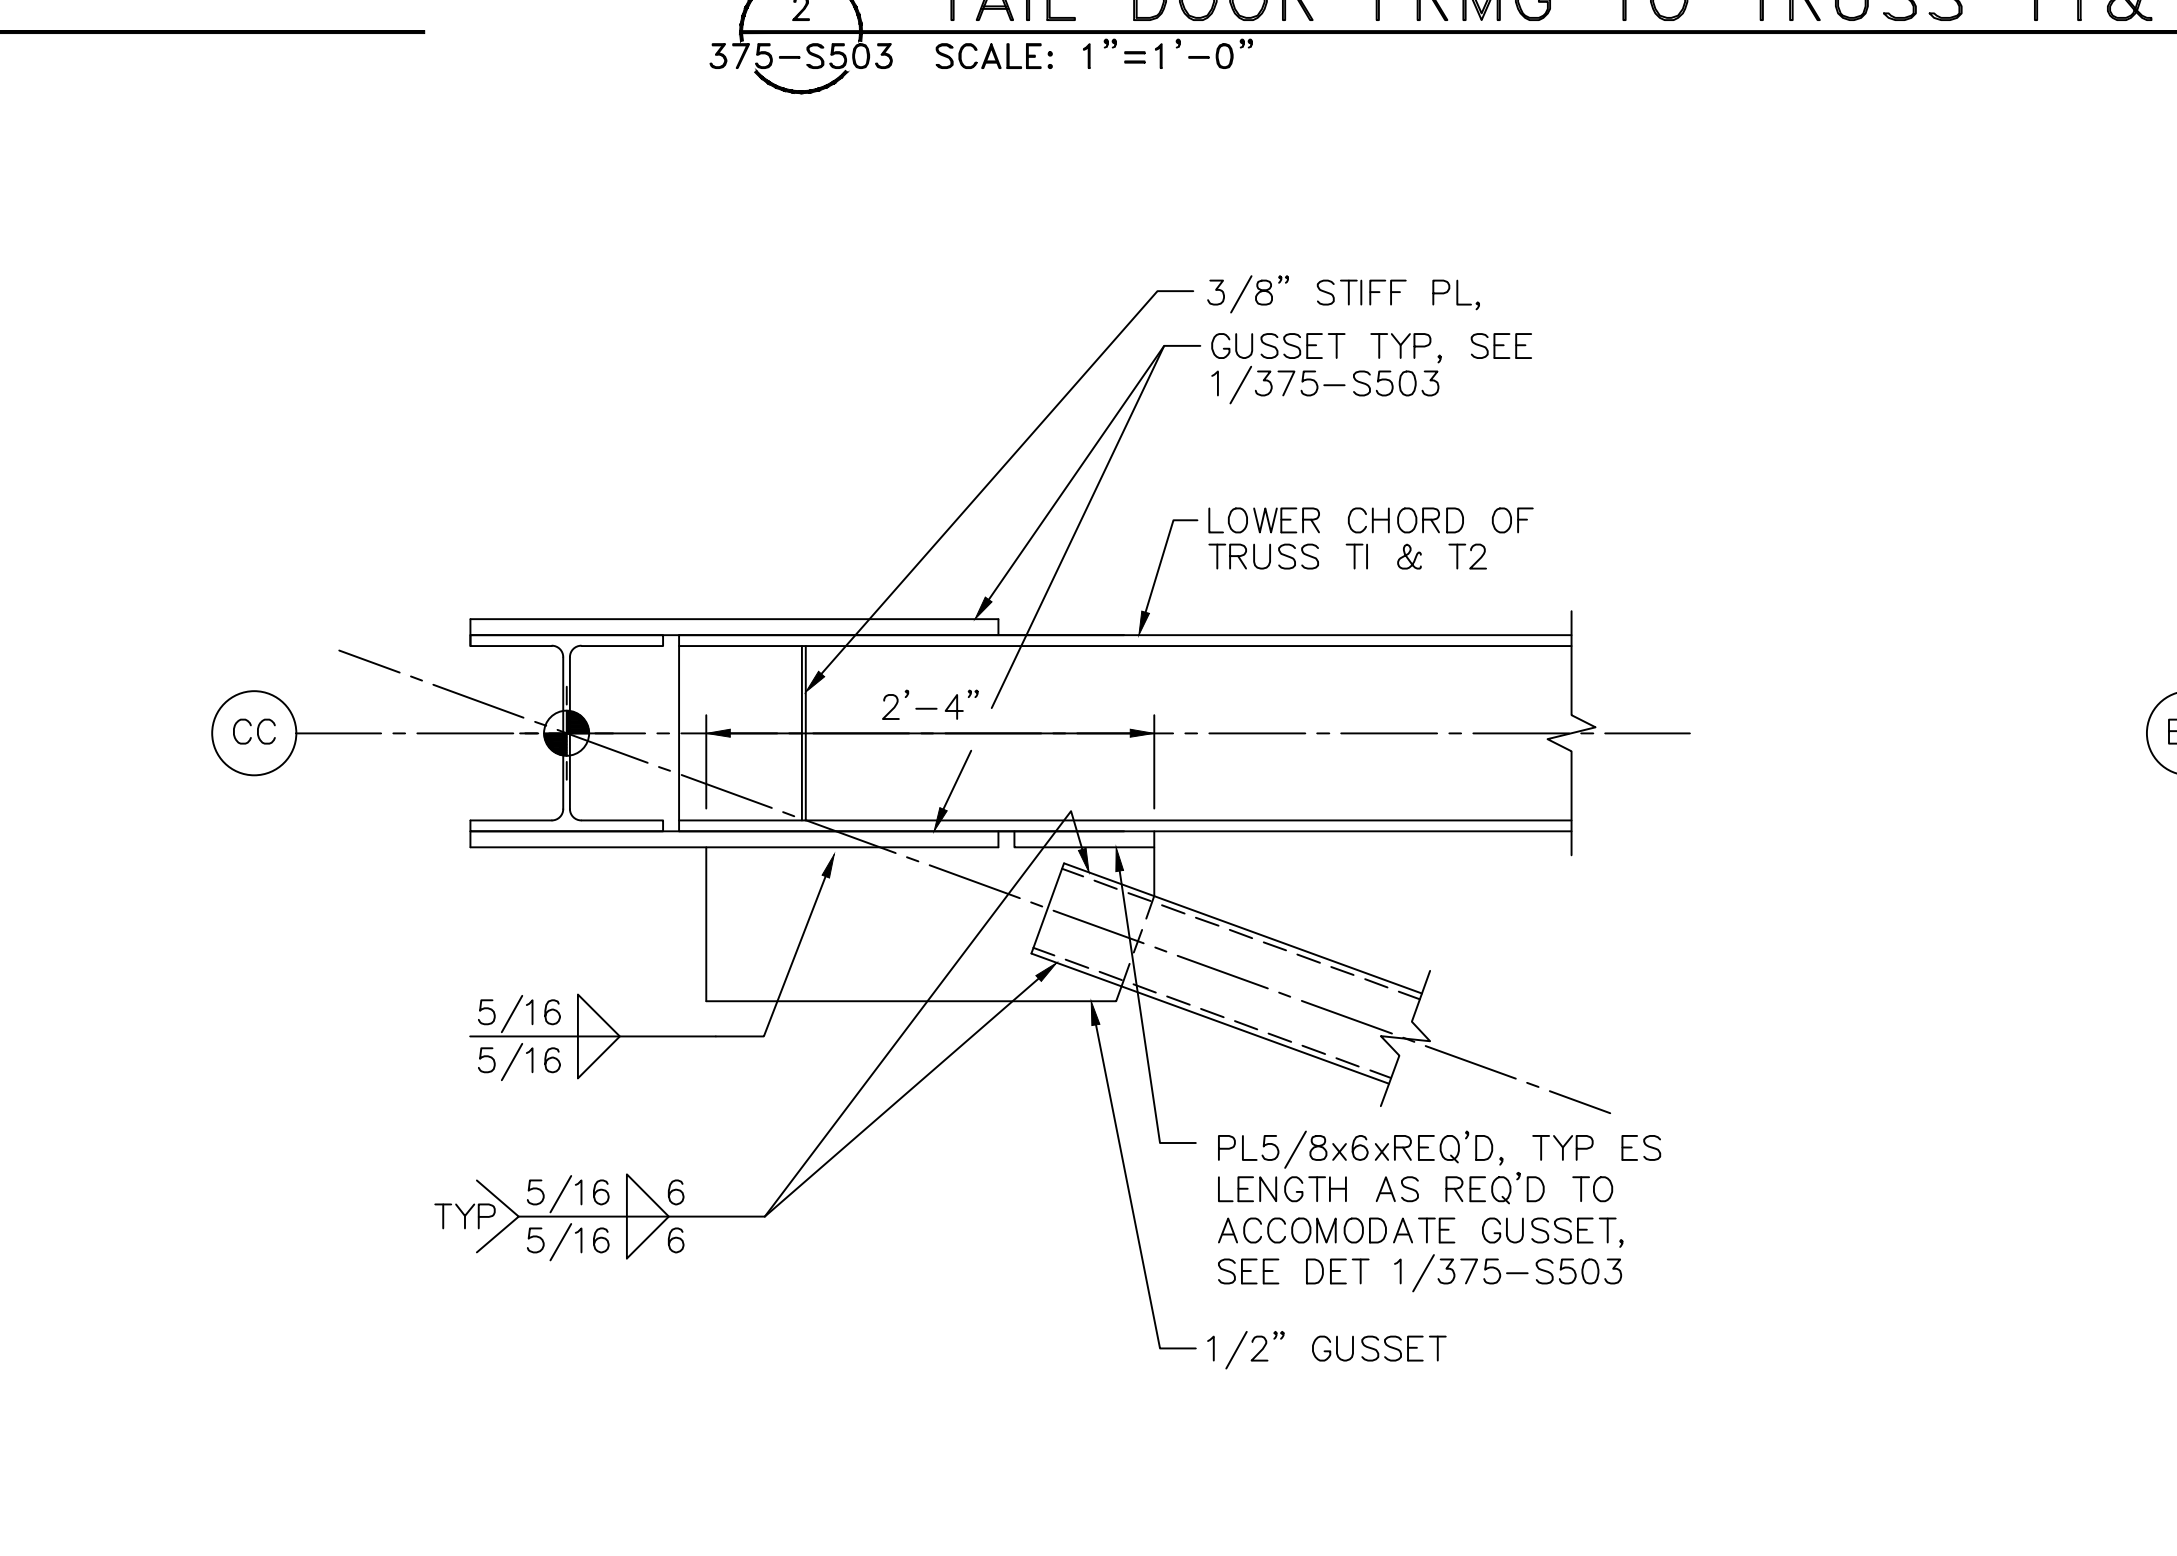


6 PLAN - LOWER CHORD BRACING TRUSS T1 & T2
375-S504 SCALE: 1"=1'-0"

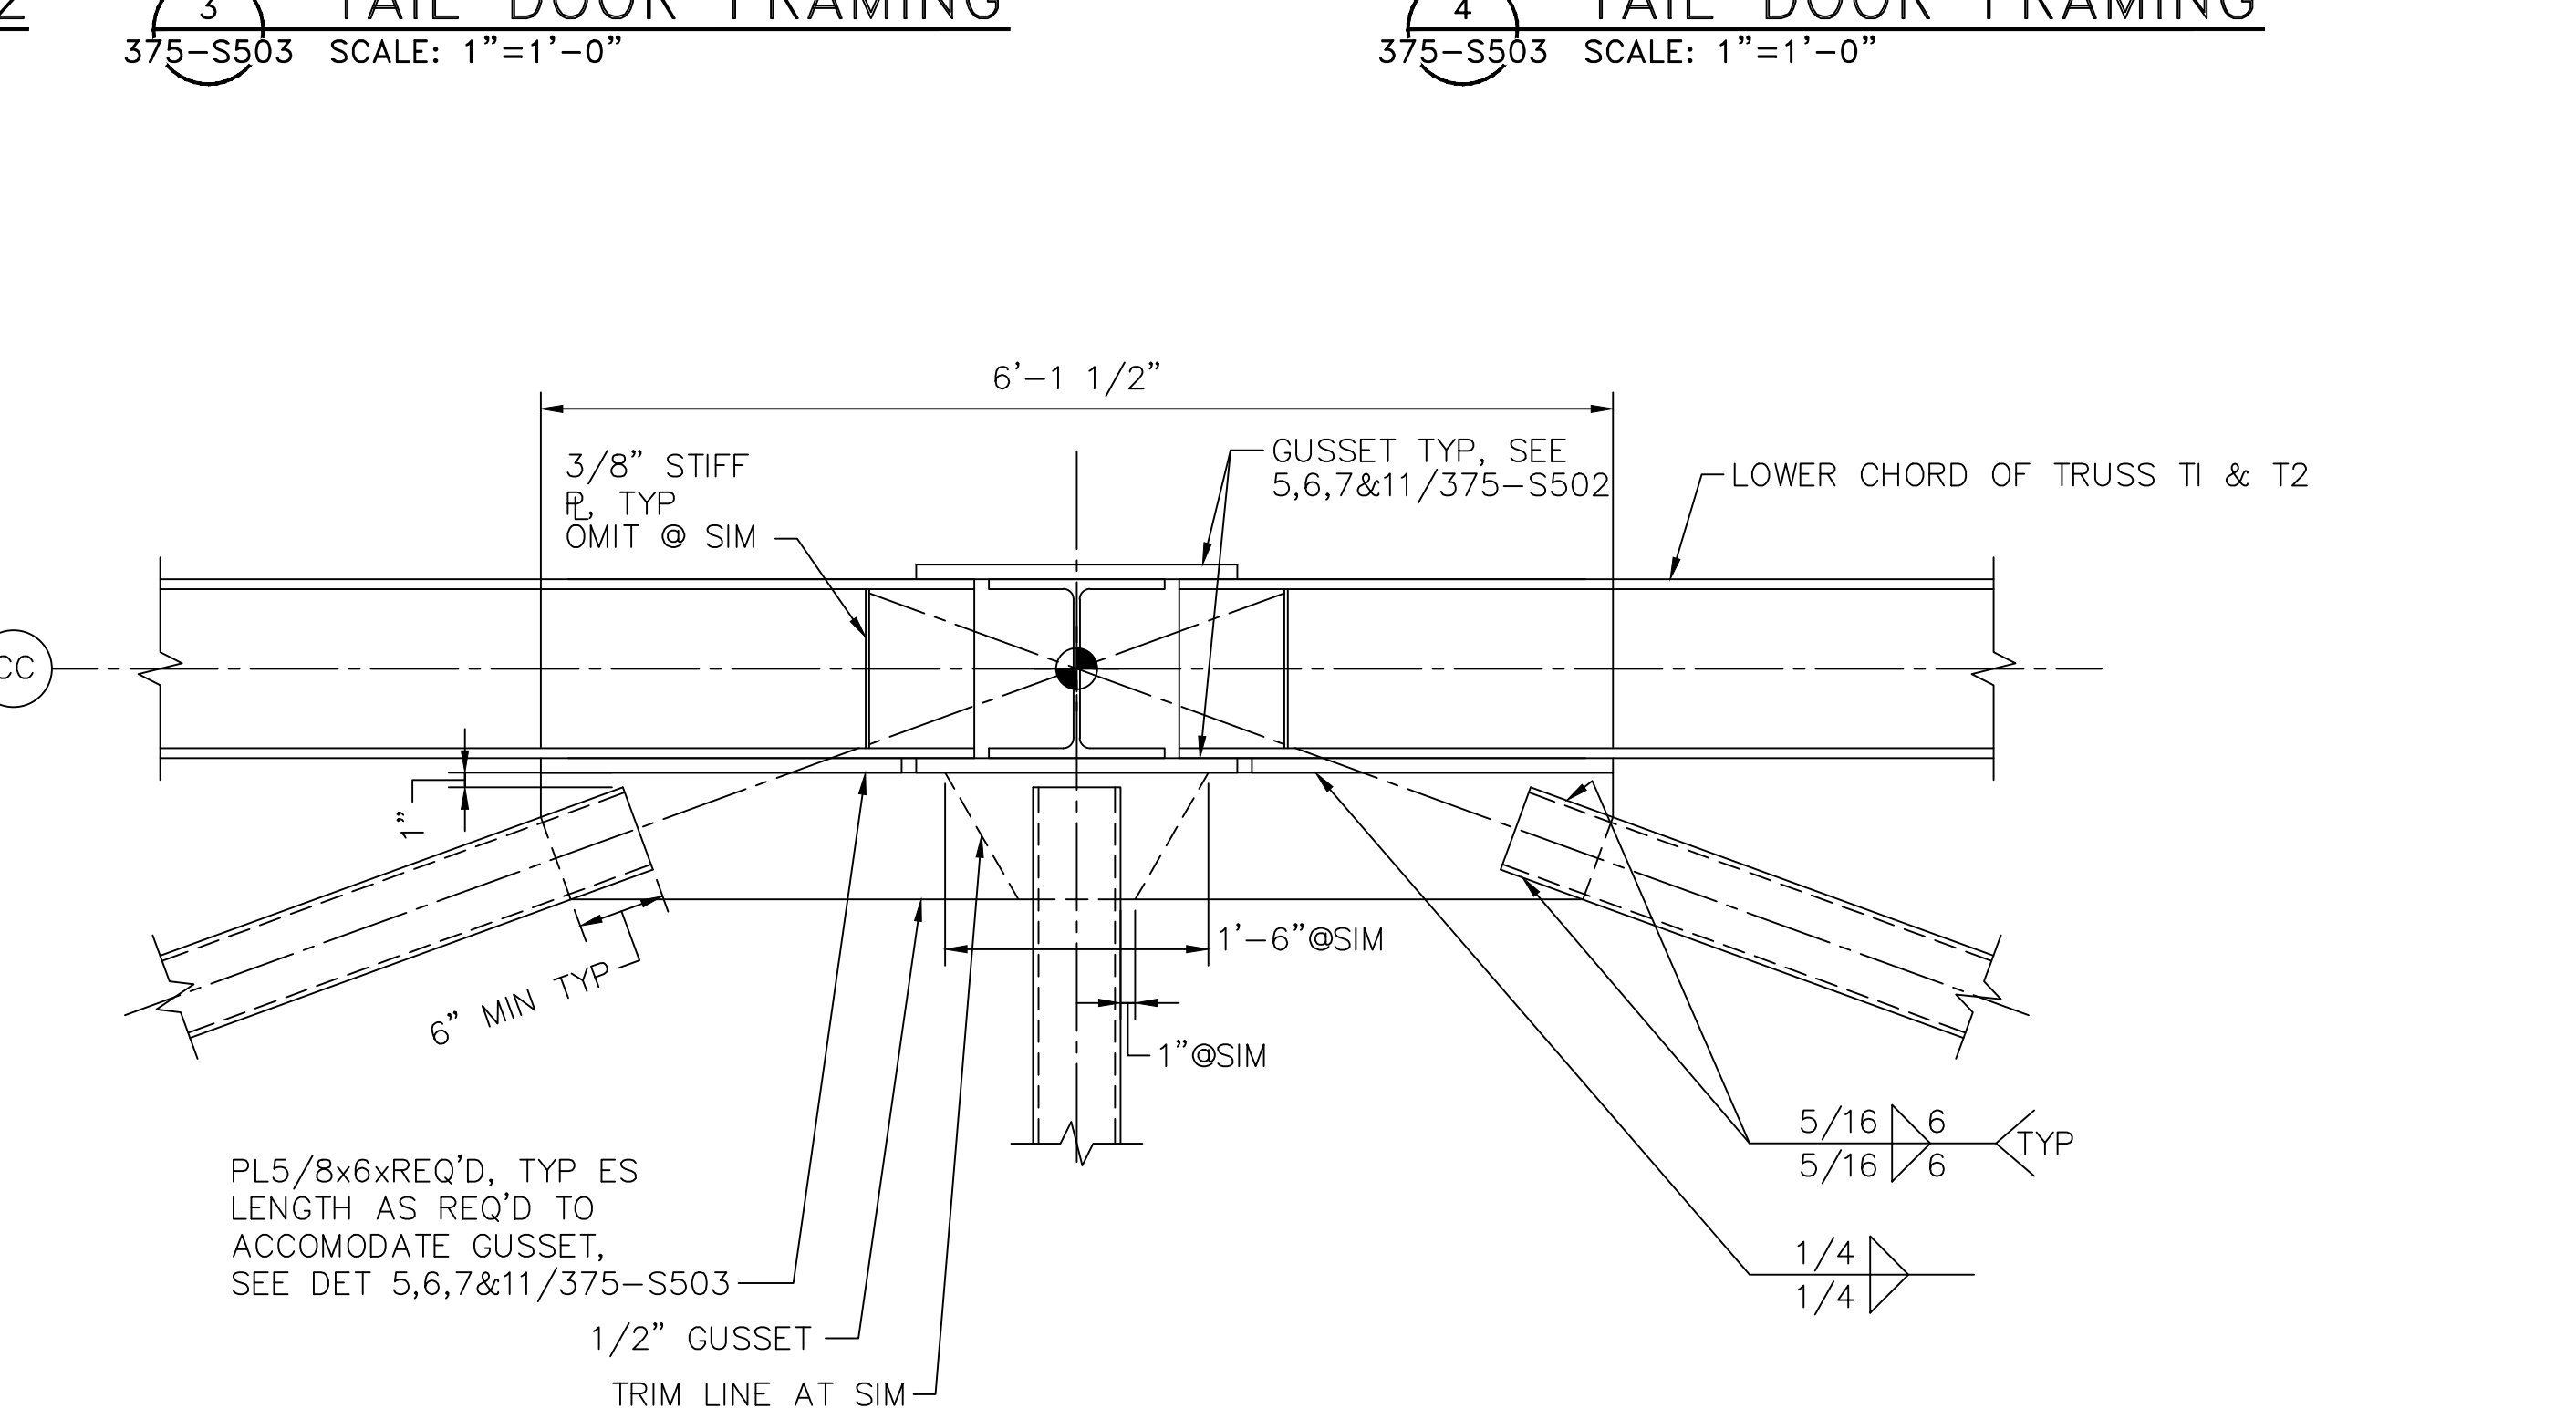


7 PLAN - LOWER CHORD BRACING TRUSS T1 & T2
375-S504 SCALE: 1"=1'-0"

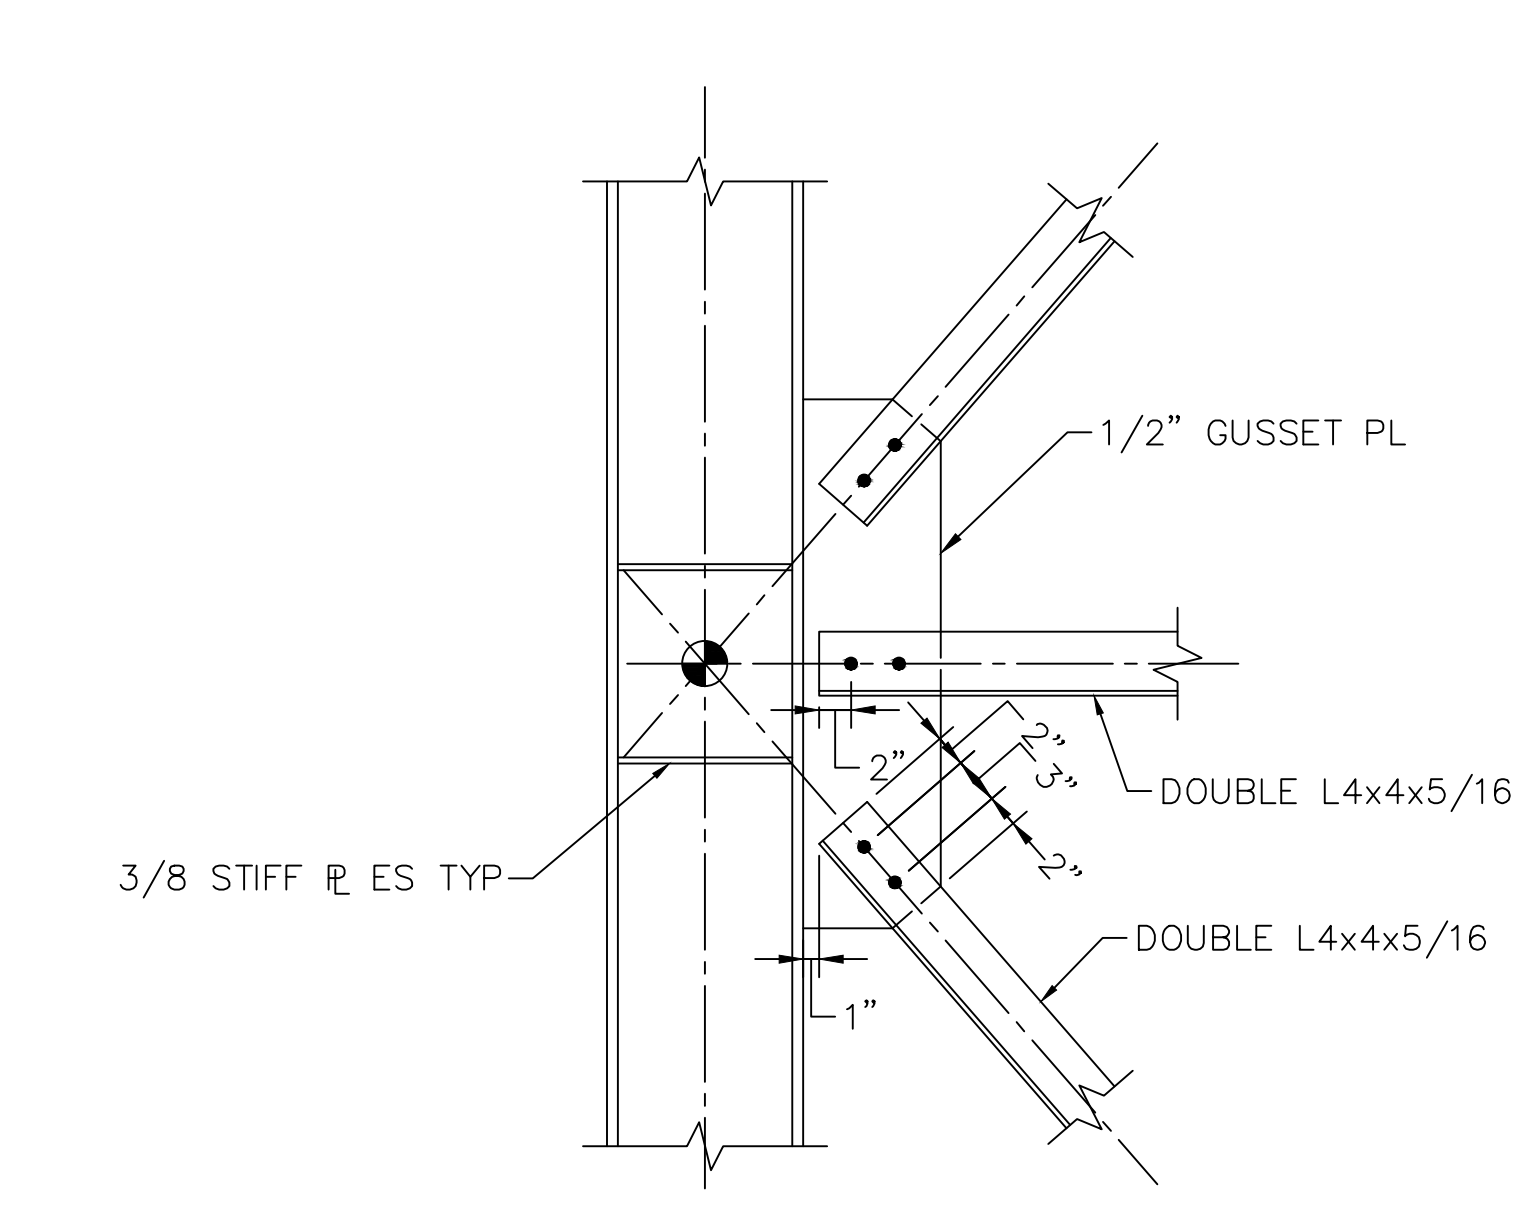


8 CONNECTION DETAIL AT BF4
375-S504 SCALE: 1"=1'-0"

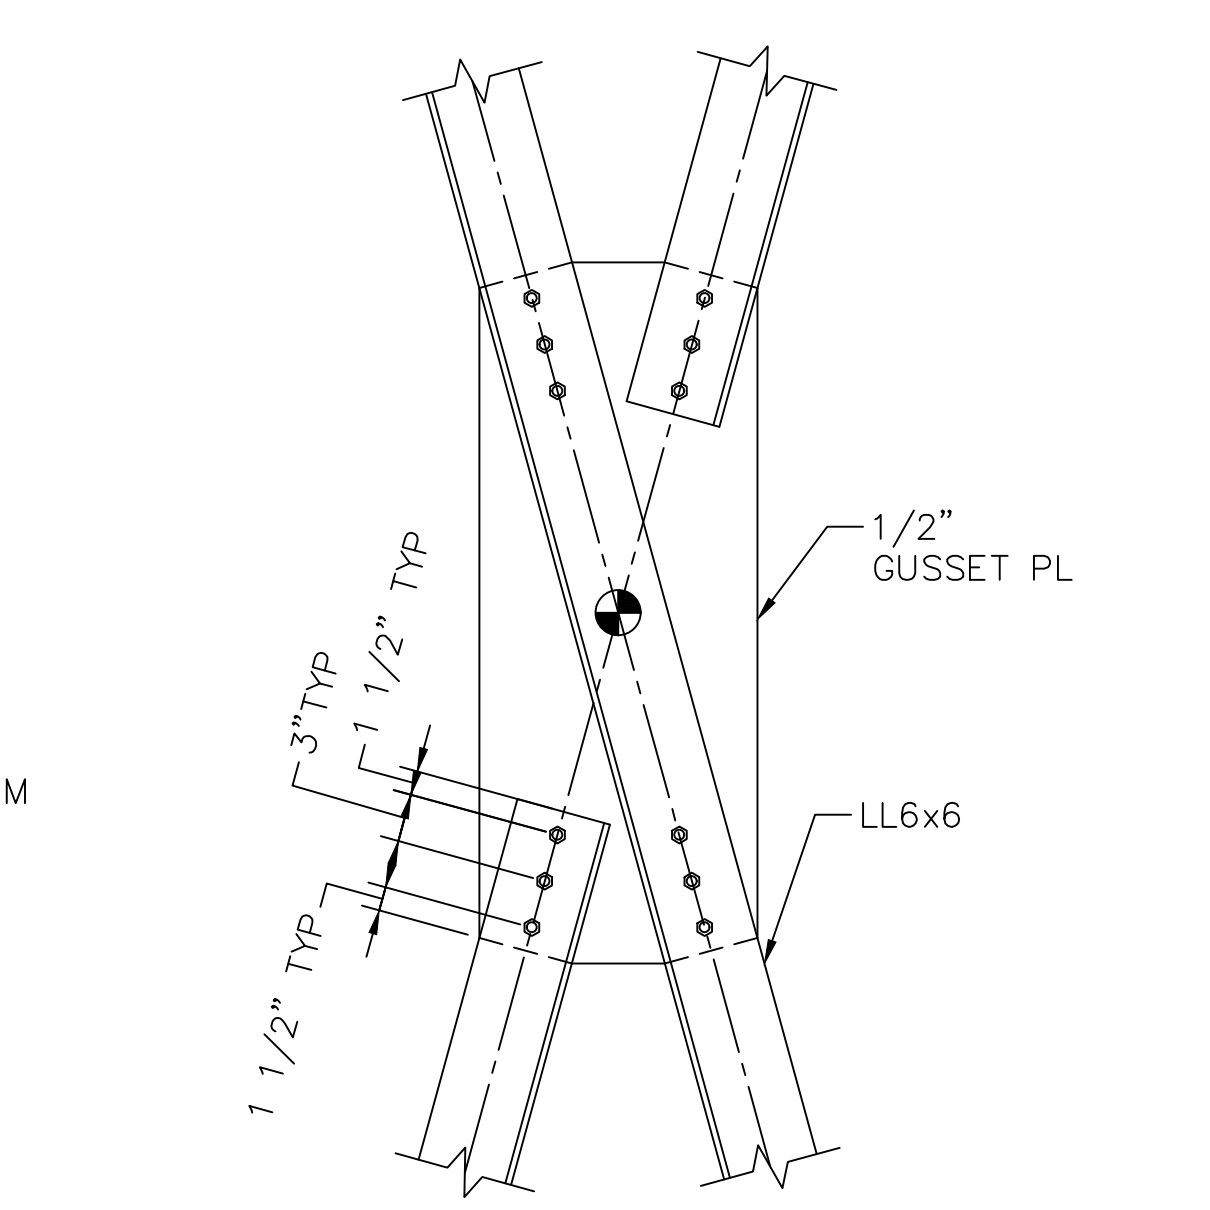


9 CONN @ LL TRUSS
375-S504 SCALE: 1"=1'-0"

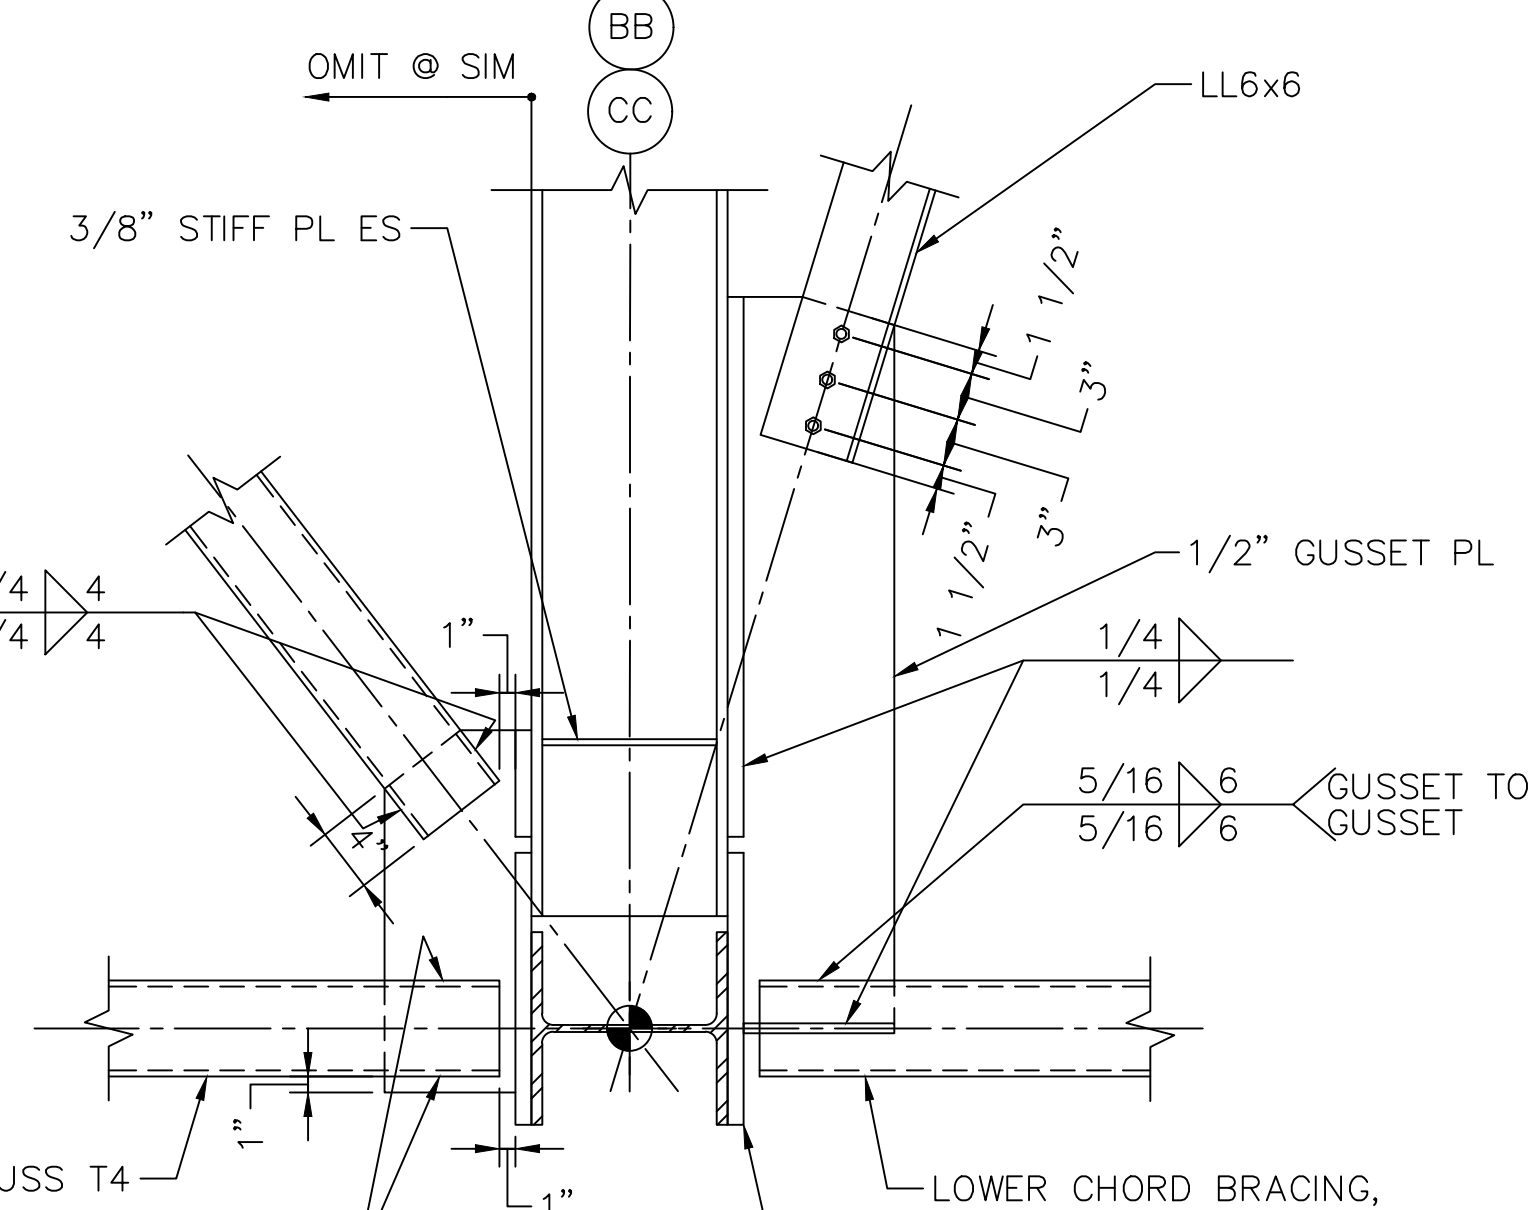

10 TRUSS T4 TO T2 & T3
375-S504 SCALE: 1"=1'-0"

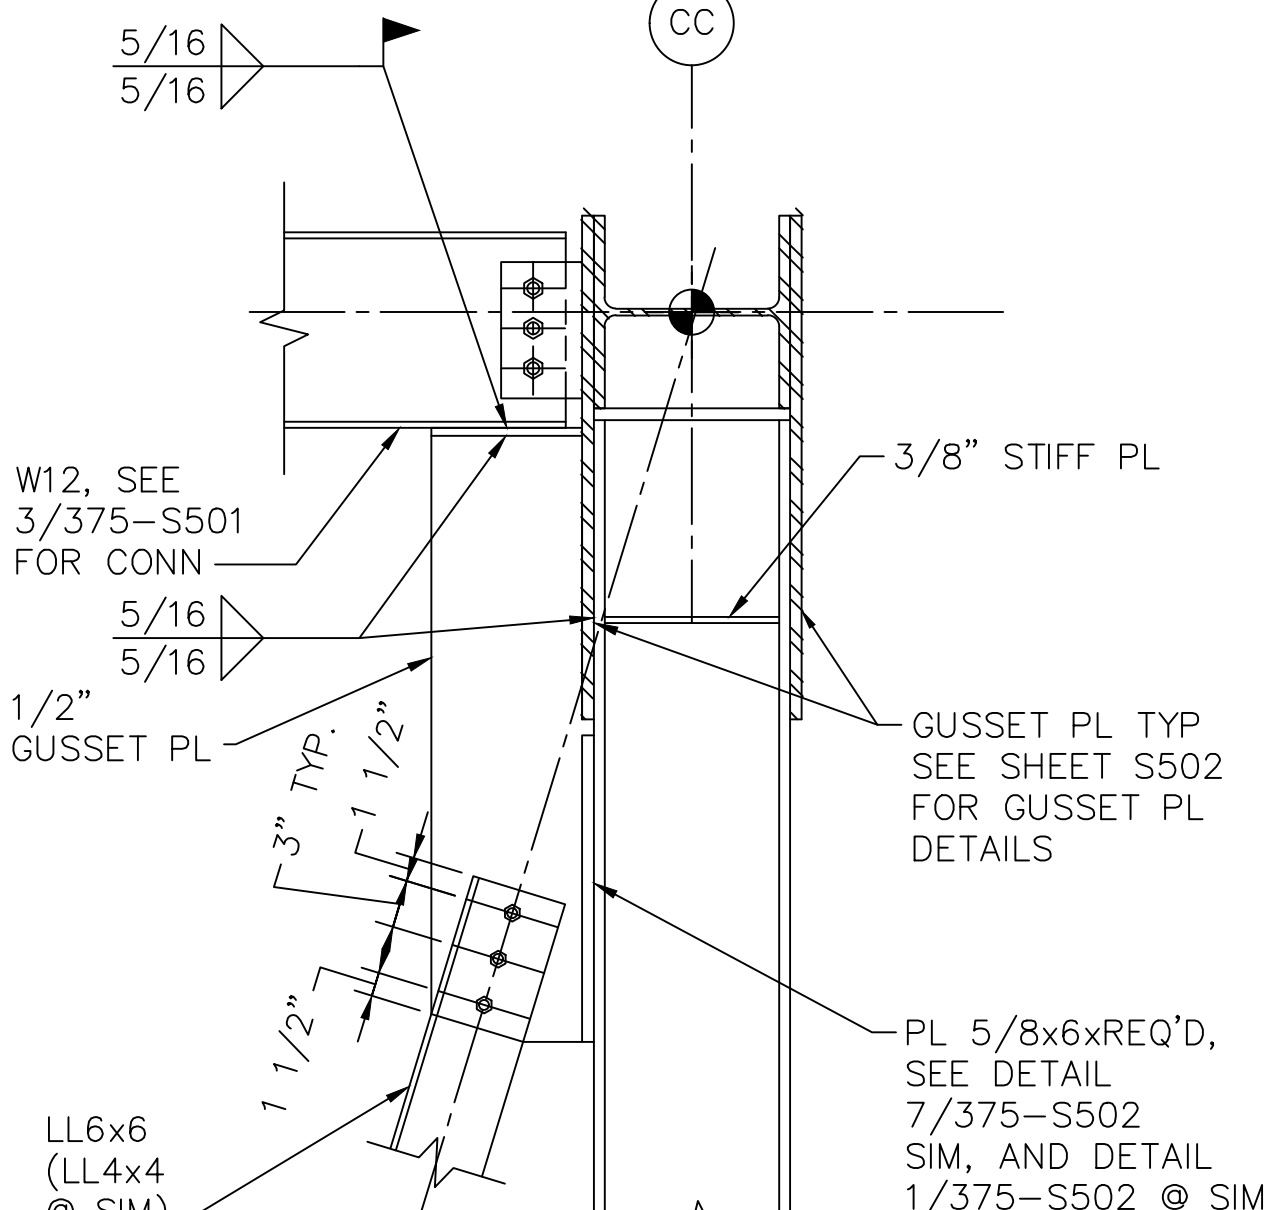


11 TRUSS T4 TO T1
375-S504 SCALE: 1"=1'-0"

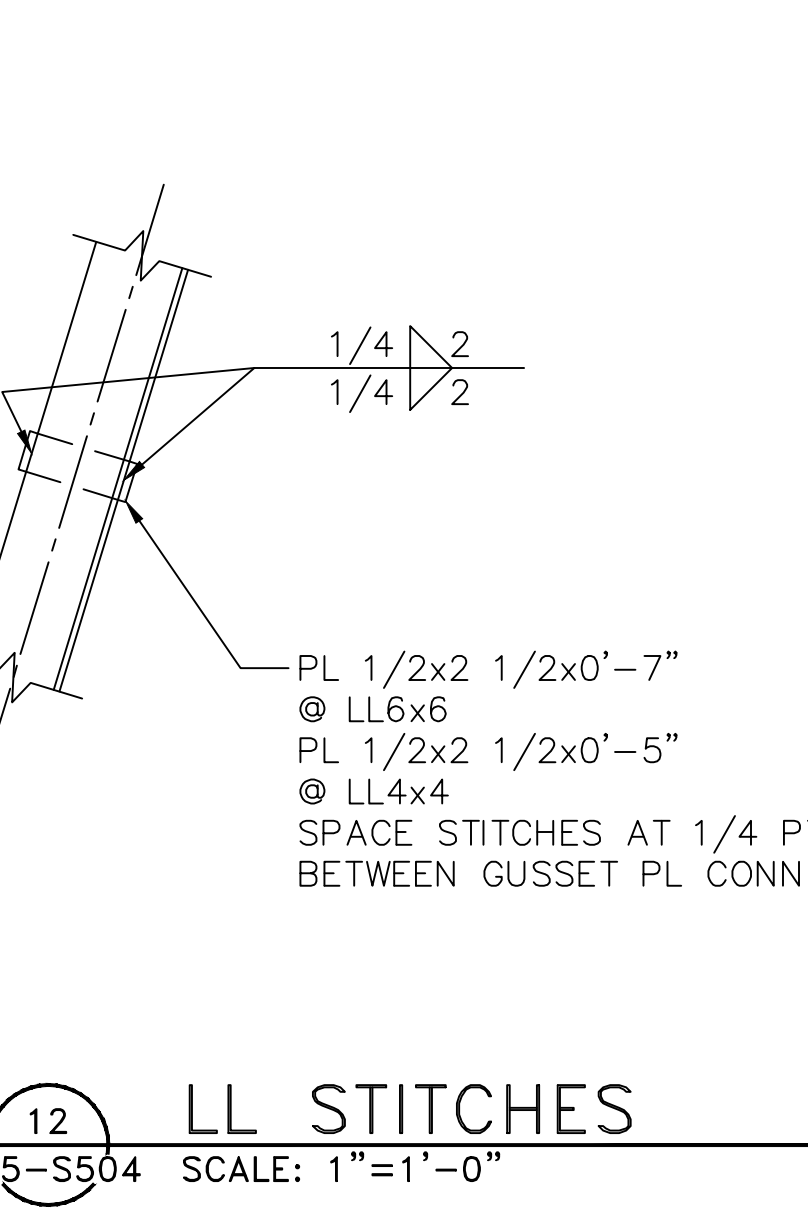

12 LL STITCHES
375-S504 SCALE: 1"=1'-0"

AFFF/FIRE ALARM SYSTEMS SEQUENCE OF OPERATIONS

SYSTEM OUTPUT	SYSTEM INPUT																
	MANUAL PULL STATIONS	OFFICE AREA SMOKE DETECTORS	OFFICE AREA HEAT DETECTORS	TEMPERATURE MONITOR	LOW BATTERY	AC POWER FAILURE	CIRCUIT FAULT	SUPERVISED COMPONENT FAILURE	SPRINKLER SYSTEM TAMPER SWITCH	SPRINKLER SYSTEM FLOW SWITCH	AFFF SYSTEM TAMPER SWITCH	AFFF SYSTEM FLOW SWITCH	HANGER EAST ZONE HEAT DETECTOR	HANGER WEST ZONE HEAT DETECTOR	AFFF LOW LEVEL MANUAL STATIONS	GAS DETECTOR	FLAME DETECTOR
AFFF PUMP START													X	X			
ACTIVATE AFFF EAST ZONE ROOF													X				
ACTIVATE AFFF WEST ZONE ROOF														X			
ACTIVATE AFFF LOW LEVEL												X	X	X			
ALARM @ FCP	X	X	X						X	X	X	X	X	X		X	
TRANSMIT ALARM TO D700 STATION	X	X	X						X	X	X	X	X	X		X	
TROUBLE @ FCP						X	X	X	X							X	
TRANSMIT TROUBLE TO D700 STATION						X	X	X	X							X	
SUPERVISORY @ FCP				X					X	X							
TRANSMIT SUPERVISORY TO D700 STATION				X					X	X							
ACTIVATE FCP NOTIFICATION DEVICES	X	X	X						X	X	X	X	X	X		X	
ACTIVATE ACP NOTIFICATION DEVICES										X	X	X	X	X		X	
FAN SHUTDOWN	X	X	X						X	X	X	X	X	X		X	

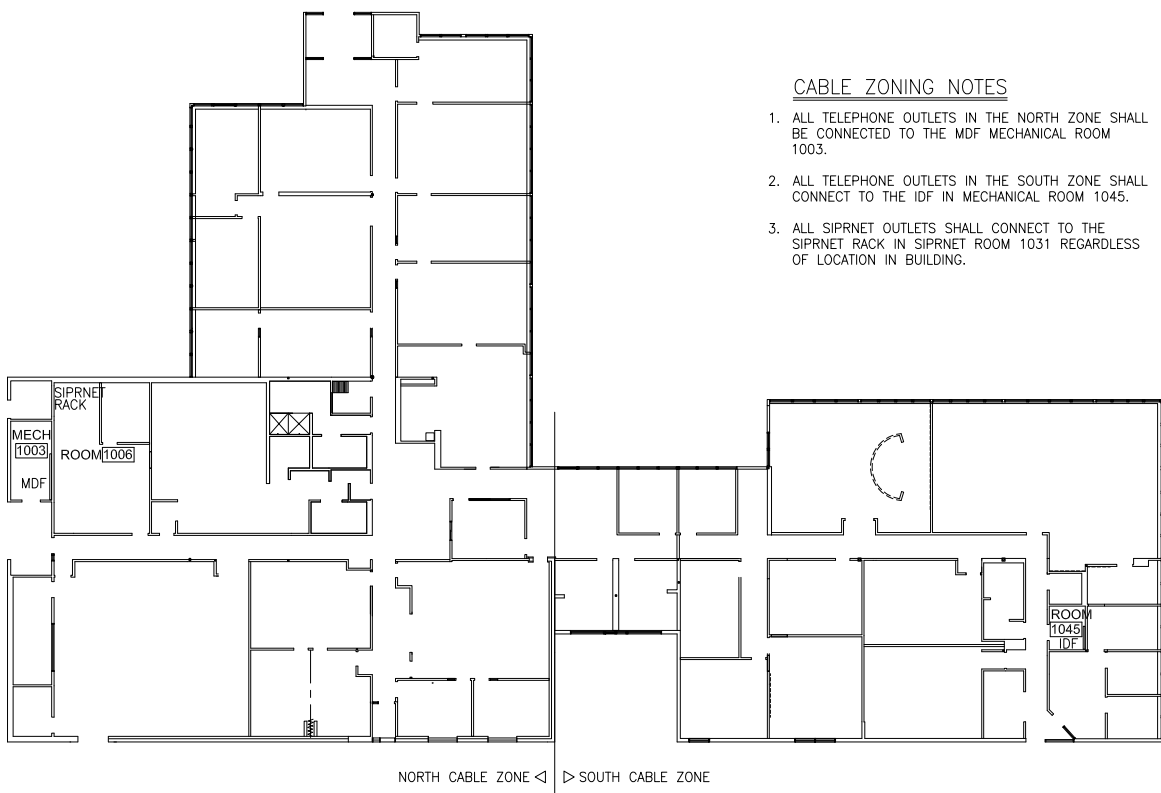


CABLE ZONING NOTES


- ALL TELEPHONE OUTLETS IN THE NORTH ZONE SHALL BE CONNECTED TO THE MDF MECHANICAL ROOM 1003.
- ALL TELEPHONE OUTLETS IN THE SOUTH ZONE SHALL CONNECT TO THE IDF IN MECHANICAL ROOM 1045.
- ALL SIPRNET OUTLETS SHALL CONNECT TO THE SIPRNET RACK IN SIPRNET ROOM 1031 REGARDLESS OF LOCATION IN BUILDING.

1 AFFF/FIRE ALARM SYSTEMS SEQUENCE OF OPERATIONS
6-E004 SCALE: NO SCALE (DETAIL TYPICAL OF BLDG 375)

2 CABLE ZONING
6-E004 SCALE: NO SCALE (DETAIL TYPICAL OF BLDG 304)

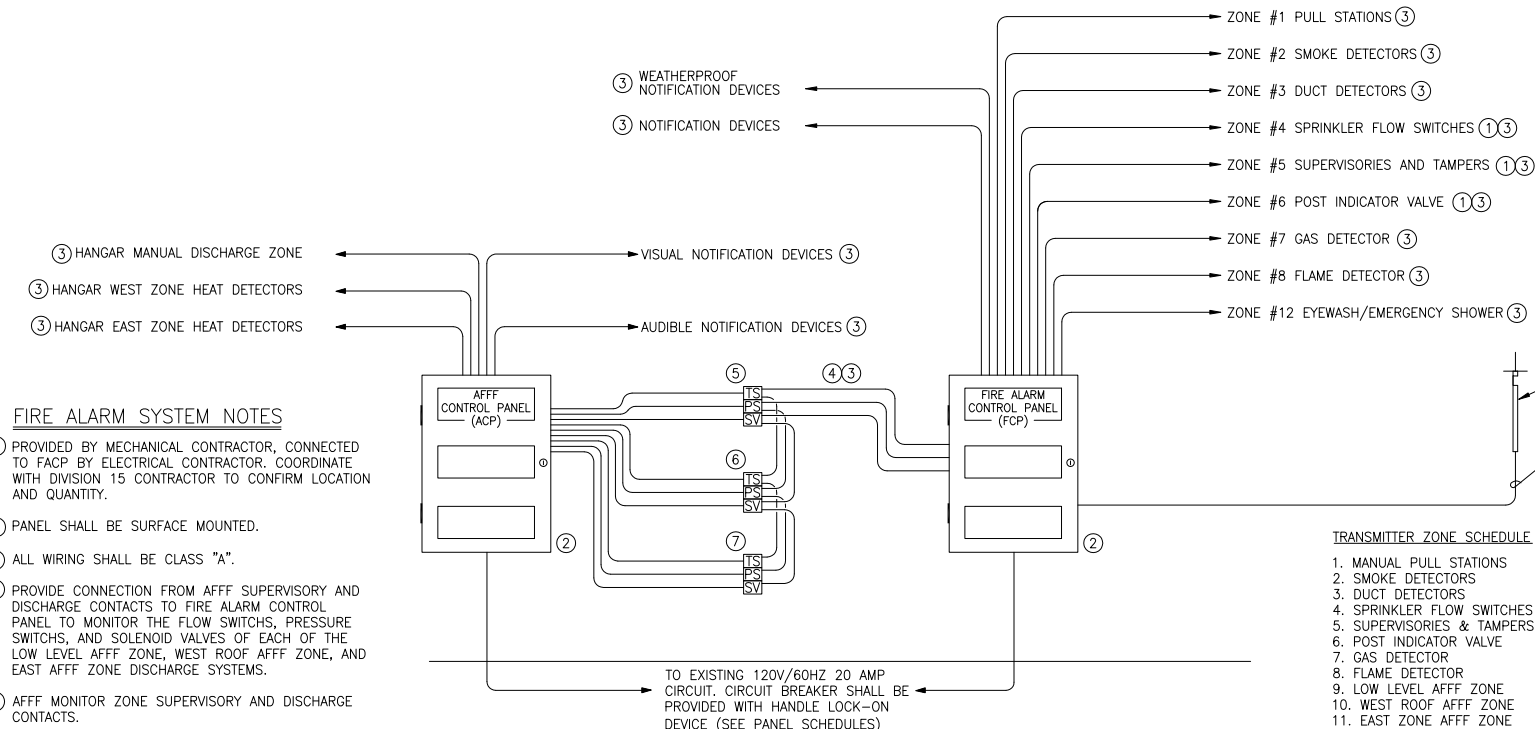

- FIRE ALARM SYSTEM NOTES
- PROVIDED BY MECHANICAL CONTRACTOR, CONNECTED TO FACP BY ELECTRICAL CONTRACTOR. COORDINATE WITH DIVISION 15 CONTRACTOR TO CONFIRM LOCATION AND QUANTITY.
 - PANEL SHALL BE SURFACE MOUNTED.
 - ALL WIRING SHALL BE CLASS "A".
 - PROVIDE CONNECTION FROM AFFF SUPERVISORY AND DISCHARGE CONTACTS TO FIRE ALARM CONTROL PANEL TO MONITOR THE FLOW SWITCHES, PRESSURE SWITCHES, AND SOLENOID VALVES OF EACH OF THE LOW LEVEL AFFF ZONE, WEST ROOF AFFF ZONE, AND EAST AFFF ZONE DISCHARGE SYSTEMS.
 - AFFF MONITOR ZONE SUPERVISORY AND DISCHARGE CONTACTS.
 - AFFF WEST ZONE SUPERVISORY AND DISCHARGE CONTACTS.
 - AFFF EAST ZONE SUPERVISORY AND DISCHARGE CONTACTS.

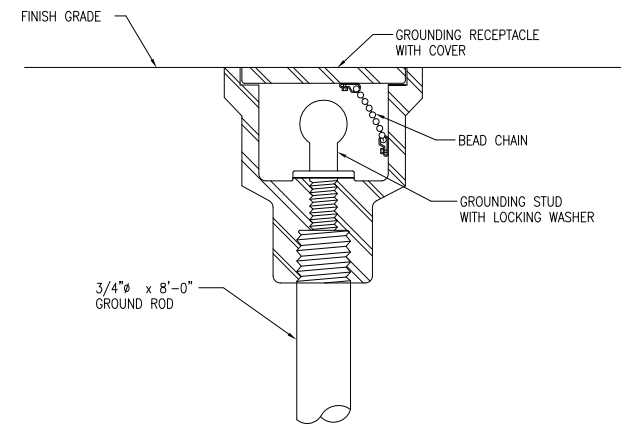

3 AFFF/FIRE ALARM SYSTEMS RISER DIAGRAM
6-E004 SCALE: NO SCALE (DETAIL TYPICAL OF BLDG 375)

4 GROUNDING RECEPTACLE DETAIL
6-E004 SCALE: NO SCALE (DETAIL TYPICAL OF BLDG 375)

Date	Description	Appr.

Designed by: RAA	Drawn by: BRH	Checked by: DAB	Submitted by: Chief
Date: 01/20/04	Design file no. 3125/211-10-02		Section

ADD/ALTER FLIGHTLINE FACILITIES BLDG 304 & 375
PORTLAND ANG, OREGON
FY04 PN TOKD 012259



ELECTRICAL DETAILS AND DIAGRAMS

GENERAL NOTES

- 1. PROVIDE GROUND WIRE IN ALL CONDUITS PER DETAIL 3 PLATE G-E003.

CONSTRUCTION NOTES

- ① REINSTALL EXISTING FIXTURES TO NEW ADDITION, CONNECT TO EXISTING CIRCUITS, AND PROVIDE NEW LAMPS.
- ② PROVIDE JUNCTION BOX AND INTERCEPT EXISTING HOMERUN. RETAIN EXISTING HOMERUN AND LIGHTING CONTROL.
- ③ REPLACE EXISTING LIGHT FIXTURES. REUSE EXISTING CONDUIT, CONDUCTORS AND SWITCHING.

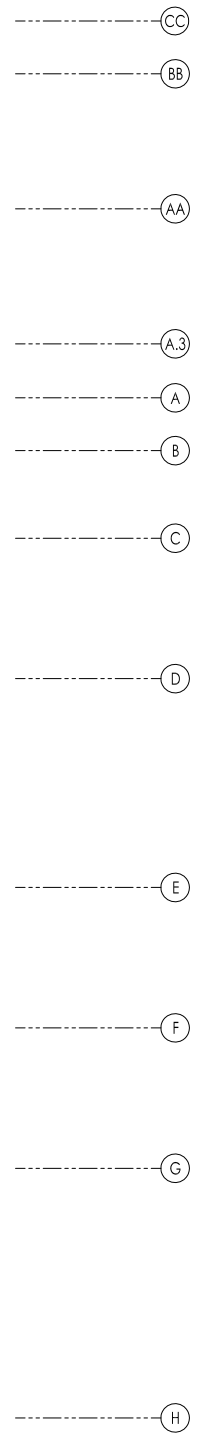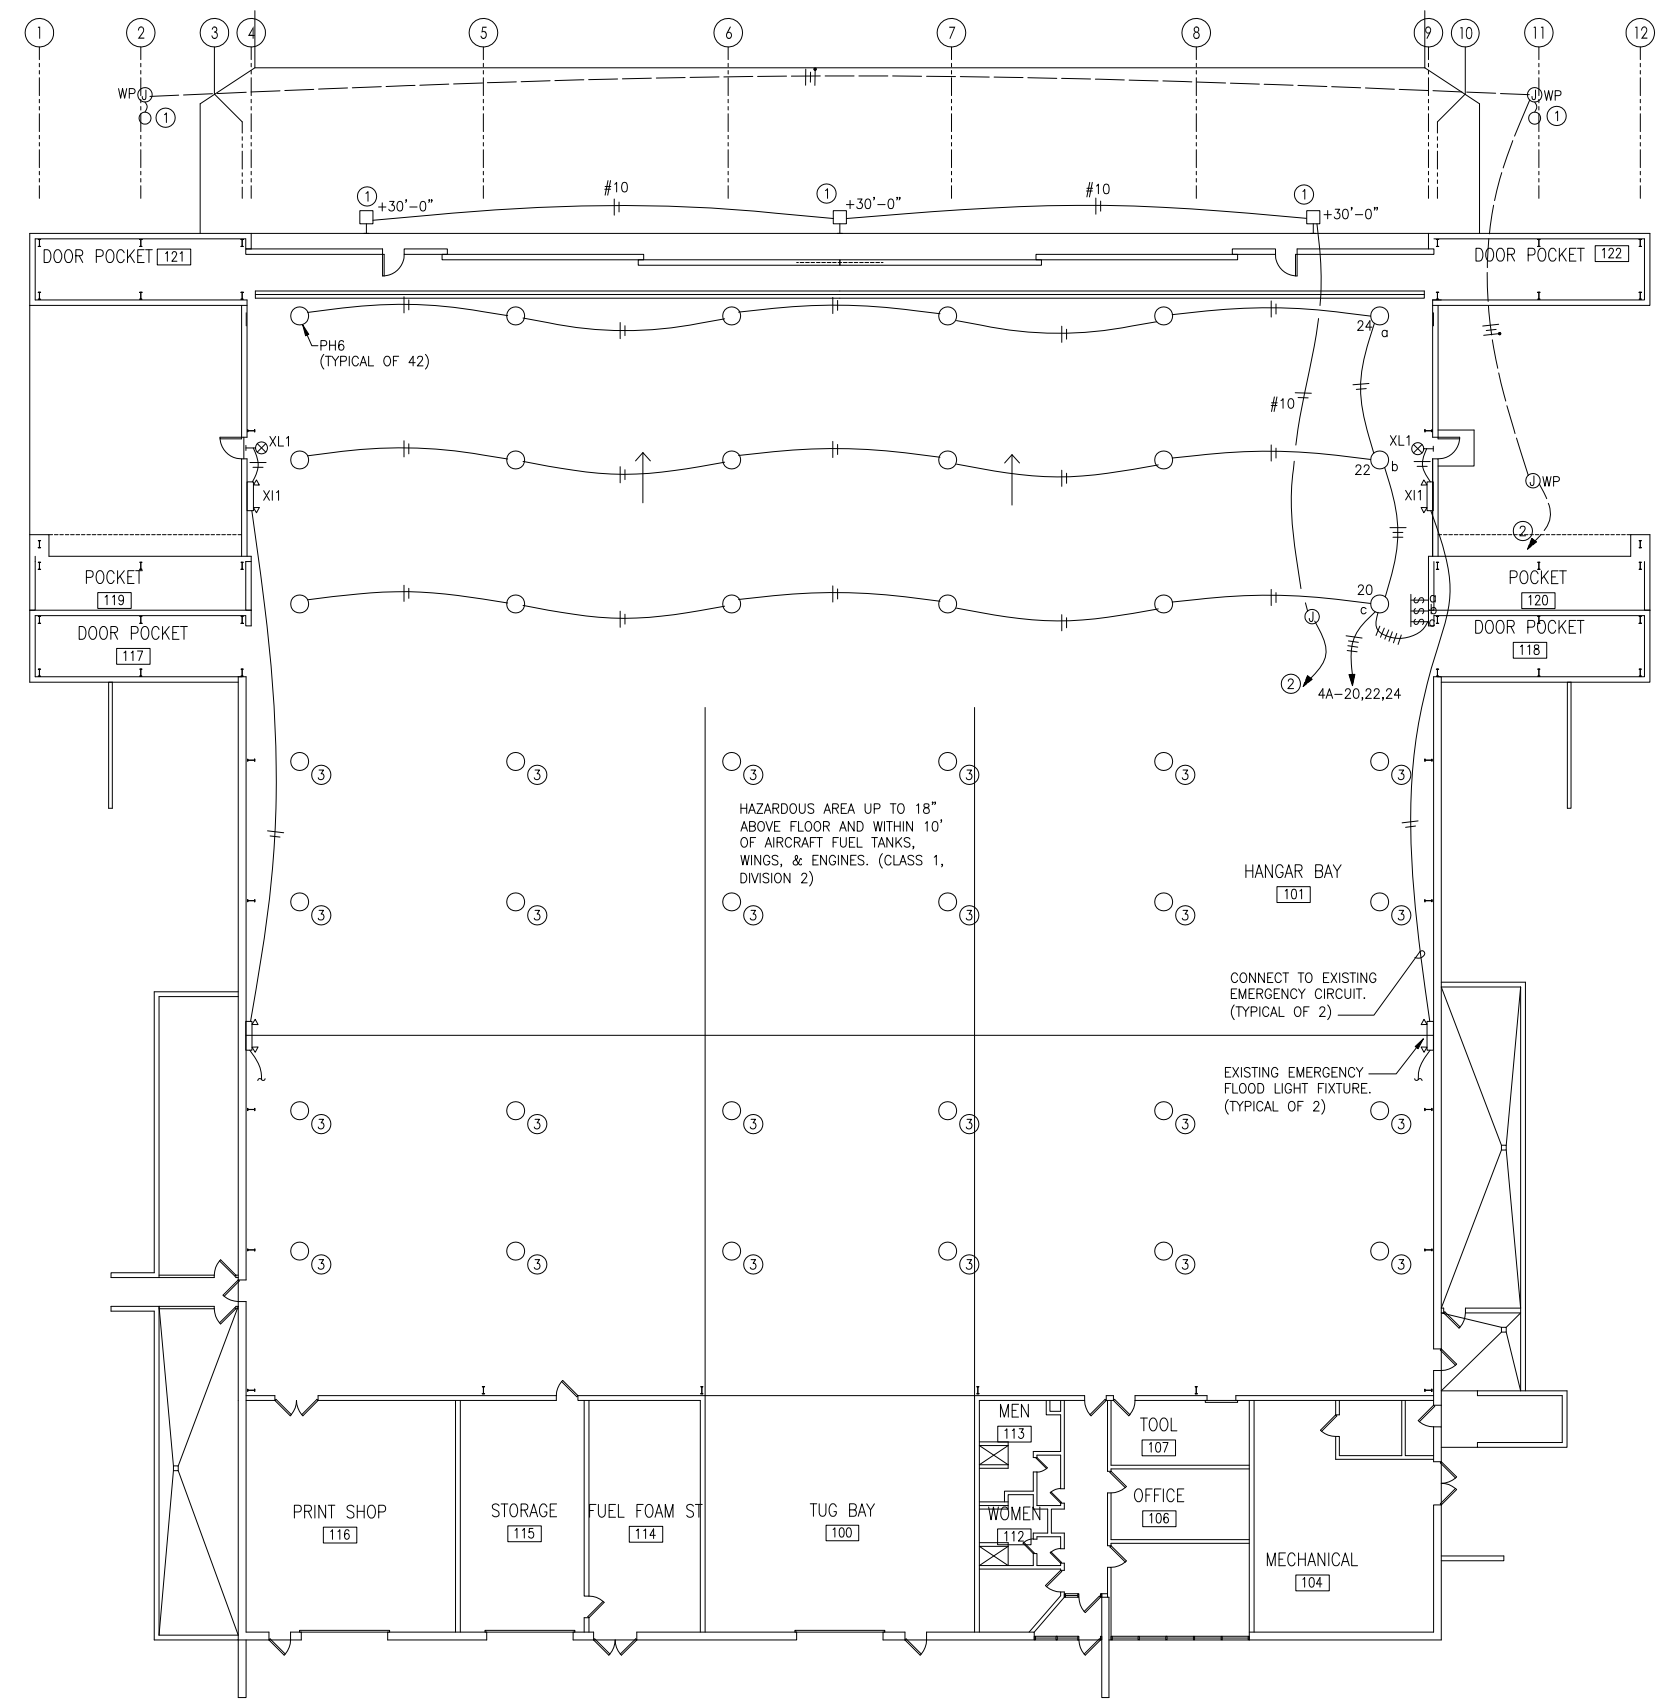

1 LIGHTING FLOOR PLAN
375-E102 SCALE: 3/32" = 1'-0"



3/32"=1'-0" scale feet

Designed by: RAA	Date: 01/30/04
Drawn by: BRH	Design file no. 3125/211-10-02
Checked by: DWB	
Submitted by: Chief	Section

ADD/ALTER FLIGHTLINE FACILITIES BLDG 304 & 375
PORTLAND ANG, OREGON
FY04 PN TOKD 012259
LIGHTING FLOOR PLAN



PLATE NUMBER:
375-E102

GENERAL NOTES


- PROVIDE GROUND WIRE IN ALL CONDUITS PER DETAIL 3 PLATE G-E003.

CONSTRUCTION NOTES


- REINSTALL AND REWIRE MOTORS AND CONTROLS AT NEW HANGAR DOOR LOCATION TO EXISTING CIRCUITING. PROVIDE CONDUIT AND WIRING AS REQUIRED.
- REINSTALL EXISTING CAMERA IN NEW LOCATION TO EXISTING CIRCUITING. PROVIDE CONDUIT AND WIRING AS REQUIRED.
- EXISTING ELECTRICAL AND COMMUNICATION ROOMS. SEE PARTIAL FLOOR PLAN THIS SHEET FOR DETAIL.
- MONITORING DEVICES FOR OFFICE AREA SPINKLER SYSTEM.
- MONITORING DEVICES FOR LOW LEVEL AFFF ZONE.
- MONITORING DEVICES FOR WEST ROOF AFFF ZONE.
- MONITORING DEVICES FOR EAST ROOF AFFF ZONE.
- ROUTE TO EXISTING PANEL 2B. PROVIDE 1P-20A CIRCUIT BREAKER TO MATCH EXISTING.
- CONNECT TO EXISTING CIRCUIT BREAKER IN PANELS.
- INTERCEPT EXISTING CIRCUITING FOR HANGAR DOOR MOTOR AND EXTEND TO NEW DOOR LOCATION. RETAIN EXISTING HOMERUN TO PANELS.
- INTERCEPT & EXTEND EXISTING CIRCUIT TO NEW RECEPTACLES.
- EXHAUST FAN OVERRIDE SWITCH ON WALL AT +48".
- REPLACE EXISTING FIRE ALARM/AFFF DEVICE AND CONNECT TO FIRE ALARM CONTROL PANEL OR AFFF CONTROL PANEL AS REQUIRED.
- RETAIN EXISTING AFFF HORN AND INSTALL A NEW BLUE STROBE. CONNECT TO AFFF CONTROL PANEL.

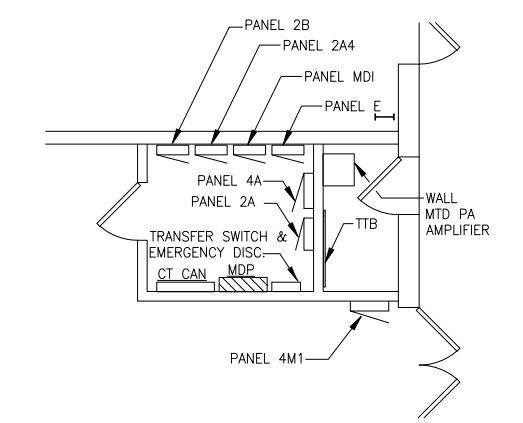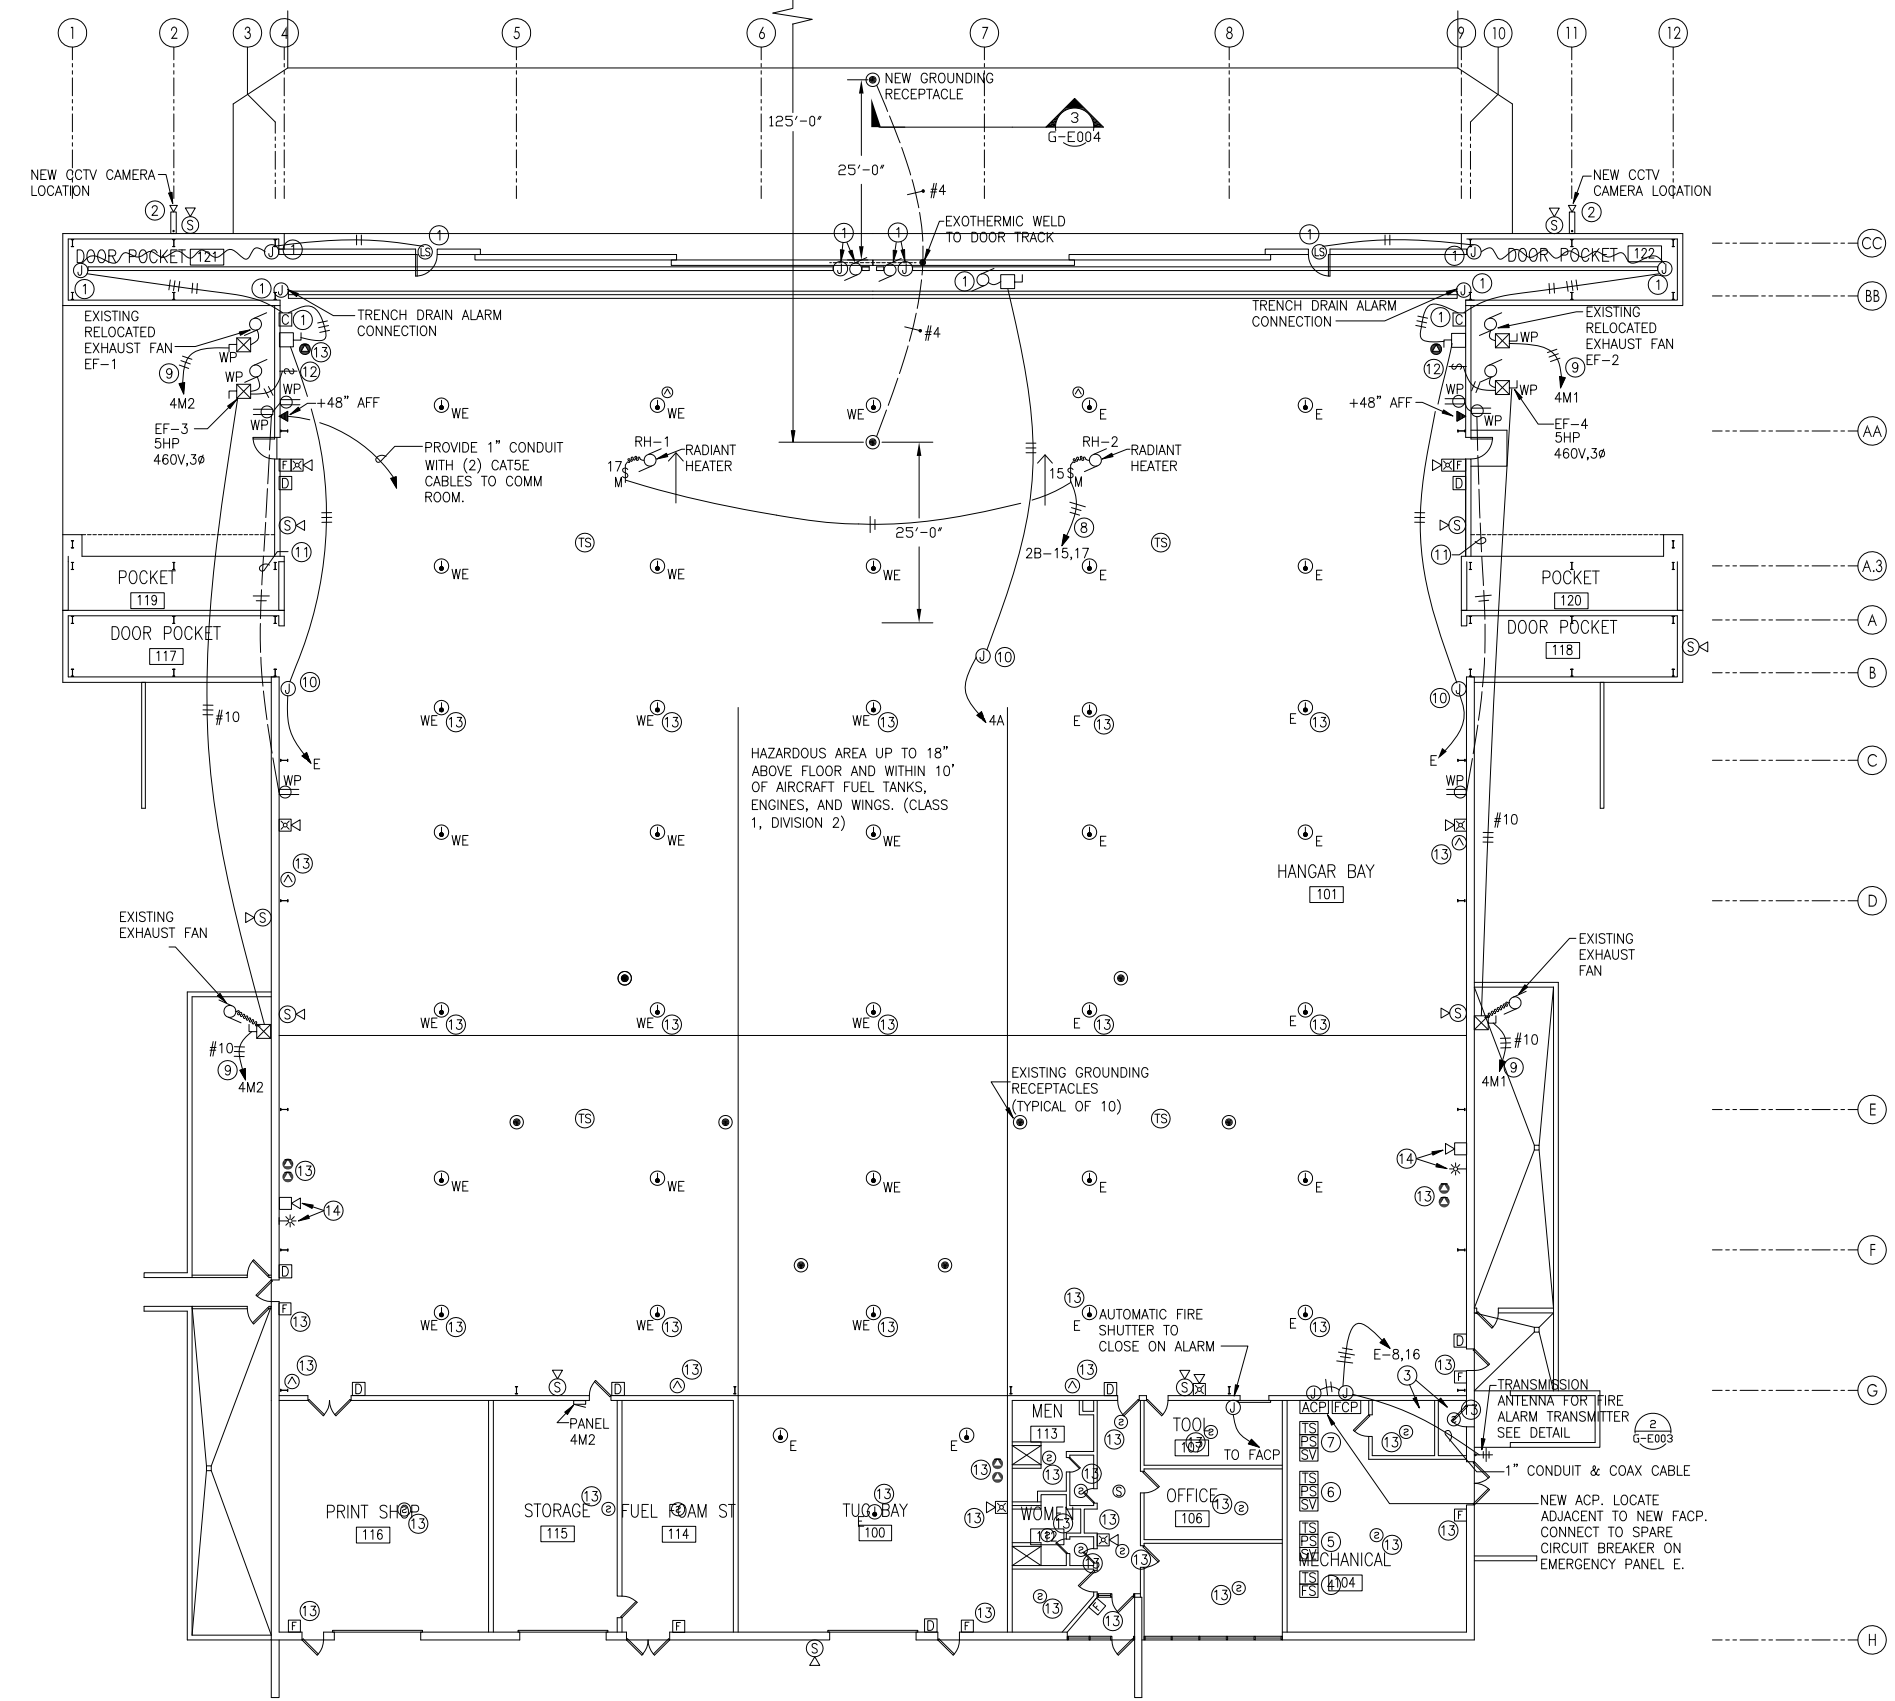

2 PARTIAL FLOOR PLAN

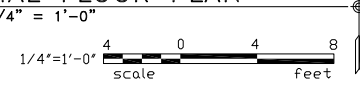

1 POWER & SYSTEMS FLOOR PLAN
375-E103 SCALE: 3/32" = 1'-0"

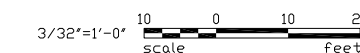

Date	Description	Symbol

U.S. ARMY ENGINEER DISTRICT, SEATTLE CORPS OF ENGINEERS	Designed by: RAA	Date: 01/20/04
SEATTLE, WASHINGTON	Drawn by: BRH	Design file no. 3102/211-10-02
Principal BERGER / ABAM ENGINEERS INC. (206) 374-9700 Fax:(206) 374-9795	Checked by: DMB	Submitted by: CMB
Section		

ADD/ALTER FLIGHTLINE FACILITIES BLDGS 304 & 375
PORTLAND ANG, OREGON
FY04 PN TOKD 012259

PLATE NUMBER:
375-E103

Symbol	Description	Date	Author

Designed by: ABC Drawn by: ACE Checked by: ABC Submitted by: ABC	Date: 07/20/2004 Design file no.: 1125/211-10-02
U.S. ARMY ENGINEER DISTRICT SEATTLE CORPS OF ENGINEERS SEATTLE, WASHINGTON	BERGER/ABAM ENGINEERS (206) 374-9999 FAX:(206) 374-9999 Principal

ADD/ALTER FLIGHTLINE FACILITIES BLDG 304 & 375
 PORTLAND, OREGON
 FY04 PN TOKD 012259


HVAC AND PLUMBING DEMOLITION PLAN

PLATE NUMBER:
375-M101


Sheet 66 of 76

- DEMOLITION NOTES**
- 1 DISCONNECT EXISTING EXHAUST DUCT FROM TRENCH DRAIN TO BE REMOVED. CAP OPENING WITH A MINIMUM 20 GAUGE SHEETMETAL CAP, FILL DUCT OPENING WITH CONCRETE.
 - 2 REMOVE EXISTING TRENCH DRAIN VENTILATION DUCT DOWN TO FLOOR CAP MINIMUM 2" BELOW FLOOR WITH A 20 GAUGE SHEETMETAL CAP.
 - 3 REMOVE AND RELOCATE EXISTING EXHAUST FANS.
 - 4 REMOVE EXISTING 16"Ø FLEX. DUCT DROPS AND CAP AIR TIGHT.
 - 5 CAP EXISTING 10" WASTE FROM TRENCH DRAIN TO BE REMOVED.
 - 6 REMOVE EXISTING HOSE REELS, VALVE AND CAP OPENINGS. RETAIN REELS FOR REINSTALLATION.
 - 7 REMOVE ALL PIPING WITHIN HATCHED AREA.

REMOVE EXISTING TRENCH DRAIN PATCH TO MATCH SURROUNDING SURFACE AND LEVEL. SEE ARCHITECTURAL PLANS FOR REQUIREMENTS. CAP PIPE OPENINGS.

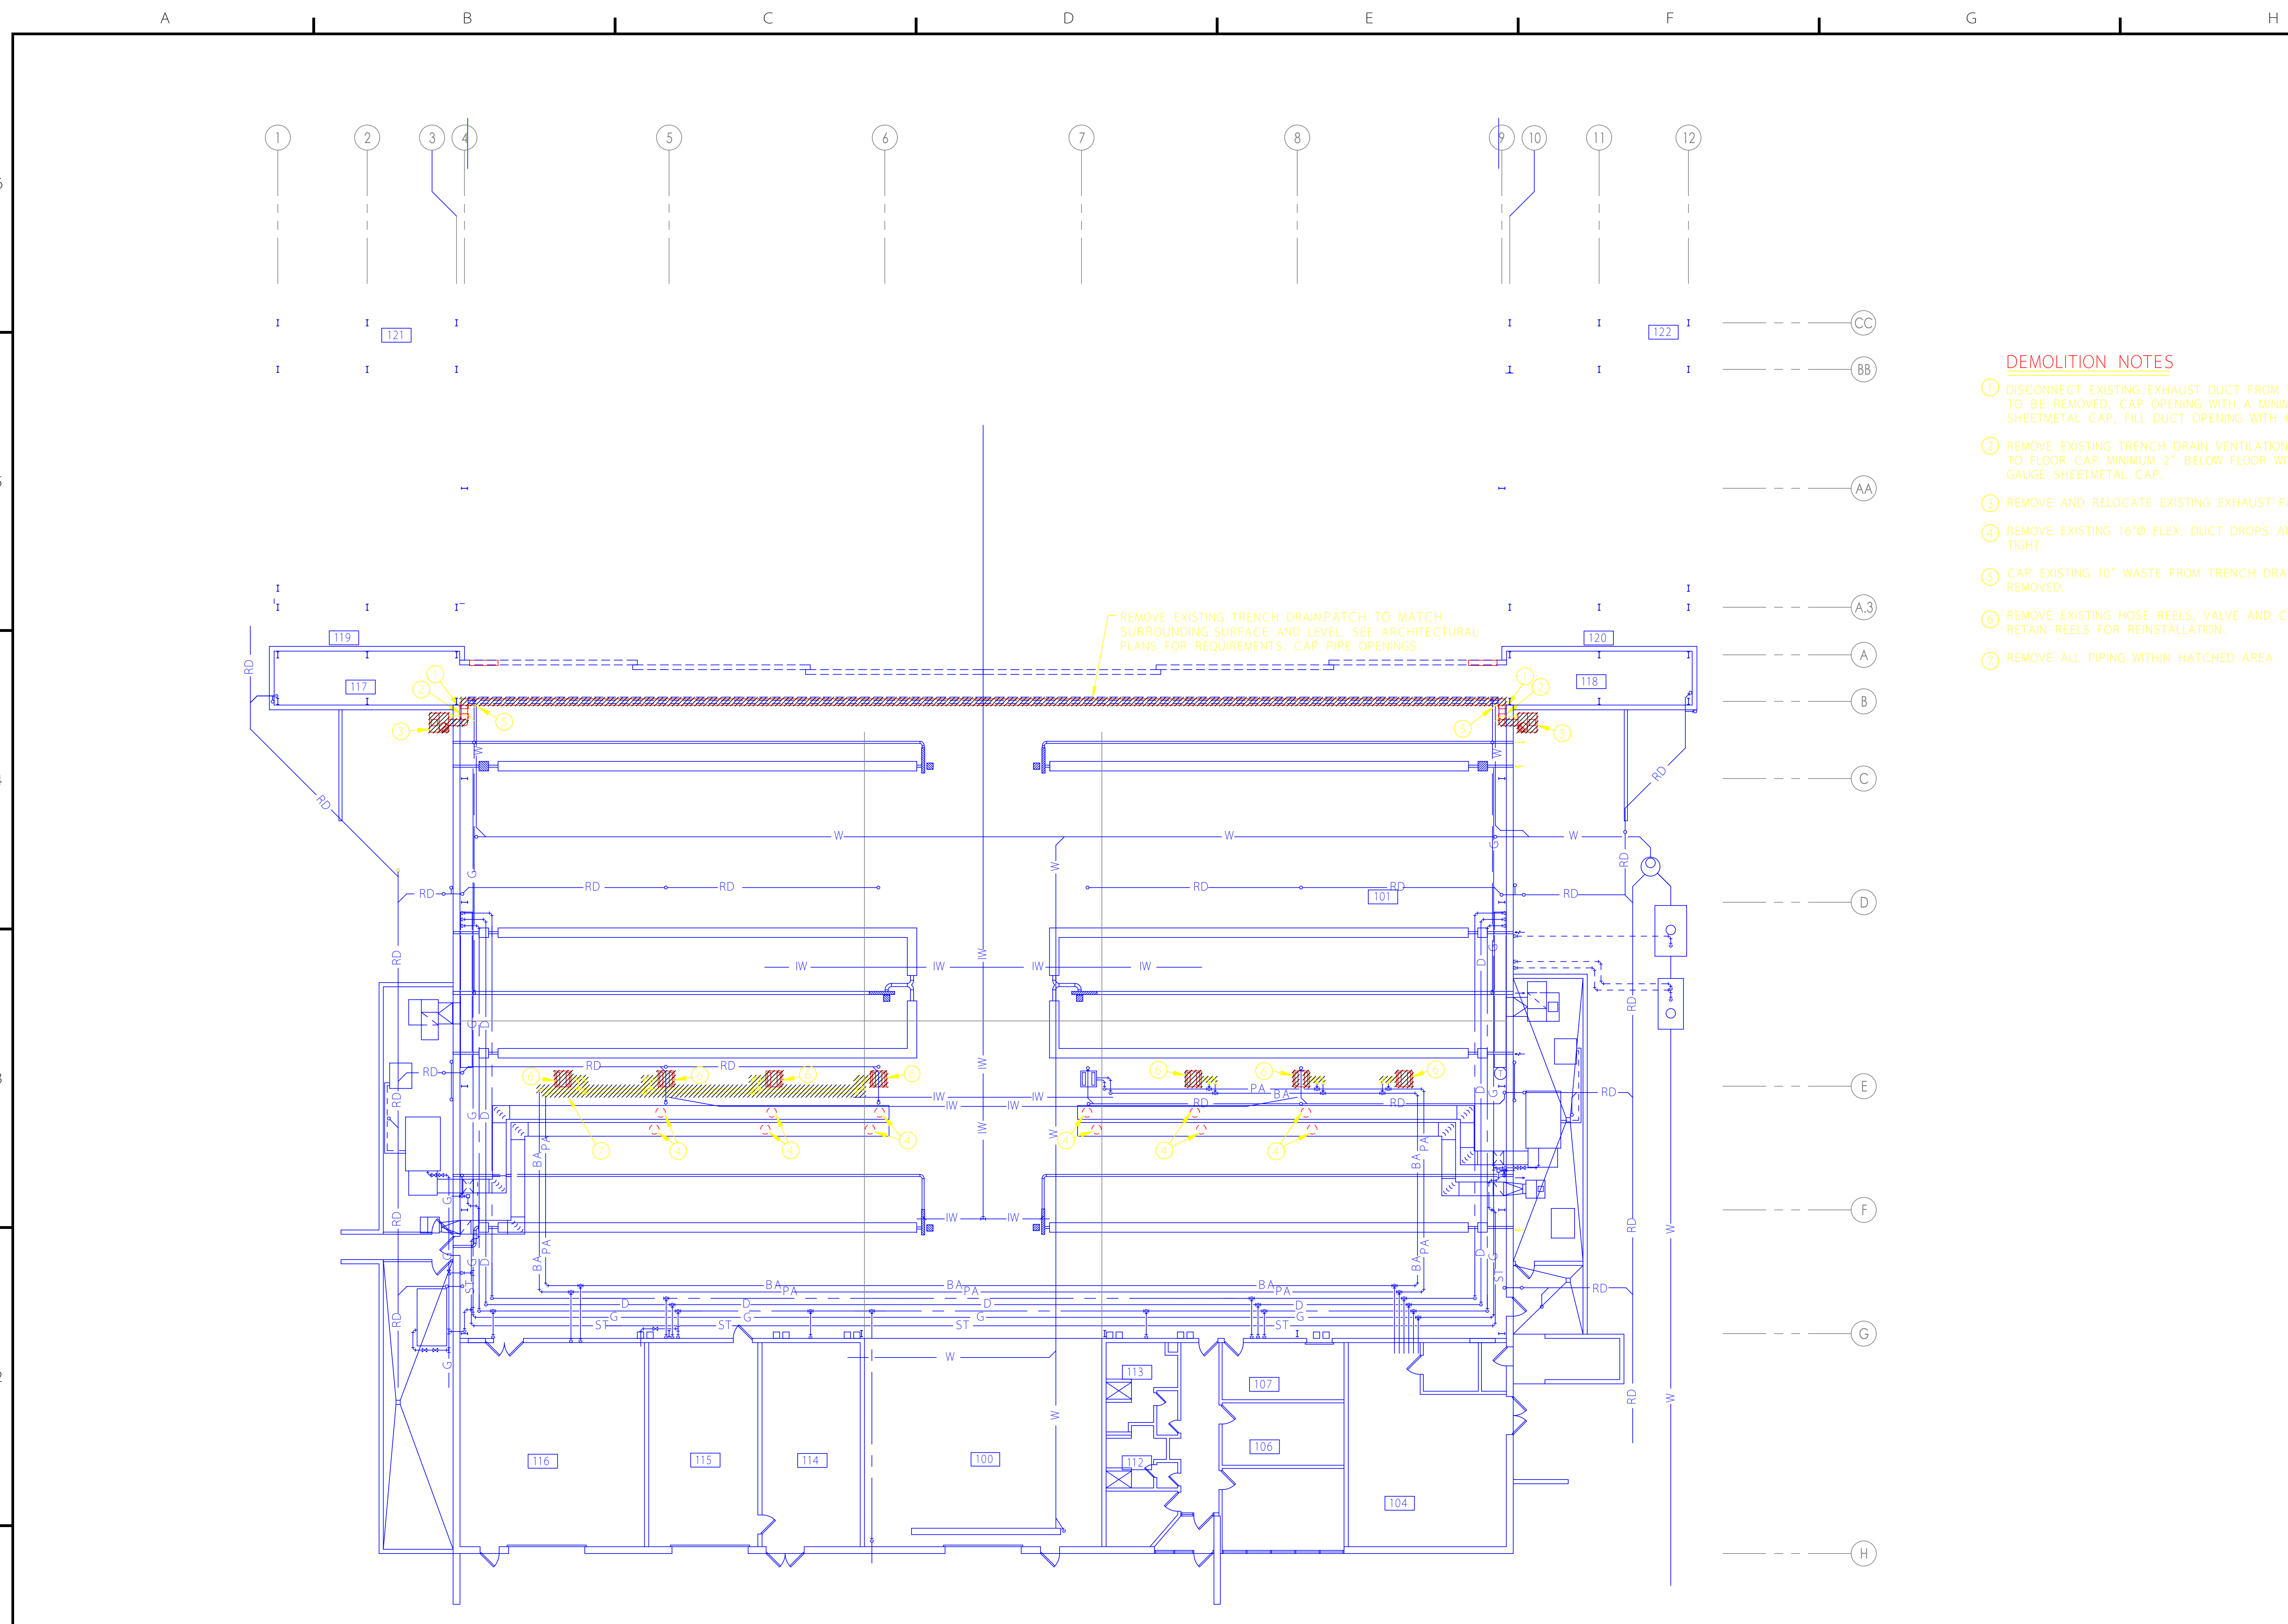


1 HVAC AND PLUMBING DEMOLITION PLAN
 3/5-M101 SCALE: 3/32" = 1'-0"

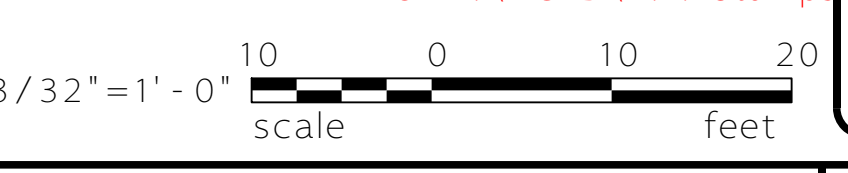




US Army Corps of Engineers
Seattle District

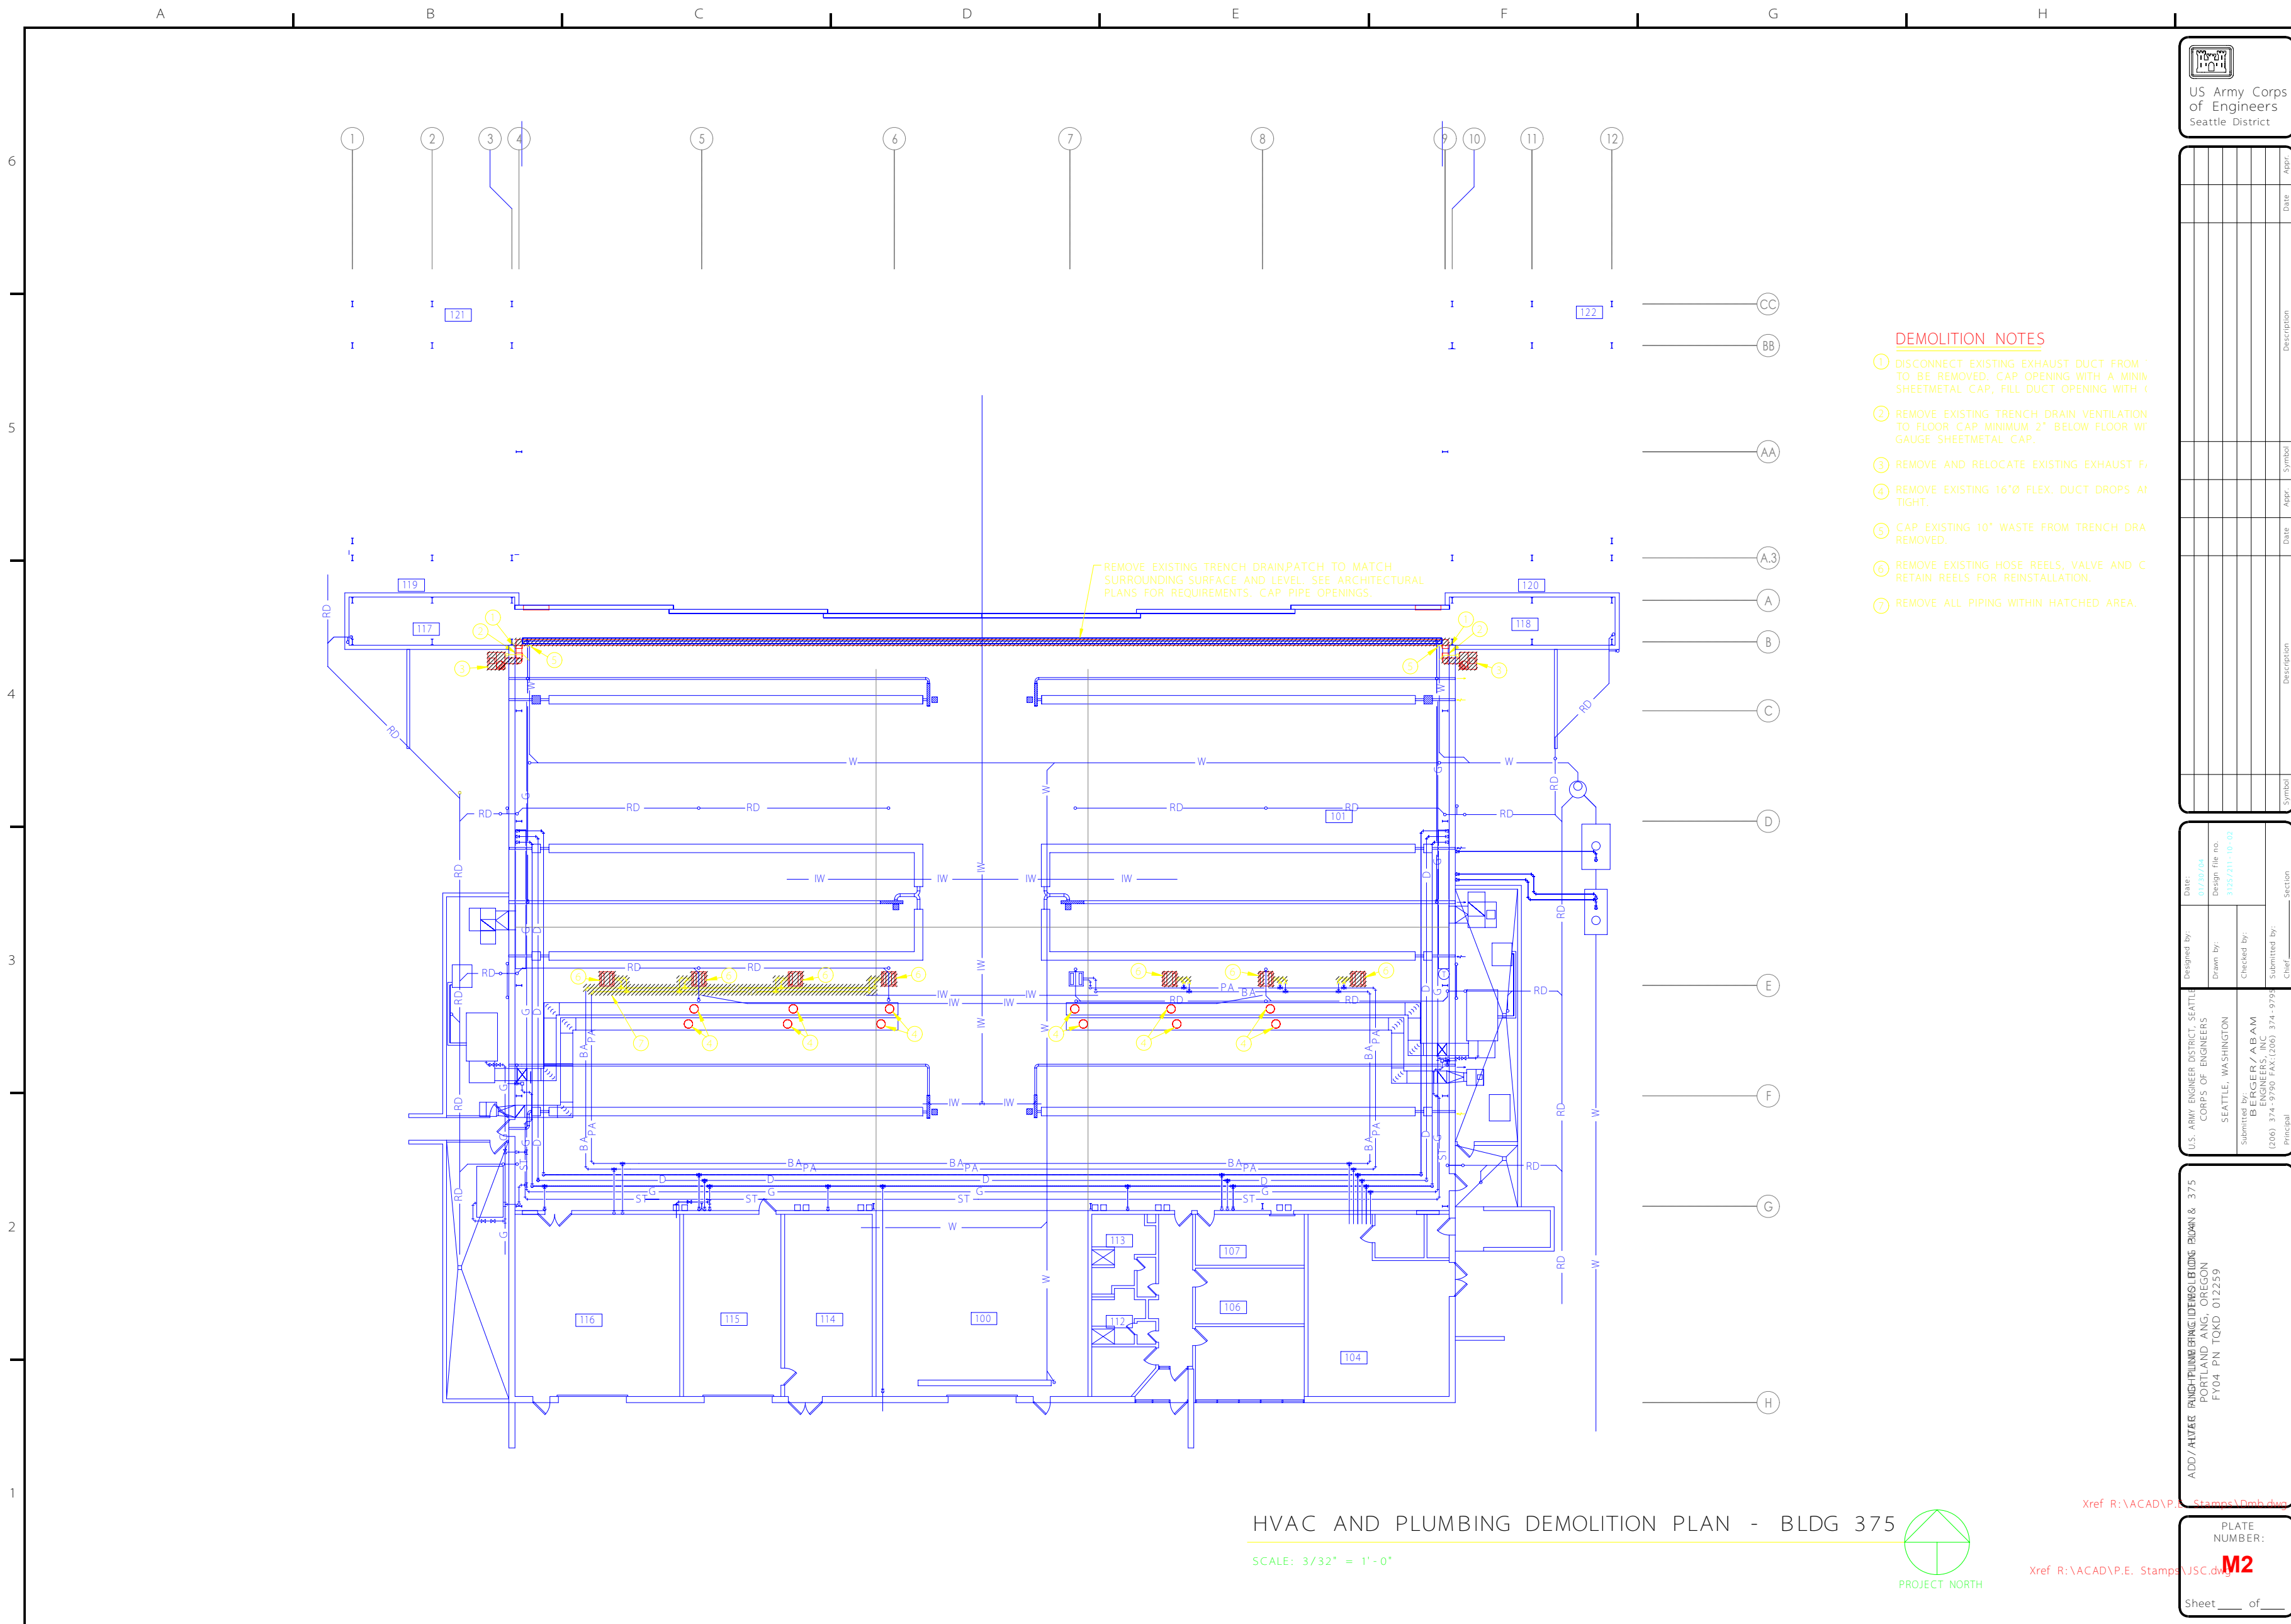

HVAC AND PLUMBING DEMOLITION PLAN - BLDG 375

SCALE: 3/32" = 1' - 0"

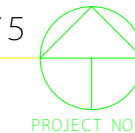

PROJECT NORTH

DEMOLITION NOTES

- ① DISCONNECT EXISTING EXHAUST DUCT FROM 1" TO BE REMOVED. CAP OPENING WITH A MINIV SHEETMETAL CAP. FILL DUCT OPENING WITH (
- ② REMOVE EXISTING TRENCH DRAIN VENTILATION TO FLOOR. CAP MINIMUM 2" BELOW FLOOR W/ GAUGE SHEETMETAL CAP.
- ③ REMOVE AND RELOCATE EXISTING EXHAUST F,
- ④ REMOVE EXISTING 16"Ø FLEX. DUCT DROPS AT TIGHT.
- ⑤ CAP EXISTING 10" WASTE FROM TRENCH DRA REMOVED.
- ⑥ REMOVE EXISTING HOSE REELS, VALVE AND C RETAIN REELS FOR REINSTALLATION.
- ⑦ REMOVE ALL PIPING WITHIN HATCHED AREA.

Xref R:\ACAD\VP Stamps\1Dmb.dwg


Xref R:\ACAD\VP.E Stamps\JSC.dwg

Date	Description	Appr.

Design	Design	Section
Design file no.	1305-011-10-00	

ADD/REMOVE PLUMBING/MECHANICAL WORK - ROOM & 375
PORTLAND, OREGON
7104 P.N. 12229


PLATE NUMBER: M2
Sheet ___ of ___

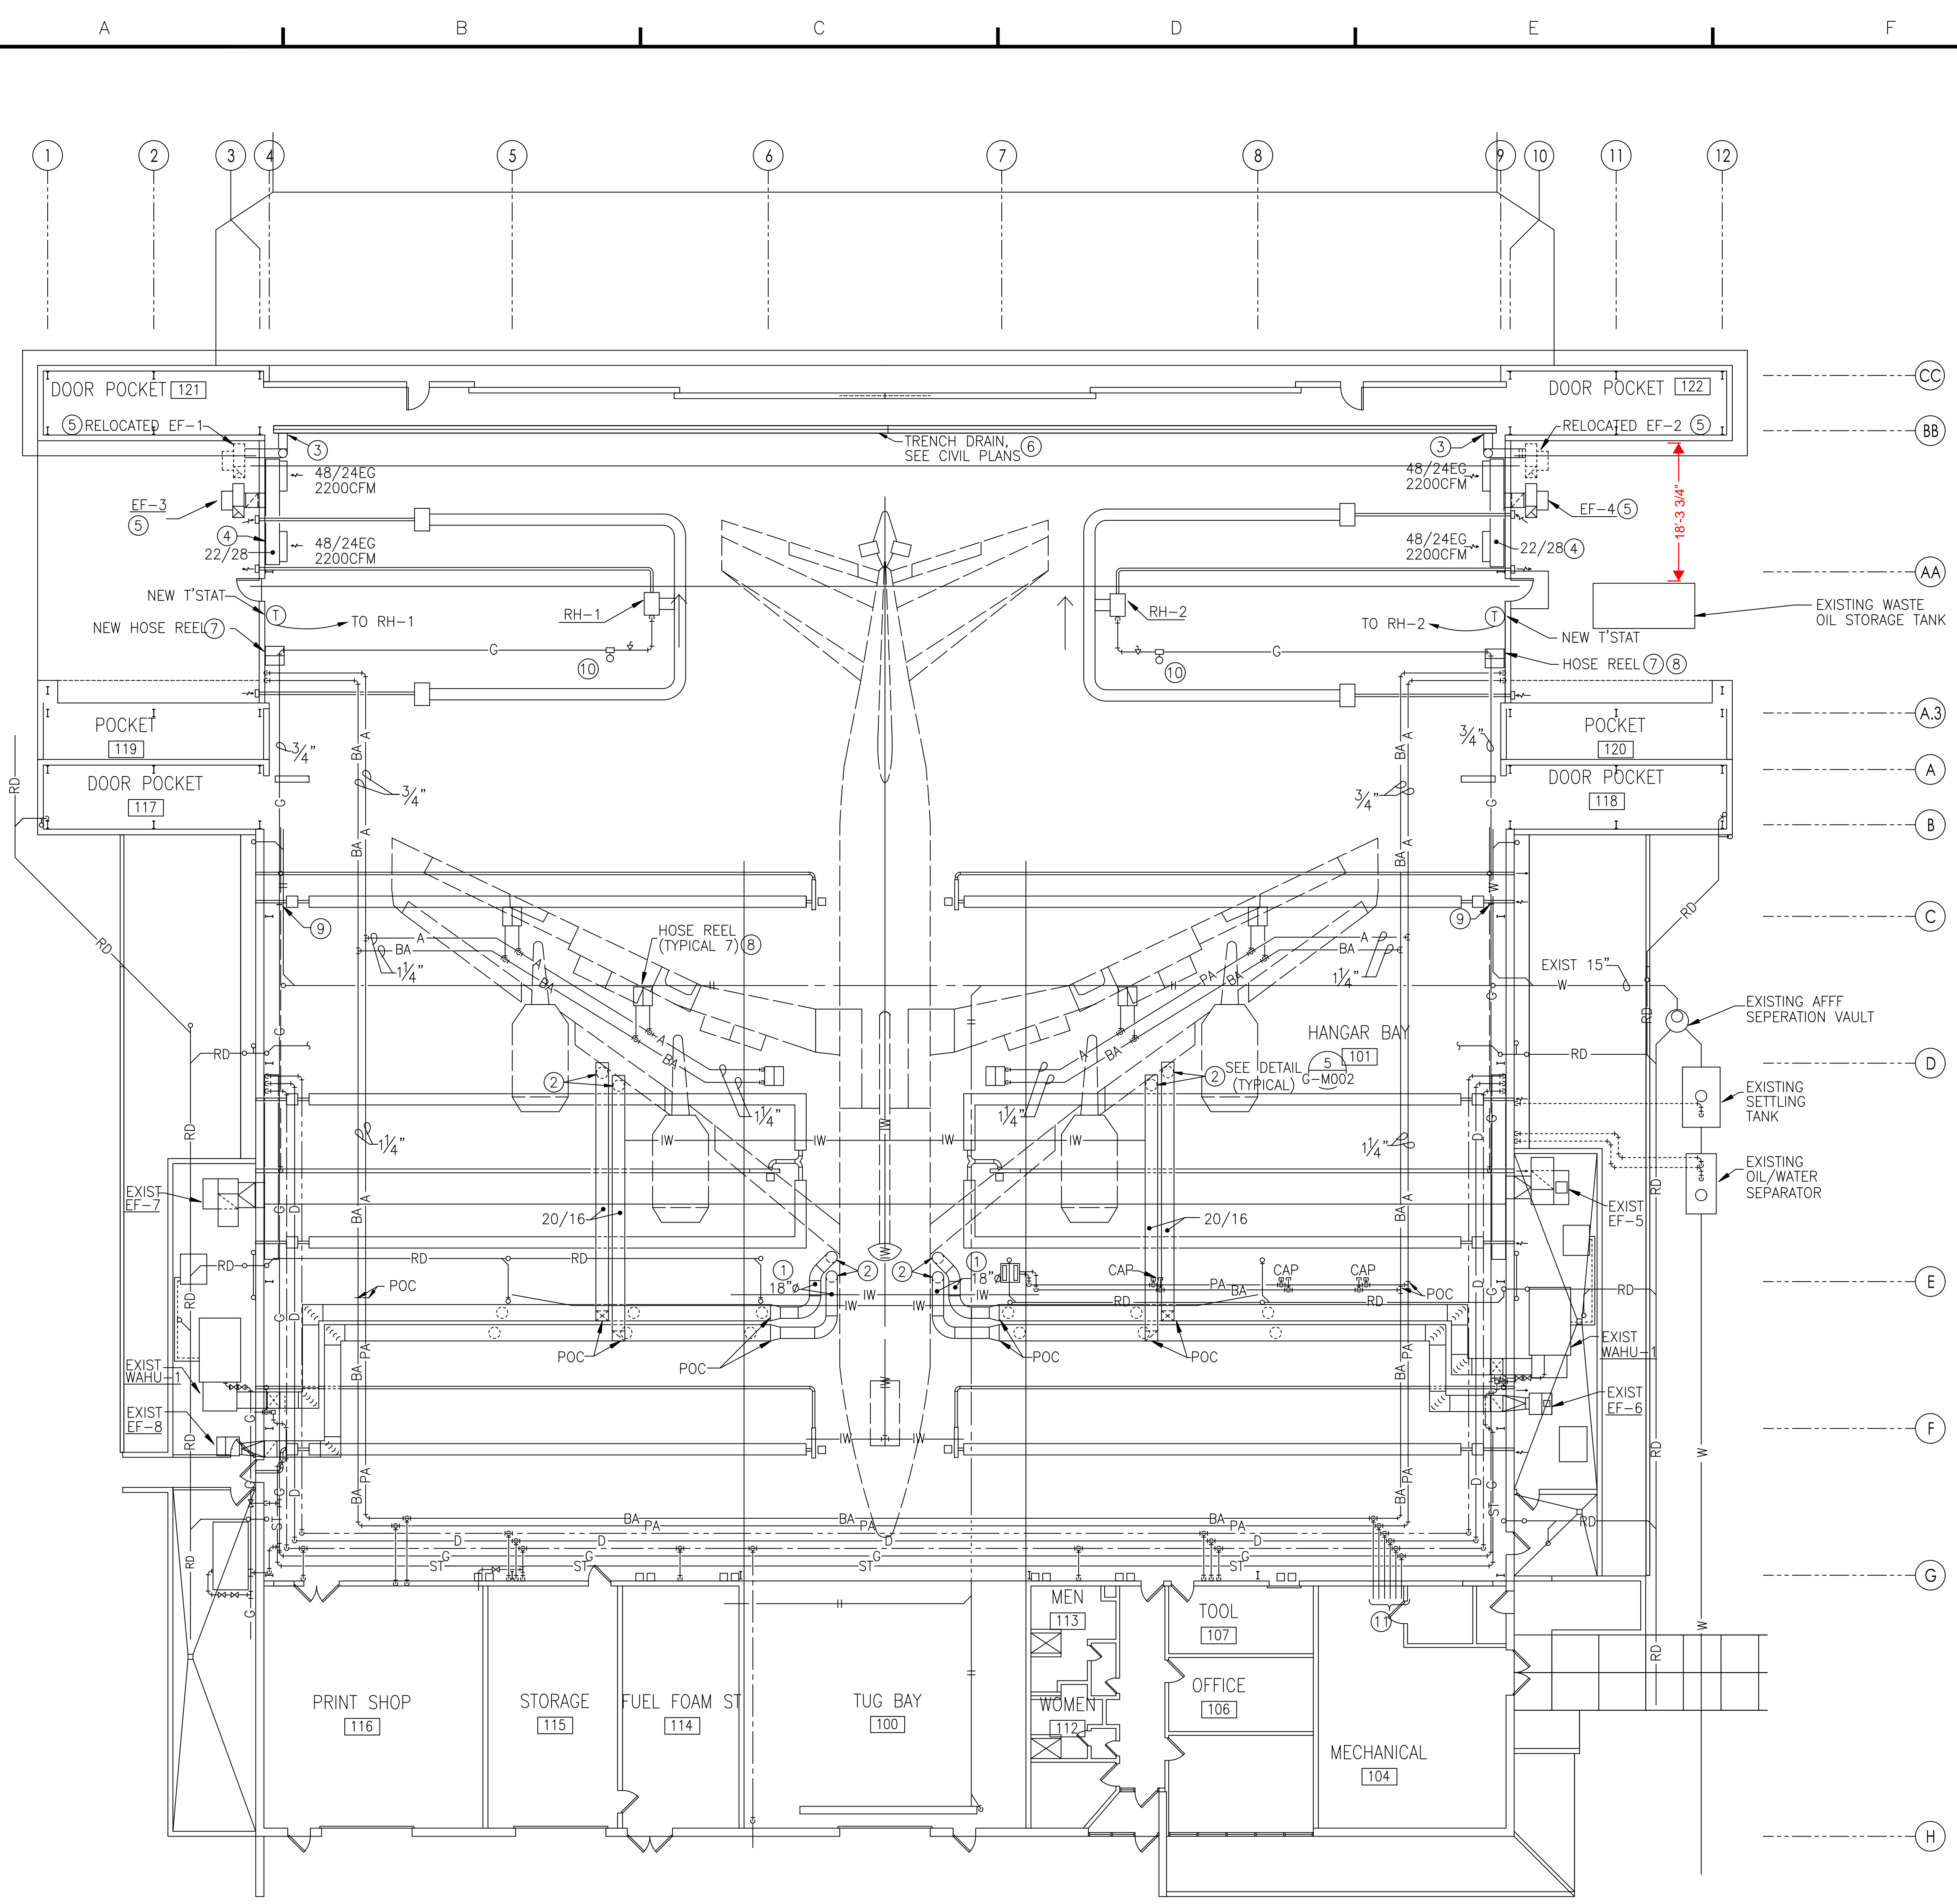

CONSTRUCTION NOTES

- ① PROVIDE MIN. 20 GAUGE DUCT.
- ② EXTEND 18"Ø SHEETMETAL DUCT 60" BELOW EXISTING RADIANT HEATER. CONTINUE WITH 18"Ø FLEXIBLE DUCT FROM THIS POINT. SUPPORT FLEXIBLE DUCT WITH CABLE AND PULLEY SYSTEM, TO BE MANUALLY RAISED/LOWERED WITH RELOCATED HAND DRAWN WINCH.
- ③ 10"Ø EXHAUST DUCT CONNECT TO TRENCH DRAIN.
- ④ COORDINATE INSTALLATION OF DUCT WITH COLUMN, ATTACH TO WALL W/BRACKET SUPPORTS AT 10'-0".
- ⑤ BRACE EXHAUST FAN TO CONCRETE PAD ON GROUND.
- ⑥ SEE CIVIL PLANS FOR WASTE PIPING FROM TRENCH.
- ⑦ BRACE HOSE REEL TO WALL.
- ⑧ RELOCATED HOSE REEL. INSTALL 3/4" SUPPLY DROP TO EACH REEL.
- ⑨ CONNECT NEW 3/4" GAS PIPE TO EXISTING 3/4" GAS PIPE.
- ⑩ GAS REGULATOR, REDUCE DELIVERY PRESSURE FROM 2 PSI TO 10" W.C. VENT TO ATMOSPHERE.
- ⑪ EXISTING PIPE TO MECHANICAL ROOM TO REMAIN.

1 HVAC AND PLUMBING FLOOR PLAN
375-M102 SCALE: 3/32" = 1'-0"

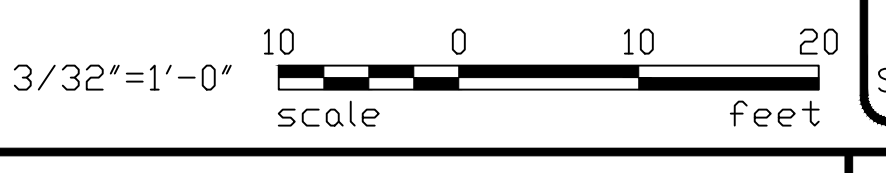


Date	Description	Appr.

Date:	01/20/04
Design file no.:	3125/211-0-02
Designed by:	BEG
Drawn by:	ME
Checked by:	JSC
Submitted by:	JSC
Submitted to:	Principal
Section:	

ADD/ALTER FLIGHTLINE FACILITIES BLDG 304 & 375
PORTLAND ANG, OREGON
FY04 PN TOKD 012259

HVAC AND PLUMBING FLOOR PLAN

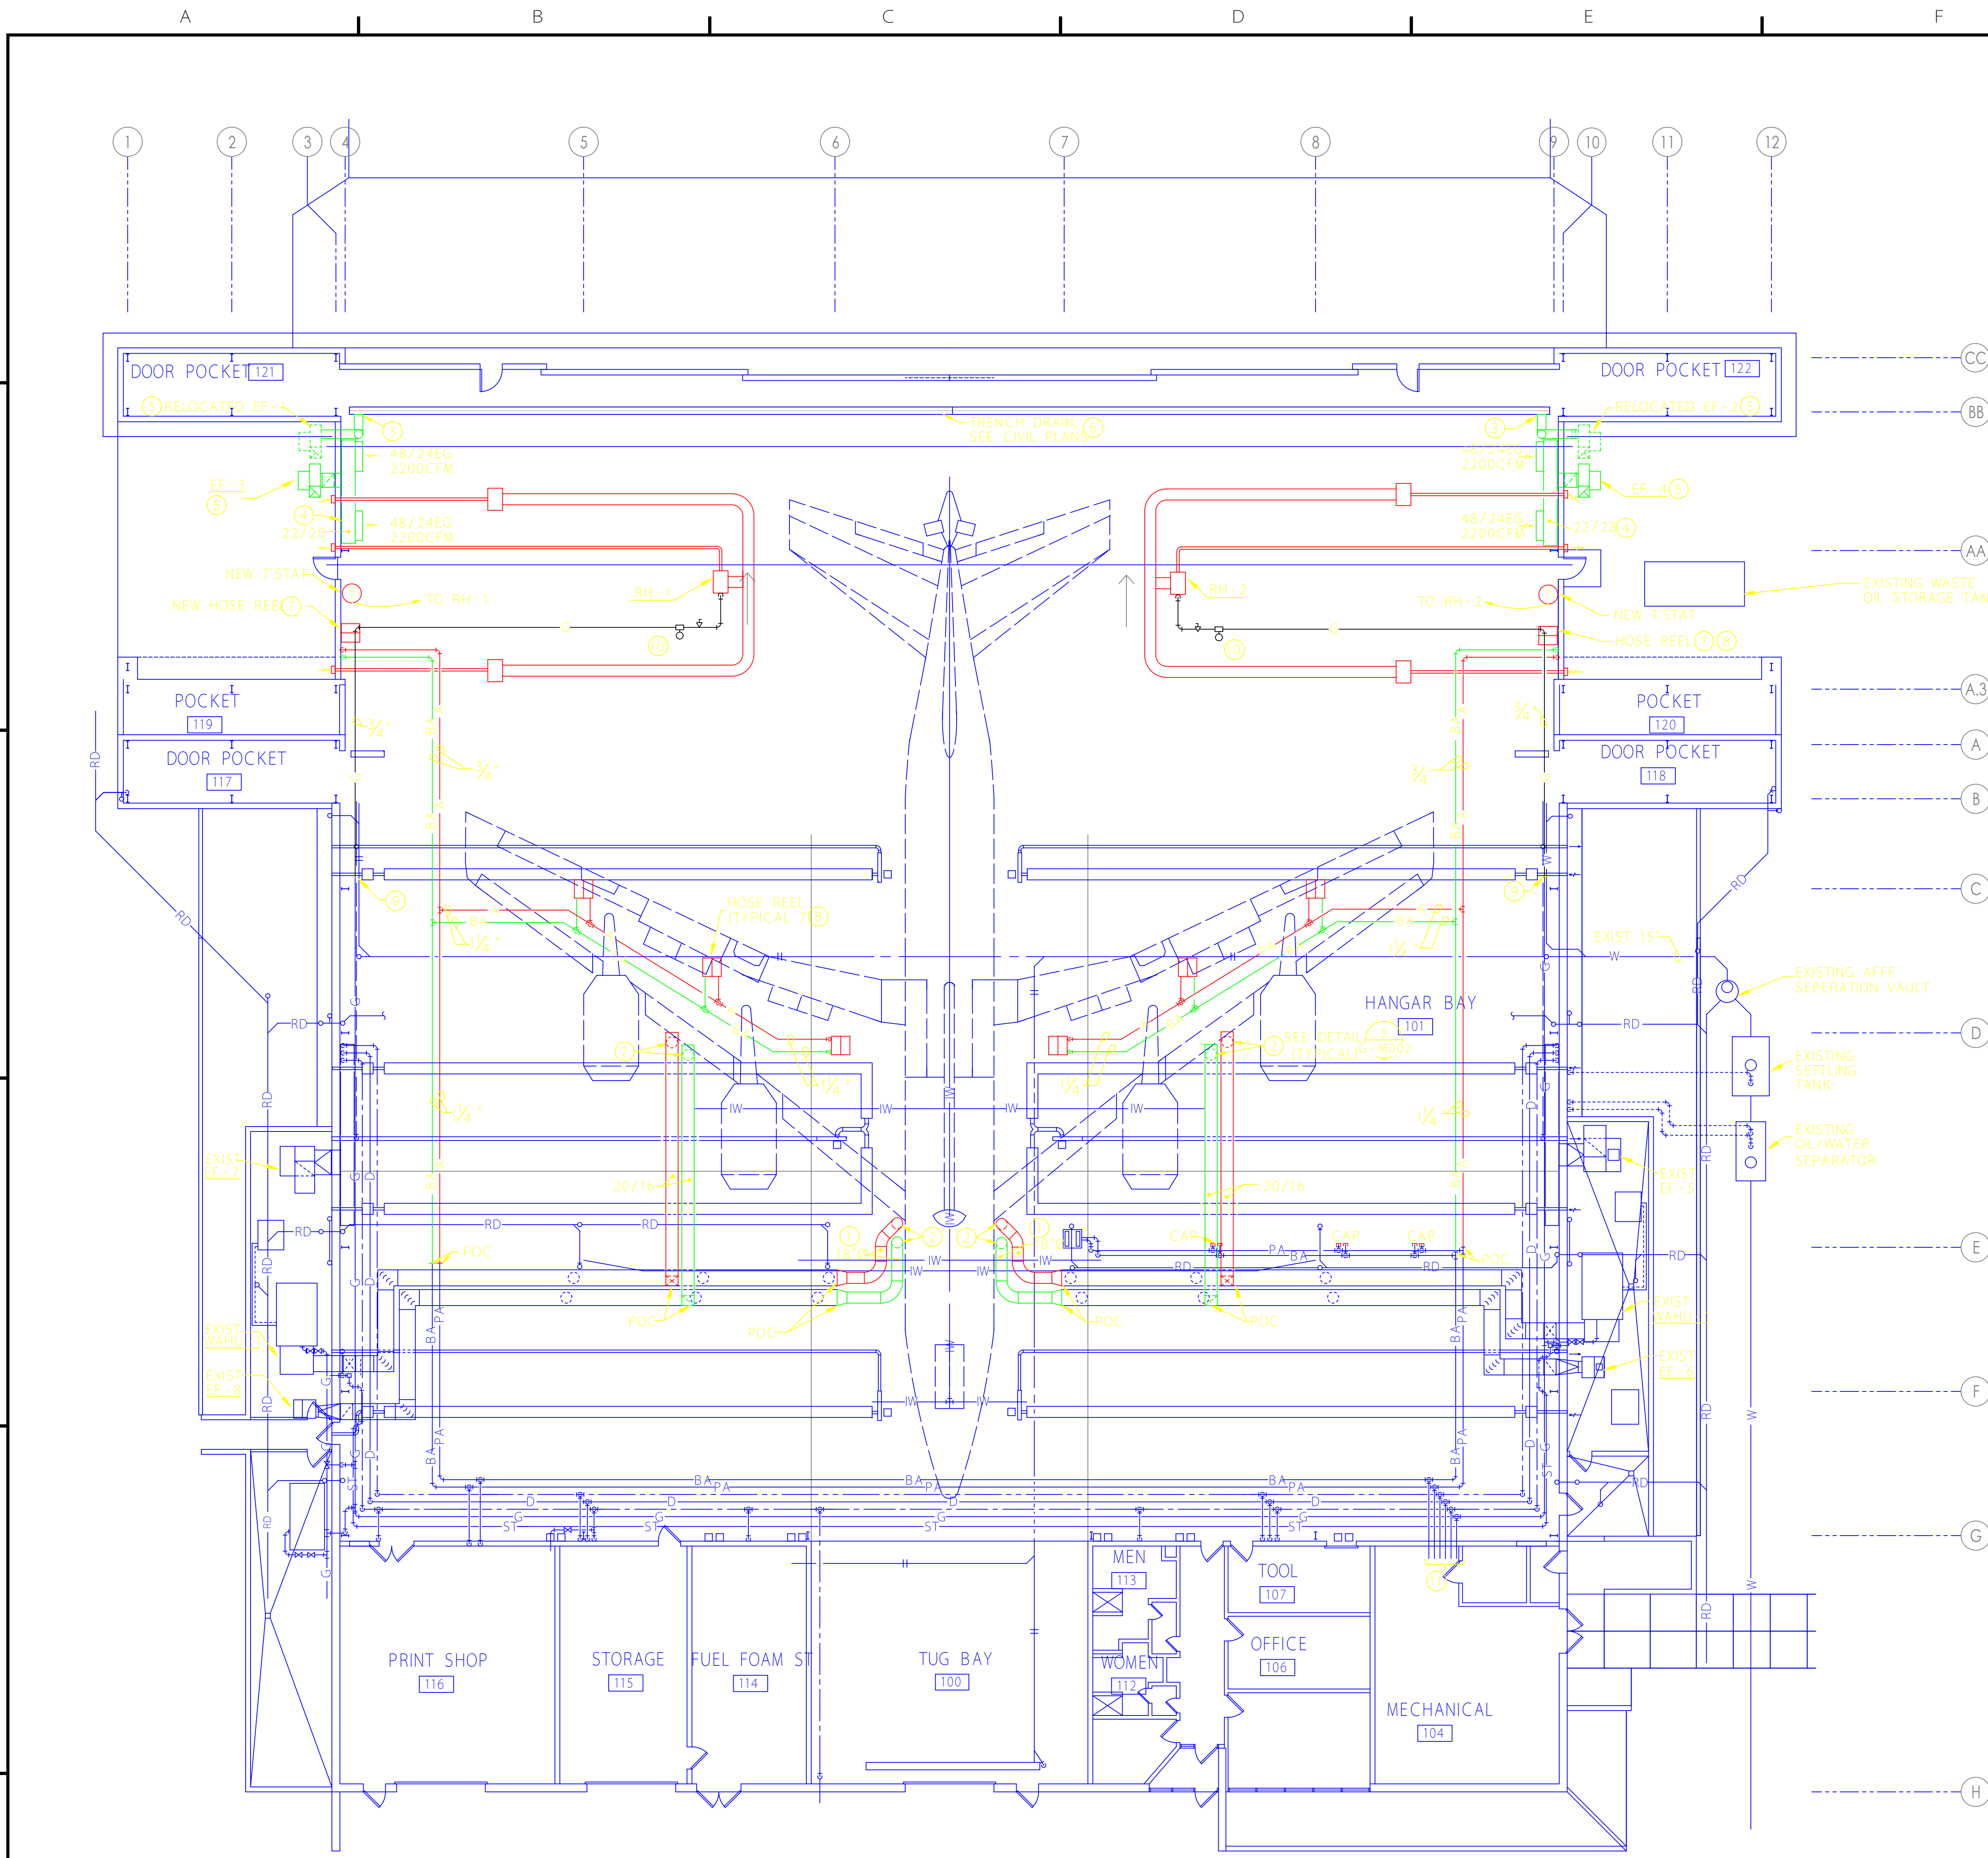

- CONSTRUCTION NOTES**
- ① PROVIDE MIN. 20 GAUGE DUCT.
 - ② EXTEND 18"Ø SHEETMETAL DUCT 60" BELOW EXISTING RADIANT HEATER, CONTINUE WITH 18"Ø FLEXIBLE DUCT FROM THIS POINT. SUPPORT FLEXIBLE DUCT WITH CABLE AND PULLEY SYSTEM, TO BE MANUALLY RAISED/LOWERED WITH RELOCATED HAND DRAWN WINCH.
 - ③ 10"Ø EXHAUST DUCT CONNECT TO TRENCH DRAIN.
 - ④ COORDINATE INSTALLATION OF DUCT WITH COLUMN, ATTACH TO WALL W/BRACKET SUPPORTS AT 10' - 0".
 - ⑤ BRACE EXHAUST FAN TO CONCRETE PAD ON GROUND.
 - ⑥ SEE CIVIL PLANS FOR WASTE PIPING FROM TRENCH.
 - ⑦ BRACE HOSE REEL TO WALL.
 - ⑧ RELOCATED HOSE REEL, INSTALL 3/4" SUPPLY DROP TO EACH REEL.
 - ⑨ CONNECT NEW 3/4" GAS PIPE TO EXISTING 3/4" GAS PIPE.
 - ⑩ GAS REGULATOR, REDUCE DELIVERY PRESSURE FROM 2 PSI TO 10" W.C. VENT TO ATMOSPHERE.
 - ⑪ EXISTING PIPE TO MECHANICAL ROOM TO REMAIN.

Date	Description	Author	Checked

Date: 07/24/2014
 Design file no.: 375-M102-10-00

Designed by: JAC
 Drawn by: JAC
 Checked by: JAC
 Submitted by: JAC

U.S. ARMY ENGINEER DISTRICT, SEATTLE
 CORPS OF ENGINEERS
 SEATTLE, WASHINGTON

Submitted by: GERRITZ/ABAM
 ENGINEERS, INC.
 (206) 374-9790 FAX:(206) 374-9793

Principal: JAC

ADD/ALTER FLIGHTLINE FACILITIES BLDG 304 & 375
 PORTLAND ANG, OREGON
 FY04 PN TQKD 012259

HVAC AND PLUMBING FLOOR PLAN

Xref R:\ACAD\... \Stamps\Dist.dwg

1 HVAC AND PLUMBING FLOOR PLAN
 375-M102 SCALE: 3/32" = 1' - 0"

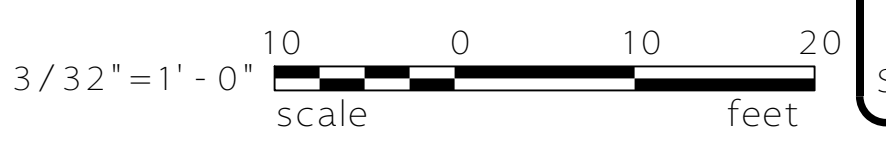


PLATE NUMBER:
375-M102
 Sheet 67 of 76

collid: May_08.2014 - 9:39am V:\DPPFS\BusinessDevelopment\pva\residents\trants - PDX\BRNG\0011 FACILITY DATA\BLOG 375\BOM 375 As-Design_cadd\MECHANICAL\M102_375_2219.dwg_collid

A B C D E F G H

FLOW TEST INFORMATION

FLOW TEST INFORMATION PROVIDED BY BCE ENGINEERS AND PORTLAND AIR NATIONAL GUARD FLOW TEST PERFORMED ON MARCH 11, 2003.

STATIC PRESSURE: 689.48 kPa (100 P.S.I.) RESIDUAL PRESSURE: 551.59 kPa (80 P.S.I.)

FLOWING:
 HYDRANT #370 - PORT #1 PITOT: 234.4 kPa (34 P.S.I.) FLOW: 3,703.7 L/min (978.4 G.P.M.)
 HYDRANT #370 - PORT #2 PITOT: 234.4 kPa (34 P.S.I.) FLOW: 3,703.7 L/min (978.4 G.P.M.)
 TOTAL FLOW: 7,407.3 L/min (1,956.8 G.P.M.)

AVAILABLE AT 137.9 kPa (20 P.S.I.): 15,670.9 L/min (4,139.8 G.P.M.)

NO STREAM STRAIGHTENERS WERE USED. FLOW WAS DIRECTLY OUT OF SMOOTH AND WELL ROUNDED HYDRANT PORTS WITH AN INTERNAL DIAMETER OF 2.5" AND A CO-EFFICIENT OF 0.90.

TEST WAS CONDUCTED ON HYDRANT # 365 LOCATED AT THE NORTH EAST CORNER OF BUILDING #360 AND FLOW HYDRANT #370 IS LOCATED AT THE NORTH WEST CORNER OF BUILDING #365.


TEST WAS PERFORMED BY: FRED BLANCHARD OF BCE ENGINEERS
 DOUG BOGGS OF THE PORTLAND AIR NATIONAL GUARD FIRE DEPARTMENT

FIRE PROTECTION LEGEND

SYMBOL	DESCRIPTION	SYMBOL	DESCRIPTION
	PIPE DOWN	P.O.C	POINT OF CONNECTION
	PIPE UP	A.F.F.	ABOVE FINISHED FLOOR
	BRANCH-TOP CONNECTION	B.F.F.	BELOW FINISHED FLOOR
	BRANCH-BOTTOM CONNECTION	B.O.R.	BASE OF RISER
	BRANCH-SIDE CONNECTION	E.C.	ELECTRICAL CONTRACTOR
	CAP ON END OF PIPE	G.C.	GENERAL CONTRACTOR
	GROOVED COUPLING	M.C.	MECHANICAL CONTRACTOR
	HEAVY LINE INDICATES NEW WORK ON SHEET (NEW PIPING ON DRAWINGS OR REMOVAL OF PIPING ON DEMOLITION PLAN)		
	DASHED LINE INDICATES EXISTING PIPING (NO WORK REQUIRED)		

GENERAL NOTES

- 1. EXISTING FIRE PROTECTION SPRINKLER SYSTEMS ARE SERVED BY A PEERLESS VERTICAL TURBINE FIRE PUMP MODEL # 16HXBF-3 WITH AN ELECTRIC DRIVER (250 H.P. 460V A.C., 3 PHASE, 1,750 RPM) WITH A BACKUP PEERLESS VERTICAL TURBINE PUMP MODEL # 16HXBF-3 WITH A CUMMINGS DIESEL DRIVER MODEL # NT855F3. BOTH OF THESE PUMPS ARE RATED AT 9,463.5 L/min (2,500 G.P.M.) @ 861.8 kPa (125 P.S.I.) AND HAVE A CHURN PRESSURE OF 1,034.2 kPa (150 P.S.I.)
- 2. THE ORIGINAL FIRE PROTECTION SYSTEM INSTALLATION REQUIRES AROUND 14,384.6 L/min (3,800 G.P.M.) @ 510.2 kPa (74 P.S.I.) AND CANNOT BE MET BY THE EXISTING SITE WATER SYSTEM AND MUST BE SUPPLIED FROM THE EXISTING FIRE PUMP INSTALLATION.

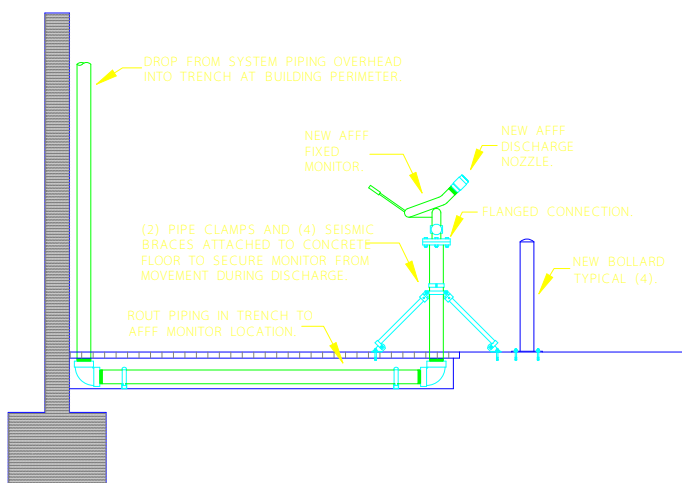


FOAM MONITOR NOZZLE SCHEDULE

LOCATION	DENSITY L/min PER SQ. M	DENSITY G.P.M. / SQ. FT.	AREA SQ. M	AREA SQ. FT.	MINIMUM FLOW (L/min)	MINIMUM FLOW (G.P.M.)	MINIMUM DISCHARGE kPa	MINIMUM DISCHARGE P.S.I.	ANGLE OF COVERAGE (DEGREES)	EFFECTIVE REACH (METERS)	EFFECTIVE REACH (FEET)
UNDER WING EAST SIDE	4.07	0.10	277.2	2,983.6	1,132	299	413.7	60	45°	14.9	49
UNDER WING WEST SIDE	4.07	0.10	277.2	2,983.6	1,132	299	413.7	60	45°	14.9	49
NOZZLE AREA	4.07	0.10	464.5	5,000	1,893	500	482.6	70	35°	23.5	77


STORAGE TANK SCHEDULE

AFFX CONCENTRATE STORAGE TAN	LITERS	GALLONS	STATUS
WEST ROOF SYSTEM	3,028.3	800	EXISTING
EAST ROOF SYSTEM	3,028.3 (2,271.3 EX)	800 (600 EX)	REPLACE WITH NEW
MONITOR SYSTEM	2,271.3 (1,135.6 EX)	600 (300 EX)	USE EXISTING EAST ROOF AFFX STORAGE TANK. REMOVE EXISTING 300 GALLON AFFX STORAGE TANK.
HOSE STATION SYSTEM	567.8	150	TO BE REMOVED


4 MONITOR DETAIL - TYPICAL
 375-M201 SCALE: 1/2" = 1'-0"

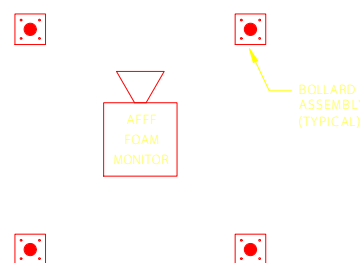

1 ENLARGED BOLLARD PLAN - TYPICAL
 375-M201 SCALE: 3/8" = 1'-0"

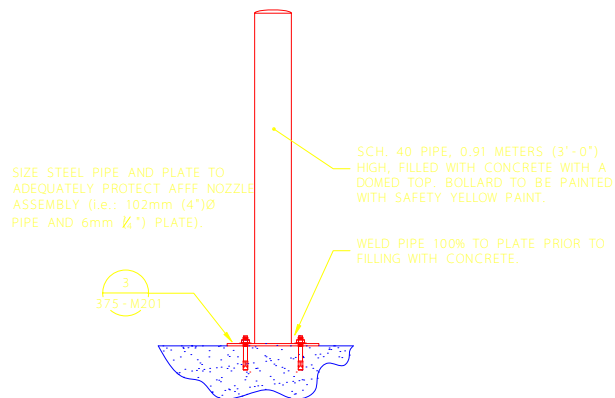

2 BOLLARD ELEVATION - TYPICAL
 375-M201 SCALE: NONE

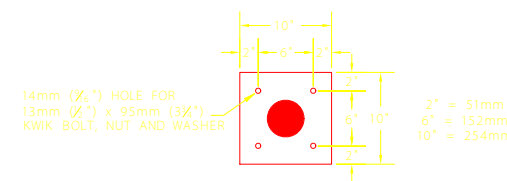

3 BOLLARD PLATE PLAN - TYPICAL
 375-M201 SCALE: NONE

Designed by: DATE	Check by: DATE
Drawn by: DATE	Submitted by: DATE
Reviewed by: DATE	

U.S. ARMY ENGINEER DISTRICT, SEATTLE
 CORPS OF ENGINEERS
 SEATTLE, WASHINGTON
 Submitted by: BERGERY/ABAM ENGINEERS, INC.
 (206) 374-9700 FAX: (206) 374-9796

ADD/ALTER FLIGHTLINE BLDG 304 & 375
 PORTLAND ANG, OREGON
 F704 PN TORD 012239


**FIRE PROTECTION PLAN
 LEGENDS AND SCHEDULES**

PLATE NUMBER:
375-M201
 Sheet 68 of 76



- CONSTRUCTION NOTES**
- 1. REMOVE EXISTING OSCILLATING MONITOR STATION AND MONITOR PIPING BACK TO THE 90° ELBOW AND MODIFY PIPING AS SHOWN ON SHEET 375-M203.
 - 2. REMOVE EXISTING AFFF HOSE VALVE AND ALL PIPING ASSOCIATED WITH THIS SYSTEM.
 - 3. REMOVE EXISTING AFFF HOSE STATION CONCENTRATE STORAGE TANK AND ALL PIPING ASSOCIATED WITH AFFF CONCENTRATE.
 - 4. REMOVE EXISTING AFFF HOSE STATION SYSTEM RISER AND ALL COMPONENTS ASSOCIATED WITH THE SYSTEM RISER. PROVIDE A CAP FOR OUTLET OFF EXISTING MANIFOLD.
 - 5. DISCONNECT NOSE AREA PROTECTION FROM THE WEST ROOF SYSTEM AND PROVIDE A CAP TO CAP OFF WEST ROOF SYSTEM OUTLET. SEE SHEET 375-M204 FOR MODIFICATION.
 - 6. REMOVE EXISTING AFFF DISCHARGE NOZZLE AND PIPING BACK TO THE MAIN OUTLET.
 - 7. DISCONNECT EXISTING NOSE AREA AFFF MONITOR SUPPLY AND PROVIDE A CAP.
 - 8. EXISTING AFFF CONCENTRATE STORAGE TANK TO REMAIN.
 - 9. ALL BLACK STEEL PIPING CONTAINING AFFF CONCENTRATE TO BE REMOVED.
 - 10. EXISTING 2,271.2 LITER (600 GALLON) AFFF CONCENTRATE STORAGE TANK TO BE REUSED FOR NEW AFFF MONITOR SYSTEM.
 - 11. REMOVE EXISTING AFFF STORAGE TANK THAT IS CURRENTLY SERVING THE AFFF MONITOR SYSTEM.

- GENERAL NOTES**
- 1. ALL SOLID HEAVY LINE PIPING ON THIS SHEET IS TO BE REMOVED.

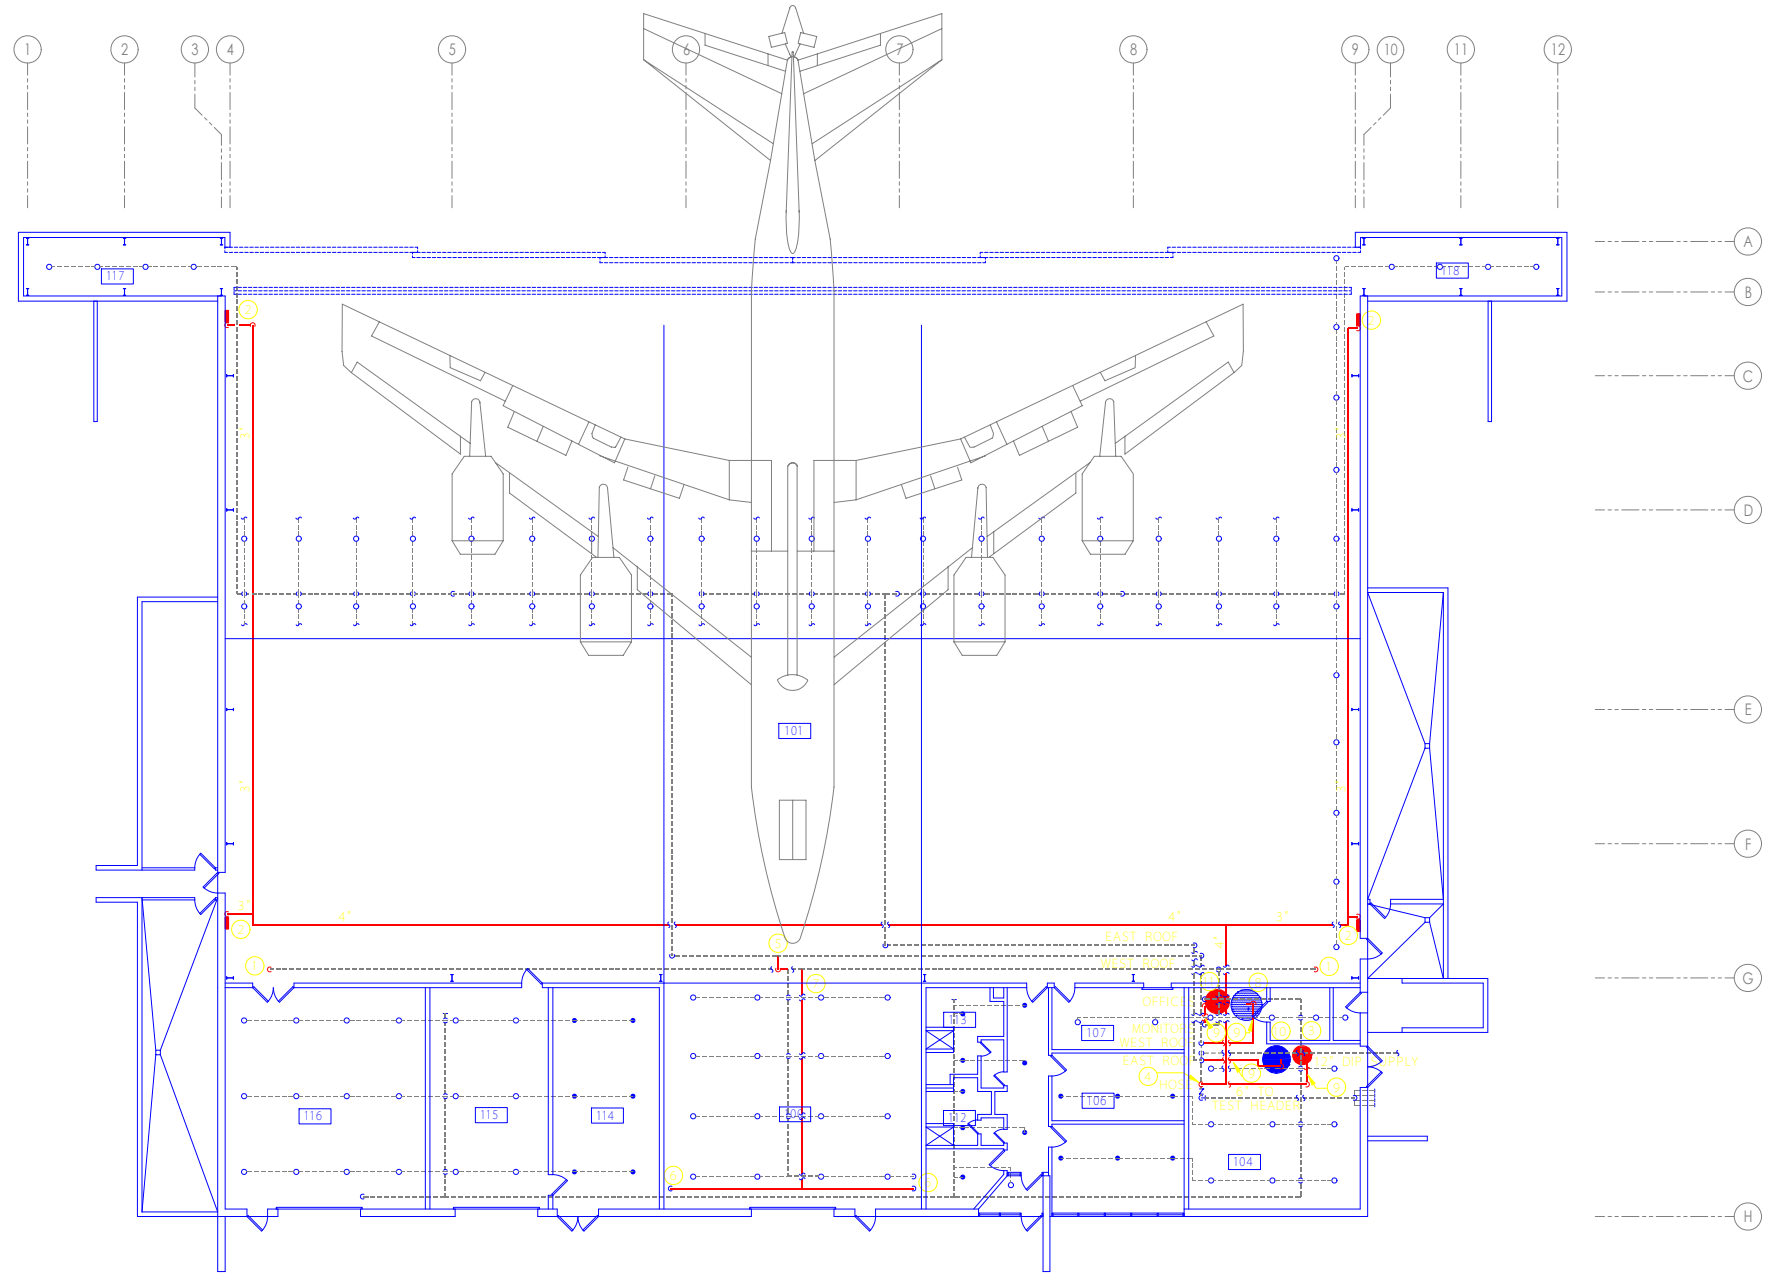

Date	Appr.	Symbol	Description

Date	Design file no.	Section
2/22/2024	1332721-10-02	

Designed by	Drawn by	Checked by	Submitted by
PHIL B.	PHIL B.		

U.S. ARMY ENGINEER DISTRICT, SEATTLE, WASHINGTON	Submitted by
SEATTLE, WASHINGTON	BERGERY/ALBAM ENGINEERS, INC 0203 374-9700 FAX:0206 374-9799 Principal


ADD/ALTER FIGHTLINE FACILITIES BLDG 304 & 375
PORTLAND ANG, OREGON
FY04 PN TOKD 012259

**FIRE PROTECTION PLAN
DEMOLITION PLAN**

1 FIRE PROTECTION DEMOLITION PLAN
375-M202 SCALE: 3/32" = 1'-0"


Xref R:\ACAD\PL\Stamps\Ornh.dwg

PLATE NUMBER:
375-M202
Sheet 69 of 76

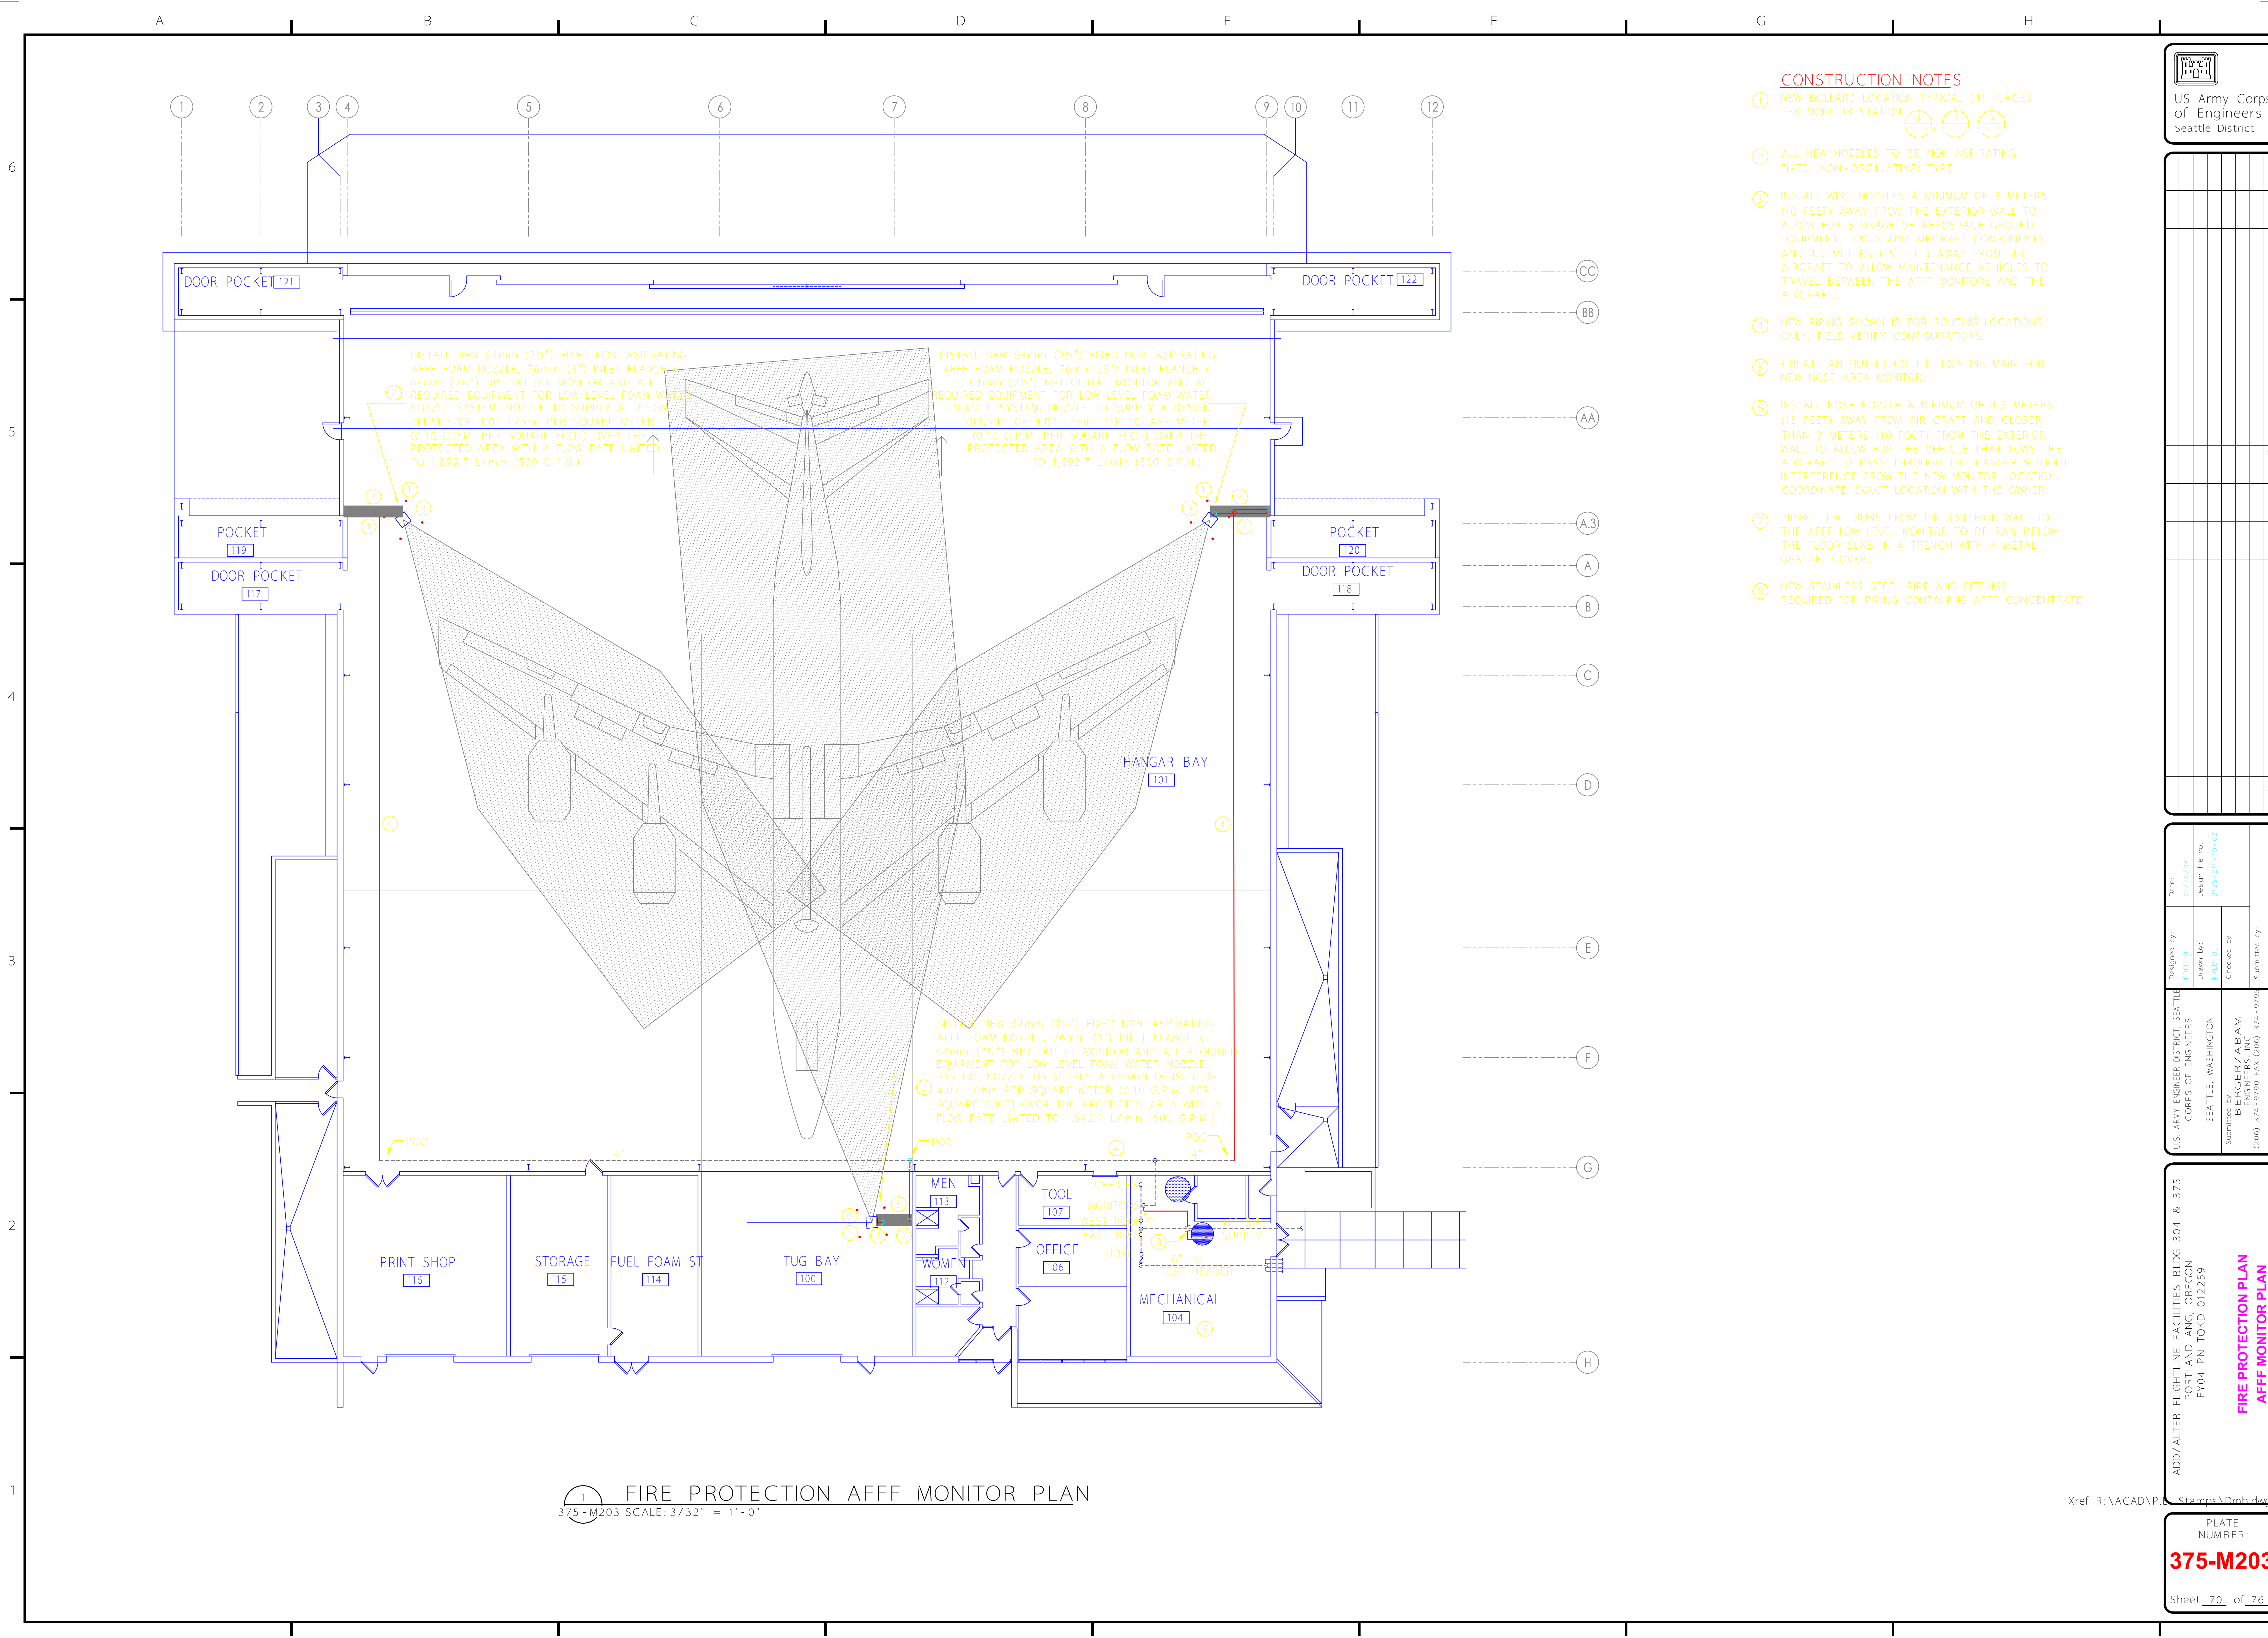

1 FIRE PROTECTION AFFF MONITOR PLAN
375-M203 SCALE: 3/32" = 1'-0"

- CONSTRUCTION NOTES**
- NEW BOLLARD LOCATION TYPICAL (4) PLACES PER MONITOR STATION. 1 2 3
 - ALL NEW NOZZLES TO BE NON-ASPIRATING FIXED (NON-OSCILLATING) TYPE.
 - INSTALL WING NOZZLES A MINIMUM OF 3 METERS (10 FEET) AWAY FROM THE EXTERIOR WALL TO ALLOW FOR STORAGE OF AEROSPACE GROUND EQUIPMENT, TOOLS AND AIRCRAFT COMPONENTS AND 4.5 METERS (15 FEET) AWAY FROM THE AIRCRAFT TO ALLOW MAINTENANCE VEHICLES TO TRAVEL BETWEEN THE AFFF MONITORS AND THE AIRCRAFT.
 - NEW PIPING SHOWN IS FOR ROUTING LOCATIONS ONLY, FIELD VERIFY CONFIGURATIONS.
 - CREATE AN OUTLET ON THE EXISTING MAIN FOR NEW NOSE AREA MONITOR.
 - INSTALL NOSE NOZZLE A MINIMUM OF 4.5 METERS (15 FEET) AWAY FROM AIR CRAFT AND CLOSER THAN 3 METERS (10 FOOT) FROM THE EXTERIOR WALL TO ALLOW FOR THE VEHICLE THAT TOWS THE AIRCRAFT TO PASS THROUGH THE HANGER WITHOUT INTERFERENCE FROM THE NEW MONITOR LOCATION. COORDINATE EXACT LOCATION WITH THE OWNER.
 - PIPING THAT RUNS FROM THE EXTERIOR WALL TO THE AFFF LOW LEVEL MONITOR TO BE RAN BELOW THE FLOOR SLAB IN A TRENCH WITH A METAL GRATING COVER.
 - NEW STAINLESS STEEL PIPE AND FITTINGS REQUIRED FOR PIPING CONTAINING AFFF CONCENTRATE.

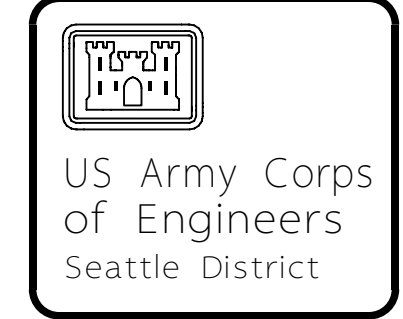

Symbol	Description	Date	Appr.

U.S. ARMY ENGINEER DISTRICT SEATTLE CORPS OF ENGINEERS SEATTLE, WASHINGTON	Assigned by: FRED B.	Date: 01/20/24
Submitted by: BERGER / ABAM (206) 374-9950 FAX:(206) 374-9793 Principal	Drawn by: FRED B.	Design file no. 1122/211-10-02
	Checked by:	Section
	Submitted by:	Chief



ADD/ALTER FLIGHTLINE FACILITIES BLDG 304 & 375
PORTLAND ANG OREGON
FY04 PN TOKD 012259

FIRE PROTECTION PLAN
AFFF MONITOR PLAN

Xref R:\ACAD\P... Stamps\Drmb.dwg

PLATE NUMBER:
375-M203

Sheet 70 of 76

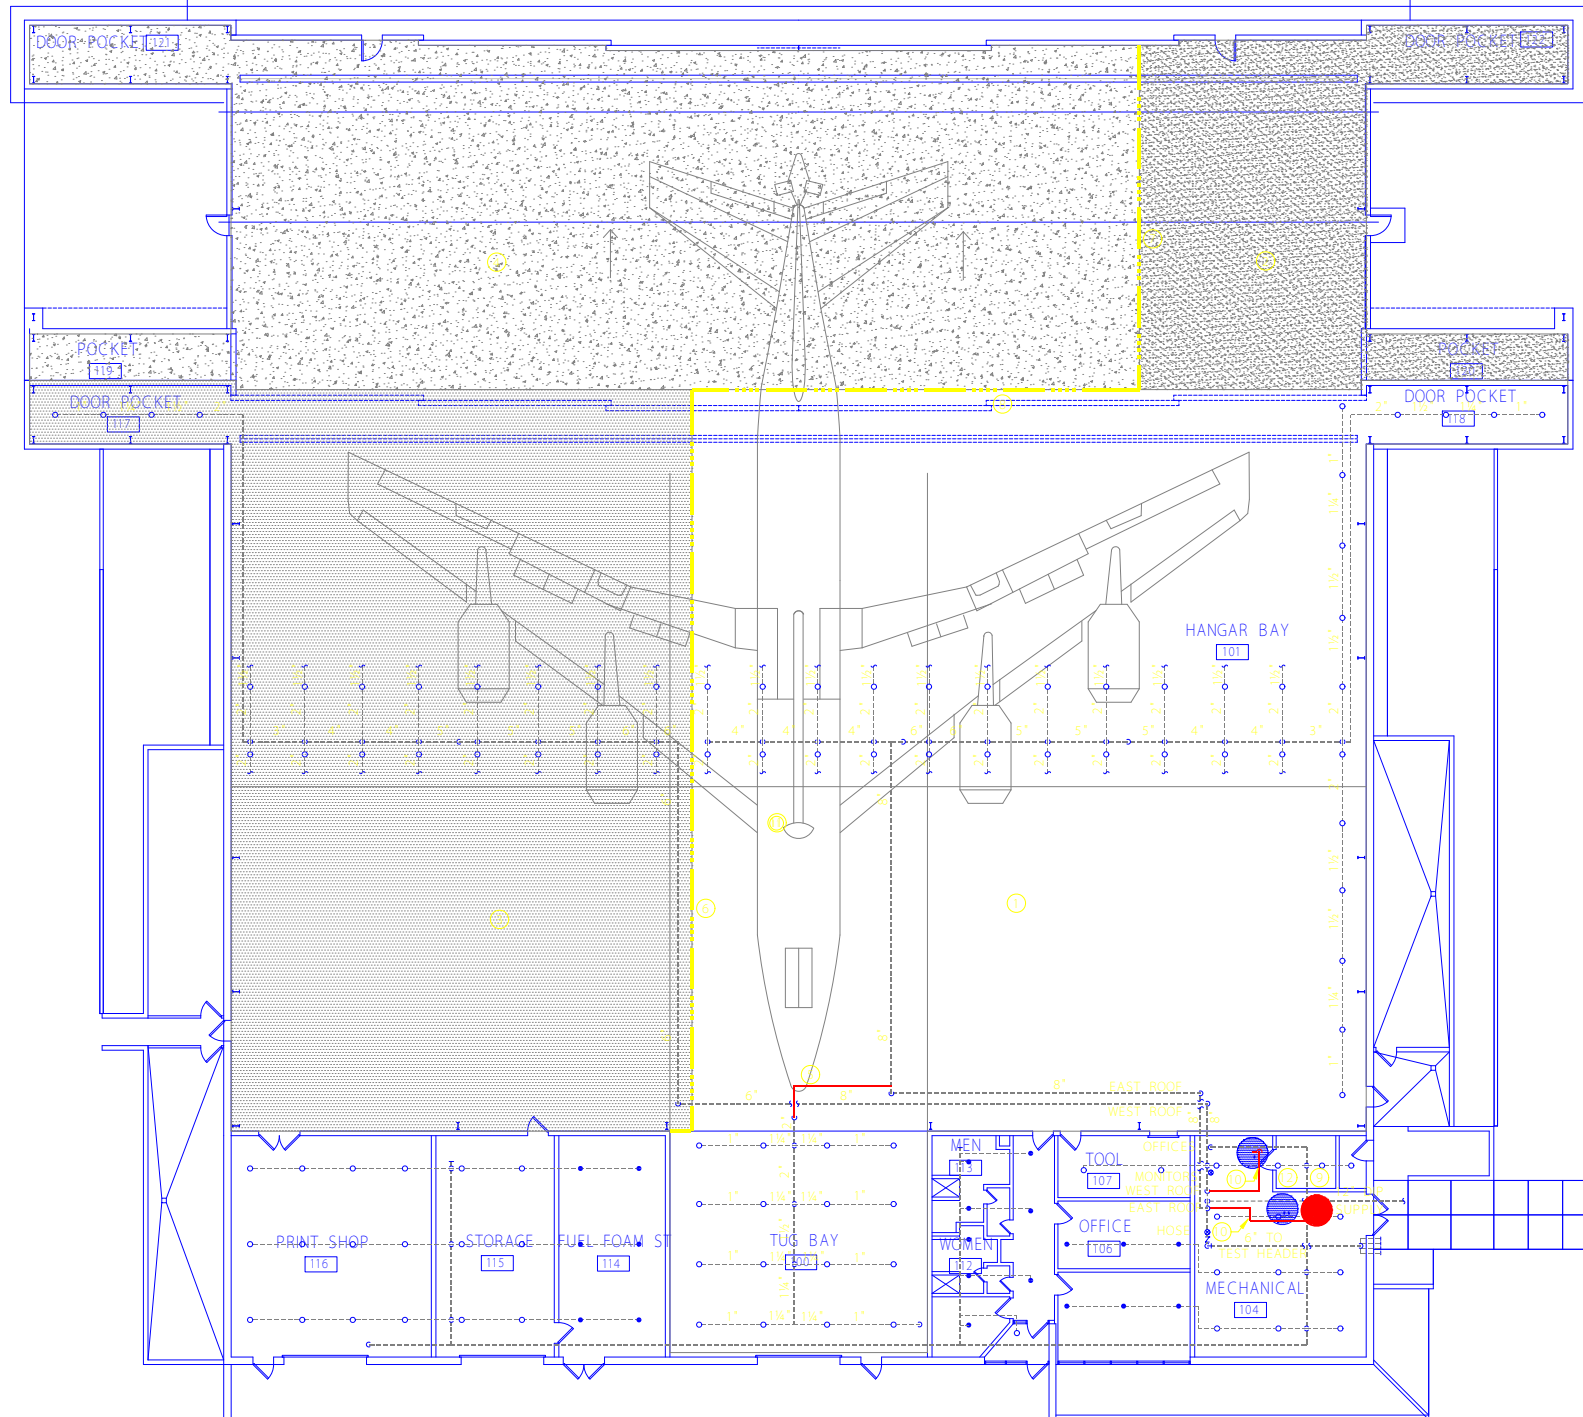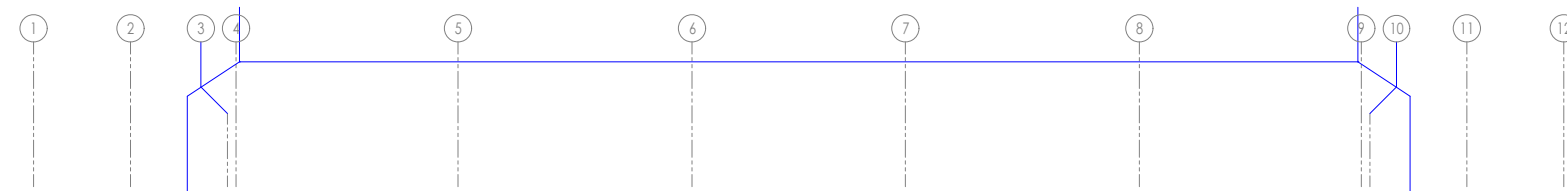


CONSTRUCTION NOTES

- 1 EXISTING EAST ROOF SYSTEM (AREA 1) TO BE EXTENDED INTO HANGAR ADDITION INDICATED WITH NO HATCHING.
- 2 ADDITION AREA (AREA 2) TO BE PROTECTED FROM THE EXISTING EAST ROOF SYSTEM INDICATED WITH HATCH PATTERN SHOWN.
- 3 EXISTING WEST ROOF SYSTEM (AREA 3) TO BE EXTENDED INTO HANGAR ADDITION INDICATED WITH HATCH PATTERN SHOWN.
- 4 ADDITION AREA (AREA 4) TO BE PROTECTED FROM THE EXISTING WEST ROOF SYSTEM INDICATED WITH HATCH PATTERN SHOWN.
- 5 NEW MAIN PIPING TO BE ADDED TO CONVERT NOSE AREA COVERAGE FROM THE EXISTING WEST ROOF SYSTEM TO THE EXISTING EAST ROOF SYSTEM.
- 6 NEW DRAFTSTOP TO BE CREATED ALONG GRIDLINE "6".
- 7 NEW DRAFTSTOP TO BE CREATED ALONG GRIDLINE "8".
- 8 EXISTING EXTERIOR WALL TO BE USED AS DRAFTSTOP.
- 9 PROVIDE A NEW 800 GALLON AFFF CONCENTRATE STORAGE TANK FOR THE EAST ROOF SYSTEM.
- 10 NEW STAINLESS STEEL PIPE AND FITTINGS REQUIRED FOR PIPING CONTAINING AFFF CONCENTRATE.
- 11 REPLACE ALL EXISTING STANDARD RESPONSE SPRINKLER HEADS IN THE AIRCRAFT SERVICE AREA WITH QUICK RESPONSE 79.4°C (175°F) SPRINKLER HEADS.
- 12 EXISTING EAST ROOF SYSTEM AFFF STORAGE TANK TO BE USED FOR NEW AFFF MONITOR SYSTEM.

GENERAL NOTES

- 1 EXISTING ROOF SYSTEM TO BE CALCULATED AT A DESIGN DENSITY OF 6.52 L/min PER SQUARE METER (0.16 G.P.M. PER SQUARE FOOT) OVER THE ENTIRE AREA OF PROTECTION.
- 2 EXISTING OVERHEAD SPRINKLER SYSTEM IS A CLOSED HEAD PRE-ACTION SYSTEM.
- 3 AREA "1" AND "2" IS 1,314.6 SQUARE METERS (14,150 SQUARE FEET).
- 4 AREA "3" AND "4" IS 1,349.0 SQUARE METERS (14,520 SQUARE FEET).
- 5 EXISTING PRE-ACTION ROOF SYSTEMS TO REMAIN UNLESS NEW HYDRAULIC CALCULATIONS REQUIRE MODIFICATIONS TO THE EXISTING INSTALLATION.

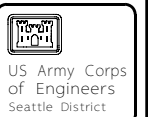


Date	Description	Author	Checked

Designed by:	Drawn by:	Checked by:	Submitted by:
DATE	DESIGN	DATE	DATE
10/10/14	J. [unclear]	11/21/14	J. [unclear]

ADD/ALTER FLIGHTLINE FACILITIES BLDG 304 & 375
 PORTLAND ANG, OREGON
 FY04 PN TORD 012259

**FIRE PROTECTION PLAN
 SPRINKLER PLAN**

1 FIRE PROTECTION SPRINKLER PLAN
 375-M204 SCALE: 3/32" = 1'-0"

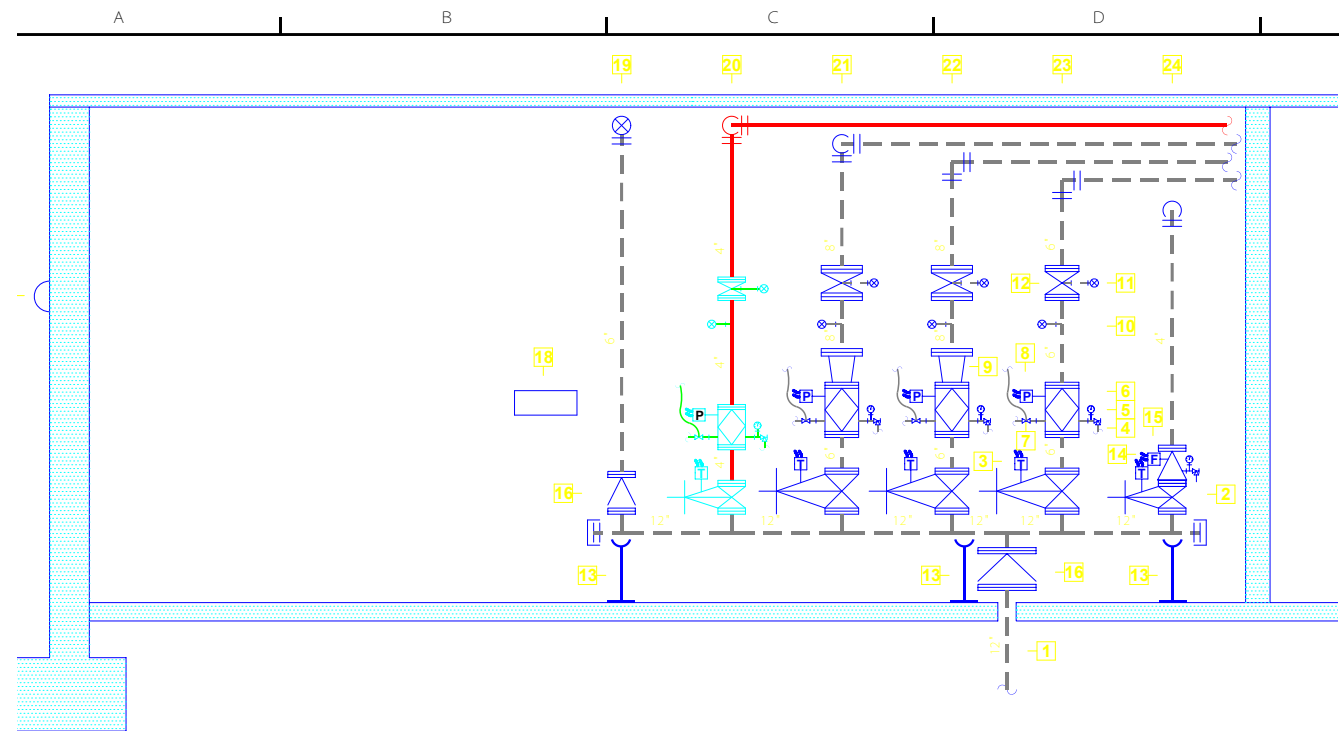


EXISTING RISER DETAIL
 375-M205 SCALE: 1/2" = 1'-0"

EXISTING RISER EQUIPMENT LIST

ITEM	QTY	SIZE	DESCRIPTION
1	1	12"	UNDERGROUND FIRE PROTECTION SUPPLY
2	5	---	OS&Y GATE VALVE
3	5	---	VALVE SUPERVISORY SWITCH
4	5	2"	MAIN DRAIN VALVE
5	5	1/4"	PRESSURE GAUGE
6	4	---	DELUGE/PRE-ACTION VALVE
7	4	---	SOLENOID CONTROLLED RELEASE VALVE
8	4	1/2"	PRESSURE SWITCH - ALARM
9	2	---	FLANGED REDUCER
10	4	---	WATER PRESSURE SUPPLY LINE TO AFFF CONCENTRATE BLADDER TANK
11	4	---	WATER PRESSURE RETURN LINE TO AFFF CONCENTRATE BLADDER TANK
12	4	---	AFFF CONCENTRATE PROPORTIONER FOR 3% AFFF SOLUTION
13	3	---	PIPE STAND
14	1	---	ALARM VALVE
15	1	---	WATER FLOW INDICATOR
16	2	---	SWING CHECK VALVE
17	1	10"	MECHANICAL SPRINKLER ALARM (WATER MOTOR GONG)
18	1	12 HEAD	SPARE HEAD CABINET
19	1	---	FIRE DEPARTMENT CONNECTION PIPING
20	1	---	HAND HELD HOSE LINE FIRE PROTECTION SYSTEM RISER (AFFF SYSTEM)
21	1	---	EAST ROOF FIRE PROTECTION SPRINKLER SYSTEM RISER (AFFF SYSTEM)
22	1	---	WEST ROOF FIRE PROTECTION SPRINKLER SYSTEM RISER (AFFF SYSTEM)
23	1	---	LOW LEVEL MONITOR FIRE PROTECTION SYSTEM RISER (AFFF SYSTEM)
24	1	---	OFFICE FIRE PROTECTION SPRINKLER SYSTEM RISER (WET SYSTEM)



Revised By:	Checked By:	Date

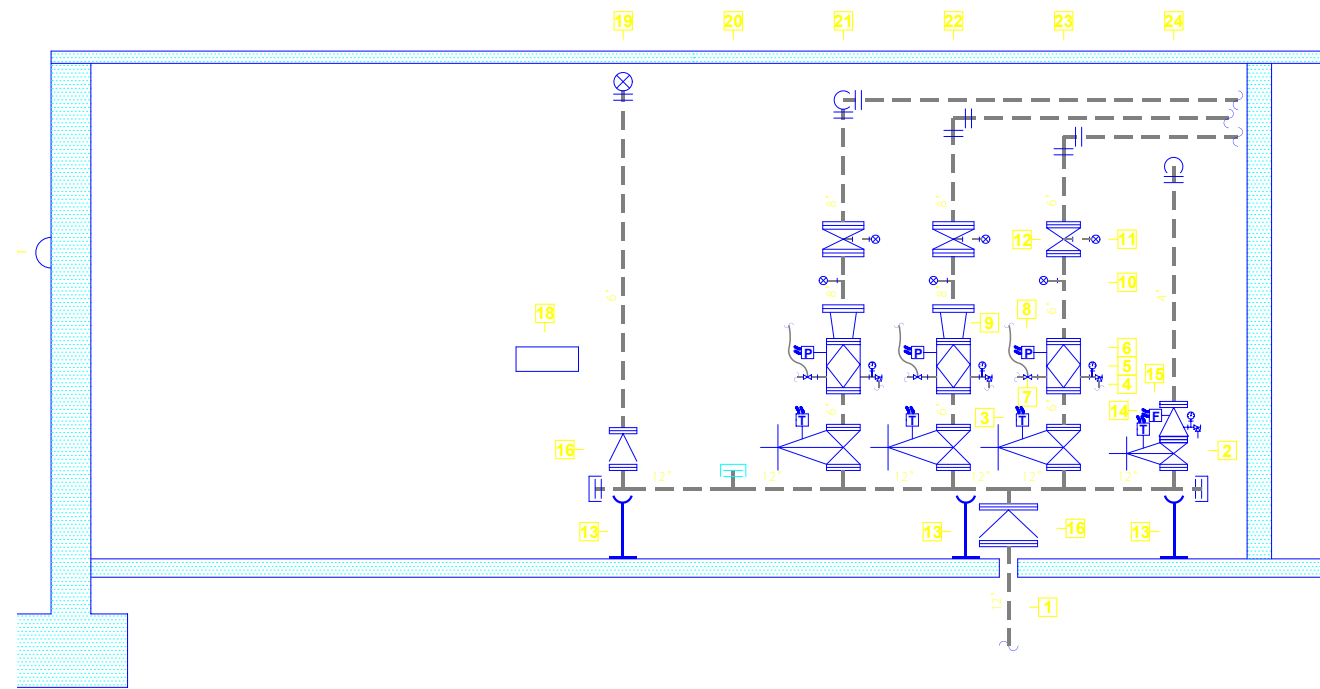

REVISED RISER DETAIL
 375-M205 SCALE: 1/2" = 1'-0"

REVISED RISER EQUIPMENT LIST

ITEM	QTY	SIZE	DESCRIPTION
1	1	12"	UNDERGROUND FIRE PROTECTION SUPPLY
2	4	---	OS&Y GATE VALVE
3	4	---	VALVE SUPERVISORY SWITCH
4	4	2"	MAIN DRAIN VALVE
5	4	1/4"	PRESSURE GAUGE
6	3	---	DELUGE/PRE-ACTION VALVE
7	3	---	SOLENOID CONTROLLED RELEASE VALVE
8	3	1/2"	PRESSURE SWITCH - ALARM
9	2	---	FLANGED REDUCER
10	3	---	WATER PRESSURE SUPPLY LINE TO AFFF CONCENTRATE BLADDER TANK
11	3	---	WATER PRESSURE RETURN LINE TO AFFF CONCENTRATE BLADDER TANK
12	3	---	AFFF CONCENTRATE PROPORTIONER FOR 3% AFFF SOLUTION
13	3	---	PIPE STAND
14	1	---	ALARM VALVE
15	1	---	WATER FLOW INDICATOR
16	2	---	SWING CHECK VALVE
17	1	10"	MECHANICAL SPRINKLER ALARM (WATER MOTOR GONG)
18	1	12 HEAD	SPARE HEAD CABINET
19	1	---	FIRE DEPARTMENT CONNECTION PIPING
20	1	---	NEW CAPPED OUTLET ON SYSTEM MANIFOLD
21	1	---	EAST ROOF FIRE PROTECTION SPRINKLER SYSTEM RISER (AFFF SYSTEM)
22	1	---	WEST ROOF FIRE PROTECTION SPRINKLER SYSTEM RISER (AFFF SYSTEM)
23	1	---	LOW LEVEL MONITOR FIRE PROTECTION SYSTEM RISER (AFFF SYSTEM)
24	1	---	OFFICE FIRE PROTECTION SPRINKLER SYSTEM RISER (WET SYSTEM)

Revised By:	Checked By:	Date

ADD/ALTER FLIGHTLINE FACILITIES BLDG 304 & 375
 PORTLAND ANG, OREGON
 F104 PN TORO 012239
FIRE PROTECTION DETAILS

PLATE NUMBER:
375-M205
 Sheet 72 of 76

Xref R:\ACAD\Pl...Stamps\Dimb.dwg