#### JURISDICTION CODES AND STANDARDS

GOVERNING CODES I. ALL WORK SHALL COMPLY WITH: 2021 OREGON ELECTRICAL SPECIALTY CODE (OESC) 2022 OREGON STRUCTURAL SPECIALTY CODE (OSSC) 2021 OREGON RESIDENTIAL SPECIALTY CODE (ORSC) 2019 OREGON FIRE CODE (IFC)

2021 OREGON PLUMBING SPECIALTY CODE

AND ALL STATE AND LOCAL BUILDING, ELECTRICAL, AND PLUMBING CODES.

SITE CLASSIFICATION NOTES, OSHA REGULATION OCCUPANCY CLASS: SFR CONSTRUCTION CLASS: V-B ZONING TYPE: RESIDENTIAL

- I. A LADDER SHALL BE IN PLACE FOR INSPECTION IN COMPLIANCE WITH OSHA REGULATIONS.
  2. THIS PROJECT HAS BEEN REVIEWED AND WILL NOT DIRECT CONCENTRATED SOLAR RADIATION OR GLARE ONTO NEARBY PROPERTIES OR ROADWAYS.
- 3. JUNCTION BOXES UNDER PV ARRAY SHALL BE INSTALLED TO BE CONSIDERED ACCESSIBLE BY OESC 690.34

ELECTRICAL CRITERIA, NOTES TEMPERATURE SOURCE: ASHRAE WEATHER STATION: PORTLAND INTL AP EXTREME MIN. TEMPERATURE: -6 ASHRAE 0.4% HIGH TEMP: 36

- I. DRAWINGS HAVE BEEN DETAILED ACCORDING TO UL LISTING REQUIREMENTS.
- 2. TERMINALS AND LUGS WILL BE TIGHTENED TO MANUFACTURER TORQUE SPECIFICATIONS (WHEN PROVIDED) IN ACCORDANCE WITH NEC 110,14(D) ON ALL ELECTRICAL.
- 3. PV MODULE CERTIFICATIONS WILL INCLUDE ULI703, IEC61646, IEC61730.
- 4. CONDUIT AND WIRE SPECIFICATIONS ARE BASED ON MINIMUM CODE REQUIREMENTS AND ARE NOT MEANT TO LIMIT UP-SIZING AS REQUIRED BY FIELD CONDITIONS.
- 5. PROPER ACCESS AND WORKING CLEARANCE AROUND EXISTING AND PROPOSED ELECTRICAL EQUIPMENT WILL BE PROVIDED AS PER SECTION [NEC 110.26].
- 6. WHERE PV CABLES ON ROOFTOP WOULD OTHERWISE BE EXPOSED TO PHYSICAL DAMAGE. 3/4" EMT SHALL BE USED TO PROTECT CABLES

STRUCTURAL CRITERIA, NOTES DESIGN LOAD STANDARD: ASCE 7-16 WIND EXPOSURE CATEGORY: C WIND SPEED (3-SEC GUST): 97 MPH GROUND SNOW LOAD: 36 PSF DESIGN ROOF SNOW LOAD: 26 PSF SEISMIC DESIGN CATEGORY: D SEISMIC RISK FACTOR: II

23-102252 RS

#### SCOPE OF WORK

AERIAL SITE VIEW

INSTALLATION OF UTILITY INTERACTIVE PHOTOVOLTAIC SOLAR SYSTEM

5.46 kW DC & 3.77 kW AC PHOTOVOLTAIC SOLAR ARRAY

PV MODULES: (I3) SILFAB SOLAR SIL-420 HC+ INVERTER(S): (I3) ENPHASE IQ8PLUS-72-2-US

ROOF TYPE: COMPOSITION SHINGLE - I LAYER(S)

PV MOUNTING HARDWARE: ECOFASTEN CLICKFIT STANDARD

#### SHEET LIST

COVER SHEET G-I V-2 SITE PLAN

S-3 ROOF PLAN

S-4 STRUCTURAL DETAILS

S-4.I STRUCTURAL SIDE VIEW S-5

STRUCTURAL CALCULATIONS & NOTES E-6 ELECTRICAL DETAILS (LINE DIAGRAM)

E-7 ELECTRICAL CALCULATIONS & NOTES

E-9 ELECTRICAL LABELS & LOCATIONS

CONFIDENTIAL - THE INFORMATION HEREIN CONTAINED SHALL NOT BE USED OR THE BENEFIT OF ANYONE EXCEPT ION DEVELOPER, LLC NOR SHALL IT BE DISCLOSED IN WHOLE OR IN PART TO OTHERS OUTSIDE RECIPIENTS ORGANIZATION, EXCEPT IN CONNECTION WITH THE SALE AND USE OF THE RESPECTIVE EQUIPMENT, WITHOUT THE WRITTEN PERMISSION OF ION DEVELOPER, LLC.



ION DEVELOPER, LLC.

44 F 800 N OREM LIT 84057 888.781.7074

DAVID STANLEY CONRAD C - ELECTRICAL CONTRACTOR CI524

> ) ENPHASE IQ8PLUS-72-2-US •6KW DC, 3.77KW STC-AC, 4.873KW CEC-AC SIL-420 HC-PORTLAND, OREGON SILFAB

46KW 4.8

(I3) 5.46

(13)

PHILIP

3232

Ш

SOUTHEAST 162ND AVENUE

AILA DIMATATAC

DATE

INFORMATION: BLECK

08-Nov-2023

PROJECT ID

00BF7I


SHEET NAME


COVER SHEET


SHEET NUMBER G-I


0

REVISON

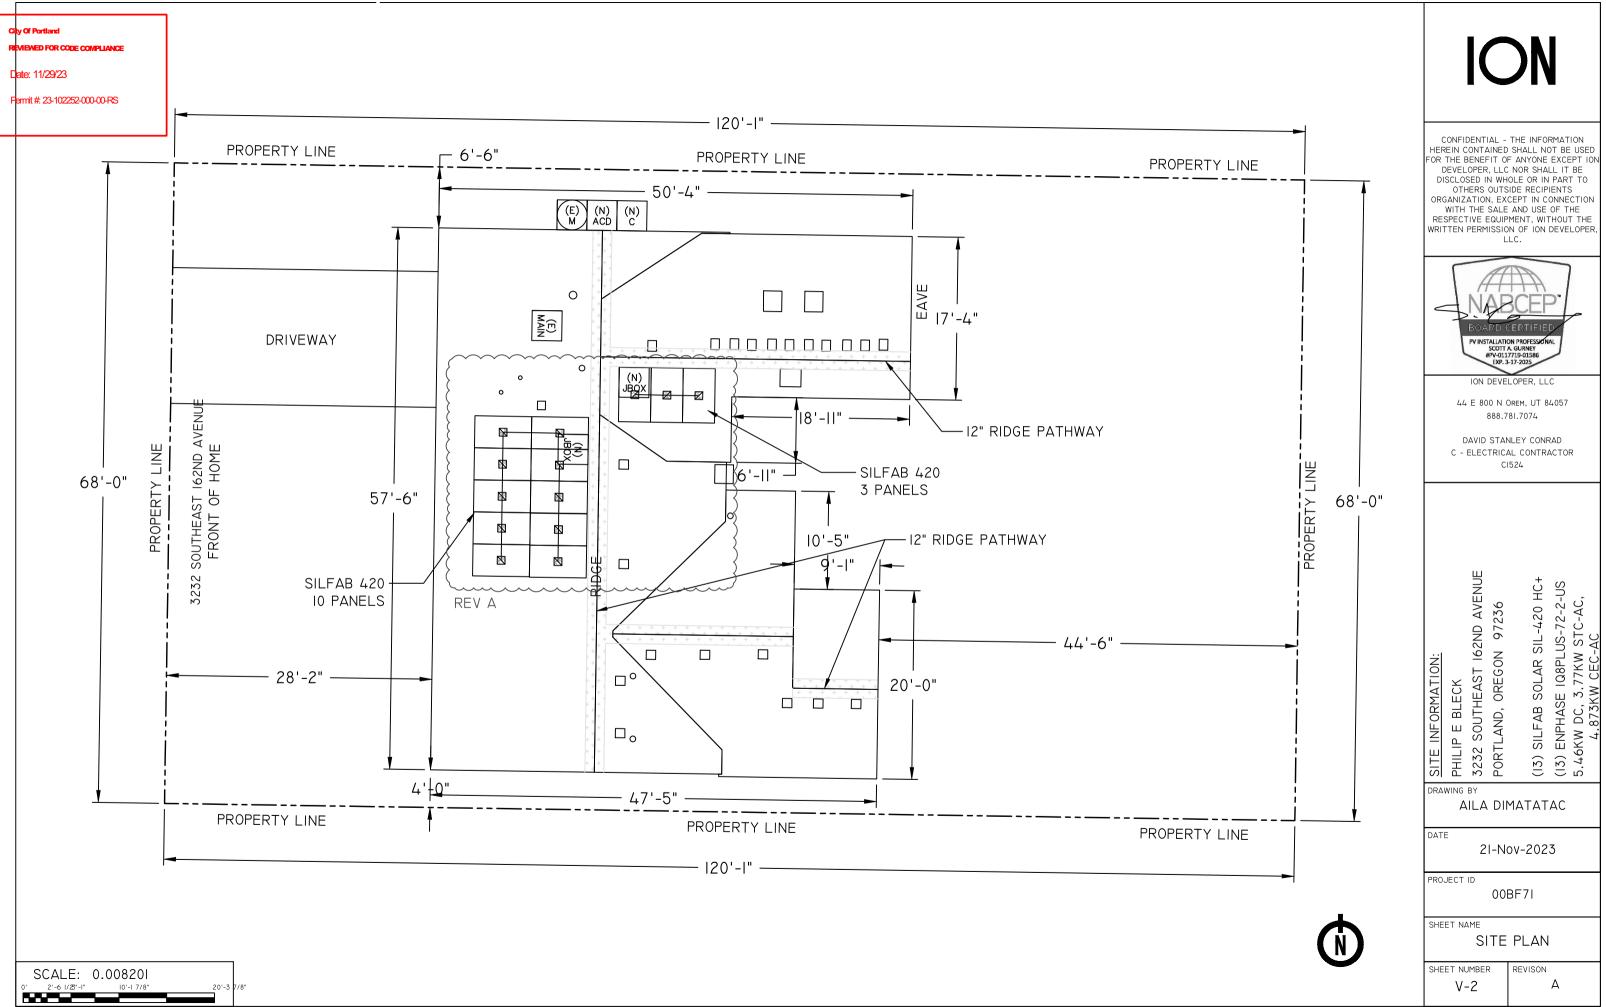

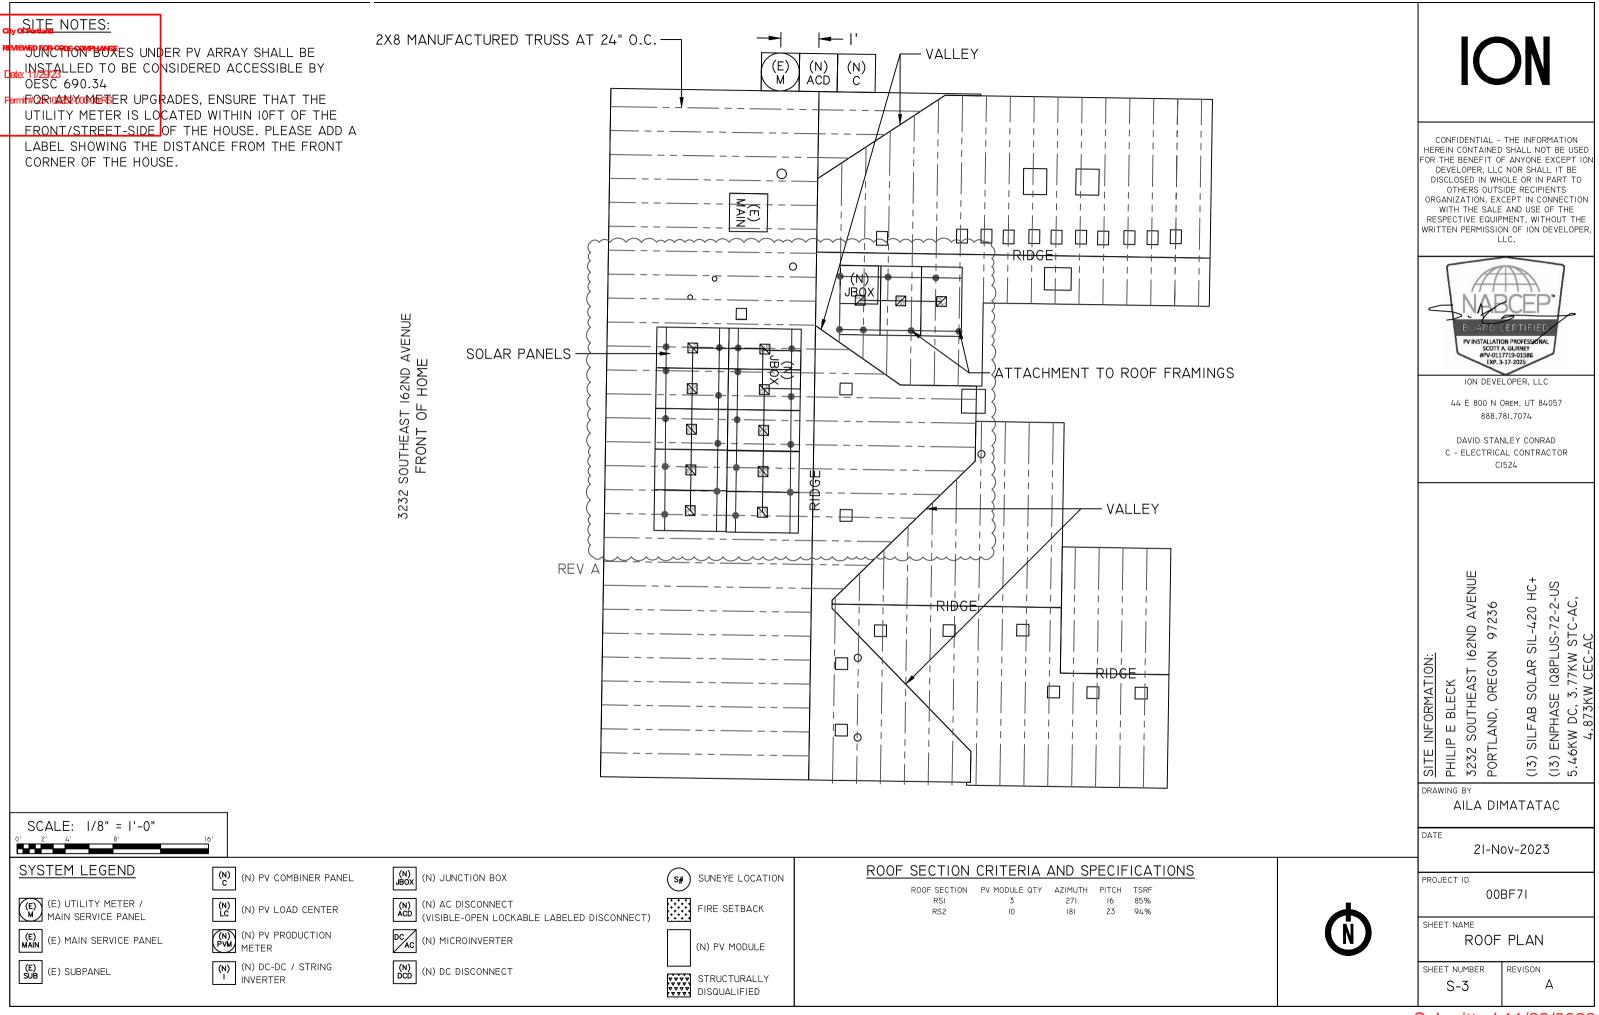

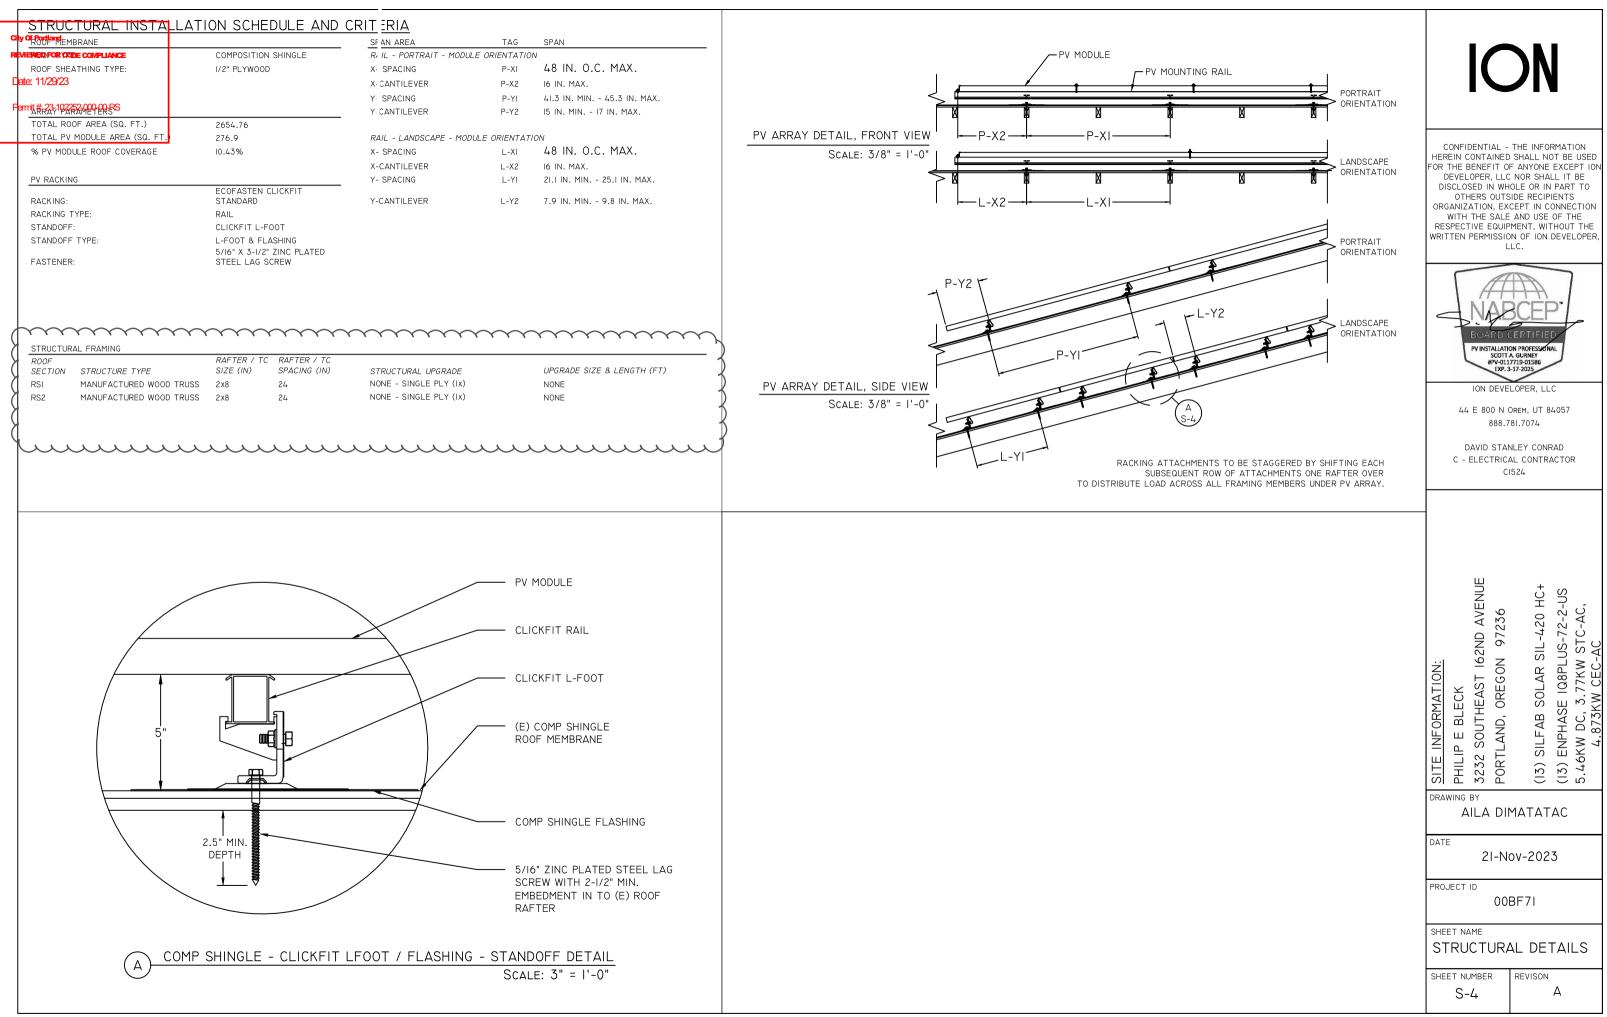

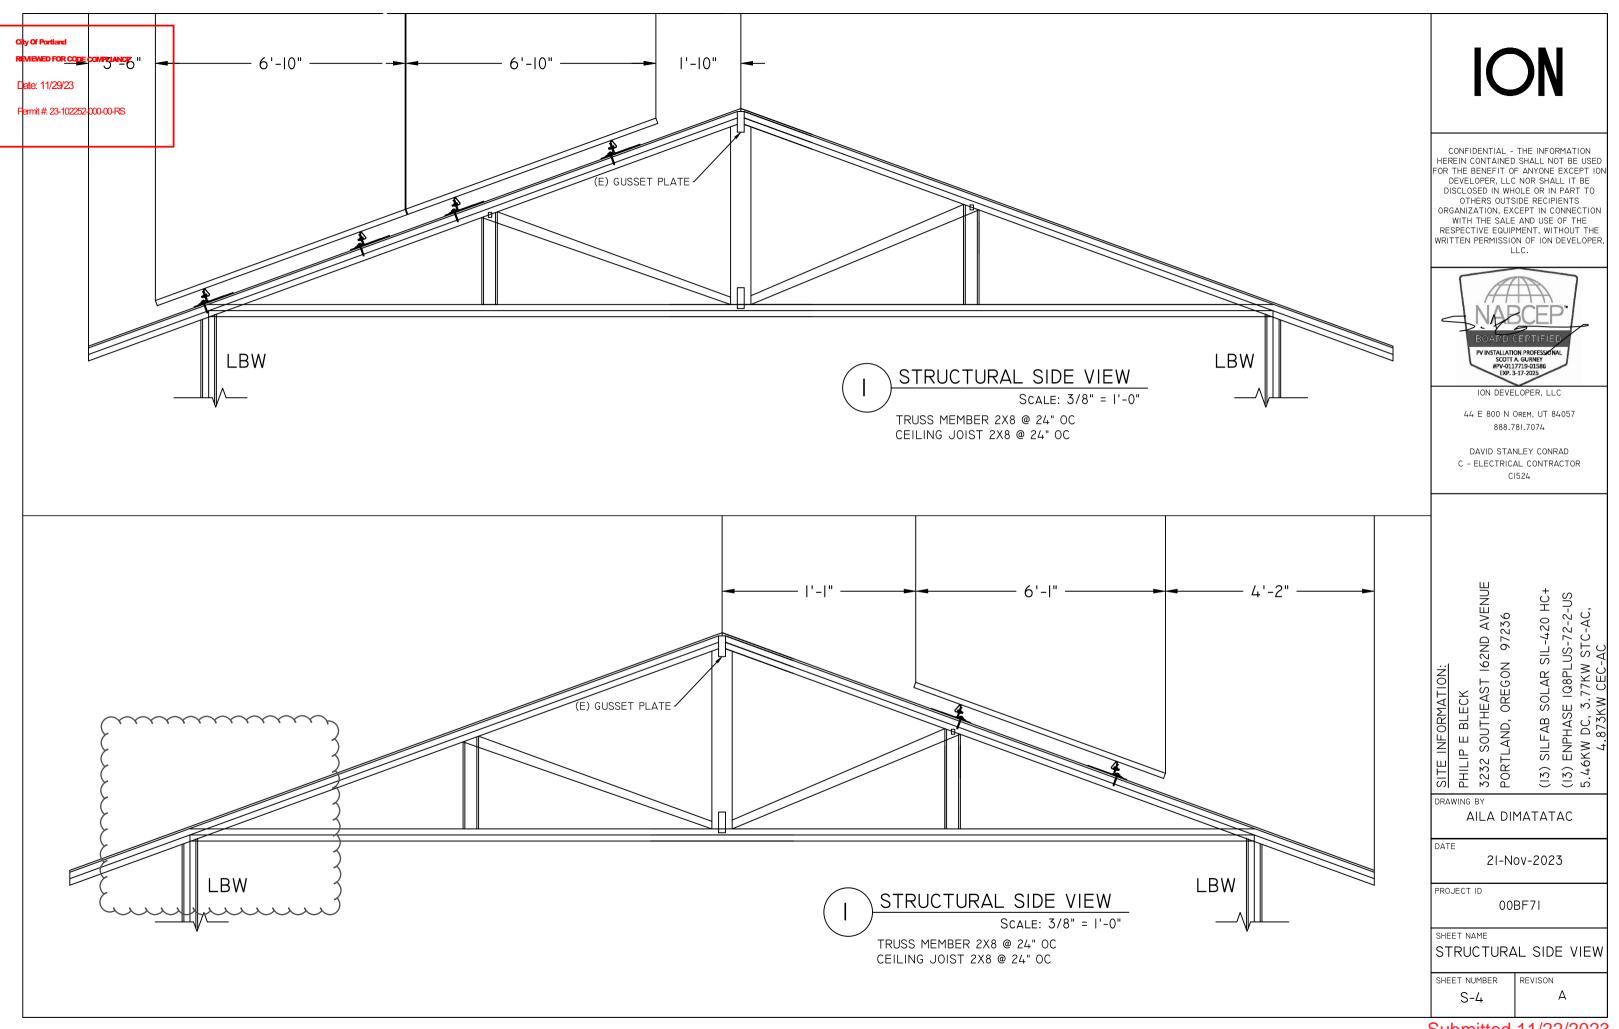


PV SYSTEM STRUCTURAL SPECIFICATIONS AND CALCULATIONS									
City OF Portland DESIGN LOCATION AND SITE SPECIFICATIONS  DESIGNED ROOF SNOW LOAD CALCULATIONS  ASCE 7-16 (C8C) CONNECTIONS - UPLIFT / DOWNWARD									
REVIEWED FOR CODE COMPLIANCE STATE	CITY OF PORTLAND OREGON	SLOPED ROOF SNOW LOAD (PSF)	= Ps = (Cs)(0.7)(CE)(CT)(Is)(PG)		EQN. 7.4-I	GABLE ROOF 7° < Ø ≤ 20°	UPLIFT	FIGURE 30.3-2B DOWNWARD	
ADOPTED LOAD STANDARD  DETC: C11/2003 / RISK CATEGORY	ASCE 7-16		EXPOSURE FACTOR (CE) = THERMAL FACTOR (CT) =	1.0		RAIL - PORTRAIT MODULE ORIENTATION ZONE I		ZONE 2E ALL ZONES	
BASIC WIND SPEED (MPH (3-SEC GUST)	97		IMPORTANCE FACTOR (IS) =	1.0 1.0	TABLE 7.3-2 TABLE 1.5-2	48 IN. O.C. SOLAR PANEL PRESSURE EQ. FACTOR (YA) = 0.80	48 IN. O.C. 4 0.80	8 IN. O.C. 48 IN. O.C. 0.80 0.80	
FemWIMP-5XIN99HP506405598FY GROUND SNOW LOAD (PSF) (PG)	C 36		SLOPE FACTOR (Cs) = Ps (PSF) =	1.0 26	FIG. 7.4-I	EXTERNAL PRESSURE COEFF. (GCP) = $-2.0$ ASD PRESSURE (0.6P)(PSF) = $-17.34$	-3.0 -26.01	-3.6 0.7 -31.21 16.86	
BASE ELEVATION (FT)	64			20		TRIBUTARY AREA (SQ. FT) = 12.6	12.6	9.4	
		DESIGN WIND PRESSURE CALCULA DESIGN WIND PRESSURE (PSF) = P			ASCE 7-I6 (C&C)	MAX. UPLIFT (0.6D+0.6P) (LBS) = -194.9	-303.7	-276.8	CONFIDENTIAL THE INFORMATION
PV SYSTEM STRUCTURAL SPECIFICATIONS		QH(GCP)(YE)(YA)			EQN. 26.10-I	RAIL - LANDSCAPE MODULE ORIENTATION			CONFIDENTIAL - THE INFORMATION HEREIN CONTAINED SHALL NOT BE USED
STRUCTURE TYPE - ROOF SHAPE	INHABITED - GABLE / FLAT ROOF	VELOCITY PRESSURE (PSF) = QH = 0.00256(KH)(KZT)(KD)(KE)(V^2)			TABLE 26.13-1	48 IN. O.C.	48 IN. O.C. 4	8 IN. O.C. 48 IN. O.C.	FOR THE BENEFIT OF ANYONE EXCEPT ION DEVELOPER, LLC NOR SHALL IT BE
MIN. ROOF SLOPE (DEG.) MEAN ROOF HEIGHT (FT.)	16 18		TERRAIN EXPO. CONSTANT (a) = TERRAIN EXPO. CONSTANT (ZG)(FT) =	9.5 900	TABLE 26.II-I TABLE 26.II-I	SOLAR PANEL PRESSURE EQ. FACTOR (YA) = 0.80 EXTERNAL PRESSURE COEFF. (GCP) = -2.0	0.80 -3.0	0.80 0.80 -3.6 0.7	DISCLOSED IN WHOLE OR IN PART TO
PORTRAIT ATT. SPACING (IN. O.C.)	48		VP EXPOSURE COEFF.(KH) =	0.88	EQN. C26.10-1	ASD PRESSURE (0.6P)(PSF) = -17.34	-26.01	-31.21 16.86	OTHERS OUTSIDE RECIPIENTS ORGANIZATION, EXCEPT IN CONNECTION
LANDSCAPE ATT. SPACING (IN. O.C.) # OF ATTACHMENT POINTS	48 28		TOPOGRAPHIC FACTOR (Kzt) = WIND DIRECTIONALITY FACTOR (Kb) =	1.0 0.85	EQN. 26.8-I TABLE 26.6-I	TRIBUTARY AREA (SQ. FT) = 6.80  MAX. UPLIFT (0.6D+0.6P) (LBS) = -105.6	6.80 -164.6	5.10 -I50.0	WITH THE SALE AND USE OF THE
MAX. POINT LOAD (LBS / ATT.)	37.7		ARRAY EDGE FACTOR (YE) =	1	EQN. 29.4-7		104.0		RESPECTIVE EQUIPMENT, WITHOUT THE WRITTEN PERMISSION OF ION DEVELOPER,
MAX. TOTAL PV DEAD LOAD TO RAFTER (LBS)	75.5		QH (PSF) =	18.06	FIG. 29.4-8	ROOF ATTACHMENT / FASTENER CHECK CLICKFIT L-FOOT - 5/16" X 3-1/2" ZINC PLATED STEEL LAG SCREW		NDS 12.2	LLC.
PV SYSTEM EQUIPMENT SPECIFICATIONS  EQN. 26.10-1 LAG SCREW WITHDRAWAL DESIGN VALUE (LBS) = W = 1800(G^3/2)(D^3/4) 12.2.1									
MODULE MANUFACTURER / TYPE SOLAR MODULE WEIGHT (LBS)	SILFAB SOLAR SIL-420 HC+ 47					ROOF ATTACHMENT FASTENER (D) (IN.) = 5/16 FASTENER QTY PER ATTACHMENT = 1		TABLE 2.3.2 ABLE 12.3.3A	
SOLAR MODULE LENGTH (IN.)	75.3	RAIL - COMPRESSION / UPLIFT			CONTINUE OF THE CONTINUE OF TH	FASTENER EMBEDMENT DEPTH (IN.) = 2.5			\ <del>// /   \ \</del>
SOLAR MODULE WIDTH (IN.) SOLAR MODULE AREA (SQ. FT)	40.8 2I.3	ECOFASTEN CLICKFIT STANDARD	MAXIMUM HORIZONTAL RAIL SPAN (FT.) =	4.0	CONTINOUS SPAN BM = (wL^2)/(8(S))	LUMBER SPECIFIC GRAVITY (G) = 0.5 LOAD DURATION FACTOR (Cb) = 1.6			A NARCEP'I
	ECOFASTEN CLICKFIT STANDARD		MAXIMUM VERTICAL SPACING BETWEEN RAILS (FT.) =	3.8	LIDLIET	PRYING COEFFICIENT = 1.5 WITHDRAWAL DESIGN VALUE(W)(LBS / IN.) = 266.0			
PV ROOF ATTACHMENT	RAIL CLICKFIT L-FOOT		TOTAL LOAD (PSF) =	COMPRESSION 27.8	UPLIFT 16.3	LAG SCREW WITHDRAWL CAPACITY (LBS) = 709.3			BOARD CERTIFIED  PV INSTALLATION PROFESSIONAL
	5/I6" X 3-I/2" ZINC PLATED STEEL LAG SCREW 0.8		TOTAL LOAD (W)(LB. / FT.) = ALLOWABLE MANU. BENDING MOMENT (LB. / FT.) =	105.0 422	61.4 517	MANUFACTURER MAX. UPLIFT CAPACITY (LBS) = 895.0 MAX. ATT. WITHDRAWAL CAPACITY (LBS) = 709.3			SCOTT A. GURNEY #PV-0117719-01586
SOLAR MODULE DEAD LOAD (PSF)	2.21		ACTUAL MAX. BENDING STRESS (LB / FT.) =	209.9	122.7				EXP. 3-17-2025
TOTAL PV ARRAY DEAD LOAD (PSF) GRAVITY LOAD / FRAMING CALCULATIONS	3.01			OK	OK	MAX. ATT. WITHDRAWL STRESS (LBS) = 303.7	OK		ION DEVELOPER, LLC
DEAD LOAD (PSF)	TYYYYR TYYYY	Y R62 Y Y Y Y Y	~~~~						44 E 800 N OREM, UT 84057
ROOF MEMBRANE	COMPOSITION SHINGLE 4.0 COMPOSI	TION SHINGLE 4.0	$\downarrow$						888.781.7074
SHEATHING	/ 1/2" PLYWOOD 1.7 1/2" PLYW	VOOD 1.7	$\downarrow$						
PITCH (DEG)	<b>)</b> 16 23		$\downarrow$						DAVID STANLEY CONRAD
	MANUFACTURED WOOD MANUFACTURED	CTURED WOOD	2						C - ELECTRICAL CONTRACTOR CI524
	TRUSS - NONE - TRUSS -	NONE - SINGLE	2						0.0024
FRAMING	CHORD 2X8 @ 24 IN. 1.0 PLT (IA)	- TOP CHORD 1.8 + IN. O.C DF	2						
		T. MAX SPAN	)						
	>		)						
TOTAL ROOF DEAD LOAD (PSF) ADJUSTED TO SLOPED ROOF (PSF)	7.5 7.7	7.5 8.2	2						
	>		)						
PV ARRAY ADJ. TO ROOF SLOPE (PSF) ROOF LIVE LOAD < ROOF SNOW LOAD (PSF)	3.I 26.0	3.3 26.0	)						
TOTAL LOAD (PSF)	36.8	37.5	)						NUB
	DF #2 - 2x8 - NONE - DF #2 -	2x8 - NONE - SINGLE	)						
RAFTER / TOP CHORD MEMBER PROPERITES	SINGLE PLY (IX)	PLY (IX)	)						Z3 23 -23 -2-4 - 4-4
SECTION MODULUS (S)(IN^3) MOMENT OF INERTIA (I)(IN^4)	13.14 47.63	13.14 47.63	)						
TOTAL LOAD ON MEMBER (W) (PLF)	73.7	74.9	)						
MAX. MEMBER SPAN (L) (FT) MODULUS OF ELASTICITY (E) (PSI)	6 1600000	6 1600000	)						
SHEAR (Fv) (PSI)	<b>&gt;</b> 180	180	)						ORMATION: BLECK JTHEAST 16 ID, OREGON AB SOLAR \$ HASE IQ8PL DC, 3.77KW 173KW CEC-
AREA (A) (IN^2)	10.875	10.875	)						RMATI LECK HEAS , ORE 3 SOL SE IQ SE IQ
MAX BENDING STRESS CHECK		FB)(CD)(CF)(CR)	)						ORMA BLE UTHE VD, O AB S AASE DC, 3
BENDING (FB) (PSI)  LOAD DURATION FACTOR (CD)	900 1.15	900 1.15	)						
SIZE FACTOR (CF)	1.20	1.20	)						E INFOR
REPETITIVE MEMBER FACTOR (CR) ALLOWABLE BENDING STRESS (PSI)	1.15 1428.3	1.15 1428.3	)						SITE IN PHILIP 3232 S PORTLA (13) SIL (13) EN 5.46KW
	>		)						SITE PHILL 323; POR (13) (13) (13) 5.46
ACTUAL BENDING STRESS (PSI) = (wL^2)/(8(S	302.8 21% OK	307.9 22% OK	)						DRAWING BY
	>		)						AILA DIMATATAC
MAX DEFLECTION CHECK - TOTAL LOAD ALLOWABLE DEFLECTION	<del></del>	ORM DISTRIBUTED	)						
ALLOWABLE DEFLECTION	L / 180 0.400 IN.	L / 180 0.400 IN.	)						DATE
ACTUAL MAX DEFLECTION	(W)(L) <sup>4</sup> / 185(E)(1) (W)	)(L)^4 / I85(E)(I)	Ć						21-Nov-2023
	0.012 IN. 3% OK	0.012 IN. 3% OK	j						
MAX DEFLECTION CHECK - LIVE LOAD			7						PROJECT ID
ALLOWABLE DEFLECTION	L / 240 0.3 IN.	L / 240 0.3 IN.	7						00BF7I
ACTUAL MAX DEFLECTION	(W)(L) <sup>4</sup> / 185(E)(1) (W)	)(L)^4 / I85(E)(I)	4						
	0.010 IN. 3% OK	0.010 IN. 3% OK	<u> </u>						SHEET NAME
MAX SHEAR CHECK	(		<u> </u>						STRUCTURAL CALCS
ALLOWABLE SHEAR	Fv (A) 1957.5 LBS.	Fv (A) 1957.5 LBS.	$\prec$						
ACTUAL MAX SHEAR	(w)(L)/2	(w)(L)/2	$\prec$						SHEET NUMBER REVISON
	22I LBS. II% OK	225 LBS. 11% OK	$\prec$						S-5 A
	( 1176 UN	11 70 UN							

turumum turum turu



#### CONDUCTOR AND RACEWAY SCHEDULE QTY SIZE - # TYPE (1) 12 AWG 2C, TC-ER, CU. QTY SIZE - # TYPE (1) 10 AWG 2C, NM-B W/G, CU. QTY SIZE - # TYPE QTY SIZE - # TYPE DESIGNATOR (1) 10 AWG THHN / THWN-2, CU. BLACK (L1) 15.73 A AC (MAX) (L1, L2, EGC) 15.73 A AC (MAX) (1) 10 AWG THHN / THWN-2, CU. BLACK (L1) 15.73 A AC (MAX) 15.73 A AC (MAX) (L1, L2) (1) 10 AWG THHN / THWN-2, CU. RED (L2) 240 V AC (1) 10 AWG THHN / THWN-2, CU. RED (L2) 240 V AC (CABLE) 240 V AC (1) 6 AWG SOLID BARE CU. (EGC) 240 V AC (1) 10 AWG THHN / THWN-2, CU. WHITE (N) (1) 10 AWG THHN / THWN-2, CU. GREEN (EGC) (1) 10 AWG THHN / THWN-2, CU. GREEN (EGC) (RACEWAY) (1) 3/4 IN. EMT (RACEWAY) EXTERIOR INTERIOR (1) 3/4 IN FMT FXTFRIOR EXTERIOR (1) 6 AWG THHN / THWN, CU. BLACK (L1) 15.73 A AC (MAX) (1) 6 AWG THHN / THWN, CU. RED (L2) 240 V AC (1) 6 AWG THHN / THWN, CU. WHITE (N) (1) 6 AWG THHN / THWN, CU. GREEN (GEC) (RACEWAY) (1) 3/4 IN. PVC SCH. 40 EXTERIOR

CONFIDENTIAL - THE INFORMATION HEREIN CONTAINED SHALL NOT BE USED FOR THE BENEFIT OF ANYONE EXCEPT ION DEVELOPER, LLC NOR SHALL IT BE DISCLOSED IN WHOLE OR IN PART TO OTHERS OUTSIDE RECIPIENTS ORGANIZATION, EXCEPT IN CONNECTION WITH THE SALE AND USE OF THE RESPECTIVE EQUIPMENT, WITHOUT THE WRITTEN PERMISSION OF ION DEVELOPER, LLC.

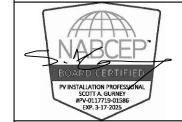

44 E 800 N OREM, UT 84057 888.781.7074

DAVID STANLEY CONRAD C - ELECTRICAL CONTRACTOR CI524



P E BLECK SOUTHEAST 162ND AVENUE SOLAR SIL-420 HC+ 3) ENPHASE IQ8PLUS-72-2-US 46KW DC, 3.77KW STC-AC, 4.873KW CEC-AC 97236 PORTLAND, OREGON SITE INFORMATION:
PHILIP E BLECK
3232 SOUTHEAST 162 SILFAB

(13)

(13) 5.46

DRAWING BY

AILA DIMATATAC

DATE

08-Nov-2023

PROJECT ID

00BF7I

SHEET NAME


ELEC. LINE DIAG.

REVISON

0

SHEET NUMBER E-6

### ELECTRICAL LINE DIAGRAM

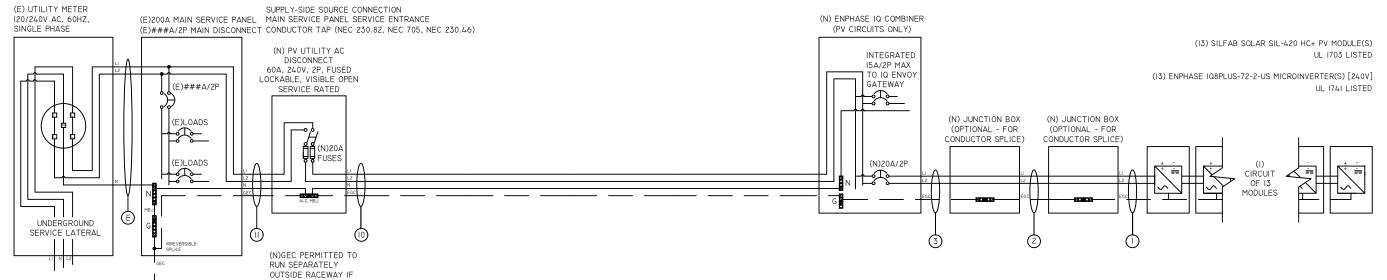

### ELECTRICAL LINE DIAGRAM NOTES

(E) GROUNDING ELECTRODE

SYSTEM

SOLID BARE AND NOT EXPOSED TO PHYSICAL

[NEC 250.64(B)]


## PV SYSTEM ELECTRICAL SPECIFCATIONS AND CALCULATIONS

DESIGN LOCATION AND TEMPERATURES	
TEMPERATURE DATA SOURCE	ASHRAE
STATE	OREGON
JURISDICTION	CITY OF PORTLAND
WEATHER STATION	PORTLAND INTL AP
ASHRAE EXTREME LOW TEMP (°C)	
	-6
ASHRAE 0.4% HIGH TEMP (°C)	36
DESIGNED MAX. SYSTEM VDROP / VRISE	4.00%
PV MODULE SPECIFICATIONS	SILFAB SOLAR SIL-420 HC+
RATED POWER (PMAX) (W)	420
MAXIMUM POWER VOLTAGE (VMP)	39.19
MAXIMUM POWER CURRENT (IMP)	10.72
OPEN CIRCUIT VOLTAGE (VOC)	45.67
SHORT CIRCUIT CURRENT (ISC)	11.46
PMP/VMP TEMP. COEFFICIENT	-0.36
VOC TEMP. COEFFICIENT	-0.28
SERIES FUSE RATING	20
ADJ. MODULE VOC @ ASHRAE LOW TEMP	49.6
ADJ. MODULE VMP @ ASHRAE 2% AVG. HIGH TEMP	33.1
INVERTER SPECIFICATIONS	ENPHASE IQ8PLUS-72-2-US
TYPE	MICROINVERTER
MAX. OR RECOMMENDED MODULE POWER (W)	440
MAXIMUM INPUT DC OPEN-CIRCUIT VOLTAGE (VOC)	60
MINIMUM START VOLTAGE (V)	30
MAXIMUM START VOLTAGE(V)	58
MAXIMUM INPUT CURRENT (ISC) (A)	15
MAX CONTINUOUS OUTPUT POWER (VA)	290
MAX. CONTINUOUS OUTPUT CURRENT (A)	1.21
NOMINAL (L-L) OUTPUT VOLTAGE	240
CEC WEIGHTED EFFICIENCY (%)	97.0%
SYSTEM ELECTRICAL SPECIFICATIONS	CIR I
NUMBER OF MODULES PER CIRCUIT	13
DC POWER RATING PER CIRCUIT (STC)(W DC)	5460
TOTAL MODULE QUANTITY	13 PV MODULES
STC DC POWER RATING OF ARRAY	5460W DC
INVERTER OUTPUT CIRCUIT CURRENT(A AC)	15.73
125% INVERTER OUTPUT CIRCUIT CURRENT(A AC)	19.66
CIRCUIT OCPD RATING (A)	20
	I5.73A
COMBINED INVERTER CONTINUOUS OUTPUT CURRENT PV POWER PRODUCTION SYSTEM OCPD RATING	AC
(XI25%)	20A
MAX. ARRAY STC-AC POWER (W)	3770W AC (STC)
MAX. ARRAY CEC-AC POWER (W)	4873W AC (CEC)
AC VOLTAGE RISE CALCULATIONS	DIST (FT) COND. VRISE(V) VEND(V) %VRISE
VRISE SEC. I (MICRO TO JBOX) *	28.8    2 Cu.
VRISE SEC. 2 (JBOX TO COMBINER BOX)	76 10 Cu. 2.9 242.9 1.20%
VRISE SEC. 3 (COMBINER BOX TO POI)	10 10 CU. 0.4 240.4 0.16%
TOTAL VRISE	5.I 245.I 2.II% OK
* 8 MICROINVERTER MAX SUB-BRANCH CIRCUIT SIZE	TO COMPLY WITH VRISE CALCULATIONS.

RACEWAY / CONDUCTOR CALCULATIONS JUNCTION BOX TO COMBINER BOX (3) MICROINV. TO JUNCTION BOX (I) MAX INVERTER OUTPUT CIRCUIT CURRENT = 15.7 A AC MAX INVERTER OUTPUT CIRCUIT CURRENT = 15.7 A AC IO AWG THHN / THWN-2, CU. CONDUCTOR SIZE / INSULATION / TYPE = 12 AWG 2C, TC-ER, CU. CONDUCTOR SIZE / INSULATION / TYPE = CONDUCTOR AMP. RATING @ 90°C = 30 A CONDUCTOR AMP. RATING @75°C = 30 A PER NEC 690.8(B)(I)(W/OUT CORRECTION FACTORS) PER NEC 690.8(B)(I)(W/OUT CORRECTION FACTORS) MAX INVERTER OUTPUT CURRENT XI25%= 20.0 A AC MAX INVERTER OUTPUT CURRENT XI25%= 20.0 PER NEC 690.8(B)(2)(WITH CORRECTION FACTORS) PER NEC 690.8(B)(2)(WITH CORRECTION FACTORS) AMB. TEMP. AMP. CORRECTION = 0.91 AMB. TEMP. AMP. CORRECTION = 0.88 # OF CONDUCTORS IN RACEWAY CORRECTION = 1.0 # OF CONDUCTORS IN RACEWAY CORRECTION = 1.0 ADJUSTED CONDUCTOR AMPACITY (A) = 27.3 A AC ADJUSTED CONDUCTOR AMPACITY (A) = 26.4 A AC LARGER AMPACITY OF 690.8(B)(I) or (B)(2) = 20.0 < 27.3LARGER AMPACITY OF 690.8(B)(I) or (B)(2) = 20.0 < 26.4(B)(I) - W/OUT CORRECTION FACTORS (B)(I) - W/OUT CORRECTION FACTORS LARGER AMPACITY COMPLIANCE = 30.0 > 20.0 LARGER AMPACITY COMPLIANCE = 30.0 > 20.0 OK FMT OR NO RACEWAY SIZE / TYPE = 3/4 IN. RACEWAY RACEWAY SIZE / TYPE = 3/4 IN. EMT CONDUCTOR(S) / CABLE(S) CROSS-SECTION AREA CONDUCTOR(S) / CABLE(S) CROSS-SECTION AREA  $(IN.^2) = 0.142 IN.2$  $(IN.^2) = 0.063 IN.^2$ CROSS-SECTIONAL AREA OF RACEWAY(IN.^2) = 0.533 IN.2 CROSS-SECTIONAL AREA OF RACEWAY(IN.^2) = 0.533 IN.^2 % ALLOWABLE RACEWAY FILL (NEC CH. 9, TBL I) = 53% > % ALLOWABLE RACEWAY FILL (NEC CH. 9, TBL I) = JUNCTION BOX TO JUNCTION BOX (2) COMBINER BOX TO MAIN PV OCPD (IO) MAX INVERTER OUTPUT CIRCUIT CURRENT = 15.7 A AC COMBINED INVERTER CONTINUOUS OUTPUT CURRENT = 15.7 A AC CONDUCTOR SIZE / INSULATION / TYPE = 10 AWG 2C, NM-B W/G, CU. CONDUCTOR SIZE / INSULATION / TYPE = 10 AWG THHN / THWN-2, CU. CONDUCTOR AMP. RATING @60°C = 30 A CONDUCTOR AMP. RATING @75°C = 35 A PER NEC 690.8(B)(I)(W/OUT CORRECTION FACTORS) PER NEC 690.8(B)(I)(W/OUT CORRECTION FACTORS) MAX COMBINED INVERTER CONTINUOUS OUTPUT MAX INVERTER OUTPUT CURRENT XI25%= 20.0 A AC CURRENT XI25% = 20.0 A AC PER NEC 690.8(B)(2)(WITH CORRECTION FACTORS) PER NEC 690.8(B)(2)(WITH CORRECTION FACTORS) AMB. TEMP. AMP. CORRECTION = 0.82 AMB. TEMP. AMP. CORRECTION = # OF CONDUCTORS IN RACEWAY CORRECTION = 1.0 # OF CONDUCTORS IN RACEWAY CORRECTION = 1.0 ADJUSTED CONDUCTOR AMPACITY (A) = 24.6 A AC ADJUSTED CONDUCTOR AMPACITY (A) = 30.8 A AC LARGER AMPACITY OF 690.8(B)(I) or (B)(2) = 20.0 < 24.6LARGER AMPACITY OF 690.8(B)(I) or (B)(2) = 20.0 < 30.8 (B)(I) - W/OUT CORRECTION FACTORS (B)(I) - W/OUT CORRECTION FACTORS 35.0 > 20.0 OK LARGER AMPACITY COMPLIANCE = 30.0 > 20.0 OK LARGER AMPACITY COMPLIANCE = RACEWAY SIZE / TYPE = RACEWAY SIZE / TYPE = 3/4 IN. NO RACEWAY EMT CONDUCTOR(S) / CABLE(S) CROSS-SECTION AREA



CONFIDENTIAL - THE INFORMATION HEREIN CONTAINED SHALL NOT BE USED FOR THE BENEFIT OF ANYONE EXCEPT ION DEVELOPER, LLC NOR SHALL IT BE DISCLOSED IN WHOLE OR IN PART TO OTHERS OUTSIDE RECIPIENTS ORGANIZATION, EXCEPT IN CONNECTION WITH THE SALE AND LISE OF THE RESPECTIVE EQUIPMENT, WITHOUT THE WRITTEN PERMISSION OF ION DEVELOPER LLC.

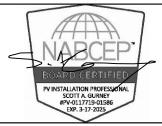

ION DEVELOPER, LLC

44 E 800 N OREM, UT 84057 888.781.7074

DAVID STANLEY CONRAD C - FLECTRICAL CONTRACTOR CI524

> HC+ 97236 SIL-420 OREGON SOLAR PORTLAND, SILF

3 3)

DRAWING BY

PHILIP 3232 S

AILA DIMATATAC

DATE

INFORMATION

SITE

BLECK

Ш

0.084 IN.^2

40% > 16% OK

CROSS-SECTIONAL AREA OF RACEWAY(IN.^2) =

% ALLOWABLE RACEWAY FILL (NEC CH. 9, TBL I) =

08-Nov-2023

PROJECT ID

SHEET NAME

00BF7I

ELECTRICAL CALCS.

REVISON

0

SHEET NUMBER

E-7

162ND AVENUE 3) ENPHASE IQ8PLUS-72-2-US 46KW DC, 3.77KW STC-AC, 4.873KW CEC-AC SOUTHEAST

#### ELECTRICAL FIELD-APPLIED HAZARD MARKINGS

## PHOTOVOLTAIC SYSTEM 🕰 AC DISCONNECT 🕰

RATED AC OUTPUT CURRENT 15.7 A NOMINAL OPERATING AC VOLTAGE 240 V

AT EACH PV SYSTEM DISCONNECTING MEANS. А [NEC 690.54, NEC 690.13(B)]

RAPID SHUTDOWN SWITCH FOR SOLAR PV SYSTEM

SIGN LOCATED ON OR NO MORE THAN 3 FT FROM THE RAPID SHUT DOWN DISCONNECT SWITCH(S). IF MORE THAN ONE PV RSD IS IN AN ENCLOSURE, EACH SHALL BE LABELED. [NEC 690.56(C), NEC 690.12(C)]

# **△WARNING**

ELECTRIC SHOCK HAZARD

TERMINALS ON THE LINE AND LOAD SIDES MAY BE ENERGIZED IN THE OPEN POSITION ....

FOR PV DISCONNECTING MEANS WHERE ALL В TERMINALS OF THE DISCONNECTING MEANS MAY BE ENERGIZED IN THE OPEN POSITION. [NEC 690.13(B), NEC 705.22]

#### SOLAR PV SYSTEM EQUIPPED WITH RAPID SHUTDOWN TURN RAPID SHUTDOWN SWITCH TO THE "OFF" POSITION TO SHUT DOWN PV SYSTEM AND REDUCE IN THE ARRAY

FOR BUILDINGS WITH PV SYSTEMS. TO BE LOCATED AT EACH SERVICE EQUIPMENT LOCATION TO WHICH THE PV SYSTEM IS CONNECTED. [NEC 690.56(C)]

# **MARNING**

**DUAL POWER SUPPLY** 

SOURCES: UTILITY GRID AND PV SOLAR ELECTRIC SYSTEM

AT EQUIPMENT CONTAINING OVERCURRENT С DEVICES IN CIRCUTS SUPPLYING POWER TO A BUSBAR OR CONDUCTOR SUPPLIED FROM MULTIPLE SOURCES. [NEC 705.12(C)]

#### CAUTION MULTIPLE SOURCES OF POWER

MAIN SERVICE DISCONNECT

Power to this building is also supplied from a solar array with a disconnecting means located

PERMANENT DIRECTORY TO BE LOCATED AT MAIN SERVICE EQUIPMENT DENOTING THE LOCATION OF THE PV RAPID SHUTDOWN SYSTEM DISCONNECTING MEANS IF SOLAR ARRAY RAPID SHUT DOWN DISCONNECT SWITCH IS NOT GROUPED AND WITHIN LINE OF SITE OF MAIN SERVICE DISCONNECTING MEANS. [NEC 705.10, NEC 690.56(C)(I)]

## *∧***WARNING**


POWER SOURCE OUTPUT CONNECTION DO NOT RELOCATE THIS OVERCURRENT DEVICE PLACED ADJACENT TO PV SYSTEM PLUG-IN TYPE BREAKER TO A BUSBAR FOR A LOAD SIDE CONNECTION. [NEC 705.12(B)(3)(2)]

### CAUTION

MULTIPLE SOURCES OF POWER SOLAR ARRAY DISCONNECT

Power to this building is also supplied from the utility with a main service disconnecting means located next to the utility meter.

PERMANENT DIRECTORY TO BE LOCATED AT SOLAR ARRAY RAPID SHUTDOWN SWITCH DENOTING THE LOCATION OF THE SERVICE EQUIPMENT LOCATION IF SOLAR ARRAY RAPID SHUT DOWN DISCONNECT SWITCH IS NOT GROUPED AND WITHIN LINE OF SITE OF MAIN SERVICE DISCONNECTING MEANS. [NEC

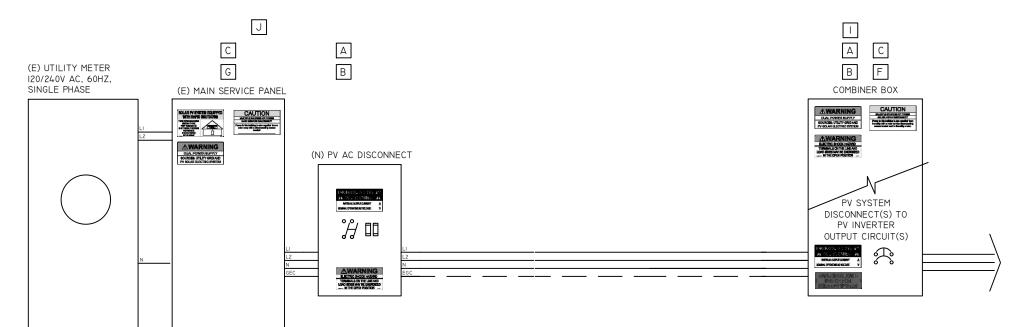


G

ALL CAUTION, WARNING, OR DANGER SIGNS OR LABELS SHALL:

- I, COMPLY WITH ANSI Z535.4-2011 STANDARDS.
- 2. BE PERMANENTLY AFFIXED TO THE EQUIPMENT OR WIRING METHOD AND SHALL NOT BE HANDWRITTEN.
- 3. SHALL BE OF SUFFICEINT DURABILITY TO WITHSTAND THE ENVIRONMENT INVOLVED.
- 4. UNLESS OTHERS SPECIFIED MINIMUM TEXT HEIGHT TO BE  $\frac{1}{8}$ " (3MM).

CONFIDENTIAL - THE INFORMATION HEREIN CONTAINED SHALL NOT BE USED FOR THE BENEFIT OF ANYONE EXCEPT ION DEVELOPER, LLC NOR SHALL IT BE DISCLOSED IN WHOLE OR IN PART TO OTHERS OUTSIDE RECIPIENTS ORGANIZATION, EXCEPT IN CONNECTION WITH THE SALE AND USE OF THE RESPECTIVE EQUIPMENT, WITHOUT THE WRITTEN PERMISSION OF ION DEVELOPER

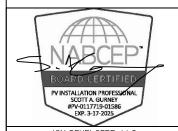

ION DEVELOPER, LLC

44 E 800 N OREM, UT 84057 888.781.7074

DAVID STANLEY CONRAD C - ELECTRICAL CONTRACTOR CI524

> 162ND AVENUE HC+

3) ENPHASE IQ8PLUS-72-2-US.46KW DC, 3.77KW STC-AC, 4.873KW CEC-AC 97236 SIL-420 OREGON SOLAR P E BLECK SOUTHEAST I SILFAB PORTLAND, PHILIP | 3232 S( (13) (I3) 5.46

DRAWING BY AILA DIMATATAC

DATE

SITE

08-Nov-2023

PROJECT ID

00BF7I

SHEET NAME

ELECTRICAL LABELS

SHEET NUMBER E-9

REVISON

0