
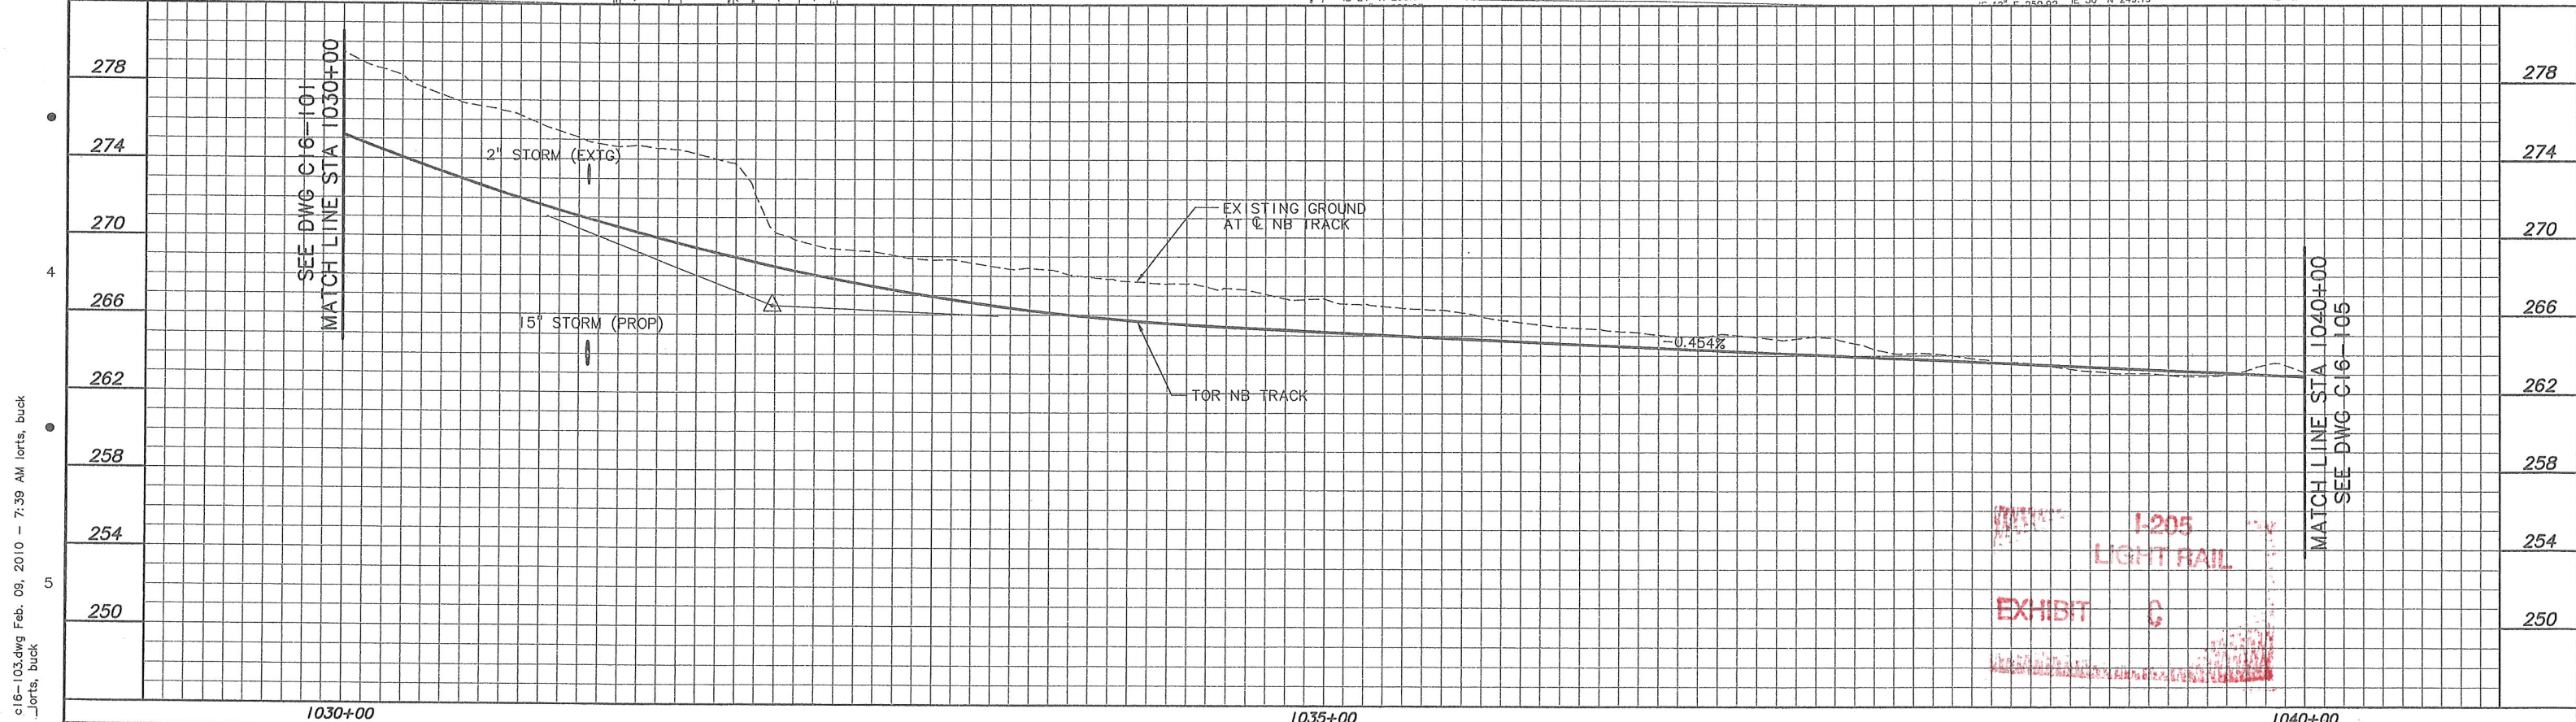


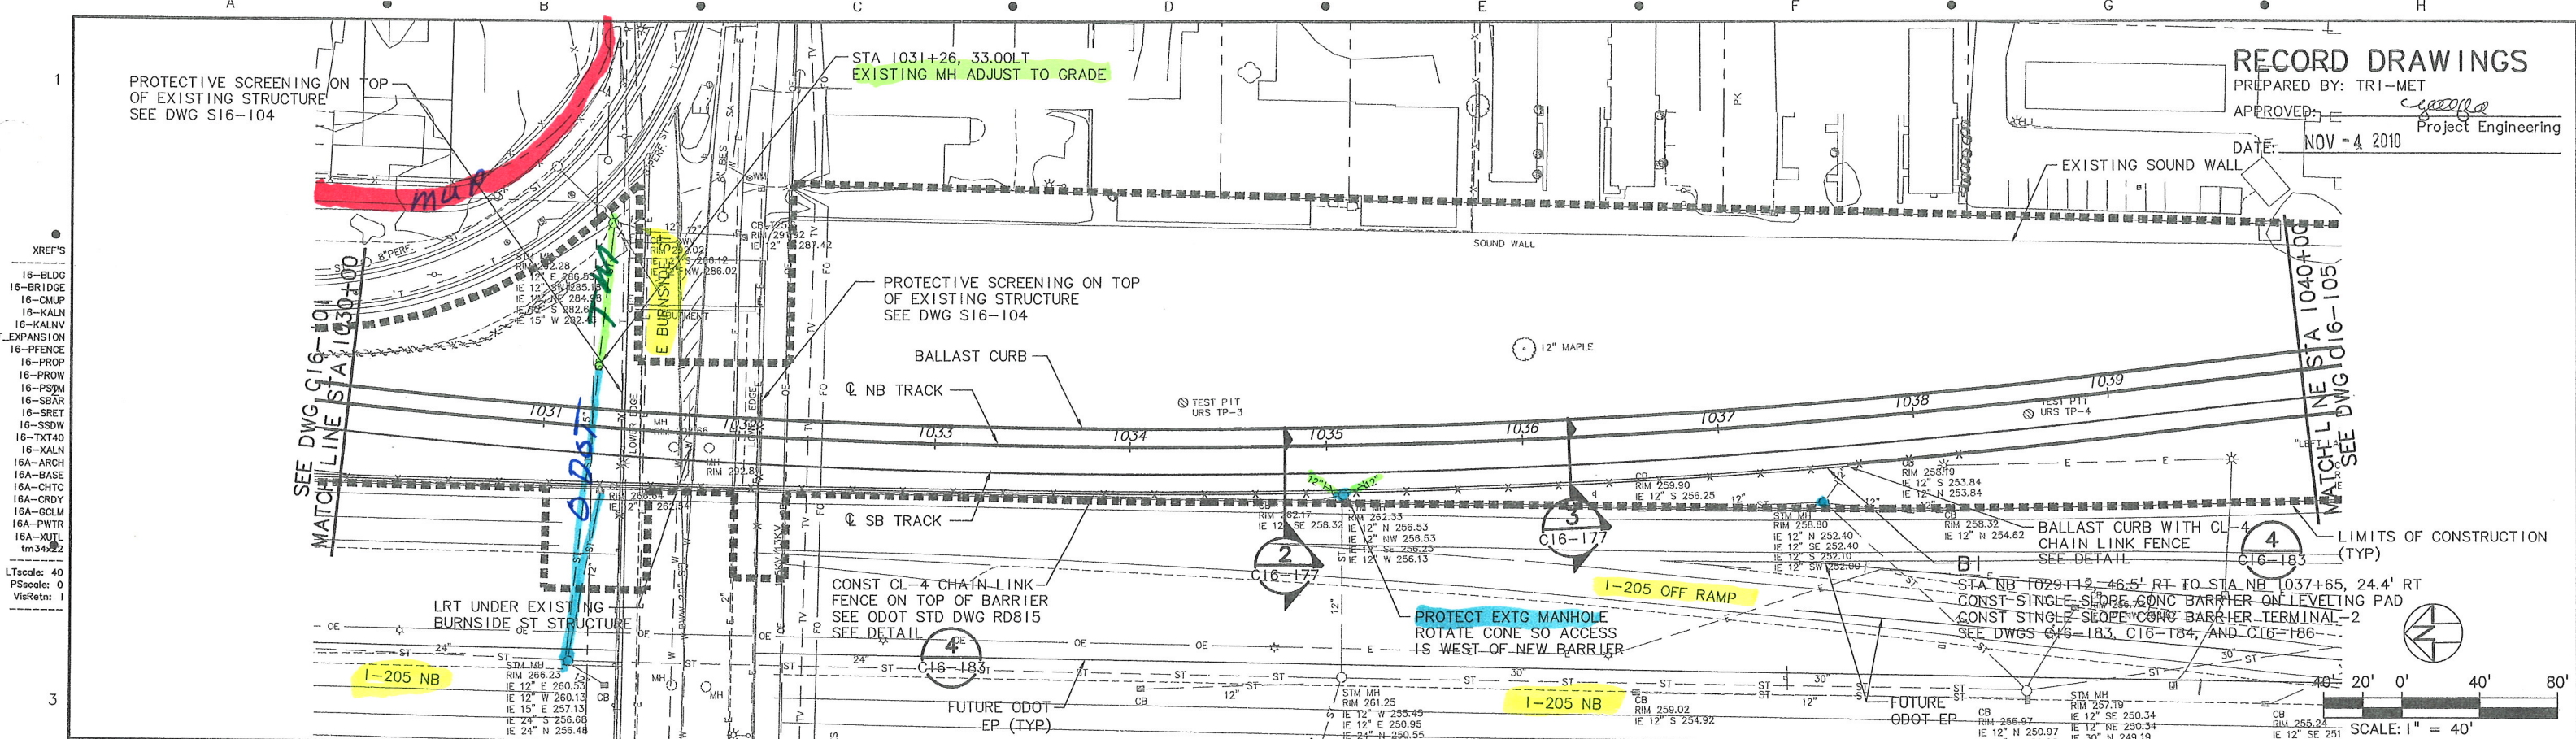

NOTE: THESE RECORD DRAWINGS REPRESENT THE BEST KNOWN INFORMATION ABOUT CONSTRUCTED FACILITIES. LOCATIONS SHOWN ARE NOT WARRANTED. UNDERGROUND UTILITIES MUST BE FIELD VERIFIED FOR ACTUAL LOCATION.

NO.	DATE	BY	CHK.	APPD.	REVISIONS

DESIGNED	DATE
JTH	2-17-06
DRAWN	DATE
JTH	2-19-06
CHECKED	DATE
APPROVED	DATE

TRI-COUNTY METROPOLITAN TRANSPORTATION DISTRICT OF OREGON

SOUTH CORRIDOR CONSTRUCTORS
Stacy and Wilbeck
GRANITE
WILDISH



DAVID EVANS AND ASSOCIATES INC.
2100 Southwest River Parkway
Portland Oregon 97201
Phone: 503.223.6663

TRI-MET
CAPITAL PROJECTS AND FACILITIES DIVISION
710 N.E. HOLLADAY STREET
PORTLAND, OREGON 97232

SUBMITTED: 12/15/06

SOUTH CORRIDOR PROJECT
I-205 SEGMENT
CIVIL PLAN & PROFILE
STA 1030+00 TO STA 1040+00

SCALE:	DRAWING NO.:	CONTRACT NO.:	SHEET NO.:
1" = 40'-0"	C16-103-AX	RH040161LE	114

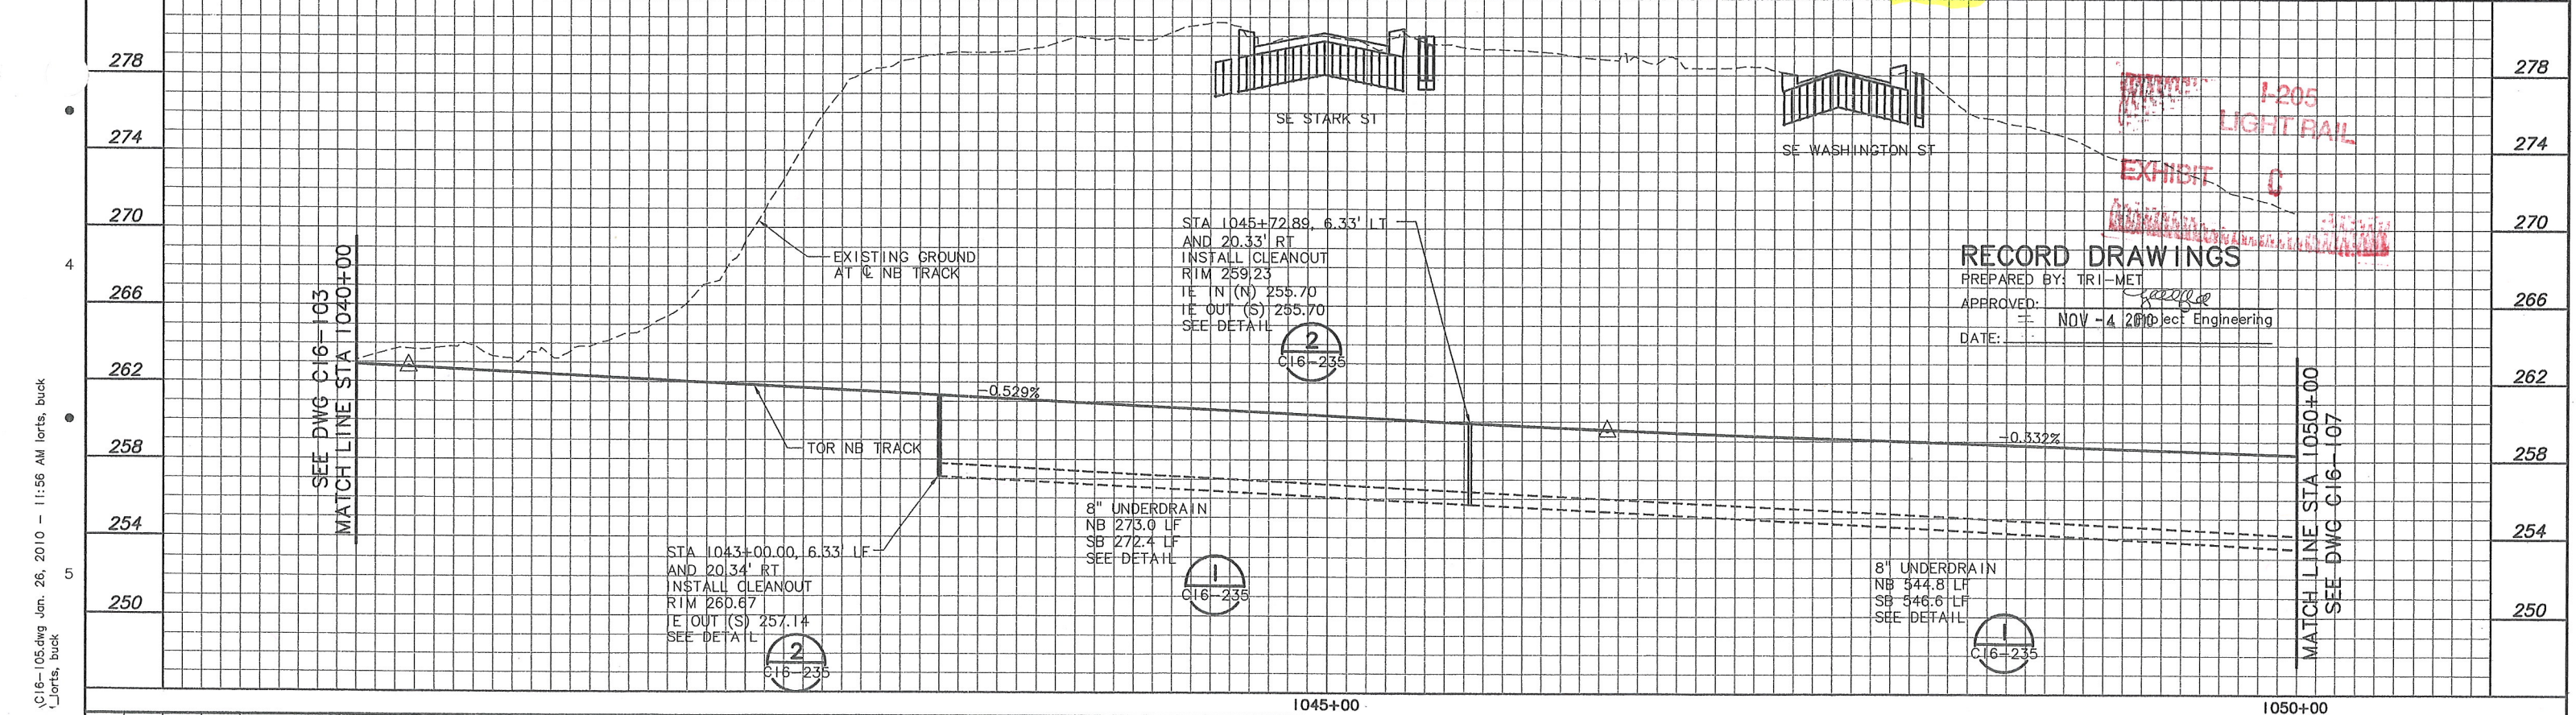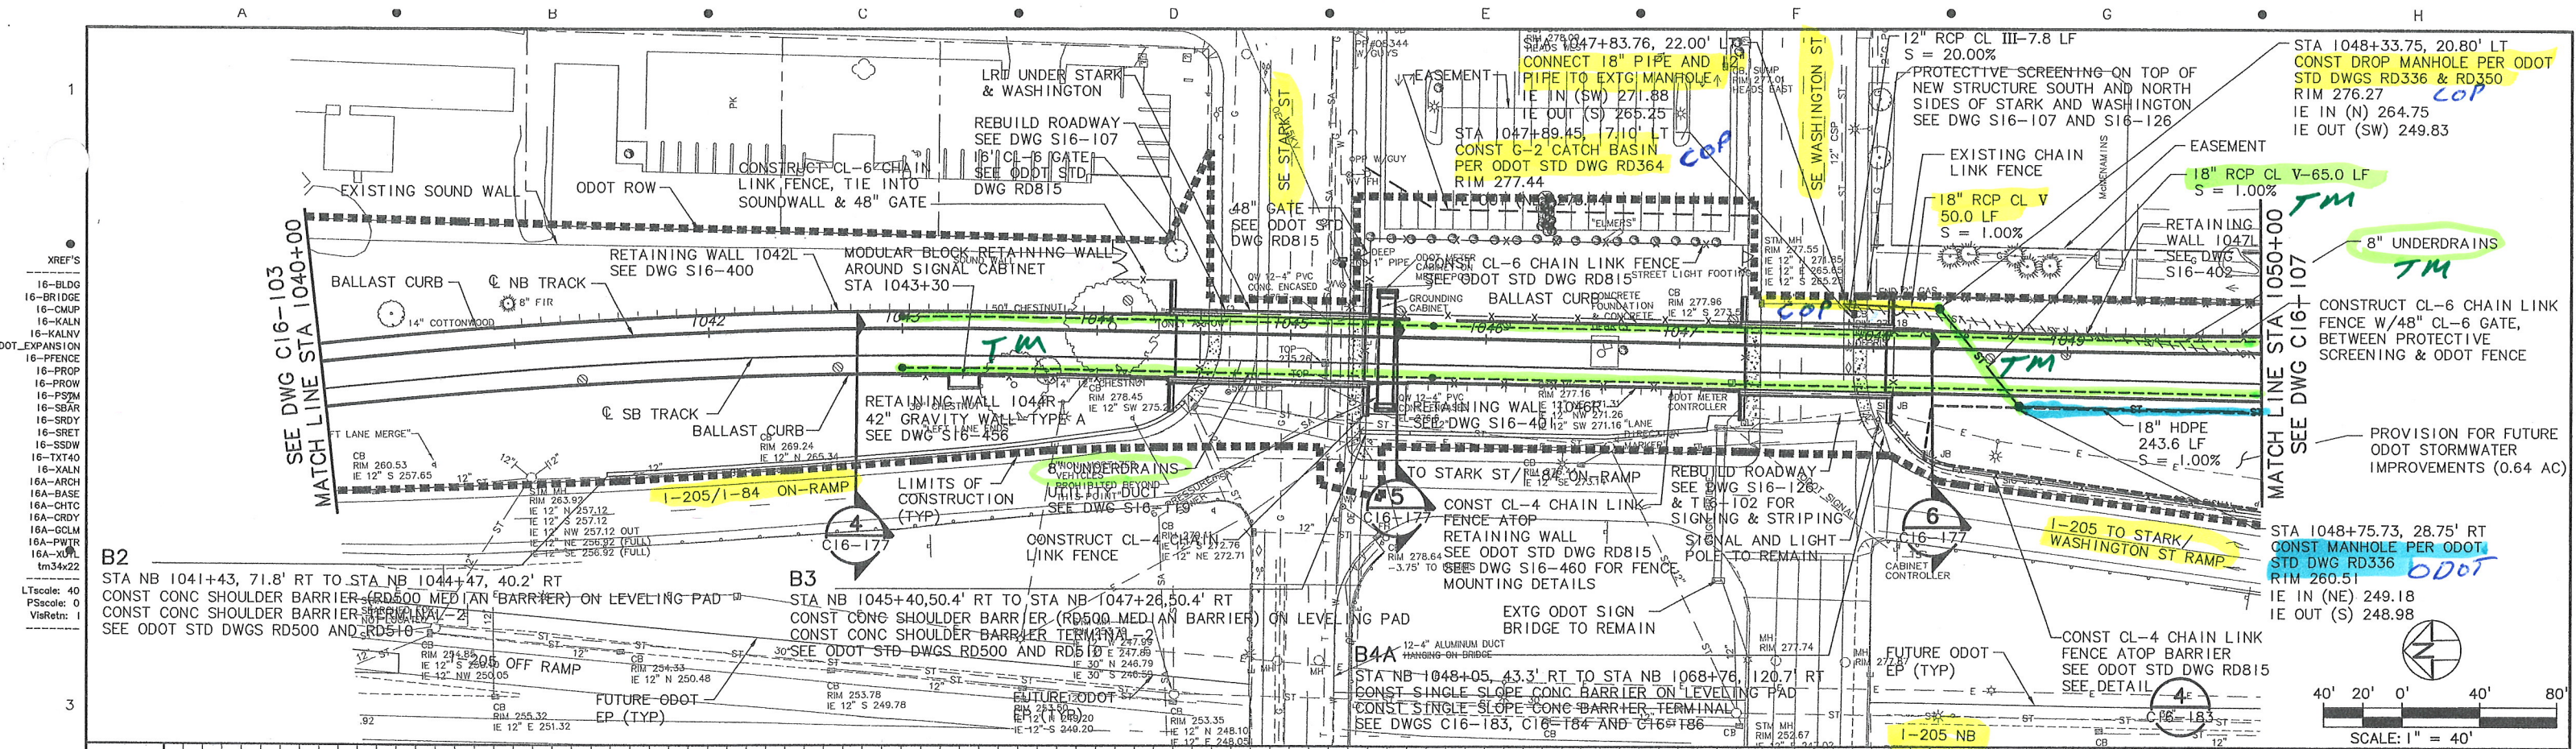

NOTE: THESE RECORD DRAWINGS REPRESENT THE BEST KNOWN INFORMATION ABOUT CONSTRUCTED FACILITIES. LOCATIONS SHOWN ARE NOT WARRANTED. UNDERGROUND UTILITIES MUST BE FIELD VERIFIED FOR ACTUAL LOCATION.

DRA/KRN DESIGNED	2-17-06 DATE
JTH DRAWN	2-19-06 DATE
CHECKED	DATE
APPROVED	DATE

RECORD DRAWING

Original Drawing Stamped and Sealed by MICHAEL J. HOHBACH

TRI-COUNTY METROPOLITAN TRANSPORTATION DISTRICT OF OREGON

SOUTH CORRIDOR CONSTRUCTORS
Stacy and Wilbeck
GRANITE
WILDISH



DAVID EVANS AND ASSOCIATES INC.
2100 Southwest River Parkway
Portland Oregon 97201
Phone: 503.223.6663

TRI-MET

CAPITAL PROJECTS AND FACILITIES DIVISION
710 N.E. HOLLADAY STREET
PORTLAND, OREGON 97232

SOUTH CORRIDOR PROJECT
I-205 SEGMENT
CIVIL PLAN & PROFILE
STA 1040+00 TO STA 1050+00

SCALE: 1" = 40'-0"	DRAWING NO.: C16-105-CX	CONTRACT NO.: RH040161LE	SHEET NO.: 115
-----------------------	----------------------------	-----------------------------	-------------------

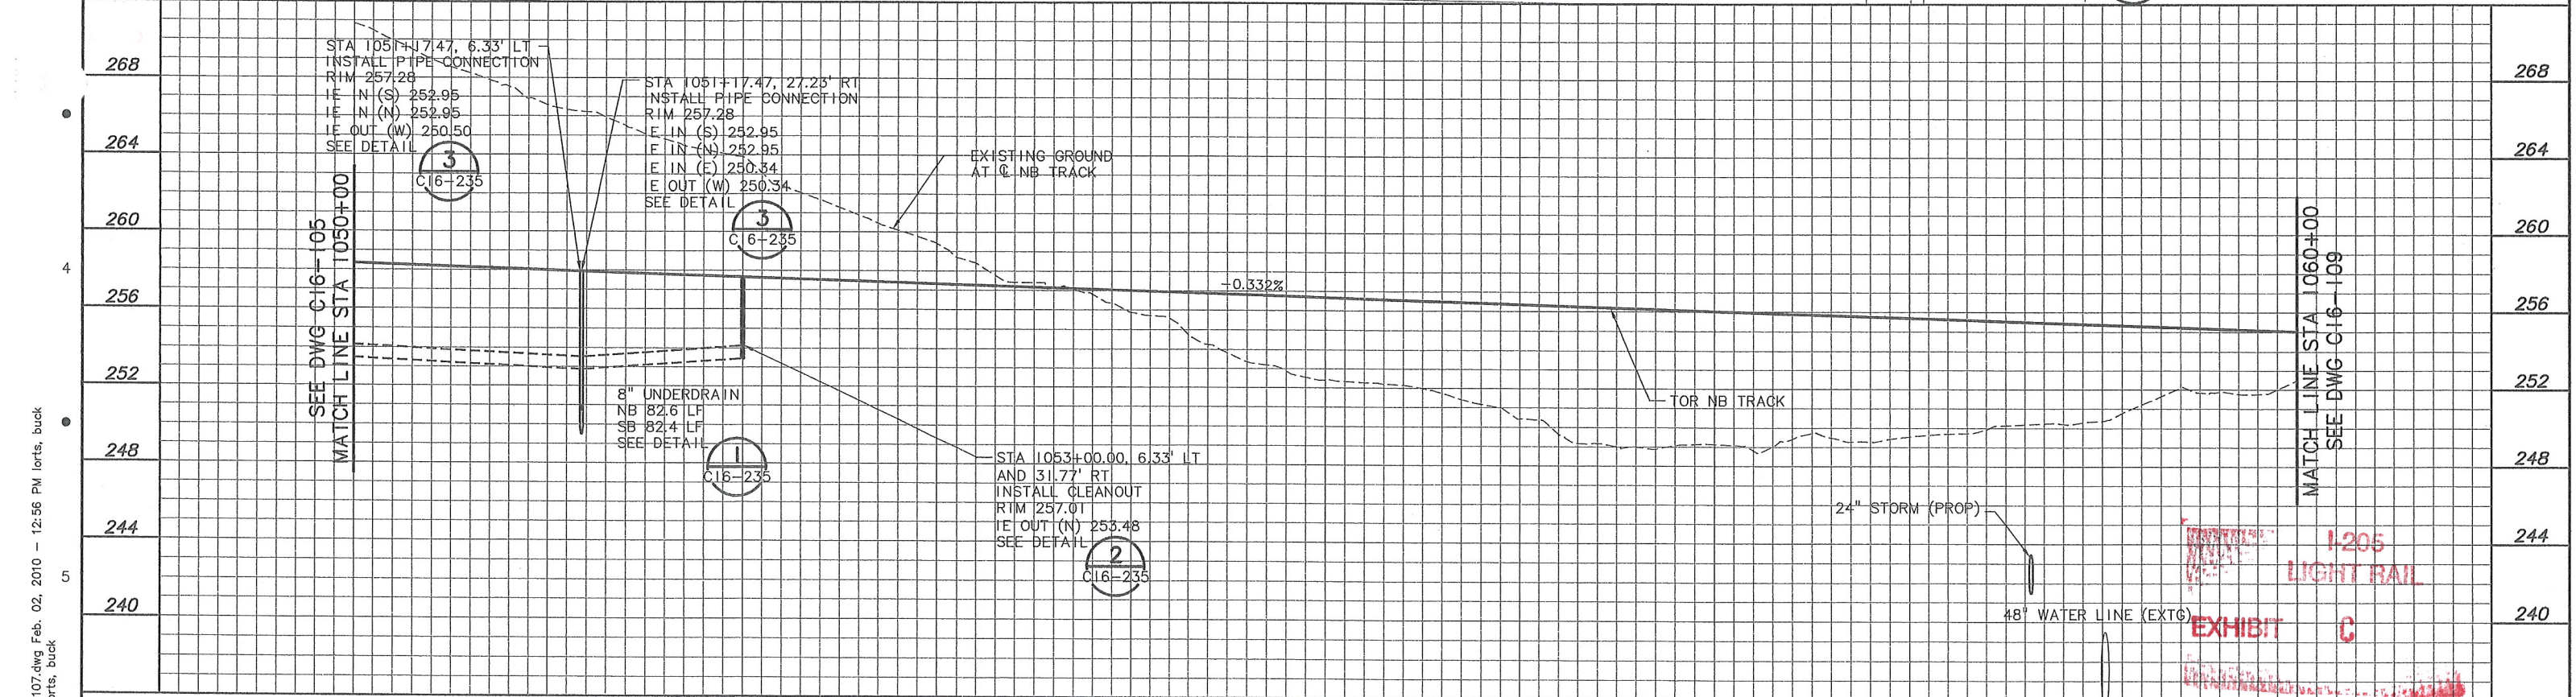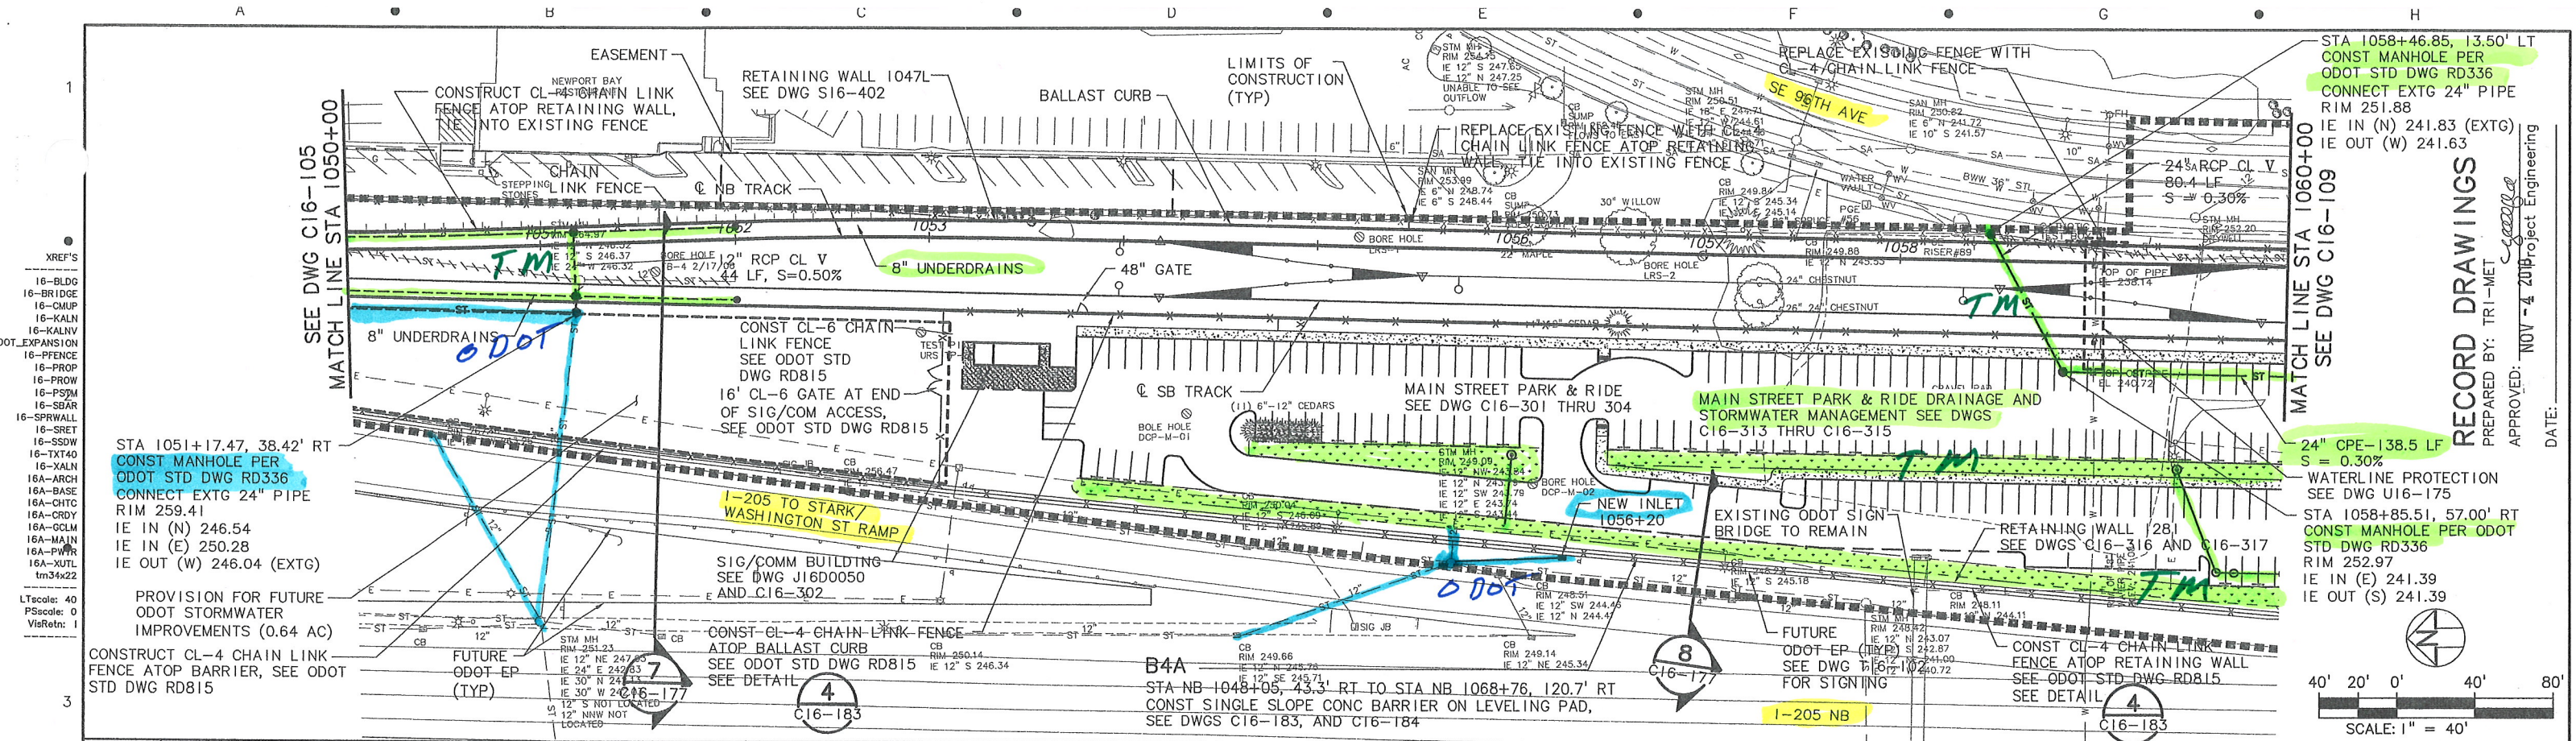

NOTE: THESE RECORD DRAWINGS REPRESENT THE BEST KNOWN INFORMATION ABOUT CONSTRUCTED FACILITIES. LOCATIONS SHOWN ARE NOT WARRANTED. UNDERGROUND UTILITIES MUST BE FIELD VERIFIED FOR ACTUAL LOCATION.

NO.	DATE	BY	APPD.	REVISIONS

DRAWN	DATE
JTH	2-19-06
CHECKED	DATE
APPROVED	DATE

RECORD DRAWING

TRI-COUNTY METROPOLITAN TRANSPORTATION DISTRICT OF OREGON

SOUTH CORRIDOR CONSTRUCTORS
Stacy and Wilbeck
GRANITE
WILDISH

DAVID EVANS AND ASSOCIATES INC.
2100 Southwest River Parkway
Portland Oregon 97201
Phone: 503.223.6663

TRIOMET


CAPITAL PROJECTS AND FACILITIES DIVISION
710 N.E. HOLLADAY STREET
PORTLAND, OREGON 97232

SOUTH CORRIDOR PROJECT
I-205 SEGMENT
CIVIL PLAN & PROFILE
STA 1050+00 TO STA 1060+00

SCALE:	DRAWING NO.:	CONTRACT NO.:	SHEET NO.:
1" = 40'-0"	C16-107-BX	RH040161LE	116

R:\205 AS-BUILT\16-107.dwg Feb. 02, 2010 12:56 PM lorts, buck
Plot Date: 3/16/2010 7:11

I:\-205 AS-BUILT\CI\ -313.dwg Jan. 26, 2010 - 7:59 AM lorts, buck
 lot Date:3/17/2010 12: Jorts, buck

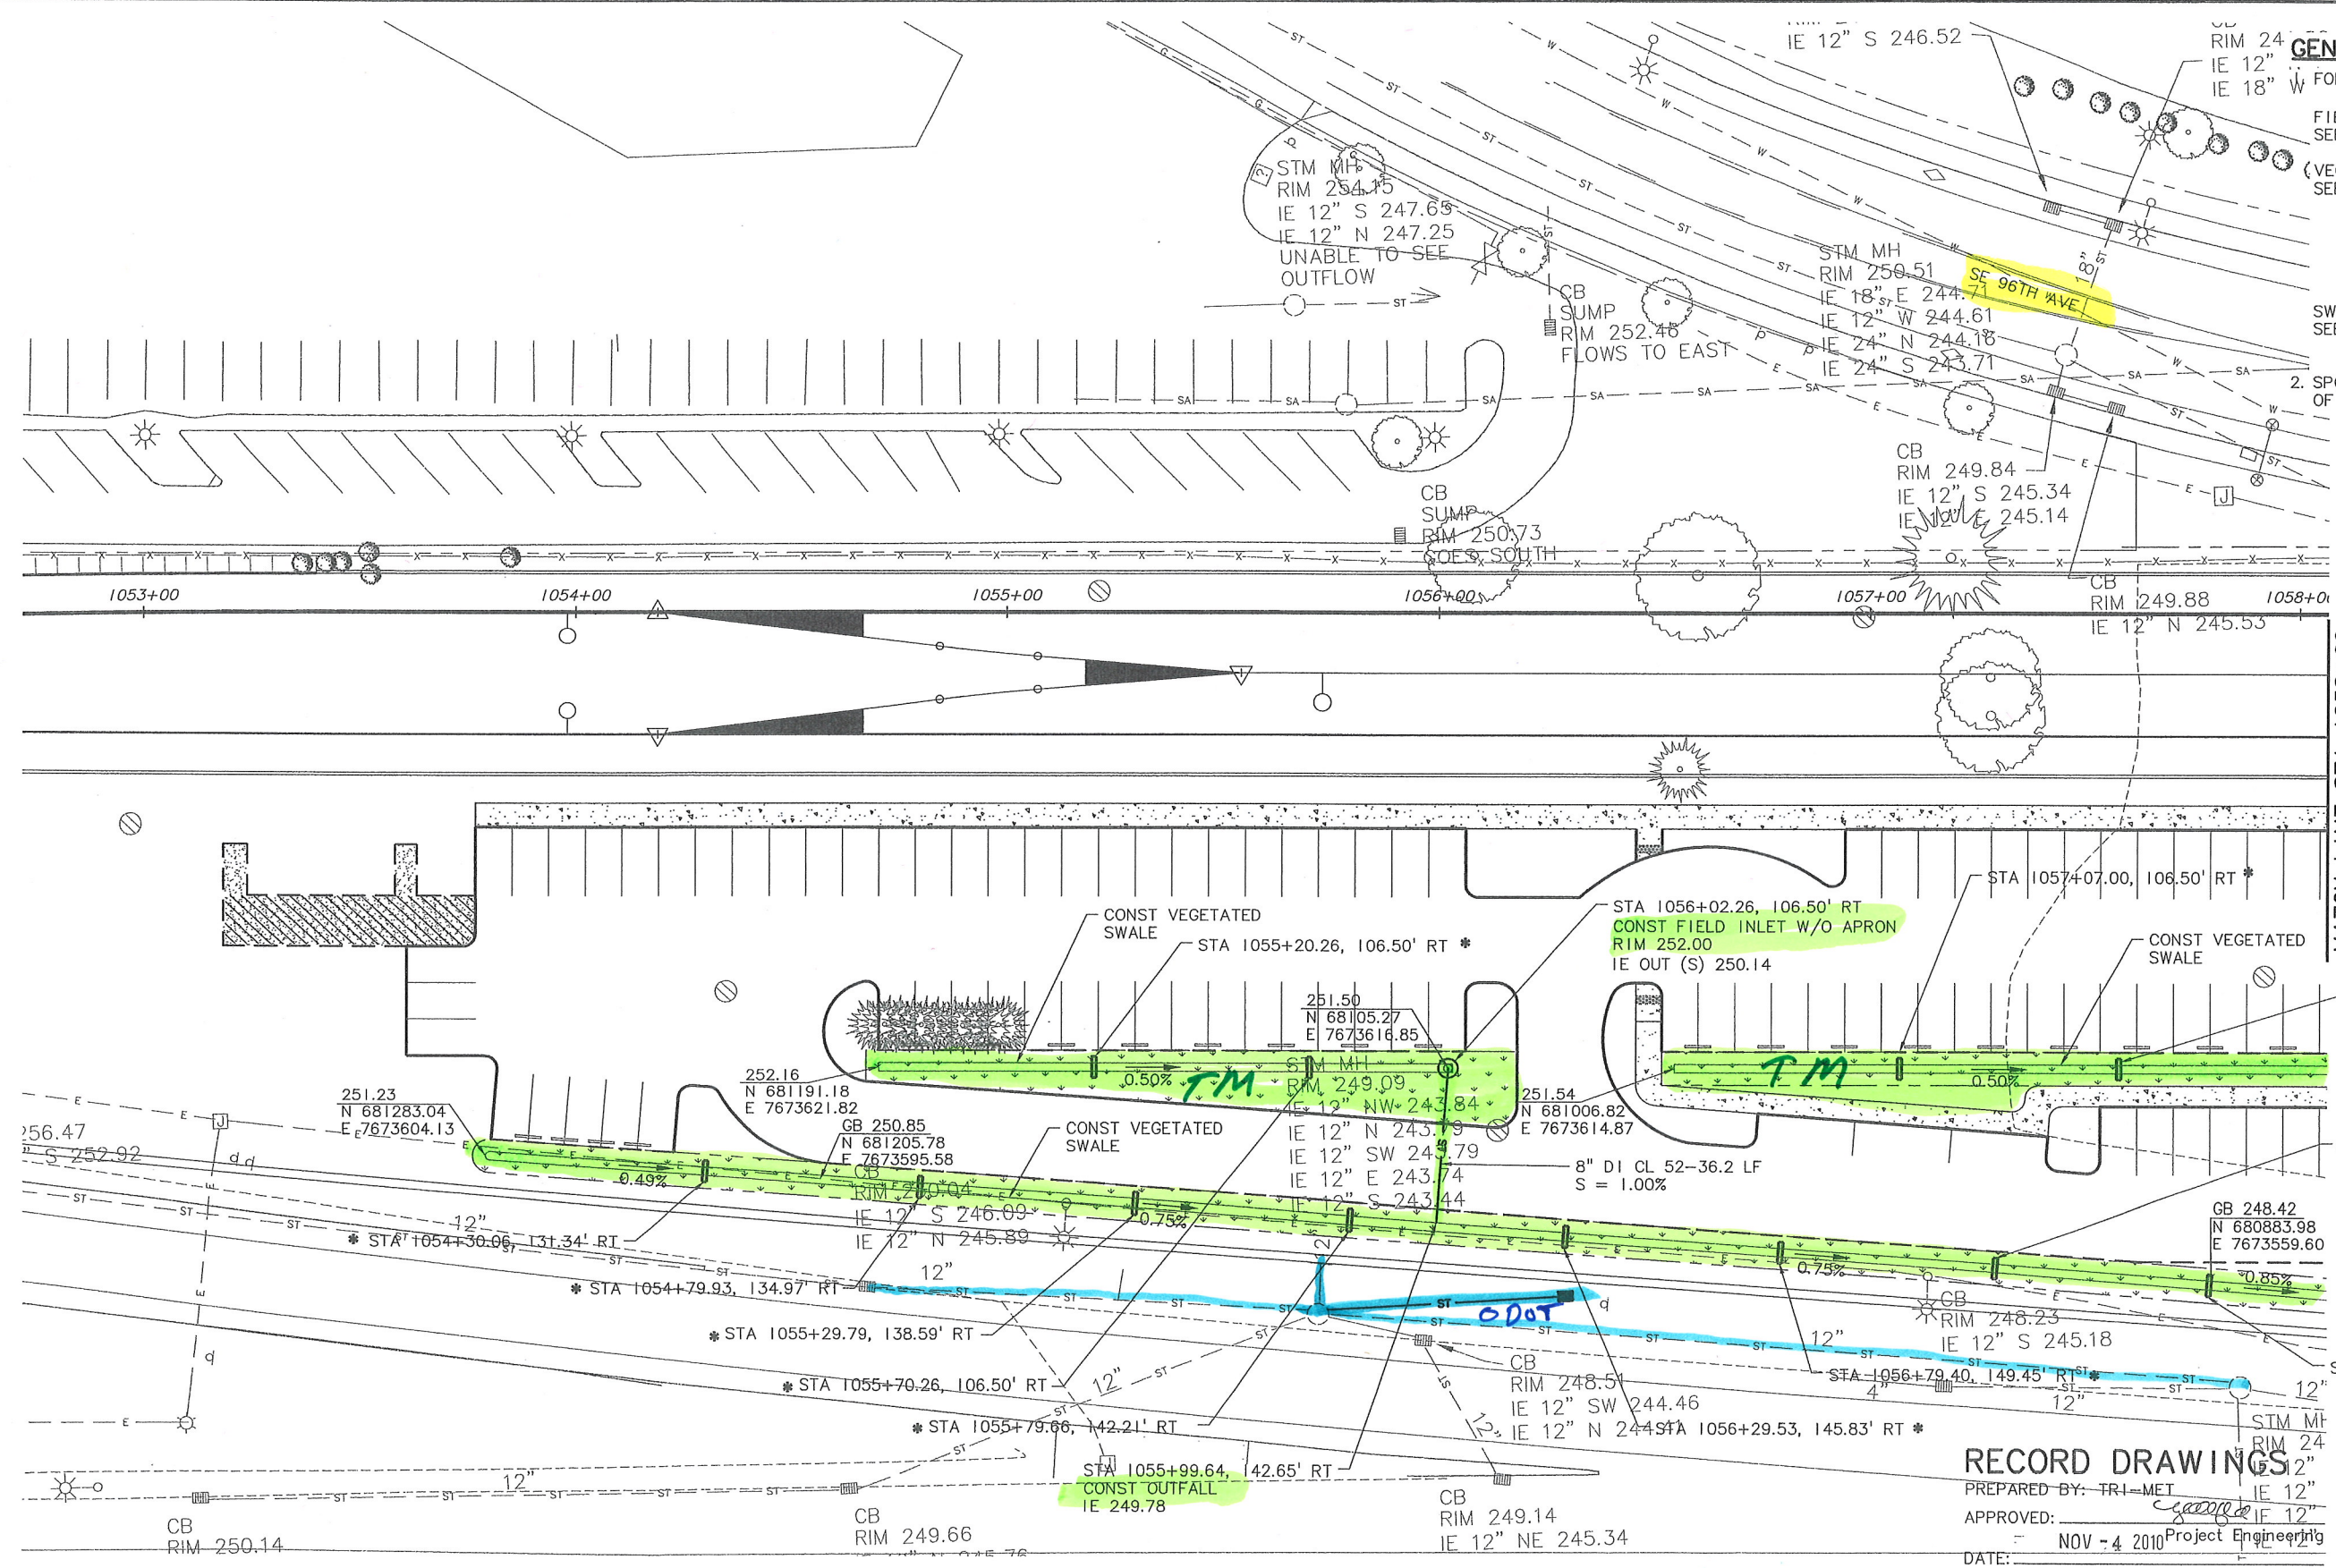

GENERAL NOTES

FOR DETAILS REFER TO THE FOLLOWING:

FIELD INLET W/O APRON
SEE ODOT STD DWG RD374

(VEGETATED SWALE
SEE DETAIL

SWALE OUTFALL
SEE DETAIL


2. SPOT ELEVATIONS GIVEN AT BOTTOM
OF SWALE

* SUBSTITUTE ROCK CHECK DAMS
4'Lx2'Wx1'D W/6" COBBLE, FULL
WIDTH OF SWALE

MATCH LINE STA 1058+00
SEE DWG C16-314

I-205
LIGHT RAIL
EXHIBIT C

RECORD DRAWINGS
PREPARED BY: TRI-MET
APPROVED: *[Signature]*
NOV - 4 2010 Project Engineer's
DATE:

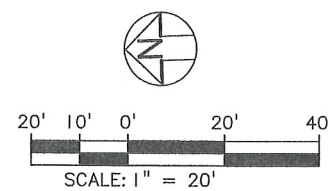

NOTE:		THESE RECORD DRAWINGS REPRESENT THE BEST KNOWN INFORMATION ABOUT CONSTRUCTED FACILITIES. LOCATIONS SHOWN ARE NOT WARRANTED. UNDERGROUND UTILITIES MUST BE FIELD VERIFIED FOR ACTUAL LOCATION.					
RECORD DRAWING							
NO.	DATE	BY CHK.	APPD.	REVISIONS			

CJH	5-17-06
DESIGNED	DATE
KRN	5-17-06
DRAWN	DATE
CHECKED	DATE
APPROVED	DATE

 TRI-COUNTY METROPOLITAN TRANSPORTATION DISTRICT OF OREGON			
SOUTH CORRIDOR CONSTRUCTORS a partnership between a joint venture Stacy and Witbeck  GRANITE WILDISH	 DAVID EVANS AND ASSOCIATES INC. 2100 Southwest River Parkway Portland Oregon 97201 Phone: 503.223.6663	 TRI-COUNTY MET	CAPITAL PROJECTS AND FACILITIES DIVISION 710 N.E. HOLLADAY STREET PORTLAND, OREGON 97232
SUBMITTED:	DATE: 12/15/06	APPROVED:	DATE: 12/15/06


SOUTH CORRIDOR PROJECT

I-205 SEGMENT

MAIN STREET PARK AND RIDE

DRAINAGE AND STORMWATER MANAGEMENT PLAN

SHEET 1 OF 3

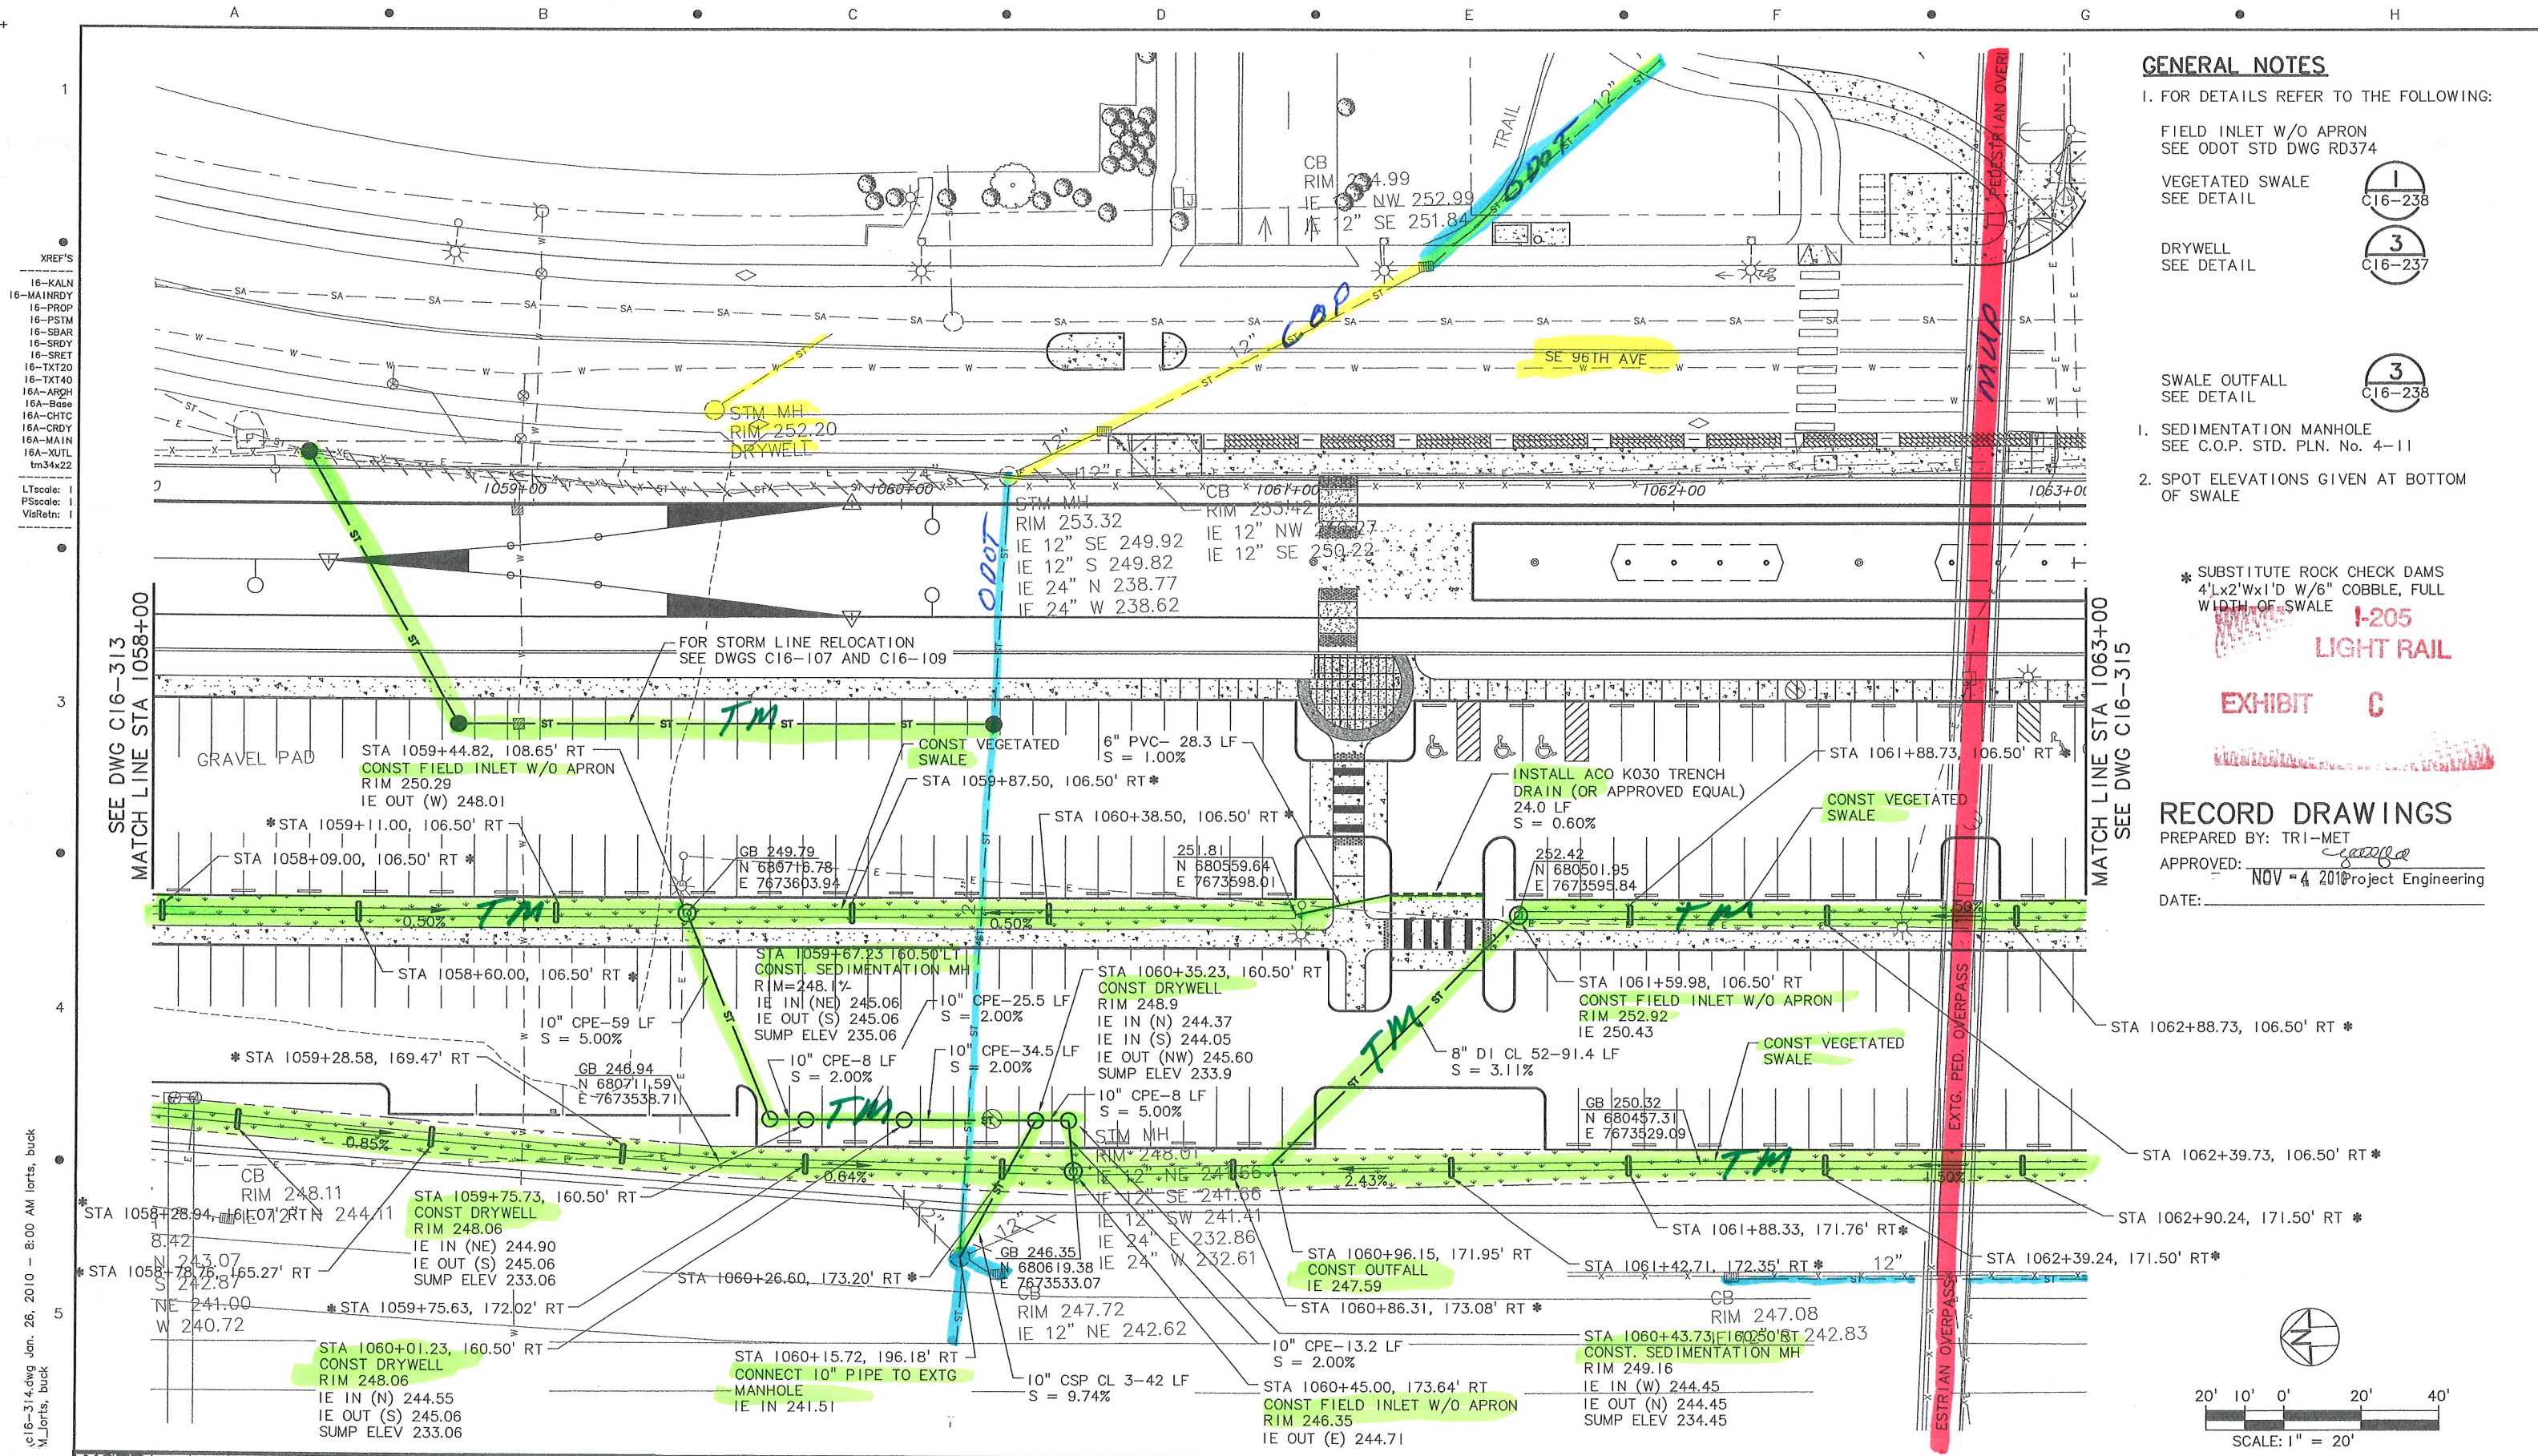


- GENERAL NOTES**
1. FOR DETAILS REFER TO THE FOLLOWING:
- FIELD INLET W/O APRON
SEE ODOT STD DWG RD374
 - VEGETATED SWALE
SEE DETAIL
 - DRYWELL
SEE DETAIL
 - SWALE OUTFALL
SEE DETAIL
1. SEDIMENTATION MANHOLE
SEE C.O.P. STD. PLN. No. 4-11
2. SPOT ELEVATIONS GIVEN AT BOTTOM OF SWALE

* SUBSTITUTE ROCK CHECK DAMS
4'Lx2'Wx1'D W/6" COBBLE, FULL WIDTH OF SWALE

EXHIBIT C

RECORD DRAWINGS
PREPARED BY: TRI-MET
APPROVED: *[Signature]*
DATE: NOV 4 2010 Project Engineering

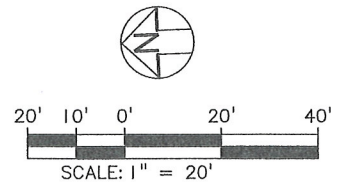

NOTE: THESE RECORD DRAWINGS REPRESENT THE BEST KNOWN INFORMATION ABOUT CONSTRUCTED FACILITIES. LOCATIONS SHOWN ARE NOT WARRANTED. UNDERGROUND UTILITIES MUST BE FIELD VERIFIED FOR ACTUAL LOCATION.

RECORD DRAWING

CJH	DESIGNED	5-17-06	DATE
KRN	DRAWN	5-17-06	DATE
	CHECKED		DATE
	APPROVED		DATE

TRI-COUNTY METROPOLITAN TRANSPORTATION DISTRICT OF OREGON


SOUTH CORRIDOR CONSTRUCTORS
Stacy and Wilbeck
GRANITE WILDISH

DAVID EVANS AND ASSOCIATES INC.
2100 Southwest River Parkway
Portland Oregon 97201
Phone: 503.223.6663

TRI-MET
CAPITAL PROJECTS AND FACILITIES DIVISION
710 N.E. HOLLADAY STREET
PORTLAND, OREGON 97232

SOUTH CORRIDOR PROJECT
I-205 SEGMENT
MAIN STREET PARK AND RIDE
DRAINAGE AND STORMWATER MANAGEMENT PLAN
SHEET 2 OF 3

NO.	DATE	BY	APPD.	REVISIONS	SUBMITTED:	DATE:	APPROVED:	DATE:	SCALE:	DRAWING NO.:	CONTRACT NO.:	SHEET NO.:
						12/15/06		12/15/06	1" = 20'-0"	C16-314-BX	RH040161LE	265

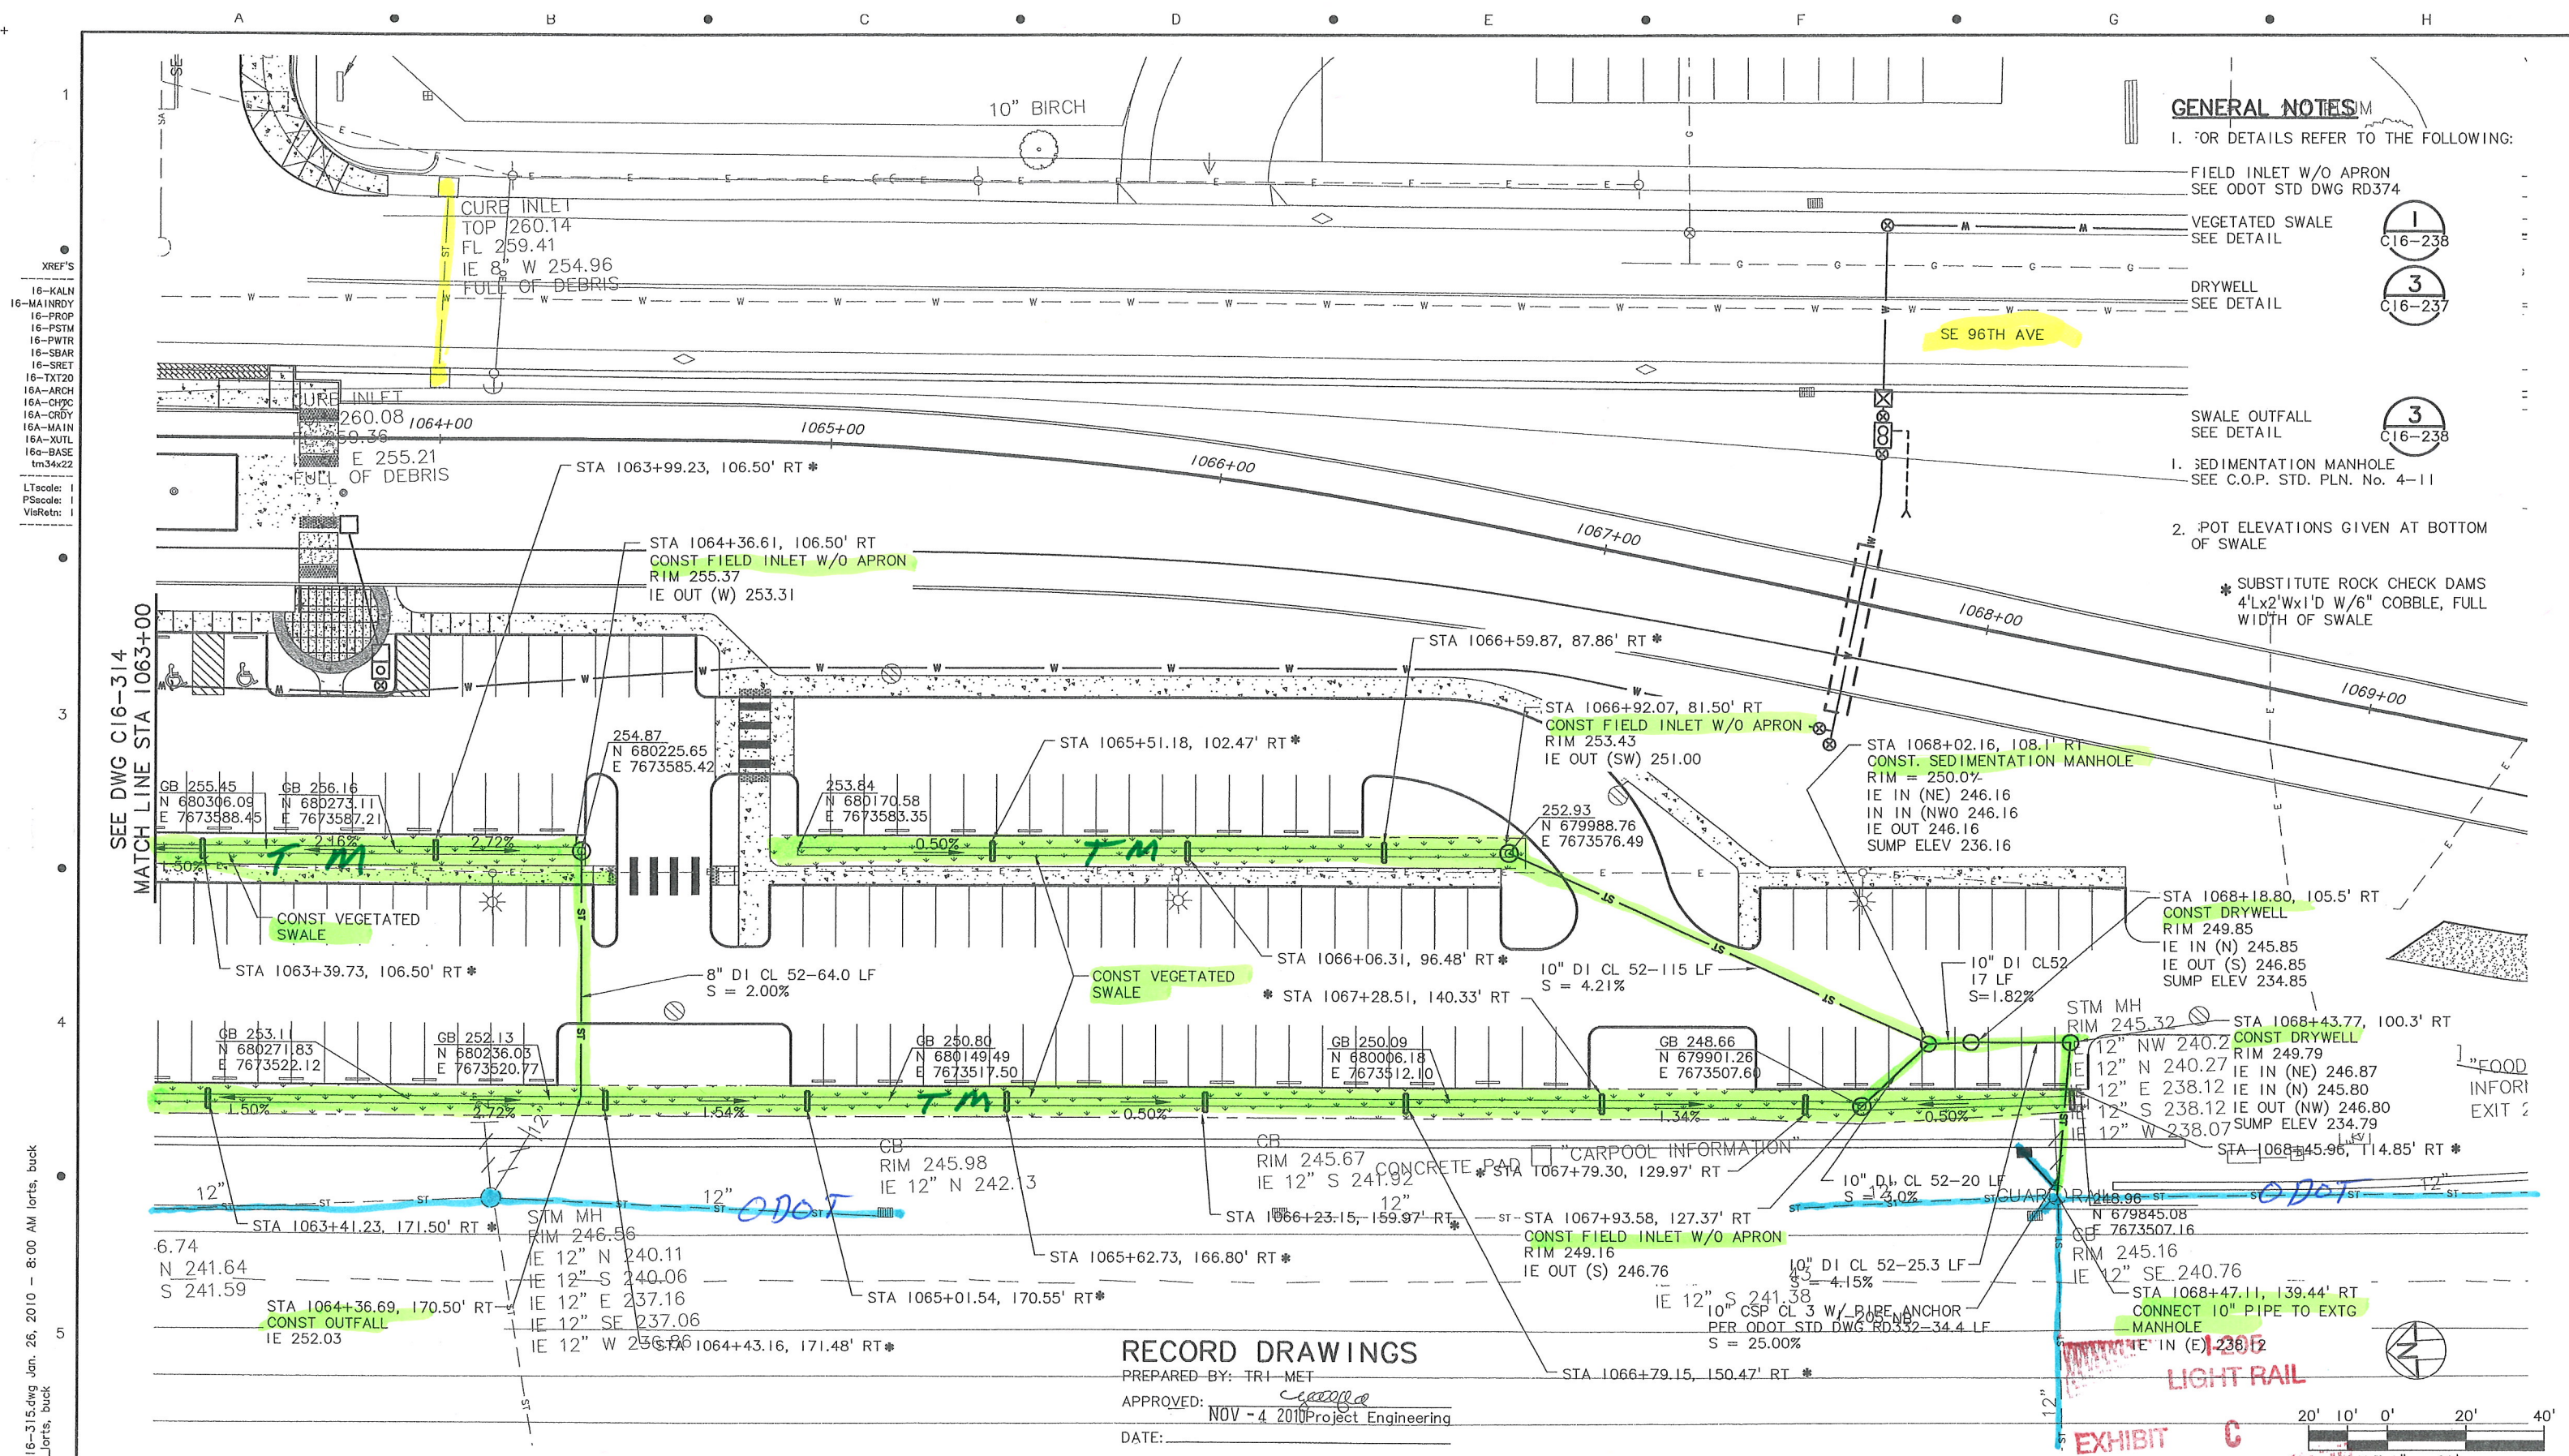

- GENERAL NOTES**
- FOR DETAILS REFER TO THE FOLLOWING:
 - FIELD INLET W/O APRON
SEE ODOT STD DWG RD374
 - VEGETATED SWALE
SEE DETAIL
 - DRYWELL
SEE DETAIL
 - SWALE OUTFALL
SEE DETAIL
 - SEDIMENTATION MANHOLE
SEE C.O.P. STD. PLN. No. 4-11
 - POT ELEVATIONS GIVEN AT BOTTOM OF SWALE
- * SUBSTITUTE ROCK CHECK DAMS
4'Lx2'Wx1'D W/6" COBBLE, FULL WIDTH OF SWALE

RECORD DRAWINGS

PREPARED BY: TRI-MET
APPROVED: *[Signature]*
DATE: NOV -4 2010 Project Engineering

NOTE: THESE RECORD DRAWINGS REPRESENT THE BEST KNOWN INFORMATION ABOUT CONSTRUCTED FACILITIES. LOCATIONS SHOWN ARE NOT WARRANTED. UNDERGROUND UTILITIES MUST BE FIELD VERIFIED FOR ACTUAL LOCATION.

RECORD DRAWING

NO.	DATE	BY	APPD.	REVISIONS

CJH	DESIGNED	5-17-06	DATE
KRN	DRAWN	5-17-06	DATE
	CHECKED		DATE
	APPROVED		DATE

TRI-COUNTY METROPOLITAN TRANSPORTATION DISTRICT OF OREGON

SOUTH CORRIDOR CONSTRUCTORS
Stacy and Wilbeck
GRANITE WILDISH

DAVID EVANS AND ASSOCIATES INC.
2100 Southwest River Parkway
Portland Oregon 97201
Phone: 503.223.6663

TRI-MET

CAPITAL PROJECTS AND FACILITIES DIVISION
710 N.E. HOLLADAY STREET
PORTLAND, OREGON 97232

SOUTH CORRIDOR PROJECT
I-205 SEGMENT
MAIN STREET PARK AND RIDE
DRAINAGE AND STORMWATER MANAGEMENT PLAN
SHEET 3 OF 3

SCALE: 1" = 20'-0"
DRAWING NO.: C16-315-CX
CONTRACT NO.: RH040161LE
SHEET NO.: 266

R:\1-205 AS-BUILTS
Plot Date: 5/17/2010 1:01 PM
c16-315.dwg Jan. 26, 2010 - 8:00 AM lorts, buck
V_Lorts, buck