
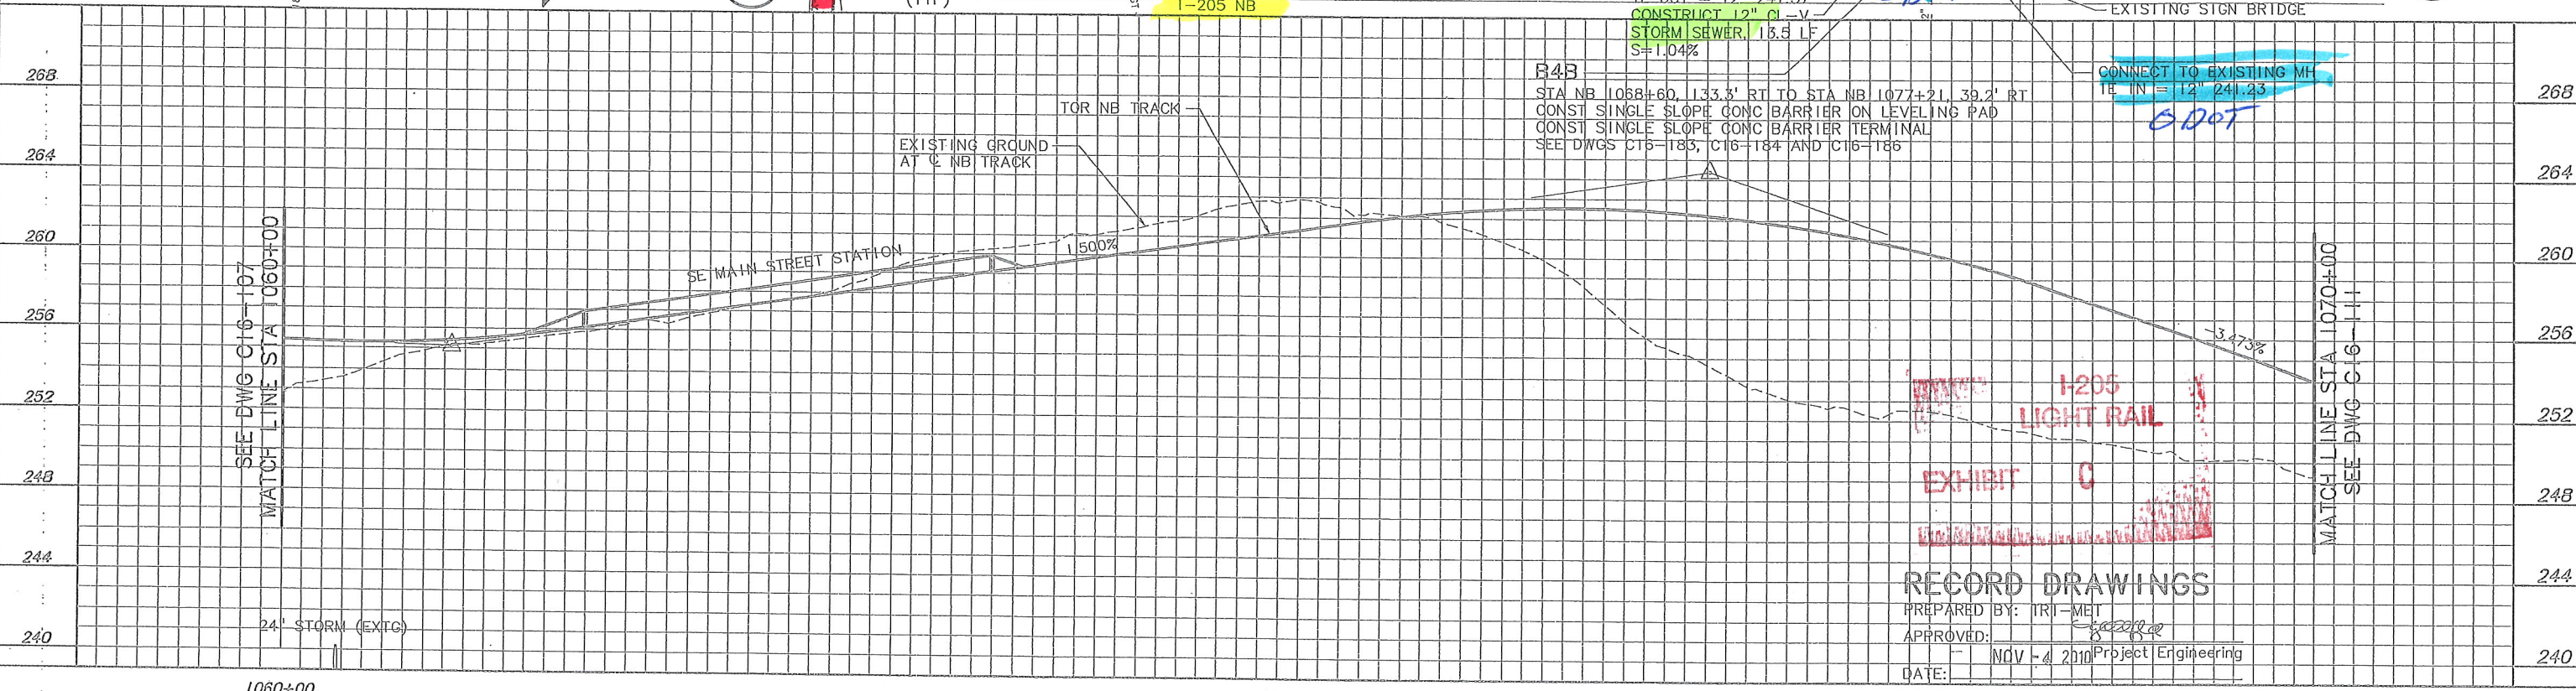



R:\V-205 AS-BUILT\6-109.dwg Jan. 26, 2010 - 8:01 AM lorts, buck
Plot Date: 3/16/2010 7:00 AM lorts, buck

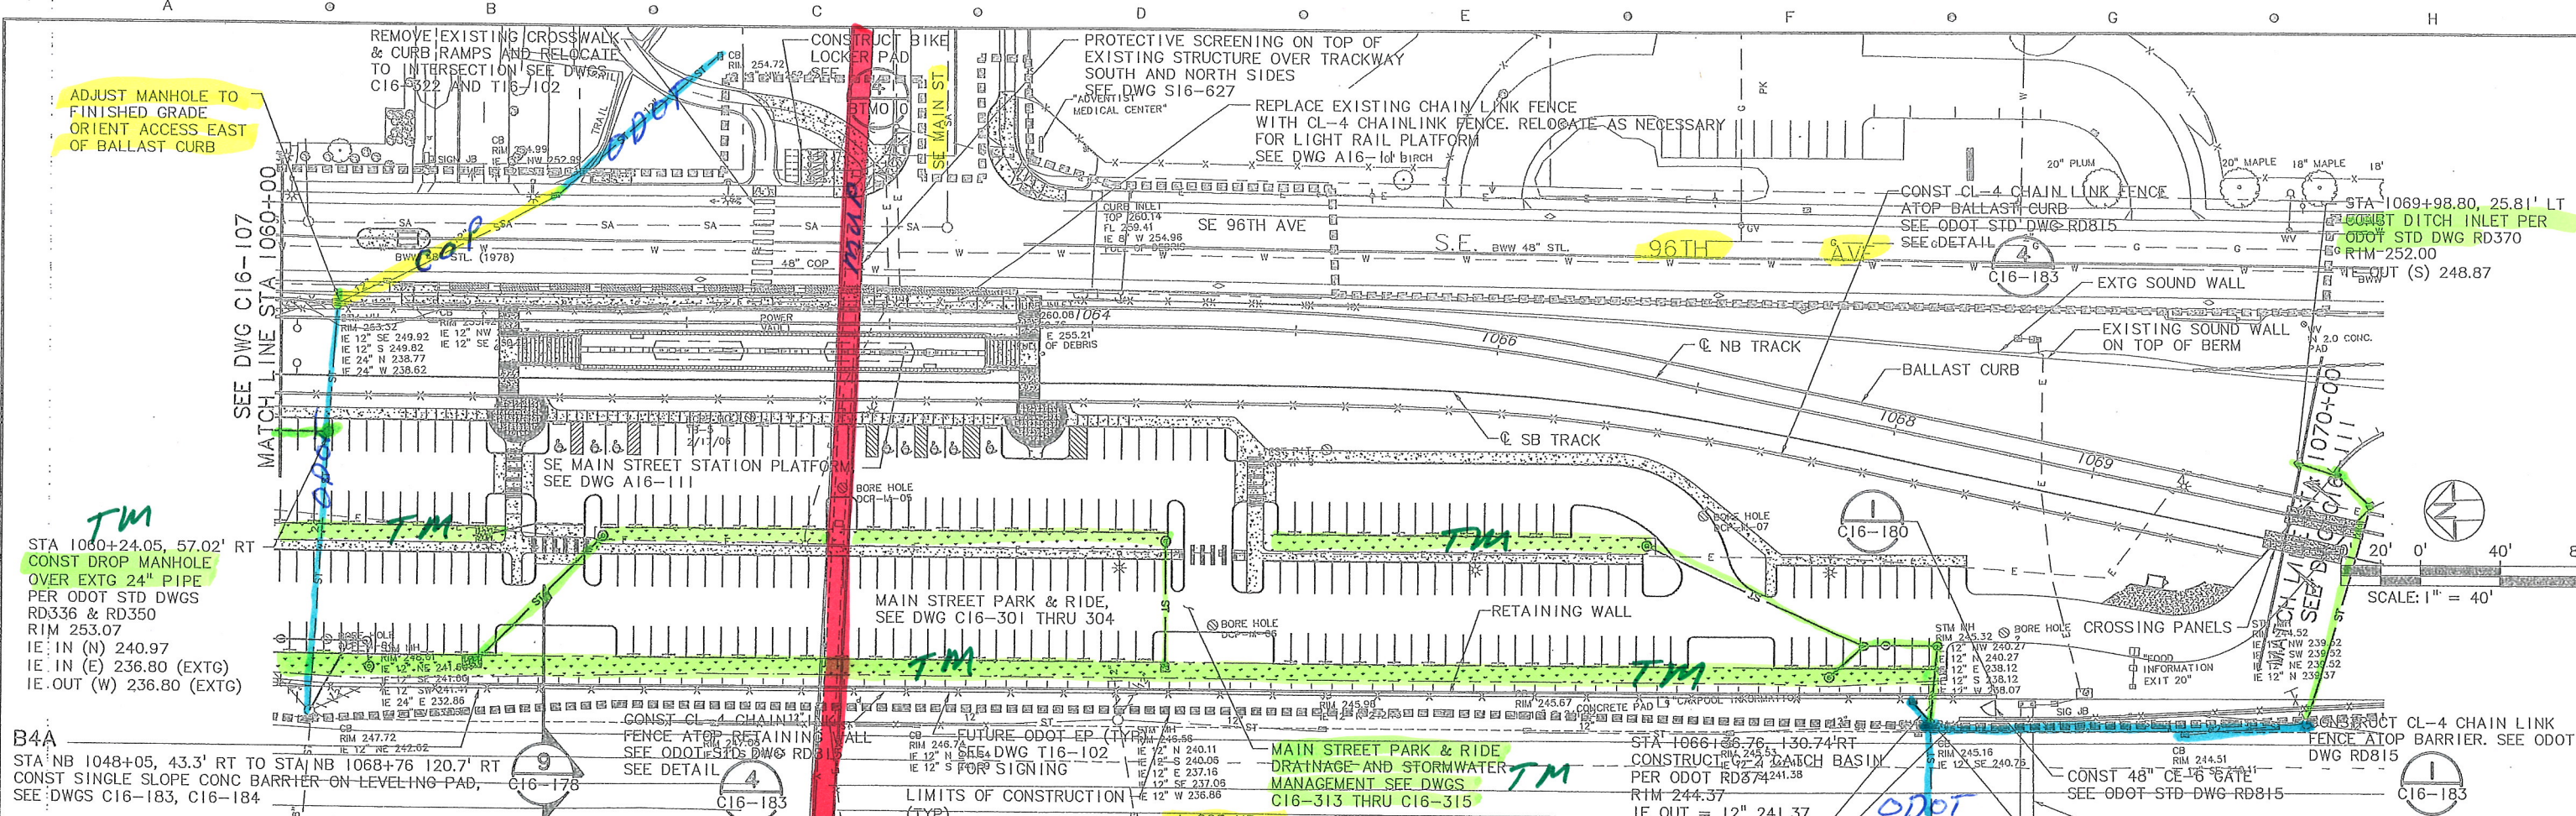

NOTE: THESE RECORD DRAWINGS REPRESENT THE BEST KNOWN INFORMATION ABOUT CONSTRUCTED FACILITIES. LOCATIONS SHOWN ARE NOT WARRANTED. UNDERGROUND UTILITIES MUST BE FIELD VERIFIED FOR ACTUAL LOCATION.		DRA/KRN DESIGNED DATE 2-17-06	
		JTH DRAWN DATE 2-19-06	
		CHECKED DATE	
		APPROVED DATE	
RECORD DRAWING			
NO.	DATE	BY	APPD.
1		CHK	

SUBMITTED: 12/15/06		DATE: 12/15/06		APPROVED: 12/15/06		DATE: 12/15/06		SCALE: 1" = 40'-0"		DRAWING NO.: C16-109-BX		CONTRACT NO.: RH040161LE		SHEET NO.: 117	
---------------------	--	----------------	--	--------------------	--	----------------	--	--------------------	--	-------------------------	--	--------------------------	--	----------------	--

TRI-COUNTY METROPOLITAN TRANSPORTATION DISTRICT OF OREGON		SOUTH CORRIDOR PROJECT I-205 SEGMENT CIVIL PLAN & PROFILE STA 1060+00 TO STA 1070+00	
CAPITAL PROJECTS AND FACILITIES DIVISION 710 N.E. HOLLADAY STREET PORTLAND, OREGON 97232			

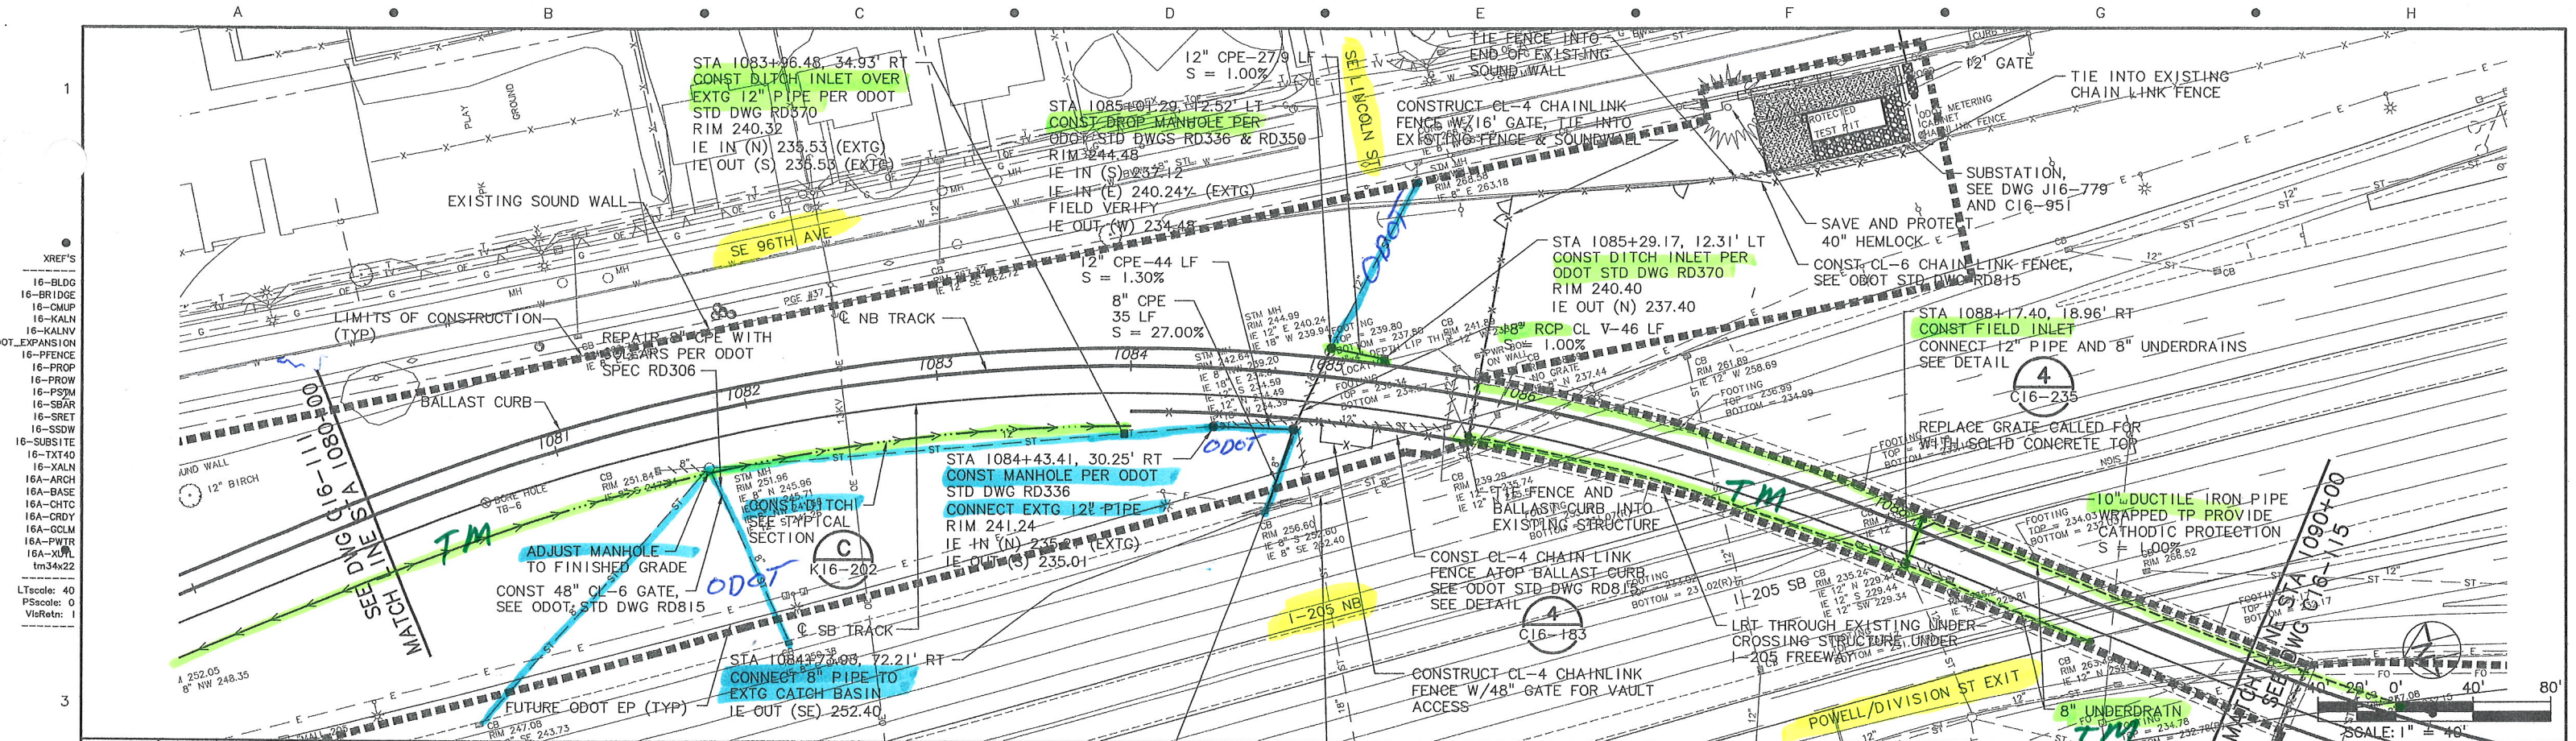


16-BLDG
16-BRIDGE
16-CMUP
16-KALN
16-KALNV
16-PFENCE
16-PROP
16-PROW
16-PSM
16-SBAR
16-SRET
16-SSDW
16-SUBSITE
16-TXT40
16-XALN
16A-ARCH
16A-BASE
16A-CHTC
16A-CRDY
16A-COLM
16A-PWTR
16A-XUL
tm34x22

LTscale: 40
PSscale: 0
VisRetn: 1

3-113.dwg Feb. 03, 2010 - 10:34 AM lorts, buck
J_lorts, buck

AS-BUILT'S G.
Plot Date: 3/16/2010 7:0

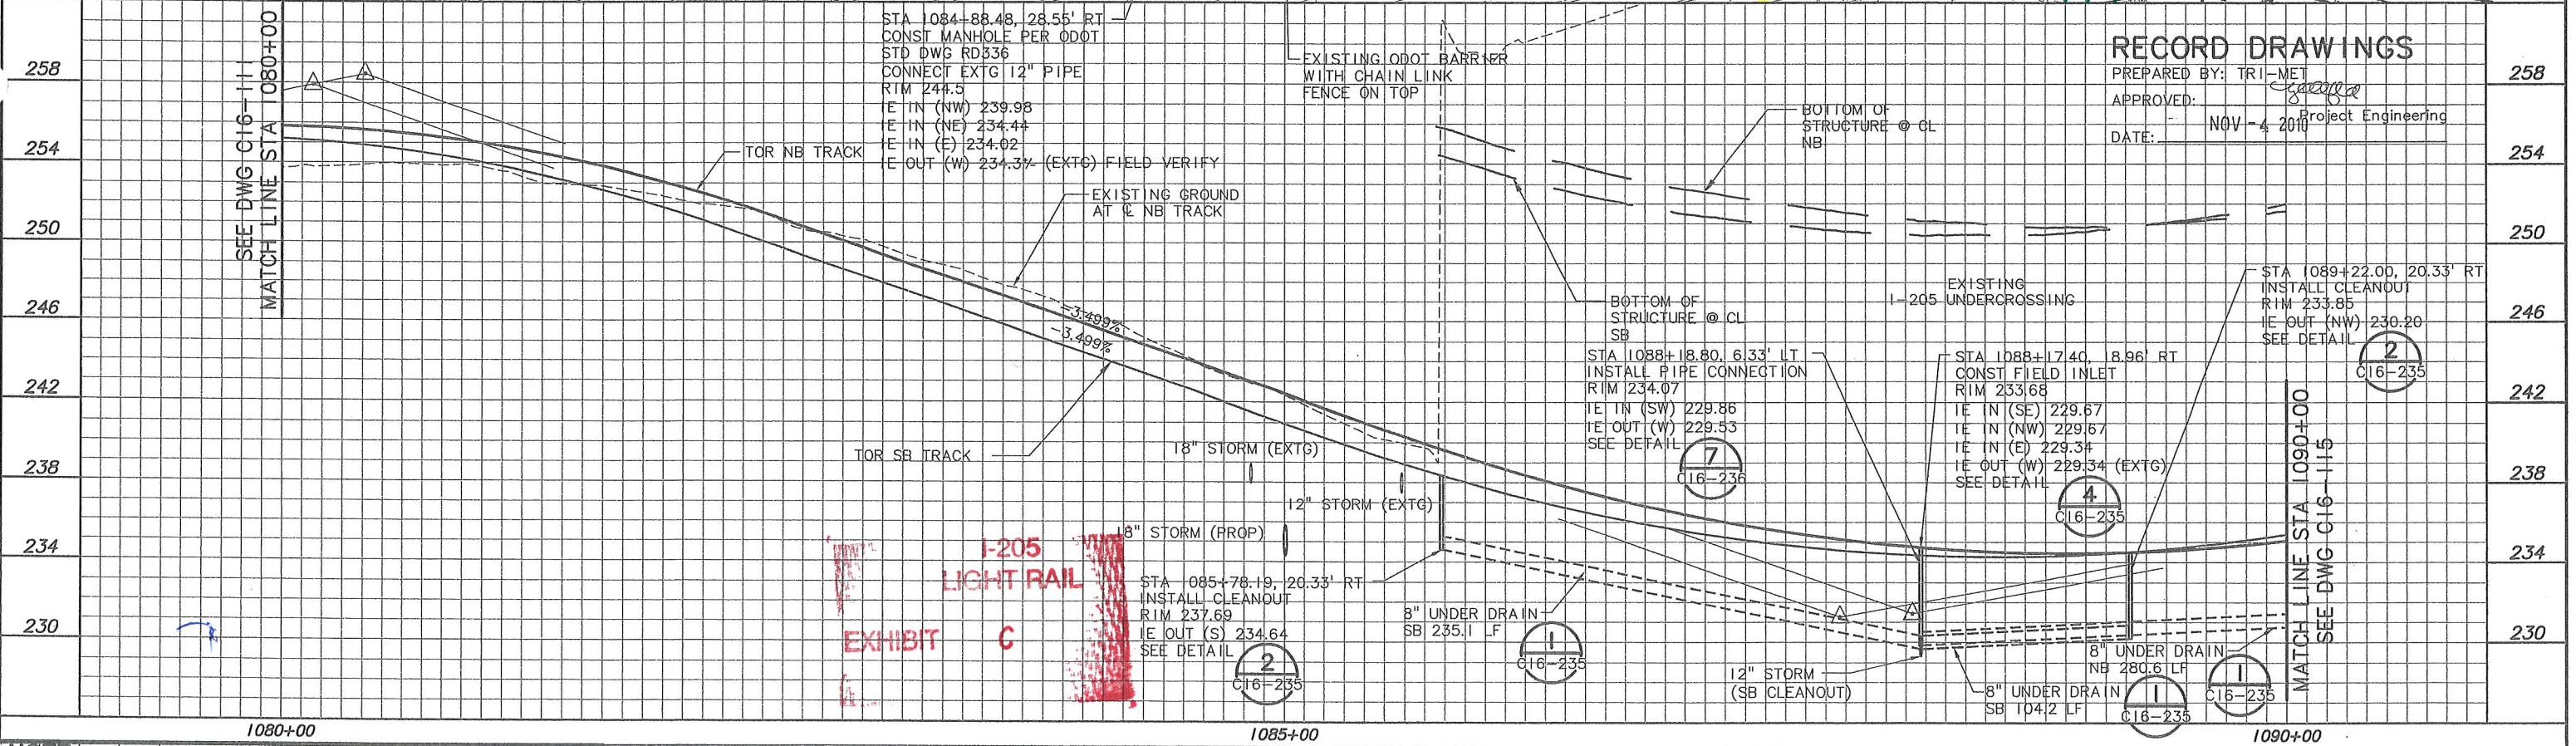

NOTE: THESE RECORD DRAWINGS REPRESENT THE BEST KNOWN INFORMATION ABOUT CONSTRUCTED FACILITIES. LOCATIONS SHOWN ARE NOT WARRANTED. UNDERGROUND UTILITIES MUST BE FIELD VERIFIED FOR ACTUAL LOCATION.

NO.	DATE	BY	APPD.	REVISIONS

Original Drawing Stamped and Sealed by MICHAEL J. HOHBACH

ORA/KRN	DATE
DESIGNED	2-17-06
JTH	2-19-06
DRAWN	
CHECKED	
APPROVED	

TRI-COUNTY METROPOLITAN TRANSPORTATION DISTRICT OF OREGON


SOUTH CORRIDOR CONSTRUCTORS
Stacy and Witbeck
GRANITE
WILDISH

DAVID EVANS AND ASSOCIATES INC.
2100 Southwest River Parkway
Portland Oregon 97201
Phone: 503.223.6663

TRI-MET


CAPITAL PROJECTS AND FACILITIES DIVISION
710 N.E. HOLLADAY STREET
PORTLAND, OREGON 97232

SOUTH CORRIDOR PROJECT I-205 SEGMENT CIVIL PLAN & PROFILE	
STA 1080+00 TO STA 1090+00	
SCALE: 1" = 40'-0"	DRAWING NO.: C16-113-DX
CONTRACT NO.: RH040161LE	SHEET NO.: 119

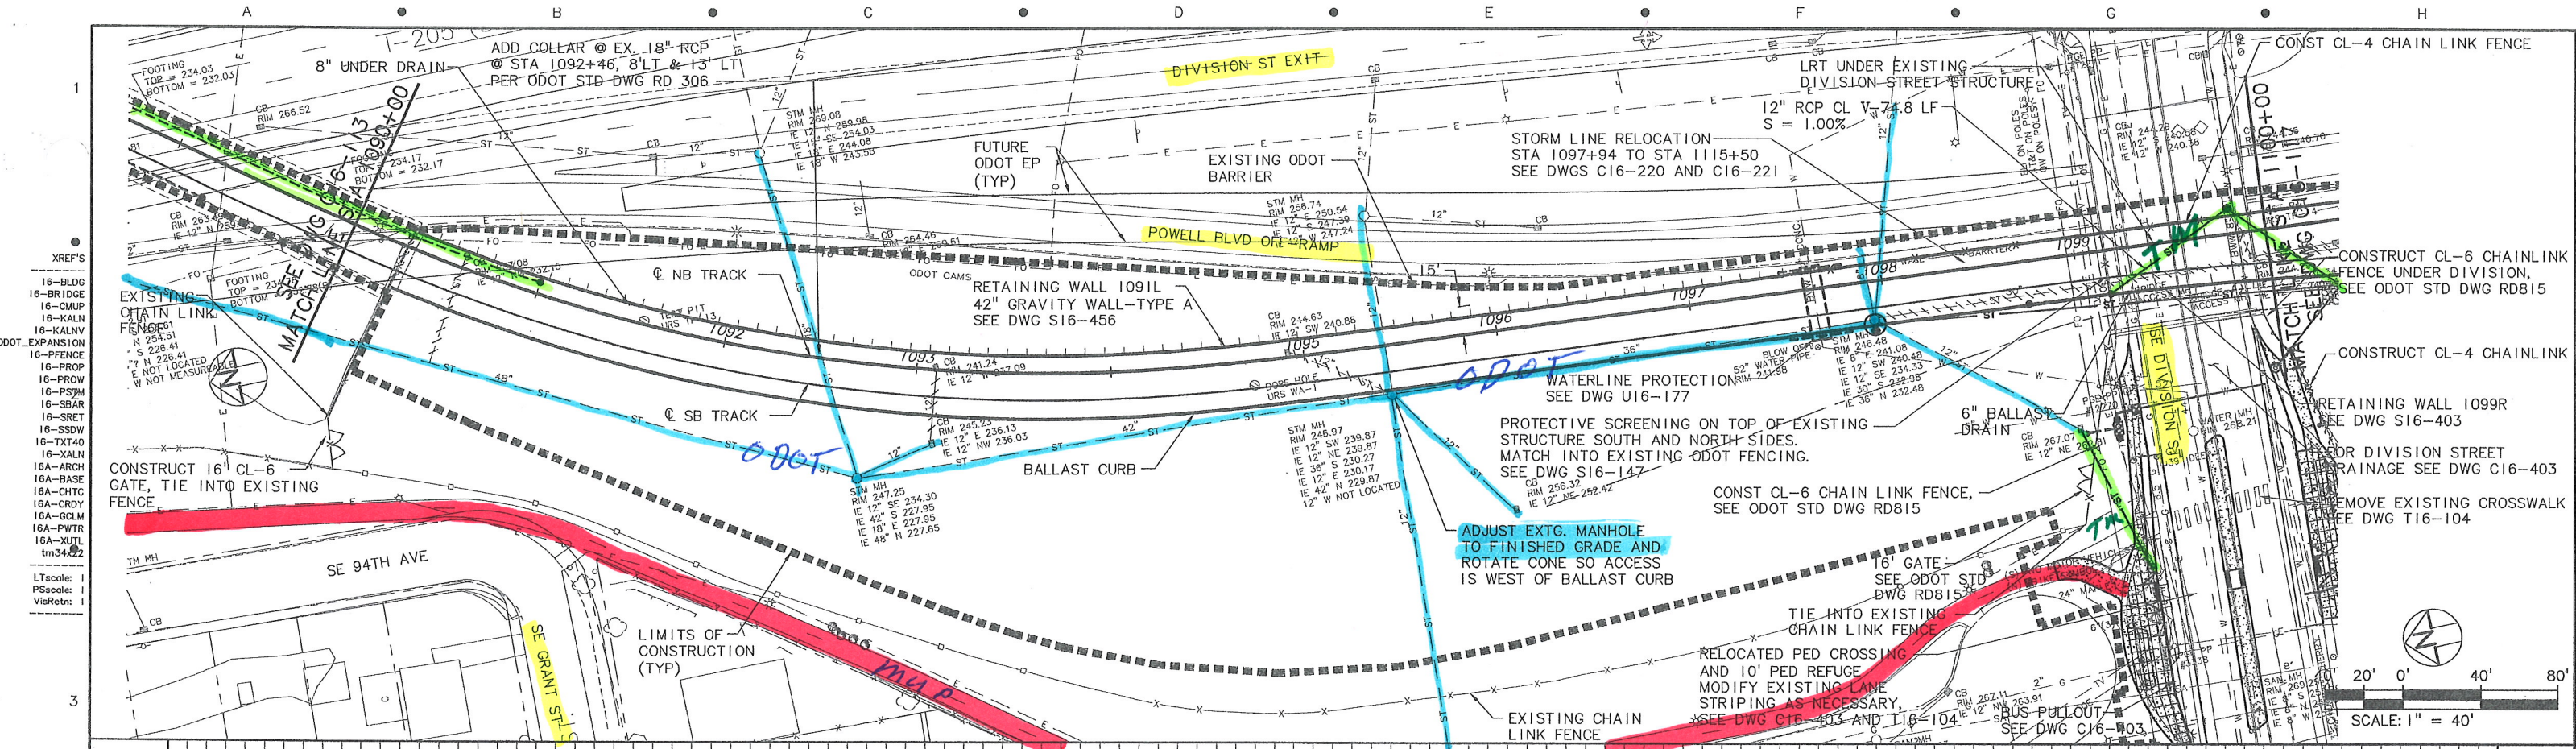

- 16-BLDG
16-BRIDGE
16-CMUP
16-KALN
16-KALNV
16-PFENCE
16-PROP
16-PROV
16-PSYM
16-SBAR
16-SRET
16-SSDW
16-TXT40
16-XALN
16A-ARCH
16A-BASE
16A-CHTC
16A-CRDY
16A-GOLM
16A-PWTR
16A-XUTL
tm34.22
- LTscale: 1
PSscale: 1
Viascale: 1

R:\V-205 AS-BUILTS\C16-115.dwg Jan. 26, 2010 - 3:31 PM lorts, buck
Plot Date: 3/16/2010 7:10

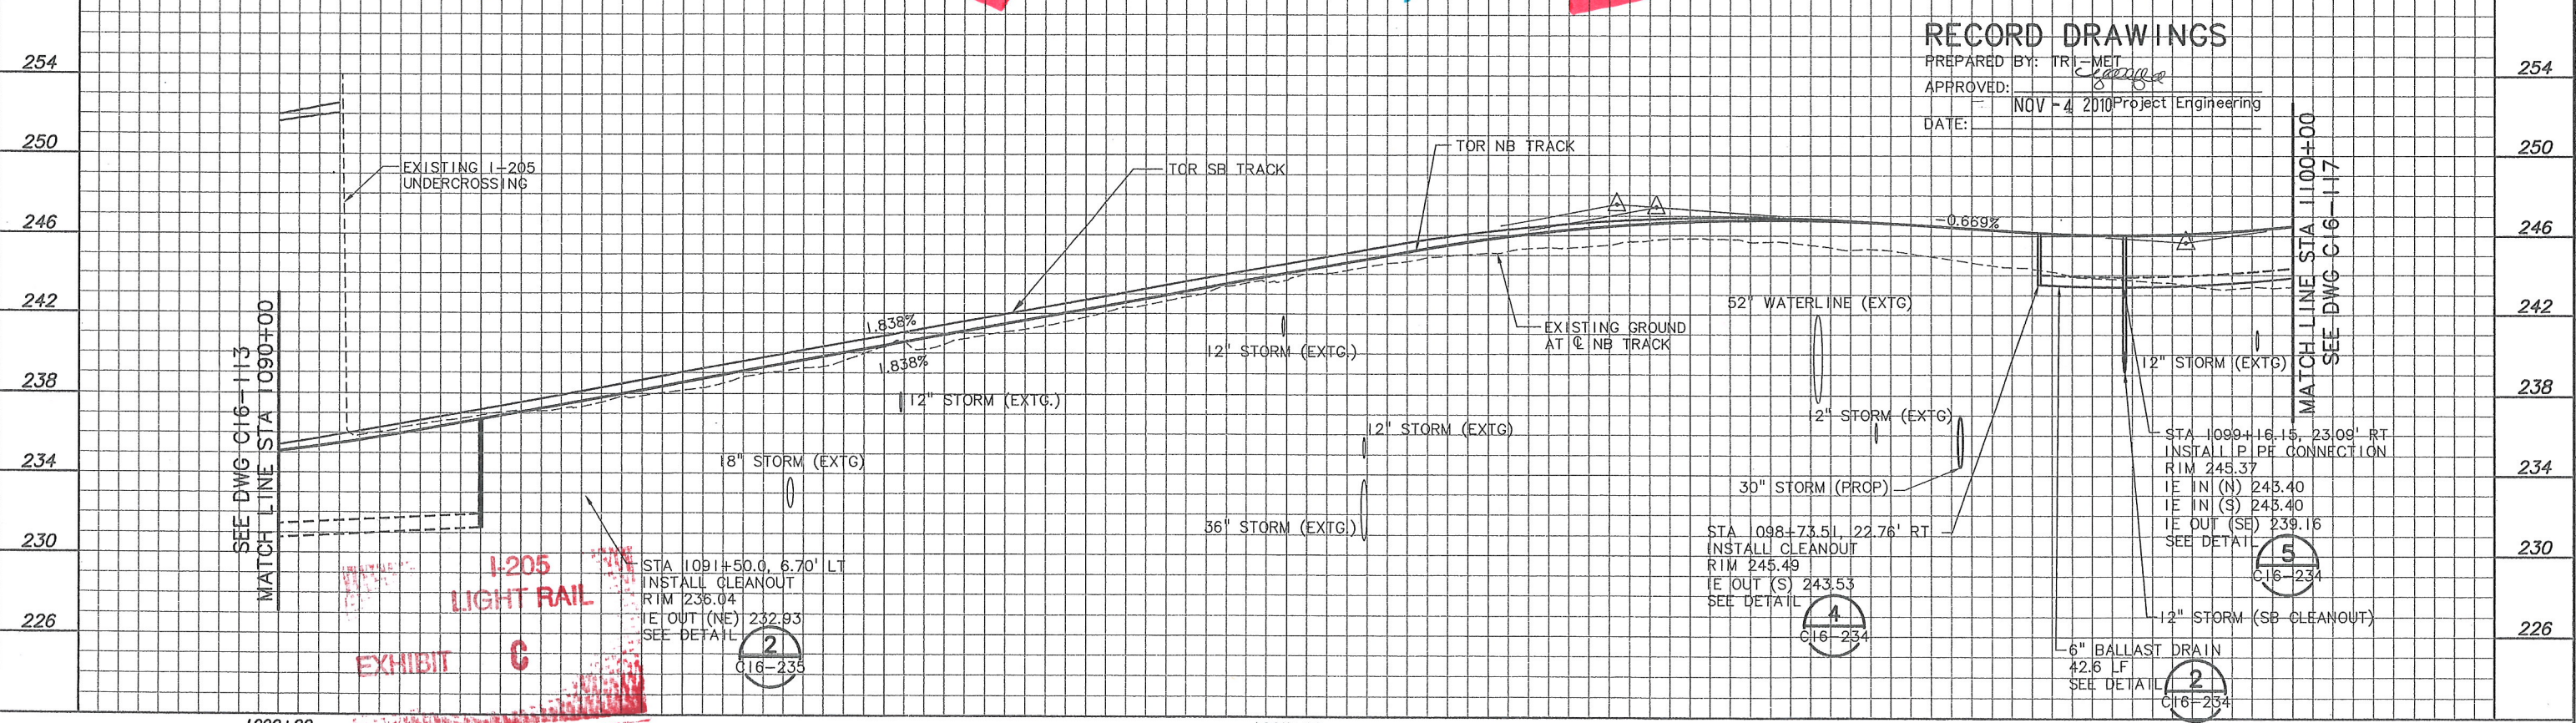

NOTE: THESE RECORD DRAWINGS REPRESENT THE BEST KNOWN INFORMATION ABOUT CONSTRUCTED FACILITIES. LOCATIONS SHOWN ARE NOT WARRANTED. UNDERGROUND UTILITIES MUST BE FIELD VERIFIED FOR ACTUAL LOCATION.

RECORD DRAWING

NO.	DATE	BY	APPD.	REVISIONS

DESIGNED	2-17-06	DATE
JTH	2-19-06	DATE
CHECKED		DATE
APPROVED		DATE

TRI-COUNTY METROPOLITAN TRANSPORTATION DISTRICT OF OREGON

SOUTH CORRIDOR CONSTRUCTORS
Stacy and Wilbeck
GRANITE
WILDISH

DAVID EVANS AND ASSOCIATES INC.
2100 Southwest River Parkway
Portland Oregon 97201
Phone: 503.223.6663



TRI@MET

CAPITAL PROJECTS AND FACILITIES DIVISION
710 N.E. HOLLADAY STREET
PORTLAND, OREGON 97232

SUBMITTED: 12/15/06
DATE: 12/15/06
APPROVED: 12/15/06
DATE: 12/15/06

SOUTH CORRIDOR PROJECT
I-205 SEGMENT
CIVIL PLAN & PROFILE
STA 1090+00 TO STA 1100+00

SCALE: 1" = 40'-0"
DRAWING NO.: C16-115-BX
CONTRACT NO.: RH040161LE
SHEET NO.: 120

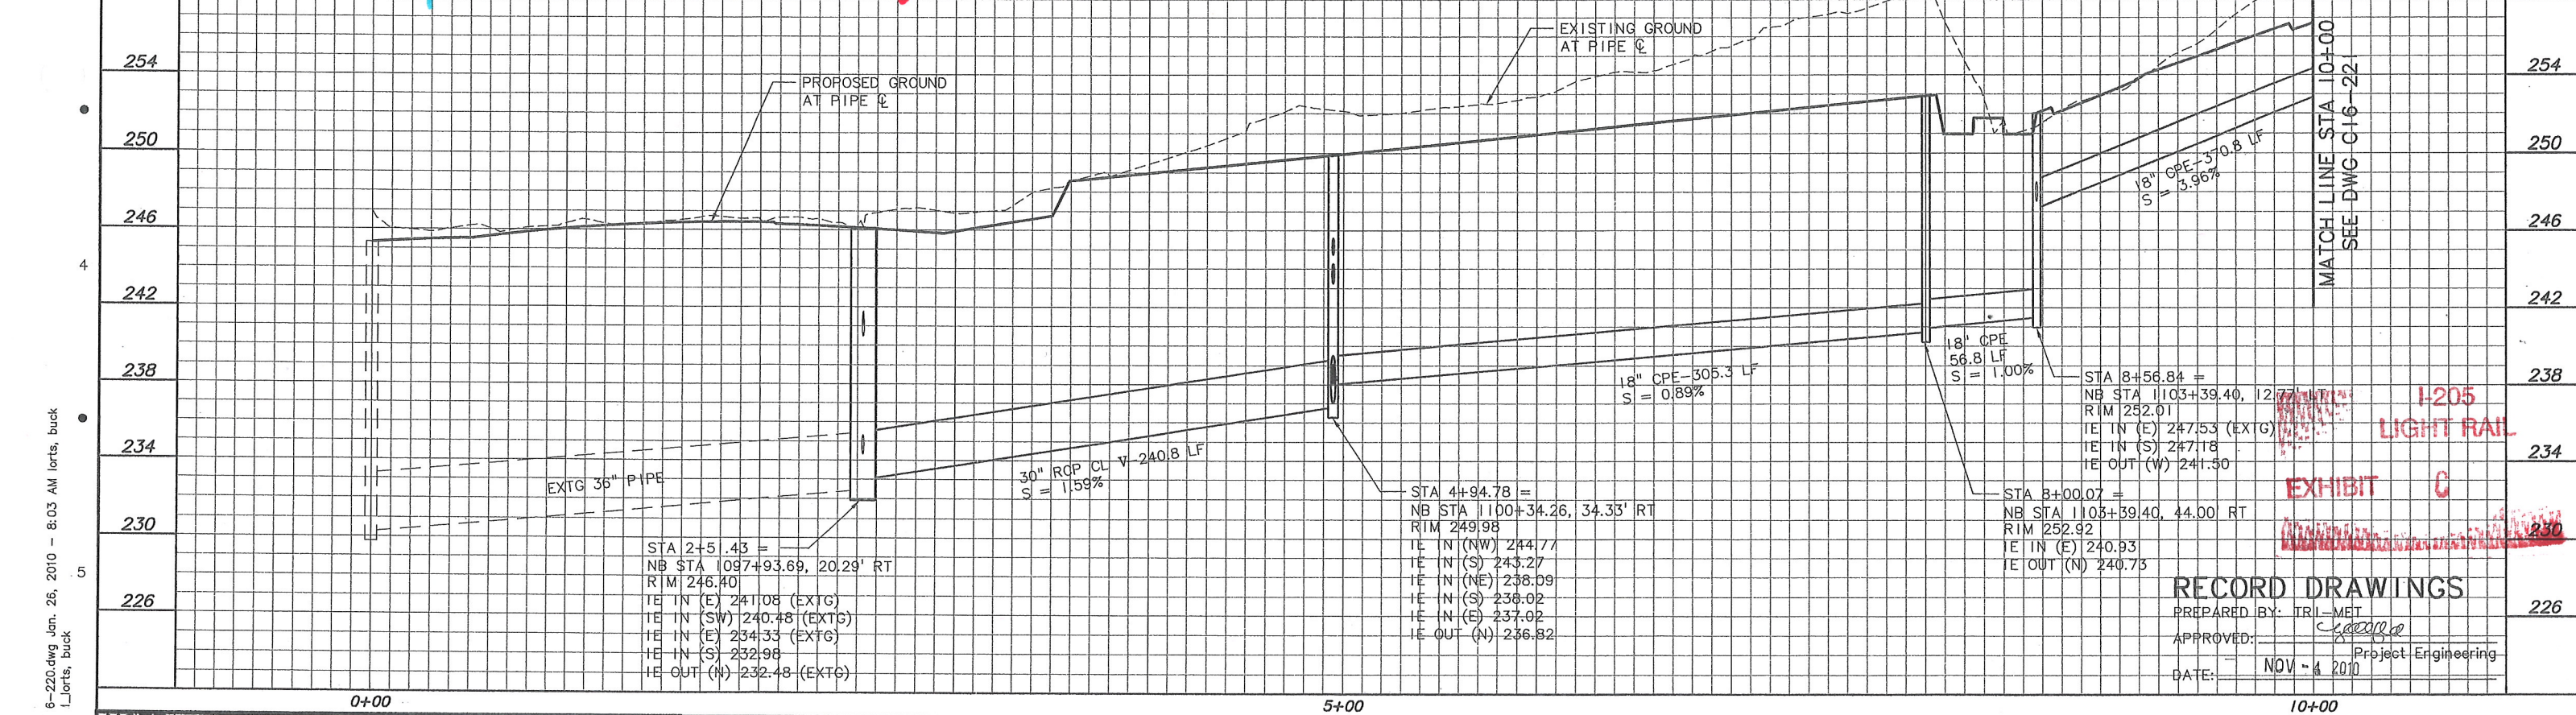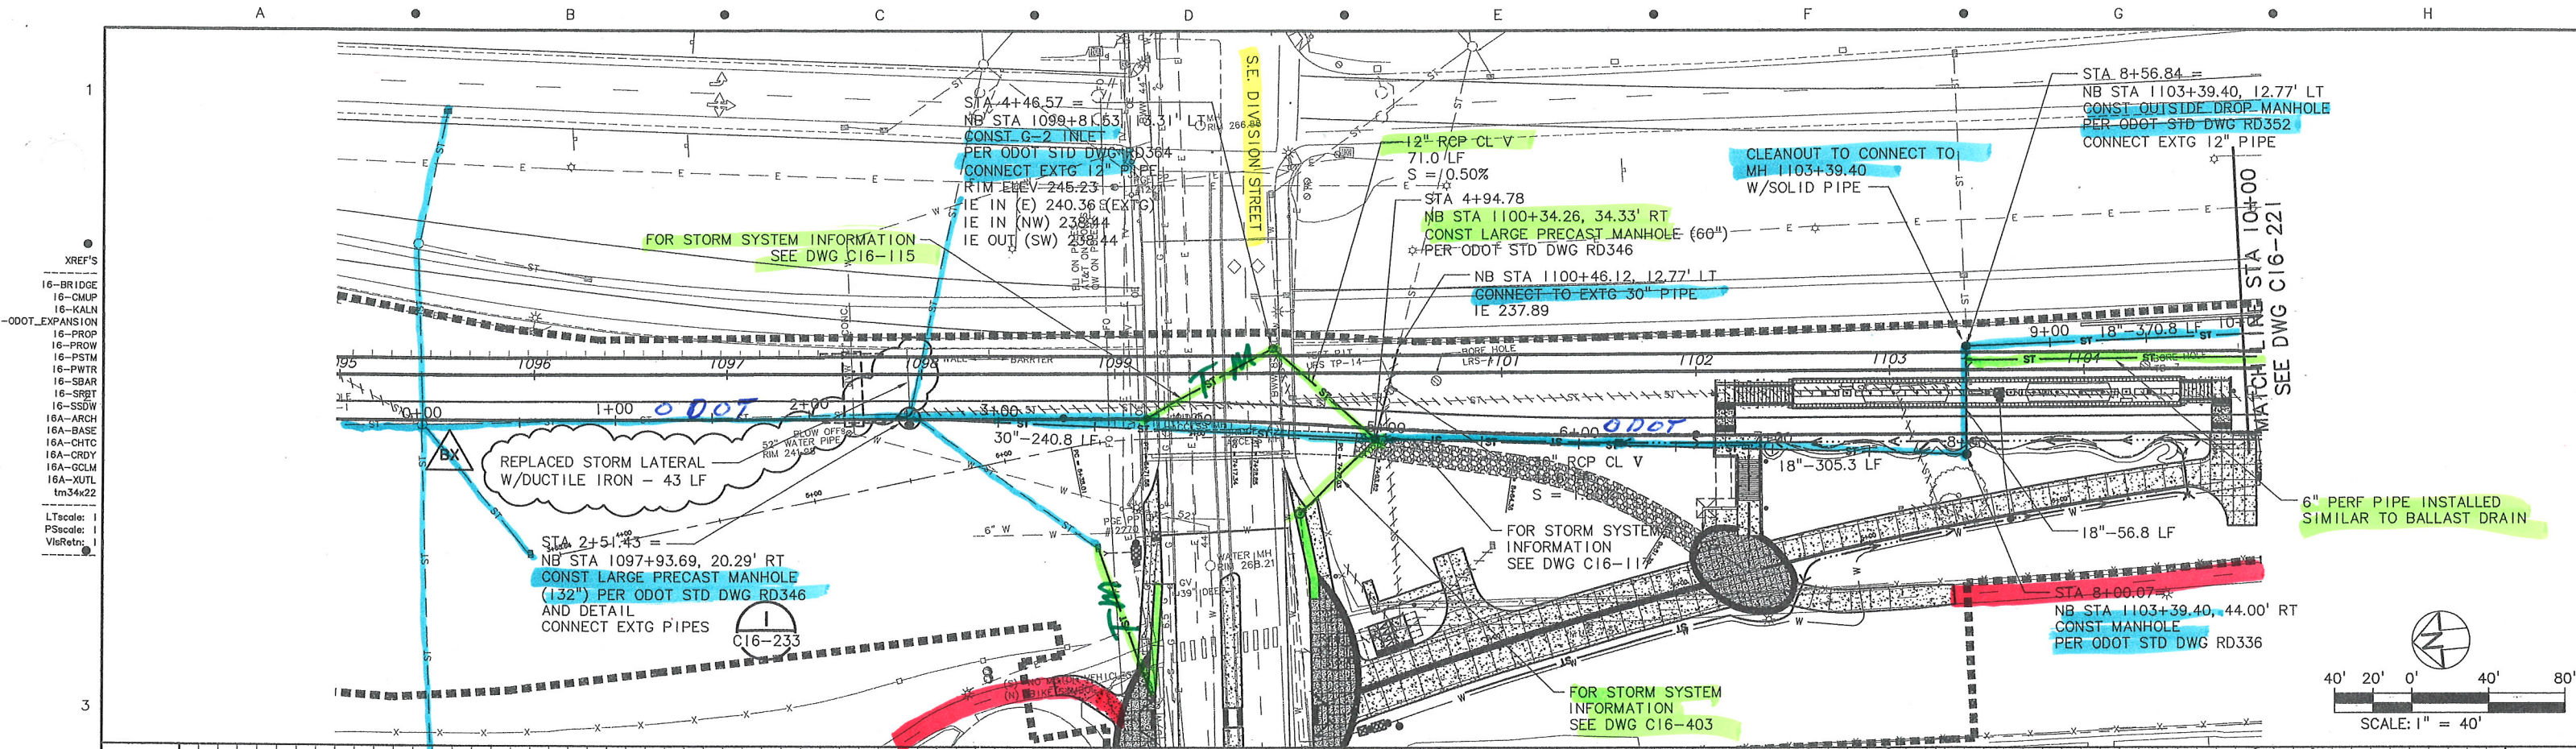

NOTE: THESE RECORD DRAWINGS REPRESENT THE BEST KNOWN INFORMATION ABOUT CONSTRUCTED FACILITIES. LOCATIONS SHOWN ARE NOT WARRANTED. UNDERGROUND UTILITIES MUST BE FIELD VERIFIED FOR ACTUAL LOCATION.

NO.	DATE	BY	APPD.	REVISIONS

CJH	DESIGNED	5-31-06
CRN	DRAWN	5-31-06
CRN	CHECKED	12-11-06
SBM	APPROVED	12-12-06

TRI-COUNTY METROPOLITAN TRANSPORTATION DISTRICT OF OREGON

SOUTH CORRIDOR CONSTRUCTORS
Stacy and Wilbeck
GRANITE
WILDISH

DAVID EVANS AND ASSOCIATES INC.
2100 Southwest River Parkway
Portland Oregon 97201
Phone: 503.223.6663

TRIOMET
CAPITAL PROJECTS AND FACILITIES DIVISION
710 N.E. HOLLADAY STREET
PORTLAND, OREGON 97232

APPROVED: _____ DATE: _____

SOUTH CORRIDOR PROJECT
I-205 SEGMENT
STORM LINE RELOCATION PLAN AND PROFILE
STA 1097+94 TO STA 1115+50
SHEET 1 OF 2

SCALE: 1" = 40'-0"
DRAWING NO.: C16-220-CX
CONTRACT NO.:
SHEET NO.: 202

R:\V-205 AS-BUILT\3/16/2010 11
6-220.dwg Jan. 26, 2010 - 8:03 AM lorts, buck
LJorts, buck

