
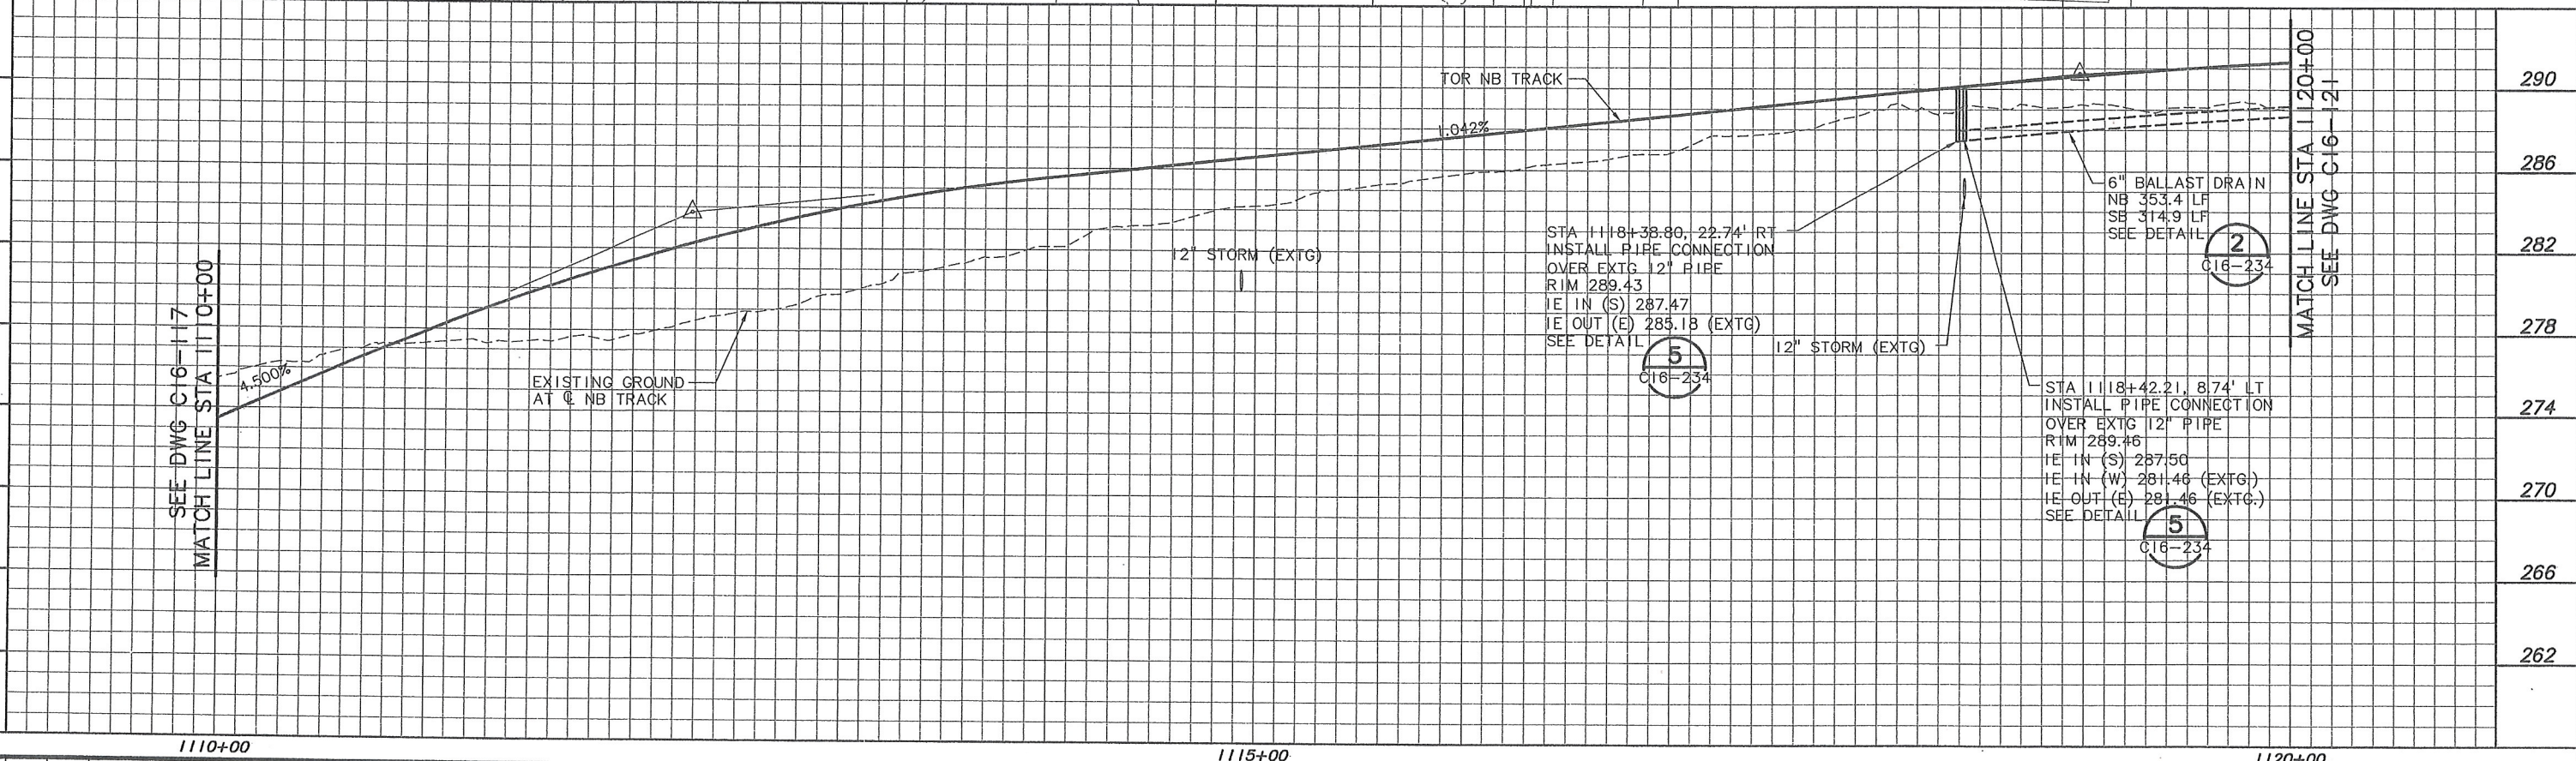


R:\205 AS-BUILTS\3-119.dwg Jan. 27, 2010 - 2:47 PM lorts, buck
Plot Date: 3/16/2010 7:11

XREF'S
16-BLDG
16-BRIDGE
16-CMUP
16-KALN
16-KALNV
3-ODOT_EXPANSION
16-PFENCE
16-PROP
16-PROV
16-PSDM
16-SBAR
16-SRET
16-SSDW
16-TXT40
16-XALN
16A-ARCH
16A-BASE
16A-BASE1
16A-CHTC
16A-CRDY
16A-GCLM
16A-PWTR
16A-XUL
tm34x22
LTScale: 1
PScale: 1
VlaRetn: 1

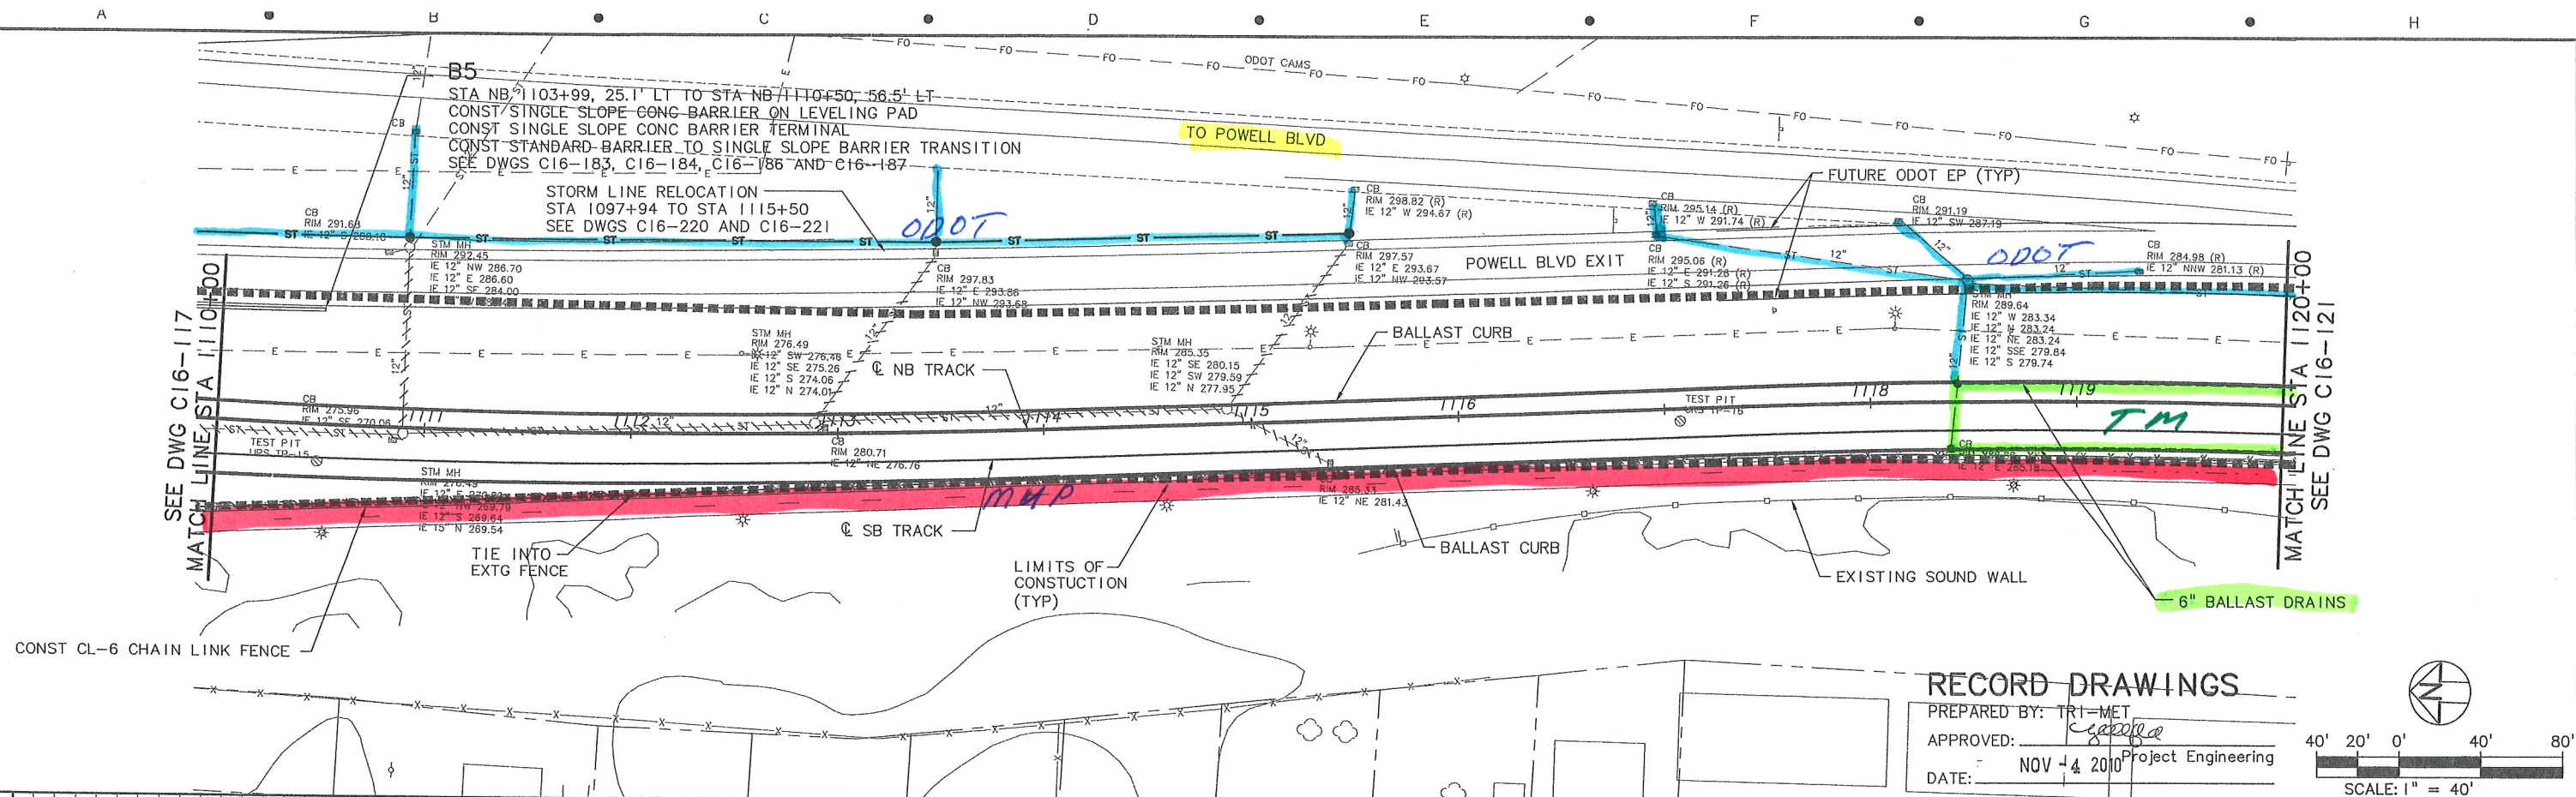

NOTE: THESE RECORD DRAWINGS REPRESENT THE BEST KNOWN INFORMATION ABOUT CONSTRUCTED FACILITIES. LOCATIONS SHOWN ARE NOT WARRANTED. UNDERGROUND UTILITIES MUST BE FIELD VERIFIED FOR ACTUAL LOCATION.				
RECORD DRAWING				
NO.	DATE	BY	APPD.	REVISIONS
		CHK.		

DRA/DESIGNED	2-14-06
KRF/DRAWN	2-16-06
CHECKED	DATE
APPROVED	DATE

TRI-COUNTY METROPOLITAN TRANSPORTATION DISTRICT OF OREGON

SOUTH CORRIDOR CONSTRUCTORS
Stacy and Witbeck
GRANITE WILDISH



DAVID EVANS AND ASSOCIATES INC.
2100 Southwest River Parkway
Portland Oregon 97201
Phone: 503.223.6683

TRI-MET
CAPITAL PROJECTS AND FACILITIES DIVISION
710 N.E. HOLLADAY STREET
PORTLAND, OREGON 97232

SOUTH CORRIDOR PROJECT
I-205 SEGMENT
CIVIL PLAN & PROFILE
STA 1110+00 TO STA 1120+00

SUBMITTED:	DATE:	APPROVED:	DATE:
	12/15/06		12/15/06

SCALE:	DRAWING NO.:	CONTRACT NO.:	SHEET NO.:
1" = 40'-0"	C16-119-AX	RH040161LE	122

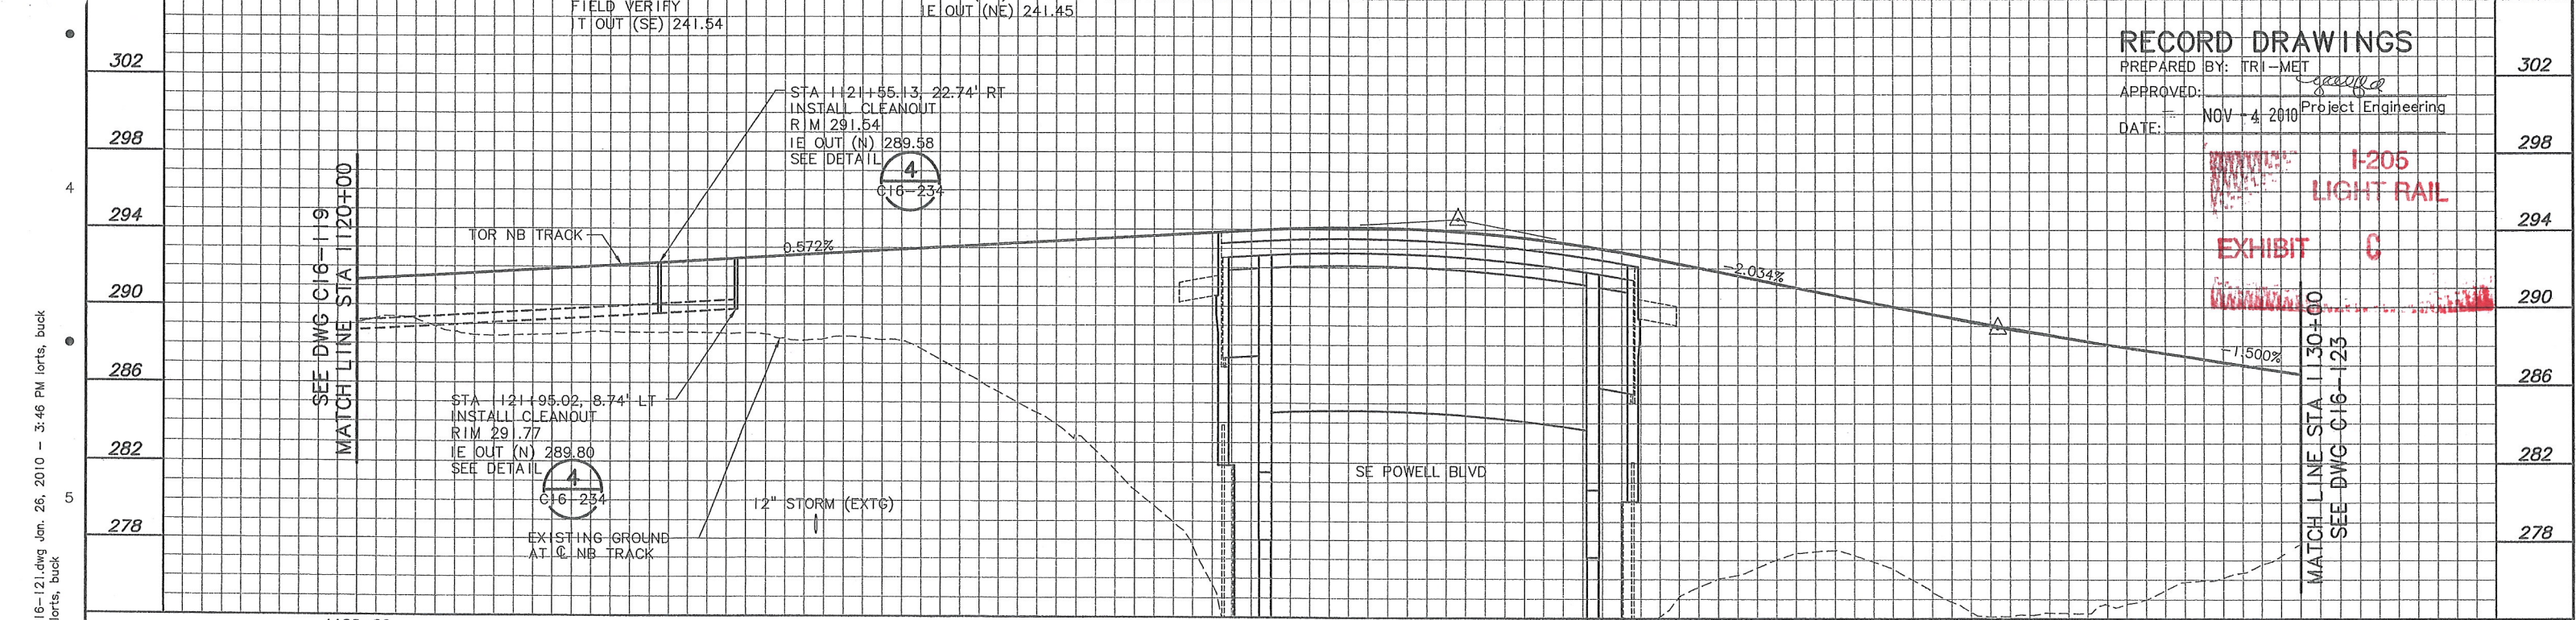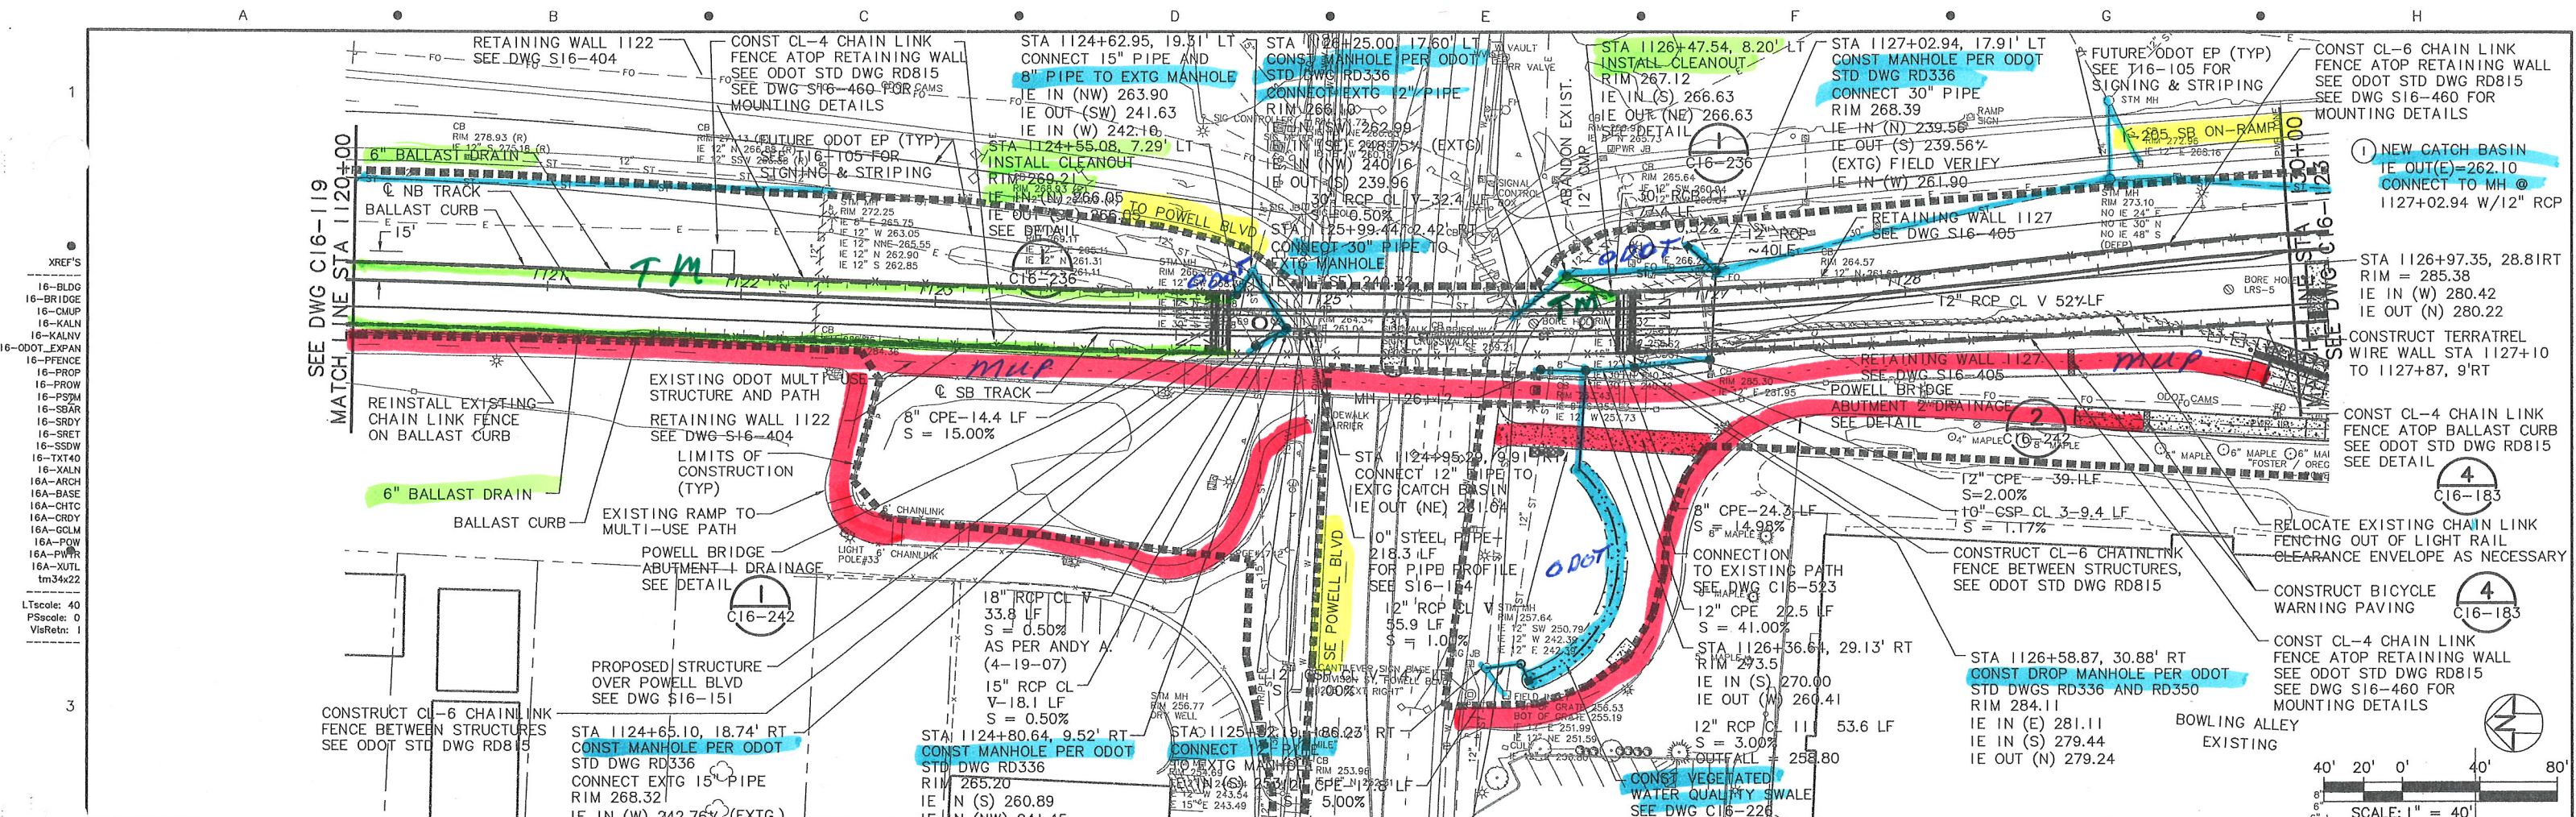

NOTE: THESE RECORD DRAWINGS REPRESENT THE BEST KNOWN INFORMATION ABOUT CONSTRUCTED FACILITIES. LOCATIONS SHOWN ARE NOT WARRANTED. UNDERGROUND UTILITIES MUST BE FIELD VERIFIED FOR ACTUAL LOCATION.

NO.	DATE	BY	APPD.	REVISIONS

DRA/KRN	2-17-06
DESIGNED	DATE
JTH	2-19-06
DRAWN	DATE
CHECKED	DATE
APPROVED	DATE

RECORD DRAWING

TRI-COUNTY METROPOLITAN TRANSPORTATION DISTRICT OF OREGON

SOUTH CORRIDOR CONSTRUCTORS
Stacy and Wilbeck
GRANITE
WILDISH

DAVID EVANS AND ASSOCIATES INC.
2100 Southwest River Parkway
Portland Oregon 97201
Phone: 503.223.6663



TRI MET

CAPITAL PROJECTS AND FACILITIES DIVISION
710 N.E. HOLLADAY STREET
PORTLAND, OREGON 97232

SOUTH CORRIDOR PROJECT
I-205 SEGMENT
CIVIL PLAN & PROFILE
STA 1120+00 TO STA 1130+00

SCALE:	1" = 40'-0"	DRAWING NO.:	C16-121-DX	CONTRACT NO.:	RH040161LE	SHEET NO.:	123
--------	-------------	--------------	------------	---------------	------------	------------	-----

R:\1-205 AS-BUILT\1121.dwg Jan. 26, 2010 - 3:46 PM Jorts, buck
Plot Date: 3/16/2010 7:00
Jorts, buck

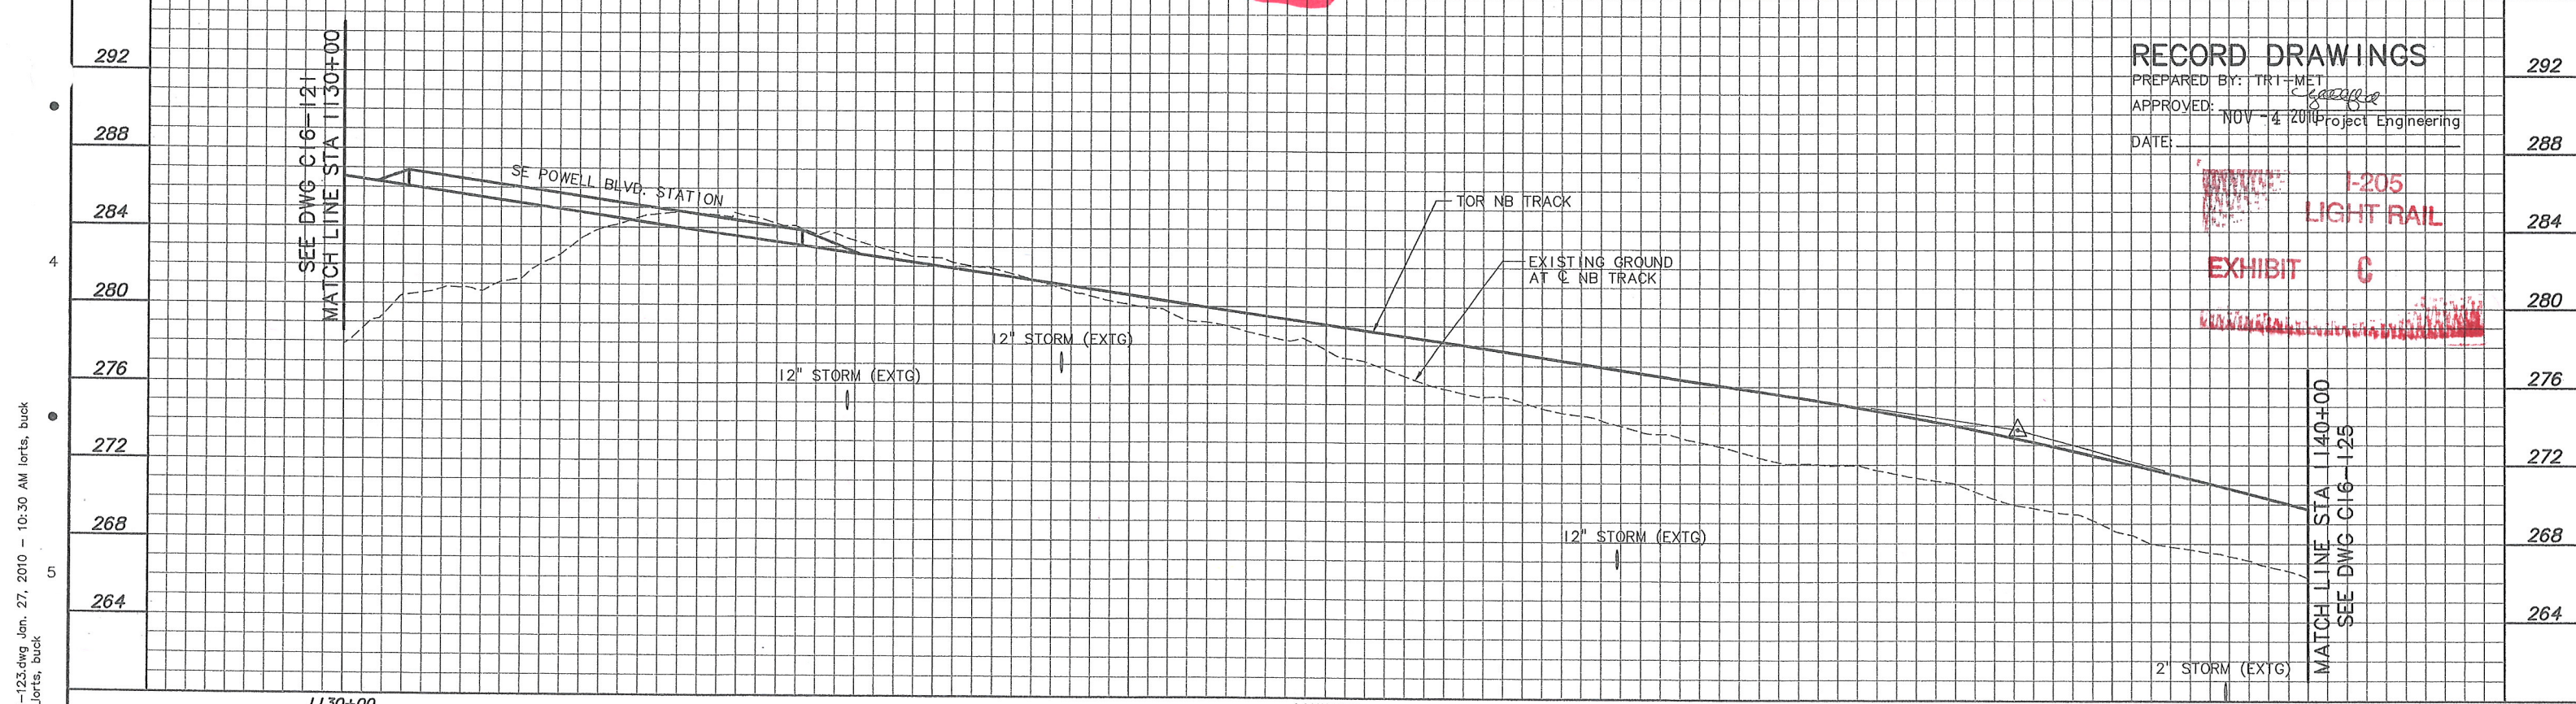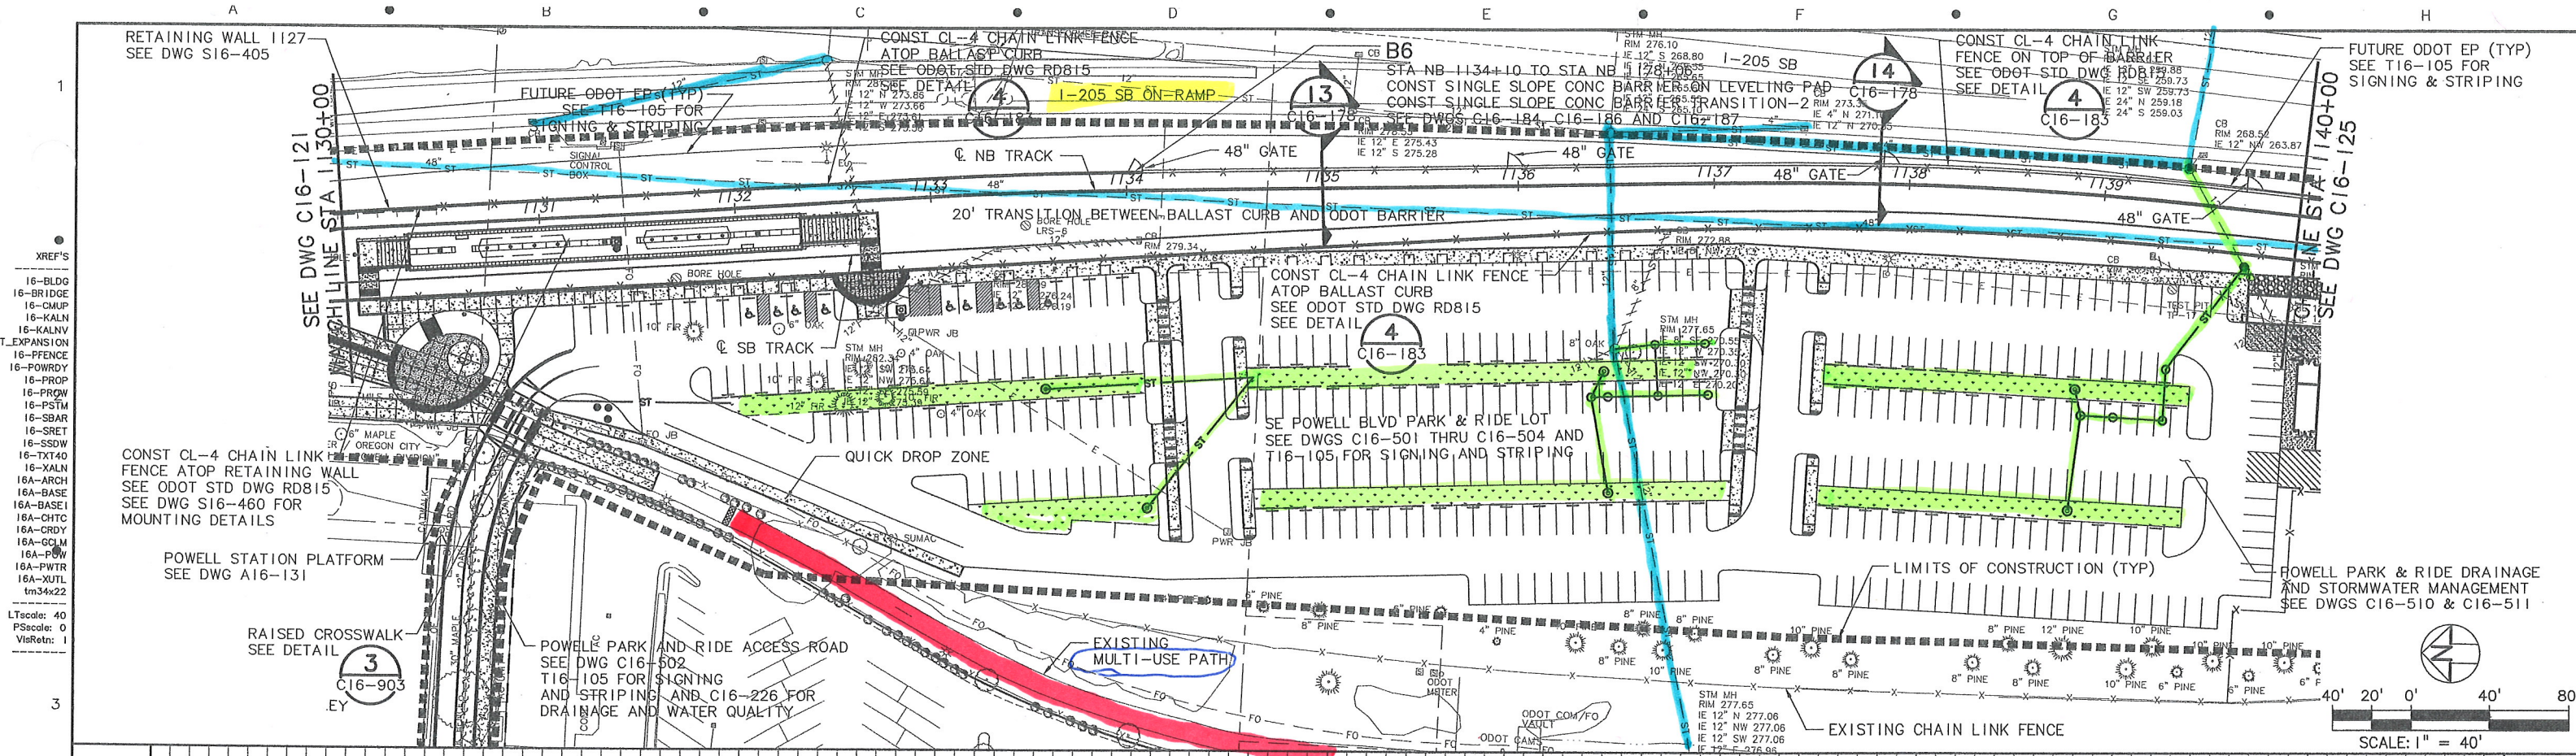

NOTE: THESE RECORD DRAWINGS REPRESENT THE BEST KNOWN INFORMATION ABOUT CONSTRUCTED FACILITIES. LOCATIONS SHOWN ARE NOT WARRANTED. UNDERGROUND UTILITIES MUST BE FIELD VERIFIED FOR ACTUAL LOCATION.

NO.	DATE	BY	CHK.	APPD.	REVISIONS

DRA/KRN DESIGNED	2-17-06 DATE
JTH DRAWN	2-19-06 DATE
CHECKED	DATE
APPROVED	DATE

RECORD DRAWING

TRI-COUNTY METROPOLITAN TRANSPORTATION DISTRICT OF OREGON

SOUTH CORRIDOR CONSTRUCTORS
Stacy and Wilbeck
GRANITE
WILDISH

DAVID EVANS AND ASSOCIATES INC.
2100 Southwest River Parkway
Portland Oregon 97201
Phone: 503.223.6663

TRIOMET


CAPITAL PROJECTS AND FACILITIES DIVISION
710 N.E. HOLLADAY STREET
PORTLAND, OREGON 97232

SUBMITTED: 12/15/06
DATE: 12/15/06
APPROVED: 12/15/06
DATE: 12/15/06

SOUTH CORRIDOR PROJECT
1-205 SEGMENT
CIVIL PLAN & PROFILE
STA 1130+00 TO STA 1140+00

SCALE: 1" = 40'-0"
DRAWING NO.: C16-123-BX
CONTRACT NO.: RH040161LE
SHEET NO.: 124

R: N-205 AS-BUILT'S C.
Plot Date: 3/16/2010 7:11 AM
6-123.dwg Jan. 27, 2010 - 10:30 AM lorts, buck
V: lorts, buck

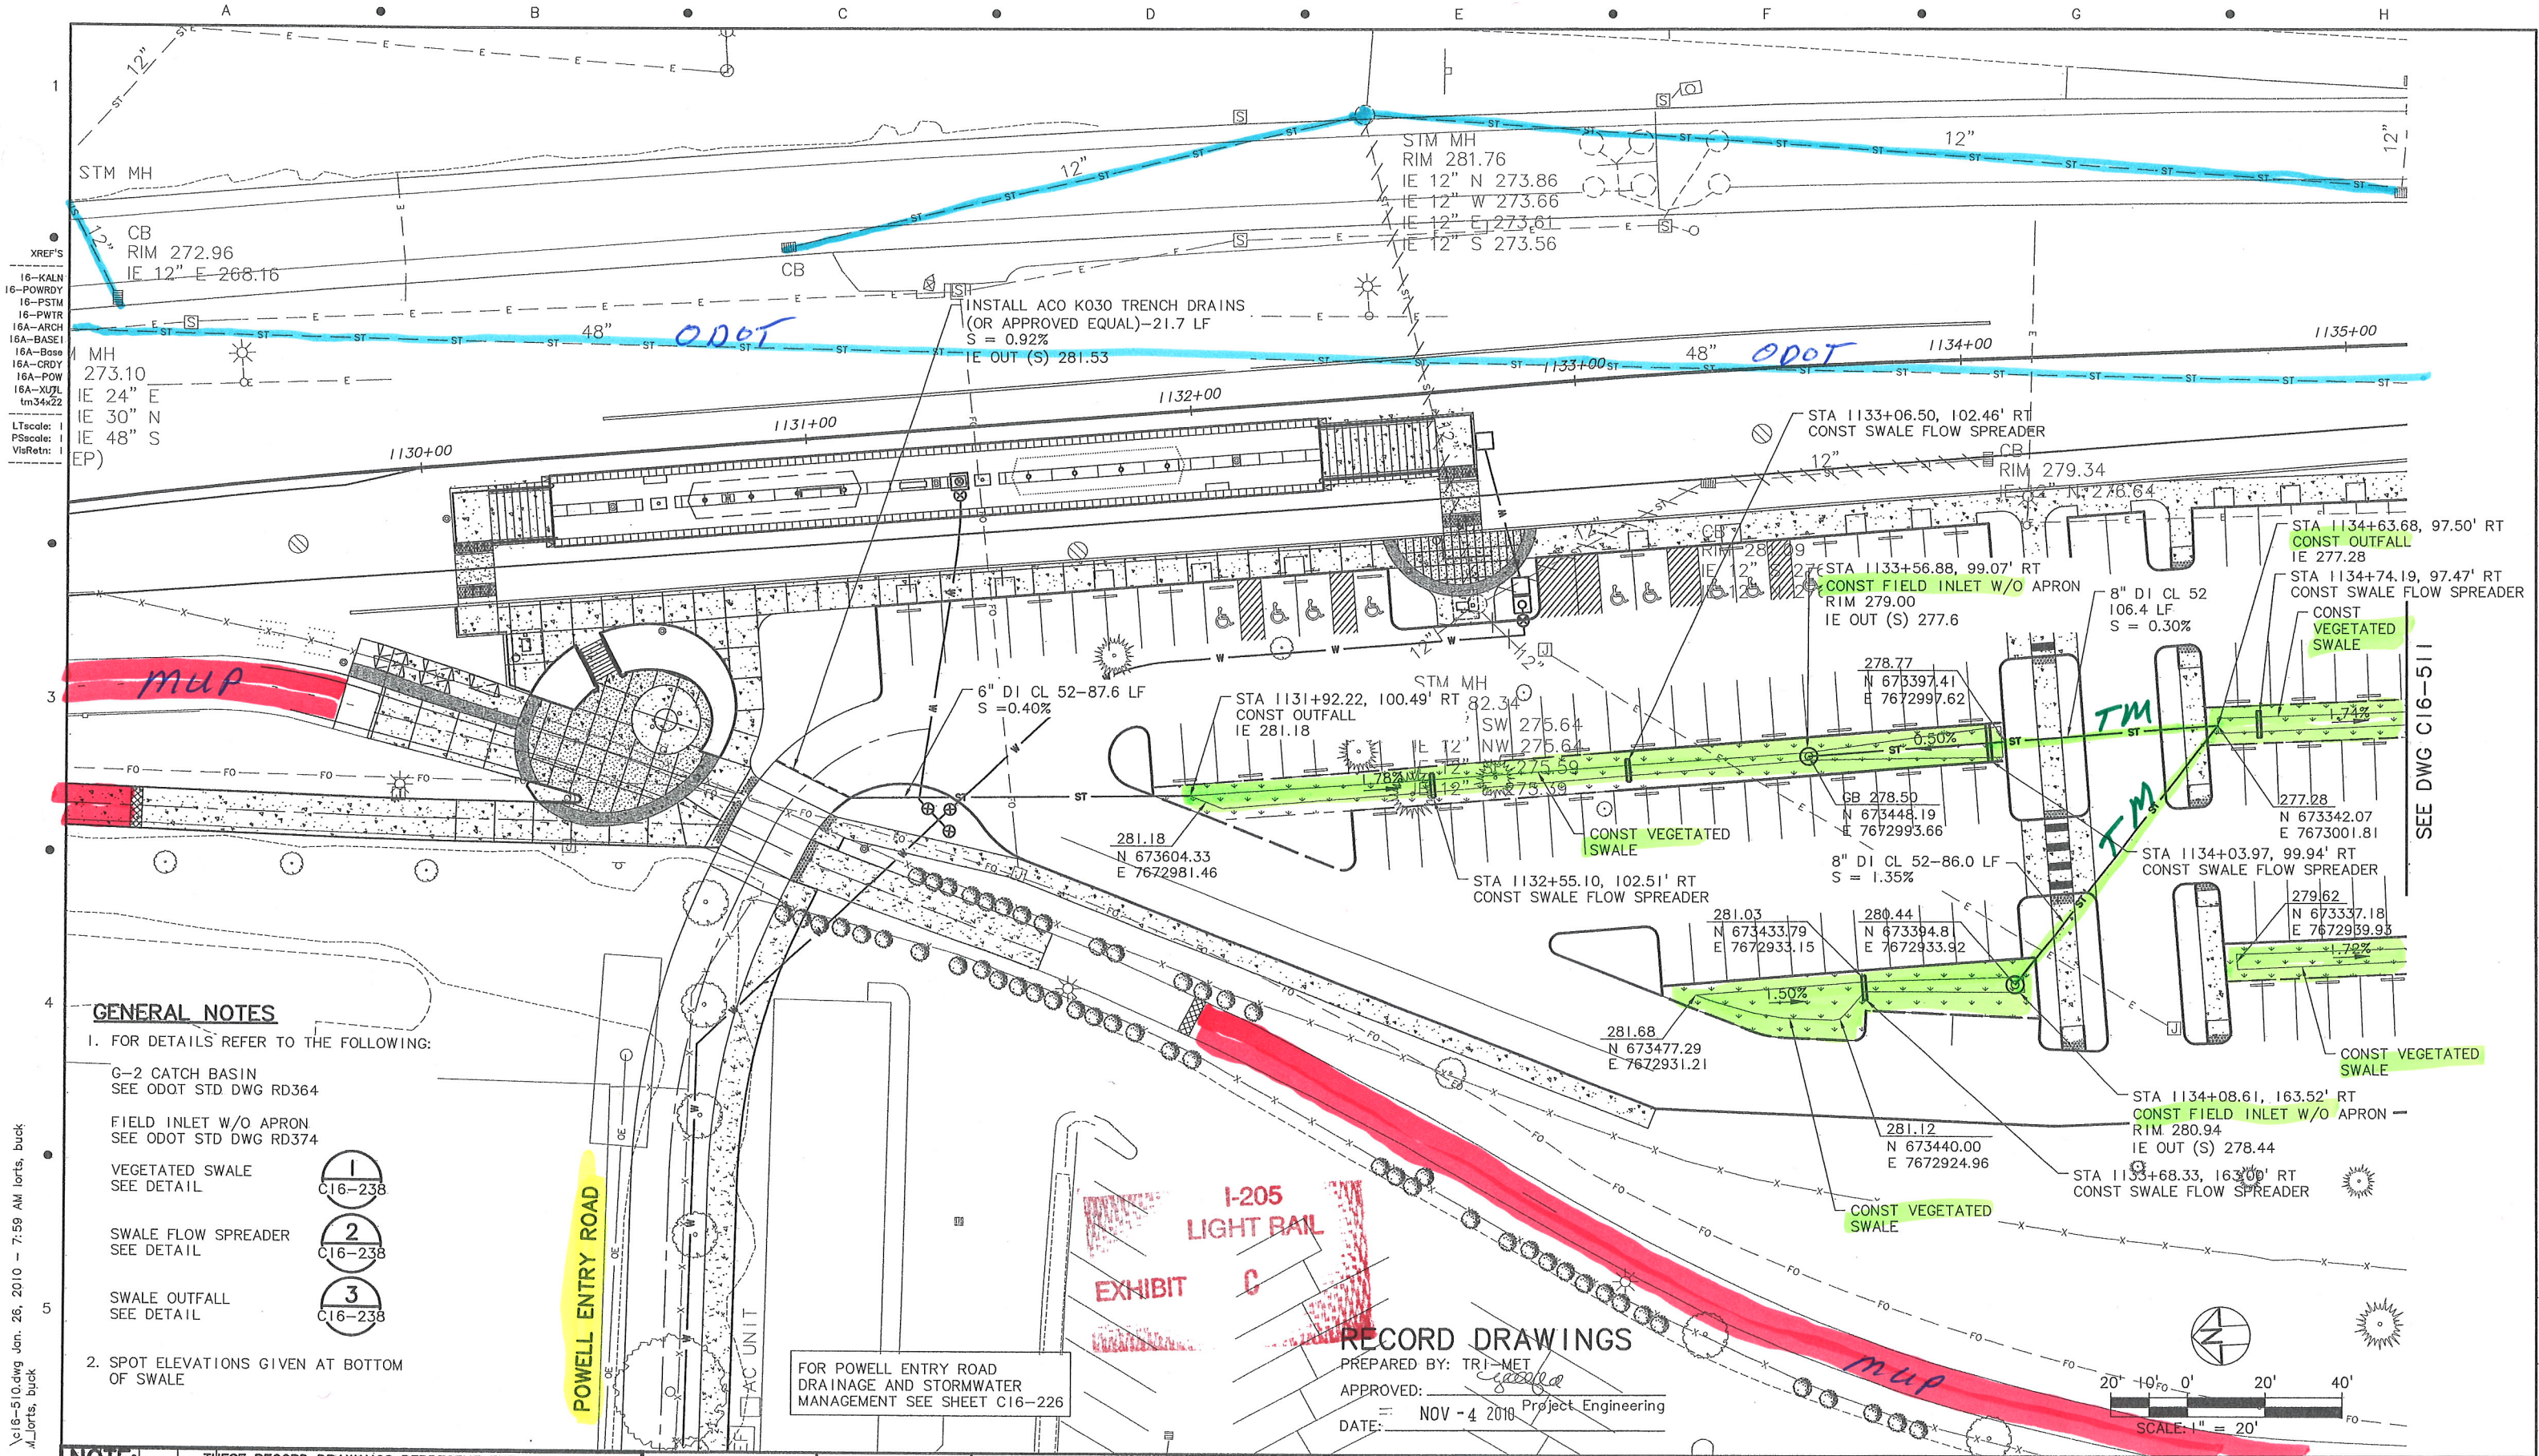

GENERAL NOTES

- FOR DETAILS REFER TO THE FOLLOWING:
 - G-2 CATCH BASIN
SEE ODOT STD DWG RD364
 - FIELD INLET W/O APRON
SEE ODOT STD DWG RD374
 - VEGETATED SWALE
SEE DETAIL
 - SWALE FLOW SPREADER
SEE DETAIL
 - SWALE OUTFALL
SEE DETAIL
- SPOT ELEVATIONS GIVEN AT BOTTOM OF SWALE

- 1
C16-238
- 2
C16-238
- 3
C16-238

NOTE: THESE RECORD DRAWINGS REPRESENT THE BEST KNOWN INFORMATION ABOUT CONSTRUCTED FACILITIES. LOCATIONS SHOWN ARE NOT WARRANTED. UNDERGROUND UTILITIES MUST BE FIELD VERIFIED FOR ACTUAL LOCATION.

RECORD DRAWING


CJH	DESIGNED	5-17-06	DATE
KRN	DRAWN	5-17-06	DATE
	CHECKED		DATE
	APPROVED		DATE

FOR POWELL ENTRY ROAD
DRAINAGE AND STORMWATER
MANAGEMENT SEE SHEET C16-226

EXHIBIT C
I-205 LIGHT RAIL

RECORD DRAWINGS

PREPARED BY: TRI-MET
APPROVED: [Signature]
DATE: NOV - 4 2010 Project Engineering

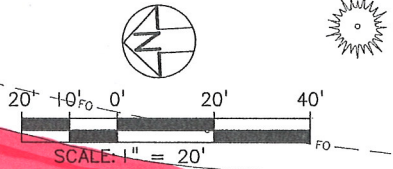

R:\1-205 AS-BUILT\ Plot Date: 3/18/2010
C:\16-510.dwg Jan. 26, 2010 - 7:59 AM lorts, buck
A:\lorts, buck

SOUTH CORRIDOR CONSTRUCTORS
Stacy and Witbeck
GRANITE
WILDISH

DAVID EVANS AND ASSOCIATES INC.
2100 Southwest River Parkway
Portland Oregon 97201
Phone: 503.223.6663

TRI-MET
CAPITAL PROJECTS
AND
FACILITIES DIVISION
710 N.E. HOLLADAY STREET
PORTLAND, OREGON 97232

SOUTH CORRIDOR PROJECT
I-205 SEGMENT
POWELL BOULEVARD PARK AND RIDE
DRAINAGE AND STORMWATER MANAGEMENT PLAN
NORTH HALF

NO.	DATE	BY	APPD.	REVISIONS
		CHK.		

SUBMITTED:	DATE:	APPROVED:	DATE:	SCALE:	DRAWING NO.:	CONTRACT NO.:	SHEET NO.:
	12/15/06		12/15/06	1" = 20'-0"	C16-510	RH040161LE	287