


RECORD DRAWINGS

PREPARED BY: TRI-MET
APPROVED: *[Signature]* Project Engineering
DATE: NOV - 4 2010

XREF'S
16-KALN
16-POWDY
16-PROP
16-PTM
16-TXT20
16A-ARCH
16A-BASE
16A-BASE
16A-CRDY
16A-PDW
16A-XUTL
tm34x22
LScale: 20
PScale: 0
VisRetn: 1


R:\1-205 AS-BUILT\1-205-511.dwg Jan. 26, 2010 - 7:59 AM lorts, buck
Plot Date: 3/18/2010 7:00 lorts, buck

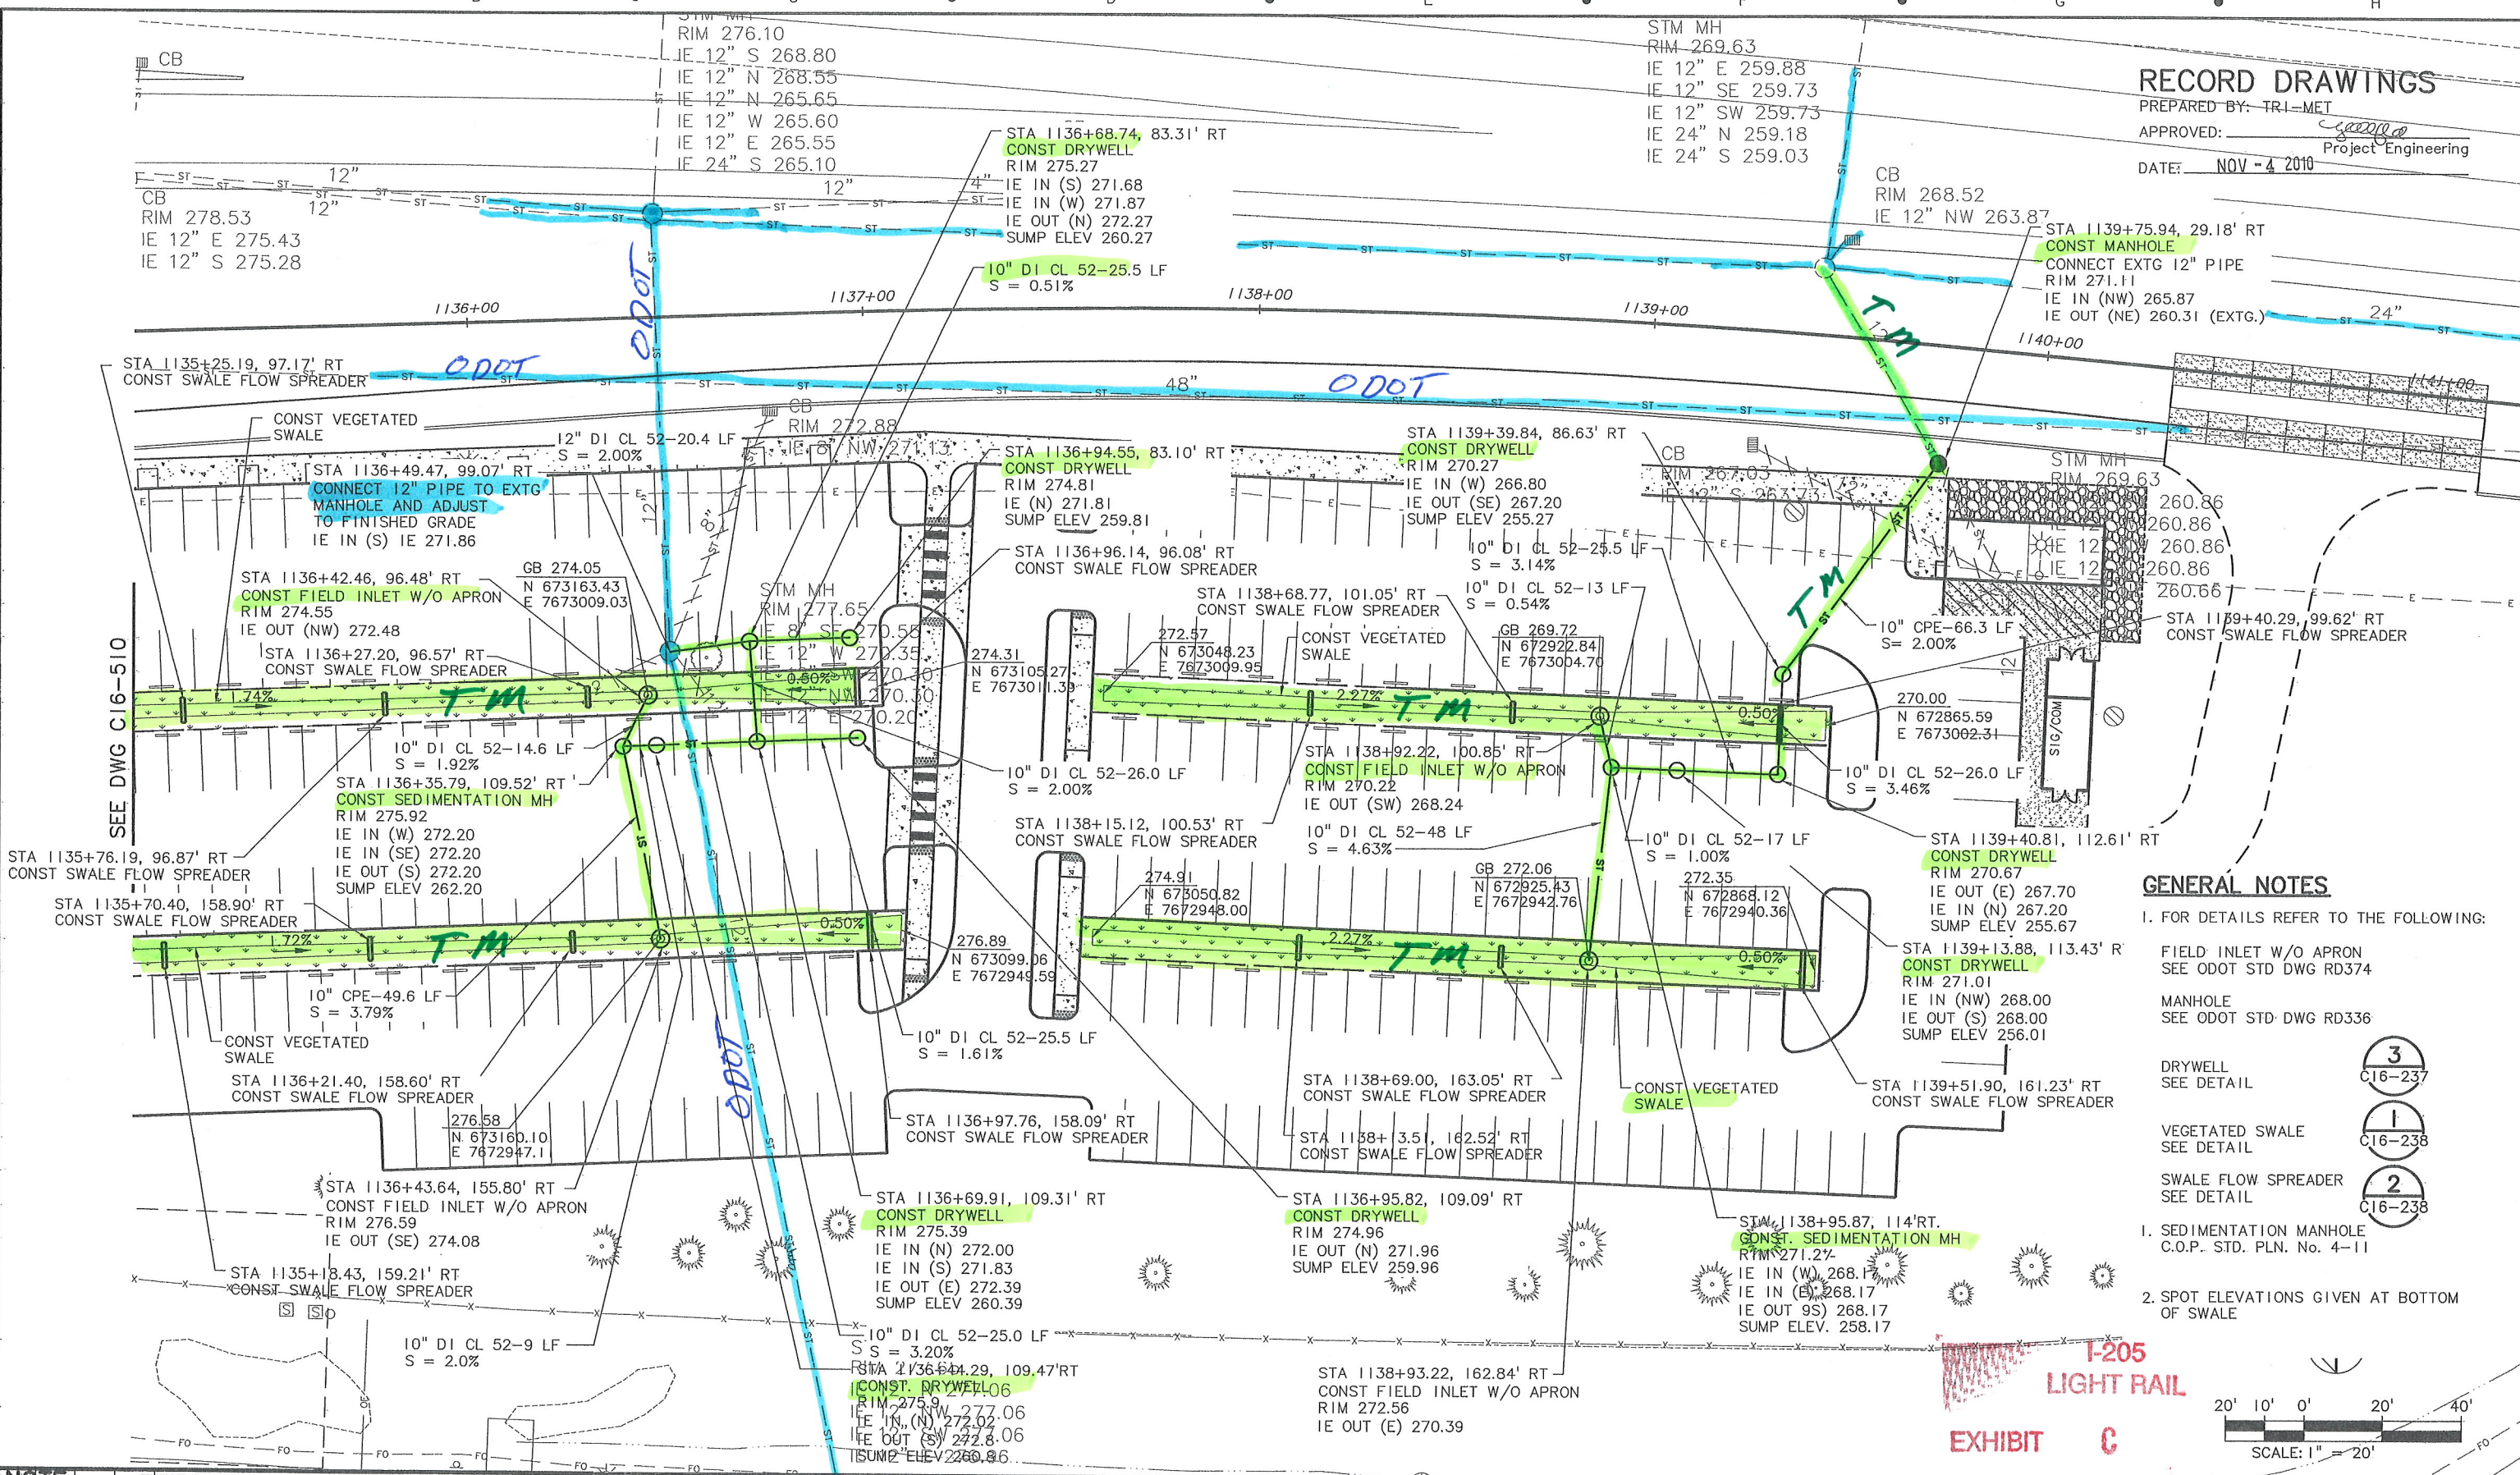

GENERAL NOTES

- FOR DETAILS REFER TO THE FOLLOWING:
FIELD INLET W/O APRON
SEE ODOT STD DWG RD374
MANHOLE
SEE ODOT STD DWG RD336
DRYWELL
SEE DETAIL
VEGETATED SWALE
SEE DETAIL
SWALE FLOW SPREADER
SEE DETAIL
- SEDIMENTATION MANHOLE
C.O.P. STD. PLN. No. 4-11
- SPOT ELEVATIONS GIVEN AT BOTTOM OF SWALE

3
C16-237
1
C16-238
2
C16-238

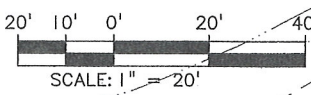

NOTE: THESE RECORD DRAWINGS REPRESENT THE BEST KNOWN INFORMATION ABOUT CONSTRUCTED FACILITIES. LOCATIONS SHOWN ARE NOT WARRANTED. UNDERGROUND UTILITIES MUST BE FIELD VERIFIED FOR ACTUAL LOCATION.

RECORD DRAWING

CJH DESIGNED	5-17-06 DATE
KRN DRAWN	5-17-06 DATE
CHECKED	DATE
APPROVED	DATE



TRI-COUNTY METROPOLITAN TRANSPORTATION DISTRICT OF OREGON

SOUTH CORRIDOR CONSTRUCTORS
Stacy and Wilbeck
GRANITE
WILDISH



DAVID EVANS AND ASSOCIATES INC.
2100 Southwest River Parkway
Portland Oregon 97201
Phone: 503.223.6663



TRI-MET

CAPITAL PROJECTS AND FACILITIES DIVISION
710 N.E. HOLLADAY STREET
PORTLAND, OREGON 97232

**SOUTH CORRIDOR PROJECT
I-205 SEGMENT**

**POWELL BOULEVARD PARK AND RIDE
DRAINAGE AND STORMWATER MANAGEMENT PLAN
SOUTH HALF**

NO.	DATE	BY	CHK.	APPD.	REVISIONS	SUBMITTED:	DATE:	APPROVED:	DATE:	SCALE:	DRAWING NO.:	CONTRACT NO.:	SHEET NO.:
							12/15/06		12/15/06	1" = 20'-0"	C16-511-AX	RH040161LE	288

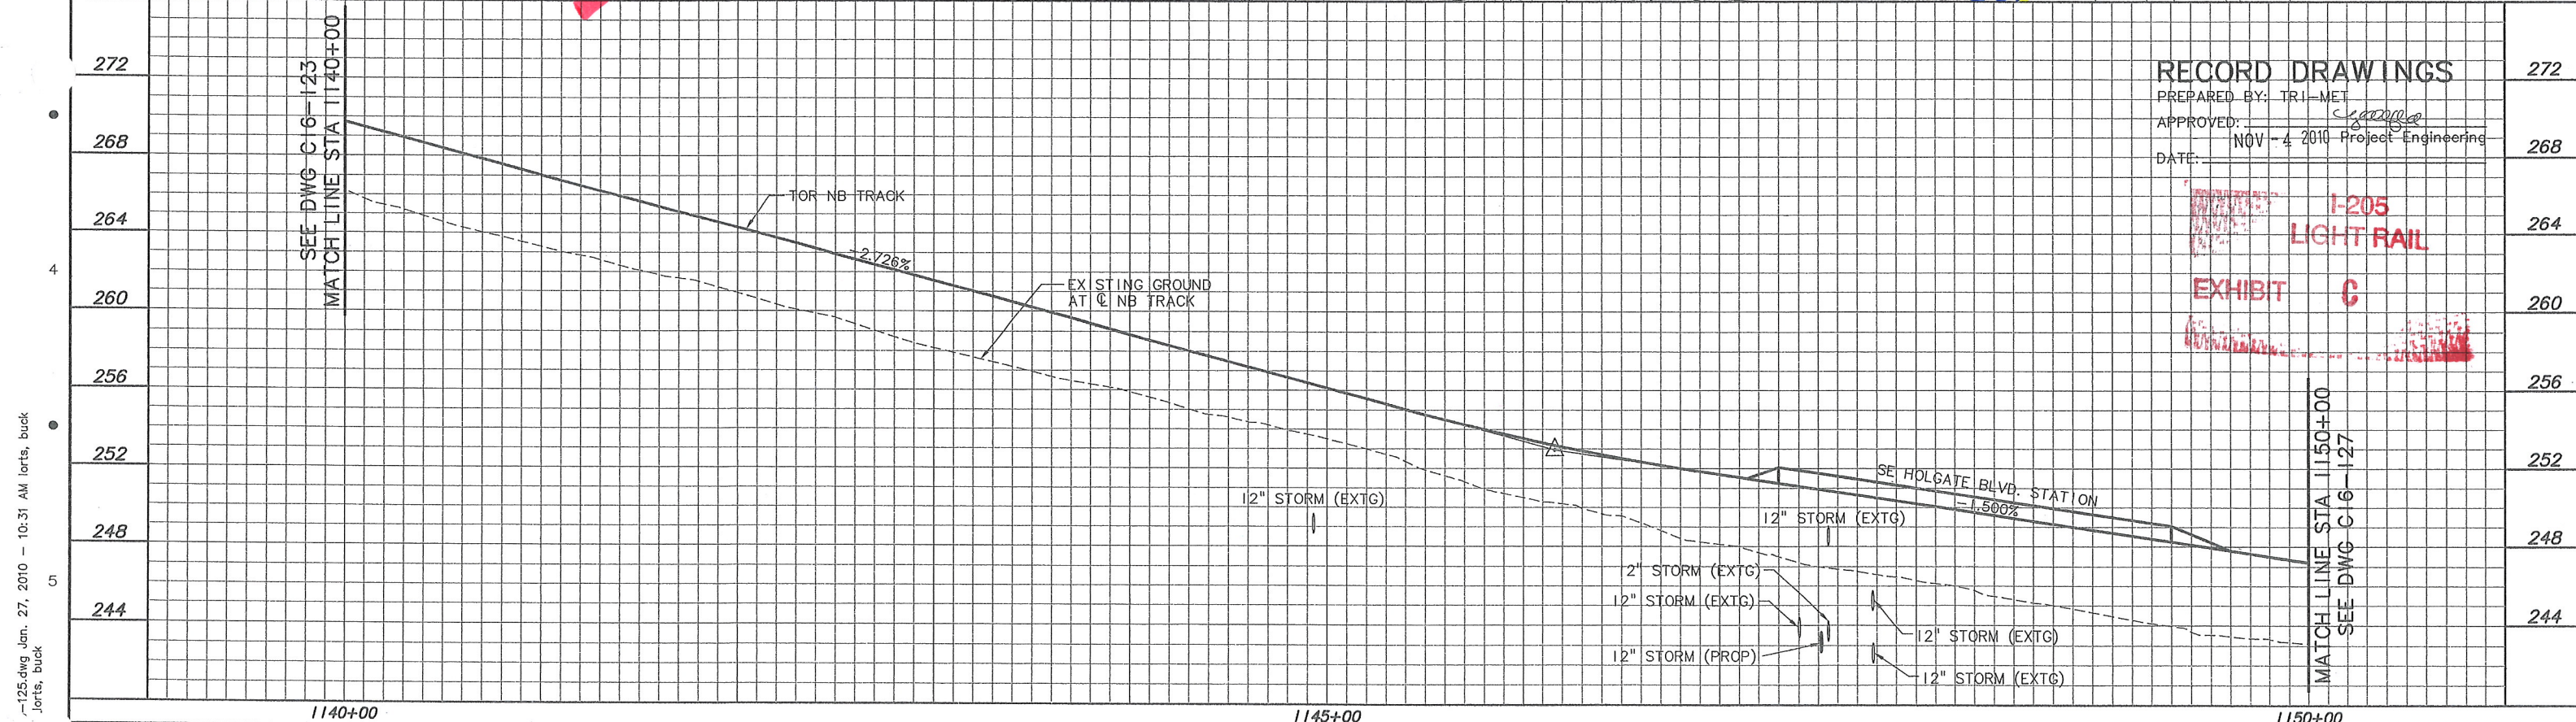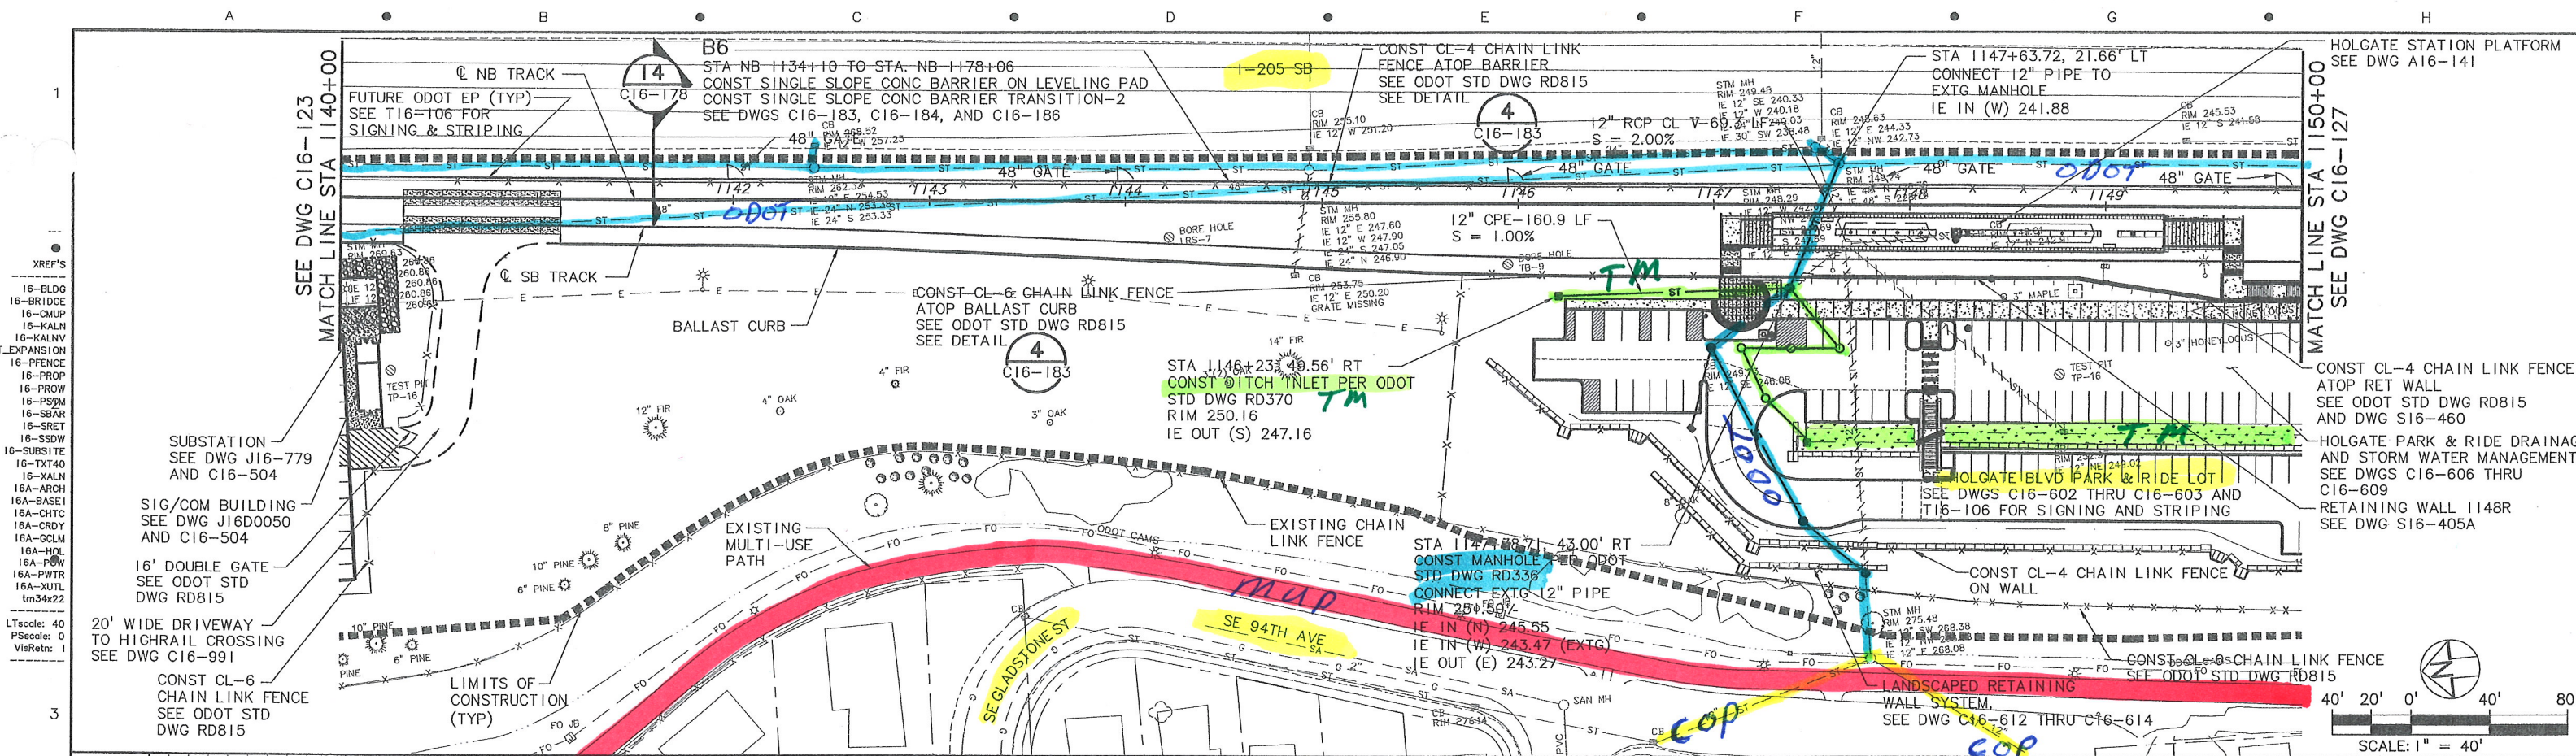

NOTE: THESE RECORD DRAWINGS REPRESENT THE BEST KNOWN INFORMATION ABOUT CONSTRUCTED FACILITIES. LOCATIONS SHOWN ARE NOT WARRANTED. UNDERGROUND UTILITIES MUST BE FIELD VERIFIED FOR ACTUAL LOCATION.

NO.	DATE	BY	APPD.	REVISIONS

DESIGNED	DATE
DRA/KRN	2-17-06

DRAWN	DATE
JTH	2-19-06

CHECKED	DATE

APPROVED	DATE

TRI-COUNTY METROPOLITAN TRANSPORTATION DISTRICT OF OREGON

SOUTH CORRIDOR CONSTRUCTORS
Stacy and Wilbeck
GRANITE
WILDISH



DAVID EVANS AND ASSOCIATES INC.
2100 Southwest River Parkway
Portland Oregon 97201
Phone: 503.223.6663

TRI-COUNTY MET
CAPITAL PROJECTS AND FACILITIES DIVISION
710 N.E. HOLLADAY STREET
PORTLAND, OREGON 97232

SUBMITTED: 12/15/06
DATE: 12/15/06
APPROVED: 12/15/06

SOUTH CORRIDOR PROJECT
I-205 SEGMENT
CIVIL PLAN & PROFILE
STA 1140+00 TO STA 1150+00

SCALE: 1" = 40'-0"
DRAWING NO.: C16-125-AX
CONTRACT NO.: RH04016 ILE
SHEET NO.: 125

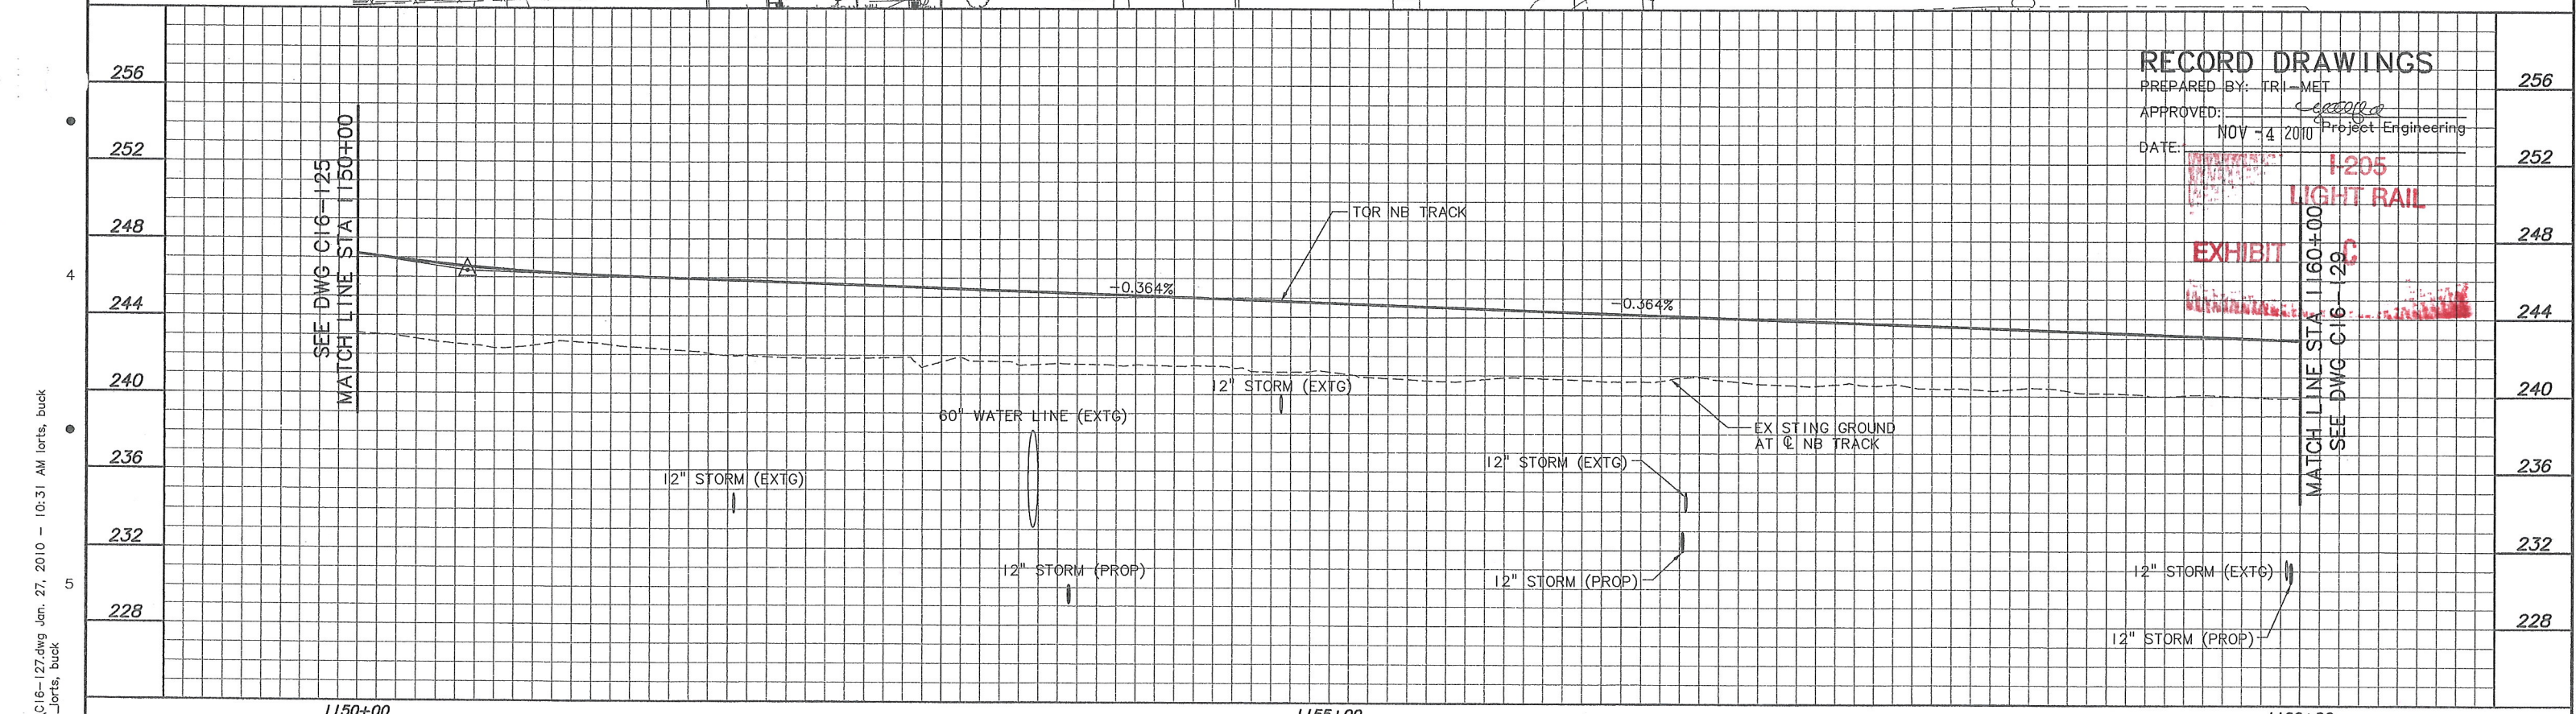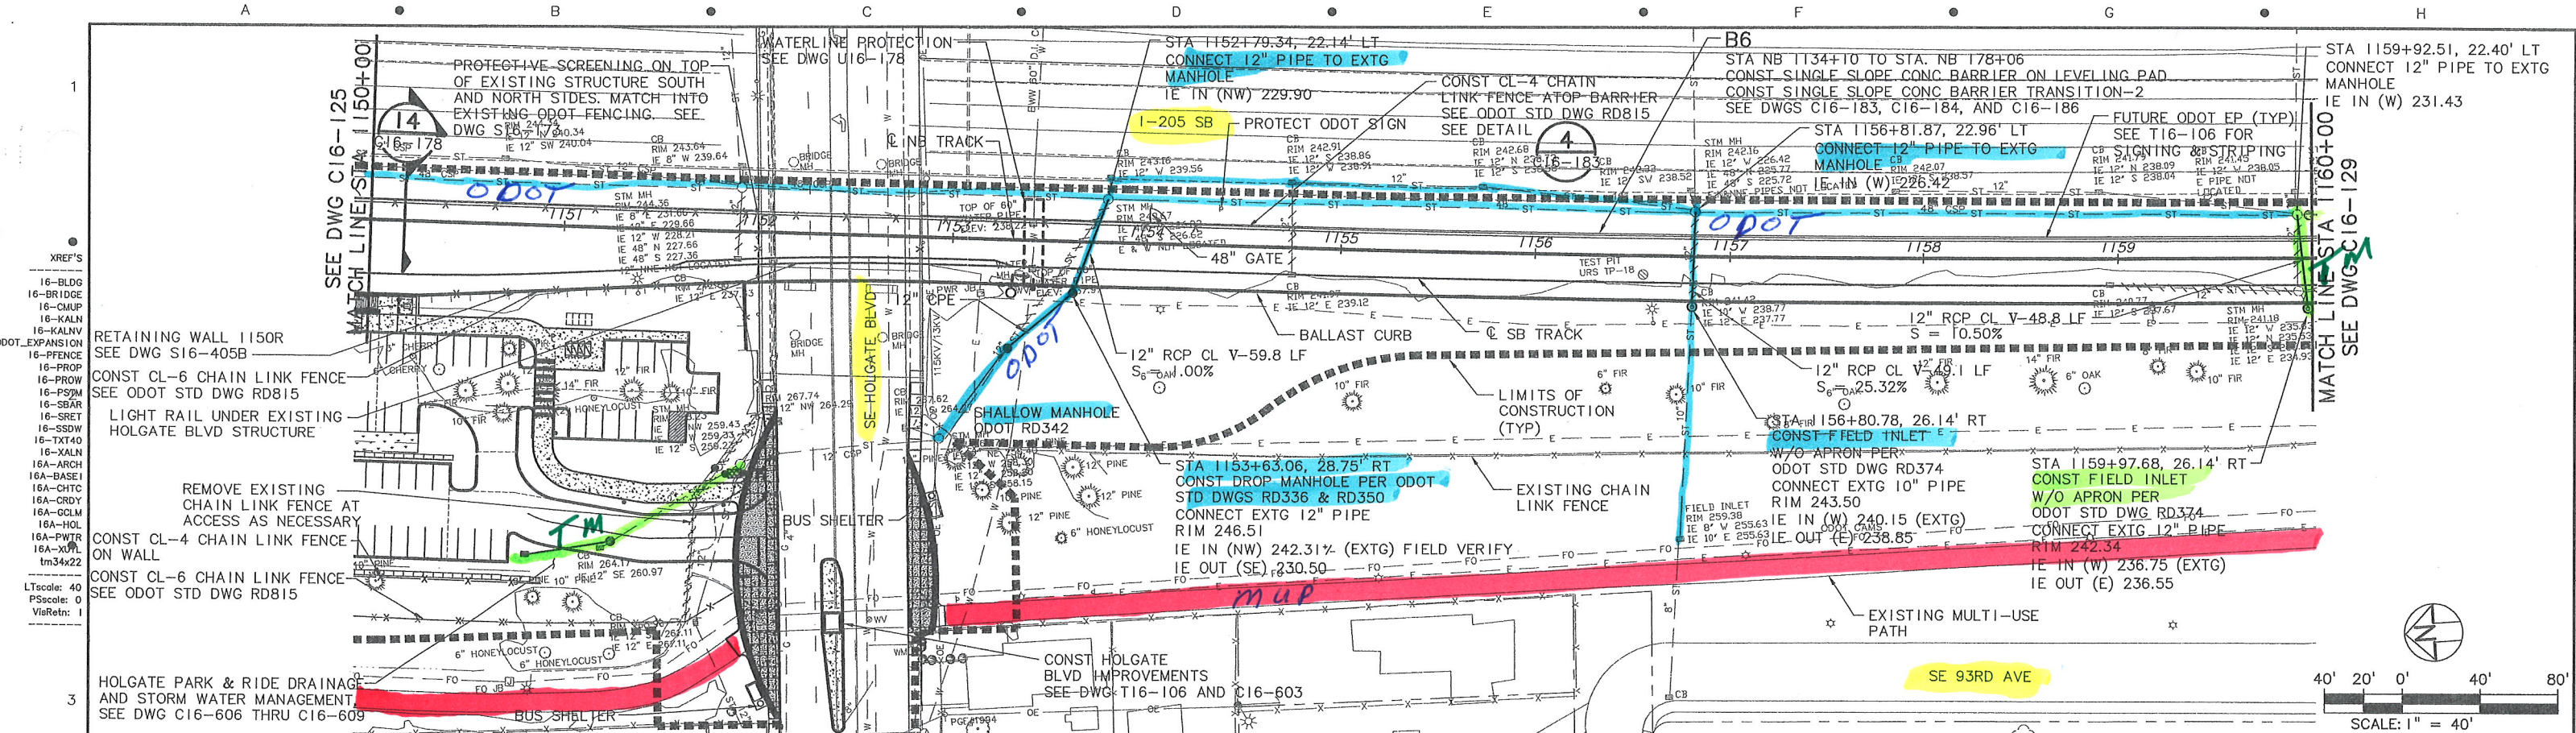

NOTE: THESE RECORD DRAWINGS REPRESENT THE BEST KNOWN INFORMATION ABOUT CONSTRUCTED FACILITIES. LOCATIONS SHOWN ARE NOT WARRANTED. UNDERGROUND UTILITIES MUST BE FIELD VERIFIED FOR ACTUAL LOCATION.

NO.	DATE	BY	APPD.	REVISIONS

Original Drawing Stamped and Sealed by MICHAEL J. HOBBACH

DRA/KRN DESIGNED	2-17-06 DATE
JTH DRAWN	2-19-06 DATE
CHECKED	DATE
APPROVED	DATE

TRI-COUNTY METROPOLITAN TRANSPORTATION DISTRICT OF OREGON

SOUTH CORRIDOR CONSTRUCTORS
Stacy and Wilbeck
GRANITE
WILDISH


DAVID EVANS AND ASSOCIATES INC.
2100 Southwest River Parkway
Portland Oregon 97201
Phone: 503.223.6663

TRI-COUNTY MET
CAPITAL PROJECTS
AND
FACILITIES DIVISION
710 N.E. HOLLADAY STREET
PORTLAND, OREGON 97232

SUBMITTED: 12/15/06 DATE: 12/15/06

SOUTH CORRIDOR PROJECT
I-205 SEGMENT
CIVIL PLAN & PROFILE
STA 1150+00 TO STA 1160+00



SCALE: 1" = 40'-0"	DRAWING NO.: C16-127-AX	CONTRACT NO.: RH040161LE	SHEET NO.: 126
--------------------	-------------------------	--------------------------	----------------

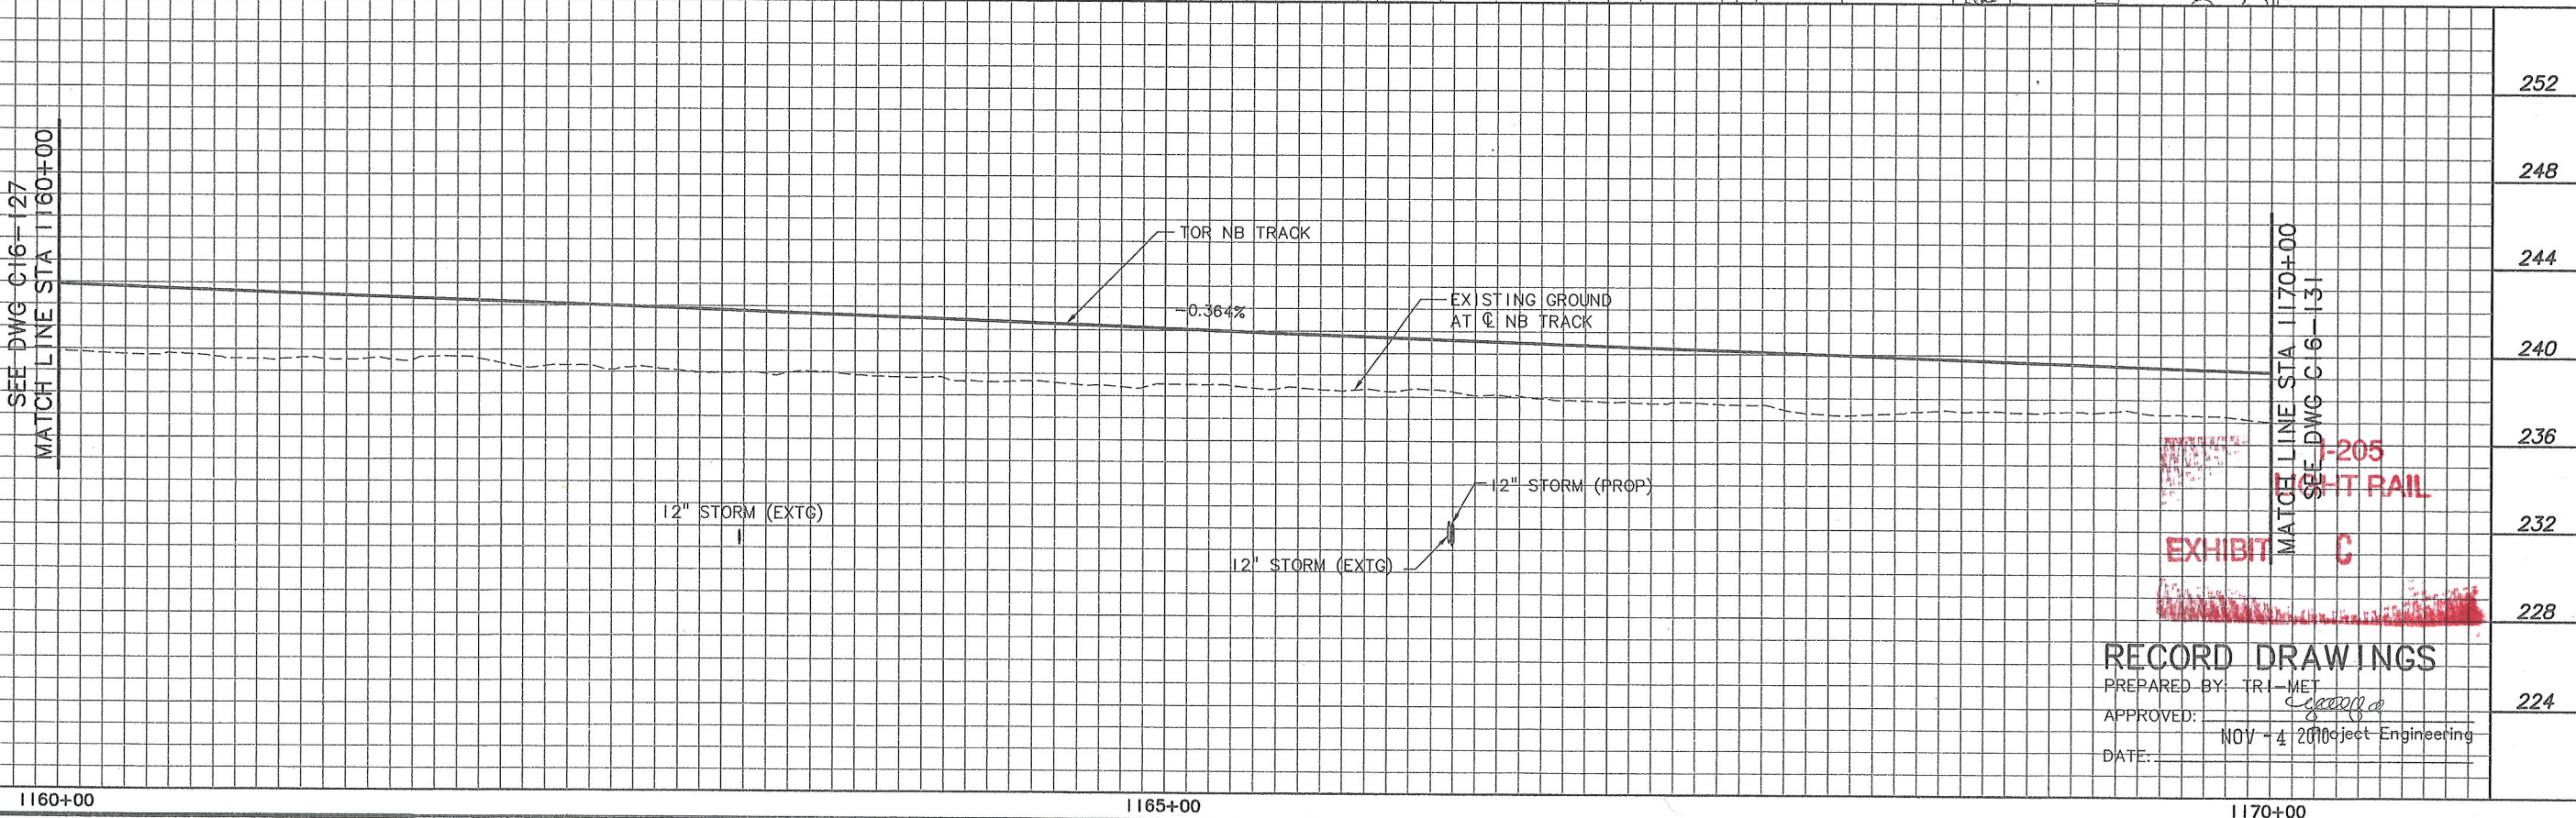

NO.	DATE	BY CHK	APPD.	REVISIONS

SHEET NO.: 127

R:\1-205 AS-BUILTS\ -\C16-129.dwg Jan. 27, 2010 - 10:33 AM lorts, buck
Plot Date: 3/16/2010 7:4_lorts, buck

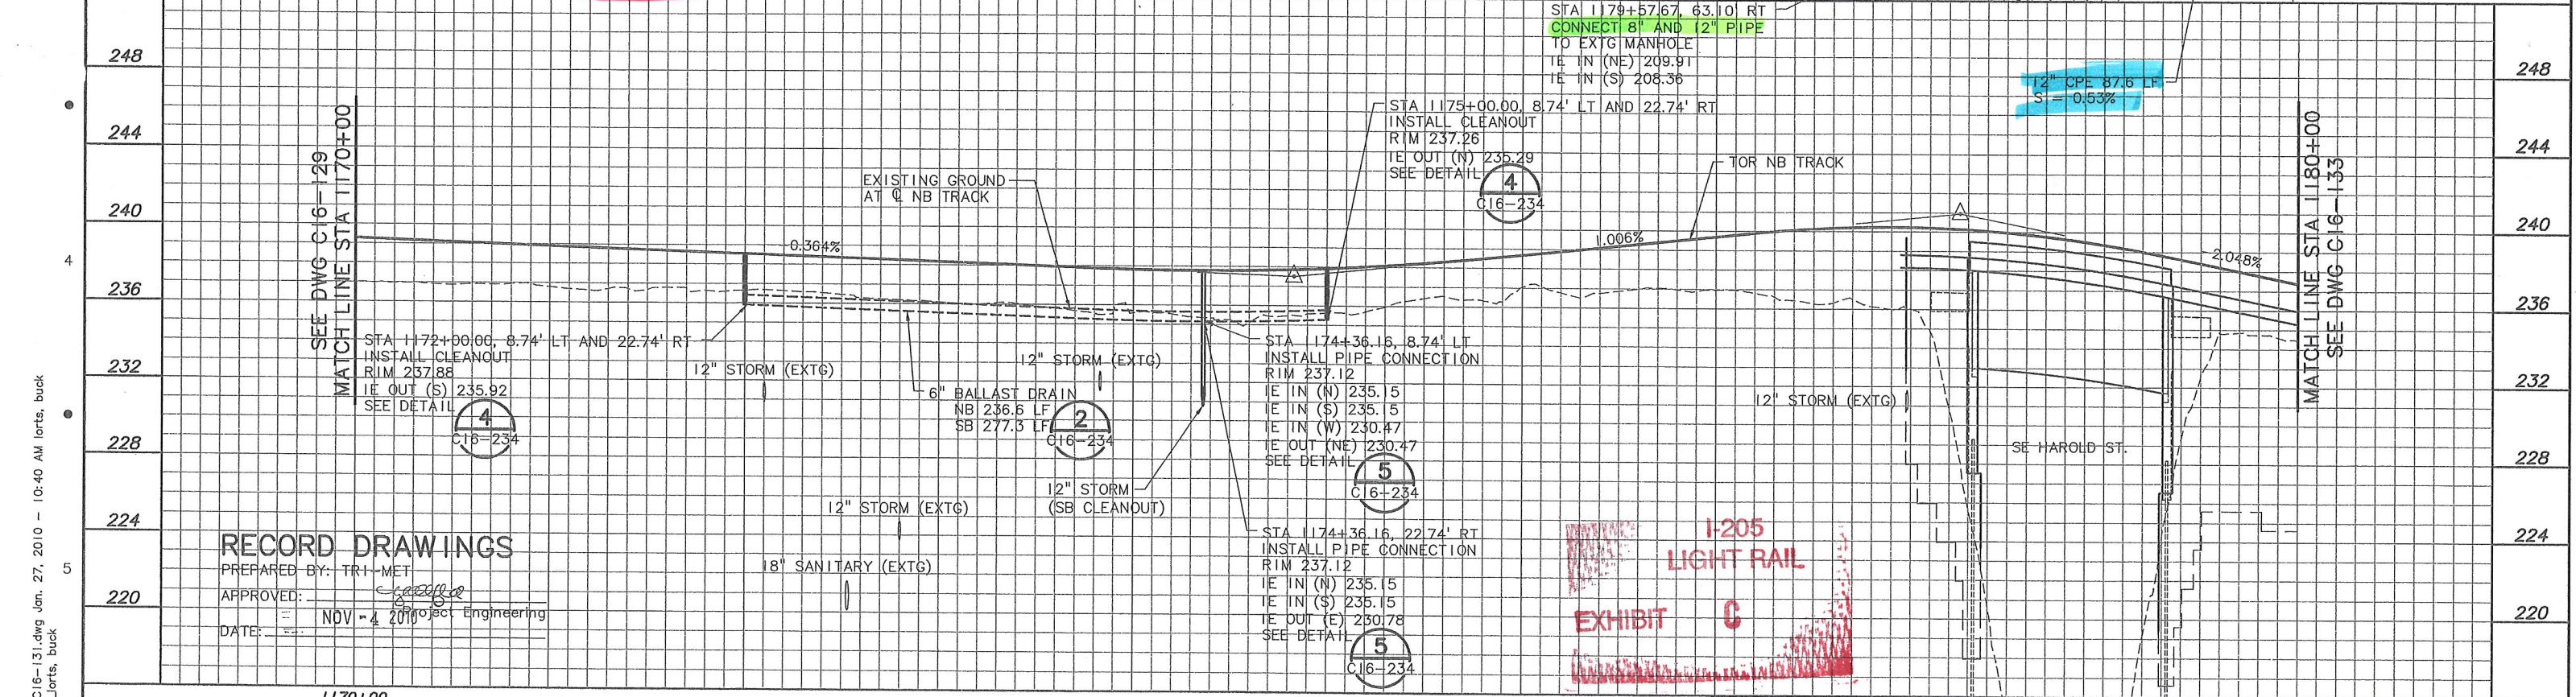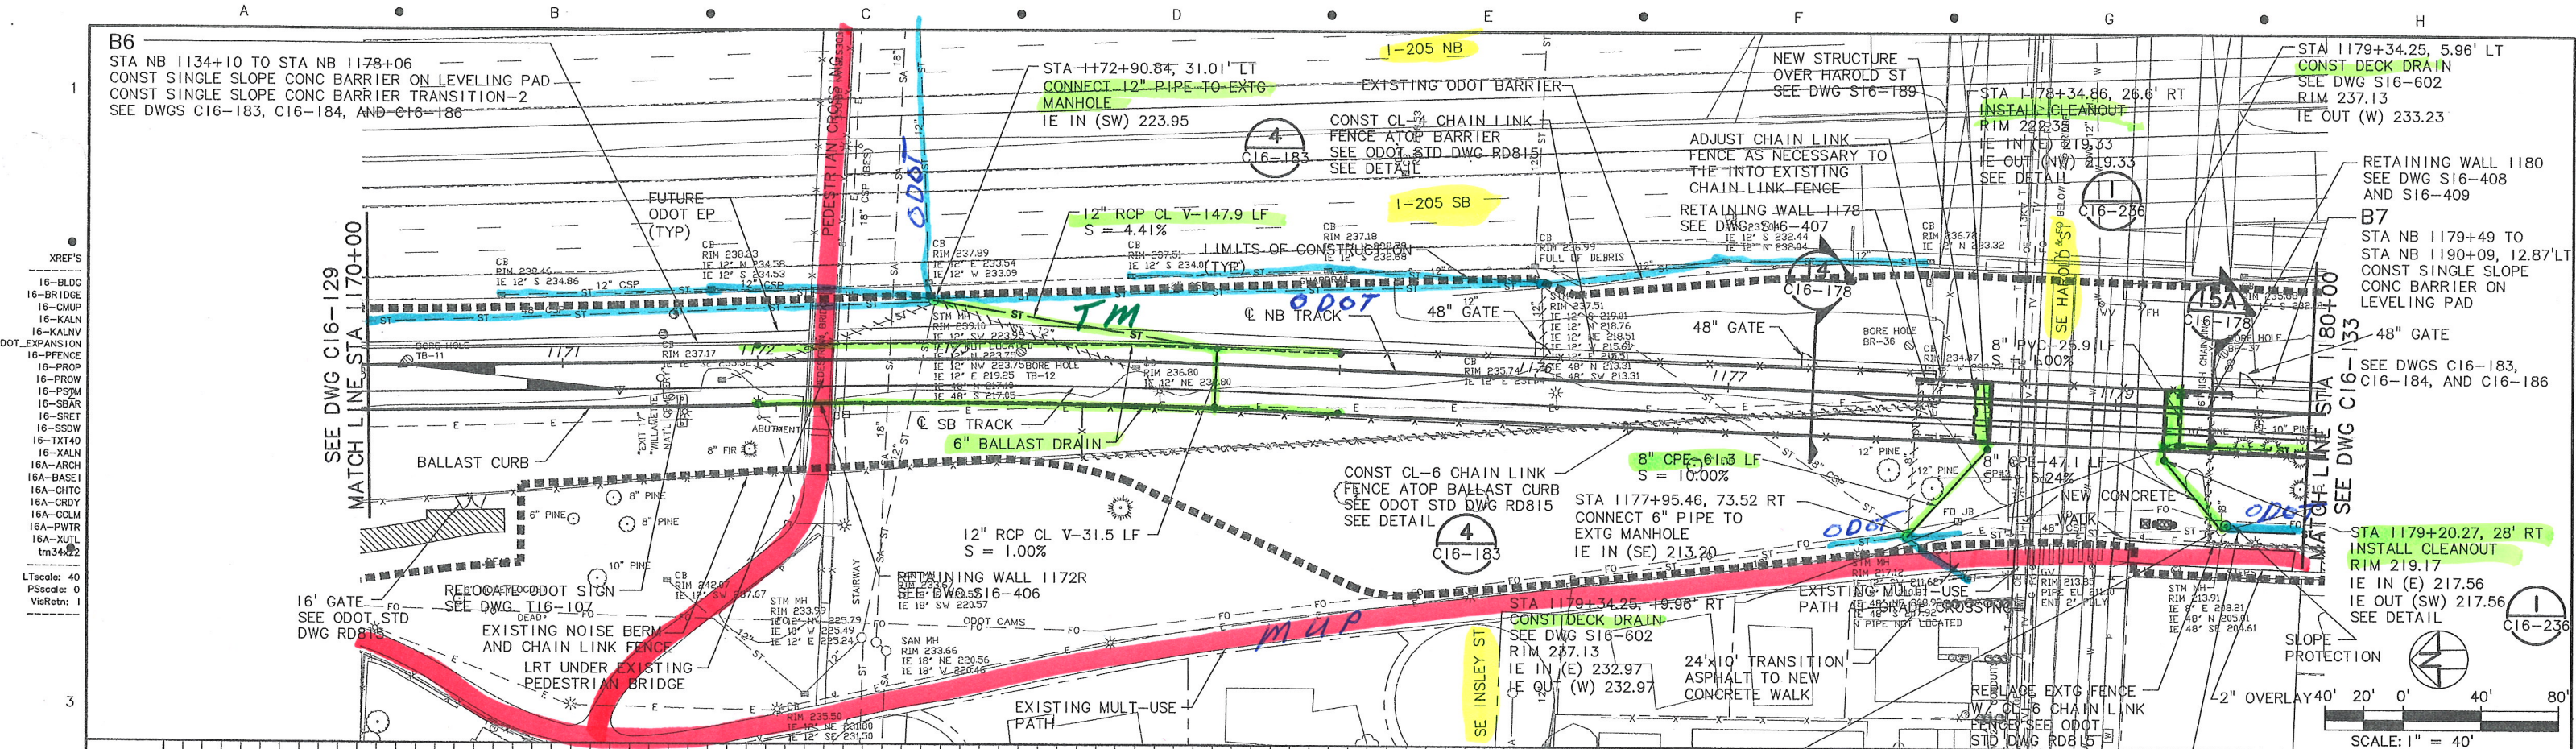

NOTE: THESE RECORD DRAWINGS REPRESENT THE BEST KNOWN INFORMATION ABOUT CONSTRUCTED FACILITIES. LOCATIONS SHOWN ARE NOT WARRANTED. UNDERGROUND UTILITIES MUST BE FIELD VERIFIED FOR ACTUAL LOCATION.

RECORD DRAWING

TRI-COUNTY METROPOLITAN TRANSPORTATION DISTRICT OF OREGON

SOUTH CORRIDOR CONSTRUCTORS
 Stacy and Wilbeck
 GRANITE WILDISH

DAVID EVANS AND ASSOCIATES INC.
 2100 Southwest River Parkway
 Portland Oregon 97201
 Phone: 503.223.6663

TRIOMET
 CAPITAL PROJECTS AND FACILITIES DIVISION
 710 N.E. HOLLADAY STREET
 PORTLAND, OREGON 97232

SOUTH CORRIDOR PROJECT
 I-205 SEGMENT
 CIVIL PLAN & PROFILE
 STA 1170+00 TO STA 1180+00


APPROVED: 12/15/06

SCALE: 1" = 40'-0"

DRAWING NO.: C16-131-AX

CONTRACT NO.: RH040161LE

SHEET NO.: 128

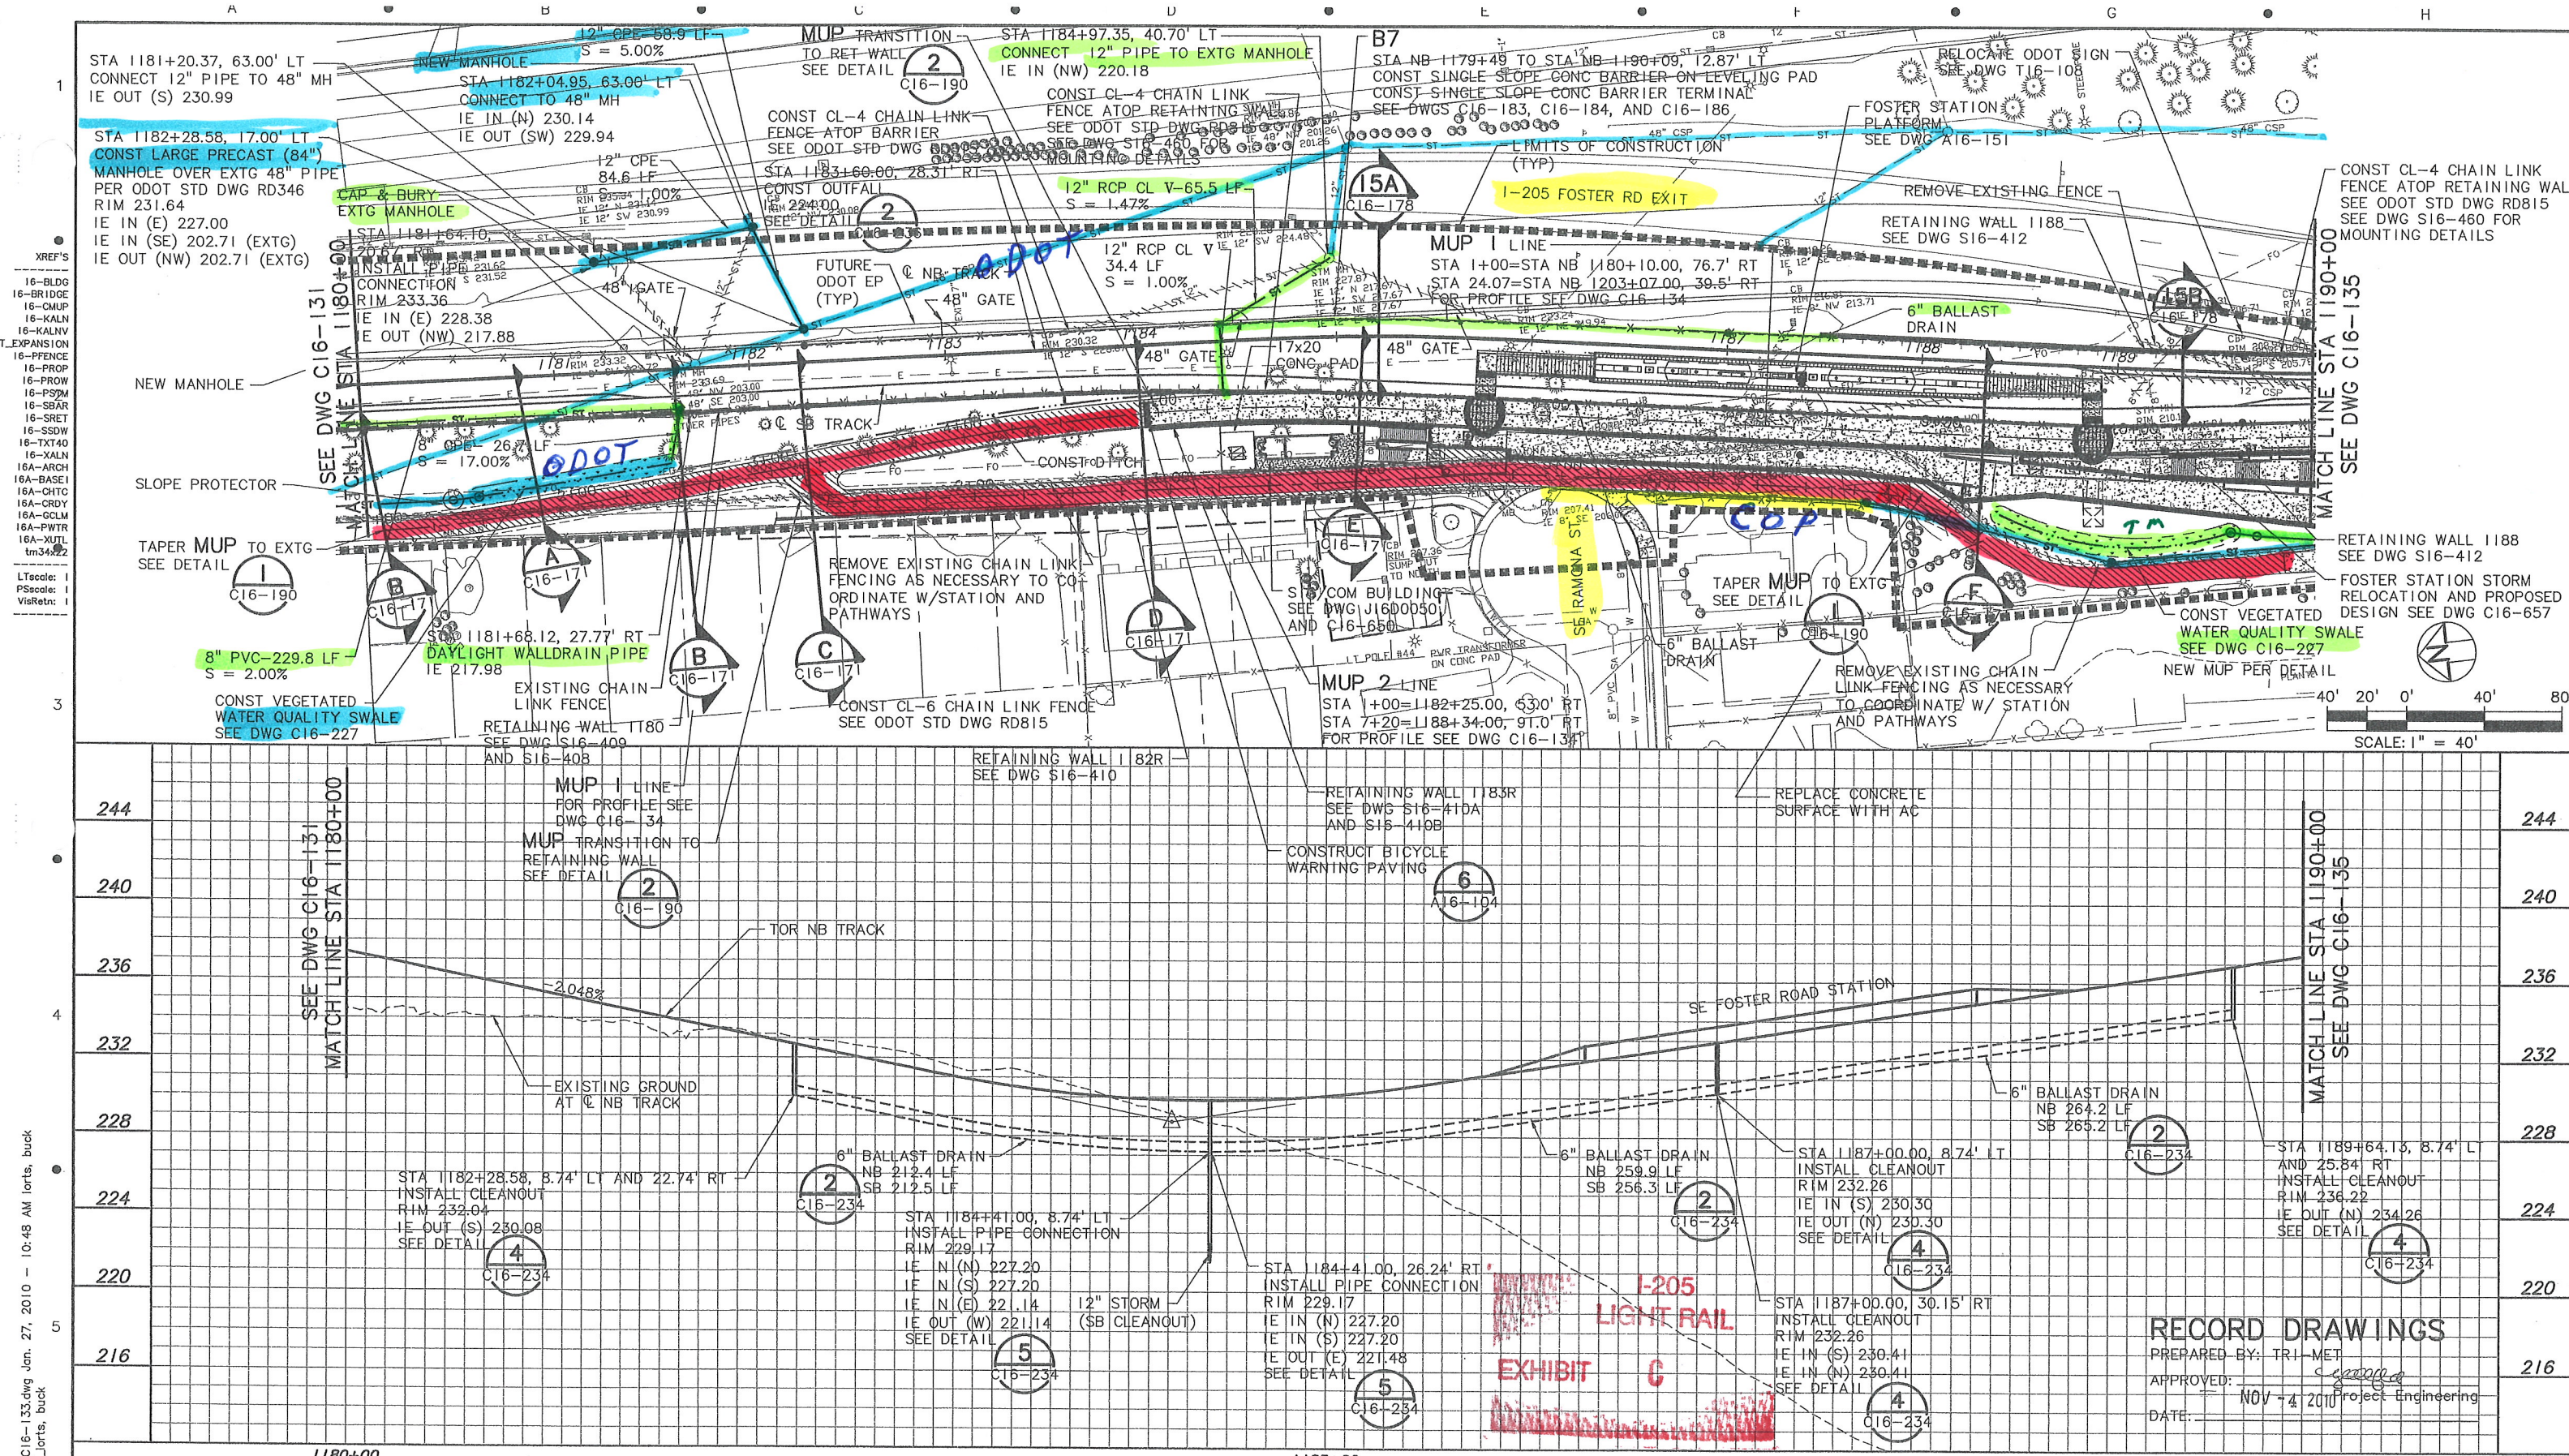

R:\I-205 AS-BUILT\I-205-133.dwg Jan. 27, 2010 - 10:48 AM lorts, buck
Plot Date: 3/16/2010
M_lorts, buck

NOTE:
THESE RECORD DRAWINGS REPRESENT THE BEST KNOWN INFORMATION ABOUT CONSTRUCTED FACILITIES. LOCATIONS SHOWN ARE NOT WARRANTED. UNDERGROUND UTILITIES MUST BE FIELD VERIFIED FOR ACTUAL LOCATION.

RECORD DRAWING

DRA/KRN
DESIGNED
2-15-06
DATE

JTH
DRAWN
2-17-06
DATE

CHECKED
DATE

APPROVED
DATE

TRI-COUNTY METROPOLITAN TRANSPORTATION DISTRICT OF OREGON
SOUTH CORRIDOR CONSTRUCTORS
Stacy and Wilbeck
GRANITE
WILDISH

DAVID EVANS AND ASSOCIATES INC.
2100 Southwest River Parkway
Portland Oregon 97201
Phone: 503.223.6663

TRIOMET
CAPITAL PROJECTS AND FACILITIES DIVISION
710 N.E. HOLLADAY STREET
PORTLAND, OREGON 97232

SUBMITTED: 12/15/06

DATE: 12/15/06

APPROVED: 12/15/06

DATE: 12/15/06

SOUTH CORRIDOR PROJECT
I-205 SEGMENT
CIVIL PLAN & PROFILE
STA 1180+00 TO STA 1190+00

SCALE: 1" = 40'-0"

DRAWING NO.: C16-133-BX

CONTRACT NO.: RH040161LE

SHEET NO.: 129