


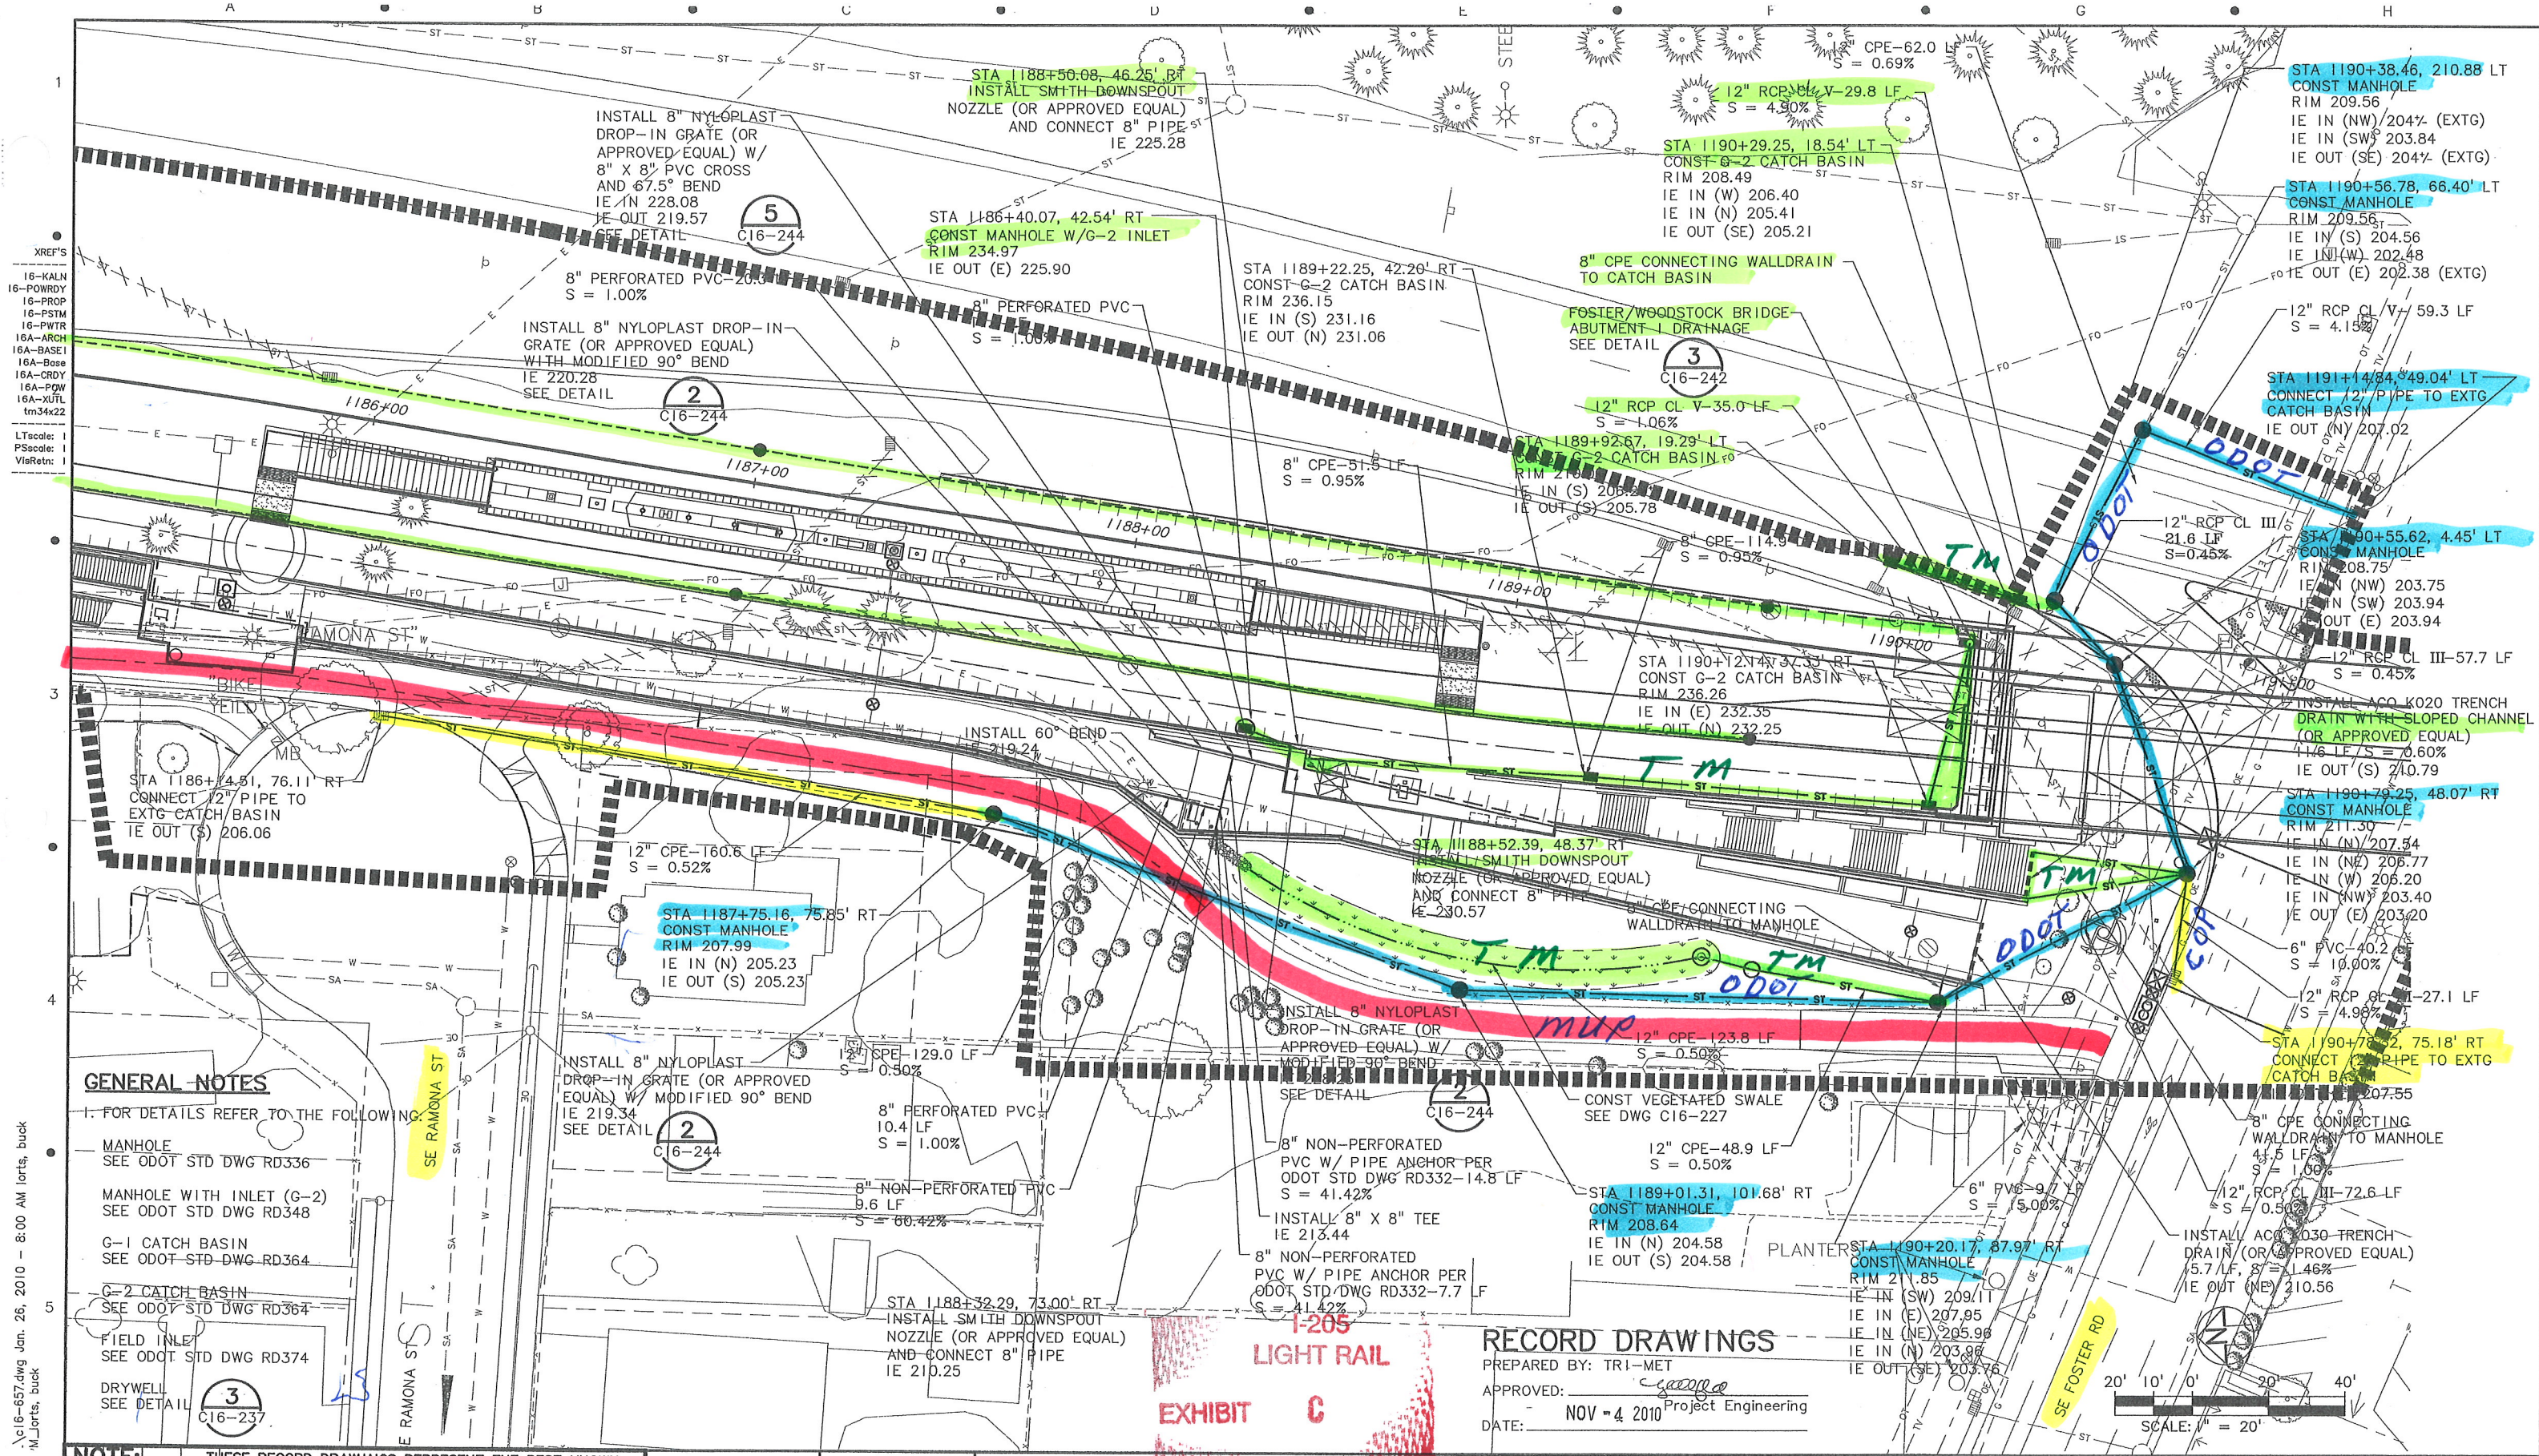

GENERAL NOTES

1. FOR DETAILS REFER TO THE FOLLOWING:

- MANHOLE
SEE ODOT STD DWG RD336
- MANHOLE WITH INLET (G-2)
SEE ODOT STD DWG RD348
- G-1 CATCH BASIN
SEE ODOT STD DWG RD364
- G-2 CATCH BASIN
SEE ODOT STD DWG RD364
- FIELD INLET
SEE ODOT STD DWG RD374
- DRYWELL
SEE DETAIL

NOTE: THESE RECORD DRAWINGS REPRESENT THE BEST KNOWN INFORMATION ABOUT CONSTRUCTED FACILITIES. LOCATIONS SHOWN ARE NOT WARRANTED. UNDERGROUND UTILITIES MUST BE FIELD VERIFIED FOR ACTUAL LOCATION.

RECORD DRAWING

CJH	7-17-06
DESIGNED	DATE
KRN	7-17-06
DRAWN	DATE
CHECKED	DATE
APPROVED	DATE



TRI-COUNTY METROPOLITAN TRANSPORTATION DISTRICT OF OREGON

SOUTH CORRIDOR CONSTRUCTORS
Stacy and Witbeck
GRANITE
WILDISH



DAVID EVANS AND ASSOCIATES INC.
2100 Southwest River Parkway
Portland Oregon 97201
Phone: 503.223.6663




CAPITAL PROJECTS AND FACILITIES DIVISION
710 N.E. HOLLADAY STREET
PORTLAND, OREGON 97232

**SOUTH CORRIDOR PROJECT
I-205 SEGMENT**



**FOSTER STATION
DRAINAGE AND STORMWATER MANAGEMENT PLAN**

RECORD DRAWINGS

PREPARED BY: TRI-MET
APPROVED: *[Signature]*
DATE: NOV 4 2010
Project Engineering

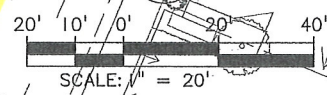

R:\I-205 AS-BUILT\Plot Date: 4/29/2010
Plot Date: 4/29/2010
M:\Jorts, buck

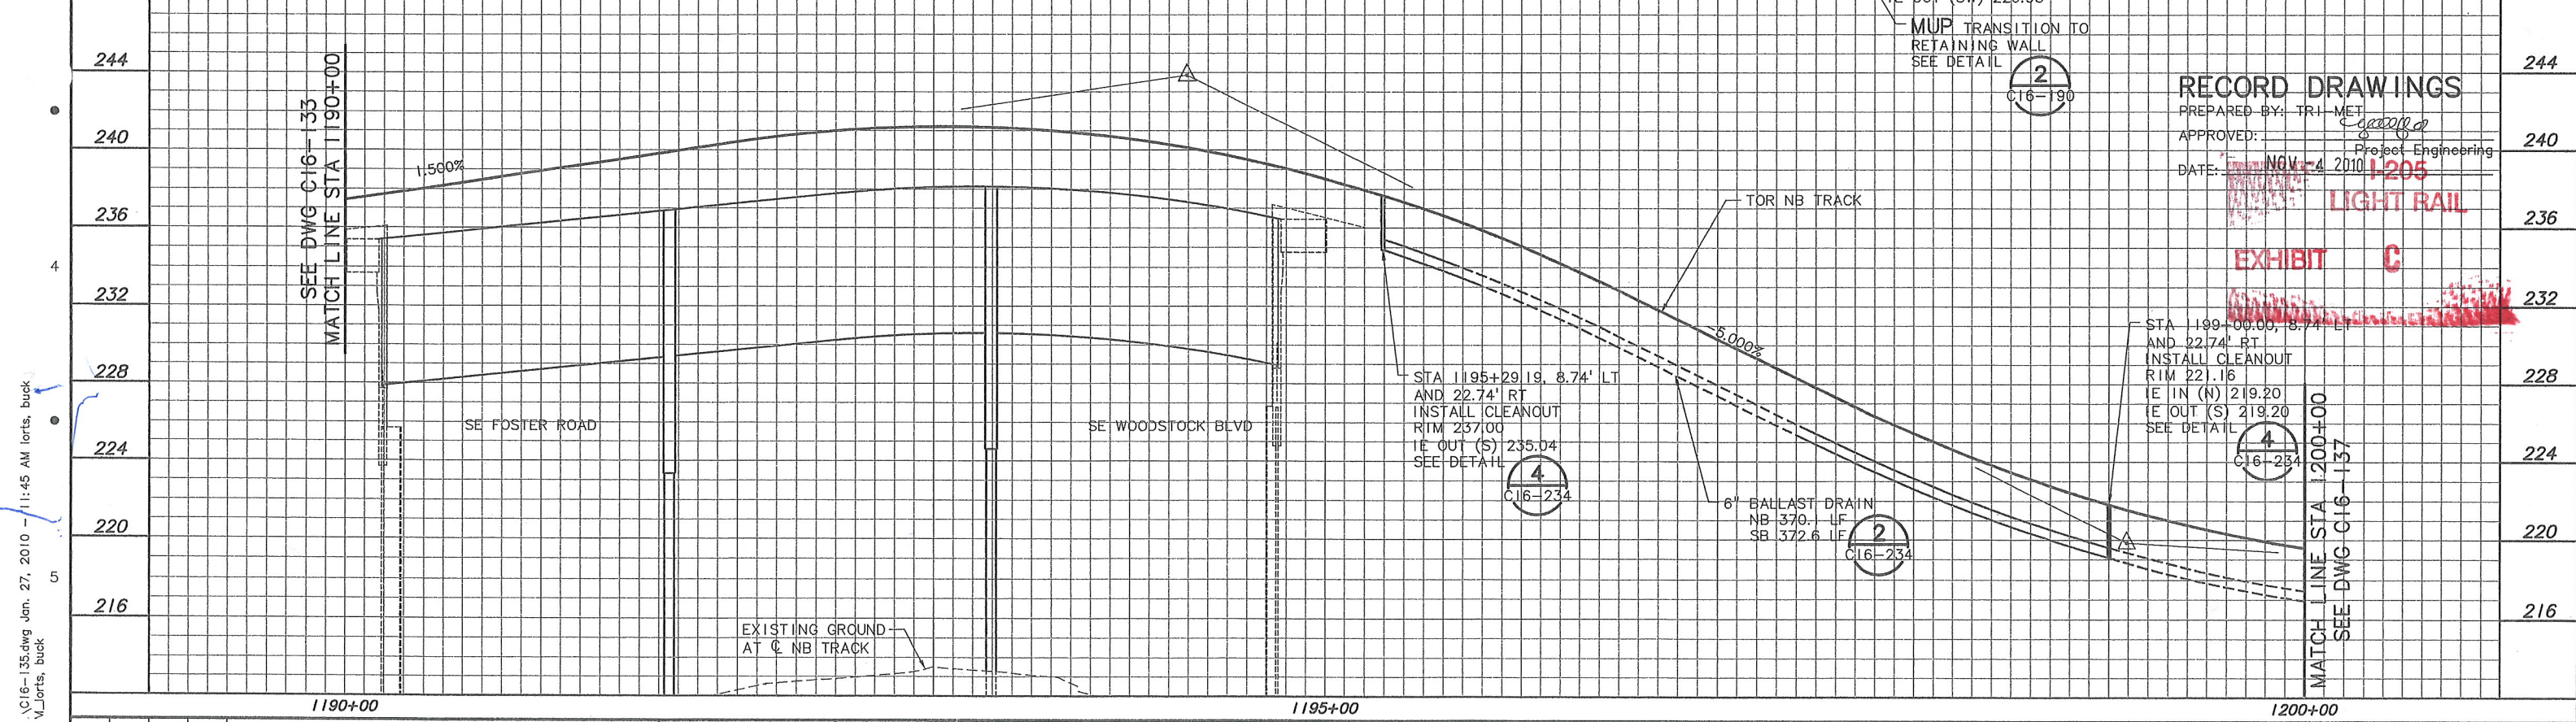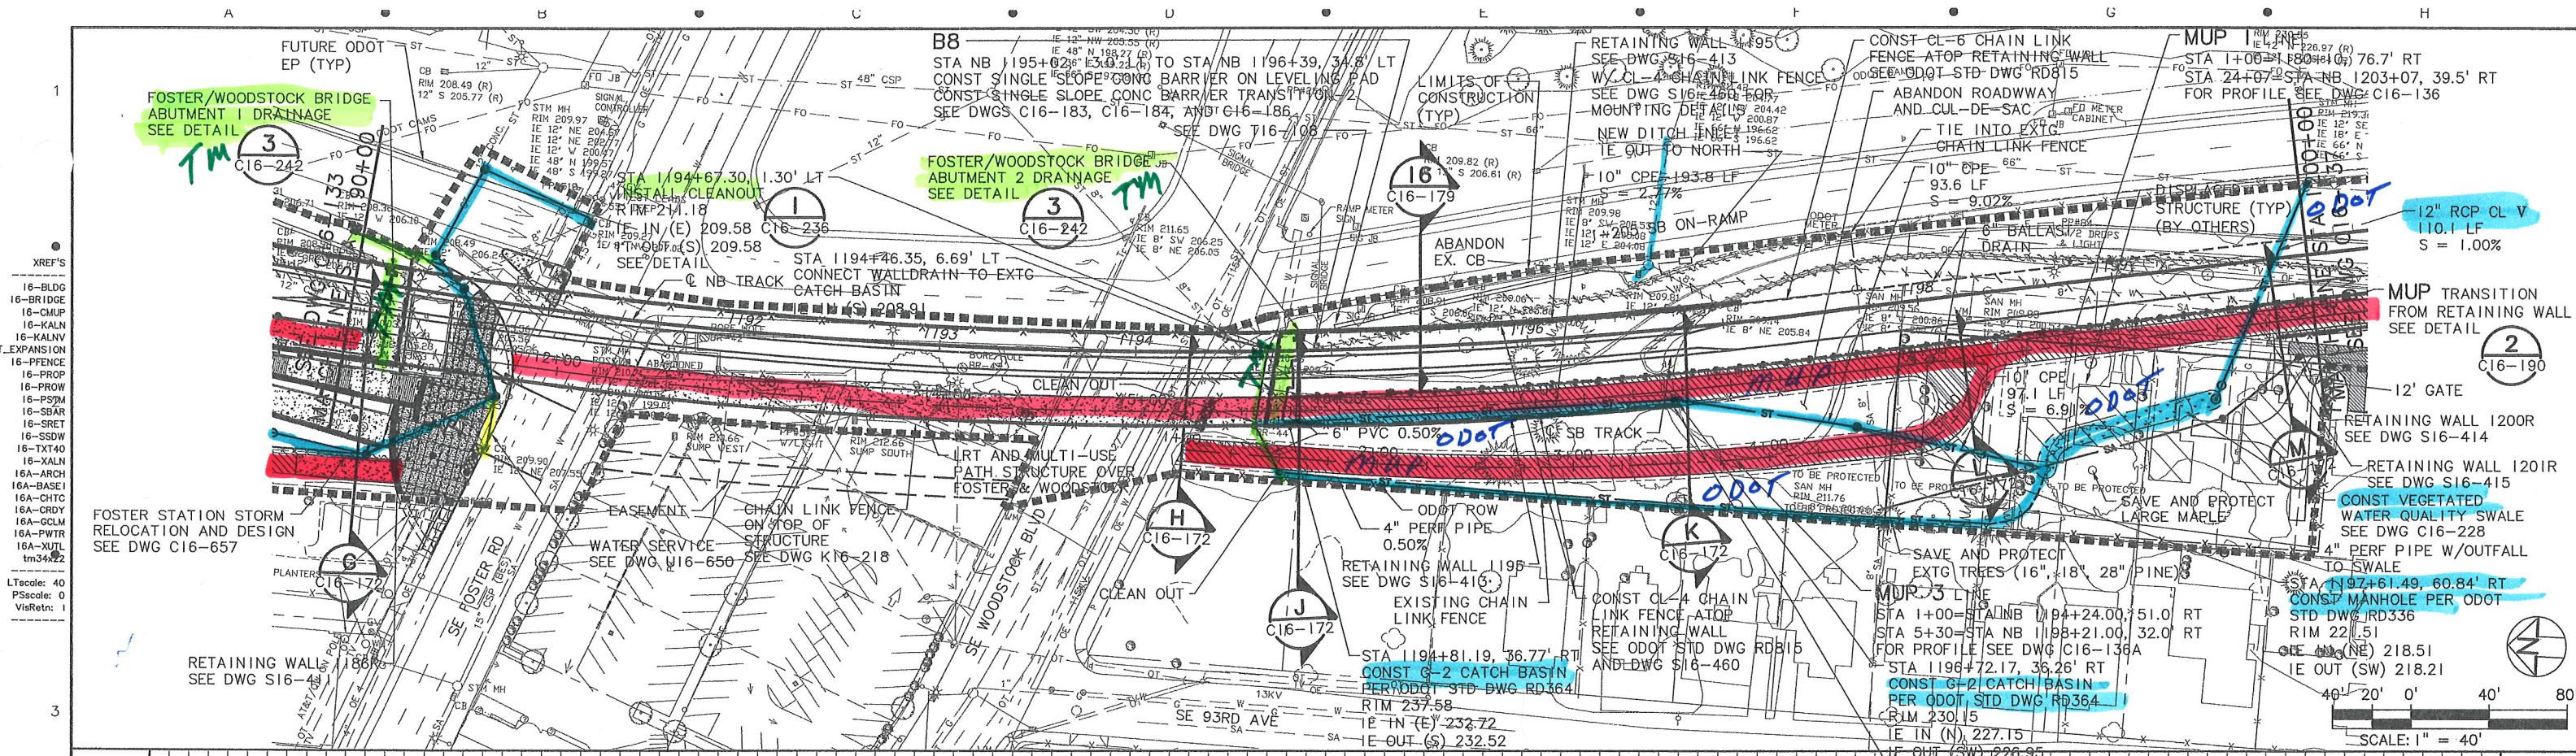

NOTE: THESE RECORD DRAWINGS REPRESENT THE BEST KNOWN INFORMATION ABOUT CONSTRUCTED FACILITIES. LOCATIONS SHOWN ARE NOT WARRANTED. UNDERGROUND UTILITIES MUST BE FIELD-VERIFIED FOR ACTUAL LOCATION.

NO.	DATE	BY	APPD.	REVISIONS

Original Drawing Stamped and Sealed by MICHAEL J. HOBBACH

DRA/KRN	2-17-06
DESIGNED	DATE
JTH	2-19-06
DRAWN	DATE
CHECKED	DATE
APPROVED	DATE

TRI-COUNTY METROPOLITAN TRANSPORTATION DISTRICT OF OREGON

SOUTH CORRIDOR CONSTRUCTORS
Stacy and Witbeck
GRANITE
WILDISH

DAVID EVANS AND ASSOCIATES INC.
2100 Southwest River Parkway
Portland Oregon 97201
Phone: 503.223.6663



TRI-MET

CAPITAL PROJECTS AND FACILITIES DIVISION
710 N.E. HOLLADAY STREET
PORTLAND, OREGON 97232

SUBMITTED: DATE: 12/15/06 APPROVED: DATE: 12/15/06

SOUTH CORRIDOR PROJECT
I-205 SEGMENT
CIVIL PLAN & PROFILE
STA 1190+00 TO STA 1200+00

SCALE: 1" = 40'-0"
DRAWING NO.: C16-135-BX
CONTRACT NO.: RH040161LE
SHEET NO.: 131

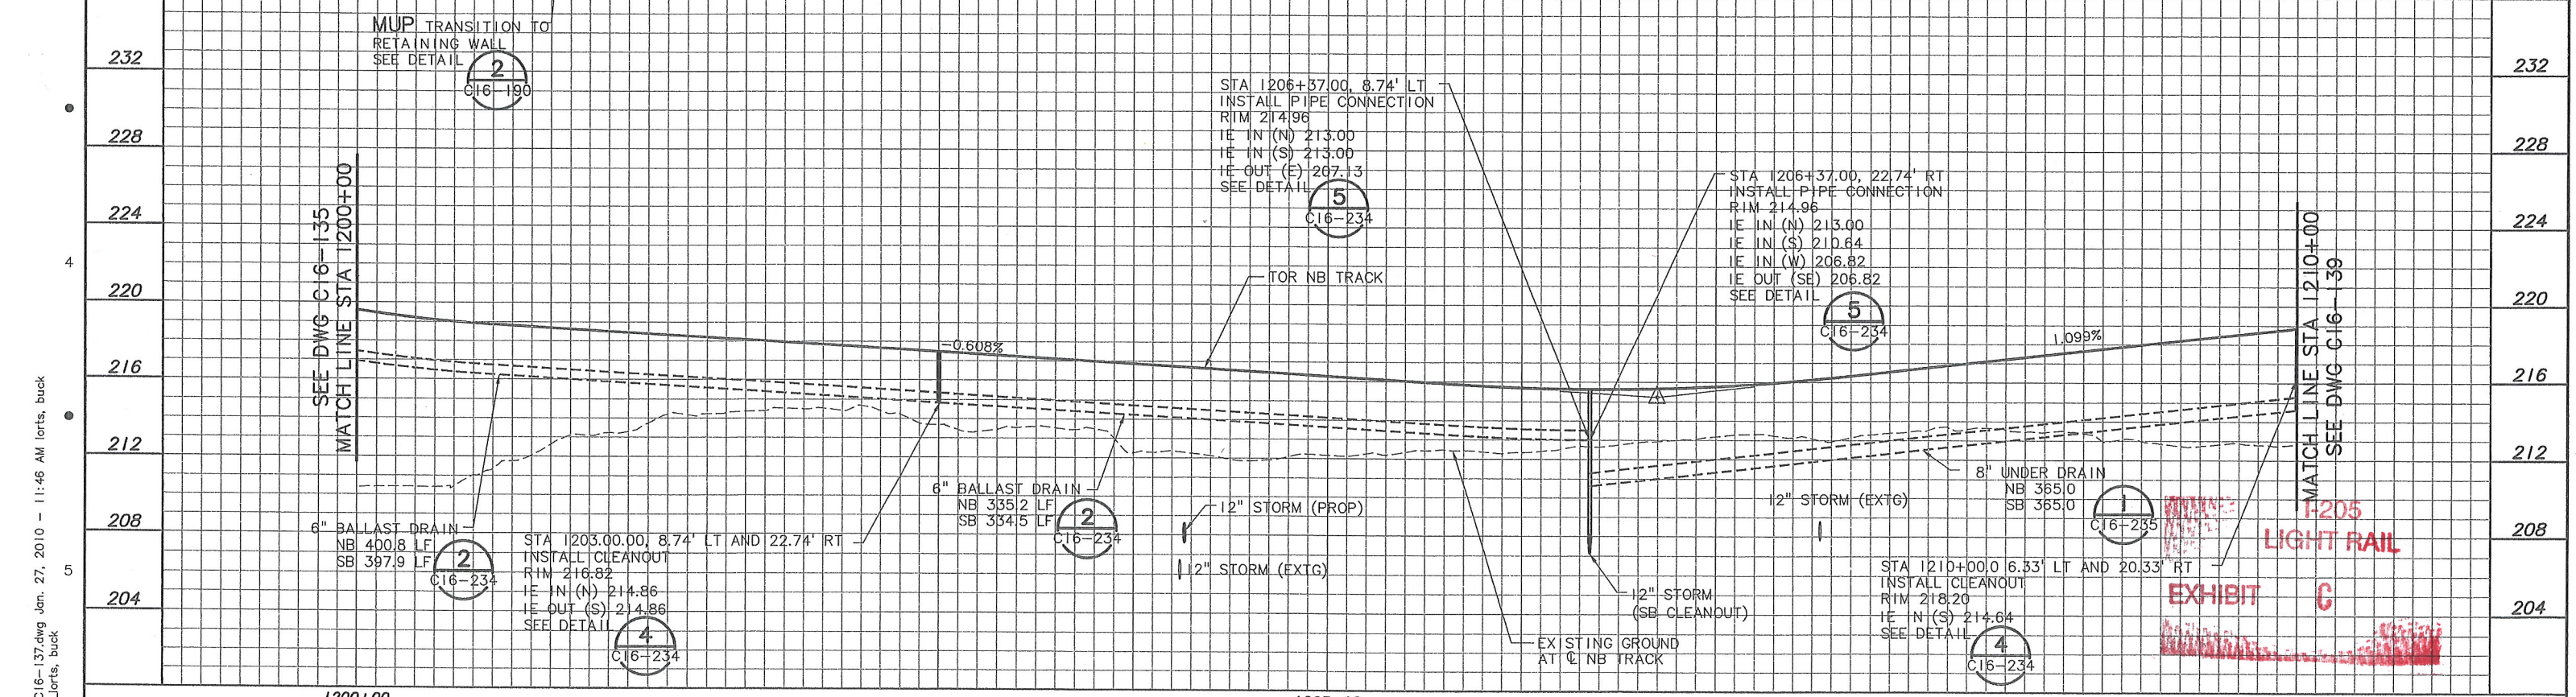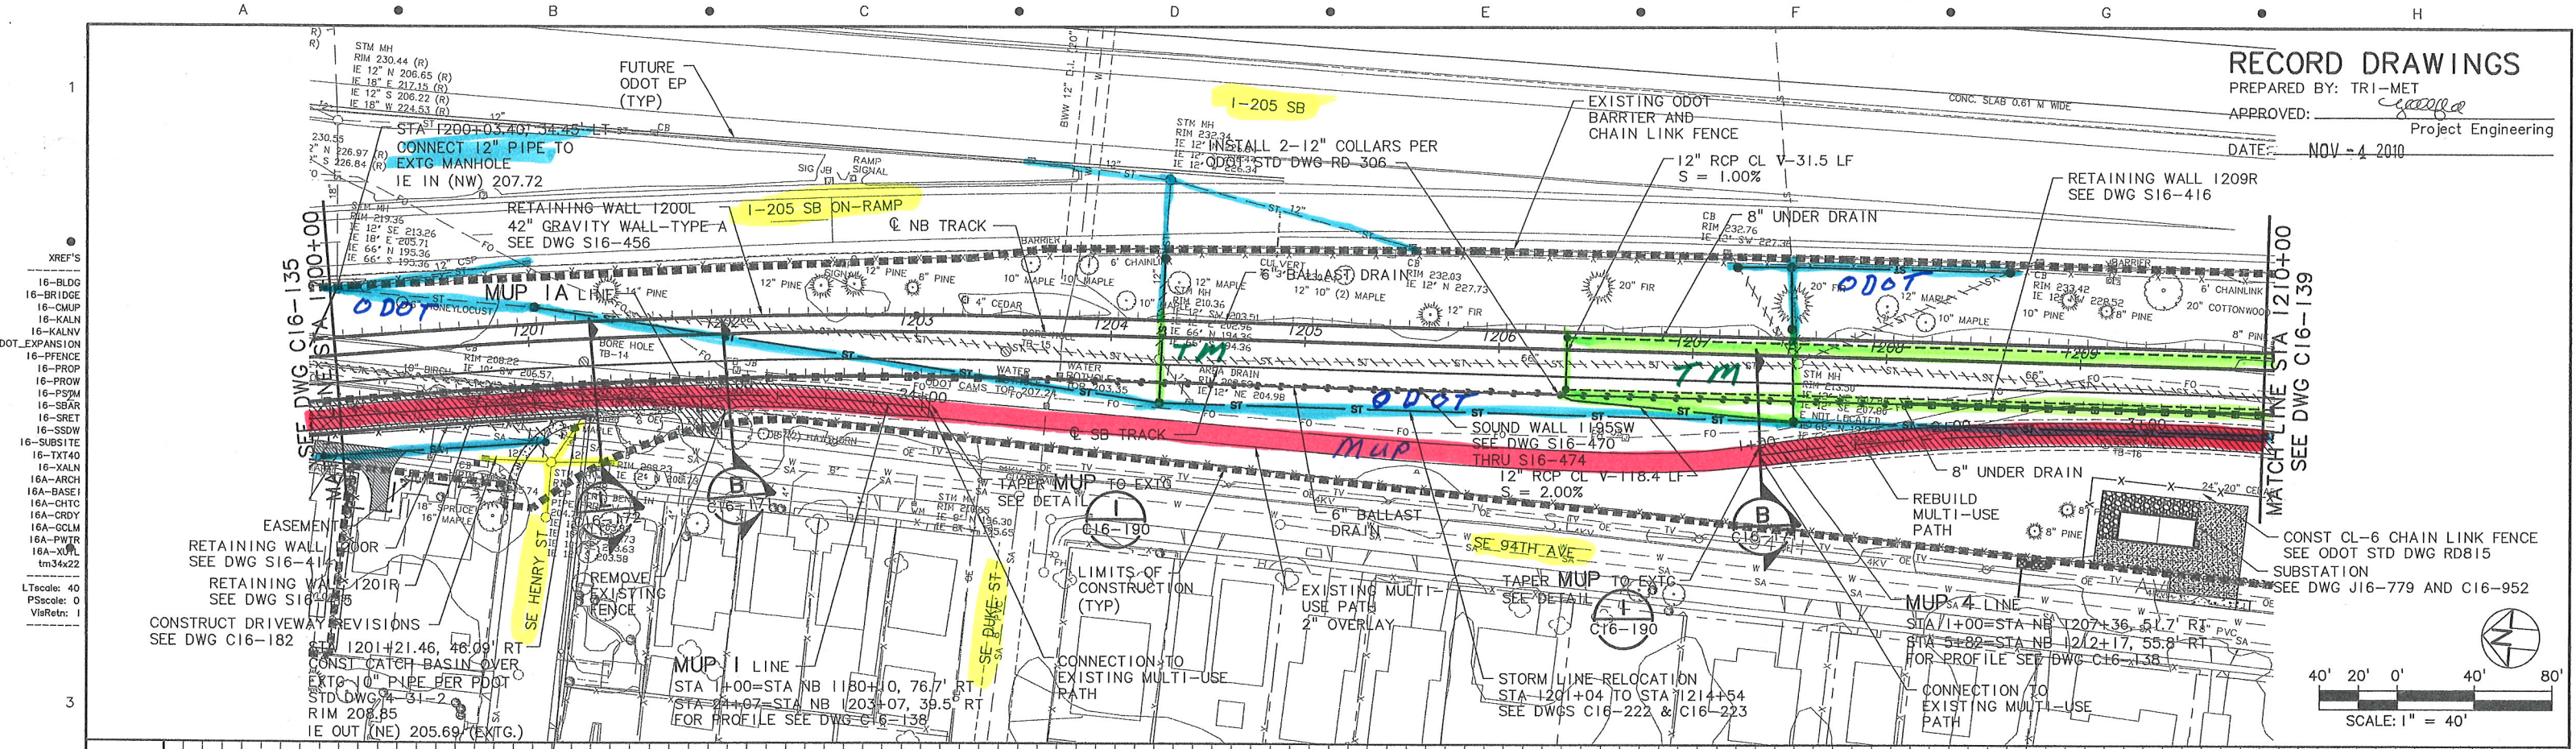

NOTE: THESE RECORD DRAWINGS REPRESENT THE BEST KNOWN INFORMATION ABOUT CONSTRUCTED FACILITIES. LOCATIONS SHOWN ARE NOT WARRANTED. UNDERGROUND UTILITIES MUST BE FIELD VERIFIED FOR ACTUAL LOCATION.

NO.	DATE	BY	APPD.	REVISIONS

DRA/KRN DESIGNED	2-17-06 DATE
JTH DRAWN	2-19-06 DATE
CHECKED	DATE
APPROVED	DATE

TRI-COUNTY METROPOLITAN TRANSPORTATION DISTRICT OF OREGON

SOUTH CORRIDOR CONSTRUCTORS
Stacy and Wilbeck
GRANITE
WILDISH

DAVID EVANS AND ASSOCIATES INC.
2100 Southwest River Parkway
Portland Oregon 97201
Phone: 503.223.6663

TRI-MET

CAPITAL PROJECTS AND FACILITIES DIVISION
710 N.E. HOLLADAY STREET
PORTLAND, OREGON 97232

SUBMITTED: 12/15/06

APPROVED: 12/15/06



SOUTH CORRIDOR PROJECT
I-205 SEGMENT
CIVIL PLAN & PROFILE
STA 1200+00 TO STA 1210+00

SCALE: 1" = 40'-0"

DRAWING NO.: C16-137-AX

CONTRACT NO.: RH040161LE

SHEET NO.: 134

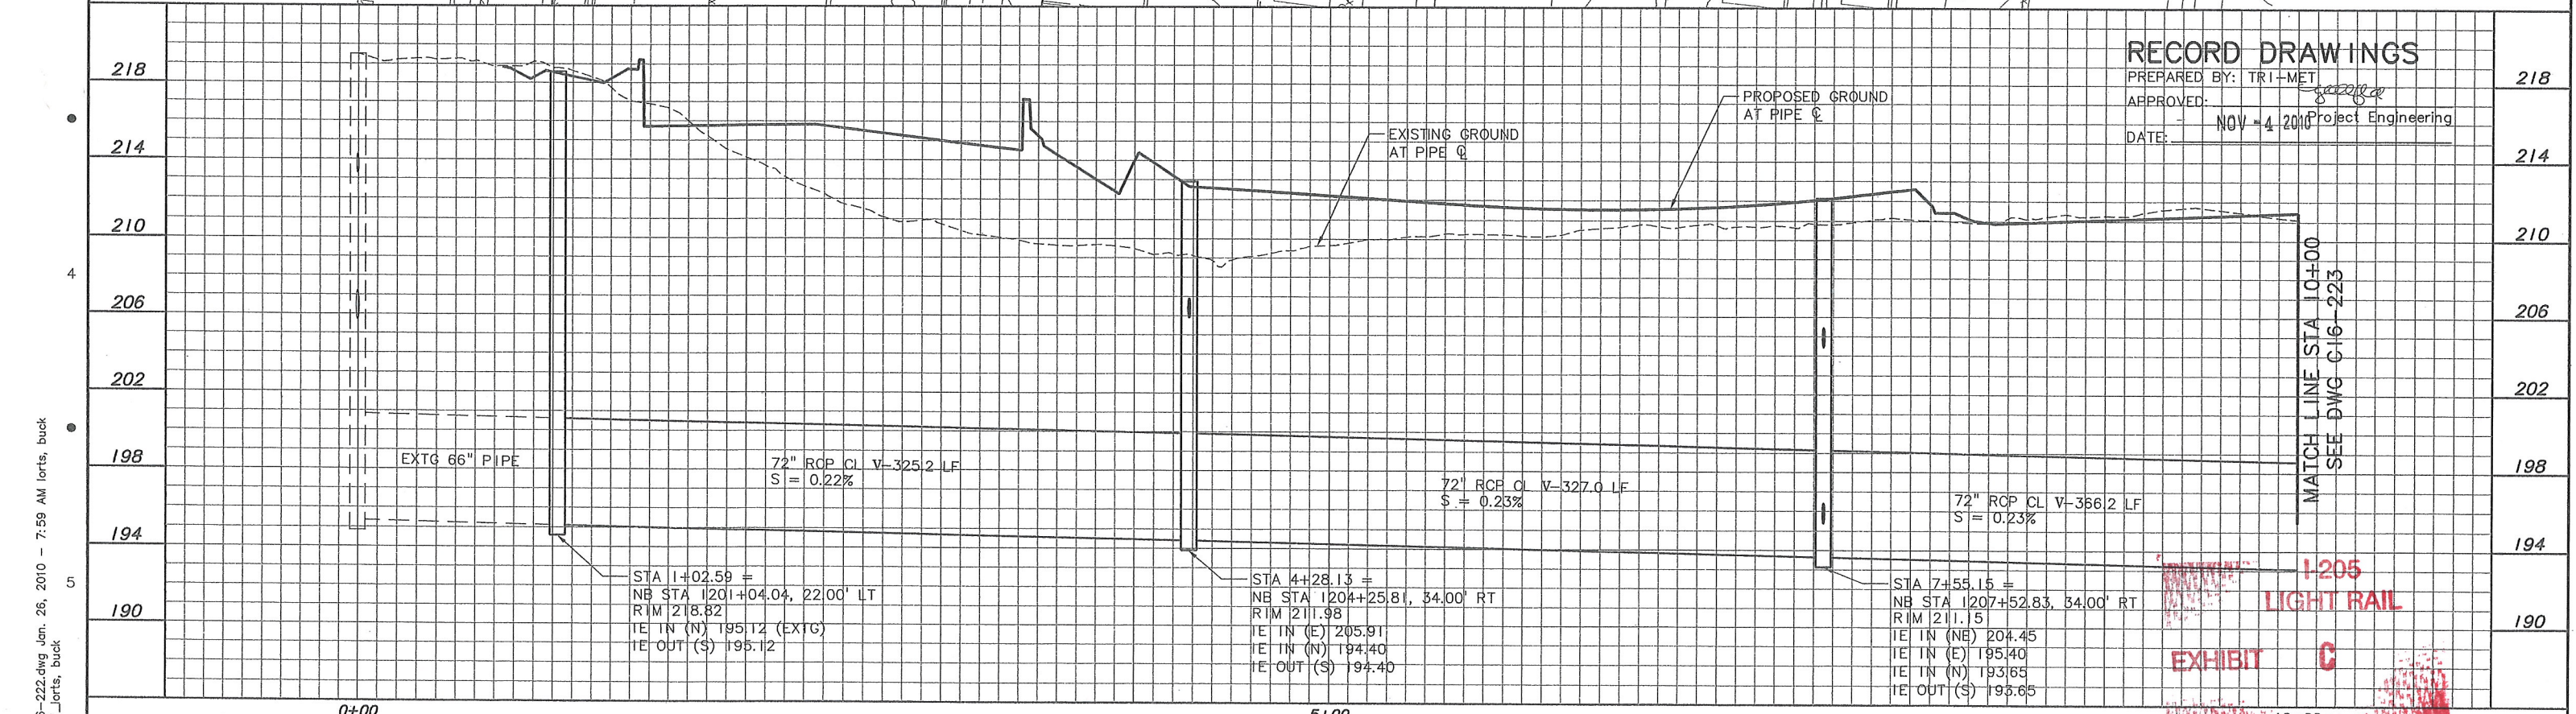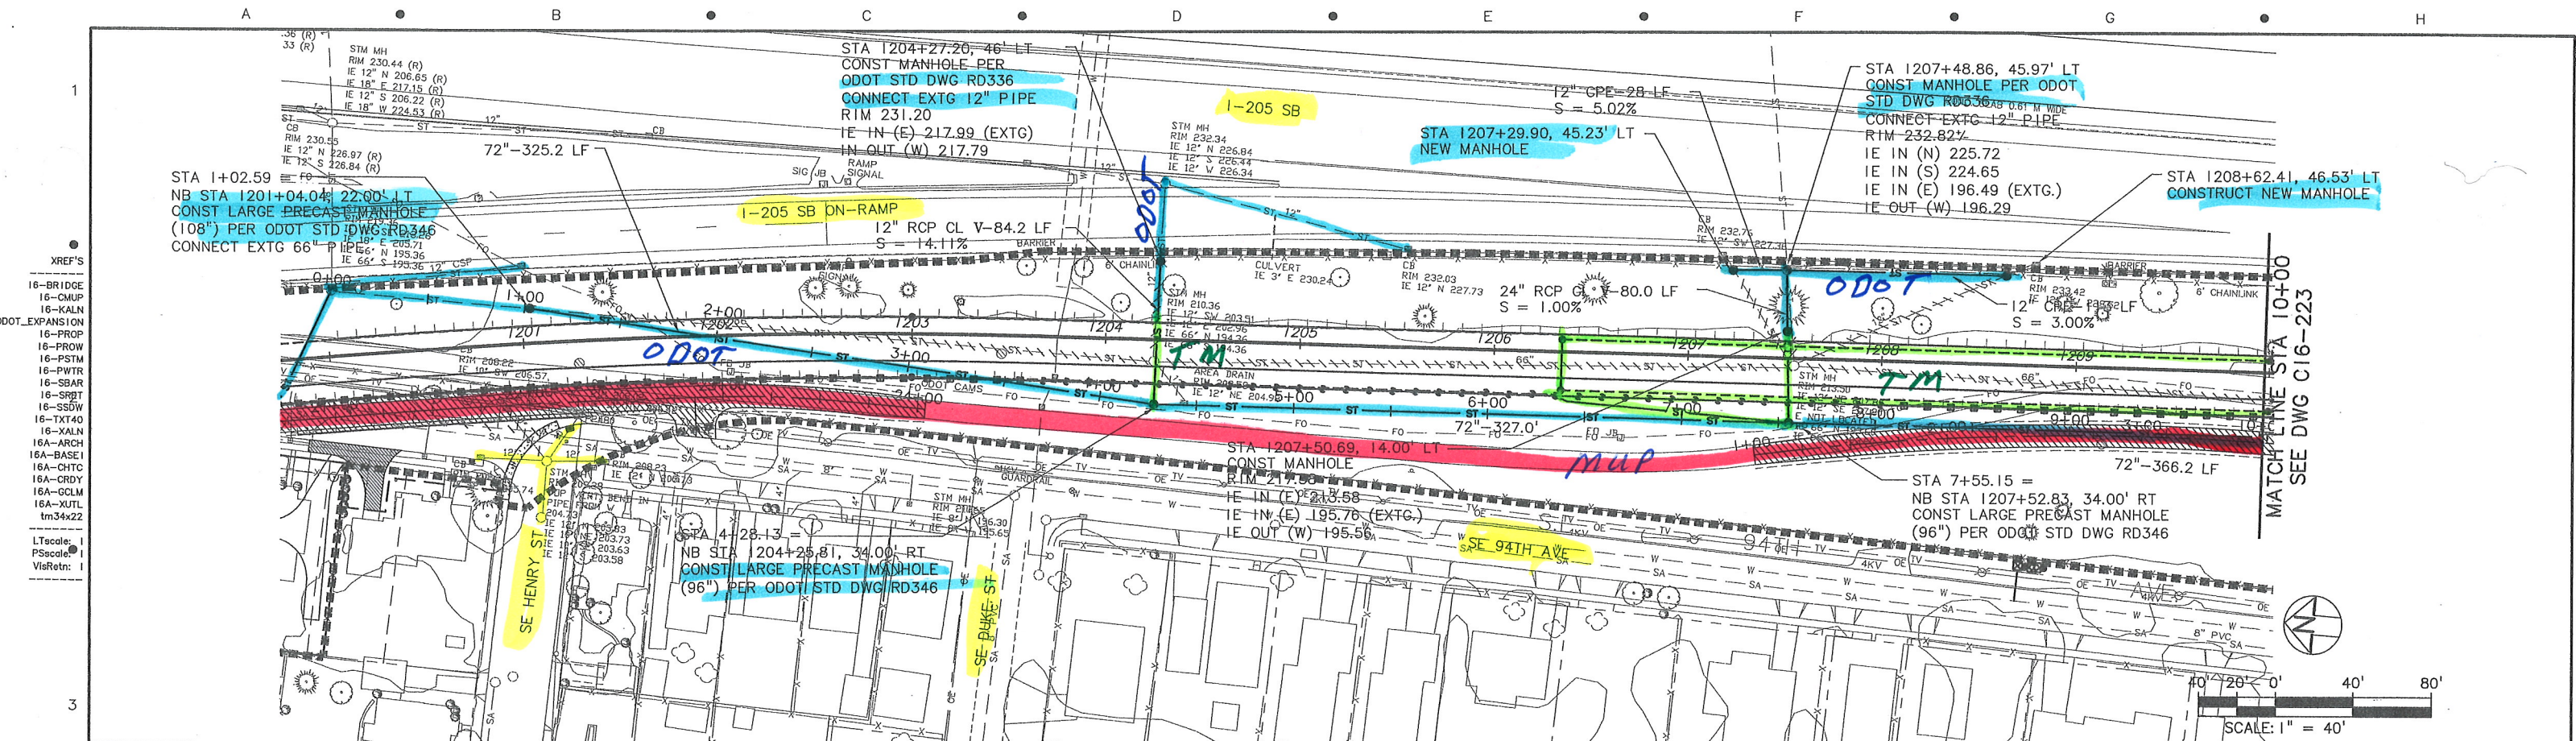

NOTE: THESE RECORD DRAWINGS REPRESENT THE BEST KNOWN INFORMATION ABOUT CONSTRUCTED FACILITIES. LOCATIONS SHOWN ARE NOT WARRANTED. UNDERGROUND UTILITIES MUST BE FIELD VERIFIED FOR ACTUAL LOCATION.

RECORD DRAWING

NO.	DATE	BY	APPD.	REVISIONS
		CHK		

CJH	DESIGNED	5-31-06	DATE
KRN	DRAWN	5-31-06	DATE
	CHECKED		DATE
	APPROVED		DATE

TRI-COUNTY METROPOLITAN TRANSPORTATION DISTRICT OF OREGON

SOUTH CORRIDOR CONSTRUCTORS
Stacy and Wilbeck
GRANITE
WILDISH



DAVID EVANS AND ASSOCIATES INC.
2100 Southwest River Parkway
Portland Oregon 97201
Phone: 503.223.6663

TRI-COUNTY MET
CAPITAL PROJECTS AND FACILITIES DIVISION
710 N.E. HOLLADAY STREET
PORTLAND, OREGON 97232

SUBMITTED: 12/15/06
DATE: 12/15/06
APPROVED: 12/15/06

SOUTH CORRIDOR PROJECT
I-205 SEGMENT
STORM LINE RELOCATION PLAN AND PROFILE
STA 1201+04 TO STA 1214+54
SHEET 1 OF 2

SCALE: 1" = 40'-0"
DRAWING NO.: C16-222-CX
CONTRACT NO.: RH040161LE
SHEET NO.: 204

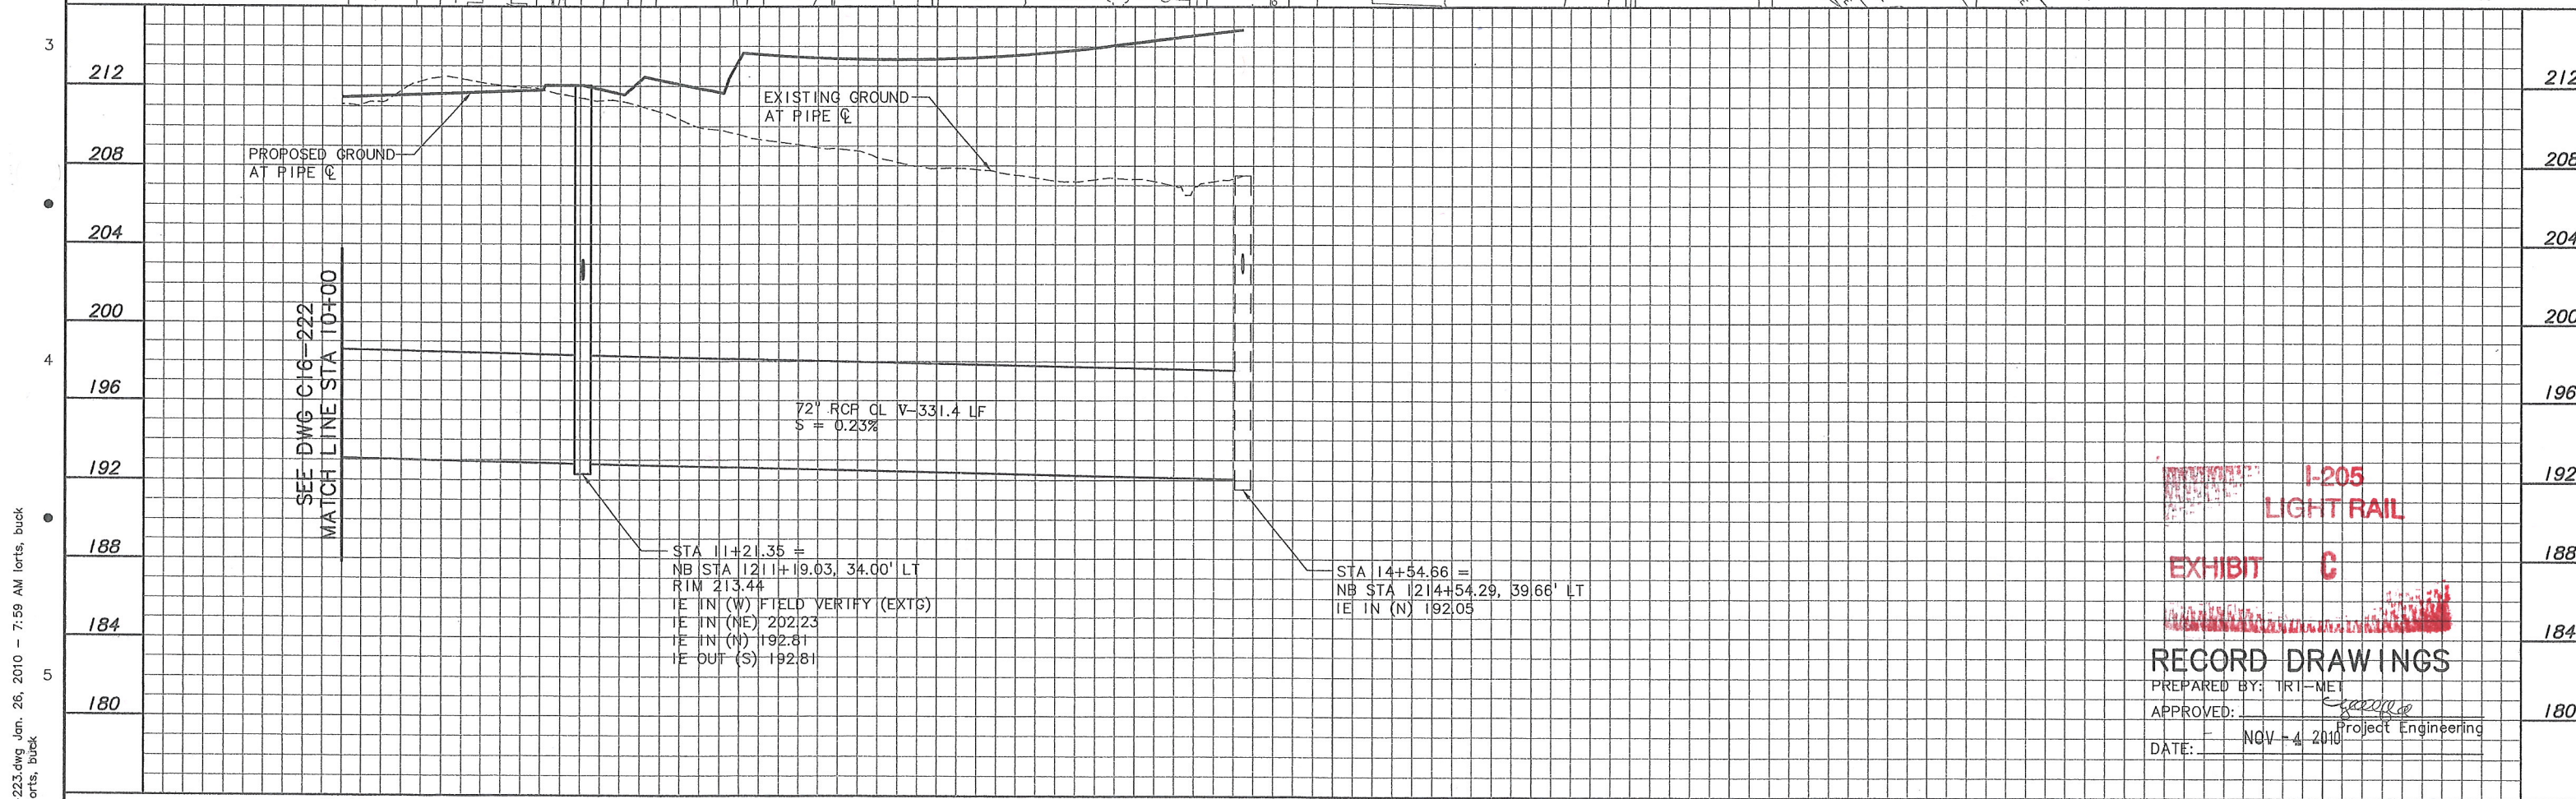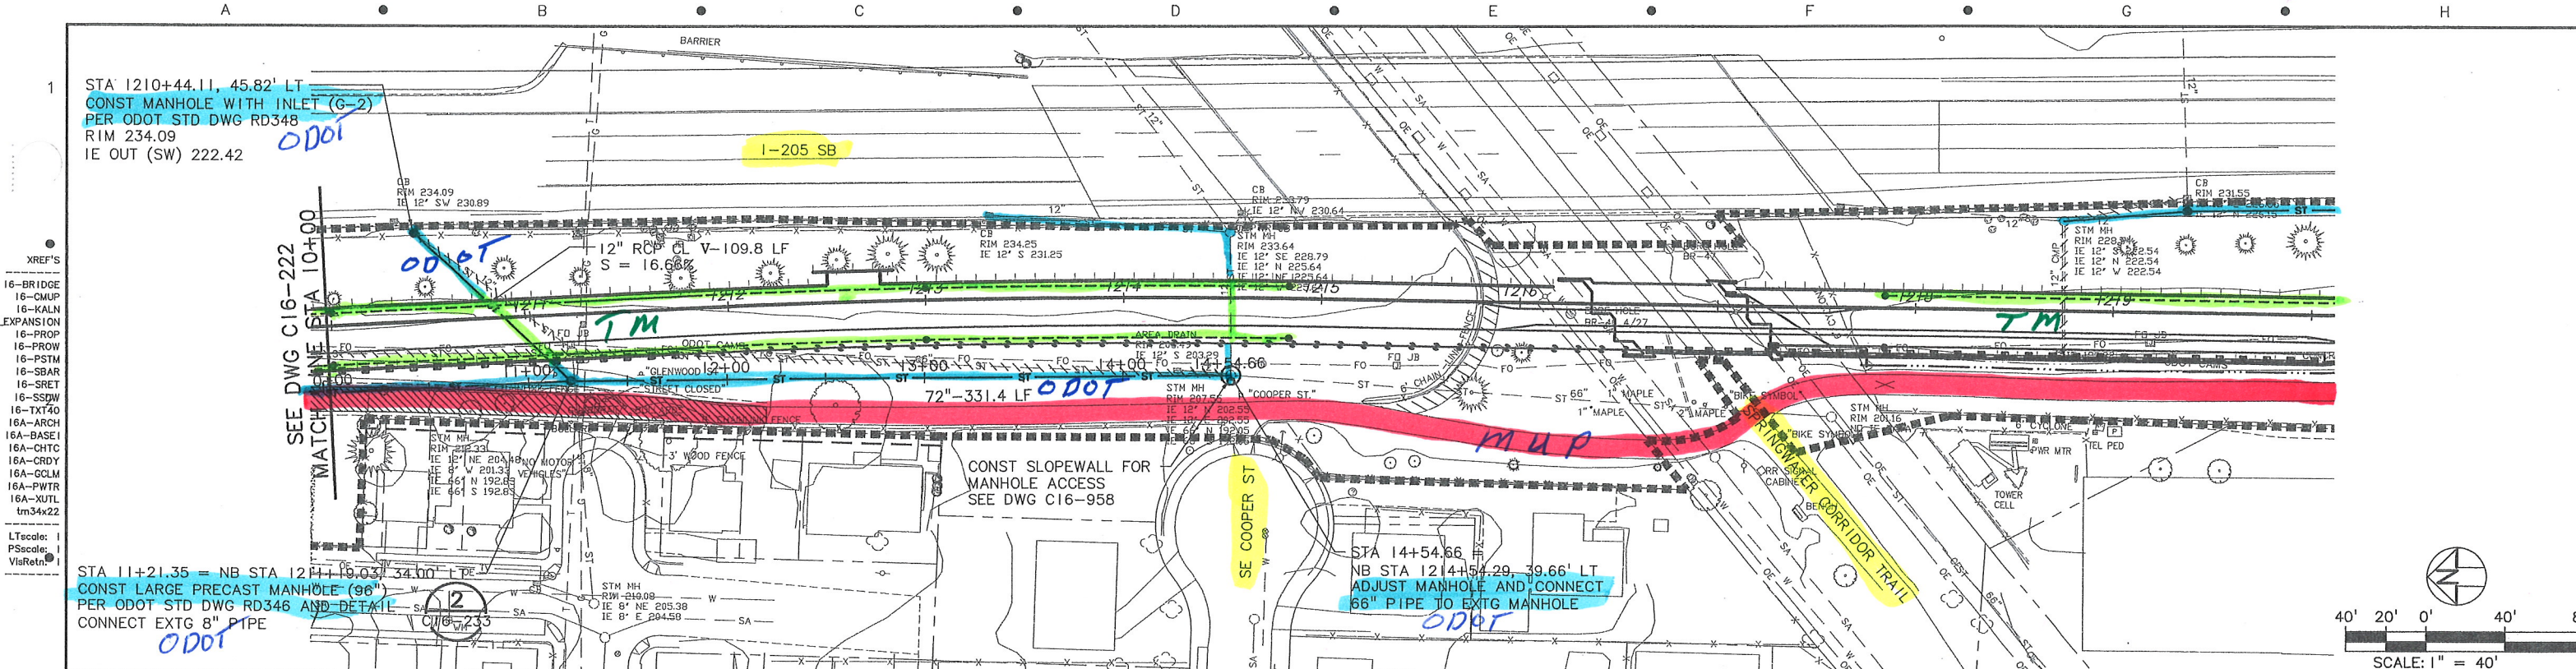

NOTE: THESE RECORD DRAWINGS REPRESENT THE BEST KNOWN INFORMATION ABOUT CONSTRUCTED FACILITIES. LOCATIONS SHOWN ARE NOT WARRANTED. UNDERGROUND UTILITIES MUST BE FIELD VERIFIED FOR ACTUAL LOCATION.

NO.	DATE	BY	APPD.	REVISIONS

CJH DESIGNED	5-31-06 DATE
KRN DRAWN	5-31-06 DATE
CHECKED	DATE
APPROVED	DATE

TRI-COUNTY METROPOLITAN TRANSPORTATION DISTRICT OF OREGON

SOUTH CORRIDOR CONSTRUCTORS
Stacy and Wilbeck
GRANITE
WILDISH

DAVID EVANS AND ASSOCIATES INC.
2100 Southwest River Parkway
Portland Oregon 97201
Phone: 503.223.6663



TRI-COUNTY MET
CAPITAL PROJECTS AND FACILITIES DIVISION
710 N.E. HOLLADAY STREET
PORTLAND, OREGON 97232

SUBMITTED: 12/15/06 DATE: 12/15/06 APPROVED: DATE: 12/15/06

SOUTH CORRIDOR PROJECT
I-205 SEGMENT
STORM LINE RELOCATION PLAN AND PROFILE
STA 1201+04 TO STA 1214+54
SHEET 2 OF 2

SCALE: 1" = 40'-0"	DRAWING NO.: C16-223-BX	CONTRACT NO.: RH040161LE	SHEET NO.: 205
--------------------	-------------------------	--------------------------	----------------

R:\V-205 AS-BUILT\16-223.dwg Jan. 26, 2010 - 7:59 AM lorts, buck
Plot Date: 3/16/2010 1
V_Lorts, buck

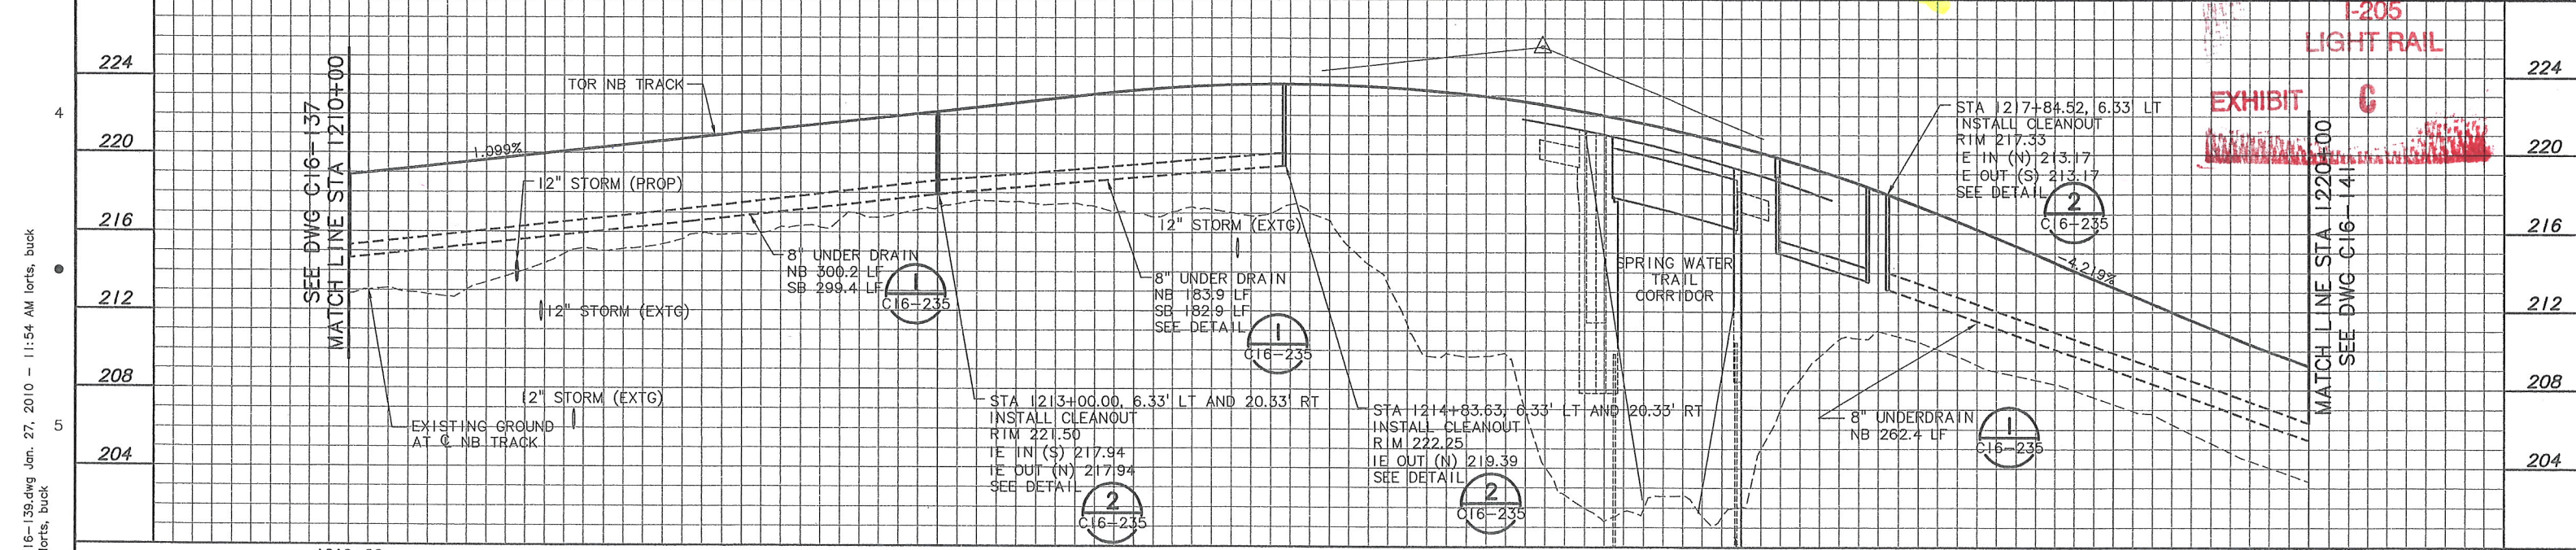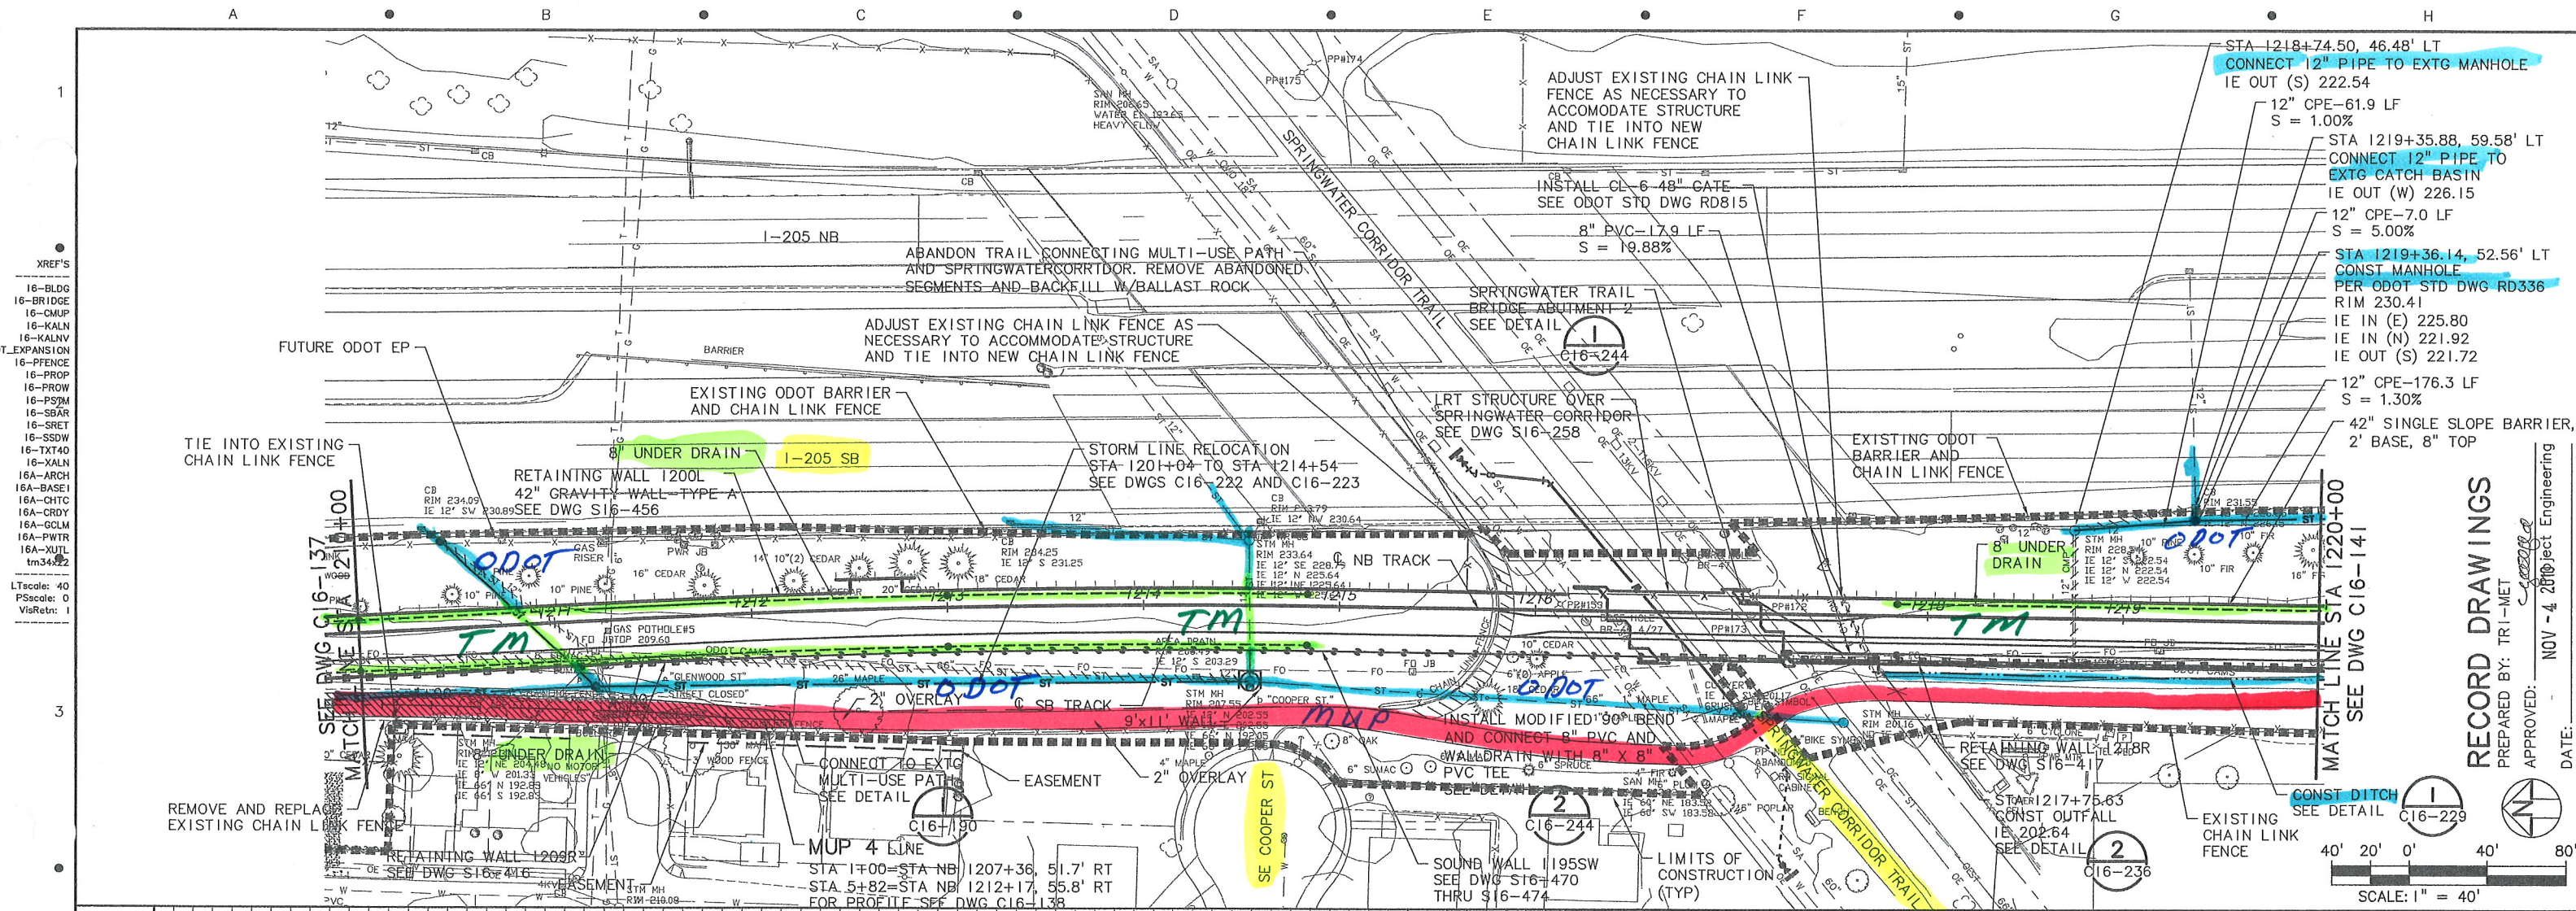

NOTE: THESE RECORD DRAWINGS REPRESENT THE BEST KNOWN INFORMATION ABOUT CONSTRUCTED FACILITIES. LOCATIONS SHOWN ARE NOT WARRANTED. UNDERGROUND UTILITIES MUST BE FIELD VERIFIED FOR ACTUAL LOCATION.

NO.	DATE	BY	APPD.	REVISIONS

DRA/KRN DESIGNED	2-17-06 DATE
JTH DRAWN	2-19-06 DATE
CHECKED	DATE
APPROVED	DATE

TRI-COUNTY METROPOLITAN TRANSPORTATION DISTRICT OF OREGON

SOUTH CORRIDOR CONSTRUCTORS
Stacy and Wilbeck
GRANITE
WILDISH

DAVID EVANS AND ASSOCIATES INC.
2100 Southwest River Parkway
Portland Oregon 97201
Phone: 503.223.6663

TRIOMET

CAPITAL PROJECTS AND FACILITIES DIVISION
710 N.E. HOLLADAY STREET
PORTLAND, OREGON 97232

SUBMITTED: 12/15/06

APPROVED: 12/15/06

SOUTH CORRIDOR PROJECT
I-205 SEGMENT
CIVIL PLAN & PROFILE
STA 1210+00 TO STA 1220+00

SCALE: 1" = 40'-0"

DRAWING NO.: C16-139-CX

CONTRACT NO.: RH040161LE

SHEET NO.: 136