
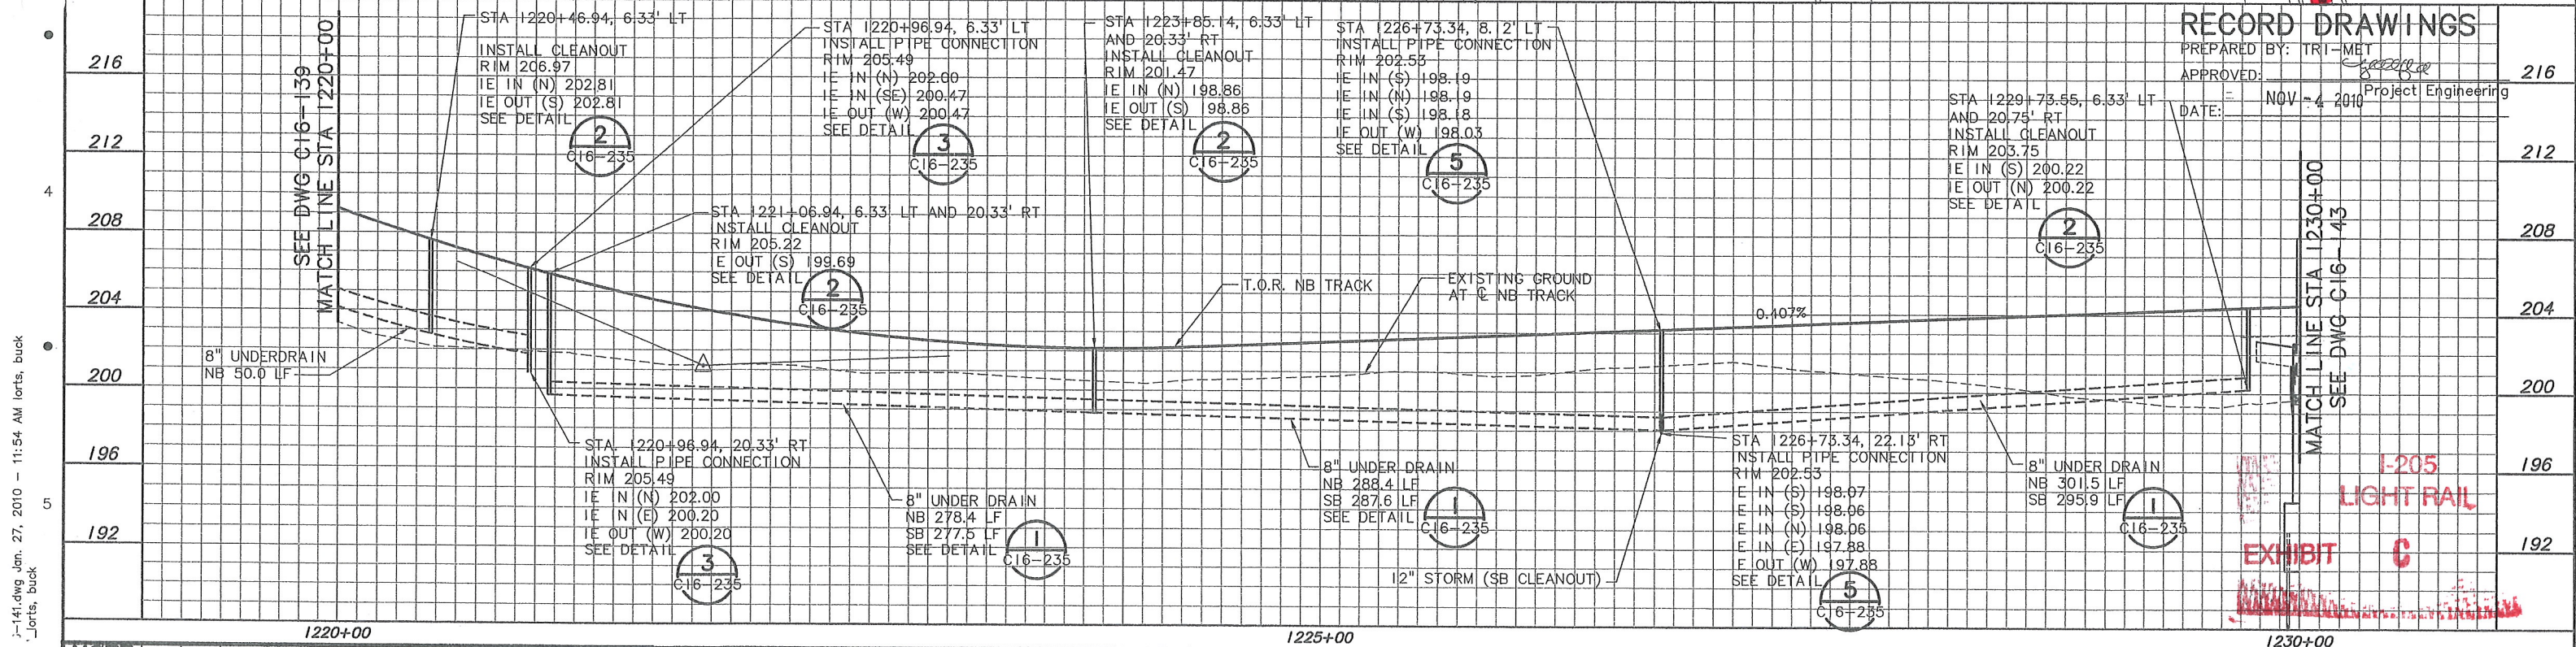


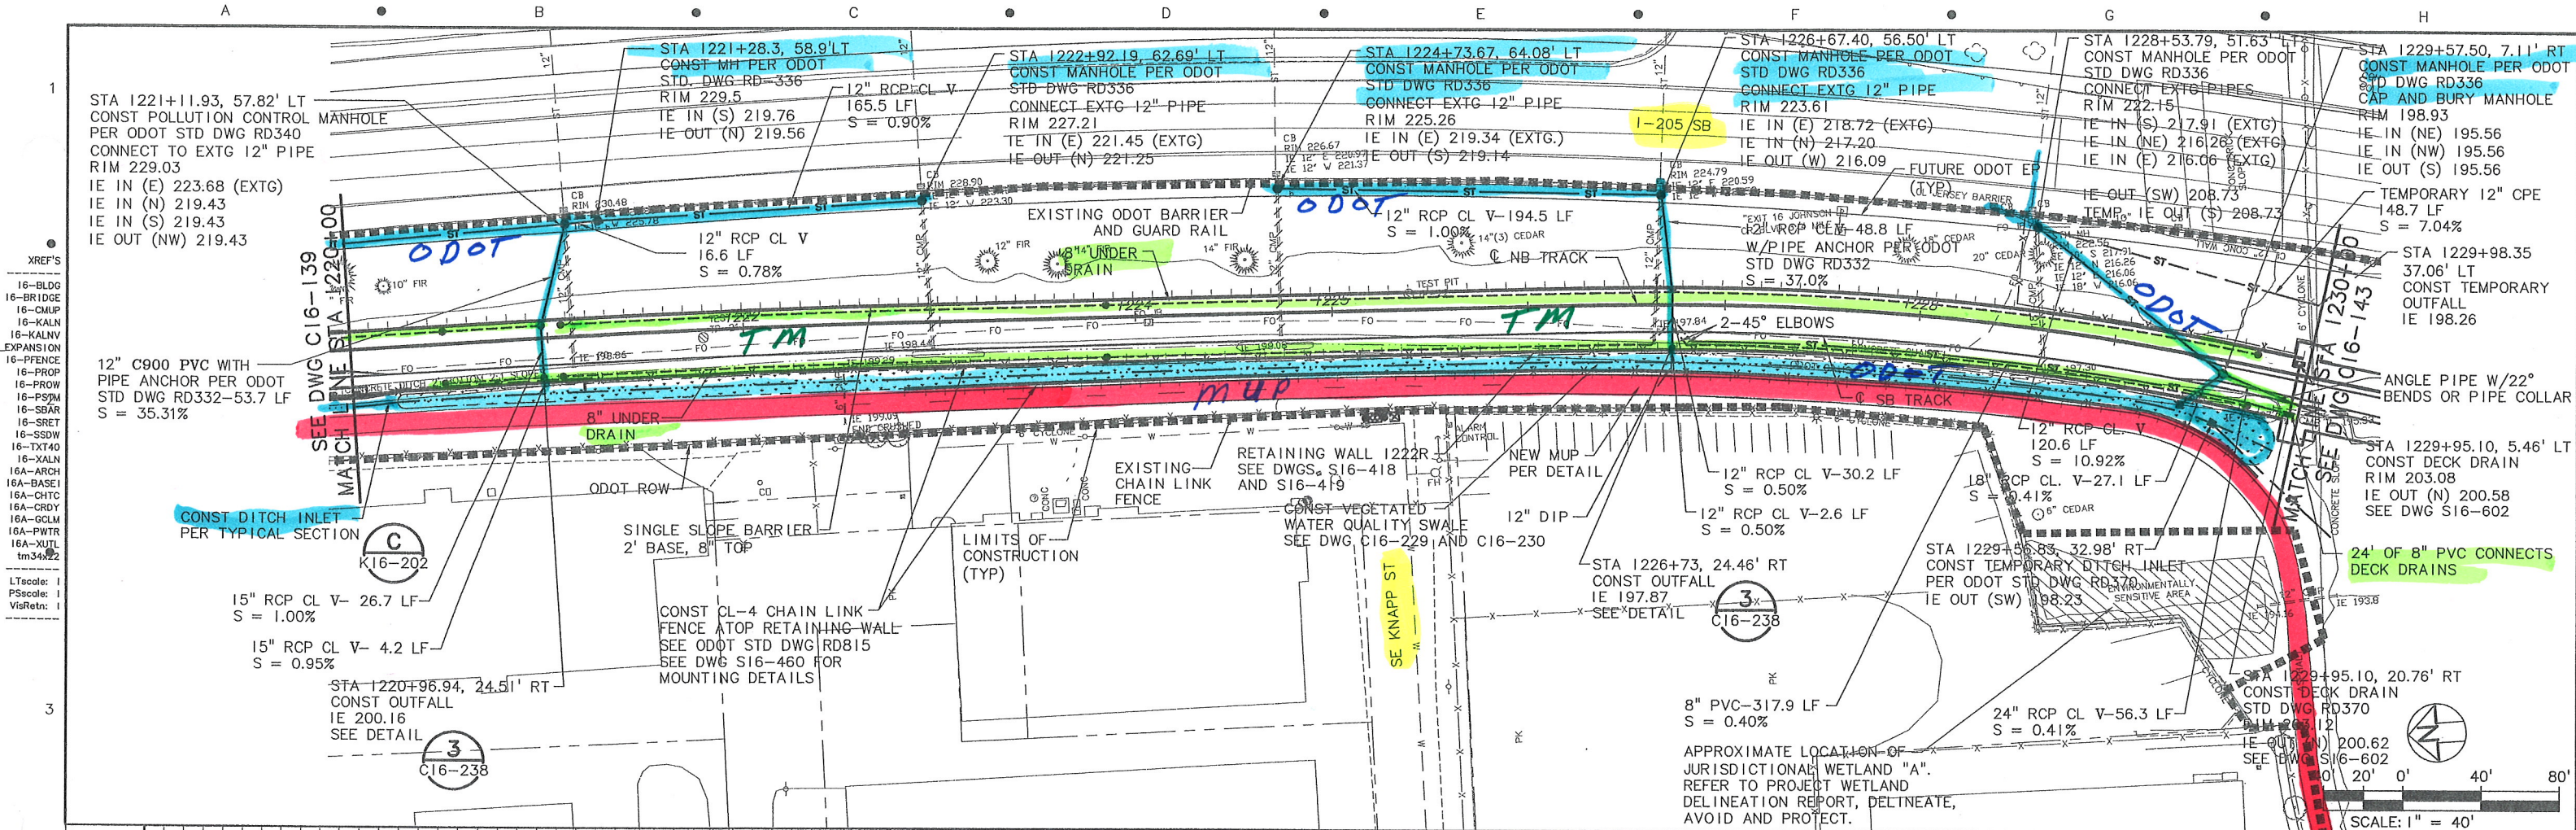

**NOTE:** THESE RECORD DRAWINGS REPRESENT THE BEST KNOWN INFORMATION ABOUT CONSTRUCTED FACILITIES. LOCATIONS SHOWN ARE NOT WARRANTED. UNDERGROUND UTILITIES MUST BE FIELD VERIFIED FOR ACTUAL LOCATION.

|     |      |    |      |       |           |
|-----|------|----|------|-------|-----------|
| NO. | DATE | BY | CHK. | APPD. | REVISIONS |
|     |      |    |      |       |           |

|          |         |
|----------|---------|
| DRA/KRN  | 2-17-06 |
| DESIGNED | DATE    |
| JTH      | 2-19-06 |
| DRAWN    | DATE    |
| CHECKED  | DATE    |
| APPROVED | DATE    |

**TRI-COUNTY METROPOLITAN TRANSPORTATION DISTRICT OF OREGON**

**SOUTH CORRIDOR CONSTRUCTORS**  
Stacy and Wilbeck  
GRANITE  
WILDISH

**DAVID EVANS AND ASSOCIATES INC.**  
2100 Southwest River Parkway  
Portland Oregon 97201  
Phone: 503.223.6663

**TRI MET**  
CAPITAL PROJECTS AND FACILITIES DIVISION  
710 N.E. HOLLADAY STREET  
PORTLAND, OREGON 97232

SUBMITTED: 12/15/06

DATE: 12/15/06

APPROVED: 12/15/06

DATE: 12/15/06

**SOUTH CORRIDOR PROJECT**  
**I-205 SEGMENT**  
**CIVIL PLAN & PROFILE**  
**STA 1220+00 TO STA 1230+00**



SCALE: 1" = 40'-0"

DRAWING NO.: C16-141-GX

CONTRACT NO.: RH040161LE

SHEET NO.: 137



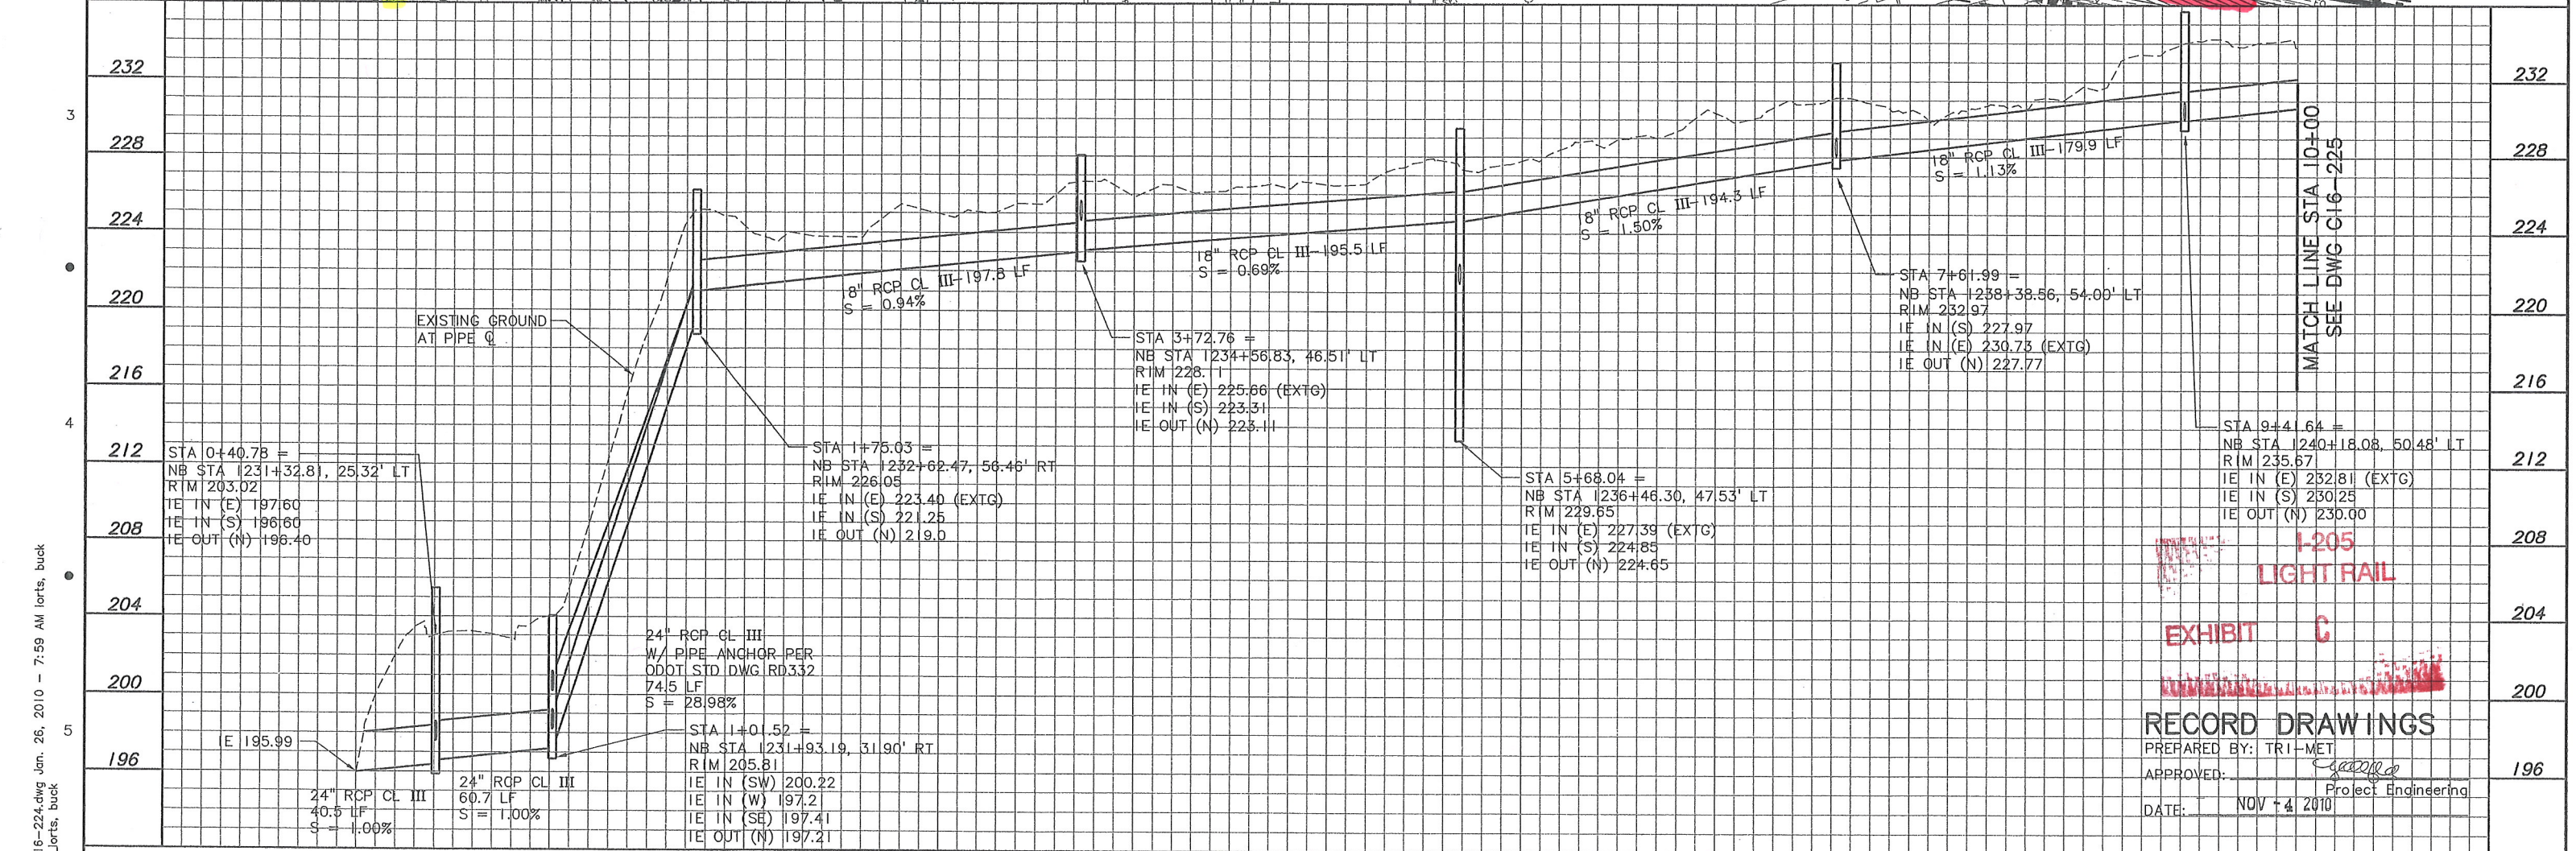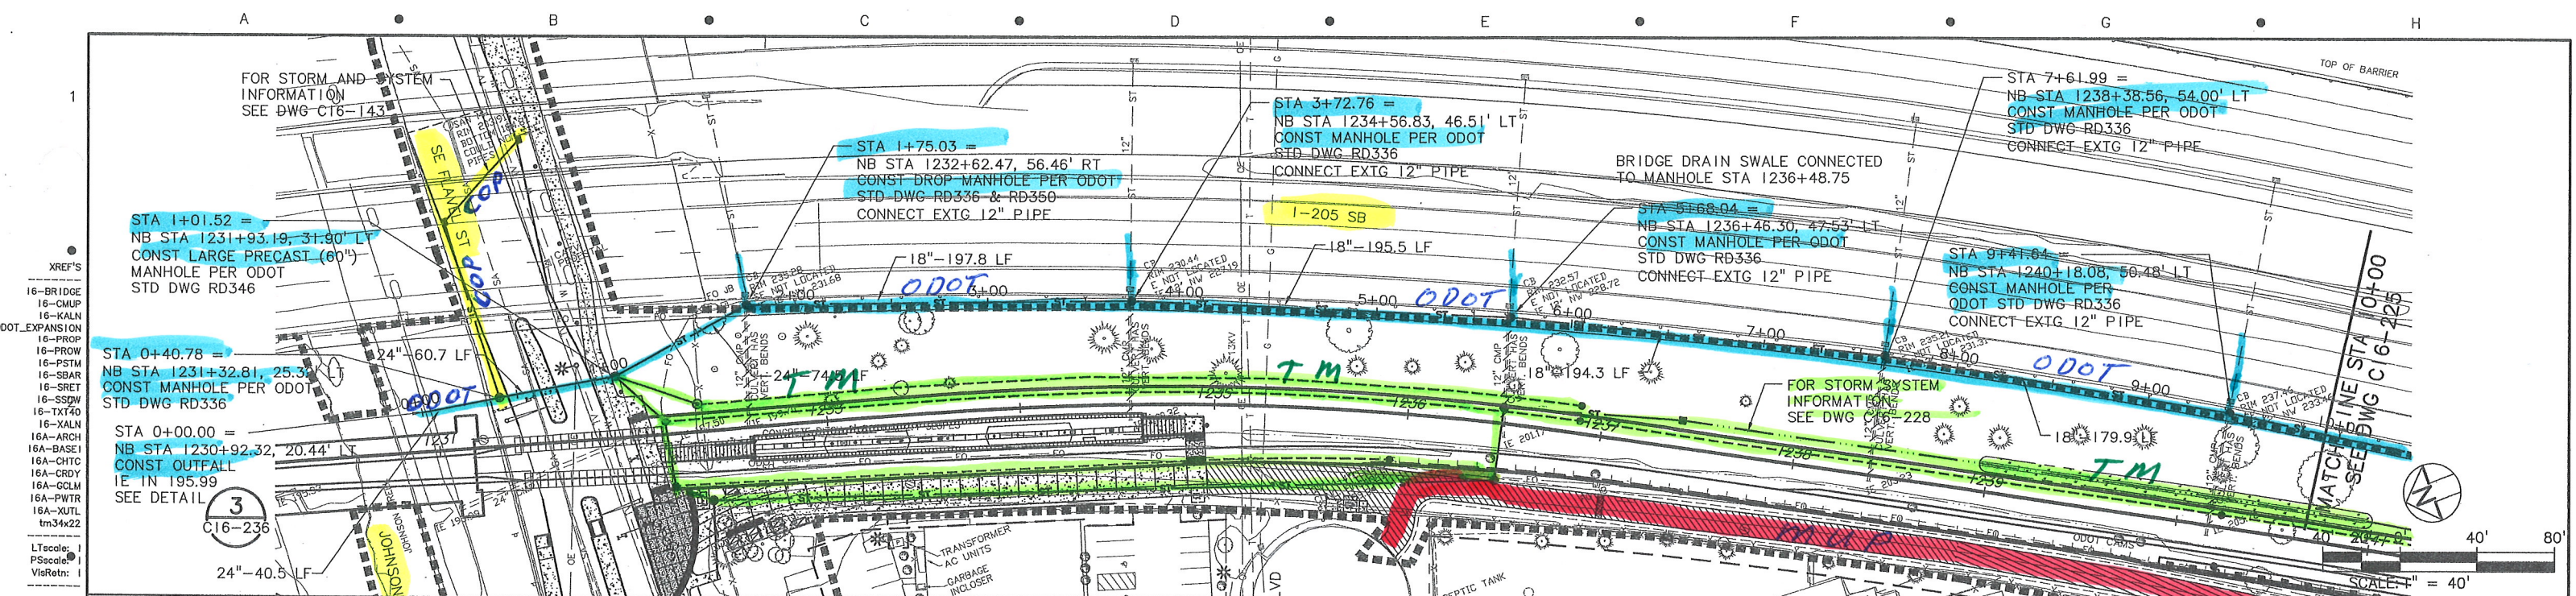

**NOTE:** THESE RECORD DRAWINGS REPRESENT THE BEST KNOWN INFORMATION ABOUT CONSTRUCTED FACILITIES. LOCATIONS SHOWN ARE NOT WARRANTED. UNDERGROUND UTILITIES MUST BE FIELD VERIFIED FOR ACTUAL LOCATION.

**RECORD DRAWING**

| NO. | DATE | BY   | APPD. | REVISIONS                                                   |
|-----|------|------|-------|-------------------------------------------------------------|
|     |      | CHK. |       | Original Drawing Stamped and Sealed by CHRISTINE J. HIGGINS |

|                 |                 |
|-----------------|-----------------|
| CJH<br>DESIGNED | 5-31-06<br>DATE |
| KRN<br>DRAWN    | 5-31-06<br>DATE |
| CHECKED         | DATE            |
| APPROVED        | DATE            |

**TRI-COUNTY METROPOLITAN TRANSPORTATION DISTRICT OF OREGON**

**SOUTH CORRIDOR CONSTRUCTORS**  
Stacy and Wilbeck  
GRANITE  
WILDISH

**DAVID EVANS AND ASSOCIATES INC.**  
2100 Southwest River Parkway  
Portland Oregon 97201  
Phone: 503.223.6663

**TRI-COUNTY MET**



**CAPITAL PROJECTS AND FACILITIES DIVISION**  
710 N.E. HOLLADAY STREET  
PORTLAND, OREGON 97232

SUBMITTED: 12/15/06  
DATE: 12/15/06  
APPROVED: 12/15/06

**SOUTH CORRIDOR PROJECT**  
**I-205 SEGMENT**  
**STORM LINE RELOCATION PLAN AND PROFILE**  
**STA 1230+92 TO STA 1243+80**  
**SHEET 1 OF 2**

SCALE: 1" = 40'-0"  
DRAWING NO.: C16-224-BX  
CONTRACT NO.: RH040161LE  
SHEET NO.: 206



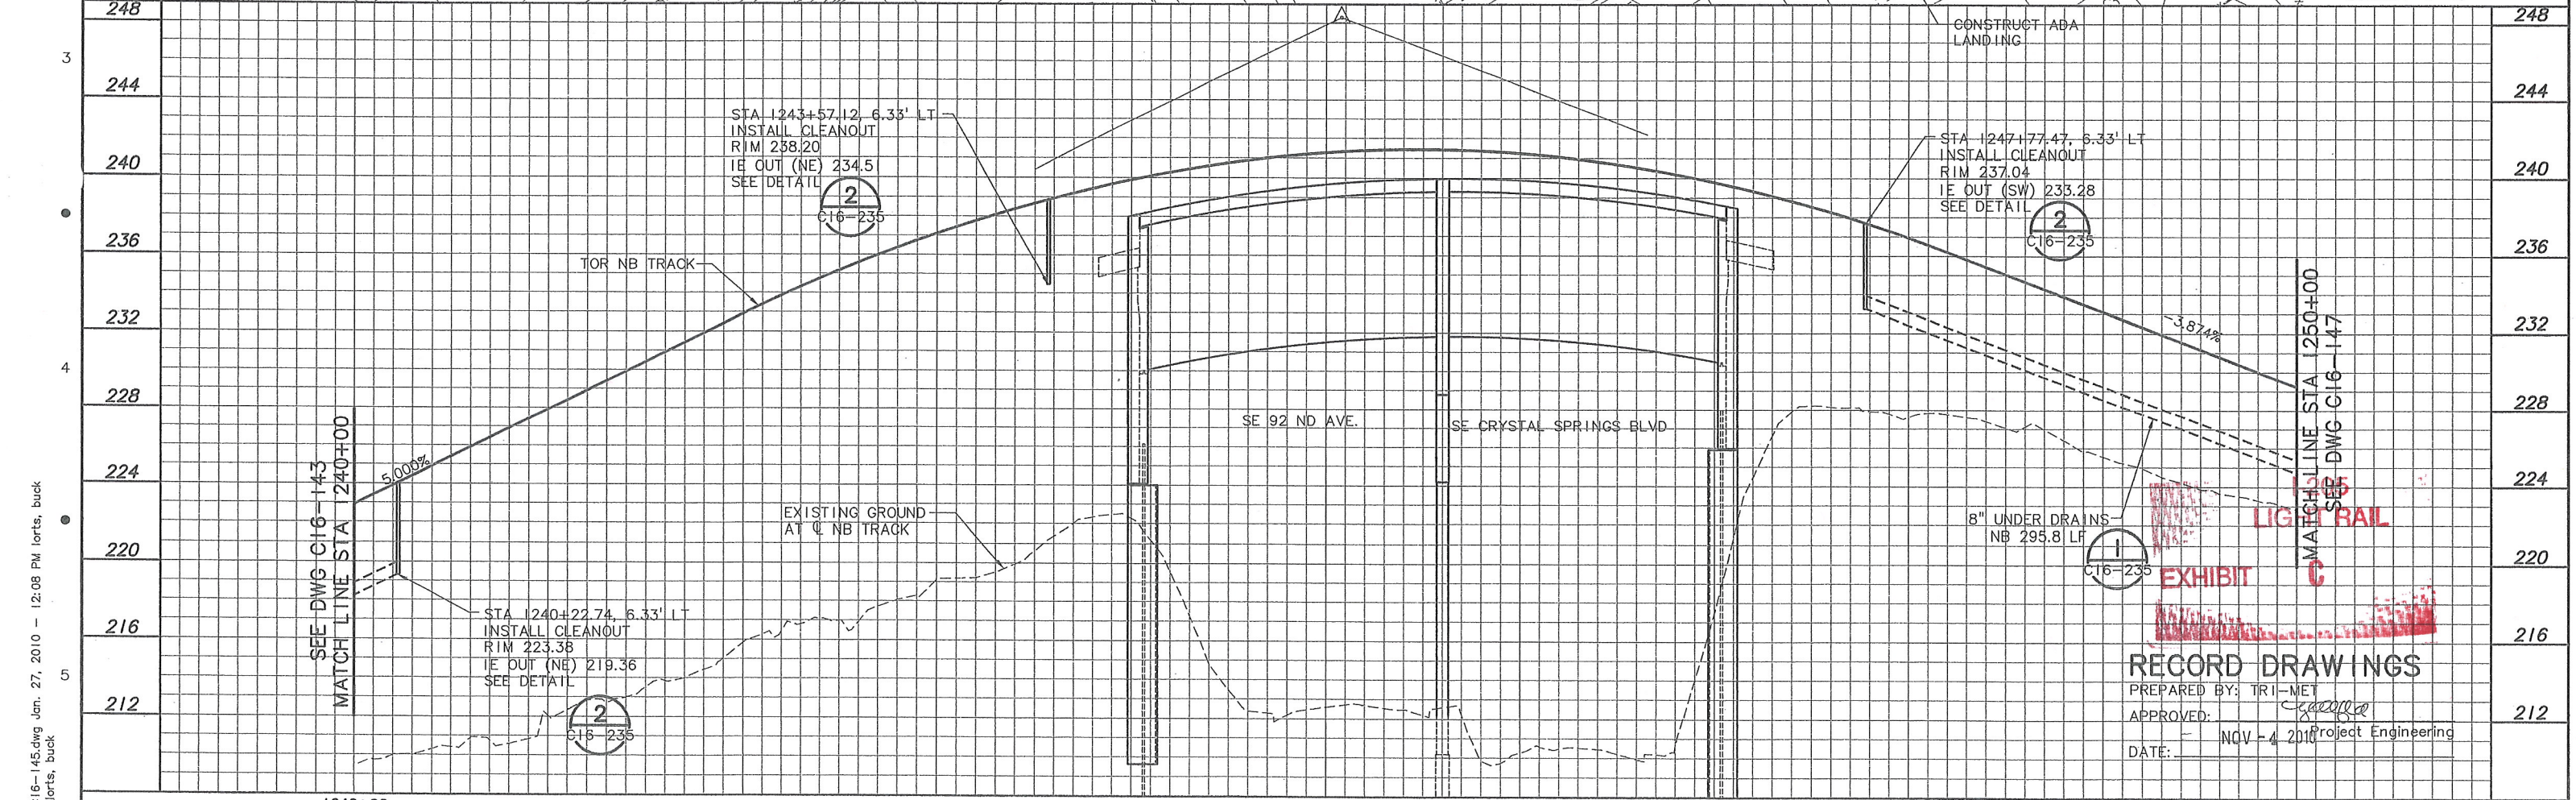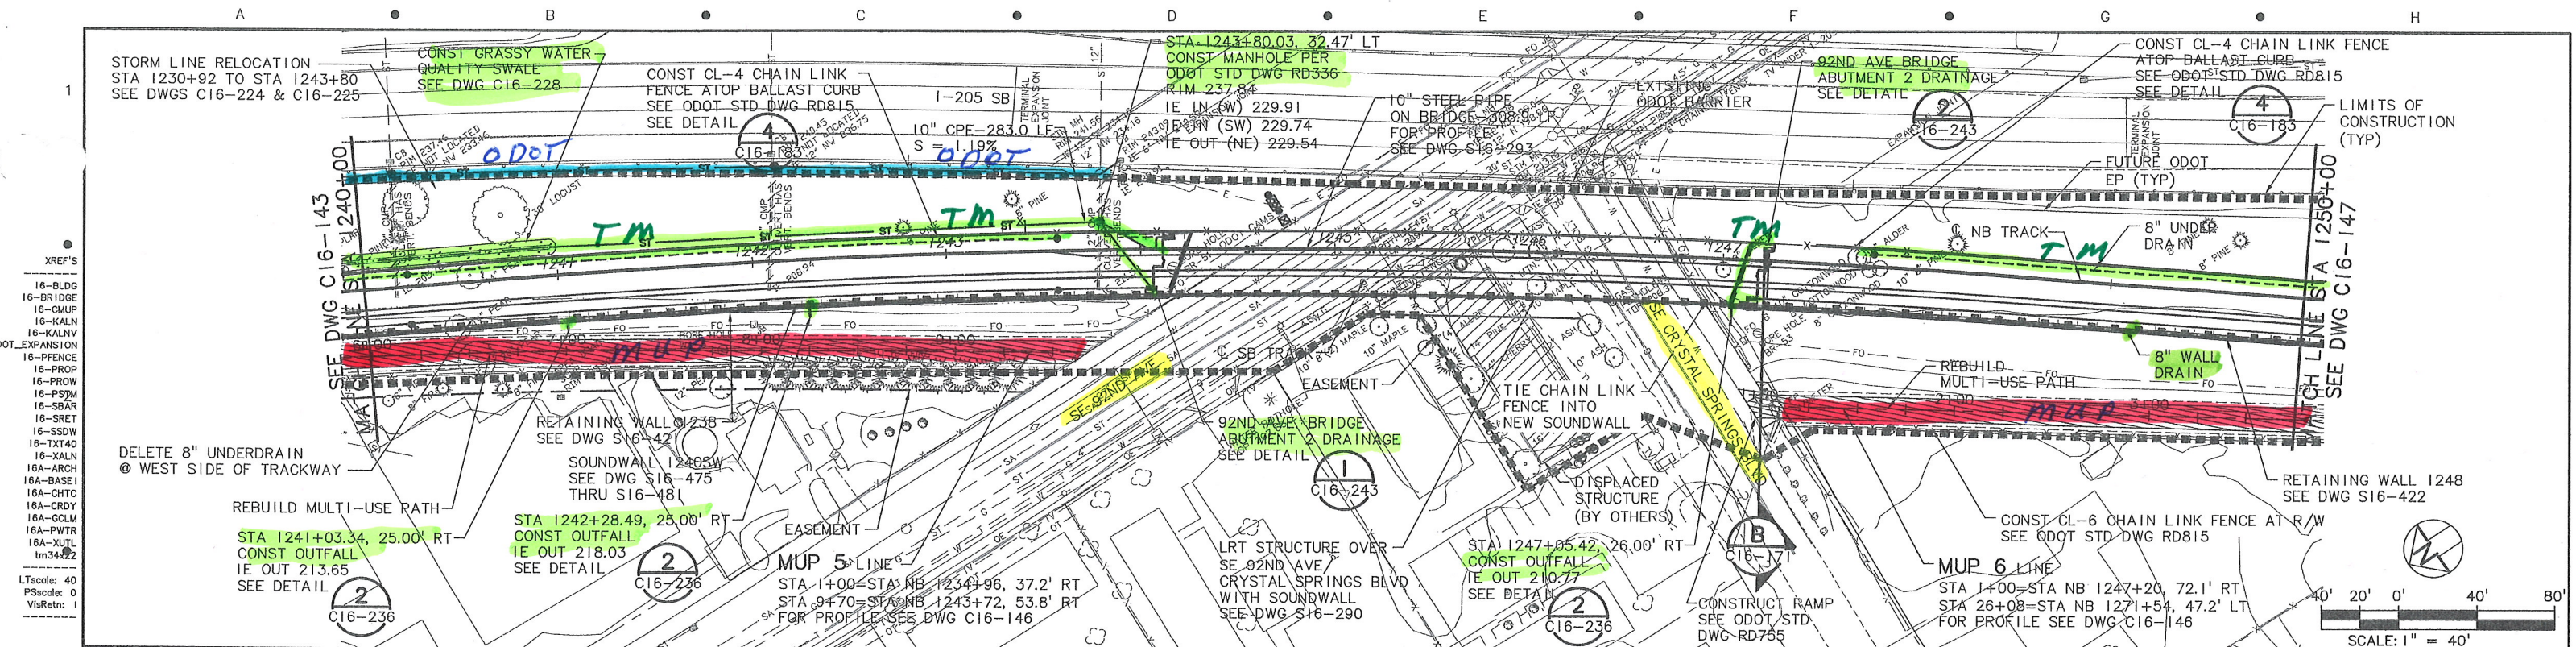

**NOTE:** THESE RECORD DRAWINGS REPRESENT THE BEST KNOWN INFORMATION ABOUT CONSTRUCTED FACILITIES. LOCATIONS SHOWN ARE NOT WARRANTED. UNDERGROUND UTILITIES MUST BE FIELD VERIFIED FOR ACTUAL LOCATION.

| NO. | DATE | BY | APPD. | REVISIONS |
|-----|------|----|-------|-----------|
|     |      |    |       |           |
|     |      |    |       |           |
|     |      |    |       |           |

|          |          |         |      |
|----------|----------|---------|------|
| DRA/KRN  | DESIGNED | 2-17-06 | DATE |
| JTH      | DRAWN    | 2-19-06 | DATE |
| CHECKED  | DATE     |         |      |
| APPROVED | DATE     |         |      |

**SOUTH CORRIDOR CONSTRUCTORS**  
Stacy and Wilbeck  
GRANITE  
WILDISH

**DAVID EVANS AND ASSOCIATES INC.**  
2100 Southwest River Parkway  
Portland Oregon 97201  
Phone: 503.223.6663

**TRI-MET**

CAPITAL PROJECTS AND FACILITIES DIVISION  
710 N.E. HOLLADAY STREET  
PORTLAND, OREGON 97232

**SOUTH CORRIDOR PROJECT**  
I-205 SEGMENT  
CIVIL PLAN & PROFILE  
STA 1240+00 TO STA 1250+00

SCALE: 1" = 40'-0"



DRAWING NO.: C16-145-AX

CONTRACT NO.: RH040161LE

SHEET NO.: 140

R:\1-205 AS-BUILTS\1-205 AS-BUILTS.dwg Jan. 27, 2010 - 12:08 PM Jorts, buck  
Plot Date: 3/16/2010 7:10 AM Jorts, buck



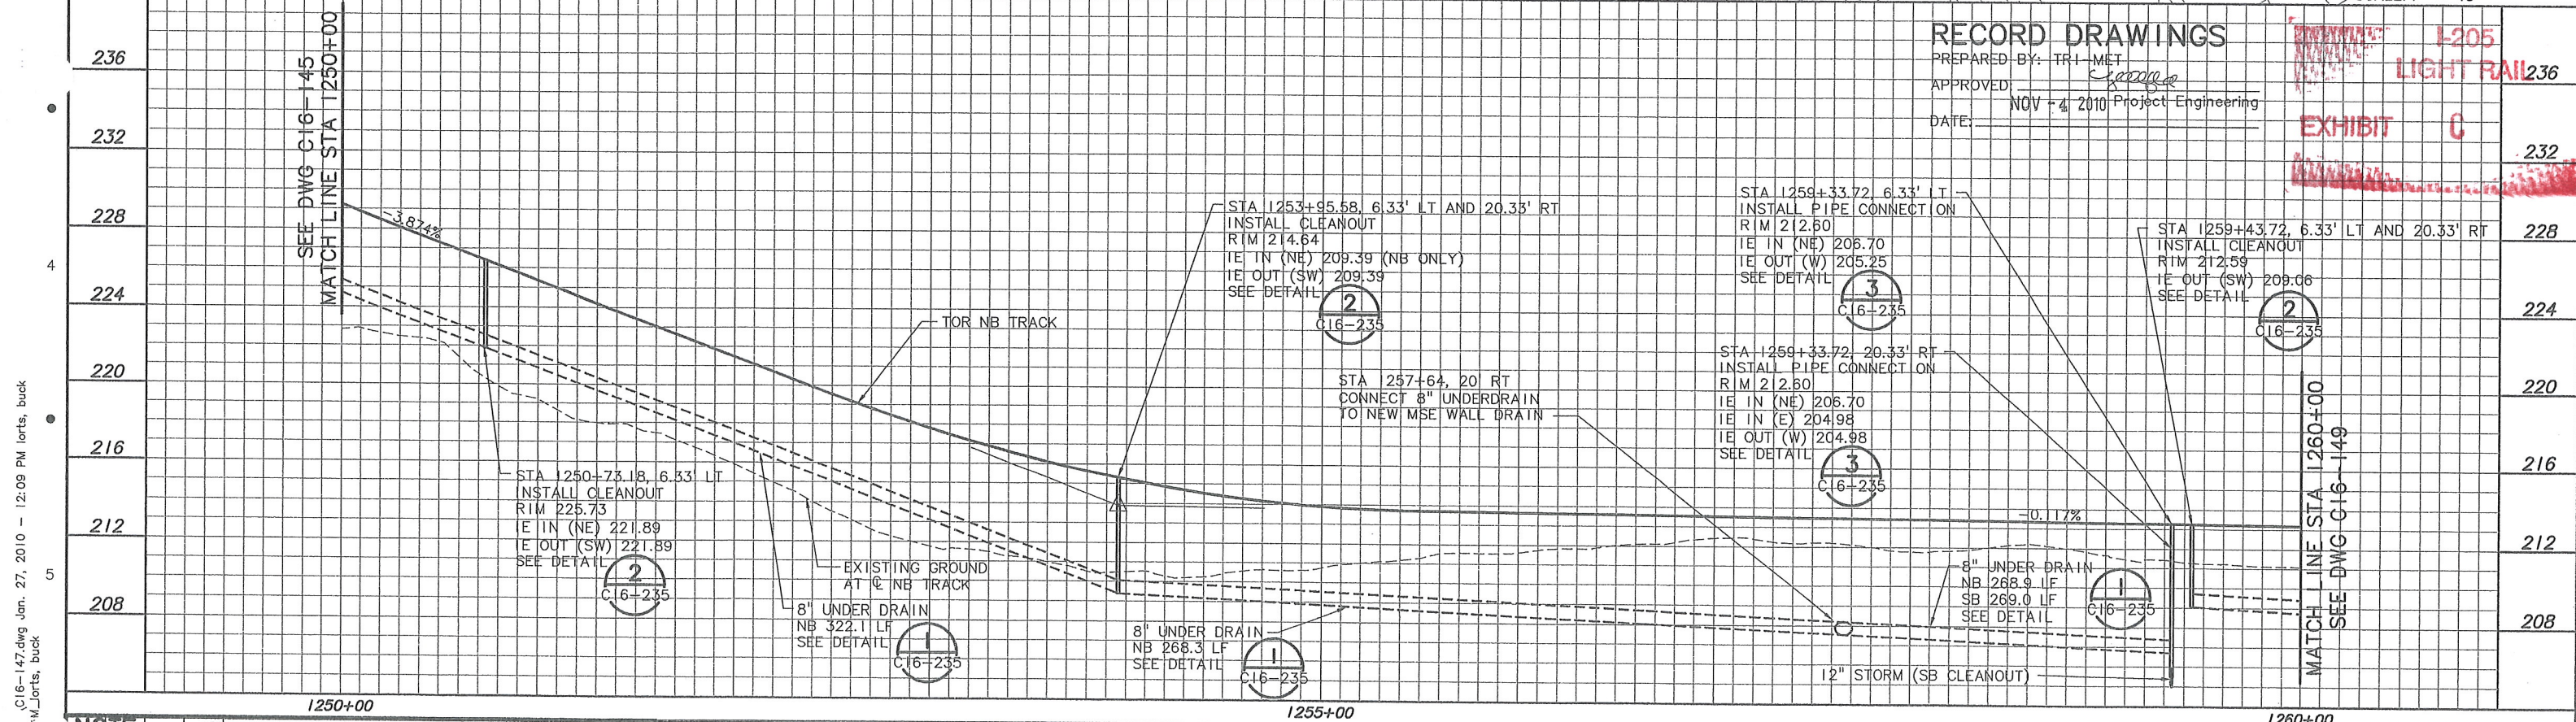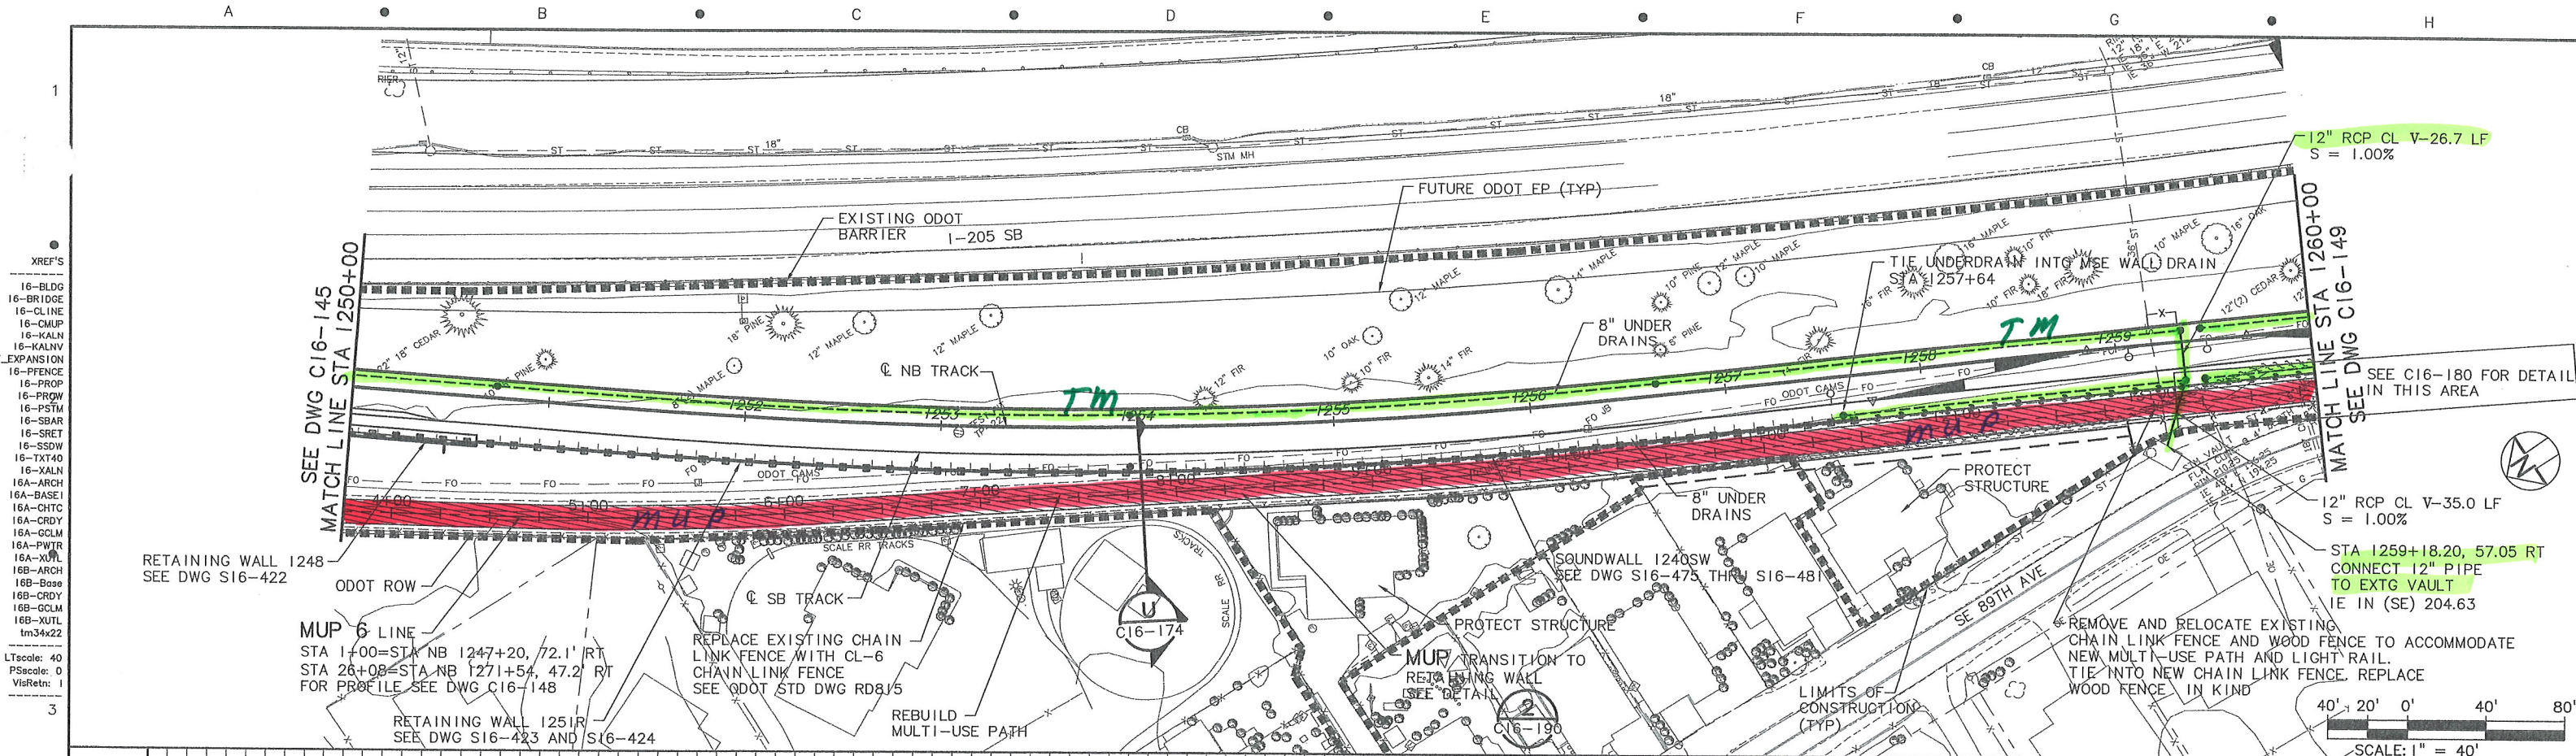

**NOTE:** THESE RECORD DRAWINGS REPRESENT THE BEST KNOWN INFORMATION ABOUT CONSTRUCTED FACILITIES. LOCATIONS SHOWN ARE NOT WARRANTED. UNDERGROUND UTILITIES MUST BE FIELD VERIFIED FOR ACTUAL LOCATION.

|     |      |    |      |       |           |
|-----|------|----|------|-------|-----------|
| NO. | DATE | BY | CHK. | APPD. | REVISIONS |
|     |      |    |      |       |           |

|          |         |
|----------|---------|
| DRA/KRN  | 2-17-06 |
| DESIGNED | DATE    |
| JTH      | 2-19-06 |
| DRAWN    | DATE    |
| CHECKED  | DATE    |
| APPROVED | DATE    |

**RECORD DRAWING**

**TRI-COUNTY METROPOLITAN TRANSPORTATION DISTRICT OF OREGON**

**SOUTH CORRIDOR CONSTRUCTORS**  
Stacy and Witbeck  
GRANITE  
WILDISH

**DAVID EVANS AND ASSOCIATES INC.**  
2100 Southwest River Parkway  
Portland Oregon 97201  
Phone: 503.223.6663



**TRI@MET**  
CAPITAL PROJECTS AND FACILITIES DIVISION  
710 N.E. HOLLADAY STREET  
PORTLAND, OREGON 97232

**SOUTH CORRIDOR PROJECT**  
1-205 SEGMENT  
CIVIL PLAN & PROFILE  
STA 1250+00 TO 1260+00

|        |             |              |            |               |            |            |     |
|--------|-------------|--------------|------------|---------------|------------|------------|-----|
| SCALE: | 1" = 40'-0" | DRAWING NO.: | C16-147-BX | CONTRACT NO.: | RH040161LE | SHEET NO.: | 142 |
|--------|-------------|--------------|------------|---------------|------------|------------|-----|

R: 1-205 AS-BUILT  
Plot Date: 3/16/2010 7:11 AM  
C16-147.dwg Jan. 27, 2010 - 12:09 PM lorts, buck  
M\_lorts, buck



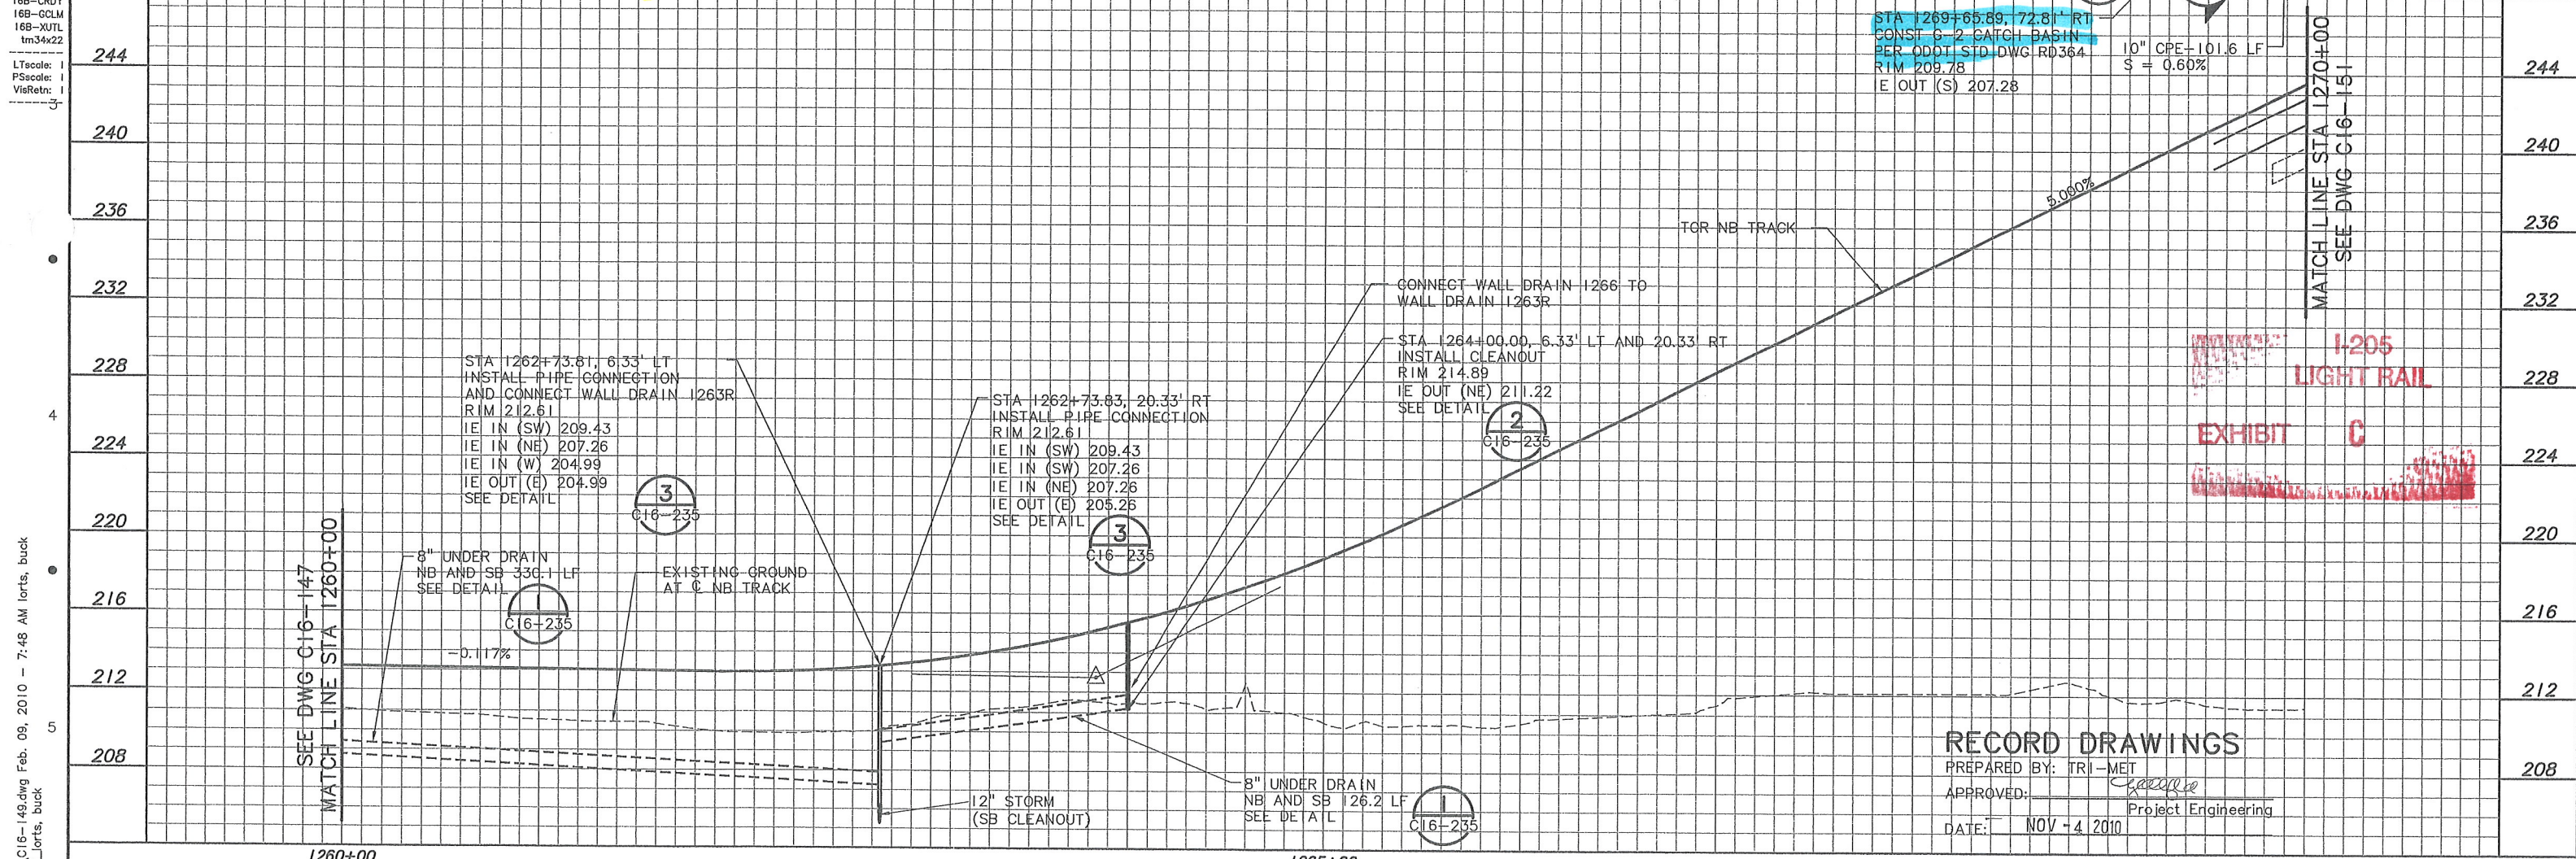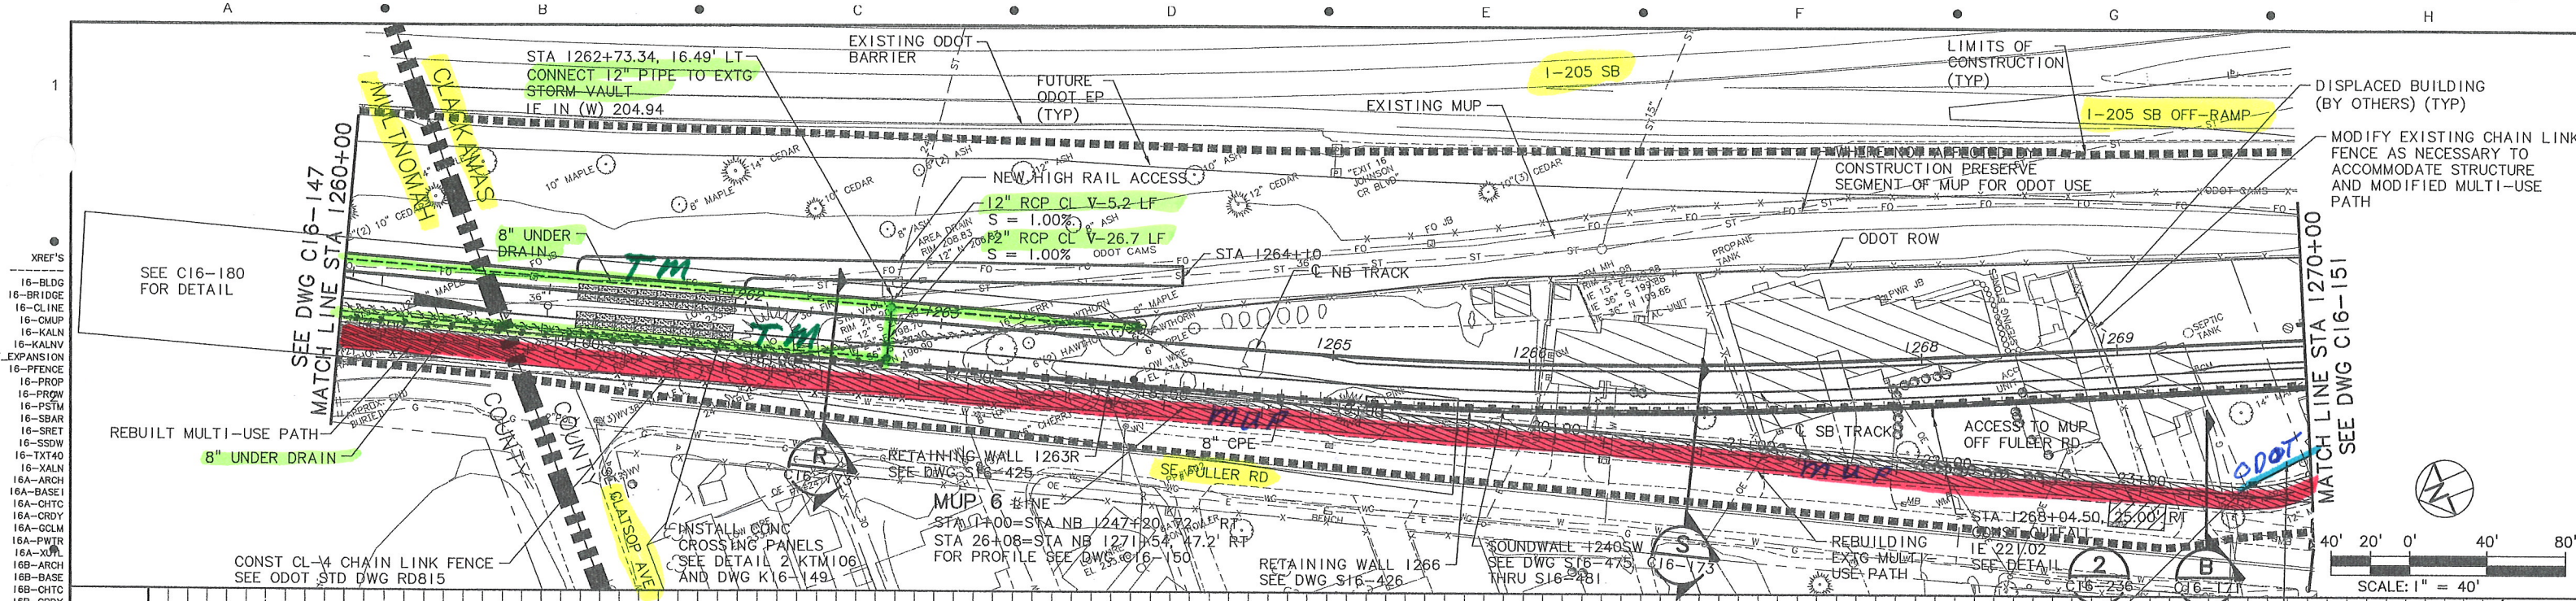

**NOTE:** THESE RECORD DRAWINGS REPRESENT THE BEST KNOWN INFORMATION ABOUT CONSTRUCTED FACILITIES. LOCATIONS SHOWN ARE NOT WARRANTED. UNDERGROUND UTILITIES MUST BE FIELD VERIFIED FOR ACTUAL LOCATION.

| NO. | DATE | BY | APPD. | REVISIONS |
|-----|------|----|-------|-----------|
|     |      |    |       |           |
|     |      |    |       |           |
|     |      |    |       |           |

|                     |                 |
|---------------------|-----------------|
| DRA/KRN<br>DESIGNED | 2-17-06<br>DATE |
| JTH<br>DRAWN        | 2-19-06<br>DATE |
| CHECKED             | DATE            |
| APPROVED            | DATE            |

**RECORD DRAWING**

**TRI-COUNTY METROPOLITAN TRANSPORTATION DISTRICT OF OREGON**

**SOUTH CORRIDOR CONSTRUCTORS**  
Stacy and Wilbeck  
GRANITE  
WILDISH

**DAVID EVANS AND ASSOCIATES INC.**  
2100 Southwest River Parkway  
Portland Oregon 97201  
Phone: 503.223.6663

**TRIOMET**

**CAPITAL PROJECTS AND FACILITIES DIVISION**  
710 N.E. HOLLADAY STREET  
PORTLAND, OREGON 97232

SUBMITTED: 12/15/06

DATE: 12/15/06

APPROVED: 12/15/06

DATE: 12/15/06

**SOUTH CORRIDOR PROJECT**  
**I-205 SEGMENT**  
**CIVIL PLAN & PROFILE**  
**STA 1260+00 TO STA 1270+00**



SCALE: 1" = 40'-0"

DRAWING NO.: C16-149-BX

CONTRACT NO.: RH040161LE

SHEET NO.: 144



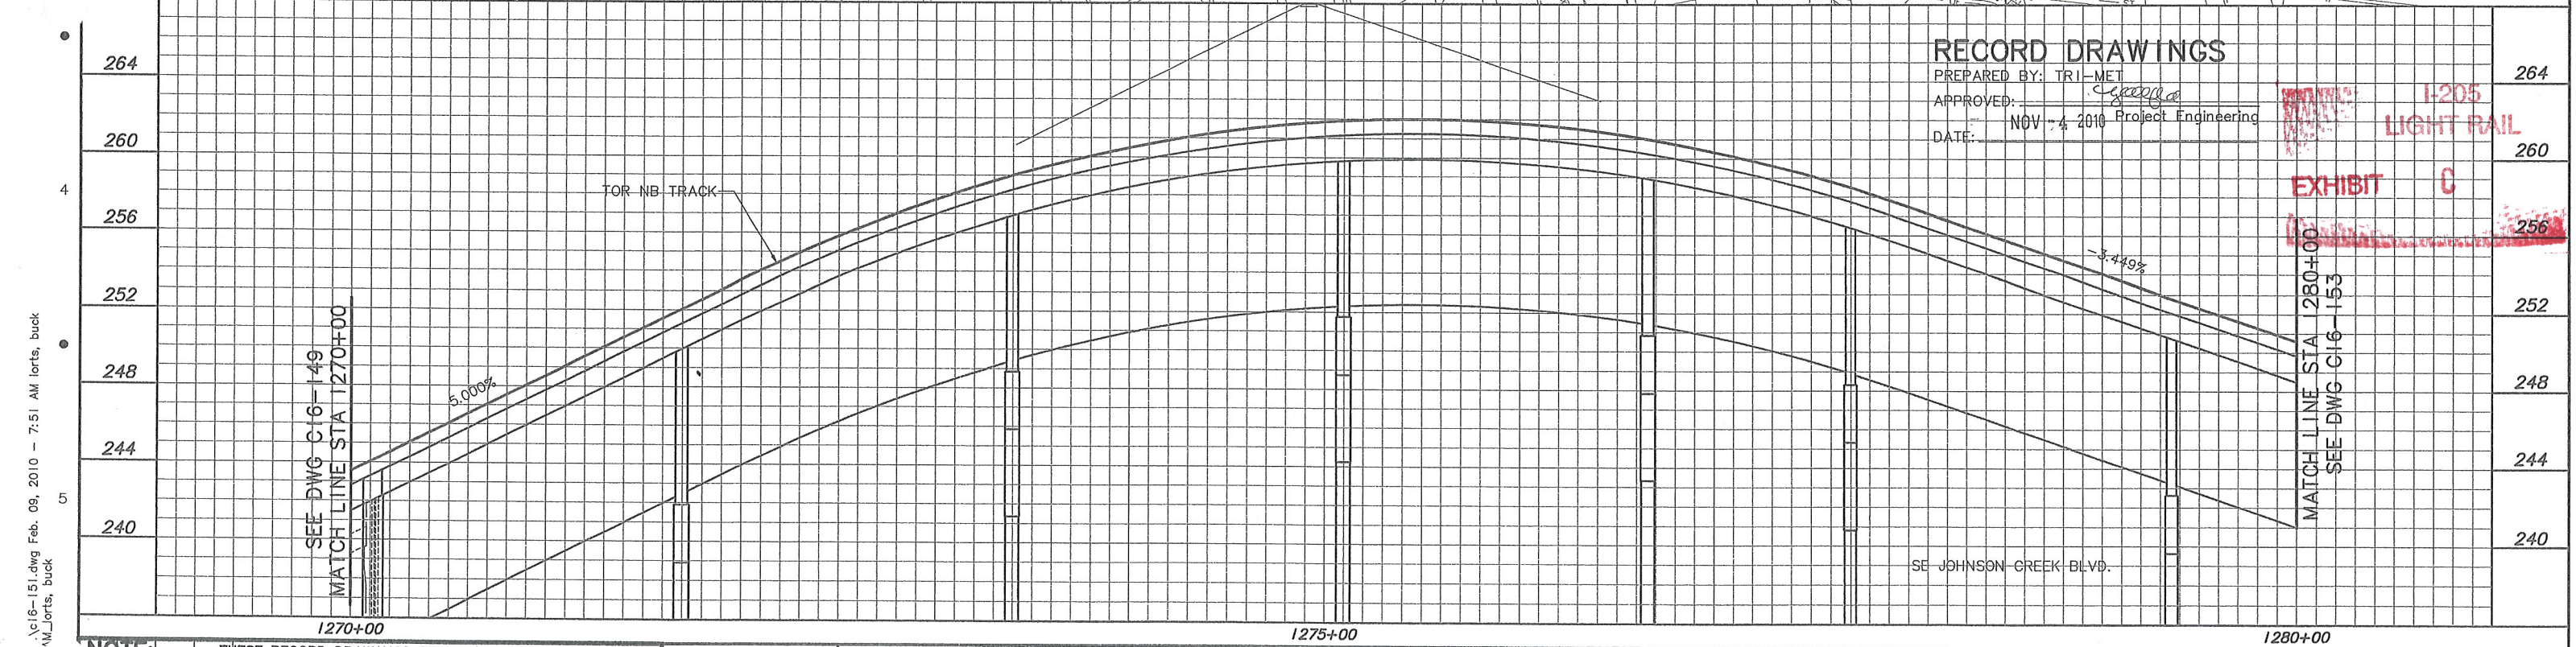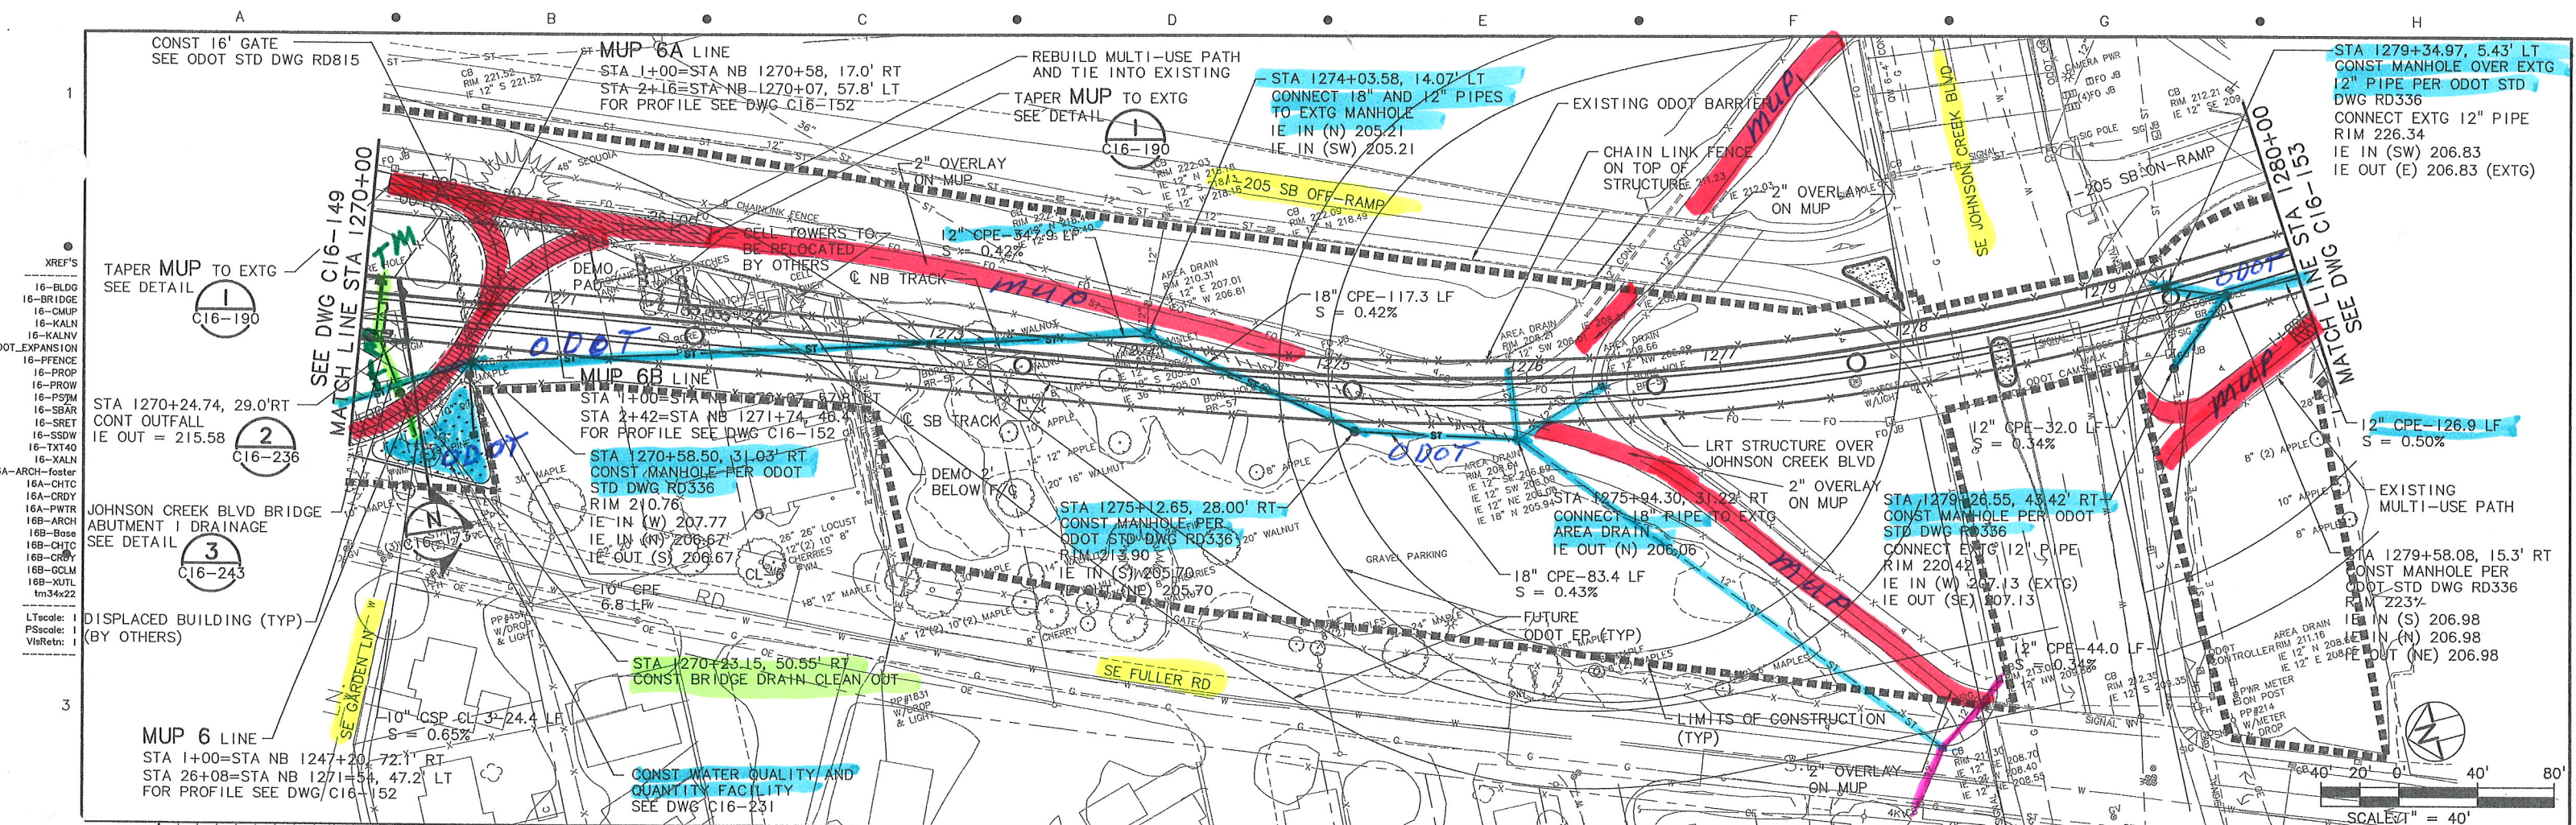

**NOTE:** THESE RECORD DRAWINGS REPRESENT THE BEST KNOWN INFORMATION ABOUT CONSTRUCTED FACILITIES. LOCATIONS SHOWN ARE NOT WARRANTED. UNDERGROUND UTILITIES MUST BE FIELD VERIFIED FOR ACTUAL LOCATION.

|     |          |     |             |           |
|-----|----------|-----|-------------|-----------|
| NO. | DATE     | BY  | APPD.       | REVISIONS |
| 1   | 12/15/06 | JTH | DAVID EVANS | 1         |
| 2   | 12/15/06 | JTH | DAVID EVANS | 2         |
| 3   | 12/15/06 | JTH | DAVID EVANS | 3         |
| 4   | 12/15/06 | JTH | DAVID EVANS | 4         |
| 5   | 12/15/06 | JTH | DAVID EVANS | 5         |
| 6   | 12/15/06 | JTH | DAVID EVANS | 6         |
| 7   | 12/15/06 | JTH | DAVID EVANS | 7         |
| 8   | 12/15/06 | JTH | DAVID EVANS | 8         |
| 9   | 12/15/06 | JTH | DAVID EVANS | 9         |
| 10  | 12/15/06 | JTH | DAVID EVANS | 10        |

**RECORD DRAWING**

**TRI-COUNTY METROPOLITAN TRANSPORTATION DISTRICT OF OREGON**

**SOUTH CORRIDOR CONSTRUCTORS**  
Stacy and Wilbeck  
GRANITE  
WILDISH

**DAVID EVANS AND ASSOCIATES INC.**  
2100 Southwest River Parkway  
Portland Oregon 97201  
Phone: 503.223.6663

**TRI-MET**  
CAPITAL PROJECTS AND FACILITIES DIVISION  
710 N.E. HOLLADAY STREET  
PORTLAND, OREGON 97232

**SOUTH CORRIDOR PROJECT**  
**I-205 SEGMENT**  
**CIVIL PLAN & PROFILE**  
**STA 1270+00 TO STA 1280+00**

**SCALE:** 1" = 40'-0"

**DRAWING NO.:** C16-151-CX

**CONTRACT NO.:** RH040161LE

**SHEET NO.:** 146