
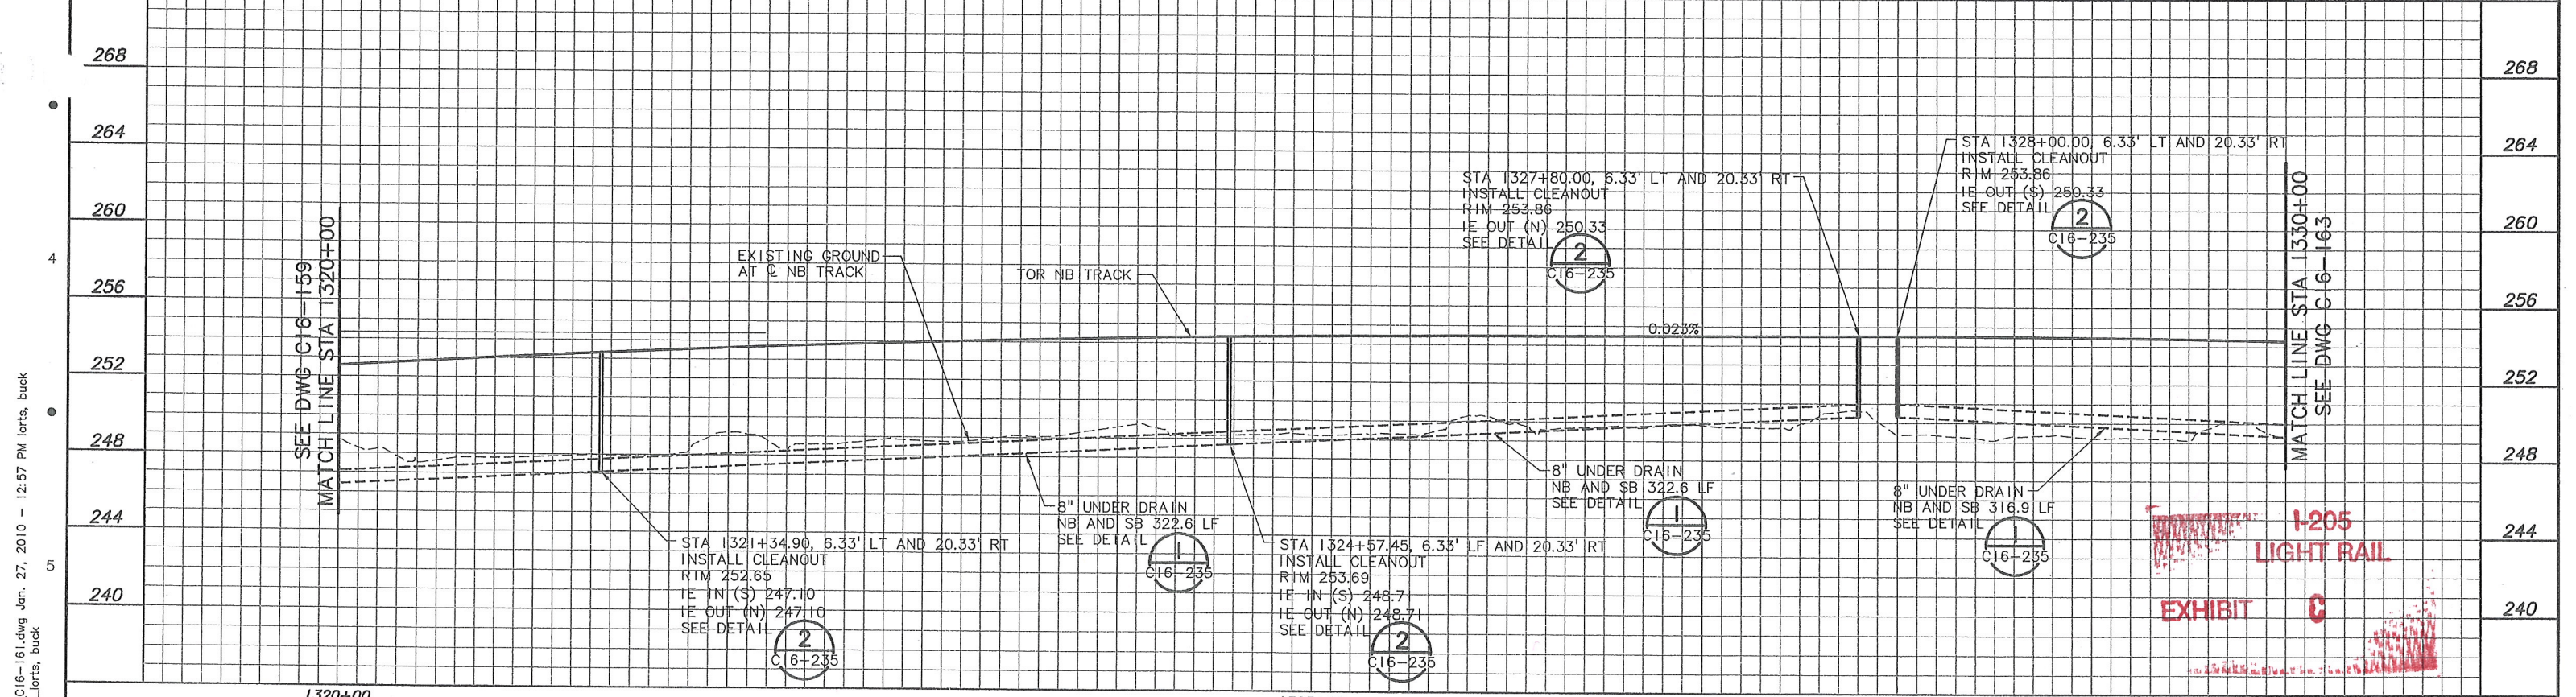


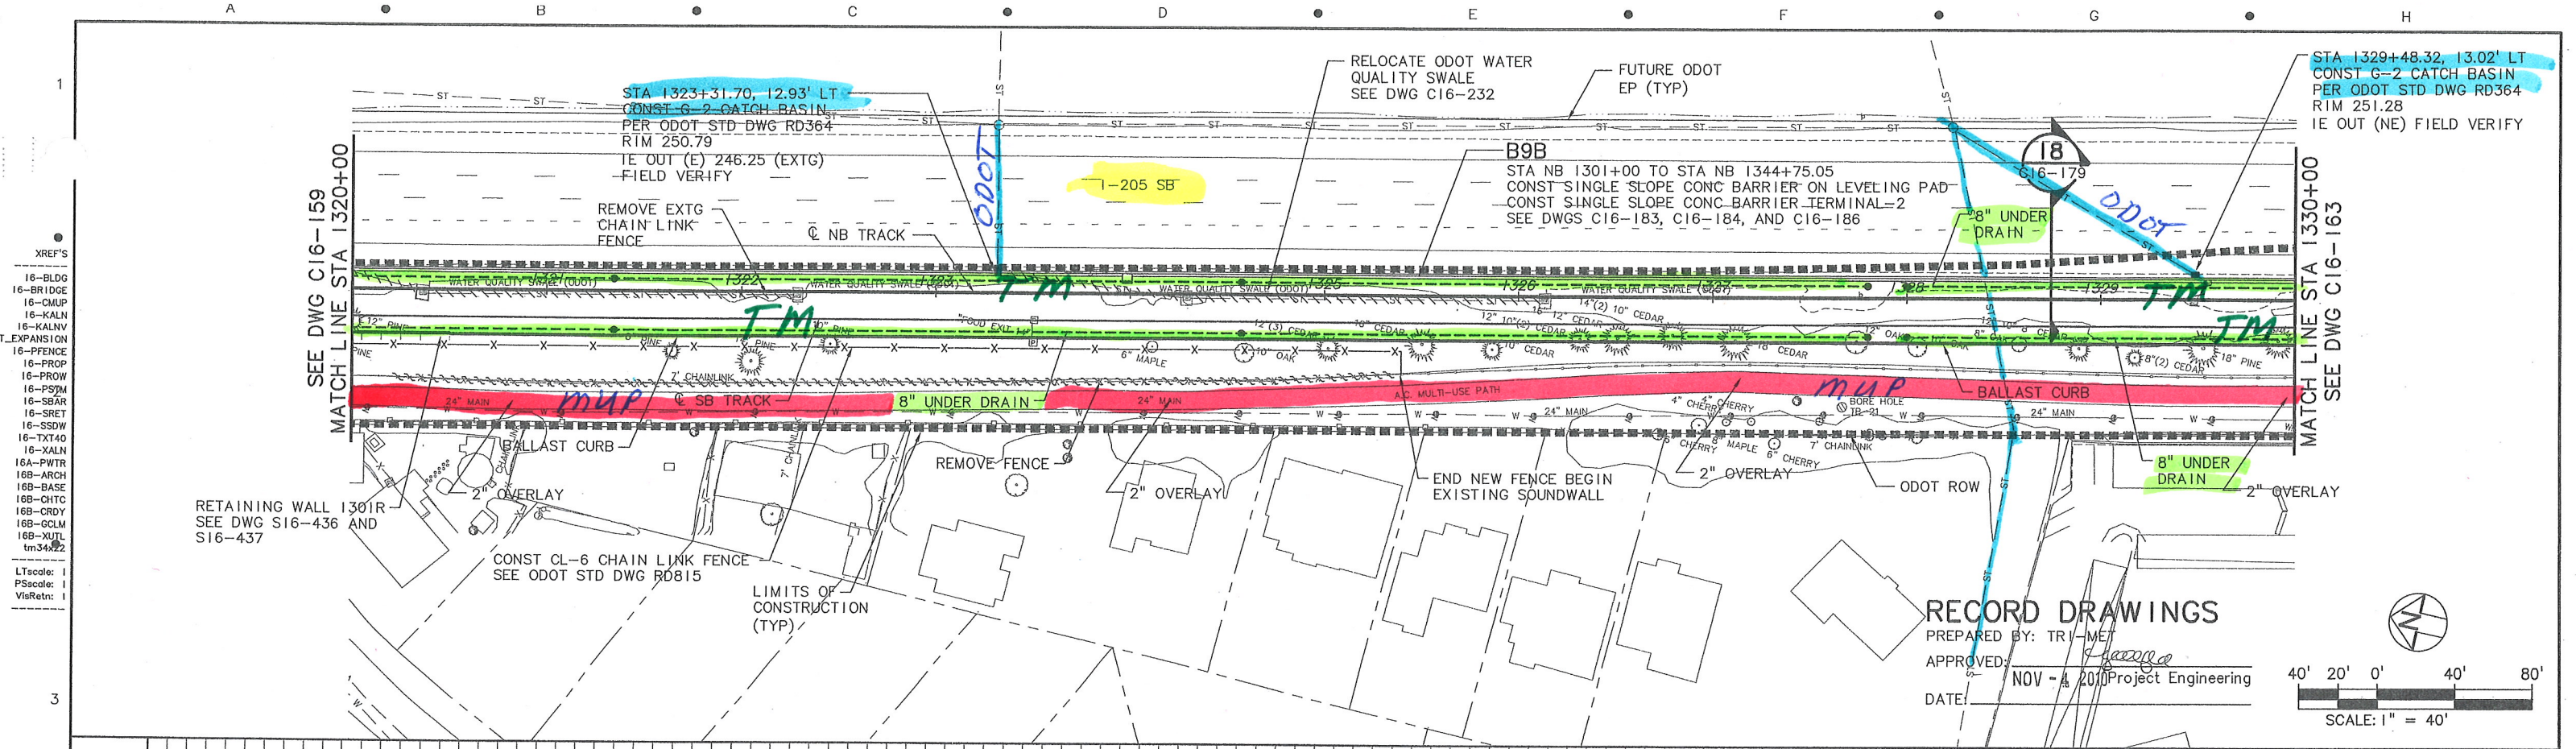

NOTE: THESE RECORD DRAWINGS REPRESENT THE BEST KNOWN INFORMATION ABOUT CONSTRUCTED FACILITIES. LOCATIONS SHOWN ARE NOT WARRANTED. UNDERGROUND UTILITIES MUST BE FIELD VERIFIED FOR ACTUAL LOCATION.

NO.	DATE	BY	APPD.	REVISIONS

DRAWN	2-17-06
DATE	2-19-06
CHECKED	DATE
APPROVED	DATE

RECORD DRAWING

TRI-COUNTY METROPOLITAN TRANSPORTATION DISTRICT OF OREGON

SOUTH CORRIDOR CONSTRUCTORS
Stacy and Witbeck
GRANITE
WILDISH

DAVID EVANS AND ASSOCIATES INC.
2100 Southwest River Parkway
Portland Oregon 97201
Phone: 503.223.6663



TRIOMET
CAPITAL PROJECTS AND FACILITIES DIVISION
710 N.E. HOLLADAY STREET
PORTLAND, OREGON 97232

SUBMITTED: DATE: 12/15/06 APPROVED: DATE: 12/15/06

SOUTH CORRIDOR PROJECT
I-205 SEGMENT
CIVIL PLAN & PROFILE
STA 1320+00 TO STA 1330+00

SCALE: 1" = 40'-0" DRAWING NO.: C16-161 CONTRACT NO.: RH040161LE SHEET NO.: 156

R:\I-205 AS-BUILT\I-205 AS-BUILT.dwg Jan. 27, 2010 - 12:57 PM lorts, buck
Plot Date: 3/16/2010 9:30 AM lorts, buck

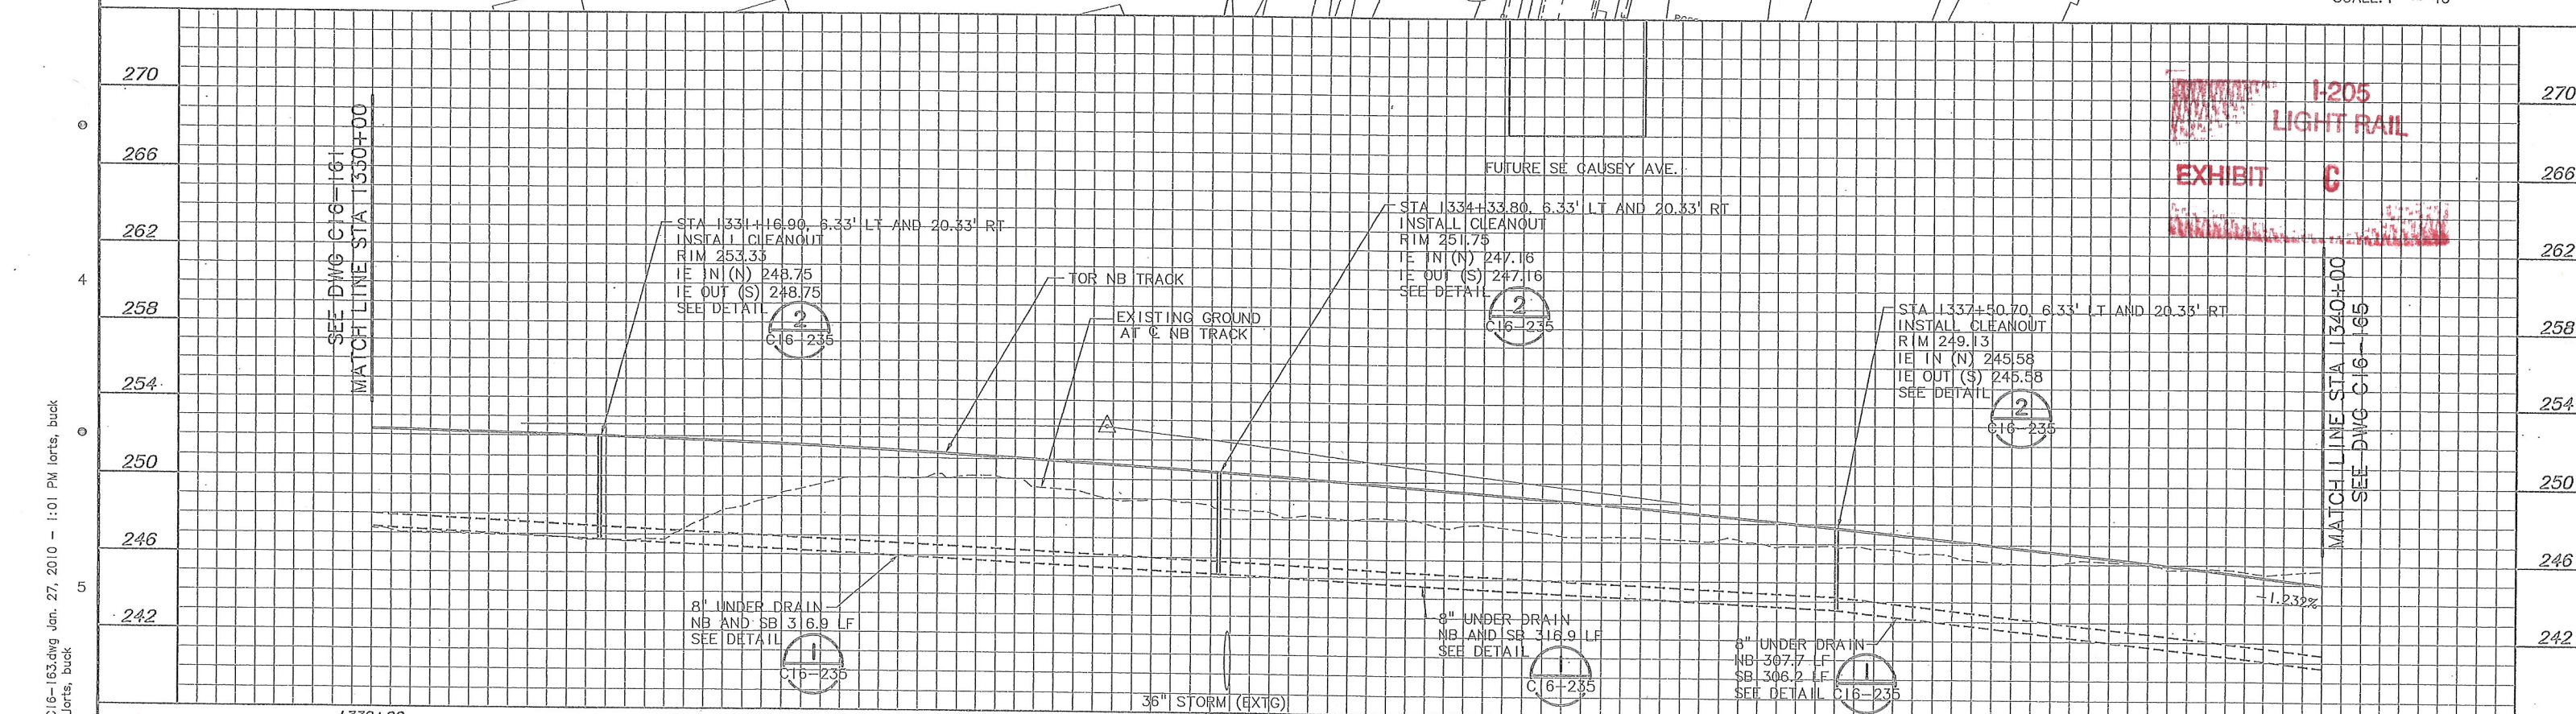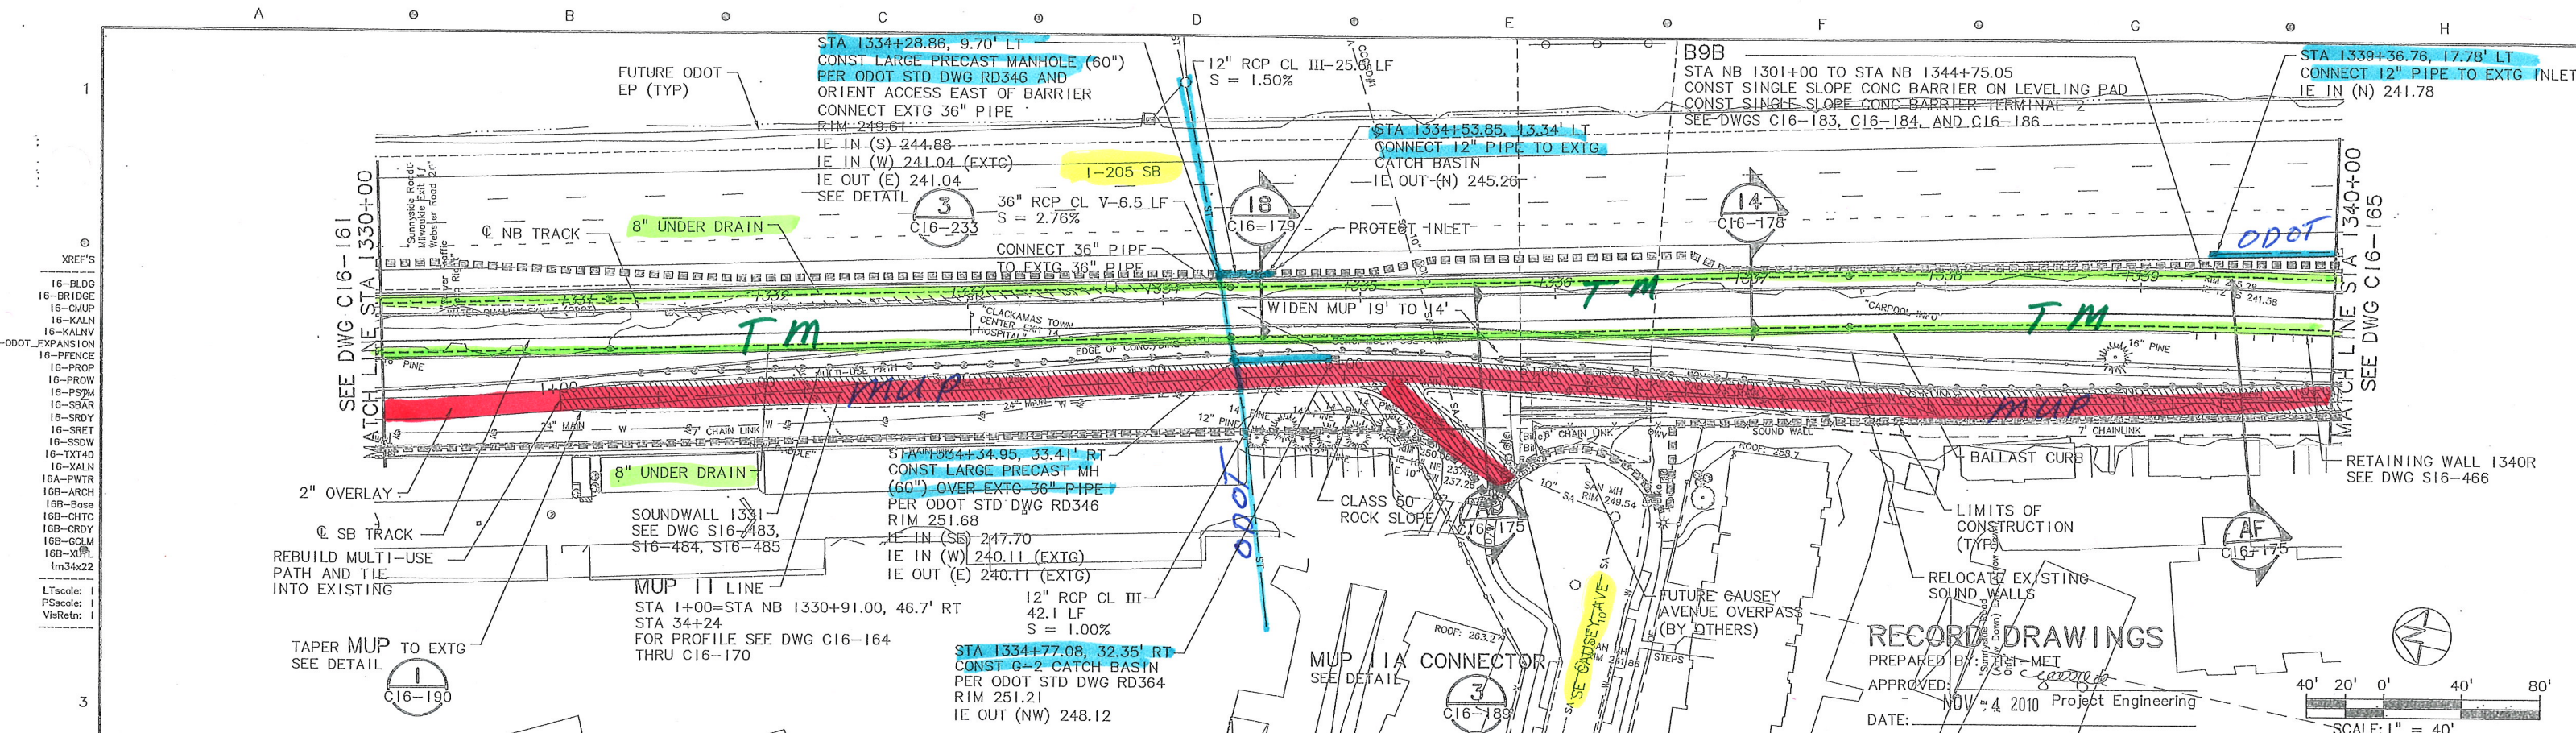

NOTE: THESE RECORD DRAWINGS REPRESENT THE BEST KNOWN INFORMATION ABOUT CONSTRUCTED FACILITIES. LOCATIONS SHOWN ARE NOT WARRANTED. UNDERGROUND UTILITIES MUST BE FIELD VERIFIED FOR ACTUAL LOCATION.

NO.	DATE	BY	CHK.	APPD.	REVISIONS

DESIGNED	DATE
DRA/KRN	2-17-06
JTH	2-19-06
STDR	12-11-06
SBM	12-12-06

TRI-COUNTY METROPOLITAN TRANSPORTATION DISTRICT OF OREGON

SOUTH CORRIDOR CONSTRUCTORS
Stacy and Wilcox
GRANITE
WILDISH


DAVID EVANS AND ASSOCIATES INC.
2100 Southwest River Parkway
Portland Oregon 97201
Phone: 503.223.6663

TRIOMET


CAPITAL PROJECTS AND FACILITIES DIVISION
710 N.E. HOLLADAY STREET
PORTLAND, OREGON 97232

SOUTH CORRIDOR PROJECT
I-205 SEGMENT
CIVIL PLAN & PROFILE
STA 1330+00 TO STA 1340+00


SCALE:	DRAWING NO.:	CONTRACT NO.:	SHEET NO.:
1" = 40'-0"	C16-163-BX	RH040161LE	157

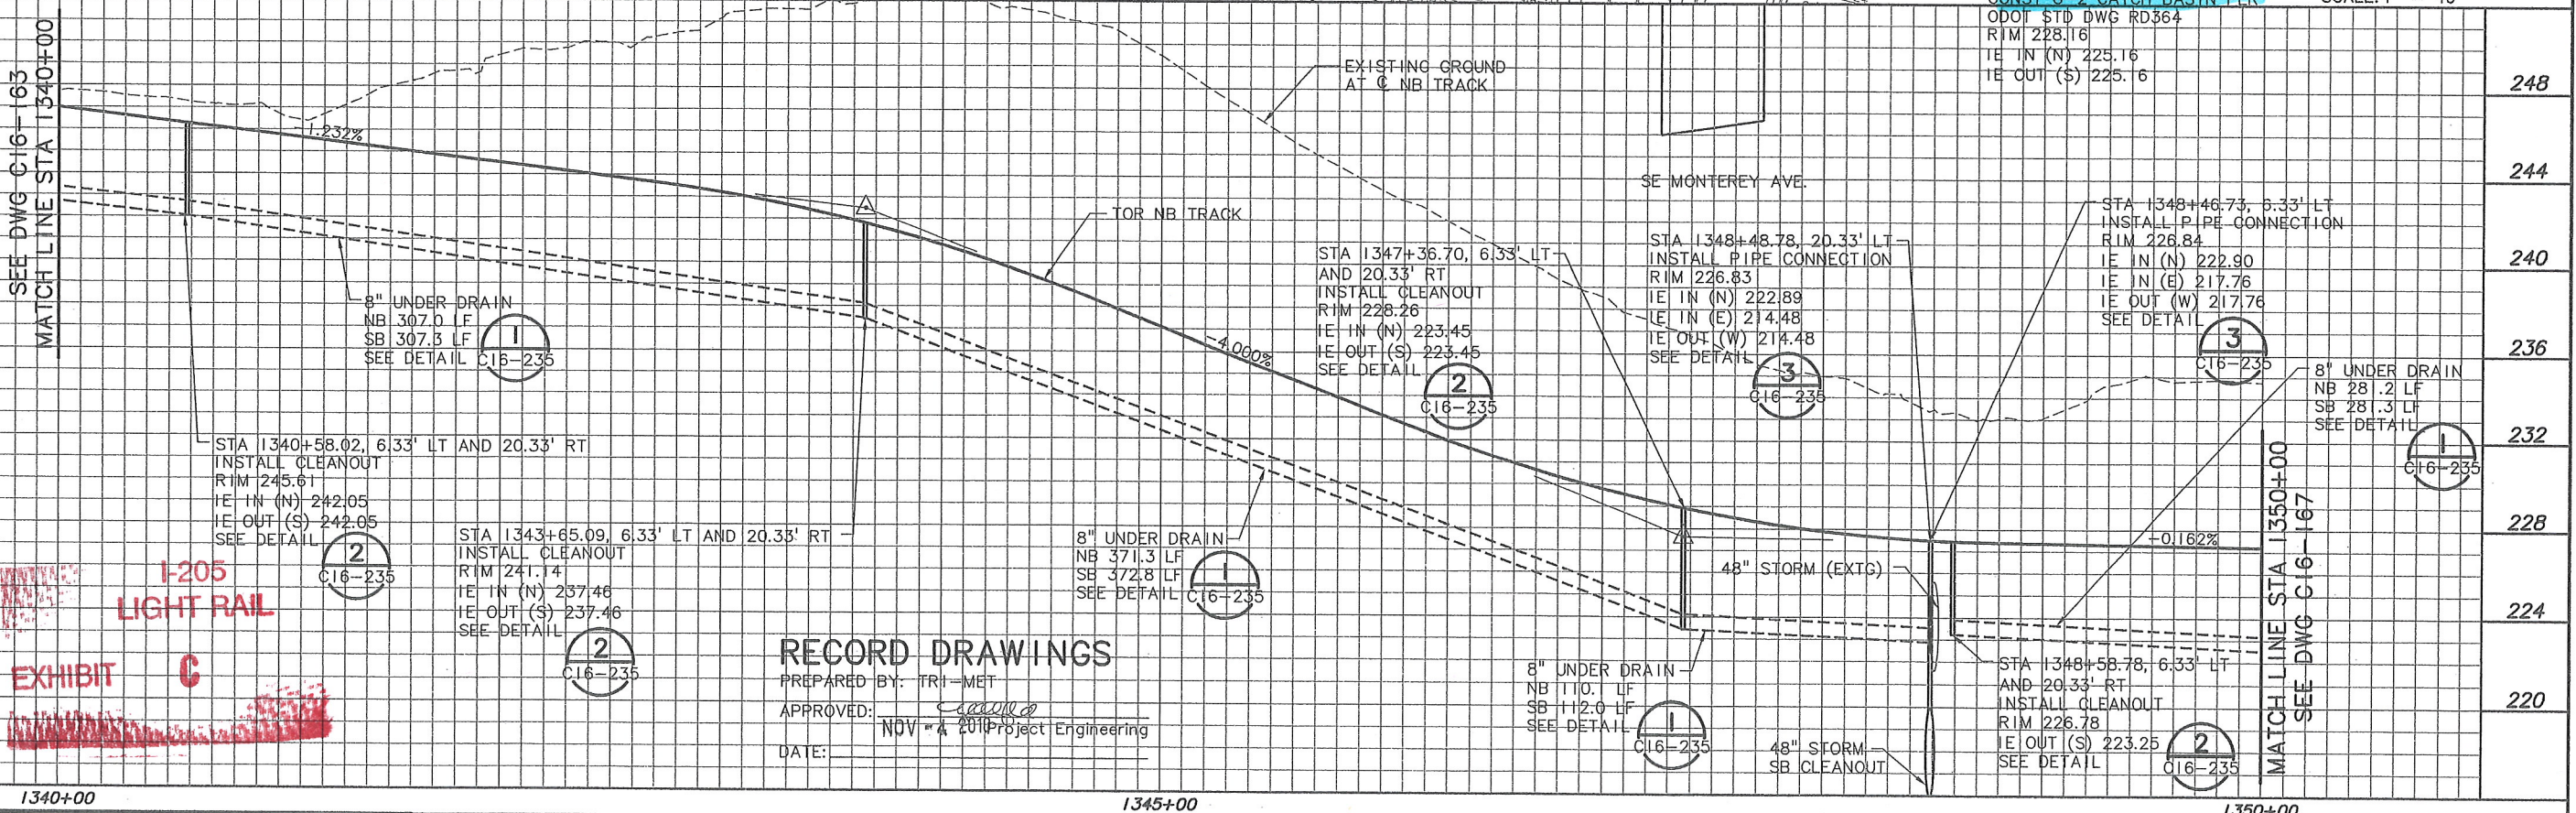


SCALE: 1" = 40'-0"	DRAWING NO.: C16-165-CX	CONTRACT NO.: RH040161LE	SHEET NO.: 158
-----------------------	----------------------------	-----------------------------	-------------------

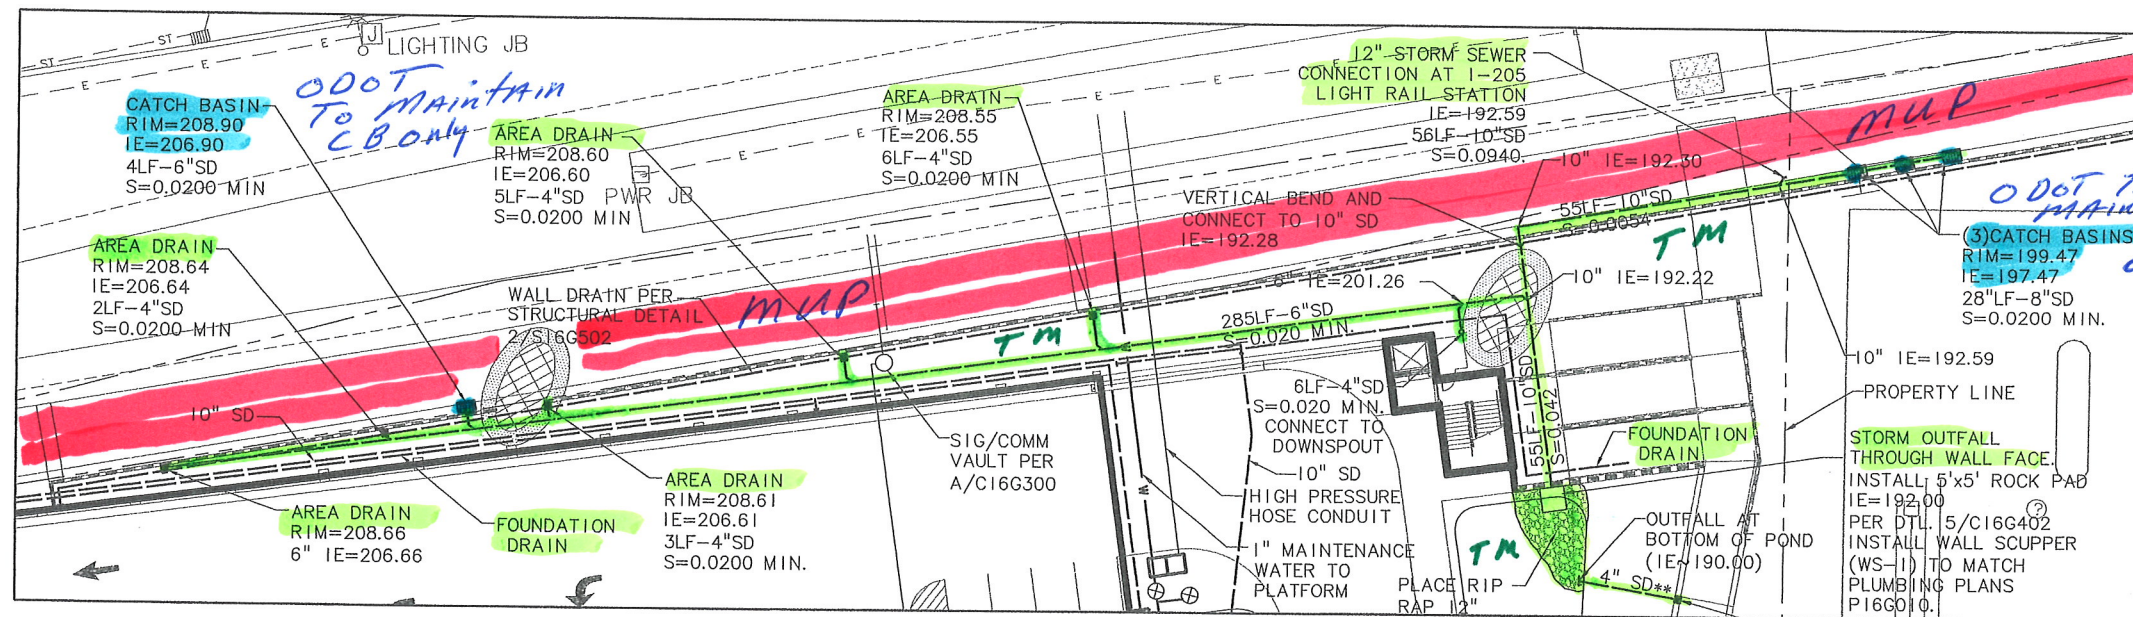


ENLARGED UTILITY DETAIL **B**
SCALE: 1" = 20'
C16G300

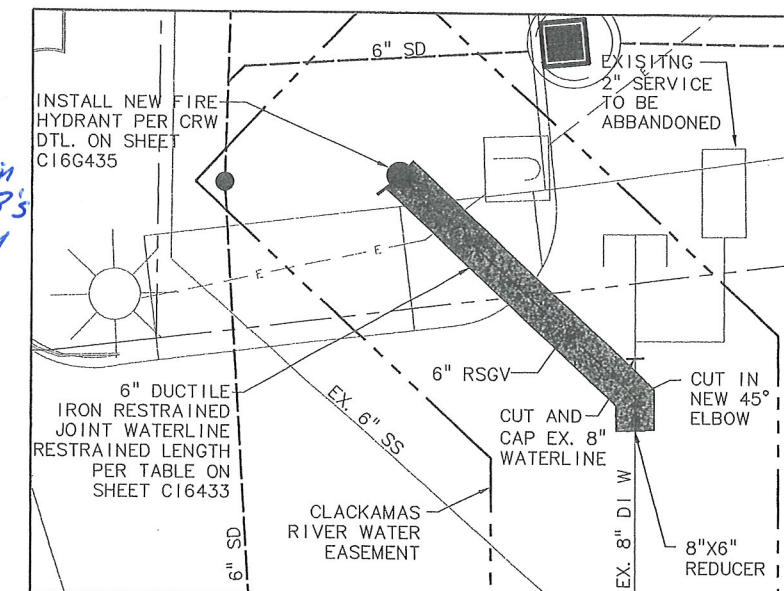

ENLARGED UTILITY DETAIL **D**
SCALE: 1" = 5'
C16G300

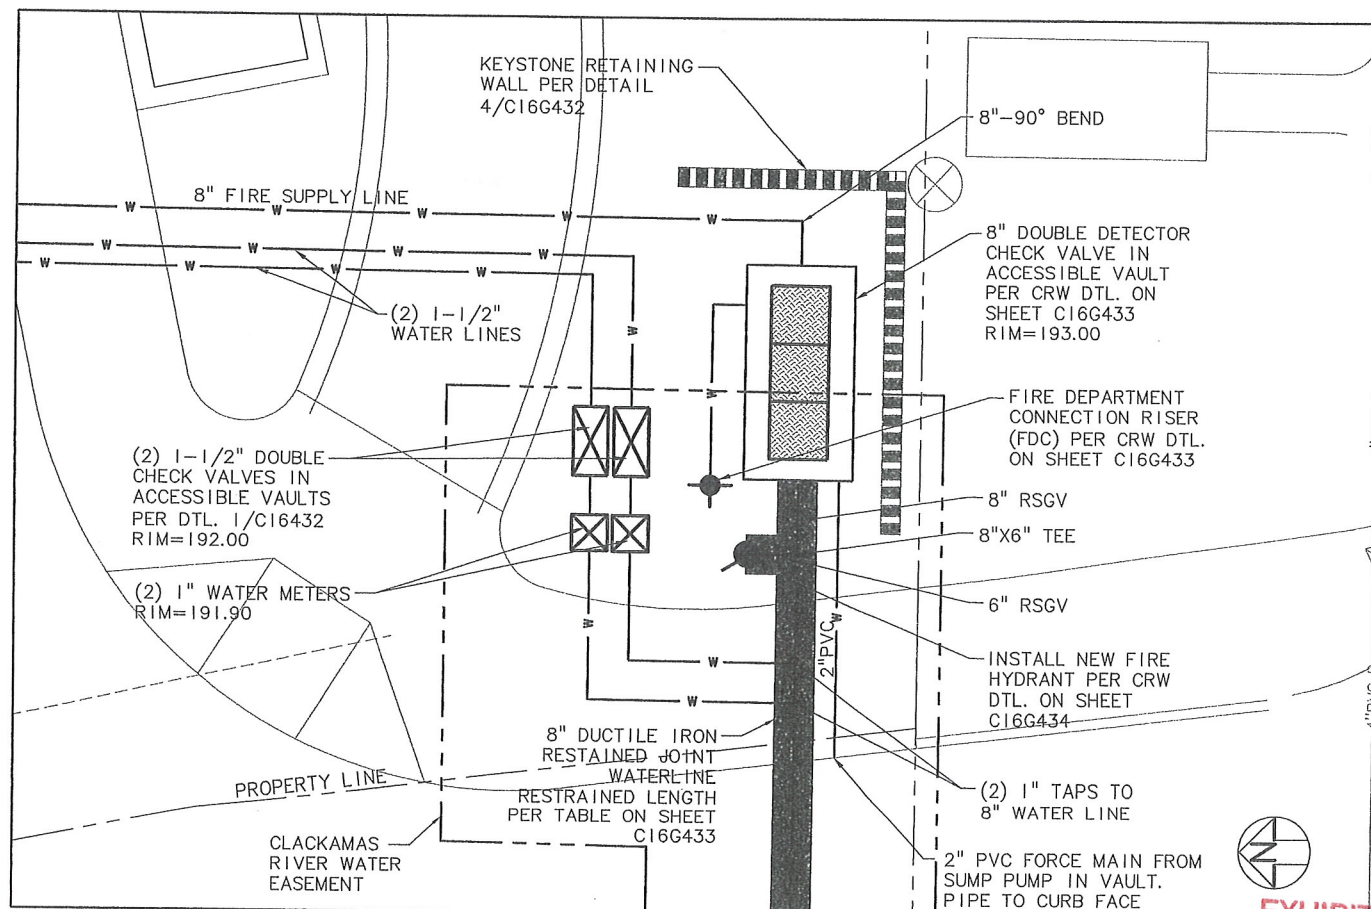

ENLARGED UTILITY DETAIL **C**
SCALE: 1" = 5'
C16G300

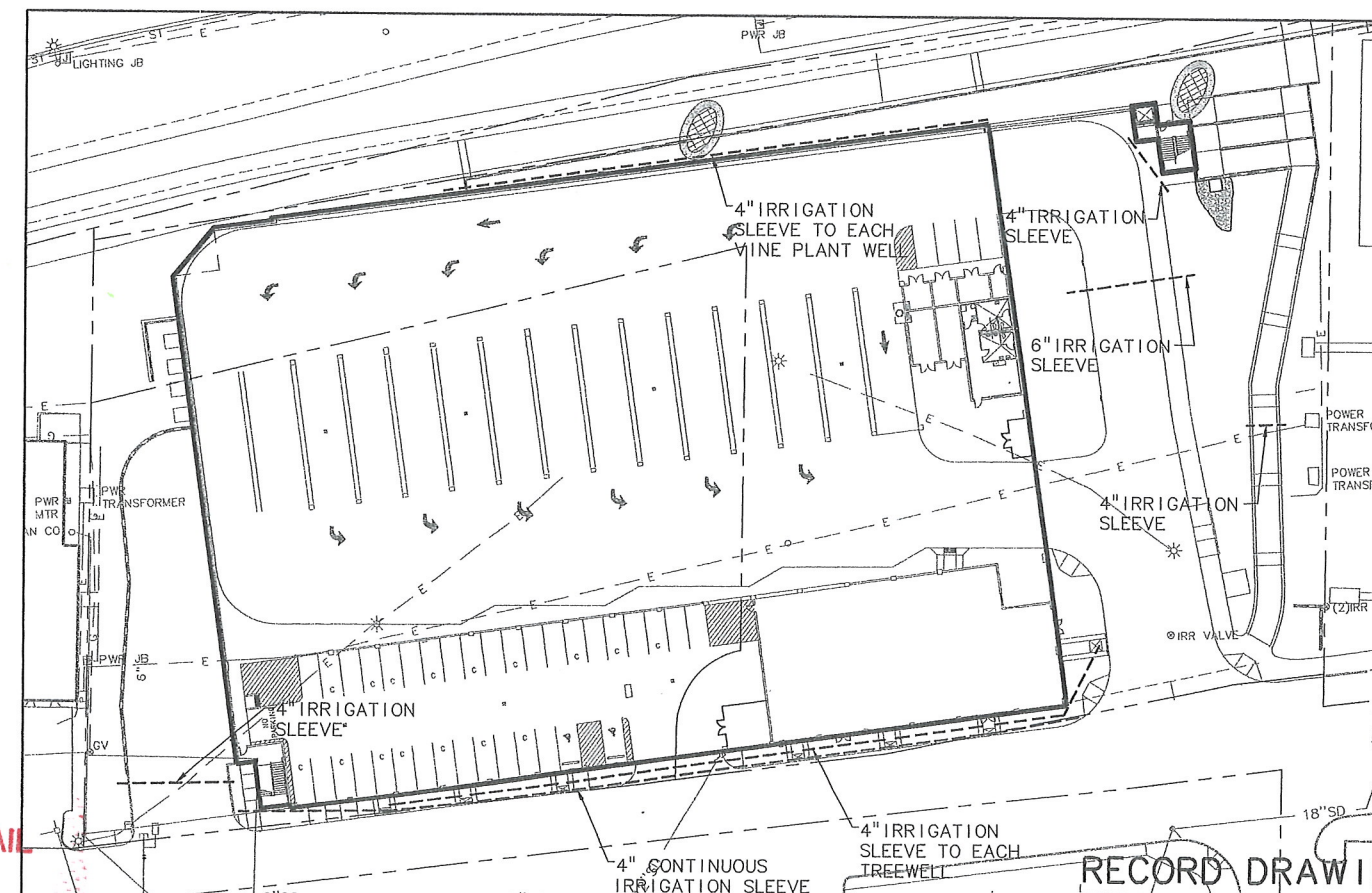

IRRIGATION SLEEVE PLAN **C**
SCALE: 1" = 40'
C16G301


RECORD DRAWINGS
PREPARED BY: TRI-MET
APPROVED: *[Signature]*
DATE: 2/25/07
Project Engineering

NOTE: THESE RECORD DRAWINGS REPRESENT THE BEST KNOWN INFORMATION ABOUT CONSTRUCTED FACILITIES. LOCATIONS SHOWN ARE NOT WARRANTED. UNDERGROUND UTILITIES MUST BE FIELD VERIFIED FOR ACTUAL LOCATION.

RECORD DRAWING

NO.	DATE	BY	APPD.	REVISIONS
		CHK.		

MSW DESIGNED	10-22-07
JMS DRAWN	10-22-07
FG CHECKED	10-29-07
MSW APPROVED	11-2-07

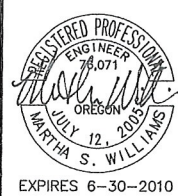

TRI-COUNTY METROPOLITAN TRANSPORTATION DISTRICT OF OREGON



104 West 9th Street
Suite 207
Vancouver, WA 98660
www.mghassociates.com

P: 360.750.0399 (WA)
F: 503.417.8639 (OR)
F: 360.750.0433





CAPITAL PROJECTS
AND
FACILITIES DIVISION
710 N.E. HOLLADAY STREET
PORTLAND, OREGON 97232

SUBMITTED: *[Signature]* DATE: 11-2-07

APPROVED: *[Signature]* DATE: 11-2-07

SOUTH CORRIDOR PROJECT
I-205 SEGMENT
CLACKAMAS TOWN CENTER GARAGE
ENLARGED UTILITY PLANS

SCALE: AS NOTED	DRAWING NO.: C16G301-H	CONTRACT NO.: RH070156BW	SHEET NO.: 10
-----------------	------------------------	--------------------------	---------------

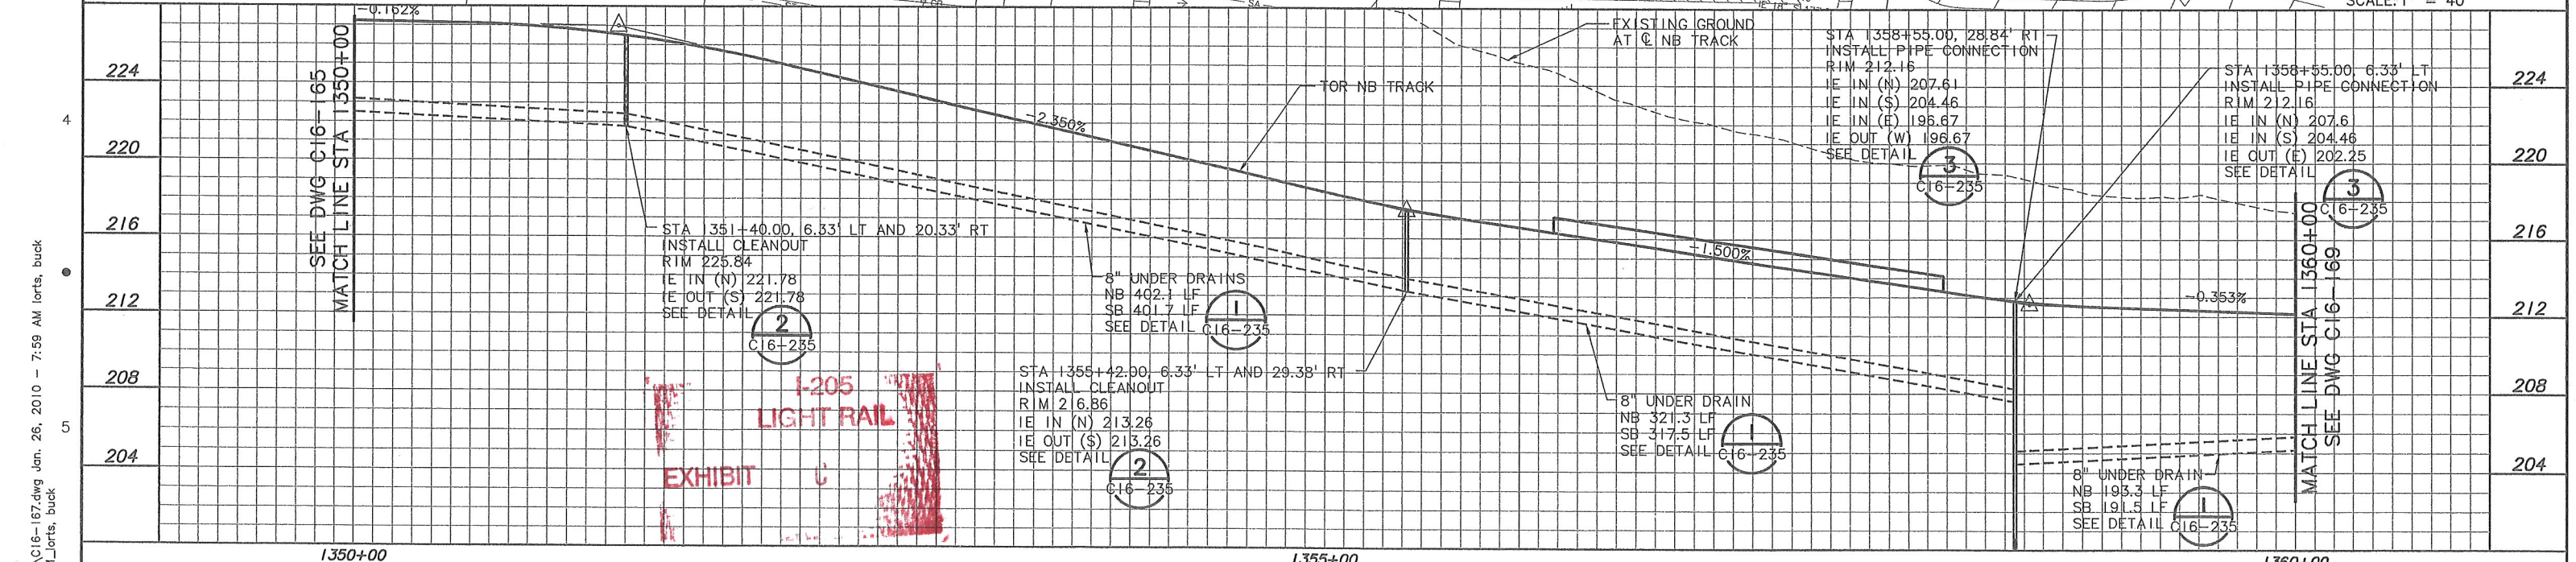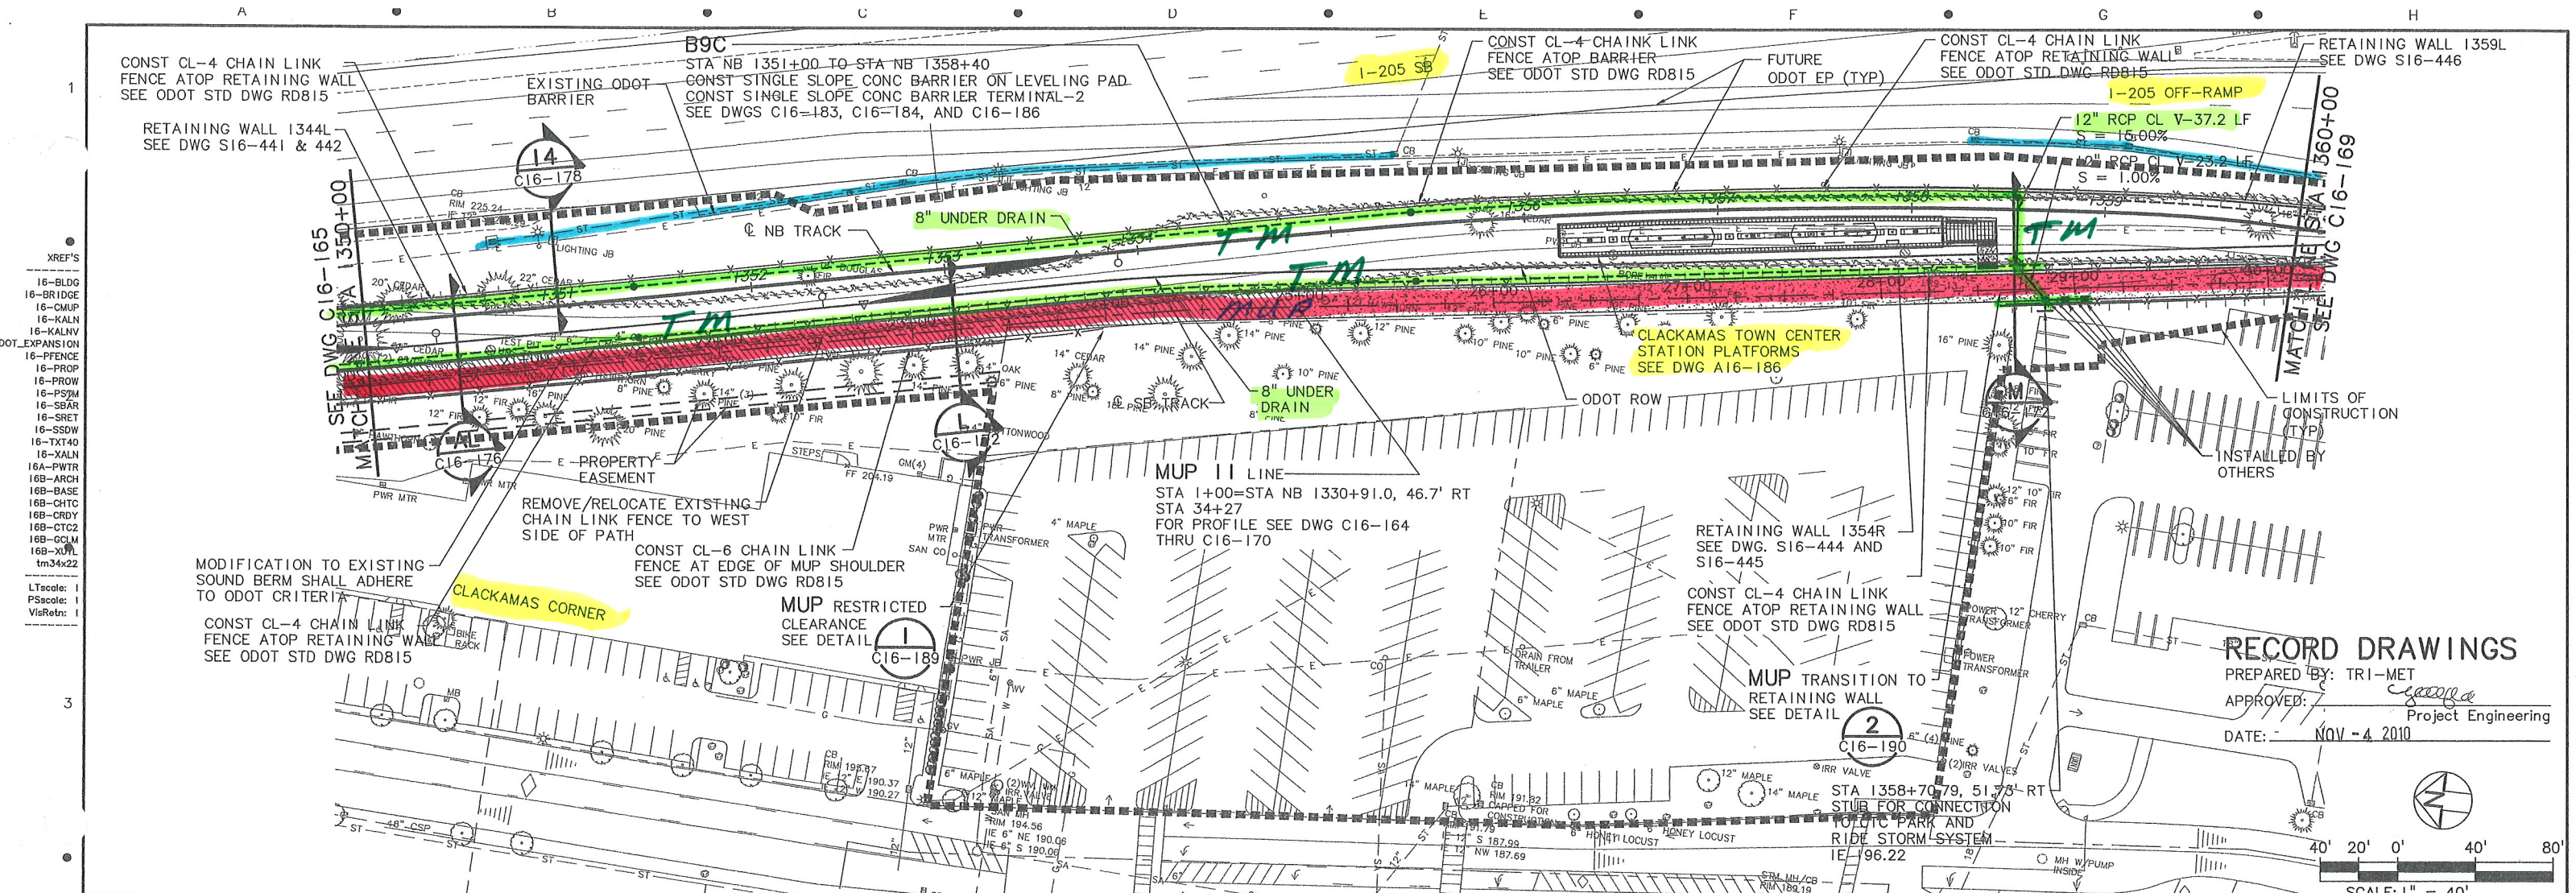

NOTE: THESE RECORD DRAWINGS REPRESENT THE BEST KNOWN INFORMATION ABOUT CONSTRUCTED FACILITIES. LOCATIONS SHOWN ARE NOT WARRANTED. UNDERGROUND UTILITIES MUST BE FIELD VERIFIED FOR ACTUAL LOCATION.

NO.	DATE	BY	APPD.	REVISIONS

DRAWN	DATE
JTH	2-19-06
STDR	12-11-06
SBM	12-12-06

TRI-COUNTY METROPOLITAN TRANSPORTATION DISTRICT OF OREGON

SOUTH CORRIDOR CONSTRUCTORS
Stacy and Wilbeck
GRANITE
WILDISH

DAVID EVANS AND ASSOCIATES INC.
2100 Southwest River Parkway
Portland Oregon 97201
Phone: 503.223.6663

TRI-MET
CAPITAL PROJECTS AND FACILITIES DIVISION
710 N.E. HOLLADAY STREET
PORTLAND, OREGON 97232


SOUTH CORRIDOR PROJECT
I-205 SEGMENT
CIVIL PLAN & PROFILE
STA 1350+00 TO STA 1360+00

SCALE: 1" = 40'-0"



DRAWING NO.: C16-167-AX

CONTRACT NO.: RH040161LE

SHEET NO.: 160

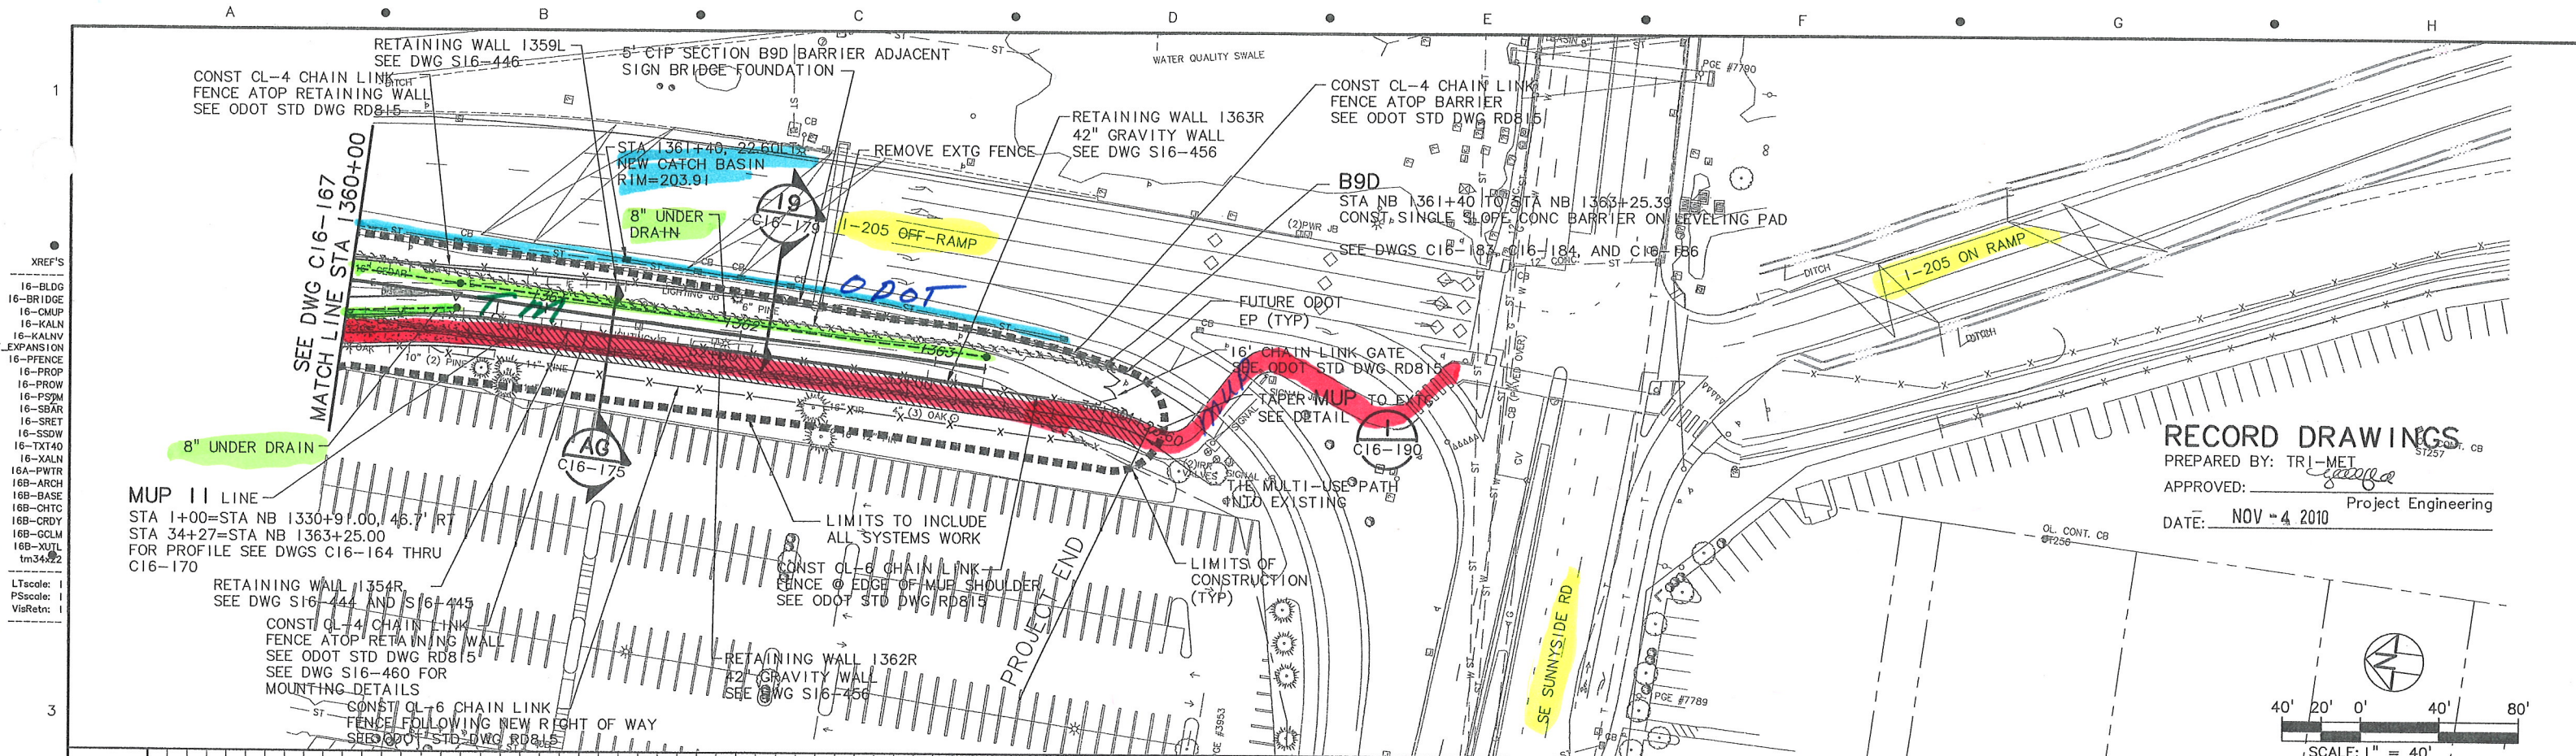

RECORD DRAWINGS
PREPARED BY: TRI-MET
APPROVED: *[Signature]*
Project Engineering
DATE: NOV -4 2010

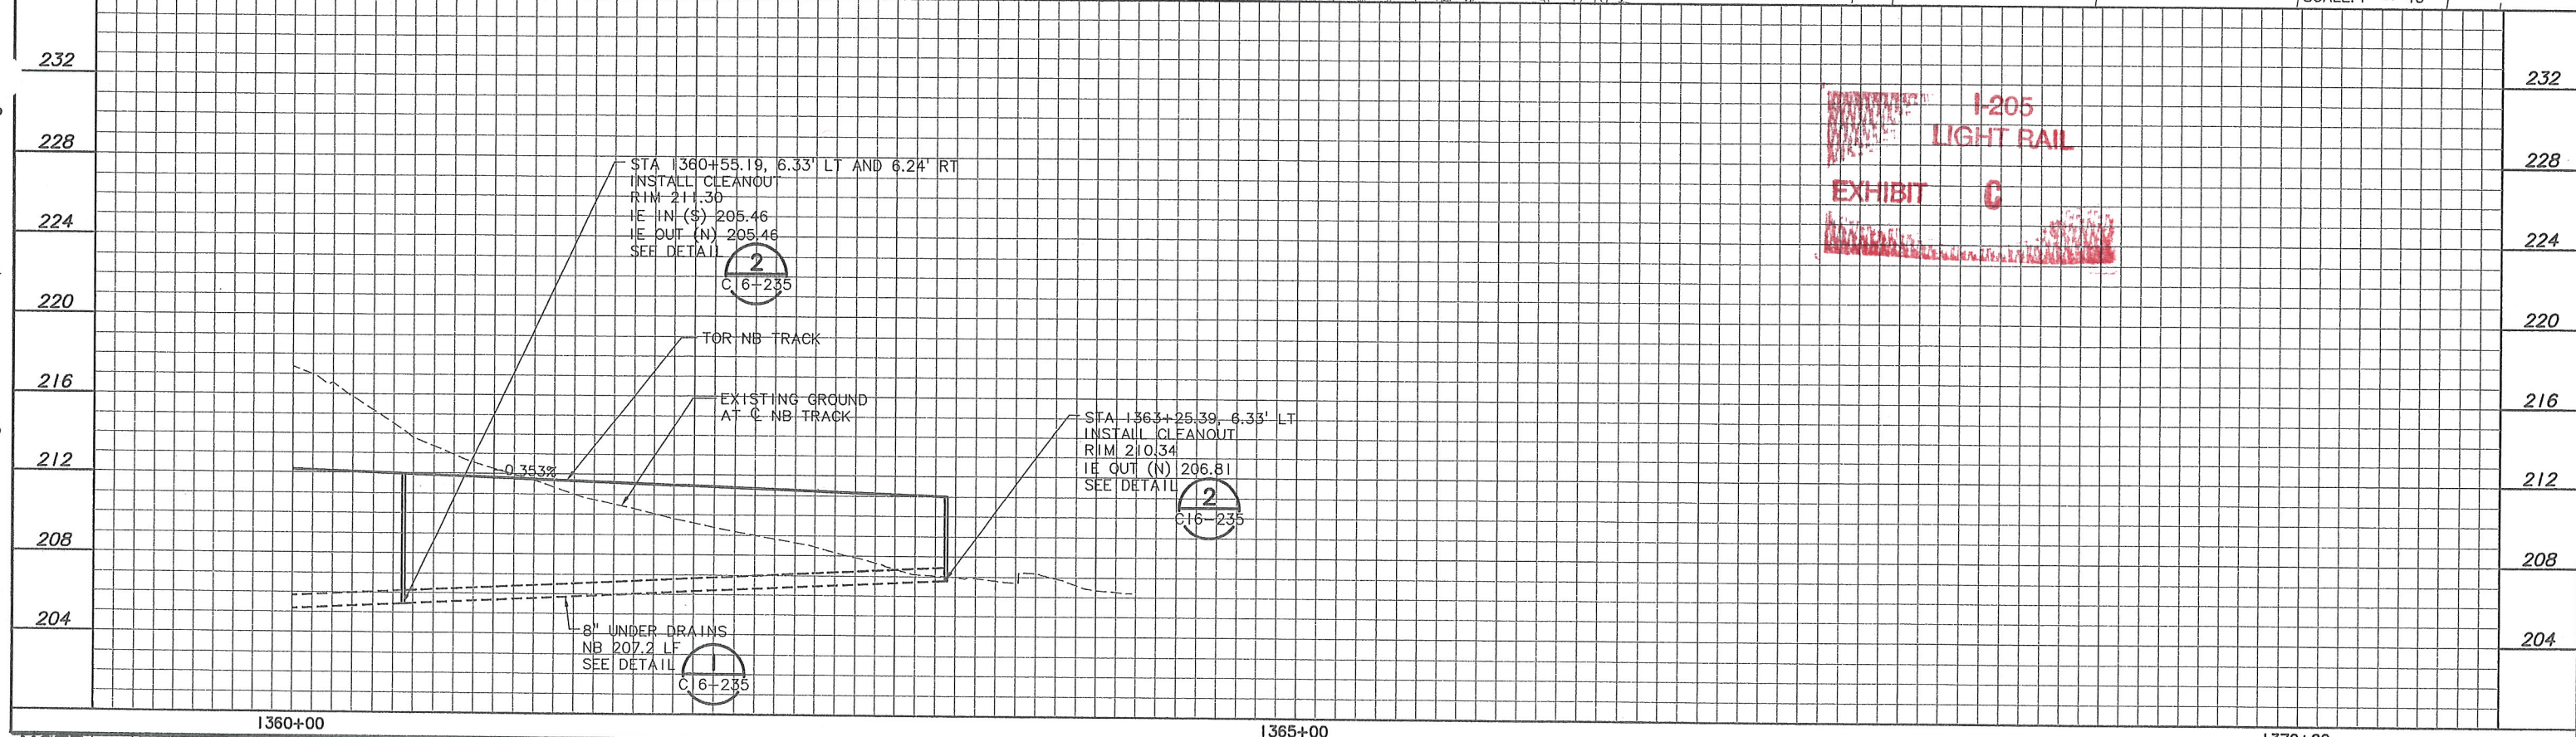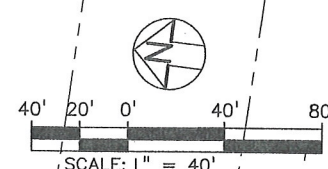

NOTE: THESE RECORD DRAWINGS REPRESENT THE BEST KNOWN INFORMATION ABOUT CONSTRUCTED FACILITIES. LOCATIONS SHOWN ARE NOT WARRANTED. UNDERGROUND UTILITIES MUST BE FIELD VERIFIED FOR ACTUAL LOCATION.

NO.	DATE	BY	CHK.	APPD.	REVISIONS

DRA/KN	2-17-06
DESIGNED	DATE
JTH	2-19-06
DRAWN	DATE
CHECKED	DATE
APPROVED	DATE

TRI-COUNTY METROPOLITAN TRANSPORTATION DISTRICT OF OREGON

SOUTH CORRIDOR CONSTRUCTORS
Stacy and Wilbeck
GRANITE
WILDISH

DAVID EVANS AND ASSOCIATES INC.
2100 Southwest River Parkway
Portland Oregon 97201
Phone: 503.223.6663

TRI-MET
CAPITAL PROJECTS
AND
FACILITIES DIVISION
710 N.E. HOLLADAY STREET
PORTLAND, OREGON 97232

SOUTH CORRIDOR PROJECT
I-205 SEGMENT
CIVIL PLAN & PROFILE
STA 1360+00 TO STA 1370+00

SCALE: 1" = 40'-0"

DRAWING NO.: C16-169-AX

CONTRACT NO.: RH040161LE

SHEET NO.: 162