



SEE DWG E16-254
MATCH LINE STA 1070+00

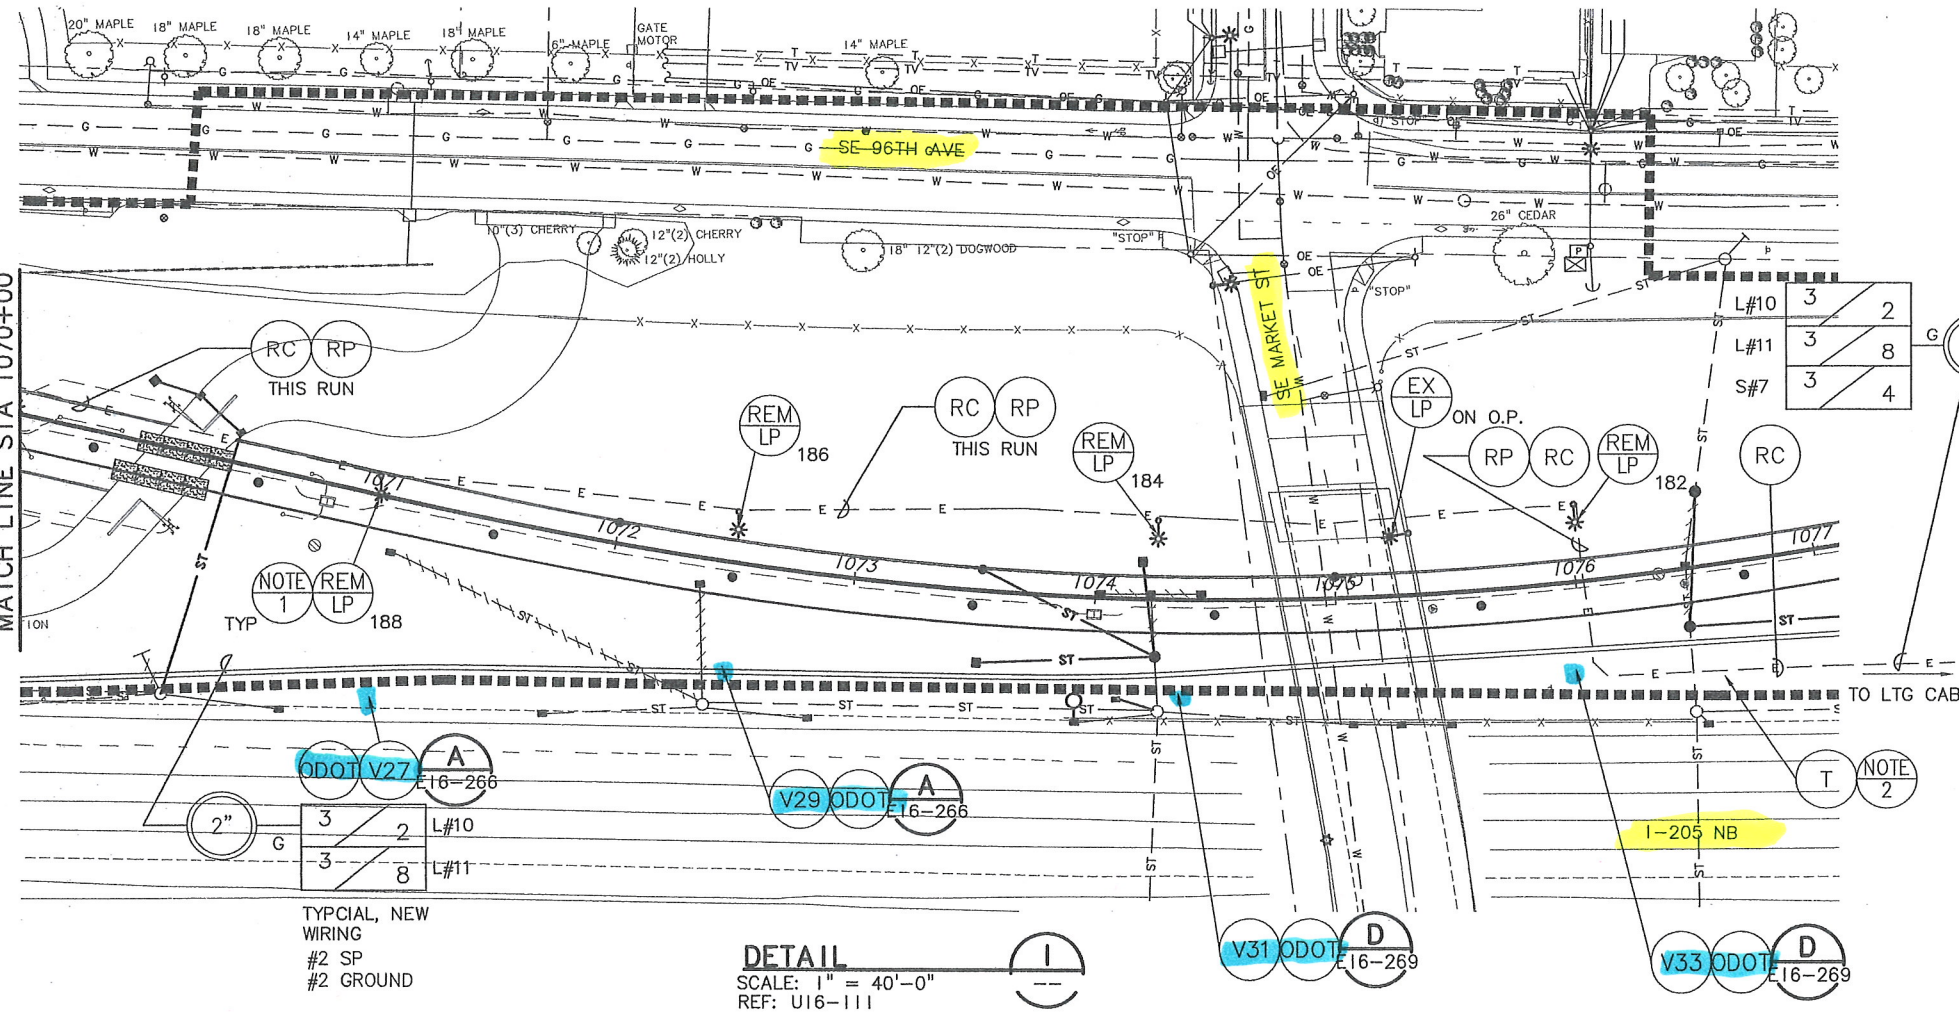

NOTES

1. AT POLES TO BE REMOVED, REMOVE ASSOCIATED WIRING. REMOVE OR ABANDON ASSOCIATED CONDUITS.
2. AS TRANSITION, PROVIDE JUNCTION BOX 24" x 18" x 12" DEEP. CONCRETE APRON.
3. J-BOX AT EVERY POLE

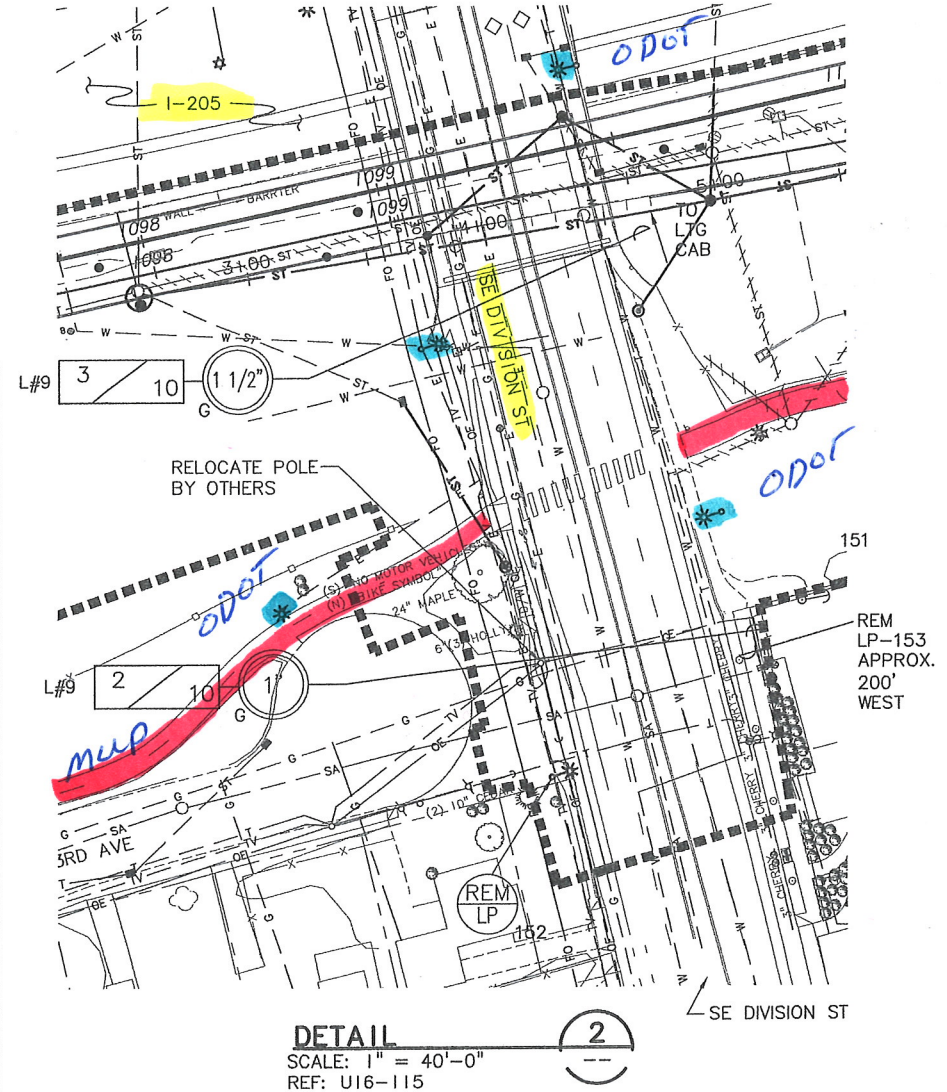

RECORD DRAWINGS

PREPARED BY: TRI-MET

APPROVED: *[Signature]* Project Engineering

DATE: NOV -5 2010

I-205
LIGHT RAIL

EXHIBIT D

40' 20' 0' 40' 80'
SCALE: 1" = 40'

NOTE: THESE RECORD DRAWINGS REPRESENT THE BEST KNOWN INFORMATION ABOUT CONSTRUCTED FACILITIES. LOCATIONS SHOWN ARE NOT WARRANTED. UNDERGROUND UTILITIES MUST BE FIELD VERIFIED FOR ACTUAL LOCATION.

RECORD DRAWING

NO.	DATE	BY	APPD.	REVISIONS

MVD DESIGNED	10-19-06
RTG DRAWN	5-31-06
CHECKED	DATE
APPROVED	DATE



TRI-COUNTY METROPOLITAN TRANSPORTATION DISTRICT OF OREGON

SOUTH CORRIDOR CONSTRUCTORS
Stacy and Wilbeck
GRANITE WILDISH

EPSILON ENGINEERING, INC.
BEAVERTON, OR
503-526-1000

TRI-MET

CAPITAL PROJECTS AND FACILITIES DIVISION
710 N.E. HOLLADAY STREET
PORTLAND, OREGON 97232


SUBMITTED:	DATE:	APPROVED:	DATE:
	12/15/06		12/15/06

SOUTH CORRIDOR PROJECT
I-205 SEGMENT
ODOT LIGHT POLE RELOCATION
STA 1070+00 TO STA 1100+00

SCALE: 1" = 40'-0"	DRAWING NO.: E16-255-AX	CONTRACT NO.: RH040161LE	SHEET NO.: 178
--------------------	-------------------------	--------------------------	----------------

NOTES:

1. REUSE EXISTING ABANDONED TWIN ARM VALENCIA STYLE LUMINAIRES WITH 2-150W-HPS LAMPS. CONTRACTOR TO REMOVE EXISTING LUMINAIRES FROM PARKROSE TRANSIT CENTER AS DIRECTED BY THE RESIDENT ENGINEER. REPAINT AFTER INSTALLATION SAME FINISH AS DIRECTED BY THE RESIDENT ENGINEER.
2. FOR LUMINAIRE SCHEDULE, REFER TO DRAWING E16-217.
3. NOT USED
4. REFER TO ARCHITECTURAL DRAWINGS FOR EXACT LOCATIONS OF LUMINAIRES.
5. REFER TO E16-113 FOR HANDHOLDS AND CONDUITS INTERFACE. BACK TO PLATFORM ELEC./COMM. CABINET.
6. REMOVE AND REINSTALL MUP LIGHTING CIRCUIT TO EXISTING MUP CIRCUIT ON NORTH SIDE OF DIVISION STREET WITH 2#10 AND 1#10 GND IN 1" C
7. NOT USED
8. ALIGN LUMINAIRE WITH CENTER OF STAIRS.

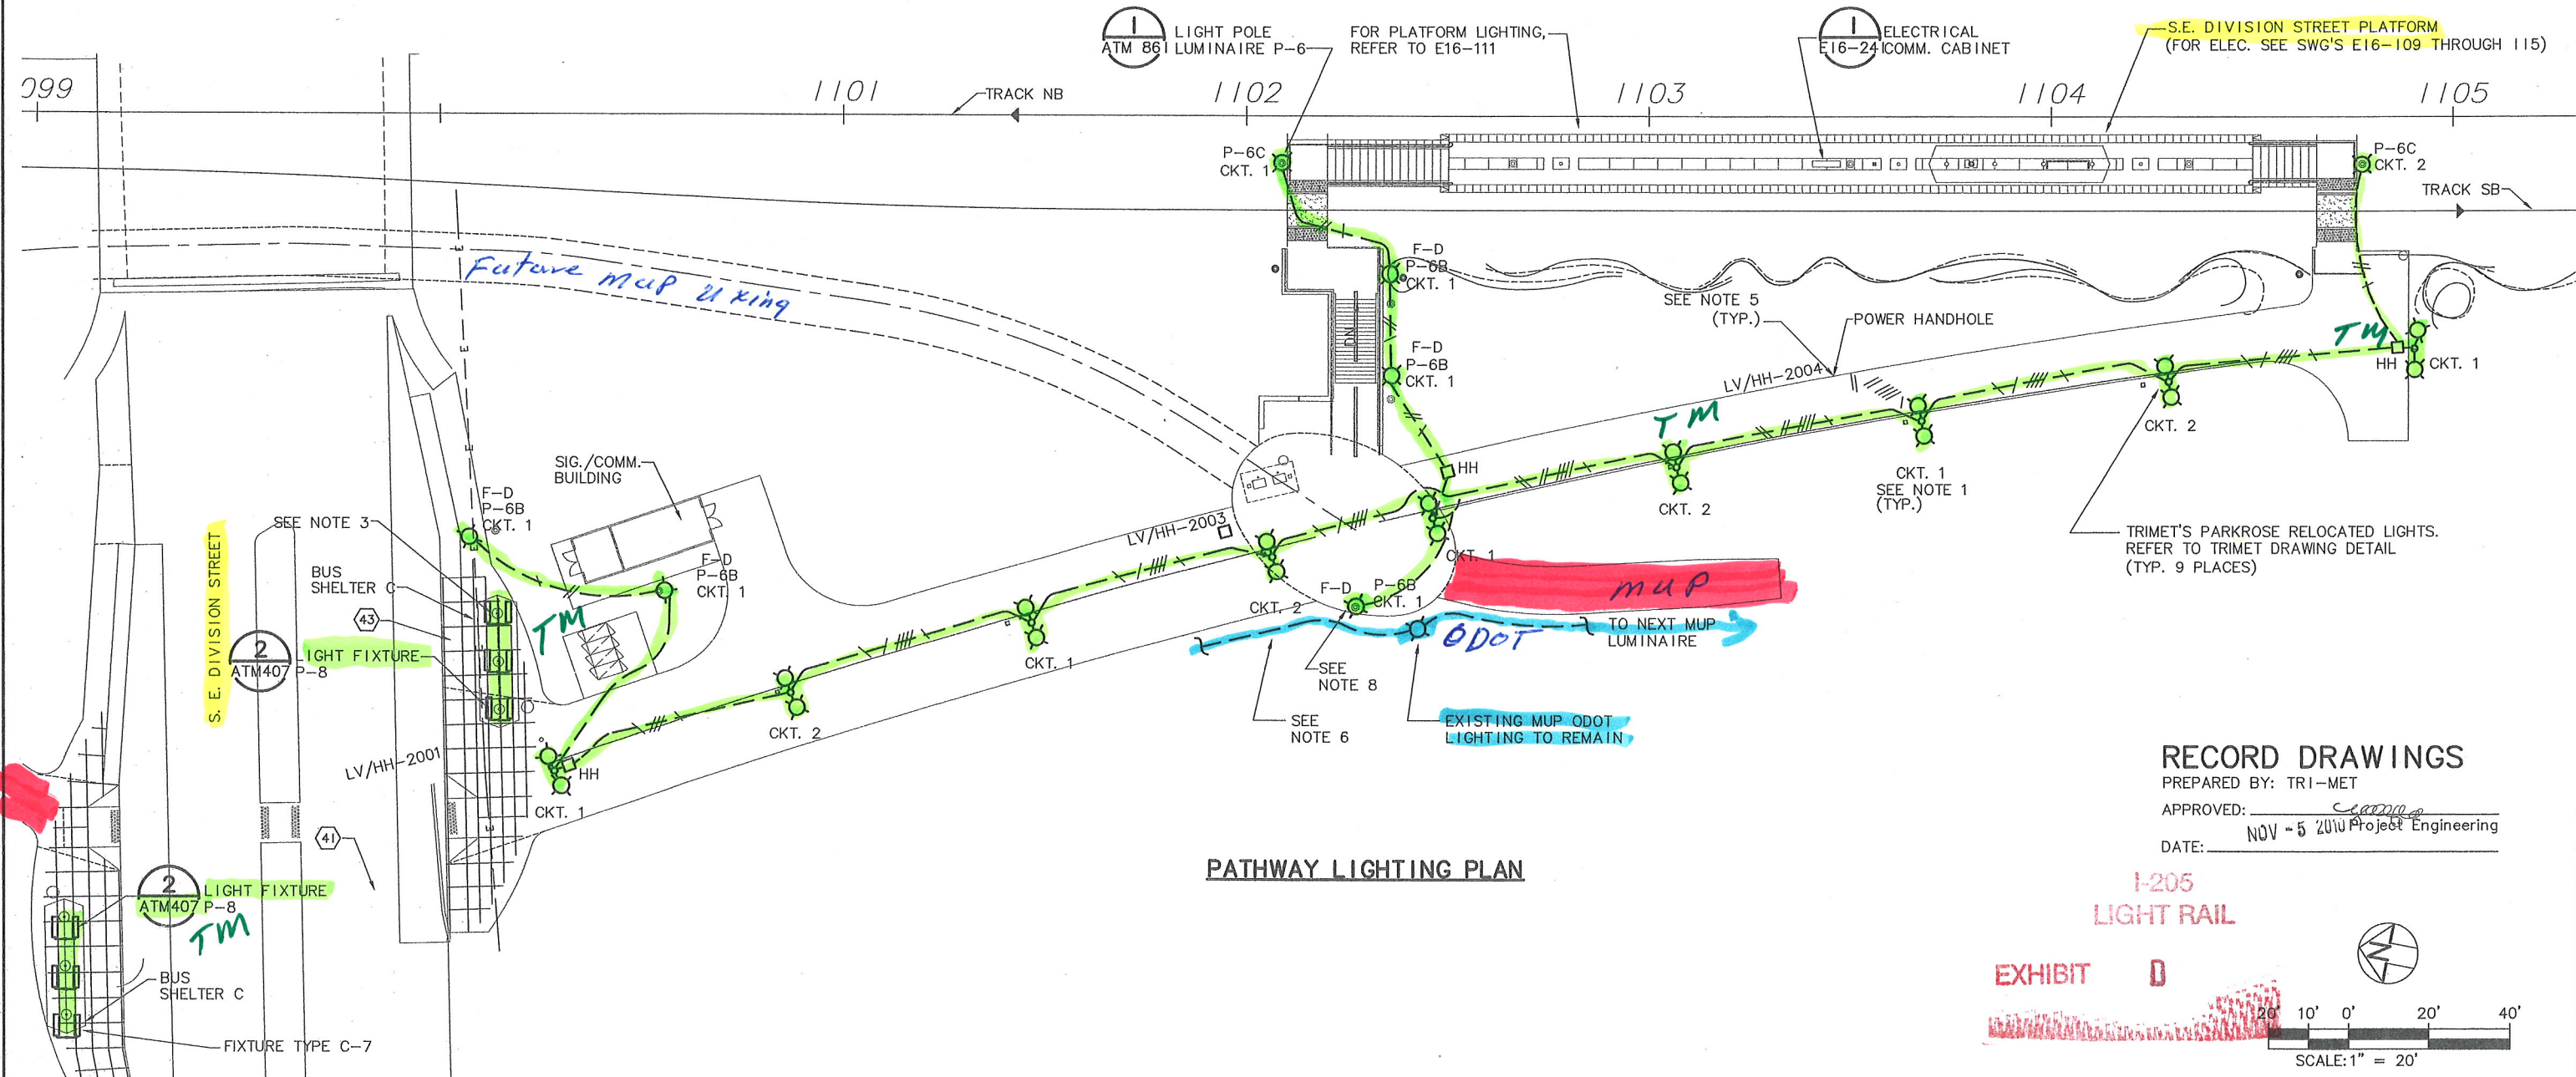


PATHWAY LIGHTING PLAN

RECORD DRAWINGS

PREPARED BY: TRI-MET
APPROVED: *Seanna*
DATE: NOV -5 2010 Project Engineering

I-205
LIGHT RAIL

EXHIBIT D

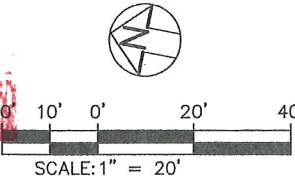

NOTE: THESE RECORD DRAWINGS REPRESENT THE BEST KNOWN INFORMATION ABOUT CONSTRUCTED FACILITIES. LOCATIONS SHOWN ARE NOT WARRANTED. UNDERGROUND UTILITIES MUST BE FIELD VERIFIED FOR ACTUAL LOCATION.

RECORD DRAWING

NO.	DATE	BY	APPD.	REVISIONS
		CHK.		

BSD	5/29/06
DESIGNED	DATE
RJ	5/30/06
DRAWN	DATE
CHECKED	DATE
APPROVED	DATE



TRI-COUNTY METROPOLITAN TRANSPORTATION DISTRICT OF OREGON

SOUTH CORRIDOR CONSTRUCTORS
Stacy and Wilbeck
GRANITE
WILDISH


DHILLON ENGINEERS, INC.
PORTLAND, OR
DAVID EVANS
AND ASSOCIATES INC.

TRI-MET

CAPITAL PROJECTS
AND
FACILITIES DIVISION
710 N.E. HOLLADAY STREET
PORTLAND, OREGON 97232

SOUTH CORRIDOR PROJECT
I-205 SEGMENT
SE DIVISION STREET STATION
PATHWAY LIGHTING PLAN

SUBMITTED:	DATE: 12/15/06	APPROVED:	DATE: 12/15/06	SCALE: 1" = 20'-0"	DRAWING NO.: E16-112-BX	CONTRACT NO.: RH040161LE	SHEET NO.: 80
------------	----------------	-----------	----------------	--------------------	-------------------------	--------------------------	---------------

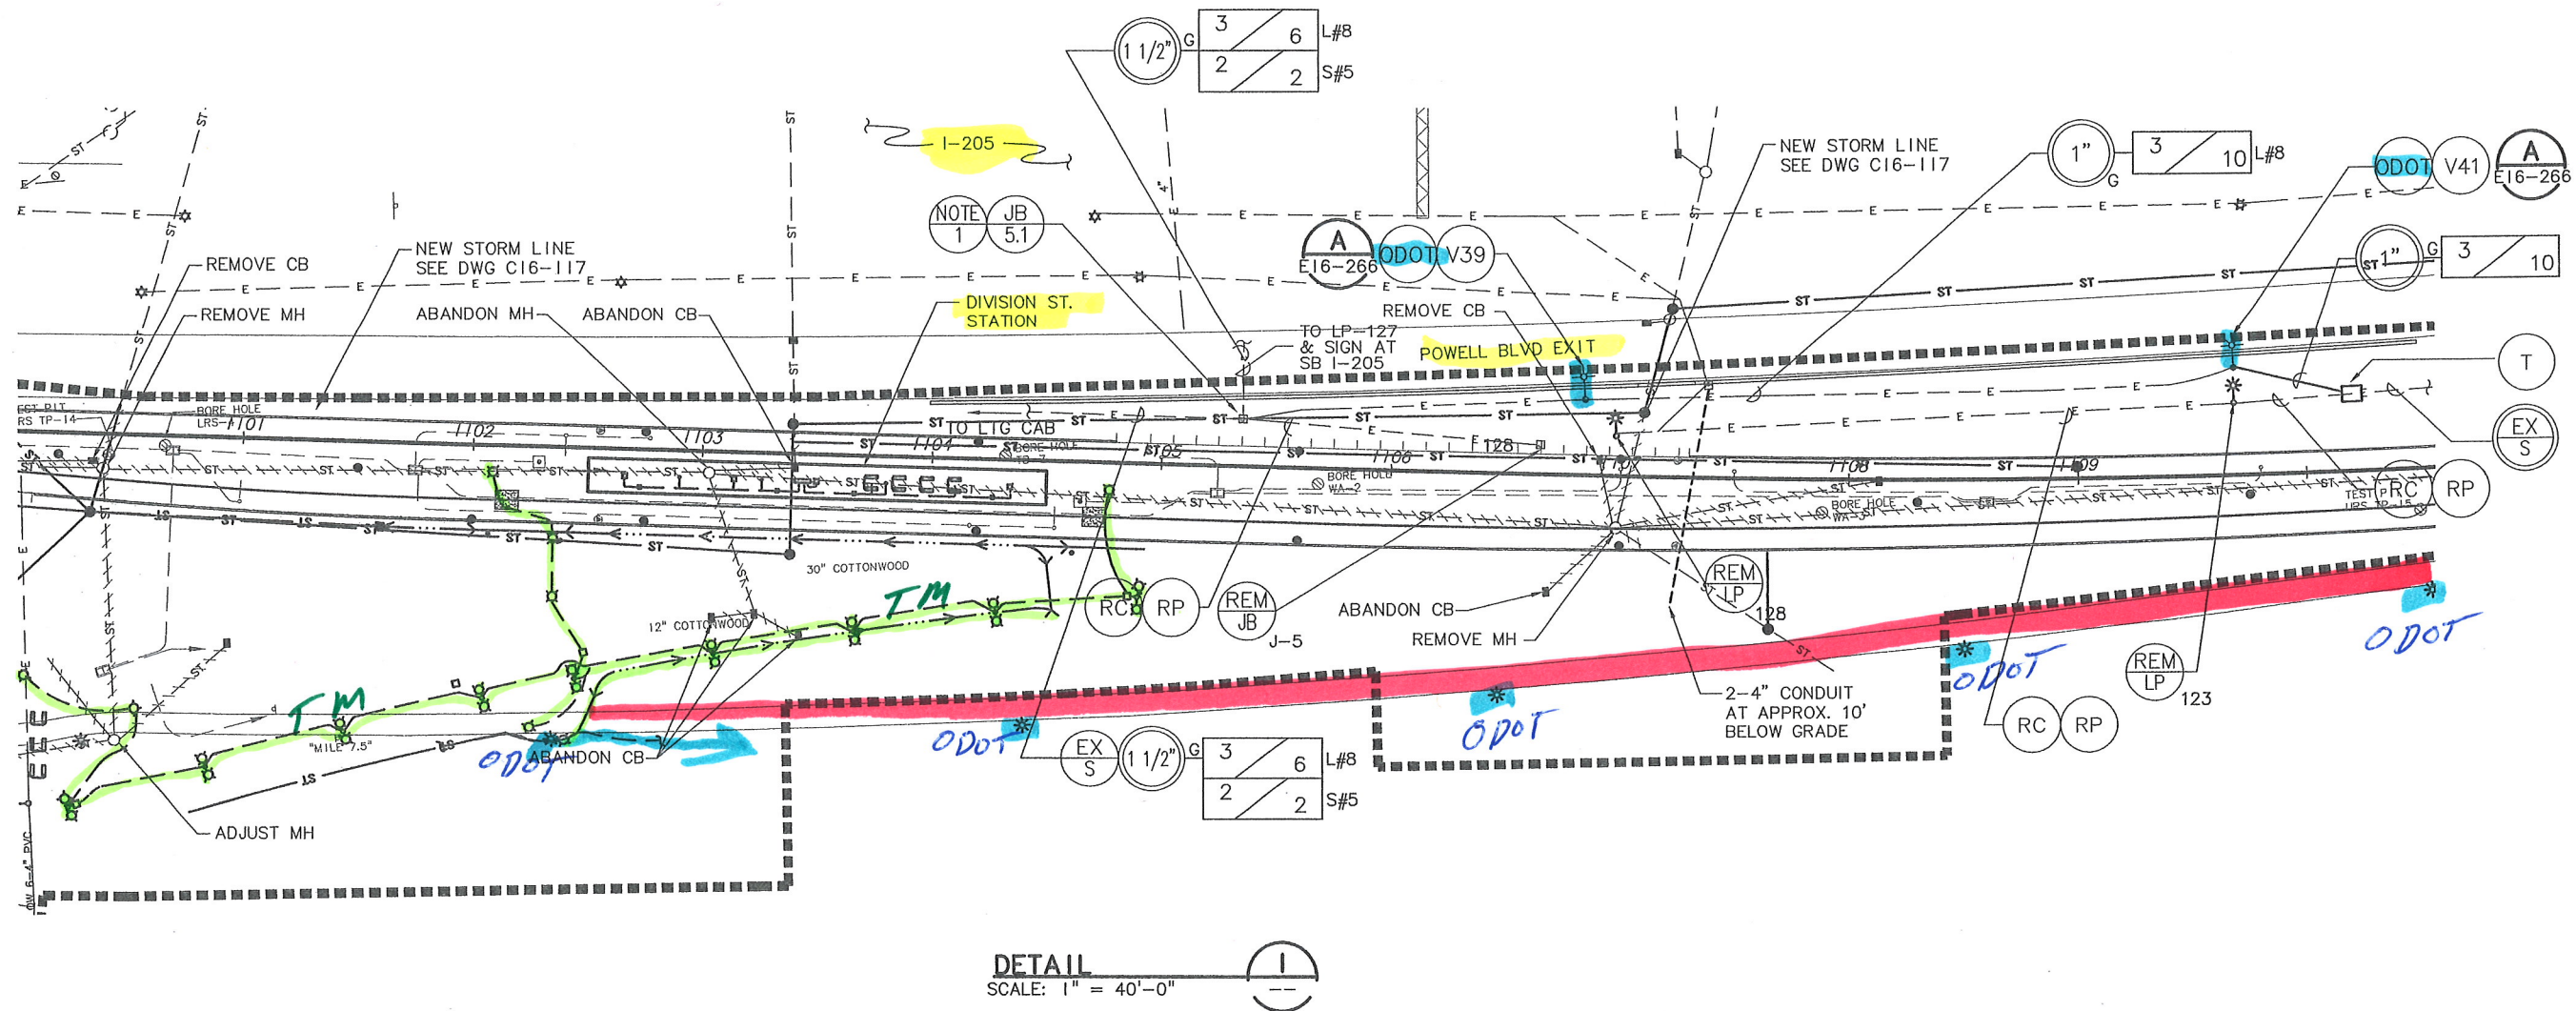

DETAIL
SCALE: 1" = 40'-0"

NOTES


1. AT JB-5.1, FIELD LOCATE AS FAR NORTH AS NEEDED TO MAINTAIN 3 FT COVER ON EX CONDUITS. GRADE IN THIS AREA WILL BE CUT APPROXIMATELY 3 FT. REMOVE/ABANDON CONDUITS WITH LESS THAN 3 FT COVER.
2. J-BOX AT EVERY POLE

RECORD DRAWINGS

PREPARED BY: TRI-MET
APPROVED: *[Signature]*
DATE: NOV -5 2006 Project Engineering

**I-205
LIGHT RAIL**

EXHIBIT D

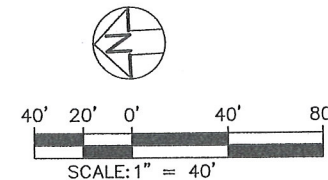

NOTE: THESE RECORD DRAWINGS REPRESENT THE BEST KNOWN INFORMATION ABOUT CONSTRUCTED FACILITIES. LOCATIONS SHOWN ARE NOT WARRANTED. UNDERGROUND UTILITIES MUST BE FIELD VERIFIED FOR ACTUAL LOCATION.

RECORD DRAWING

NO.	DATE	BY	CHK.	APPD.	REVISIONS

MVD DESIGNED	10-19-06
DATE	
RTG DRAWN	5/31/2006
DATE	
CHECKED	
DATE	
APPROVED	
DATE	



TRI-COUNTY METROPOLITAN TRANSPORTATION DISTRICT OF OREGON

SOUTH CORRIDOR CONSTRUCTORS
Stacy and Wilbeck
GRANITE
WILDISH

EPSILON ENGINEERING, INC.
BEAVERTON, OR
503-526-1000

TRI-MET


CAPITAL PROJECTS AND FACILITIES DIVISION
710 N.E. HOLLADAY STREET
PORTLAND, OREGON 97232

SUBMITTED:	DATE:	APPROVED:	DATE:
	12/15/06		12/15/06

**SOUTH CORRIDOR PROJECT
I-205 SEGMENT**

ODOT LIGHT POLE RELOCATION
STA 1100+00 TO STA 1110+00

SCALE:	DRAWING NO.:	CONTRACT NO.:	SHEET NO.:
1" = 40'-0"	E16-256-AX	RH040161LE	179

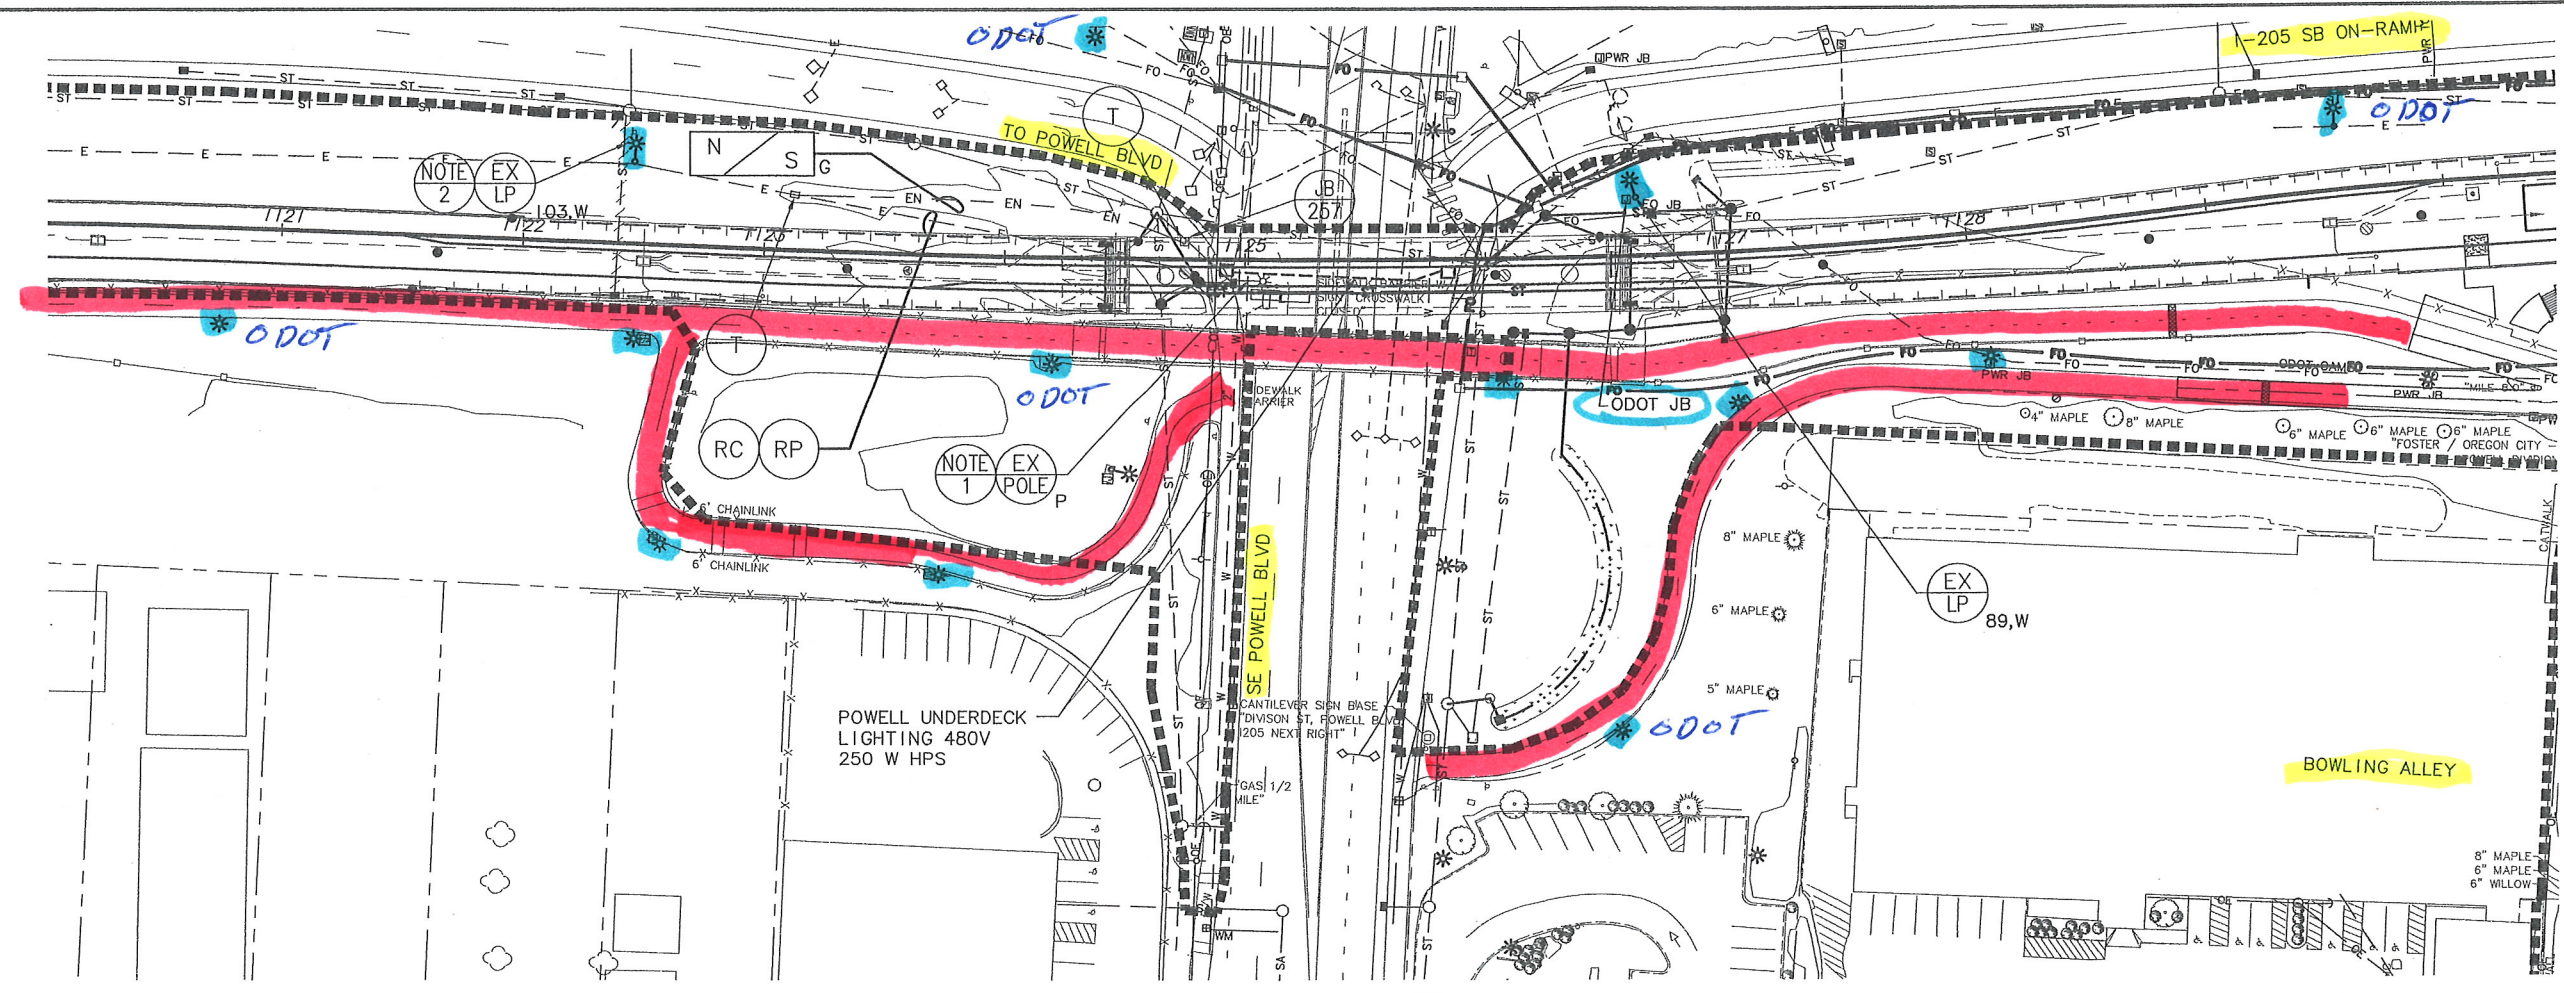

DETAIL
SCALE: 1" = 40'-0"
REF: U16-121


NOTES

1. POLE "P" IS FOR TRAFFIC SIGNALS. IT IS NOT FOR ROADWAY LIGHTING.
2. AT LP-103, FIELD ADJUST CONDUIT AS REQUIRED. ROUTE NEW CONDUIT DUE SOUTH TO NEW J.B. (18" x 10" x 12" DEEP), JB-257 TRANSITION TO EAST - WEST RUN AT NEW J.B.. AVOID BRIDGE ABUTMENT AT APPROX. STA N.B. 1124+50.

I-205
LIGHT RAIL
EXHIBIT D

RECORD DRAWINGS

PREPARED BY: TRI-MET
APPROVED: *[Signature]*
DATE: NOV - 5 2010 Project Engineering

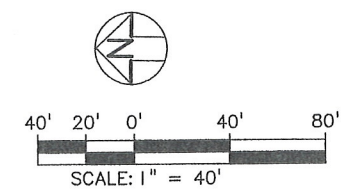

NOTE: THESE RECORD DRAWINGS REPRESENT THE BEST KNOWN INFORMATION ABOUT CONSTRUCTED FACILITIES. LOCATIONS SHOWN ARE NOT WARRANTED. UNDERGROUND UTILITIES MUST BE FIELD VERIFIED FOR ACTUAL LOCATION.

RECORD DRAWING

NO.	DATE	BY	APPD.	REVISIONS
		CHK.		

MVD DESIGNED	10-19-06
RTG DRAWN	5-31-06
CHECKED	
APPROVED	

**TRI-COUNTY METROPOLITAN TRANSPORTATION DISTRICT OF OREGON**

SOUTH CORRIDOR CONSTRUCTORS
Stacy and Wilbeck
GRANITE WILDISH

**EPSILON ENGINEERING, INC.**
BEAVERTON, OR
503-626-1000

CAPITAL PROJECTS AND FACILITIES DIVISION
710 N.E. HOLLADAY STREET
PORTLAND, OREGON 97232

SUBMITTED: 12/15/06

APPROVED: 12/15/06

SOUTH CORRIDOR PROJECT
I-205 SEGMENT
ODOT LIGHT POLE RELOCATION
STA 1110+00 TO STA 1130+00


SCALE: 1" = 40'-0"	DRAWING NO.: E16-257	CONTRACT NO.: RH040161LE	SHEET NO.: 180
--------------------	----------------------	--------------------------	----------------

1
2
3
4
5

A B C D E F G H

NOTES:

1. PENDANT MOUNT LUMINAIRES WITH 1" CRS AND LINE BOTTOM OF LUMINAIRES WITH BOTTOM OF GIRDERS.
2. FOR POWELL ST. UNDERPASS LIGHTING PROVIDE 208V BALLAST FOR TYPE C-4 LUMINAIRES.

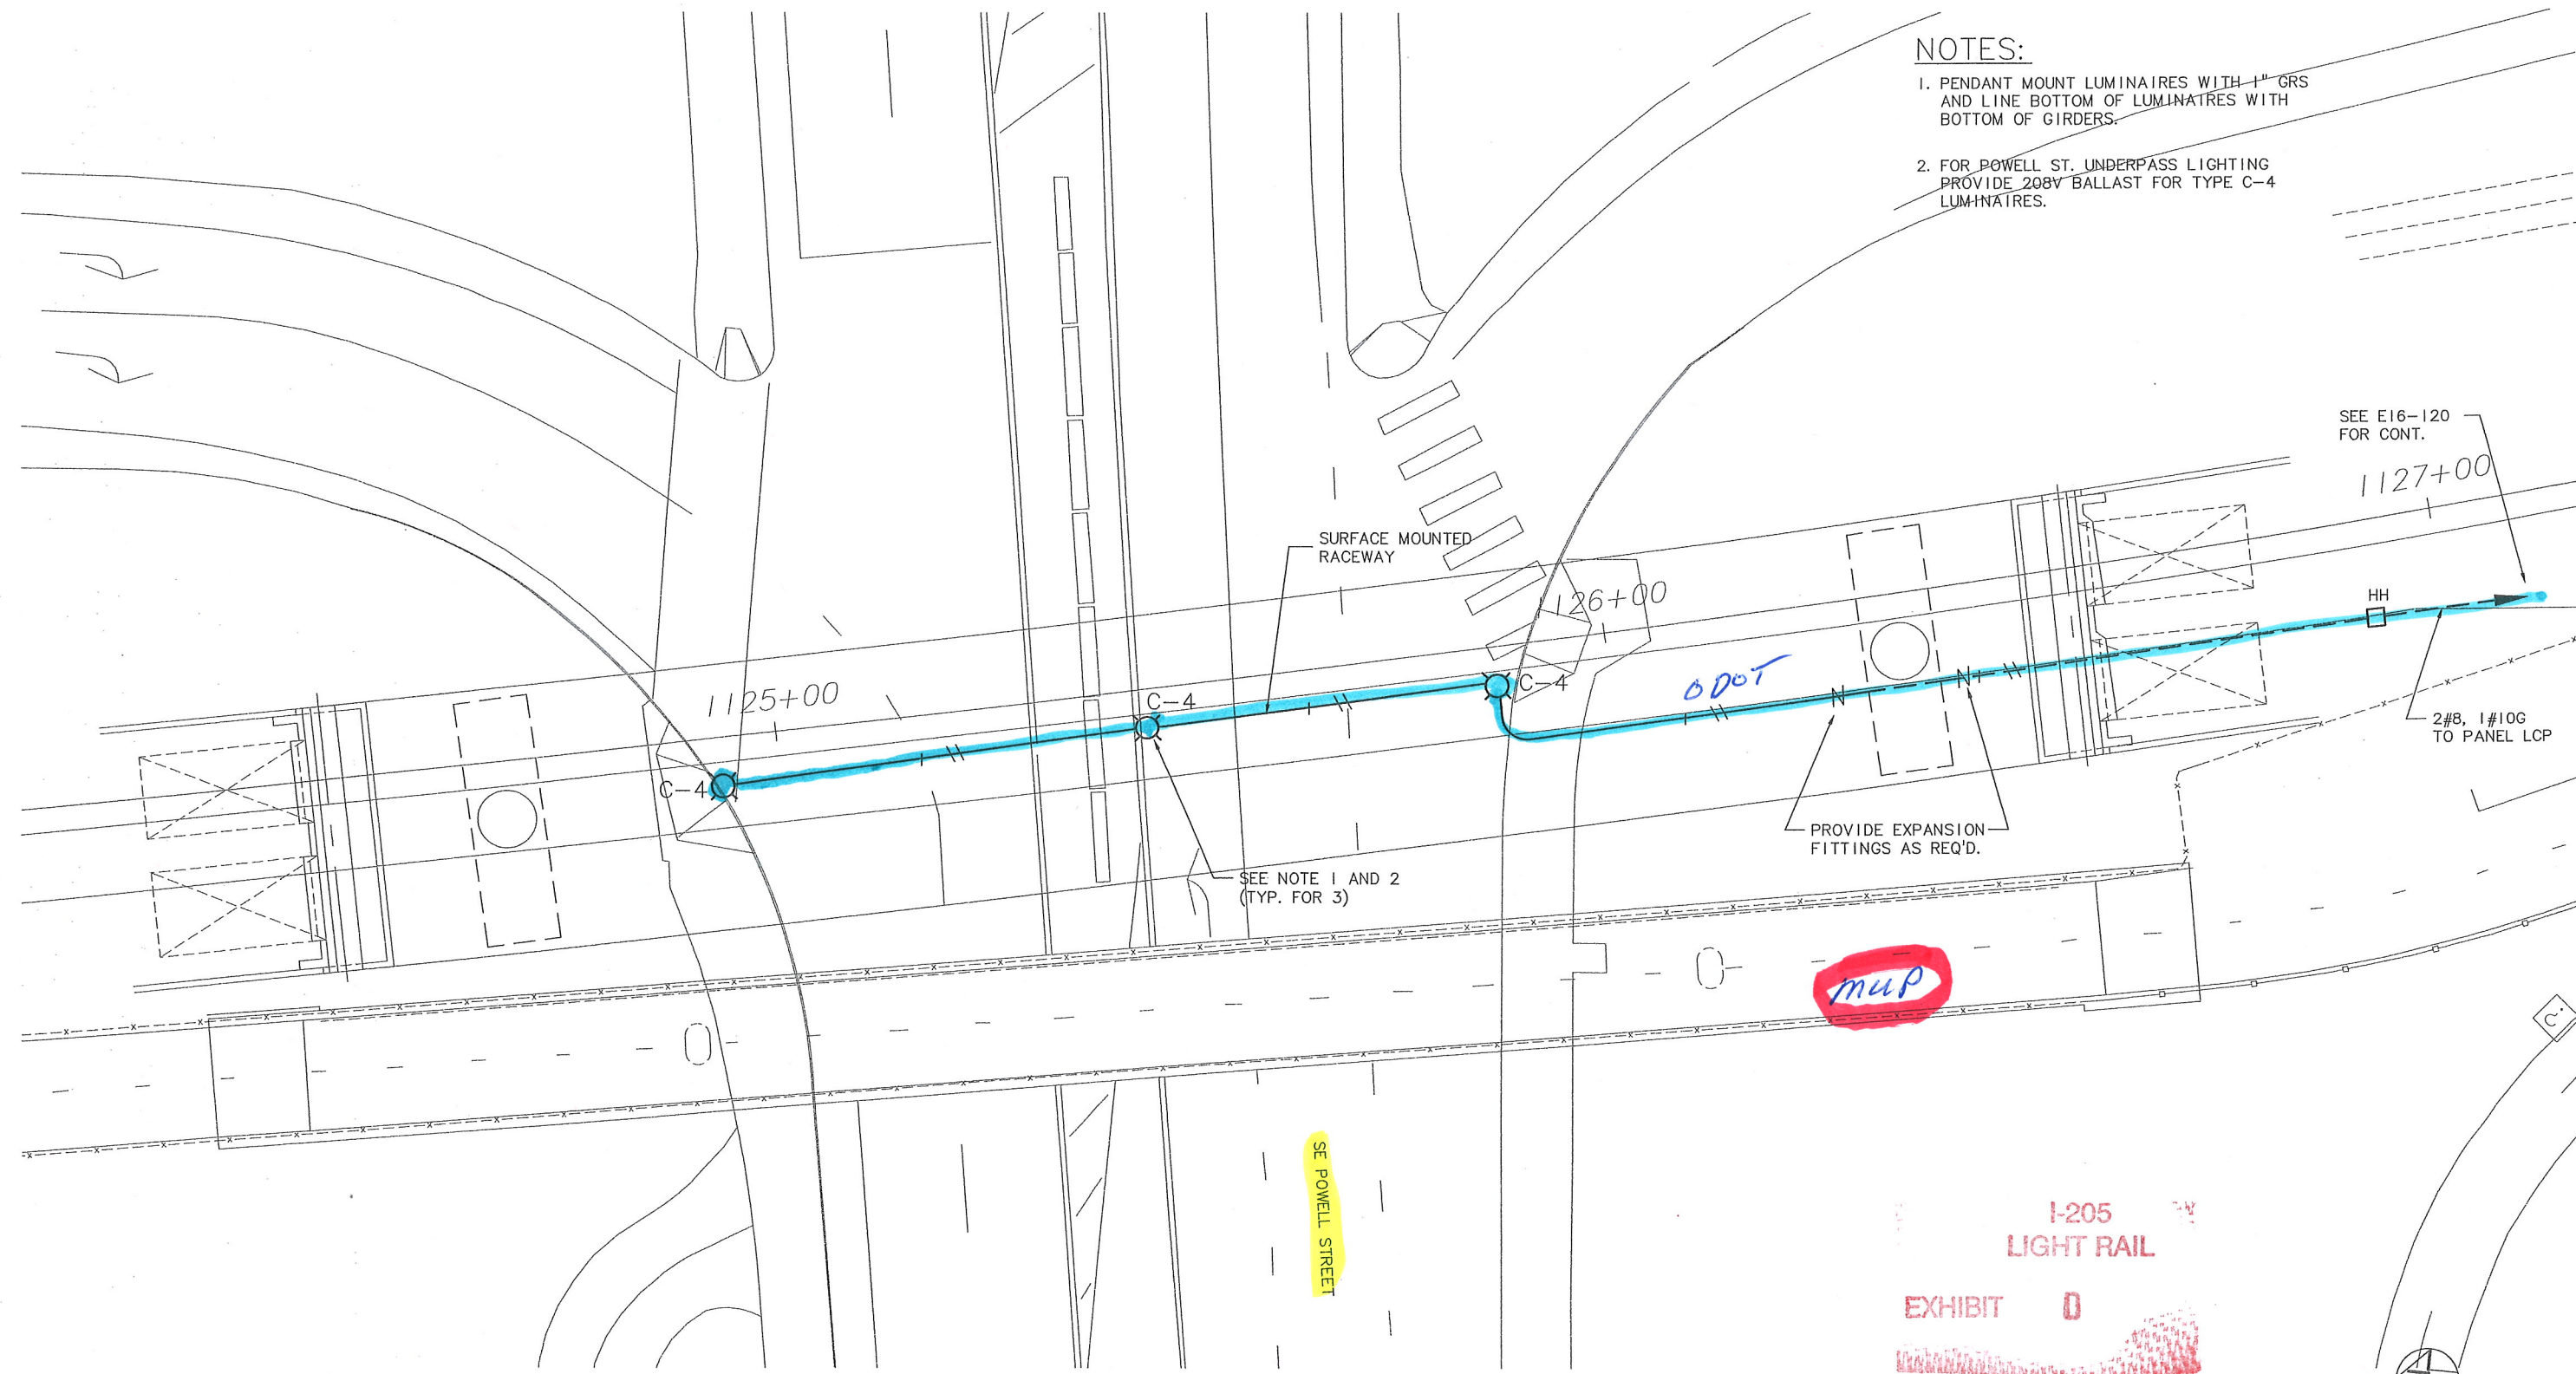


POWELL STREET UNDERPASS-LIGHTING PLAN

I-205
LIGHT RAIL

EXHIBIT **D**

RECORD DRAWINGS

PREPARED BY: TRI-MET
APPROVED: _____
DATE: NOV - 5 2010 Project Engineering

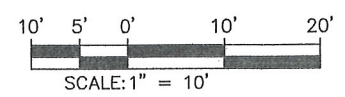

NOTE: THESE RECORD DRAWINGS REPRESENT THE BEST KNOWN INFORMATION ABOUT CONSTRUCTED FACILITIES. LOCATIONS SHOWN ARE NOT WARRANTED. UNDERGROUND UTILITIES MUST BE FIELD VERIFIED FOR ACTUAL LOCATION.

RECORD DRAWING

NO.	DATE	BY	APPD.	REVISIONS
		CHK.		

BSD DESIGNED	10/5/06 DATE
JMS DRAWN	10/6/06 DATE
CHECKED	DATE
APPROVED	DATE

**TRI-COUNTY METROPOLITAN TRANSPORTATION DISTRICT OF OREGON**

**Stacy and Witbeck
GRANITE**

**DHILLON ENGINEERS, INC.**
PORTLAND, OR

**DAVID EVANS
AND ASSOCIATES INC.**

**CAPITAL PROJECTS
AND
FACILITIES DIVISION**
710 N.E. HOLLADAY STREET
PORTLAND, OREGON 97232


SUBMITTED: _____ DATE: 12/15/06

APPROVED: _____ DATE: 12/15/06

**SOUTH CORRIDOR PROJECT
I-205 SEGMENT
POWELL STREET UNDERPASS-LIGHTING PLAN**

SCALE: 1" = 10'-0"	DRAWING NO.: E16-234	CONTRACT NO.: RH040161LE	SHEET NO.: 168
--------------------	----------------------	--------------------------	----------------

REFER TO DRAWING E16-120 FOR NOTES.

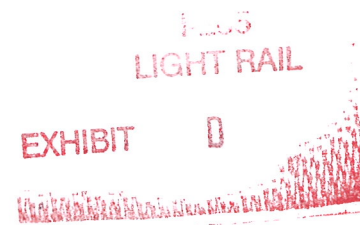

PREPARED BY: TRI-MET

APPROVED: _____
Project Engineering

DATE: NOV - 5 2010



20' 10' 0' 20' 40'

SCALE: 1" = 20'

RECORD DRAWING

BSD	6/01/06
DESIGNED	DATE
RJ	6/02/06
DRAWN	DATE
CHECKED	DATE
APPROVED	DATE



SOUTH CORRIDOR CONSTRUCTORS
a joint venture
Stacy and Wilbeck
GRANITE
WILDISH



DHILLON ENGINEERS, INC.
PORTLAND, OR



**CAPITAL PROJECTS
AND
FACILITIES DIVISION**
710 N.E. HOLLADAY STREET
PORTLAND, OREGON 97232

S.E. POWELL BLVD STATION
PATHWAY LIGHTING PLAN—NORTH END

SUBMITTED:

DATE:

12/15/06

APPROVED:

DATE _____

12/15/06

2

$$1'' = 20' - 0''$$

© 2006 The Authors
Journal compilation © 2006 Blackwell Publishing Ltd


DRAWING NO.:
F16-121

CONTRACT NO.: RH0401611E

३३

NOTES:

1. FOR LUMINAIRE SCHEDULE, REFER TO DWG. E16-217/218.
2. REFER TO ARCHITECTURAL DRAWING FOR EXACT LOCATIONS OF LUMINAIRES.
3. MINIMUM CONDUCTOR SIZE SHALL BE #8 WITH #10G UNLESS NOTED OTHERWISE.
4. EXTEND EXISTING CIRCUIT WITH 2#10, 1#10G TO NEW LUMINAIRES.
5. FOR POLE FOUNDATION FOR NEW MUP MOUNTED LUMINAIRE SEE I/JTM173

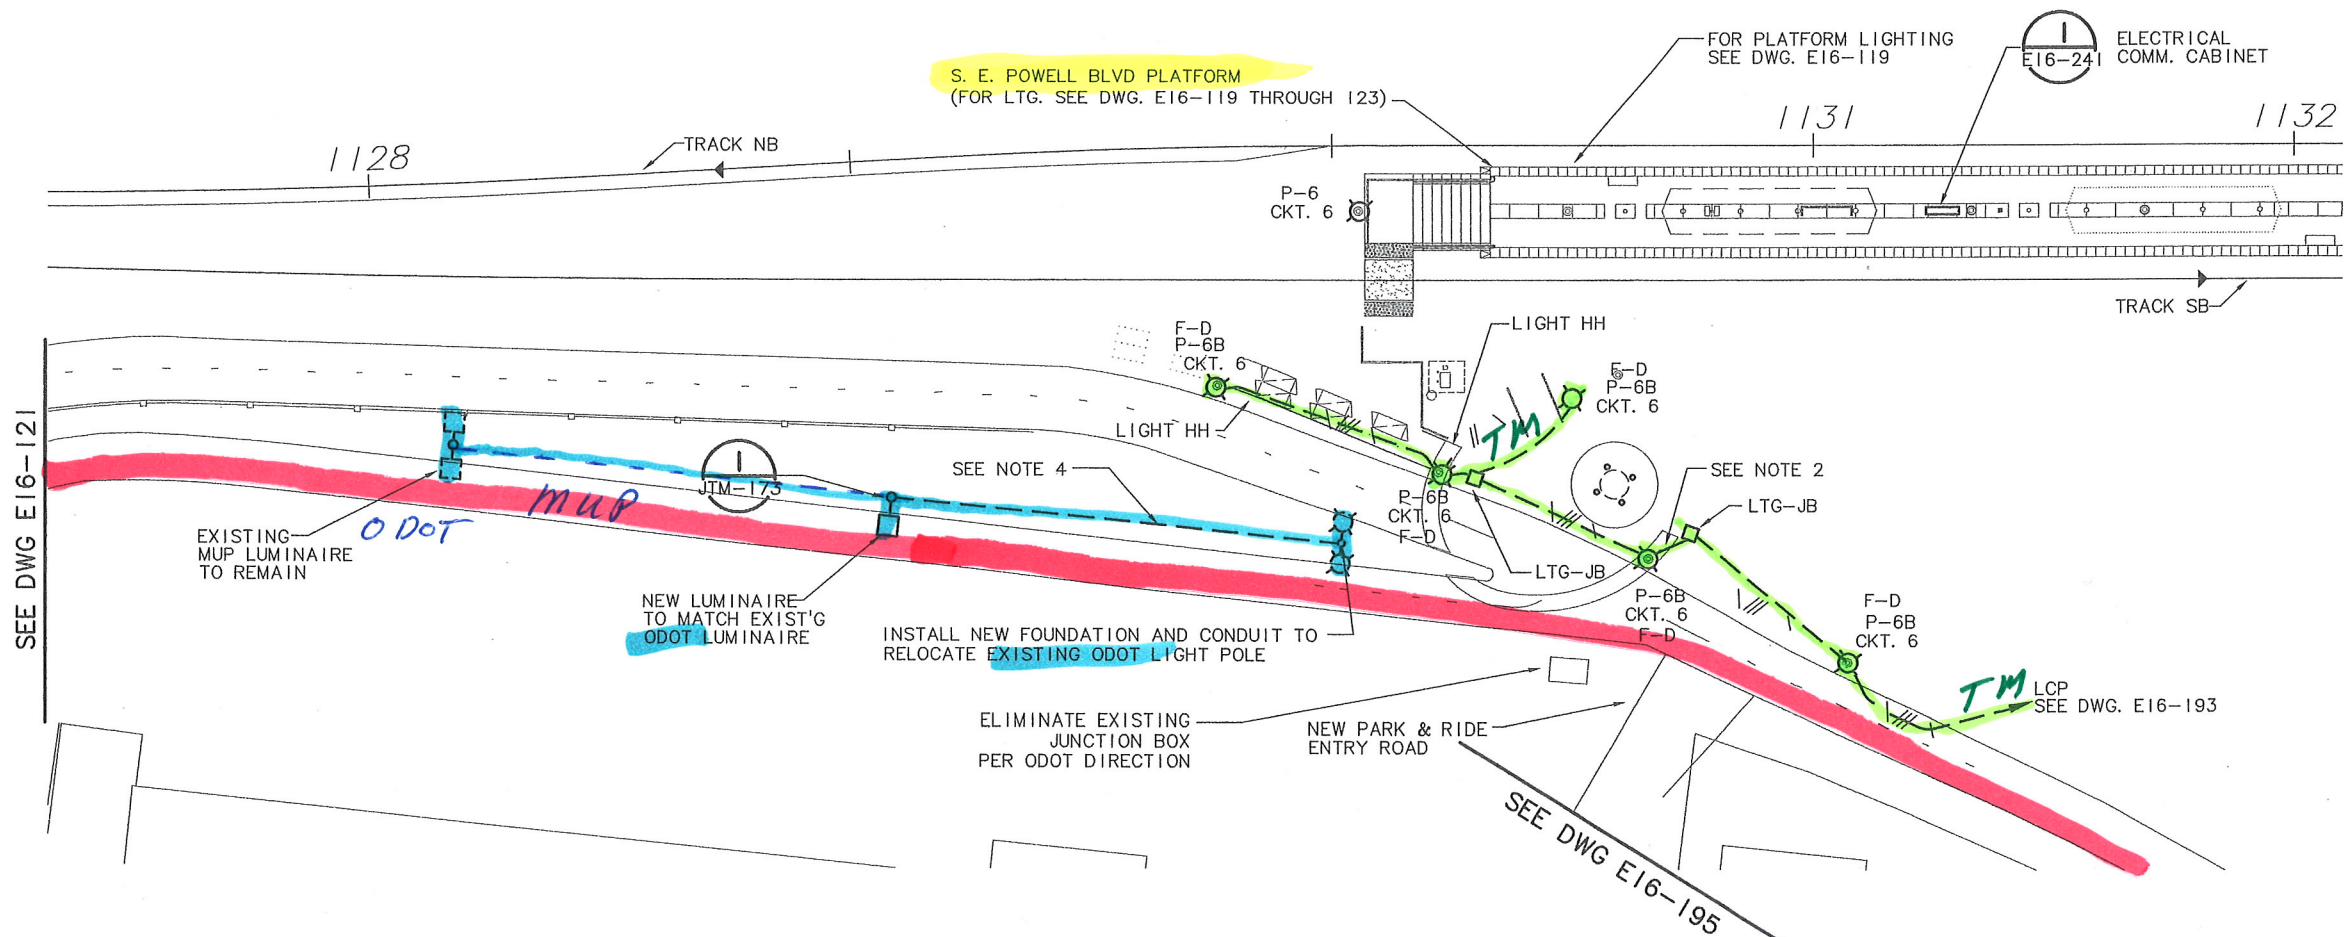

PATHWAY LIGHTING PLAN-SOUTH END


RECORD DRAWINGS

PREPARED BY: TRI-MET
APPROVED: *[Signature]*
DATE: NOV -5 2010 Project Engineering

I-205
LIGHT RAIL

EXHIBIT

D

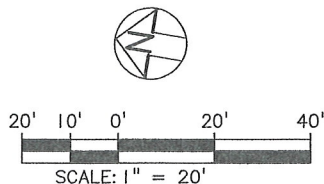

NOTE: THESE RECORD DRAWINGS REPRESENT THE BEST KNOWN INFORMATION ABOUT CONSTRUCTED FACILITIES. LOCATIONS SHOWN ARE NOT WARRANTED. UNDERGROUND UTILITIES MUST BE FIELD VERIFIED FOR ACTUAL LOCATION.

RECORD DRAWING

BSD DESIGNED	6/01/06
RJ DRAWN	6/02/06
CHECKED	DATE
APPROVED	DATE



TRI-COUNTY METROPOLITAN TRANSPORTATION DISTRICT OF OREGON

SOUTH CORRIDOR CONSTRUCTORS
Stacy and Wilbeck
GRANITE
WILDISH

DHILLON ENGINEERS, INC.
PORTLAND, OR
DAVID EVANS
AND ASSOCIATES INC.



CAPITAL PROJECTS
AND
FACILITIES DIVISION
710 N.E. HOLLADAY STREET
PORTLAND, OREGON 97232

SOUTH CORRIDOR PROJECT
I-205 SEGMENT
S.E. POWELL BLVD STATION
PATHWAY LIGHTING PLAN-SOUTH END

NO.	DATE	BY	APPD.	REVISIONS

SUBMITTED:

DATE: 12/15/06

APPROVED:

DATE: 12/15/06

SCALE: 1" = 20'-0"


DRAWING NO.: E16-120-CX

CONTRACT NO.: RH040161LE

SHEET NO.: 87

- NOTES:
1. FOR LUMINAIRE SCHEDULE REFER TO DRAWING E16-217.
 2. SAME LUMINAIRE AS P-1 EXCEPT WITH 5 FOOT ARM.
 3. PROVIDE PVC COATED GRS CONDUIT UNDER TRACK
 4. PROVIDE PULL WIRE IN TELEPHONE CONDUIT
 5. PROVIDE TRIMET TYPE 4 HANDHOLE PER DWG. JTM092 OR EQUAL.
COVER TO BE MARKED WITH "TELCO" OR "QWEST"


FOR POLE FOUNDATIONS FOR NEW POLE MOUNTED
LUMINAIRES ALONG ENTRY ROAD TO PARK & RIDE SEE
I/JTM173

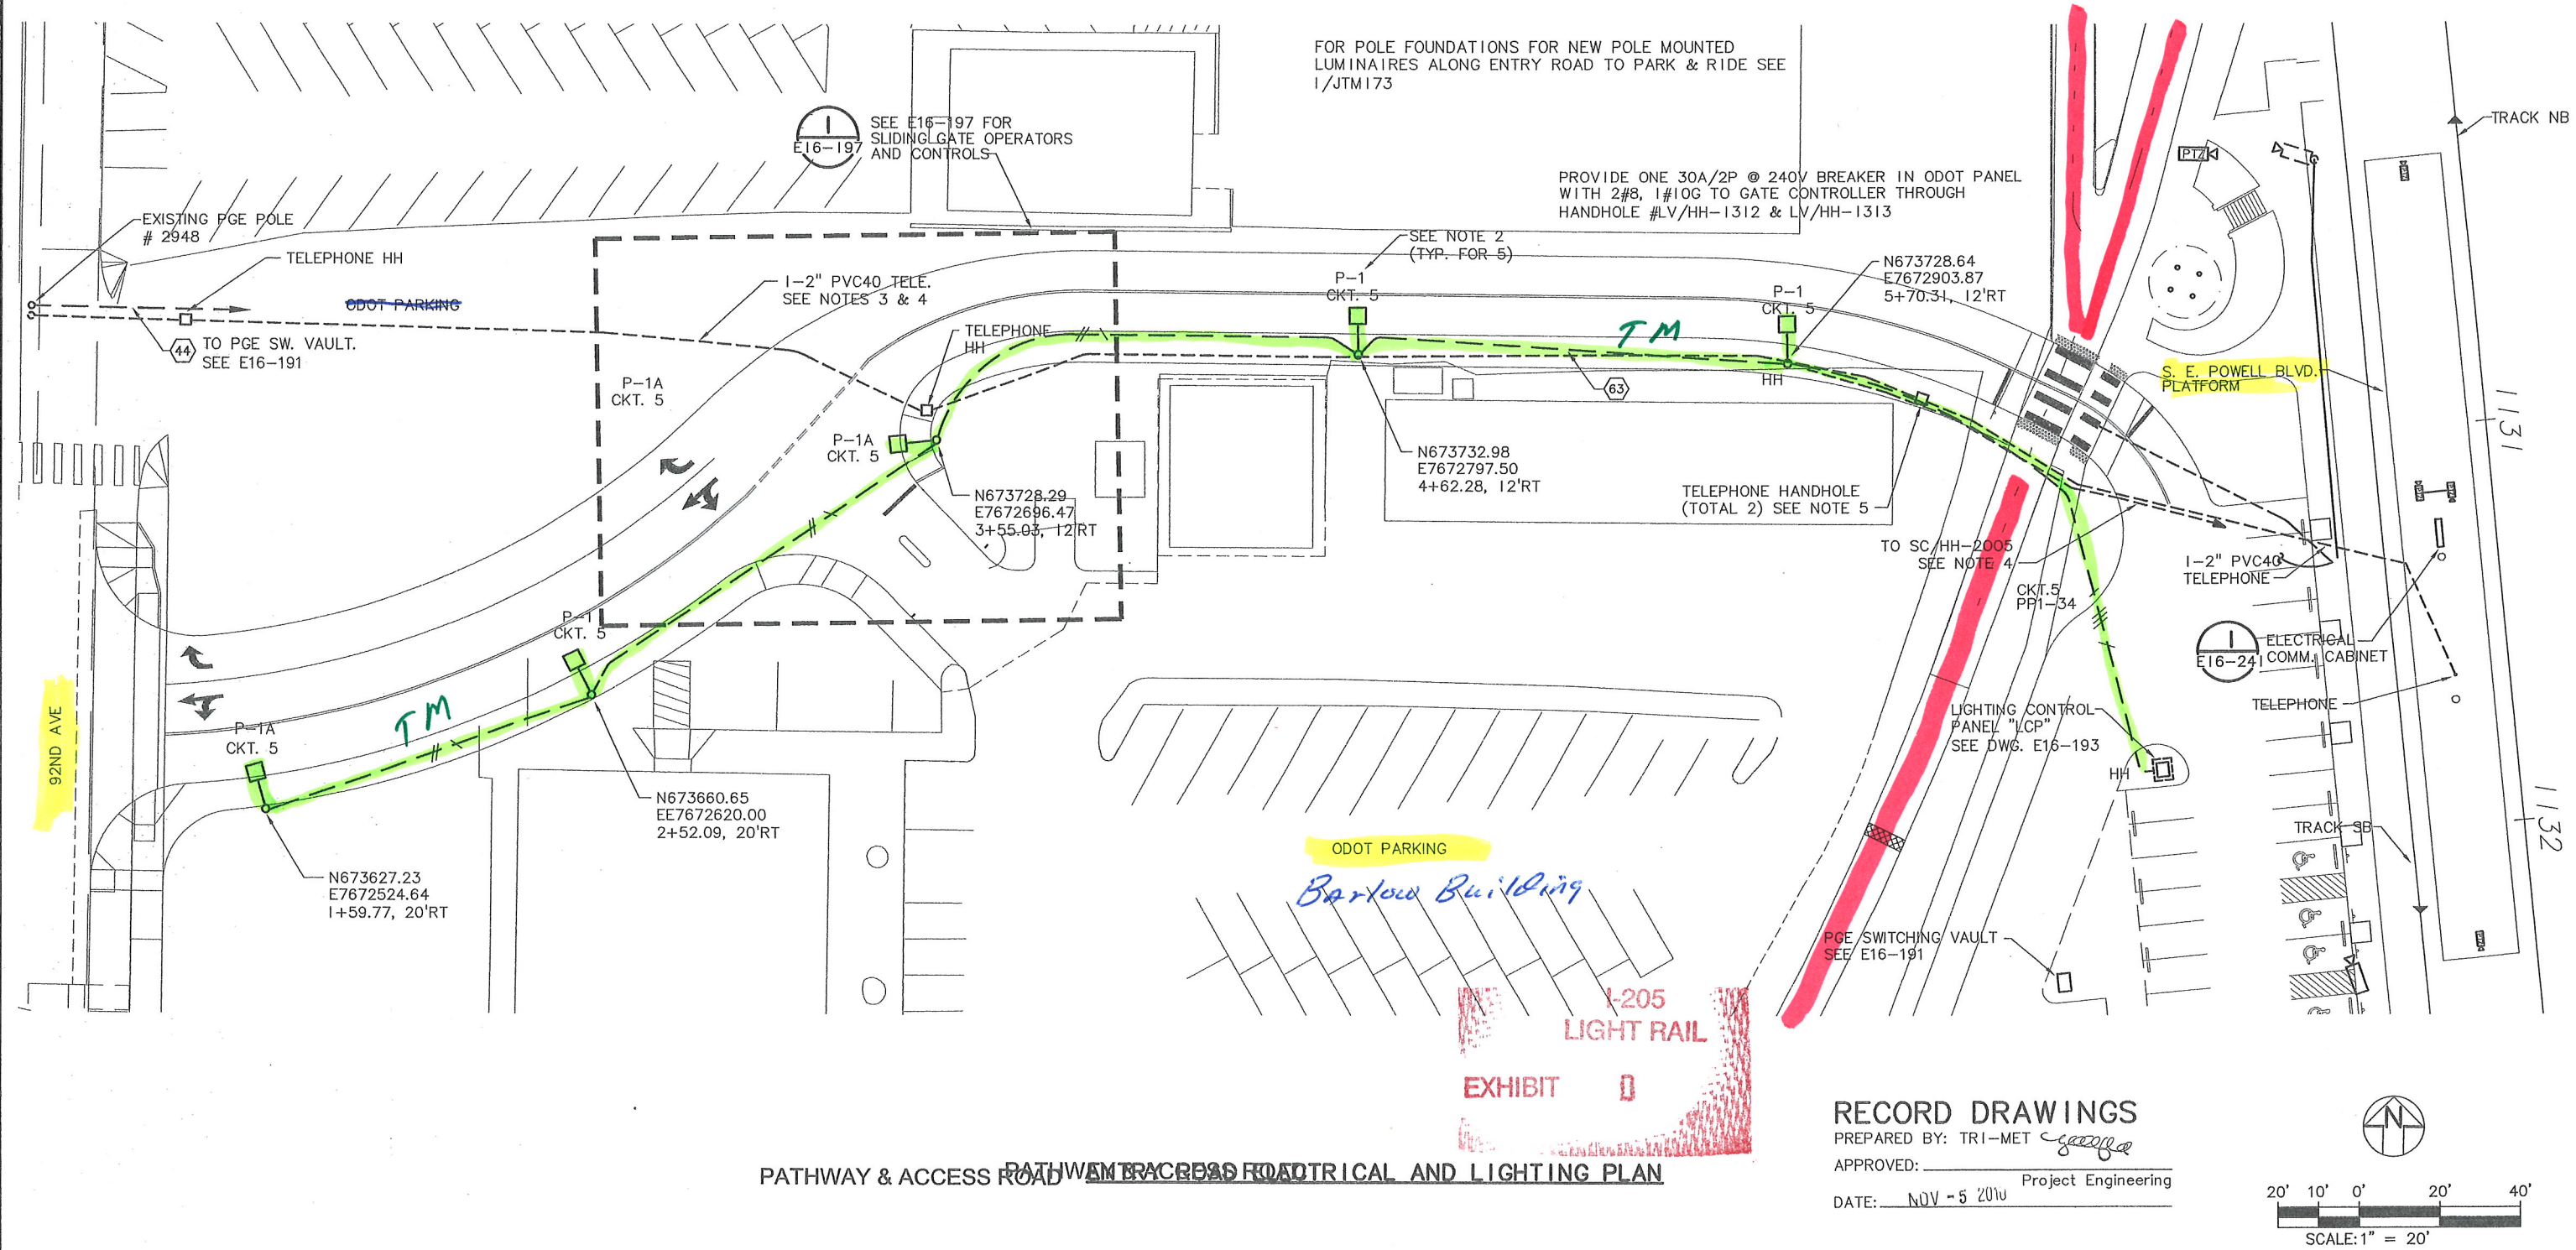

PATHWAY & ACCESS ROAD ELECTRICAL AND LIGHTING PLAN

RECORD DRAWINGS

PREPARED BY: TRI-MET
APPROVED: *[Signature]* Project Engineering
DATE: NOV - 5 2010

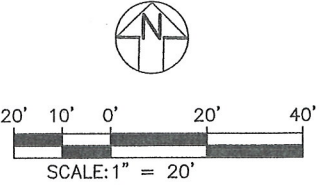

NOTE: THESE RECORD DRAWINGS REPRESENT THE BEST KNOWN INFORMATION ABOUT CONSTRUCTED FACILITIES. LOCATIONS SHOWN ARE NOT WARRANTED. UNDERGROUND UTILITIES MUST BE FIELD VERIFIED FOR ACTUAL LOCATION.				
RECORD DRAWING				
NO.	DATE	BY	APPD.	REVISIONS
CHK.				Original Drawing Stamped and Sealed by BHUPINDAR S. DHILLON

BSD DESIGNED	6/01/06	DATE
RJ DRAWN	6/02/06	DATE
CHECKED		DATE
APPROVED		DATE


TRI-COUNTY METROPOLITAN TRANSPORTATION DISTRICT OF OREGON

SOUTH CORRIDOR CONSTRUCTORS
Stacy and Wilbeck
GRANITE
WILDISH AND ASSOCIATES INC.

DHILLON ENGINEERS, INC.
PORTLAND, OR

TRI-MET
CAPITAL PROJECTS AND FACILITIES DIVISION
710 N.E. HOLLADAY STREET
PORTLAND, OREGON 97232

SOUTH CORRIDOR PROJECT I-205 SEGMENT S.E. POWELL BLVD STATION ENTRY ROAD ELECTRICAL AND LIGHTING PLAN			
SCALE: 1" = 20'-0"	DRAWING NO.: E16-195-FX	CONTRACT NO.: RH040161LE	SHEET NO.: 138

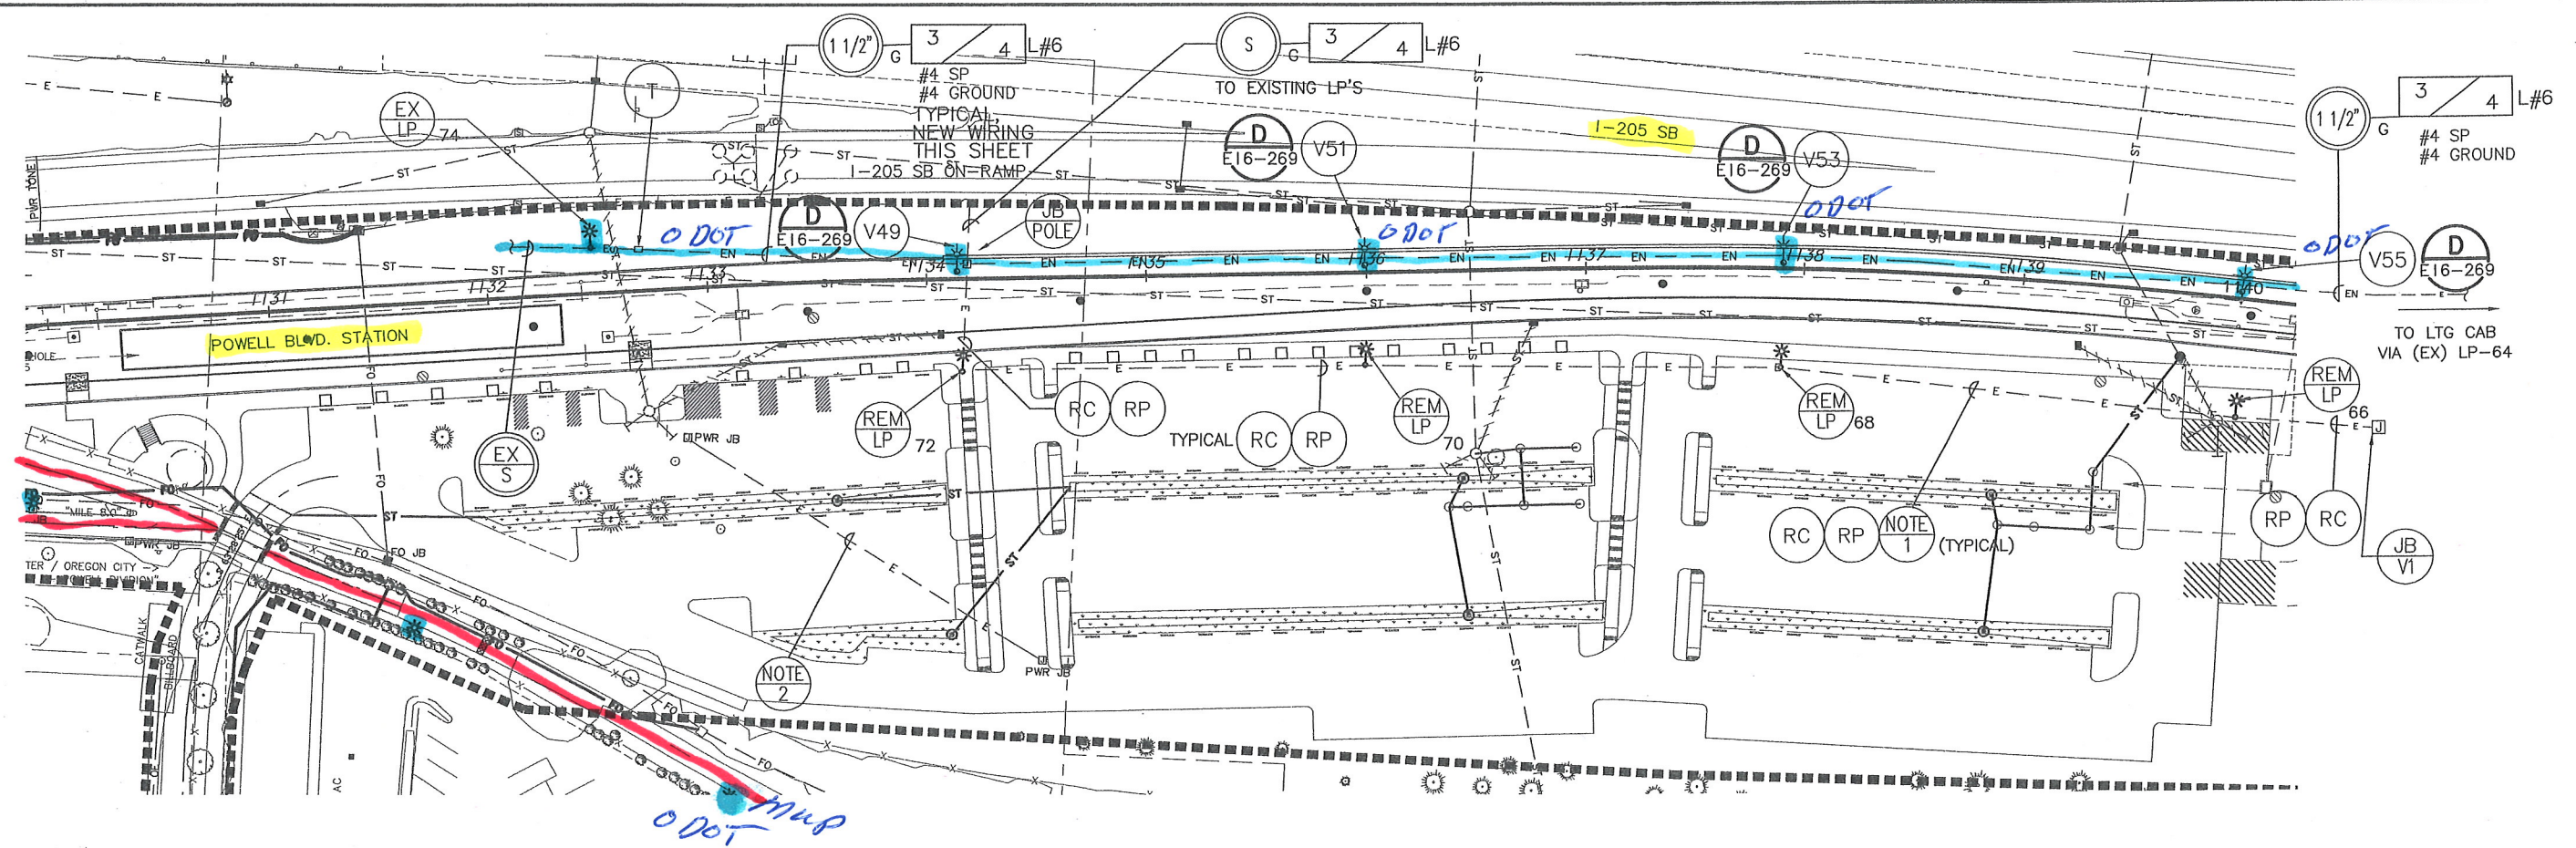


DETAIL
SCALE: 1" = 40'-0"
REF: U16-123

- NOTES:
1. AT POLES TO BE REMOVED, REMOVE ASSOCIATED WIRING. REMOVE OR ABANDON ASSOCIATED CONDUITS.
 2. FIELD LOCATE AND IDENTIFY. COORDINATE WITH ENGINEER FOR CONSTRUCTION REQUIREMENTS.
 3. J-BOX AT EVERY POLE

RECORD DRAWINGS
PREPARED BY: TRI-MET
APPROVED: _____
DATE: NOV -5 2010
Project Engineering

**I-205
LIGHT RAIL**
EXHIBIT D

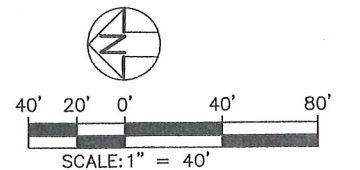

NOTE: THESE RECORD DRAWINGS REPRESENT THE BEST KNOWN INFORMATION ABOUT CONSTRUCTED FACILITIES. LOCATIONS SHOWN ARE NOT WARRANTED. UNDERGROUND UTILITIES MUST BE FIELD VERIFIED FOR ACTUAL LOCATION.

RECORD DRAWING

NO.	DATE	BY	APPD.	REVISIONS
		CHK.		

MVD DESIGNED	10-19-06
RTG DRAWN	5-31-06
CHECKED	DATE
APPROVED	DATE

TRI-COUNTY METROPOLITAN TRANSPORTATION DISTRICT OF OREGON

SOUTH CORRIDOR CONSTRUCTORS
Stacy and Wilbeck
GRANITE
WILDISH

EPSILON ENGINEERING, INC.
BEAVERTON, OR
503-526-1000

CAPITAL PROJECTS AND FACILITIES DIVISION
710 N.E. HOLLADAY STREET
PORTLAND, OREGON 97232


SUBMITTED: _____

DATE: 12/15/06

APPROVED: _____


DATE: 12/15/06

SCALE: 1" = 40'-0"	DRAWING NO.: E16-258	CONTRACT NO.: RH040161LE	SHEET NO.: 181
--------------------	----------------------	--------------------------	----------------

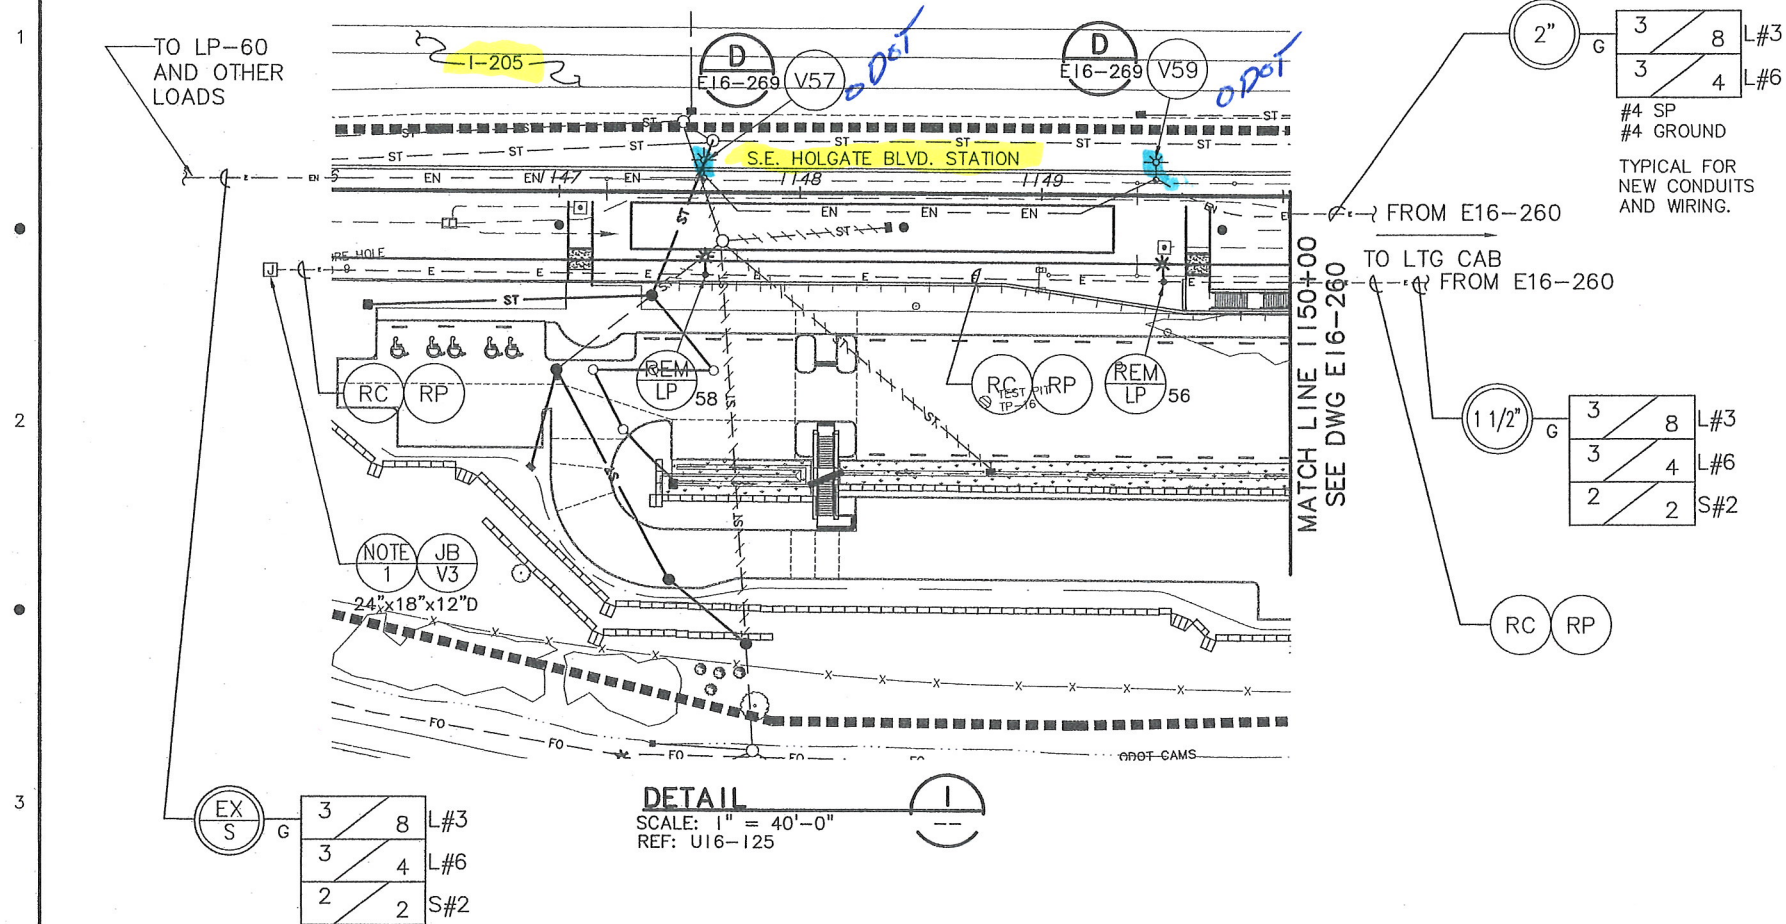


NOTES

1. AT JB-V3 TRANSITION FROM EX CONDUITS TO NEW CONDUITS. PROVIDE J.B.'S AND ALLOW FOR 5 FT OF ADDED FILL.

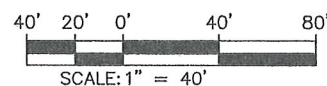

RECORD DRAWINGS

PREPARED BY: TRI-MET

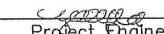APPROVED:  Project Engineering

DATE: NOV -5 2010

NOTE: THESE RECORD DRAWINGS REPRESENT THE BEST KNOWN INFORMATION ABOUT CONSTRUCTED FACILITIES. LOCATIONS SHOWN ARE NOT WARRANTED. UNDERGROUND UTILITIES MUST BE FIELD VERIFIED FOR ACTUAL LOCATION.


RECORD DRAWING

NO.	DATE	BY	APPD.	REVISIONS

MVD DESIGNED	10-19-06
RTG DRAWN	5-31-06
CHECKED	DATE
APPROVED	DATE



TRI-COUNTY METROPOLITAN TRANSPORTATION DISTRICT OF OREGON

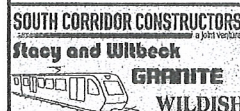

EPSILON
ENGINEERING, INC.
BEAVERTON, OR
503-526-1000



CAPITAL PROJECTS
AND
FACILITIES DIVISION
710 N.E. HOLLADAY STREET
PORTLAND, OREGON 97232

SUBMITTED:	DATE: 12/15/06	APPROVED:	DATE: 12/15/06
------------	----------------	-----------	----------------


SOUTH CORRIDOR PROJECT I-205 SEGMENT

ODOT LIGHT POLE RELOCATION
STA 1140+00 TO STA 1150+00

SCALE: 1" = 40'-0"	DRAWING NO.: E16-259	CONTRACT NO.: RH040161LE	SHEET NO.: 182
--------------------	----------------------	--------------------------	----------------

SEE DWG E16-259
MATCH LINE STA 1150+00

MATCH LINE STA 1160+00
SEE DWG E16-261

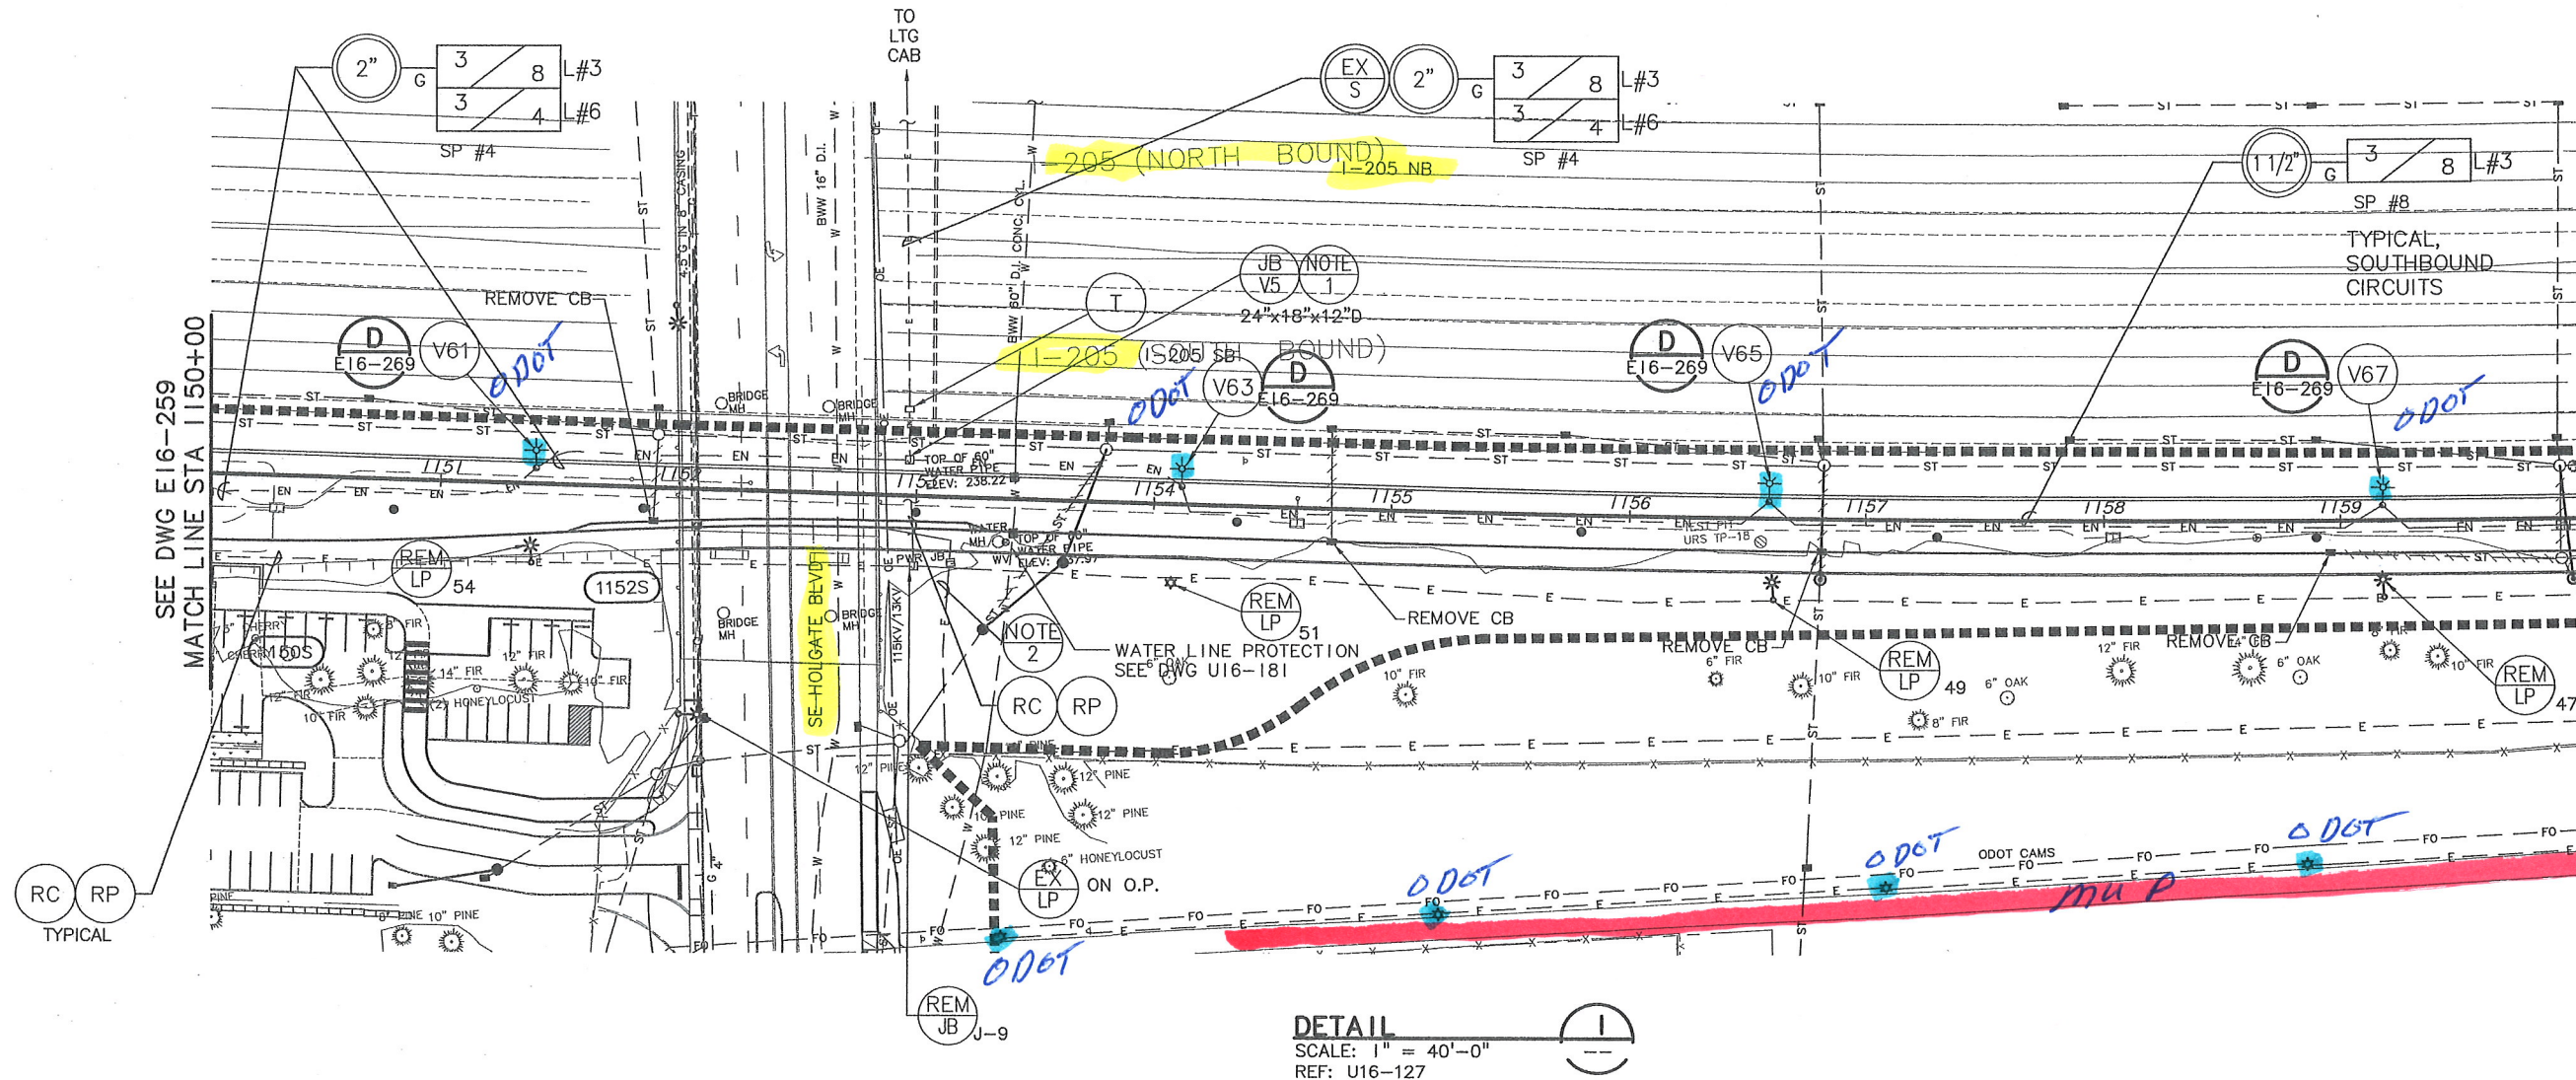

NOTES

1. AT JB-V5, SHORTEN CONDUITS TO JB-J-9 (TO BE DEMO). TRANSITION INTO NEW J.B..
2. AT EXISTING JB & CONDUIT SOUTH OF HOLGATE: FIELD VERIFY AND EXTEND CONDUIT AND WIRING TO MAINTAIN N-S CIRCUITS AT FENCELINE & PATHWAY
3. J-BOX AT EVERY POLE

RECORD DRAWINGS

PREPARED BY: TRI-MET
APPROVED:
DATE: NOV -5 2010 Project Engineering




40' 20' 0' 40' 80'
SCALE: 1" = 40'

NOTE: THESE RECORD DRAWINGS REPRESENT THE BEST KNOWN INFORMATION ABOUT CONSTRUCTED FACILITIES. LOCATIONS SHOWN ARE NOT WARRANTED. UNDERGROUND UTILITIES MUST BE FIELD VERIFIED FOR ACTUAL LOCATION.				
RECORD DRAWING				
NO.	DATE	BY	APPD.	REVISIONS
Original Drawing Stamped and Sealed by MARK J. VAN DOUSER				

TPC DESIGNED	10-19-06
JTH DRAWN	2-16-06
CHECKED	DATE
APPROVED	DATE

TRI-COUNTY METROPOLITAN TRANSPORTATION DISTRICT OF OREGON	
SOUTH CORRIDOR CONSTRUCTORS	
Stacy and Wilbeck	GRANITE WILDISH
EPSILON ENGINEERING, INC.	
BEAVERTON, OR 503-526-1000	
TRI-MET	
CAPITAL PROJECTS AND FACILITIES DIVISION	
710 N.E. HOLLADAY STREET PORTLAND, OREGON 97232	
SUBMITTED:	DATE: 12/15/06
APPROVED:	DATE: 12/15/06


SOUTH CORRIDOR PROJECT			
I-205 SEGMENT			
ODOT LIGHT POLE RELOCATION			
STA 1150+00 TO STA 1160+00			
SCALE: 1" = 40'-0"	DRAWING NO.: E16-260-AX	CONTRACT NO.: RH040161LE	SHEET NO.: 183

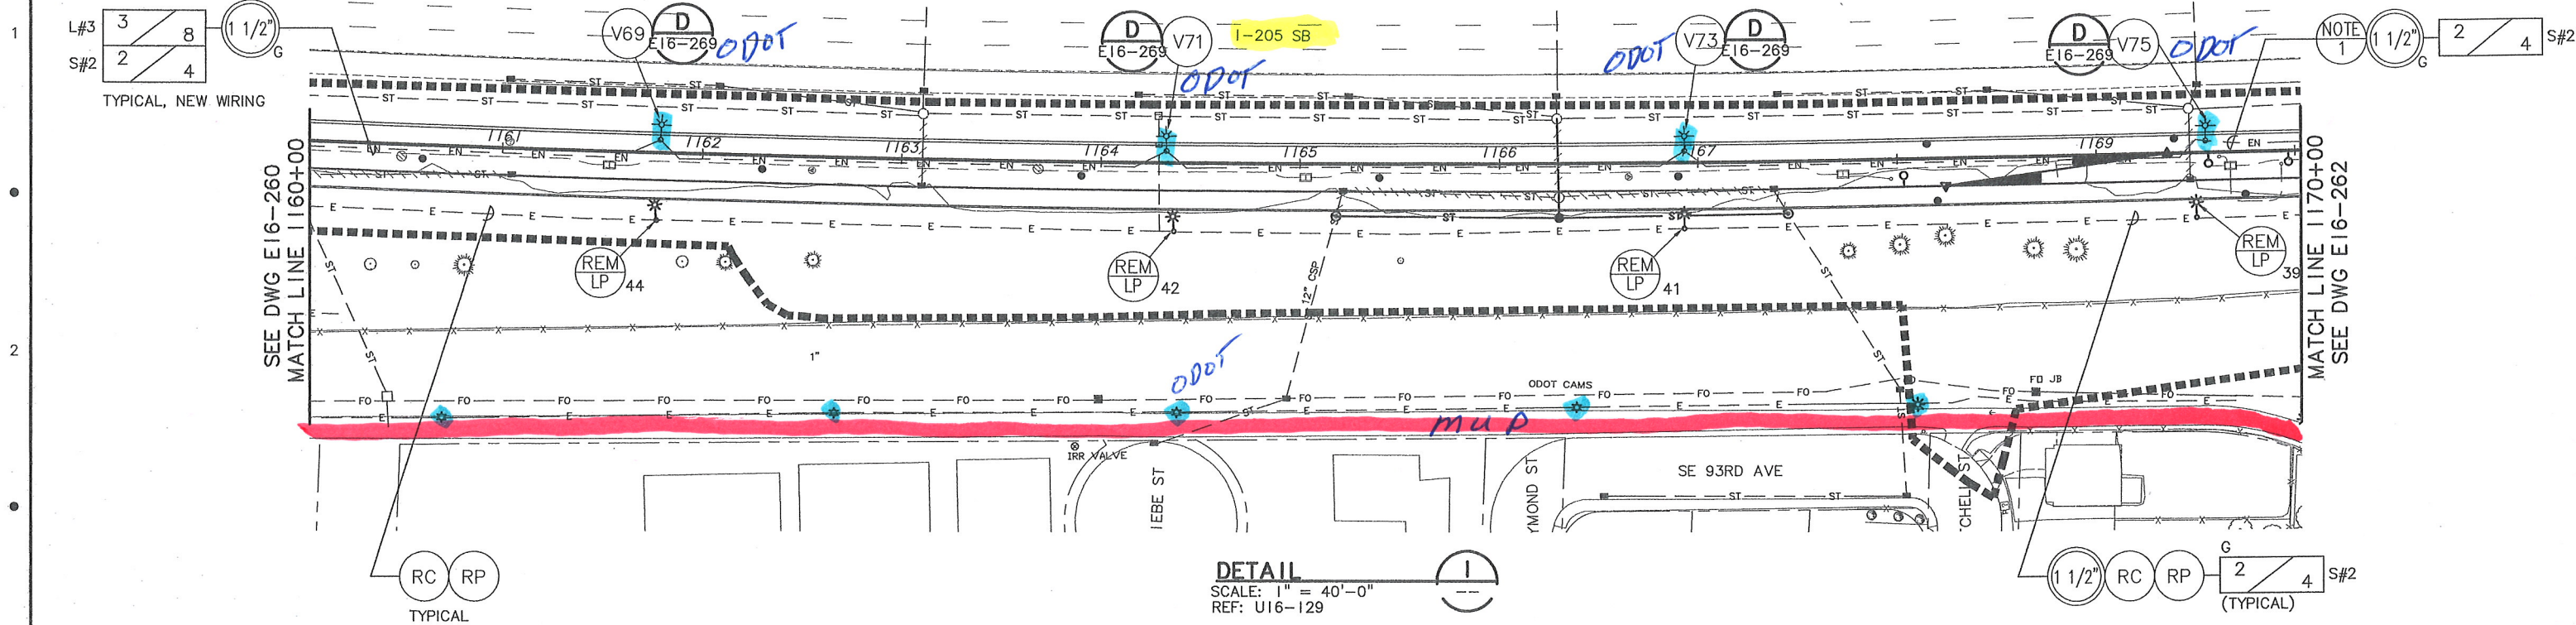

- NOTES**
1. AT LP-V75, INSTALL NEW CONDUIT & WIRES TO SIGN. FIELD LOCATE SIGN AND TRANSITION POINT FOR CONDUIT. (APPROX. STA N.B. 1178+25)
 2. J-BOX AT EVERY POLE

RECORD DRAWINGS
 PREPARED BY: TRI-MET
 APPROVED: _____
 DATE: NOV -5 2010

I-205 LIGHT RAIL
EXHIBIT D

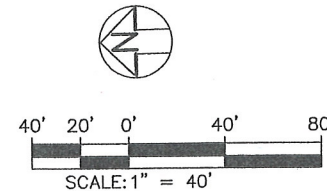

NOTE: THESE RECORD DRAWINGS REPRESENT THE BEST KNOWN INFORMATION ABOUT CONSTRUCTED FACILITIES. LOCATIONS SHOWN ARE NOT WARRANTED. UNDERGROUND UTILITIES MUST BE FIELD VERIFIED FOR ACTUAL LOCATION.

RECORD DRAWING

NO.	DATE	BY	APPD.	REVISIONS
		CHK.		

MVD DESIGNED	10-19-06
RTG DRAWN	5-31-06
CHECKED	DATE
APPROVED	DATE

TRI-COUNTY METROPOLITAN TRANSPORTATION DISTRICT OF OREGON

SOUTH CORRIDOR CONSTRUCTORS
 Stacy and Wilbeck
 GRANITE
 WILDISH

EPSILON ENGINEERING, INC.
 BEAVERTON, OR
 503-526-1000

CAPITAL PROJECTS AND FACILITIES DIVISION
 710 N.E. HOLLADAY STREET
 PORTLAND, OREGON 97232

SUBMITTED: DATE: 12/15/06

APPROVED: DATE: 12/15/06

SOUTH CORRIDOR PROJECT		I-205 SEGMENT	
ODOT LIGHTPOLE RELOCATION		STA 1160+00 TO STA 1170+00	
SCALE: 1" = 40'-0"	DRAWING NO.: E16-261	CONTRACT NO.: RH040161LE	SHEET NO.: 184