


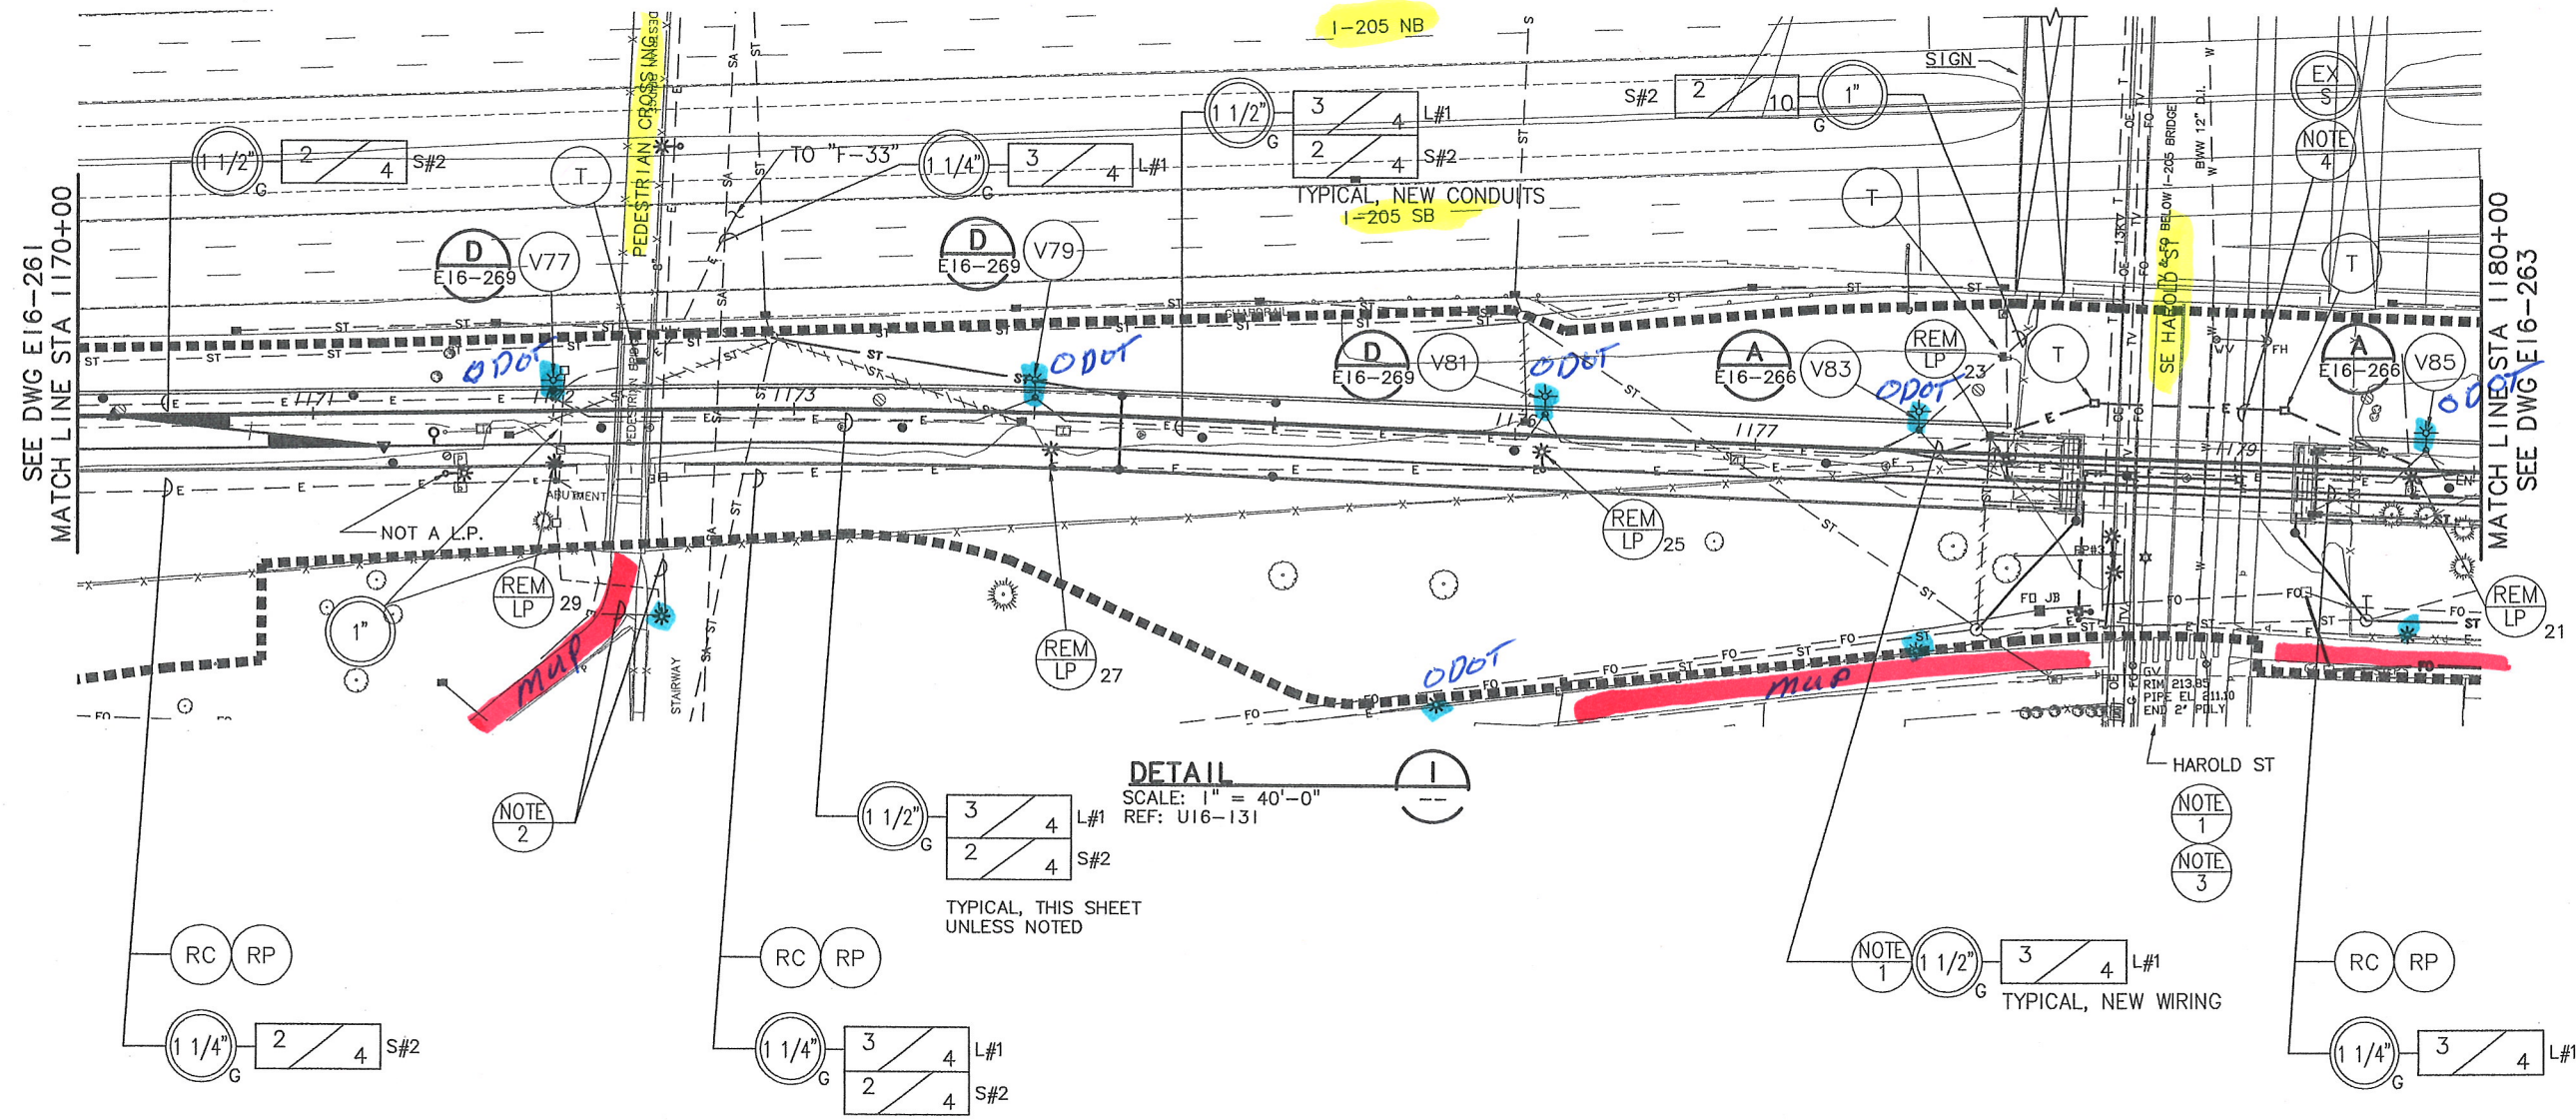


DETAIL
SCALE: 1" = 40'-0"
REF: U16-131

- NOTES:**
1. LIGHT RAIL TRACKS GO OVER HAROLD STREET. AVOID BRIDGE ABUTMENTS WHEN INSTALLING NEW CONDUITS. PROVIDE JB'S AS REQUIRED BY N.E.C.
 2. AT PEDESTRIAN OVERCROSSING, WEST END: MODIFY CONDUITS AND WIRING AS NEEDED TO MAINTAIN ROADWAY LIGHTING AND OTHER CIRCUITS.
 3. NEAR HAROLD STREET AT NEW TRACKS, LOCATE AND PROTECT/RELOCATE CIRCUIT(S) TO PATH LIGHTING.
 4. AT CKT FROM LP-V83 TO LP-V85: RE-USE PORTION OF CONDUIT UNDER HAROLD ST., ROUTE NEW CONDUIT TO AVOID BRIDGE ABUTMENTS.
 5. J-BOX AT EVERY POLE

RECORD DRAWINGS
PREPARED BY: TRI-MET
APPROVED: *[Signature]*
DATE: NOV - 5 2010 Project Engineering


I-205 LIGHT RAIL
EXHIBIT D

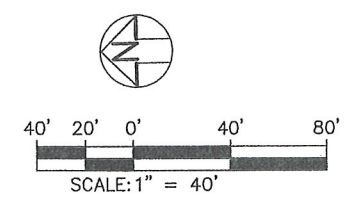

NOTE: THESE RECORD DRAWINGS REPRESENT THE BEST KNOWN INFORMATION ABOUT CONSTRUCTED FACILITIES. LOCATIONS SHOWN ARE NOT WARRANTED. UNDERGROUND UTILITIES MUST BE FIELD VERIFIED FOR ACTUAL LOCATION.				RECORD DRAWING		TRI-COUNTY METROPOLITAN TRANSPORTATION DISTRICT OF OREGON		SOUTH CORRIDOR PROJECT I-205 SEGMENT ODOT LIGHT POLE RELOCATION STA 1170+00 TO STA 1180+00	
MVD DESIGNED 10-19-06 DATE		RTG DRAWN 5-31-06 DATE		CHECKED DATE		APPROVED DATE		SUBMITTED DATE	
NO.		DATE		BY		APPD.		REVISIONS	
CHK.		DATE		BY		APPD.		REVISIONS	
Original Drawing Stamped and Sealed by MARK J. VAN DUSER									
SOUTH CORRIDOR CONSTRUCTORS Stacy and Wilbeck GRANITE WILDISH		EPSILON ENGINEERING, INC. BEAVERTON, OR 503-526-1000		TRI-MET		CAPITAL PROJECTS AND FACILITIES DIVISION 710 N.E. HOLLADAY STREET PORTLAND, OREGON 97232		SCALE: 1" = 40'-0" DRAWING NO.: E16-262-AX CONTRACT NO.: RH040161LE SHEET NO.: 185	
DATE: 12/15/06		DATE: 12/15/06		DATE: 12/15/06		DATE: 12/15/06		DATE: 12/15/06	

NOTES:

1. PROVIDE CONDUIT EXPANSION FITTINGS AS REQUIRED.
2. PROVIDE CONCRETE FOUNDATION UNDER TYPE "C" CAB. PER C.O.P. DWG. No. 304E.
3. GROUND SERVICE WITH #8 CU TO GROUND ROD.
4. PENDANT MOUNT LUMINAIRE WITH 3/4"GRS AND LINE BOTTOM OF LUMINAIRE WITH BOTTOM OF GIRDERS.
5. REFER TO E16-217/218 FOR LUMINAIRE SCHEDULE. PROVIDE LUMINAIRE C-4 WITH 100 WATT HPS LAMP
6. PROVIDE SERVICE FROM PGE POLE WITH 120/240V-1Ø LOCATE NON-HETERD BASE MT'D CAB. (TYP) WITHIN 10 FT. OF PGE POLE. SERVICE CHARGES TO BE PAID BY CITY PER CITY RATE SCHEDULE WITH PGE.
7. PROVIDE FOUR ELECTRIC TYPE "C" NON-METERED (C.O.P. STD.) BASE MOUNTED CABINET WITH:
100A-2P MAIN
20A-2P UNDERPASS LIGHTING
20A-1P PHOTOCELL CONTROL
MOUNT PC ON TOP OF CABINET FACING NORTH
8. AS REQ'D BY PDOT, PROVIDE ALL UNDERGROUND CONDUITS 1 1/2" PVC (SCH 80) AND GRS ABOVE GROUND. FOLLOW PDOT STANDARD SPEC. AND USE #12 YELLOW TRACER WIRE AND PUT IN MULE-TAPE.
9. FOR STREET LIGHT INSPECTIONS, CONTACT DALE KIRKINEN, C.O.P. AT 503-823-8889.
10. EXTEND AND CAP 1 - 1 1/2" PVC(80) FOR FUTURE USE.
11. ALL ELECTRICAL INSTALLATION SHALL COMPLY WITH LATEST CODES AND PDOT STANDARDS.

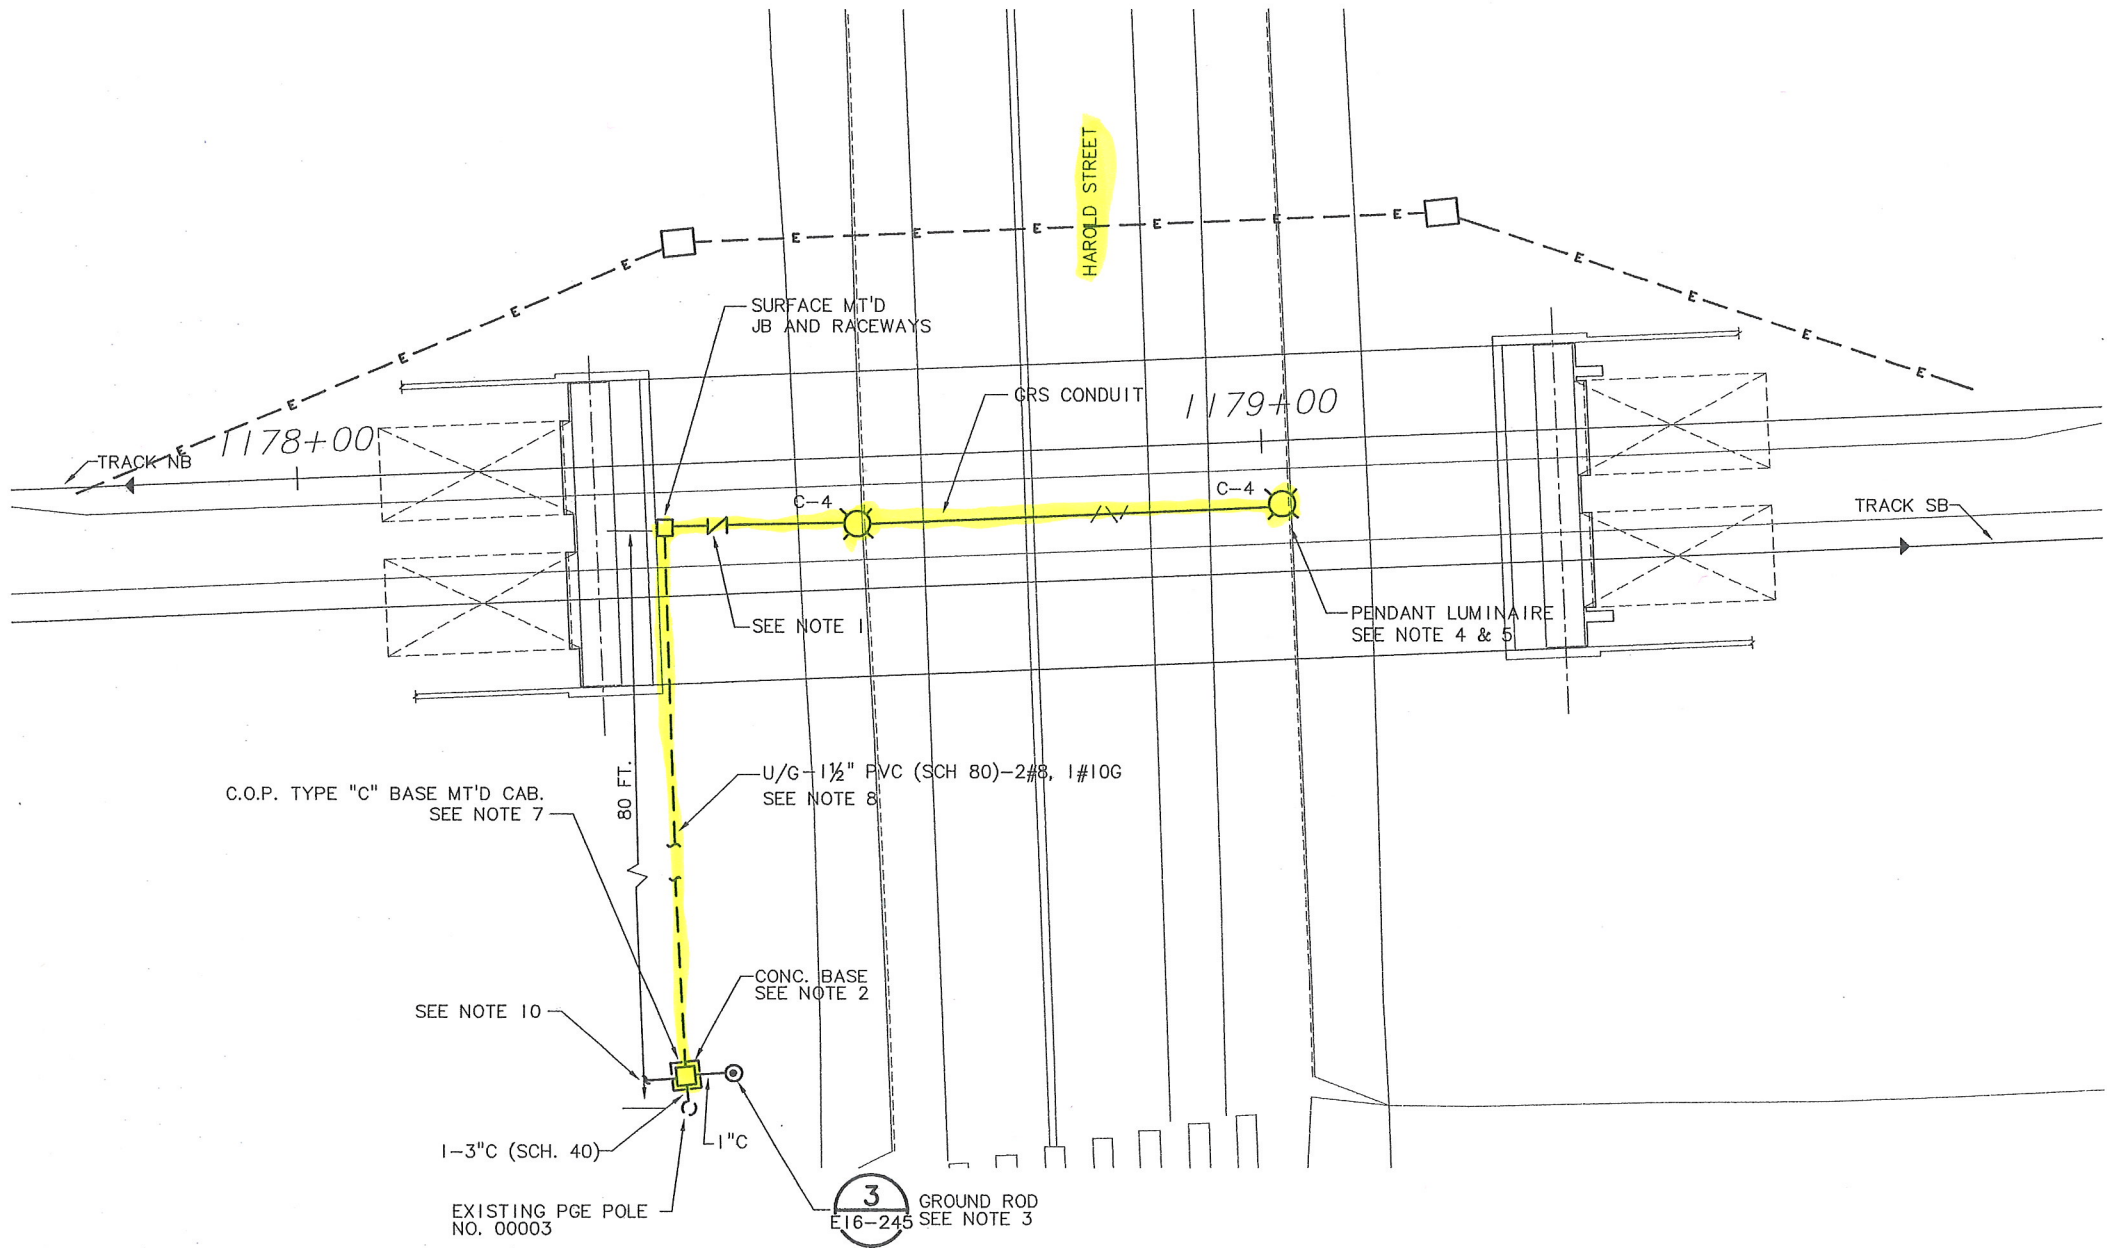

I-205
LIGHT RAIL
EXHIBIT D
RECORD DRAWINGS
PREPARED BY: TRI-MET
APPROVED: _____ Project Engineering
DATE: NOV -5 2010

NOTE: THESE RECORD DRAWINGS REPRESENT THE BEST KNOWN INFORMATION ABOUT CONSTRUCTED FACILITIES. LOCATIONS SHOWN ARE NOT WARRANTED. UNDERGROUND UTILITIES MUST BE FIELD VERIFIED FOR ACTUAL LOCATION.

RECORD DRAWING

NO.	DATE	BY	APPD.	REVISIONS
		CHK.		

BSD DESIGNED	7/11/06 DATE
RJ DRAWN	7/12/06 DATE
CHECKED	DATE
APPROVED	DATE

TRI-COUNTY METROPOLITAN TRANSPORTATION DISTRICT OF OREGON

SOUTH CORRIDOR CONSTRUCTORS
Stacy and Wilbeck
GRANITE
WILDISH

DAVID EVANS AND ASSOCIATES INC.

DHILLON ENGINEERS, INC.
PORTLAND, OR

TRI-MET
CAPITAL PROJECTS
AND
FACILITIES DIVISION
710 N.E. HOLLADAY STREET
PORTLAND, OREGON 97232

SUBMITTED: 12/15/06


DATE: 12/15/06

APPROVED: 12/15/06

DATE: 12/15/06

SOUTH CORRIDOR PROJECT
I-205 SEGMENT
HAROLD STREET UNDERPASS-LIGHTING PLAN

SCALE: 1" = 10'-0"	DRAWING NO.: E16-228-AX	CONTRACT NO.: RH040161LE	SHEET NO.: 162
--------------------	-------------------------	--------------------------	----------------

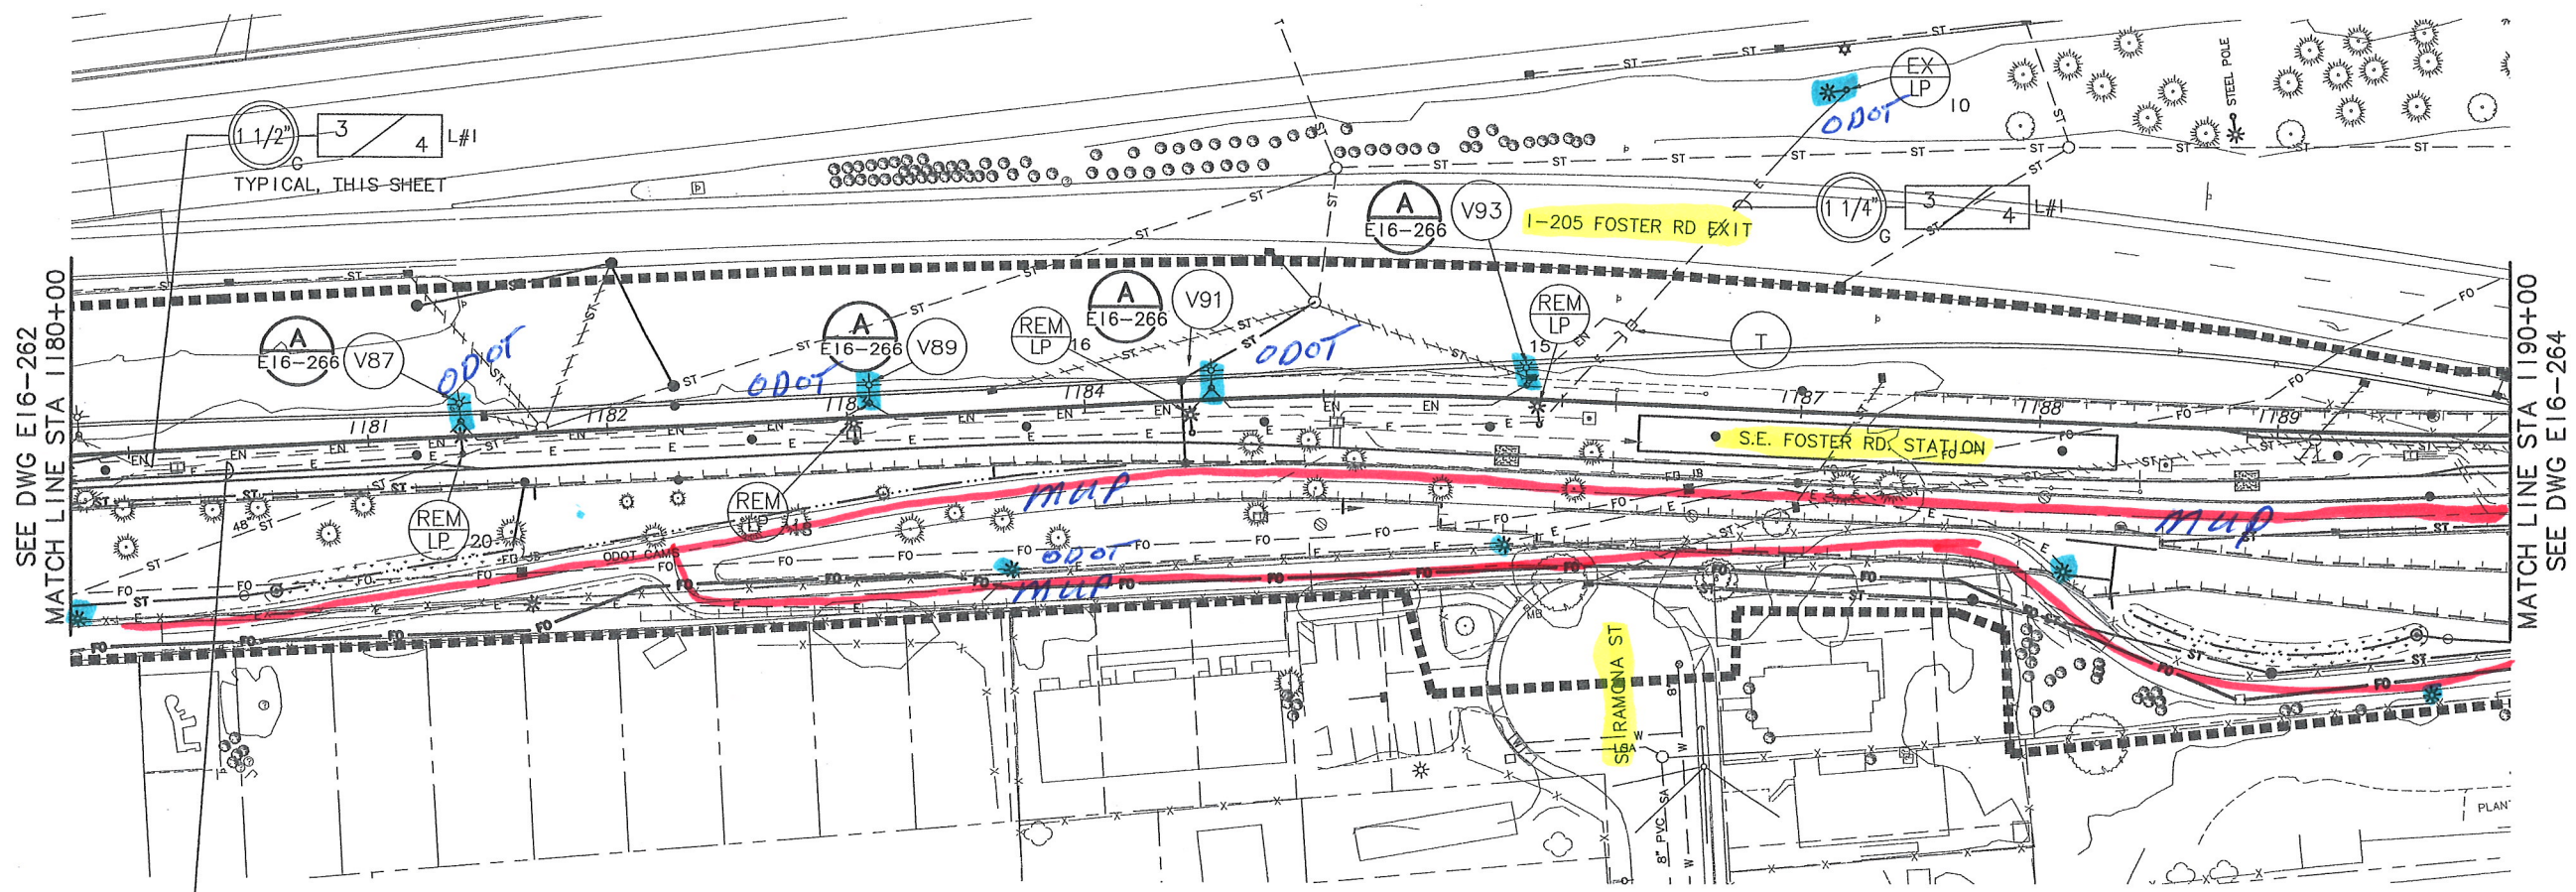


DETAIL
SCALE: 1" = 40'-0"
REF: U16-133

NOTES:
1. J-BOX AT EVERY POLE

I-205
LIGHT RAIL
EXHIBIT D

RECORD DRAWINGS
PREPARED BY: TRI-MET
APPROVED: *[Signature]*
DATE: NOV -5 2010 Project Engineering

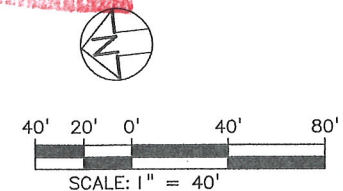

NOTE: THESE RECORD DRAWINGS REPRESENT THE BEST KNOWN INFORMATION ABOUT CONSTRUCTED FACILITIES. LOCATIONS SHOWN ARE NOT WARRANTED. UNDERGROUND UTILITIES MUST BE FIELD VERIFIED FOR ACTUAL LOCATION.

RECORD DRAWING

NO.	DATE	BY	APPD.	REVISIONS
		CHK.		

MVD DESIGNED	10-19-06
RTG DRAWN	5-31-06
CHECKED	DATE
APPROVED	DATE

TRI-COUNTY METROPOLITAN TRANSPORTATION DISTRICT OF OREGON

SOUTH CORRIDOR CONSTRUCTORS
Stacy and Wilbeck
GRANITE
WILDISH

EPSILON
ENGINEERING, INC.
BEAVERTON, OR
503-526-1000

CAPITAL PROJECTS
AND
FACILITIES DIVISION
710 N.E. HOLLADAY STREET
PORTLAND, OREGON 97232

SUBMITTED: 12/15/06

DATE: 12/15/06

APPROVED: 12/15/06

DATE: 12/15/06

SOUTH CORRIDOR PROJECT I-205 SEGMENT	
ODOT LIGHT POLE RELOCATION STA 1180+00 TO STA 1190+00	
SCALE: 1" = 40'-0"	DRAWING NO.: E16-263
CONTRACT NO.: RH040161E	SHEET NO.: 184

1. REFER TO DRAWING E16-141 FOR NOTES.



PREPARED BY: TRI-MET

APPROVED: _____
2010 Project Engineering

DATE: NOV - 5 2010 Project Engineering

EXHIBIT



SCALE: 1" = 20'

RECORD DRAWING

SOUTH CORRIDOR CONSTRUCTORS
a joint venture
Stacy and Wilbeck
GRANITE
WILDISH

DE **DHILLON ENGINEERS, INC.**
PORTLAND, OR

DAVID EVANS ASSOCIATES INC.

TRIOMET

**CAPITAL PROJECTS
AND
FACILITIES DIVISION**
710 N.E. HOLLADAY STREET
PORTLAND, OREGON 97232

**SOUTH CORRIDOR PROJECT
I-205 SEGMENT
S.E. FOSTER ROAD STATION
PATHWAY LIGHTING PLAN-NORTH END**

SUBMITTED:

DATE: _____

12/15/06

APPROVED:

DATE:

12/15/06

SCALE:

$$1'' = 20' - 0''$$


DRAWING NO.:
E16-140-CX

CONTRACT NO.:	RH040161LE	SH
---------------	------------	----

SHEET NO.: 101

NOTES:

- FOR LUMINAIRE SCHEDULE REFER TO DRAWING E16-217/218.
- ROUTE POWER CONDUIT INTO FOUNDATION OF CANOPY SUPPORT UP TO CANOPY AND TERMINATE IN J. BOX.
- VERIFY EXACT LOCATIONS OF PANELS BEFORE CONDUITS ROUGH-INS.
- MINIMUM CONDUCTOR SIZE SHALL BE #8 WITH #10G.
- P-6B IS THE SAME AS P-6 EXCEPT WITH A TYPE 3 DISTRIBUTION.
- ADDITIONAL CONDUCTORS SHOWN ARE FOR CCTV CAMERA POWER. SEE DRAWING E16-141 FOR CCTV CAMERA LOCATIONS.
- REFER TO ARCHITECTURAL DRAWINGS FOR EXACT LOCATIONS OF LUMINAIRES.
- NOT USED
- INSTALL 1" C, 2#8, 1#10 GND TO KEEP CONTINUITY OF EXISTING MULTI-USE PATH CIRCUIT.
- NOT USED
- OCS POLE MOUNT LUMINAIRE. MOUNT AT 12'-0" AFF.
- NOT USED
- CCTV CAMERAS ARE PROVIDED BY OTHERS. 24V DC POWER SUPPLY IS LOCATED IN THE ELEC. COMM. CABINET FOR CAMERA POWER. 24V DC POWER SUPPLY FED FROM PPI-CKT.22.
- REFER TO DRAWING E16-141 AND E16-217 FOR LIGHT POLE REQUIREMENTS. REFER TO DRAWING J16-232 FOR CAMERAS AND MOUNTING REFERENCES.

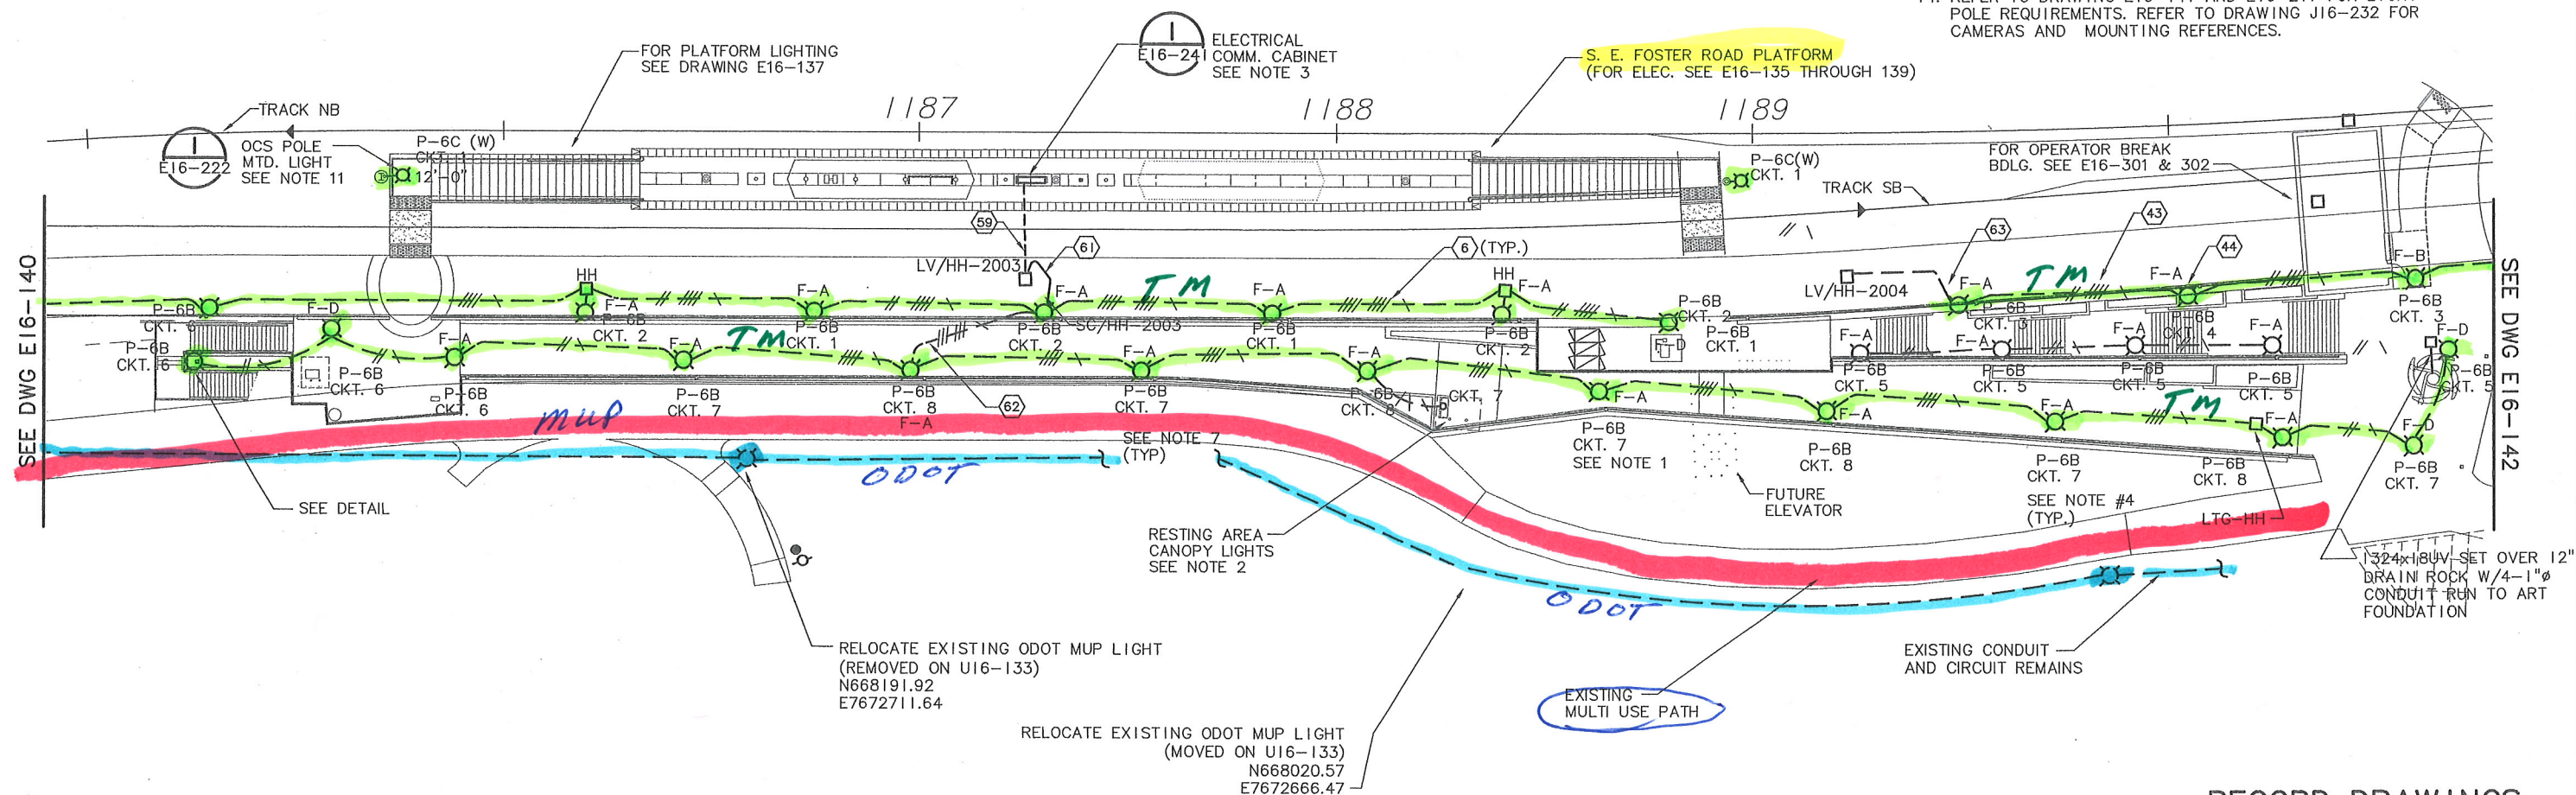

PATHWAY LIGHTING PLAN - CENTER
(SEE NOTE 5)

RECORD DRAWINGS

PREPARED BY: TRI-MET
APPROVED: *[Signature]*
DATE: NOV - 5 2010 Project Engineering

**I-205
LIGHT RAIL**
EXHIBIT D

20' 10' 0' 20' 40'
SCALE: 1" = 20'

NOTE: THESE RECORD DRAWINGS REPRESENT THE BEST KNOWN INFORMATION ABOUT CONSTRUCTED FACILITIES. LOCATIONS SHOWN ARE NOT WARRANTED. UNDERGROUND UTILITIES MUST BE FIELD VERIFIED FOR ACTUAL LOCATION.

RECORD DRAWING

BSD DESIGNED 5/29/06
RJ DRAWN 6/01/06
CHECKED
APPROVED

TRI-COUNTY METROPOLITAN TRANSPORTATION DISTRICT OF OREGON
SOUTH CORRIDOR CONSTRUCTORS
Stacy and Wilbeck
GRAFITE
WILDISH

DHILLON ENGINEERS, INC.
PORTLAND, OR
DAVID EVANS AND ASSOCIATES INC.

TRI-MET


CAPITAL PROJECTS
AND
FACILITIES DIVISION
710 N.E. HOLLADAY STREET
PORTLAND, OREGON 97232

**SOUTH CORRIDOR PROJECT
I-205 SEGMENT
S.E. FOSTER ROAD STATION
PATHWAY LIGHTING PLAN-CENTER**

NO.	DATE	BY	APPD.	REVISIONS

SUBMITTED: 12/15/06
DATE: 12/15/06
SCALE: 1" = 20'-0"
DRAWING NO.: E16-141-EX
CONTRACT NO.: RH040161LE
SHEET NO.: 102

NOTES:
REFER TO DRAWING E16-141 FOR NOTES.

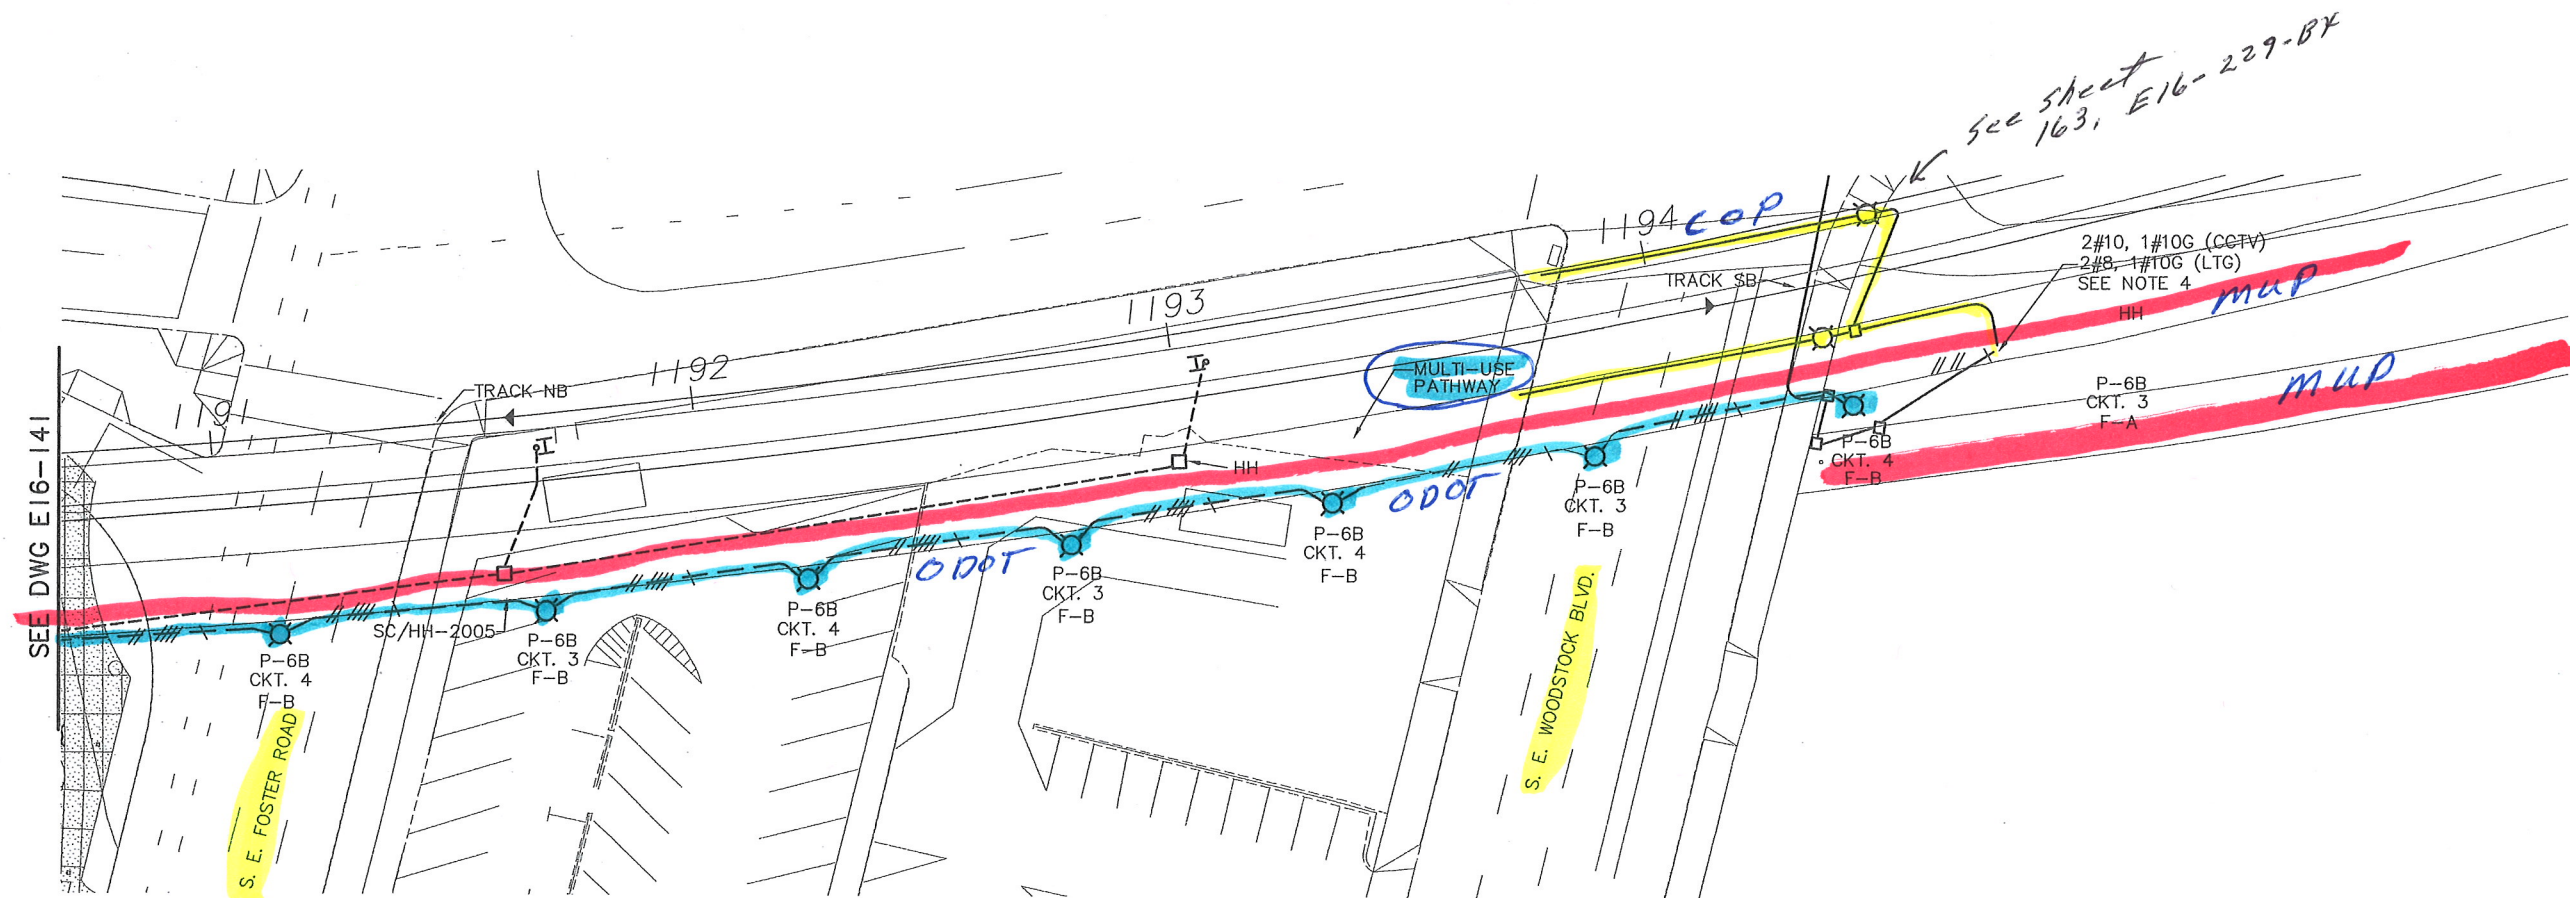


PATHWAY LIGHTING PLAN - SOUTH END

RECORD DRAWINGS
PREPARED BY: TRI-MET
APPROVED: *George*
DATE: NOV -5 2013
Project Engineering

I-205
LIGHT RAIL

EXHIBIT D

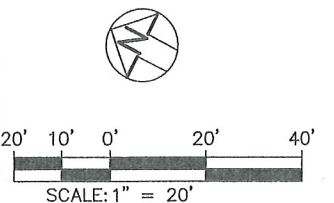

NOTE: THESE RECORD DRAWINGS REPRESENT THE BEST KNOWN INFORMATION ABOUT CONSTRUCTED FACILITIES. LOCATIONS SHOWN ARE NOT WARRANTED. UNDERGROUND UTILITIES MUST BE FIELD VERIFIED FOR ACTUAL LOCATION.

RECORD DRAWING

NO.	DATE	BY	APPD.	REVISIONS
		CHK		

BSD	5/29/06
DESIGNED	DATE
RJ	6/01/06
DRAWN	DATE
CHECKED	DATE
APPROVED	DATE



TRI-COUNTY METROPOLITAN TRANSPORTATION DISTRICT OF OREGON

SOUTH CORRIDOR CONSTRUCTORS
Stacy and Wilbeck
GRANITE
WILDISH

DHILLON ENGINEERS, INC.
PORTLAND, OR
DAVID EVANS
AND ASSOCIATES INC.

TRI-MET

CAPITAL PROJECTS
AND
FACILITIES DIVISION
710 N.E. HOLLADAY STREET
PORTLAND, OREGON 97232

SOUTH CORRIDOR PROJECT
I-205 SEGMENT
S.E. FOSTER ROAD STATION
PATHWAY LIGHTING PLAN-SOUTH END

SUBMITTED:

DATE:

12/15/06

APPROVED:

DATE:

12/15/06

SCALE:

1" = 20'-0"

DRAWING NO.:
E16-142-AX

CONTRACT NO.:
RH040161LE

SHEET NO.:
103


NOTES:

1. REFER TO DRAWING E16-217/218 FOR LUMINAIRE SCHEDULE. PROVIDE LUMINAIRE C-4 WITH 100 WATT HPS LAMP
2. PENDANT-MOUNT LUMINAIRES WITH 3/4" GRS AND LINE BOTTOM OF LUMINAIRE WITH BOTTOM OF GIRDERS.
3. PROVIDE CONDUIT EXPANSION FITTINGS AS REQUIRED.
4. PROVIDE FOUR ELECTRIC TYPE "C" NON-METERED (C.O.P. STD.) BASE MOUNTED CABINET WITH:
100A-2P MAIN
20A-1P UNDERPASS LIGHTING
20A-1P PHOTOCELL CONTROL
MOUNT PC ON TOP OF CABINET FACING NORTH
5. PROVIDE CONCRETE FOUNDATION UNDER TYPE "C" CAB. PER C.O.P. DWG. No. 304E.

6. AS REQ'D BY PDOT, PROVIDE ALL UNDERGROUND CONDUITS 1 1/2" PVC (SCH 80) AND GRS ABOVE GROUND. FOLLOW PDOT STANDARD SPEC. AND USE #12 YELLOW TRACER WIRE AND PUT IN MULE-TAPE.
7. GROUND SERVICE WITH #8 CU TO GROUND ROD.
8. FOR STREET LIGHT INSPECTIONS, CONTACT DALE KIRKINEN, C.O.P. AT 503-823-8889.
9. EXTEND AND CAP 1 - 1 1/2" PVC(80) FOR FUTURE USE.
10. ALL ELECTRICAL INSTALLATION SHALL COMPLY WITH LATEST CODES AND PDOT STANDARDS.

RECORD DRAWINGS

PREPARED BY: TRI-MET
APPROVED: *[Signature]*
DATE: NOV -5 2010 Project Engineering

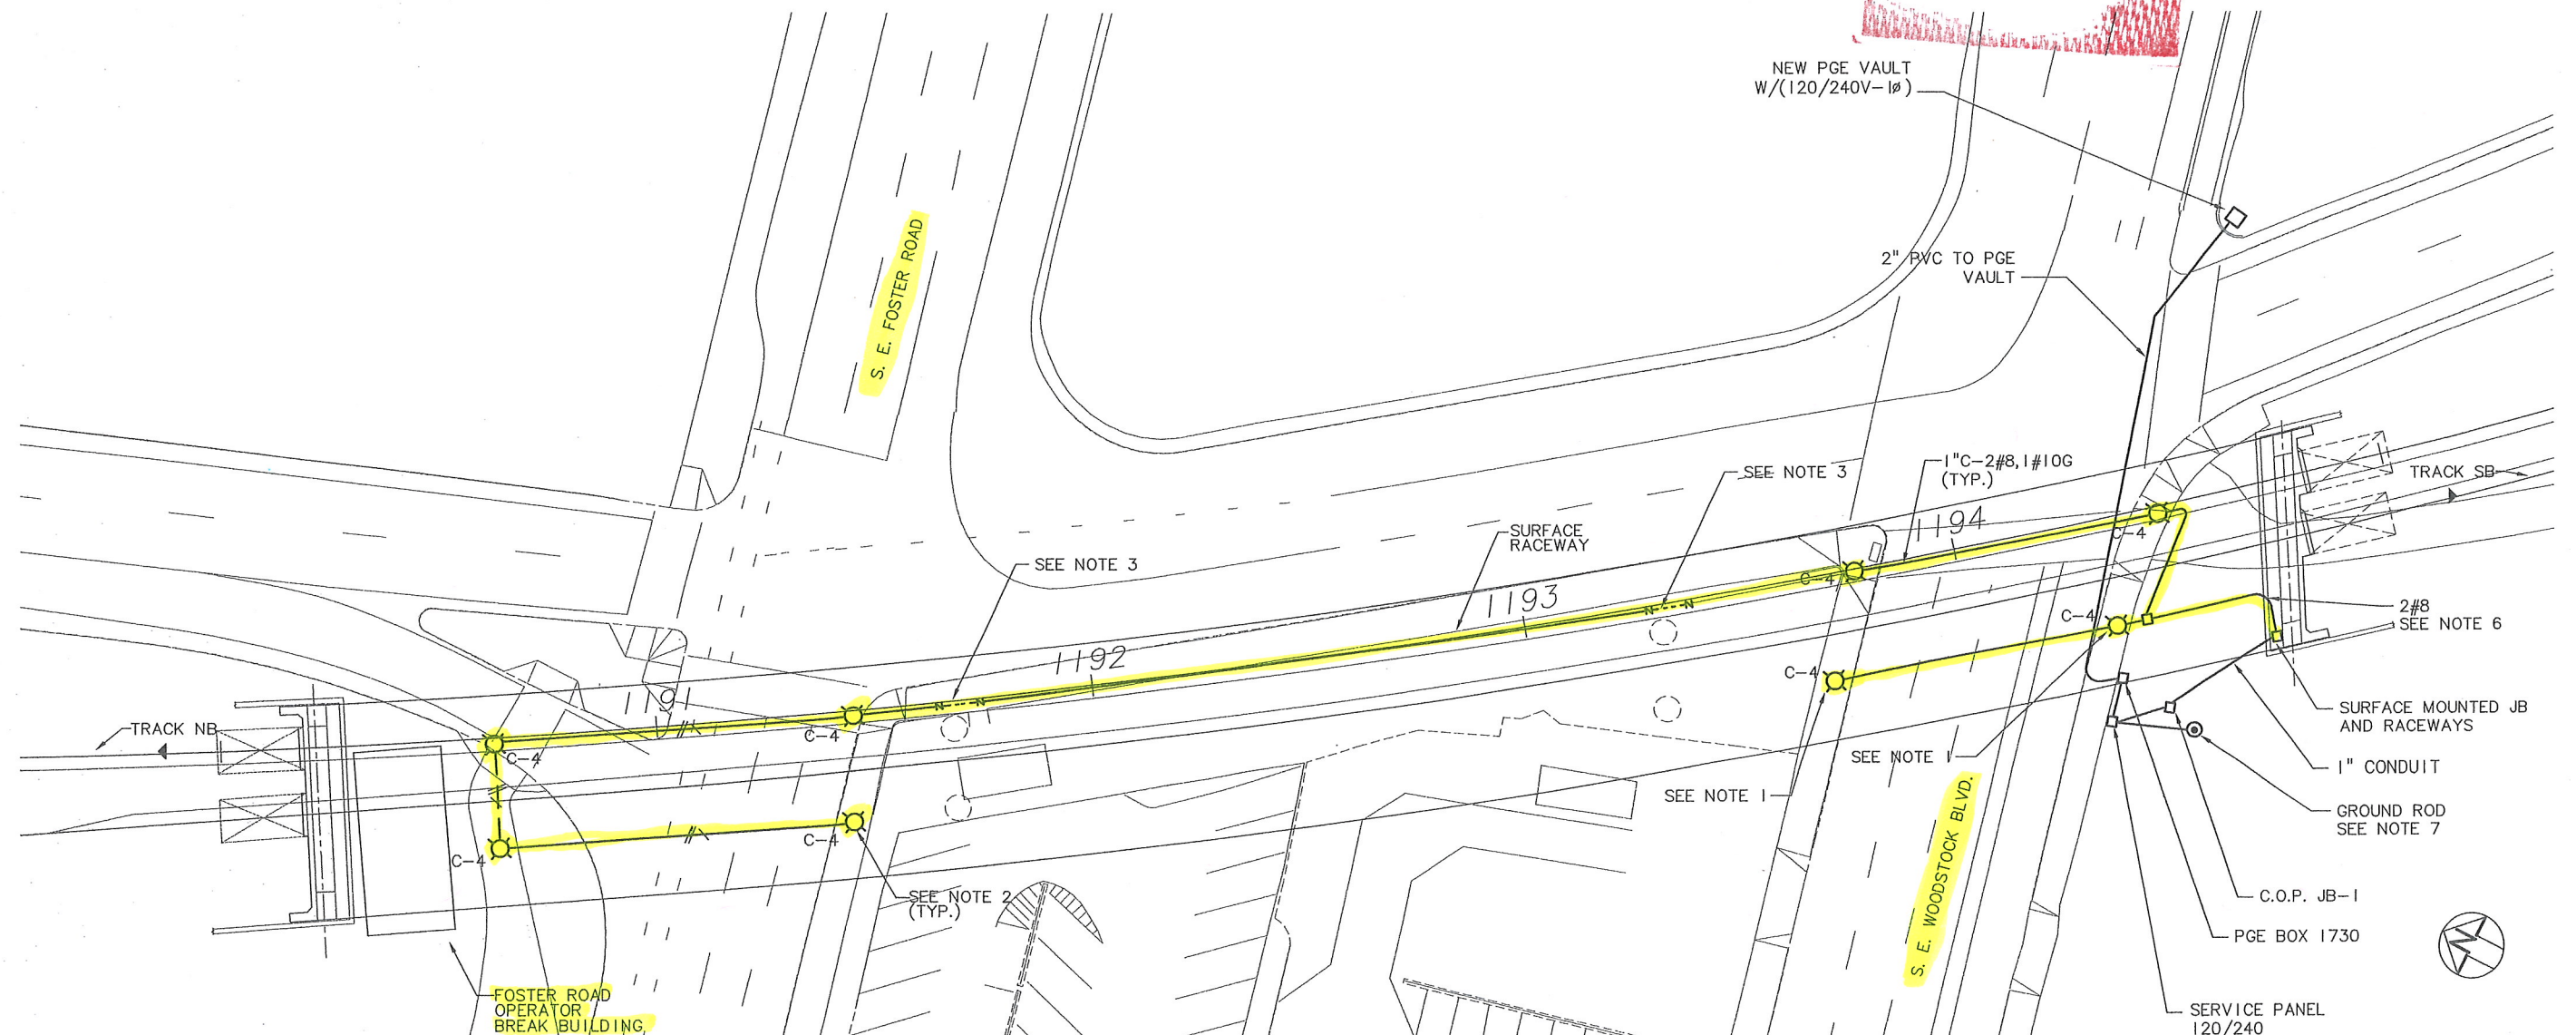

FOSTER RD. AND WOODSTOCK BLVD. UNDERPASS-LIGHTING PLAN

SEE NOTE 10

City of Portland

SERVICE PANEL 120/240 UNMETERED SEE NOTE 4
SCALE: 1" = 20'

NOTE: THESE RECORD DRAWINGS REPRESENT THE BEST KNOWN INFORMATION ABOUT CONSTRUCTED FACILITIES. LOCATIONS SHOWN ARE NOT WARRANTED. UNDERGROUND UTILITIES MUST BE FIELD VERIFIED FOR ACTUAL LOCATION.

RECORD DRAWING

NO.	DATE	BY	APPD.	REVISIONS
		CHK.		

BSD DESIGNED	7/11/06
RJ DRAWN	7/12/06
CHECKED	DATE
APPROVED	DATE



TRI-COUNTY METROPOLITAN TRANSPORTATION DISTRICT OF OREGON

SOUTH CORRIDOR CONSTRUCTORS
Stacy and Wilbeck
GRANITE
WILDISH AND ASSOCIATES INC.

DHILLON ENGINEERS, INC.
PORTLAND, OR
DAVID EVANS
AND ASSOCIATES INC.

TRI-MET


CAPITAL PROJECTS AND FACILITIES DIVISION
710 N.E. HOLLADAY STREET
PORTLAND, OREGON 97232

SUBMITTED:	DATE:	APPROVED:	DATE:
	12/15/06		12/15/06

SOUTH CORRIDOR PROJECT
I-205 SEGMENT
FOSTER ROAD AND WOODSTOCK BLVD UNDERPASS-LIGHTING PLAN

SCALE:	DRAWING NO.:	CONTRACT NO.:	SHEET NO.:
1" = 20'-0"	E16-229-BX	RH040161LE	163

SEE DWG E16-263
MATCH LINE STA 1190+00

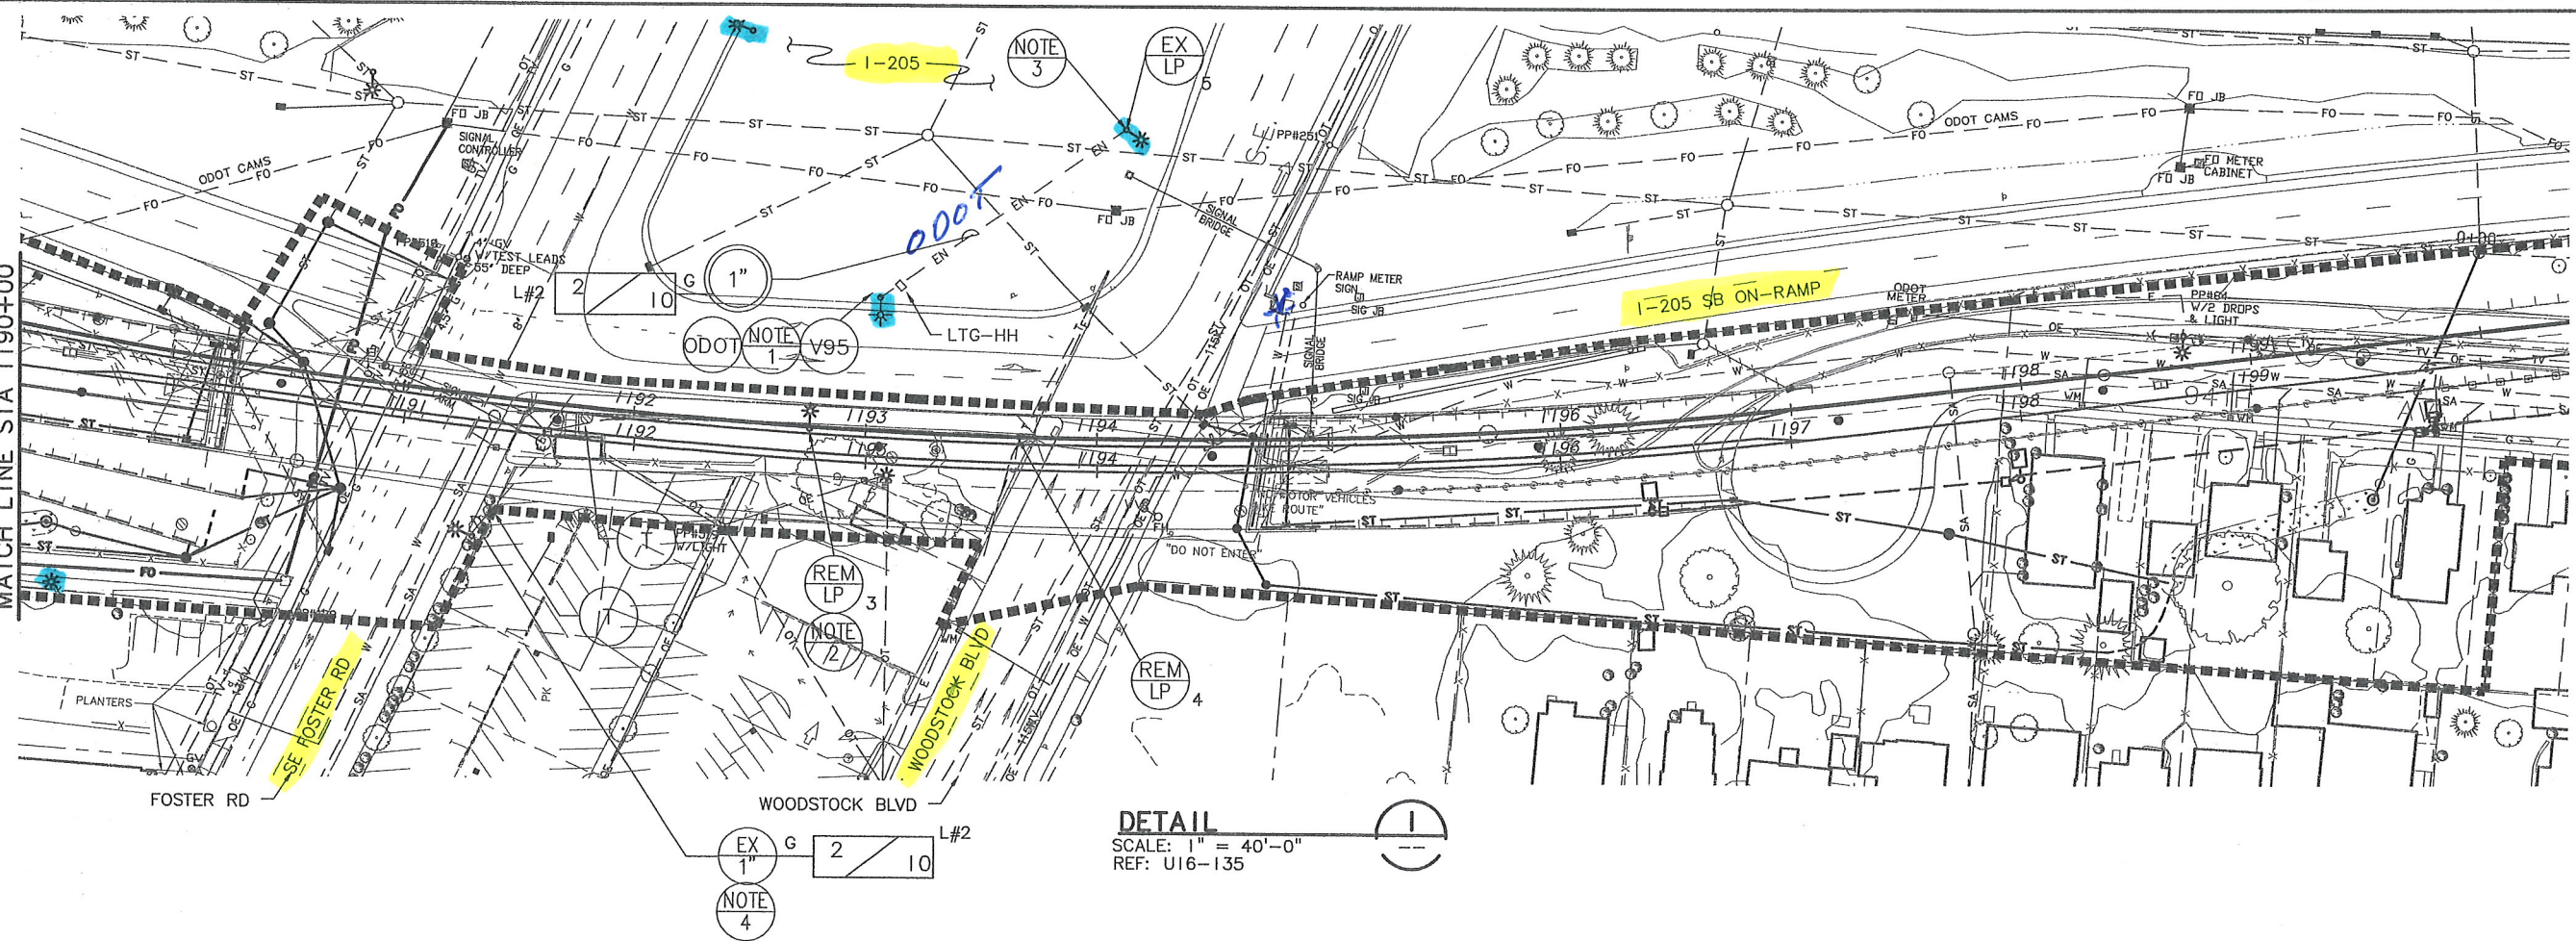


NOTES:

1. AT LP-V95, LOCATE AT MID-POINT ALONG CONNECTOR BETWEEN FOSTER ROAD AND WOODSTOCK. LOCATE CENTER OF POLE AT 3'-0" BEHIND SIDEWALK.
2. AT LP-3 AND LP-4, DEMO FOUNDATION. REPLACE WITH J.B. AND TRANSITION CONDUITS. RE-WORK WIRING.
3. AT LP-5, INSTALL J.B. AT BASE OF POLE. ROUTE EXISTING WIRING THRU THIS J.B. WITHIN THIS J.B, SPLICE NEW WIRING FOR LP-V95.
4. AT SW CORNER OF FOSTER ROAD INTERSECTION, RE-ROUTE ROADWAY LIGHTING CONDUITS TO AVOID CONFLICT WITH NEW BRIDGE

RECORD DRAWINGS

PREPARED BY: TRI-MET

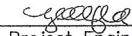APPROVED:  Project Engineering

DATE: NOV -5 2010



40' 20' 0' 40' 80'
SCALE: 1" = 40'

NOTE: THESE RECORD DRAWINGS REPRESENT THE BEST KNOWN INFORMATION ABOUT CONSTRUCTED FACILITIES. LOCATIONS SHOWN ARE NOT WARRANTED. UNDERGROUND UTILITIES MUST BE FIELD VERIFIED FOR ACTUAL LOCATION.

RECORD DRAWING

NO.	DATE	BY	APPD.	REVISIONS
		CHK.		

MVD DESIGNED	10-19-06 DATE
RTG DRAWN	5-31-06 DATE
CHECKED	DATE
APPROVED	DATE



TRI-COUNTY METROPOLITAN TRANSPORTATION DISTRICT OF OREGON

SOUTH CORRIDOR CONSTRUCTORS
Stacy and Wilbeck
GRANITE
WILDISH

 EPSILON
ENGINEERING, INC.
BEAVERTON, OR
503-526-1000

TRI-MET

CAPITAL PROJECTS
AND
FACILITIES DIVISION
710 N.E. HOLLADAY STREET
PORTLAND, OREGON 97232

SUBMITTED:

DATE:

12/15/06

APPROVED:

DATE:

12/15/06

SCALE:

1" = 40'-0"

DRAWING NO.:
E16-264-AX


CONTRACT NO.:
RH040161LE

SHEET NO.:
187

SOUTH CORRIDOR PROJECT
I-205 SEGMENT
ODOT LIGHT POLE RELOCATION
STA 1190+00 TO STA 1200+00



NOTES:
REFER TO E16-426 FOR GENERAL NOTES.

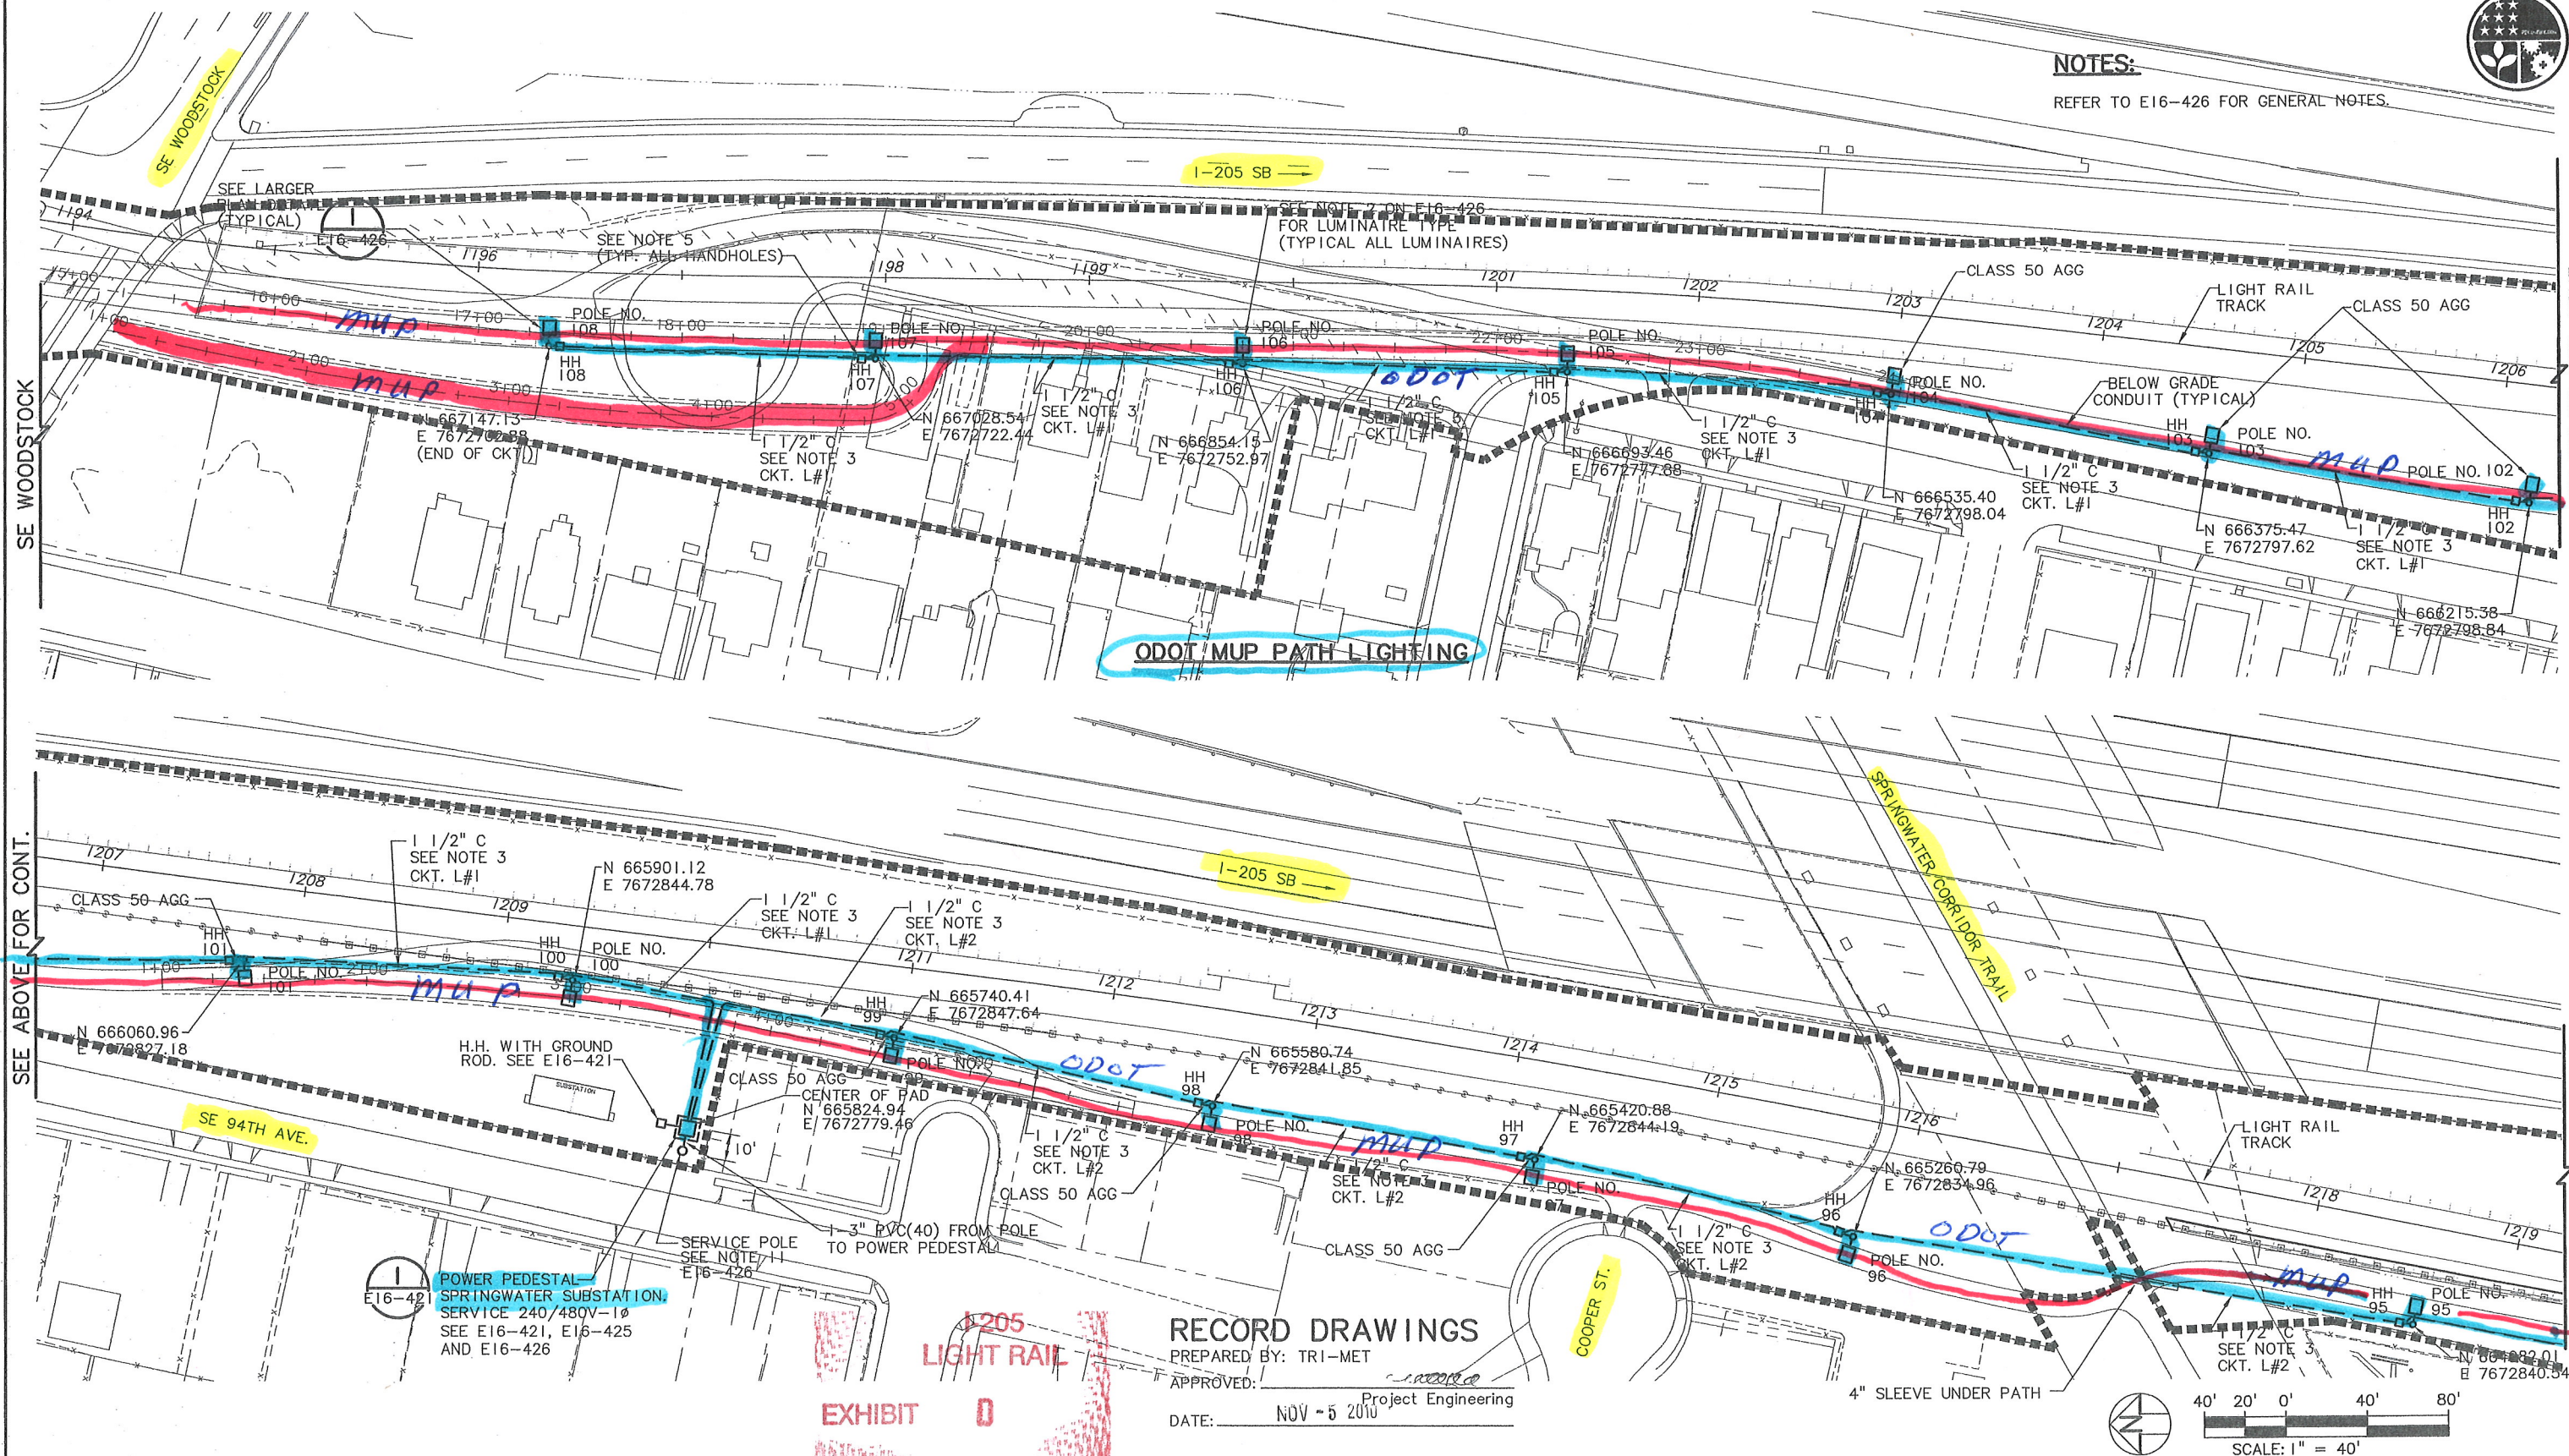

NOTE: THESE RECORD DRAWINGS REPRESENT THE BEST KNOWN INFORMATION ABOUT CONSTRUCTED FACILITIES. LOCATIONS SHOWN ARE NOT WARRANTED. UNDERGROUND UTILITIES MUST BE FIELD VERIFIED FOR ACTUAL LOCATION.

RECORD DRAWING

NO.	DATE	BY	APPD.	REVISIONS
		CHK.		

BSD DESIGNED	3/9/09
RJ DRAWN	3/9/09
BSD CHECKED	3/9/09
APPROVED	DATE

EXHIBIT 0

RECORD DRAWINGS
PREPARED BY: TRI-MET
APPROVED: *[Signature]*
DATE: NOV -5 2010

TRI-COUNTY METROPOLITAN TRANSPORTATION DISTRICT OF OREGON

SOUTH CORRIDOR CONSTRUCTORS
Stacy and Witbeck
GRANITE
WILDISH

DE DHILLON ENGINEERS, LLC
PORTLAND, OR

DAVID EVANS AND ASSOCIATES INC.

TRIMET

CAPITAL PROJECTS AND FACILITIES DIVISION
710 N.E. HOLLADAY STREET
PORTLAND, OREGON 97232

SOUTH CORRIDOR PROJECT
I-205 SEGMENT
ODOT MUP PATH LIGHTING
PLANS
STA 1195+10 TO 1219+50

SCALE: AS SHOWN



DRAWING NO.: E16-411

CONTRACT NO.: RH040161LE

SHEET NO.: 193E

NOTES:

1. PROVIDE CONCRETE BASE UNDER POWER/METERING PEDESTAL.
2. REFER TO E16-217/218 FOR LUMINAIRE SCHEDULE.
3. GROUND SERVICE WITH #8, CH. 10 GROUND ROD.
4. PROVIDE SERVICE FROM POLE WITH 120/240V-1Ø
LOCATE METERED POWER PEDESTAL WITHIN 10 FT. OF PGE
POLE. SERVICE CHARGES TO BE PAID BY CITY PER
CITY RATE SCHEDULE WITH PGE.

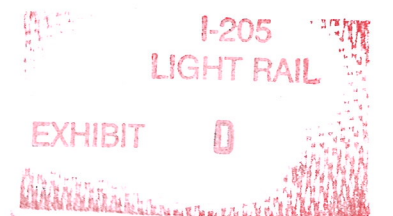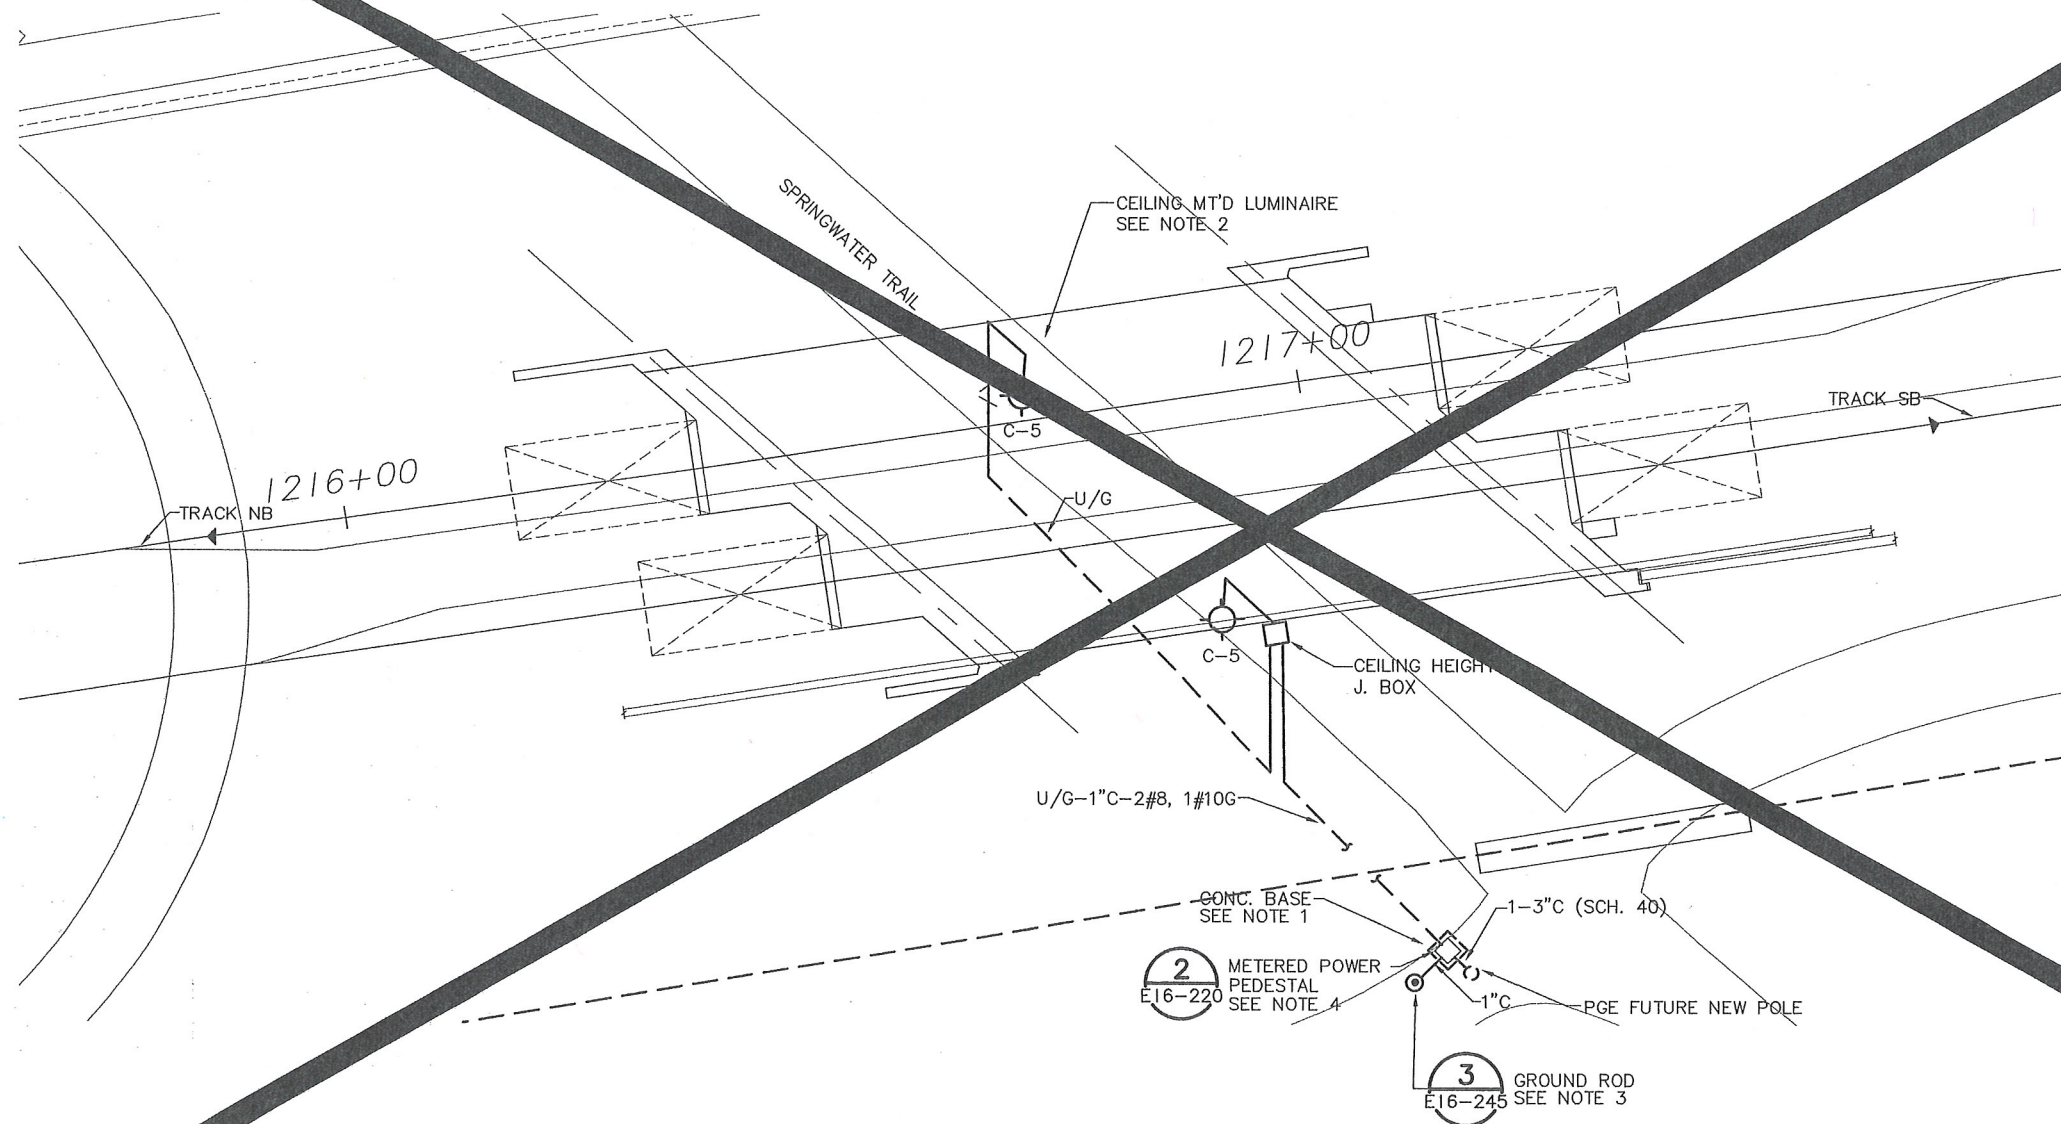


SPRINGWATER TRAIL UNDERPASS-LIGHTING PLAN

SHEET DELETED

				BSD DESIGNED 7/11/06 DATE	TRI-COUNTY METROPOLITAN TRANSPORTATION DISTRICT OF OREGON				SOUTH CORRIDOR PROJECT I-205 SEGMENT SPRINGWATER TRAIL UNDERPASS-LIGHTING PLAN							
				RJ DRAWN 7/12/06 DATE	SOUTH CORRIDOR CONSTRUCTORS Stacy and Wilbeck GRANTE WILDISH				DHILLON ENGINEERS, INC. PORTLAND, OR DAVID EVANS AND ASSOCIATES INC.				CAPITAL PROJECTS AND FACILITIES DIVISION 710 N.E. HOLLADAY STREET PORTLAND, OREGON 97232			
				CHECKED DATE	SUBMITTED: DATE: 12/15/06				APPROVED: DATE: 12/15/06				SCALE: 1" = 10'-0"			
				APPROVED DATE									DRAWING NO.: E16-230-AX			
													CONTRACT NO.: RH040161LE			
													SHEET NO.: 164			

AX	1-21-09	JG	DC No. 35
0	12/15/06		ISSUED FOR CONSTRUCTION
NO.	DATE	BY	APPD.
		CHK.	REVISIONS

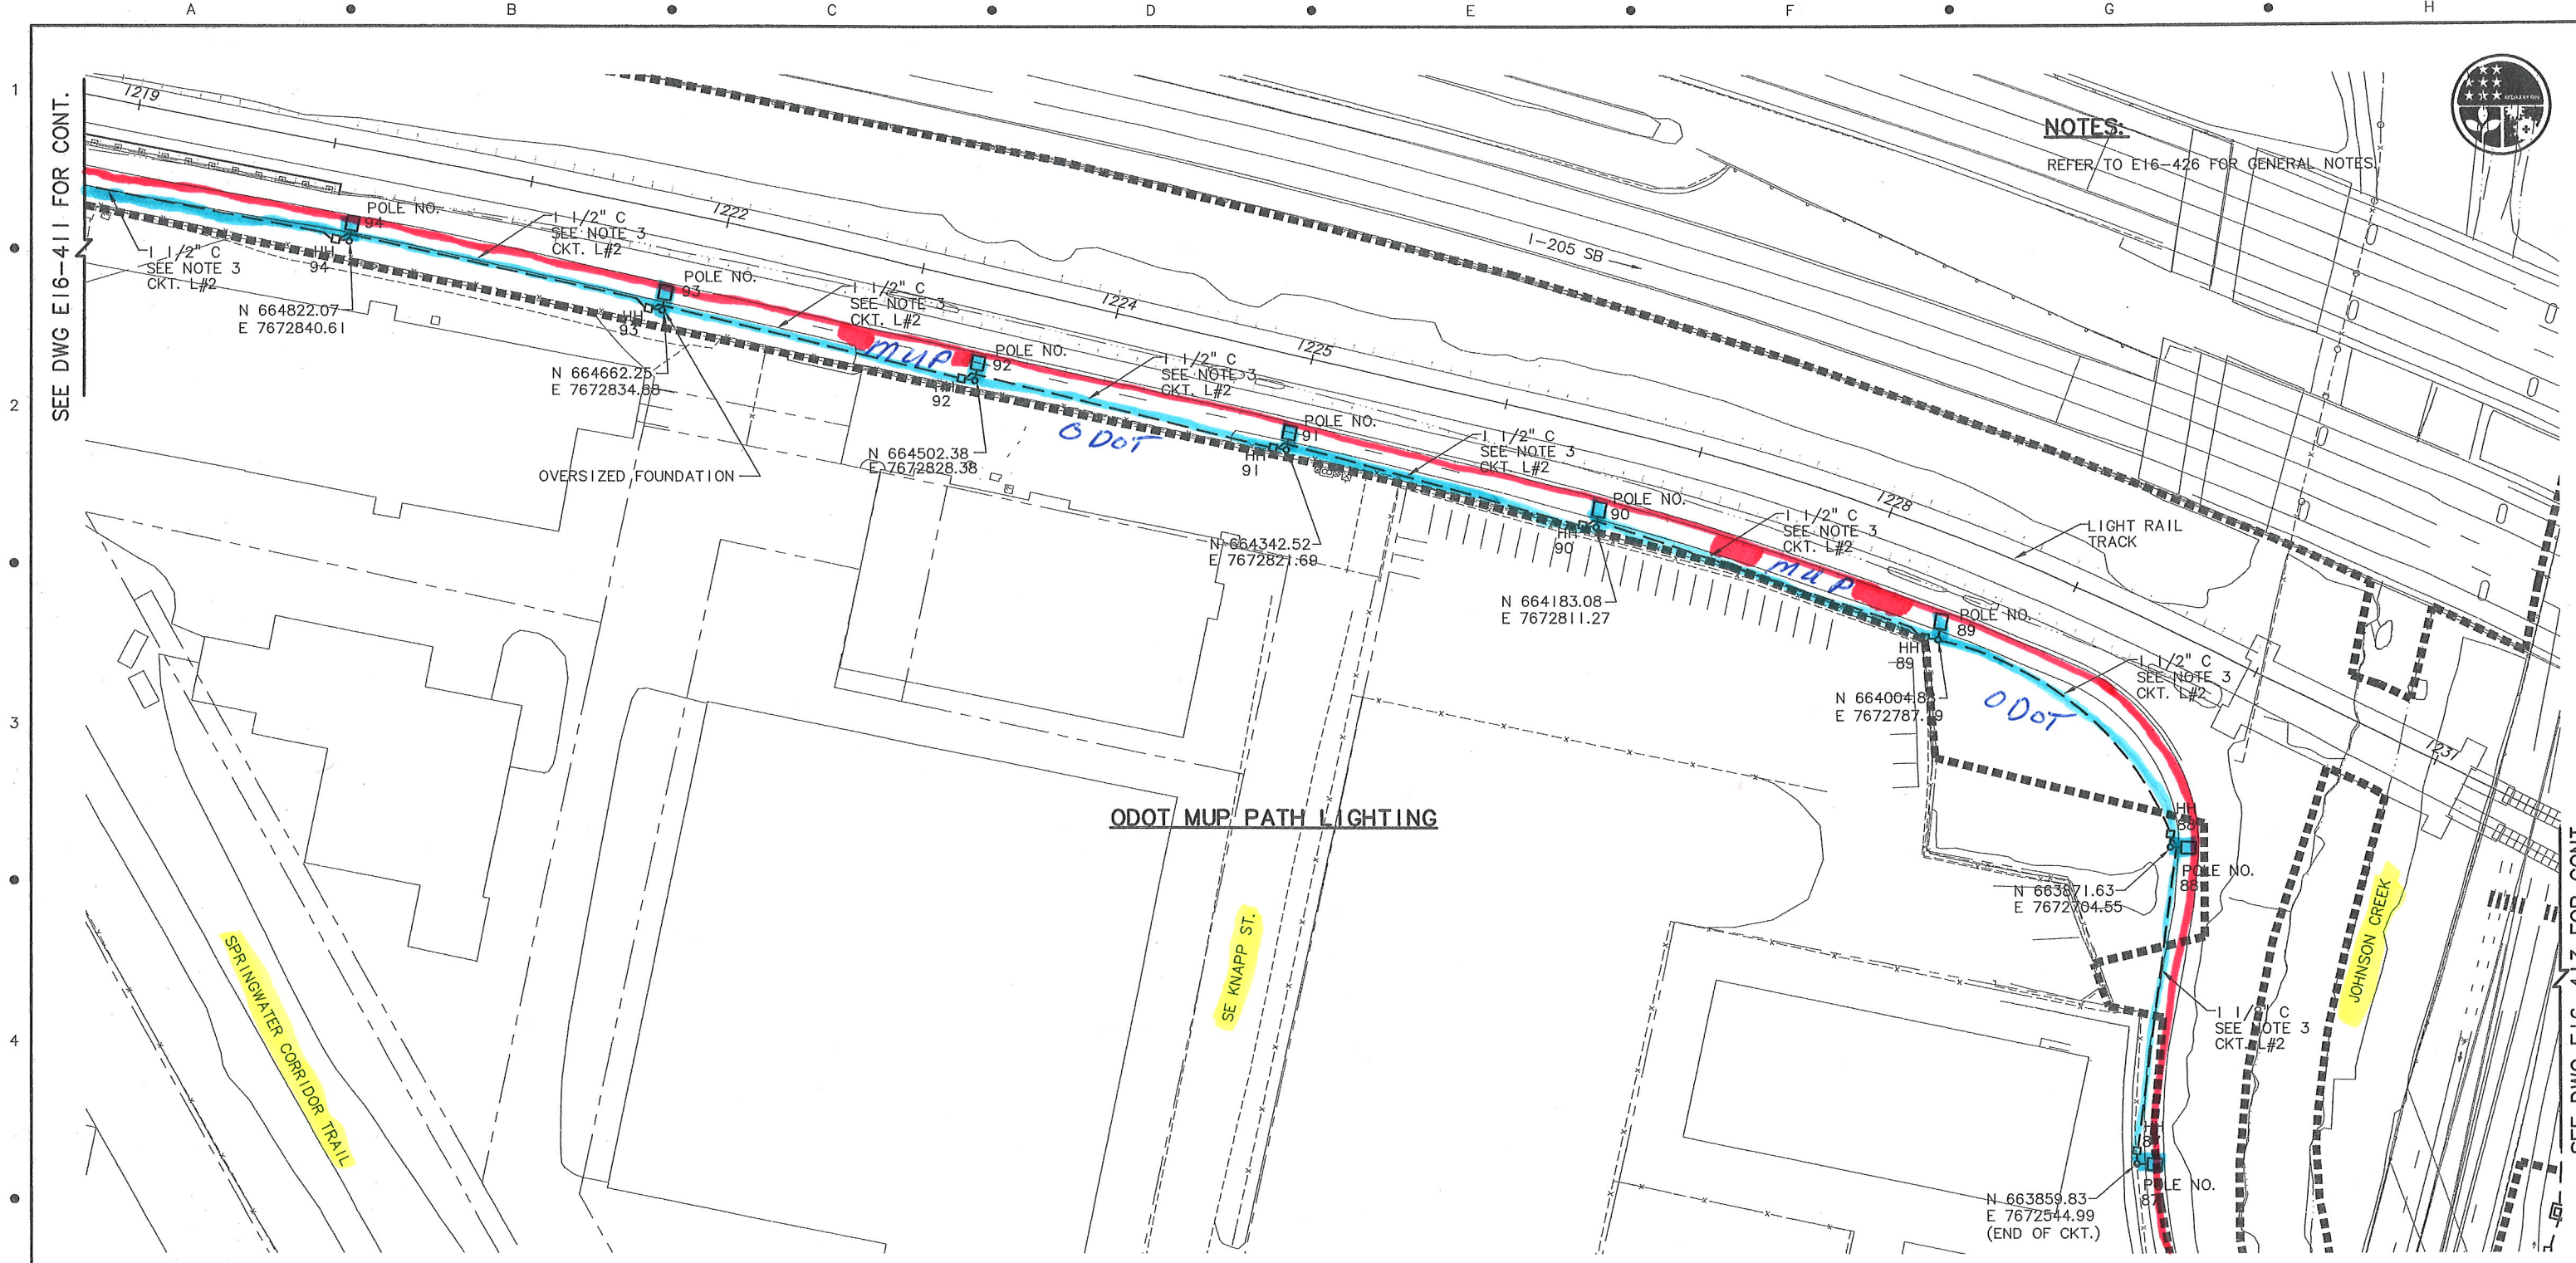


NOTES:
REFER TO E16-426 FOR GENERAL NOTES.

ODOT MUP PATH LIGHTING

I-205
LIGHT RAIL
EXHIBIT D

RECORD DRAWINGS

PREPARED BY: TRI-MET
APPROVED: *[Signature]* Project Engineering
DATE: NOV - 5 2010

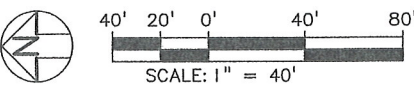

NOTE: THESE RECORD DRAWINGS REPRESENT THE BEST KNOWN INFORMATION ABOUT CONSTRUCTED FACILITIES. LOCATIONS SHOWN ARE NOT WARRANTED. UNDERGROUND UTILITIES MUST BE FIELD VERIFIED FOR ACTUAL LOCATION.

RECORD DRAWING

NO.	DATE	BY	APPD.	REVISIONS
		CHK.		

BSD DESIGNED	3/9/09	DATE
RJ DRAWN	3/9/09	DATE
BSD CHECKED	3/9/09	DATE
APPROVED		DATE

**TRI-COUNTY METROPOLITAN TRANSPORTATION DISTRICT OF OREGON**

**SOUTH CORRIDOR CONSTRUCTORS**
facy and Wilbeck
GRANTE
WILDISH AND ASSOCIATES INC.

**DHILLON ENGINEERS, LLC**
PORTLAND, OR

**DAVID EVANS AND ASSOCIATES INC.**

**TRI-MET**
CAPITAL PROJECTS AND FACILITIES DIVISION
710 N.E. HOLLADAY STREET
PORTLAND, OREGON 97232

SOUTH CORRIDOR PROJECT			
I-205 SEGMENT			
ODOT MUP PATH LIGHTING PLANS			
STA 1219+50 TO 1231+00			
SCALE: AS SHOWN	DRAWING NO.: E16-412	CONTRACT NO.: RH040161LE	SHEET NO.: 193F

