

NOTES:

1. REFER TO ARCHITECTURAL DRAWING FOR P6 LUMINAIRES EXACT LOCATION.
2. NOT USED
3. NOT USED


I-205
LIGHT RAIL

EXHIBIT D

RECORD DRAWINGS

PREPARED BY: TRI-MET
APPROVED: *Nov 5 2006* *Project Engineering*
DATE: _____

PATHWAY LIGHTING PLAN
SEE NOTE 1

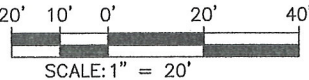

NOTE: THESE RECORD DRAWINGS REPRESENT THE BEST KNOWN INFORMATION ABOUT CONSTRUCTED FACILITIES. LOCATIONS SHOWN ARE NOT WARRANTED. UNDERGROUND UTILITIES MUST BE FIELD VERIFIED FOR ACTUAL LOCATION.

RECORD DRAWING

NO.	DATE	BY	APPD.	REVISIONS
		CHK.		

BSD DESIGNED	6/01/06 DATE
RJ DRAWN	6/02/06 DATE
CHECKED	DATE
APPROVED	DATE



TRI-COUNTY METROPOLITAN TRANSPORTATION DISTRICT OF OREGON

SOUTH CORRIDOR CONSTRUCTORS
Stacy and Wilbeck
GRANITE
WILDISH

DHILLON ENGINEERS, INC.
PORTLAND, OR
DAVID EVANS
AND ASSOCIATES INC.




CAPITAL PROJECTS
AND
FACILITIES DIVISION
710 N.E. HOLLADAY STREET
PORTLAND, OREGON 97232

SOUTH CORRIDOR PROJECT
I-205 SEGMENT
S.E. FLAVEL STREET STATION
PATHWAY LIGHTING PLAN

SCALE: 1" = 20'-0"	DRAWING NO.: E16-153-EX	CONTRACT NO.: RH040161LE	SHEET NO.: 112
-----------------------	----------------------------	-----------------------------	-------------------

NOTES:


1. PROVIDE CONDUIT EXPANSION FITTINGS AS REQUIRED.
2. PROVIDE CONCRETE BASE PER ODOT STANDARD.
3. GROUND SERVICE WITH #8 CU TO GROUND ROD.
4. PENDANT MOUNT LUMINAIRES WITH 3/4"GRS AND LINE BOTTOM OF LUMINAIRES WITH BOTTOM OF GIRDERS.
5. REFER TO E16-217/218 FOR LUMINAIRE SCHEDULE. PROVIDE LUMINAIRE C-4 W/100 WATT HPS LAMP
6. RELOCATE & REWIRE EXIST'G ODOT U/G CONDUCTORS AND RACEWAYS AS REQUIRED.
7. SERVICE FROM PGE VAULT VT00117 SHALL BE 120/240V-1Ø AND FROM PGE VAULT VT00118 480-1Ø SERVICE CHARGES TO BE PAID BY CITY PER CITY RATE SCHEDULE WITH PGE.
8. PGE TO REMOVE EXISTING OVERHEAD SERVICE AND RESUPPLY NEW SERVICES FROM NEW VAULTS No. VT00117 & VT00118.
9. AS REQ'D BY PDOT, PROVIDE ALL UNDERGROUND CONDUITS 1½" PVC (SCH 80) AND GRS ABOVE GROUND. FOLLOW PDOT STANDARD SPEC. AND USE #12 YELLOW TRACER WIRE AND PUT IN MULE-TAPE.
10. FOR STREET LIGHT INSPECTIONS, CONTACT DALE KIRKINEN, C.O.P. AT 503-823-8889.
11. EXTEND AND CAP 1 - 1½" PVC(80) FOR FUTURE USE.
12. PROVIDE FOUR ELECTRIC TYPE "C" NON-METERED (C.O.P. STD.) BASE MOUNTED CABINET WITH:
100A-2P MAIN
20A-1P UNDERPASS LIGHTING
20A-1P PHOTOCELL CONTROL
MOUNT PC ON TOP OF CABINET FACING NORTH
13. ALL ELECTRICAL INSTALLATION SHALL COMPLY WITH LATEST CODES AND PDOT STANDARDS.
14. PROVIDE NEMA 3R PANELBOARD WITH:
125A-2P MAIN
30A-2P CIRCUIT FOR ODOT EXIST. LIGHTING
2-30A/2P SPACES
PROVIDE 30A/2P LIGHTING CONTRACTOR WITH 277 VOLT COIL. MOUNT PHOTO CELL (PC) ON TOP OF PANEL FACING NORTH.
15. PROVIDE CONC. FOUNDATION PER C.O.P. DWG No. 304E.

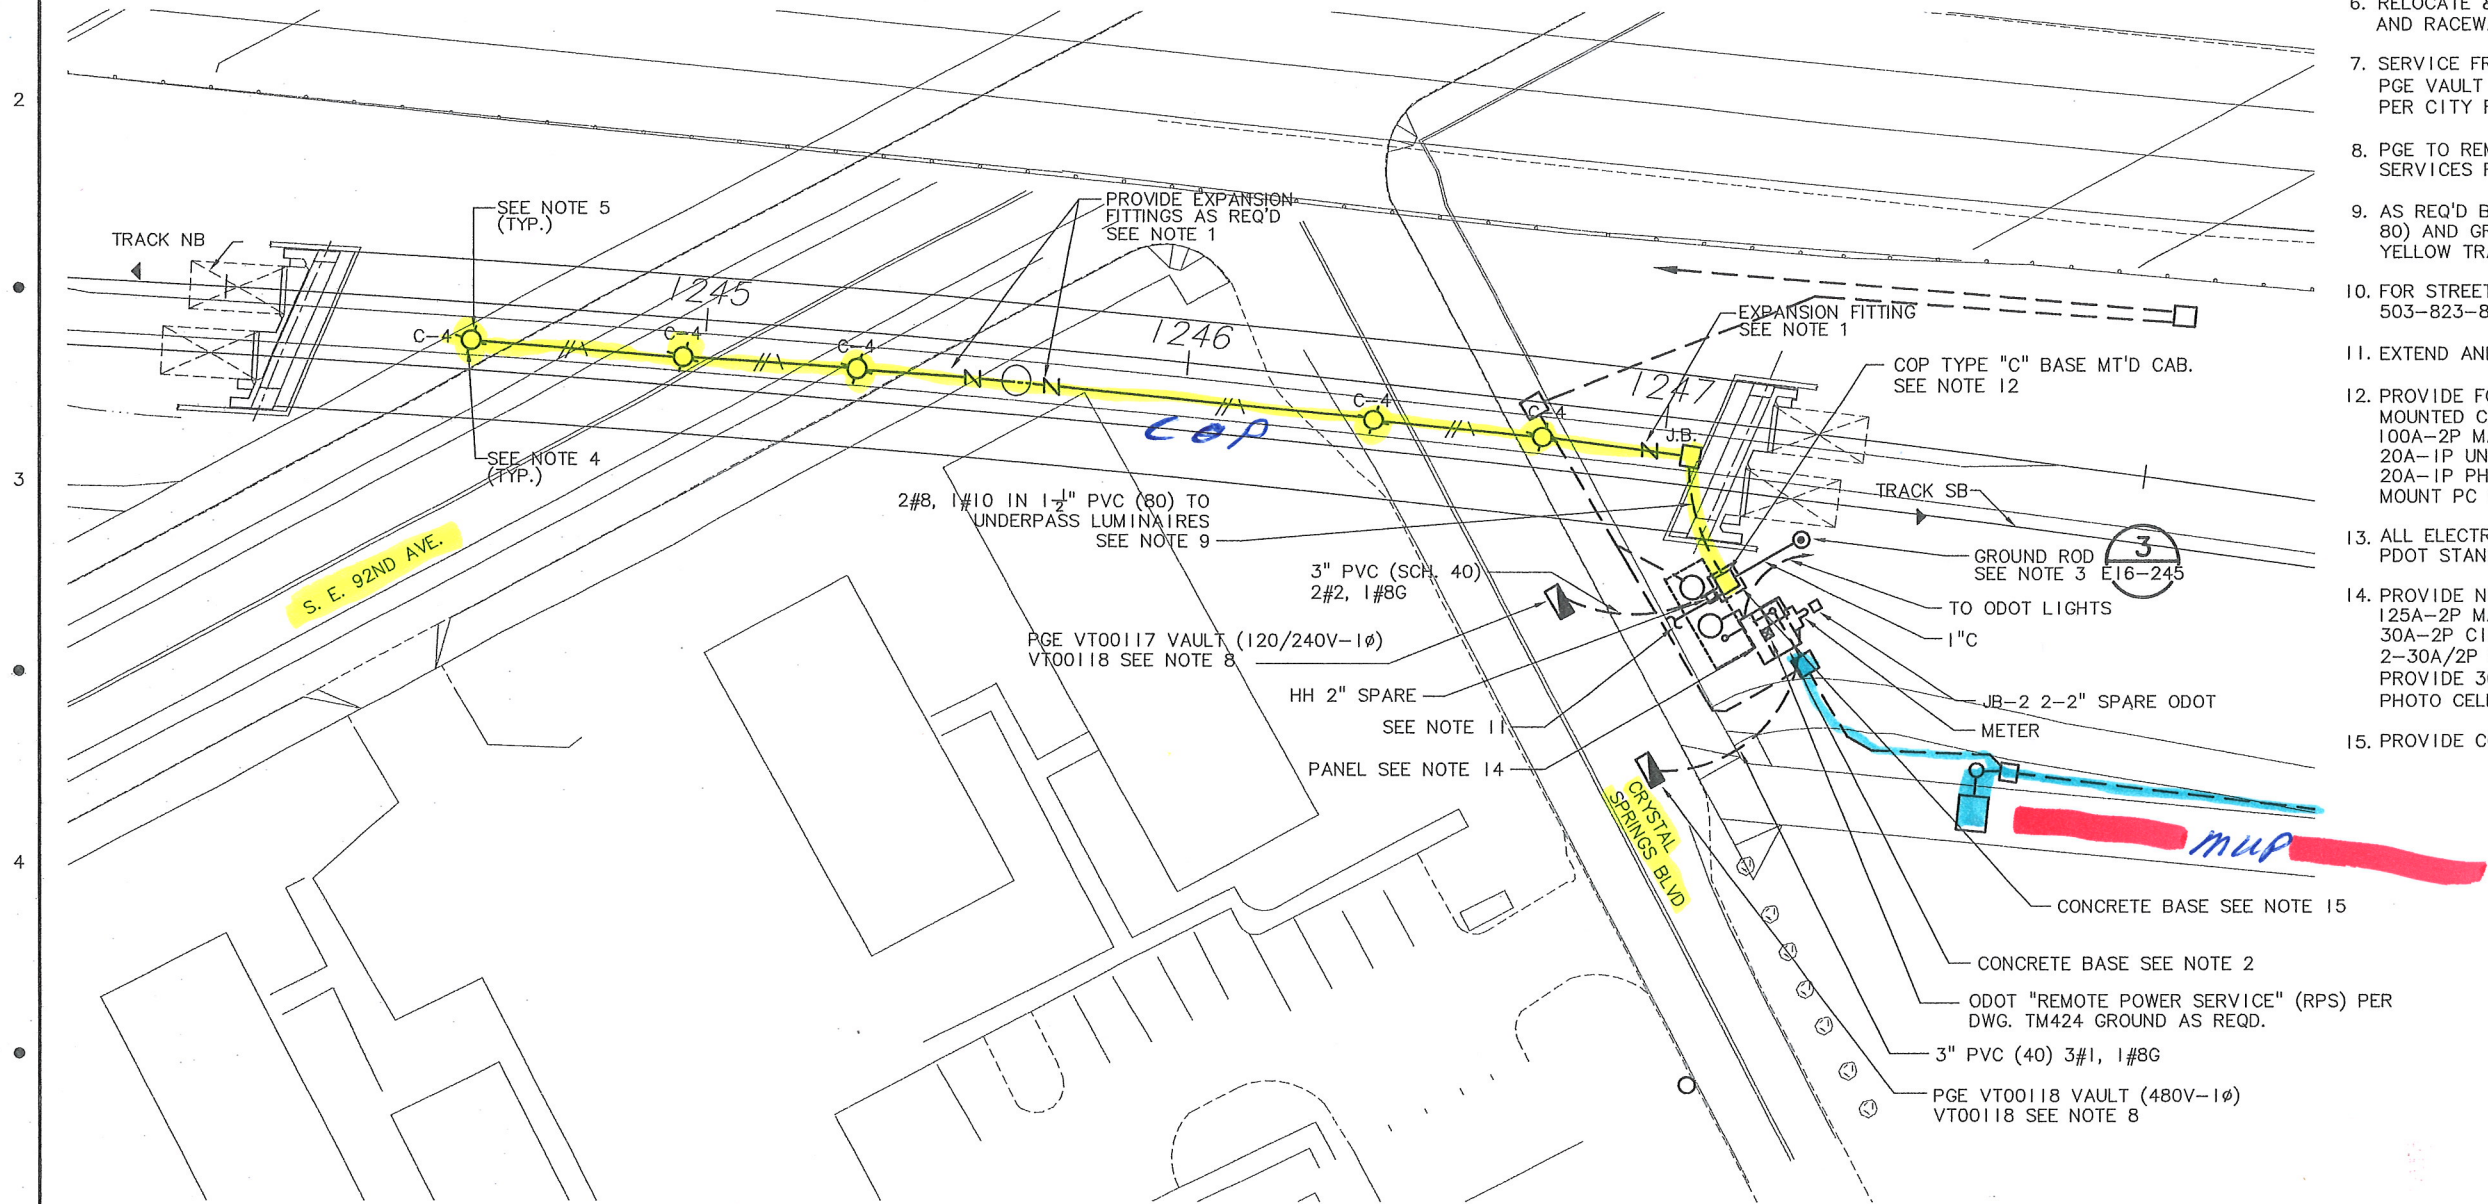

92ND AVE. AND CRYSTAL SPRINGS BLVD. UNDERPASS-LIGHTING PLAN
SEE NOTE 13

RECORD DRAWINGS

PREPARED BY: TRI-MET
APPROVED: NOV-5-2010
DATE: _____
Project Engineering

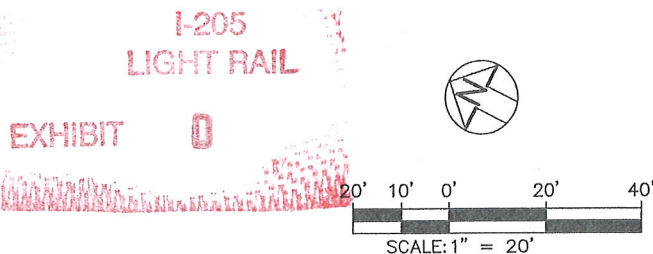

NOTE: THESE RECORD DRAWINGS REPRESENT THE BEST KNOWN INFORMATION ABOUT CONSTRUCTED FACILITIES. LOCATIONS SHOWN ARE NOT WARRANTED. UNDERGROUND UTILITIES MUST BE FIELD VERIFIED FOR ACTUAL LOCATION.

RECORD DRAWING

NO.	DATE	BY	APPD.	REVISIONS
		CHK.		

BSD DESIGNED	7/12/06 DATE
RJ DRAWN	7/12/06 DATE
CHECKED	DATE
APPROVED	DATE

**TRI-COUNTY METROPOLITAN TRANSPORTATION DISTRICT OF OREGON**

**SOUTH CORRIDOR CONSTRUCTORS**
Stacy and Wilbeck
GRANITE
WILDISH

**DHILLON ENGINEERS, INC.**
PORTLAND, OR

**DAVID EVANS AND ASSOCIATES INC.**

CAPITAL PROJECTS
AND
TRI-MET
FACILITIES DIVISION
710 N.E. HOLLADAY STREET
PORTLAND, OREGON 97232

SUBMITTED: _____ DATE: 12/15/06 APPROVED: _____ DATE: 12/15/06

SOUTH CORRIDOR PROJECT I-205 SEGMENT				
92ND AVE AND CYRSTAL SPRINGS BLVD UNDERPASS-LIGHTING PLAN				
SCALE: 1" = 20'-0"	DRAWING NO.: E16-231-AX	CONTRACT NO.: RH040161LE	SHEET NO.: 165	



NOTES:

REFER TO E16-426 FOR GENERAL NOTES.

I-205
LIGHT RAIL

RECORD DRAWINGS

PREPARED BY: TRI-MET

APPROVED: NOV - 5 2009 Project Engineering

DATE:


EXHIBIT D

SEE E16-413 FOR CONT.

SEE BELOW FOR CONT.

SEE DWG E16-415 FOR CONT.

NOTES: CKT #15 FED FROM CRYSTAL SPRINGS SERVICE

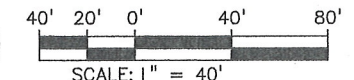

NOTE: THESE RECORD DRAWINGS REPRESENT THE BEST KNOWN INFORMATION ABOUT CONSTRUCTED FACILITIES. LOCATIONS SHOWN ARE NOT WARRANTED. UNDERGROUND UTILITIES MUST BE FIELD VERIFIED FOR ACTUAL LOCATION.

RECORD DRAWING

NO.	DATE	BY	APPD.	REVISIONS
		CHK.		

BSD DESIGNED	3/9/09	DATE
RJ DRAWN	3/9/09	DATE
BSD CHECKED	3/9/09	DATE
APPROVED		DATE



SOUTH CORRIDOR CONSTRUCTORS
Stacy and Wilbeck
GRANITE
WILDISH AND ASSOCIATES INC.



DHILLON ENGINEERS, LLC
PORTLAND, OR

TRI-MET

CAPITAL PROJECTS AND FACILITIES DIVISION
710 N.E. HOLLADAY STREET
PORTLAND, OREGON 97232


SOUTH CORRIDOR PROJECT
I-205 SEGMENT
ODOT MUP PATH LIGHTING
PLANS
STA 1248+50 TO 1274+00

SCALE: AS SHOWN	DRAWING NO.: E16-414	CONTRACT NO.: RH040161LE	SHEET NO.: 1934
-----------------	----------------------	--------------------------	-----------------



NOTES:

REFER TO E16-426 FOR GENERAL NOTES.

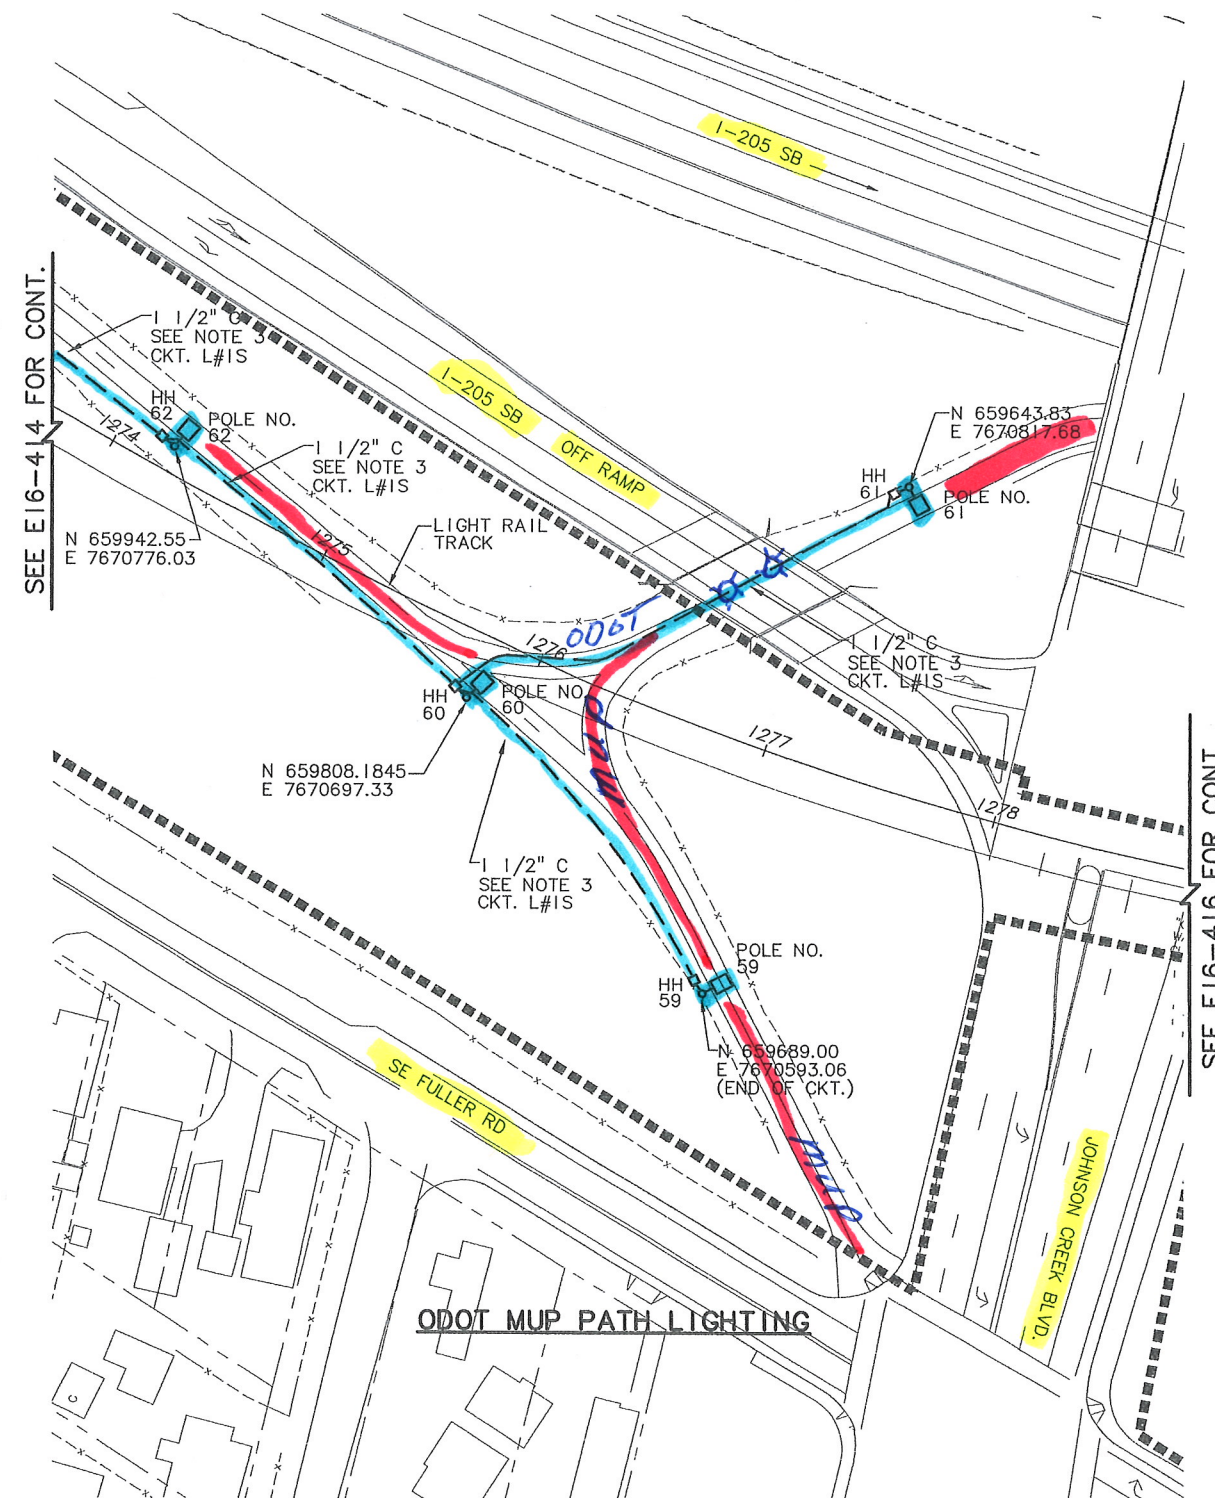

I-205
LIGHT RAIL


EXHIBIT D

RECORD DRAWINGS

PREPARED BY: TRI-MET

APPROVED: *[Signature]*
NOV - 5 2010 Project Engineering

DATE: _____

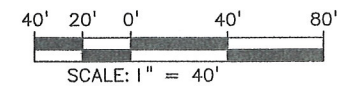

SCALE: 1" = 40'

NOTE: THESE RECORD DRAWINGS REPRESENT THE BEST KNOWN INFORMATION ABOUT CONSTRUCTED FACILITIES. LOCATIONS SHOWN ARE NOT WARRANTED. UNDERGROUND UTILITIES MUST BE FIELD VERIFIED FOR ACTUAL LOCATION.

RECORD DRAWING

NO.	DATE	BY	APPD.	REVISIONS

BSD DESIGNED	3/9/09	DATE
RJ DRAWN	3/9/09	DATE
BSD CHECKED	3/9/09	DATE
APPROVED		DATE

TRI-COUNTY METROPOLITAN TRANSPORTATION DISTRICT OF OREGON

SOUTH CORRIDOR CONSTRUCTORS
Stacy and Wilbeck

DHILLON ENGINEERS, LLC
PORTLAND, OR

CAPITAL PROJECTS
AND
FACILITIES DIVISION
710 N.E. HOLLADAY STREET
PORTLAND, OREGON 97232

DAVID EVANS
AND ASSOCIATES, INC.

SUBMITTED: _____ DATE: _____

APPROVED: _____ DATE: _____

SOUTH CORRIDOR PROJECT
I-205 SEGMENT
ODOT MUP PATH LIGHTING
PLANS
STA 1274+00 TO 1278+00

SCALE: AS SHOWN	DRAWING NO.: E16-415	CONTRACT NO.: RH040161LE	SHEET NO.: 193I
-----------------	----------------------	--------------------------	-----------------

NOTES:


1. SEE NOTE 11
2. PROVIDE CONCRETE BASE UNDER POWER/METERING PEDESTAL.
3. PROVIDE CONDUIT EXPANSION FITTINGS AS REQUIRED.
4. GROUND SERVICE WITH #8 CU TO GROUND ROD.
5. PENDANT MOUNT LUMINAIRE WITH 3/4"GRS AND LINE BOTTOM OF LUMINAIRE WITH BOTTOM OF GIRDERS.
6. PROVIDE SERVICE FROM PGE POLE WITH 120/240V-1Ø. LOCATE METERED POWER PEDESTAL WITHIN 10 FT. OF PGE. POLE. SERVICE CHARGES TO BE PAID BY CITY PER CITY RATE SCHEDULE WITH PGE.
7. PROVIDE GROUND ROD INSIDE HANDHOLE AND MAKE PROVISIONS FOR FUTURE CONNECTION
8. PROVIDE HANDHOLE 18"x10"x12"D WITH LID SECURELY FASTENED. PROVIDE DRAINAGE
9. PROVIDE 4-1" PVC (80) EMPTY CONDUITS FOR FUTURE USE. TERMINATE EMPTY CONDUITS IN JUNCTION BOX AND CAP
10. PROVIDE A MIN. OF 6 SPACES FOR FUTURE IP BREAKERS
11. PROVIDE HOLOPHANE PA-100HP-NT-PA LUMINAIRE (C-4) WITH 100W-HPS LAMP

I-205
LIGHT RAIL


EXHIBIT D

RECORD DRAWINGS

 PREPARED BY: TRI-MET

APPROVED:  Project Engineer

DATE: NOV -5 2010

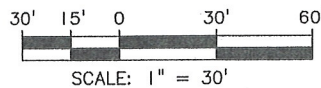

JOHNSON CREEK BLVD. UNDERPASS-LIGHTING PLAN

NOTE: THESE RECORD DRAWINGS REPRESENT THE BEST KNOWN INFORMATION ABOUT CONSTRUCTED FACILITIES. LOCATIONS SHOWN ARE NOT WARRANTED. UNDERGROUND UTILITIES MUST BE FIELD VERIFIED FOR ACTUAL LOCATION.

RECORD DRAWING

NO.	DATE	BY	APPD.	REVISIONS
		CHK.		

BSD DESIGNED	7/12/06 DATE
RJ DRAWN	7/12/06 DATE
CHECKED	DATE
APPROVED	DATE



TRI-COUNTY METROPOLITAN TRANSPORTATION DISTRICT OF OREGON

SOUTH CORRIDOR CONSTRUCTORS
Stacy and Wilbeck
GRANITE
WILDISH



DHILLON ENGINEERS, INC.
PORTLAND, OR
DAVID EVANS
AND ASSOCIATES INC.

TRI-MET

CAPITAL PROJECTS
AND
FACILITIES DIVISION
710 N.E. HOLLADAY STREET
PORTLAND, OREGON 97232

SUBMITTED:

DATE:

12/15/06

APPROVED:

DATE:

12/15/06

SCALE:

1" = 30'-0"

DRAWING NO.:

E16-232-AX

CONTRACT NO.:

RH040161LE

SHEET NO.:

166




NOTES:
REFER TO E16-426 FOR GENERAL NOTES.

SEE E16-415 FOR CONT.


SEE BELOW FOR CONT.

SEE ABOVE FOR CONT.

SEE DWG. E16-417 FOR CONT.

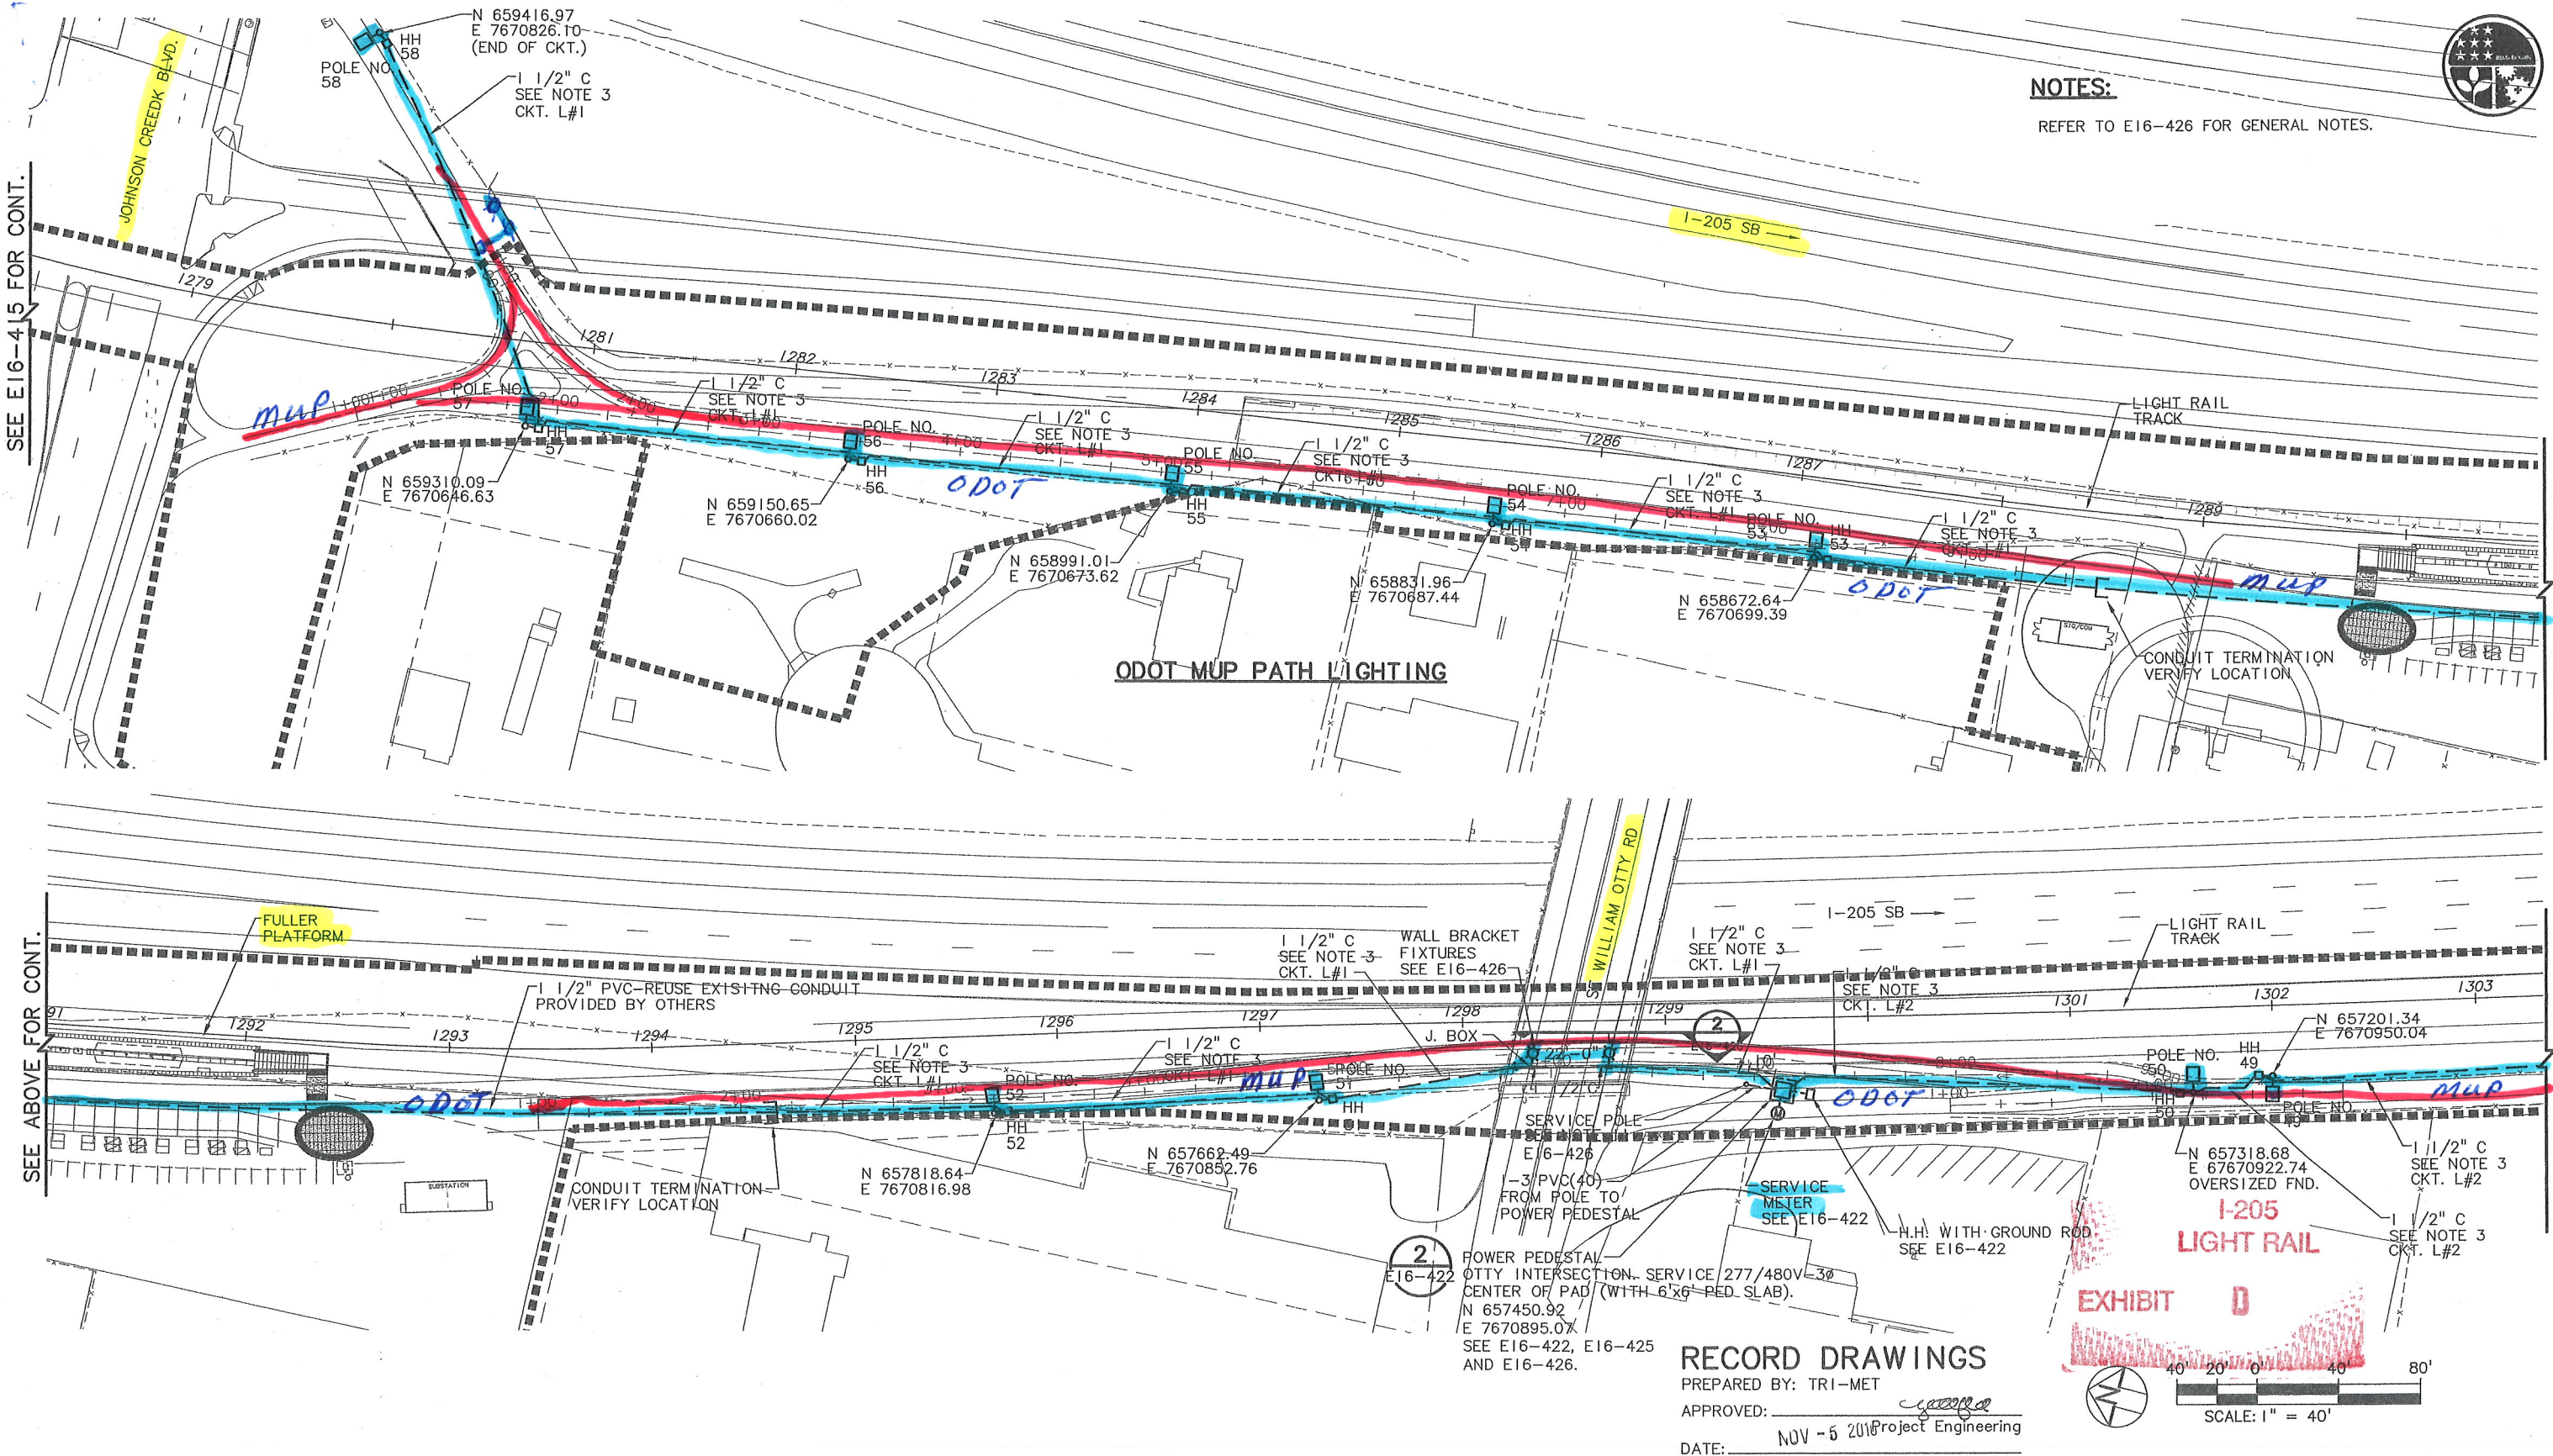

RECORD DRAWINGS
PREPARED BY: TRI-MET
APPROVED: *[Signature]*
DATE: NOV - 5 2010 Project Engineering

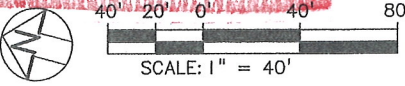

NOTE: THESE RECORD DRAWINGS REPRESENT THE BEST KNOWN INFORMATION ABOUT CONSTRUCTED FACILITIES. LOCATIONS SHOWN ARE NOT WARRANTED. UNDERGROUND UTILITIES MUST BE FIELD VERIFIED FOR ACTUAL LOCATION.				
RECORD DRAWING				
NO.	DATE	BY	APPD.	REVISIONS
		CHK.		

BSD DESIGNED	3/9/09
RJ DRAWN	3/9/09
BSD CHECKED	3/9/09
APPROVED	DATE

TRI-COUNTY METROPOLITAN TRANSPORTATION DISTRICT OF OREGON

SOUTH CORRIDOR CONSTRUCTORS
Stacy and Wilbeck
GARANTE
WILDISH AND ASSOCIATES INC.


DHILLON ENGINEERS, LLC
PORTLAND, OR

TRI-MET
CAPITAL PROJECTS AND FACILITIES DIVISION
710 N.E. HOLLADAY STREET
PORTLAND, OREGON 97232


SOUTH CORRIDOR PROJECT I-205 SEGMENT ODOT MUP PATH LIGHTING PLANS STA 1278+00 TO 1303+00			
SCALE: AS SHOWN	DRAWING NO.: E16-416	CONTRACT NO.: RH040161LE	SHEET NO.: 193J

NOTES:

1. REFER TO E16-217/218 FOR LUMINAIRE SCHEDULE.
2. GROUND SERVICE WITH #8 CU TO GROUND ROD.
3. PROVIDE SERVICE FROM PGE POLE WITH 120/240V-1Ø.
4. LOCATE METERED POWER PEDESTAL WITHIN 10 FT. OF PGE POLE. MONTHLY SERVICE CHARGES TO BE PAID BY ODOT.

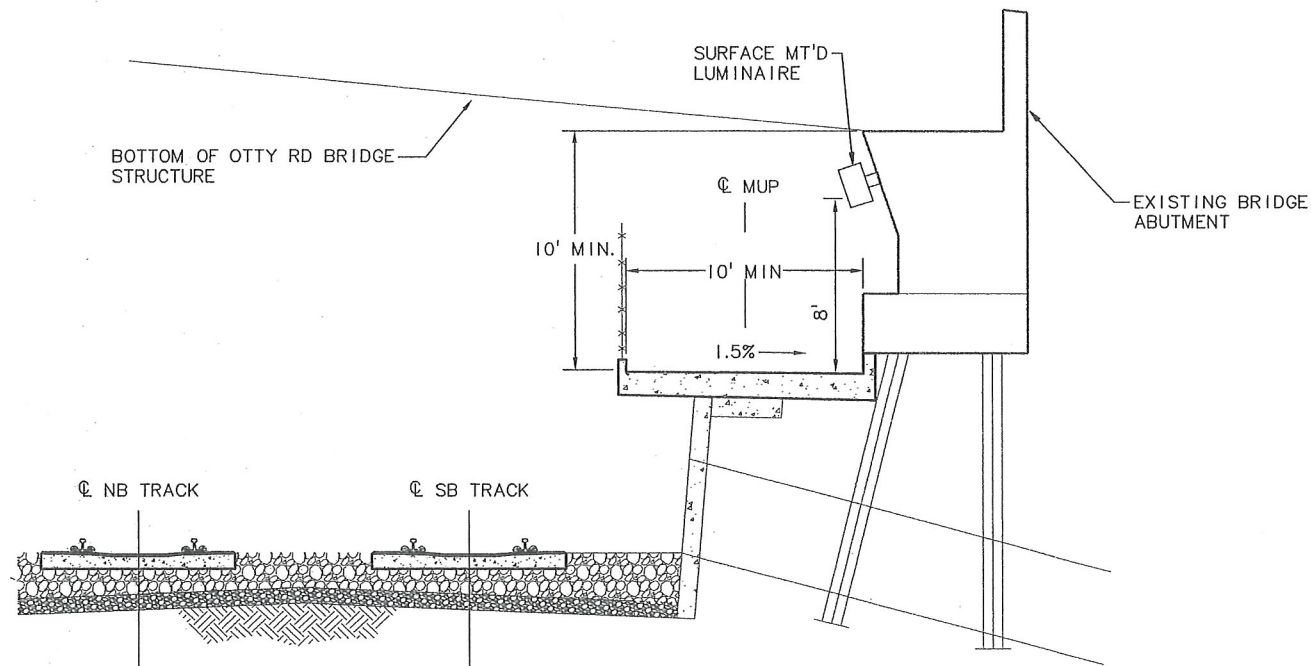

MULTI-USE PATH SECTION - LIGHTING
NOT TO SCALE

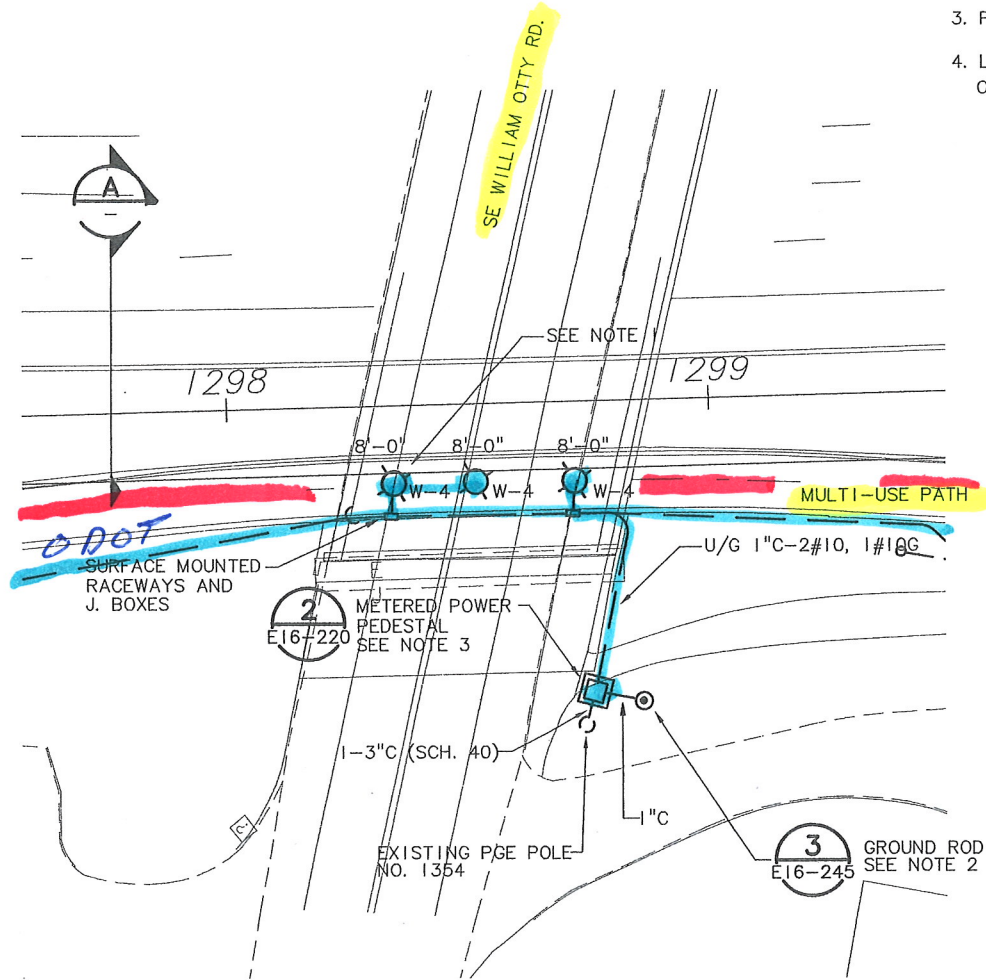


SE OTTY RD MULTI-USE PATH UNDERPASS-LIGHTING PLAN

I-205 LIGHT RAIL
EXHIBIT D

RECORD DRAWINGS

PREPARED BY: TRI-MET
APPROVED: *[Signature]*
DATE: NOV -5 2010 Project Engineering

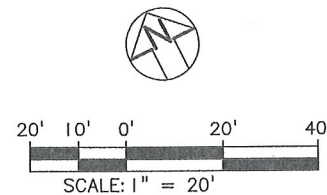

NOTE: THESE RECORD DRAWINGS REPRESENT THE BEST KNOWN INFORMATION ABOUT CONSTRUCTED FACILITIES. LOCATIONS SHOWN ARE NOT WARRANTED. UNDERGROUND UTILITIES MUST BE FIELD VERIFIED FOR ACTUAL LOCATION.

RECORD DRAWING

NO.	DATE	BY	APPD.	REVISIONS
		CHK.		

BSD DESIGNED	12/06/06 DATE
RJ DRAWN	12/06/06 DATE
CHECKED	DATE
APPROVED	DATE



TRI-COUNTY METROPOLITAN TRANSPORTATION DISTRICT OF OREGON

SOUTH CORRIDOR CONSTRUCTORS
Stacy and Wilbeck
GRANITE
WILDISH



DHILLON ENGINEERS, INC.
PORTLAND, OR
DAVID EVANS
AND ASSOCIATES INC.

TRI-MET

CAPITAL PROJECTS
AND
FACILITIES DIVISION
710 N.E. HOLLADAY STREET
PORTLAND, OREGON 97232

SUBMITTED:

DATE:

12/15/06

APPROVED:

DATE:

12/15/06

SCALE:

1" = 20'-0"

DRAWING NO.:

E16-235

CONTRACT NO.:

RH040161LE

SHEET NO.:

169

SOUTH CORRIDOR PROJECT
I-205 SEGMENT

S.E. OTTY RD MUP UNDERPASS-LIGHTING PLAN



NOTES:

REFER TO E16-426 FOR GENERAL NOTES.

SEE E16-416 FOR CONT.

SEE BELOW FOR CONT.


SEE ABOVE FOR CONT.

SEE E16-418 FOR CONT.



RECORD DRAWINGS

PREPARED BY: TRI-MET
APPROVED: *[Signature]*
DATE: NOV -5 2010 Project Engineering

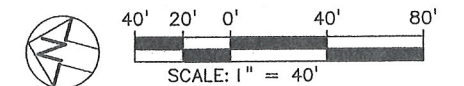

NOTE: THESE RECORD DRAWINGS REPRESENT THE BEST KNOWN INFORMATION ABOUT CONSTRUCTED FACILITIES. LOCATIONS SHOWN ARE NOT WARRANTED. UNDERGROUND UTILITIES MUST BE FIELD VERIFIED FOR ACTUAL LOCATION.

RECORD DRAWING

NO.	DATE	BY	APPD.	REVISIONS
		CHK.		

BSD DESIGNED	3/9/09
RJ	3/9/09
DRAWN	DATE
BSD CHECKED	3/9/09
DATE	
APPROVED	DATE

TRI-COUNTY METROPOLITAN TRANSPORTATION DISTRICT OF OREGON

SOUTH CORRIDOR CONSTRUCTORS
Stacy and Wilbeck
GRANITE
WILDISH AND ASSOCIATES INC.

DHILLON ENGINEERS, LLC
PORTLAND, OR

DAVID EVANS
AND ASSOCIATES INC.

CAPITAL PROJECTS
AND
FACILITIES DIVISION
710 N.E. HOLLADAY STREET
PORTLAND, OREGON 97232

SUBMITTED: DATE: APPROVED: DATE:

SOUTH CORRIDOR PROJECT
I-205 SEGMENT
ODOT MUP PATH LIGHTING
PLANS
STA 1303+00 TO 1323+00


SCALE: AS SHOWN	DRAWING NO.: E16-417	CONTRACT NO.: RH04016 ILE	SHEET NO.: 193K
-----------------	----------------------	---------------------------	-----------------



NOTES:
REFER TO E16-426 FOR GENERAL NOTES.

SEE E16-417 FOR CONT.

SEE BELOW FOR CONT.

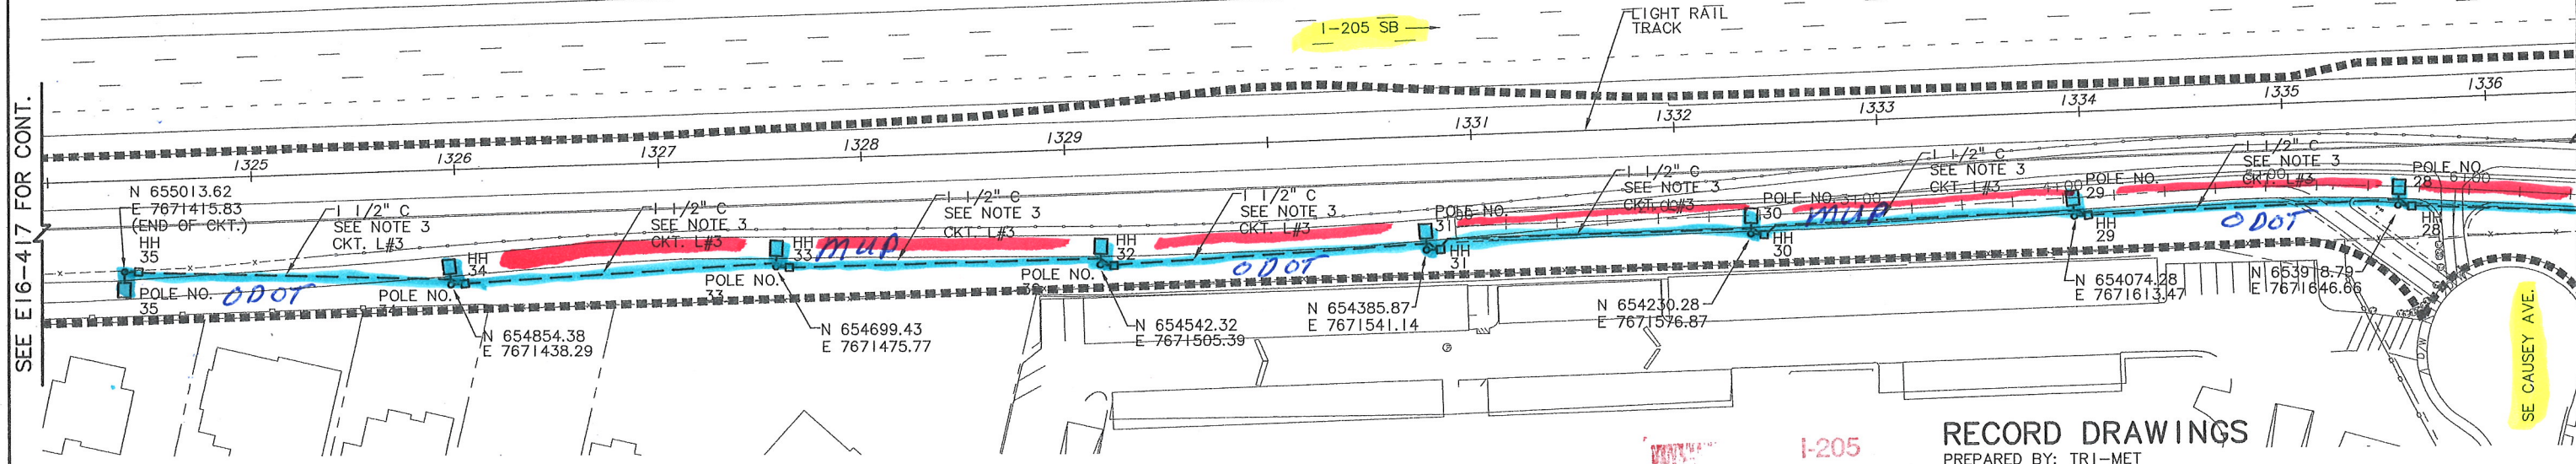



ODOT MUP PATH LIGHTING

I-205
LIGHT RAIL

RECORD DRAWINGS
PREPARED BY: TRI-MET
APPROVED: *[Signature]*
DATE: NOV -5 2010 Project Engineering

SEE ABOVE FOR CONT.

SEE MUP STA 18+10 TO STA 23+00

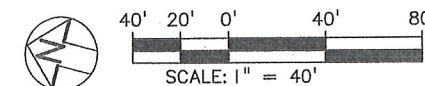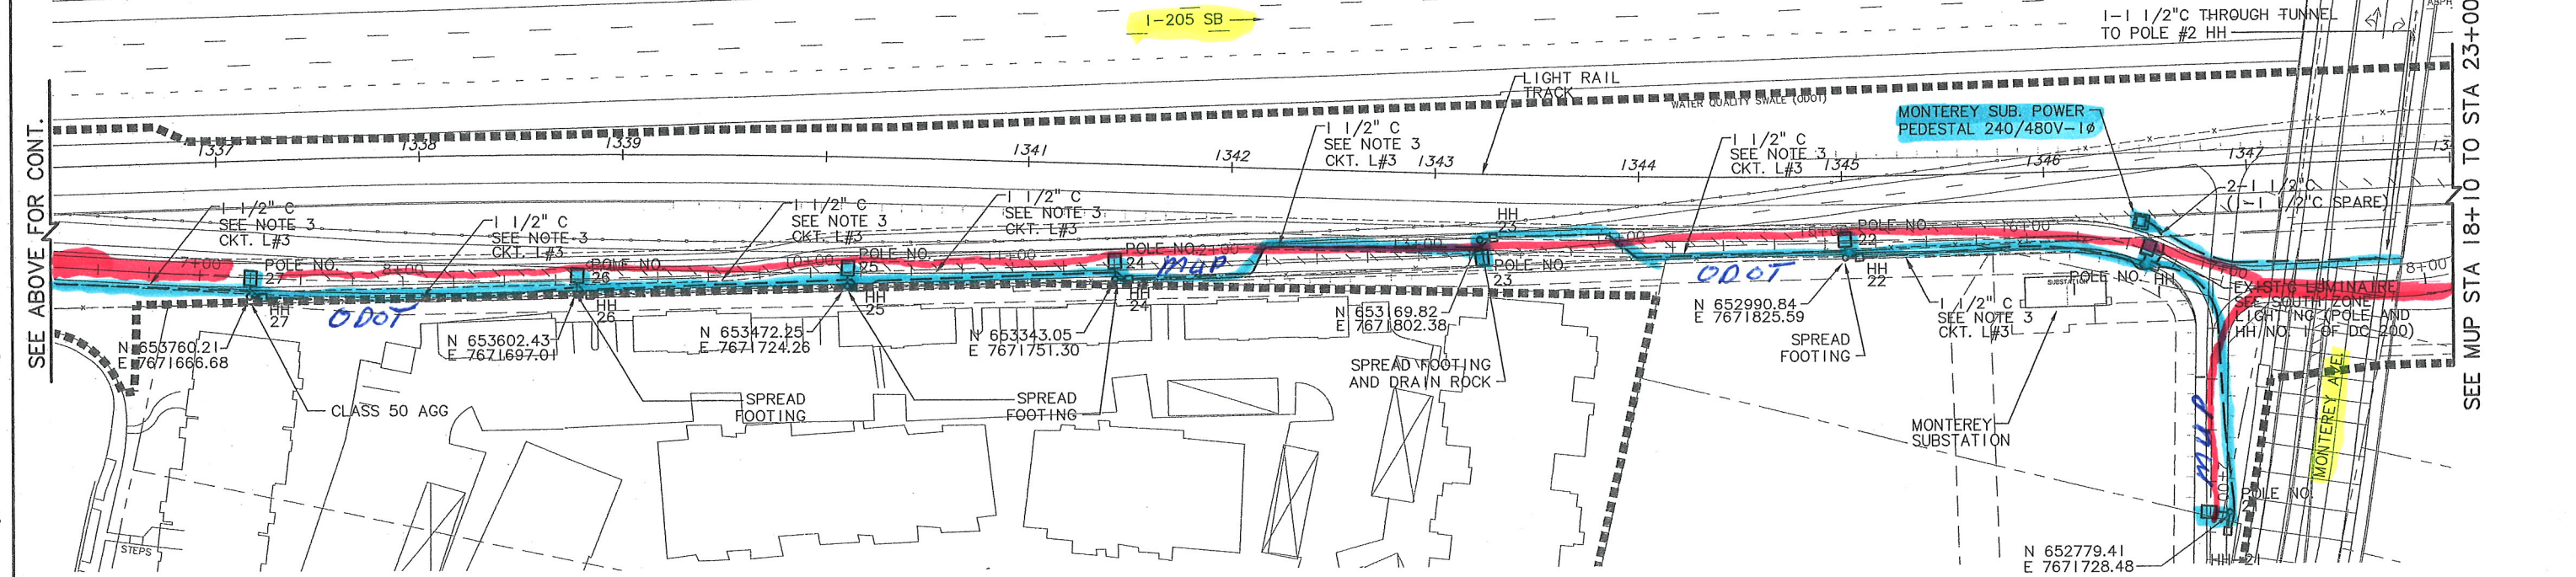

NOTE: THESE RECORD DRAWINGS REPRESENT THE BEST KNOWN INFORMATION ABOUT CONSTRUCTED FACILITIES. LOCATIONS SHOWN ARE NOT WARRANTED. UNDERGROUND UTILITIES MUST BE FIELD VERIFIED FOR ACTUAL LOCATION.

RECORD DRAWING

NO.	DATE	BY	CHK.	APPD.	REVISIONS

BSD DESIGNED	3/9/09 DATE
RJ DRAWN	3/9/09 DATE
BSD CHECKED	3/9/09 DATE
APPROVED	DATE

SOUTH CORRIDOR CONSTRUCTORS
Stacy and Wilbeck
GRANITE
WILDISH AND ASSOCIATES INC.

DHILLON ENGINEERS, LLC
PORTLAND, OR


TRI-MET
CAPITAL PROJECTS
AND
FACILITIES DIVISION
710 N.E. HOLLADAY STREET
PORTLAND, OREGON 97232

SUBMITTED: DATE: APPROVED: DATE:

SOUTH CORRIDOR PROJECT
I-205 SEGMENT
ODOT MUP PATH LIGHTING
PLANS
STA 1323+00 TO 1347+00

SCALE: AS SHOWN
DRAWING NO.: E16-418
CONTRACT NO.: RH040161LE
SHEET NO.: 193L

1
2
3
4
5

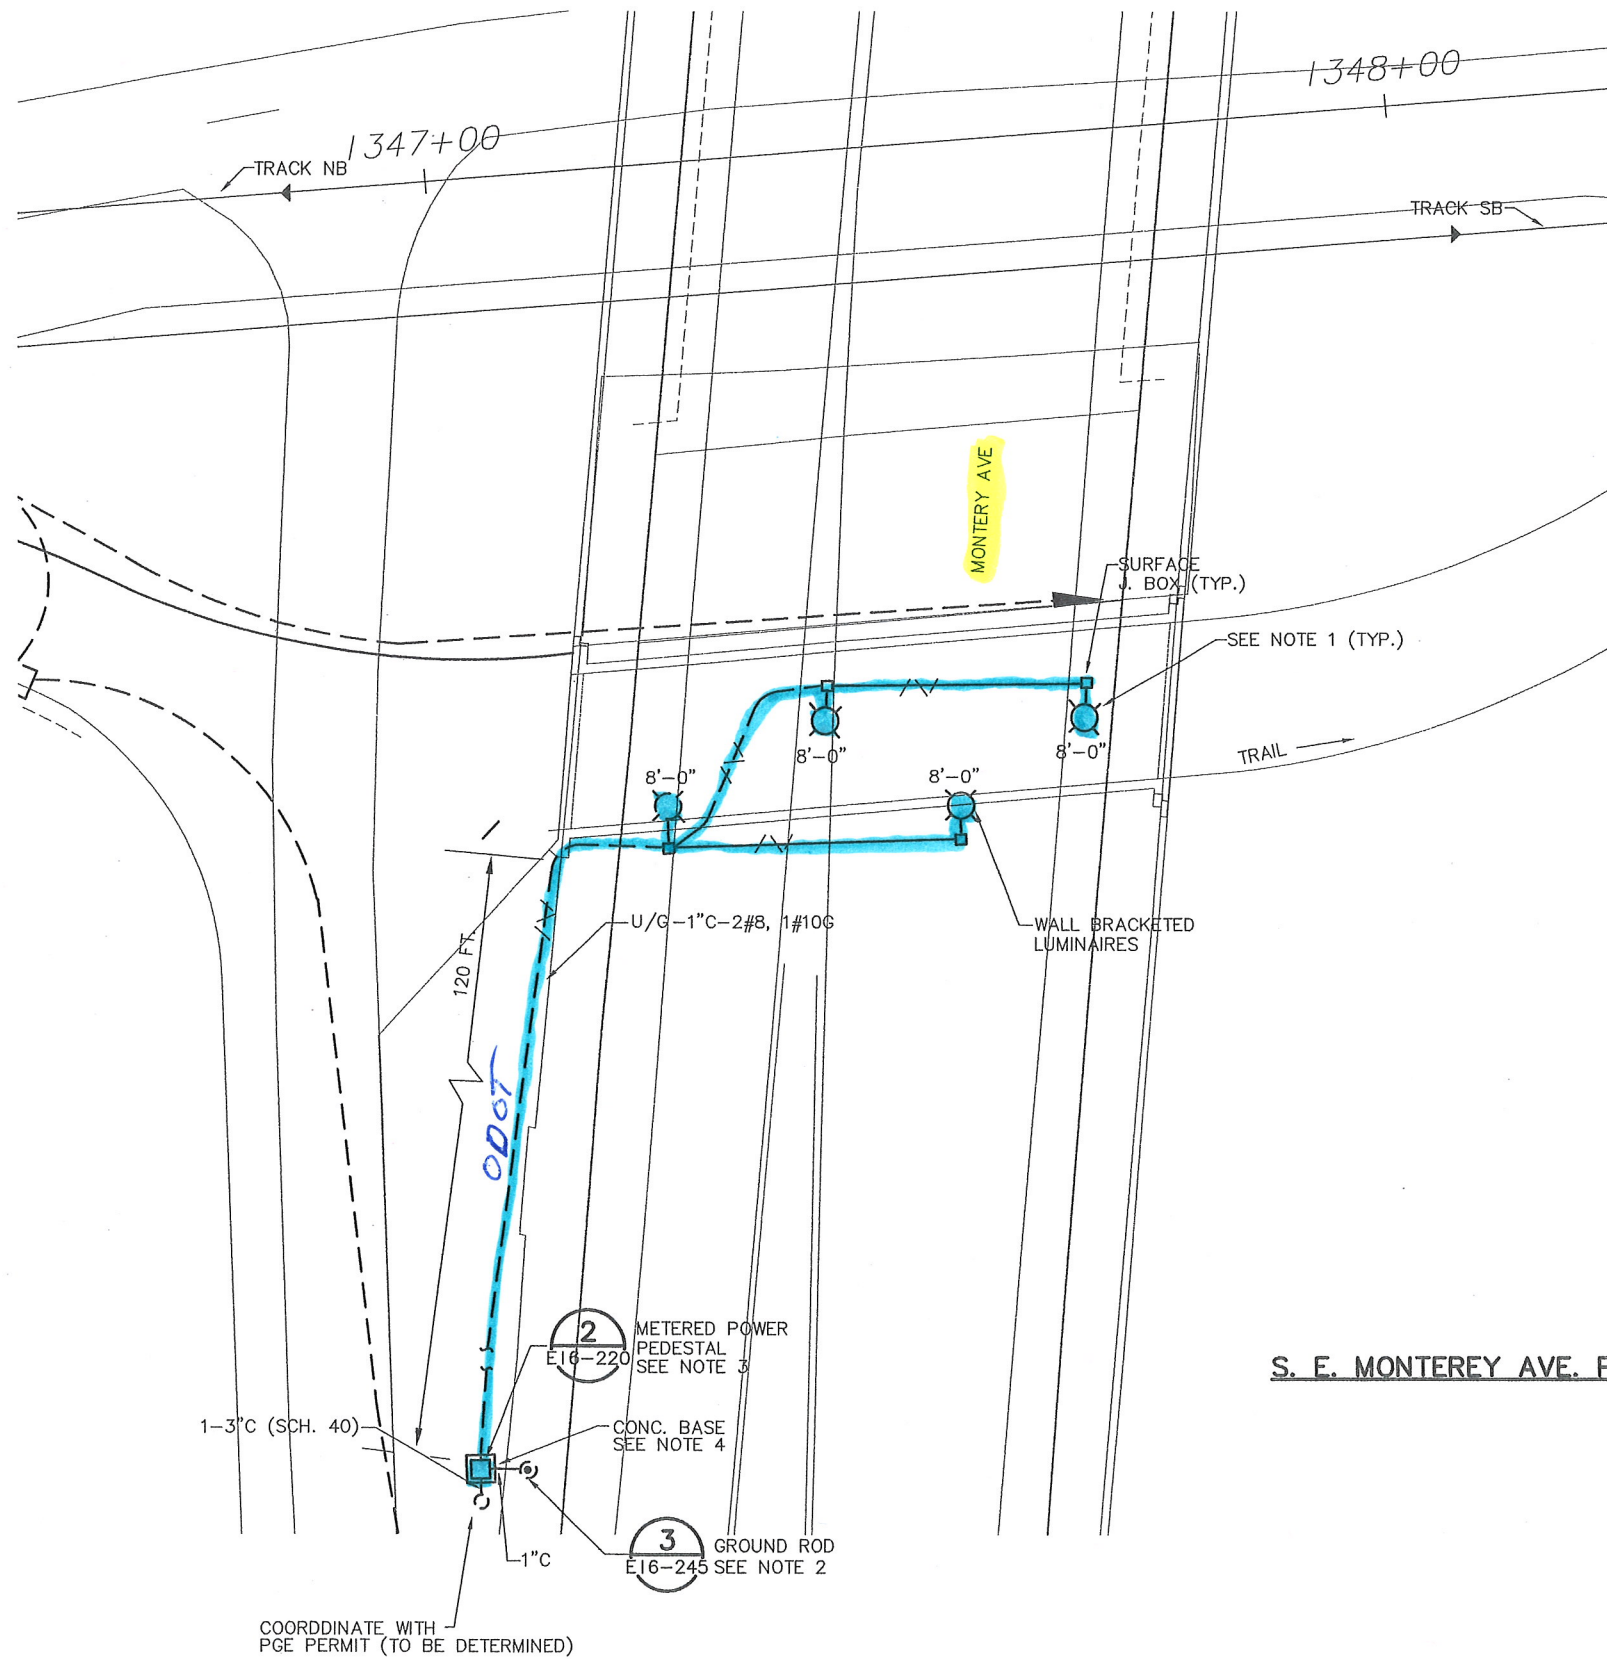


NOTES:

1. LIGHTS TO BE HOLOPHANE PK-175HPS-12-C-2A-WB ENCLOSED AND GASKETED, UL LISTED FOR WET AREAS WITH NON BREAKABLE LENS (LEXARE). AND FIXTURE GUARD HIGH POWER FACTOR BALLAST-REPLACE 120V WITH 480 VAC.
2. GROUND SERVICE WITH #8 CU TO GROUND ROD.
3. PROVIDE SERVICE FROM PGE POLE WITH 277/480V-1 PHASE.
4. PROVIDE CONCRETE BASE AS SHOWN ON E16-220.
5. METERED MONTHLY SERVICE CHARGES TO BE PAID BY ODOT.



RECORD DRAWINGS
PREPARED BY: TRI-MET
APPROVED: *[Signature]*
DATE: NOV -5 2010 Project Engineering

S. E. MONTEREY AVE. PEDESTRIAN UNDERPASS -LIGHTING PLAN

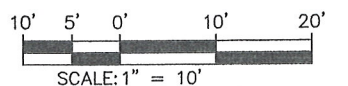

NOTE: THESE RECORD DRAWINGS REPRESENT THE BEST KNOWN INFORMATION ABOUT CONSTRUCTED FACILITIES. LOCATIONS SHOWN ARE NOT WARRANTED. UNDERGROUND UTILITIES MUST BE FIELD VERIFIED FOR ACTUAL LOCATION.


RECORD DRAWING

NO.	DATE	BY	APPD.	REVISIONS
		CHK.		

BSD DESIGNED	7/12/06 DATE
RJ DRAWN	7/12/06 DATE
RFH CHECKED	12/12/06 DATE
SBM APPROVED	12/12/06 DATE



TRI-COUNTY METROPOLITAN TRANSPORTATION DISTRICT OF OREGON

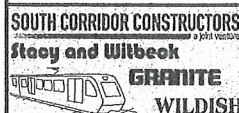

DHILLON ENGINEERS, INC.
PORTLAND, OR

DAVID EVANS
AND ASSOCIATES INC.



CAPITAL PROJECTS
AND
FACILITIES DIVISION
710 N.E. HOLLADAY STREET
PORTLAND, OREGON 97232

SUBMITTED:

DATE:

APPROVED:

DATE:

SCALE:

1" = 10'-0"


DRAWING NO.:
E16-233-AX

CONTRACT NO.:
RH040161LE

SHEET NO.:

167



NOTES:
REFER TO E16-404 FOR NOTES.

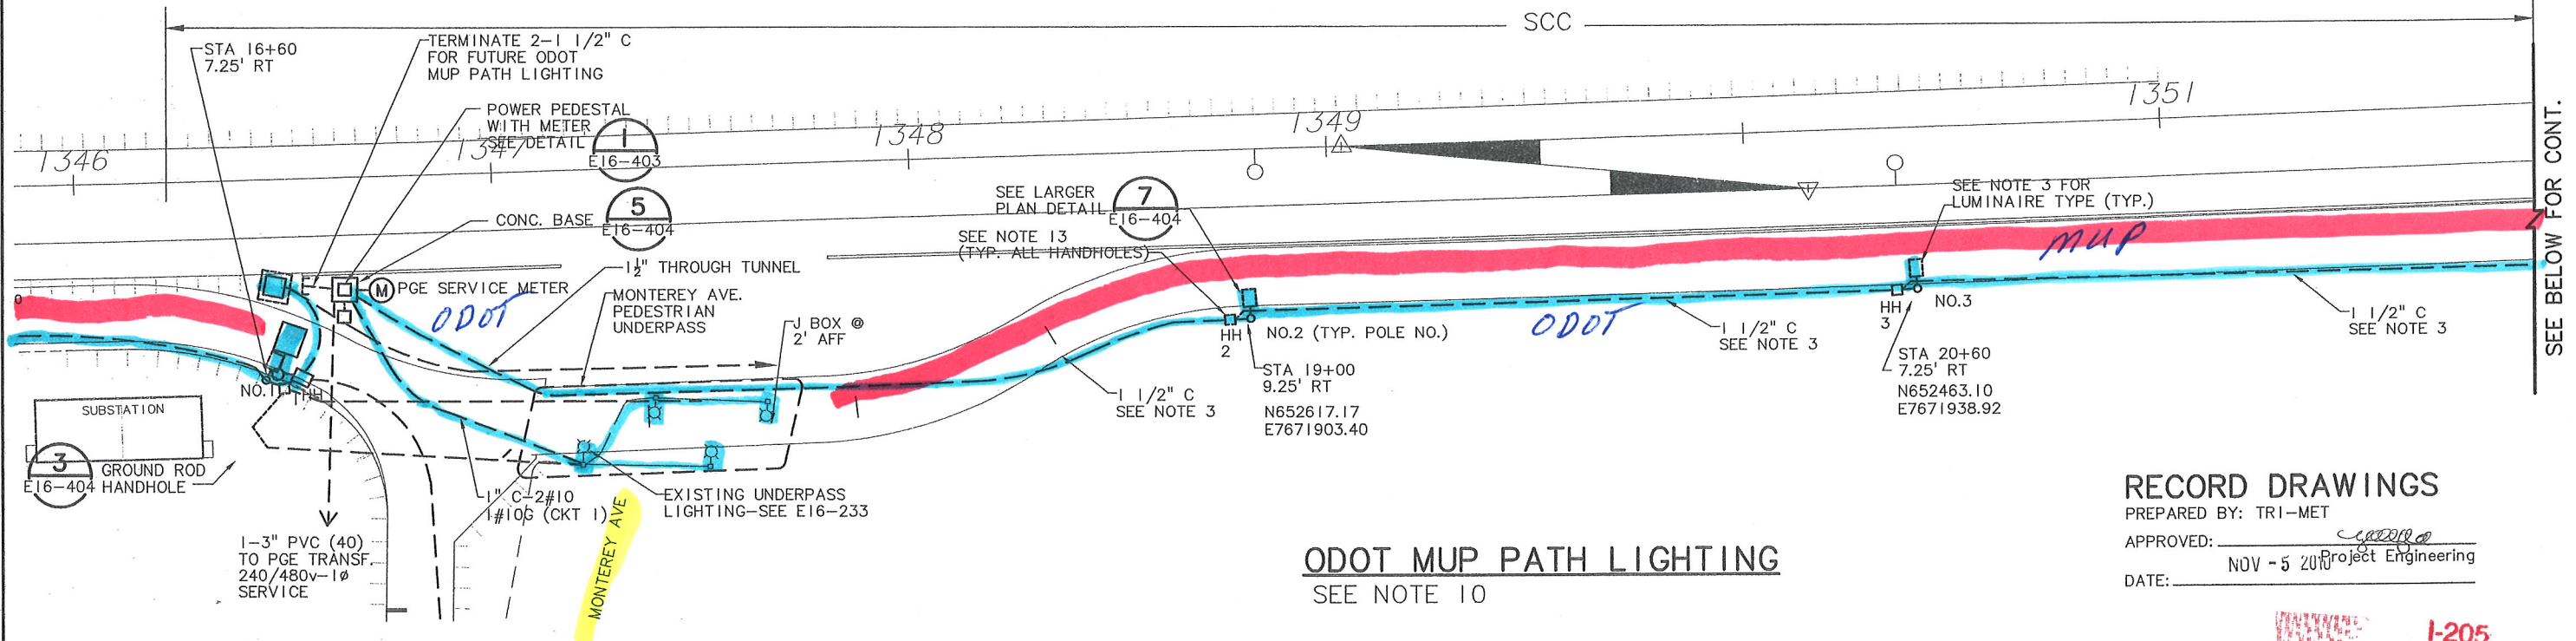

ODOT MUP PATH LIGHTING
SEE NOTE 10

RECORD DRAWINGS
PREPARED BY: TRI-MET
APPROVED: *[Signature]*
DATE: NOV -5 2010 Project Engineering

I-205
LIGHT RAIL
EXHIBIT D

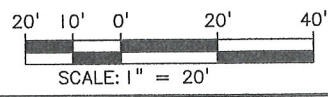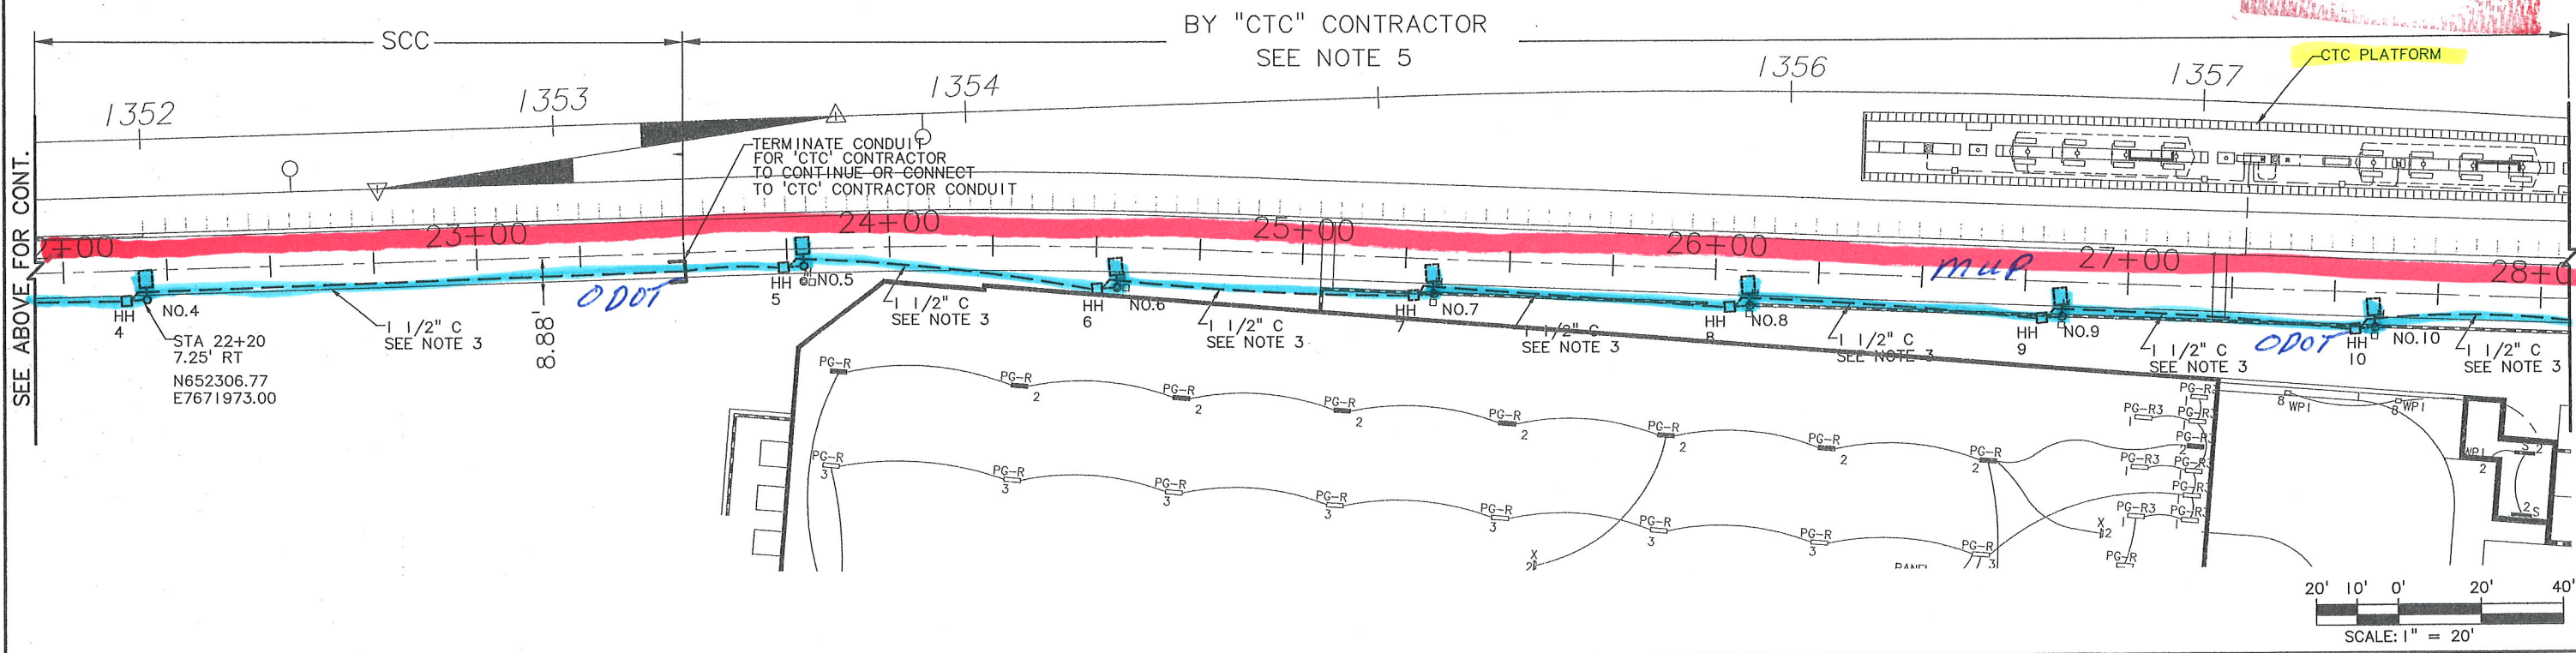

NOTE: THESE RECORD DRAWINGS REPRESENT THE BEST KNOWN INFORMATION ABOUT CONSTRUCTED FACILITIES. LOCATIONS SHOWN ARE NOT WARRANTED. UNDERGROUND UTILITIES MUST BE FIELD VERIFIED FOR ACTUAL LOCATION.

RECORD DRAWING				
NO.	DATE	BY	APPD.	REVISIONS
		CHK.		

BSD DESIGNED	9/16/08
JS DRAWN	9/16/08
BSD CHECKED	9/16/08
APPROVED	DATE

TRI-COUNTY METROPOLITAN TRANSPORTATION DISTRICT OF OREGON

SOUTH CORRIDOR CONSTRUCTORS
Stacy and Wilbeck
GRANITE
WILDISH

DHILLON ENGINEERS, LLC
PORTLAND, OR

CAPITAL PROJECTS AND FACILITIES DIVISION
710 N.E. HOLLADAY STREET
PORTLAND, OREGON 97232

APPROVED: _____ DATE: _____

SOUTH CORRIDOR PROJECT I-205 SEGMENT ODOT MUP PATH LIGHTING PLANS MUP 11 STA 18+10 TO STA 23+00				
SCALE: AS SHOWN	DRAWING NO.: E16-401	CONTRACT NO.: RH040161LE	SHEET NO.: 193A	

NOTES:

REFER TO E16-404 FOR NOTES.

I-205
LIGHT RAIL
EXHIBIT D

RECORD DRAWINGS

PREPARED BY: TRI-MET


APPROVED: *[Signature]*
NOV -5 2010 Project Engineering

DATE:

TERMINATE CONDUIT
FOR 'CTC' CONTRACTOR
TO CONTINUE OR CONNECT
TO 'CTC' CONTRACTOR CONDUIT

BY "CTC" CONTRACTOR
SEE NOTE 5



FROM E16-401 DRAWING

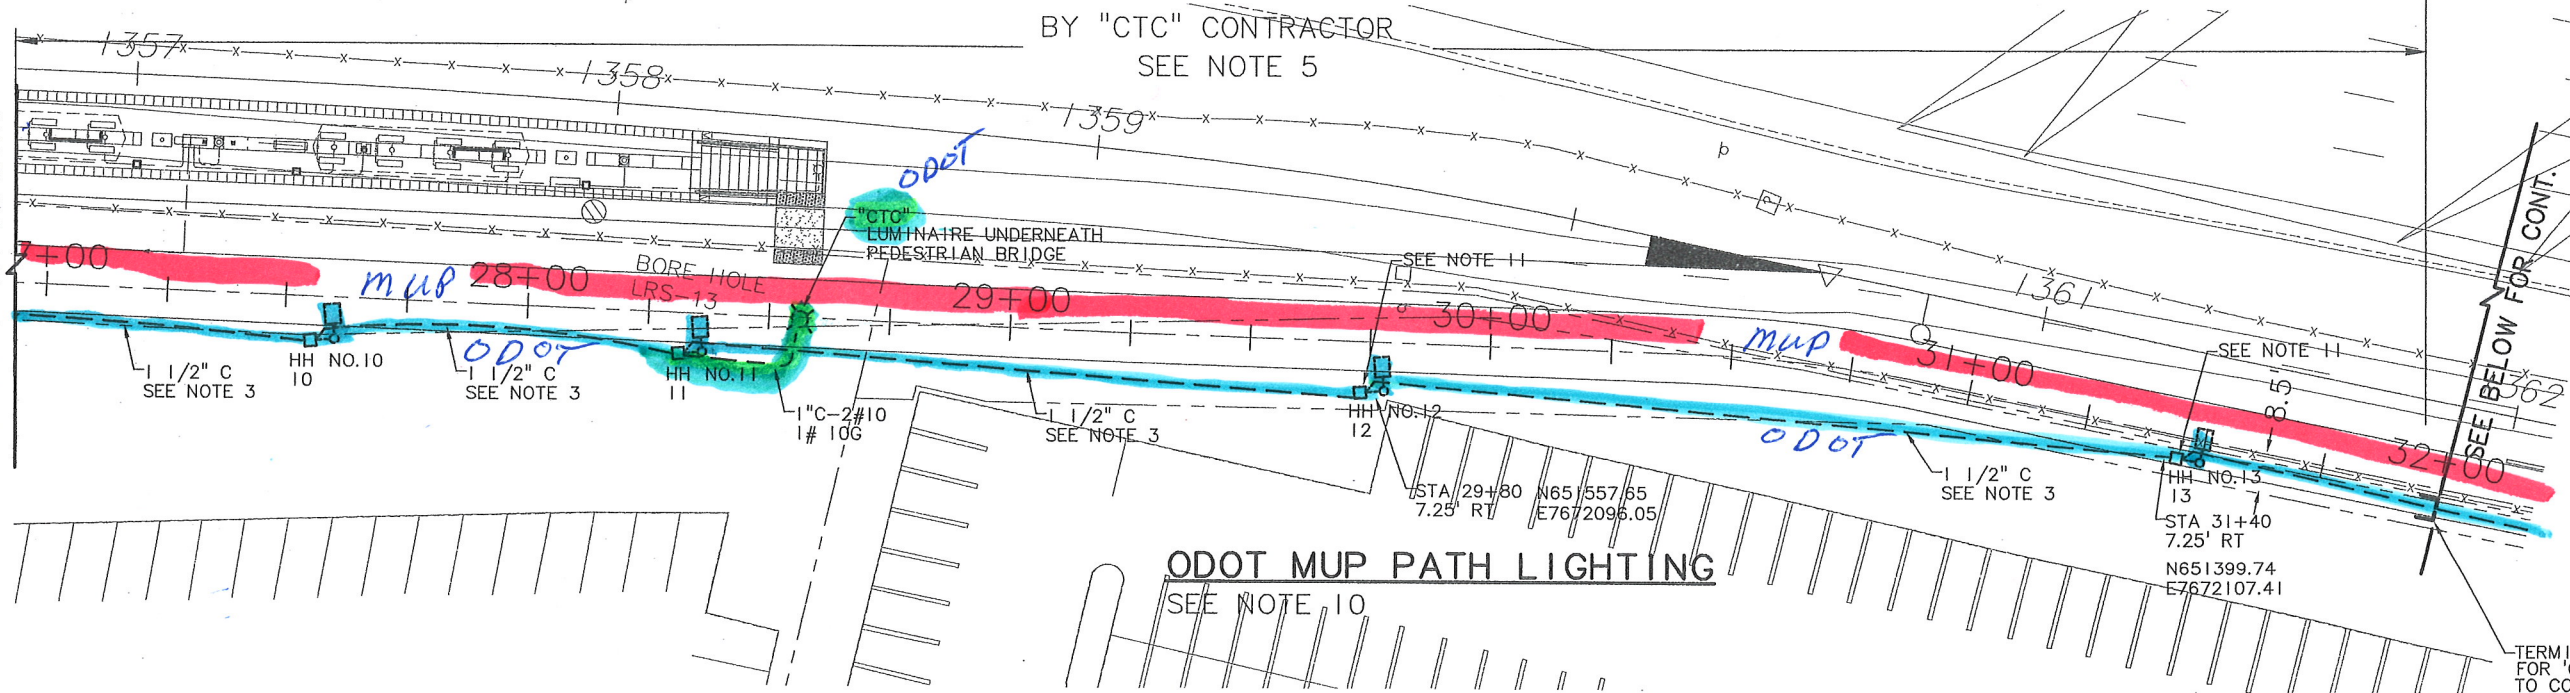

ODOT MUP PATH LIGHTING

SEE NOTE 10

SEE ABOVE FOR CONT.

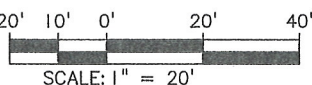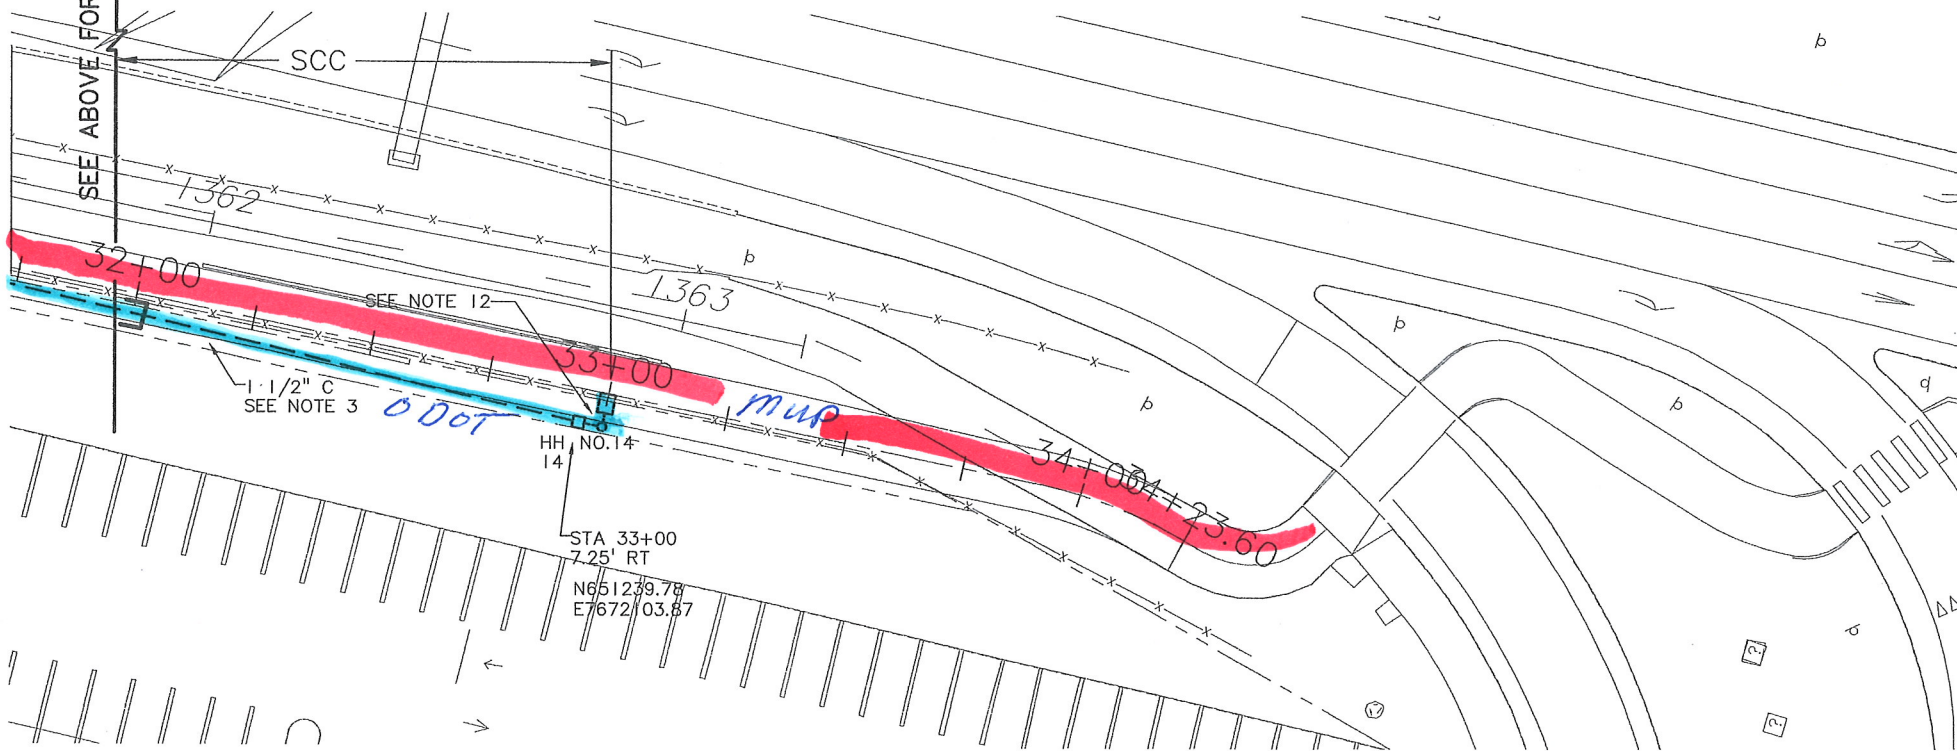

NOTE: THESE RECORD DRAWINGS REPRESENT THE BEST KNOWN INFORMATION ABOUT CONSTRUCTED FACILITIES. LOCATIONS SHOWN ARE NOT WARRANTED. UNDERGROUND UTILITIES MUST BE FIELD VERIFIED FOR ACTUAL LOCATION.

RECORD DRAWING

NO.	DATE	BY	APPD.	REVISIONS

BSD DESIGNED	9/16/08
DATE	
JS DRAWN	9/16/08
DATE	
BSD CHECKED	9/16/08
DATE	
APPROVED	
DATE	



TRI-COUNTY METROPOLITAN TRANSPORTATION DISTRICT OF OREGON

SOUTH CORRIDOR CONSTRUCTORS
Stacy and Wilbeck
GRANITE
WILDISH

DHILLON ENGINEERS, LLC
PORTLAND, OR
DAVID EVANS
AND ASSOCIATES INC.



CAPITAL PROJECTS
AND
FACILITIES DIVISION
710 N.E. HOLLADAY STREET
PORTLAND, OREGON 97232

SOUTH CORRIDOR PROJECT
I-205 SEGMENT

ODOT MUP PATH LIGHTING
PLANS
MUP 11 STA 32+00 TO STA 34+20

SCALE: AS SHOWN	DRAWING NO.: E16-402	CONTRACT NO.: RH040161LE	SHEET NO.: 193B
-----------------	----------------------	--------------------------	-----------------