



# Site Plan for 311 NE 90<sup>th</sup> Street

## Root Zone Protection

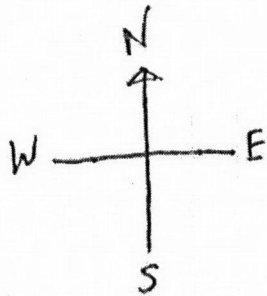

1" = 20'  
Scale

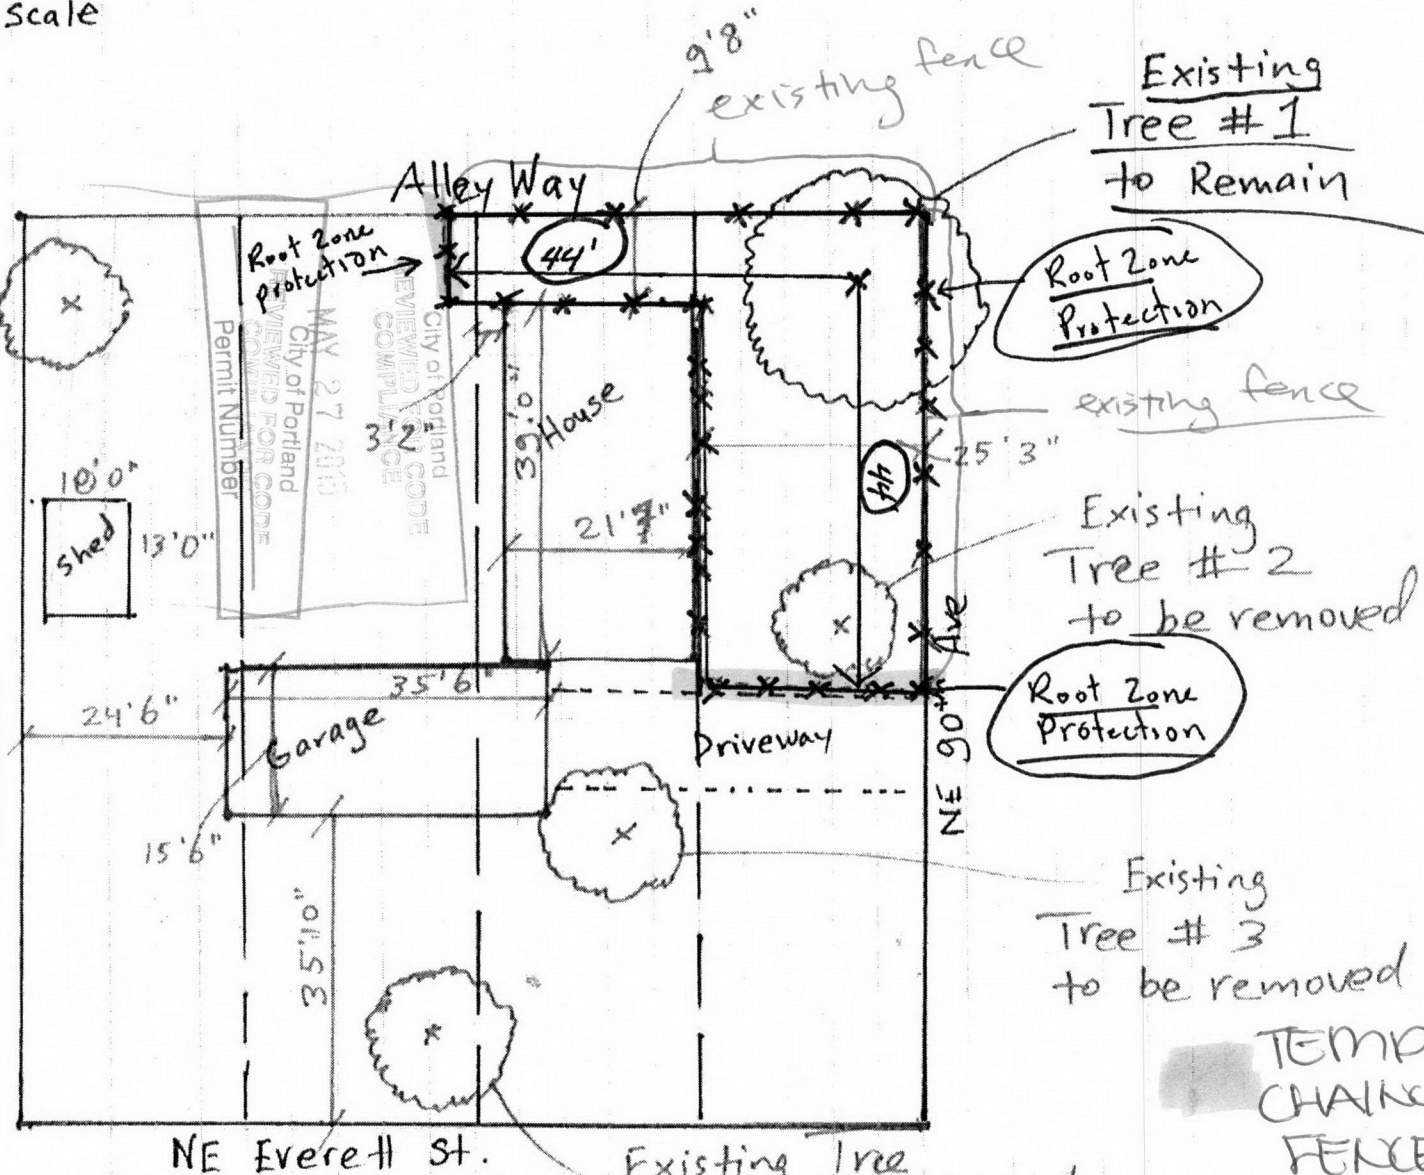

Existing Tree #5 to be removed

Existing Tree #1 to Remain

Root Zone Protection

existing fence

Existing Tree #2 to be removed

Root Zone Protection

Existing Tree #3 to be removed

TEMP 6' T CHAINLINK FENCE

Existing Tree #4 to be removed

TREE PROTECTION REQUIRED

REQUIRED SIGN & TREE PROTECTION FENCING MUST BE INSPECTED BEFORE ANY GROUND DISTURBANCE. SEE ATTACHED SHEET FOR MORE INFORMATION ON REGULATIONS.

ROOT PROTECTION ZONE: ☐ PERFORMANCE ☒ PRESCRIPTIVE

City of Portland  
Development Services  
Approved by  
Planning & Zoning Review  
5/21/10

15-170207 Rev 01 RS

2



# City of Portland, Oregon - Bureau of Development Services

1900 SW Fourth Avenue • Portland, Oregon 97201 • 503-823-7300 • [www.portlandoregon.gov/bds](http://www.portlandoregon.gov/bds)



## Permit Revision Application and Submittal Requirements

A Permit Revision is required when there are proposed changes to the project after the permit has been issued. This may arise due to discrepancies between the city-approved permit drawings and actual field conditions, or the customer has changed their mind about an aspect of the project. In all cases, a revision to the existing permit must be submitted, reviewed and approved.

### Applicants will provide:

☐ A copy of this application

☐ Three (3) sets of plans that clearly reflect the proposed change(s).

Drawings and calculations must be stamped and signed by the Architect and/or the Engineer of Record, if applicable.

☐ One (1) copy of the original city approved permit drawings. (NOTE: If your project has an assigned process manager please contact them regarding submittal of the revision).

☐ Two (2) sets of calculations, if applicable

☐ Inspector's correction notice, if revision is due to an inspection correction

☐ Revision fee (paid at time of submittal)

### Contact Information:

Contact name Joseph Kim

Address 71250 NW Skyline Blvd

City Portland State OR Zip Code 97231

Phone 503 943 0001 Email joemalibu@hotmail.com

Value of proposed revision \_\_\_\_\_ Issued permit # 15-170207-R

Description of revision tree code must be met with

root protection zone provided

### Fees:

The Permit Revisions are subject to fees associated with plan review, processing and any increase in project value. Additional fees may apply if adding plumbing fixtures.

The Bureau of Development Services fee schedule is available under the fees tab on the BDS web site at: [www.portlandoregon.gov/bds](http://www.portlandoregon.gov/bds). Fees are updated annually on July 1st.

### Helpful Information:

#### Bureau of Development Services

City of Portland, Oregon  
1900 SW 4th Avenue, Portland, OR 97201  
[www.portlandoregon.gov/bds](http://www.portlandoregon.gov/bds)

#### Submit your plans in person to:

Development Services Center (DSC), First Floor,  
For Hours Call 503-823-7310 | Select option 1

### Important Telephone Numbers:

BDS main number ..... 503-823-7300  
DSC automated information line ..... 503-823-7310  
Building code information ..... 503-823-1456  
BDS 24 hour inspection request line ..... 503-823-7000  
Residential information for  
one and two family dwelling ..... 503-823-7388  
General Permit Processing and  
Fee Estimate info ..... 503-823-7357  
City of Portland TTY ..... 503-823-6868