



CITY OF PORTLAND, OREGON - BUREAU OF DEVELOPMENT SERVICES

1900 SW Fourth Avenue, Suite 5000 • Portland, Oregon 97201 • www.portlandonline.com/bds • Fax 503-823-7425



Facility Permit Plan Intake Form

FOR INTAKE, STAFF USE ONLY

Date Received 12/5 Building/Mechanical SCOTT B
Electrical LEEH
Building Registration # _____ Plumbing n/b
Fixed Bid _____ Fire TERRY K
Bin # F26 Planning LAURA
Building Permit # 17-254022 REV01 FA BES _____
Mechanical # _____ PDOT _____
Plumbing Permit # _____ Structural _____
Electrical Permit # _____ Other _____

APPLICANT: Complete all sections below that apply to the project. Please print legibly.

Print Name PHILIP ZWETTLER Sign Name [Signature]
Street Address 812 SW WASHINGTON ST.
City PORTLAND State OR Zip Code 97205
Day Phone (503) 226 0622 FAX _____ email ZWETTLER@MCA-ARCHITECTS.COM

Plans / permits available for pick up at 1900 SW 4th Avenue, 2nd floor between 8:00 am to 5:00 pm

Contact Name for plan/permit pick up PHILIP ZWETTLER
Day Phone (503) 226-0622 email ZWETTLER@MCA-ARCHITECTS.COM

Project Building Name / # ADIDAS NARCO WH.
Project Address or Location 2120 NW 27th AVE
Project Name and Description ADIDAS AMERICA NARCO WAREHOUSE - WAREHOUSE
REUDO INCLUDE: SCOPE CHANGE & ASSOCIATED CALCULATIONS
Total Project Value \$1.7 MILLION Project Reference #/Billing ID # 17-254022 FA
Building Contractor TURNER CONST. CCB # _____
Mechanical Contractor _____ CCB # _____
Electrical Contractor _____ CCB# _____ License # _____
Plumbing Contractor _____ CCB# _____ License # _____

☐ Building Permit

No. of Stories _____
Const. Type _____

Alarms Required _____
Smoke Det. Req'd _____
Sprinklers Req'd _____
Struct. Eng / Calcs Submitted _____

☐ Electrical Permit


Please provide a completed standard electrical permit application form. You may mail or deliver it to 1900 SW 4th Avenue, Portland, Oregon 97201 or FAX to 503-823-7425.

☐ Plumbing Permit

Number of Fixtures _____
Back Flow Devices _____
Water Service (# of Feet) _____
Medical Gas _____
Other _____

☐ Mechanical Permit

Mechanical Valuation _____
Description _____

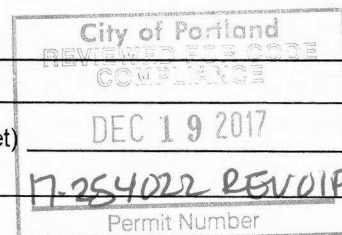

2

3
2

17-254022 REV01 FA

F26



MEMORANDUM

TO: Facilities Permit Program City of Portland
Bureau of Development Services

FROM: Philip Zwettler
MCA Architects, PC
812 SW Washington Street, Suite 800
Portland, OR 97205

DATE: December 05, 2017

JOB NO.: 17-126

JOB NAME: #17-254022 FA adidas NACCO Warehouse
Portland, OR

RE: Scope and Submission Changes

This memorandum is for the purpose of clarifying scope changes to the adidas NACCO Warehouse project #17-254022 FA that may affect the current review process.

SCOPE CHANGE: Previous approved submission showed partial occupancy of the building – this current submission shows full building occupancy. S-1 occupancy remains for the entirety of the building. No exterior changes to the building.

All Plans: Modified to show scope, areas of work.

G-101	Modified Egress, calculations
A-101	Modified Parking, parking calculations
A-200	Modified to show full scope
A-202	Modified to show full scope, additional security fence, shelving
A-203	Modified due to scope
A-204	Modified due to scope
A-205	Modified to show full scope
A-206	Modified to show full scope
A-207	Modified to show full scope
A-400	Modified to show full scope, additional security wall
A-500	Removed due to change in security wall
A-600	Modified door schedule
A-700	Modified details

17126_2.3.4_memo_2017-12-05



MEMORANDUM

TO: Facilities Permit Program City of Portland
Bureau of Development Services

FROM: Philip Zwettler
MCA Architects, PC
812 SW Washington Street, Suite 800
Portland, OR 97205

DATE: December 13, 2017

JOB NO.: 17-126

JOB NAME: #17-254022 FA adidas NACCO Warehouse
Portland, OR

RE: Scope and Submission Changes

This memorandum is for the purpose of clarifying scope changes to the adidas NACCO Warehouse project #17-254022 FA that may affect the current review process.

REVISIONS: The following sheets have had revisions:

A-200	Revised to show removal of urinal
A-202	Revised to show new racking layout, no partition in men's restroom
A-600	Revised elevations, door schedule

17126_2.3.4_memo_2017-12-13

adidas AMERICA, INC.
NACCO WAREHOUSE
2120 NW 27th Avenue
PORTLAND, OR, 97210

COVER SHEET

REV. #	DATE	DESCRIPTION
1	10/17/17	ADDITIONAL REVISION
2	10/25/17	REVISIONS


PROJECT NO: 17-426

DRAWN BY: P2, CHKD BY: FR


DATE: 10/06/17

G-000


© copyright

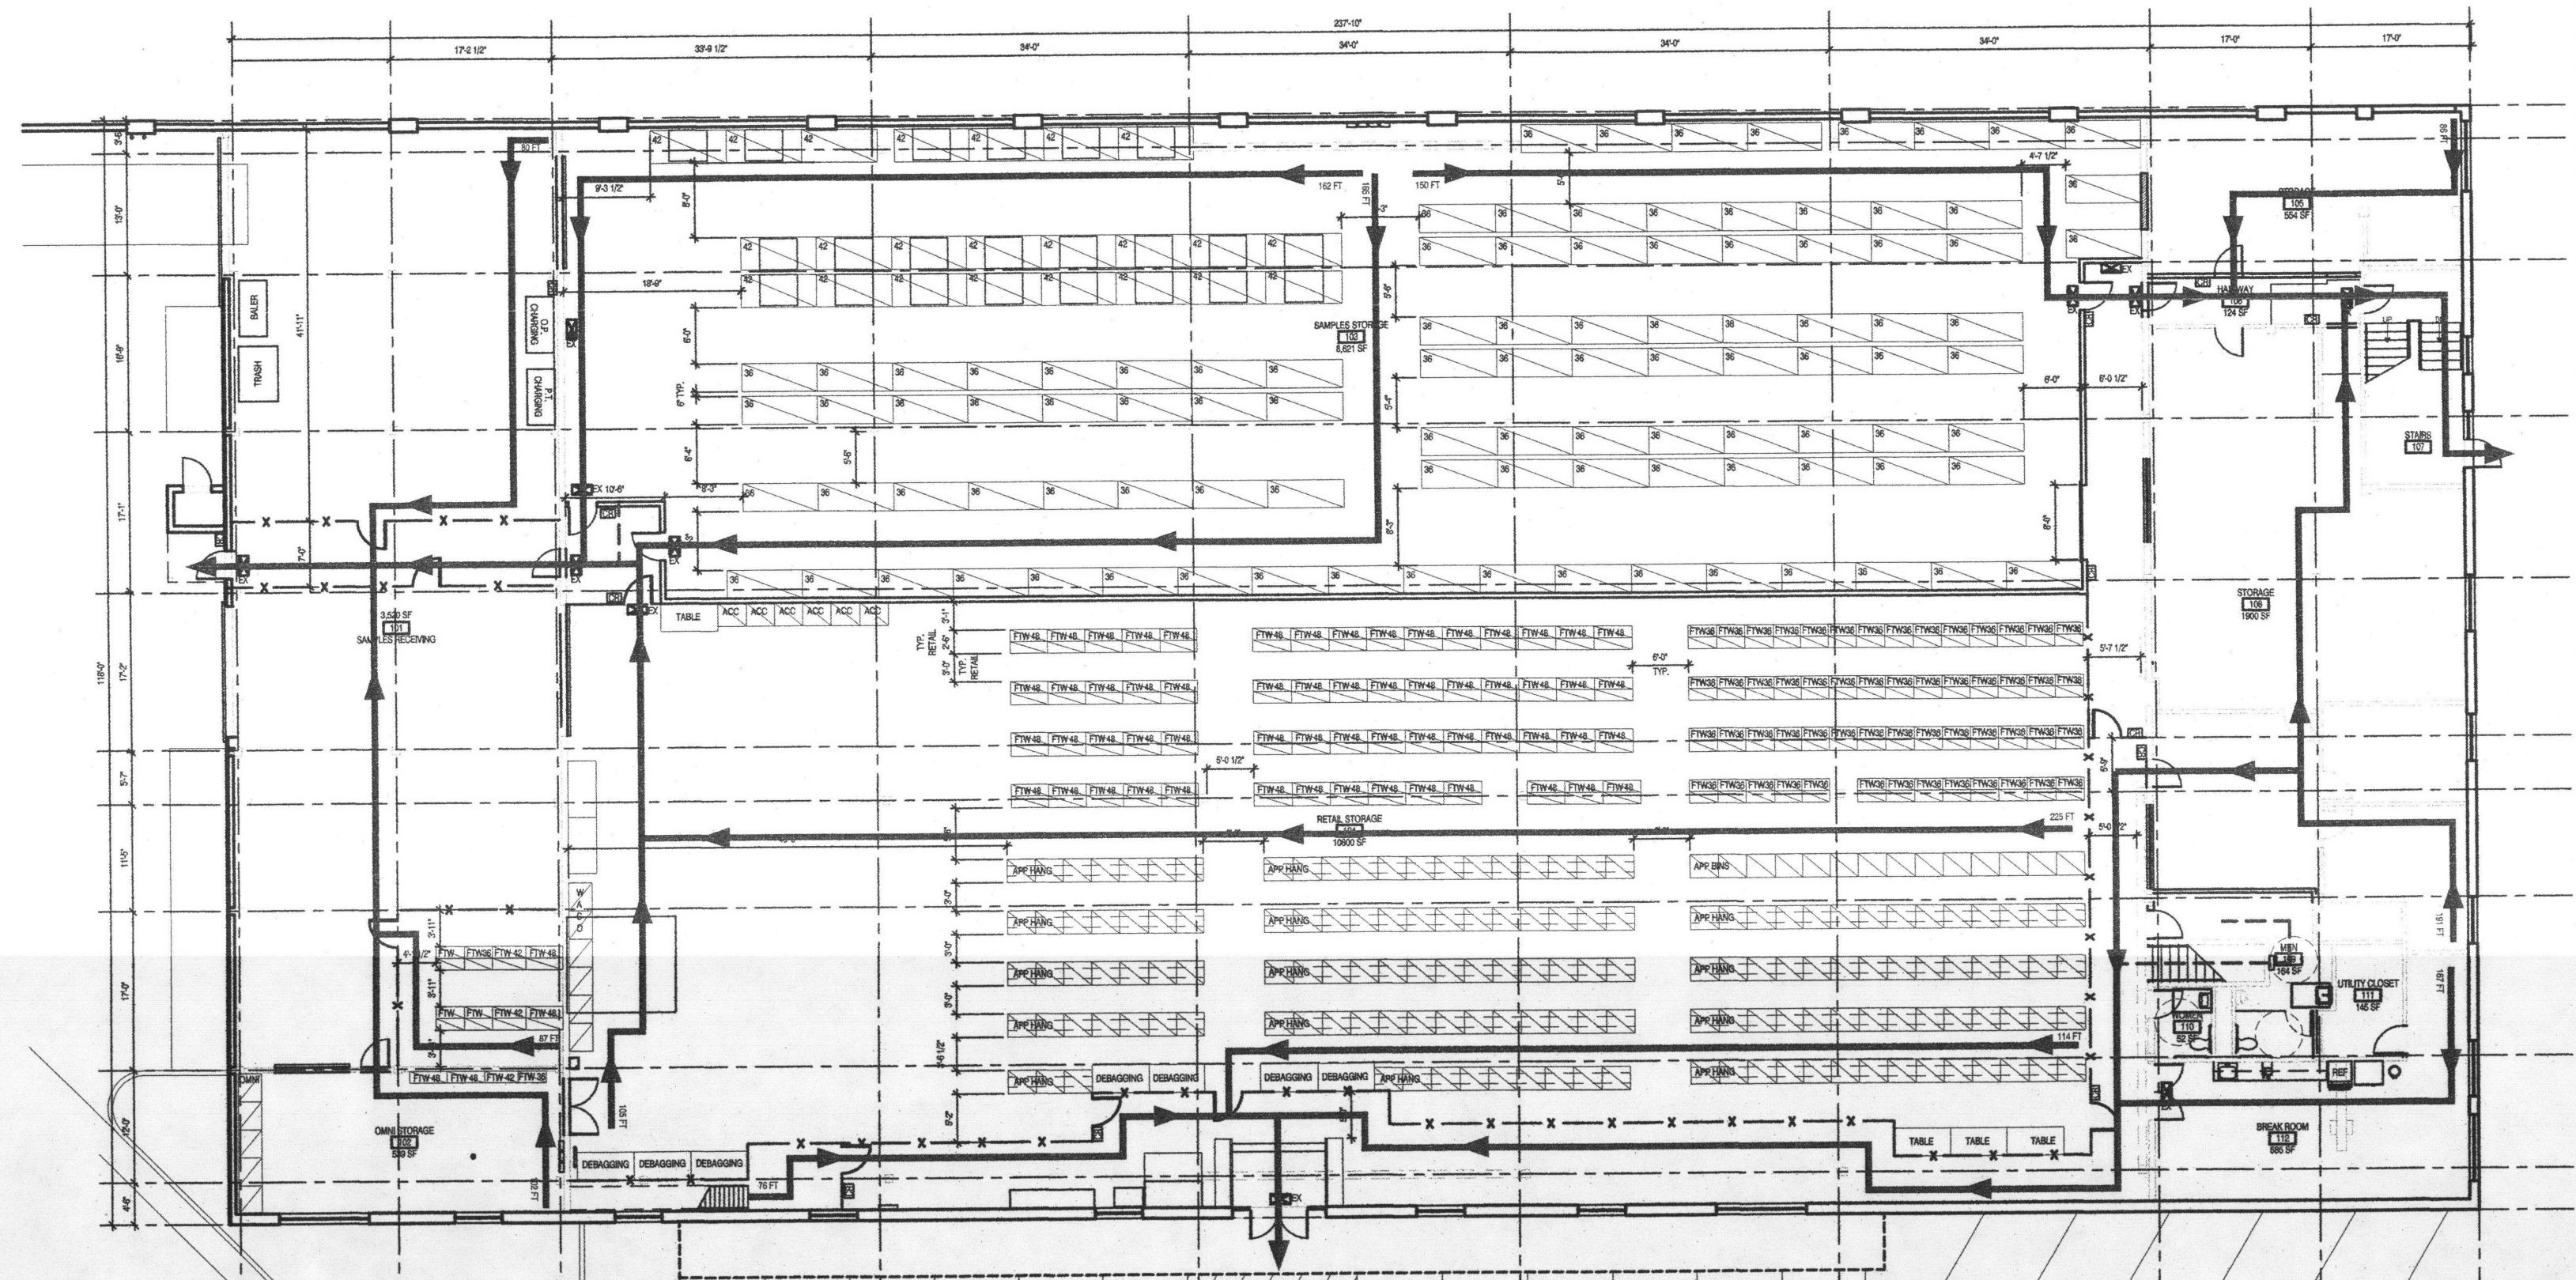


1 FIRST FLOOR EGRESS PLAN
G-101 1/16" = 1'-0"

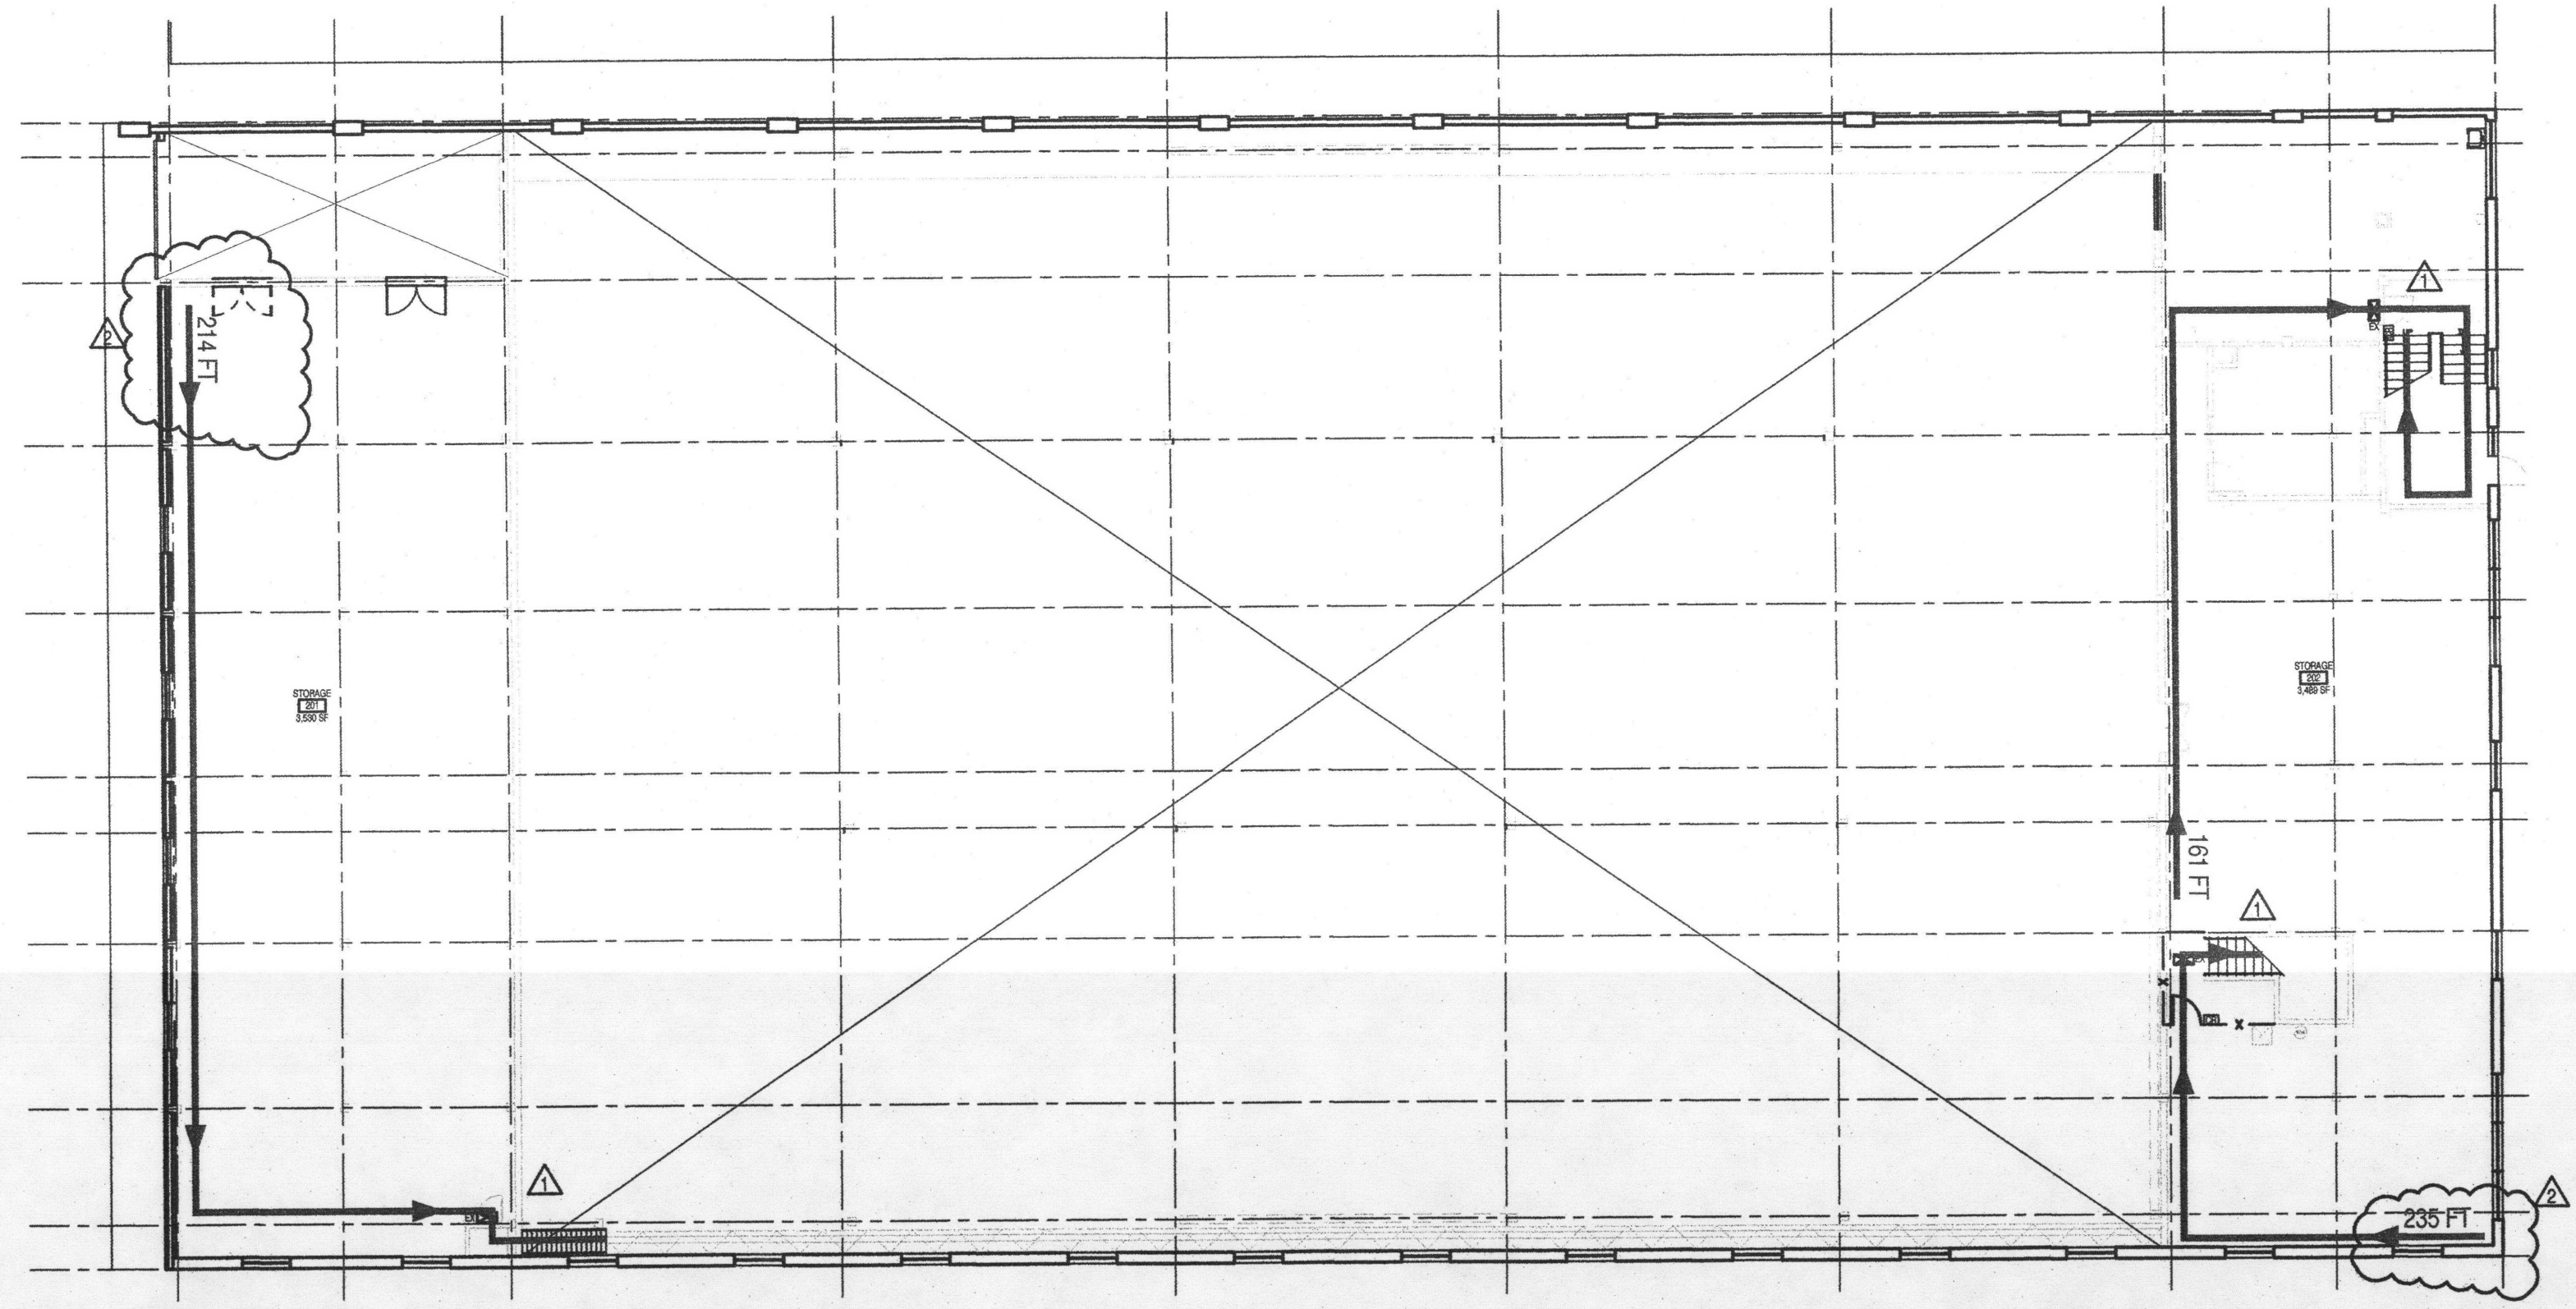


2 MEZZANINE EGRESS PLAN
G-101 1/16" = 1'-0"

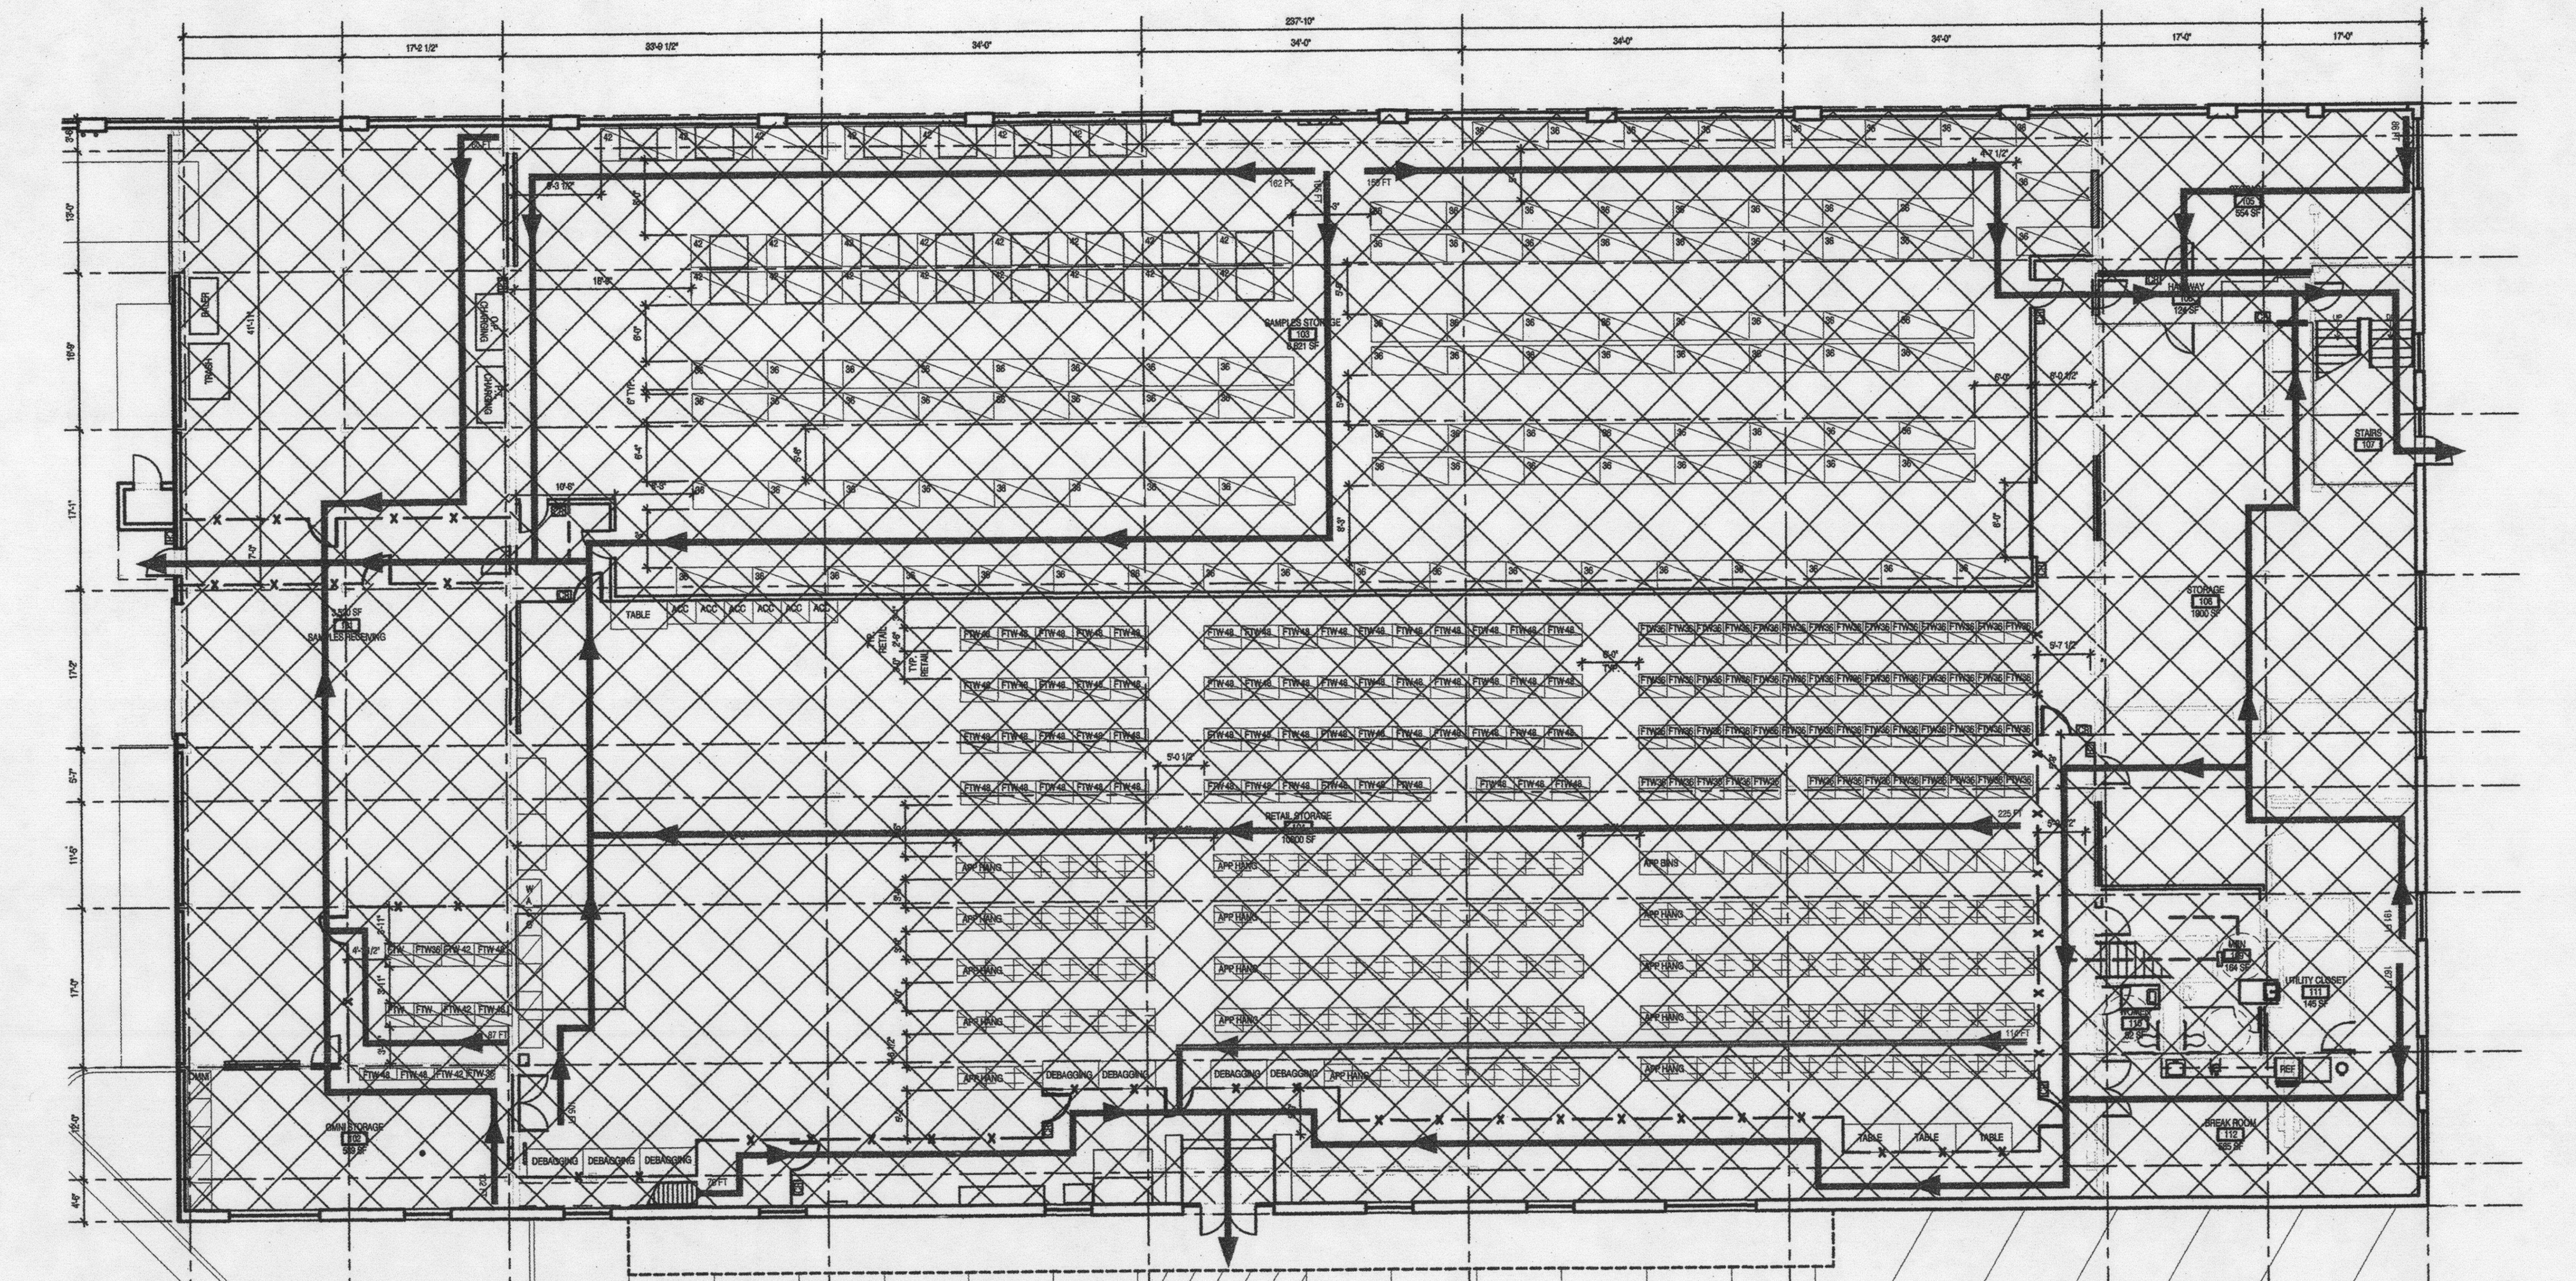

3 FIRST FLOOR OCCUPANCY
G-101 1/16" = 1'-0"

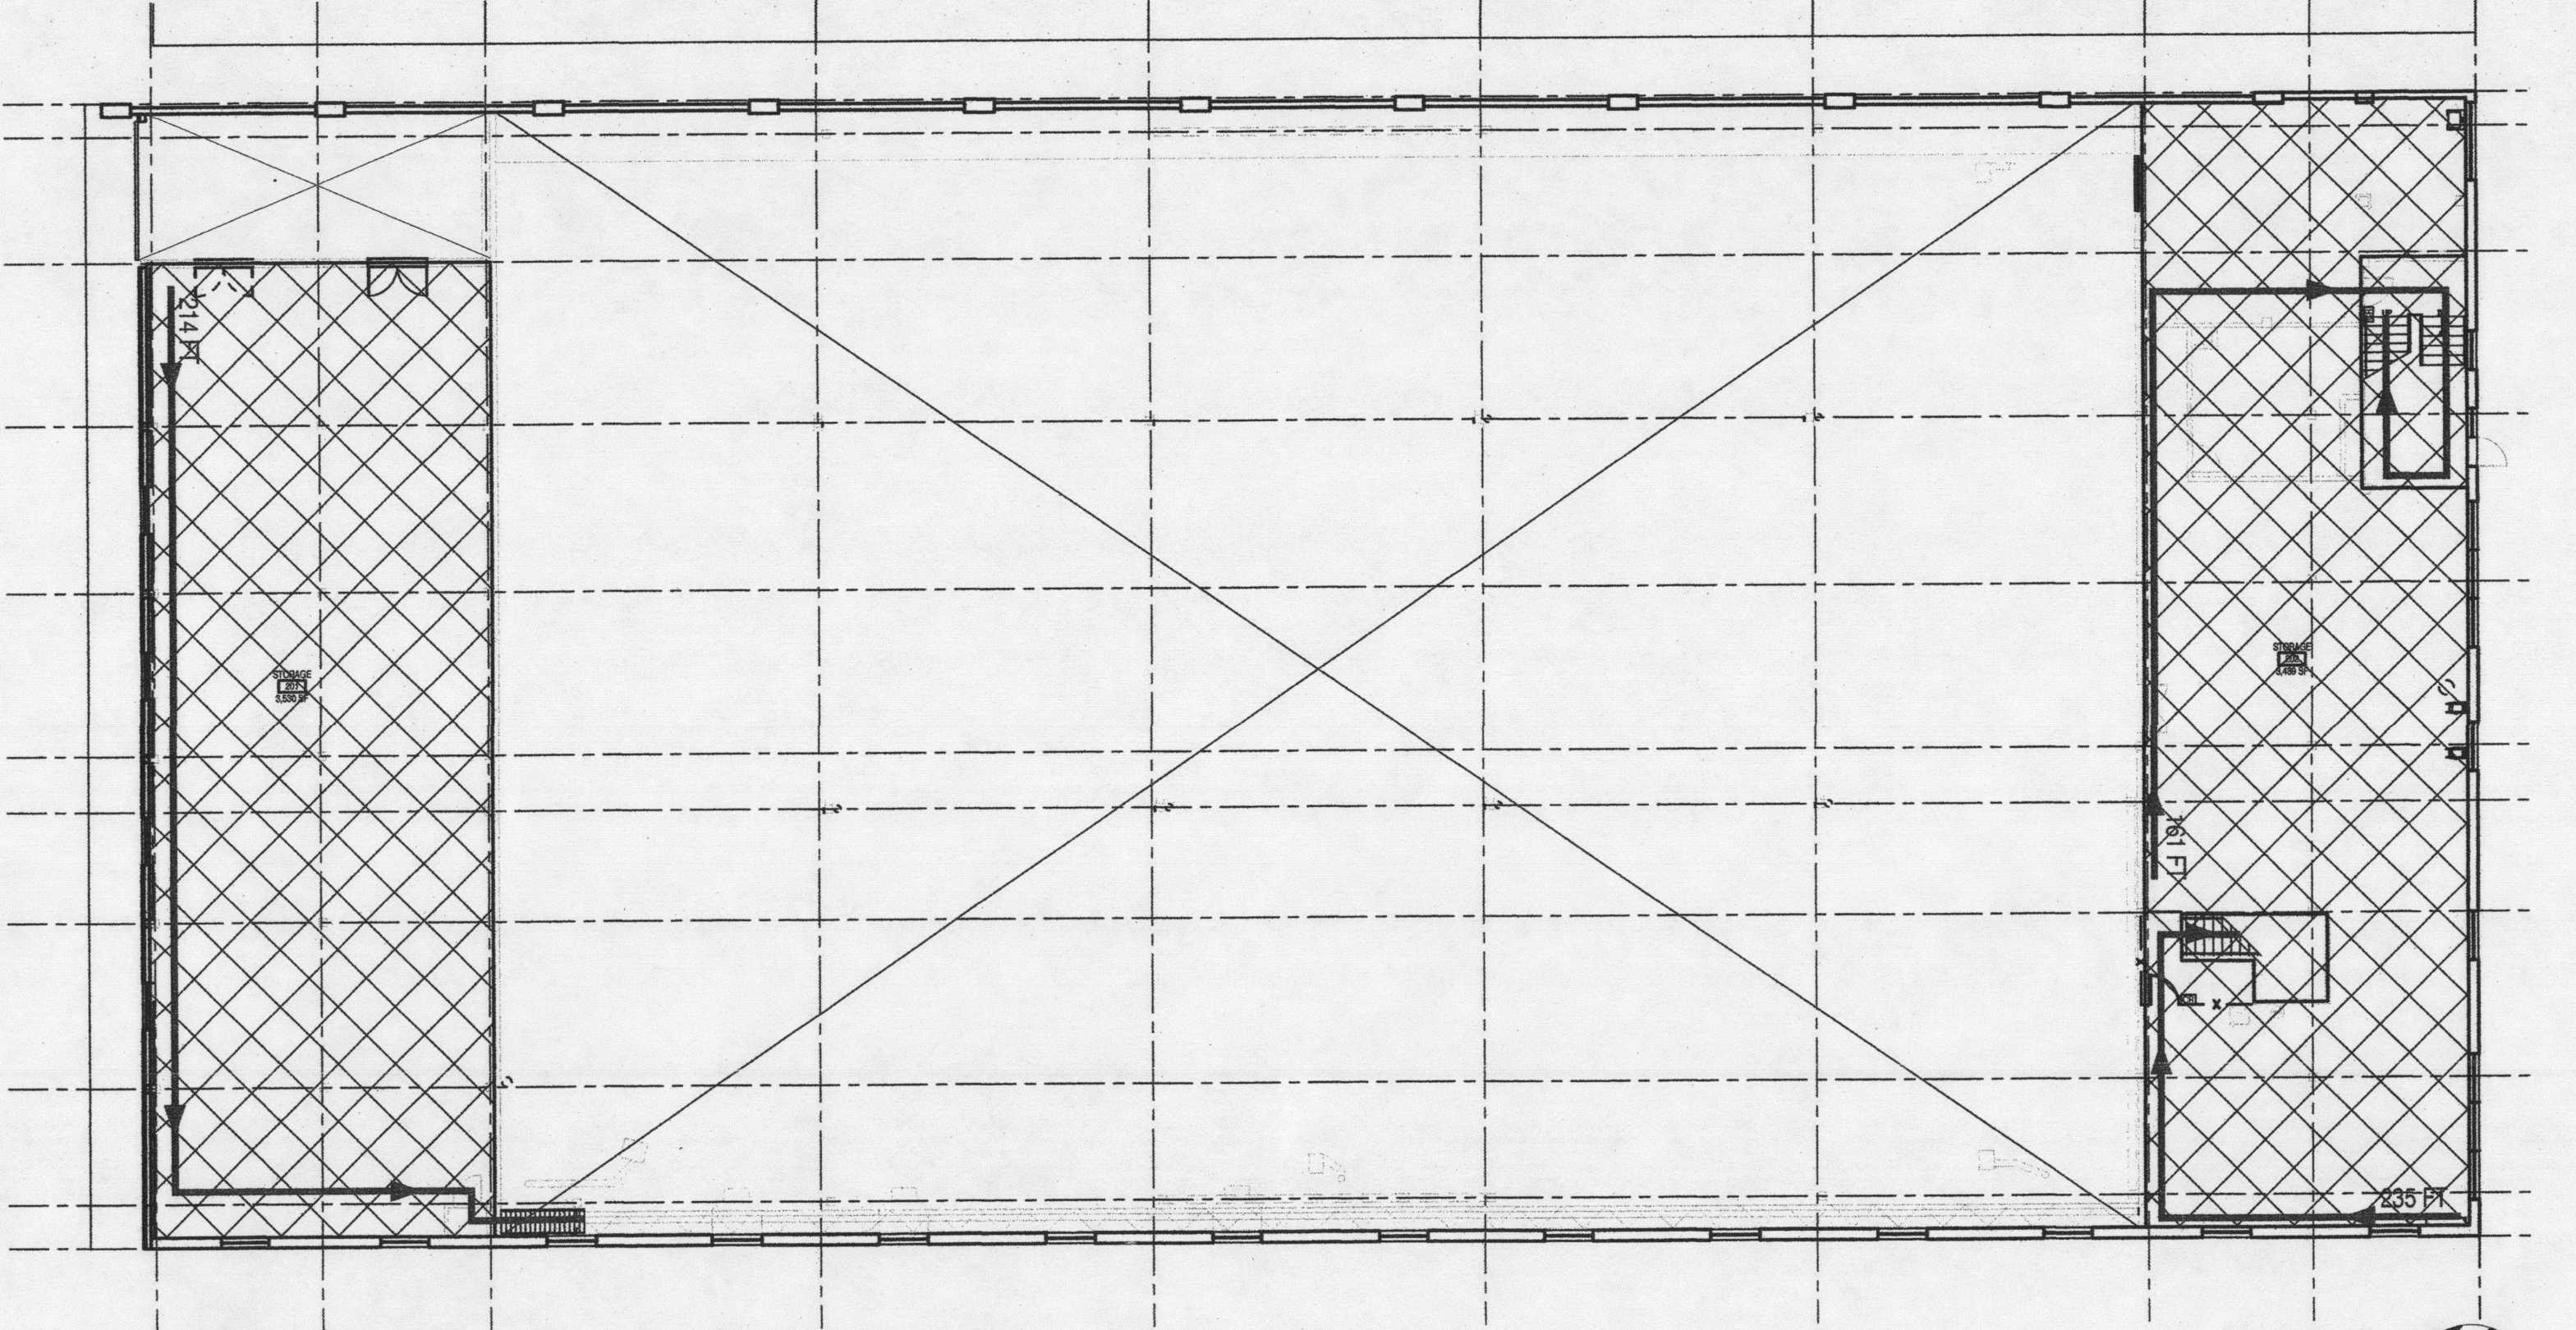

4 MEZZANINE PLAN - OCCUPANCY
G-101 1/16" = 1'-0"

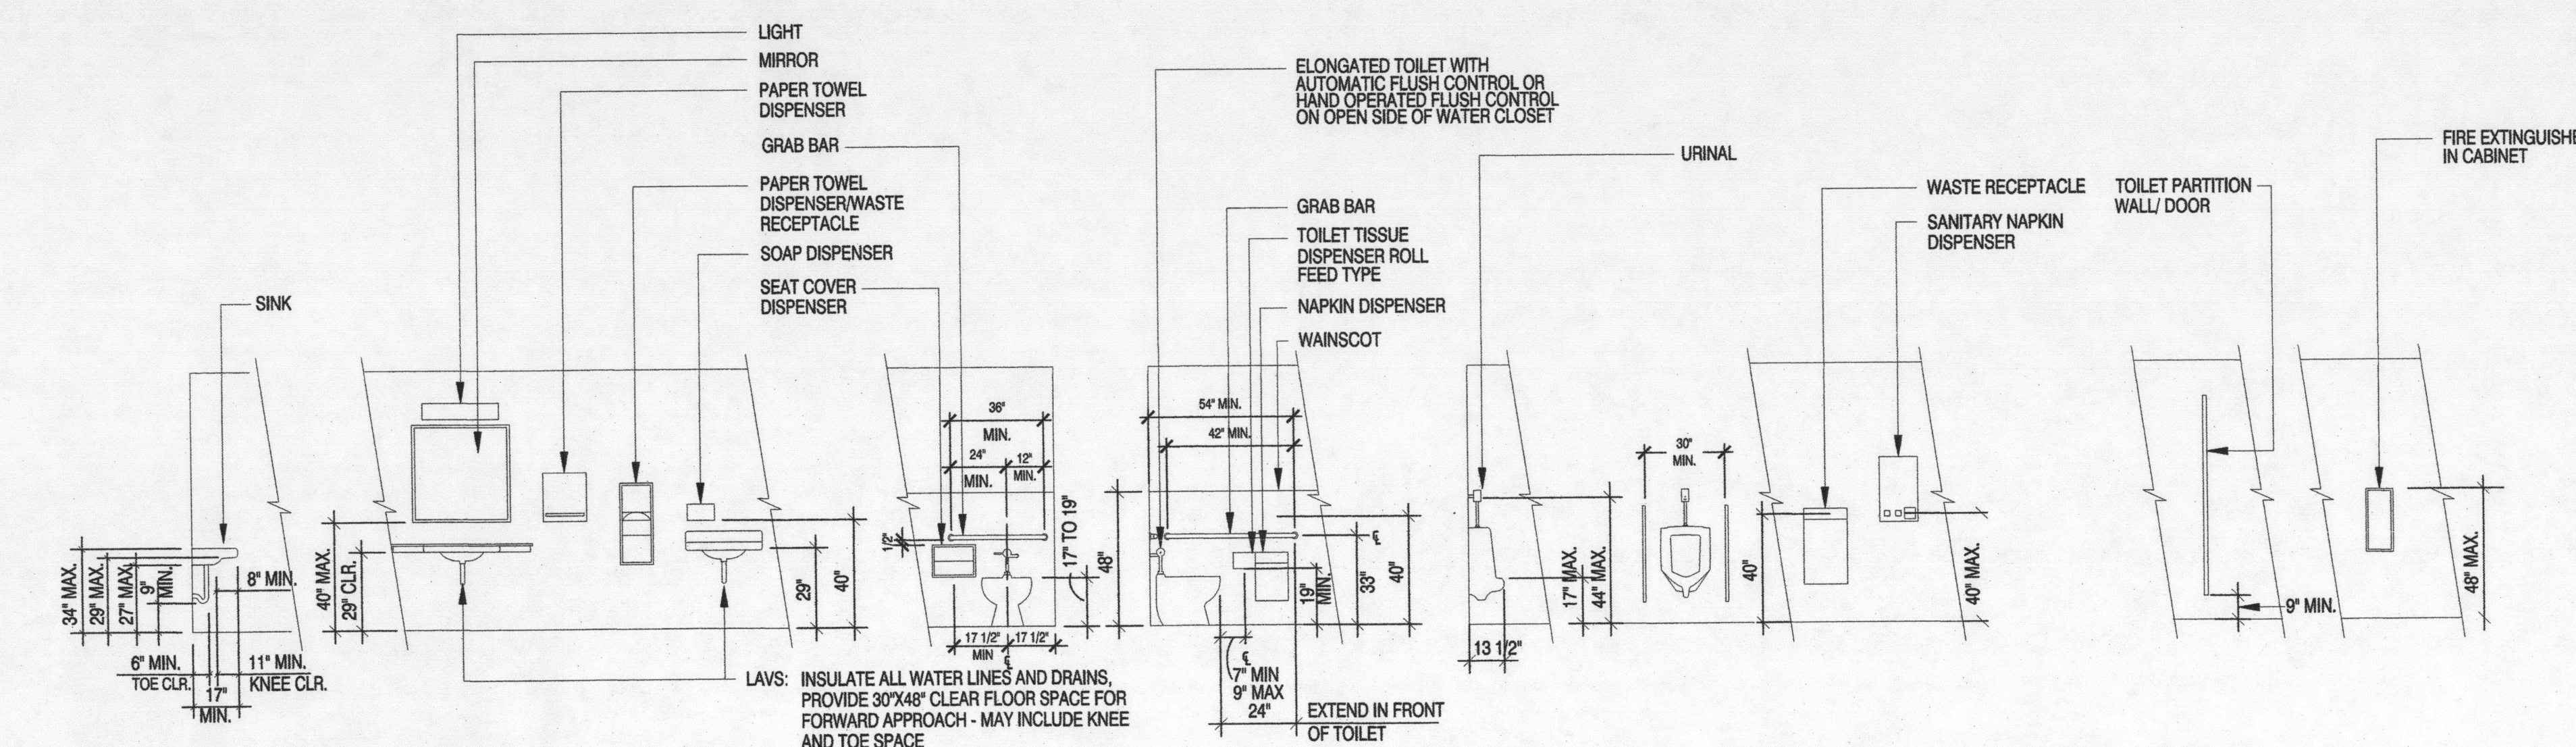

5 ACCESSORY MOUNTING HEIGHTS - ADA ACCESSIBLE
G101 NOT ALL ACCESSORIES SHOWN ON MOUNTING HEIGHT SCHEDULE OCCUR - REFER TO PLAN FOR LOCATIONS.

RM #	ROOM NAME	AREA	OCCUPANCY	RATE	TOTAL OCCUPANTS
FIRST FLOOR AREAS					
101	RECEIVING	3520	S-1	1/500	7.04
102	OMNI	539	S-1	1/500	1.08
103	SAMPLES STORAGE	8621	S-1	1/500	17.24
104	RETAIL STORAGE	10800	S-1	1/500	21.60
105	STORAGE	554	S-1	1/500	1.10
106	HALLWAY	124	S-1	1/500	0.25
107	STAIRS	250	S-1	1/500	0.50
108	STORAGE	1900	S-1	1/500	3.80
109	MENS	164	S-1	1/500	0.33
110	WOMENS	52	S-1	1/500	0.10
111	UTILITY CLOSET	145	S-1	1/500	0.29
112	BREAK ROOM	585	S-1	1/500	1.17
SECOND FLOOR AREAS					
201	STORAGE	3530	S-1	1/500	7.06
202	STORAGE	3500	S-1	1/500	7.00
					0.00
					0.00
					68.56

OCCUPANCY BREAKDOWN



		FIRST FLOOR	SECOND FLOOR
S-1 WAREHOUSE / STORAGE		27,348 SQ FT 54.69	7,030 SQ FT 14.06
TOTAL		27,348 SQ FT 54.69 OCC.	7,030 SQ FT 14.06 OCC.
TOTAL FLOOR AREA:		34,378 SQ FT 68.75 (69 OCC)	

PLUMBING CALCULATIONS

S-1 WAREHOUSE / STORAGE	34,378 SQ FT	68.76 = 69 OCC
TOTAL	34,374 SQ FT	68.76 = 69 OCC
S-1 1 PER 100 OCCUPANTS = (1) WC (69) OCCUPANTS		
TOTAL REQUIRED WATER CLOSETS = (1) WATER CLOSETS		
S-1 1 PER 100 OCCUPANTS = (1) LAV (69) OCCUPANTS		
TOTAL REQUIRED LAVATORIES = (1) LAVATORIES		
PER OSSC CHAPTER 2902.2 - SEPARATE FACILITIES	MEN	WOMEN
	1 WC	1 WC
	1 LAV	1 LAV

LEGEND

EX EXIT SIGN - SEE ELECTRICAL BY SEPARATE PERMIT

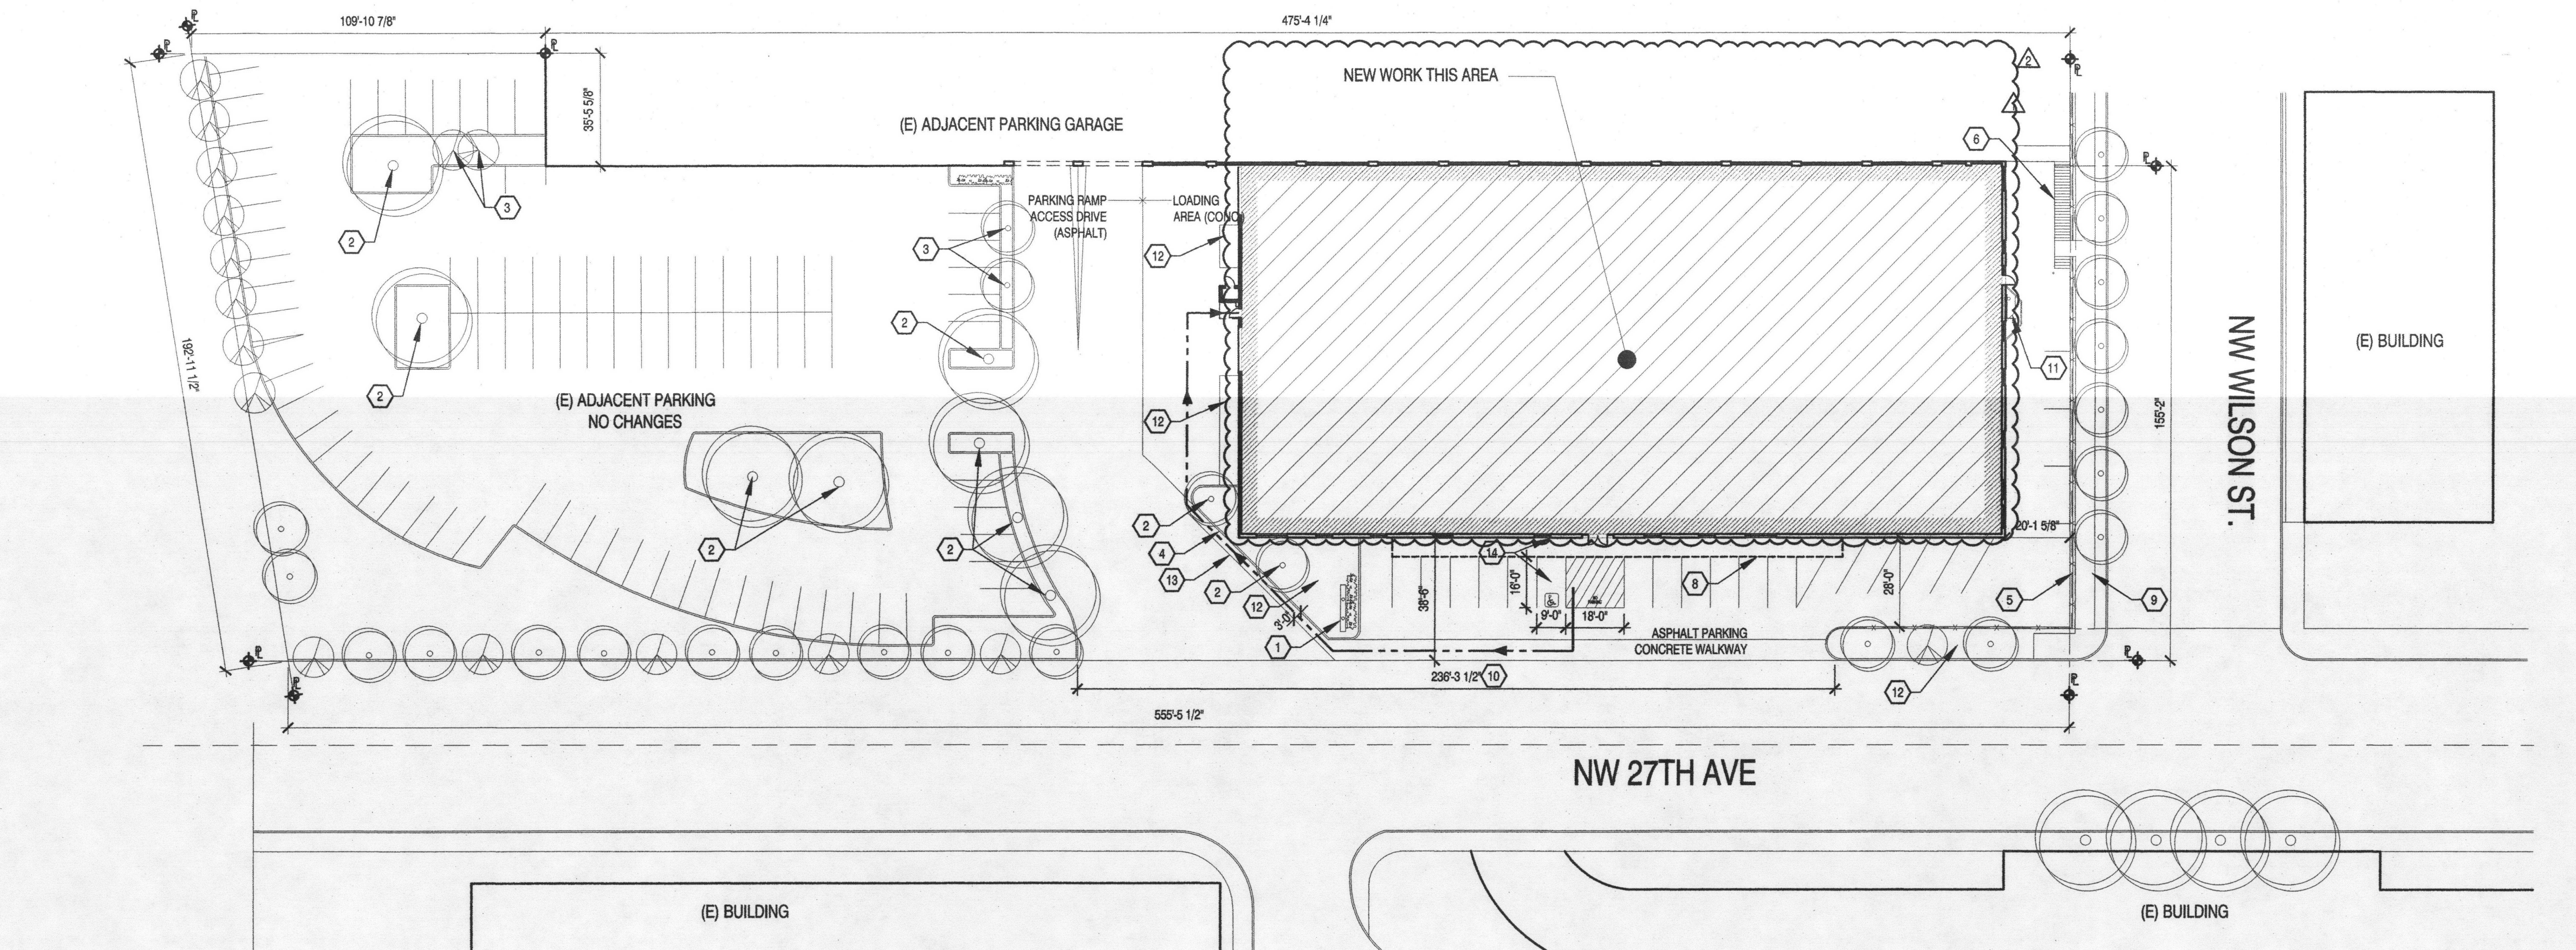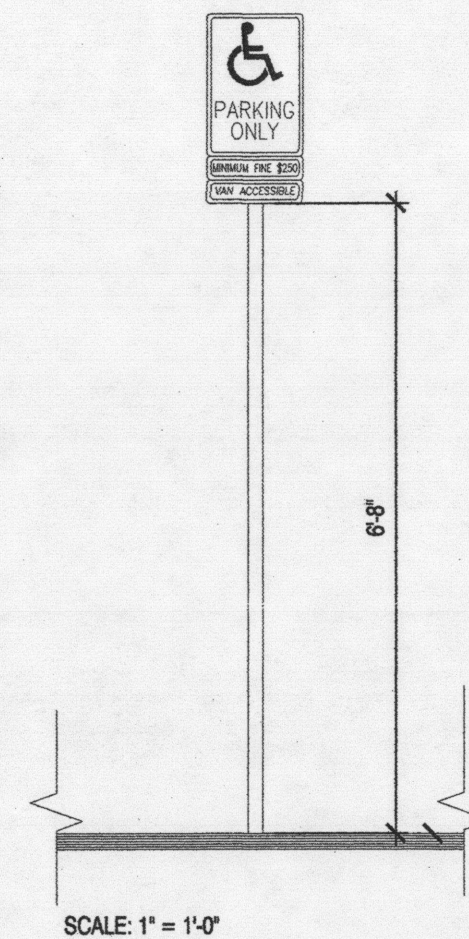**1 SITE PLAN**
A-101 1/32" = 1'-0"**2 ACCESSIBLE PARKING SIGNAGE**
A-101**SITE NOTES**

1. NO EXTERIOR WORK THIS PERMIT.
2. ALL STREET TREES, PROPERTY TREES TO REMAIN

LEGEND

ACCESSIBLE PATH

KEYNOTES

1. (E) SIGN TO REMAIN
2. (E) 10" CALIPER TREE TO REMAIN
3. (E) 6" CALIPER TREE TO REMAIN
4. (E) RETAINING WALL TO REMAIN
5. (E) CHAIN LINK FENCE TO REMAIN
6. (E) SIDEWALK CANOPY TO REMAIN
7. (E) STAIR WAY TO REMAIN - SERVES ADJACENT PARKING STRUCTURE
8. (E) CANOPY TO REMAIN
9. (E) SIDEWALK - NO CHANGES
10. (E) DRIVEWAY APRON - NO CHANGES
11. (E) GAS METER, PLATFORM, BARRIER TO REMAIN
12. (E) LANDSCAPE BED TO REMAIN
13. (E) STRIPING
14. (N) ACCESSIBLE VAN PARKING SIGN, SPACE - SEE 2/A-101

AREA CALCULATIONS (EXISTING CONDITIONS NO CHANGE IN BUILDING AREA)

TOTAL AREA OF SITE	83,635 SQ FT
AREA WITHIN TENANT SPACE	34,378 SQ FT
TOTAL AREA BY USES	
WAREHOUSE	34,378 SQ FT

PARKING CALCULATIONSEXISTING PARKING STALLS - 75 TOTAL EXISTING STALLS
75 STANDARD

EXISTING BUILDING 34,820 SQ FT (NO CHANGE PROPOSED)

S-1 STORAGE	34,378 SF	1/750 SF*	12.9
			12.9 (13 STALLS)

TOTAL REQUIRED STALLS 13 STALLS

BICYCLE PARKING REQUIREMENTS

LONG TERM		REQ'D SPACES	
S-1 STORAGE	34,378 SF	2, OR 1/40,000 SF	2 SPACES
TOTAL LONG TERM BICYCLE SPACES			2 SPACES*
SHORT TERM		REQ'D SPACES	
S-1 STORAGE	31,170 SF	NONE	0 SPACES
TOTAL SHORT TERM BICYCLE SPACES			0 SPACES

*LONG-TERM BIKE STORAGE WILL BE PROVIDED IN THE MONTGOMERY PARK MAIN BUILDING'S LONG TERM BIKE PARKING CORRAL - THIS CORRAL IS LOCATED ON THE 1ST FLOOR, SECURED (WITHIN 100'-0" OF A SECURITY GUARD AND MONITORED WITH A SECURITY CAMERA). THIS LONG-TERM STORAGE IS WITHIN 300'-0" OF THE SITE.

BUILDING INFORMATION


OCCUPANCY TYPE:	S-1 WAREHOUSE
CONSTRUCTION TYPE	III-A
BUILDING AREA	34,820 SQ. FT.
NUMBER OF STORIES	2
FIRE SPRINKLERS	YES
FIRE ALARM	YES
ZONING	
BASE	EX - CENTRAL EMPLOYMENT
OVERLAY	O - DESIGN ZONE
COMP PLAN	EX - CENTRAL EMPLOYMENT
HISTORIC RESOURCE	
TYPE	HISTORIC LANDMARK
CLASSIFICATION	INDIVIDUAL NATIONAL REGISTER RESOURCE

REV # DATE DESCRIPTION
A 10/27/17 ADDENDUM 1 REVISION
A 12/05/17 REVISIONS

SITE PLAN

PROJECT NO: 17-426
DRAWN BY: PZ/CHK'D BY: FR
DATE: 10/06/17

REV #	DATE	DESCRIPTION	ADDITIONAL REVISION
1	10/27/17	ADDITIONAL REVISION	
2	12/05/17	REVISION	
3	12/05/17	REVISION	

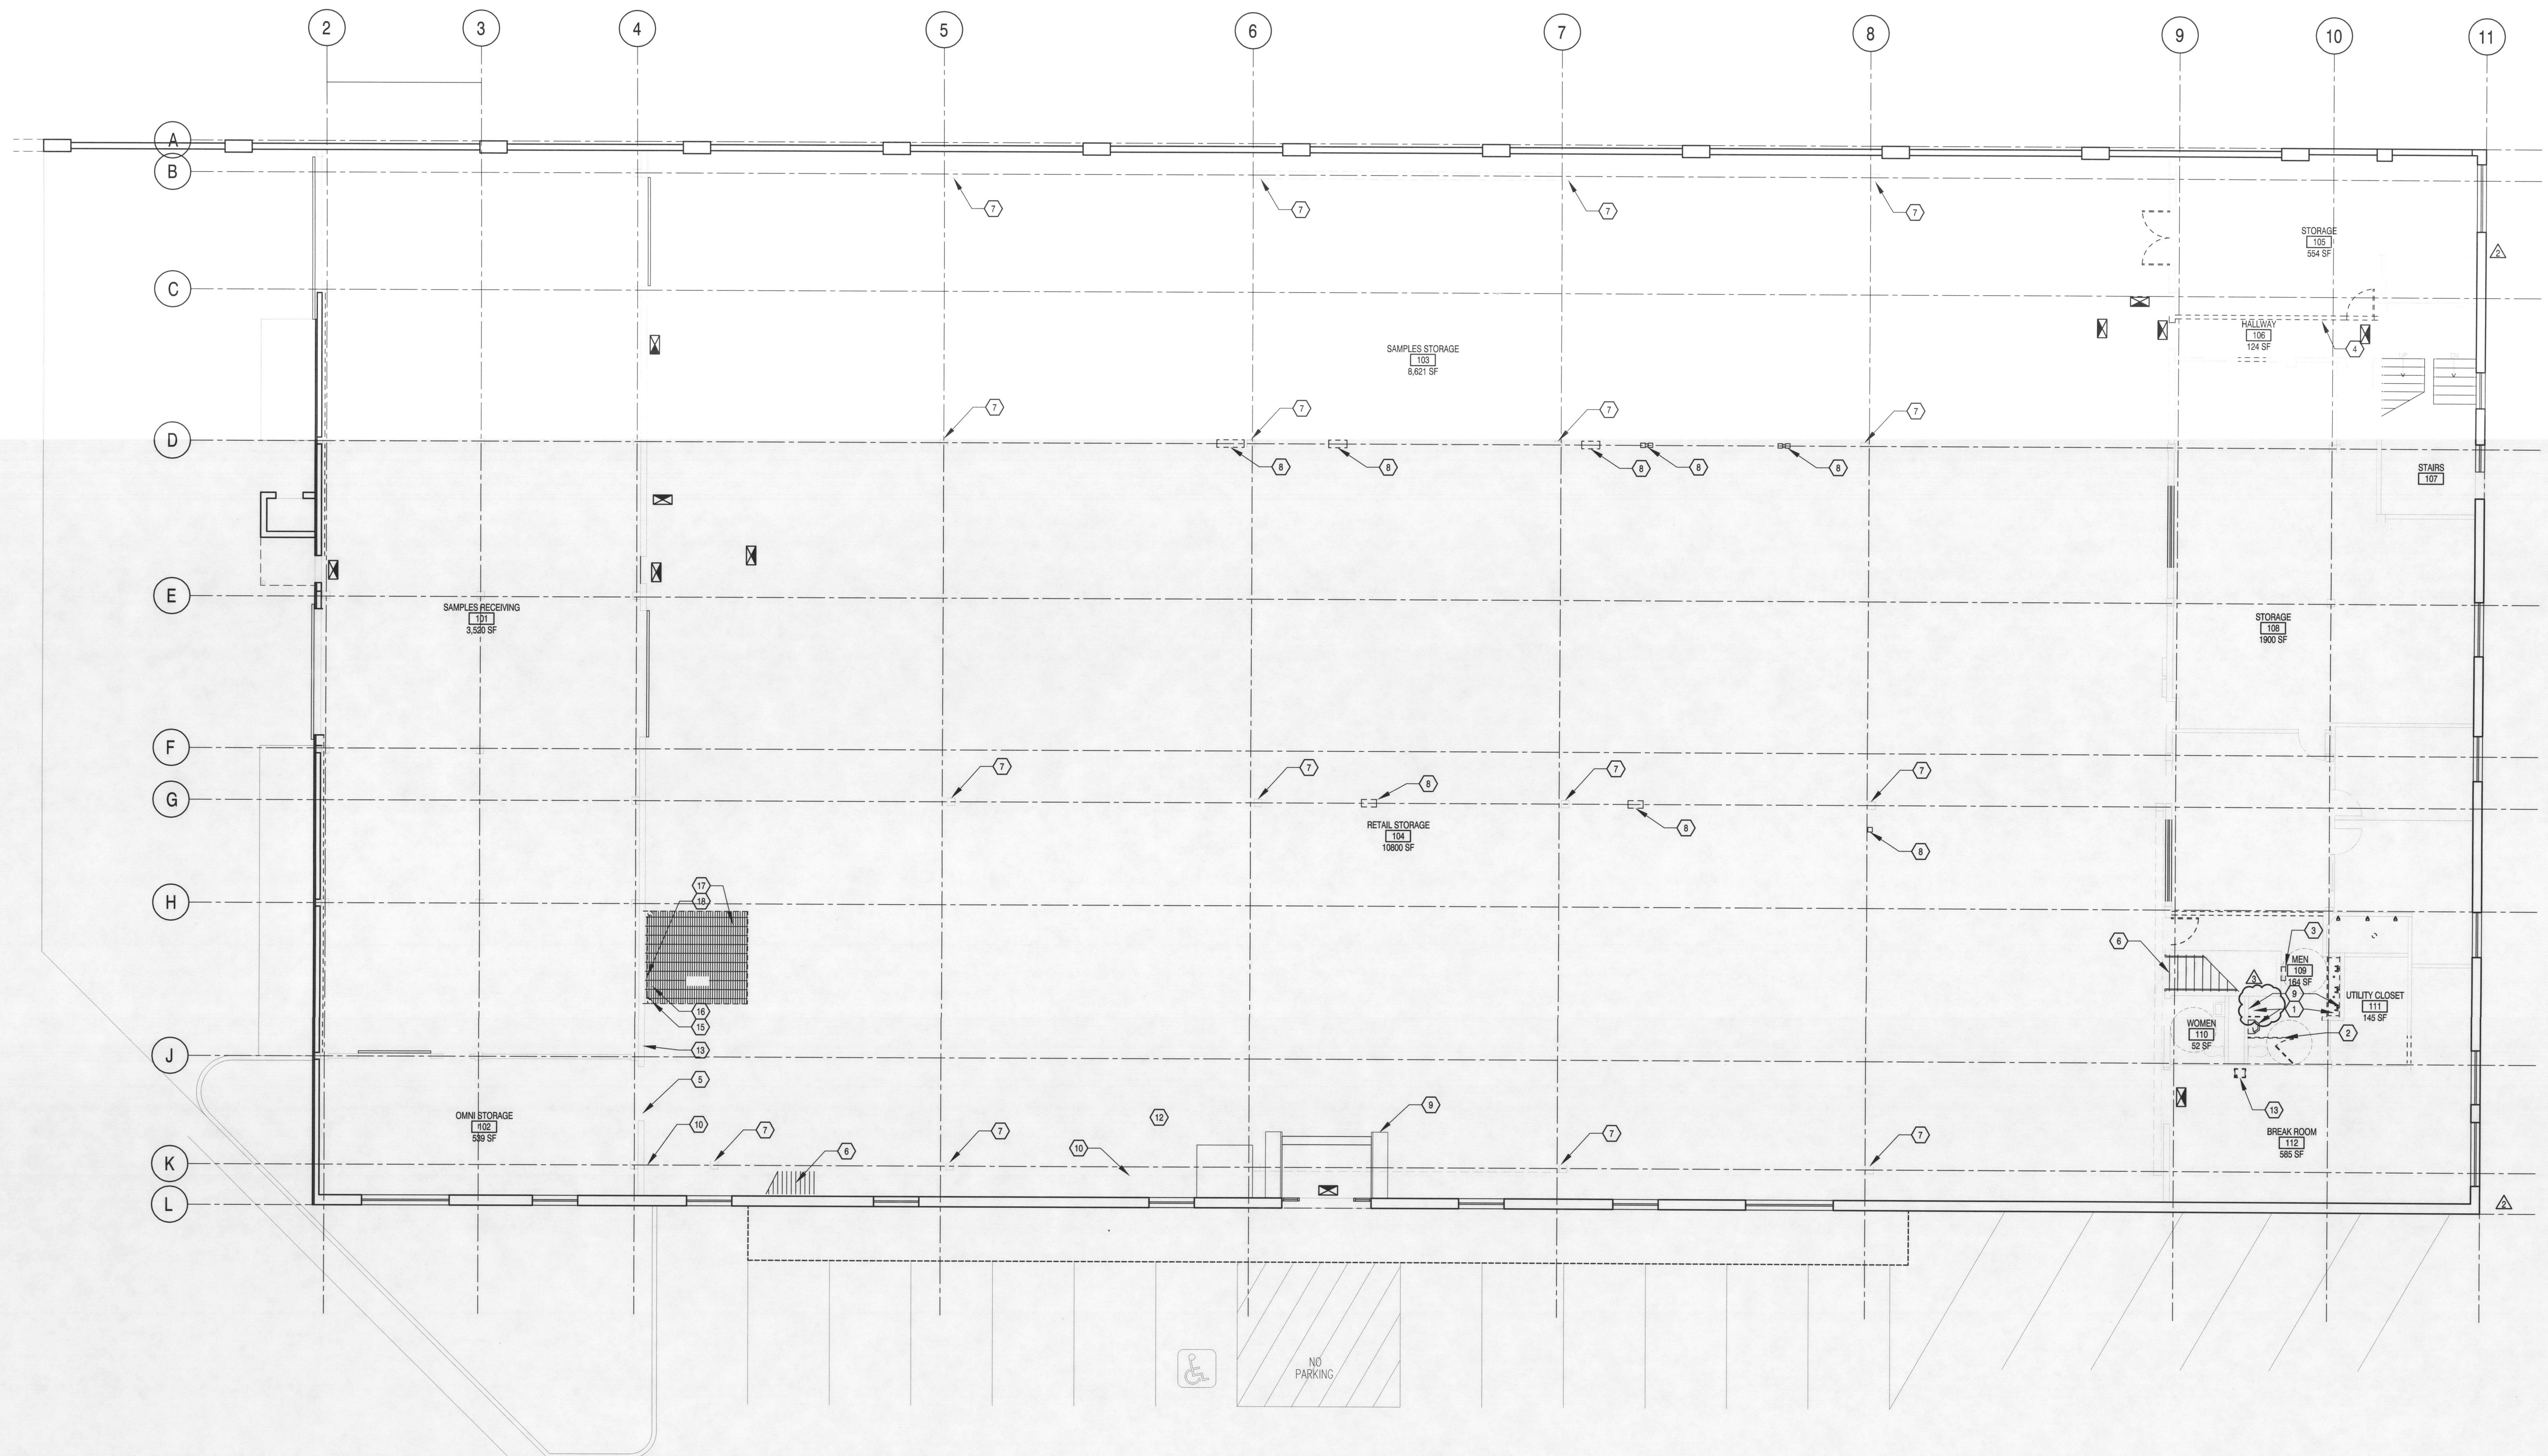

1 DEMOLITION PLAN - FIRST FLOOR
A-200 1/8" = 1'-0"


KEYNOTES

- REMOVE (E) BATHROOM FIXTURE
- REMOVE (E) TOILET PARTITION
- REMOVE (E) BATHROOM EQUIPMENT
- REMOVE (E) CONCRETE CURB, SMOOTH TO MATCH (E) SLOPE
- (E) DOOR TO REMAIN - PAINT FRAME, DOOR
- (E) STAIRWAY TO REMAIN - CLEAN, SCRAPE, REPAINT
- REMOVE (E) DECOMMISSIONED ELECTRICAL, WATER, DUCT, CONDUIT/TIPPING AT COLUMN UP TO CEILING
- REMOVE (E) UTILITY
- REMOVE (E) WALL TILE
- (E) PLUMBING RISER TO REMAIN
- HANDRAIL, MOUNTING PANEL TO REMAIN
- ELECTRICAL SWITCHBOXES, EQUIPMENT TO REMAIN
- REMOVE (E) DRINKING FOUNTAIN, PATCH WALL BEHIND
- REPAIR DAMAGED WALL WHERE OCCURS, PAINT
- REMOVE (E) BLAST SHIELD
- REMOVE (E) HOSE REEL
- REMOVE (E) FLOOR GRATE, INFILL TO MATCH EXISTING FLOOR
- REMOVE (E) EXHAUST DUCT


LEGEND

- DEMO INTERIOR WALL
- EXISTING WALL TO REMAIN
- - - - - REMOVE (E) DOOR, FRAME, REUSE IF POSSIBLE
- == == == REMOVE (E) GLAZING, FRAME
- /// NO WORK THIS PERMIT

REV #	DATE	DESCRIPTION
1	10/27/17	ADDITIONAL REVISIONS
2	12/05/17	REVISIONS
3	12/13/17	REVISIONS

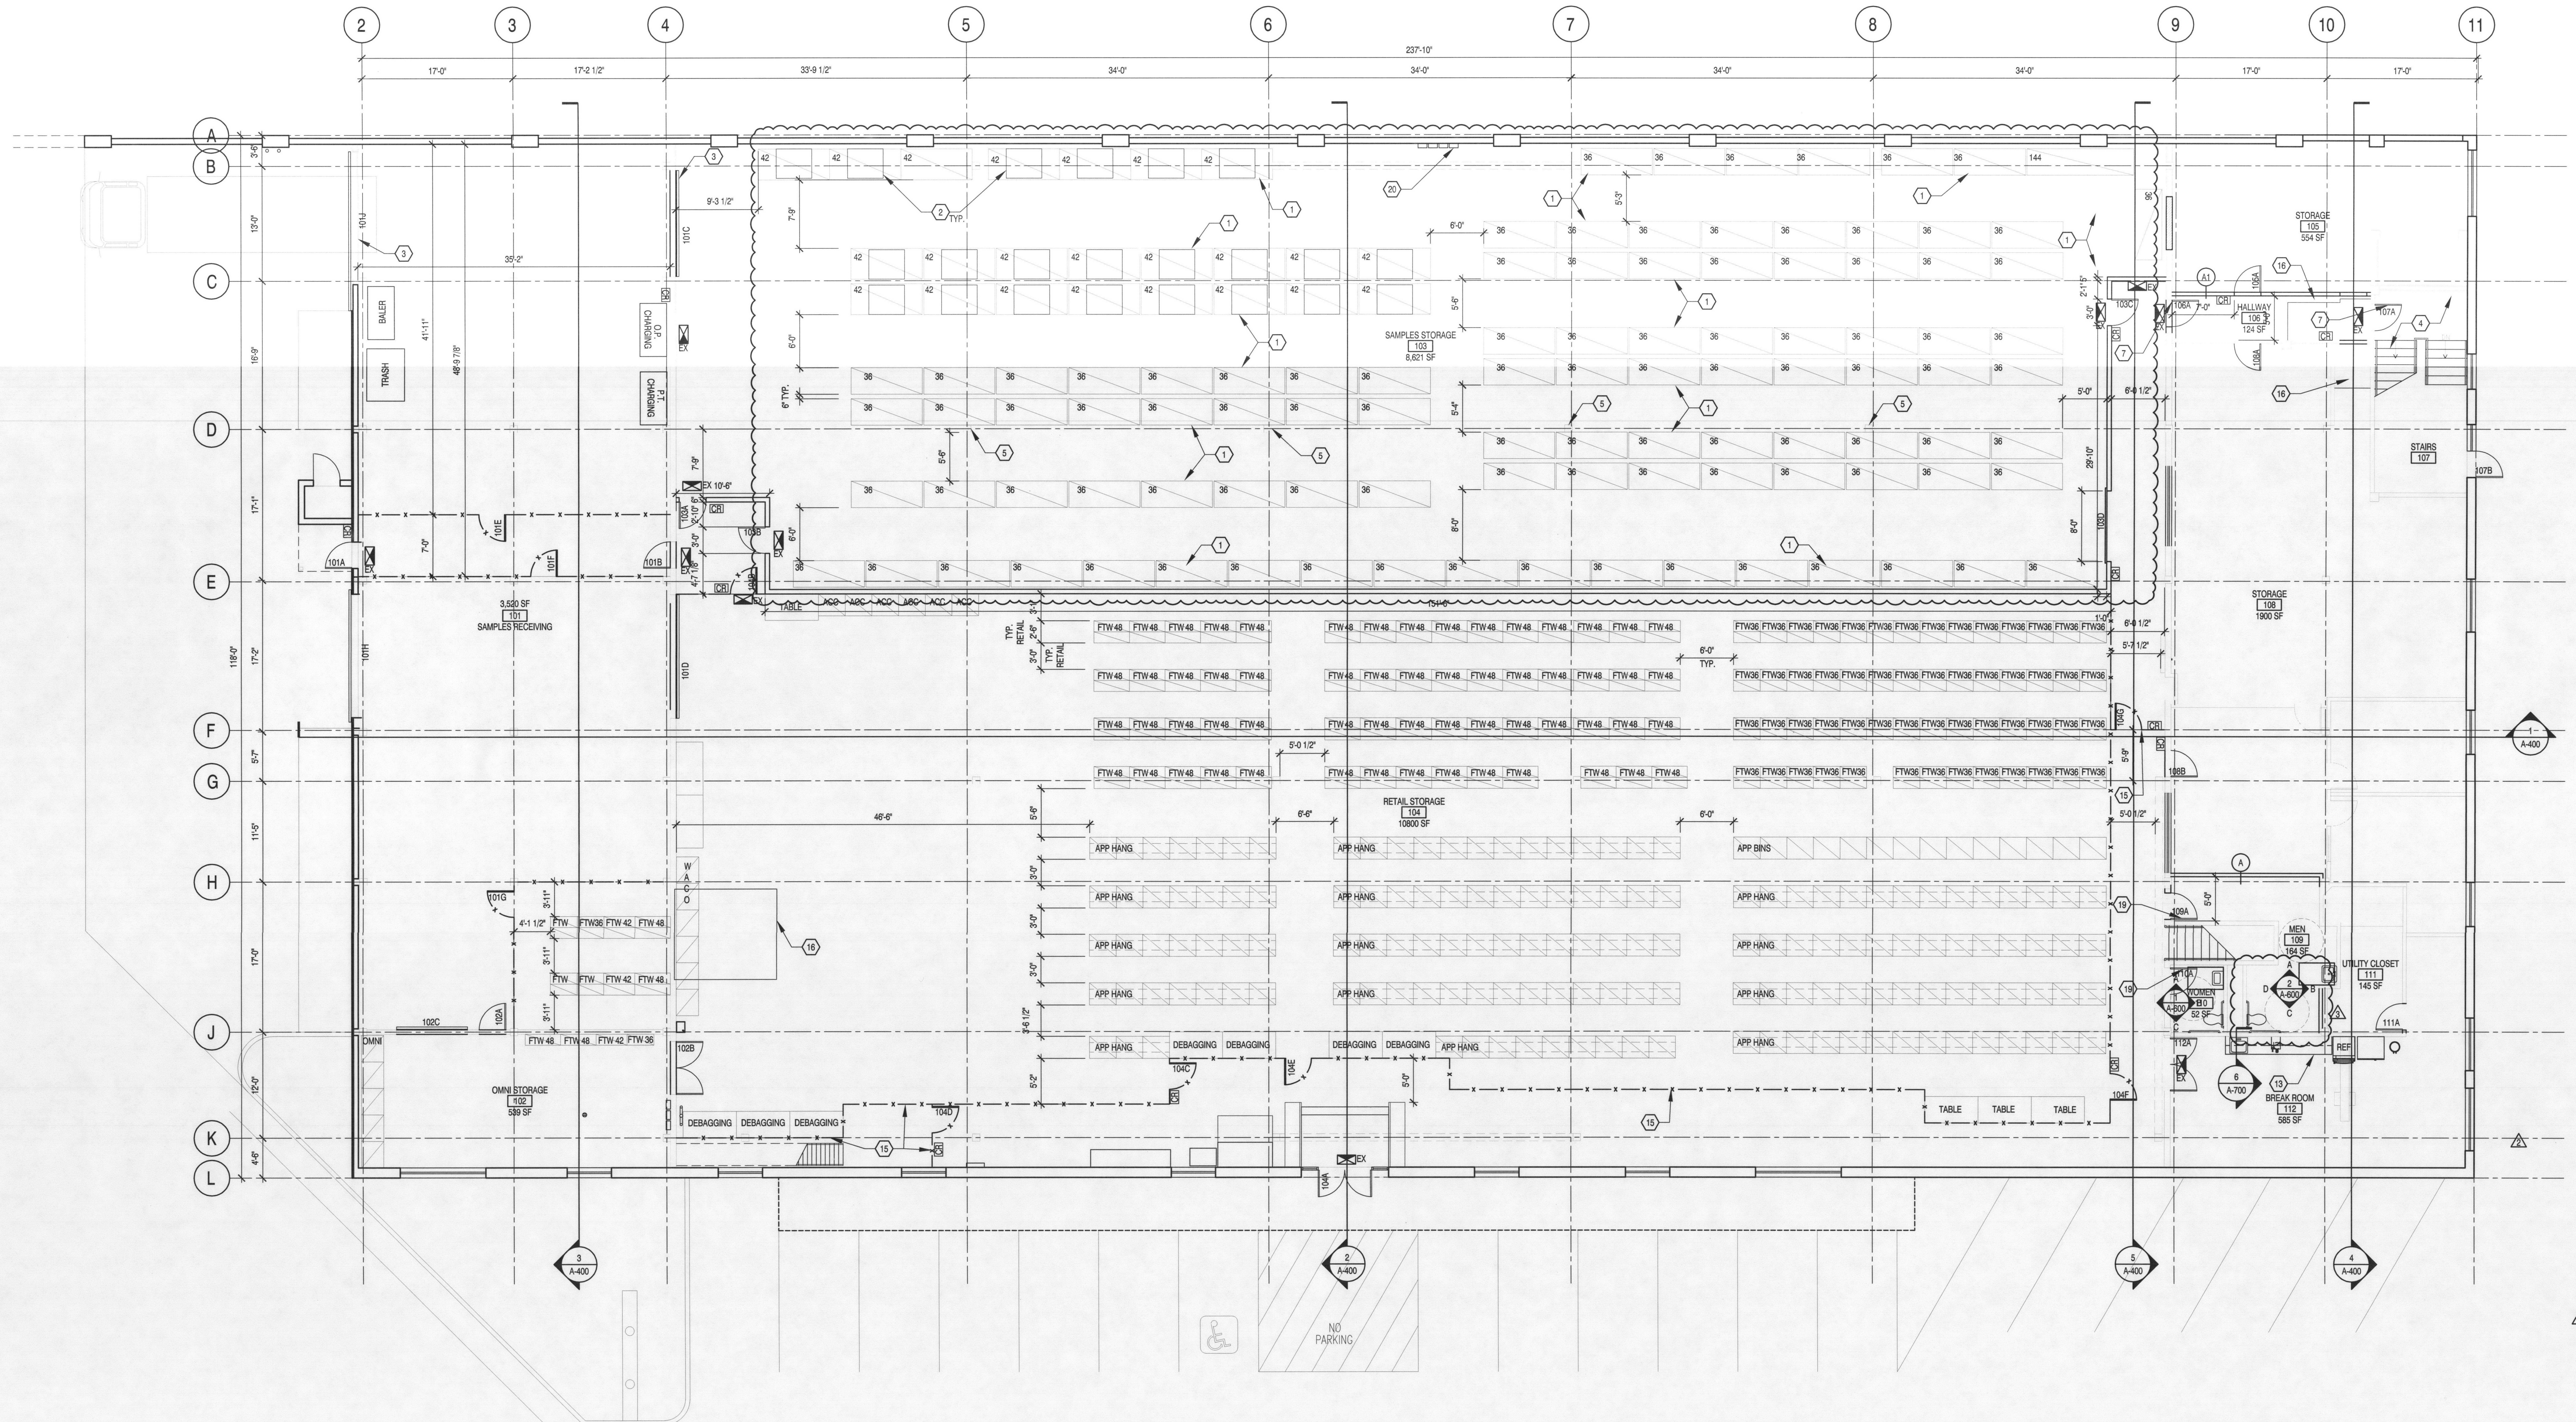1 FIRST FLOOR PLAN
A-202 1/8" = 1'-0"

WALL / PARTITION TYPES:

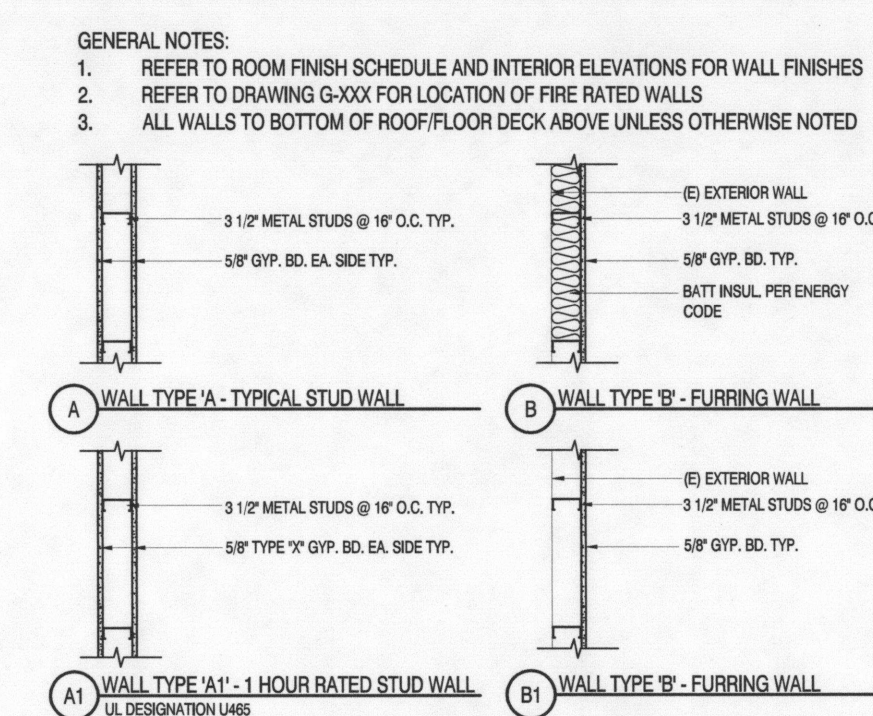


KEYNOTES


- HIGH BAY PALLET RACKING/SHELVING, FLOOR CONNECTIONS BY RACKING INSTALLER, BY SEPARATE PERMIT
- 40'x48' STORAGE PALLET - ON FLOOR
- (E) COILING DOOR TO REMAIN - VERIFY OPERATING CONDITION, CLEAN & REPAIR AS NEEDED
- (E) STAIRWAY TO REMAIN - CLEAN, SCRAPE, REPAIR, VERIFY CONDITION OF HANDRAIL - REPLACE/ADD IF NECESSARY
- REMOVE (E) DECOMMISSIONED ELECTRICAL, WATER, ELECTRICAL CONDUIT/PIPING AT COLUMN UP TO CEILING
- NOT USED
- (E) DOOR TO REMAIN - PAINT FRAME, DOOR
- (E) ELECTRICAL BOXES TO REMAIN - VERIFY OPERATING CONDITION
- CLEAN AND REPAIR/REPAINT (E) STAIRWAY WHERE NECESSARY
- (E) DOOR TO REMAIN - CLEAN AND PAINT
- OPTIONAL - 2" YELLOW SAFETY STRIPING
- NEW (N) SECURITY PARTITION
- (N) CASEWORK & SINK, SEE PLUMBING - BY SEPARATE PERMIT
- APPLIANCES - F.O.I.O.
- CHAIN LINK SECURITY FENCING WITH GATES
- FILL AND LEVEL TO MATCH EXISTING SURROUNDING FLOOR

GENERAL NOTES

- EXIT SIGN LOCATIONS FOR REFERENCE ONLY, SEE ELECTRICAL SUBMISSION FOR INFORMATION - BY SEPARATE PERMIT. EMERGENCY LIGHTING LEVEL SHALL NOT BE LESS THAN (1) FOOTCANDLE (11 LUX) AT THE WALKING SURFACE AS PER OSBC 1006.2. EMERGENCY POWER AND ILLUMINATION TO BE PROVIDED AS PER OSBC 1006.3.

LEGEND

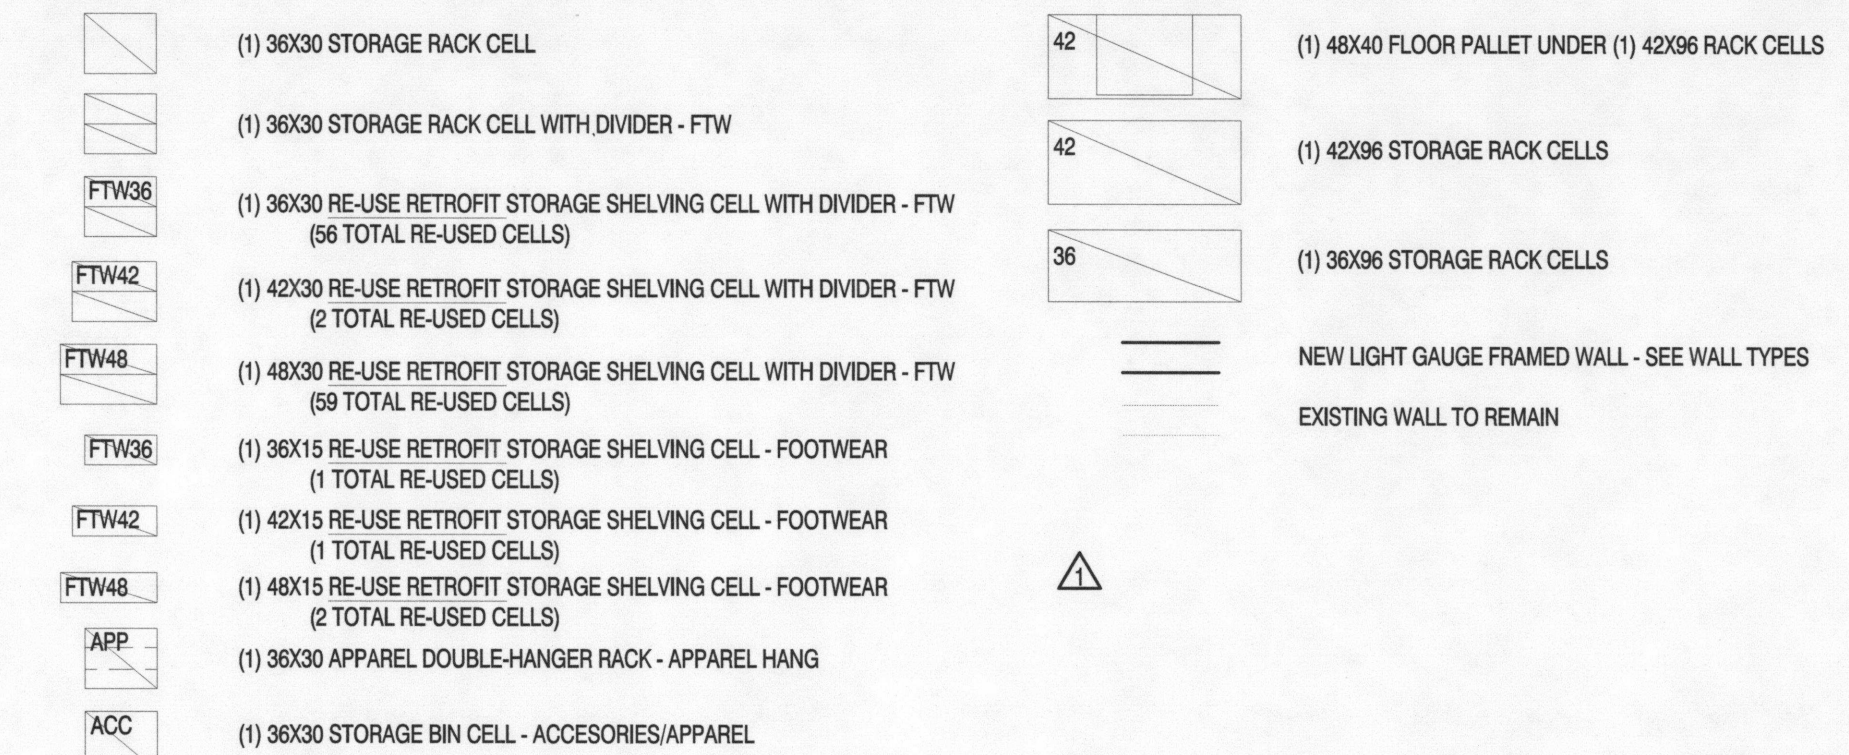

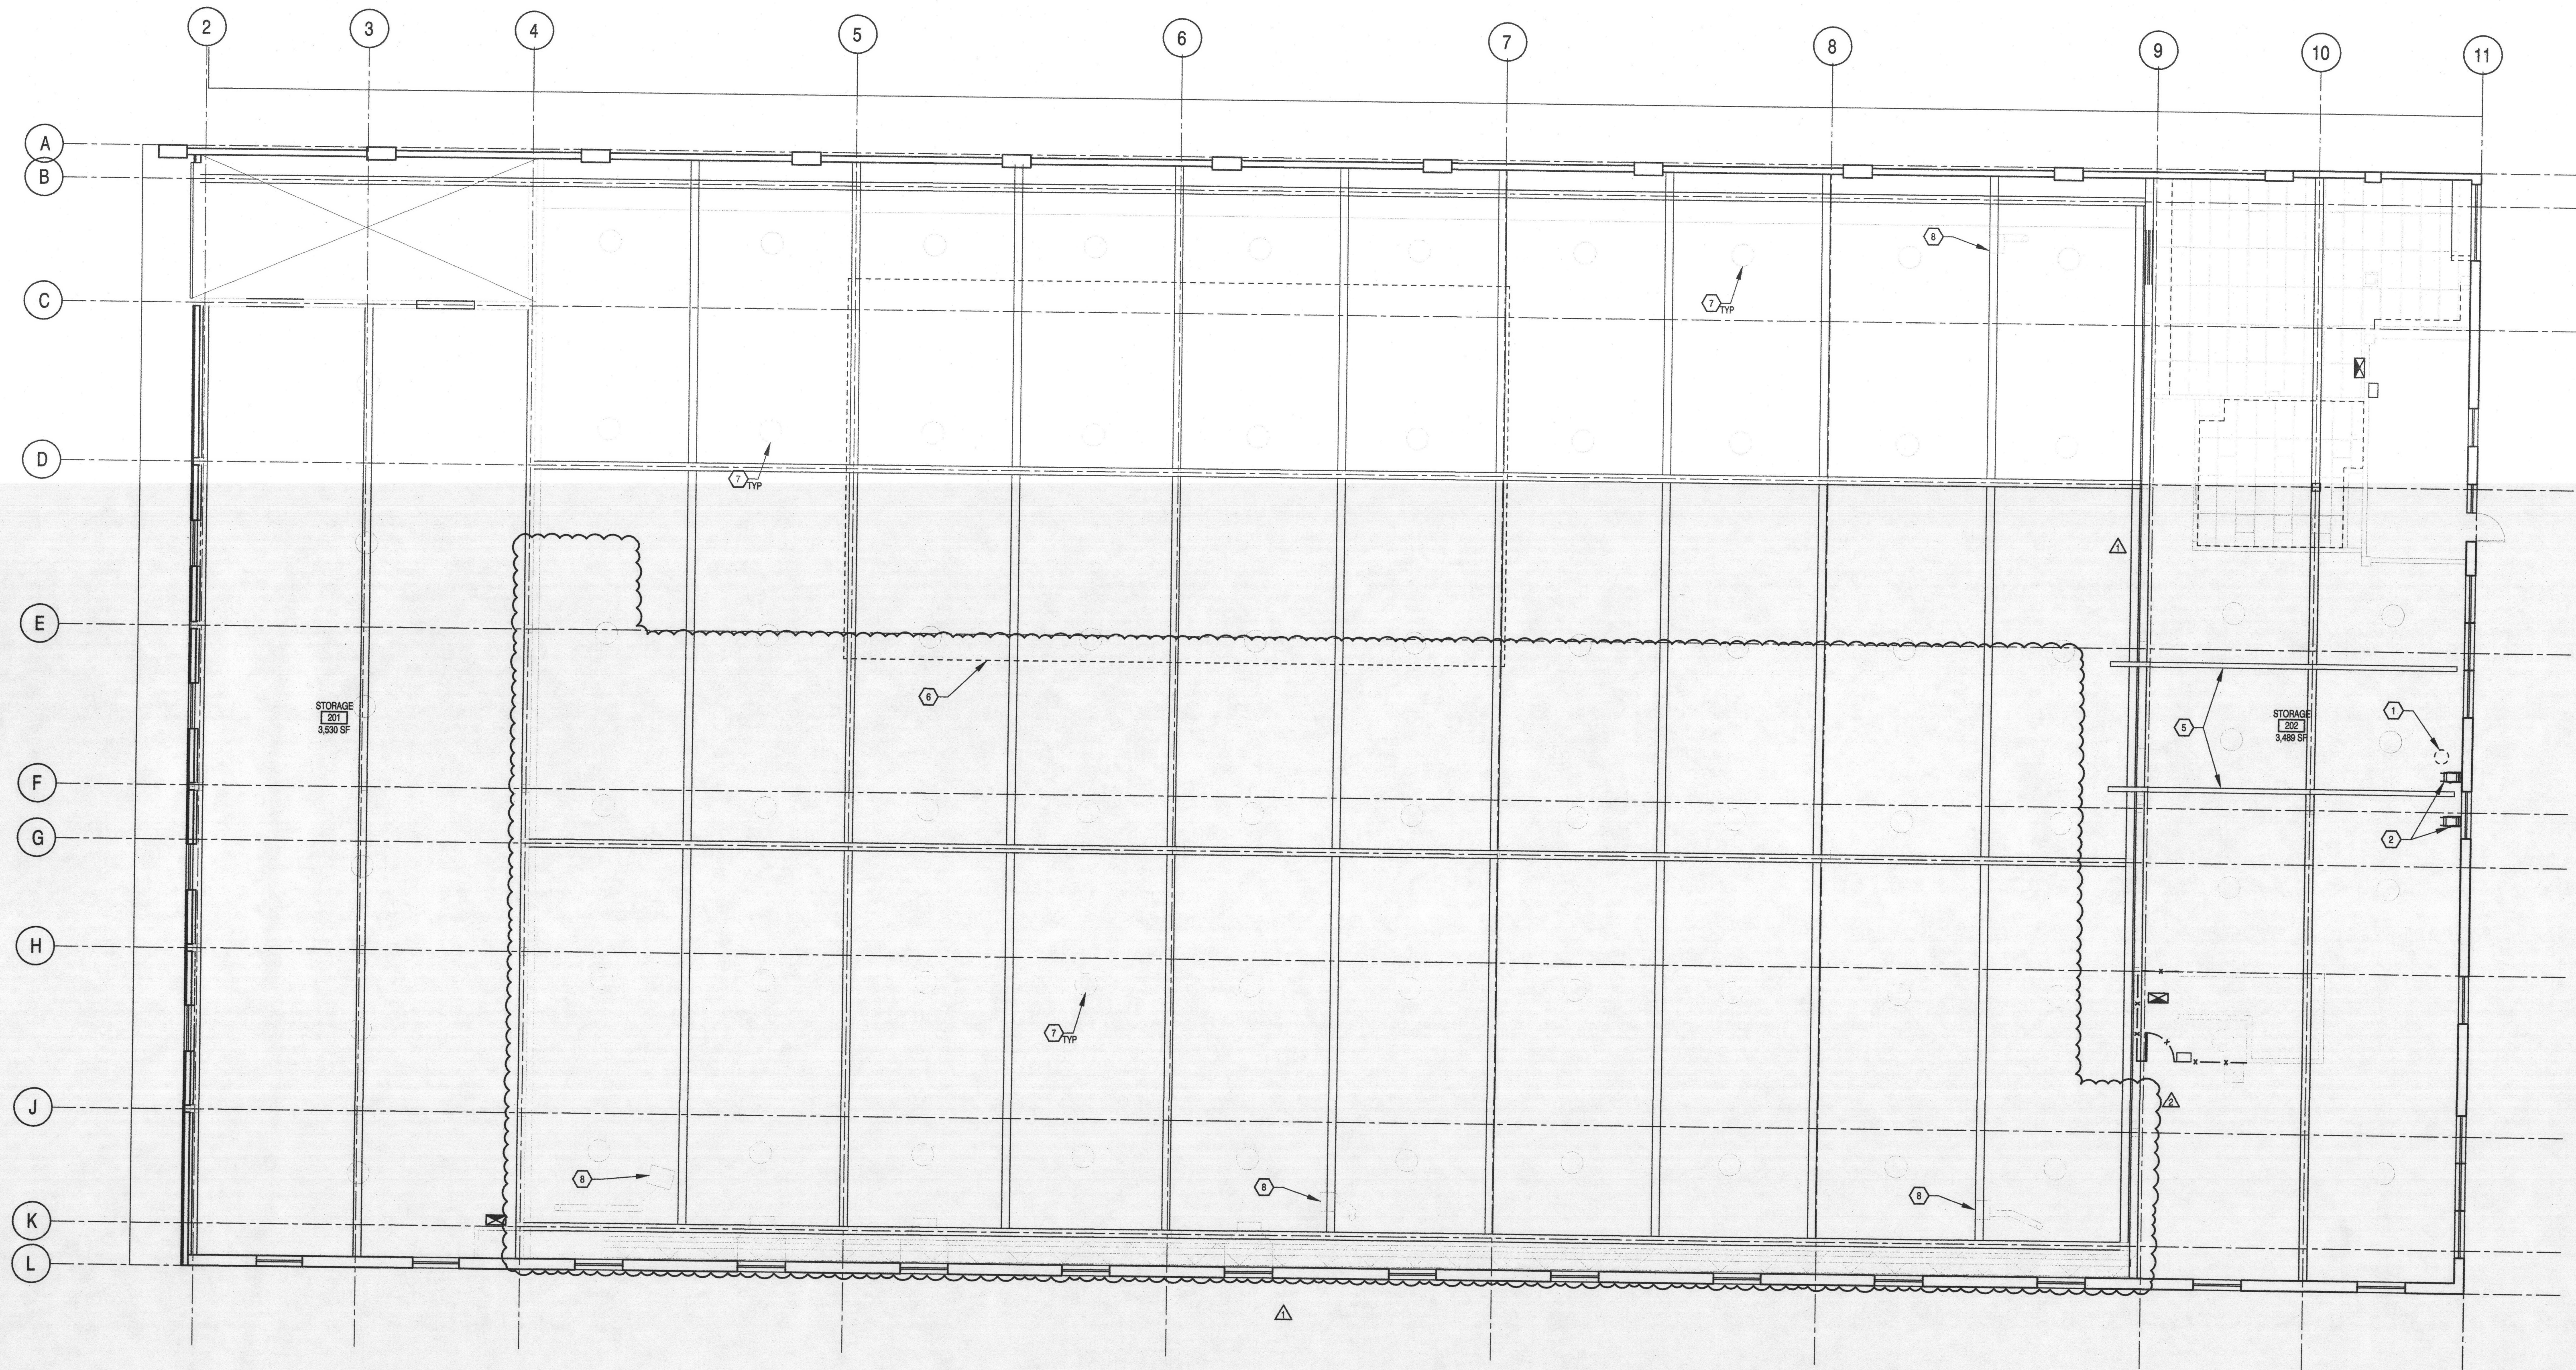


1 MEZZANINES - REFLECTED CEILING PLAN
A-205 1/8" = 1'-0"

KEYNOTES

1. REMOVE (E) EXHAUST DUCT
2. REMOVE (E) HOSE REEL
3. REMOVE (E) UTILITY
4. (E) ELECTRICAL BOXES TO REMAIN - VERIFY OPERATING CONDITION
5. (E) HOIST BEAMS TO REMAIN
6. REMOVE (E) PLYWOOD HOOD
7. (E) FIXTURES TO REMAIN, REPLACE NON-ACTIVE FIXTURES, LAMPS
8. (E) MECHANICAL TO REMAIN

LEGEND

- DEMO INTERIOR WALL
- EXISTING WALL TO REMAIN
- REMOVE (E) DOOR, FRAME, REUSE IF POSSIBLE
- ACT. GRID, FIXTURES TO REMAIN - CLEAN AND REUSE
FIXTURES, REPLACE BROKEN LAMPS, FIXTURES

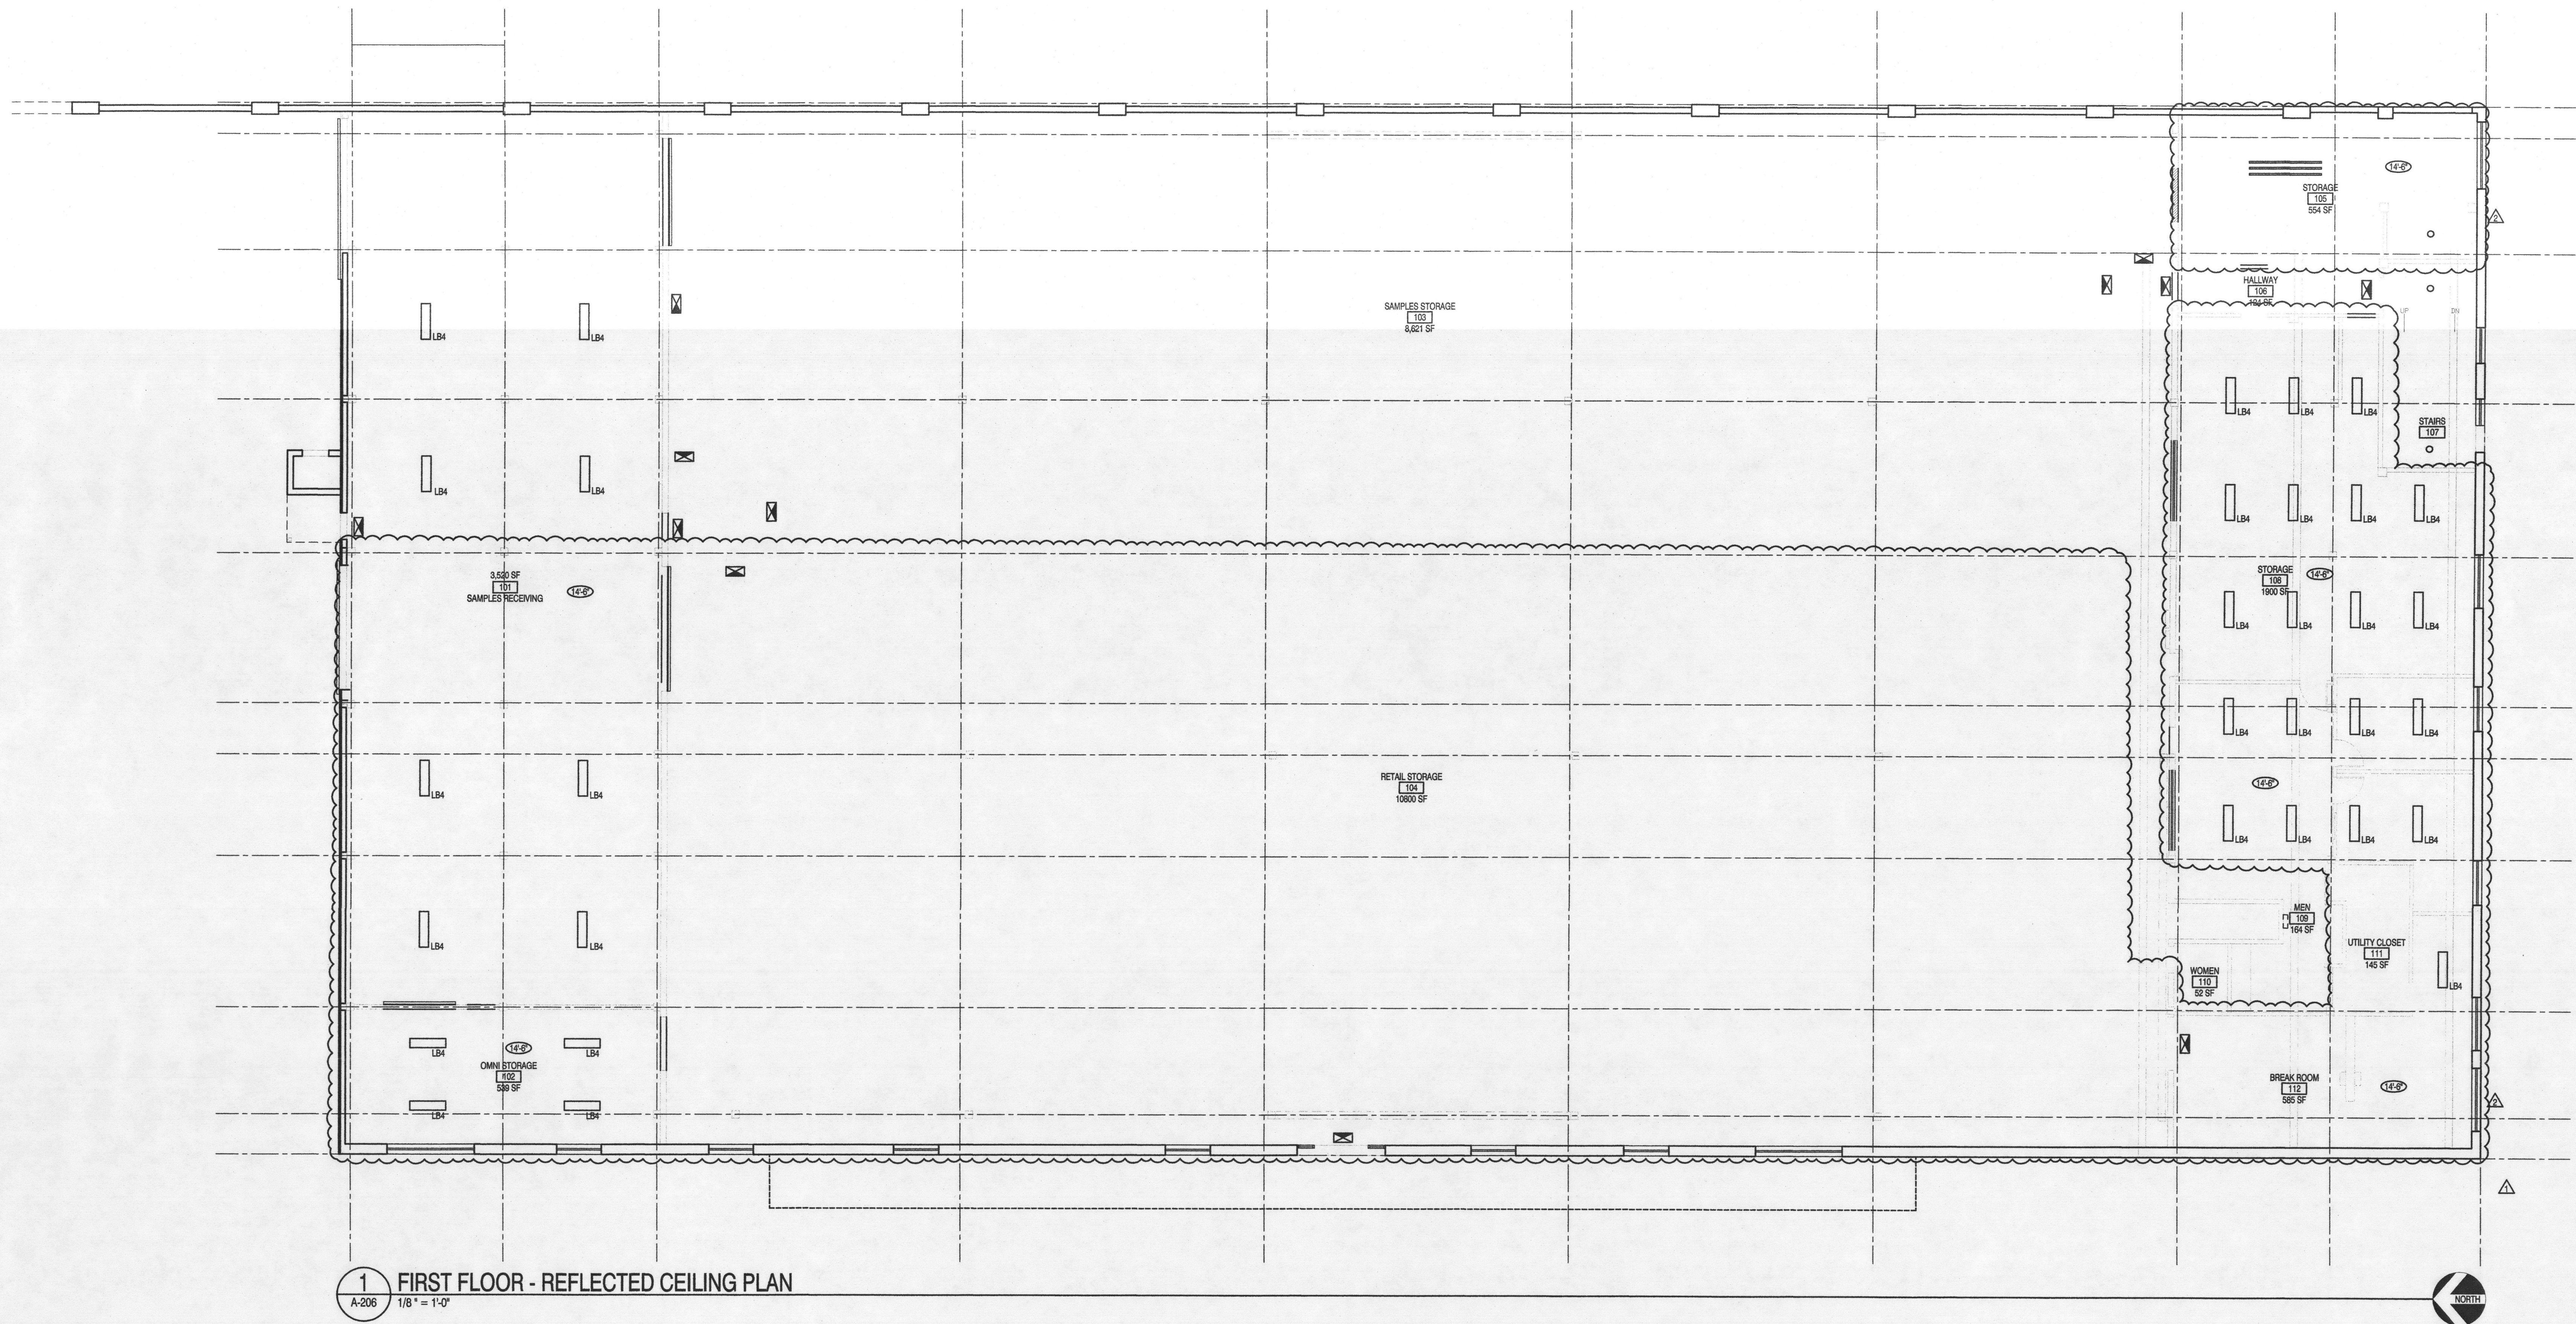


1 FIRST FLOOR - REFLECTED CEILING PLAN
A-206 1/8" = 1'-0"

KEYNOTES

- HIGH-BAY FIXTURE, MATCH EXISTING
- HEATING UNIT - CONFIRM OPERATING CONDITION, REPLACE AND REPAIR WHERE NECESSARY.
- REPAIR DAMAGED/SCALD, 3/4" O.D. CONDUIT, IN SEPARATE PERMIT.
- EXIT SIGN LOCATIONS FOR REFERENCE ONLY. SEE ELECTRICAL SUBMISSION FOR INFORMATION - BY SEPARATE PERMIT. EMERGENCY LIGHTING LEVEL SHALL NOT BE LESS THAN (1) FOOTCANDLE (11 LUX) AT THE WALKING SURFACE AS PER OSBC 1000.2. EMERGENCY POWER AND ILLUMINATION TO BE PROVIDED AS PER OSBC 1000.3.
- LIGHTING SHOWN FOR DESIGN INTENT ONLY. SEE ELECTRICAL FOR FIXTURE INFORMATION - BY SEPARATE PERMIT.

LIGHTING LEGEND

- SLB 90° LED STRIP LIGHT W/ LENS (LITHONIA ZL1D OR SIMILAR)
- HB HIGH BAY FIXTURE - MATCH EXISTING HIGH BAY FIXTURES
- LB4 48" LOW BAY FIXTURE W/ WIRE CAGE (LITHONIA EJS OR SIMILAR)
- SM SURFACE MOUNT FIXTURE
- SM4 48" SURFACE MOUNT FIXTURE (LITHONIA OR SIMILAR)
- EXISTING HIGH-BAY FIXTURE TO REMAIN

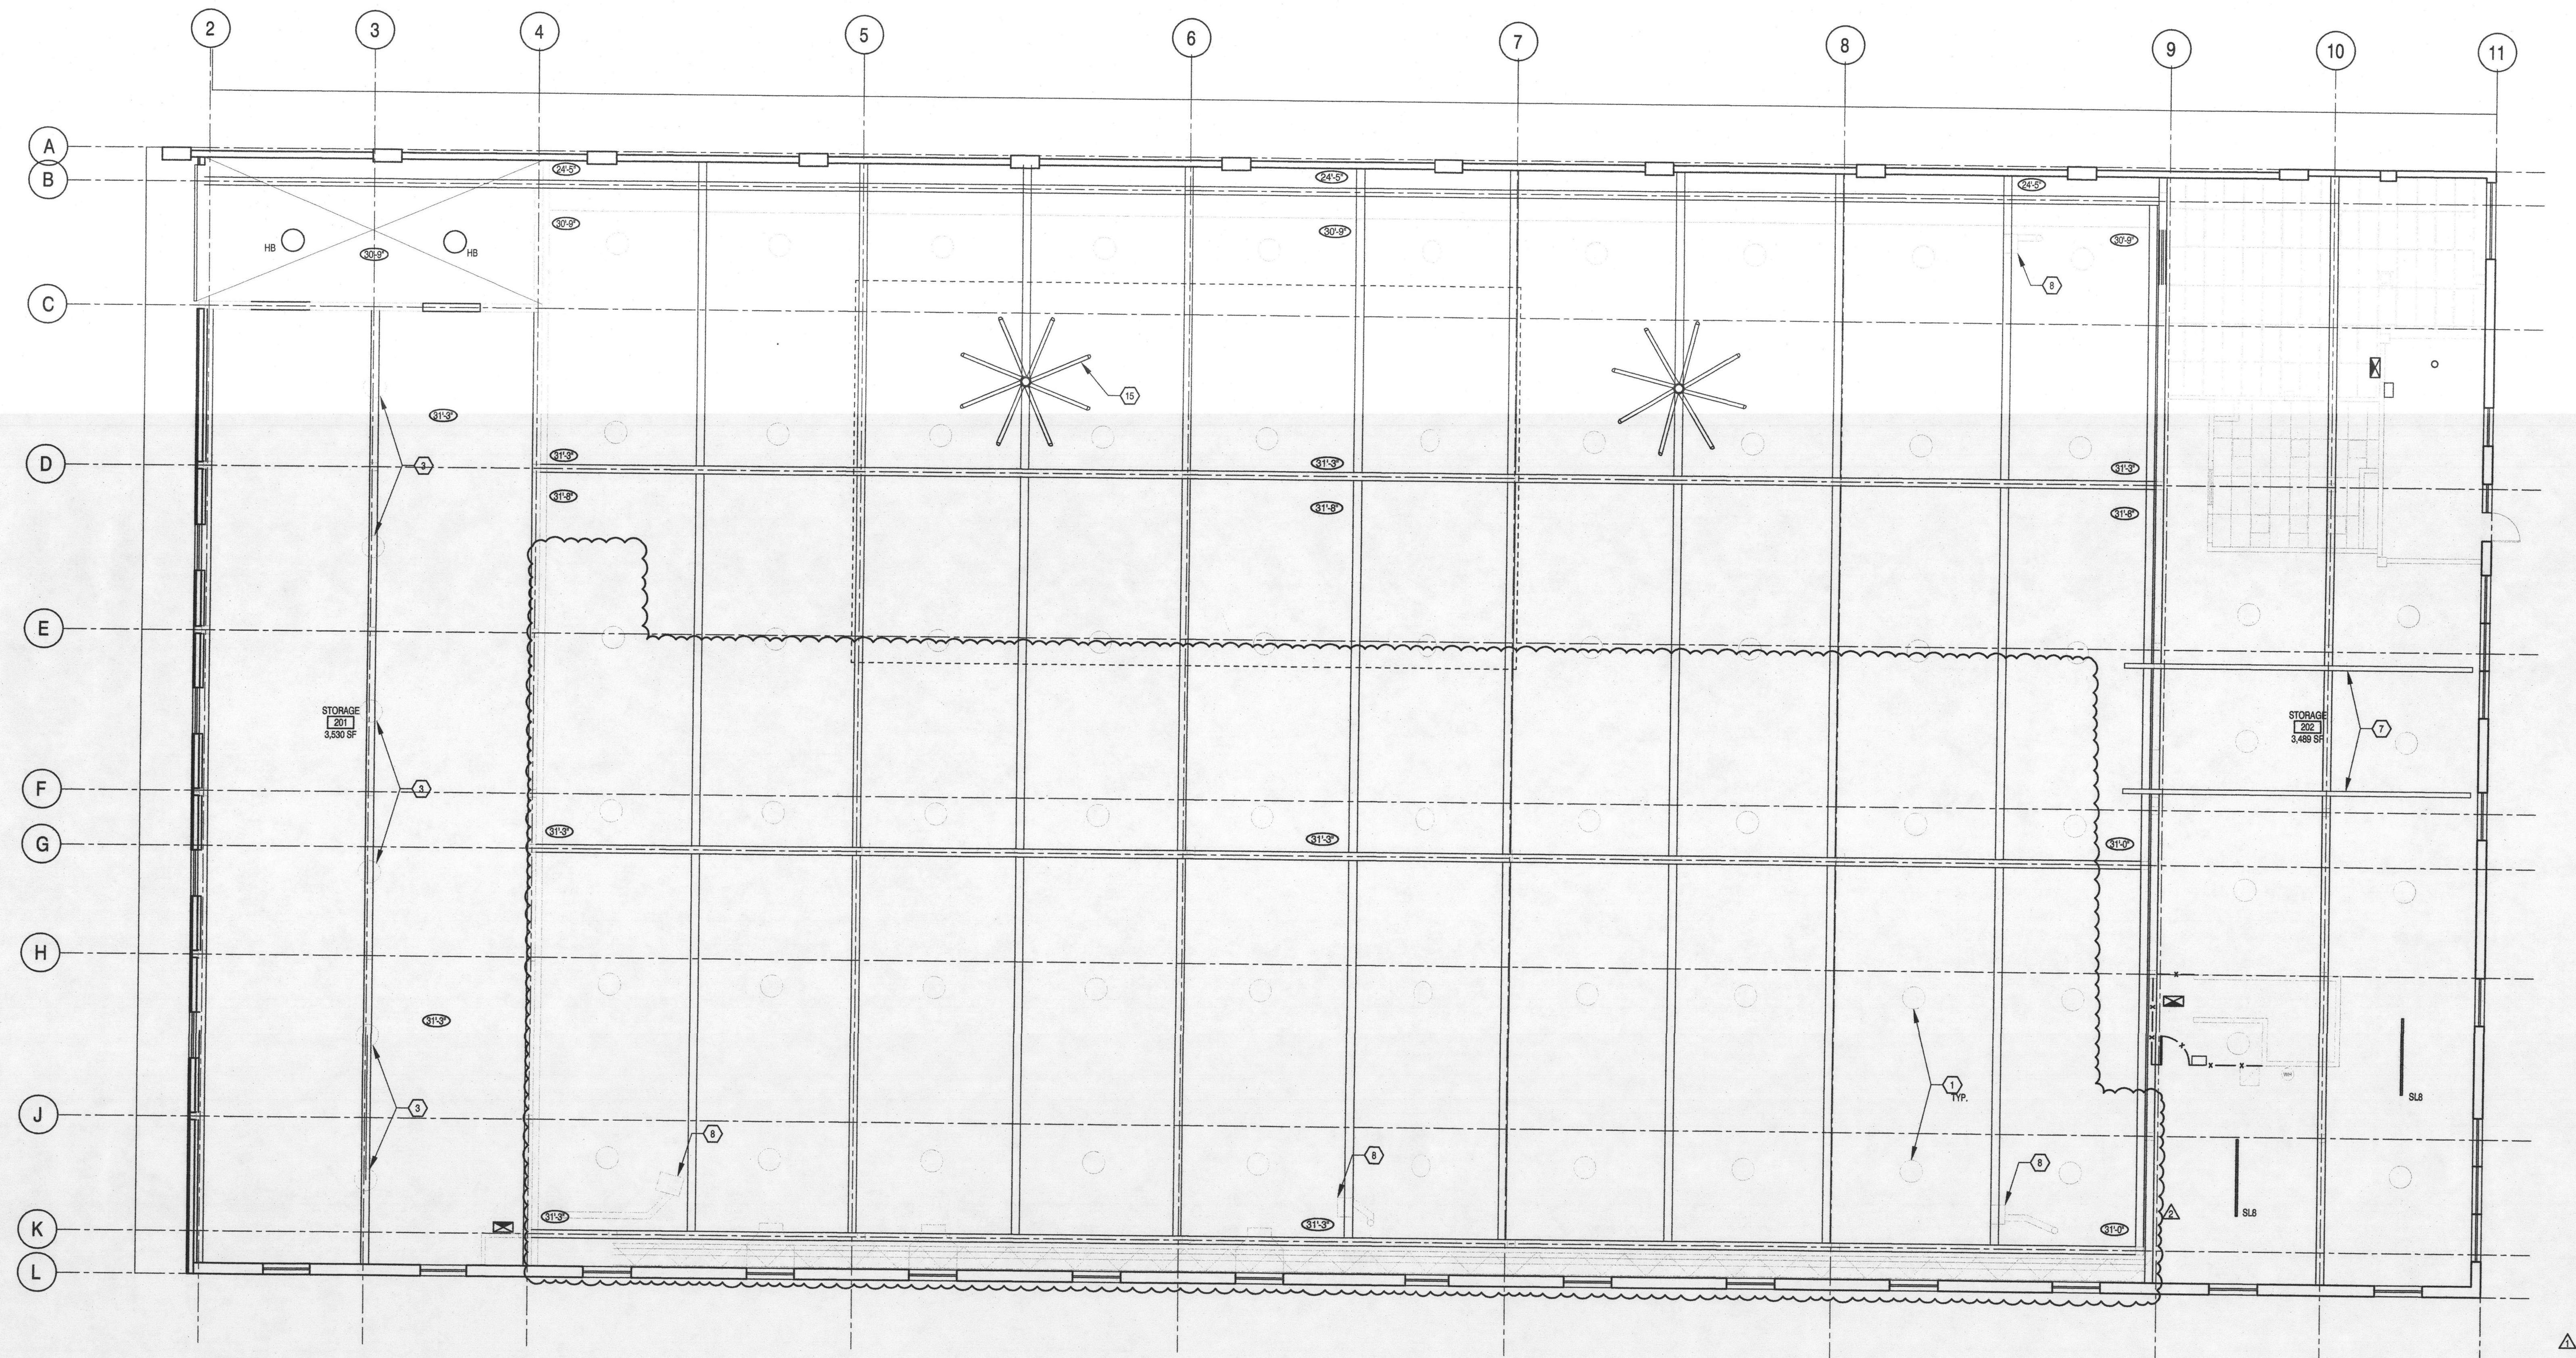

1 MEZZANINES - REFLECTED CEILING PLAN
A-207 1/8" = 1'-0"

KEYNOTES

- (E) HIGH-BAY FIXTURE TO REMAIN - REPLACE NON-ACTIVE FIXTURES, LAMPS
- HIGH-BAY FIXTURE - MATCH EXISTING
- (E) LOW-BAY FIXTURE TO REMAIN - REPLACE NON-ACTIVE FIXTURES, LAMPS
- SUSPENDED LED STRIP LIGHT W/ LENS
- (E) COILING DOOR TO REMAIN - VERIFY OPERATING CONDITION, CLEAN & REPAIR AS NEEDED
- FILL AND PATCH CMU WALL
- HOIST BEAMS TO REMAIN
- (E) HEATING UNIT TO REMAIN - CONFIRM OPERATING CONDITION, REPLACE AND REPAIR WHERE NECESSARY.
- REMOVE (E) EXHAUST DUCT
- REMOVE (E) HOSE REEL
- REMOVE (E) DECOMMISSIONED ELECTRICAL, WATER, ELECTRICAL CONDUIT/PIPING AT COLUMN UP TO CEILING
- CLEAN, SAND, & PAINT COLUMNS, BEAMS, JOISTS, DECKING
- (E) ELECTRICAL BOXES TO REMAIN - VERIFY OPERATING CONDITION
- NOT USED
- 800-ASS-TAN - POWERPOLE 8, 14"Ø DIAMETER - BY SEPARATE PERMIT

LIGHTING LEGEND


- SL 96" LED STRIP LIGHT W/ LENS (LITHONIA ZL10)
- HB HIGH BAY FIXTURE - MATCH EXISTING HIGH BAY FIXTURES

REV #	DATE	DESCRIPTION	ADDENDUM / REVISION
1	10/27/17	ADDITIONAL REVISION	
2	12/05/17	REVISIONS	


REFLECTED CEILING PLAN
NORTH & SOUTH MEZZANINE

PROJECT NO: 17-026
DRAWN BY: PZ/CHK'D BY: FR
DATE: 10/06/17


A-207

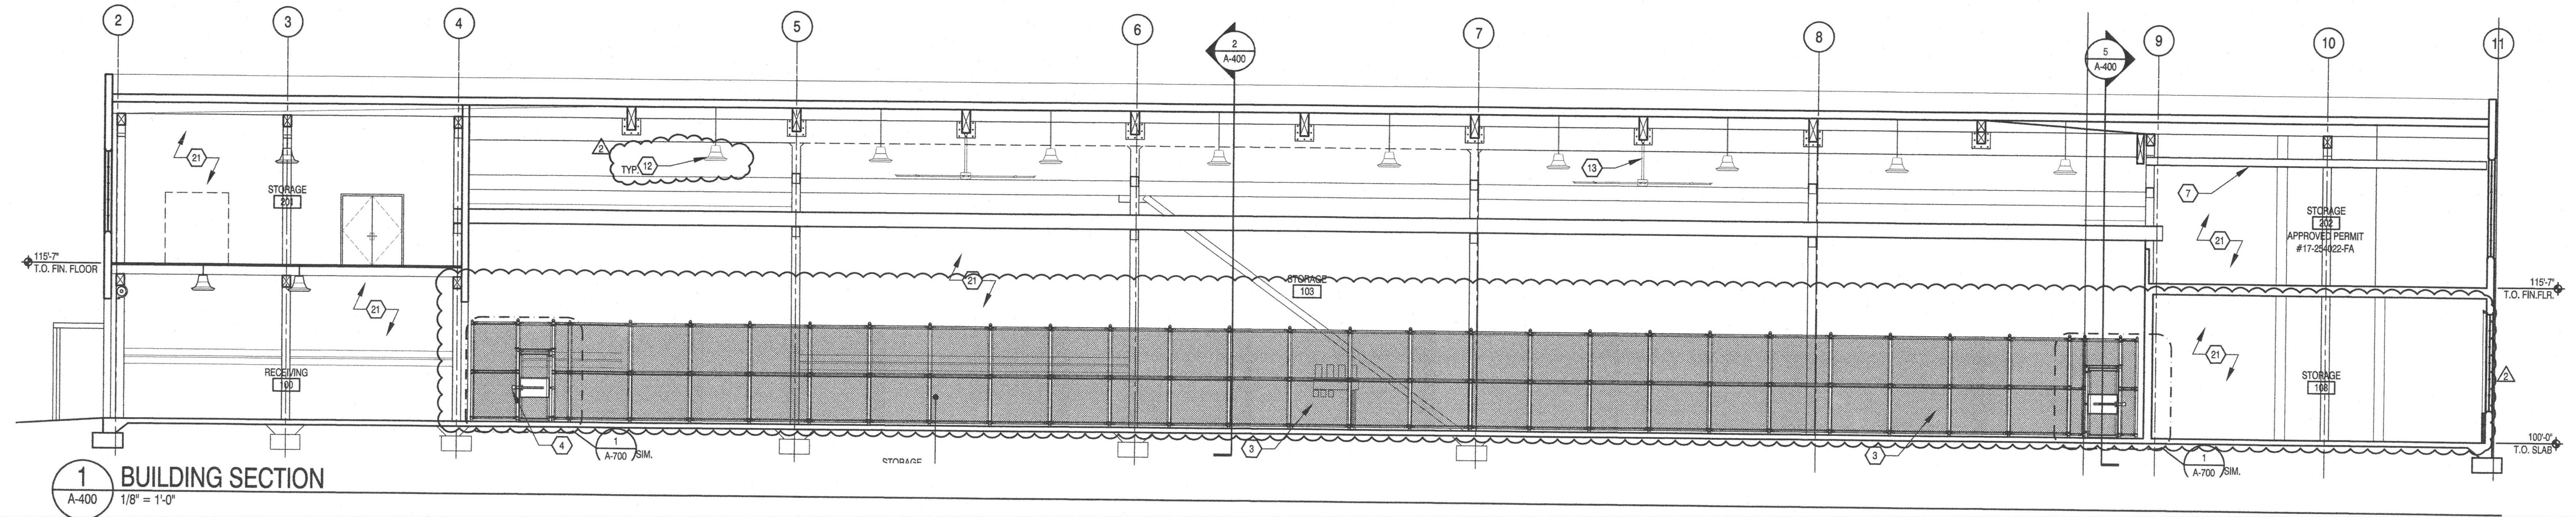


1 BUILDING SECTION
A-400 1/8" = 1'-0"

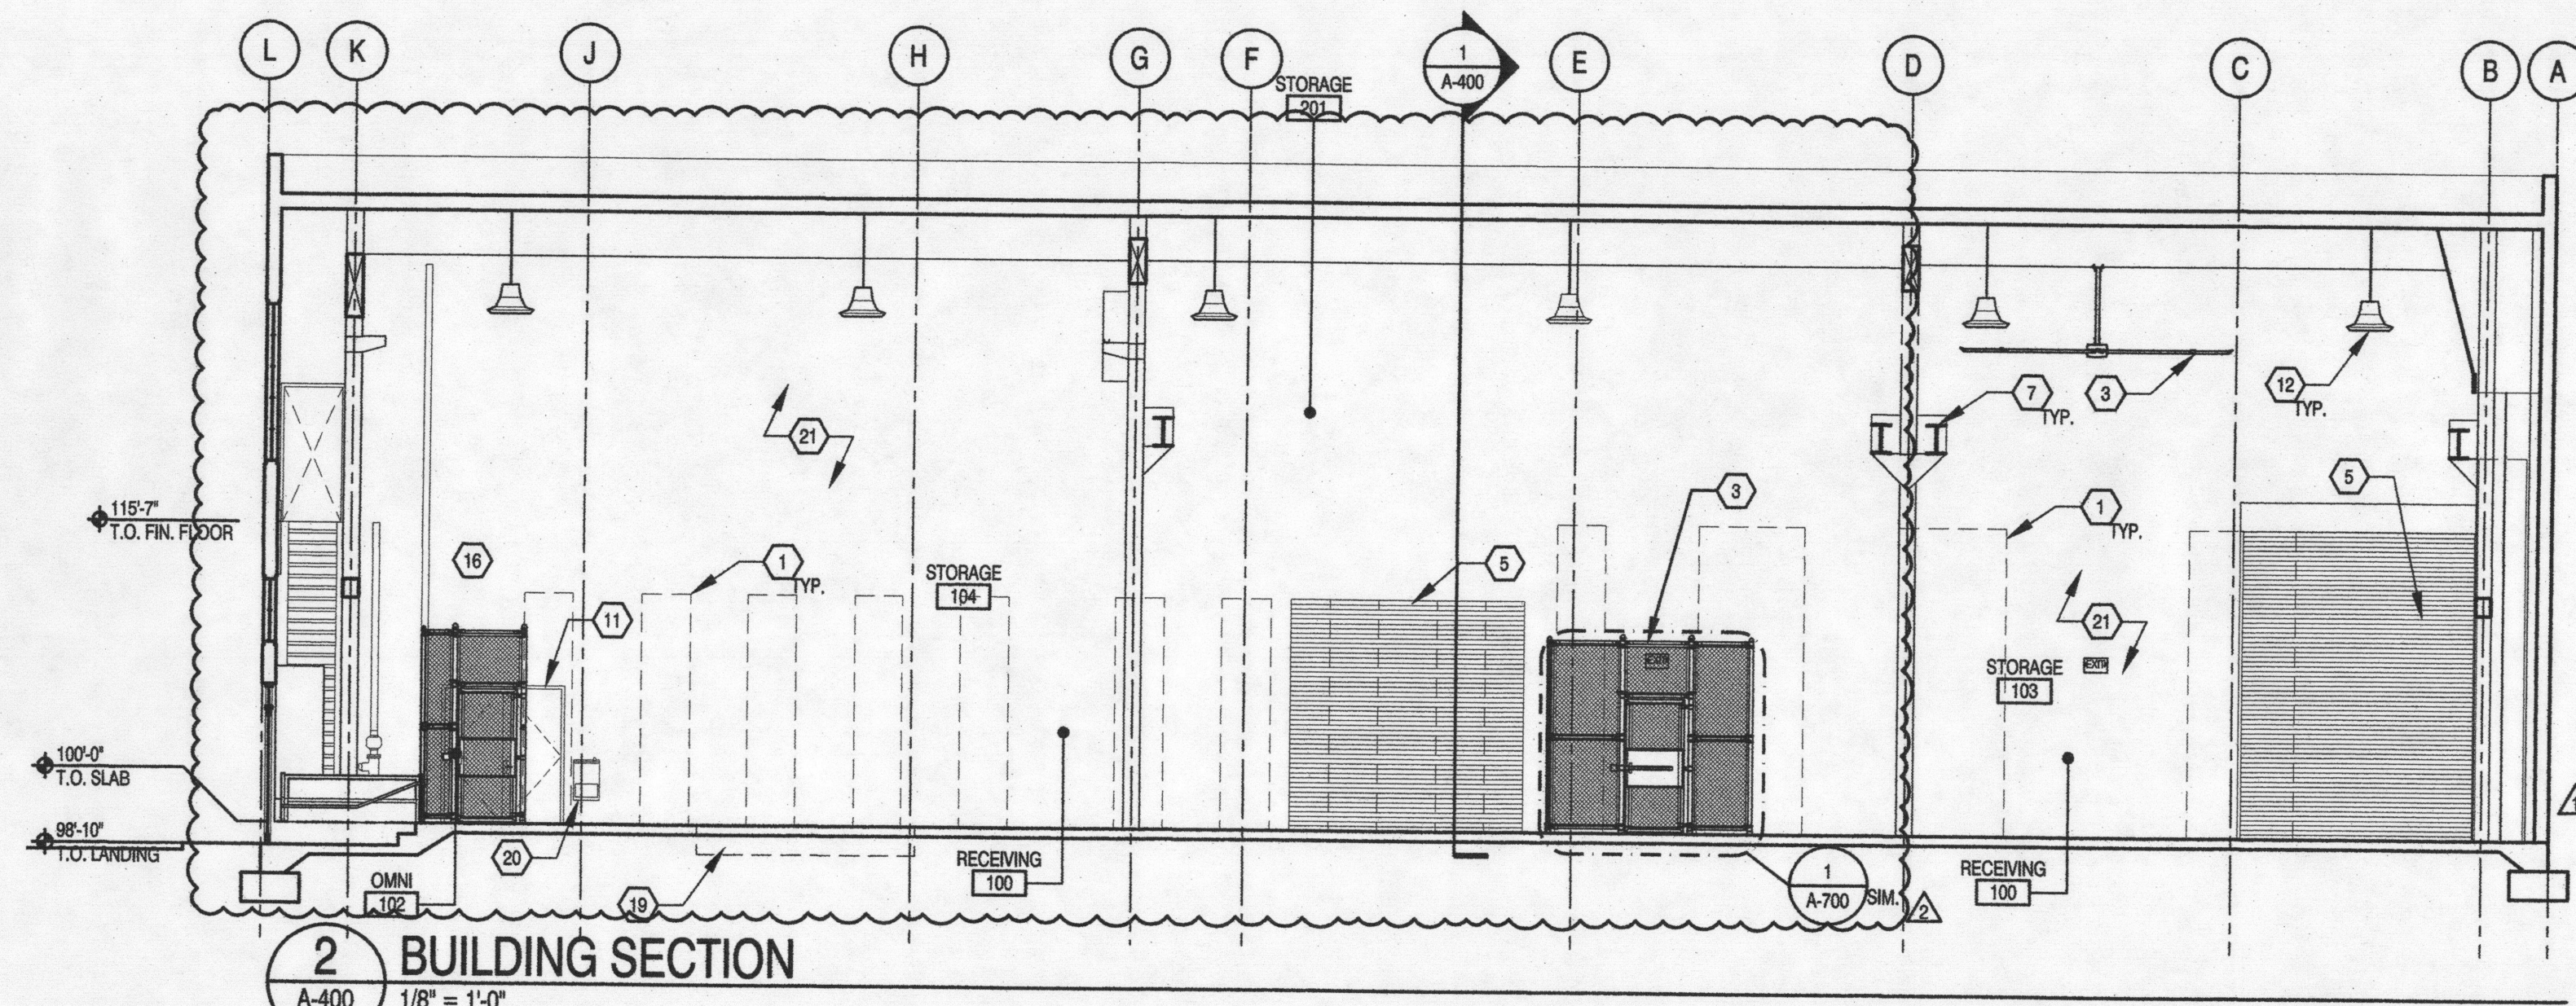


2 BUILDING SECTION
A-400 1/8" = 1'-0"

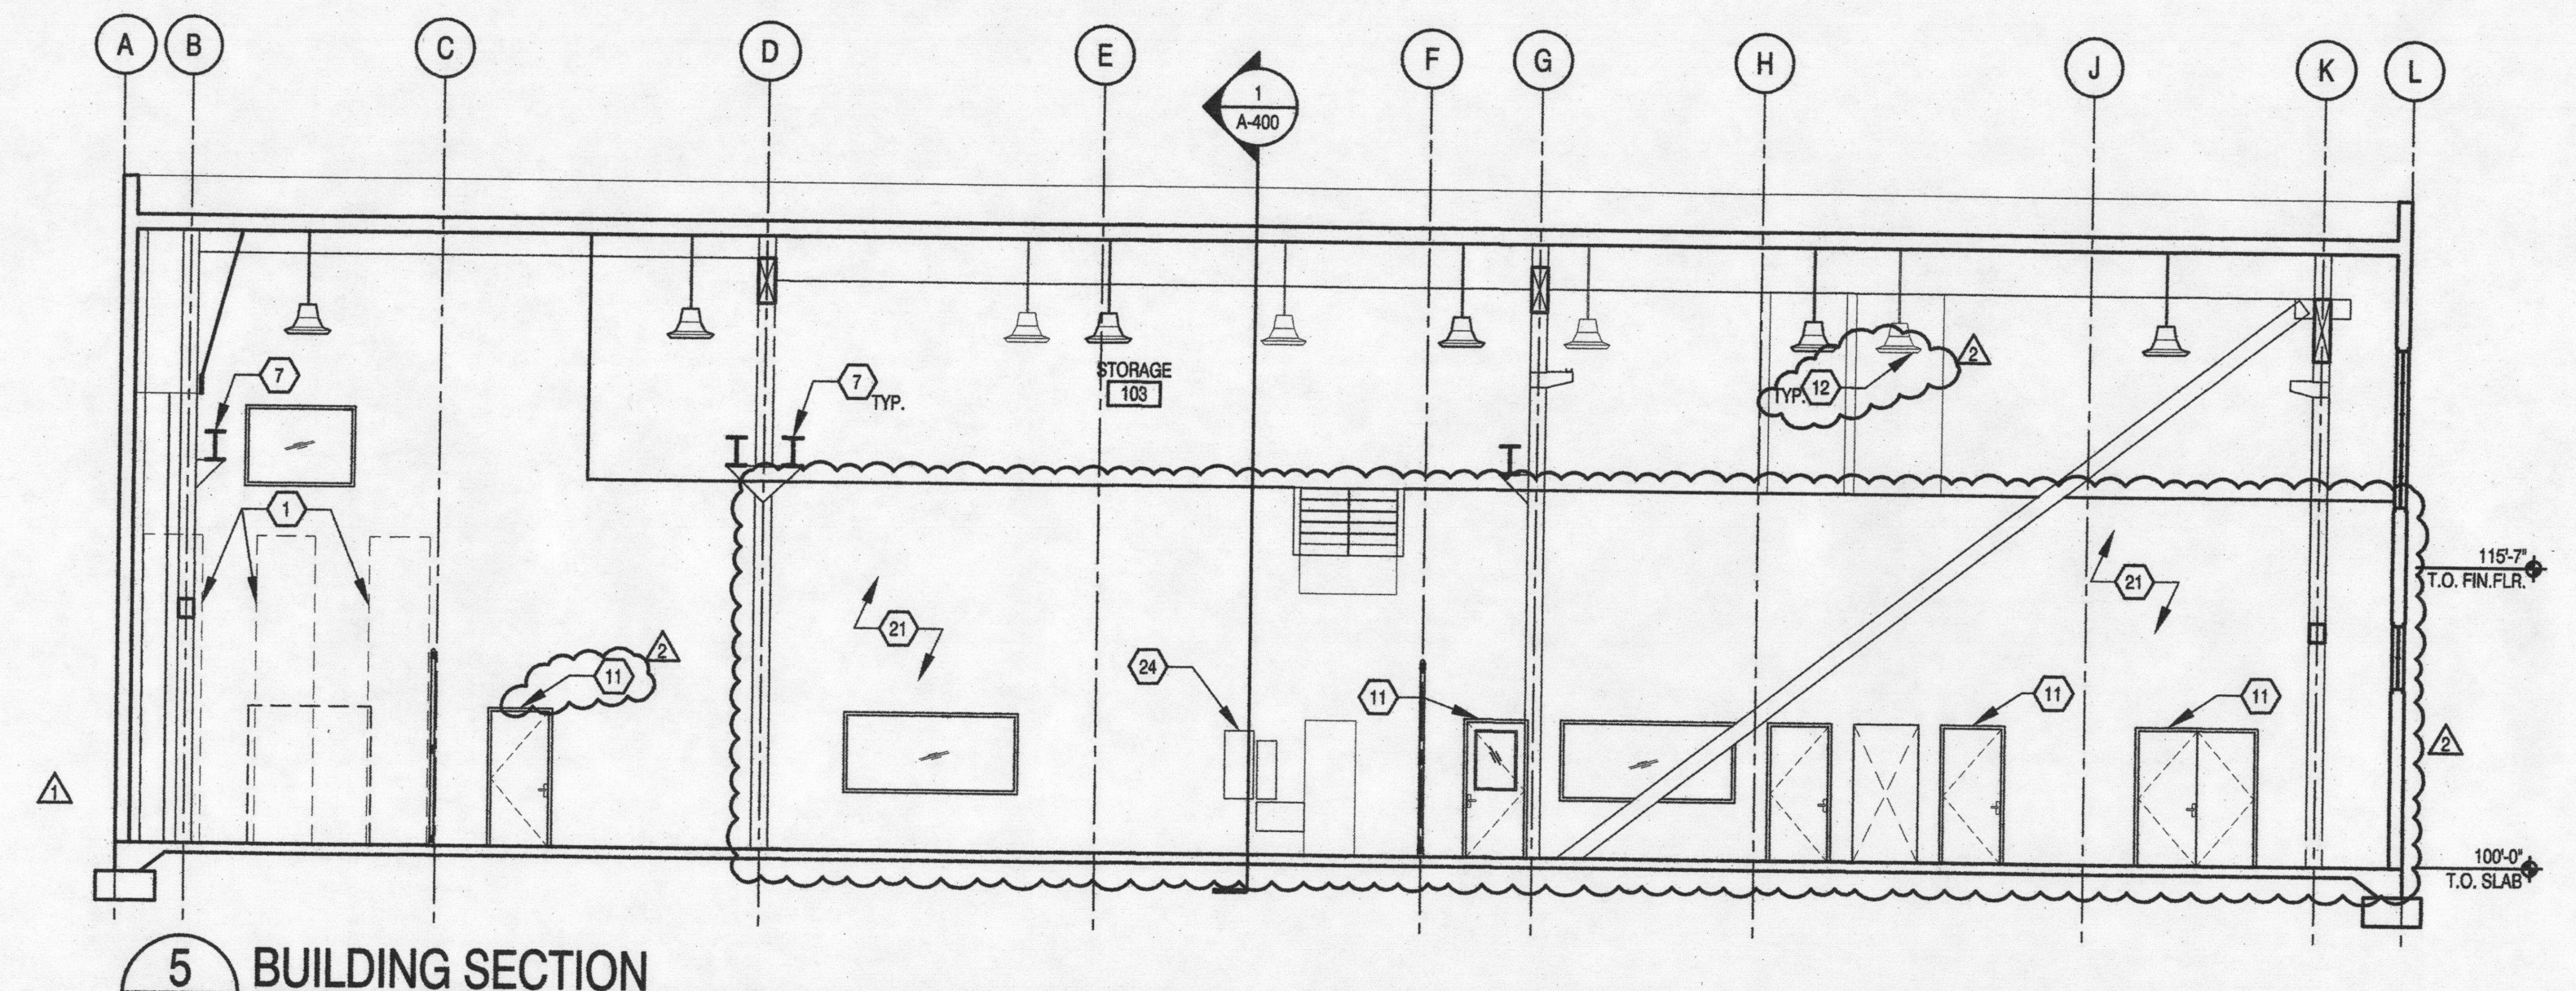

5 BUILDING SECTION
A-400 1/8" = 1'-0"

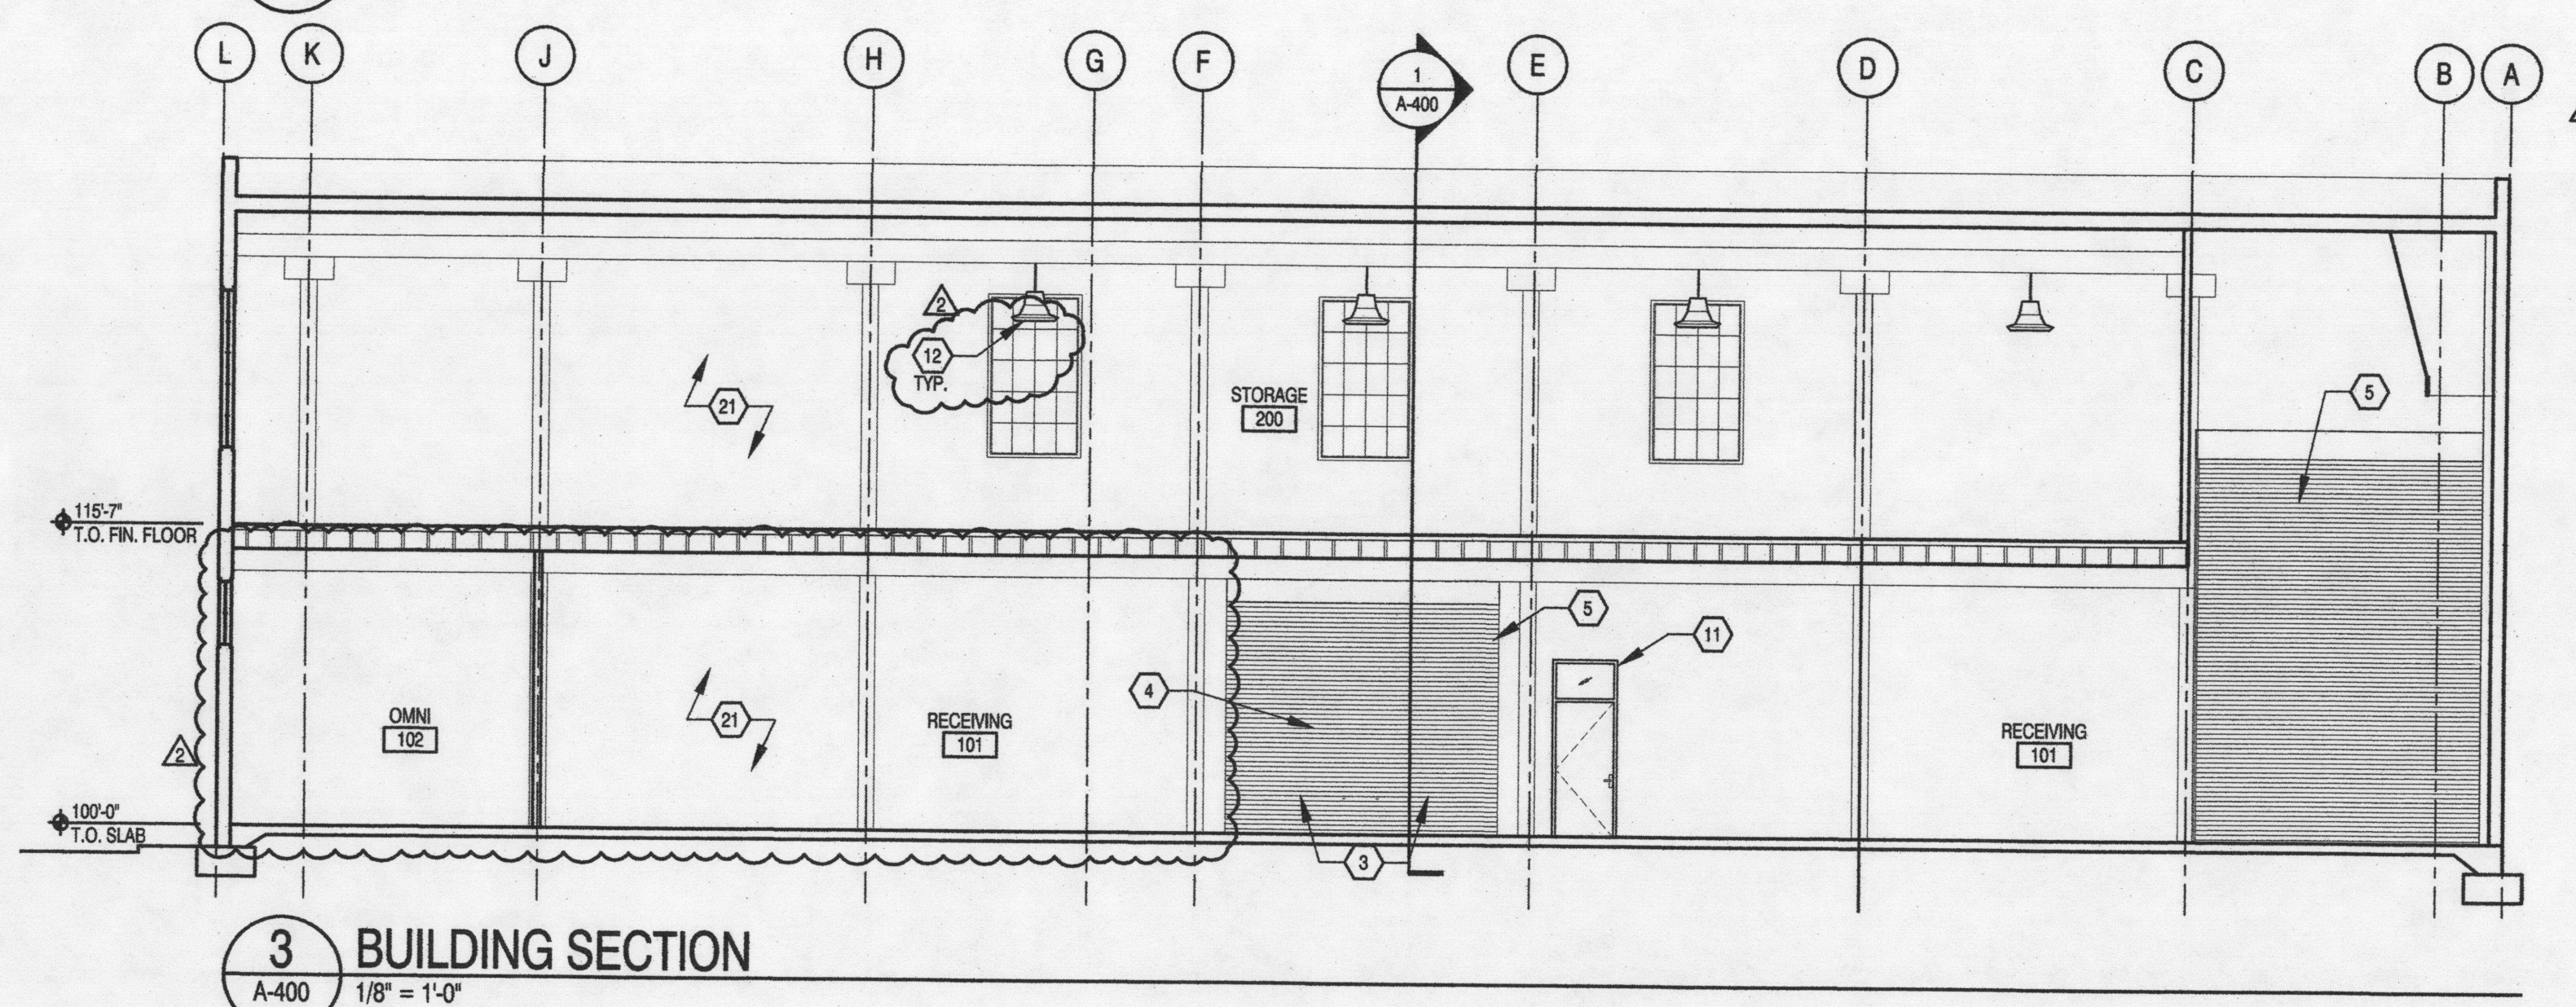



3 BUILDING SECTION
A-400 1/8" = 1'-0"

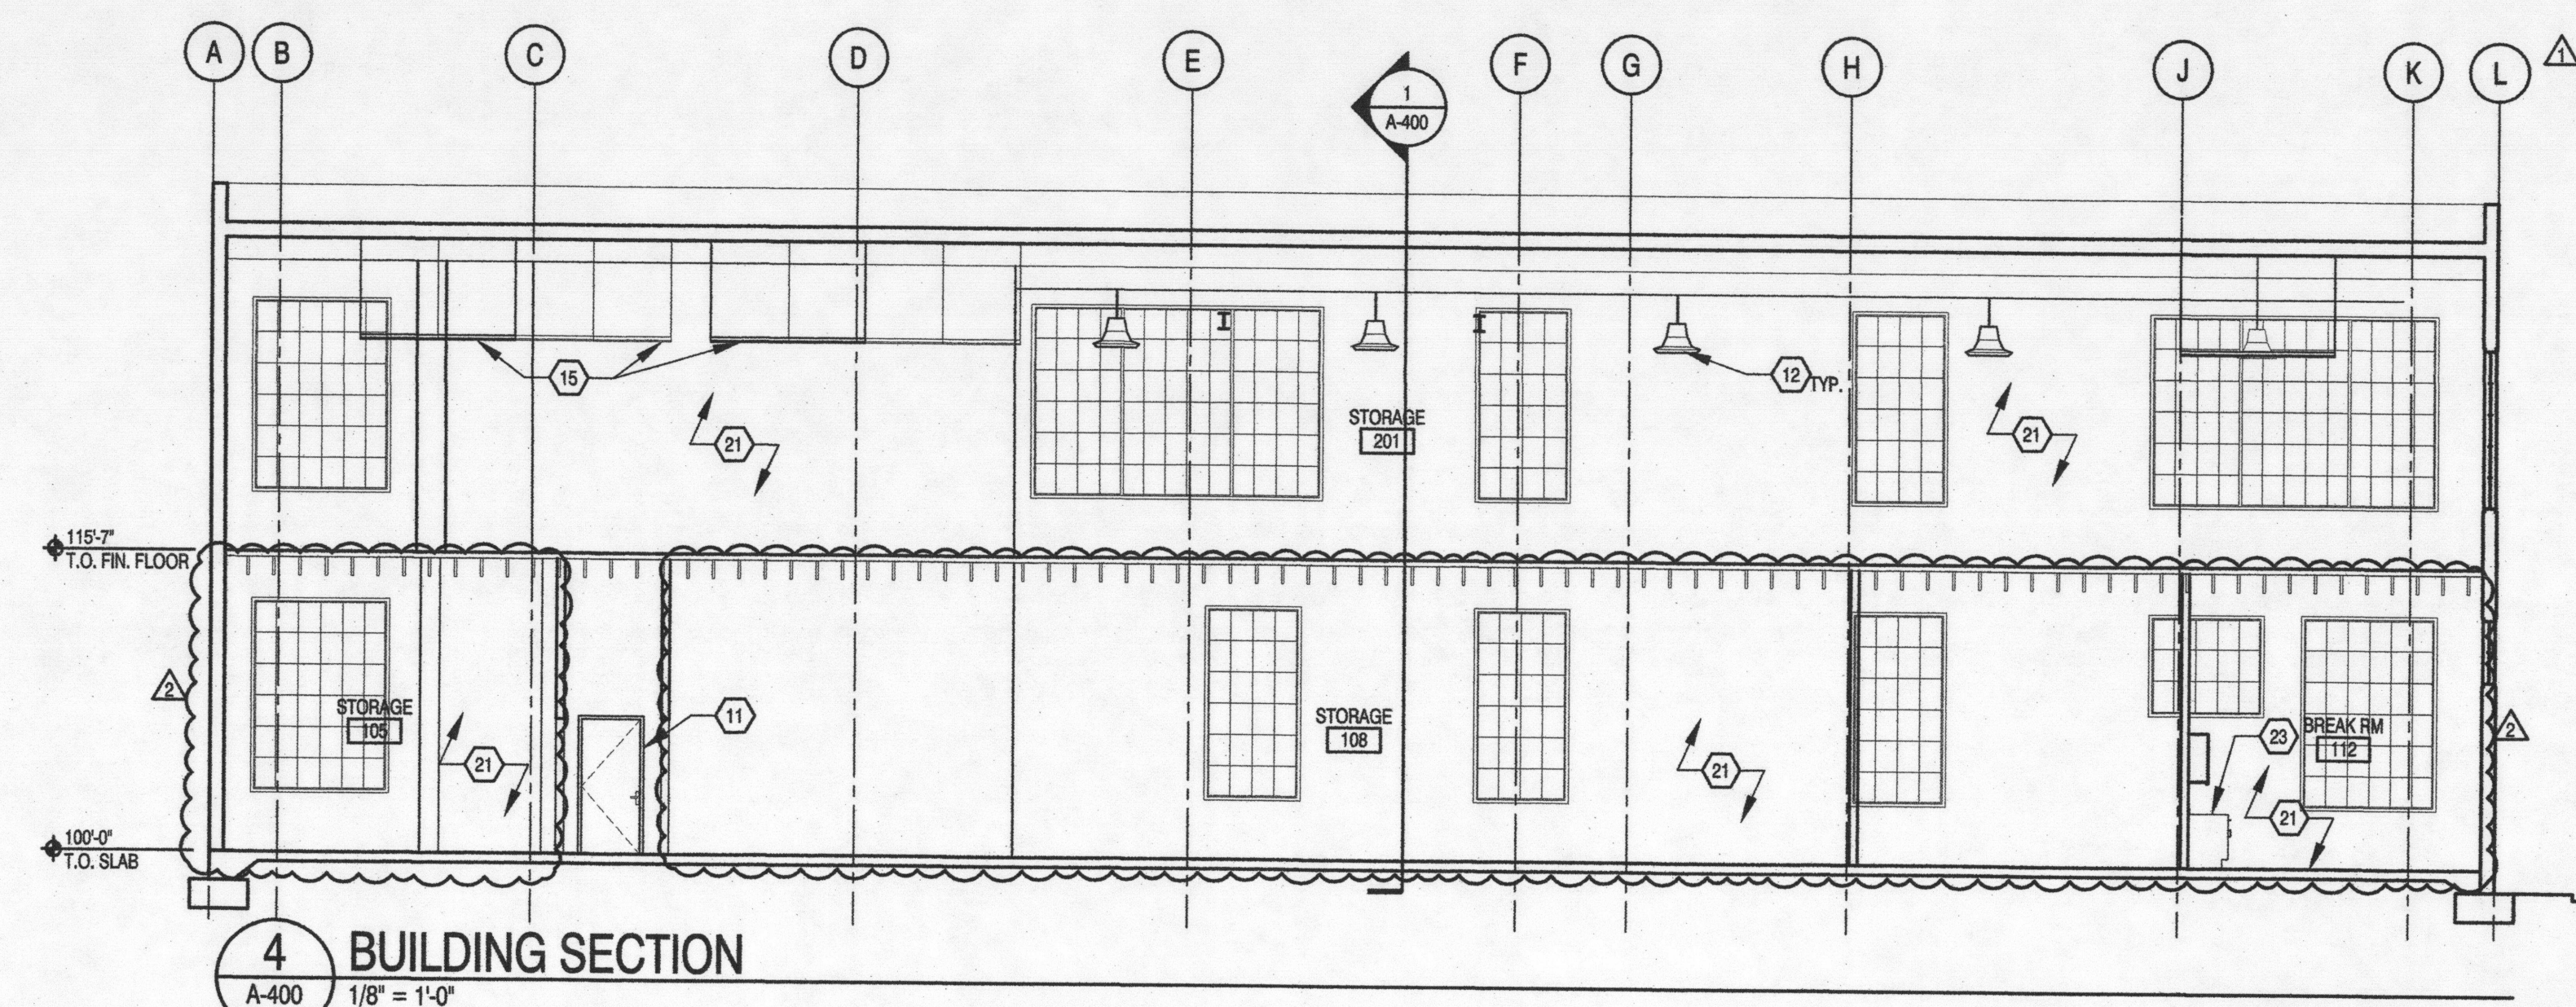

4 BUILDING SECTION
A-400 1/8" = 1'-0"

KEYNOTES

- HIGH BAY PALLET RACKING BY RACKING INSTALLER - BY SEPARATE PERMIT
- FLOOR CONNECTIONS FOR RACKING BY RACKING INSTALLER - BY SEPARATE PERMIT
- SECURITY FENCE
- ID CARD READER
- (E) COILING DOOR TO REMAIN - VERIFY OPERATING CONDITION
- NOT USED
- HOIST BEAMS TO REMAIN
- (E) STAIRWAY TO REMAIN - CLEAN, SCRAPER, REPAINT
- REMOVE (E) DECOMMISSIONED ELECTRICAL, WATER, CONDUIT/PIPING, DUCTWORK
- CLEAN, SAND, & PAINT COLUMNS, BEAMS, JOISTS, DECKING
- (E) DOOR TO REMAIN - PAINT FRAME, DOOR
- (E) HIGH BAY FIXTURE TO REMAIN - REPLACE NON-ACTIVE FIXTURES, LAMPS
- BIG ASS FAN - POWERFOL 8 W/ 14'-0" DIAMETER - BY SEPARATE PERMIT
- (E) BEAM TO REMAIN
- NEW LIGHTING FIXTURE - BY SEPARATE PERMIT
- REMOVE (E) EXHAUST DUCT
- REMOVE (E) "BLAST SHIELD"
- REMOVE (E) HOSE REEL
- REMOVE (E) FLOOR GRATE - INFILL TO MATCH SURROUNDING FLOOR
- REMOVE (E) WATER FOUNTAIN
- CLEAN AND REPAIR INTERIOR WALL SURFACE, PAINT
- CLEAN (E) CARPET, REPLACE DAMAGED PORTIONS TO MATCH EXISTING
- NEW CASEWORK, SNK - SEE PLUMBING FOR FIXTURES, BY SEPARATE PERMIT
- (E) ELECTRIC SWITCHBOXES, EQUIPMENT TO REMAIN
- (E) HANDRAIL, MOUNTING PANEL TO REMAIN

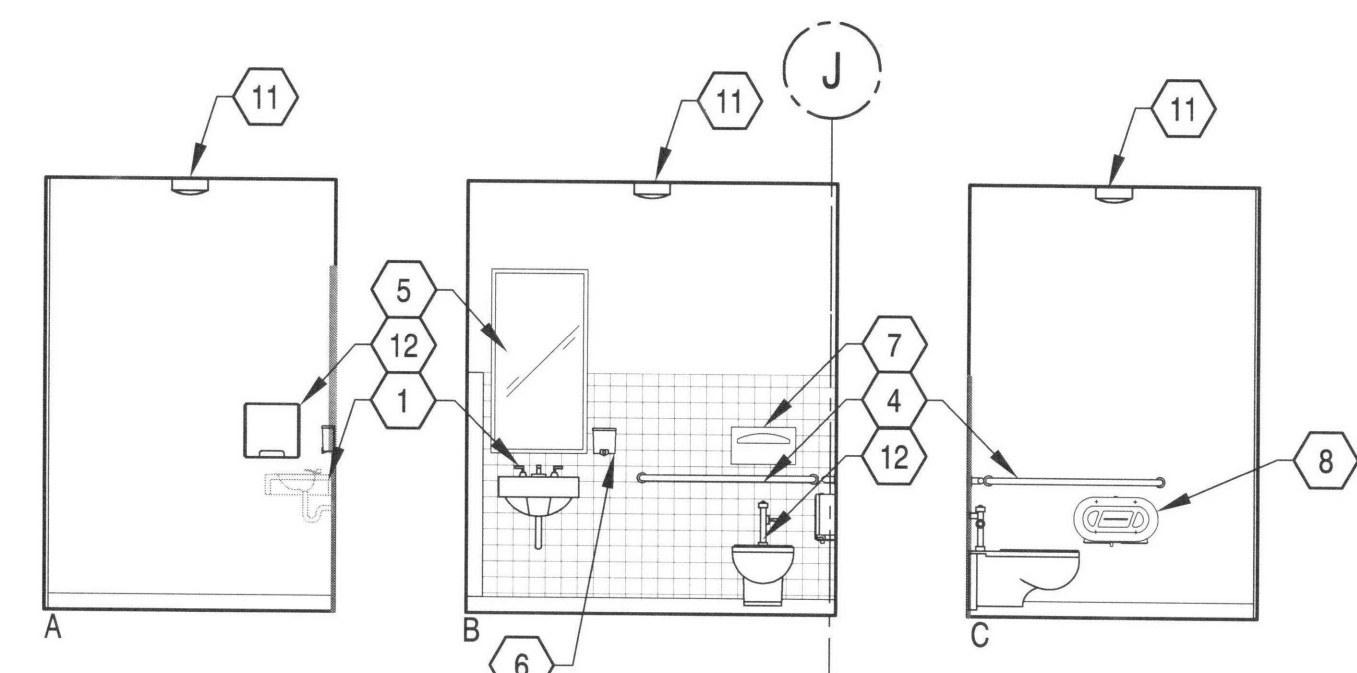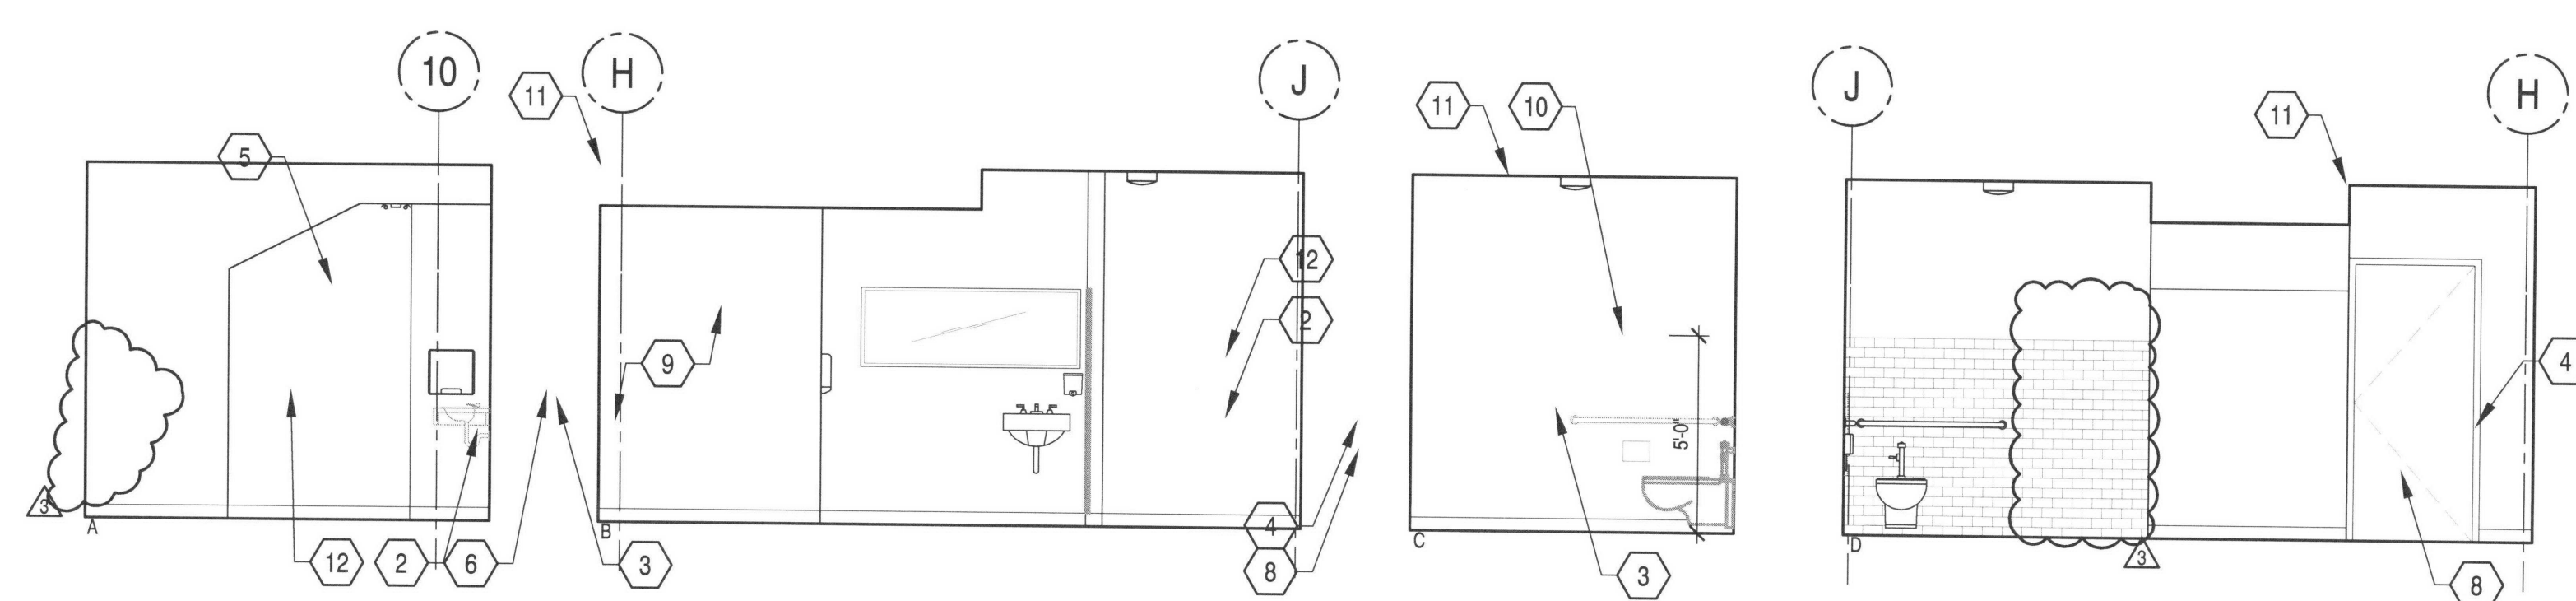1 EXISTING WOMENS 110
A-600 1/4" = 1'-0"2 MENS 109
A-600 1/4" = 1'-0"

KEYNOTES

- SEE MECHANICAL / PLUMBING DRAWINGS FOR TOILET FIXTURES
- OSSC 2014 COMPLIANT LAVATORY SINK - BY SEPARATE PERMIT
- METAL TOILET PARTITIONS
- STAINLESS STEEL GRAB BARS
- (E) STAINLESS STEEL FRAMED PLATE GLASS MIRROR TO REMAIN
- SOAP DISPENSER
- (E) SURFACE MOUNTED TOILET SEAT COVER DISPENSER - VERIFY CONDITION, REUSE IF POSSIBLE
- SURFACE MOUNTED TOILET PAPER DISPENSER - IF EXISTING, VERIFY WORKING CONDITION AND REUSE IF POSSIBLE
- (N) GYP BD. INFILL WALL, PAINT FINISH
- SUBWAY TILE - WHITE DALTILE WITH COVE BASE, BULLNOSE TOP COURSE
- (N) SURFACE MOUNTED FIXTURE - BY SEPARATE PERMIT
- HAND TOWEL DISPENSER

DOOR SCHEDULE NOTES:

- INSTALL NEW 'OCCUPIED/UNOCCUPIED' LOCK.
- REPLACE OR PLACE NEW PANIC BAR HARDWARE
- CARD READER CONTROLLED ENTRY
- PLACE NEW ALARMED PANIC BAR HARDWARE - VON DUPRIN GUARD-X EXIT ALARM LOCK OR EQUAL
- ADA COMPLIANT GATE/DOOR CLOSER
- NO EXTERNAL ENTRY HARDWARE
- LOCKING DOOR HARDWARE ON PULL SIDE, SAFETY CHAIN ACROSS OPENING ON "HOSTWAY" SIDE
- ROLLING GATE

GENERAL NOTES - DOORS:

- DOOR SUPPLIER SHALL SUPPLY AND INSTALL ALL DOOR HARDWARE
- INSTALL NEW OR CONFIRM EXISTING HARDWARE IS FULLY OPERATIONAL
- ALL HARDWARE TO BE COMPLIANT WITH 2014 OSSC SECTION 11B-404.2.7 COMPLIANT LEVER HARDWARE IS TO BE USED ON ALL DOORS UNLESS PUSH/PULLS OR EXIT DEVICE IS USED
- GENERAL CONTRACTOR TO VERIFY PROPER FUNCTIONING, LATCHING, LOCKING, AND SEALING/WHERE APPLICABLE OF ALL EXISTING DOORS. ALL NON FUNCTIONING HARDWARE IS TO BE SERVICED/REPAIRED BACK TO OPERATING CONDITION.
- CONTRACTOR TO VERIFY DOOR SCHEDULE WITH PLANS AND CONTACT ARCHITECT IN CASE OF CONFLICT, INCOMPATIBILITY, OR OMISSION.
- CONTRACTOR TO FIELD VERIFY ALL DOOR OPENINGS PRIOR TO ORDERING AND INSTALLATION OF DOORS
- INSTALL DOORS WITH HARDWARE THAT WILL ALLOW DOOR TO BE OPENED FROM THE INSIDE WITHOUT KEY, SPECIAL KNOWLEDGE, OR EFFORT

DOOR SCHEDULE																
DR #	ROOM NAME	DOOR						FRAME						FIRE RATING LABEL	HDOVR GROUP	NOTES
		SIZE			MATL	TYPE	GLAZ	MATL	TYPE	DETAIL						
		W	HT	THK						HEAD	JAMB	THRESH				
101A (E)	RECEIVING	3'-0"	7'-0"	1 3/4"	H.M.		--	(E) H.M.	--	--	--	--	--		2,3	
101B (E)	RECEIVING	3'-0"	7'-0"	1 3/4"	H.M.		--	(E) H.M.	--	--	--	--	--		2,3	
101C (E)	RECEIVING	12'-0"	12'-0"	2"	COILING /O/H		--	(E) STL	--	--	--	--	--			
101D (E)	RECEIVING	14'-0"	18'-0"	2"	COILING /O/H		--	(E) STL	--	--	--	--	--			
101E	RECEIVING	3'-0"	7'-0"	2 1/2"	CHAIN LINK			GALV. PIPE							2,5,6	
101F	RECEIVING	3'-0"	7'-0"	2 1/2"	CHAIN LINK			GALV. PIPE							2,5,6	
101G	RECEIVING	3'-0"	7'-0"	2 1/2"	CHAIN LINK			GALV. PIPE							3	
101H (E)	RECEIVING	14'-0"	12'-0"	2"	COILING /O/H			(E) STL								
101J (E)	RECEIVING	14'-0"	18'-0"	2"	COILING /O/H			(E) STL								
102A (E)	OMNI OUTGOING	3'-0"	7'-0"	1 3/4"	H.M.	--		(E) H.M.	--	--	--	--	--			
102B (E)	OMNI OUTGOING	6'-0"	7'-0"	1 3/4"	H.M.	--		(E) H.M.	--	--	--	--	--			
102C (E)	OMNI OUTGOING	8'-0"	12'-0"	2"	COILING /O/H	--		(E) STL	--	--	--	--	--			
103A	SAMPLES STORAGE	3'-0"	7'-0"	1 3/4"	H.M.	--		H.M.	--	--	--	--	--		3,5	
103B	SAMPLES STORAGE	3'-0"	7'-0"	1 3/4"	H.M.	--		H.M.	--	--	--	--	--		5,6	
103C	SAMPLES STORAGE	3'-0"	7'-0"	1 3/4"	H.M.	--		H.M.	--	--	--	--	--		3,5	
103D	SAMPLES STORAGE	8'-0"	10'-0"	2 1/2"	CHAIN LINK	--		GALV. PIPE	--	--	--	--	--		3	
104A (E)	RETAIL STORAGE	6'-0"	7'-0"	1 3/4"	ALUM		VISION PNL.	(E) ALUM	--	--	--	--	--			
104B	RETAIL STORAGE	3'-0"	7'-0"	2 1/2"	CHAIN LINK	--		GALV. PIPE	--	--	--	--	--		2,3,5	
104C	RETAIL STORAGE	3'-0"	7'-0"	2 1/2"	CHAIN LINK	--		GALV. PIPE	--	--	--	--	--		5,6	
104D	RETAIL STORAGE	3'-0"	7'-0"	2 1/2"	CHAIN LINK	--		GALV. PIPE	--	--	--	--	--		3	
104E	RETAIL STORAGE	3'-0"	7'-0"	2 1/2"	CHAIN LINK	--		GALV. PIPE	--	--	--	--	--		3	
104F	RETAIL STORAGE	3'-0"	7'-0"	2 1/2"	CHAIN LINK	--		GALV. PIPE	--	--	--	--	--		5	
104G	RETAIL STORAGE	3'-0"	7'-0"	2 1/2"	CHAIN LINK	--		GALV. PIPE	--	--	--	--	--		2,3	
105A	STORAGE	3'-0"	7'-0"	1 3/4"	H.M.	--		H.M.	--	5/A-702	10/A-702	--	--		3	
106A (E)	HALLWAY	3'-0"	7'-0"	1 3/4"	H.M.	--		(E) H.M.	--	5/A-702	10/A-702	--	--		2	
107A (E)	STAIRS	3'-0"	7'-0"	1 3/4"	H.M.	--		(E) H.M.	--	5/A-702	10/A-702	--	--		2	
107B (E)	STAIRS	3'-0"	7'-0"	1 3/4"	H.M.	--		(E) H.M.	--	--	--	--	--		2	
108A (E)	STORAGE	3'-0"	7'-0"	1 3/4"	H.M.	--		(E) H.M.	--	--	--	--	--		3	
108B (E)	STORAGE	3'-0"	7'-0"	1 3/4"	H.M.	--		(E) H.M.	--	--	--	--	--		3	
109A	MEN	3'-0"	7'-0"	1 3/4"	H.M.	--		H.M.	--	--	--	--	--		3	
110A (E)	WOMEN	3'-0"	7'-0"	1 3/4"	H.M.	--		(E) H.M.	--	--	--	--	--		1	
111A	UTILITY CLOSET	3'-0"	7'-0"	1 3/4"	H.M.	--		H.M.	--	--	--	--	--		1	
112A (E)	BREAK ROOM	6'-0"	7'-0"	1 3/4"	H.M.	--		(E) H.M.	--	--	--	--	--			
MEZZANINES																
201A	STORAGE	6'-0"	7'-0"	1 3/4"	H.M.	--		H.M.	--	--	--	--	--		7	
201B (E)	STORAGE	3'-0"	7'-0"	1 3/4"	H.M.	--		(E) H.M.	--	--	--	--	--		3	
202A	STAIRS	3'-0"	7'-0"	1 3/4"	H.M.	--		(E) H.M.	--	--	--	--	--		2,3	
202B	STORAGE SECURITY	3'-0"	7'-0"	2 1/2"	CHAIN LINK	--		GALV. PIPE	--	--	--	--	--		3	

adidas AMERICA, INC.
NACCO WAREHOUSE
2120 NW 27th Avenue
PORTLAND, OR, 97210






RECEIVED

DEC 15 2017

FACILITIES PERMIT

REV # DATE DESCRIPTION
1 10/27/17 ADDENDUM 1 REVISIONS
2 12/05/17 REVISIONS
3 12/05/17 REVISIONSINTERIOR ELEVATIONS
DOOR SCHEDULEPROJECT NO: 17-126
DRWN BY: FZ CHK'D BY: FR
DATE: 10/06/17

A-600

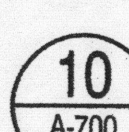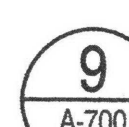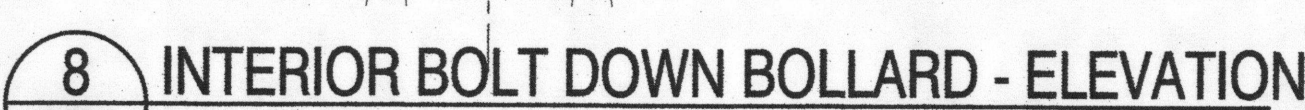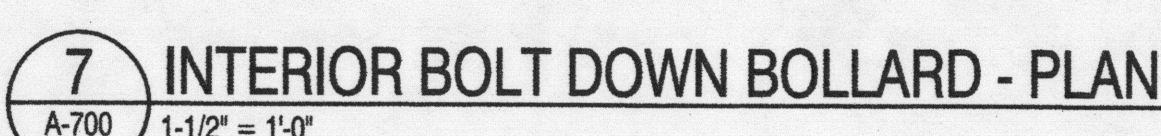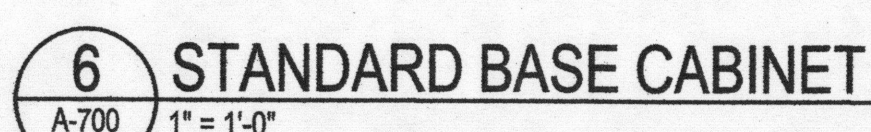© copyright