



--21

--20

---19

<del>\"--</del>16

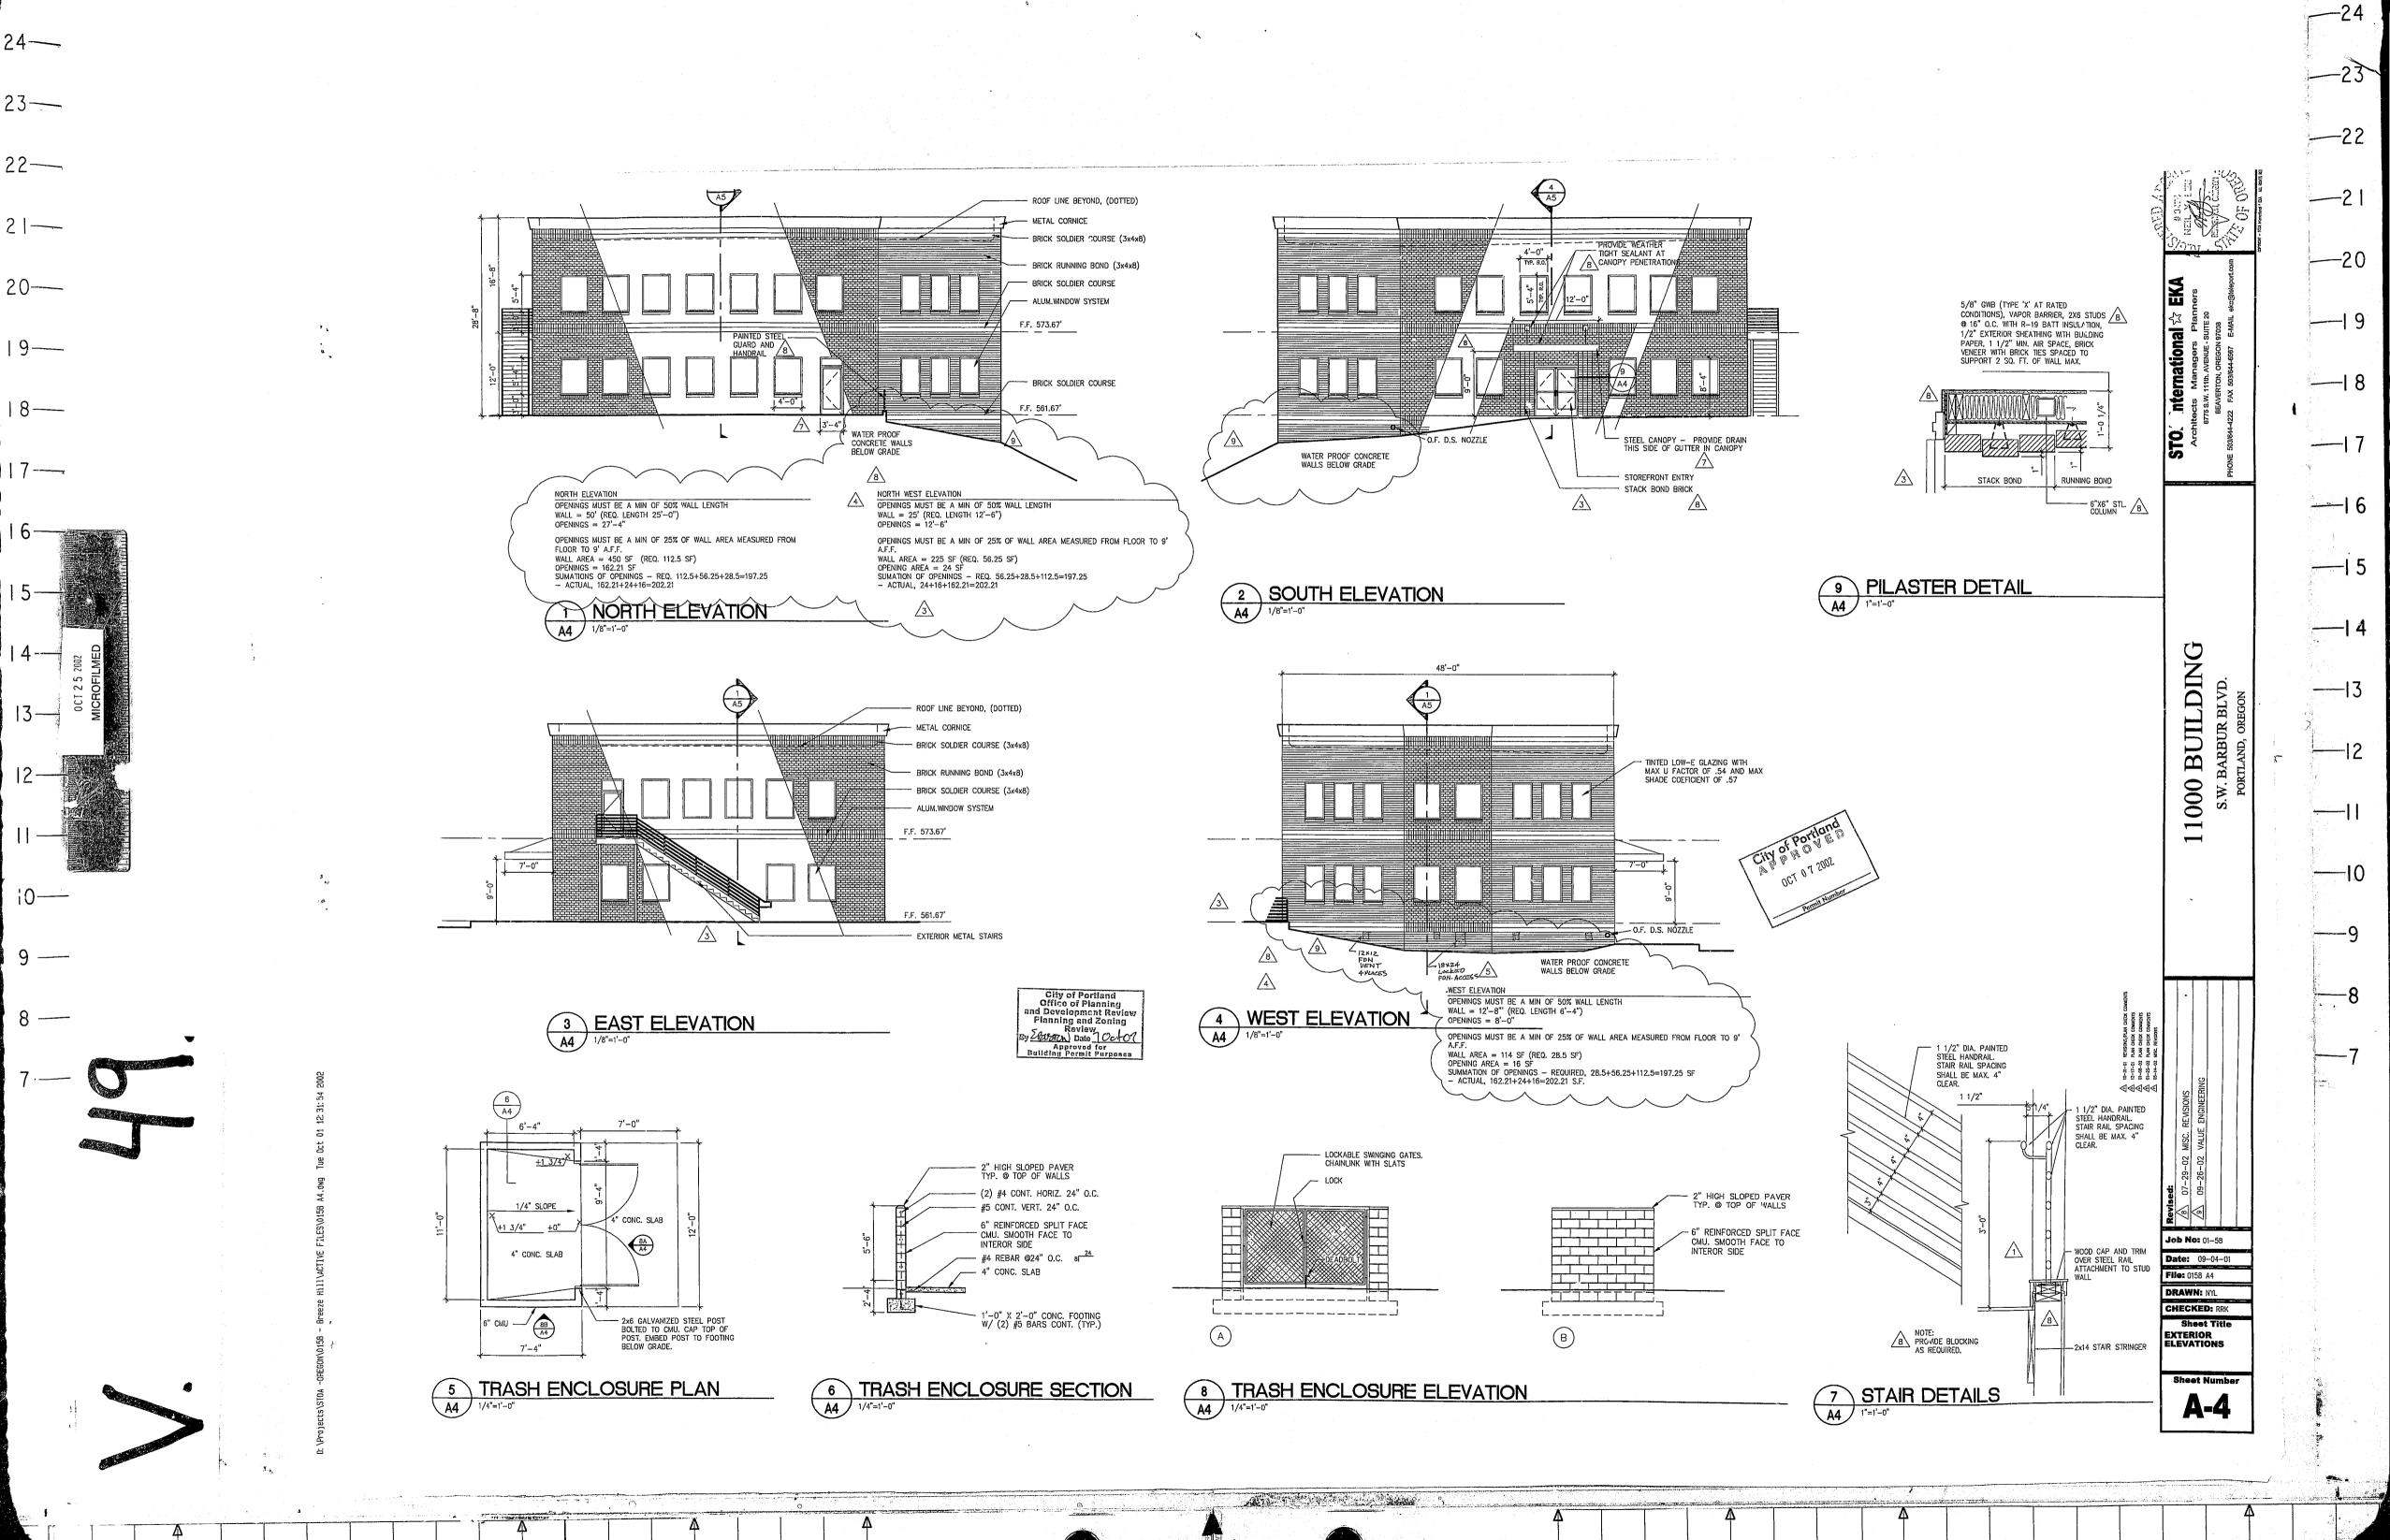

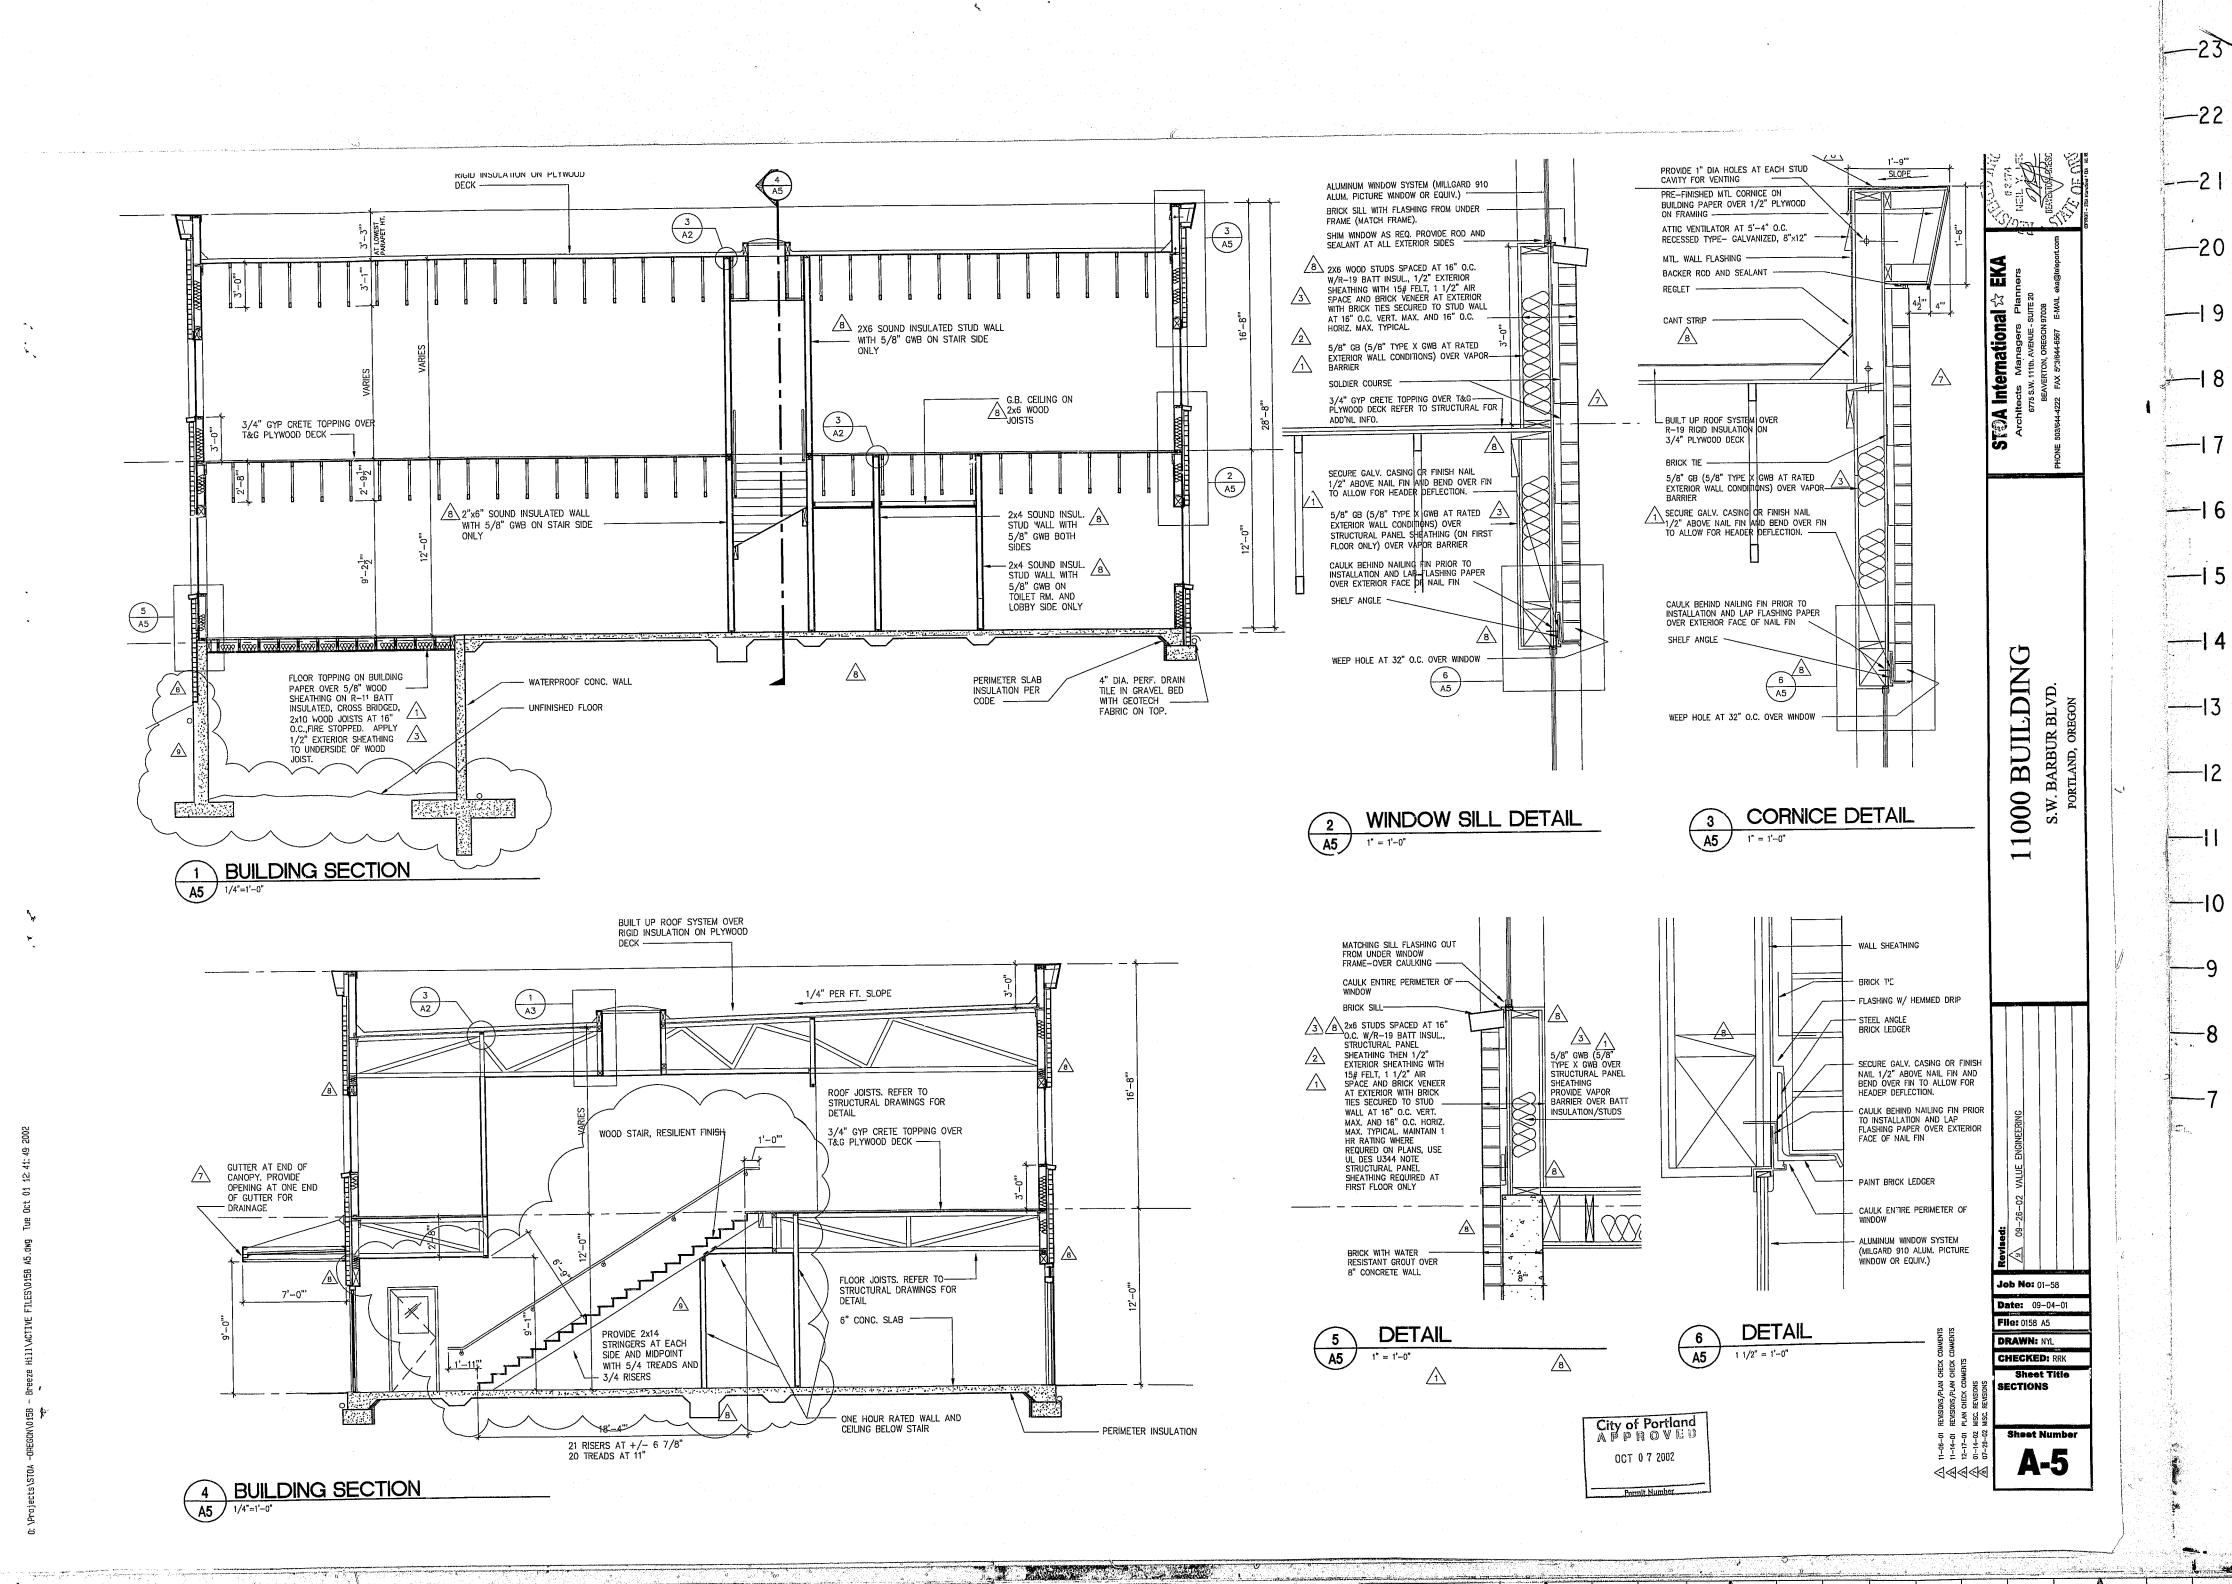

23

13—

<del>--</del>16 -I 5


-24

-23

--22

-20

--10

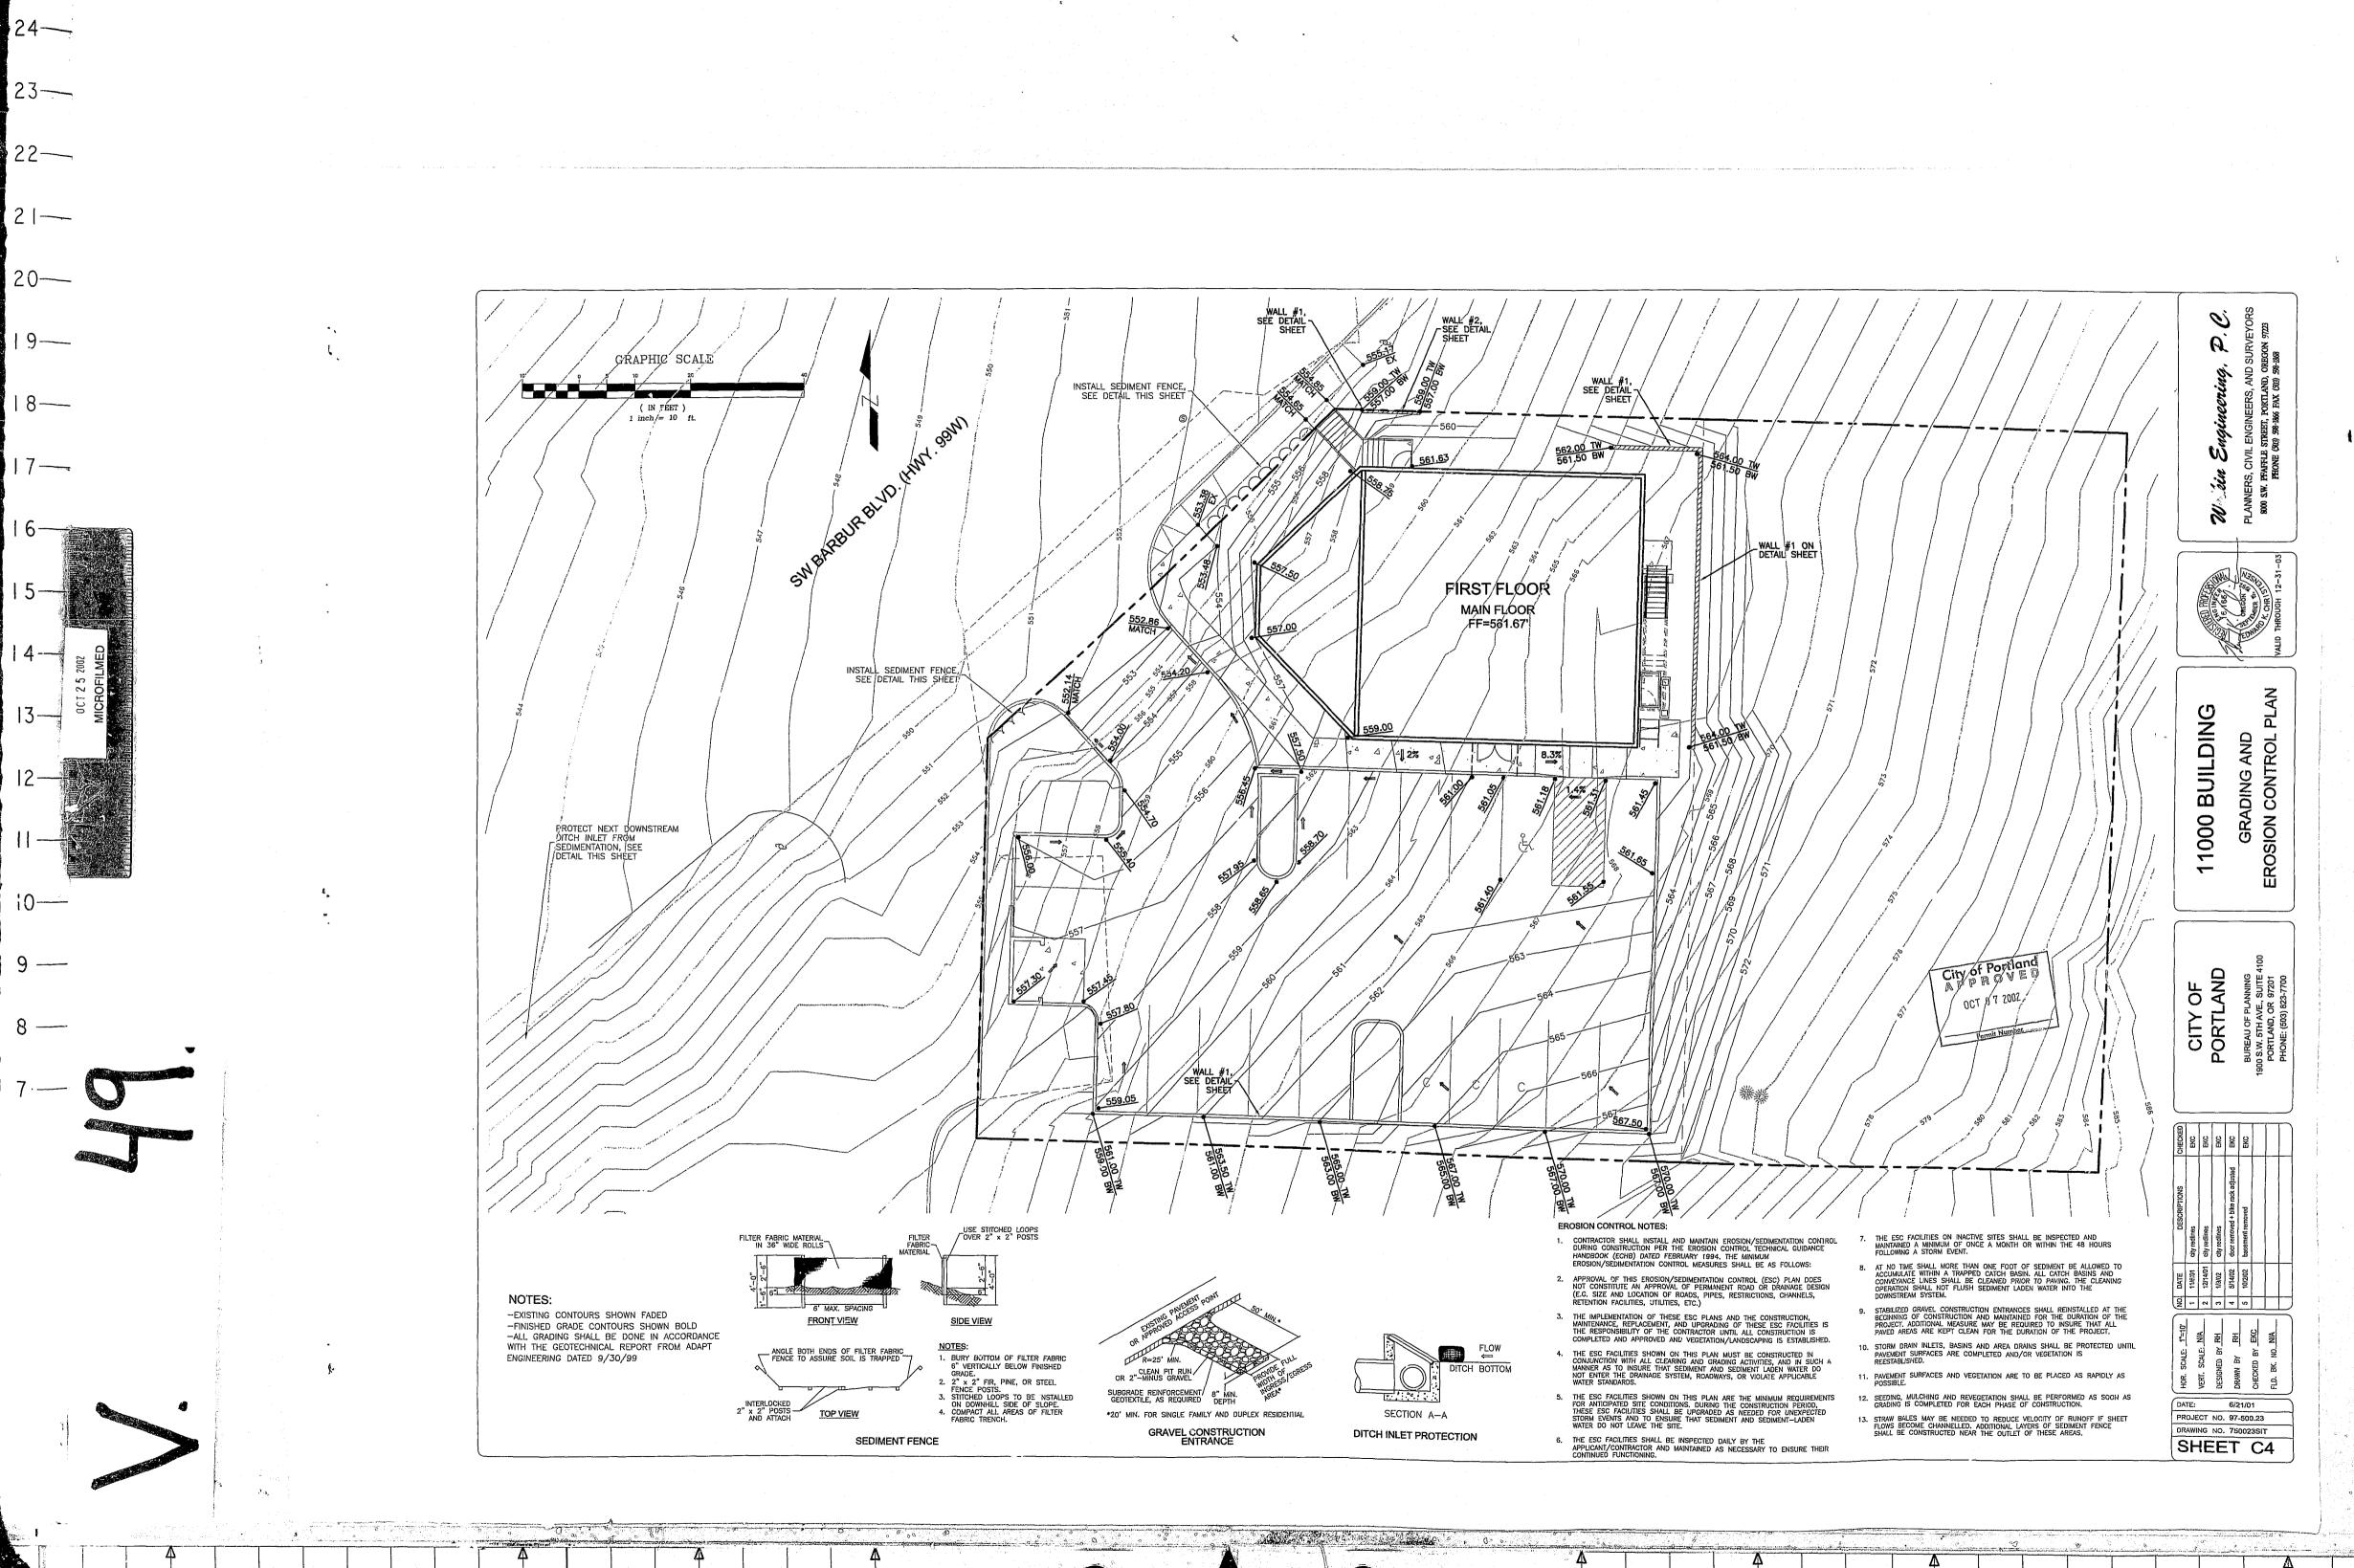

\_\_24

—22 —22

-2 |

-20

-19

—I 8 —I 7

-16

**−**I 5

-14


-13


—I2

--10

9

7

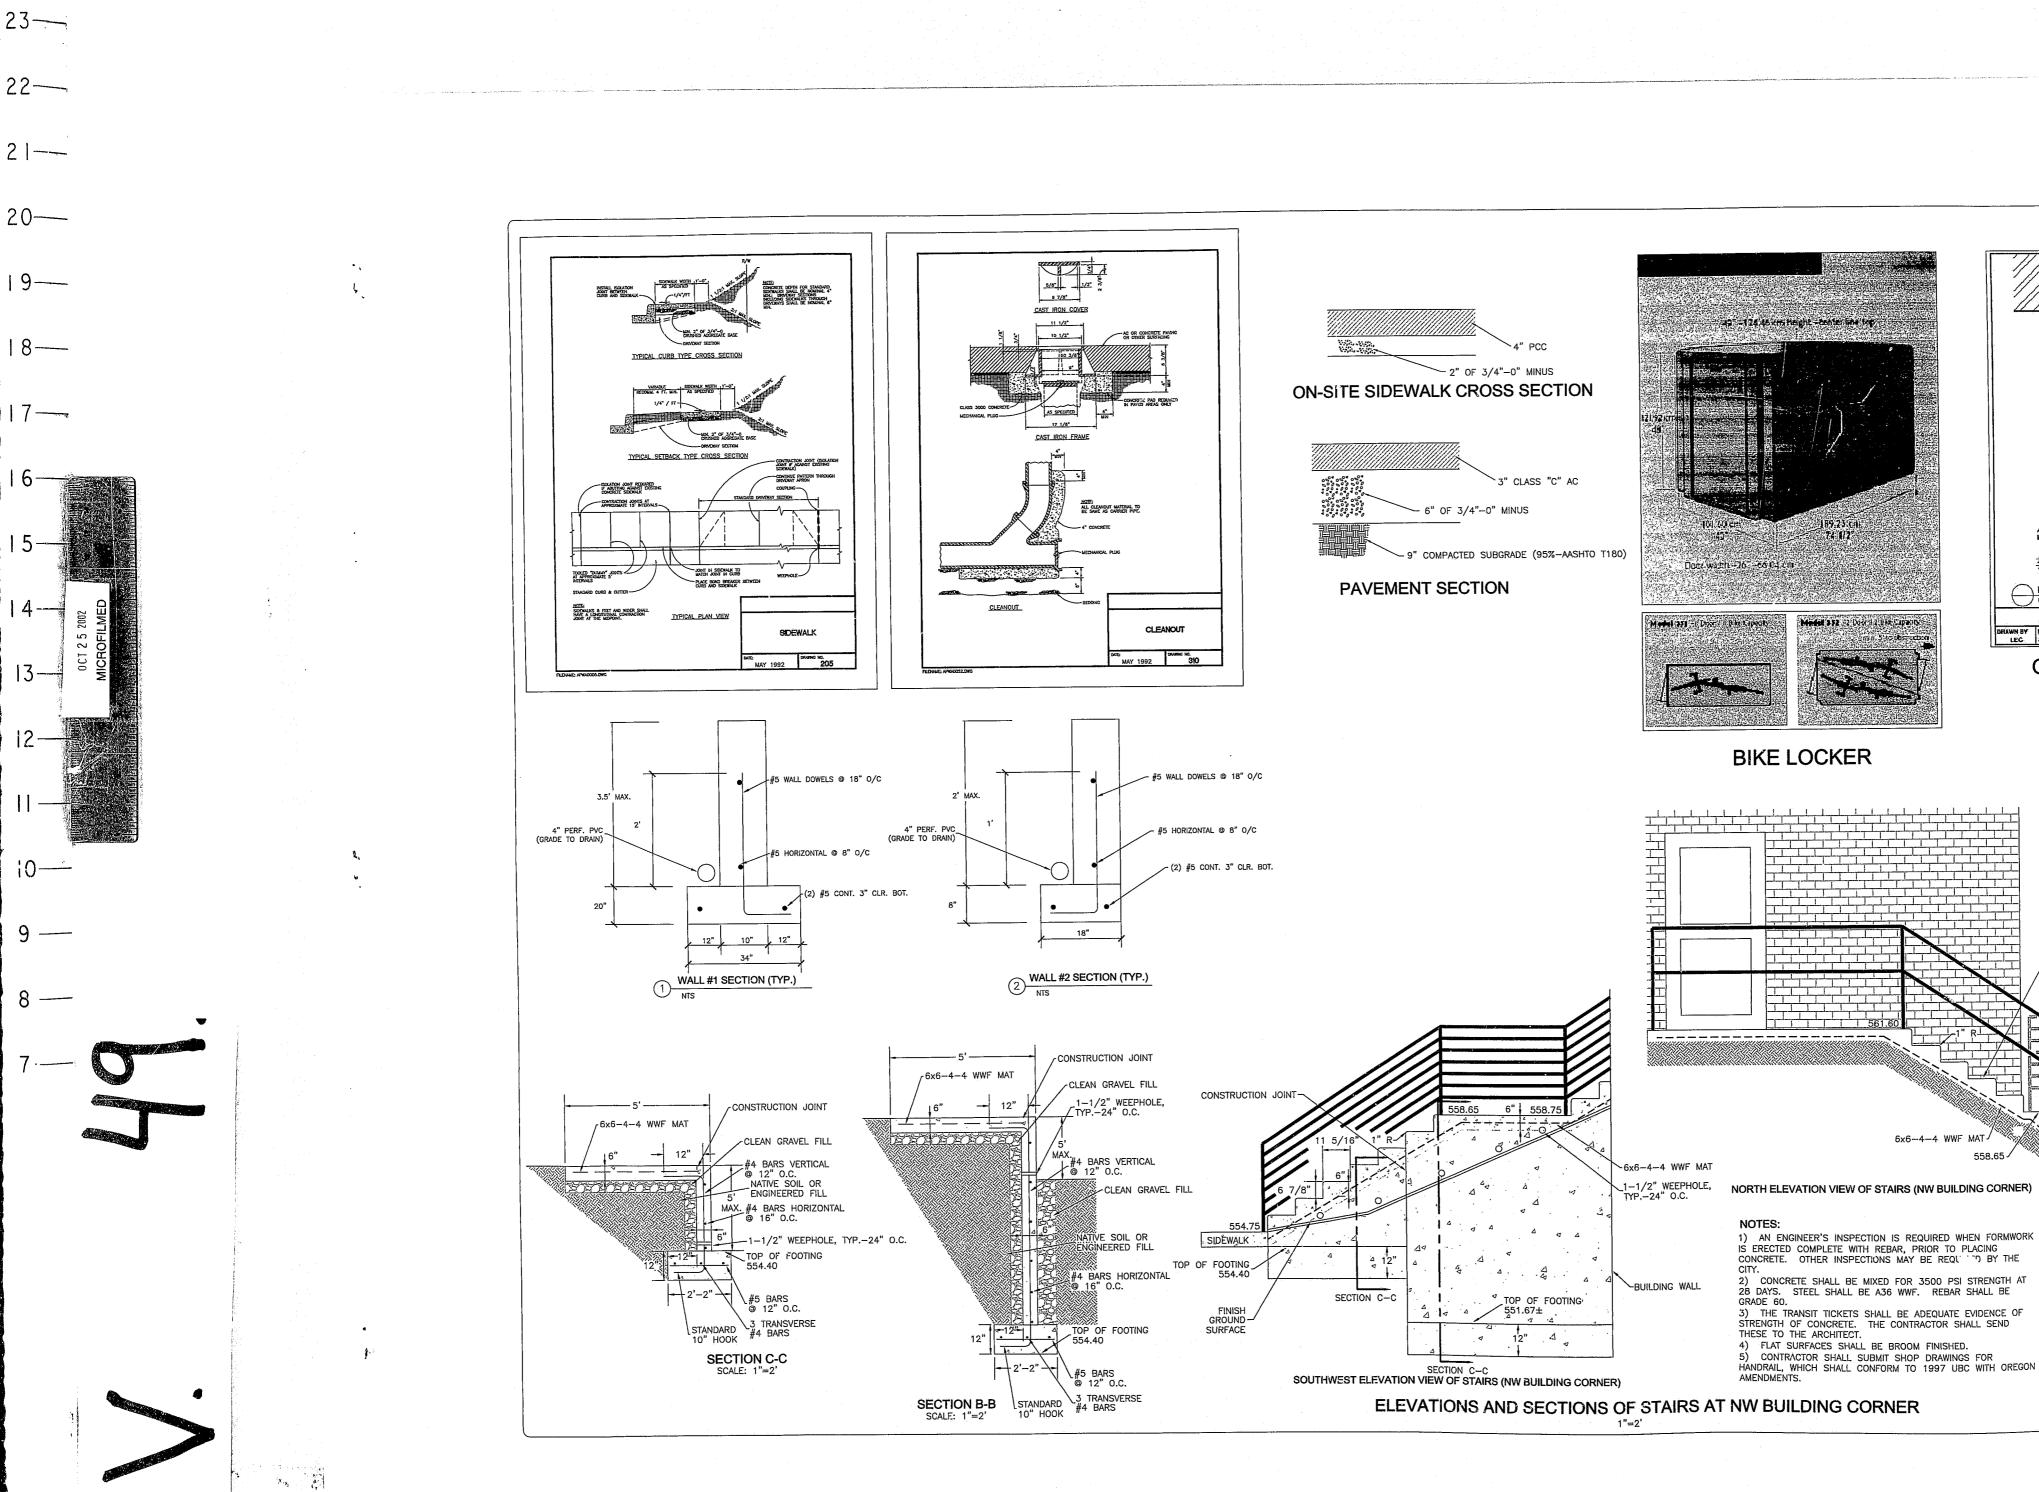

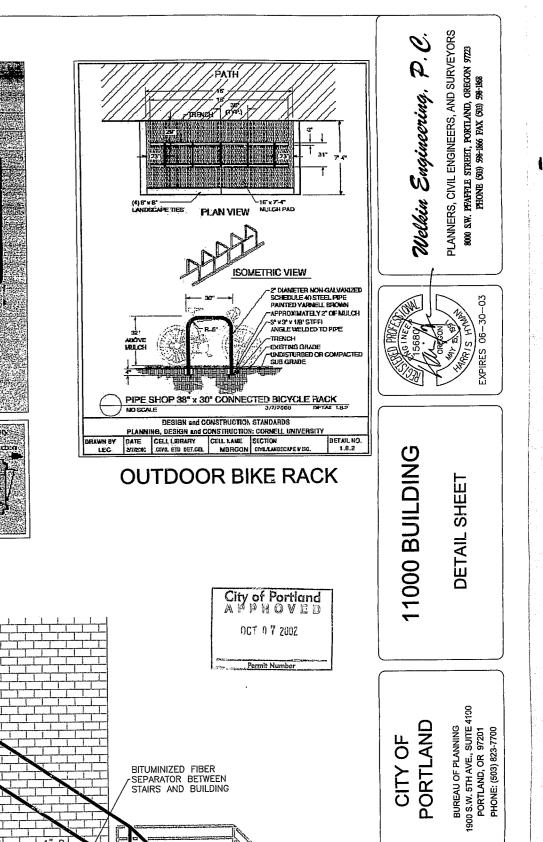

6/21/01


DATE: PROJECT NO. 97-500.23

DRAWING NO. 750023SIT SHEET C6

558.65

**—22** 

--21

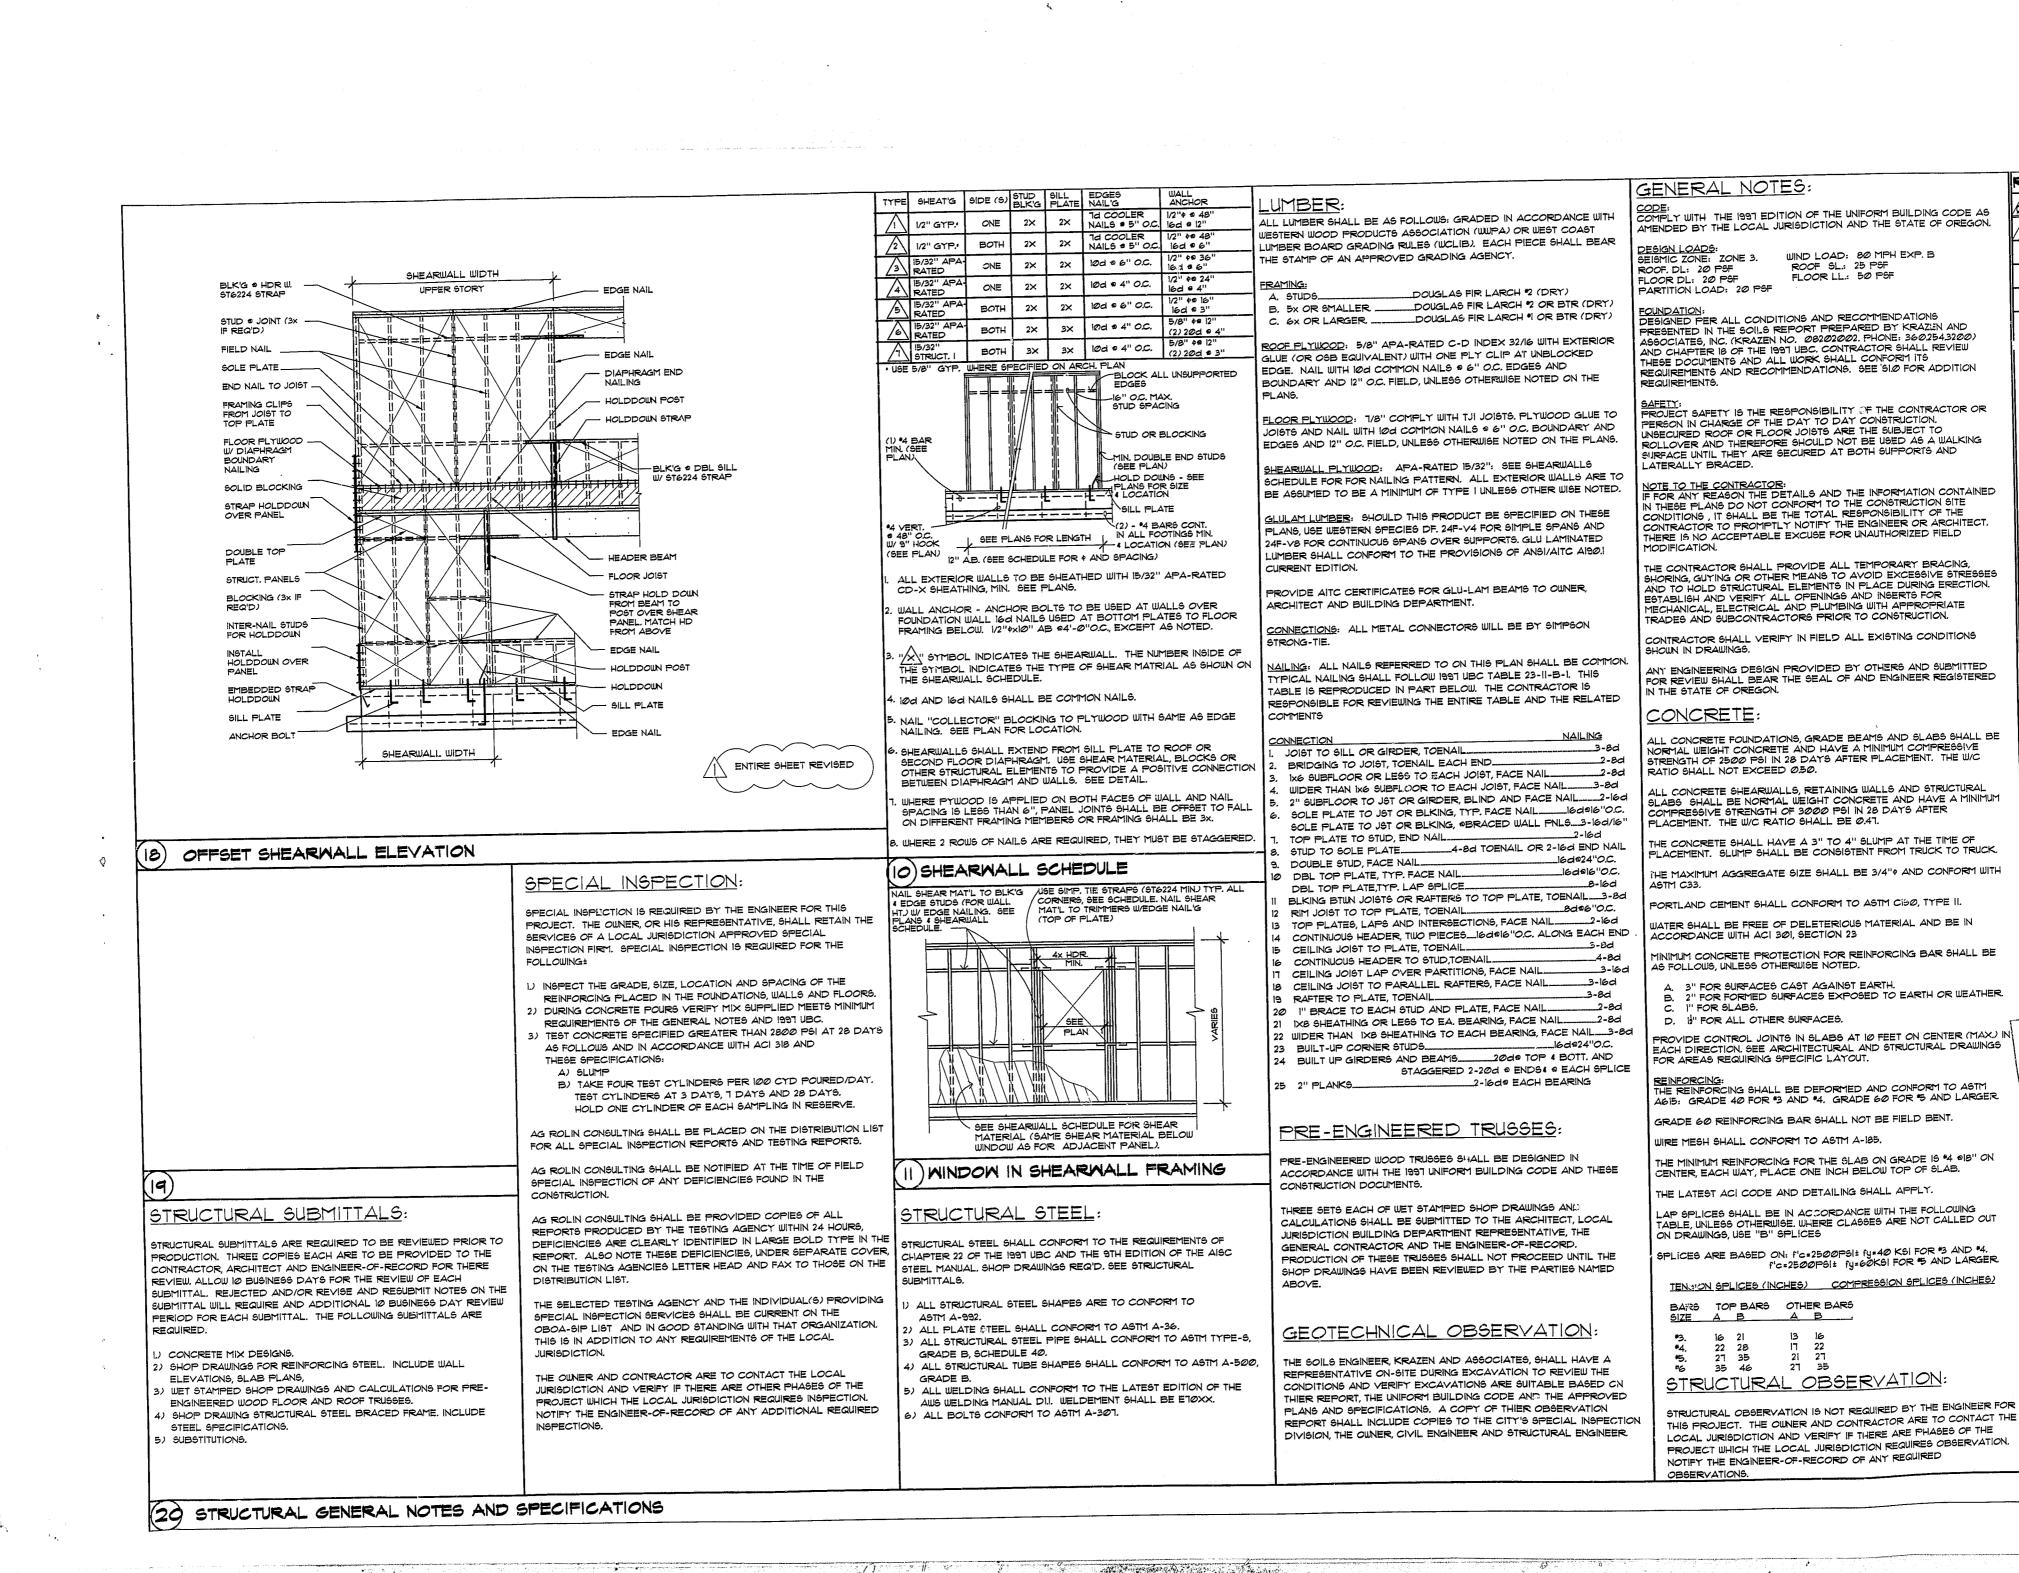

REVISIONS BY

18122

EXPIRES; 12-31-20

tten dimensions on these docume

rig and obtain clarification from Monte Flor to commencing Work. Shop dra ngs must be submitted to this offi or review before proceeding w

ШOZШ

のダくり

ity of Portland

2002 P 0 7200

Ш

NIC TAY

0

<u>S</u>

DATE 8-31-00

S-0.0

SCALE !"=1'-0"

DRÁWN JMW


JOB BØ121

以

2 08/31/01

A MAT'L CHG

07/24/02

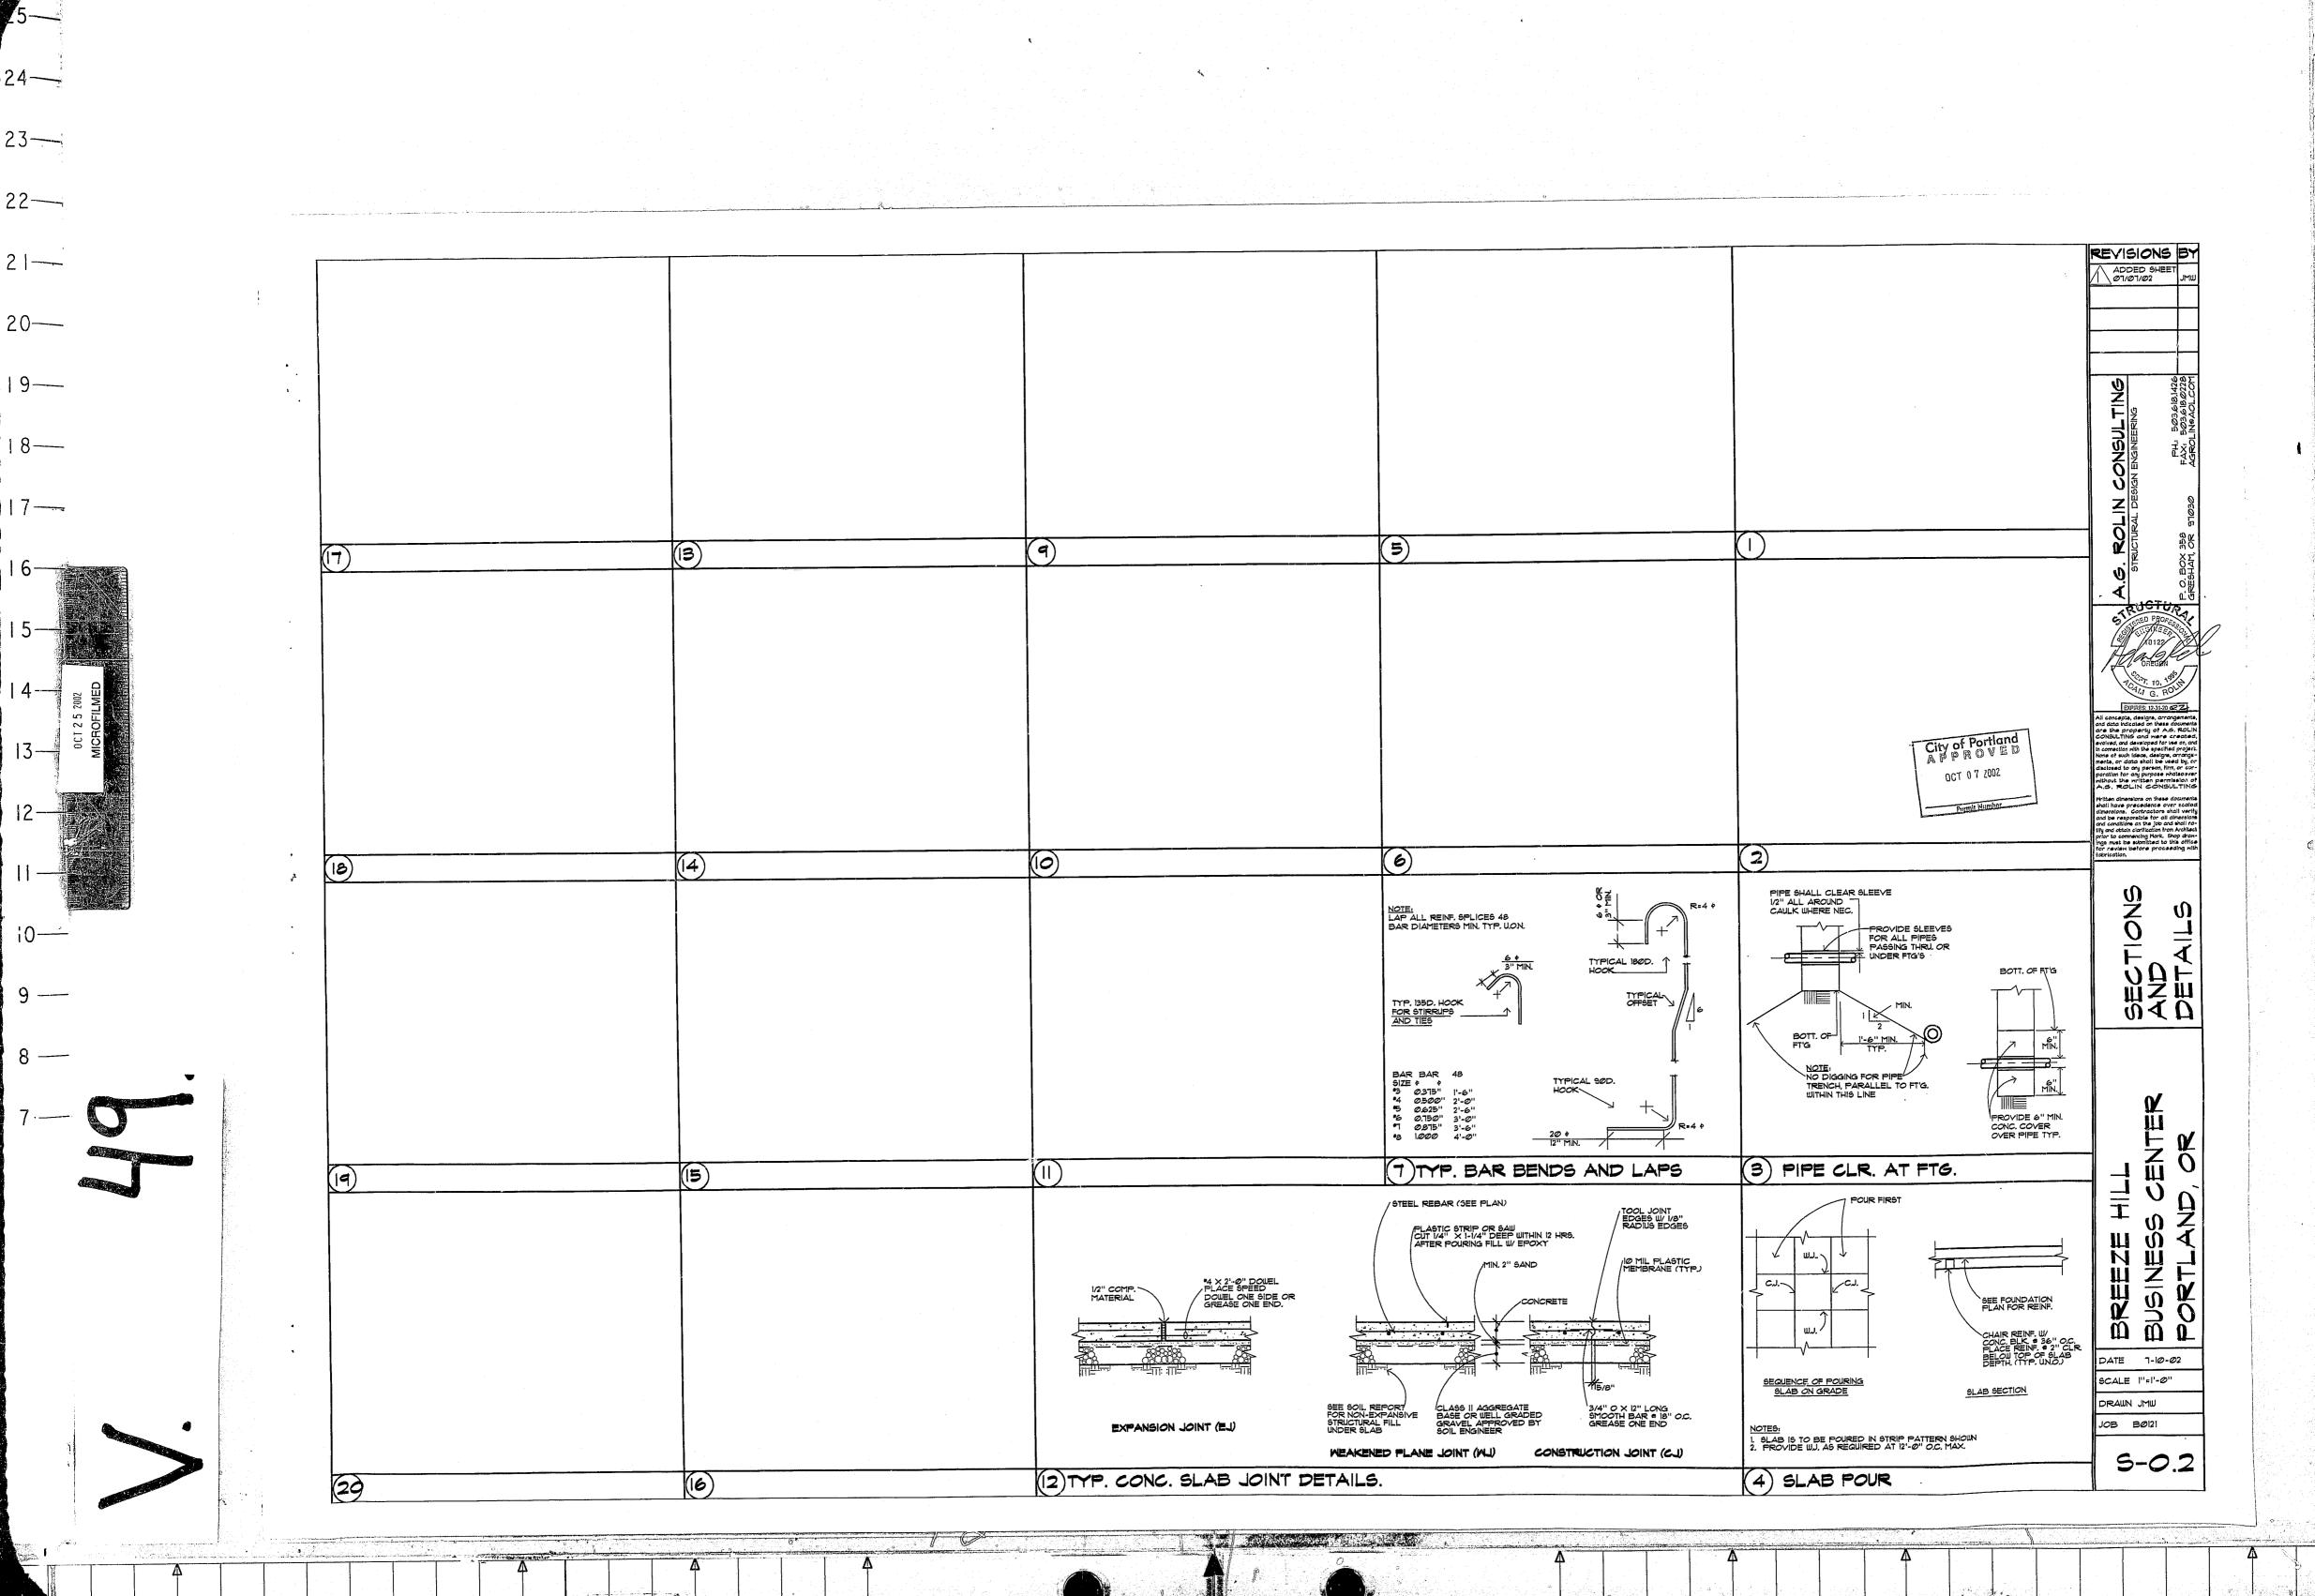

—24 —27

—22

--21

—20 —19

\_10

-17

-16

-l 5

-| 4

--12

-10

-8

<del>--</del>7

3'-10<u>1</u>" 4'-7" 5'-11<del>21</del>'' 4'-7" (2) %" + A-307 BOLTS 3" O.C. THROUGH CENTER OF HS54x4 AND C6 OR C12. GRATING, SEE PLAN FOR SPEC. K " CAP PLATE SEAL WELD L2x2x2x14 CONT. GRATING SHOWN IN THE PLANS AND SECTIONS IS 2-6 36" TYP. -GRATING CONTINUES TO FACE OF WALL ® DOORWAY %" TRIANGULAR PLATE W/ ル" OF HOLE FOR 光" OF PIN. CENTERLINE OF HOLE 必" FROM FREE EDGES FLANS AND SECTIONS IS FOR REPRESENTATION ONLY. REFER TO THE PLANS FOR ACTUAL GRATING SPECIFICATIONS, C12x2@.T A GRATING ATTACHMENT B GRATING ATTACHMENT INCLUDING THICKNESS. 34" A A30T TREADED ROD-- 1-1/4 SCHEDULE 40 STEEL PIPE RAILING AND POSTS, FILLET WELD POSTS TO FLANGES OF C12. -HANDRAIL POST W/ 21/2 CLEVIS EACH END GRATING SECOND IN %"x4"x5" PLATE W/
%"+ HOLE FOR %"+ PIN.
4 OF HOLE K" FROM
FREE EDGES. Y" CAP RE SEAL WELD TO TOP OF COL., TYP. // "x3"xi2" R P ALLOW CI2 WEB TO BE WELDED TO C6. (2) %"ex8' LAG9. TY (3) LOC. THREADED D WALL ATTACHMENT 4" GAP. FINISH AND INSTALL STD. 4" GUTTER IN SPACE. SLOPE TO ONE END AND DAYLIGHT DOWN THROUGH STD. CONNECTOR FLANGE. DO NOT ADD DOWN SPOUT. C STRINGER ATTACHMENT (9) MISC. STAIR DETAILS SCALE: 1" = 1'-0" BUCKLE (4)%"+ HOLES FOR -2 CLEVIS, "X"×3"×12" E ® FACE OF COL. ౹'-౭ిజ్జి'' 一片"xlの"xlの" 記 W/(4) %"+xl2" ANCHOR BOLTS %"4x12" ANCHOR BOLTS BASEPLATE (A) FIRST FLOOR CANOPY SECTION GRATING, SEE PLAN FOR SPEC. EXTERIOR STAIR SECTION W/ (2) %"+x8" LAGS INTO 6x10. BOLT TO C6 OR C12 W/ L9X4X1X6" LONG W/ (2) 1/8" +x8" -LAGS INTO 6X10. BOLT TO C6 W/ (2) %"♦ A-3Ø7 BOLTS. (2) %"+ A-307 BOLTS. (IB) (603) IN STAIR LANDING
AREA USE 6xIØ AT
TOP PLATES FOR
BLOCKING FANELS,
DBL STID UNDER 6
EACH END 4 ADD
H25 6 EACH END
ON INSIDE OF
BUILDING FACE. C6X82 HSS4x4 W/ 1/4-WELDED TO TOP. TOP OF CAPIE & BOTT OF GRATING. IN STAIR LANDING AREA USE— 6XIØ AT TOP PLATES FOR BLOCKING PANELS, DBL STUD UNDER 9 EACH END 4 ADT H2.5 22 EACH END ON INSIDE OF BUILDING FACE. B WALL CONNECTION A WALL CONNECTION ) MISC. STAIR DETAILS SCALE: 1" = 1'-0" H994x4 W/X— "CAP R SEAL WELDED TO TOP. TOP OF CAPR & BOTT OF GRATING. - AT DOOR
OPENING
GRATING
CONTINUES TO
THRESHOLD DETAIL REMOVED C12×20.7 L9X4XXX6" LONG W/ (2) 56" +x8" LAGS INTO 6x10. BOLT TO C12

SCALE: 1" = 1'-0"

W/ (2) %"+ A-307 BOLTS.

(2) ENLARGED STAIR LANDING PLAN

REVISIONS BY ADDED SHEET H954x4x1/2 STUB GROOVE WELDED TO COL. W/ I"x1"x1" AT EXT. FACE OF BRICK. FILLET WELD TRIANGULAR PLATE TO 90. PLATE AND 90. PLATE TO H994x4. ADDED SHEET JMW 3GAX3"X36" LONG STRAP FILLET WELDED TO COL. BOLT STRAP TO TOP OF TRUSS W/ (3光"; THRU-BOLTS AT 6" OCSTARTING W" FROM THE FAR END OF THE STRAP. DESIGN TRUSS TOP CHORD FOR TENSION LOAD # 4000 DESIGN TRUSS BY CHORD FOR COMPRESSION LOAD: 4000\* - ¼"X5"X12 STL TE WELDED TO COL TO SUPPORT TRUSS, (4) %"4 BOLTS © 3" O.C. THROUGH TRUSS(ES) \_HSS4x4x14 STUB GROOVE WELDED TO COL. W/ I"x10"x10" AT FACE OF BRICK. (4) %"? TREADED TAP HOLES AT T" OC. EA WAY IN PLATE TO BOLT ON CI2. ½" FILLET WELD AROUND HSS4X4 TO PLATE Written dimensions on these documents shall have precedence over scaled dimensions. Contractors shall verify and be responsible for all dimensions and conditions on the job and shall not this and obtain dorification from Architect to commencing Nork. Shop drawings must be submitted to this office for review before proceeding with fabrication. Ö City of Portland OCT 0 7 2002 REEZE DETAIL REMOVED DATE 7-10-02 SCALE 1/2"=1'-0" DRAWN JMW JOB B0121 5-0.3

(B)

-22

-20


REVISIONS BY Ø8/31/Ø1 COORDINATE DIMENSIONS WITH NOTE: PHD5 W/ 65TB24 MAY BE SUBSTITUTED FOR THE HDC5/22 SPECIFIED ON THE PLANS, HOWEVER, IF PHD5 ARE USED THEY MUST BE LOCATED UNDER THE WINDOWS. ALL DIMENSIONS TO FACE OF ARCHITECTURAL AND CIVIL DRAWINGS. MAT'L CHG. 08/14/02 SHEATHING. ADD 15" TO FACE FROM FACE OF SHEATHING TO OBTAIN FACE OF SLAB. QUNER CHG. 09/27/02 HDC 5/22 • DBL. CORNER - END OF RETAINING WALL HDC 5/22 . HDC 5/22 • HDC 5/22 0 HDC 5/22 € rdbl. Bearing --DBL. BEARING DBL. BEARING -DBL. CORNER STUD W/SSTB24 STUD W/SSTB24 STUD W/SSTB24 SEE SCHEDULE HDC 5/22 0 2'-6" x 12" THICK FOOTING W/(3) \*4 CONT. \*4 VERTICAL HDC 5/22 0 (2) 5 BOUNDARY BARS DBL. BEARING STUD W/SSTB24 6" SLAB W/\*4 ● 18" O.C. EACH WAY SET 2" BELOW TOP OF SLAB OVER 2" CLEAN SAND STUD W/SSTB24 INTO STEMWALL/SLAB # 48" O.C. OVER 10 MIL VAPOR BARRIER OVER 4"
CLASS II BASE ROCK COMPACTED TO 90% SLAB ENDS AND RETAINING 12" x 12" THICK FOOTING 5'-6"x1'-6"x2'-0" THK FTG. W/(3) •4 WALL BELOW BEGINS OVER SUBBASE COMPACTED TO 90% PARTITION FOOTING -HDC 5/22 ● W/(2) 4 BOTTOM PROVIDE WEAKENED PLANE BUILD INTEGRAL WITH SLAB STUD W/SSTB24 JOINTS . 12" O.C. E.W. (MAX.) 4" SLAB W/ 3 SEE SHEET OO ●18"O.C. E.W. 7 HDC 5/22 # PHD8 W/SSTB34 ~ \$ OF COL DBL. BEARING -STUD W/55TB24-\$ OF COL 16'-14" 3'-0"x3'-0"x3'-0" THK FTG. BACKFILL THIS AREA W/ I'-O" MIN 4 4'-O" MAX. OVER TOP OF 4 x 12 DF 12 PT. LEDGER C12x2Ø.7 (2) 5 BOUNDARY BARS 10" RETAINING WALL, ~ W/ 3/4" + AB W/ 6-5/8" -FOOTING W/ STRUCTURAL FILL COMPACTED TO 90%. 2'-0"x2'-0" THK FTG. TYP. BASEMENT
LEVEL FOUNDATION
4'-O" WIDE x 1'-3"
THK CONT. FIG. U/
40 12" O.C. E.W.,
BOTT. SEE SCHEDULE EMBED AT 12" O.C. MAX. (2) W/(3) 5 T4B BUILD HDC 5/22 0 BOLTS AT ENDS OF LEDGER SECTIONS, TYP. HDC 5/22 € DBL. BEARING 3' -0"x 3'-0" THK FTG. STUD W/SSTB24 8" CONCRETE WALL STUD W/SSTB24 / W/(4) 5 T4B 3 TIES 0 12" O.C. 1 W/5 AT 12" O.C. E.W. LTT20B AT 48" O.C. ON SIDE OF EXPIRES: 12-31-20 2 3 135" HOOKS AT ENDS OF TIES IN CENTER OF WALL, TYP. JOIST, TYP. ADD WEB STIFFENERS HSS 4x4x1/2 COL. TO JOISTS AS REQUIRED USE ADDITIONAL 3/4" + AB W/6-5/8" EMBED AT EACH are the property of A.G. ROLLI CONSULTING and were created evolved, and developed for use an, an - HDQ8 W/ SSTB34 6'-0"x6'-0"x2'-0" THK FTG. 34" APA-RATED SHEATHING W 100 6 W/(6) S EW. BOTT, DEEPEN CENTER 3'-0"X3'-0" AREA OF Printen dimensions on these documenta shall have precedence over saded dimensions. Contractors shall verify and be responsible for all dimensions and conditions on the job and shall notify and obtain carrication. Shop drawling must be submitted to this office for review before proceeding with topication. 6" O.C. EDGE 4 BOUNDARY, 12" O.C. SET COLUMN 6'-6" FOOTING TO 3'-0" FOR 55TB34 (2) 5 BOUNDARY BARS 14" TJI/PRO 350 € 16" O.C. WALL CORNER 3" GYPCRETE OVER SHEATHING. NOTE: CONTINUE GRADE BEAM BAR THROUGH ISOLATED FOOTING, TYP. MPSON ITT3514 HDC 5/22 6 - 8" RETAINING WALL © PERPENDICULAR CONNECTION. LBV3514xR45 © DBL. CORNER STUD W/55TB24 2'-0"x2'-0"THK FTG, 山(3) ち T4B BUILD BUILD PARTITION FOOTINGS INTEGRAL W/ SLAB INTEGRAL WITH SLAB (12"x12") HDC 5/22 6 DBL. BEARING I'-9"xI'-0" THICK FOOTING STUD W/SSTB24 W/(2) 4 BOTT. 4 VERT., 6" HK 3'-0"x3'-0"x3'-0" THK FTG. ~ IN BOTT, OF FTG. 4 VERT, INTO W/(4) % E.W. T4B SLAB/STEMWALL . 48" O.C. (2) 5 BOUNDARY BARS 2'-0"x2'-0" THK FTG. ~  $\mathbb{D} \Leftrightarrow \mathbb{F} \mathcal{D}$ 2'-6" x 12" THICK FOOTING

W/(3) \*4 CONT. \*4 VERTICAL

W/6" HOOK IN BOTTOM OF FOOTING
INTO STEMWALL/SLAB • 48" O.C. HDC 5/22 e BUILD PARTITION FOOTINGS -INTEGRAL W/ SLAB INTEGRAL WITH SLAB (12"x12") DBL. BEARING -END OF RETAINING WALL (FIELD VERIFY) HDC 5/22 @ DBL. CORNER BOTTOF (SØ.1) ADJACONT GRADE AT IS" BELOW LOWEST ADJACENT GRADE, MIN., TYP. RETAINING WALL 5'-0" SEE SCHEDULE 12' x T' CANOPY City o SEE 520 FOR DESIGN Ш OCT 0 7 2002 22'-3|2'' 27'-0悟'' SHEET NOTES: A BASEMENT FOUNDATION PLAN NOTE: 1) SEE SHEETS SOO AND SOI FOR GENERAL NOTES AND TYPICAL DETAILS. B FIRST FLOOR FOUNDATION PLAN ALL EXTERIOR WALLS AND INTERIOR SHEAR WALL SHALL BE CONSTRUCTED THESE STRUCTURAL NOTES SUPERSEDE OTHER STRUCTURAL NOTES FOUND IN SINE STATE \$1.0 1/4"-11-0" OF 2 x 6 DF STUD GRADE . 16" O.C. 2) FLOOR FRAMING BY OTHERS. THIS IS A DEFERRED SUBMITTAL. SUBMIT FIVE (5) SETS OF WET STAMPED SHOP DRAWINGS AND CALCULATIONS TO THE 5) A SOILS REPORT HAS BEEN PREPARED FOR THIS PROJECT BY KRAZEN AND ASSOCIATES, INC. (KRAZEN®8202002, PHONE NO.: 3602543200). ALL FOUNDATIONS SHALL CONFORM FORT TO THIS REPORT'S RECOMENDATIONS AND IN ADDITION CONFORM TO 1991 UBC CHAPTER IS (ESPECIALLY SECTIONS REGARDING DEPTH OF FOOTING REQUIREMENTS AT SLOPING GRADES). THE SOILS ENGINEER SHALL BE PRESENT ON SITE TO REVIEW THE EXCAVATIONS TO INSURE THEY MEET THE REQUIREMENTS OF THER REPORT AND THE BUILDING CODE. THE BOTTOM OF ALL FOOTINGS SHALL BE A MINIMUM OF IS!" BELOW LOWEST ADJACENT GRADE. IN ADDITION, THE BOTTOM ALL FOOTINGS SHALL BE A MINIMUM OF ISPT (MEASURED HORIZONTALLY) TO DAYLIGHT OF THE SLOPE, ALL DIRECTIONS. MPORTANT NOTICE REGARDING ARCHITECT FOR REVIEW. THREE (3) SHALL BE FORWARDED TO AG ROLIN PENETRATION OF SHEARWALLS. CONSULTING FOR THEIR REVIEW. SEND THREE (3) REVIEWED SETS TO THE CITY FOR THEIR REVIEW. DO NOT FABRICATE TRUSSES UNTIL REVIEWED SHOP DRAWINGS AND CALCULATIONS HAVE BEEN APPROVED BY THE CITY. SHEARWALLS AT THE FIRST FLOOR ARE VERY HIGHLY STRESSED. ONLY (1) 12"X12" OR (2) 8"X8" PENETRATIONS PER SHEARWALL, NO PENETRATIONS IN 3) DESIGN FLOOR LOADS (MIN) SHEARWALLS LESS THAN 4 FT WIDE, PENETRATIONS THROUGH SHEARWALLS DATE 8-31-00 SHALL BE BLOCKED W/ 4x SOLID MEMBERS AND EDGE NAILED W/ 10d DL = 20 PSF COMMON • 4" @C. ALL PENETRATIONS ARE TO BE BETWEEN STUD. DO NOT CUT STUDS TO CREATE PENETRATIONS. THE EDGE OF ANY PENETRATION PARTITION LOAD = 20 PSF SCALE |"=1'-0" TOTAL DL = 40 PSF LIVE LOAD . 50 PSF TYP. SHALL BE 18" FROM THE SIDE AND 36" FROM THE TOP OR BOTTOM OF THE 6) SEE S2.0 FOR SHEARWALL DESIGNATIONS AT FIRST FLOOR WALLS. DRAWN JMW 100 PSF AT EXIT 4) DESIGN DEFLECTION FOR FLOOR FRAMING 1) DESIGN, DIMENSIONS, AND ELEVATIONS FOR CANOPIES AND STAIRS PER STRUCTURAL DRAWINGS (SOO THROUGH SOO) UNLESS OTHERWISE NOTED ON SHEETS SOO THROUGH AND JOB B0121  $\Delta$  = L/360 FOR TL ENTIRE PLAN REVISED FOR CONSTRUCTION WITH WOOD STUDS INSTEAD OF METAL STUDS. 1 = L/600 FOR LL 8) SHOP DRAWINGS ARE REQUIRED FOR ALL STRUCTURAL STEEL. SEE SOO FOR SPECIFICATION. 5-1.0

24-

8 ---

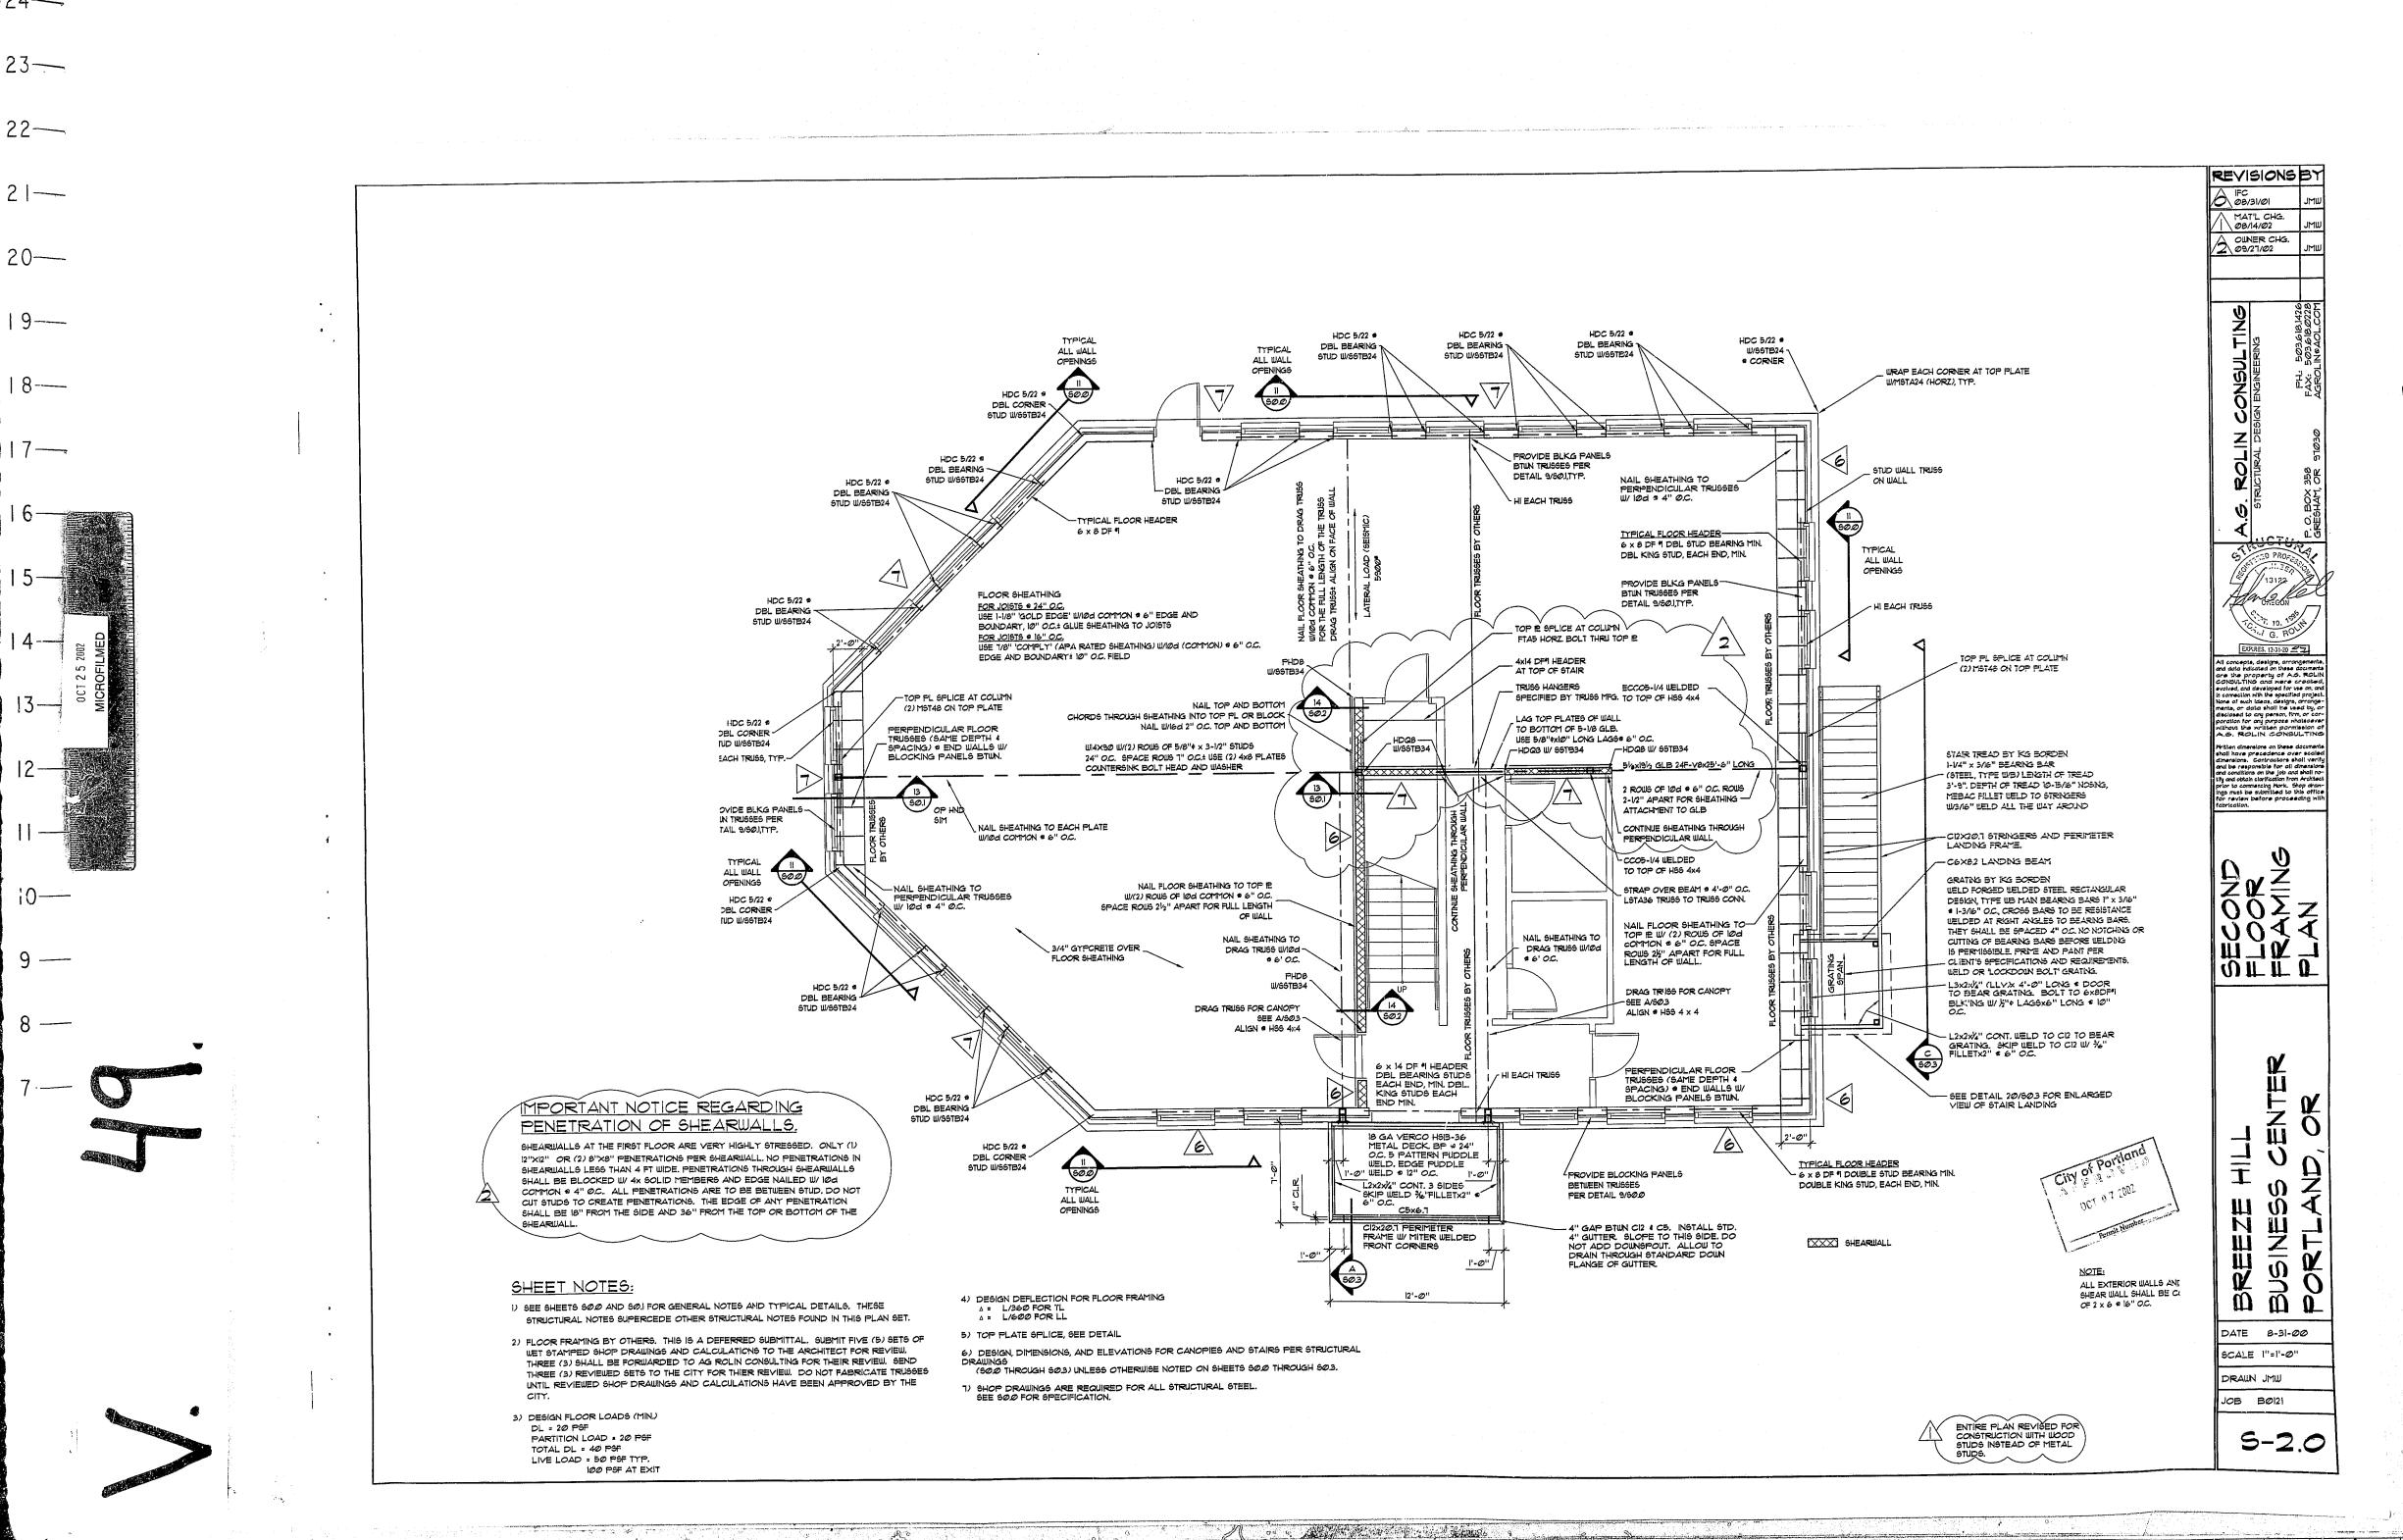

--22

--20

—I 8

-- I 6 -- I 5


---1 **4** ----13

-12

---10 ----9

-...-8 -----7

7

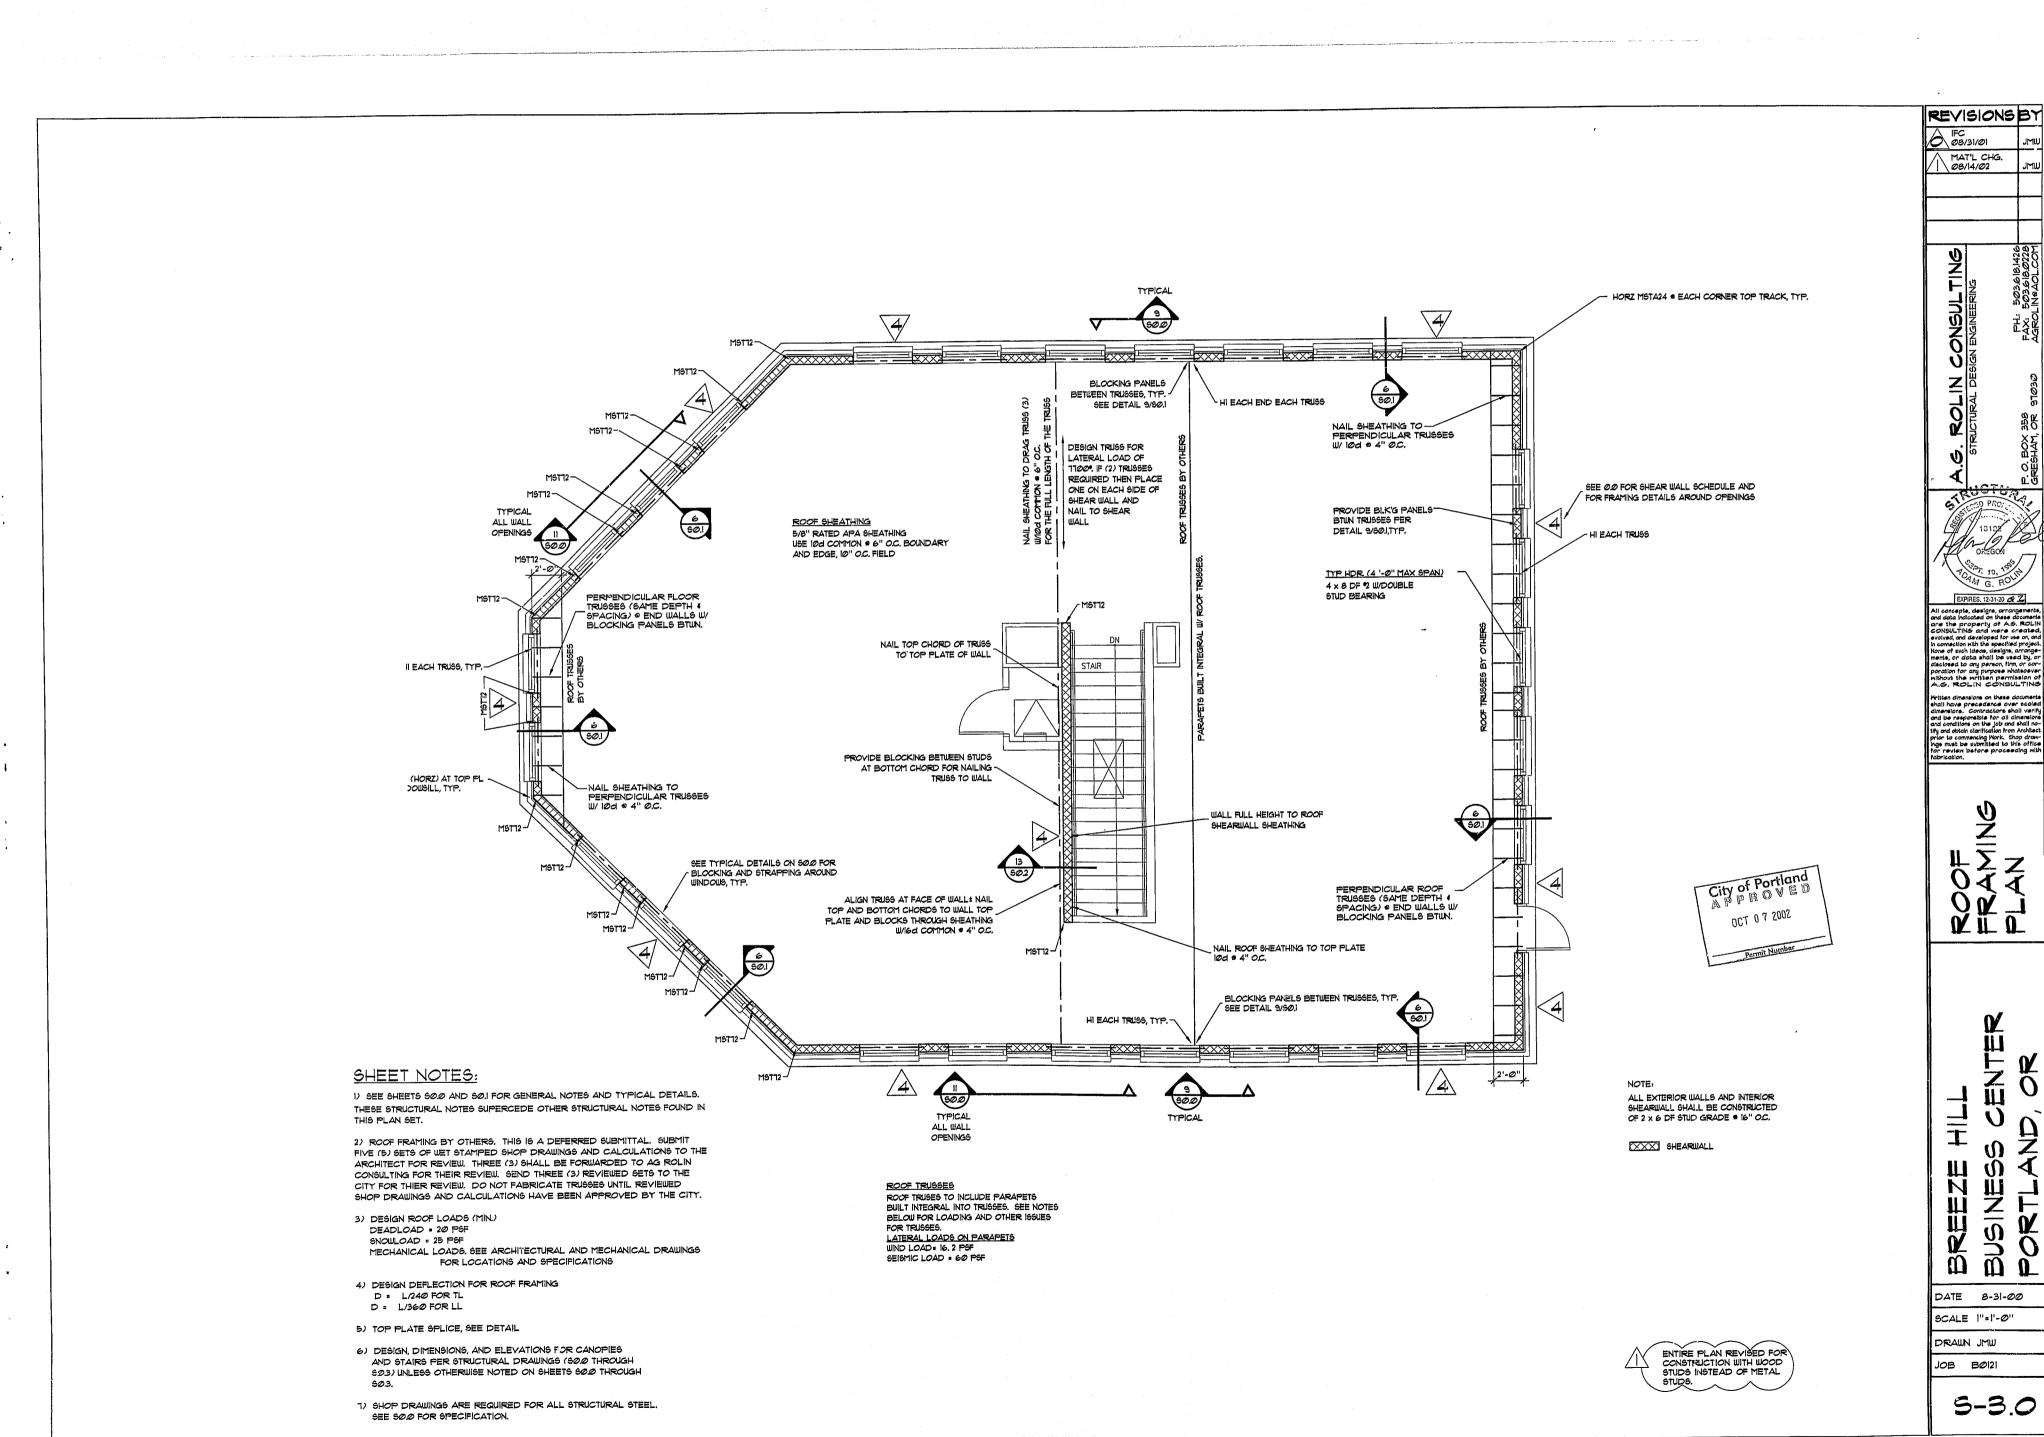

\_\_\_22

<u>---21</u>

<del>---</del>16