

**City of Portland, Oregon - Bureau of Development Services**1900 SW Fourth Avenue • Portland, Oregon 97201 | 503-823-7300 | www.portlandoregon.gov/bds**Permit Revision Submittal Requirements and Application**

A Permit Revision is required when there are proposed changes to the project after the permit has been issued. This may arise due to discrepancies between the city-approved permit drawings and actual field conditions, or the customer has changed their mind about an aspect of the project. In all cases, a revision to the existing permit must be submitted, reviewed and approved.

Applicants will provide:☒ A copy of this application☒ Three (3) sets of plans that clearly reflect the proposed change(s).

Drawings and calculations must be stamped and signed by the Architect and/or the Engineer of Record, if applicable.

☒ One (1) copy of the original city approved permit drawings. (NOTE: If your project has an assigned process manager please contact them regarding submittal of the revision).☐ Two (2) sets of calculations, if applicable☐ Inspector's correction notice, if revision is due to an inspection correction☒ Revision fee (paid at time of submittal)**Contact Information:**Contact name DAVID MULLENSAddress 735 SW 158TH AVECity BEAVERTONState ORZip Code 97006Phone 360-518-6985Email DAVID.L.MULLENS@GMAIL.COMValue of proposed revision -0-Issued permit # 17-10954260Job site address 1475 SE 14TH AVE

Description of revision ADD FIRE RISER ROOM IN THE RETAIL AREA AND
RELOCATE ELEVATION EQUIP ROOM TO BIKE ROOM

Fees:

The Permit Revisions are subject to fees associated with plan review, processing and any increase in project value. Additional fees may apply if adding plumbing fixtures.

The Bureau of Development Services fee schedule is available under the fees tab on the BDS web site at: www.portlandoregon.gov/bds. Fees are updated annually on July 1st.

Helpful Information:**Bureau of Development Services**

City of Portland, Oregon

1900 SW 4th Avenue, Portland, OR 97201

www.portlandoregon.gov/bds**Submit your plans in person to:**

Development Services Center (DSC), First Floor,
 For Hours Call 503-823-7310

Important Telephone Numbers:

BDS main number 503-823-7300

DSC automated information line 503-823-7310

Building code information 503-823-1456

BDS 24 hour inspection request line 503-823-7000

Residential information for

one and two family dwelling 503-823-7388

General Permit Processing and

Fee Estimate info 503-823-7357

City of Portland TTY 503-823-6868

ROOM OCCUPANT LOAD :

ROOM NAME	ROOM NAME
OCC: R-2	OCCUPANCY CLASSIFICATION
AREA: 884 SF	ROOM AREA
FACT: 200	OCCUPANCY LOAD FACTOR
LOAD: 5	OCCUPANT LOAD

OCCUPANT LOAD AT EGRESS COMPONENT:

DOOR	OCCUPANT LOAD AT DOOR
1/2 OF 128 - CORRIDOR	EGRESS COMPONENT
18'-32"	SOURCE FOR LOAD
	OCCUPANT LOAD CALCULATION
	EGRESS CLEAR WIDTH PROVIDED
	EGRESS CLEAR WIDTH REQUIRED

FIRE & LIFE SAFETY LEGEND

---	FIRE RATED BARRIER (1 HR)	▨	EGRESS ROUTE
---	FIRE RATED BARRIER (2 HR)	▨	EXIT ENCLOSURE
---	FIRE RATED BARRIER (3 HR)	▨	EXIT PASSAGEWAY
---	FIRE RATED PARTITION (1 HR)	▨	2HR RATED FLOOR/CEILING ASSEMBLY
---	FIRE RATED ASSEMBLY (1 HR)		
---	FIRE RATED ASSEMBLY (2 HR)		
---	FIRE RATED ASSEMBLY (3 HR)		

FEC	FIRE EXTINGUISHER CABINET	10	EXIT LOAD
⊗	EXIT SIGNAGE WITH EMERGENCY EGRESS LIGHTING, REF ELEC DRAWINGS	E	TACTILE EXIT SIGN
		PH	PANIC HARDWARE

SHEET NOTES

- A. REFER TO SHEET G0.11 FOR GENERAL FIRE AND LIFE SAFETY NOTES.
B. REFER TO FS PERMIT FOR ADDITIONAL FIRE SUPPRESSION PER APPEAL 15065

KEYNOTES

G301	NO OCCUPANCY THIS PERMIT. SEPARATE BUILDING PERMIT REQUIRED FOR TENANT IMPROVEMENTS. PERMIT SHALL INCLUDE, BUT BE LIMITED TO, EGRESS COMPONENT, LIGHTING, AND PLUMBING ELEMENTS.
G304	OVERHEAD SMOKE CONTAINMENT SYSTEM
G306	PROVIDE SIGNAGE INDICATING STAIRWAY CONTINUES TO ROOF
G314	EXTERIOR WALL TO BE FIRE RESISTANT RATED FROM EXPOSURE ON BOTH SIDES PER OSSC 705.5. SEE FLOOR PLANS AND ASSEMBLY SHEETS.
G315	1-HOUR WRAPPED STEEL COLUMN
G316	PROVIDE 2-HR LID AT EXIT.

MGA
MYHRE GROUP ARCHITECTS

620 SW 5th Avenue, Suite 500 Portland, Oregon 97204
1.503.238.0000 1.503.238.7500 www.myhregroup.com

REGISTERED ARCHITECT
ERIK M. PETERSEN
6636
PORTLAND, OR
STATE OF OREGON

© MYHRE GROUP ARCHITECTS, INC.
THESE DRAWINGS ARE THE PROPERTY OF MYHRE GROUP ARCHITECTS AND ARE NOT TO BE REPRODUCED IN ANY MANNER WITHOUT THE WRITTEN APPROVAL OF MYHRE GROUP ARCHITECTS

PERMIT REVIEW SET

SE 14TH &
HAWTHORNE
APARTMENTS

URBAN DEVELOPMENT
GROUP

△	DATE	FILE
1	2017/05/05	AHJ 01
3	2017/07/17	AHJ 02
5	2018/02/14	ASI 02
9	2018/12/13	ASI 06

PIC:
PM: ERIK PETERSEN
JC: JIM STADICK
DRAWN BY: JS
JOB NO: 161150
DATE: 2017.01.13

G3.20
FIRE, LIFE
SAFETY PLANS

A1 FIRE, LIFE SAFETY PLAN-FIRST FLOOR

G3.20 SCALE: 1/8" = 1'-0"

A4 FIRE, LIFE SAFETY PLAN-SECOND TO FOURTH FLOOR

G3.20 SCALE: 1/8" = 1'-0"

SHEET NOTES

- A. REFER TO SHEET G1.10 FOR GENERAL FLOOR PLAN NOTES.
- B. WINDOW DIMENSIONS ARE TO CENTERLINE OF OPENING, TYP. UNLESS OTHERWISE NOTED.
- C. UNIT DEMISING AND CORRIDOR WALLS TO BE CONSTRUCTED AS ASSEMBLY A, UNLESS OTHERWISE NOTED.
- D. DIMENSIONS CONTAINING THE NOTE 'MAS' ARE TO FACE OF MASONRY.

KEYNOTES

- 109 HIGH SPEED REMOTE CONTROL OPERATED OVERHEAD DOOR. PROVIDE AUTOMATIC ALARM WITH AN AUDIOVISUAL WARNING SYSTEM INSTALLED ON THE EXTERIOR WALL ABOVE THE APPROACH TO WARM PEDESTRIANS OF EXITING VEHICLES. AND PREVENT BLOCKING OF PEDESTRIAN CORRIDOR. CROSS SLOPE AT DOOR BOTTOM SHALL NOT EXCEED 12 INCHES. REFER TO CIVIL AND ELECTRICAL DRAWINGS.
- 111 ALIGN FINISH FACES.
- 202 SLOPE AND CROSS SLOPE NOT TO EXCEED 2%. COORDINATE WITH CIVIL
- 205 LONG-TERM BICYCLE STORAGE RACKS. 2'-0" X 3'-8" CLEAR STALL AREA PER BIKE. PROVIDE IMPACT RESISTANT SURFACE AT ALL WALL MOUNTED BIKE STORAGE LOCATIONS, TYP.
- 206 TENANT MAILBOXES. VERIFY QUANTITY AND DIMENSIONS, TYP. HIGHEST DOOR TO BE LOCATED NOT MORE THAN 48" MAX. AFF TO CENTERLINE OF ACCESS DOOR
- 207 FLOOR DRAIN, SEE PLUMBING DRAWINGS. SLOPE FLOOR TO DRAIN
- 210 STANDING UTILITY SINK. SEE PLUMBING DRAWINGS
- 213 PROPOSED LOCATION FOR TENANT CALL BOX WITH KEYLESS ENTRY, (DESIGN BUILT - BY OTHERS)
- 215 CLEAR ANODIZED ALUMINUM STOREFRONT SYSTEM, TYP
- 222 GRAB BARS. SEE ACCESSIBILITY DIAGRAMS
- 238 ACCESSIBLE WATER CLOSET, REFER TO PLUMBING DESIGN/BLDG DRAWINGS AND G SERIES
- 243 ROOF SCUPPER AND DOWNSPOUT, PTD TO MATCH TYP. REFER TO ROOF DETAILS FOR LOCATIONS AND CIVIL DRAWINGS FOR DOWNSPOUT CONNECTIONS
- 254 PER 2016 OFC SECTION 509, ROOMS CONTAINING CONTROLS FOR AIR-CONDITIONING SYSTEMS, SPRINKLER RISERS AND VALVES, OR OTHER FIRE DETECTION, SUPPRESSION OR CONTROL ELEMENTS SHALL BE IDENTIFIED FOR THE USE OF THE FIRE DEPARTMENT. APPROVED SIGNS REQUIRED TO IDENTIFY FIRE PROTECTION EQUIPMENT AND EQUIPMENT LOCATION SHALL BE CONSTRUCTED OF DURABLE MATERIALS, PERMANENTLY INSTALLED AND READILY VISIBLE
- 255 KNOX BOX. LOCATION AND MODEL PER FIRE MARSHAL
- 256 PROVIDE INTUMESCENT PAINT (DEFERRED SUBMITTAL), PROVIDE THICKNESS AS REQUIRED TO OBTAIN 2-HR RATING.
- 258 PACKAGE CONCIERGE SYSTEM (BY OTHERS)
- 1014 DASHED LINE INDICATES APPROXIMATE OUTLINE OF ADJACENT BUILDING.
- ACC05 60" DIAMETER TURNAROUND SPACE OR T-SHAPED TURNING SPACE, AT LEAST ONE TOILET AND BATHING FACILITY WITHIN EACH TYPE A UNIT SHALL COMPLY. DOORS ARE PERMITTED TO SWING INTO TURNING SPACE
- ACC24 56" x 60" CLEAR FLOOR SPACE AT TOILET - TYPE 'A' UNIT
- G303 FIRE DEPARTMENT CONNECTION. PROVIDE SIGNAGE IDENTIFYING CONNECTION. SIGNAGE TO BE VISIBLE FROM R.O.W.

MGA
MYHRE GROUP ARCHITECTS

620 SW 5th Avenue, Suite 500 Portland, Oregon 97204
1.503.236.6000 1.503.236.7500 www.myhregroup.com




© MYHRE GROUP ARCHITECTS, INC.
THESE DRAWINGS ARE THE PROPERTY OF MYHRE GROUP ARCHITECTS AND ARE NOT TO BE REPRODUCED IN ANY MANNER WITHOUT THE WRITTEN APPROVAL OF MYHRE GROUP ARCHITECTS


PERMIT REVIEW SET

SE 14TH &
HAWTHORNE
APARTMENTS

URBAN DEVELOPMENT
GROUP

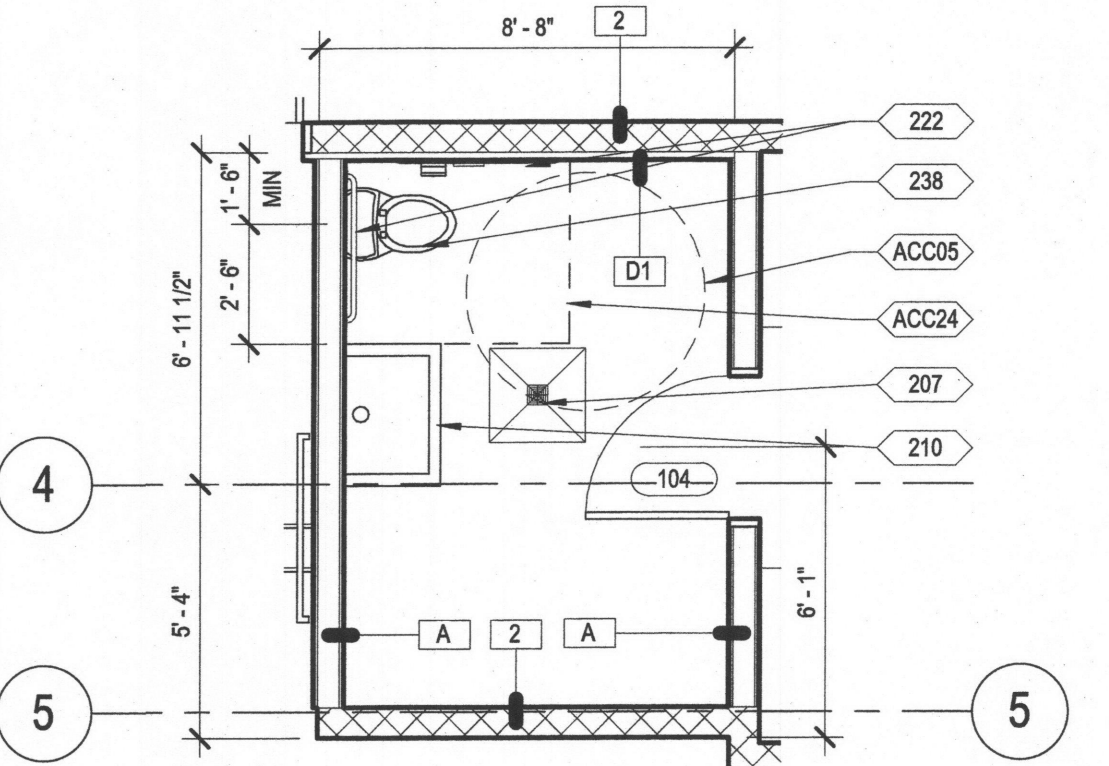

B5 ENLARGED RESTROOM/JANITOR PLAN
SCALE: 1/4" = 1'-0"

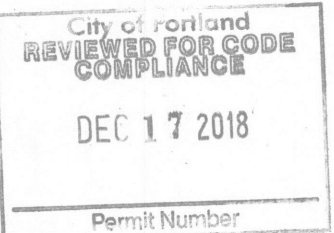

A1 FIRST FLOOR PLAN
A2.10 SCALE: 1/8" = 1'-0"

A2.10
FIRST FLOOR
PLAN

SHEET NOTES

A. REFER TO SHEET G0.10 FOR GENERAL REFLECTED CEILING PLAN NOTES.

REFLECTED CEILING PLAN LEGEND

- DROP CEILING/SOFFIT. HEIGHT 8'-9" AFF IN CORRIDORS UNLESS OTHERWISE NOTED.
- UNIT DROP CEILING/SOFFIT. REFER TO A5.20 SERIES FOR UNIT REFLECTED CEILING PLANS.
- INTERIOR - 3X DECKING IN CORRIDOR, REFER TO G6.00 SERIES FOR ASSEMBLY INFORMATION.
- GYPSUM BOARD CEILING TIGHT TO STRUCTURE, UNLESS OTHERWISE NOTED. REFER TO G6.00 SERIES FOR ASSEMBLY TYPES.
- EXTERIOR - T&G WOOD SOFFIT, TIGHT TO STRUCTURE, UNLESS OTHERWISE NOTED.
- MAINTAIN 8'-2" CLEAR WITHIN THIS AREA

* REFER TO ARCHITECTURAL SYMBOLS AND ABBREVIATIONS SHEET FOR SYMBOLS NOT SHOWN IN LEGEND

KEYNOTES

- 414 PROVIDE INTUMESCENT PAINT (DEFERRED SUBMITTAL). PROVIDE THICKNESS AS REQUIRED TO OBTAIN 2-HR RATING. GYP WRAP TO MATCH FINISH OF OTHER STEEL MEMBER.

MGA
MYHRE GROUP ARCHITECTS

620 SW 8th Avenue, Suite 500 Portland, Oregon 97204
1.503.236.6000 F 503.236.7500 www.myhregroup.com



© MYHRE GROUP ARCHITECTS, INC.
THESE DRAWINGS ARE THE PROPERTY
OF MYHRE GROUP ARCHITECTS AND
ARE NOT TO BE REPRODUCED IN
ANY MANNER WITHOUT THE
PRIOR WRITTEN APPROVAL OF MYHRE
GROUP ARCHITECTS

PERMIT REVIEW
SET

SE 14TH &
HAWTHORNE
APARTMENTS

URBAN DEVELOPMENT
GROUP

△	DATE	FILE
1	2017/05/05	AHJ 01
3	2017/07/7	AHJ 02
5	2018/02/14	ASI 02
9	2018/12/13	ASI 06

PIC:
PM: ERIK PETERSEN
JC: JIM STADICK
DRAWN BY: JS
JOB NO: 161150
DATE: 2017.01.13

A4.10
FIRST FLOOR
RCP


A1 FIRST FLOOR REFLECTED CEILING PLAN
A4.10 SCALE: 1/8" = 1'-0"

KEYNOTES


111	ALIGN FINISH FACES.
217	36" X 96" LOCKABLE 90 MINUTE FIRE-RESISTANCE-RATED ROOF ACCESS HATCH AND GUARDRAIL SYSTEM. SEE A14 SERIES
251	PROVIDE STANDPIPE. TO MEET PFC 905 AND NFPA 14 REQUIREMENTS. STANDPIPE INFORMATION ABOVE ROOF. SEE FIRE SPRINKLER DIAGRAM (DESIGN-BUILD) SEE ROOF DETAILS SHEET FOR THROUGH ROOF FLASHING INFORMATION
1014	DASHED LINE INDICATES APPROXIMATE OUTLINE OF ADJACENT BUILDING.
1305	80" MINIMUM CLEAR OVERHEAD AT STAIRS, TYP
1315	PAINTED METAL HANDRAIL.
1316	FULL HEIGHT STAIR SEPARATION WALL.
1317	WOOD STAIR.

SHEET NOTES


A. REFER TO SHEET G0.10 FOR GENERAL VERTICAL CIRCULATION NOTES.

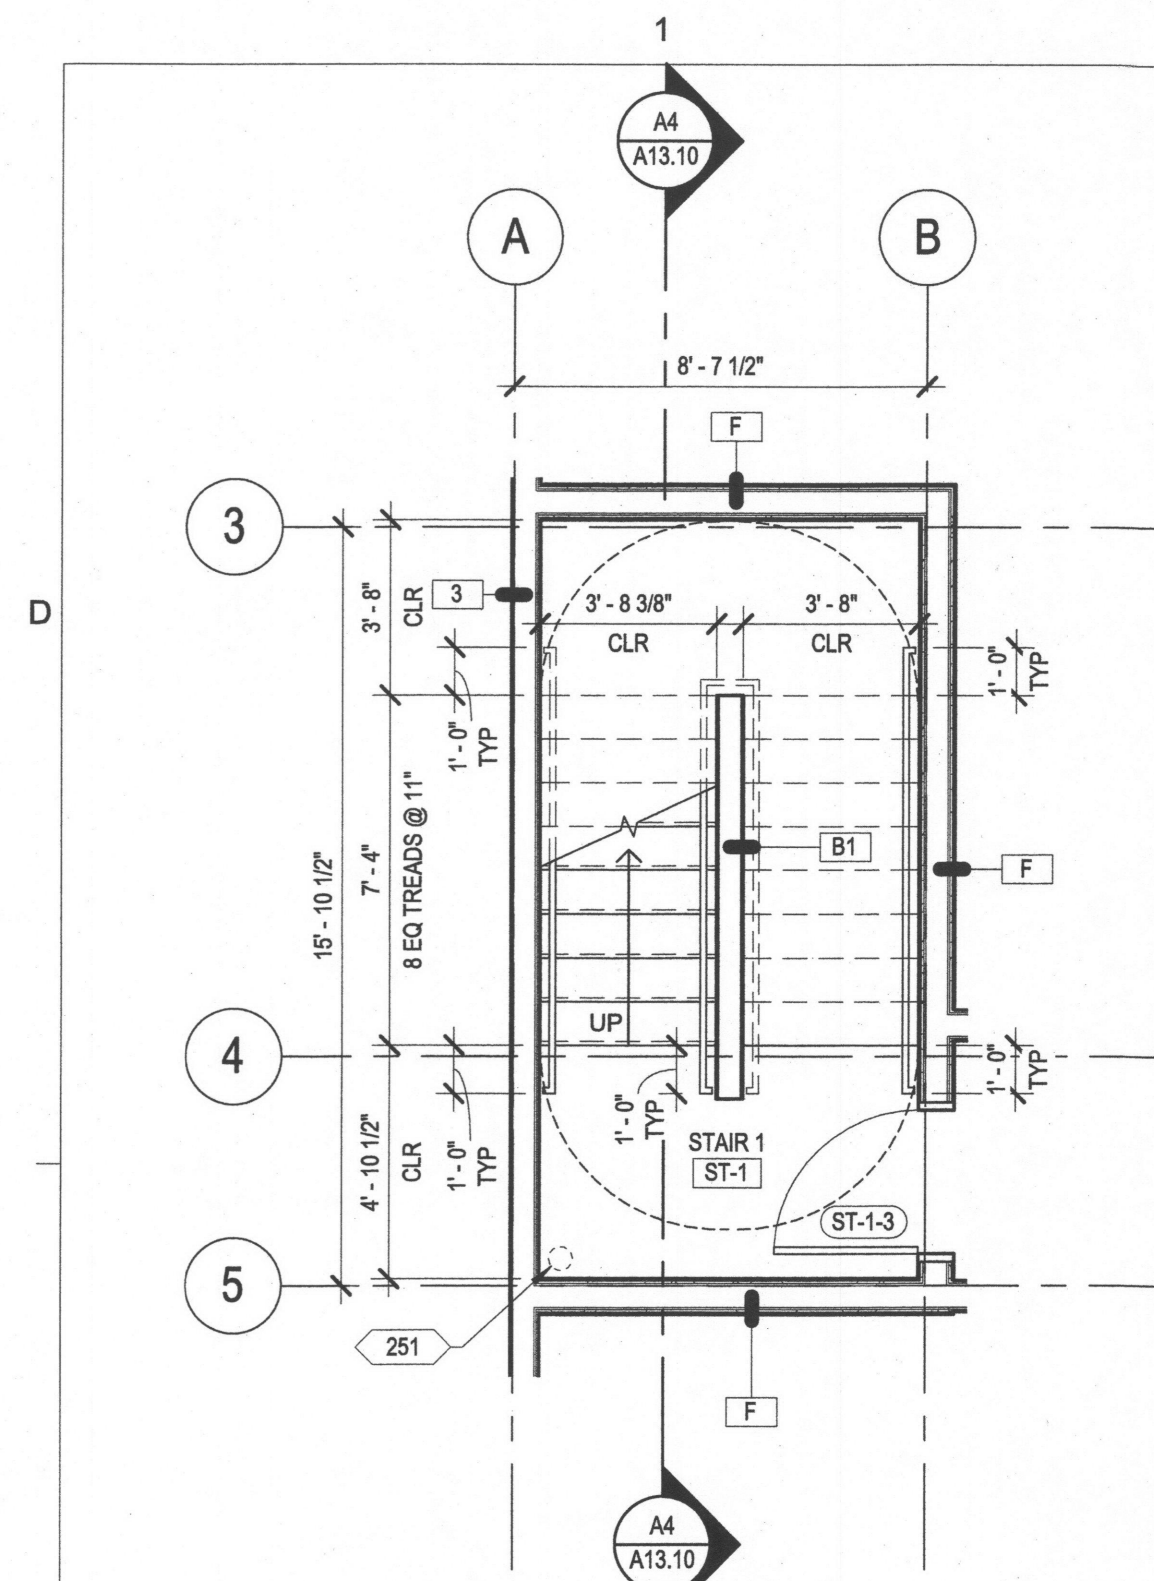


C1 STAIR 1 - THIRD FLOOR
A13.10 SCALE: 1/4" = 1'-0"

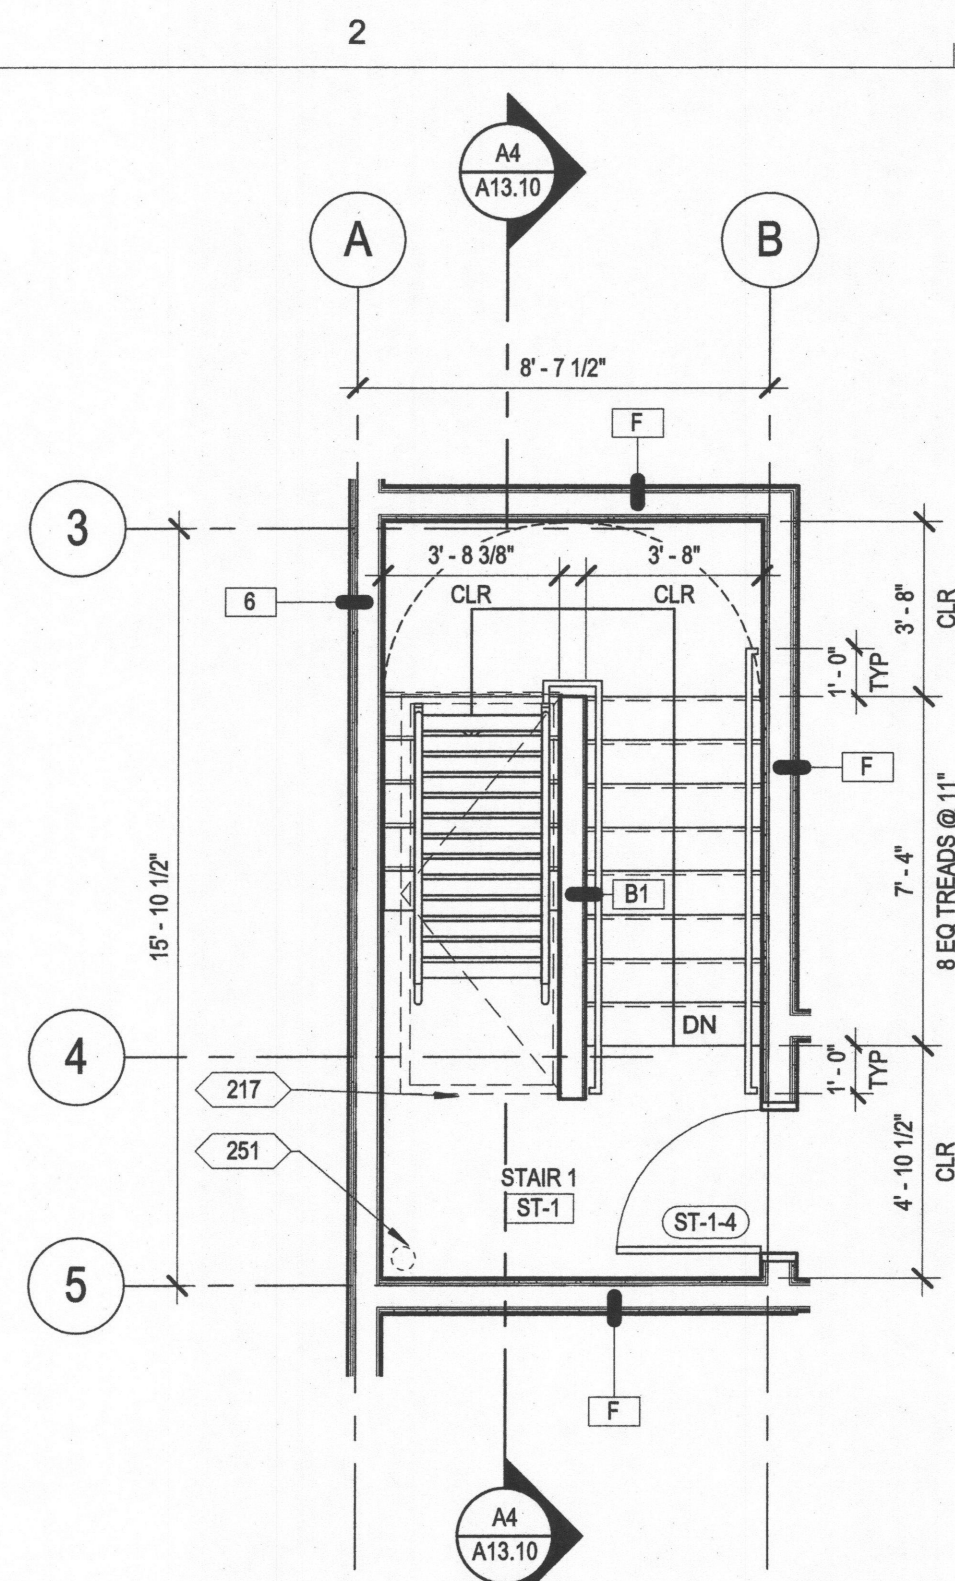


STAIR 1 - FOURTH FLOOR

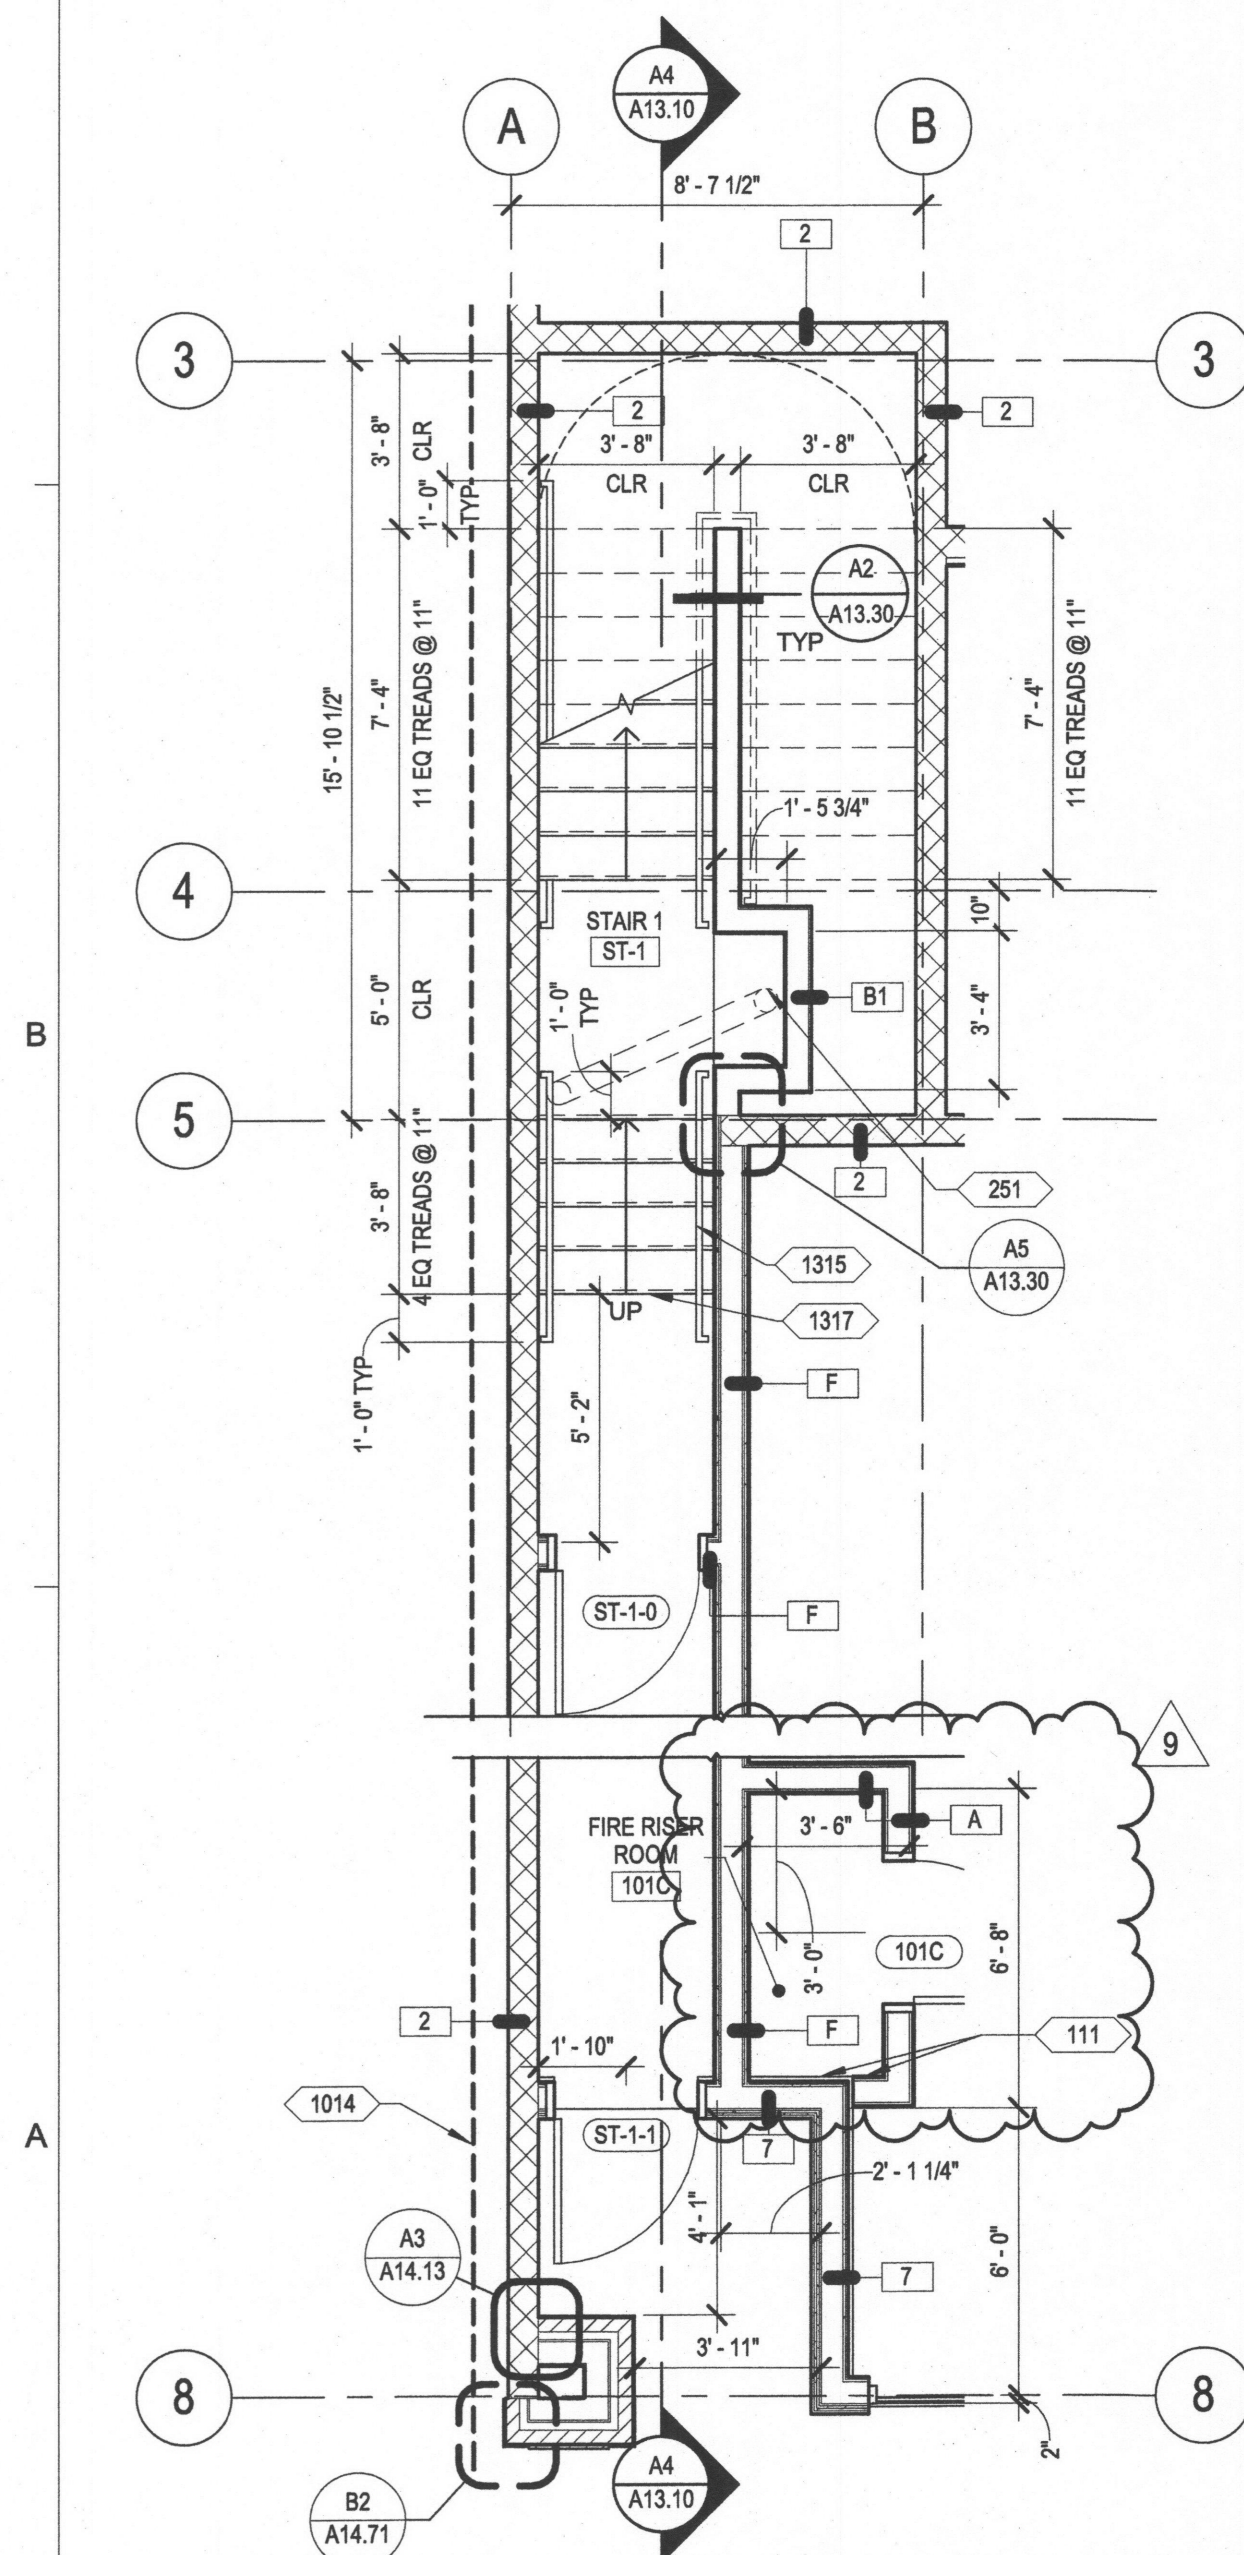

STAIR 1 - FIRST FLOOR
SCALE: 1/4" = 1'-0"

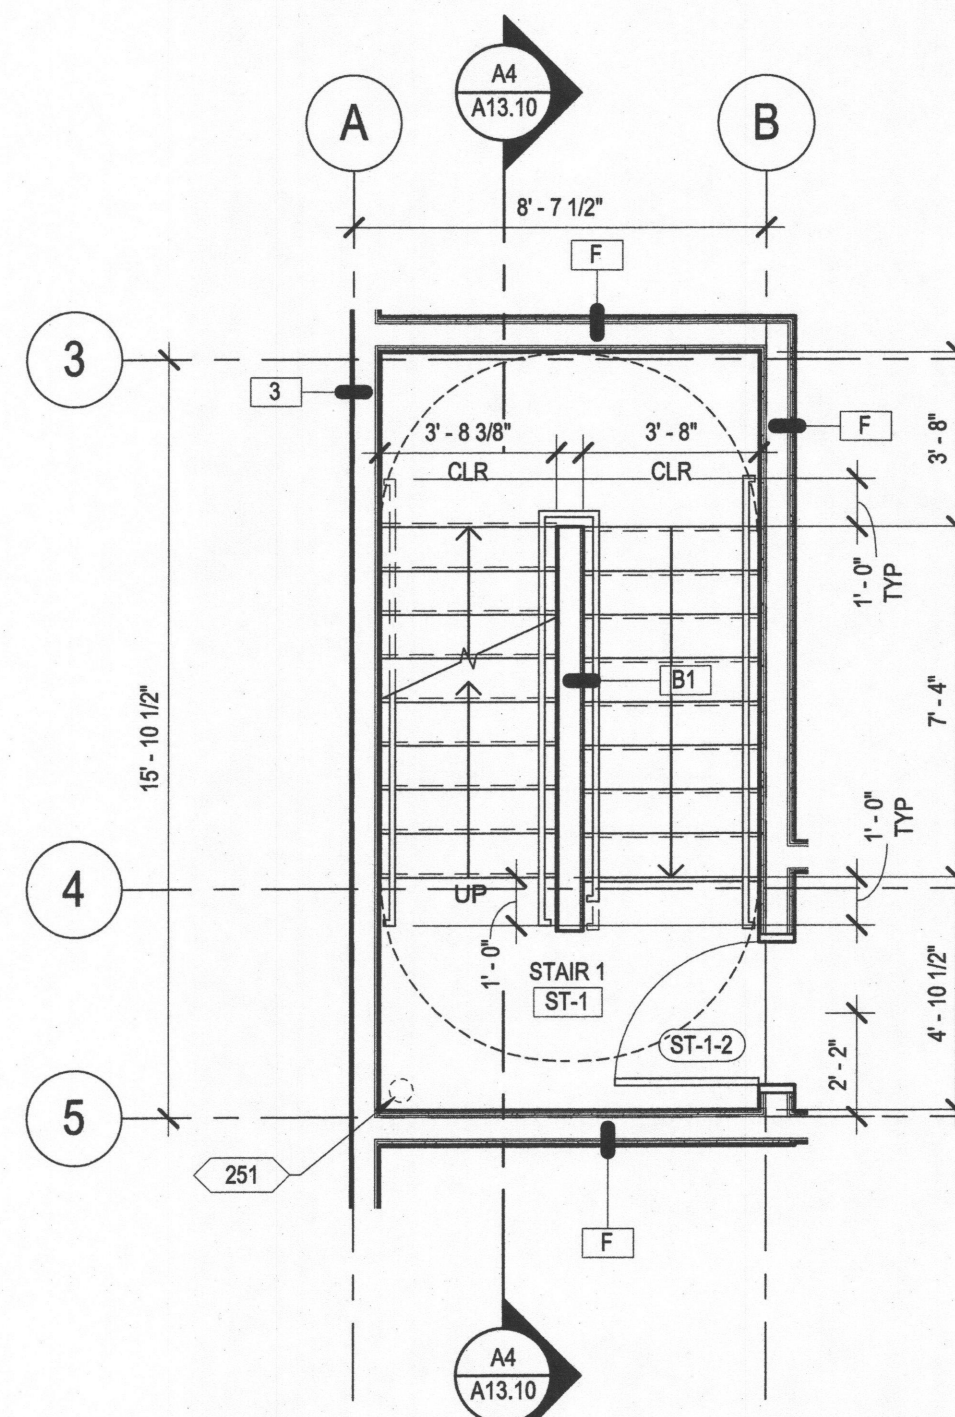

STAIR 1 - SECOND FLOOR
SCALE: 1/4" = 1'-0"

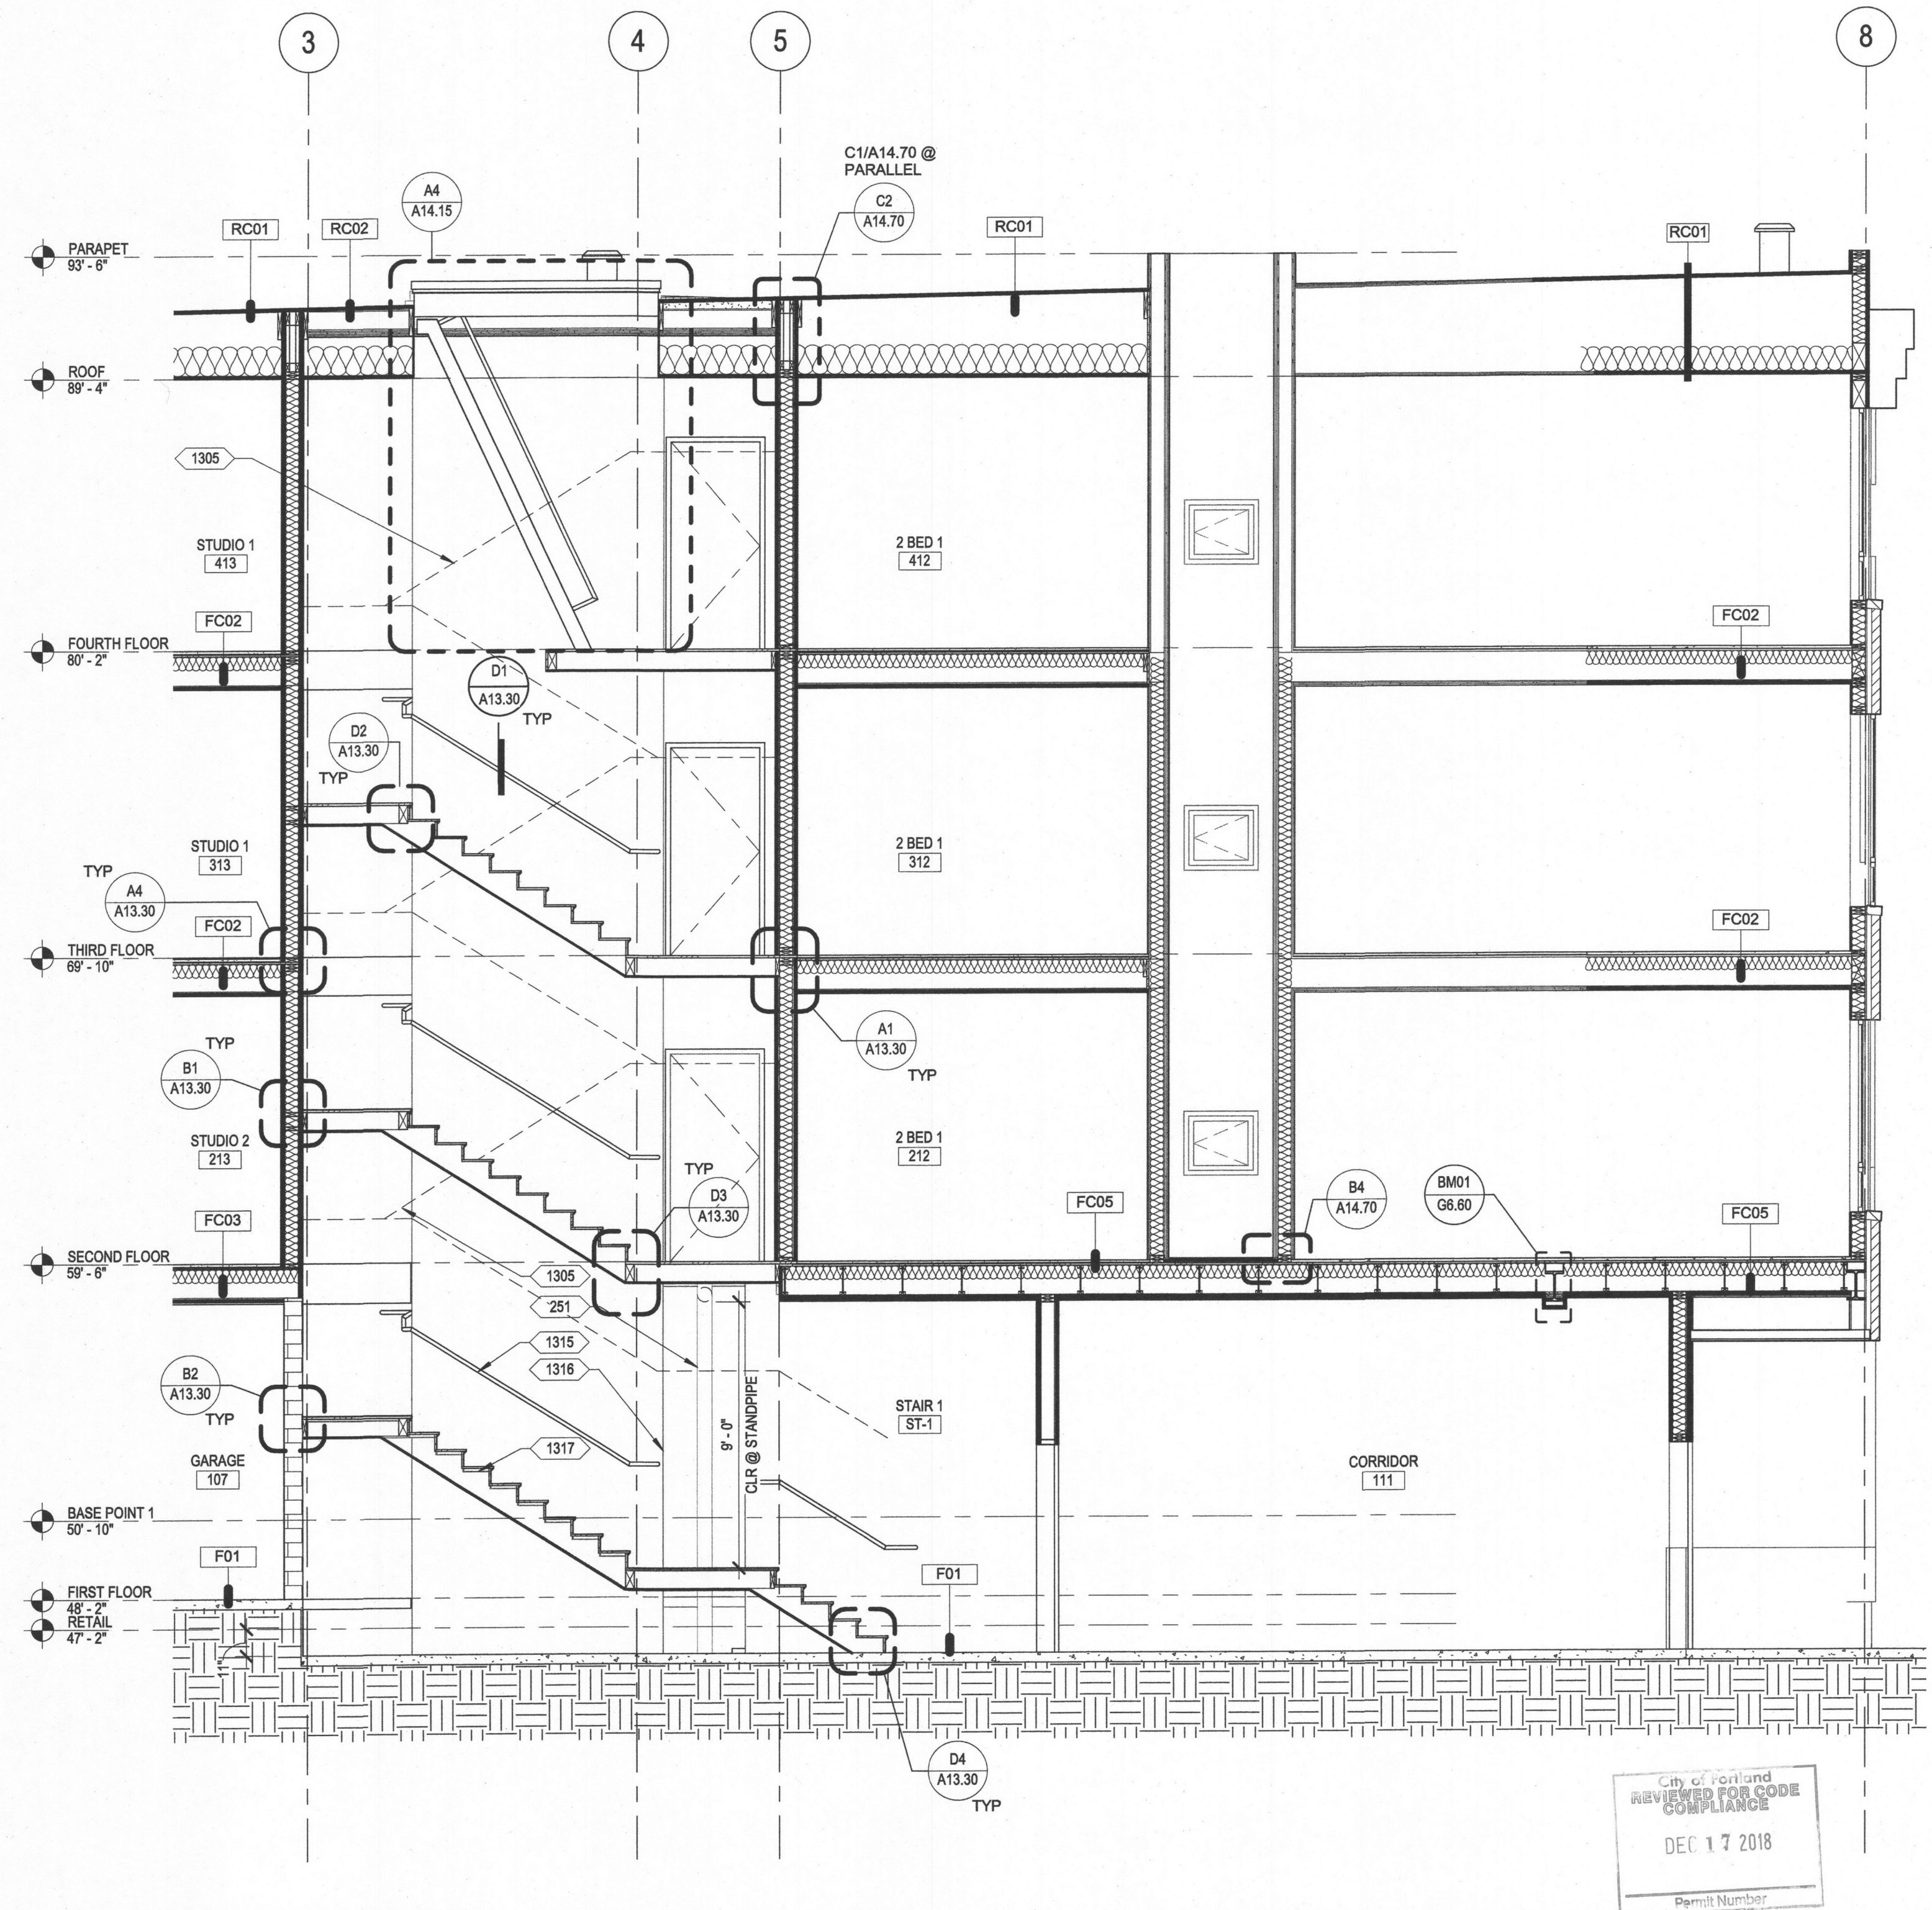

STAIR 1 - SECTION
A4
A13.10 SCALE: 1/4" = 1'-0"

ERMIT REVIEW
SET

SE 14TH &
SAWTHORNE
APARTMENTS

**URBAN DEVELOPMENT
GROUP**

DATE	FILE
2017/05/05	AHJ 01
2018/12/13	ASI 06

NAME:	ERIK PETERSEN
NAME:	JIM STADICK
DRAWN BY:	JS
JOB NO:	161150
DATE:	2017.01.13

A13.10

VERTICAL CIRCULATION - STAIRS PLANS & SECTIONS

A. REFER TO SHEET G0.10 FOR GENERAL VERTICAL CIRCULATION NOTES.

City of Portland
REVIEWED FOR CODE
COMPLIANCE
DEC 17 2018
Permit Number

A13.11 SCALE: 1/4" = 1'-0"

VERTICAL CIRCULATION - STAIR PLANS & SECTIONS

D

C

B

A

DOOR SCHEDULE

DOOR NUMBER	ROOM LOCATION	DOOR								FRAME			HDW GROUP	FIRE RATING	DOOR SCHEDULE REMARK REFERENCE NUMBER	REVISION NUMBER
		WIDTH	HEIGHT	THICK.	MATL	FINISH	TYPE	GLASS	MATL	FINISH	TYPE					
RETAIL																
101A	COMMERCIAL	3'-0"	6'-11"	2"	ALUM	PREFIN	F	SG	ALUM	PREFIN	-	1	-			5
101B	COMMERCIAL	3'-0"	6'-11"	2"	ALUM	PREFIN	F	SG	ALUM	PREFIN	-	1	-			5
101C	COMMERCIAL	3'-0"	7'-0"	1 3/4"	MTL	PAINT	K	-	HM	PAINT	-	2	-			9
ST-1-0	CORRIDOR	3'-0"	7'-0"	1 3/4"	HM	PAINT	J	-	HM	PAINT	-	-		90 MIN		5
ST-1-1	CORRIDOR	3'-0"	7'-0"	1 3/4"	HM	PAINT		-	HM	PAINT	-	1		20 MIN		5
FIRST FLOOR																
102A	LOBBY	3'-6"	7'-0"	1 3/4"	ALUM	PREFIN	F	SG	ALUM	PREFIN	-	1	-			5
102B	LOBBY	3'-0"	7'-0"	1 3/4"	HM	PAINT	J	-	HM	PAINT	-	1		20 MIN	15	5
103	BIKE STORAGE	3'-0"	7'-0"	1 3/4"	HM	PAINT	J	-	HM	PAINT	-	2		20 MIN	15	5
104	JANITOR	3'-0"	7'-0"	1 3/4"	MTL	PAINT	K	-	HM	PAINT	-	2				5
105	BOILER	3'-0"	7'-0"	1 3/4"	HM	PAINT		-	HM	PAINT	-	2		45 MIN		5
106	ELEV EQUIPMENT	3'-0"	7'-0"	1 3/4"	HM	PAINT	K	-	HM	PAINT	-	2		90 MIN		5
107	COMMERCIAL	3'-0"	7'-0"	1 3/4"	HM	PAINT	J	-	HM	PAINT	-	2		20 MIN		5
107A	GARAGE	3'-0"	7'-0"	1 3/4"	HM	PAINT	K	-	HM	PAINT	-	1	-			5
108	ELECTRICAL EQUIPMENT/DATA	3'-0"	7'-0"	1 3/4"	HM	PAINT	K	-	HM	PAINT	-	2		20 MIN	5	5
109	TRASH/RECYCLING	6'-0"	7'-0"	1 3/4"	HM	PAINT	H	-	HM	PAINT	-	2		45 MIN	5,15	5
110	FDC	3'-0"	7'-0"	1 3/4"	HM	PAINT	K	-	HM	PAINT	-	2		20 MIN		5
139	GARAGE	16'-0"	7'-0"	2"	ALUM	PREFIN	L	-	ALUM	PREFIN	-	-	-		13	5
EL-1	ELEV	3'-6"	7'-0"	2"	HM	SS	-	-	HM	SS	-	-	-	90 MIN		5
ST-2-0	STAIR 2	3'-0"	7'-0"	1 3/4"	HM	PAINT	K	-	HM	PAINT	-	-	-	20 MIN		5
ST-2-1	STAIR 2	3'-0"	7'-0"	1 3/4"	HM	PAINT	J	-	HM	PAINT	-	8		90 MIN	3, 5	5
SECOND FLOOR																
EL-2	ELEV	3'-6"	7'-0"	2"	HM	SS	-	-	HM	SS	-	-	-	90 MIN		5
ST-1-2	STAIR 1	3'-0"	7'-0"	1 3/4"	HM	PAINT	J	-	HM	PAINT	-	8		90 MIN	3, 5	5
ST-2-2	STAIR 2	3'-0"	7'-0"	1 3/4"	HM	PAINT	J	-	HM	PAINT	-	8		90 MIN	3, 5	5
THIRD FLOOR																
EL-3	ELEV	3'-6"	7'-0"	2"	HM	SS	-	-	HM	SS	-	-	-	90 MIN		5
ST-1-3	STAIR 1	3'-0"	7'-0"	1 3/4"	HM	PAINT	J	-	HM	PAINT	-	8		90 MIN	3, 5	5
ST-2-3	STAIR 2	3'-0"	7'-0"	1 3/4"	HM	PAINT	J	-	HM	PAINT	-	8		90 MIN	3, 5	5
FOURTH FLOOR																
EL-4	ELEV	3'-6"	7'-0"	2"	HM	SS	-	-	HM	SS	-	-	-	90 MIN		5
ST-1-4	STAIR 1	3'-0"	7'-0"	1 3/4"	HM	PAINT	J	-	HM	PAINT	-	8		90 MIN	3, 5	5
ST-2-4	STAIR 2	3'-0"	7'-0"	1 3/4"	HM	PAINT	J	-	HM	PAINT	-	8		90 MIN	3, 5	5

DWELING UNITS


DOOR NUMBER	ROOM NAME	WIDTH	HEIGHT	THICK.	MATL	FINISH	TYPE	GLASS	MATL	FINISH	TYPE	HDW GROUP	FIRE RATING	DOOR SCHEDULE REMARK REFERENCE NUMBER	REVISION NO
DU-1	UNIT ENTRY	3'-0"	7'-0"	1 3/4"	SC	PAINT	A	-	WD	PAINT	A	3	20 MIN	15	1
DU-3		2'-10"	7'-0"	1 3/4"	HC	PAINT	C	-	WD	PAINT			-		
DU-3G	UNIT INTERIOR	2'-10"	7'-0"	1 3/4"	HC	PAINT	N	-	WD	PAINT		4	-	15	1
DU-4	CLOSET	2'-6"	7'-0"	1 3/4"	HC	PAINT	C	-	WD	PAINT		6	-	15	1
DU-5		2'-0"	7'-0"	1 3/4"	HC	PAINT	C	-	WD	PAINT			-		
DU-9	CLOSET SLIDING	4'-0"	6'-8"	1 3/4"	HC	PAINT	D	-	WD	PAINT		12	-		
DU-10	CLOSET SLIDING	5'-0"	6'-8"	1 3/4"	HC	PAINT	D	-	WD	PAINT		12	-		
DU-13	CLOSET BIFOLD	2'-10"	6'-8"	1 3/4"	WD	PAINT	P	-	WD	PAINT		10	-		

DOOR SCHEDULE REMARKS:


- PROVIDE PANIC HARDWARE
- UNEVEN LEAF DOUBLE DOOR - 3'-0" & 1'-8" LEAFS.
- KICKPLATE
- PROVIDE MAGNETIC HOLD-OPEN TIED TO SMOKE DETECTION / ALARM SYSTEM
- SELF CLOSING
- PROVIDE SCREEN DOOR
- WITH TRANSOM WINDOW, REF FLOOR PLANS, REF A12.10.
- PEEP HOLE, TYPICAL HEIGHT: 56-64" ADA HEIGHT 43"
- INSULATED GARAGE DOOR WITH WINDOW INSERTS
- SMOKE AND DRAFT CONTROL ALL DOOR ASSEMBLIES IN CORRIDORS SHALL BE TESTED AND LABELED FOR SMOKE AND DRAFT CONTROL IN ACCORDANCE WITH UL 1784, OSSC SECTION 715.4.3.1 AND 715.4.6.3
- FIXED STOREFRONT PANEL WITH SAFETY GLASS.
- 4" FRAME HEAD & 7'-0" DOOR @ MASONRY
- HIGH SPEED REMOTE CONTROL OPERATED OVERHEAD DOOR. PROVIDE AUTOMATIC ALARM WITH AN AUDIO/VISUAL WARNING SYSTEM INSTALLED ON THE EXTERIOR WALL ABOVE THE APPROACH TO WARN PEDESTRIANS OF EXITING VEHICLES, AND PREVENT BLOCKING OF PEDESTRIAN CORRIDOR. CROSS SLOPE AT DOOR BOTTOM SHALL NOT EXCEED 12 INCHES. SEE CIVIL AND ELECTRICAL DRAWINGS
- PROVIDE VENT.
- ACCESSIBLE LEVER HARDWARE PROVIDED ON ACCESSIBLE ROUTE.

DOOR TYPES

UNIT DOORS

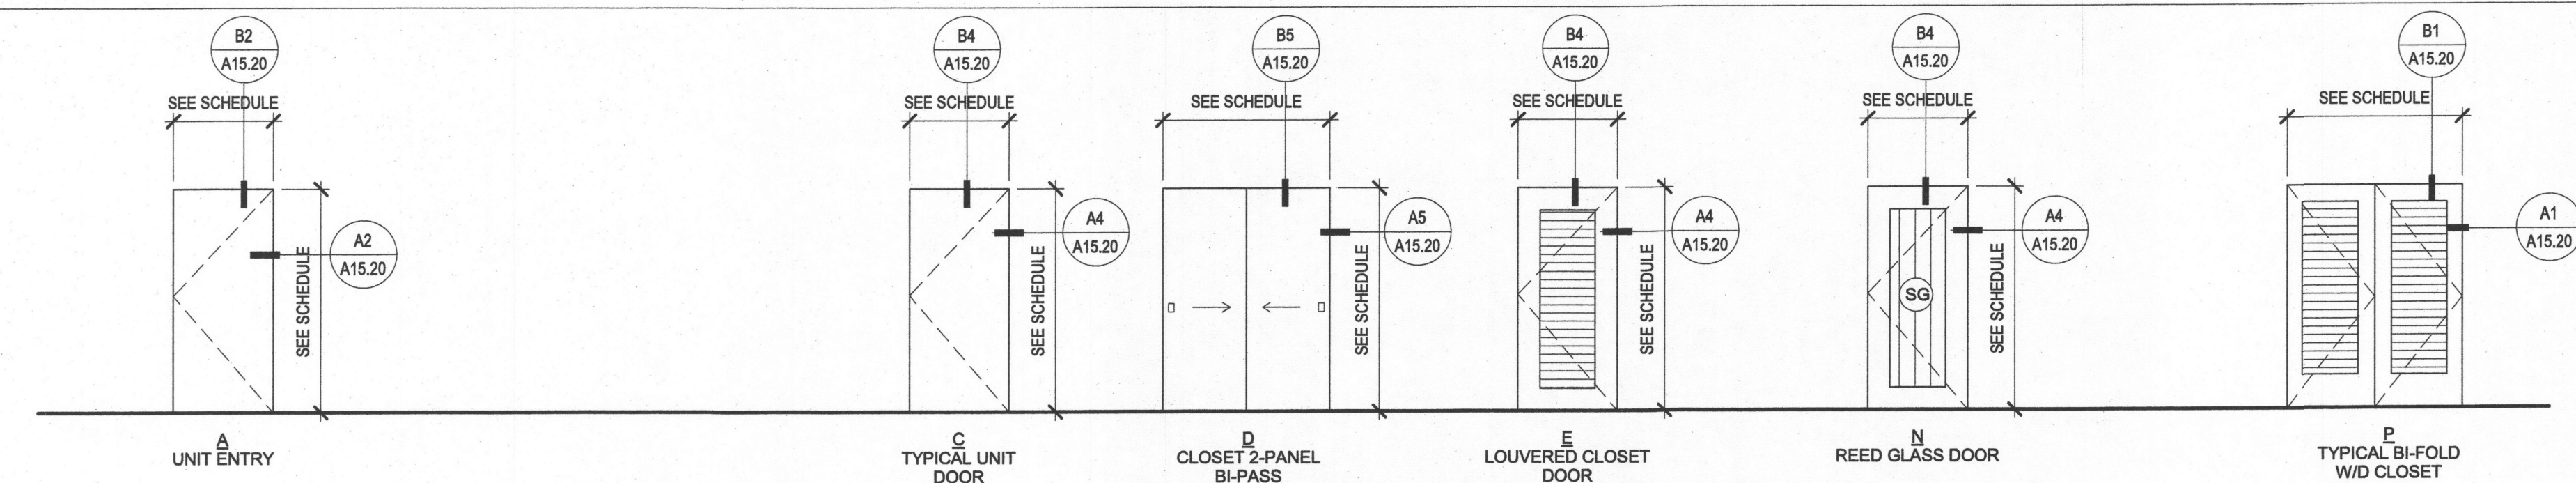

EXTERIOR AND COMMON DOORS

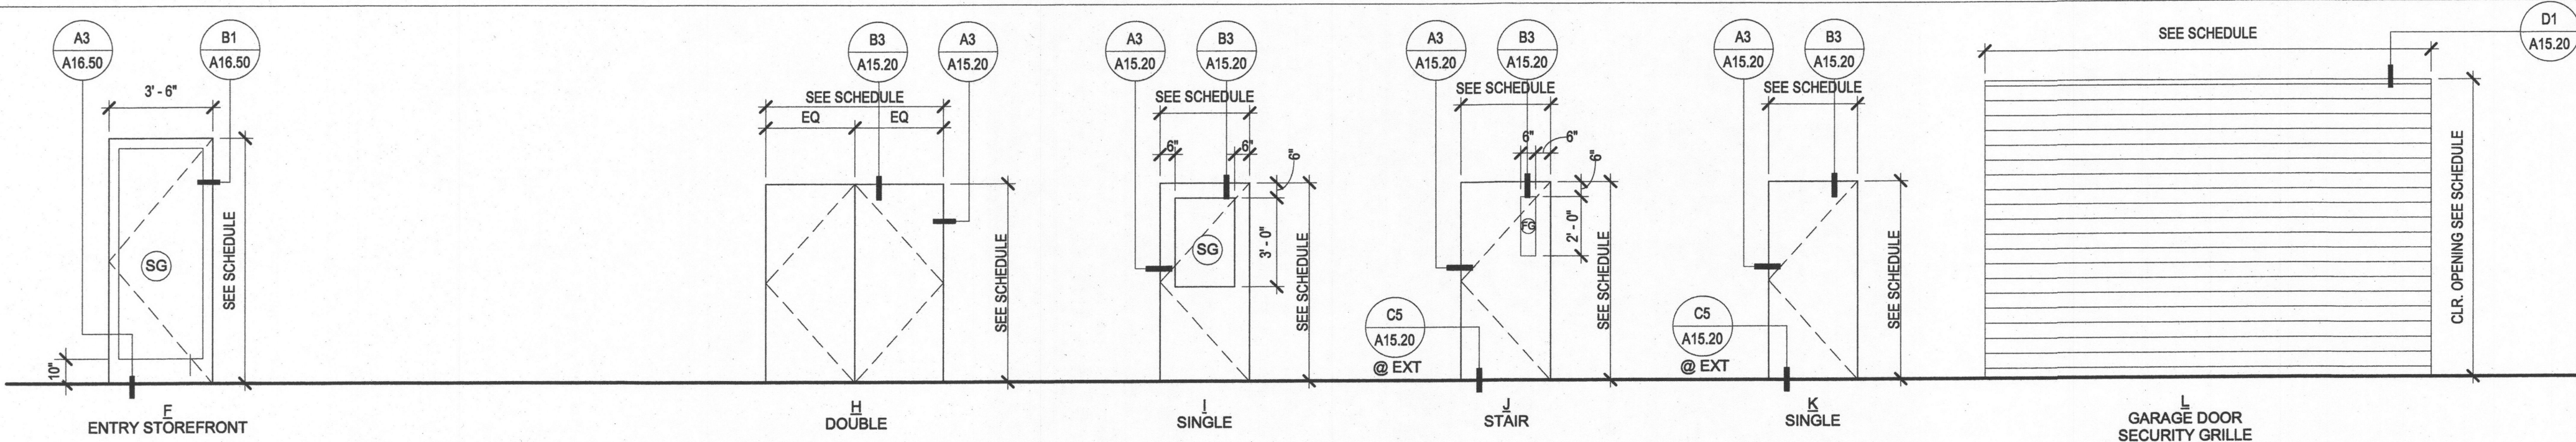

HARDWARE GROUPS

GROUP		GROUP	
1	ENTRANCE LOCK FUNCTION (ANSI F82) ELECTRIC STRIKE PANIC BAR HINGES THRESHOLD CLOSER DUMMY LOCK WITH HANDLE	6	PASSAGE LOCK FUNCTION (ANSI F75) HINGES SILENCERS CLOSER DUMMY LOCK WITH HANDLE
	KICKPLATE PUSHPLATE PULL PLATE DOOR SHOE WEATHER SEAL		STOREROOM LOCK FUNCTION (ANSI F86) HINGES CLOSER KICKPLATE DOOR SHOE WEATHER SEAL
2	STOREROOM LOCK FUNCTION (ANSI F86) HINGES CLOSER KICKPLATE SMOKE SEAL	8	PASSAGE LOCK FUNCTION (ANSI F75) HINGES CLOSER WALL STOP KICKPLATE DOOR SHOE SMOKE & ACOUSTICAL SEAL
	SCHLAGE UNIT ENTRY HINGES (2 BOMBER) (1 REG) THRESHOLD PEEPHOLE WALL STOP DOOR SHOE SMOKE & ACOUSTICAL SEAL		ENTRANCE LOCK FUNCTION (ANSI F82) HINGES CLOSER THRESHOLD DOOR SHOE WEATHER SEAL
3	PRIVACY LOCK FUNCTION (ANSI F76) HINGES SILENCERS	9	SINGLE DUMMY TRIM CATCH HINGES
	PATIO LOCK FUNCTION (ANSI F77) WEATHERPROOFING DOOR SHOE HINGES 1/2" MAX THRESHOLD WEATHER SEAL		PULL
4		10	
5		11	
		12	

GENERAL DOOR NOTES


- CONTRACTOR TO COORDINATE REQUIRED UNDERCUT OF EACH SCHEDULED DOOR WITH THE SILL OR THRESHOLD PER DETAIL, FIRE RATING, AND MAKE-UP AIR REQUIREMENTS OF ROOM.
- CONTRACTOR IS RESPONSIBLE FOR THE PROPER INSTALLATION AND OPERATION OF SCHEDULED DOORS AND HARDWARE COMPLIANT WITH REQUIREMENTS OF THE ADA, ANSI, AND BUILDING CODE(S).
- COORDINATE THE INSTALLATION OF HARDWARE WITH THE PROPER SIDE OF DOOR. REFER TO PLANS FOR INDIVIDUAL DOOR SWING DIRECTION AND RELATION IN FRAME.
- PROVIDE MANEUVERING CLEARANCES AT DOORS AS PRESCRIBED BY PREVAILING FEDERAL, STATE, OR LOCAL CODE/REGULATION.
- GLASS USED IN DOORS AND GLAZING LOCATED WITHIN A 24-INCH ARC OF THE NEAREST VERTICAL EDGE OF A DOOR AND UP TO 60 INCHES ABOVE FINISH FLOOR AND AREAS SUBJECT TO HUMAN IMPACT OR OTHER HAZARDOUS LOCATIONS SHALL HAVE APPROVED SAFETY GLAZING MATERIAL AS DEFINED BY THE AUTHORITIES HAVING JURISDICTION. REFERENCE PLANS FOR ALL INSTANCES OF GLAZING NEAR DOOR SWINGS.
- 1/4 INCH IN 2 INCHES DOOR BEVEL, UNLESS OTHERWISE NOTED BY HARDWARE TEMPLATE REQUIREMENTS.
- ALL HOLLOW METAL DOORS AND FRAMES PRIMED AND FINISH PAINTED UPON DELIVERY OR PRIMED AND FIELD PAINTED, UNLESS OTHERWISE NOTED.
- PROVIDE THE APPROPRIATE JAMB ANCHOR FOR LABELED OR NON-LABELED FRAMES.
- PROVIDED A MINIMUM OF THREE ANCHORS PER JAMB OR SPACE AT 24 INCHES MAXIMUM ON CENTER, WHICHEVER IS A GREATER QUANTITY.
- AT METAL STUD PARTITIONS, PROVIDE TWO METAL STUDS AT EACH JAMB. SECURE EACH WITH A GALVANIZED CLIP ANGLE AT THE FLOOR AND SECURE THE TOP TO AN 18 GAGE METAL RUNNER WHICH IS SECURED TO STRUCTURE AT A MINIMUM OF TWO STRUCTURAL POINTS.
- SINGLE SOURCE DOORS AND FRAME WITH MATCHING LABELS.
- PROVIDE RUBBER DOOR SILENCERS (3 PER JAMB) WHERE LIGHT / SOUND GASKETS OR WEATHER-STRIPPING IS NOT OTHERWISE REQUIRED.
- TOPS AND BOTTOMS OF ALL HOLLOW METAL DOORS EXPOSED TO WEATHER SHALL BE PAINTED.
- ALLOW FOR PLASTIC LAMINATE FACES AT DOOR FRAMES, ADJUST HINGES AS REQUIRED.
- REFER TO DOOR DETAILS FOR FURTHER INFORMATION ON TYPICAL CONDITIONS.
- WALL MAGNETS TO BE TIED TO FIRE ALARM SYSTEM.
- PROVIDE COMPLETE WEATHER STRIPPING AT ALL EXTERIOR DOORS.
- ALL EXTERIOR GLAZING TO BE THERMAL INSULATING.
- ALL EXTERIOR DOORS TO BE INSULATED.
- WHERE TWO OR MORE GLAZING DESIGNATIONS ARE GIVEN, REFERENCE THE BUILDING ELEVATIONS FOR LOCATIONS OF PARTICULAR GLAZING TYPES.
- VISION PANEL IN DOORS TO BE FIRE RATED GLAZING PER THE SPECIFICATIONS.
- REFER TO D2/A11.71 FOR TYPICAL INTERIOR DOOR TRIM.

SYMBOLS AND ABBREVIATIONS

100	DOOR TAG (SEE PLANS)	HC	HOLLOW CORE
ST-1-1	STAIR ABBREVIATION STAIR NUMBER	HDW	HARDWARE
SG	SAFETY GLAZING	HM	HOLLOW METAL
FG	FIRE RATED GLAZING	INSUL	INSULATED
ALUM	ALUMINUM	MIN	MINUTE or MINIMUM
BO	BOTTOM OF	MTL	METAL
DO	DOOR OPENING (NOMINAL)	NTS	NOT TO SCALE
FB	FIBERGLASS	OTO	OUT TO OUT
H	HEIGHT (NOMINAL)	PR	PAIR
		PREFIN	PRE FINISHED
		SC	SOLID CORE
		TO	TOP OF
		W	WIDTH (NOMINAL)
		WD	WOOD

SHEET NOTES

NOTE: NOT ALL DOOR OPERATIONS MAY BE USED ON THIS PROJECT.

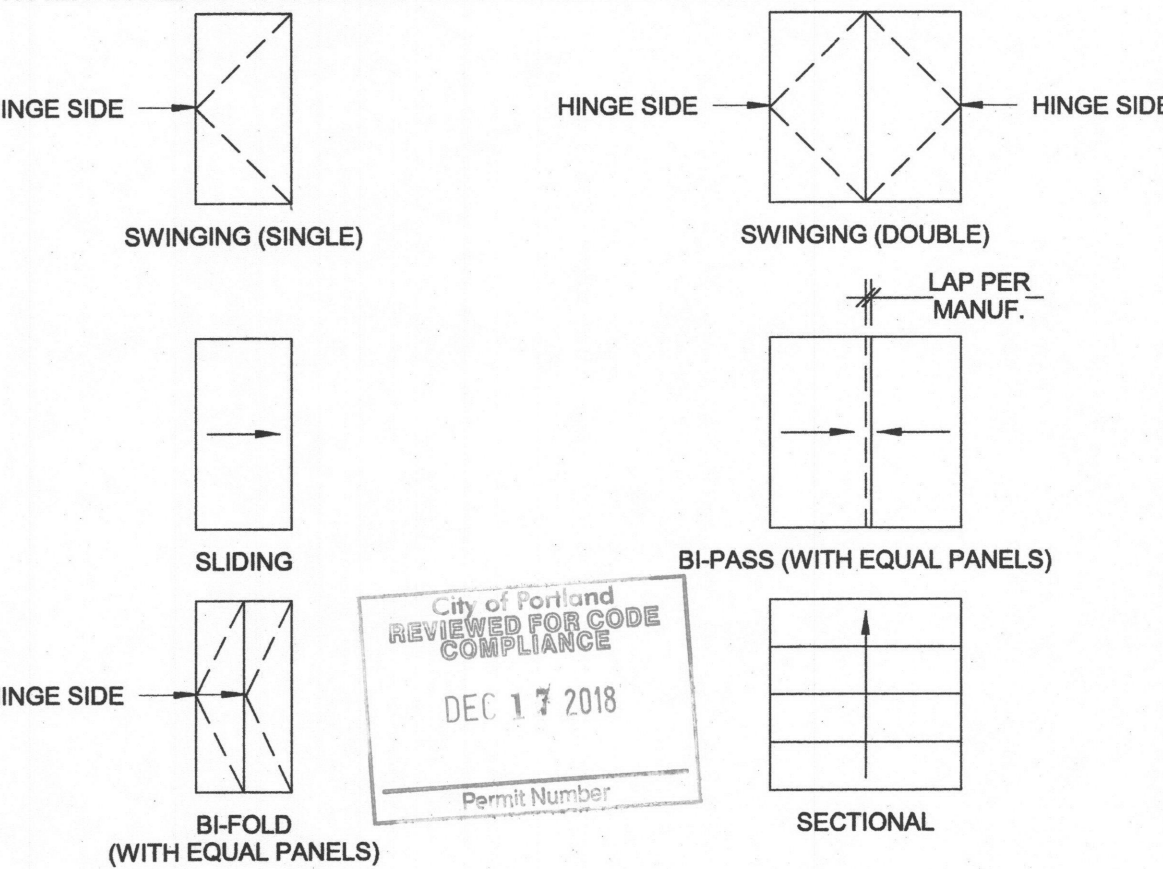

MGA
MYHRE GROUP ARCHITECTS

620 SW 5th Avenue, Suite 500 Portland, Oregon 97204
1.503.236.8000 • 1.503.236.7000 www.myhregroup.com

REGISTERED ARCHITECT
ERIK M. PETERSEN
6636
PORTLAND, OR
STATE OF OREGON

© MYHRE GROUP ARCHITECTS, INC.
THESE DRAWINGS ARE THE PROPERTY
OF MYHRE GROUP ARCHITECTS AND
ARE NOT TO BE REPRODUCED IN
ANY MANNER WITHOUT THE
PRIOR WRITTEN APPROVAL OF MYHRE
GROUP ARCHITECTS

PERMIT REVIEW SET

SE 14TH &
HAWTHORNE
APARTMENTS

URBAN DEVELOPMENT
GROUP

△	DATE	FILE
1	2017/05/05	AHJ 01
5	2018/02/14	ASI 02
9	2018/12/13	ASI 06
PIC:		
PM: ERIK PETERSEN		
JC: JIM STADICK		
DRAWN BY: JS		
JOB NO: 161150		
DATE: 2017.01.13		

A15.10 DOOR SCHEDULE