

**City of Portland, Oregon - Bureau of Development Services**1900 SW Fourth Avenue • Portland, Oregon 97201 | 503-823-7300 | [www.portlandoregon.gov/bds](http://www.portlandoregon.gov/bds)**Permit Revision Submittal Requirements and Application**

A Permit Revision is required when there are proposed changes to the project after the permit has been issued. This may arise due to discrepancies between the city-approved permit drawings and actual field conditions, or the customer has changed their mind about an aspect of the project. In all cases, a revision to the existing permit must be submitted, reviewed and approved.

**Applicants will provide:**☐ A copy of this application☐ Three (3) sets of plans that clearly reflect the proposed change(s).

Drawings and calculations must be stamped and signed by the Architect and/or the Engineer of Record, if applicable.

☐ One (1) copy of the original city approved permit drawings. (NOTE: If your project has an assigned process manager please contact them regarding submittal of the revision).

☐ Two (2) sets of calculations, if applicable

☐ Inspector's correction notice, if revision is due to an inspection correction

☐ Revision fee (paid at time of submittal)**Contact Information:**Contact name BRYAN CARTERAddress 3433 NE 59TH AVECity PORTLANDState ORZip Code 97213Phone 509-592-7230Email CRAZYGOPHER@GMAIL.COMValue of proposed revision \$0 (NO INCREASE) Issued permit # 4505421Job site address 3433 NE 59TH AVE, PORTLAND, OR 97213Description of revision FINAL MEASUREMENTS TO PERMITTED STAIRCASE**Fees:**

The Permit Revisions are subject to fees associated with plan review, processing and any increase in project value. Additional fees may apply if adding plumbing fixtures.

The Bureau of Development Services fee schedule is available under the fees tab on the BDS web site at: [www.portlandoregon.gov/bds](http://www.portlandoregon.gov/bds). Fees are updated annually on July 1st.

**Helpful Information:**

**Bureau of Development Services**  
City of Portland, Oregon  
1900 SW 4th Avenue, Portland, OR 97201  
[www.portlandoregon.gov/bds](http://www.portlandoregon.gov/bds)

**Submit your plans in person to:**

Development Services Center (DSC), First Floor,  
For Hours Call 503-823-7310

**Important Telephone Numbers:**

BDS main number ..... 503-823-7300  
DSC automated information line ..... 503-823-7310  
Building code information ..... 503-823-1456  
BDS 24 hour inspection request line ..... 503-823-7000  
Residential information for  
one and two family dwelling ..... 503-823-7388  
General Permit Processing and  
Fee Estimate info ..... 503-823-7357  
City of Portland TTY ..... 503-823-6868



**LOT AREA**

BUILDING FOOTPRINT \_\_\_\_\_

WALK \_\_\_\_\_

ROOF AREA  
(INCL. OVERHANG) \_\_\_\_\_

TOTAL \_\_\_\_\_

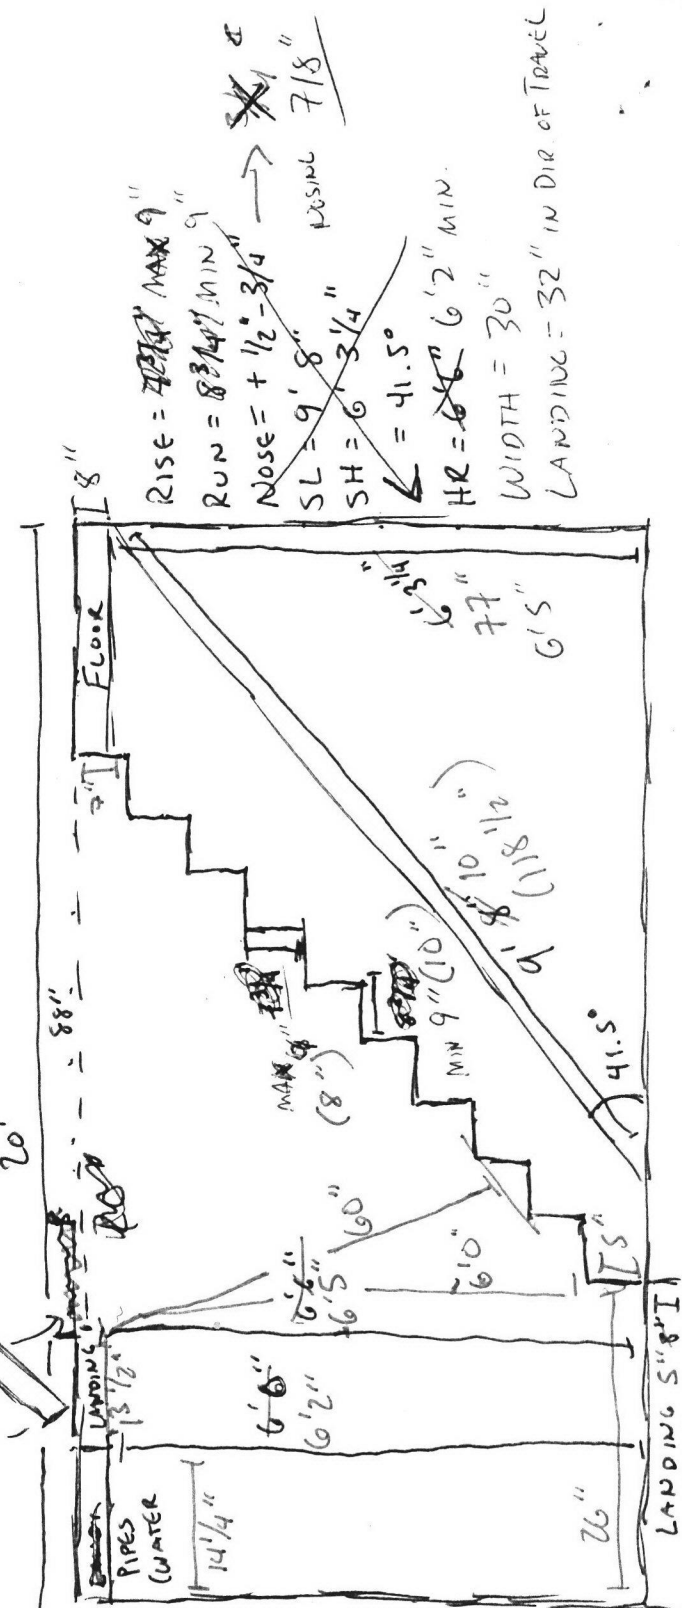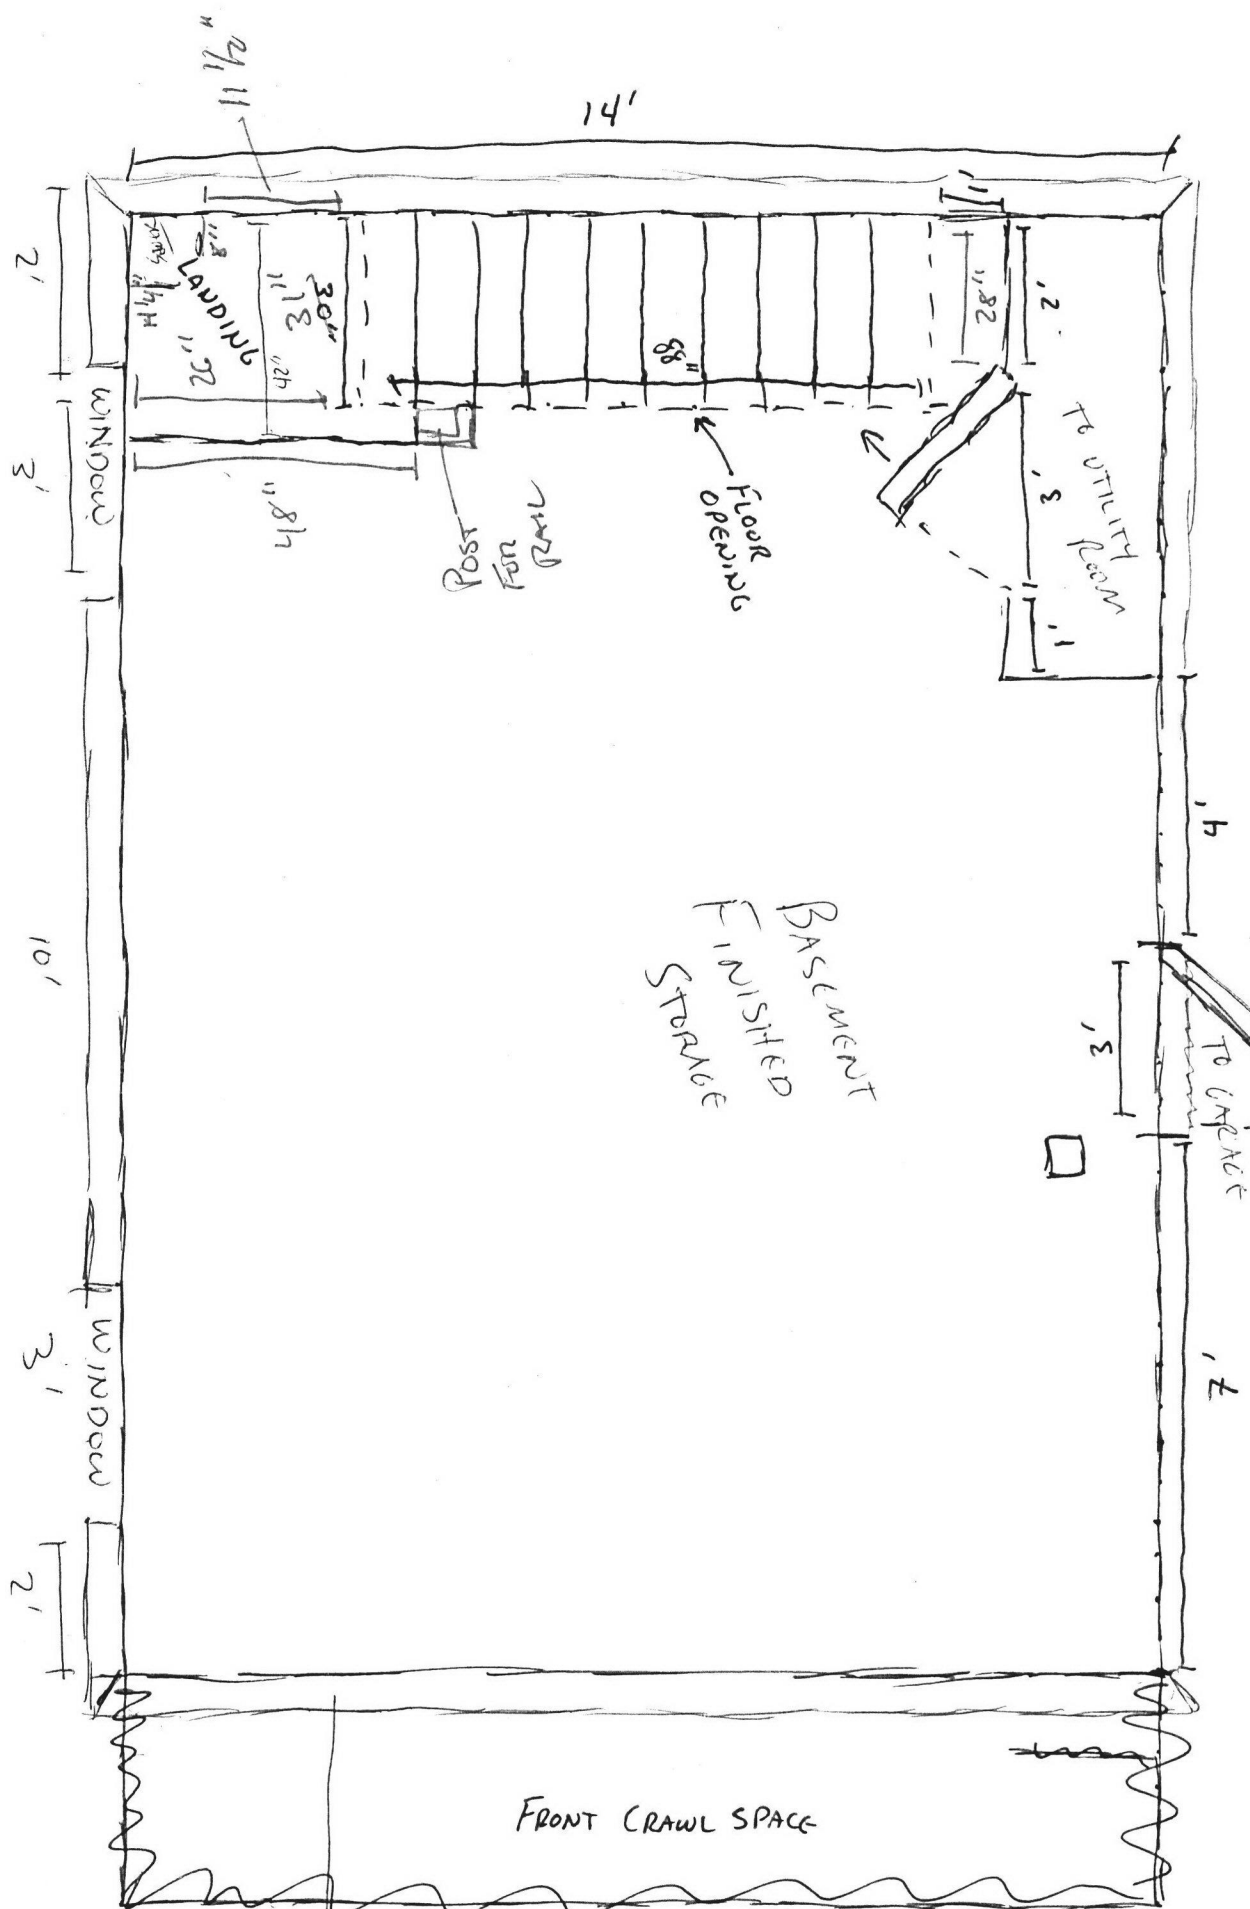

City of Portland  
RECEIVED  
FEB 28 2020  
COMMUNITY CODE


ROSE CITY PARK, BLOCK 124, S 1/2 OF LOT 1  
R 723 114 750  
R 155

# SCAN

## SITE PLAN

SCALE 1" = 10'

A horizontal line segment with a point labeled 2' at the left end and 10' at the right end.

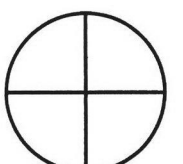

# NORTH ARIZONA

## PROJECT LEGAL

## PROJECT ADDRESS

3433 NE 59<sup>TH</sup> AVE

PORTLAND, OR 97213

20-101819. REV-01-R5