#### **Development Services**

#### From Concept to Construction







APPEAL SUMMARY

Status:	Decision I	Rendered
---------	------------	----------

Appeal ID: 14738	Project Address: 620 NE 20th Ave
Hearing Date: 3/8/17	Appellant Name: Scott Sholar
Case No.: B-011	Appellant Phone: 5034442223
Appeal Type: Building	Plans Examiner/Inspector: Maureen McCafferty
Project Type: commercial	Stories: 6 Occupancy: R-2 Construction Type: I-A, III-B
Building/Business Name:	Fire Sprinklers: Yes - throughout
Appeal Involves: Erection of a new structure	LUR or Permit Application No.: 16-144056-CO
Plan Submitted Option: pdf [File 1] [File 2] [File 3] [File 4] [File 5]	Proposed use: Mixed Use Multi-family Housing

#### APPEAL INFORMATION SHEET

#### Appeal item 1

**Code Section** 

2014 OSSC 1012.6

#### Requires

1012.6 Handrail extensions. Handrails shall return to a wall, guard or the walking surface or shall be continuous to the handrail of an adjacent stair flight or ramp run. Where handrails are not continuous between flights, the handrails shall extend horizontally at least 12 inches beyond the top riser and continue to slope for the depth of one tread beyond the bottom riser. The extensions of handrails shall be in the same direction of the stair flights at stairways and the ramp runs at ramps.

#### **Proposed Design**

The permitted project is a new multi-family building located in the Kerns neighborhood currently under construction with the framing of Level 3 beginning. The building construction is fully sprinkled (NFPA 13) with 5 stories of Type IIIB over 1 story of Type IA.

The proposed handrail extension at the base of Stair 1 on Level 1 would turn 90 degrees following the path of travel, sloping for 11" to match the stair slope and then a 12" horizontal extension for a total extension of 1'-11". This additional horizontal extension will allow handrail users additional time to orient themselves in the direction of travel. The wall would terminate at the stair nosing allowing for the handrail to turn 90 degrees, similar to the continuation of handrails at intermediate landings. See Exhibit B for proposed design.

Reason for alternative The current permitted drawings have the handrail extension and wall protruding into the landing reducing the path of travel to 3'-7" while the stair width is 4'-2" (stair/landing width is only required to be 48" per OSSC 1007.3 since the highest occupant load exiting requires significantly less width). The proposed handrail revision provides a 4'-6" wide stair landing at the exit discharge level of the stairway, which is 4" wider than required. Adjusting the stair run would not be feasible as the project is starting to frame Level 3 with Level 1 concrete poured (L1 stairs walls are

concrete) and Level 2 PT slab poured. There is also a PT slab tendon located at the top riser for the staircase going between Levels 1 and 2 not allowing for the concrete to be removed.

The proposed design provides equivalent life safety as the handrail is continuing in the path of travel towards the stairwell's exit. The proposed design also provides additional space at the Level 1 landing from the permitted drawings to reduce any potential bottle-neck issues during egress.

See Exhibit A, C, D, and E for current permitted design and occupant load information.

#### APPEAL DECISION


Handrail extension turned 90 degrees at bottom landing: Denied. Proposal does not provide equivalent safety.


The Board approves modification to the as-permitted configuration that reduces the handrail extension dimension such that the clear width of 3'-7" increases to 3'-8".


Appellant may contact Maureen McCafferty (503-823-7850) with questions.


For the option granted, the Administrative Appeal Board finds with the conditions noted, that the approved modifications or alternate methods are consistent with the intent of the code; do not lessen health, safety, accessibility, life, fire safety or structural requirements; and that special conditions unique to this project make strict application of those code sections impractical.


Pursuant to City Code Chapter 24.10, you may appeal this decision to the Building Code Board of Appeal within 180 calendar days of the date this decision is published. For information on the appeals process and costs, including forms, appeal fee, payment methods and fee waivers, go to www.portlandoregon.gov/bds/appealsinfo, call (503) 823-7300 or come in to the Development Services Center.

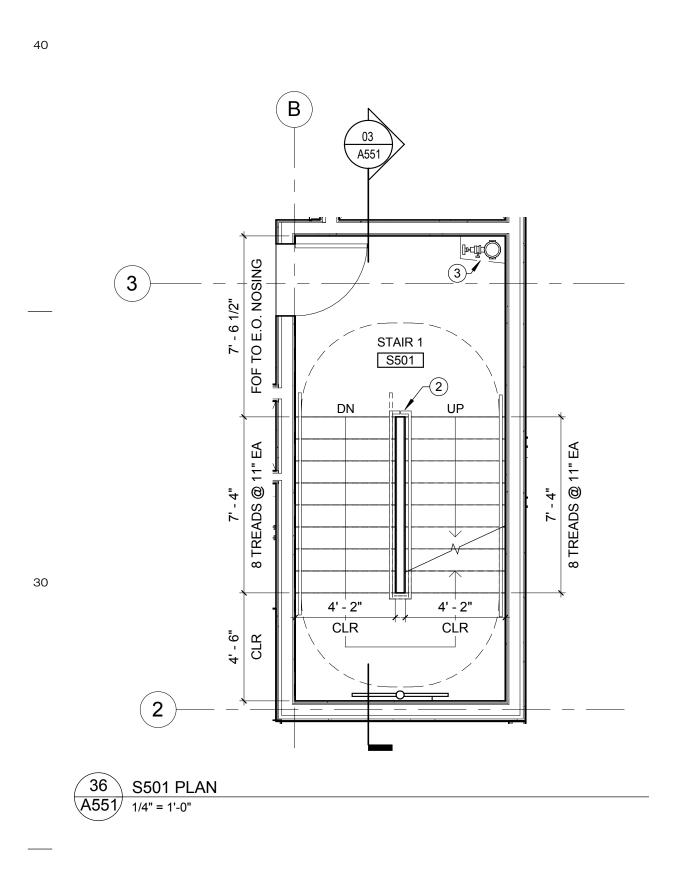


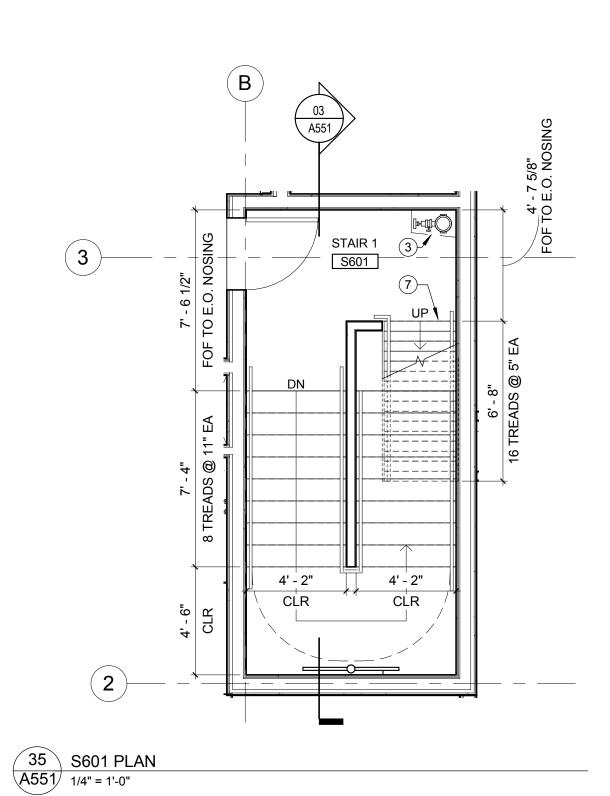


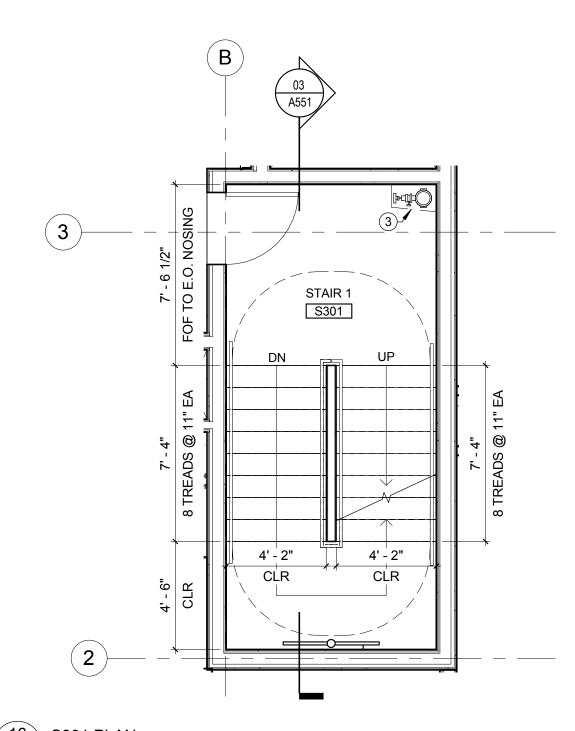

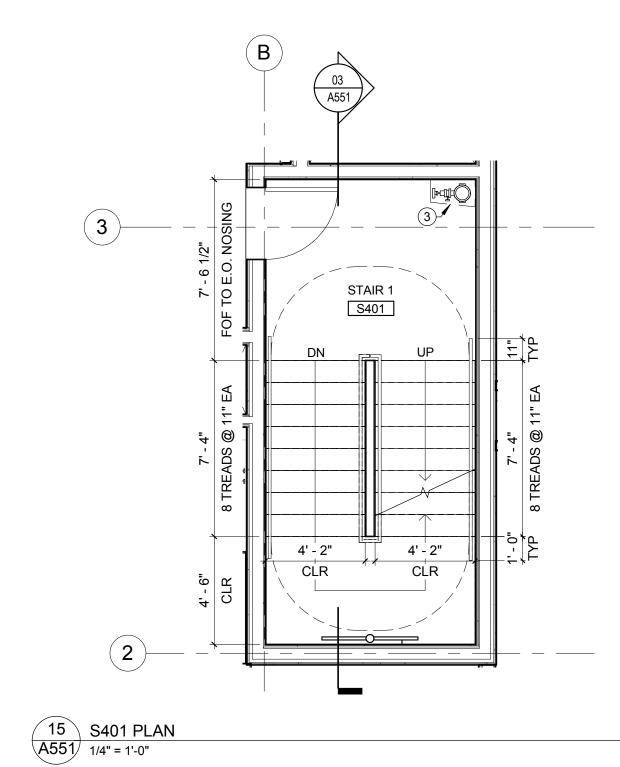

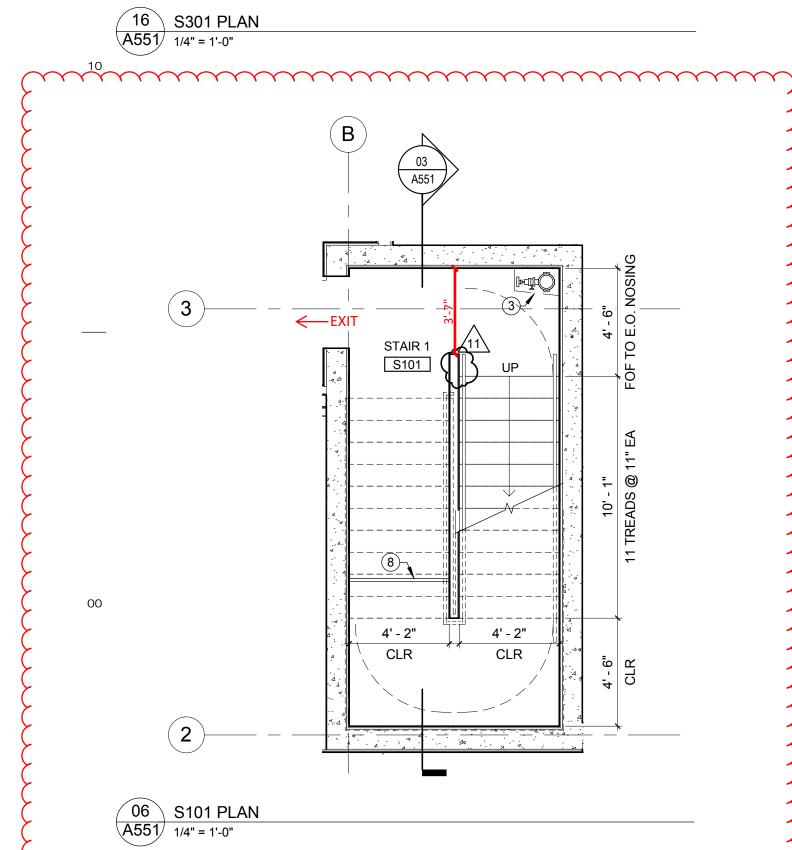

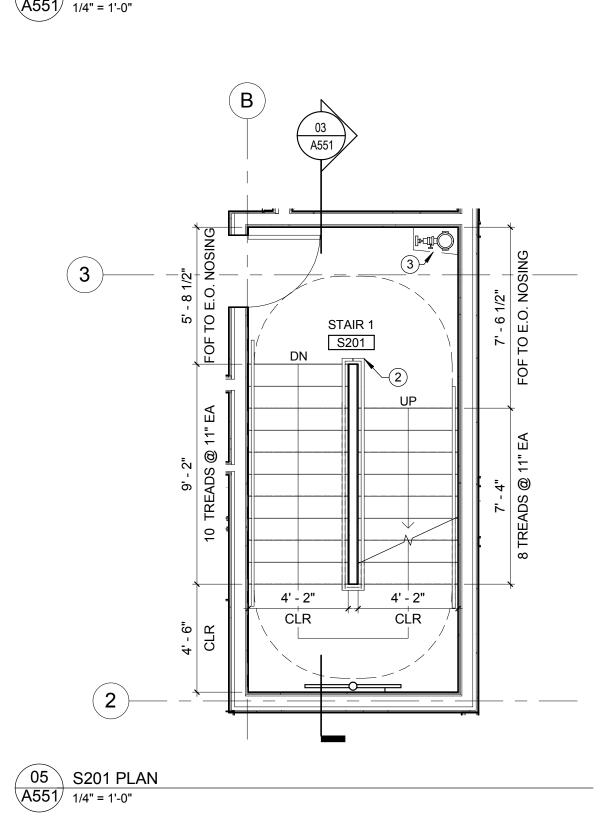

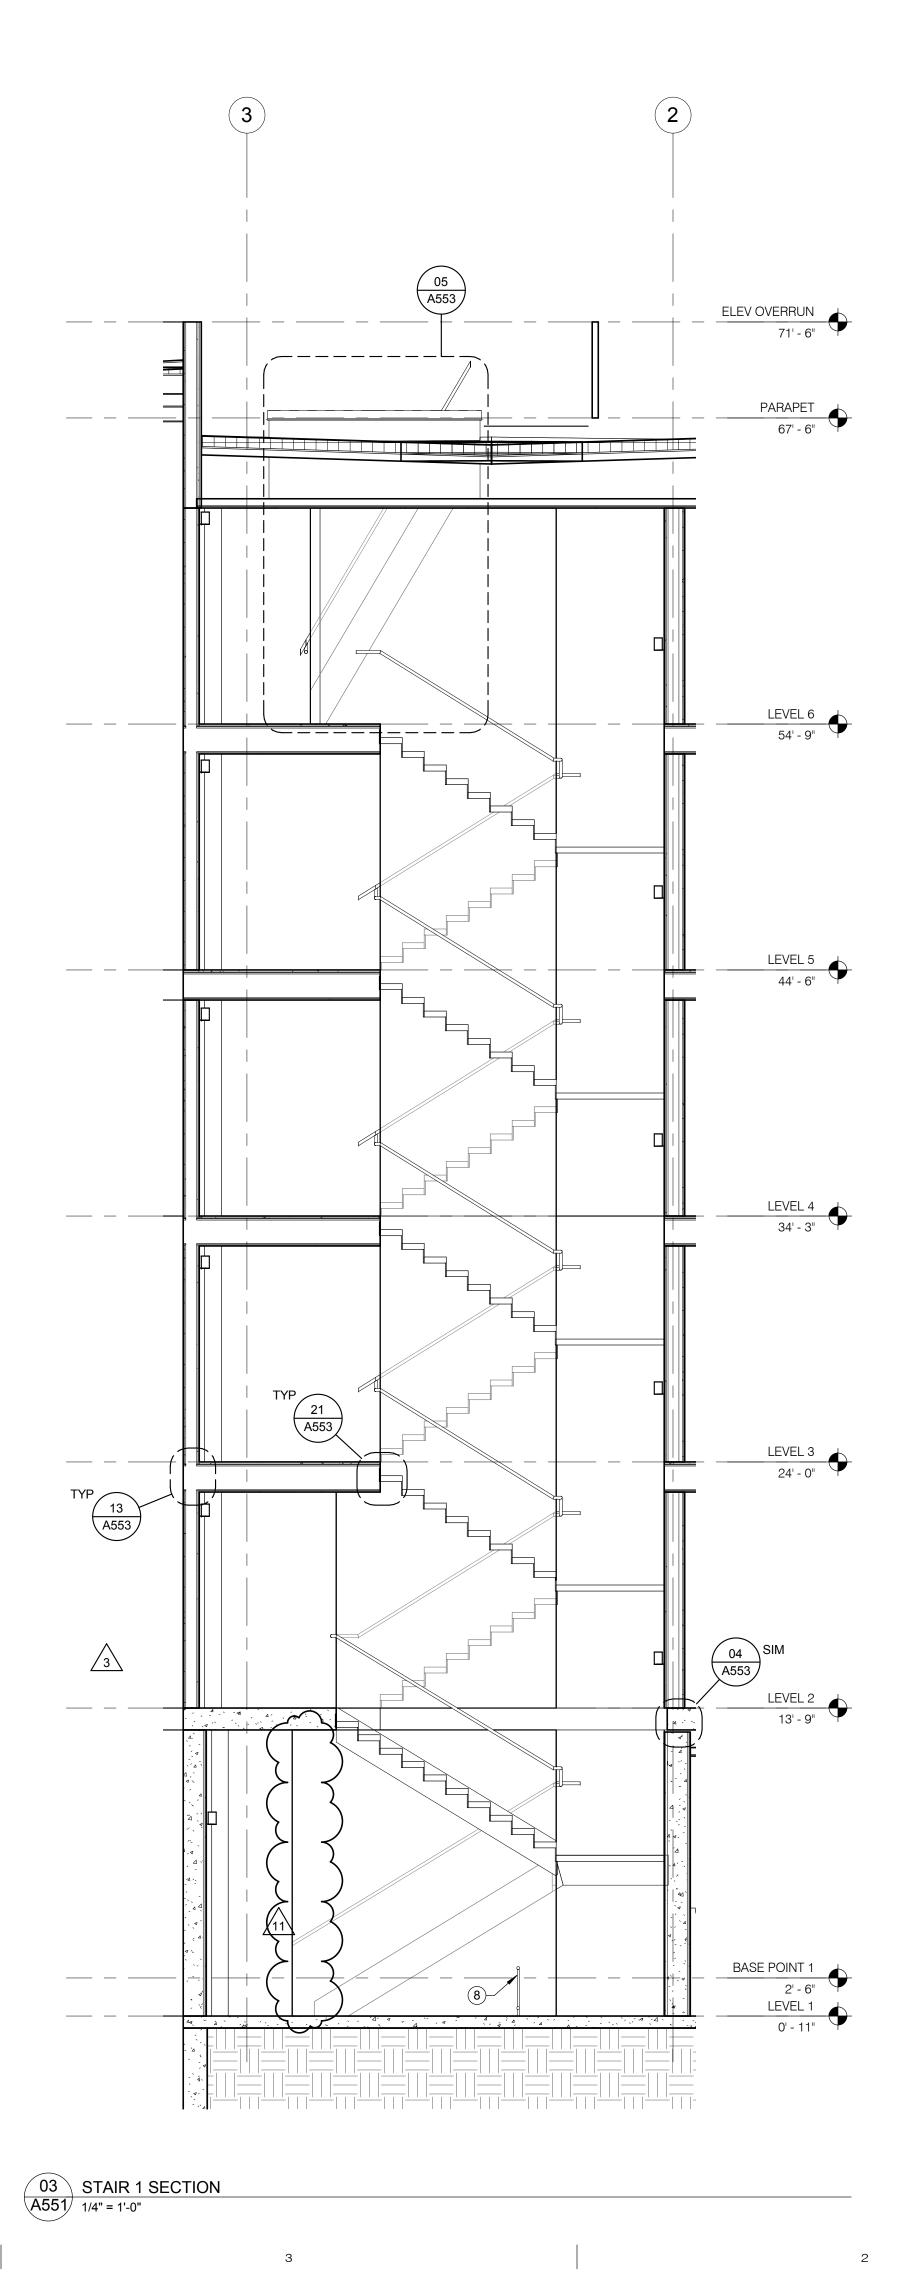

### GENERAL NOTES - VERTICAL CIRCULATION

- 1. COORDINATE FINAL STAIR ELEVATIONS WITH FINISHED FLOOR ELEVATIONS
- ELEVATOR EQUIPMENT SHOWN IS DIAGRAMMATIC, VERIFY SPECIFIC REQUIREMTNET WITH ELEVATOR MANUFACTURER.
- 3. STEEL STAIRS AT LEVEL 1 ARE BIDDER DESIGNED
- 4. CLR DIMENSIONS ARE FROM FACE OF FINISH TO FACE OF FINISH



	KEYNOTES - VERTICAL CIRCULATION
2	WRAP HANDRAILS AS LANDINGS, TYP
3	STANDPIPE
5	HOISTWAY BEAM
6	ELEVATOR SUMP
7	SHIPS LADDER
8	CANE DETECTION

## HOYT20 APARTMENTS

GREEN LIGHT DEVELOPMENT

604 NE 20TH AVE PORTLAND, OR 97232

PROJECT NO.: 15183

DRAWN: Author

BUILDING PERMIT

EVISION: DESCRIPTION:


3 5/24/16 CHECKSHEET 1-3 11 7/13/16 CHECKSHEET 1-6


PRODUCTION OF THIS DRAWING IS EXPRESSLY FORBIDDEN WITHOUT THE SPECIFIC WRITTEN IS CALL ARCHITECTURE INC. THIS DRAWING IS ONLY CONDITIONALLY ISSUED, AND NEITHER RECESSESSION THEREOF CONFERS OR TRANSFERS ANY RIGHT TO, OR LICENSE TO, USE THE SUBJECTHIS DRAWING OR ANY TECHNICAL INFORMATION SHOWN THEREON, NOR ANY RIGHT TO REPES DRAWING OR PART THEREOF, WITHOUT THE WRITTEN AUTHORIZATION OF CZK ARCHITECTU





VERTICAL CIRCULATION STAIR 1




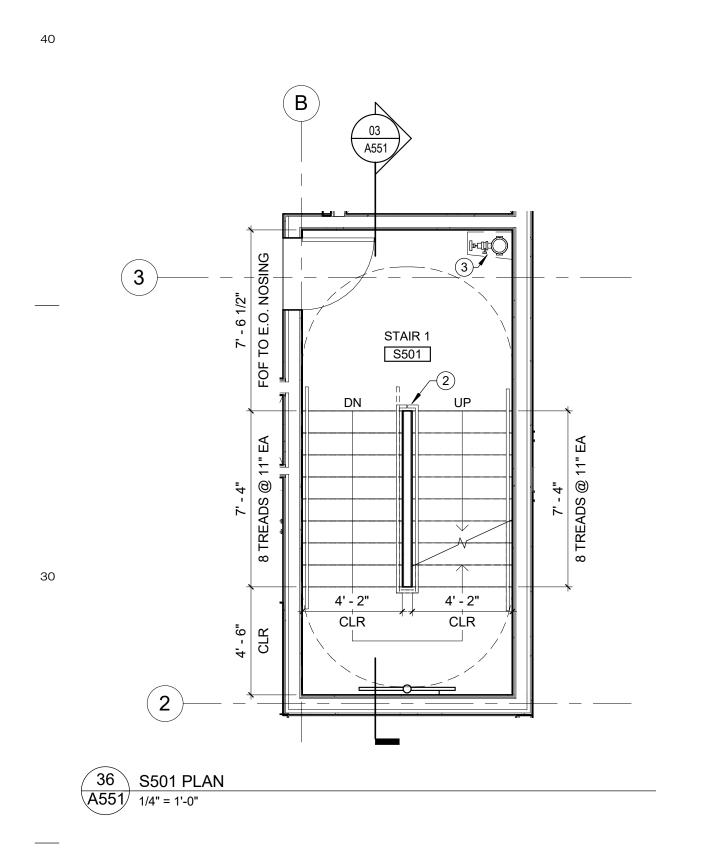


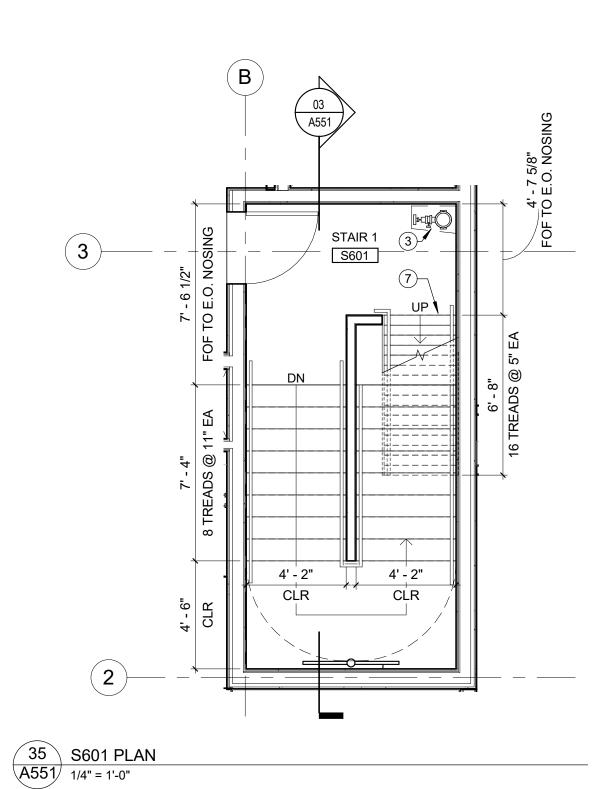

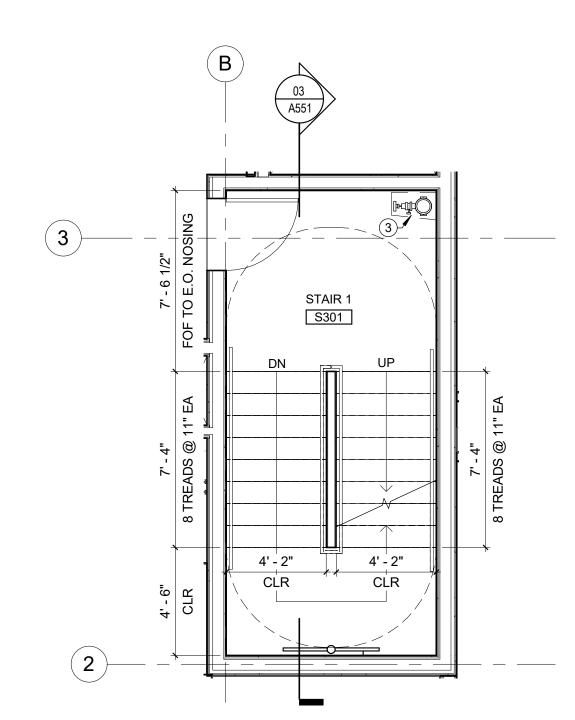

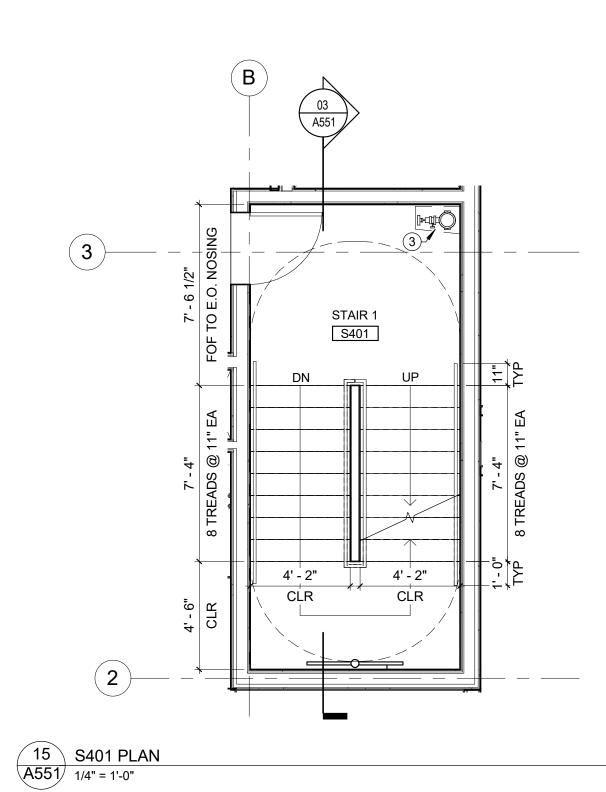

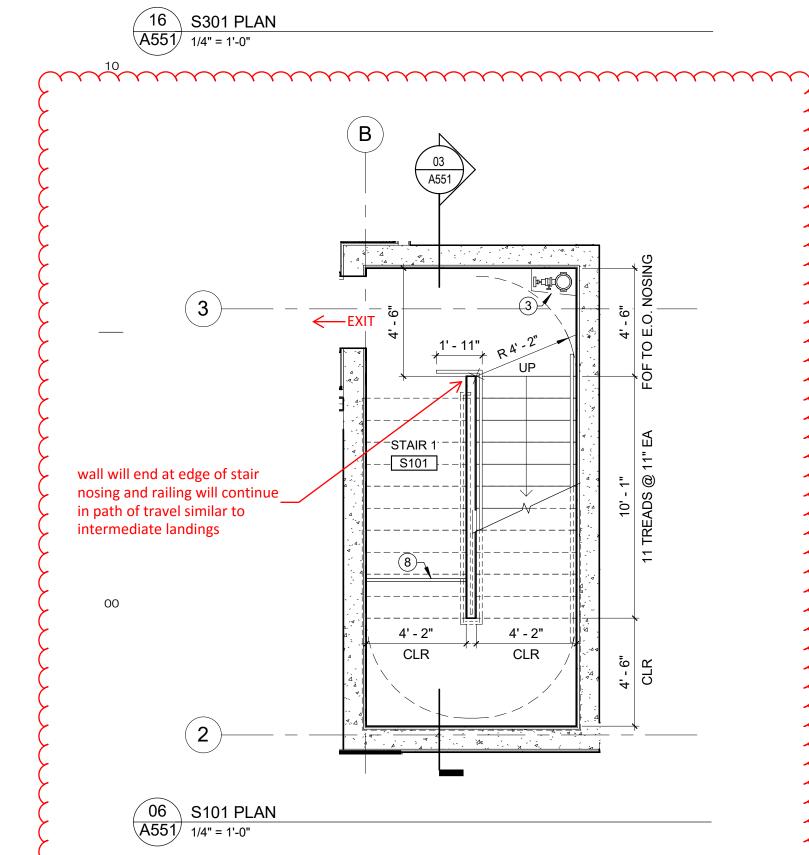

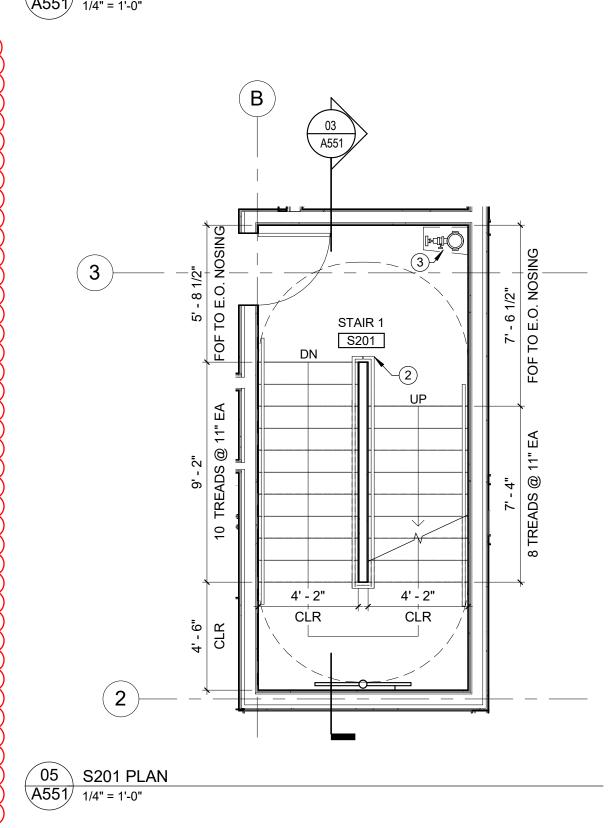

# GENERAL NOTES - VERTICAL CIRCULATION 1. COORDINATE FINAL STAIR ELEVATIONS WITH FINISHED FLOOR ELEVATIONS 2. ELEVATOR EQUIPMENT SHOWN IS DIAGRAMMATIC, VERIFY SPECIFIC REQUIREMENT WITH ELEVATOR MANUFACTURER. 4. CLR DIMENSIONS ARE FROM FACE OF FINISH TO FACE OF FINISH



2	WRAP HANDRAILS AS LANDINGS, TYP
3	STANDPIPE
5	HOISTWAY BEAM
6	ELEVATOR SUMP
7	SHIPS LADDER
8	CANE DETECTION
9	ELEVATOR AUTOTRANSFORMER, SEE ELECTRICAL

## HOYT20 APARTMENTS

GREEN LIGHT DEVELOPMENT

620 NE 20TH AVE PORTLAND, OR 97232

PROJECT NO.: 15183

DRAWN: Author

DATE: 20 SEPTEMBER 2016 100% CONSTRUCTION SET

3 5/24/16 CHECKSHEET 1-3 11 7/13/16 CHECKSHEET 1-6 20 9/20/16 100 CD SET 22 10/14/16 RF1 012


REPRODUCTION OF THIS DRAWING IS EXPRESSLY FORBIDDEN WITHOUT THE SPECIFIC WRITTEN PERMISSION OF C2K ARCHITECTURE INC. THIS DRAWING IS ONLY CONDITIONALLY ISSUED, AND NEITHER RECEIPT OR POSSESSION THEREOF CONFERS OR TRANSFERS ANY RICHT TO, OR LICENSE TO, USE THE SUBJECT MATTER OF THIS DRAWING OR ANY TECHNICAL INFORMATION SHOWN THEREON, NOR ANGING THE ORDOR THE SUBJECT MATTER OF THIS DRAWING OR ANY TECHNICAL INFORMATION SHOWN THEREON, WIGHT TO REPRODUCE THIS DRAWING OR PART THEREOF, WITHOUT THE WRITTEN AUTHORIZATION OF C2K ARCHITECTURE LLC.


SOURCE OF THE STANDARD OF THE ORDOR OF THE ORD


No. 3587
OF OREG


VERTICAL CIRCULATION - STAIR 1



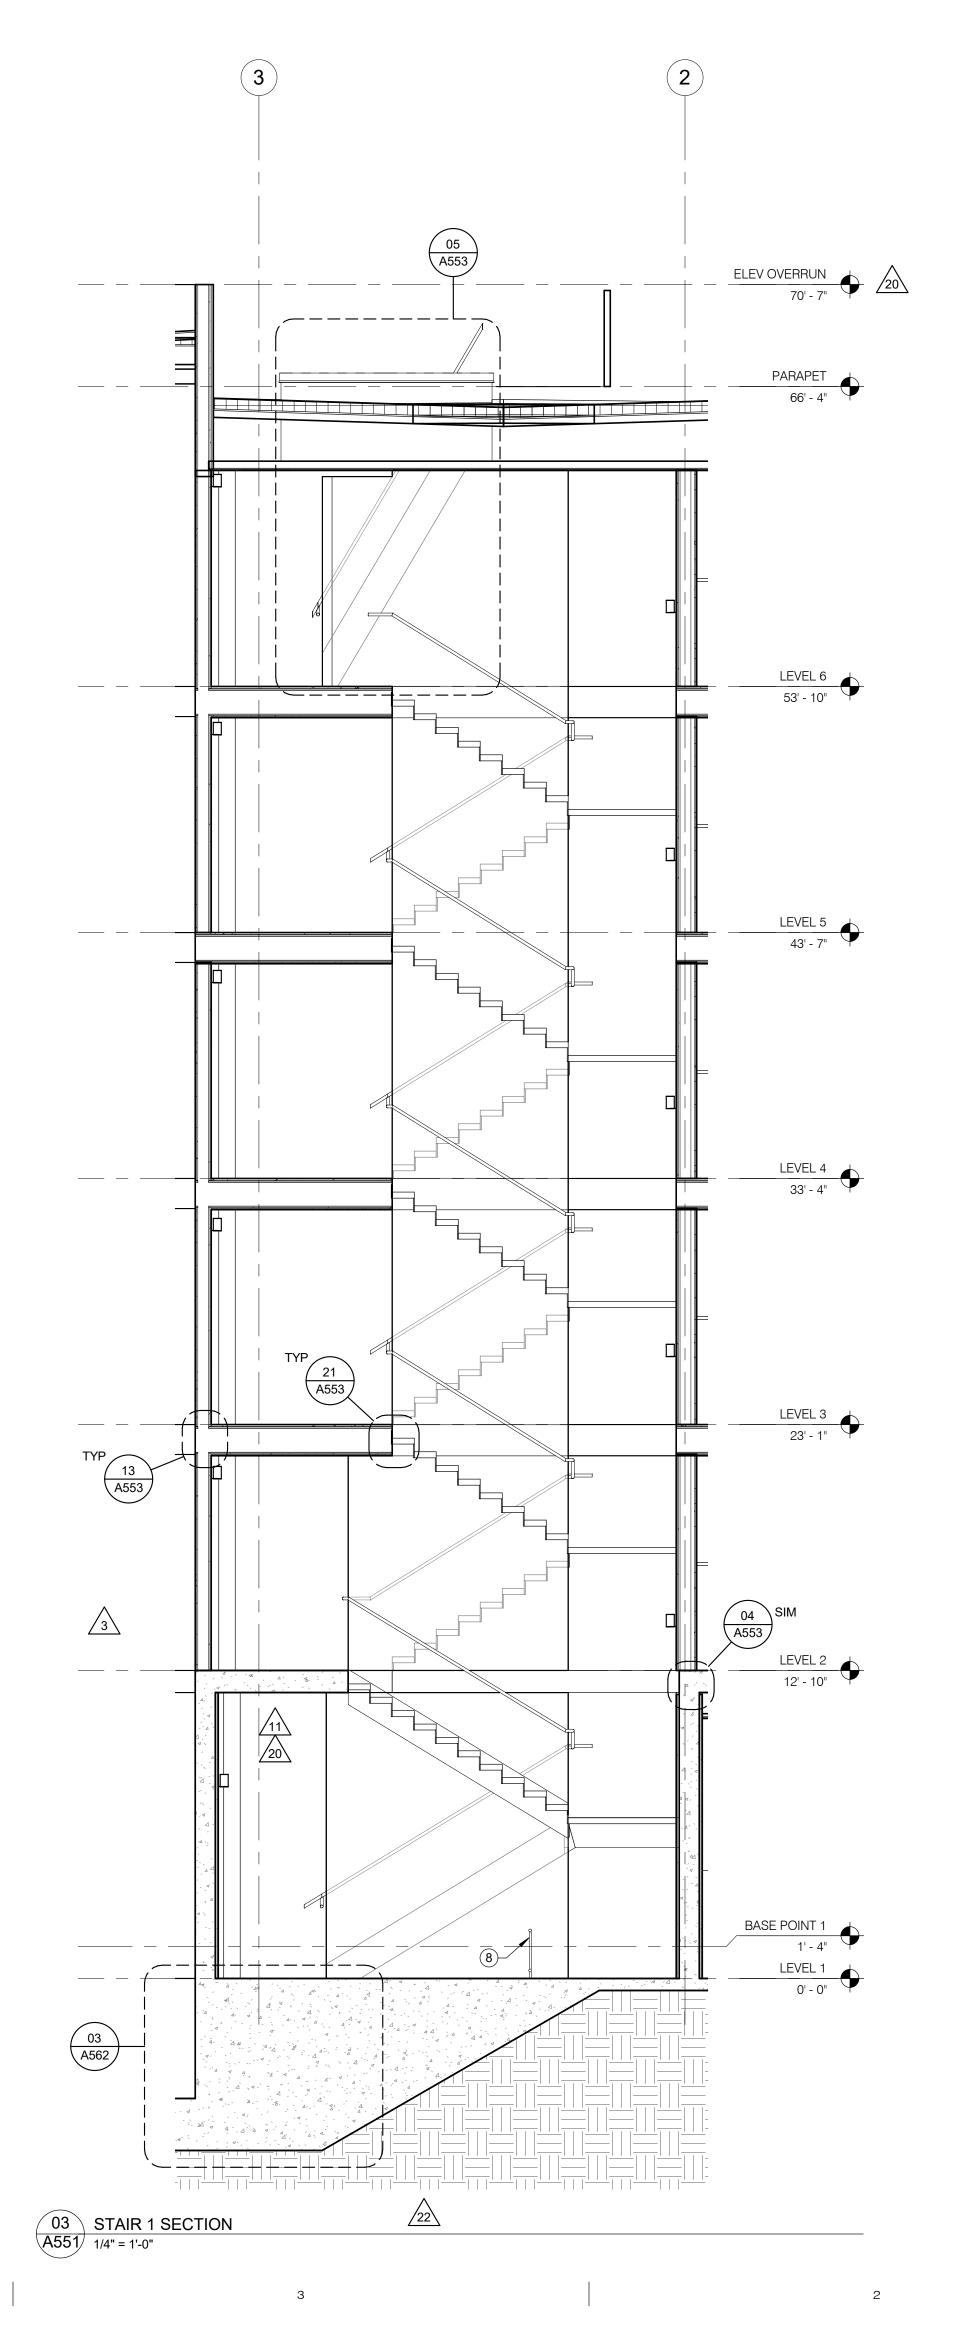

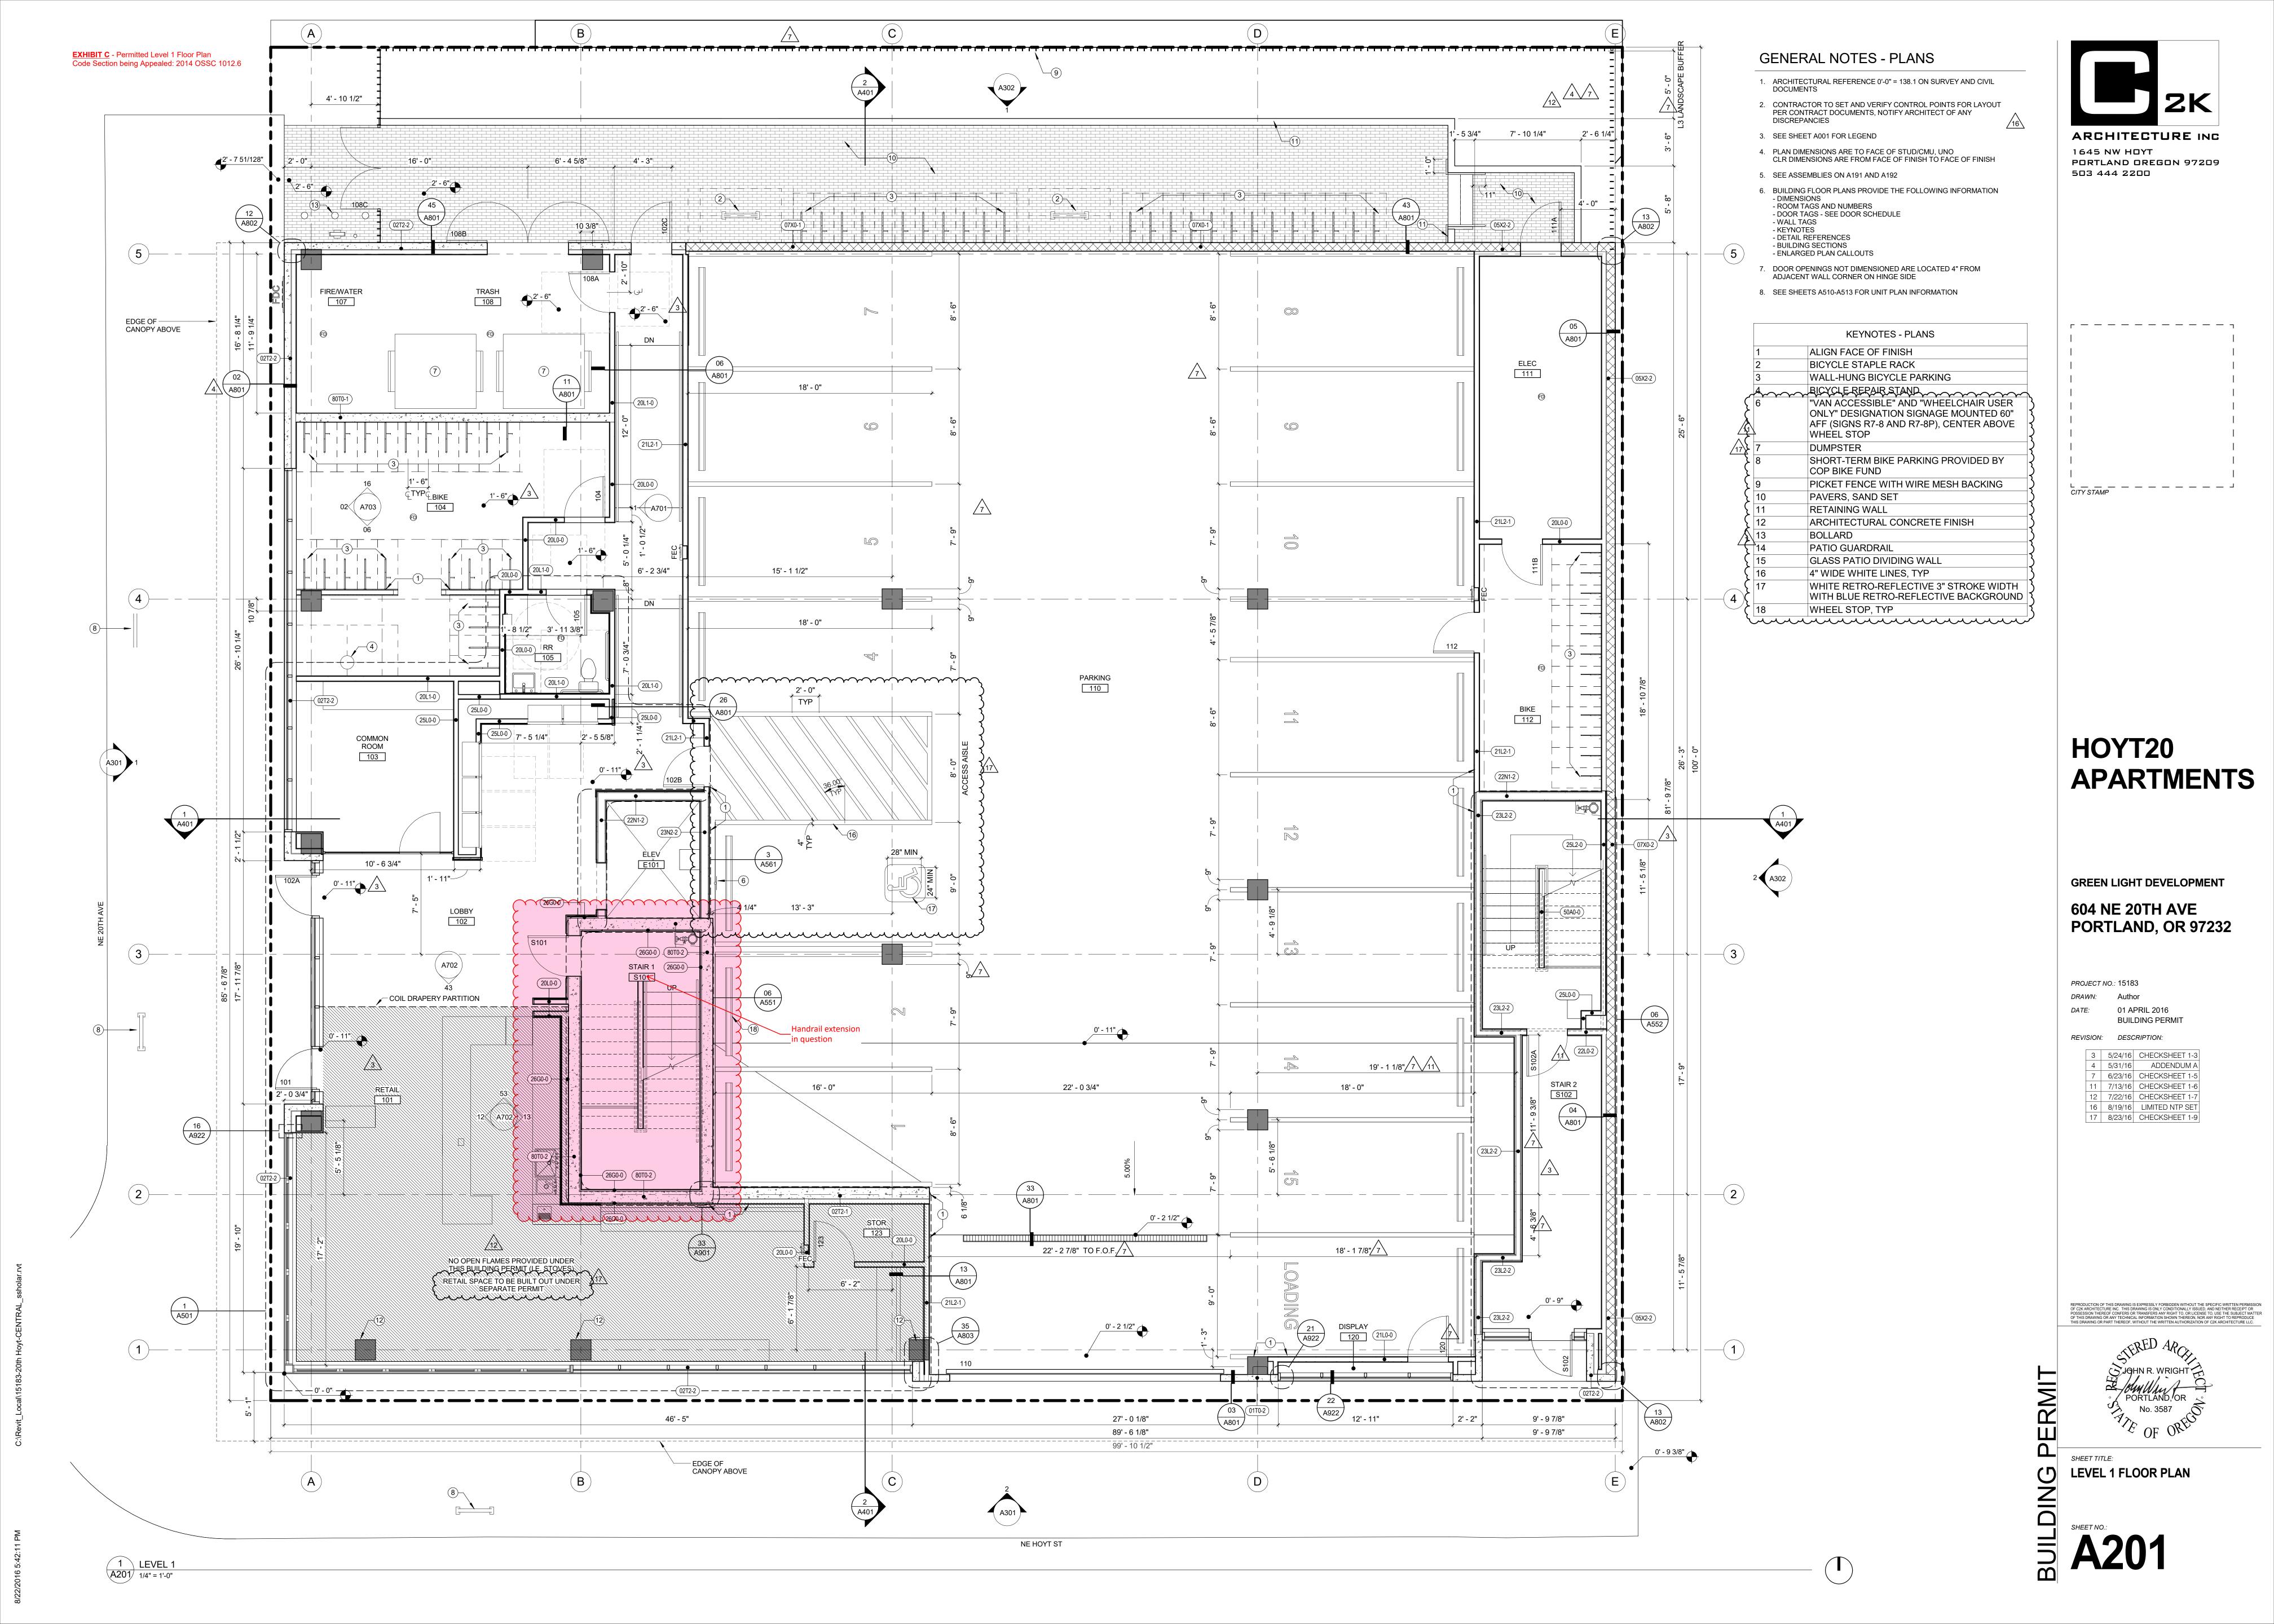

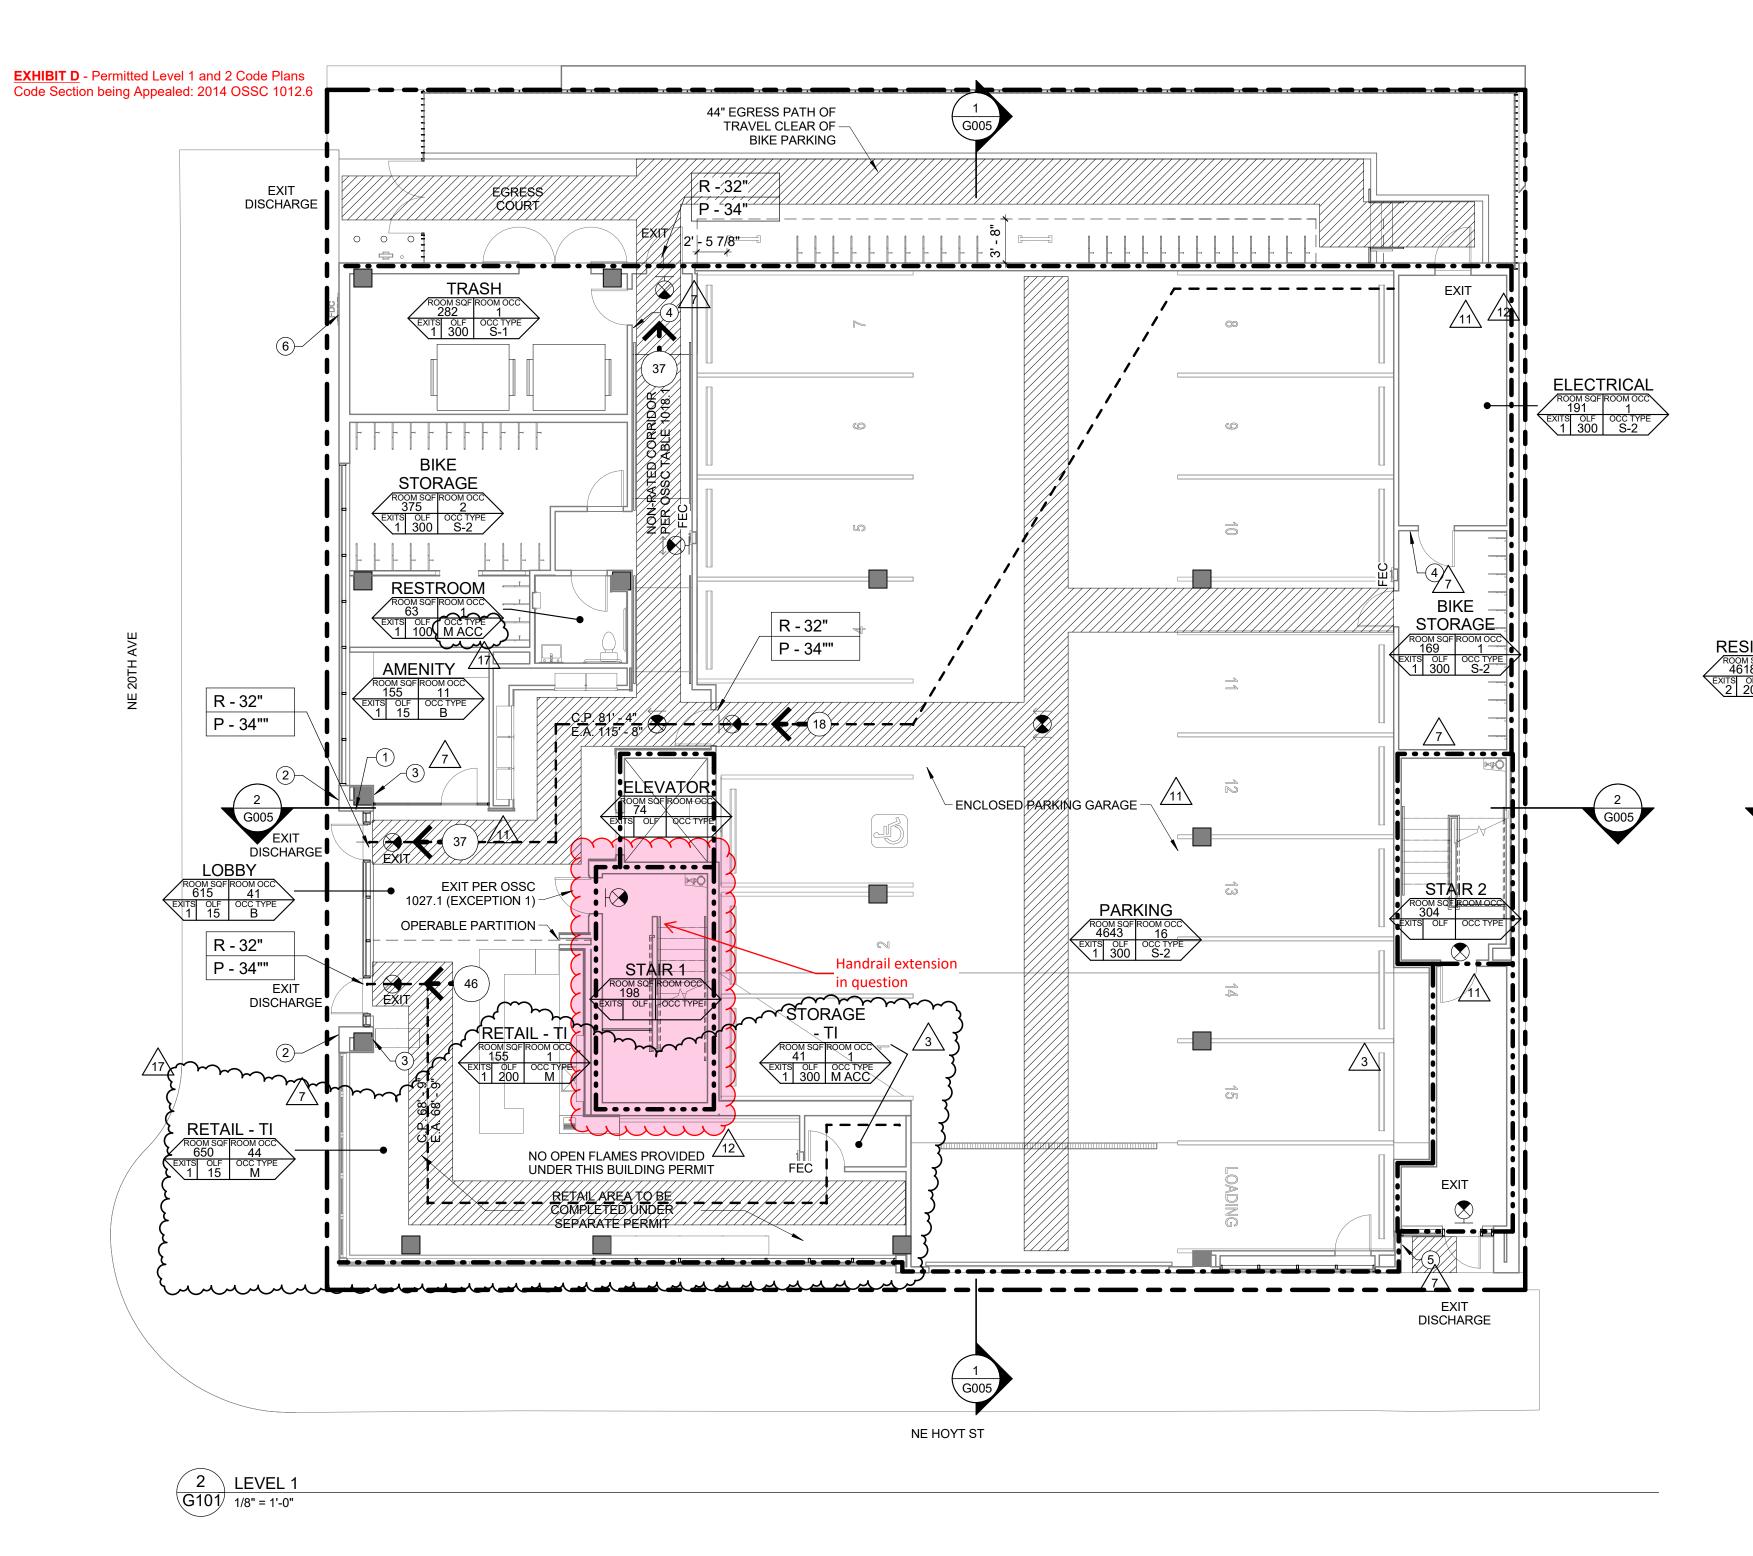


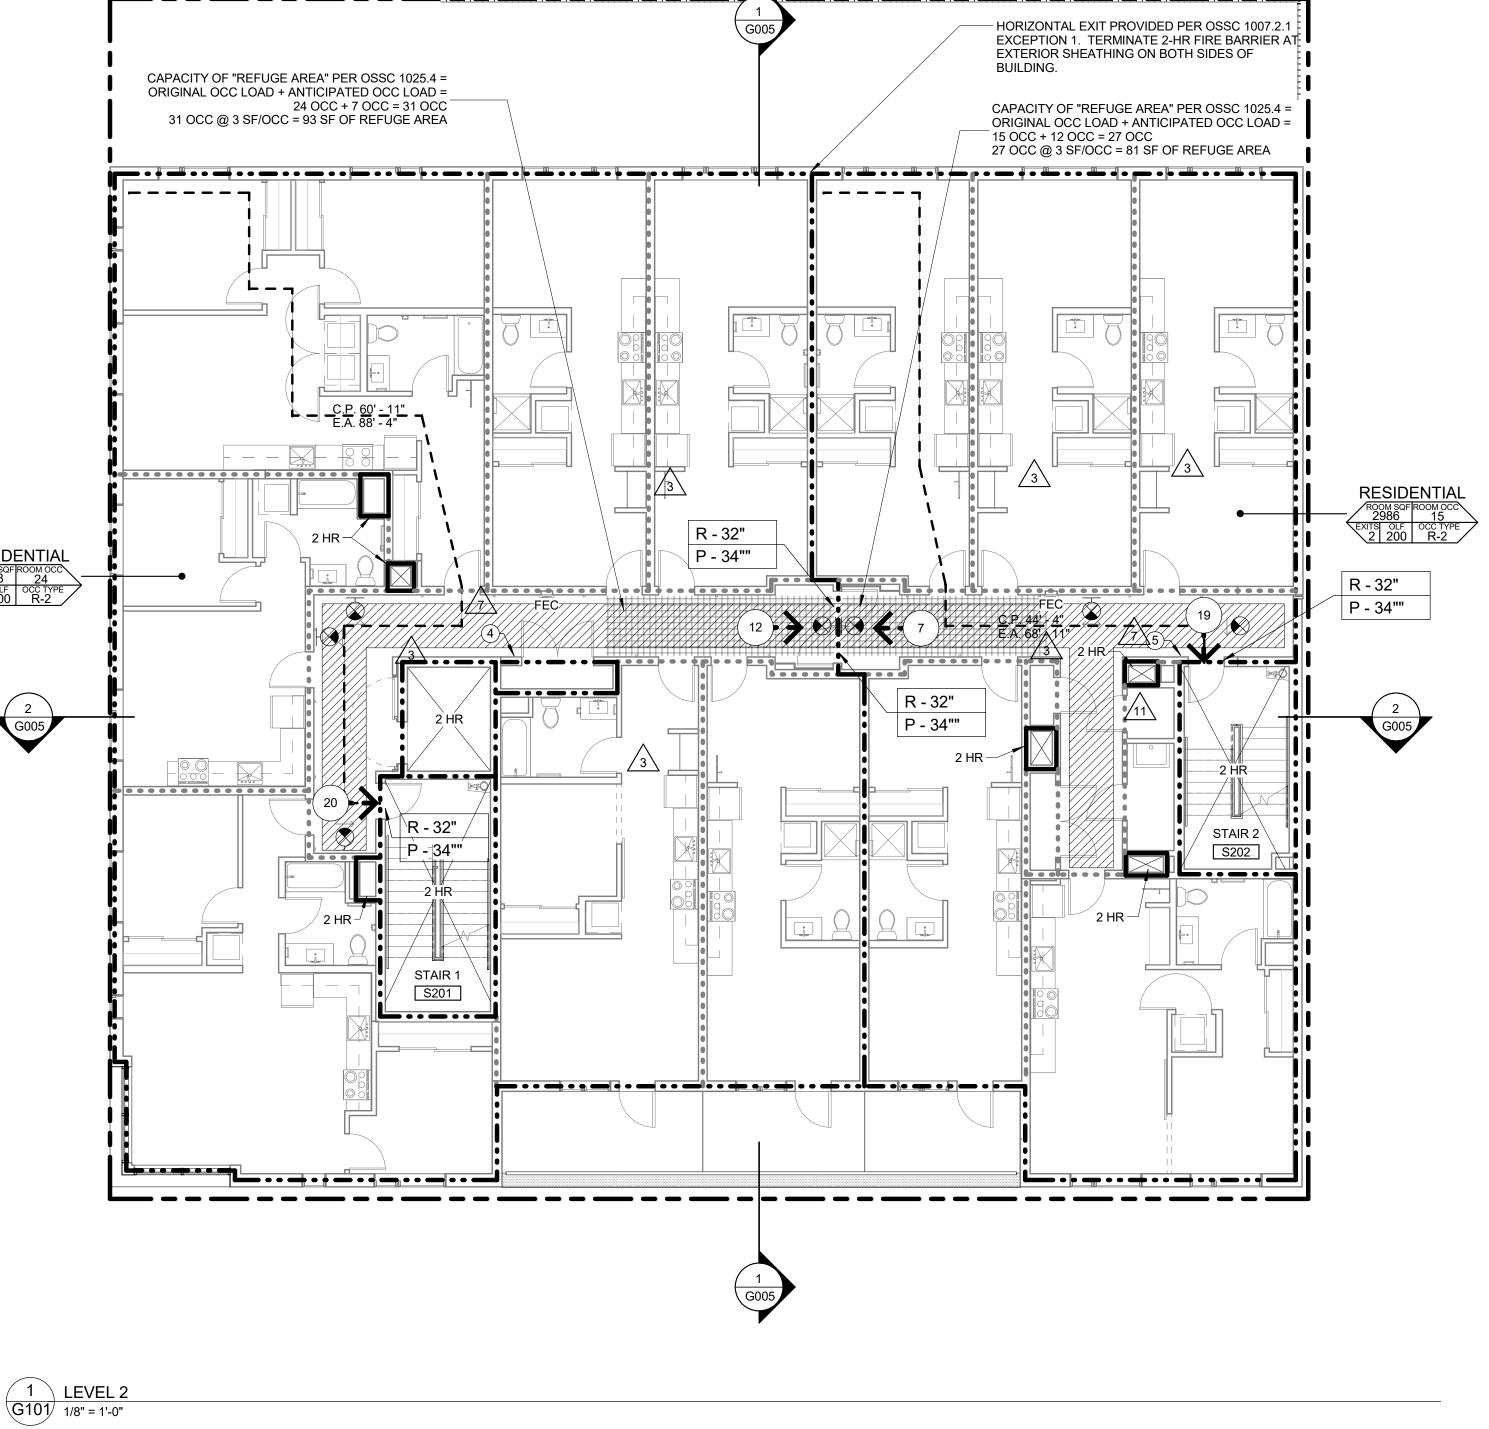

	KEYNOTES - CODE SHEETS	7
1	KNOX BOX	
2	BUILDING ADDRESS, NUMBERS TO CONTRAST WITH THEIR BACKGROUND AND BE A MINIMUM OF 4" HIGH WITH A MINUMUM STROKE WIDTH OF 0.5".	
3	OCCUPANT LOAD SIGNAGE, APPLICATIONS FOR OCCUPANT LOAD ARE AVAILABLE ONLINE AT: HTTPS://WWW.PORTLANDOREGON.GOV/FIRE/ARTICLE/230181	
4	EQUIPMENT ROOM SIGNAGE. ROOMS CONTAINING FIRE PROTECTION EQUIPMENT (AIR-CONDITIONING SYSTEMS, FIRE SPRINKLER, RISERS AND VALVES OR OTHER FIRE DETECTION, SUPPRESSION OR CONTROL ELEMENTS) AND ELECTRICAL/MECHANICAL/ELEVATOR MACHINE ROOMS SHALL BE IDENTIFIED IN AN APPROVED MANNER. REQUIRED SIGNS SHALL BE CONSTRUCTED OF DURABLE MATERIALS, PERMANENTLY INSTALLED AND READILY VISIBLE.	
5	STAIRWAY SIGNAGE INDICATING STAIRWAY CONTINUES TO ROOF, LOCATE AT STREET LEVEL AND ALL FLOOR LEVELS.	
6	PROVIDE APPROVED SIGNAGE ON SIDE OF BUILDING FOR FDC	1
7	FIREPLACE, UL RATED AND GLASS COVERED OPENING	
8	NO ROOF PENETRATIONS TO OCCUR WITHIN 5' OF EXTERIOR WALL	


BIKE STORAGE 375 SF 1 LEVEL 1 2 300 BIKE STORAGE 169 SF 1 LEVEL 1 1 300 ELECTRICAL 191 SF 1 LEVEL 1 1 300 ELEVATOR 74 SF LEVEL 1	olumns
AMENITY 155 SF 1 LEVEL 1 11 15  BIKE STORAGE 375 SF 1 LEVEL 1 2 300  BIKE STORAGE 169 SF 1 LEVEL 1 1 300  ELECTRICAL 191 SF 1 LEVEL 1 1 300  ELEVATOR 74 SF LEVEL 1	B PER OSSC 303.1.2 S-2 S-2 S-2
BIKE STORAGE       375 SF       1       LEVEL 1       2       300         BIKE STORAGE       169 SF       1       LEVEL 1       1       300         ELECTRICAL       191 SF       1       LEVEL 1       1       300         ELEVATOR       74 SF       LEVEL 1       1       LEVEL 1	S-2 S-2 S-2
BIKE STORAGE         169 SF         1         LEVEL 1         1         300           ELECTRICAL         191 SF         1         LEVEL 1         1         300           ELEVATOR         74 SF         LEVEL 1         1         300	S-2 S-2
ELECTRICAL         191 SF         1         LEVEL 1         1         300           ELEVATOR         74 SF         LEVEL 1         1         300	S-2
ELEVATOR 74 SF LEVEL 1	
	CIRCUI ATION
LODDY 045 05 4 LEVEL 4 44	
LOBBY 615 SF 1 LEVEL 1 41 15	B PER OSSC 303.1.2
PARKING 4643 SF 1 LEVEL 1 16 300	S-2
RESTROOM 63-8E/SY 1 LEVELT 1 100 100 100 100 100 100 100 100 100	~~~ MAGE~~~~~~~~~~~~~~~~~~~~~~~~~~~~~~~~~~~~
RETAIL - TI   650 SF   1   LEVEL 1   44 \( \sqrt{3} \)   15	M TO BE UNDER SEPARATE PERMIT
RETAIL - TI 155 SF 1 LEVEL 1 1 200	M TO BE UNDER SEPARATE PERMIT
STAIR 1 198 SF LEVEL 1	CIRCULATION
STAIR 2 304 SF LEVEL 1	CIRCULATION
STORAGE - TI	M ACC TO BE UNDER SEPARATE PERMIT
TRASH 282 SF 1 LEVELY 1 1 300 1 300 <del>mis</del> putient

				FLS SCHEDULE -	LEVEL 2		
		Exits		Occupant Load Columns	Occupant Load FACTOR columns		
Name	Area	Required	Level	Occupant Load	Occupant Load Factor	Occupant Type	Comments
	·						
RESIDENTIAL	4618 SF	2	LEVEL 2	24	200	R-2	
RESIDENTIAL	2986 SF	2	LEVEL 2	15	200	R-2	
	7603 SF			39	,		

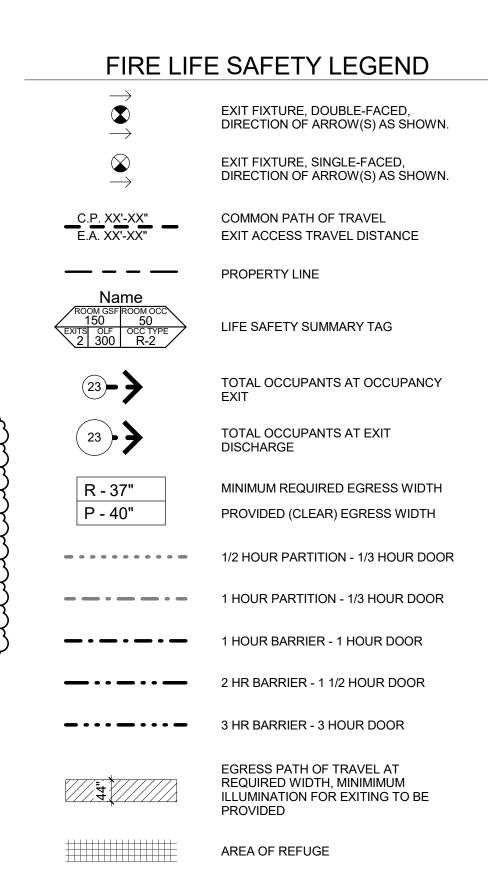

FIRE EXTINGUISHER CABINET



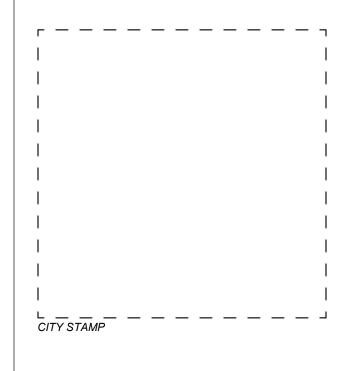

## HOYT20 APARTMENTS

GREEN LIGHT DEVELOPMENT

604 NE 20TH AVE PORTLAND, OR 97232

DATE: 01 APRIL 2016
BUILDING PERMIT

REVISION: DESCRIPTION:

3 5/24/16 CHECKSHEET 1-3
7 6/23/16 CHECKSHEET 1-5
11 7/13/16 CHECKSHEET 1-6
12 7/22/16 CHECKSHEET 1-7

Author

PROJECT NO.: 15183

DRAWN:

12 7/22/16 CHECKSHEET 1-7 17 8/23/16 CHECKSHEET 1-9

REPRODUCTION OF THIS DRAWING IS EXPRESSLY FORBIDDEN WITHOUT THE SPECIFIC WRITTEN ROF CZK ARCHITECTURE INC. THIS DRAWING IS ONLY CONDITIONALLY ISSUED, AND NEITHER RESPOSSESSION THEREOF CONFERS OR TRANSFERS ANY RIGHT TO, OR LICENSE TO, USE THE SUBJICT OF THIS DRAWING OR ANY TECHNICAL INFORMATION SHOWN THEREON, NOR ANY RIGHT TO REPROPER THIS DRAWING OR PART THEREOF, WITHOUT THE WRITTEN AUTHORIZATION OF CZK ARCHITECTURED THE CONTROL OF THE C

JOHN R. WRIGHT


PORTLAND, OR


No. 3587


OF ORTHOR

FIRE LIFE SAFETY - LEVEL 1
AND 2

G101

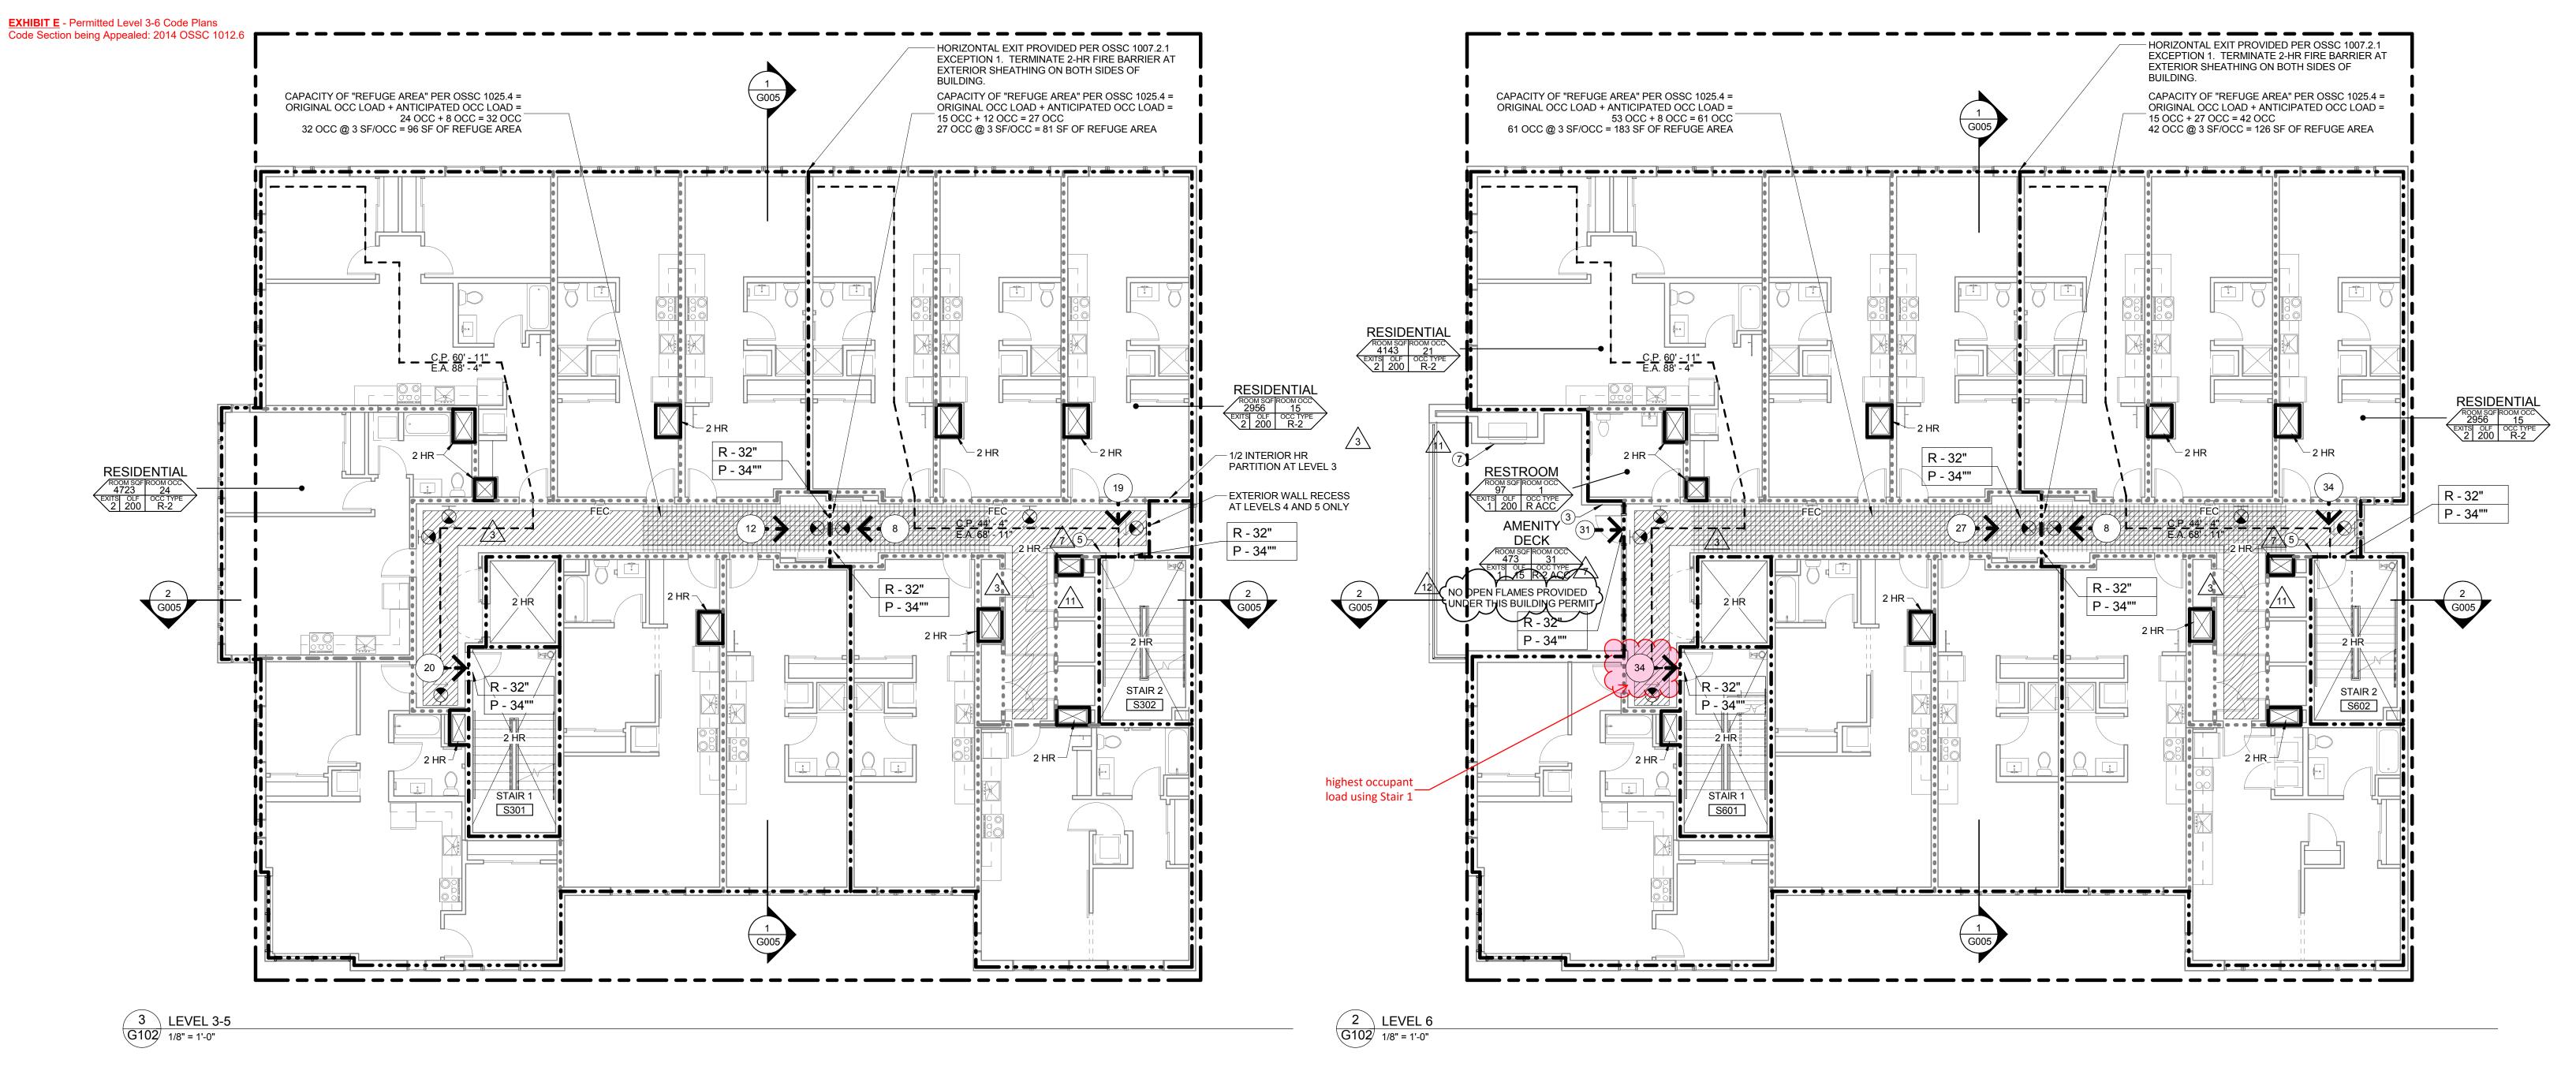

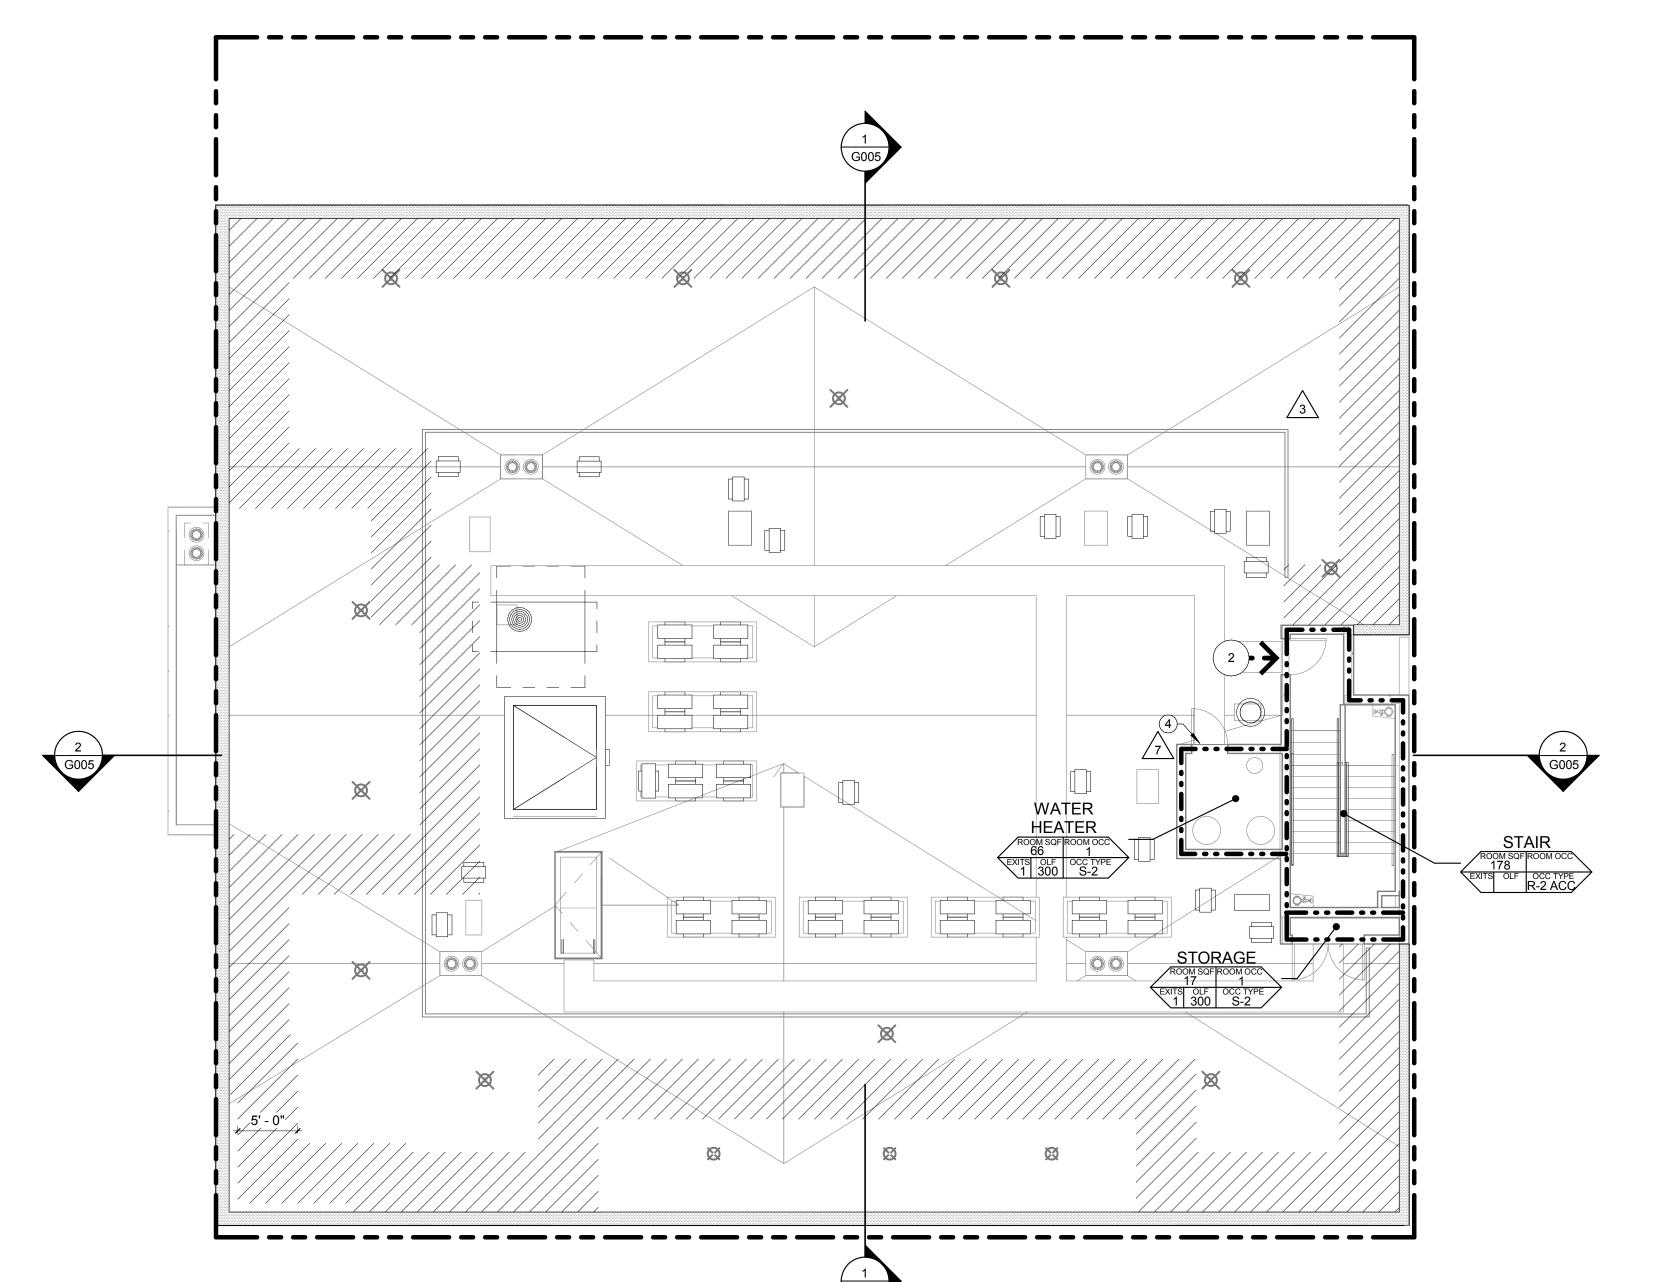

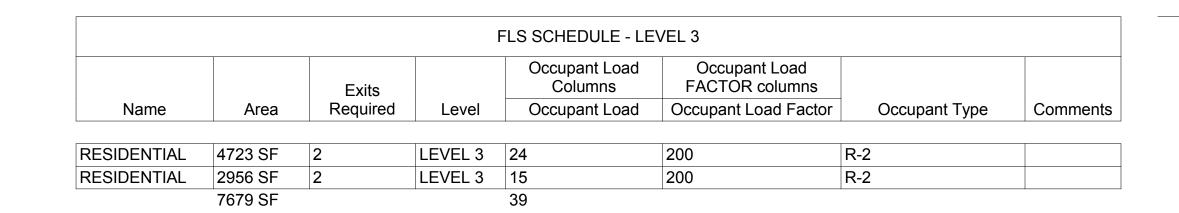

			F	FLS SCHEDULE - LE	VEL 6		
		Exits		Occupant Load Columns	Occupant Load FACTOR columns		
Name	Area	Required	Level	Occupant Load	Occupant Load Factor	Occupant Type	Comments
AMENITY DECK	473 SF	1	LEVEL 6	31	15	R-2 ACC	PER OSSC 303.1.2
RESIDENTIAL	4143 SF	2	LEVEL 6	21	200	R-2	
RESIDENTIAL	2956 SF	2	LEVEL 6	15	200	R-2	
RESTROOM	97 SF	1	LEVEL 6	1	200	R ACC	
	7668 SF			68		•	

				FLS SCHEDULE - R	OOF		
		Exits		Occupant Load Columns	Occupant Load FACTOR columns		
Name	Area	Required	Level	Occupant Load	Occupant Load Factor	Occupant Type	Comments
STAIR	178 SF		PARAPET			R-2 ACC	
STORAGE	17 SF	1	PARAPET	1	300	S-2	
WATER HEATER	66 SF	1	PARAPET	1	300	S-2	
	261 SF			2		1	

		KEYNOTES - CODE SHEETS	ı
٨	1	KNOX BOX	
<u>/</u> 3\	2	BUILDING ADDRESS, NUMBERS TO CONTRAST WITH THEIR BACKGROUND AND BE A MINIMUM OF 4" HIGH WITH A MINUMUM STROKE WIDTH OF 0.5".	
	3	OCCUPANT LOAD SIGNAGE, APPLICATIONS FOR OCCUPANT LOAD ARE AVAILABLE ONLINE AT: HTTPS://WWW.PORTLANDOREGON.GOV/FIRE/ARTICLE/230181	
	4	EQUIPMENT ROOM SIGNAGE. ROOMS CONTAINING FIRE PROTECTION EQUIPMENT (AIR-CONDITIONING SYSTEMS, FIRE SPRINKLER, RISERS AND VALVES OR OTHER FIRE DETECTION, SUPPRESSION OR CONTROL ELEMENTS) AND ELECTRICAL/MECHANICAL/ELEVATOR MACHINE ROOMS SHALL BE IDENTIFIED IN AN APPROVED MANNER. REQUIRED SIGNS SHALL BE CONSTRUCTED OF DURABLE MATERIALS, PERMANENTLY INSTALLED AND READILY VISIBLE.	
	5	STAIRWAY SIGNAGE INDICATING STAIRWAY CONTINUES TO ROOF, LOCATE AT STREET LEVEL AND ALL FLOOR LEVELS.	
11	6	PROVIDE APPROVED SIGNAGE ON SIDE OF BUILDING FOR FDC	
/11\	7	FIREPLACE, UL RATED AND GLASS COVERED OPENING	



FIRE LIFE SAFETY LEGEND

C.P. XX'-XX" E.A. XX'-XX"

23

R - 37"

P - 40"

EXIT FIXTURE, DOUBLE-FACED, DIRECTION OF ARROW(S) AS SHOWN.

DIRECTION OF ARROW(S) AS SHOWN.

EXIT FIXTURE, SINGLE-FACED,

COMMON PATH OF TRAVEL

LIFE SAFETY SUMMARY TAG

TOTAL OCCUPANTS AT EXIT DISCHARGE

1/2 HOUR PARTITION - 1/3 HOUR DOOR

1 HOUR PARTITION - 1/3 HOUR DOOR

3 HR BARRIER - 3 HOUR DOOR

TOTAL OCCUPANTS AT OCCUPANCY EXIT

MINIMUM REQUIRED EGRESS WIDTH

PROVIDED (CLEAR) EGRESS WIDTH

1 HOUR BARRIER - 1 HOUR DOOR

2 HR BARRIER - 1 1/2 HOUR DOOR

EGRESS PATH OF TRAVEL AT REQUIRED WIDTH, MINIMIMUM ILLUMINATION FOR EXITING TO BE

FIRE EXTINGUISHER CABINET

AREA OF REFUGE

EXIT ACCESS TRAVEL DISTANCE

GREEN LIGHT DEVELOPMENT

604 NE 20TH AVE PORTLAND, OR 97232

ARCHITECTURE INC

PORTLAND OREGON 97209

1645 NW HOYT

503 444 2200

PROJECT NO.: 15183

DRAWN: Author

DATE: 01 APRIL 2016

BUILDING PERMIT

REVISION: DESCRIPTION:

3 5/24/16 CHECKSHEET 1-3 7 6/23/16 CHECKSHEET 1-5 11 7/13/16 CHECKSHEET 1-6 12 7/22/16 CHECKSHEET 1-7

REPRODUCTION OF THIS DRAWING IS EXPRESSLY FORBIDDEN WITHOUT THE SPECIFIC WRITTEN PER OF C2K ARCHITECTURE INC. THIS DRAWING IS ONLY CONDITIONALLY ISSUED, AND NEITHER RECEIPT POSSESSION THEREOF CONFERS OR TRANSFERS ANY RIGHT TO, OR LICENSE TO, USE THE SUBJECT OF THIS DRAWING OR ANY TECHNICAL INFORMATION SHOWN THEREON, NOR ANY RIGHT TO REPROD THIS DRAWING OR PART THEREOF, WITHOUT THE WRITTEN AUTHORIZATION OF C2K ARCHITECTURE

PORTLAND, OR No. 3587

OF ORL

SHEET TITLE:

FIRE LIFE SAFETY - LEVEL
3-ROOF

SHEET NO.:
G102