# **Development Services**

# From Concept to Construction







APPEAL SUMMARY

Status:	Decision	Rendered
---------	----------	----------

Appeal ID: 14917	Project Address: 1500 SE Hawthorne Blvd		
Hearing Date: 4/12/17	Appellant Name: ROBERT SALADOFF		
Case No.: B-012	Appellant Phone: 5416019031		
Appeal Type: Building	Plans Examiner/Inspector: Geoffrey Harker		
Project Type: commercial	Stories: 3 Occupancy: R-2 Construction Type: V-B		
Building/Business Name: The Celine Apartments	Fire Sprinklers: No		
Appeal Involves: Addition to an existing structure	LUR or Permit Application No.: 17-133296-CO		
Plan Submitted Option: pdf [File 1] [File 2] [File 3] [File 4] [File 5] [File 6] [File 7]	Proposed use: Exterior Stair		

# APPEAL INFORMATION SHEET

# Appeal item 1

$C \sim 4 \sim$	Section
Coue	SECHOL

602,705.8,1026.5

# Requires

Table 602 - Fire-Resistance rating requirements for exterior walls based on fire separation

distance.

Table 705.8 - Maximum area of exterior wall openings based on fire separation distance and

degree of opening protection

Section 1026.5 - Location - Exterior exit stairways and ramps shall have a minimum fire separation distance of 10'-0" measured from the exterior edge of the stairway or ramp, including

landings, to adjacent lot lines and from other buildings on the same lot.

# **Proposed Design**

The proposed stairway design will consist of:

Concrete footings and 4 x 4 structural posts Cedar, structural wood posts, stringers and beams Cedar railing posts, treads and risers, railings

The new stair will connect the existing second floor exit door to the ground at the rear of the building and will provide secondary egress for second floor tenants. The stair will be 9'-3 1/2" from the nearest accessory building property. No other buildings or property lines are within 10'-0". The current accessory building consists of the original storage units that are adjacent to the alley to the south and a small extension (building area in question). The accessory building is used for storage only. It is this building extension that extends 9" into the 10'-0" minimum setback. See plans for details and more information.

### Reason for alternative

The proposed project consists of a new, required, code-compliant stair located in the south rear yard of the property, providing a second means of egress for the second story units. The stair will replace the original metal stair that was removed several years ago by a previous owner. The new stair will continue to connect the upper egress location to the ground plane in the same general area as the original historical stairway.

The existing site and building conditions pose several competing dimensional, fire-code and historic considerations that limit design options for the client. Several alternative layouts were explored, but the small side yard, limited setbacks and the requirements of the Historic Resource Review for the Ladd's Addition eliminated these options. Although the proposed design is 8 1/2" short of the 10' setback, it is the best practical solution given the existing conditions and competing considerations.

### Code Considerations:

The following code sections are relevant and have been used to direct the design layout and construction detailing and provide exceptions and mitigating circumstances for approval of the proposed design. We are seeking approval of the appeal based on the 1) difficult existing site conditions as stated previously, 2) historic review considerations and approval of the proposed design, 3) the removal of existing openings in the affected wall surface and 4) because the encroachment is less than 9" out of 10'.

Table 602 - Fire-Resistance rating requirements for exterior walls based on fire separation distance. We are seeking an exception to this requirement with the encroachment of less than 9".

The alternative fire protection measure, namely a fire-wall adjacent or part of the perimeter of the stair and landing is not suitable for this situation, as it would block all circulation to and from the two other existing stairs at the rear of the building. These stairs provide a secondary access to the rear apartment and the only access to the shared laundry and basement storage and adequate horizontal and vertical clearances will be maintained with the proposed design.

Table 705.8 – Maximum area of exterior wall openings based on fire separation distance and degree of opening protection. The wall in question has total wall area of 70.5 SF. The existing window has an area of 14 SF, or 20% of the wall area surface, exceeding the maximum allowable area of 10% for buildings less than 10' from proposed stair.

To mitigate this condition, the existing window will be removed and the opening will be framed to match existing wall construction.

Section 1026.5 – Location - Exterior exit stairways and ramps shall have a minimum fire separation distance of 10'-0" measured from the exterior edge of the stairway or ramp, including landings, to adjacent lot lines and from other buildings on the same lot.

We are seeking for an exception to this requirement, as the encroachment into the minimum setback requirement will be less than 9 inches.

### **Historic Review Considerations:**

The project site is located in the Ladd's Addition Historic District and is subject to a Historic Resource Review (approved) that includes maintaining the historic character and record of its time, maintaining historic features and materials, and providing architectural compatibility with any changes or additions.

The proposed design allows the existing building exterior to remain as is while providing a needed secondary, safe egress for tenants. The project received approval from the BDS on 2/14/17.

Alternative layouts and location for the stair were explored with the city during the LU action and review, and were all rejected as they were either more visible from the street or encroached upon the setback with the accessory building in question.

# APPEAL DECISION

# Replacement stair within 10 feet of adjacent building on same lot: Granted as proposed.

The Administrative Appeal Board finds that the information submitted by the appellant demonstrates that the approved modifications or alternate methods are consistent with the intent of the code; do not lessen health, safety, accessibility, life, fire safety or structural requirements; and that special conditions unique to this project make strict application of those code sections impractical.

Pursuant to City Code Chapter 24.10, you may appeal this decision to the Building Code Board of Appeal within 180 calendar days of the date this decision is published. For information on the appeals process and costs, including forms, appeal fee, payment methods and fee waivers, go to www.portlandoregon.gov/bds/appealsinfo, call (503) 823-7300 or come in to the Development Services Center.

# CONSULTANTS

**ARCHITECT** 

STRUCTURAL ENGINEER

ROBERT SALADOFF, ARCHITECT **3519 NE 45TH AVENUE** PORTLAND, OR 97213 541-601-9031

MILLER CONSULTING ENGINEERS 9570 SW BARBUR BLVD PORTLAND, OR 97219 503-246-1250

**GENERAL CONTRACTOR** 

TBD

PORTLAND, OR 97282-0606

LANDSCAPE ARCHITECT

CLIENTS

SLJ LLC

JOSH SHULMAN

PO BOX 82606

# MECHANICAL CONTRACTOR

# PLANNING SUMMARY

PROJECT NAME/ADDRESS:

THE CELINE 1500 SE HAWTHORNE BLVD. PORTLAND, OR 97214

**ZONING DESIGNATION: RESIDENTIAL R-1** 

PROPERTY DESCRIPTION:

1500 SE HAWTHORNE BLVD. PORTLAND, OR 97214

PROPERTY ID: R200392

TAX RECORD: LADDS ADD, BLOCK 14, E 20' OF LOT 8 EXC PT IN ST, LOT 11 EXC PT IN ST, W 15'

OF LOT 12 EXC PT IN ST

8-UNIT MULTI-FAMILY

# DRAWING INDEX

SHEET NO. SHEET TITLE

**COVER SHEET** 

SITE PLAN

FLOOR PLANS FLOOR PLANS - OCCUPANCY LOADS AND EGRESS

**PLANS** 

**ENLARGED STAIR PLANS** STAIR ELEVATIONS

**DETAILS** 

STRUCTURAL DRAWINGS PROVIDED BY ENGINEER STAIR DETAILS

STRUCTURAL NOTES S1.01 **FLOOR PLANS** PLAN AND ELEVATIONS

EAST FIRE ESCAPE PLAN **ELEVATIONS AND SECTIONS** 

**DETAILS** 

# BUILDING CODE

-BUILDING CODE: 2014 OREGON SPECIALTY **CODE W/UPDATES** -CONSTRUCTION TYPE: TYPE V- B -OCCUPANCY TYPE: GROUP R-2

1 NEW EGRESS STAIR

1 EXISTING FIRE ESCAPE

6.536 S.F

**BSMT - UNFINISHED** BSMT - FINISHED

LOT SIZE:

**SECOND** ATTIC

DET. GARAGE/STORAGE

**BUILDING COVERAGE**: 3,163 S.F. (34%)

# **BUILDING SUMMARY**

LOAD TESTING

9,225 S.F. (.21 ACRES)

APT. BLDG. - FINISHED

622 S.F. 1,017 S.F.

1,885 S.F. 2,154 S.F. 1,480 S.F.

634 S.F.

# ABBREVIATIONS

. –	ANCHOR BOLT	D.L.	DEAD LOAD	GALV.	GALVANIZED			5.J.	SAWN JOINT
A.D.J. A.A.A. B.B.B.B. C.C.C.C.C.C.C.C.C.C.C.C.C.C.C	ACOUSTICAL ADJUSTABLE AIR CONDITIONER ABOVE FINISH FLOOR AIR HANDLER ASPHALT CONCRETE  BOTTOM OF FOOTING BEAM BUILDING BUILT-UP  CABINET CEILING CENTER CENTERLINE COLUMN CONCRETE CONCRETE MASONRY UNIT CONTINUOUS CONTROL JOINT COUNTERSINK	DDDDDDD EEEEEEEEEEEEEEEEFF. P.A.M.B.S.W.E.E.D.N.Q.H.S.P.I.T. G.N.F.	DEEP DIAMETER DIMENSION DOUBLE DOWN SPOUT DRAWING DRINKING FOUNTAIN  EACH EACH SIDE EACH WAY ELECTRIC ELEVATION ENCLOSURE EDGE NAILING EQUAL EXHAUST EXISTING EXPANSION EXPANSION EXPANSION EXPANSION EXPANSION FIBERGLASS FINISH FINISH FLOOR	GGGGGGGGGGGGGGGGGGGGGGGGGGGGGGGGGGGGGG	GAUGE GARBAGE DISPOSAL GLASS GLUE LAM BEAM GYPSUM WALL BOARD HARDWARE HEADER HEIGHT HEATING VENTILATING & AIR CONDITIONING HOLLOW CORE HOLLOW METAL HORIZONTAL HOSE BIBB KILN DRIED LAMINATED LIGHT LIVE LOAD MANUFACTURER MECHANICAL MAKE IT WORK	(N.T. BOOOO PPPPPPP RRRRRRRRRRRRRRRRRRRRRRRRR	NEW NOT IN CONTRACT NOT TO SCALE  OBSCURE ON CENTER OVER OVERHEAD  PAIR PAINTED PLASTIC OR PLATE PLASTIC LAMINATE PLYWOOD PRESSURE TREATED PROPERTY LINE  RADIUS REFRIGERATOR REGISTER REINFORCING REQUIRED RIGHT HAND ROOF DRAIN ROOM	SECT. SHM. S.C. K.C. SPEQ. N. ST. ST. S.D. ST. S	SECTION SHEET SIMILAR SLIDING SOLID CORE SPEAKER SPECIFICATIONS SQUARE STAINED STAINLESS STEEL STANDARD STEEL STRUCTURAL SUSPENDED TELEPHONE TEMPERED OR TEMPORARY TONGUE & GROOVE TOOLED JOINT TOP OF TYPICAL WATER RESISTANT WEATHER PROOF WELDED WIRE MESE WITH

# SYMBOLS

T.O. CONCRETE ELEV. +1860.75' **ELEVATION BUILDING SECTION** DETAIL REFERENCE **EXTERIOR ELEVATIONS** ELEV. NO. **INTERIOR ELEVATIONS** DOOR TYPE

WINDOW TYPE

INT. PARTITIONS & WALL ASSY'S

REVISION

(+)—TYPE NO.

TYPE NO.

REVISION NO.

ASSEMBLY NO.

**EXISTING WALL** WALL, ASSEMBLY, FIXTURE TO BE DEMOLISHED **NEW PARTITION OR BEARING WALL** CONC. MASONRY WALL

CONCRETE

# ENGINEERING GUIDE

GENERAL NOTES: THE APARTMENT BUILDING WILL BE OCCUPIED DURING CONSTRUCTION AND THE FOLLOWING CONDITIONS AND SAFETY GUIDELINES WILL BE USED.

STRUCTURAL SAFETY: THE PROPOSED EXTERIOR STAIR INVOLVES ONLY EXTERIOR WORK AND THE EXISTING STRUCTURE WILL BE UNAFFECTED BEFORE, DURING AND AFTER CONSTRUCTION. EXTERIOR GLAZING AND ARCHITECTURAL FEATURES WILL BE PROTECTED FROM CONSTRUCTION ACTIVITIES DURING CONSTRUCTION SCHEDULE.

FIRE SAFETY: ALL FIRE AND LIFE SAFETY FEATURES WILL REMAIN INTACT AND FUNCTIONAL DURING THE CONSTRUCTION SCHEDULE. ALL EXISTING EXIT PLANS WILL BE UNAFFECTED BY CONSTRUCTION AT THE REAR OF THE BUILDING. ALL EXISTING EXIT PLANS WILL REMAIN FULLY ACCESSIBLE DURING CONSTRUCTION, UNLESS NOTED OTHERWISE HERE. THE LAUNDRY FACILITIES IN THE BASEMENT WILL BE CLOSED DURING CONSTRUCTION AND TENANTS WILL BE GIVEN ALTERNATIVE OFFSITE FACILITIES WILL BE OFFERED TO TENANTS.

OCCUPANCY SAFETY PROGRAM: ALL WORK AREAS AND CONSTRUCTION MATERIALS WILL BE CLEARLY IDENTIFIED, PROTECTED AND FENCED OFF AT ALL TIMES DURING THE CONSTRUCTION SCHEDULE. TENANTS WILL BE NOTIFIED IN ADVANCE OF THE SCOPE OF WORK, CONSTRUCTION SCHEDULE AND ROUTES OF TRAVEL, CIRCULATION AND EGRESS DURING CONSTRUCTION. CLEAR SIGNAGE WILL BE PROVIDED TO IDENTIFY ROUTES OF TRAVEL AND EGRESS, AS WELL AS THE CONSTRUCTION SITE AND MATERIAL STORAGE.

THE GENERAL CONTRACTOR SHALL KEEP THE CONSTRUCTION SITE A BROOM CLEAN CONDITION AT ALL TIMES DURING THE PROJECT.


IT SHALL BE THE RESPONSIBILITY OF THE CONTRACTOR TO VERIFY THE LOCATION OF ALL EXISTING UTILITIES WHETHER SHOWN HEREIN OR NOT AND TO PROTECT THEM FROM DAMAGE AND FOR THE SAFETY OF ALL TENANTS AND WORKERS. THE CONTRACTOR SHALL BE RESPONSIBLE FOR THE COMPLETE SECURITY OF THE SITE WHILE THE JOB IS IN PROGRESS AND UNTIL JOB COMPLETION. THE CONTRACTOR SHALL TAKE ALL NECESSARY PRECAUTIONS TO ENSURE THE SAFETY OF THE OCCUPANTS AND WORKERS AT ALL TIMES.

THE SHARED LAUNDRY ROOM WILL BE CLOSED OFF UP TO TWO WEEKS DURING THE CONSTRUCTION PERIOD. ALTERNATIVE OFFSITE MEASURES WILL BE OFFERED TO TENANTS.

# GENERAL NOTES

- 1. THE CONTRACTOR SHALL FIELD VERIFY ALL CONDITIONS AND DIMENSIONS PRIOR TO ANY WORK AND SHALL BE RESPONSIBLE FOR ALL WORK AND MATERIALS INCLUDING THOSE FURNISHED BY SUBCONTRACTORS.
- 2. DIMENSIONS TAKE PRECEDENCE OVER DRAWING: DO NOT SCALE DRAWINGS TO DETERMINE ANY LOCATIONS. THE ARCHITECT SHALL BE NOTIFIED OF ANY DISCREPANCY PRIOR TO CONTINUING WITH WORK
- GENERAL CONTRACTOR SHALL KEEP THE CONSTRUCTION SITE A BROOM CLEAN CONDITION AT ALL TIMES DURING THE PROJECT
- 4. THE CONTRACTOR SHALL REPORT TO THE ARCHITECT ANY ERRORS. INCONSISTENCIES OR OMISSIONS HE OR SHE MAY DISCOVER. THE CONTRACTOR IS RESPONSIBLE FOR CORRECTING ANY ERROR AFTER THE START OF CONSTRUCTION WHICH HAS NOT BEEN BROUGHT TO THE ATTENTION OF THE ARCHITECT. THE MEANS OF CORRECTING ANY ERROR SHALL BE APPROVED BY THE ARCHITECT
- 5. ALL REQUIRED CITY AND / OR COUNTY LICENSE SHALL BE ACQUIRED AND PAID FOR BY THE INDIVIDUAL TRADES.
- THE ARCHITECT WILL REVIEW SHOP DRAWINGS AND SAMPLES AS REQUIRED FOR CONFORMANCE WITH THE DESIGN CONCEPT OF THE PROJECT. THE ARCHITECT'S REVIEW OF A SEPARATE ITEM SHALL NOT INDICATE APPROVAL OF AN ASSEMBLY IN WHICH THE ITEM FUNCTIONS.
- 7. IT SHALL BE THE RESPONSIBILITY OF THE CONTRACTOR TO VERIFY LOCATION OF ALL EXISTING UTILITIES WHETHER SHOWN HEREIN OR NOT AND TO PROTECT THEM FROM DAMAGE. THE CONTRACTOR SHALL BEAR ALL EXPENSES OF REPAIR OR REPLACEMENT OF UTILITIES OR OTHER PROPERTY DAMAGED BY OPERATIONS IN CONJUNCTION WITH THE **EXECUTION OF THE WORK**
- CITY APPROVED PLANS SHALL BE KEPT IN A SECURE PLACE AND SHALL BE RESPONSIBLE THAT ALL CONTRACTORS' CONSTRUCTION SETS REFLECT THE SAME INFORMATION. THE CONTRACTOR SHALL ALSO MAINTAIN, IN GOOD CONDITION, ONE COMPLETE SET OF STAMPED CITY APPROVED PLANS WITH ALL REVISION, ADDENDUMS AND CHANGE ORDERS ON THE PREMISES AT ALL TIMES. THESE ARE UNDER THE CARE OF THE JOB SUPERINTENDENT AND MUST BE MADE AVAILABLE TO BUILDING AND FIRE INSPECTORS FOR REFERENCE DURING CONSTRUCTION
- 9. THE CONTRACTOR SHALL BE RESPONSIBLE FOR THE COMPLETE
- 10. THE CONTRACTOR SHALL TAKE ALL NECESSARY PRECAUTIONS TO ENSURE THE SAFETY OF THE OCCUPANTS AND WORKERS AT ALL TIMES.
- 11. THE CONTRACTOR IS SOLELY RESPONSIBLE FOR ALL CONSTRUCTION MEANS AND METHODS AND SHALL MAINTAIN THE STRUCTURAL INTEGRITY OF ANY CONSTRUCTION UNTIL ALL FINAL LATERAL AND VERTICAL LOAD CARRYING SYSTEMS ARE COMPLETED.
- 12. THE CONTRACTOR SHALL BE RESPONSIBLE FOR AND SHALL REPLACE OR REMEDY ANY FAULTY, IMPROPER OR INFERIOR MATERIALS OR WORKMANSHIP WHICH SHALL APPEAR, WITHIN ONE (1) YEAR (OR AS PROPOSED TO CLIENT) AFTER THE COMPLETION AND ACCEPTANCE OF THE WORK UNDER THE CONTRACT.
- 13. CONTRACTOR TO PROVIDE BACKING OR BLOCKING AS REQUIRED FOR MOUNTING ALL WALL MOUNTED SHELVES, EQUIPMENT, ACCESSORIES CABINETS, ETC.
- 14. THE CONTRACTOR IS TO PROTECT ALL TREES AND ROOTS NOT SLATED FOR REMOVAL DURING CONSTRUCTION.
- 15. THE GENERAL CONTRACTOR IS RESPONSIBLE FOR MAINTENANCE OF STAGING AREA, AND TO ENSURE THAT MATERIALS DELIVERY AND STORAGE DOES NOT INTERFERE WITH DAILY OPERATION OF ADJACENT
- PROPERTIES OR PUBLIC RIGHT OF WAY. 16. THE GENERAL CONTRACTOR IS RESPONSIBLE FOR CONSTRUCTION

# VICINITY MAP

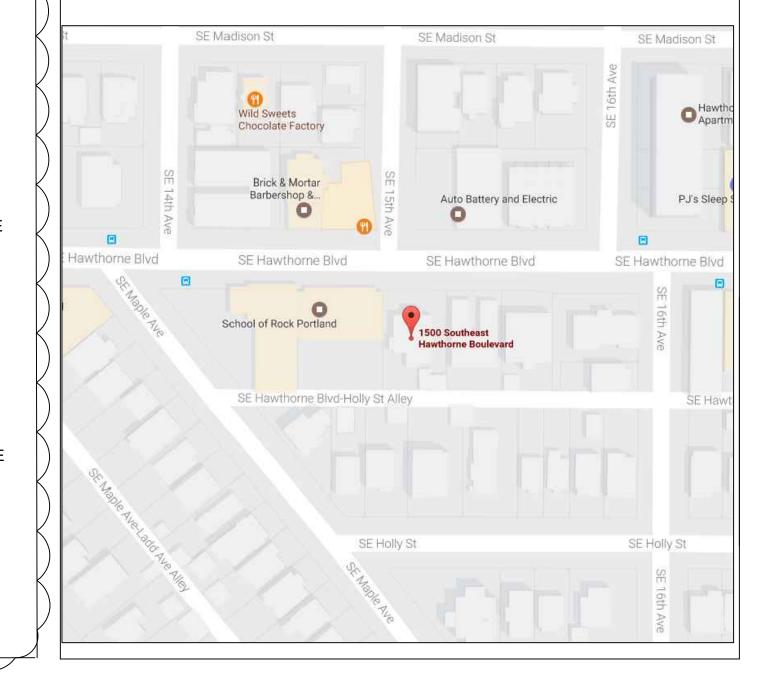




M


PHASE/DATE ISSUED PLANNING: **DEMOLITION:** 


CD'S/PERMIT: 03.07.17 **\ REVISON 1** 

> **TMENT** NE 972 AR AP, HAW 'LANI LINE SE OR

**DRAWINGS: COVER SHEET** 

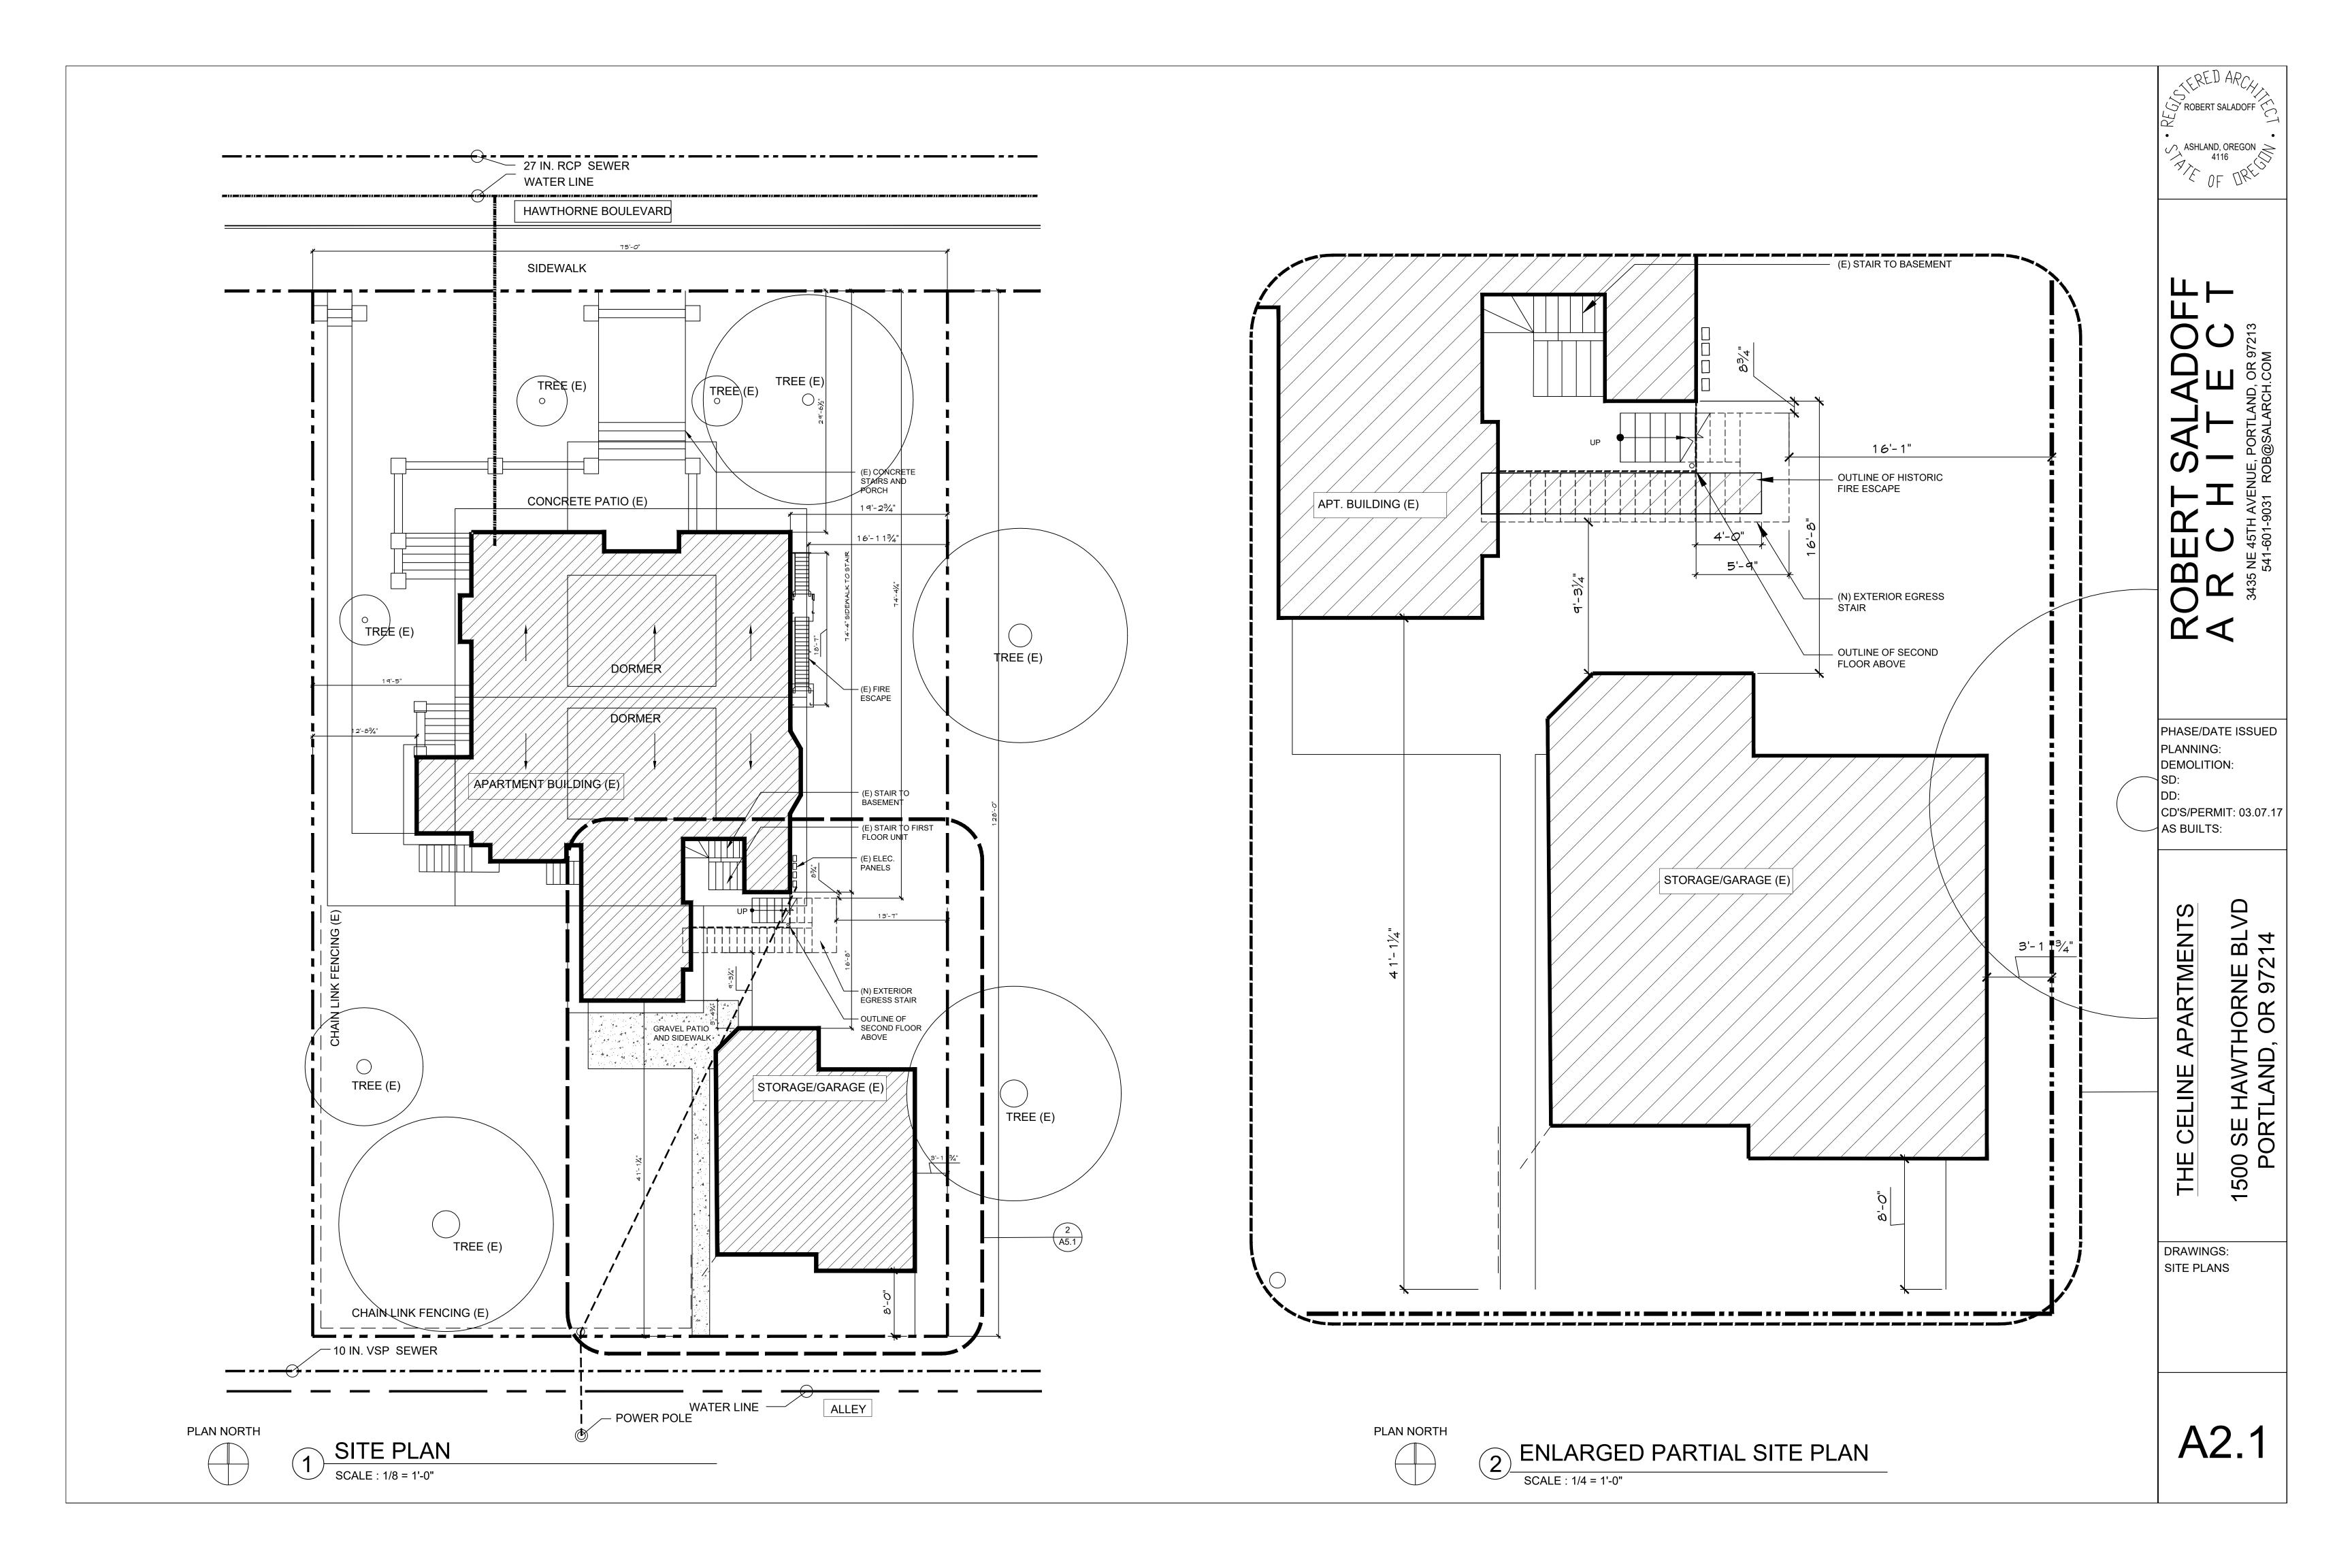

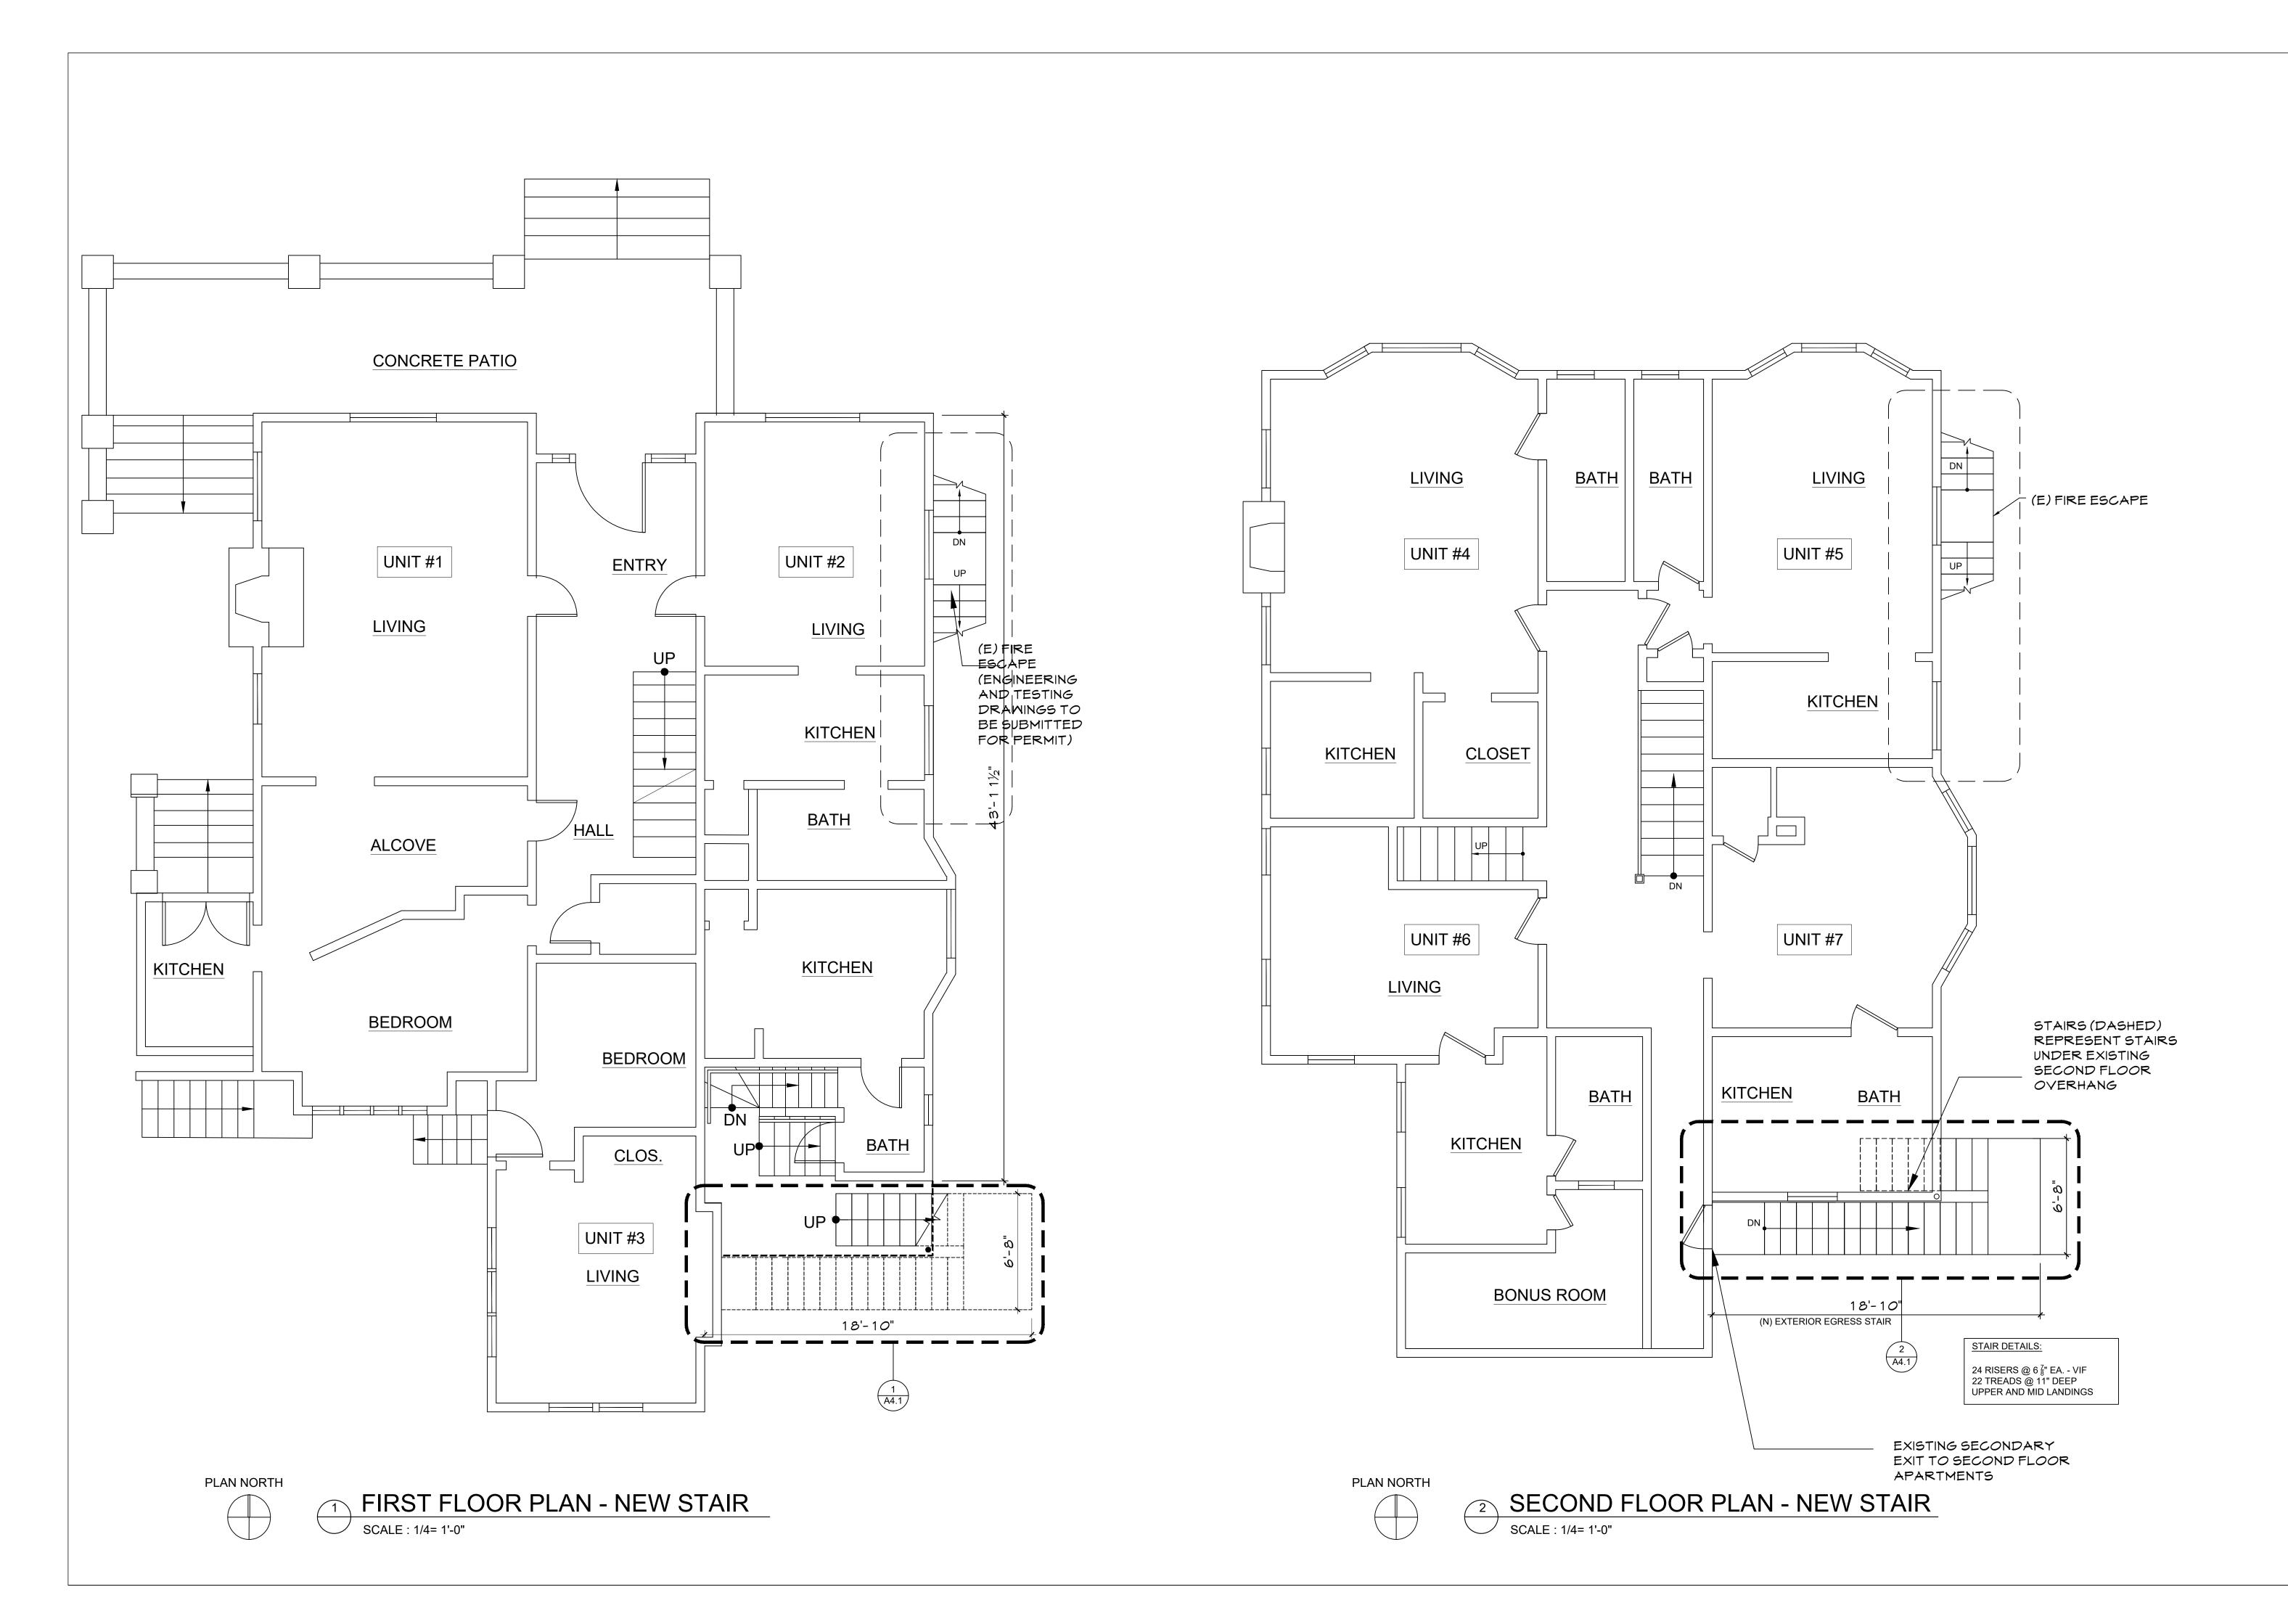

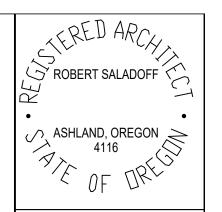

ROBEI A R C


PHASE/DATE ISSUED PLANNING: DEMOLITION: CD/PERMIT: 03.07.17 AS BUILTS:


> 1500 SE HAWTHORNE BLVD PORTLAND, OR 97214 **APARTMENTS** CELINE

DRAWINGS: FLOOR PLANS

开

A3.1

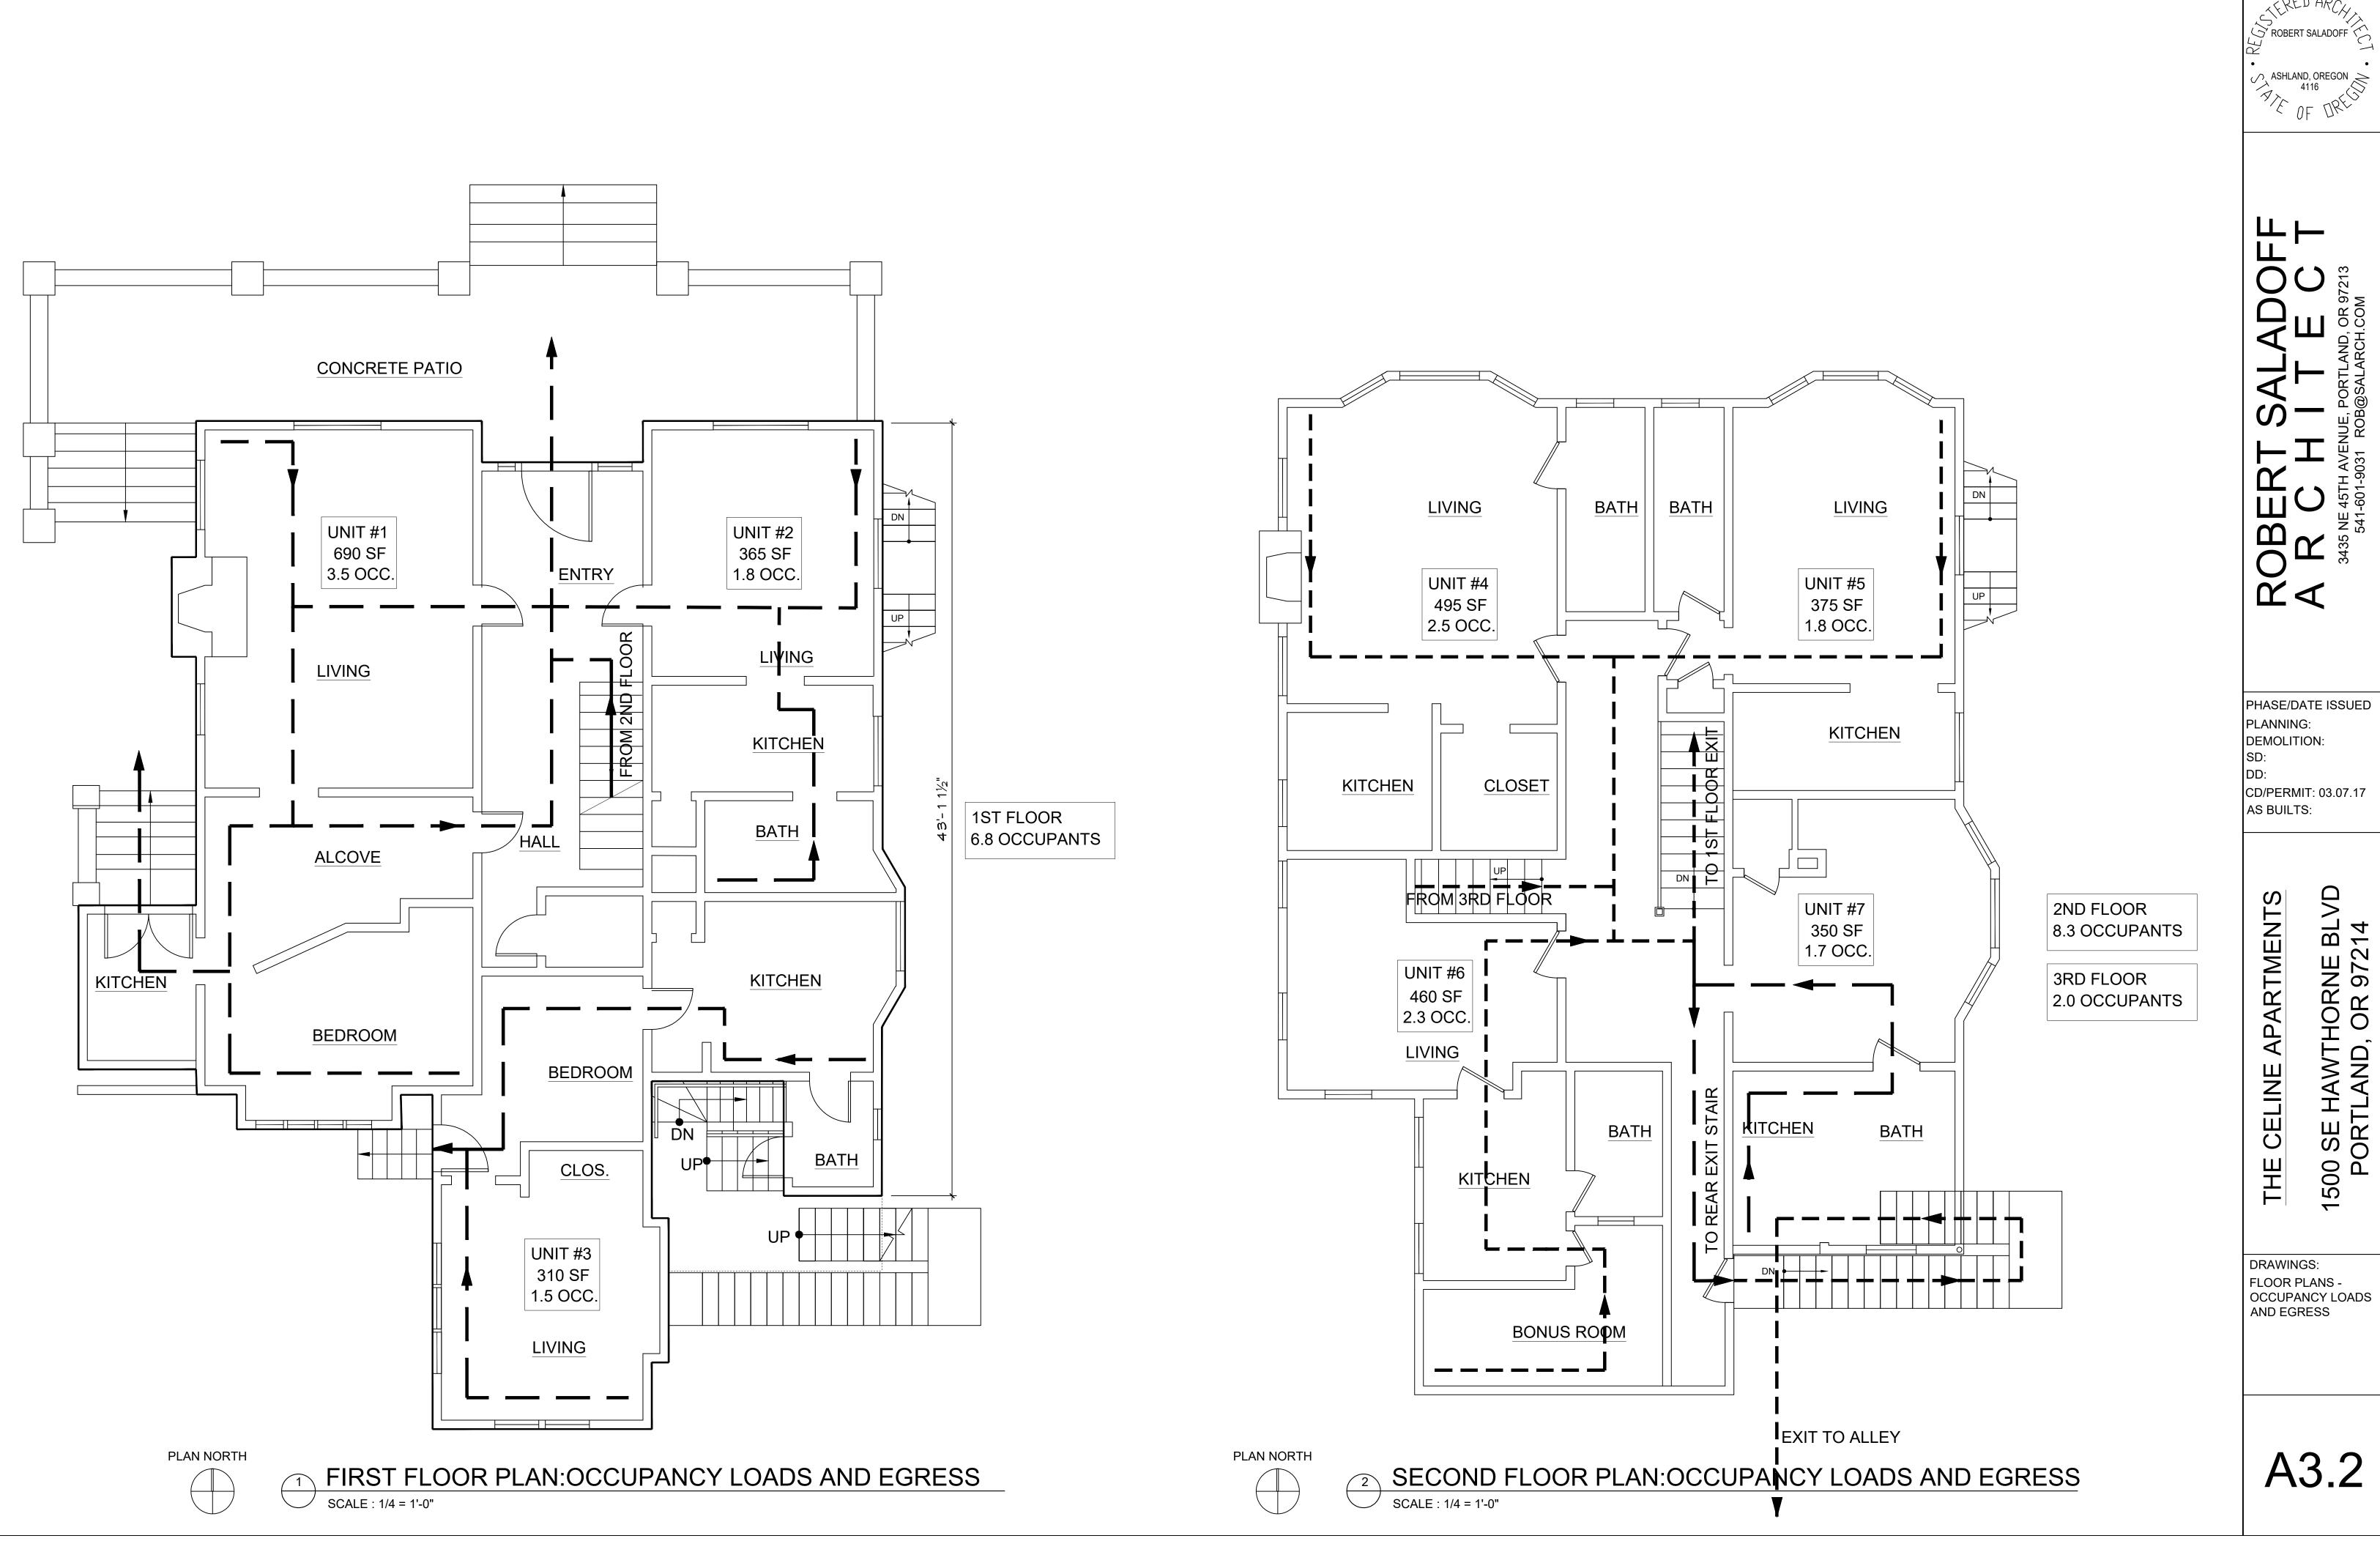


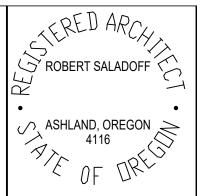


PHASE/DATE ISSUED CD/PERMIT: 03.07.17

FLOOR PLANS -OCCUPANCY LOADS AND EGRESS

A3.2

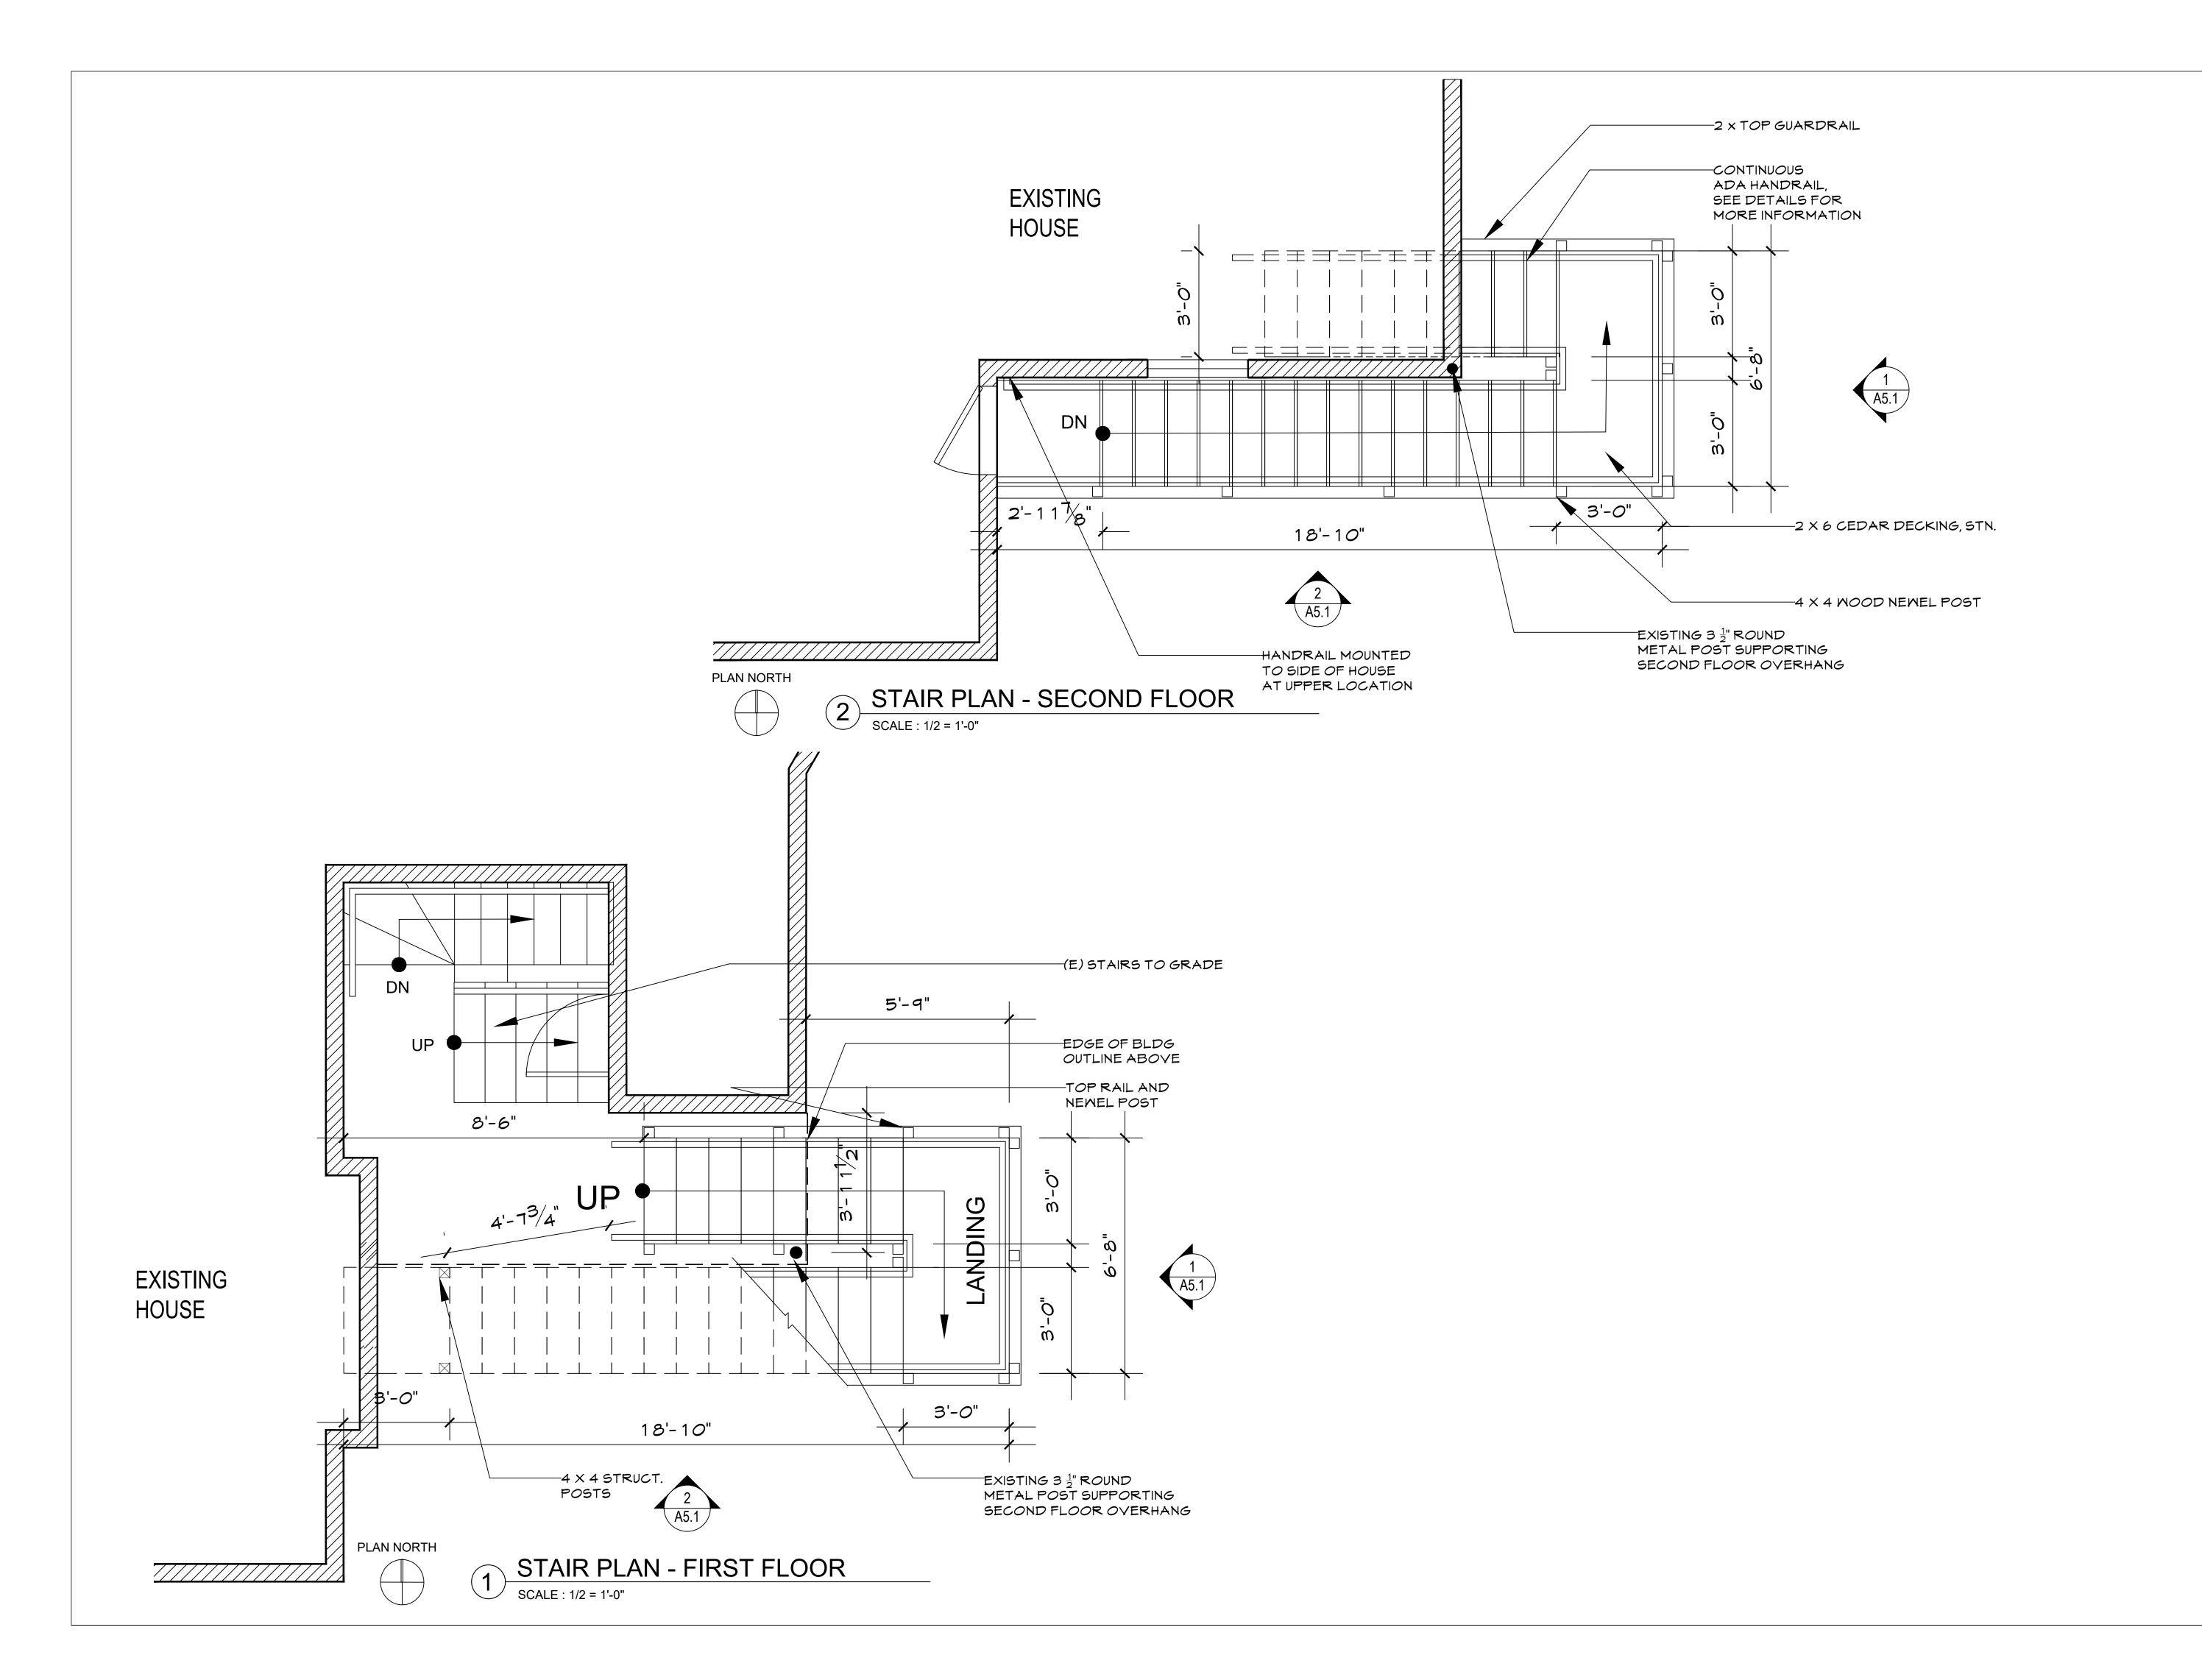

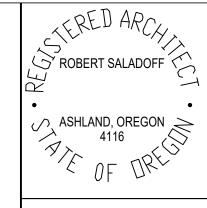

ROBERT SALADOFF
A R C H I T E C T
3435 NF 45TH AVENUE PORTI AND OR 97213


PHASE/DATE ISSUED
PLANNING:
DEMOLITION:
SD:
DD:
CD'S/PERMIT: 11.14.16

CD'S/PERMIT: 1

THE CELINE APARTMENTS
1500 SE HAWTHORNE BLVD
PORTLAND, OR 97214

DRAWINGS: STAIR PLANS

A4.1

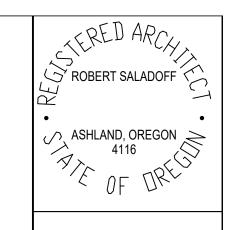

# M


PHASE/DATE ISSUED


AS BUILTS:

**APARTMENTS** 

1500 SE HAWTHORNE BLVD PORTLAND, OR 97214 CELINE 뮢

DRAWINGS: STAIR ELEVATIONS

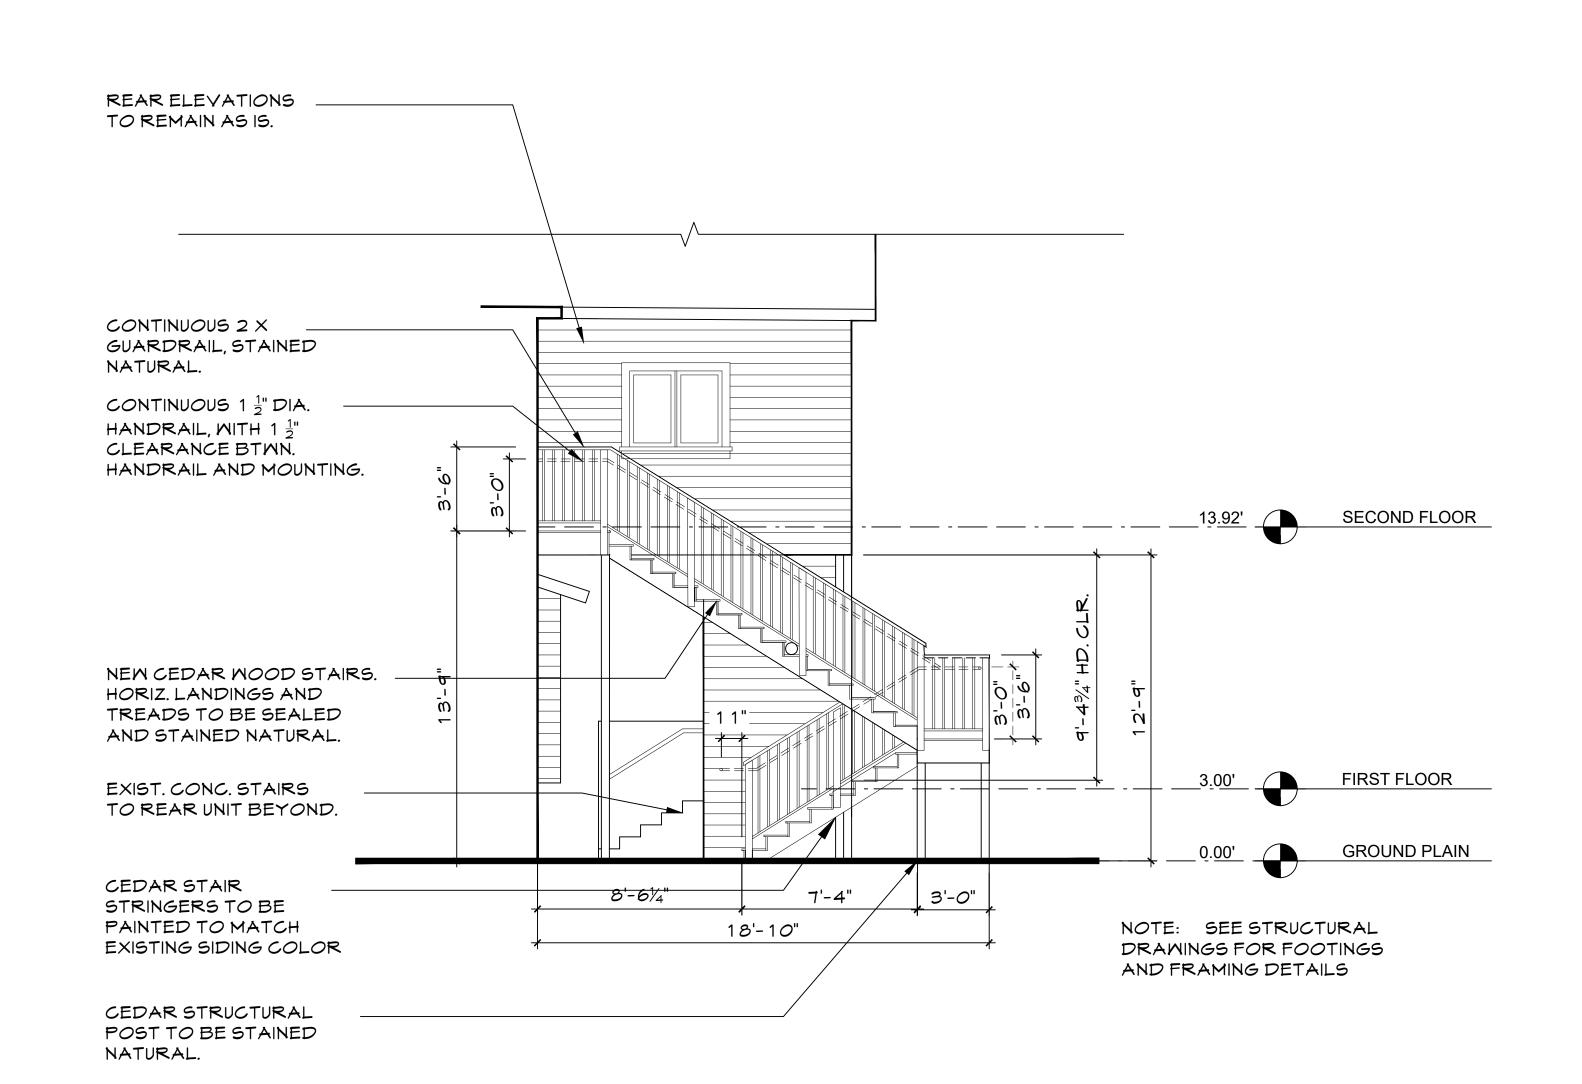


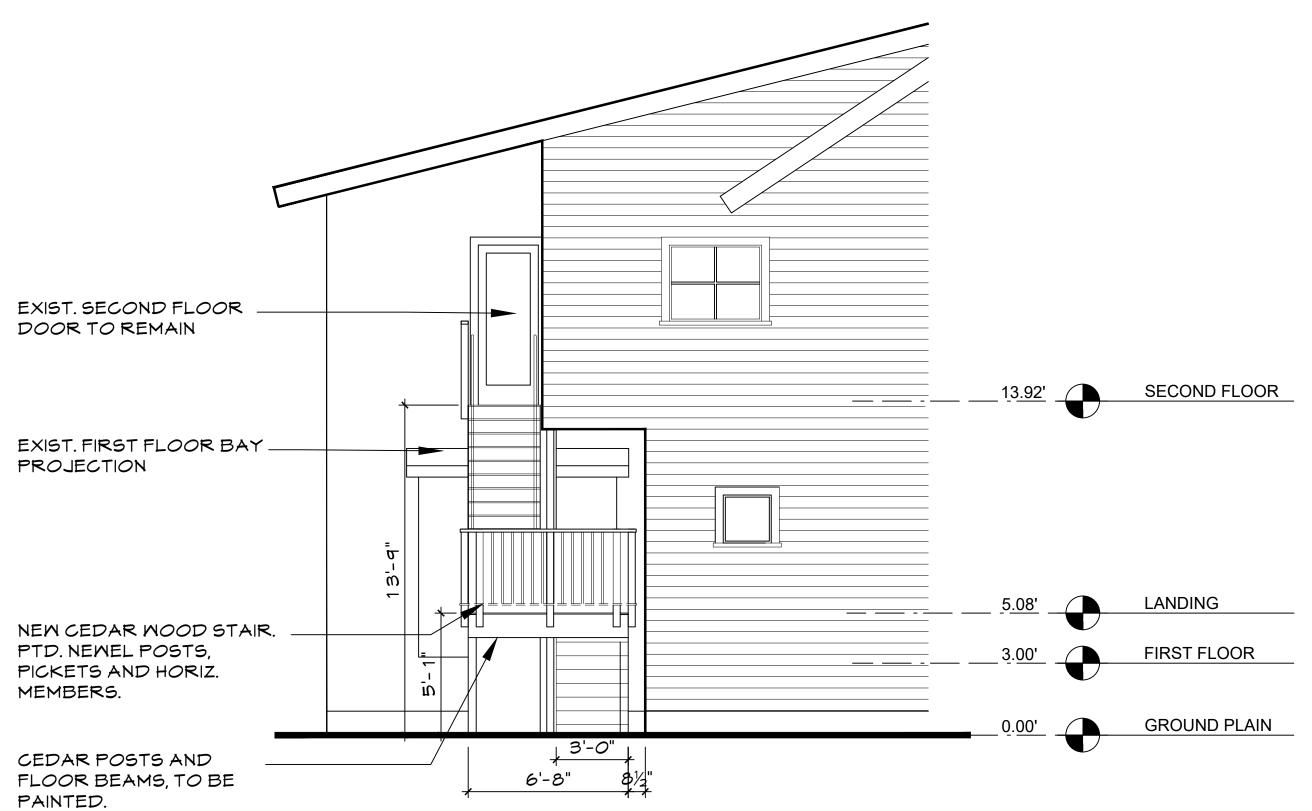

STAIR ELEVATION - SOUTH SCALE : 1/4 = 1'-0"


STAIR ELEVATION - EAST


SCALE: 1/8 = 1'-0"

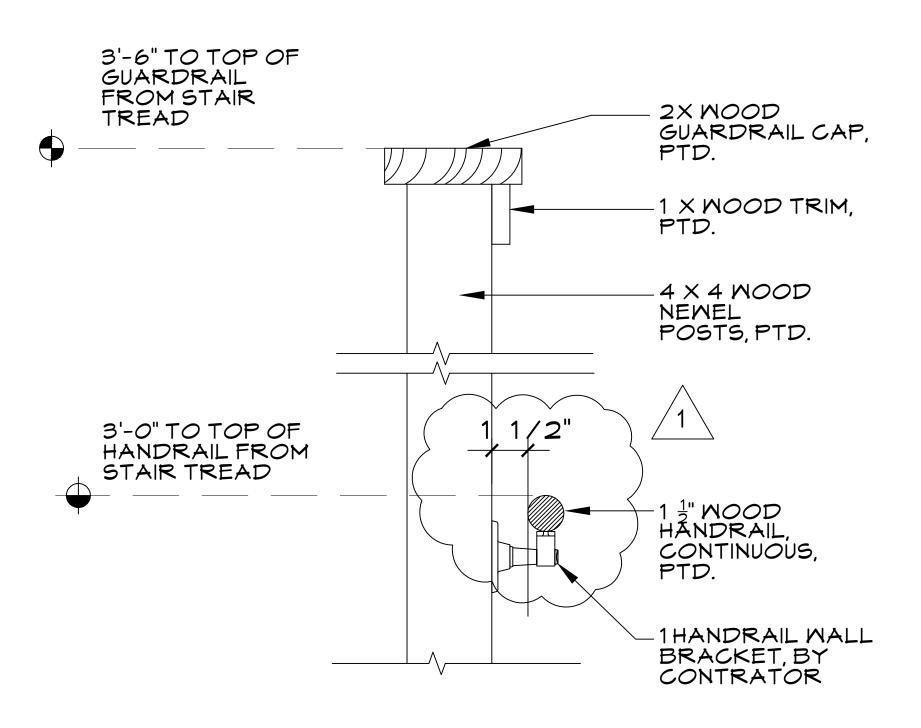


# 3 HANDRAIL ELEVATION

SCALE : 3 = 1'-0"

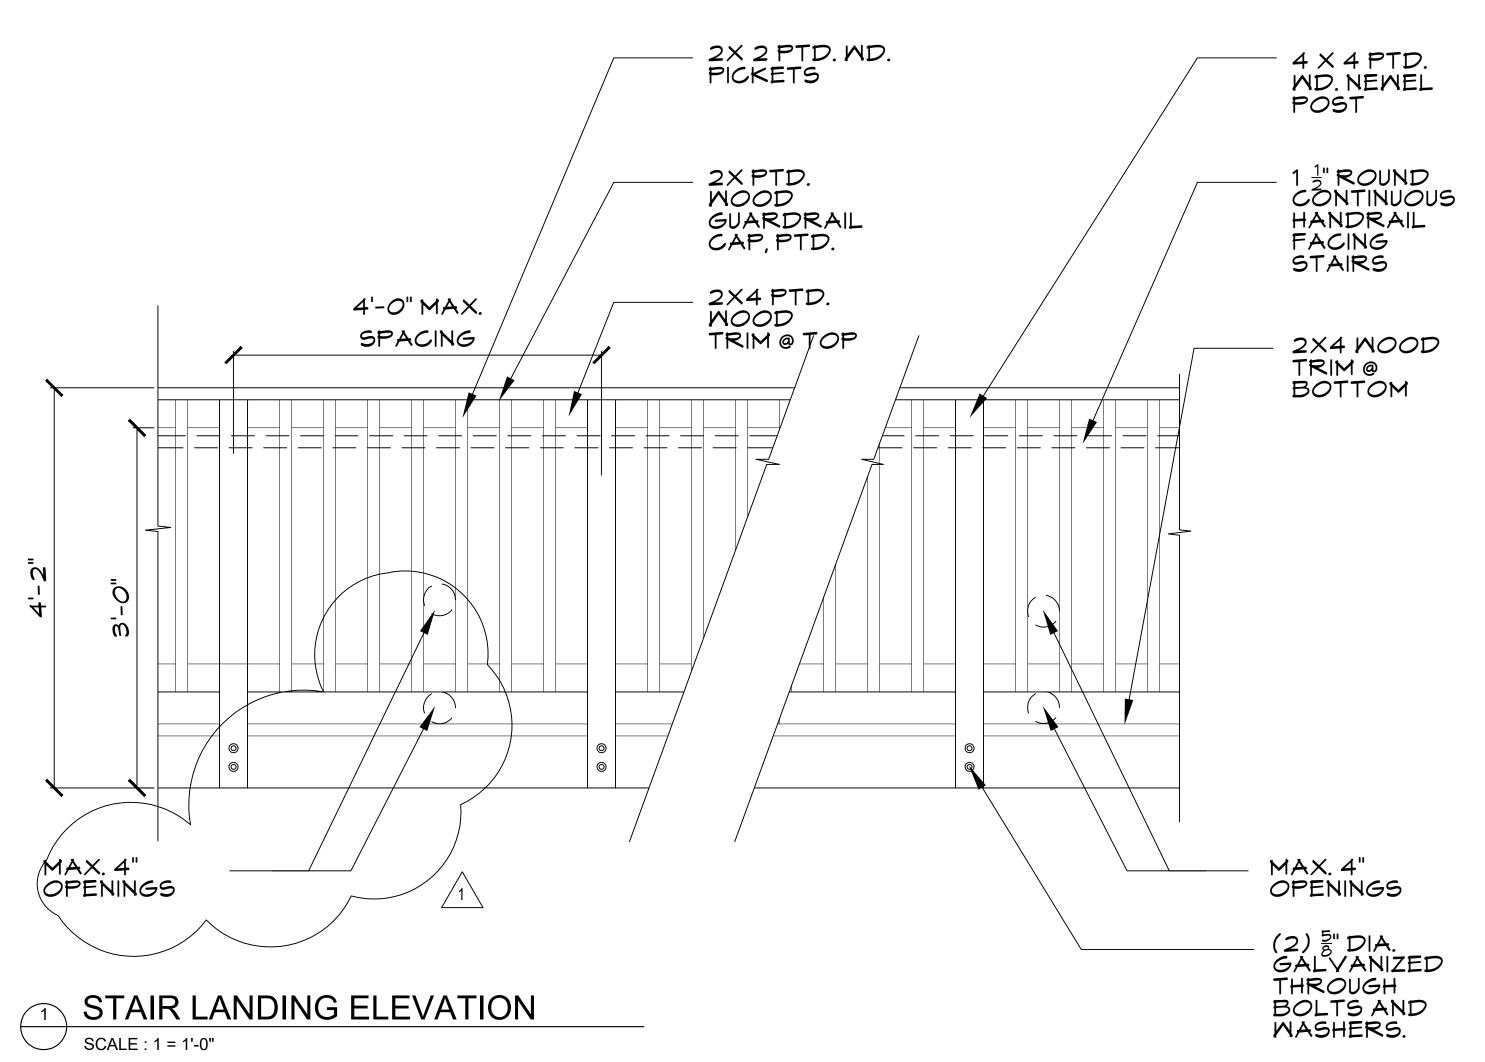

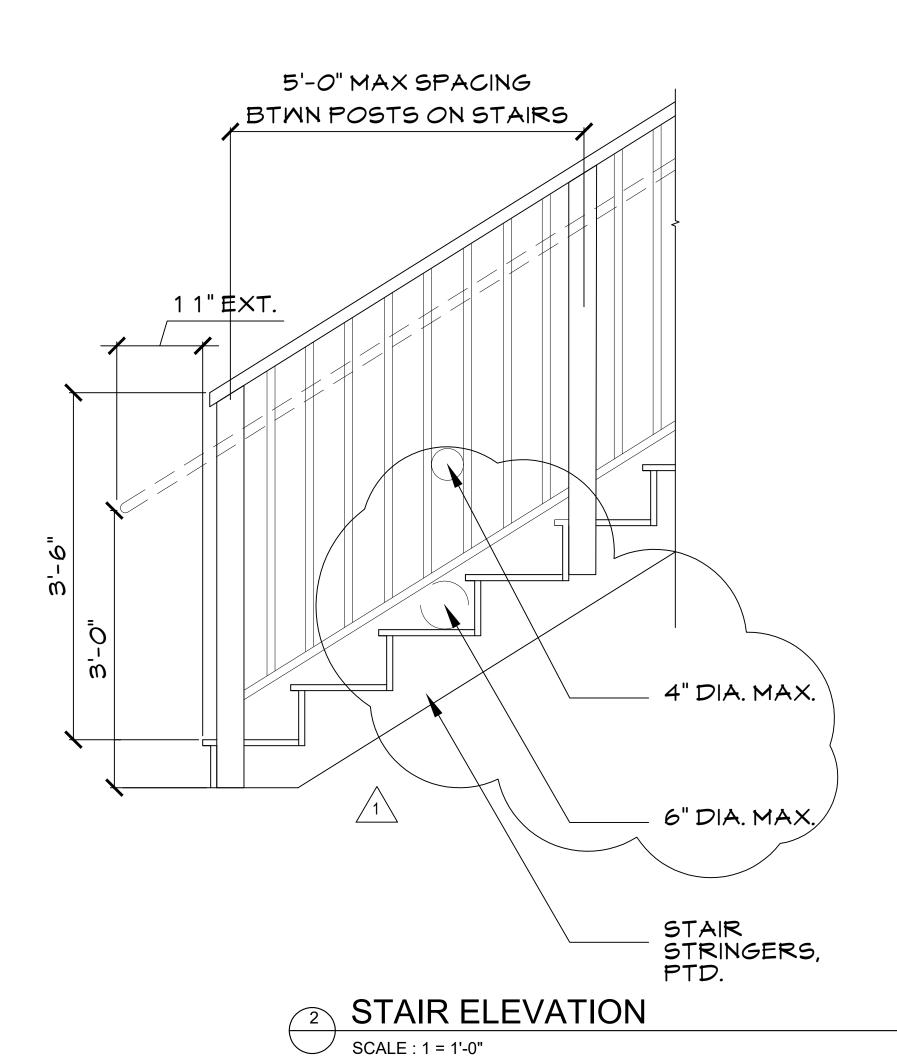

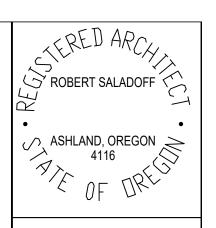

# ROBERT SALADOFF A R C H I T E C T 3435 NE 45TH AVENUE, PORTLAND, OR 97213

PHASE/DATE ISSUED
PLANNING:
DEMOLITION:
SD:
DD:
CD/PERMIT: 03.07.17

CD/PERMIT: 03.07

THE CELINE APARTMENTS 1500 SE HAWTHORNE BLVD PORTLAND, OR 97214

DRAWINGS: STAIR DETAILS

A5.1