
More Contact Info (http://www.portlandoregon.gov//bds/article/519984)

Development Services

From Concept to Construction





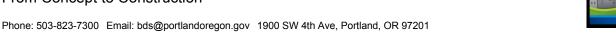

APPEAL SUMMARY

Status: Decision Rendered	
Appeal ID: 16103	Project Address: 515 NE Holladay St
Hearing Date: 11/8/17	Appellant Name: Calista Fitzgerald
Case No.: M-001	Appellant Phone: 503-265-1535
Appeal Type: Mechanical	Plans Examiner/Inspector: Thomas Ng
Project Type: commercial	Stories: 12 Occupancy: Construction Type:
Building/Business Name: Grand Avenue Apartments	Fire Sprinklers: Yes - entire building
Appeal Involves: Erection of a new	LUR or Permit Application No.: 17-204636-MT
structure,Reconsideration of appeal	

APPEAL INFORMATION SHEET

Plan Submitted Option: pdf [File 1] [File 2]

OSMC 505.1

Appeal item 1

Code Section

Requires	Domestic range hoods and domestic appliances equiped with downdraft exhaust shall dischrge to	
	outdoors through sheet metal ducts constrcuted og galvanized steel, stainless steel, aluminum,	
	copper. Such ducts shall have smooth inner wals, shall be airtight, shall be equiped with a	

backdraft damper, and shall be independent of all other exahust systems.

Proposed Design Th

The proposed design will meet the requirements of OSMC 505.1, except the kitchen exhaust and bathroom exhaust will combined to use a subduct system per OSMC 607.5.5, exceptions 1.1 and 2 and the dryer exhaust from each unit will be combined into a separate subduct system per OSMC 607.5.5, exceptions 1.1 and 2

Proposed use: A2, B, M, R2, S1

Equivalent protection is provided for the 2 separate subduct systems by the following:

Rigid 26 ga. min. metal subducts extending 22" min. above shaft penetration.

Continuous vent fan at the top of the shaft.

Continuous vent fan provided with emergency power for the shaft with the kitchen exhaust. Continuous vent fan provided with emergency power for the vertical dud with the dryer exhaust.

The kitchen/bathroom subduct system will be into the shaft space per OSMC 505.3.

Dryer exhaust will be provided in separate 26 ga. min. vertical duct. Dryer exhaust from each unit will have 26 ga. metal duct that extends into the vertical duct and extends 22 inches minimum into the vertical duct. The duct will be provided a fire rated access panel at each level.

See 9/M602 and A202 attached.

Reason for alternative

The proposed design is based on system for kitchen exhaust per OSMC 607.5.5. This code section allows the use of the subduct system for kitchen exhaust to be used without for or smoke damper. This system is the same as allowed per OSSC 717.5.3. The proposed design uses the system allowed for kitchen exhaust and allows the system to also be used for bathroom exhaust. The bathroom exhaust is less hazardous than the kitchen exhaust and does not add any additional hazard to the building. The single shaft vent fan will be supplied with emergency power, run continuously and be sized to exhaust the combined exhaust loads per OSMC.

The proposed design is based on system for kitchen exhaust per OSMC 607.5.5. This code section allows the use of the subduct system for kitchen exhaust to be used without for or smoke damper. This system is the same as allowed per OSSC 717.5.3. The proposed design uses the system allowed for kitchen exhaust and allows the system to also be used for bathroom exhaust. The bathroom exhaust is less hazardous than the kitchen exhaust and does not add any additional hazard to the building. The single shaft vent fan will be supplied with emergency power, run continuously and be sized to exhaust the combined exhaust loads per OSMC.

The proposed design for the dryer subdued system meets the requirements for exhaust per OSMC 607.5.5. 607.5.5 does not mention the system can be used for dryer exhaust due to the nature of potential lint in the shaft. The prescriptive design allows dryer vents to be separate from other unit vertical vents to prevent the accumulated buildup of lint. The continuous vent fan eat the top of the dedicated dryer vent exhaust provides additional protection as the lint is continuously pulled from the subduct shaft and does not have the potential to accumulate. Separation of the dryer vertical shaft from the kitchen/bathroom exhaust allows the intent of the code to be met and an equivalent protection system for the dryer ventilation.

The proposed design provides equivalent protection for exhaust of kitchen and bathroom exhaust in a single shaft using the subduct system with a separate vertical duct for dryer exhaust using the subduct system to allow for the kitchen exhaust per OSMC 607.5.5 and OSSC 717.5.3 and therefore request approval of this alternate method.

APPEAL DECISION

Domestic range hoods and bathroom exhaust to share common airstream as part of a subduct exhaust system: Granted as proposed.

The Administrative Appeal Board finds that the information submitted by the appellant demonstrates that the approved modifications or alternate methods are consistent with the intent of the code; do not lessen health, safety, accessibility, life, fire safety or structural requirements; and that special conditions unique to this project make strict application of those code sections impractical.

Pursuant to City Code Chapter 24.10, you may appeal this decision to the Building Code Board of Appeal within 180 calendar days of the date this decision is published. For information on the appeals process and costs, including forms, appeal fee, payment methods and fee waivers, go to www.portlandoregon.gov/bds/appealsinfo, call (503) 823-7300 or come in to the Development Services Center.

KEY PLAN

— UNIT 0/1-P

UNIT 2/1-B UNIT UNIT UNIT UNIT 2/1-A 2/1-A

GENERAL NOTES:

DIMENSIONS ARE TO FACE OF FRAMING, UON, OR DIMENSIONS ARE TO CENTER OF WINDOW OPENING, COLUMN OR GRID. EXTERIOR DIMENSIONS ARE TO FACE OF FOUNDATION/FACE OF FRAMING. DIMENSIONS INDICATED AS "CLEAR MINIMUM" ARE TO FACE OF FINISH. ALL DOOR OPENINGS PERPENDICULAR TO A WALL ARE 5" TO THE WALL, UON.

SEE A100i SHEET FOR STANDARD FIXTURE MOUNTING HEIGHTS AND REQUIREMENTS, UON.

720 NW Davis 503.221.1121 🖀

Portland OR 97209 www.lrsarchitects.com

Suite 300 503.221.2077

LEVERARCHITECTURE

4713 N ALBINA AVE, PDX OR 97217 T 503 928 6040 www.leverarchitecture.com

CONSULTANT:

D6 s 1 S -TYPICAL CORRIDOR WALL WITH ENTRY DOOR

-TYPICAL CORRIDOR WALL AT BATHROOMS

PROJECT NUMBER: GRAND AVENUE APARTMENTS

1010 NE GRAND AVE. PORTLAND, OR 97232

SHEET TITLE:


LEVEL 2 - FLOOR PLAN


KEY PLAN:

DRAWN BY: DATE CREATED:


2 ADDENDUM #02




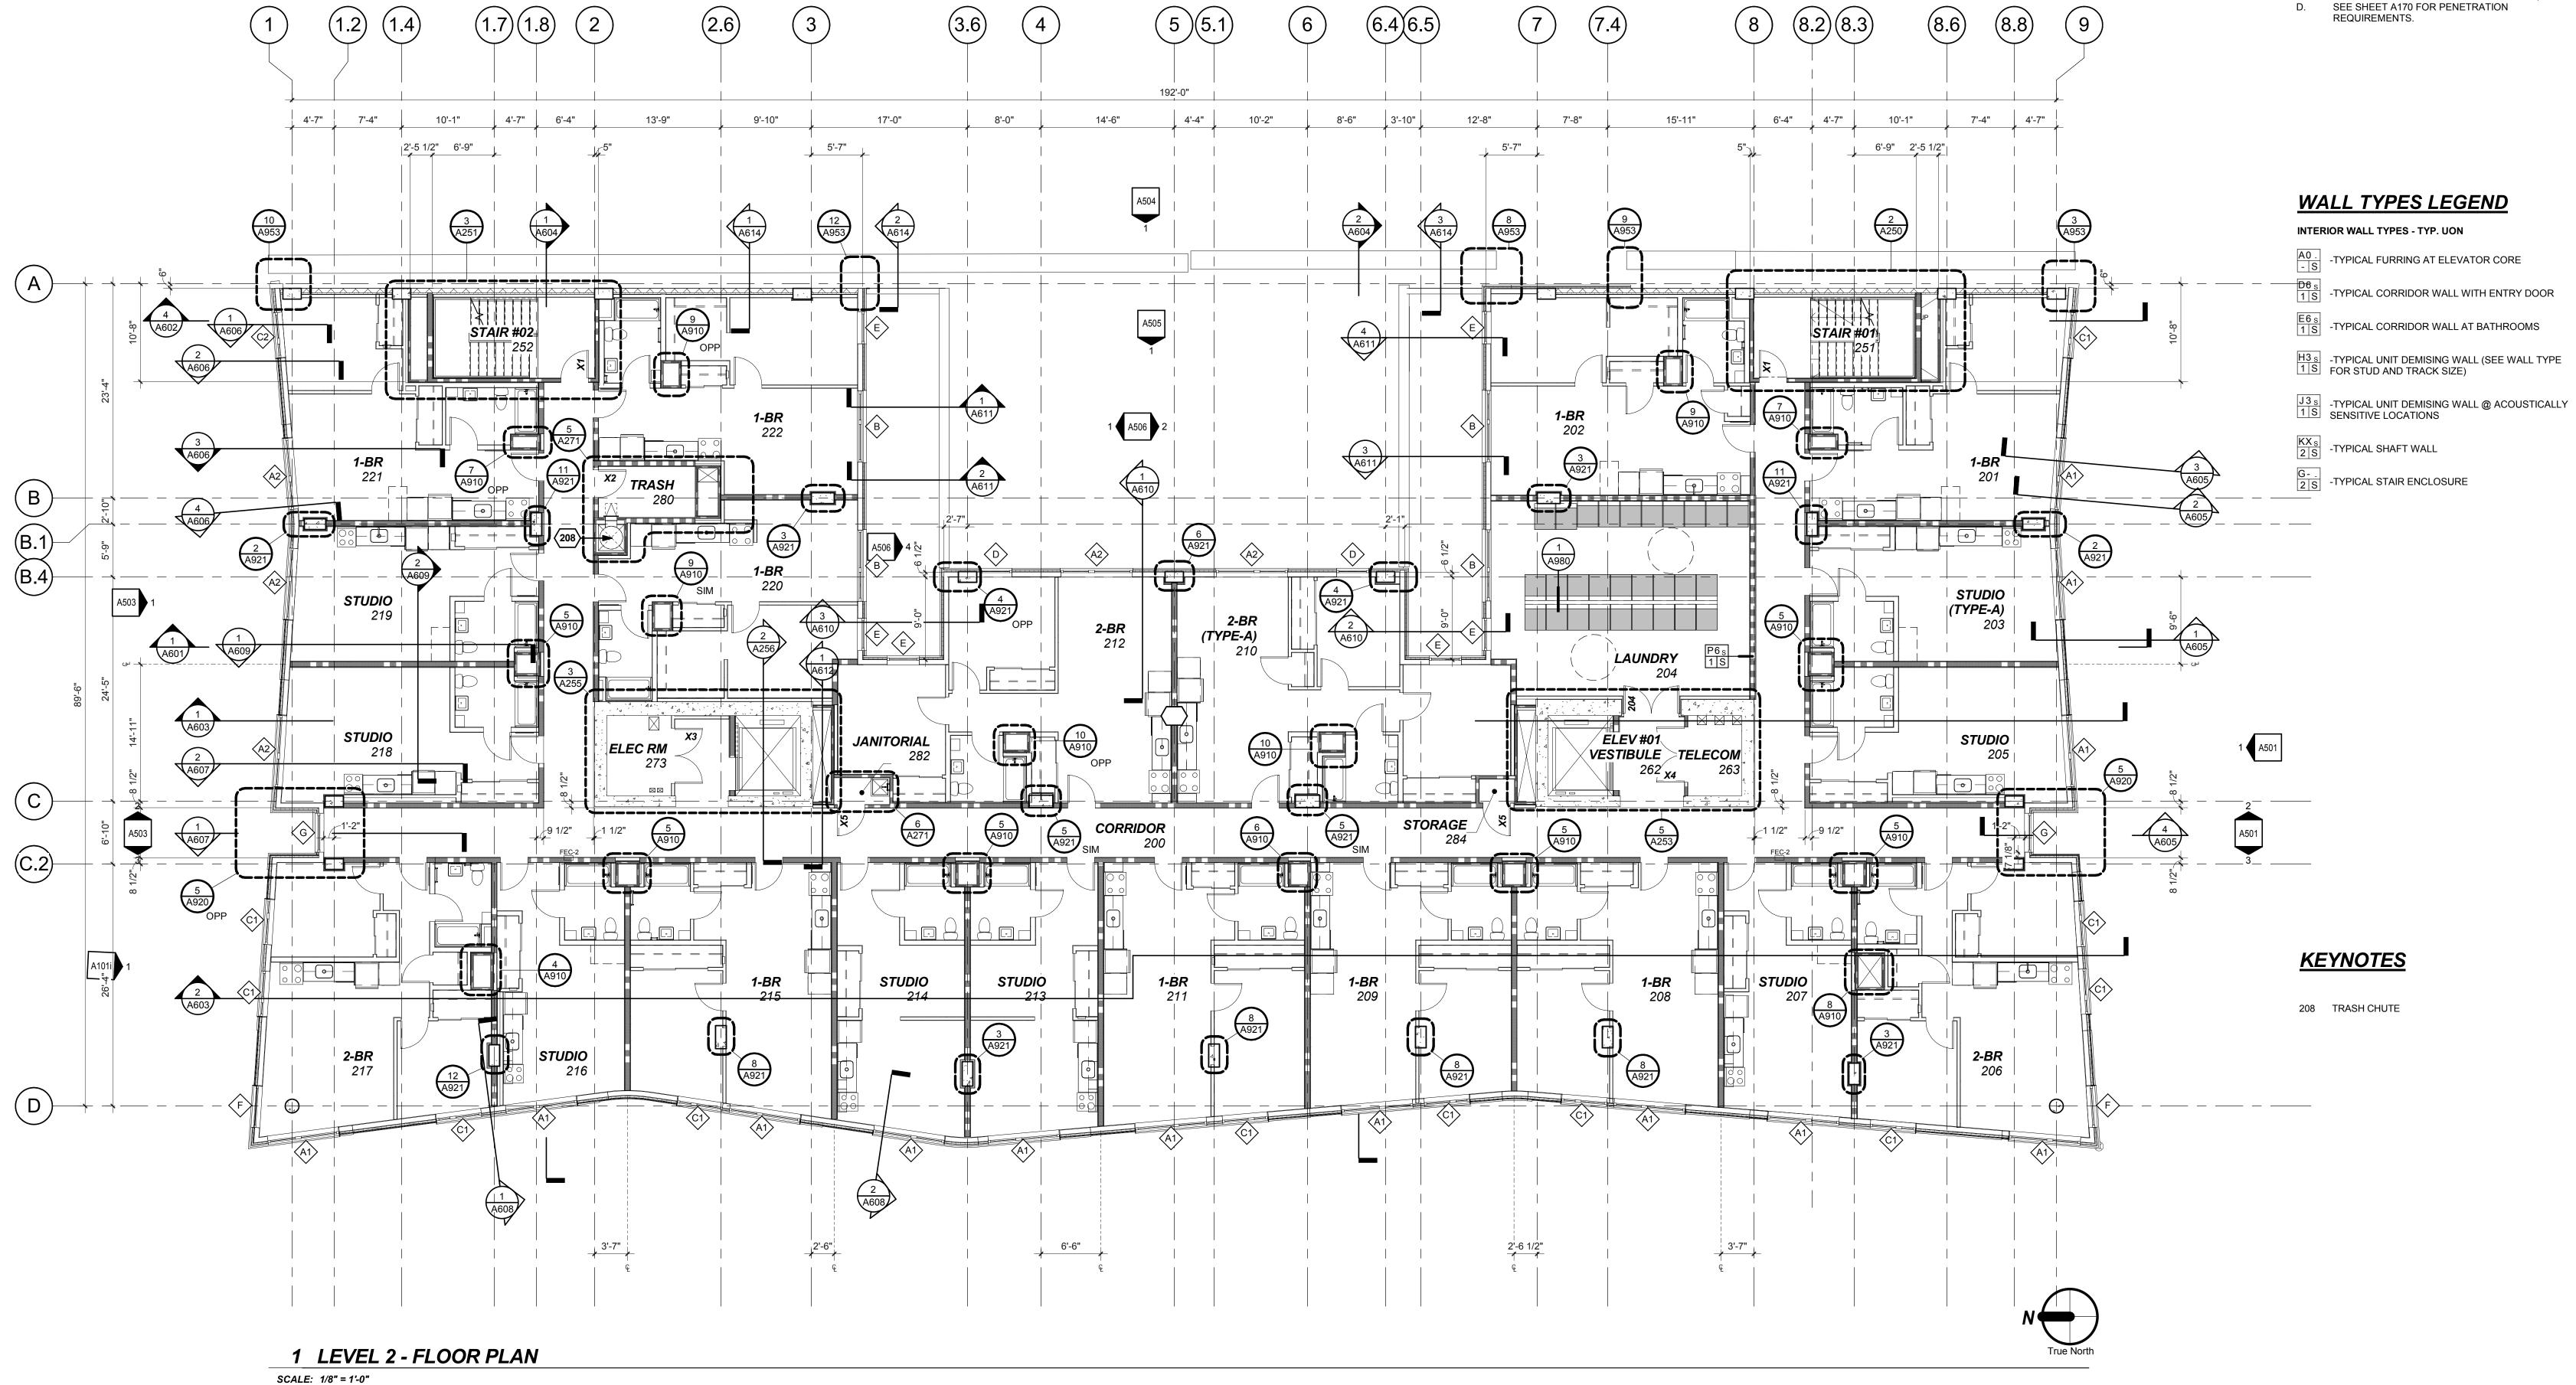

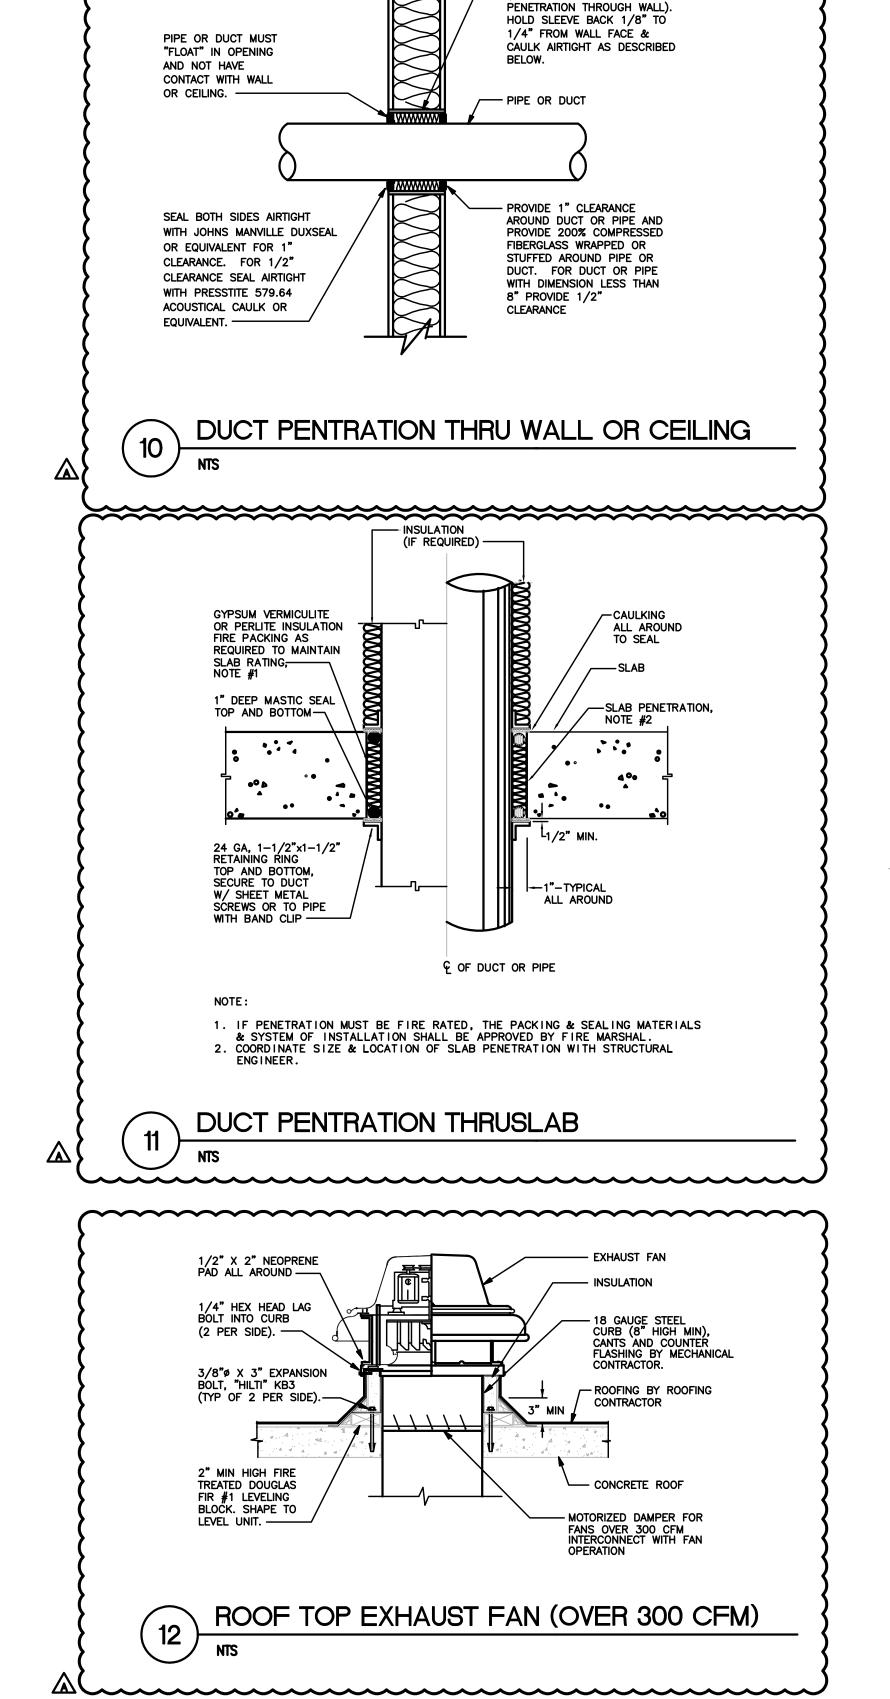


(NOT REQUIRED FOR

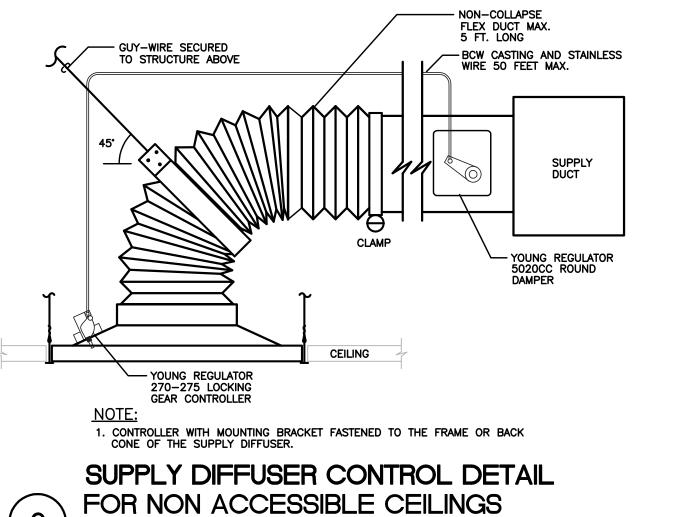

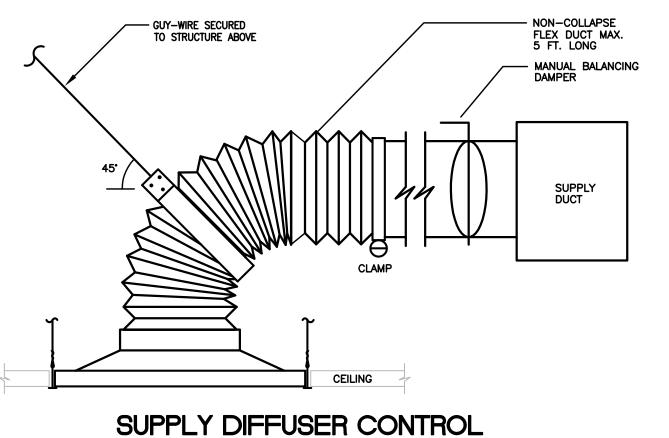



DETAIL FOR ACCESSIBLE CEILING

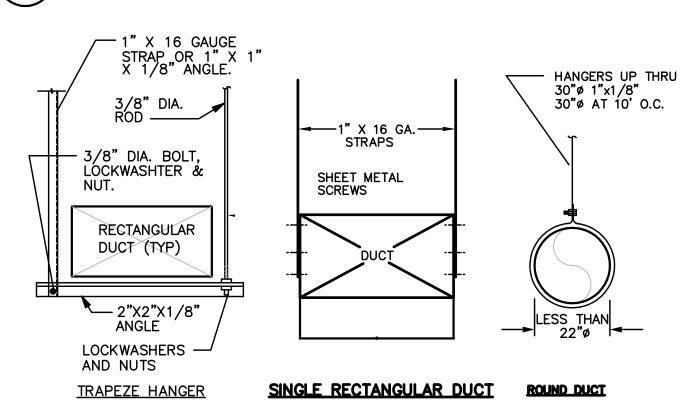


TRAPEZE HANGER NOTES: HANGERS AND TRAPEZE ANGLES TO BE SIZED IN ACCORDANCE WITH SMACNA DUCT CONTRUCTION STANDARDS, TABLES 4-1 & 4-3. MAXIMUM SPACING BETWEEN HANGERS - 10 FEET.


HANGER AND SUPPORT FOR DUCTWORK

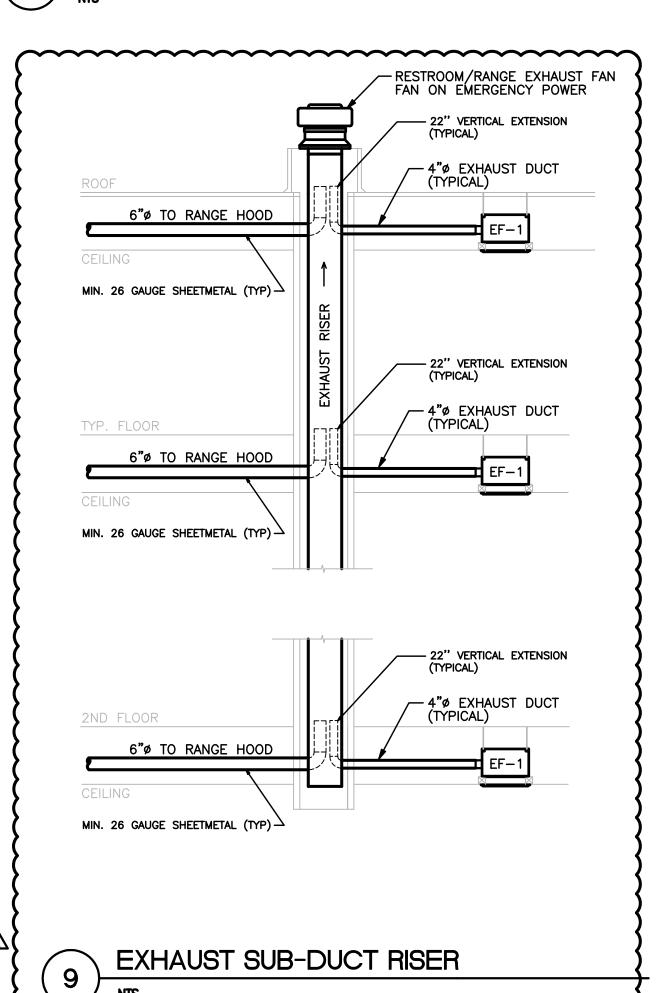

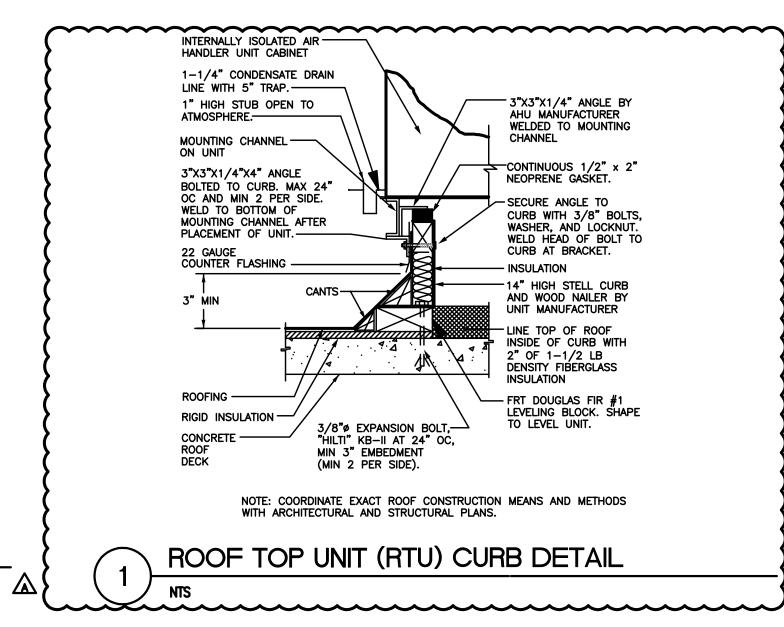

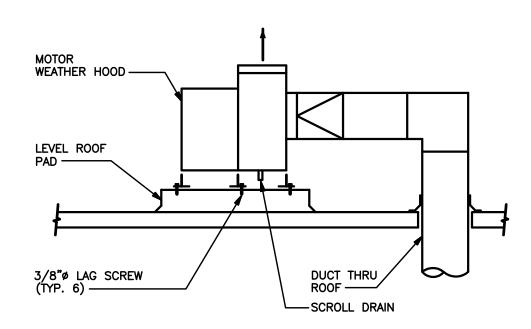


UTILITY SET EXHAUST FAN DETAIL

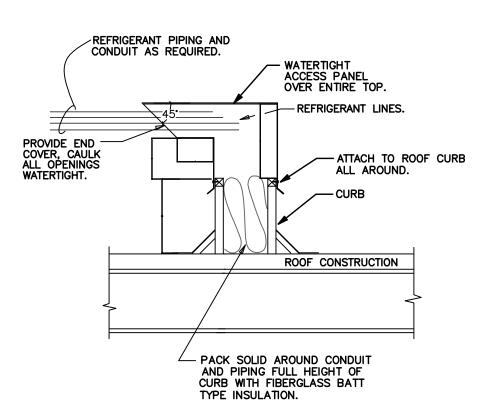


NOTE: USE PORTAL PLUS OR PATE CURBS

TYPICAL PIPE PORTALTHROUGH ROOF

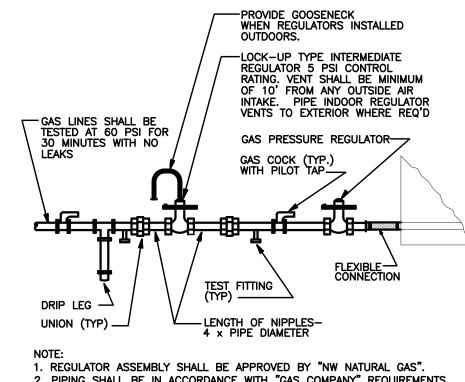


3. ALL PIPING SHALL BE PAINTED. DO NOT PAINT BRAIDED HOSE 4. SEAL ROOF PENETRATIONS WITH MEMBRANE COLLAR & CLAMP.



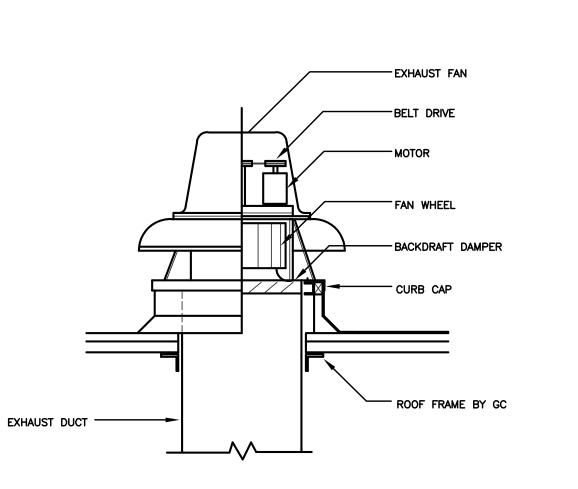

ROOF TOP EXHAUST FAN

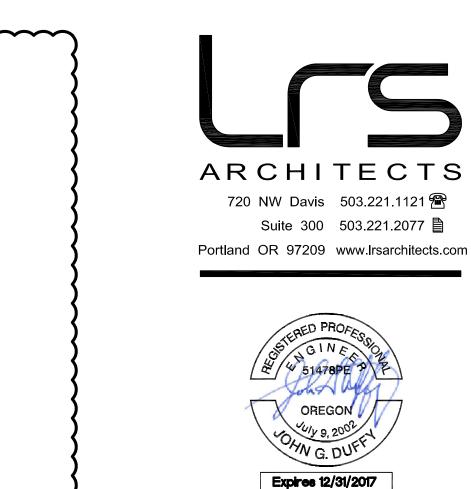


LEVERARCHITECTURE

OREGON /

720 NW Davis 503.221.1121 🕾

Suite 300 503.221.2077

239 NW 13TH AVE, PDX OR 97209 T 503 928 6040 www.leverarchitecture.com

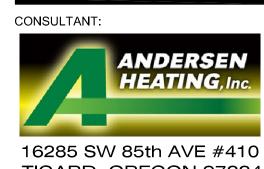

TIGARD, OREGON 97224 PHONE: 503.841.0742

9220 SW BARBUR BLVD. SUITE 1119-324, PORTLAND, OR 97219 P: (503)248.5300 Em: david.keys@mepcon.com

PROJECT NUMBER: **GRAND AVENUE APARTMENTS**

1010 NE GRAND AVE. PORTLAND, OR 97232

SHEET TITLE:

MECHANICAL DETAILS

KEY PLAN:

DRAWN BY: DRK DATE CREATED: 07/14/17

REVISIONS: Plan Check Review - 09.01.2017



LRS Architects, Inc. ©2016