

Development Services

From Concept to Construction

Phone: 503-823-7300 Email: bds@portlandoregon.gov 1900 SW 4th Ave, Portland, OR 97201

More Contact Info (<http://www.portlandoregon.gov/bds/article/519984>)



APPEAL SUMMARY

Status: Decision Rendered

Appeal ID: 20393	Project Address: 8247 NE Sandy Blvd
Hearing Date: 5/15/19	Appellant Name: dave spitzer
Case No.: B-004	Appellant Phone: 503 335 9040
Appeal Type: Building	Plans Examiner/Inspector: Gail Knoll
Project Type: commercial	Stories: 2 Occupancy: R-1 Construction Type: V-B
Building/Business Name: Howard Johnsons	Fire Sprinklers: No
Appeal Involves: Alteration of an existing structure	LUR or Permit Application No.: 19-124572-CO, 19-124581-CO, 19-124582-CO
Plan Submitted Option: pdf [File 1]	Proposed use: hotel

APPEAL INFORMATION SHEET

Appeal item 1

Code Section	1976 UBC 505 (d) 1.
Requires	Requires 90 minute doors in two hour fire resistive area separation walls.
Proposed Design	This is a code violation case - during the plan review we submitted all of the original 1976 permit drawings for reference. This permit is being reviewed per the 1976 UBC as requested/suggested by BDS staff. There are three buildings on site. Building B has one 2 hour area separation wall and building C has three 2 hour area separation walls. The 1976 UBC clearly states that 90 minute openings are required in two hour area separation walls. The original permit drawings list 90 minute openings in a minimum of 3 places - including the door schedule - but - in one place there is a hand written note pointing to one door at an area separation wall that reads '2 hour door/jamb'. We are not proposing any changes - but to meet the requirements of the UBC and what is documented on the original permit drawings. During the last round of permit revisions - we listed all doors at area separation walls as 90 minutes - while at the one door that is called out as 2 hours per the original permit drawings - we show that as a 2 hour door. This is consistent with what is documented on the 1976 permit.
Reason for alternative	This is not an alternative. While there may have been some unknown reason for the one hand written 2 hour door/jamb note to be added - it clearly points to one door on one floor. Both the 1976 UBC and numerous notes on the original permit drawings call out 90 minute doors as

existing/proposed. I see no reason that all doors would need to exceed the requirements of code at the time.


APPEAL DECISION

Replacement of fire rated door assemblies in 2 hour area separation walls: Granted provided 2 hour doors are installed in locations identified as 2 hour doors on City approved permit plans.

Appellant may contact John Butler (503 823-7339) with questions.


The Administrative Appeal Board finds with the conditions noted, that the information submitted by the appellant demonstrates that the approved modifications or alternate methods are consistent with the intent of the code; do not lessen health, safety, accessibility, life, fire safety or structural requirements; and that special conditions unique to this project make strict application of those code sections impractical.

Pursuant to City Code Chapter 24.10, you may appeal this decision to the Building Code Board of Appeal within 180 calendar days of the date this decision is published. For information on the appeals process and costs, including forms, appeal fee, payment methods and fee waivers, go to www.portlandoregon.gov/bds/appealsinfo, call (503) 823-7300 or come in to the Development Services Center.

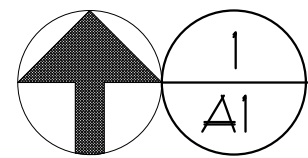

SCHEMATIC OVERALL SITE PLAN

1" = 20'-0"

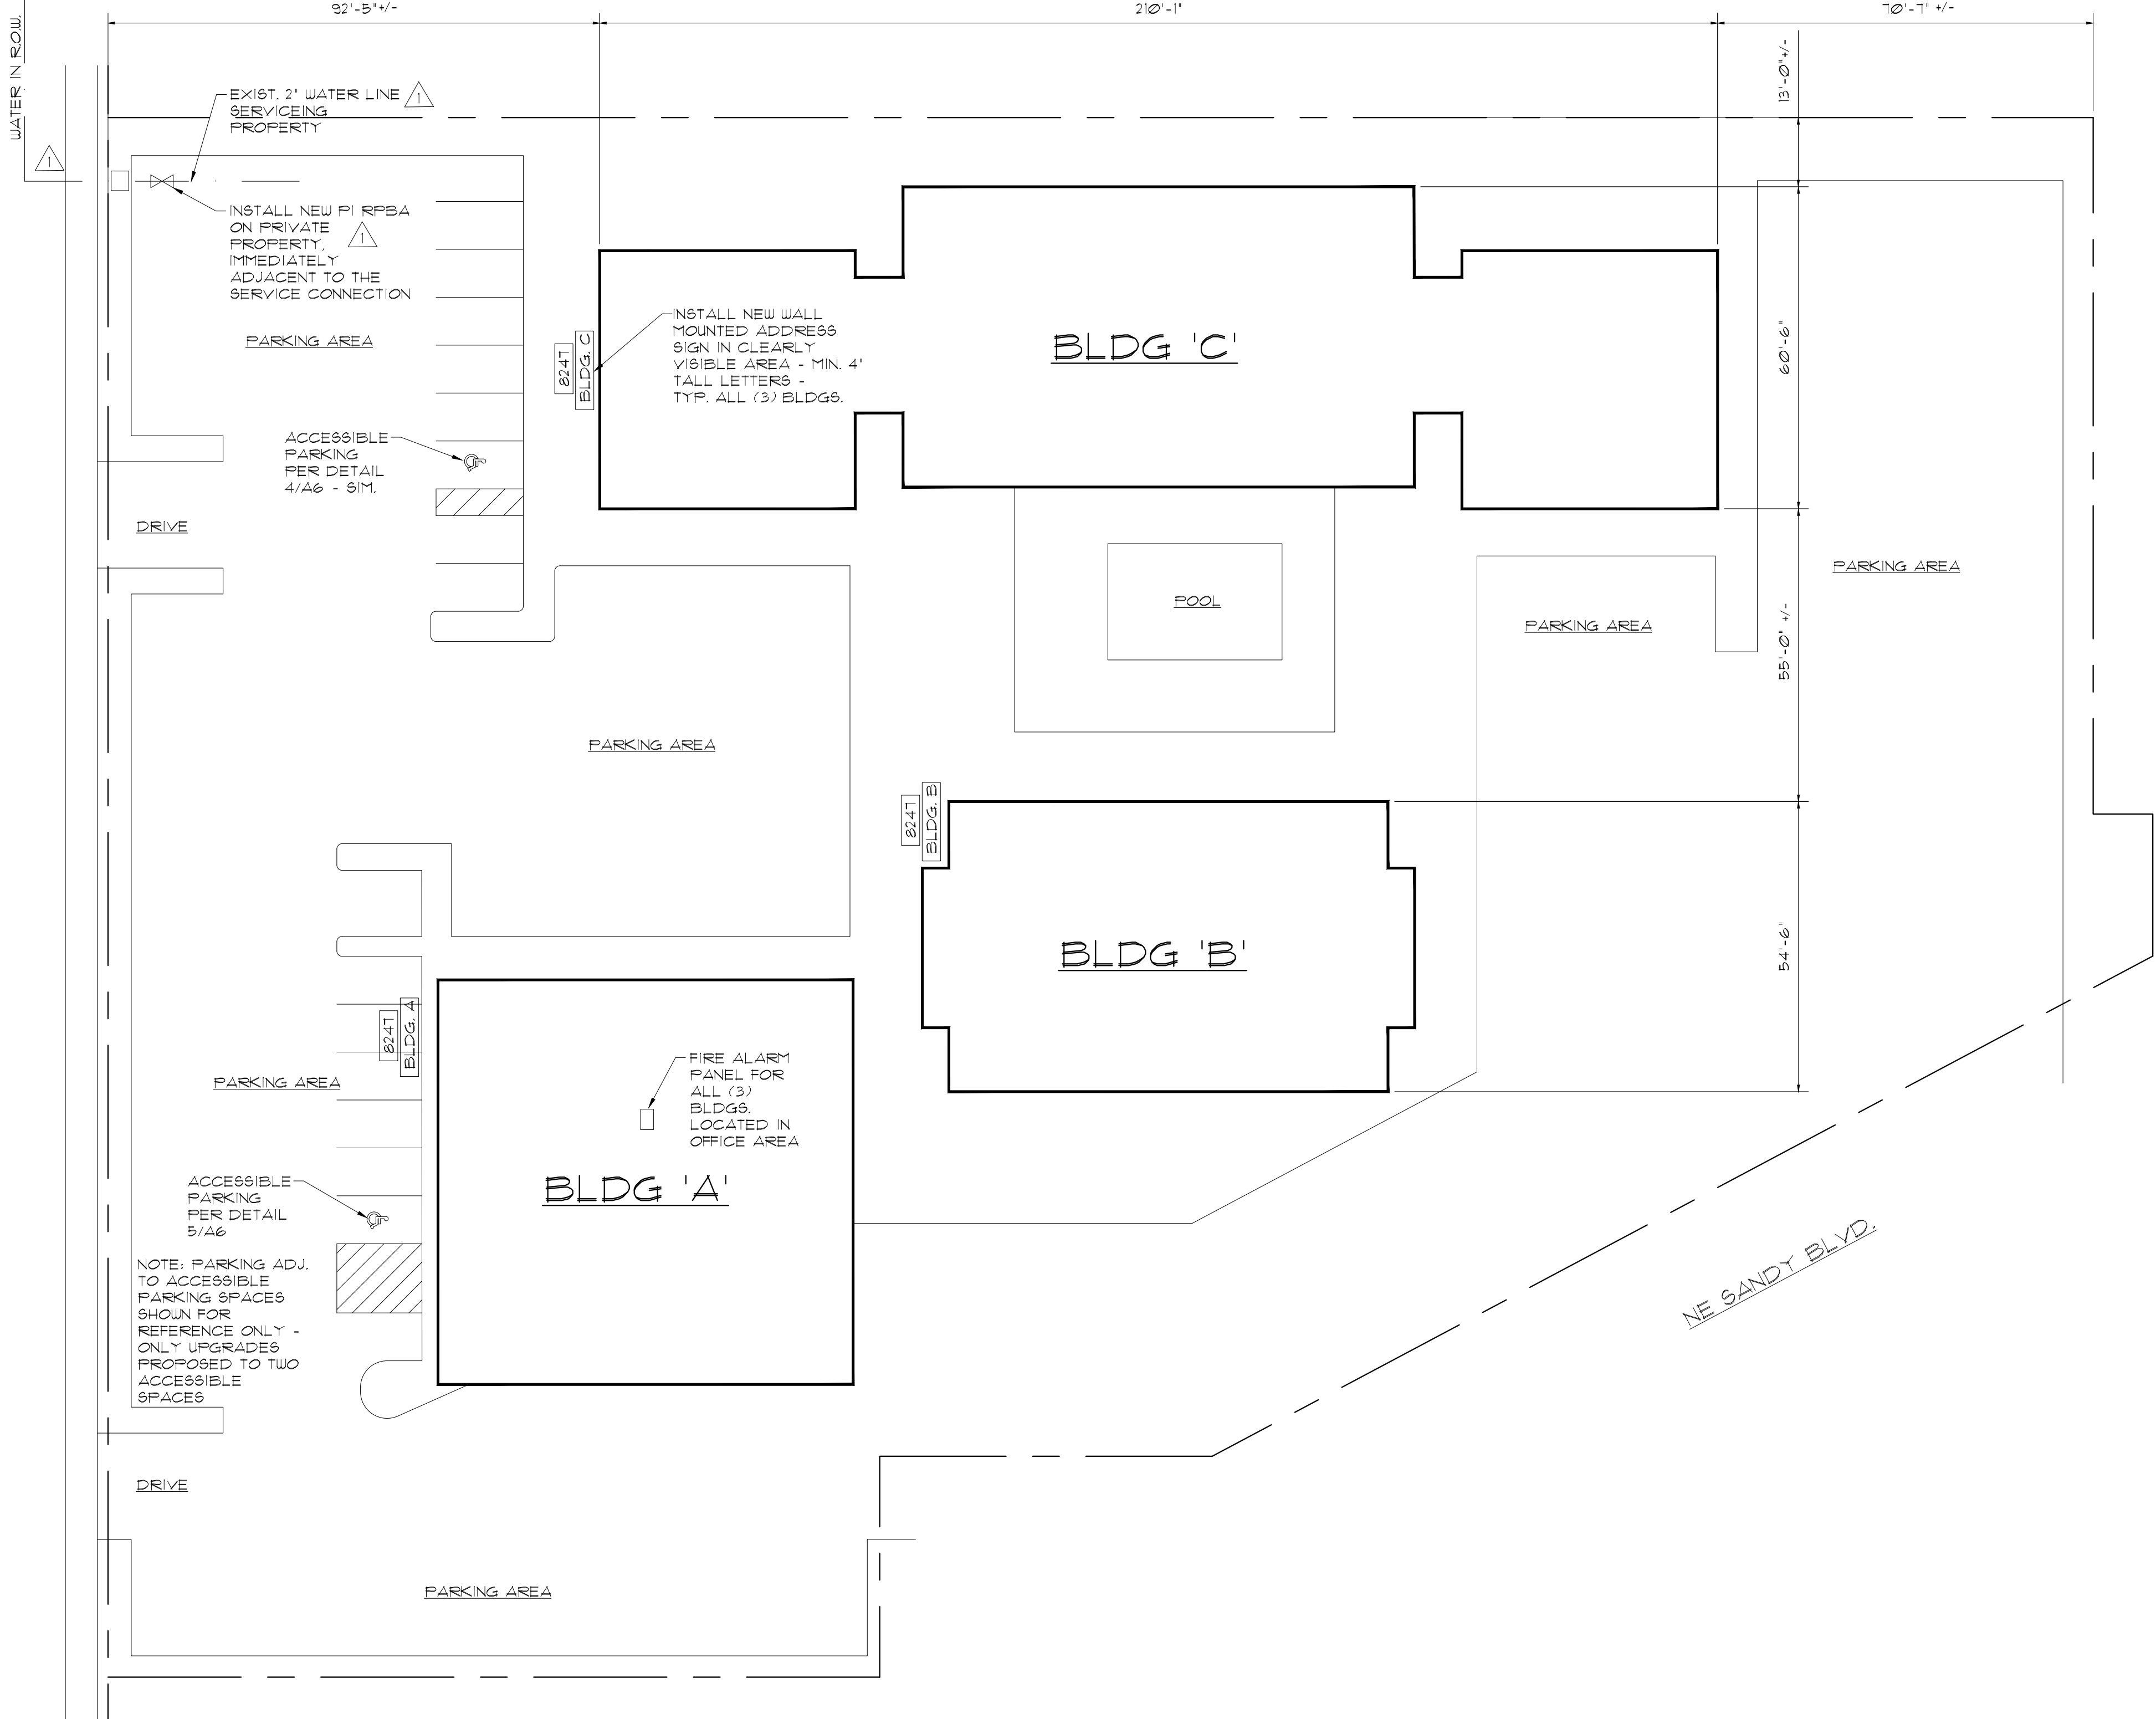

BUILDING INFORMATION

OWNER:
GSS PROPERTIES LLC
8241 NE SANDY BLVD.
PORTLAND, OR 97220

PROJECT ADDRESS:
8241 NE SANDY BLVD.
PORTLAND, OR 97220

LEGAL DESCRIPTION:
ROSEWAY 4 FLAT 2, BLOCK 1, 12 AND 38 TL 8200

MULTNOMAH CO. TAX ACCT. NUMBER: R261793

ZONING DESIGNATIONS: CM2h

BUILDING CODE SUMMARY

THE 1976UBC WAS WHAT BUILDINGS WERE BUILT UNDER AND WHAT IS BEING USED FOR THIS CODE SUMMARY AS OUTLINED BELOW

INFORMATION SHOWN ON THIS DRAWING IS BASED ON THE ORIGINAL PERMIT DRAWINGS (#161985 AND 05-144516-CO) AND LIMITED OBSERVATIONS OF COMMON AREAS AND AREAS IDENTIFIED AS HAVING CODE VIOLATIONS BY BDS

SCOPE OF PERMIT: TO ADDRESS AND CORRECT CODE VIOLATIONS AND NON-PERMITTED WORK PER BDS LETTER DATED NOVEMBER 14, 2018 AND PORTLAND FIRE AND RESCUE LETTER DATED JANUARY 8, 2019. SEE ALSO INDIVIDUAL BUILDING PLANS FOR DETAILED LIST PER BLDG.

PERMITS REQUIRED FROM THE CITY OF PORTLAND:

- A. BUILDING
- B. ELECTRICAL
- C. MECHANICAL

EXIST/PROPOSED OCCUPANCY GROUP: RI - HOTEL (PER 1976 UBC)
CONSTRUCTION TYPE: VB - NOT SPRINKLERED
SPRINKLER SYSTEM: NOT PROVIDED
FIRE ALARM SYSTEM: PROVIDED
BUILDING HEIGHTS: 2 STORIES TYP. ABOVE GRADE PLANE
W/ DAYLIGHT LOWER LEVELS ON N. SIDES OF ALL BLDGS.

PERMITS REQUIRED FROM THE FIRE MARSHALL'S OFFICE:
A. FIRE ALARM

BUILDING INFORMATION:		
BUILDING 'A'	APPROX. SF.	# OF UNITS/USE
LOWER FLOOR PLAN:	2,030 SF +/-	6 UNITS
MAIN FLOOR PLAN:	3,500 SF +/-	6 UNITS + OFFICE/LOBBY
UPPER FLOOR PLAN:	1,430 SF +/-	4 UNITS
TOTAL:	6,960 SF	16 UNITS

BUILDING 'B'		
BUILDING 'B'	APPROX. SF.	# OF UNITS/USE
LOWER FLOOR PLAN:	3,950 SF +/-	5 UNITS + MTG. RM/LAUNDRY AND BREAK RM.
MAIN FLOOR PLAN:	3,950 SF +/-	11 UNITS
UPPER FLOOR PLAN:	3,950 SF +/-	11 UNITS
TOTAL:	11,850 SF	27 UNITS

BUILDING 'C'		
BUILDING 'C'	APPROX. SF.	# OF UNITS/USE
LOWER FLOOR PLAN:	4,100 SF +/-	15 UNITS
MAIN FLOOR PLAN:	9,600 SF +/-	31 UNITS
UPPER FLOOR PLAN:	9,600 SF +/-	32 UNITS
TOTAL:	23,300 SF	78 UNITS

BASIC ALLOWABLE BUILDING HEIGHT AND AREA - PER UBC 1976 TABLE 5-C AND 5-D
RI - TYPE V-N CONSTRUCTION 4,500 SF BASE ALLOWABLE
2 STORIES BASE ALLOWABLE

AREA SEPARATION WALLS PER 1976 UBC SEC. 505 (d)
AREA SEPARATION WALLS ARE USED IN BUILDINGS 'B' AND 'C' AS SHOWN ON 'CODE DIAGRAMS' PER DWG. A2. EACH AREA SEPARATED BY AREA SEPARATION WALLS SHALL BE CONSIDERED A SEPARATE BUILDING.

ACCESSIBLE UPGRADE SUMMARY
TOTAL PROJECT VALUATION = \$20,000
25% OF \$20,000 = \$5,000 OF REQUIRED UPGRADES

RESTRIPE ACCESSIBLE PARKING STALLS. ADD ACCESSIBLE SYMBOL AT ACCESSIBLE SPACE - WALL OR POLE MOUNT ACCESSIBLE SIGNAGE = \$3,000
CHANGE DOOR KNOBS TO LEVERED HANDLES - \$2,000

WALL LEGEND

- EXISTING WALL TO REMAIN
- EXISTING WALL TO BE REMOVED
- NEW WALL OF 2x4 STUDS @ 16" O.C. W/ 5/8" GYP. BD. EA. SIDE - SEE DETAIL 4/A6
- NEW 1 HR. RATED WALL PER GA FILE # WP 3510 - 2x4 STUDS @ 16" O.C. W/ 5/8" TYPE 'X' GYP. BD. EA. SIDE SEE DETAIL 4/A6-S1M1.
- NEW 2 HR. RATED INFILL WALL PER GA FILE # WP 4135 - 2x4 STUDS @ 16" O.C. W/ (2) LAYERS 5/8" TYPE 'X' GYP. BD. EA. SIDE SEE DETAIL 4/A6-S1M2.

OCCUPANT LOAD CALCULATIONS

OCCUPANT LOAD IN 2004

BLDG. A:	SF	OL
LOWER FLOOR		
SLEEPING ROOMS	2,030	11
MAIN FLOOR		
OFFICE	180	2
LOBBY AREA	360	24
SLEEPING ROOMS	3,000	15
UPPER FLOOR		
SLEEPING ROOMS	1,430	8
TOTAL		60

BLDG. B:	SF	OL
LOWER FLOOR		
MEETING ROOM	750	50
MECHANICAL	250	3
LAUNDRY	500	5
SUNNAS	350	11
SLEEPING ROOMS	2,050	11
MAIN FLOOR		
SLEEPING ROOMS	3,950	20
UPPER FLOOR		
SLEEPING ROOMS	3,950	20
TOTAL		116

BLDG. C:	SF	OL
LOWER FLOOR		
MAID/STOR.	200	2
SLEEPING ROOMS	3,900	20
MAIN FLOOR		
MAID/STOR.	200	2
SLEEPING ROOMS	9,400	41
UPPER FLOOR		
MAID/STOR.	200	2
SLEEPING ROOMS	9,400	41
TOTAL		120

PROPOSED OCCUPANT LOAD

BLDG. A:	SF	OL
LOWER FLOOR		
SLEEPING ROOMS	2,030	11
MAIN FLOOR		
OFFICE	530	6
LOBBY AREA	800	54
SLEEPING ROOMS	2,250	12
UPPER FLOOR		
SLEEPING ROOMS	1,430	8
TOTAL		91

BLDG. B:	SF	OL
LOWER FLOOR		
FITNESS RM.	500	10
STORAGE	500	5
LAUNDRY	500	5
BREAK ROOM	350	12
SLEEPING ROOMS	2,050	11
MAIN FLOOR		
SLEEPING ROOMS	3,950	20
UPPER FLOOR		
SLEEPING ROOMS	3,950	20
TOTAL		83

BLDG. C:	SF	OL
LOWER FLOOR		
MAID/STOR.	200	2
SLEEPING ROOMS	3,900	20
MAIN FLOOR		
MAID/STOR.	200	2
SLEEPING ROOMS	9,400	41
UPPER FLOOR		
MAID/STOR.	200	2
SLEEPING ROOMS	9,400	41
TOTAL		120

* CHANGES MADE PER PERMIT 05-144516-CO
** CHANGES PROPOSED PER THIS PERMIT



DMS ARCHITECTS

2325 NE 19TH AVE
PORTLAND, OR 97212

OFFICE 503 335 9040
FAX 503 335 5850
DAVE@DMSARCHITECTS.COM

HOWARD JOHNSONS

8247 NE SANDY BLVD.
PORTLAND, OREGON 97220

SHEET CONTENT
SITE PLAN
CODE SUMMARY

JOB No.
000016

DRAWN
DMS


CHECKED

DATE
2-20-19


REVISIONS
REV. 1 4-12-19

SHEET


A1 of 6

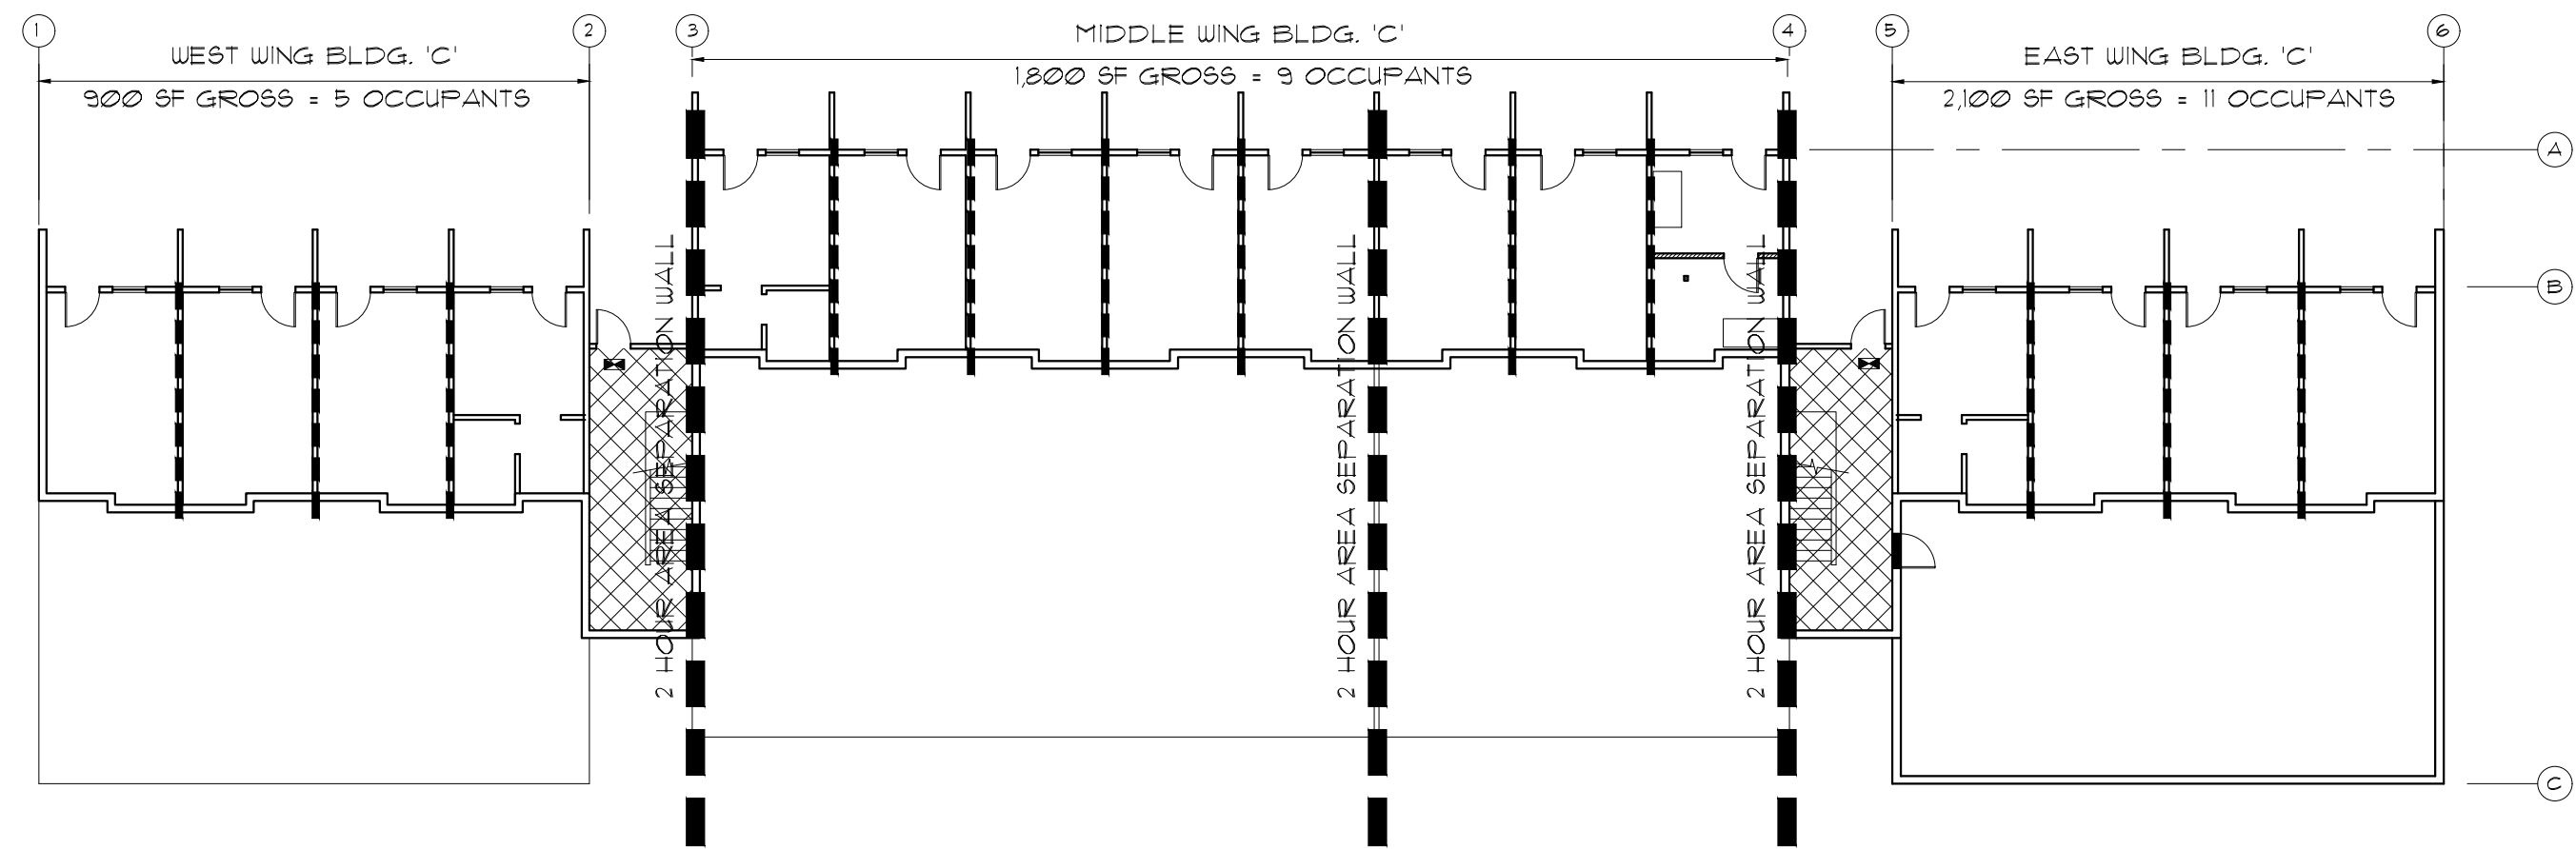


1
A2 GROUND FLOOR PLAN BUILDING 'C'
1/16" = 1'-0"

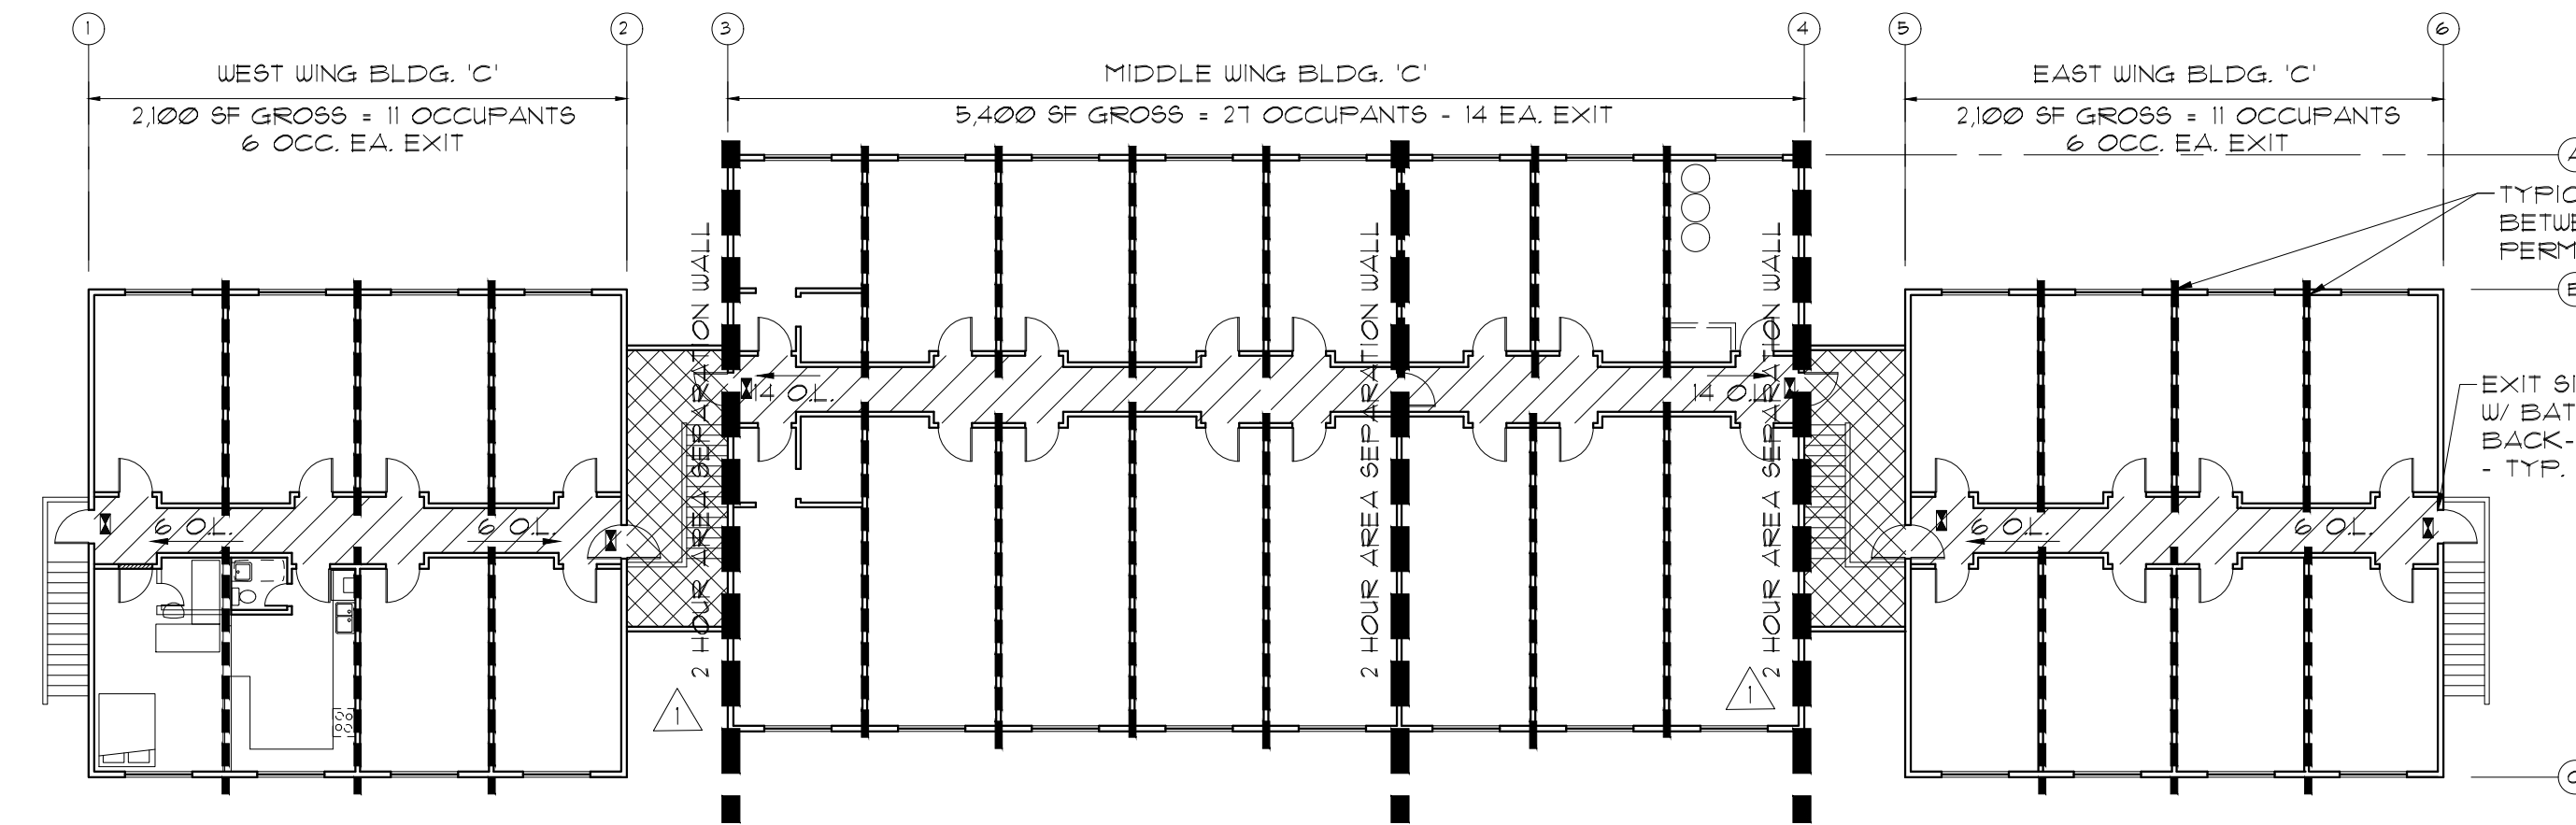


2
A2 UPPER FLOOR PLAN BUILDING 'C'
(MAIN FLOOR SIMILAR)
1/16" = 1'-0"

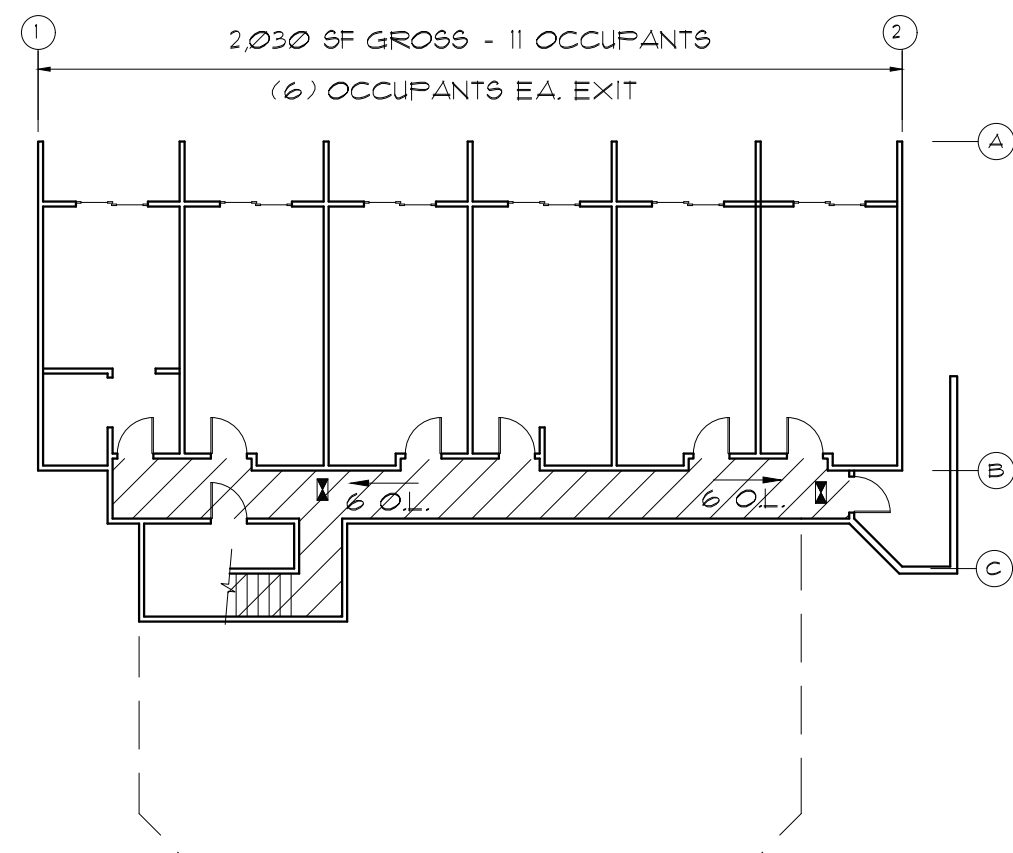

5
A2 LOWER FLOOR PLAN BLDG. 'A'
1/16" = 1'-0"

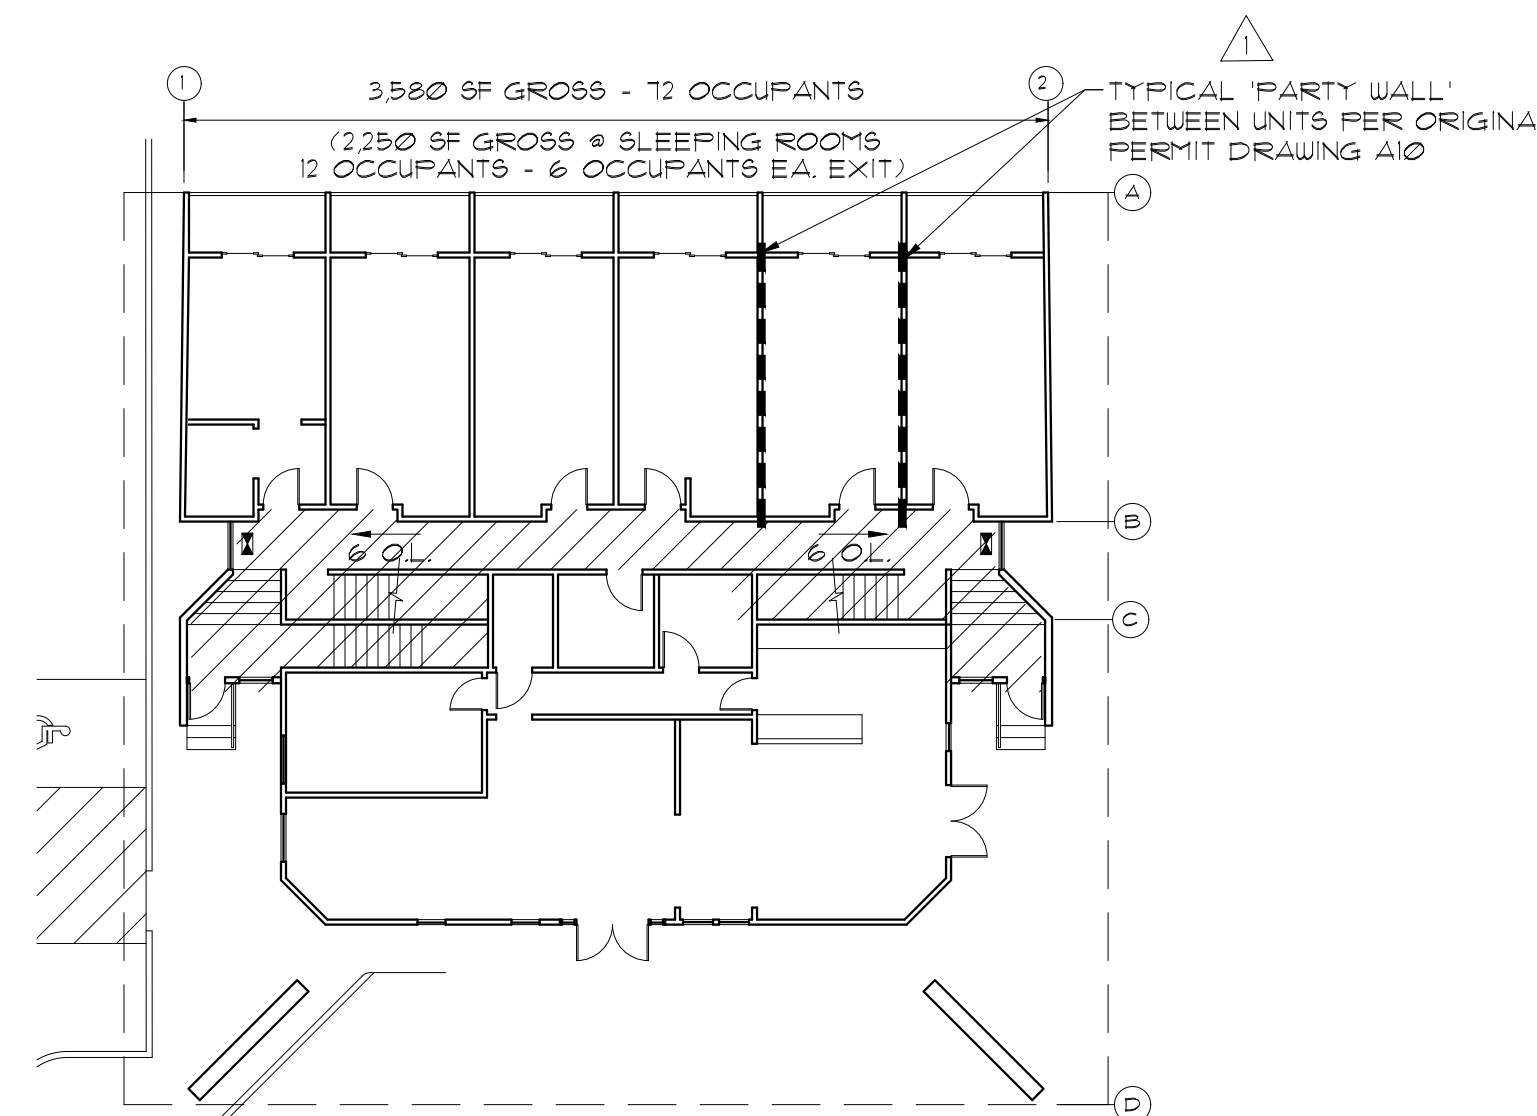


6
A2 GROUND FLOOR PLAN BLDG. 'A'
1/16" = 1'-0"

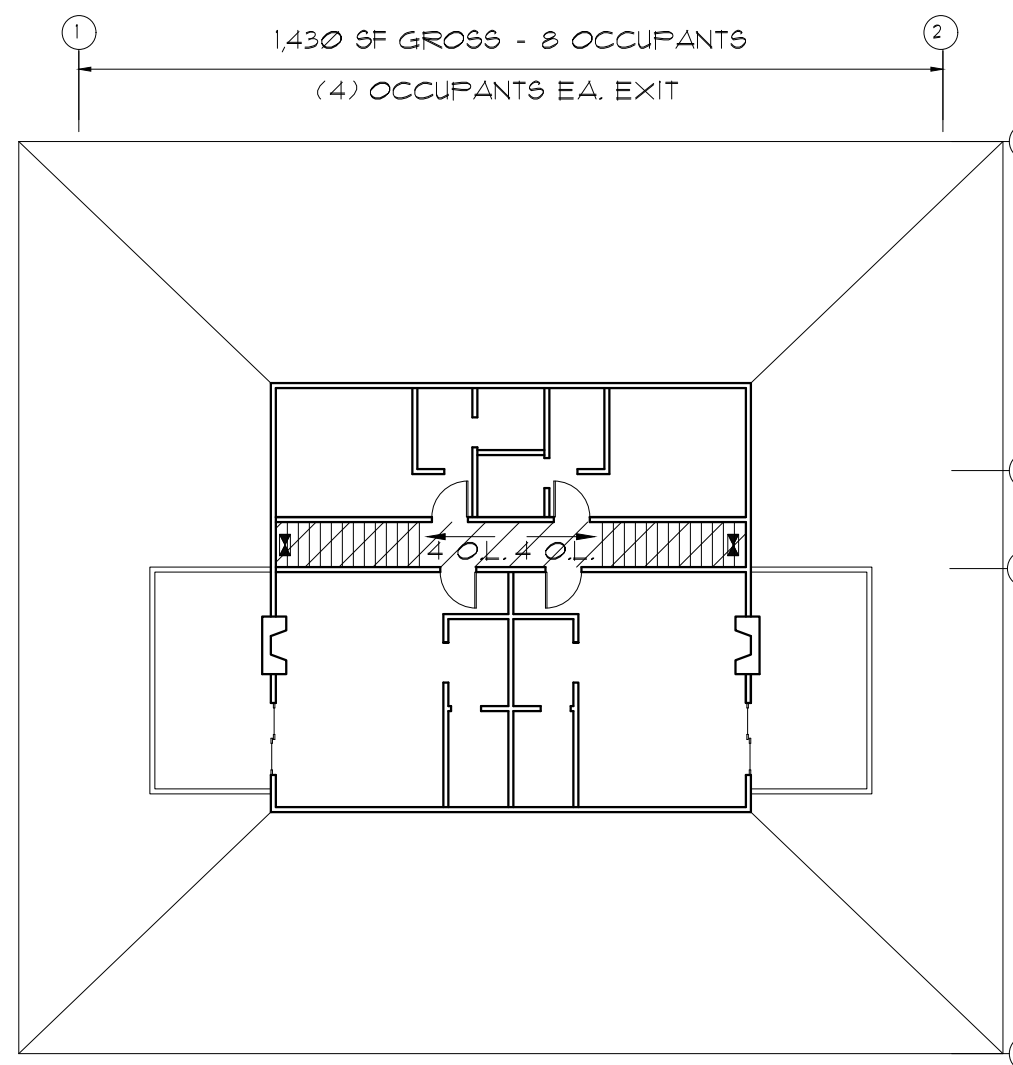


7
A2 UPPER FLOOR PLAN BLDG. 'A'
1/16" = 1'-0"

KEY

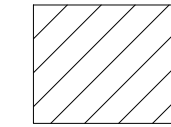

ONE HOUR CORRIDOR

- ALL DOORS OPENING INTO RATED CORRIDOR TO BE 20 MINUTE RATED OR 1 1/2" S.C. DOORS W/ CLOSERS AND SMOKE GASKETING
- EGRESS LIGHTING SHALL BE PROVIDED ALONG ENTIRE CORRIDOR - 1 FT. CANDLE MIN.
- NO OTHER OPENINGS IN FIREWALL OTHER THAN FIRE RATED OPENINGS/ PENETRATIONS

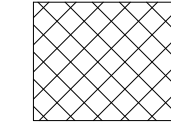

TWO HOUR RATED STAIR ENCLOSURE


- ALL DOORS OPENING INTO RATED STAIR ENCLOSURE SHALL BE 90 MINUTE RATED W/ CLOSERS AND SMOKE GASKETING
- EGRESS LIGHTING SHALL BE PROVIDED THROUGHOUT ALL STAIR ENCLOSURES - 1 FT. CANDLE MIN.

2 HOUR AREA SEPARATION WALL


- ALL DOORS OPENING THROUGH 2 HOUR AREA SEPARATION WALLS SHALL BE 90 MINUTE RATED W/ CLOSERS AND SMOKE GASKETING
- NO OTHER OPENINGS IN FIREWALL OTHER THAN FIRE RATED OPENINGS/ PENETRATIONS

TYPICAL PARTY WALL BETWEEN UNITS


- PER ORIGINAL PERMIT DRAWING A10.

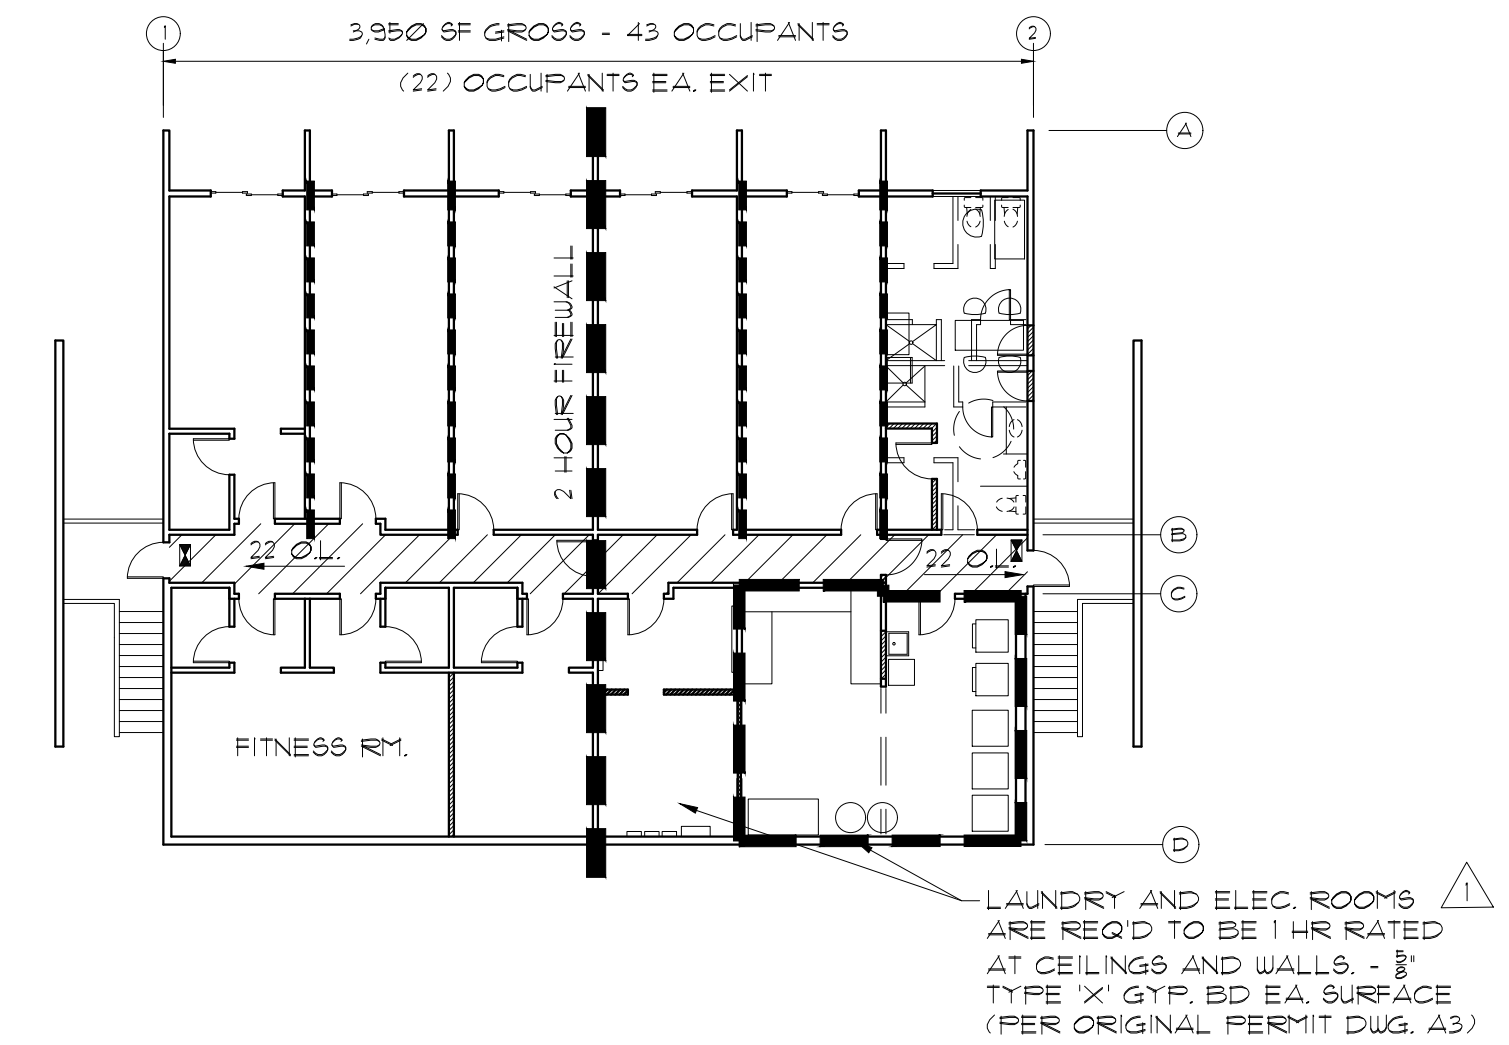


3
A2 GROUND FLOOR PLAN BLDG. 'B'
(MAIN FLOOR SIMILAR)
1/16" = 1'-0"

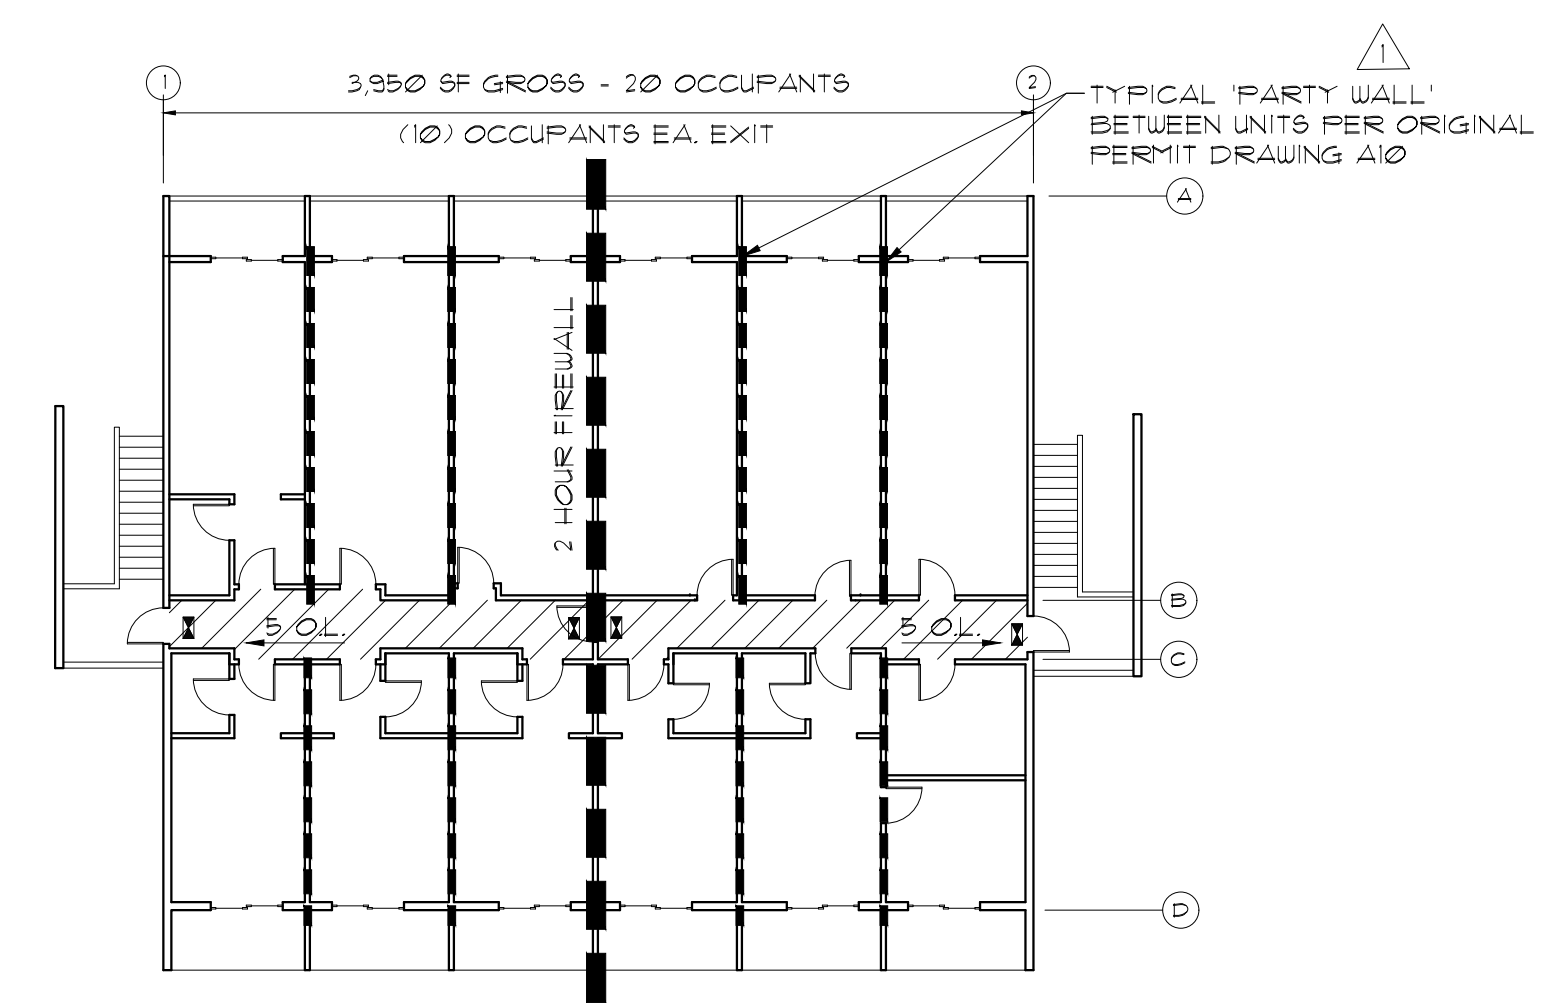


4
A2 UPPER FLOOR PLAN BLDG. 'B'
(MAIN FLOOR SIMILAR)
1/16" = 1'-0"

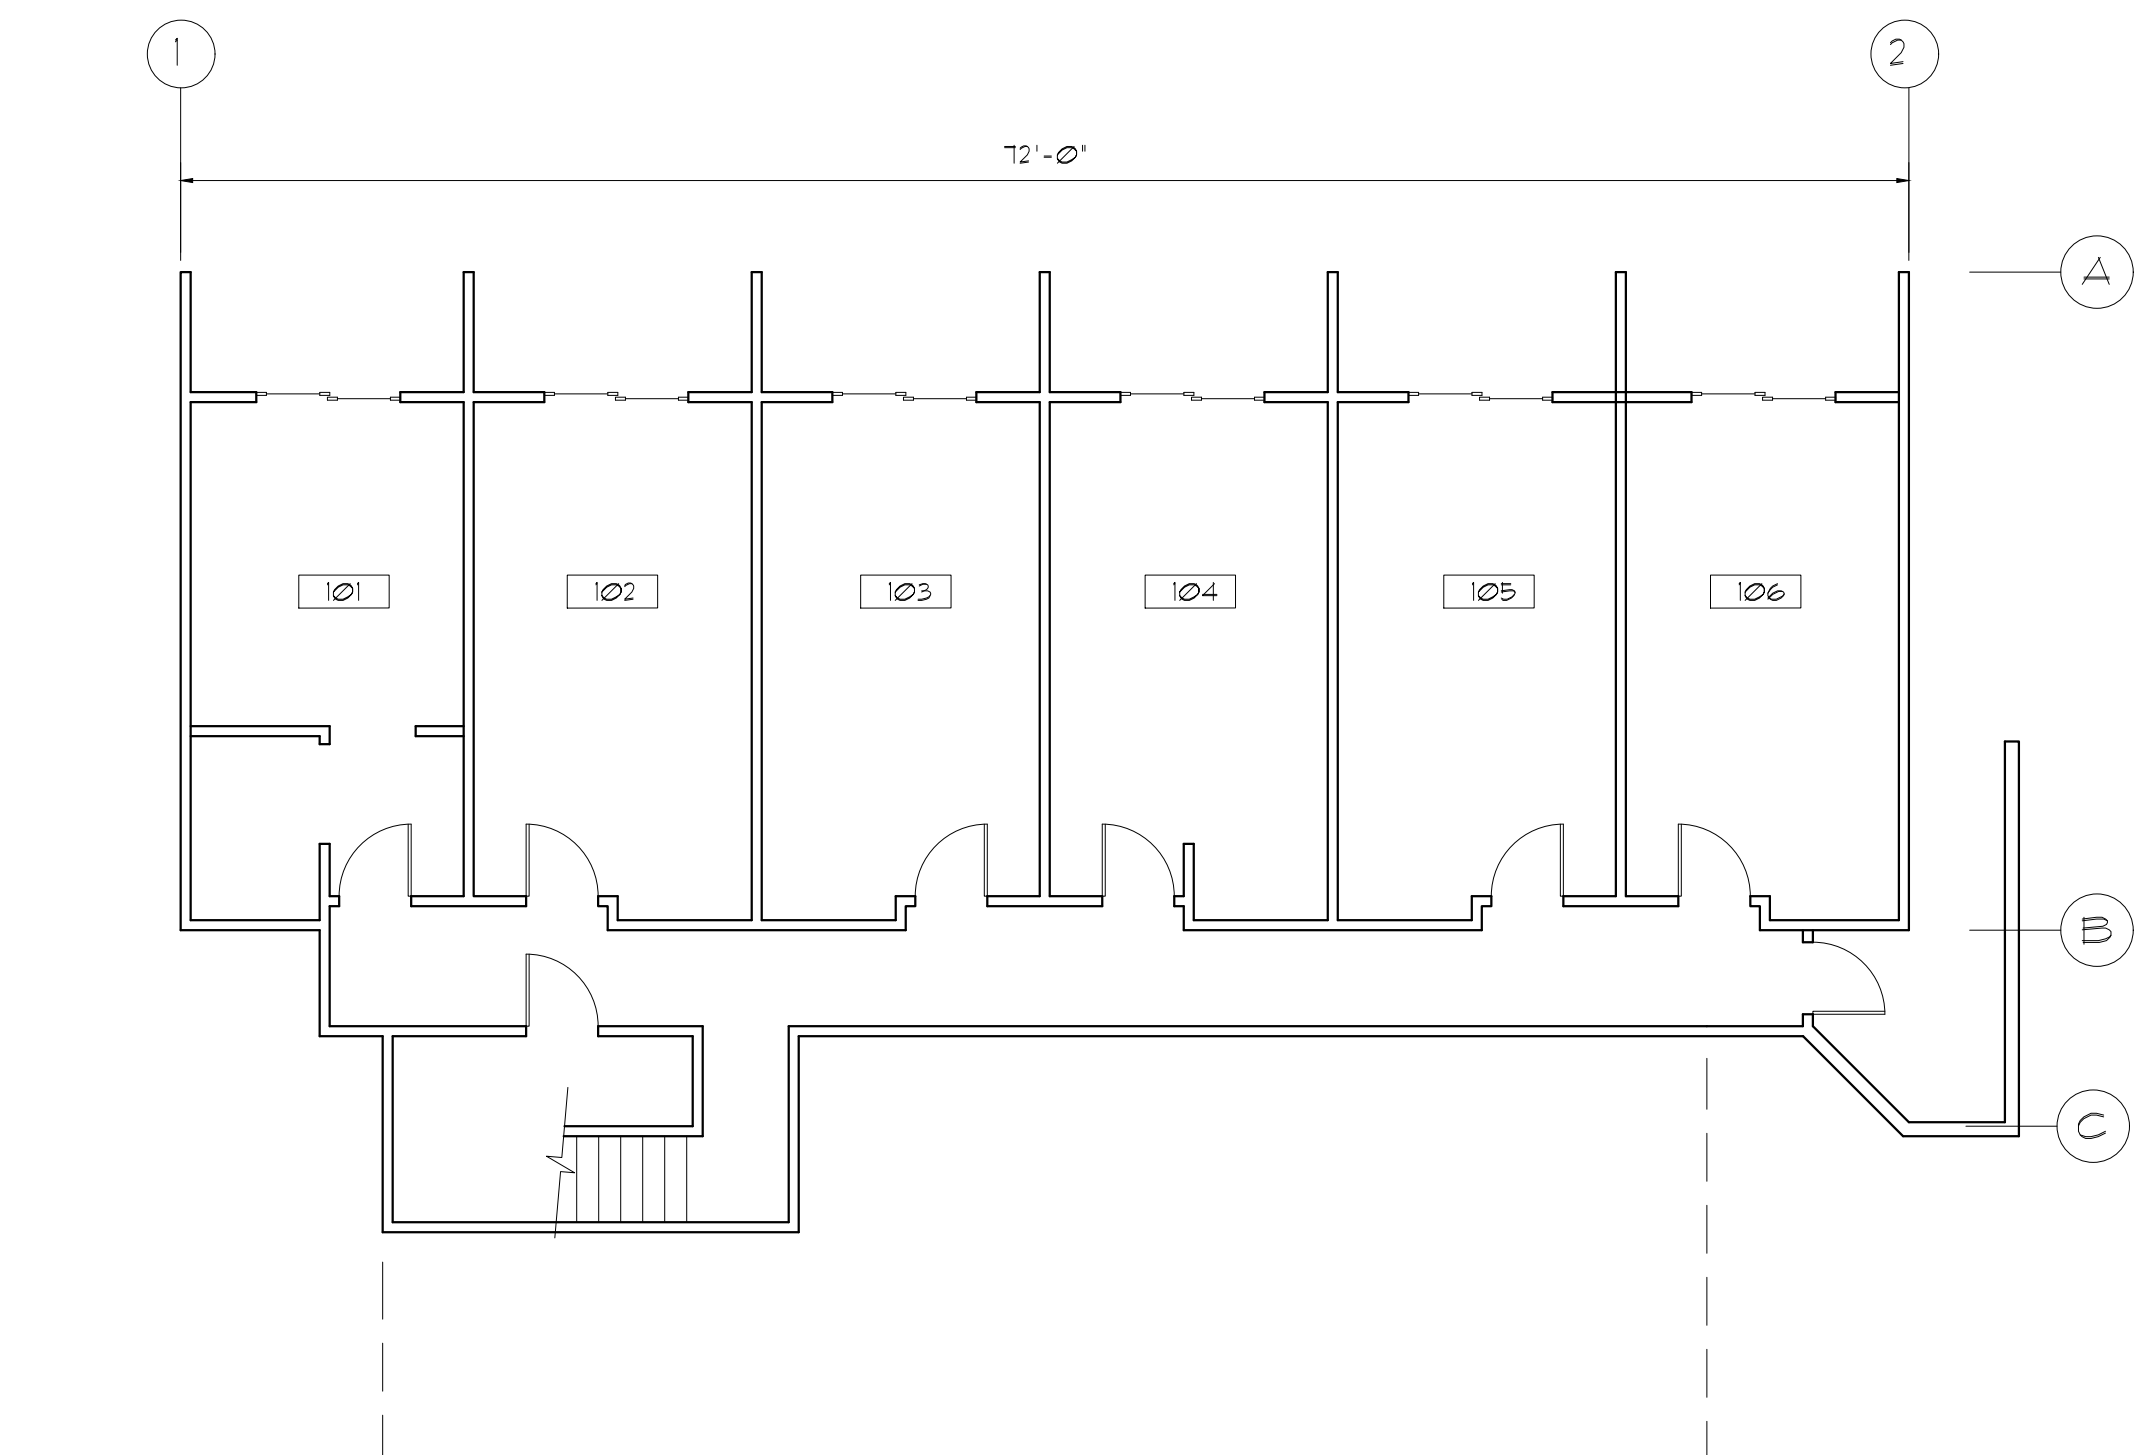

1 LOWER LEVEL PLAN BUILDING 'A'

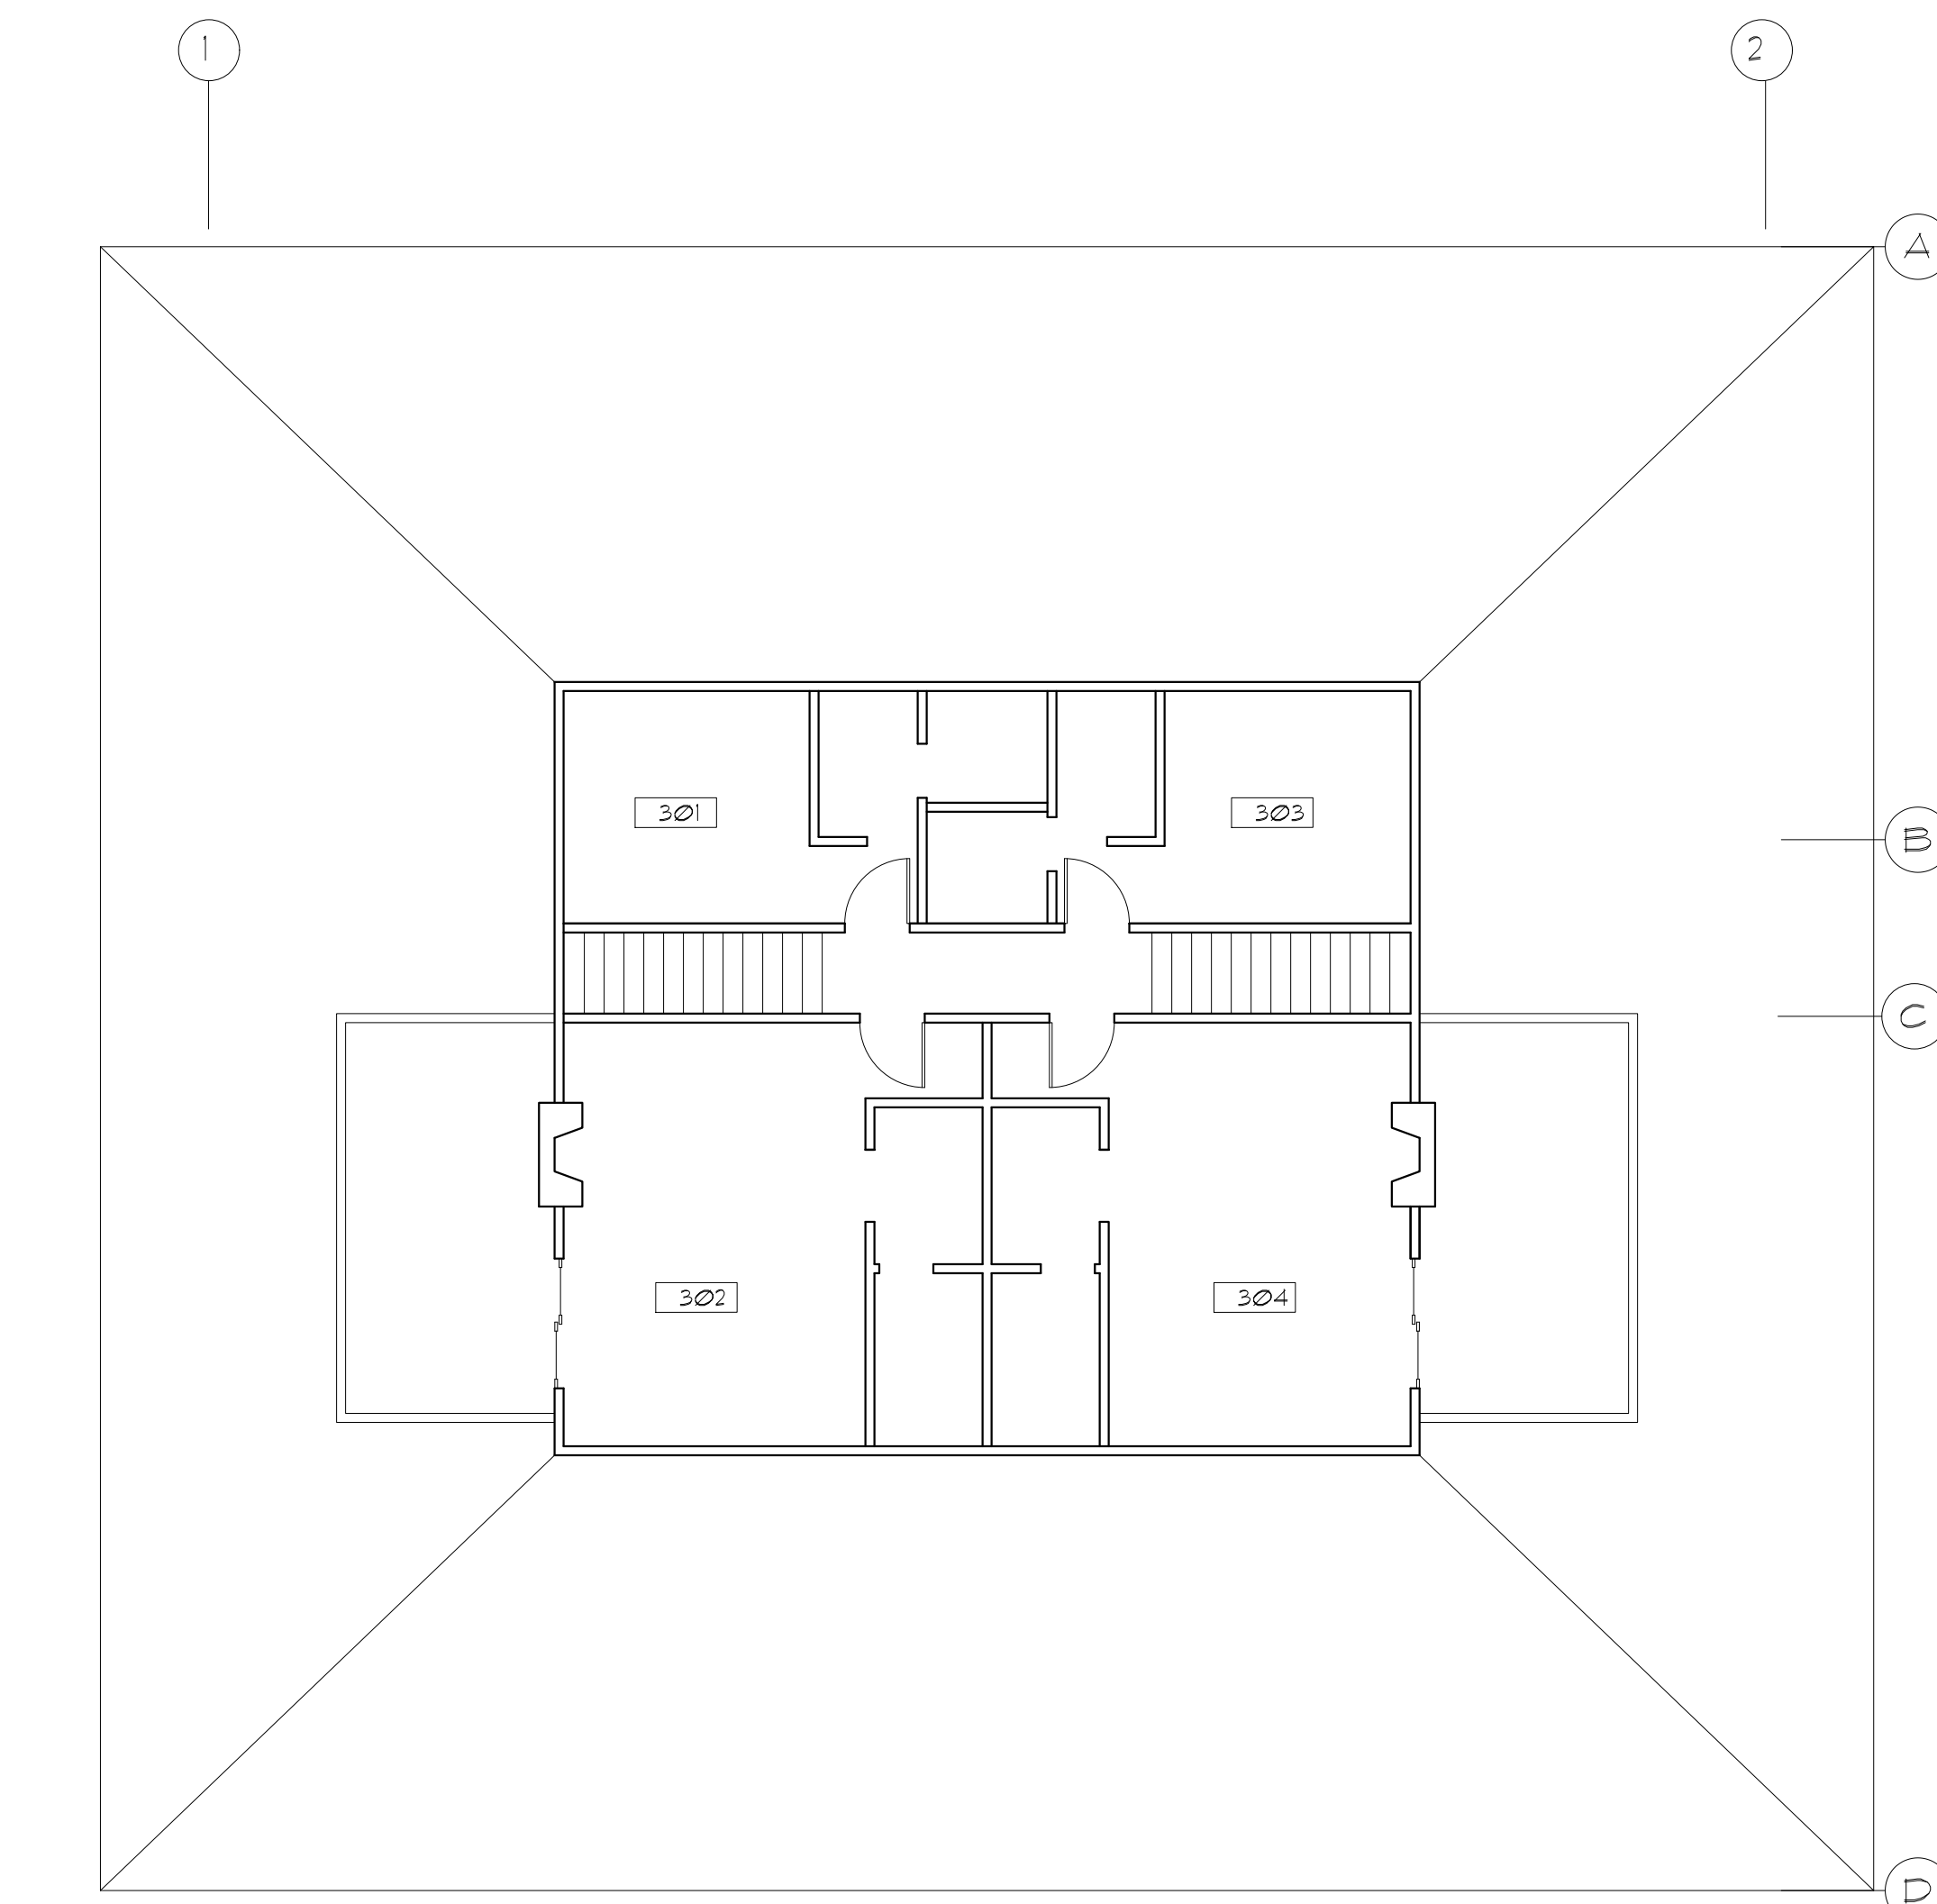

3 UPPER LEVEL PLAN BUILDING 'A'

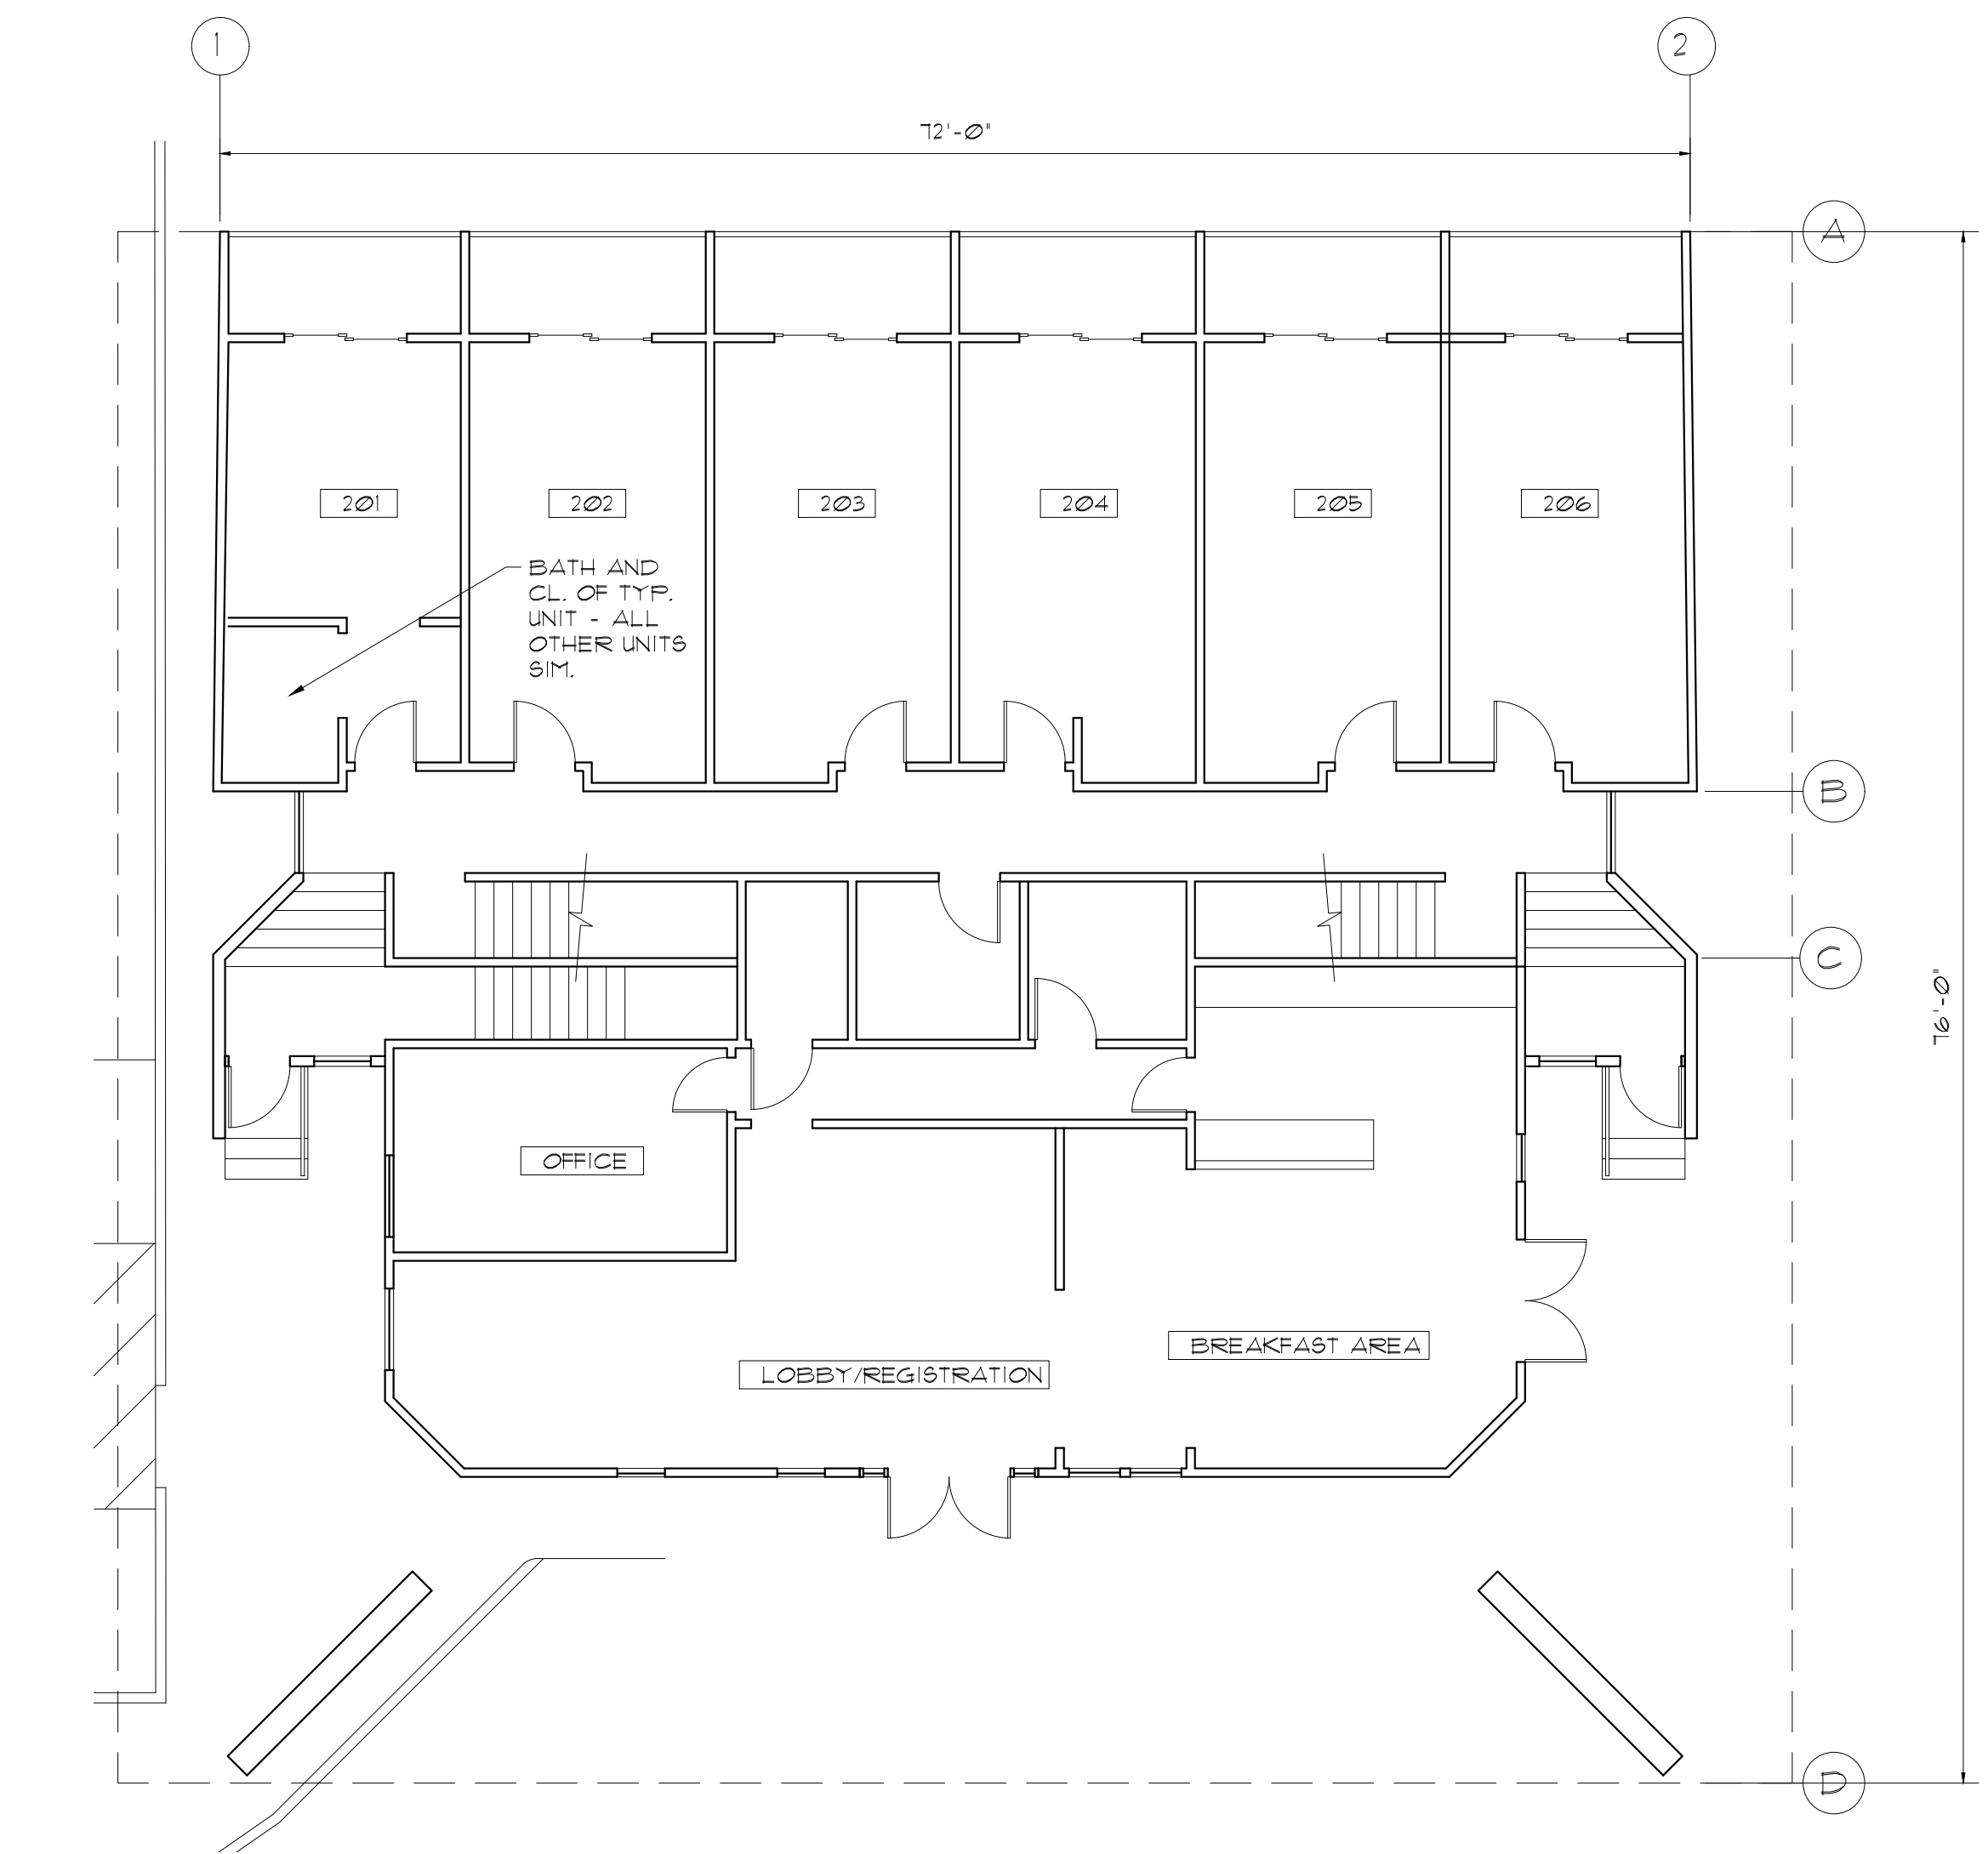

2 MAIN LEVEL PLAN BUILDING 'A'

SCOPE OF WORK BUILDING 'A'
NO PROPOSED WORK IN BLDG. A EXCEPT AS SHOWN ON THE 'CODE DIAGRAMS' ON A2 - IE VERIFICATION/INSTALLATION/REPAIR OF WORKING EXIT SIGNS, EGRESS LIGHTING AND FIRE RATED DOORS (OR 1 3/4" S.C.) W/ CLOSERS AND SMOKE GASKETING



DMS ARCHITECTS
2325 NE 19TH AVE
PORTLAND, OR 97212
OFFICE 503 335 9040
FAX 503 335 5850
DAVE@DMSARCHITECTS.COM

HOWARD JOHNSONS

8247 NE SANDY BLVD.
PORTLAND, OREGON 97220

SHEET CONTENT
BUILDING 'A' FLOOR PLANS


JOB No. 000016

DRAWN DMS CHECKED


DATE 2-20-19

REVISIONS


SHEET A3 OF 6

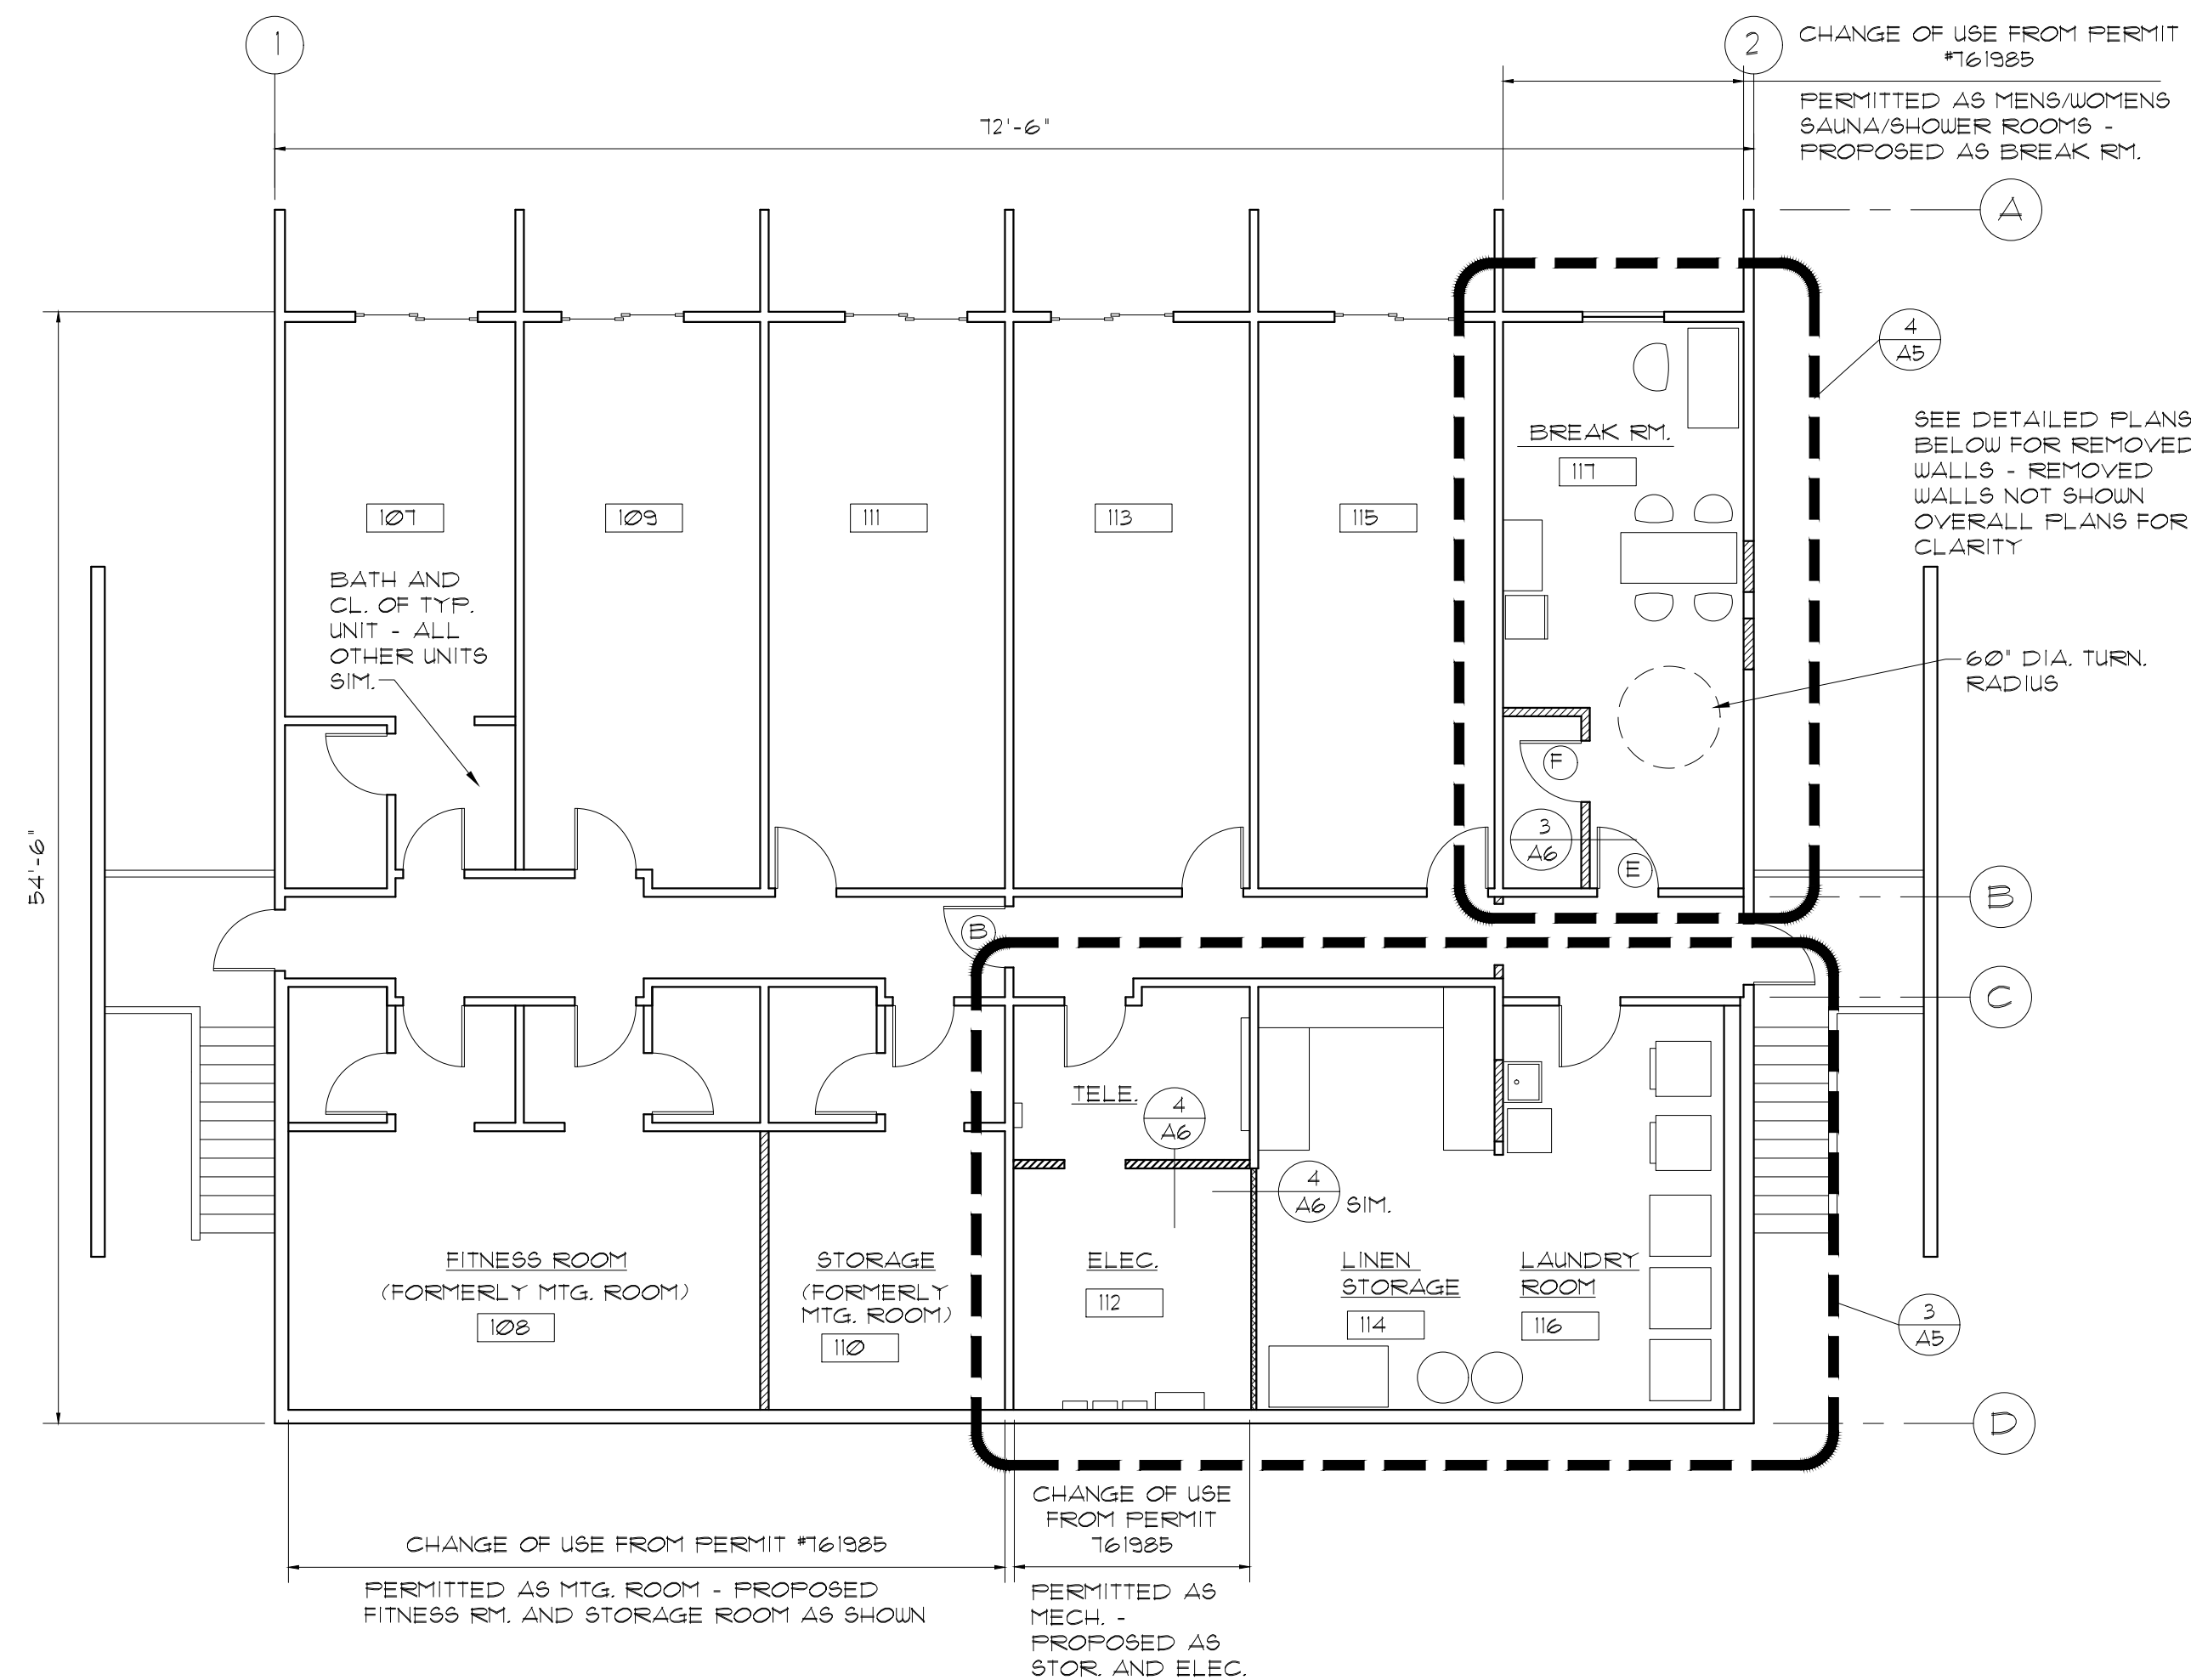


1 LOWER LEVEL FLOOR PLAN BLDG. 'B'

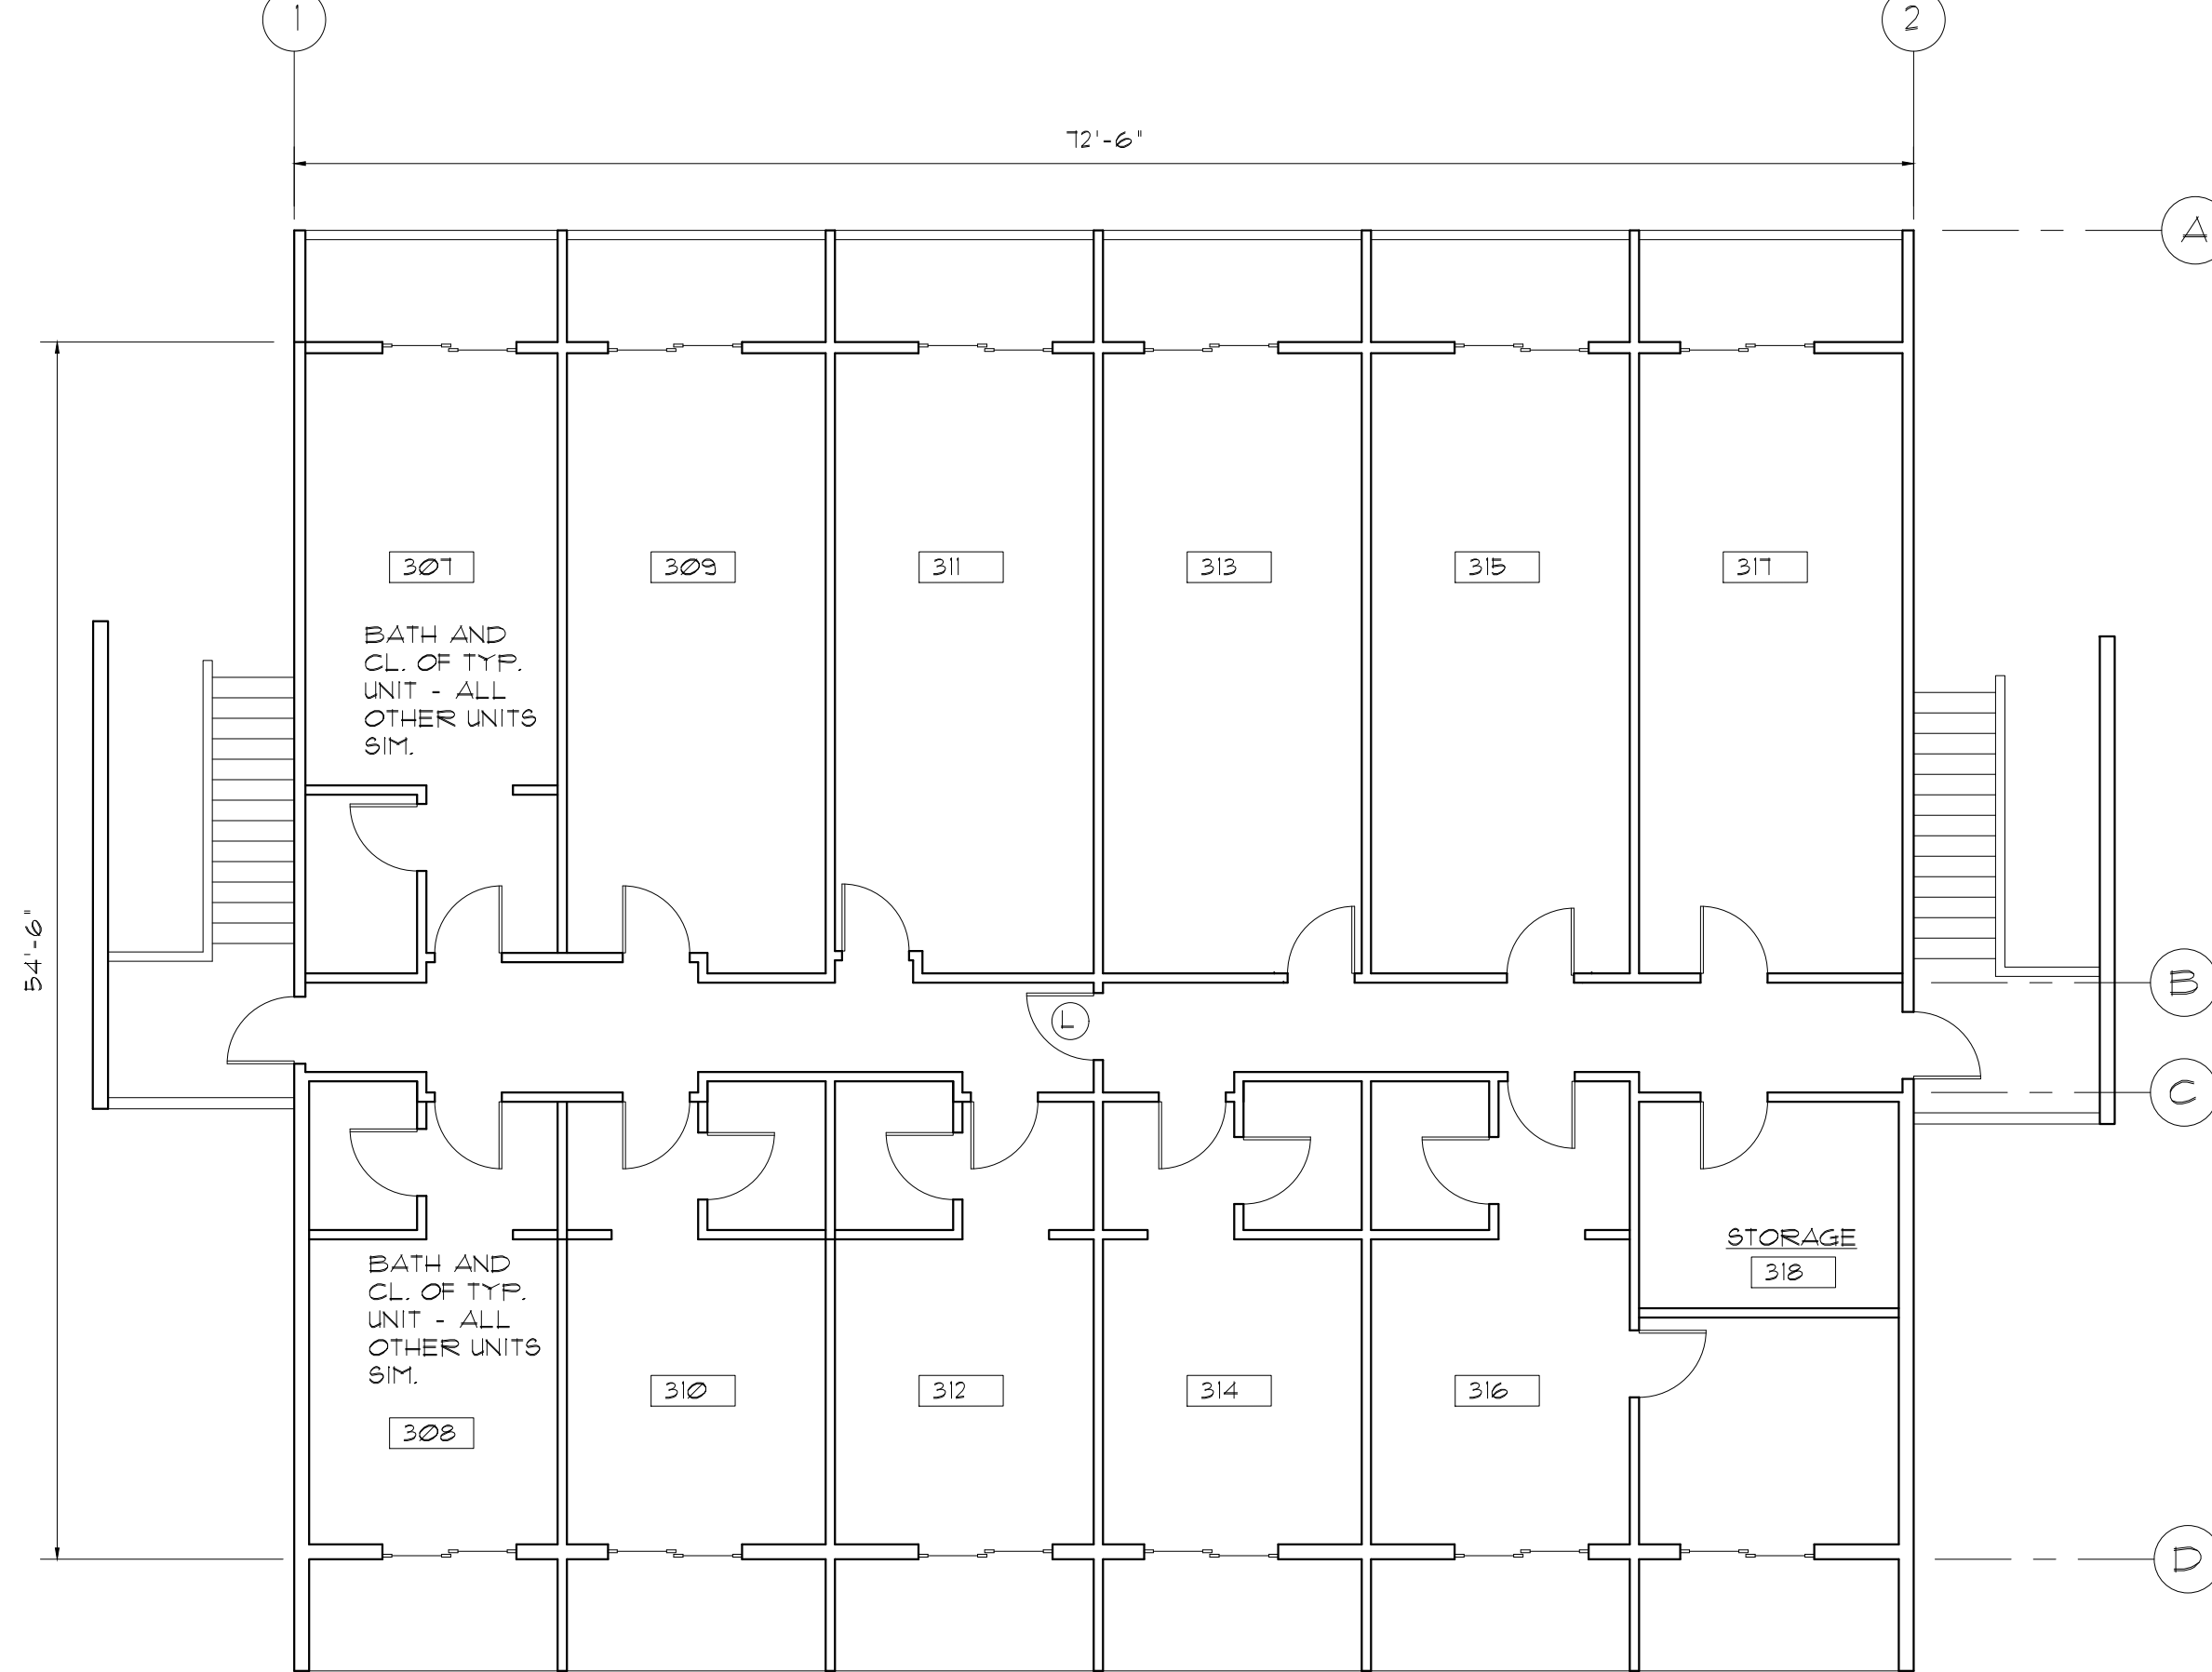

2 UPPER FLOOR PLAN BUILDING 'B'

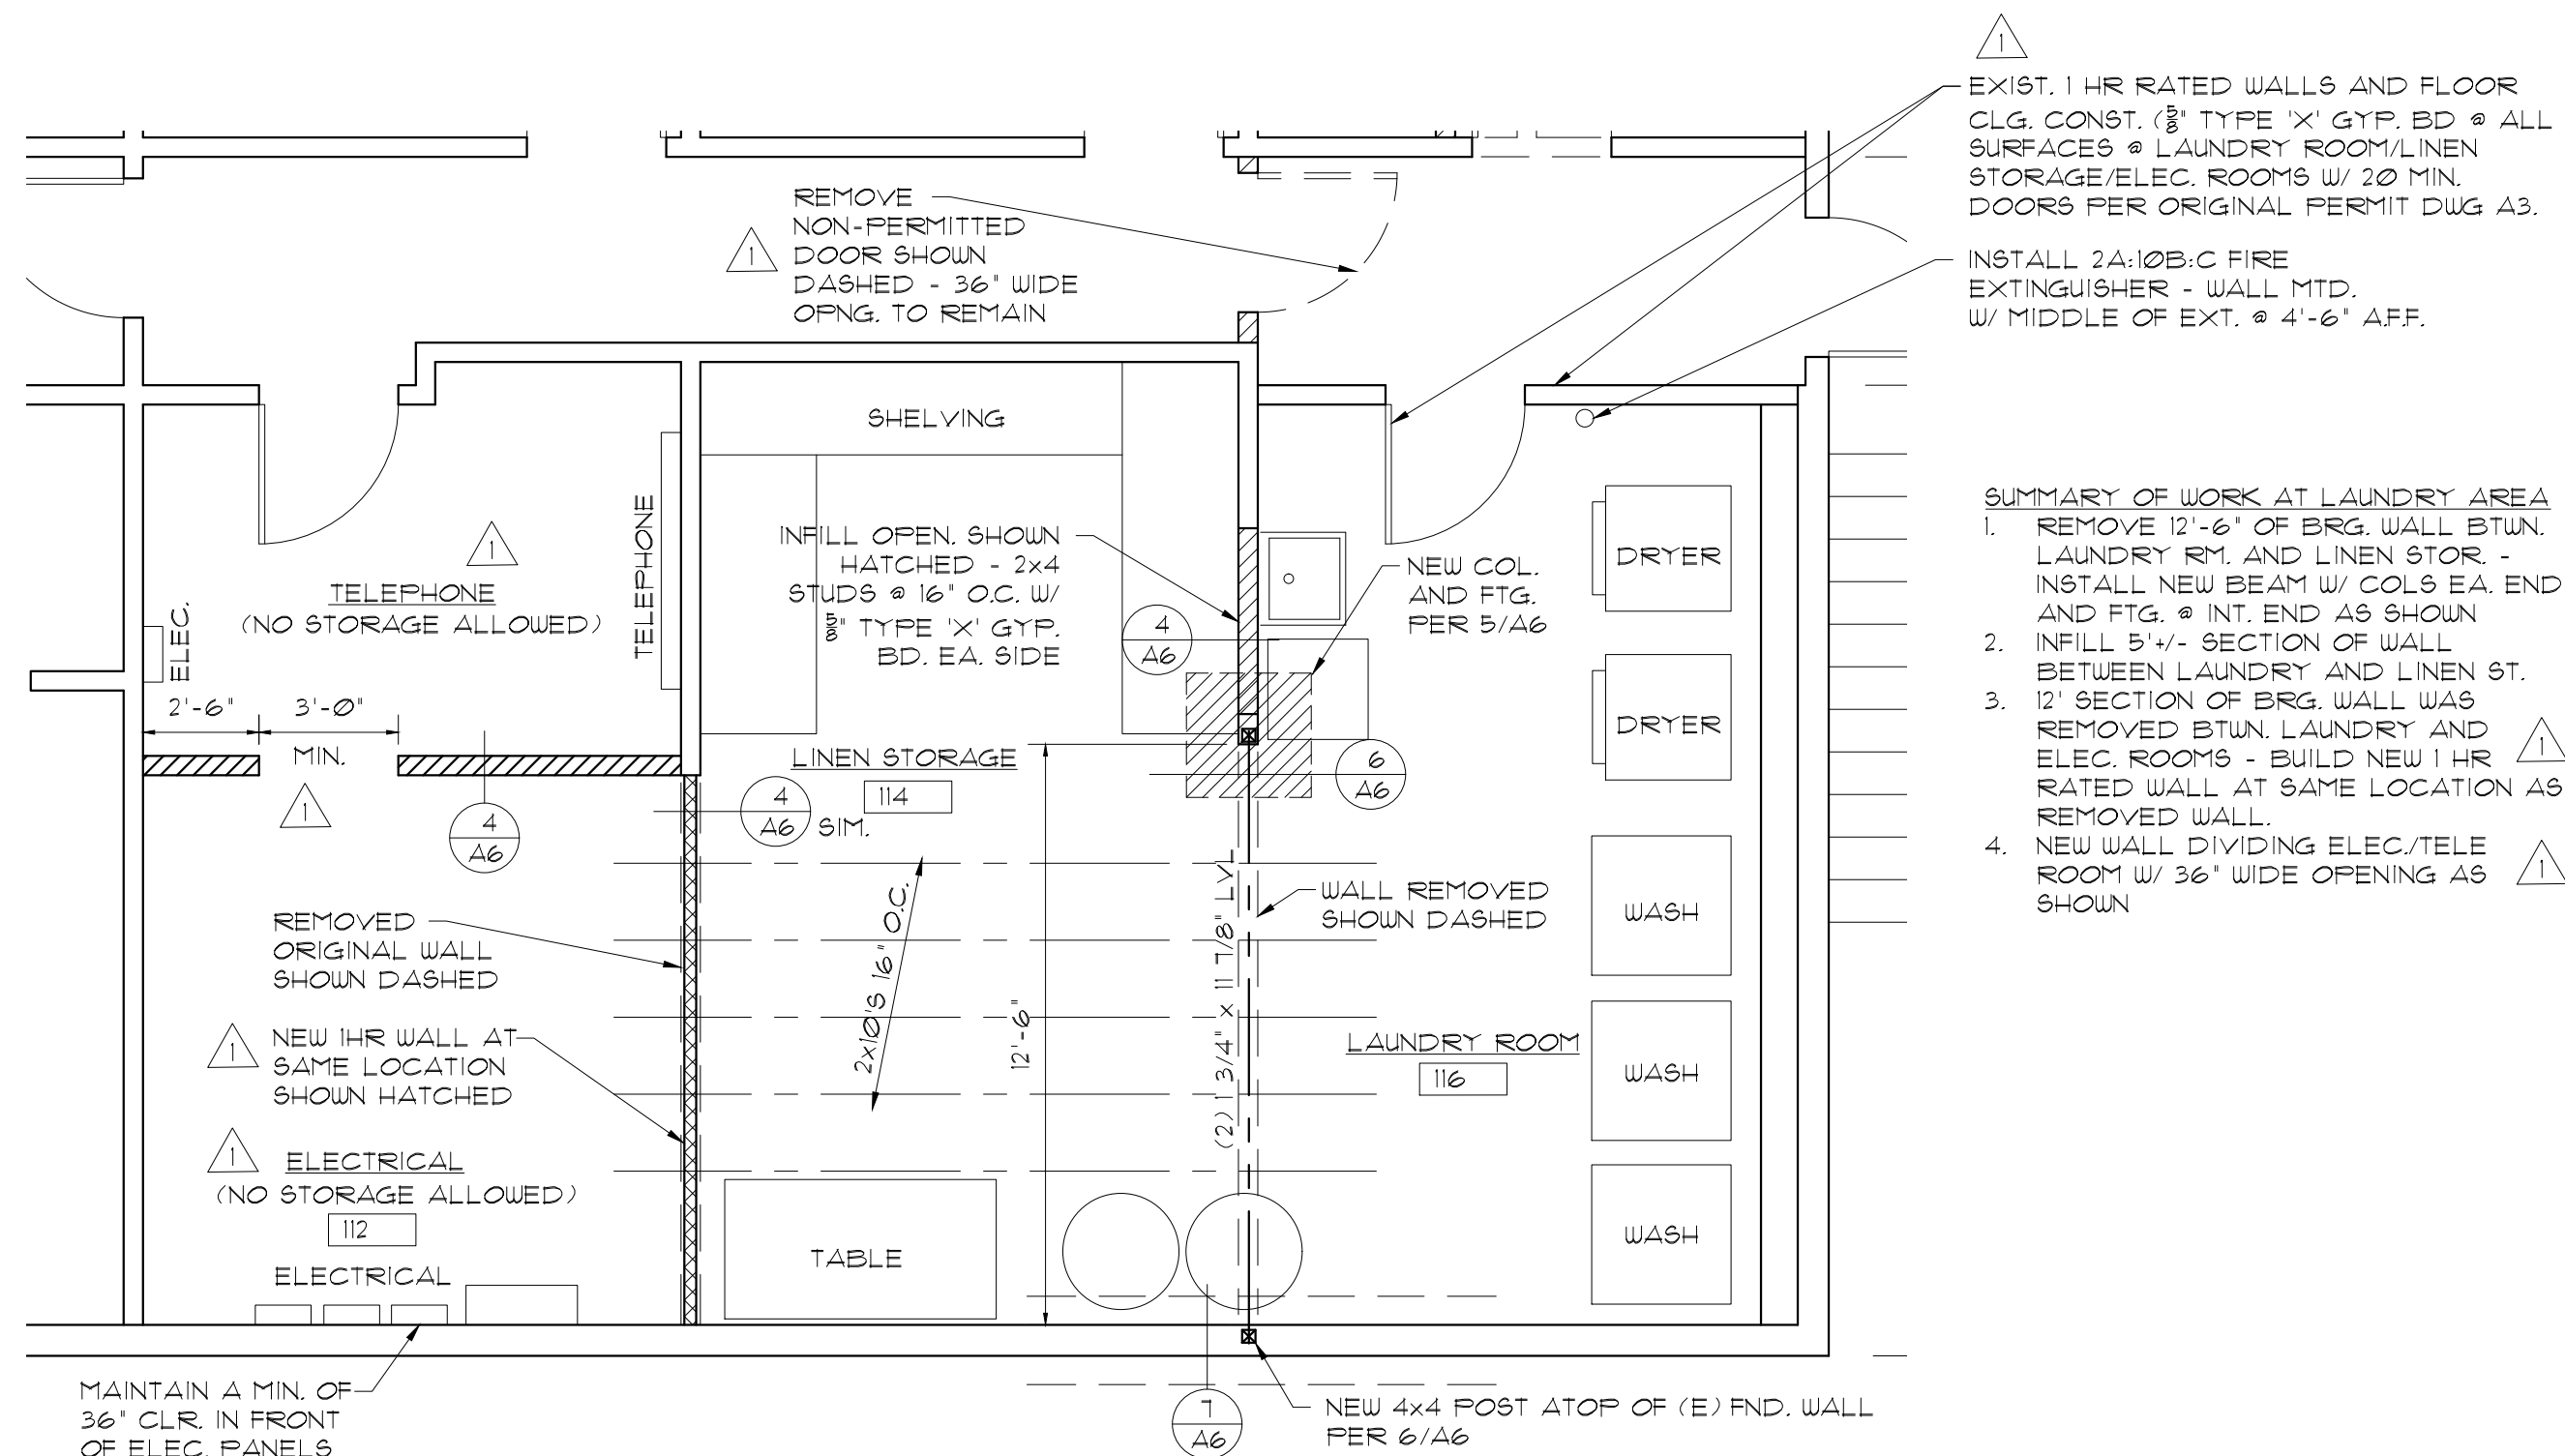

3 ENLARGED PLAN OF LAUNDRY AREA GROUND FLOOR BLDG. 'B'

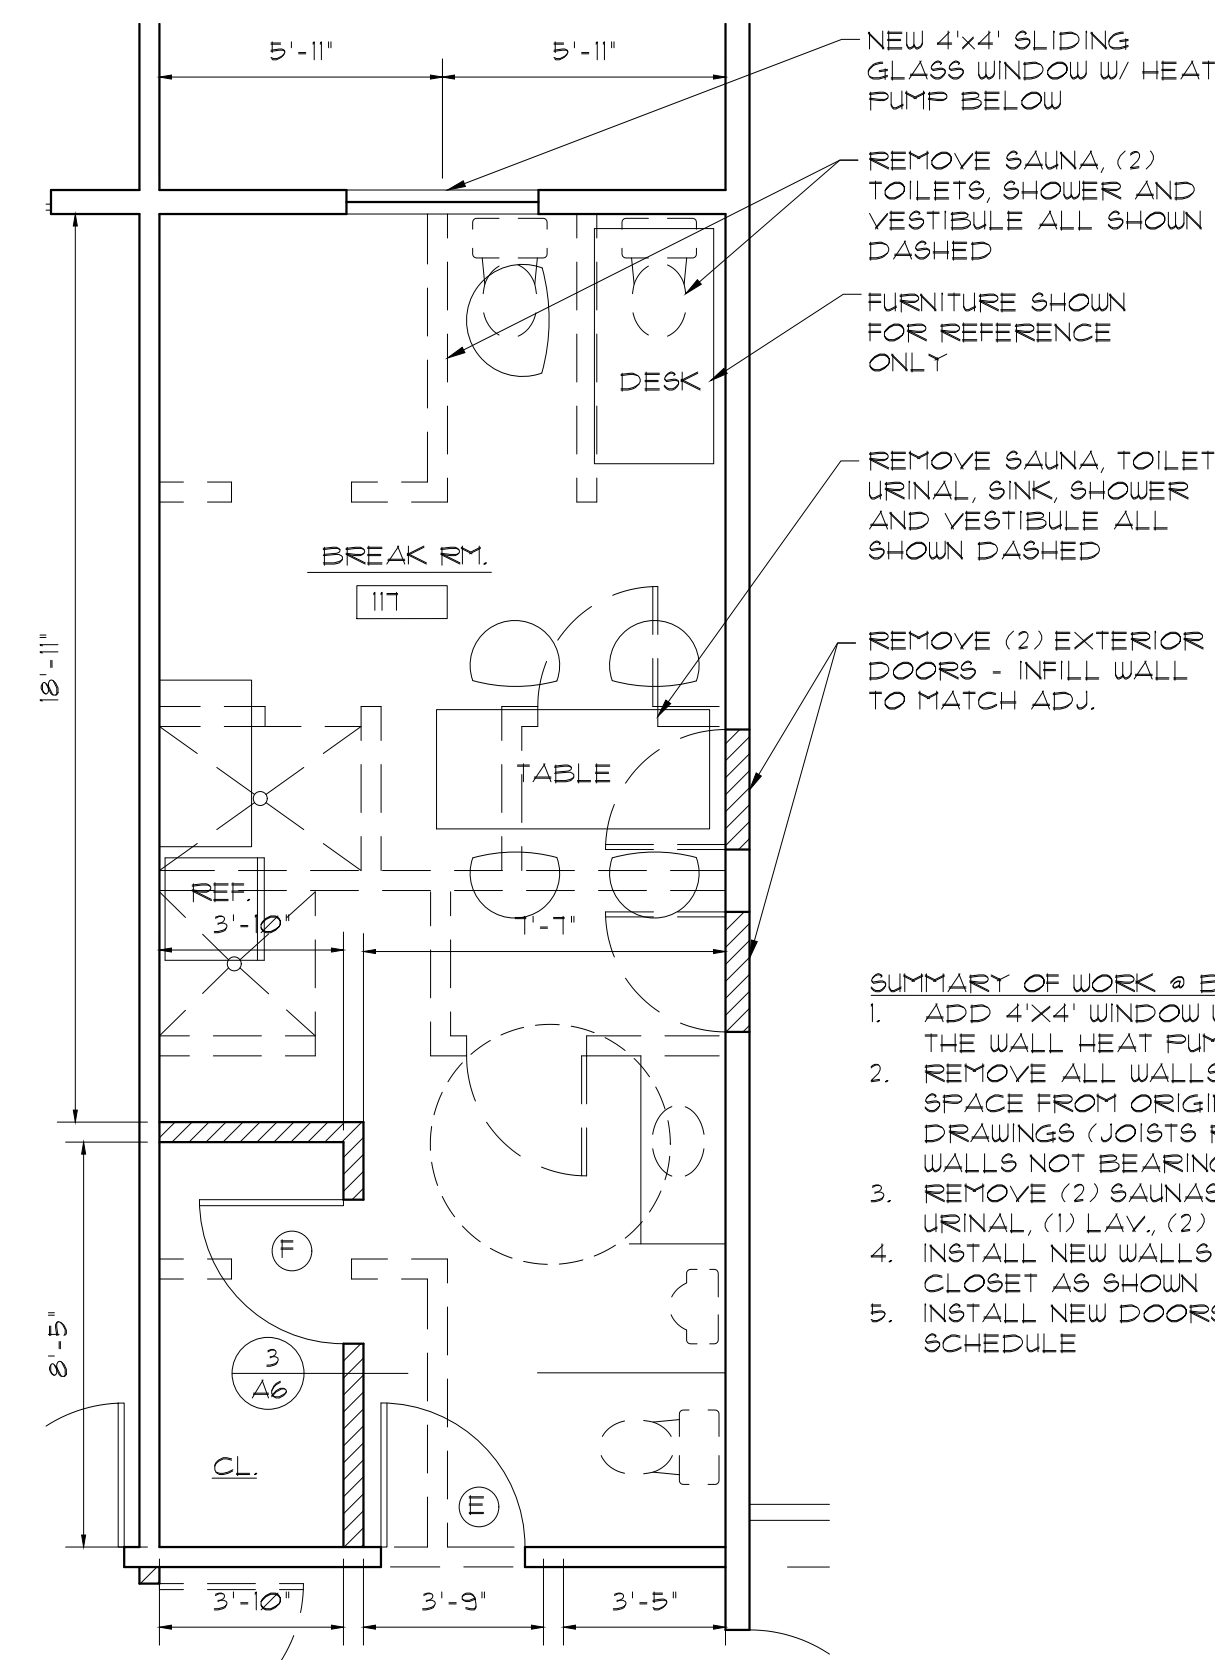

4 ENLARGED PLAN OF BREAK ROOM - GROUND FLOOR BLDG. 'B'

SCOPE OF WORK BUILDING 'B'

- VERIFICATION/INSTALLATION/REPAIR OF WORKING EXIT SIGNS, EGRESS LIGHTING AND FIRE RATED DOORS ALONG CORRIDOR (OR 1 1/2" S.C.) W/ CLOSERS AND SMOKE GASKETING.
- CHANGE OF USE FOR ORIGINAL MEETING ROOM FOR NEW FITNESS ROOM AND STORAGE ROOMS.
- ADD WALL AT ELECTRICAL ROOM TO SEPARATE TELEPHONE EQUIPMENT PORTION FROM ELECTRICAL PORTIONS OF ROOM.
- ENLARGING EXISTING LAUNDRY ROOM BY ENLARGING OPENING TO ADJACENT LINEN STORAGE ROOM.
- REMOVAL OF TWO SAUNAS AND RELATED SHOWERS, TOILETS, ETC. CREATING A BREAK ROOM AND SMALL STORAGE CLOSET IN THIS AREA.

NOTE: SEE ALSO 'SUMMARY OF WORK' AS LISTED AT 3/A4 AND 4/A4 FOR SPECIFIC WORK @ ELEC/TELE AND LAUNDRY/LINEN ROOMS.



DMS ARCHITECTS

2325 NE 19TH AVE
PORTLAND, OR 97212

OFFICE 503 335 9040
FAX 503 335 5850
DAVE@DMSARCHITECTS.COM

HOWARD JOHNSONS

8247 NE SANDY BLVD.
PORTLAND, OREGON 97220

SHEET CONTENT

BUILDING 'B' FLOOR PLANS
DETAILED FLOOR PLANS

JOB No. 000016


DRAWN DMS CHECKED

DATE 2-20-19


REVISIONS
REV. 1 4-12-19

SHEET

A4 OF 6

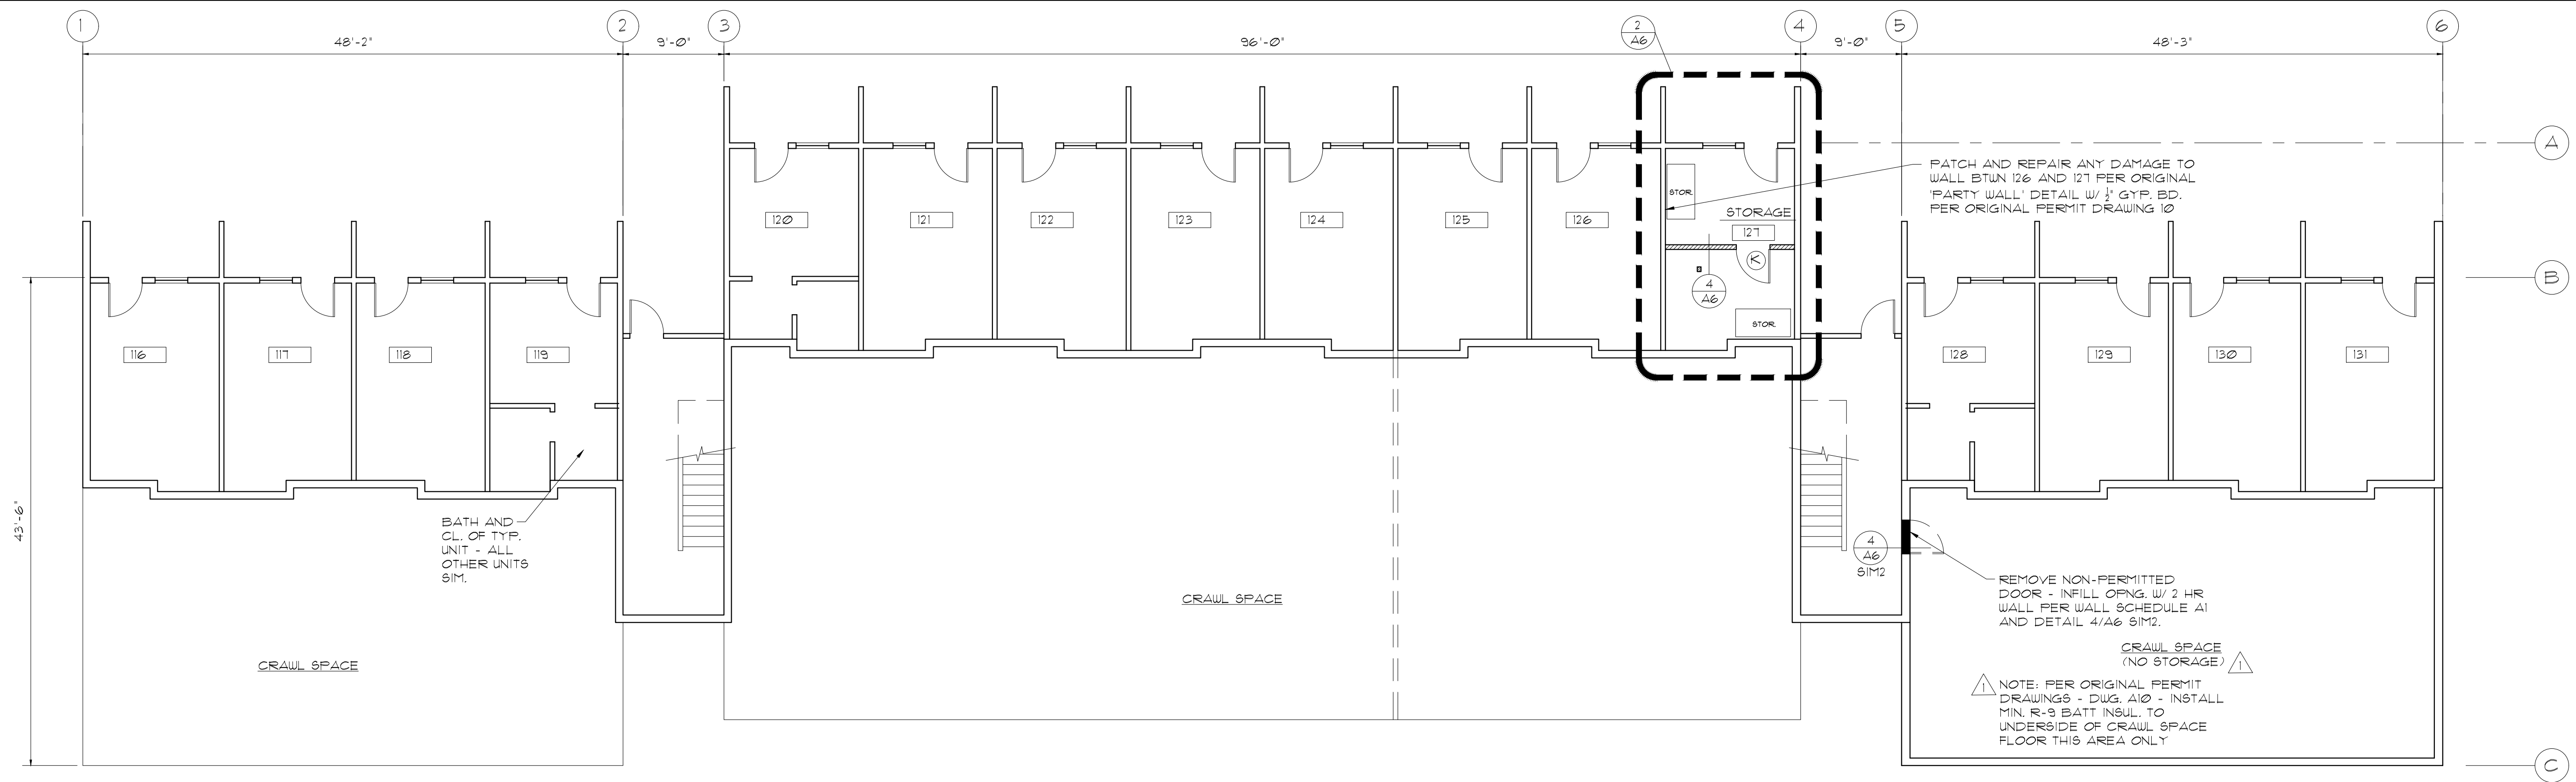

1 LOWER LEVEL FLOOR PLAN BUILDING 'C'

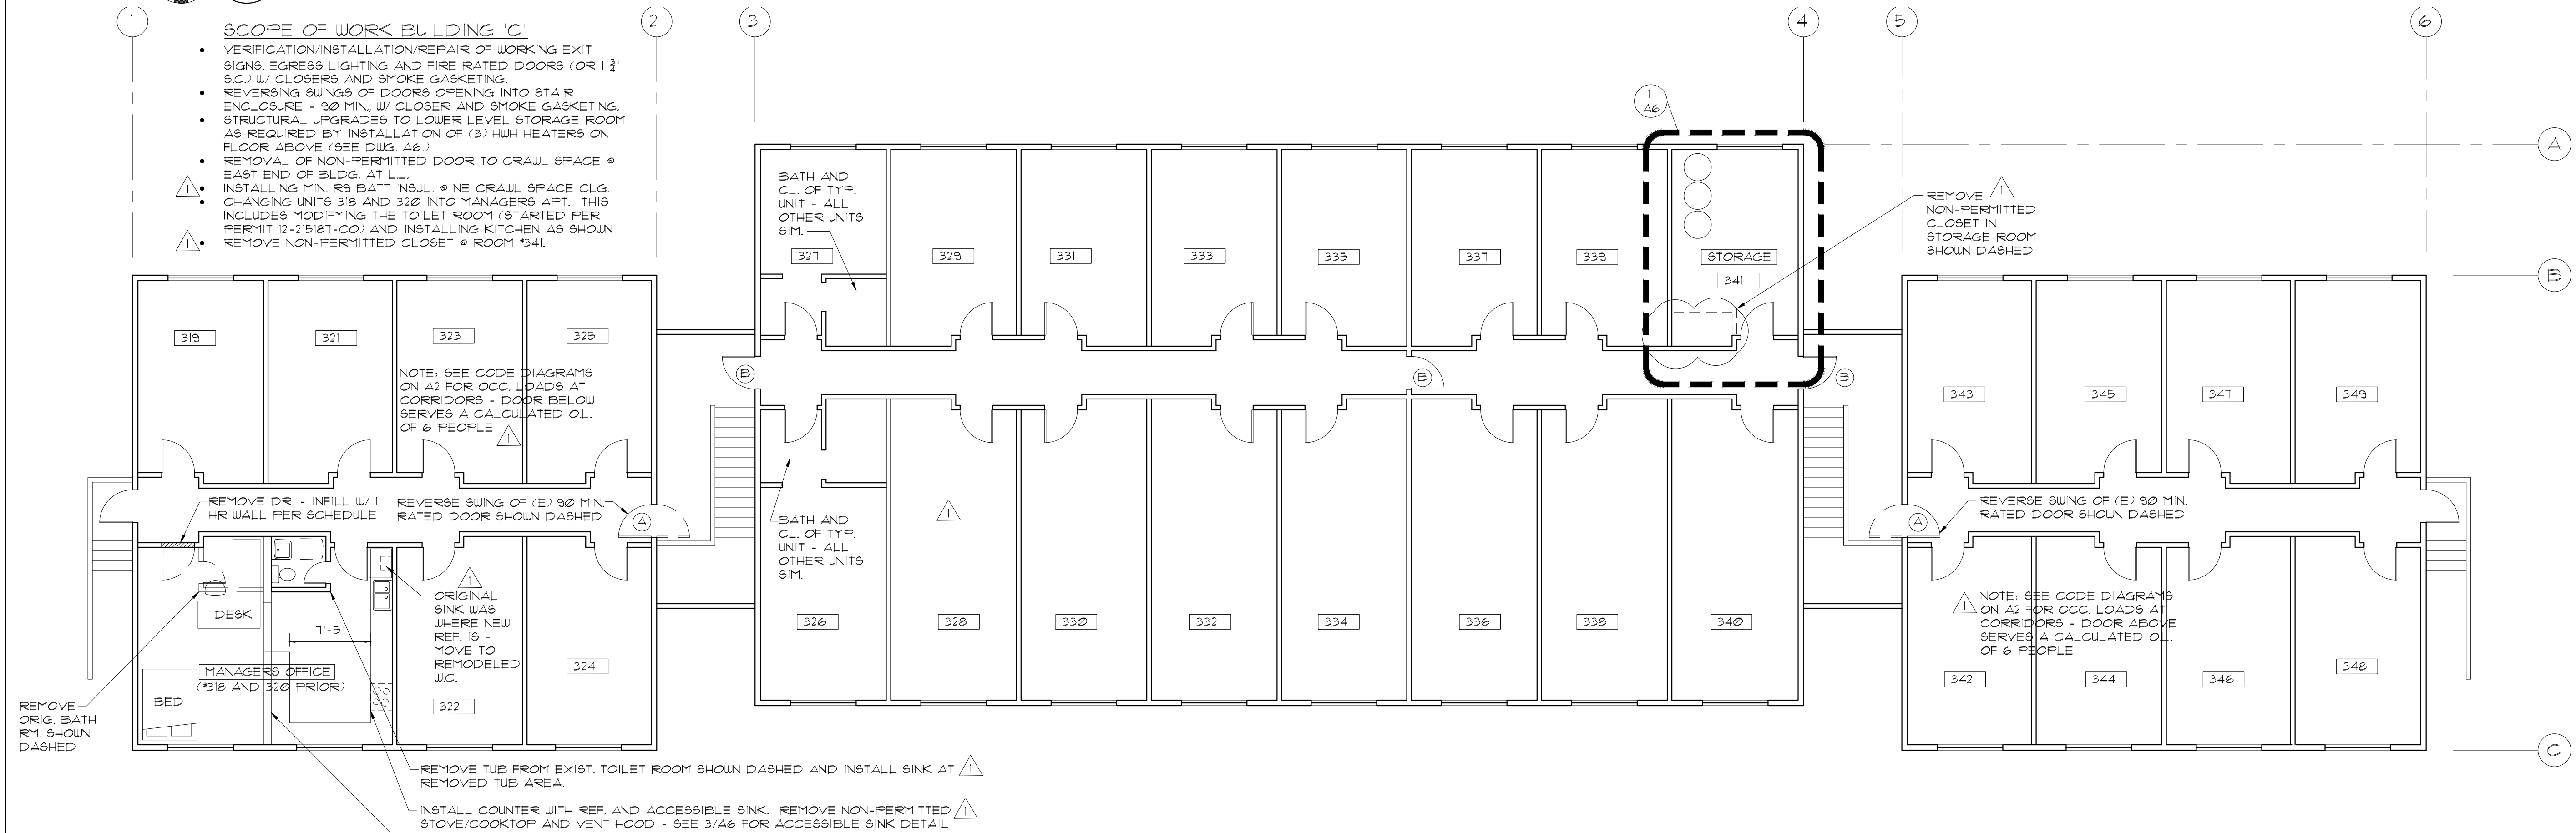

2 UPPER FLOOR PLAN BUILDING 'C'



DMS

2325 NE 19TH AVE
PORTLAND, OR 97212

OFFICE 503 335 9040
FAX 503 335 5850
DAVE@DMSARCHITECTS.COM

HOWARD JOHNSONS

8247 NE SANDY BLVD.
PORTLAND, OREGON 97220

SHEET CONTENT
BUILDING 'C' FLOOR PLANS


JOB No.
000016

DRAWN DMS
CHECKED


DATE 2-20-19

REVISIONS
REV. 1 4-12-19

SHEET
A5 OF 6

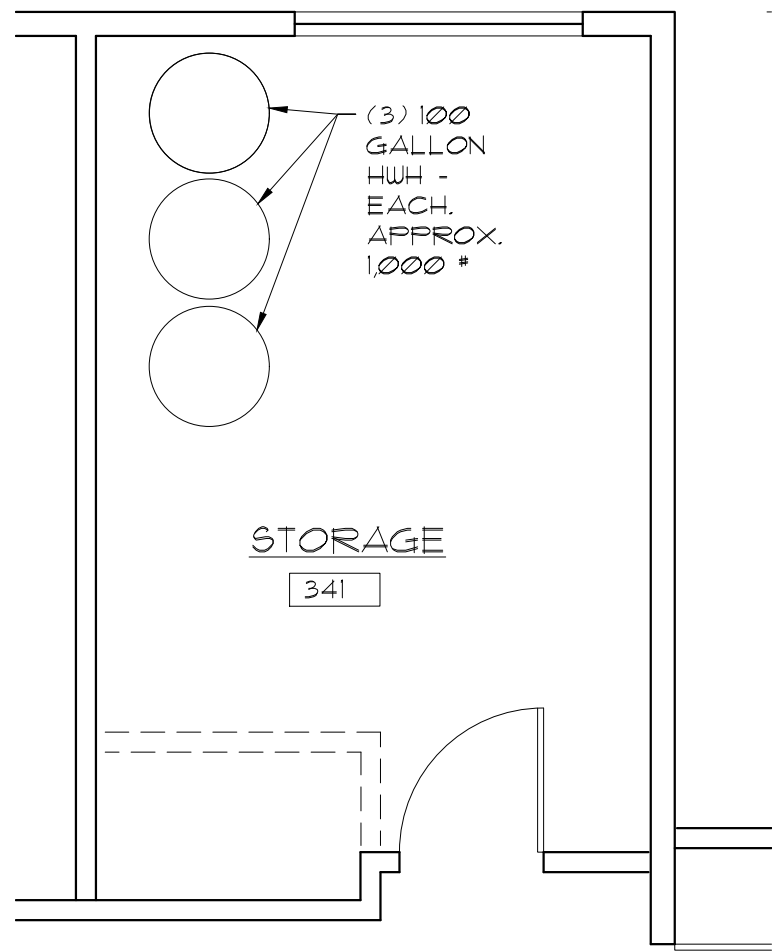

1
A6
ENLARGED PLAN OF STORAGE ROOM - MAIN FLOOR BLDG. 'C'
1/4" = 1'-0"

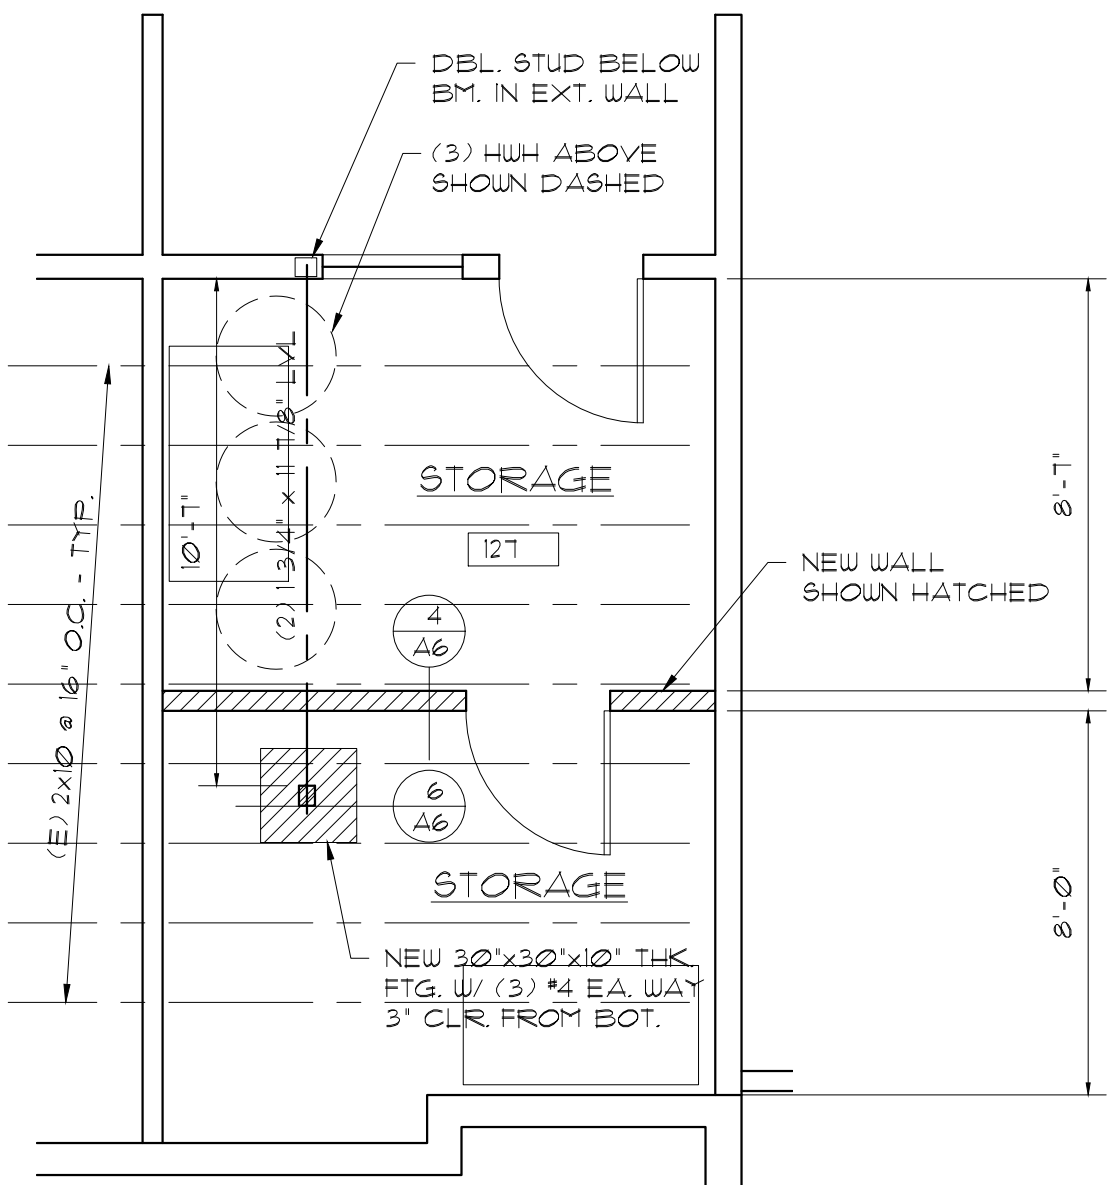


2
A6
ENLARGED PLAN OF STORAGE ROOM - GROUND FLOOR BLDG. 'C'
1/4" = 1'-0"


DOOR SCHEDULE

DOOR #	SIZE	TYPE	FRAME	QNTY.	HARDWARE	NOTES
A	3'-0" x 6'-8"	METAL	METAL	TYP. x4	PASSAGE	DOOR RATING NOT READABLE (90 MIN. PER ORIGINAL PERMIT PLANS) - DOOR SWING REVERSED (AT TIME OF CONST.), ADD CLOSER AND GASKETING, CHANGE DOOR KNOB TO PASSAGE LEVERED LATCHSET, INSTALL MAGNETIC HOLD OPEN TIED TO BLDG. FIRE ALARM.
B	3'-0" x 6'-8"	METAL	METAL	TYP. x8	PASSAGE	DOOR RATING NOT READABLE (90 MIN. PER ORIGINAL PERMIT PLANS) - ADD CLOSER AND GASKETING, CHANGE DOOR KNOB TO PASSAGE LEVERED LATCHSET, INSTALL MAGNETIC HOLD OPEN TIED TO BLDG. FIRE ALARM.
C	NOT USED	--	--	--	--	--
D	NOT USED	--	--	--	--	--
E	3'-0" x 6'-8"	METAL	METAL	TYP. x1	OFFICE	NEW 20 MIN. DOOR AND FRAME W/ CLOSER AND SMOKE GASKETING
F	3'-0" x 6'-8"	WOOD	WOOD	TYP. x1	PASSAGE	
G	NOT USED	--	--	--	--	--
H	NOT USED	--	--	--	--	--
J	NOT USED	--	--	--	--	--
K	3'-0" x 6'-8"	WOOD	WOOD	TYP. x1	PASSAGE	
L	3'-0" x 6'-8"	METAL	METAL	TYP. x1	PASSAGE	DOOR RATING NOT READABLE (2 HR MIN. PER ORIGINAL PERMIT PLANS) - ADD CLOSER AND GASKETING, CHANGE DOOR KNOB TO PASSAGE LEVERED LATCHSET, INSTALL MAGNETIC HOLD OPEN TIED TO BLDG. FIRE ALARM.


NOTE: ALL HARDWARE SHALL BE LEVERED
NOTE: NO THUMB TURN DEAD BOLTS ALLOWED.

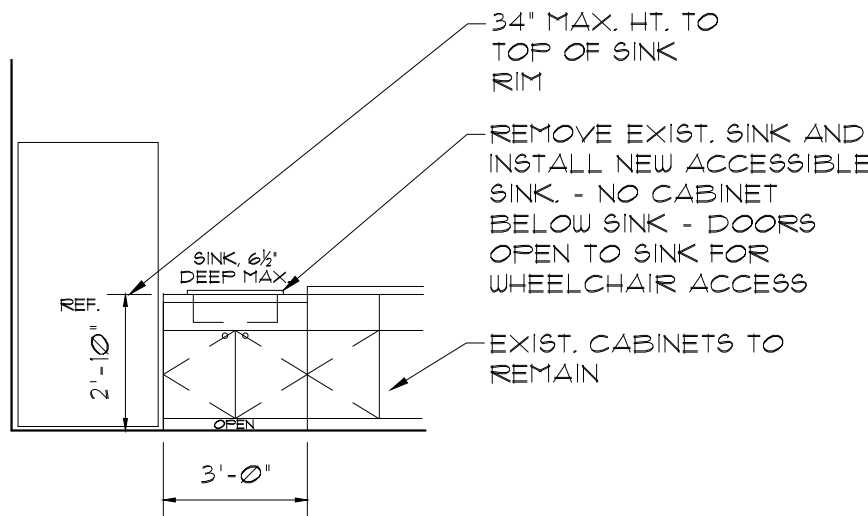


3
A6
ACCESSIBLE SINK AT KITCHEN
(MANAGERS OFFICE #318 AND 320)
1/4" = 1'-0"

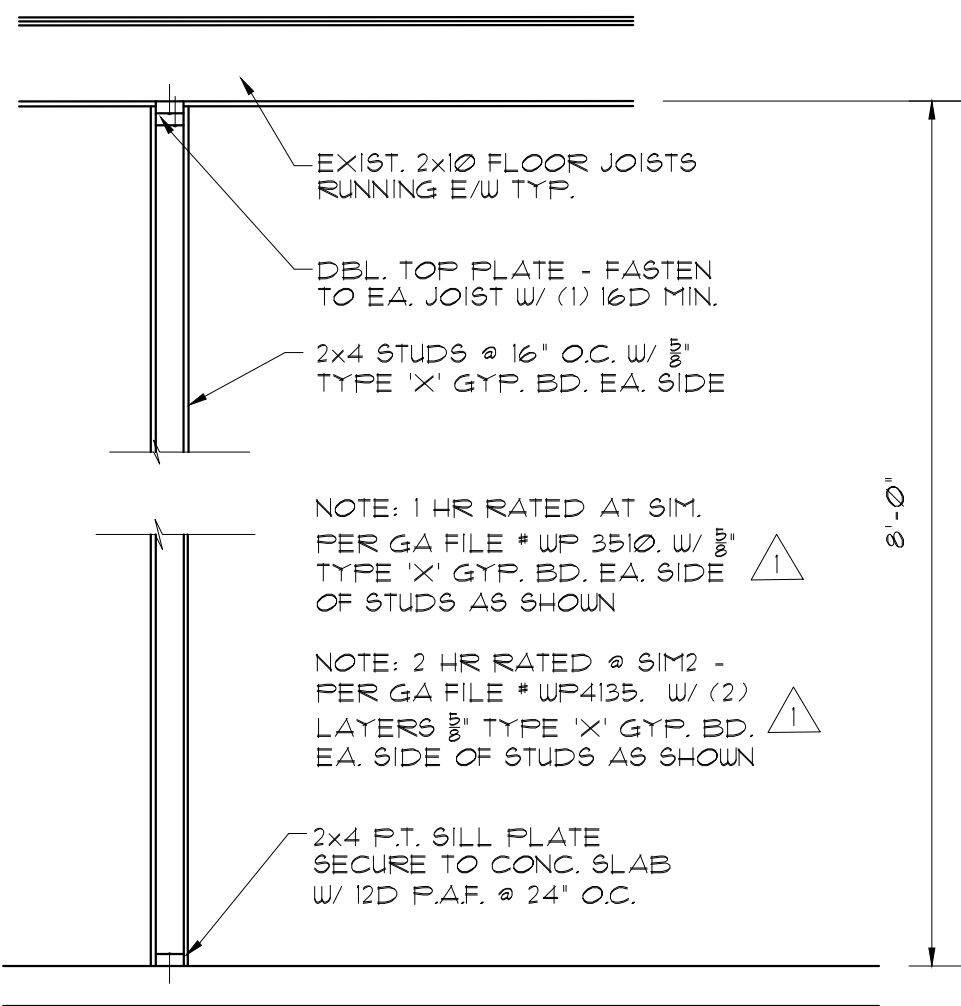


4
A6
TYPICAL NEW WALL DETAIL
1/2" = 1'-0"

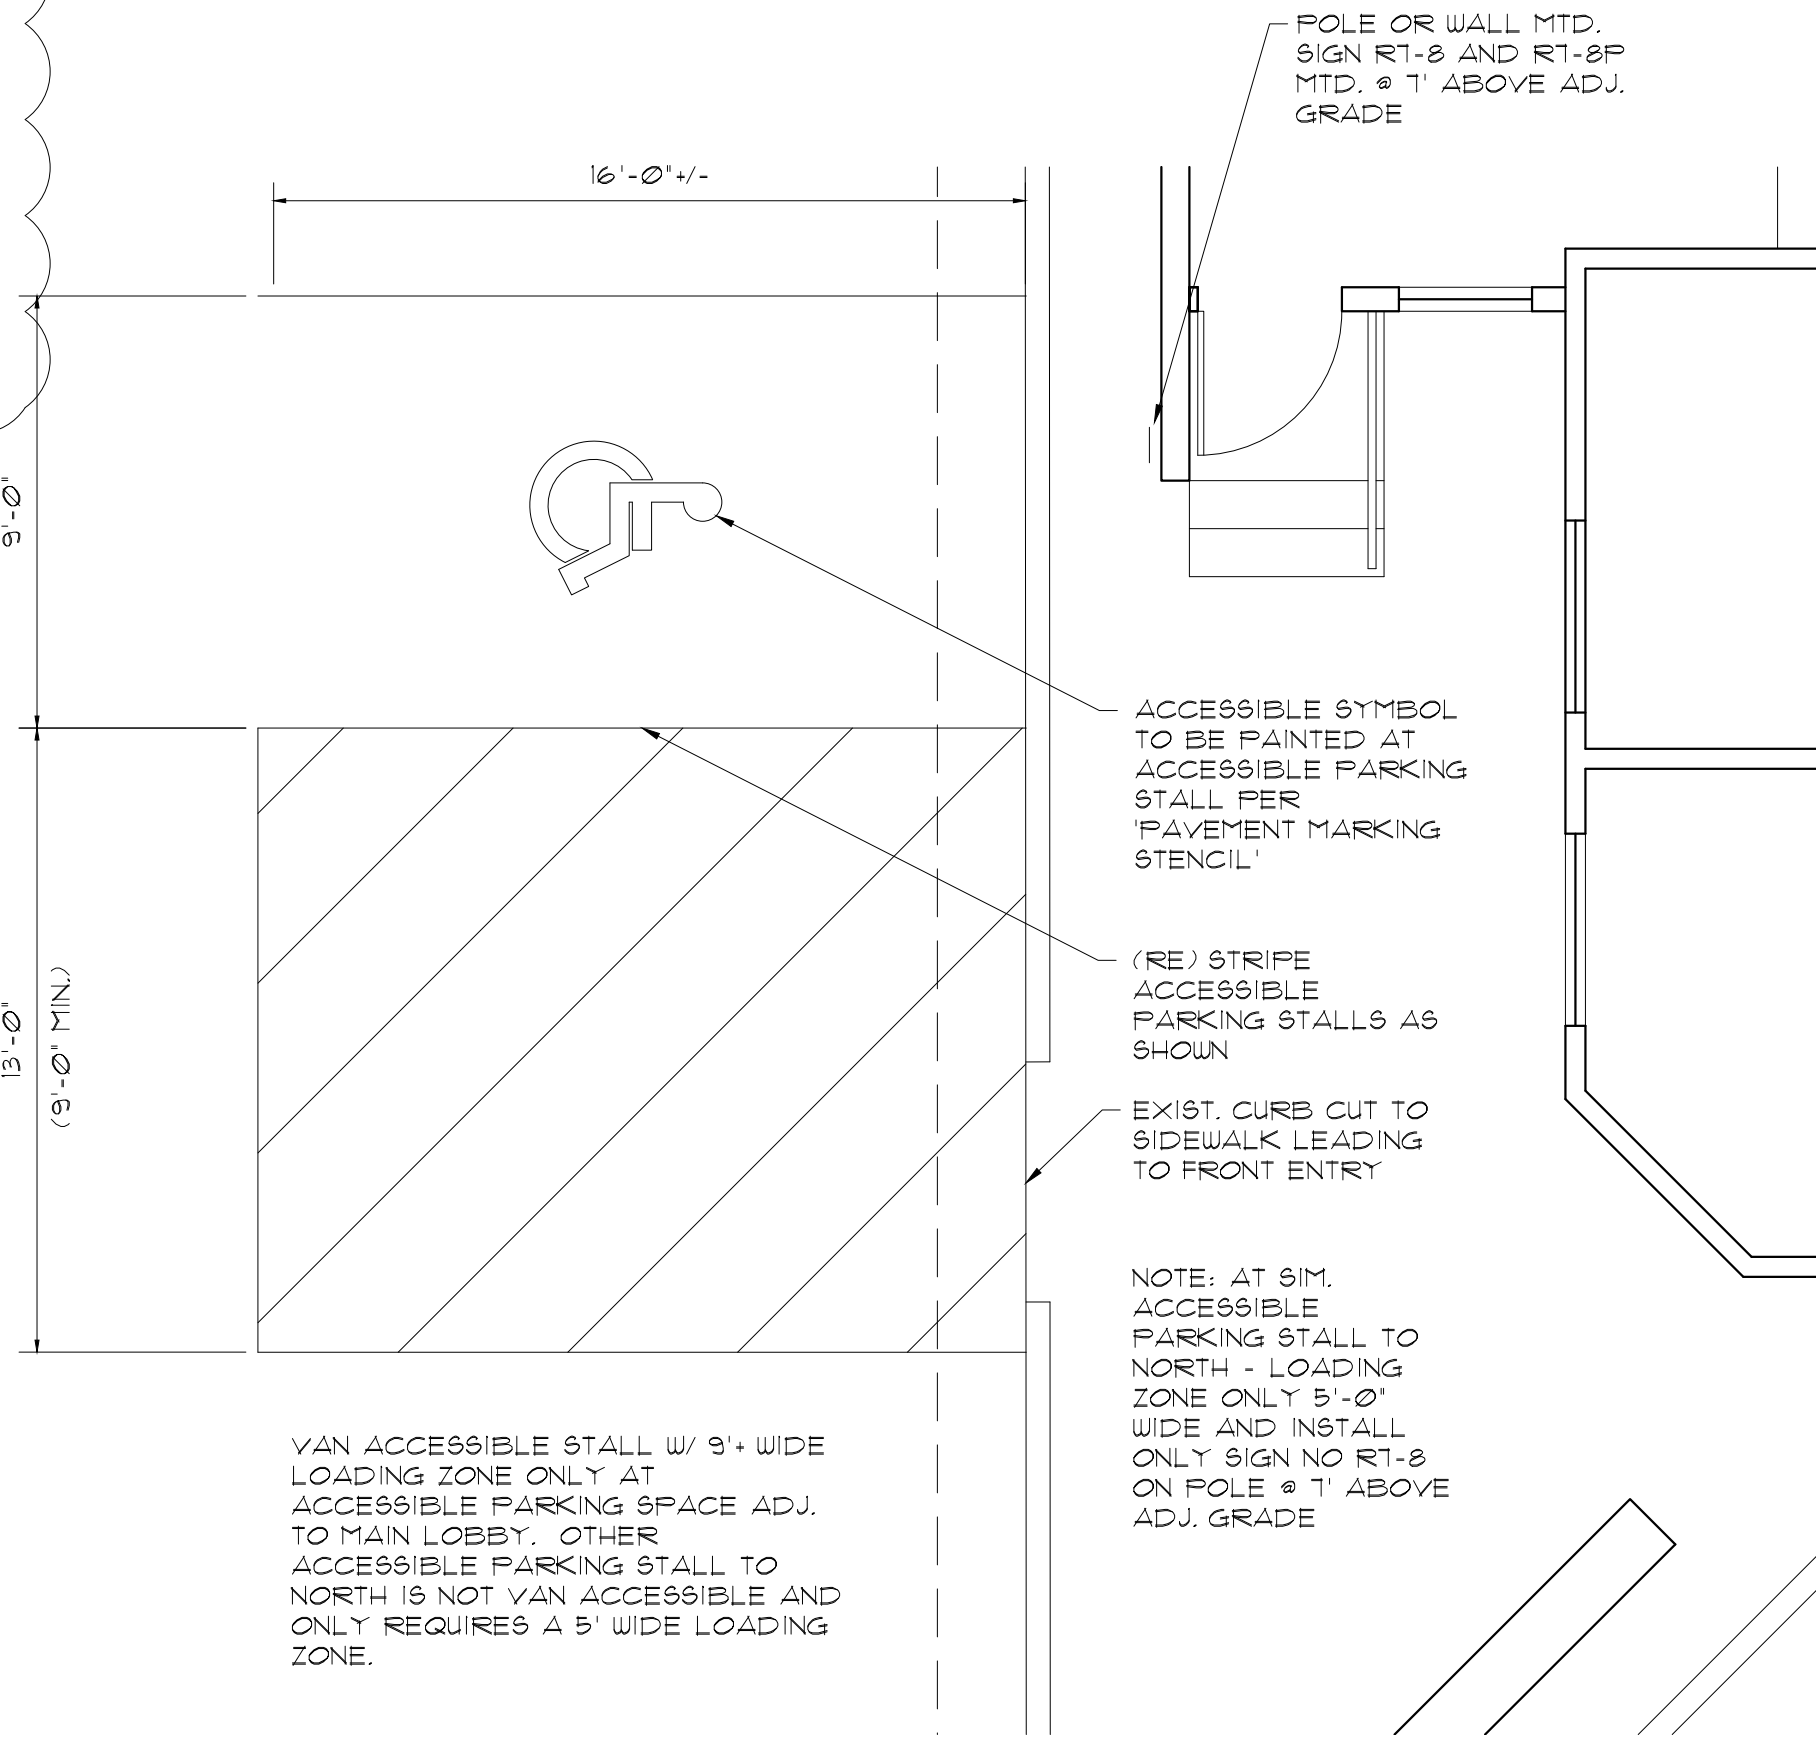

5
A6
ACCESSIBLE PARKING STALL DETAIL
1/4" = 1'-0"

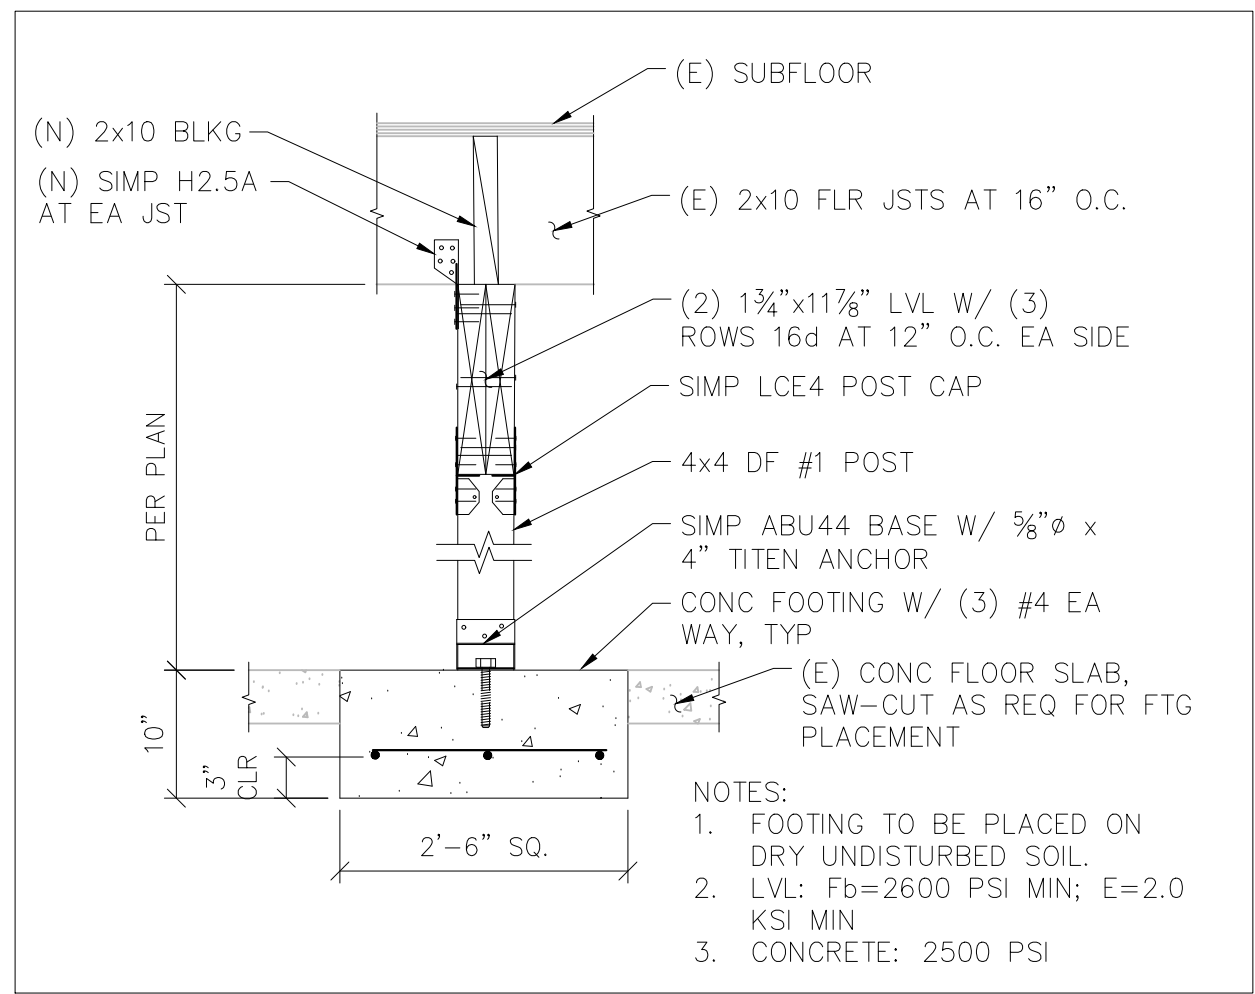

6
A6
NEW BEAM DETAIL
NOTE: GYP. BD. NOT SHOWN FOR STRUCTURAL CLARITY
1" = 1'-0"

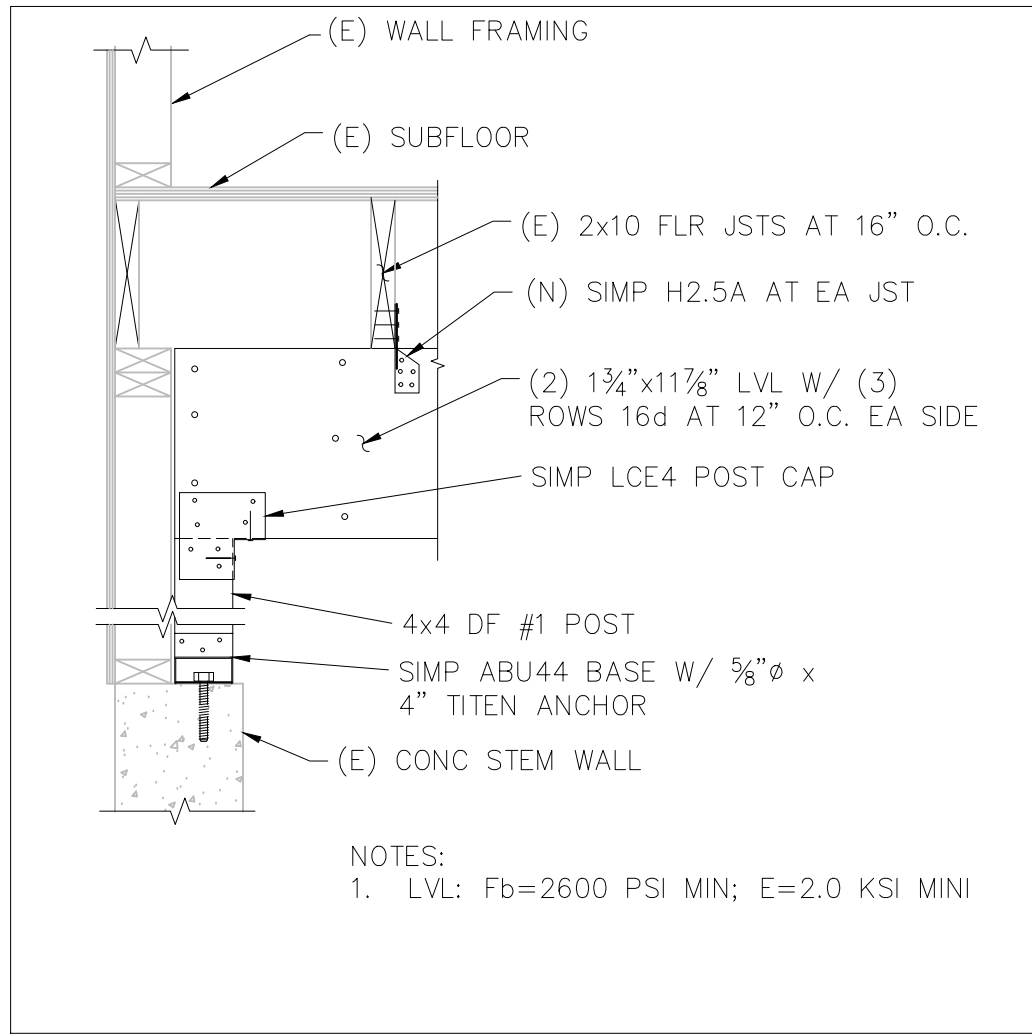

7
A6
NEW BEAM DETAIL
NOTE: GYP. BD. NOT SHOWN FOR STRUCTURAL CLARITY
1" = 1'-0"

PAVEMENT MARKING STENCIL	SIGN DESIGN SIGN NO. R7-8	SIGN DESIGN SIGN NO. R7-8P
Pavement Marking Background: Optional: Blue, Retro-reflective Pavement Marking Stencil: White, Retro-reflective	Sign Background: White, Retro-reflective sheeting Sign Legend: Green, Retro-reflective sheeting Symbol: White on Blue Background, Retro-reflective Sign: Standard Federal R7-8 without arrow from the Standards Highway and Markings Handbook	Sign Background: White, Retroreflective sheeting Sign Legend: Green, Retroreflective sheeting Refer to the Standard Highway Signs book for details.
The pavement marking stencil shall be used to designate an accessible parking area reserved for vehicles with DMV permits.	The Accessible Person parking sign is used to designate a parking area reserved for vehicles with DMV permit as stated.	The VAN ACCESSIBLE sign shall only be used with sign R7-8 to designate the parking spaces that have an access aisle 8 ft or wider.

ACCESSIBLE PARKING SIGN DETAILS



DMS
ARCHITECTS

2325 NE 19TH AVE
PORTLAND, OR 97212

OFFICE 503 335 9040
FAX 503 335 5850
DAVE@DMSARCHITECTS.COM

HOWARD JOHNSONS

8247 NE SANDY BLVD.
PORTLAND, OREGON 97220

SHEET CONTENT
DETAILS
SCHEDULE

JOB No.
000016


DRAWN
DMS

CHECKED
DATE 2-20-19

REVISIONS
REV. 1 4-12-19

SHEET

A6 OF 6

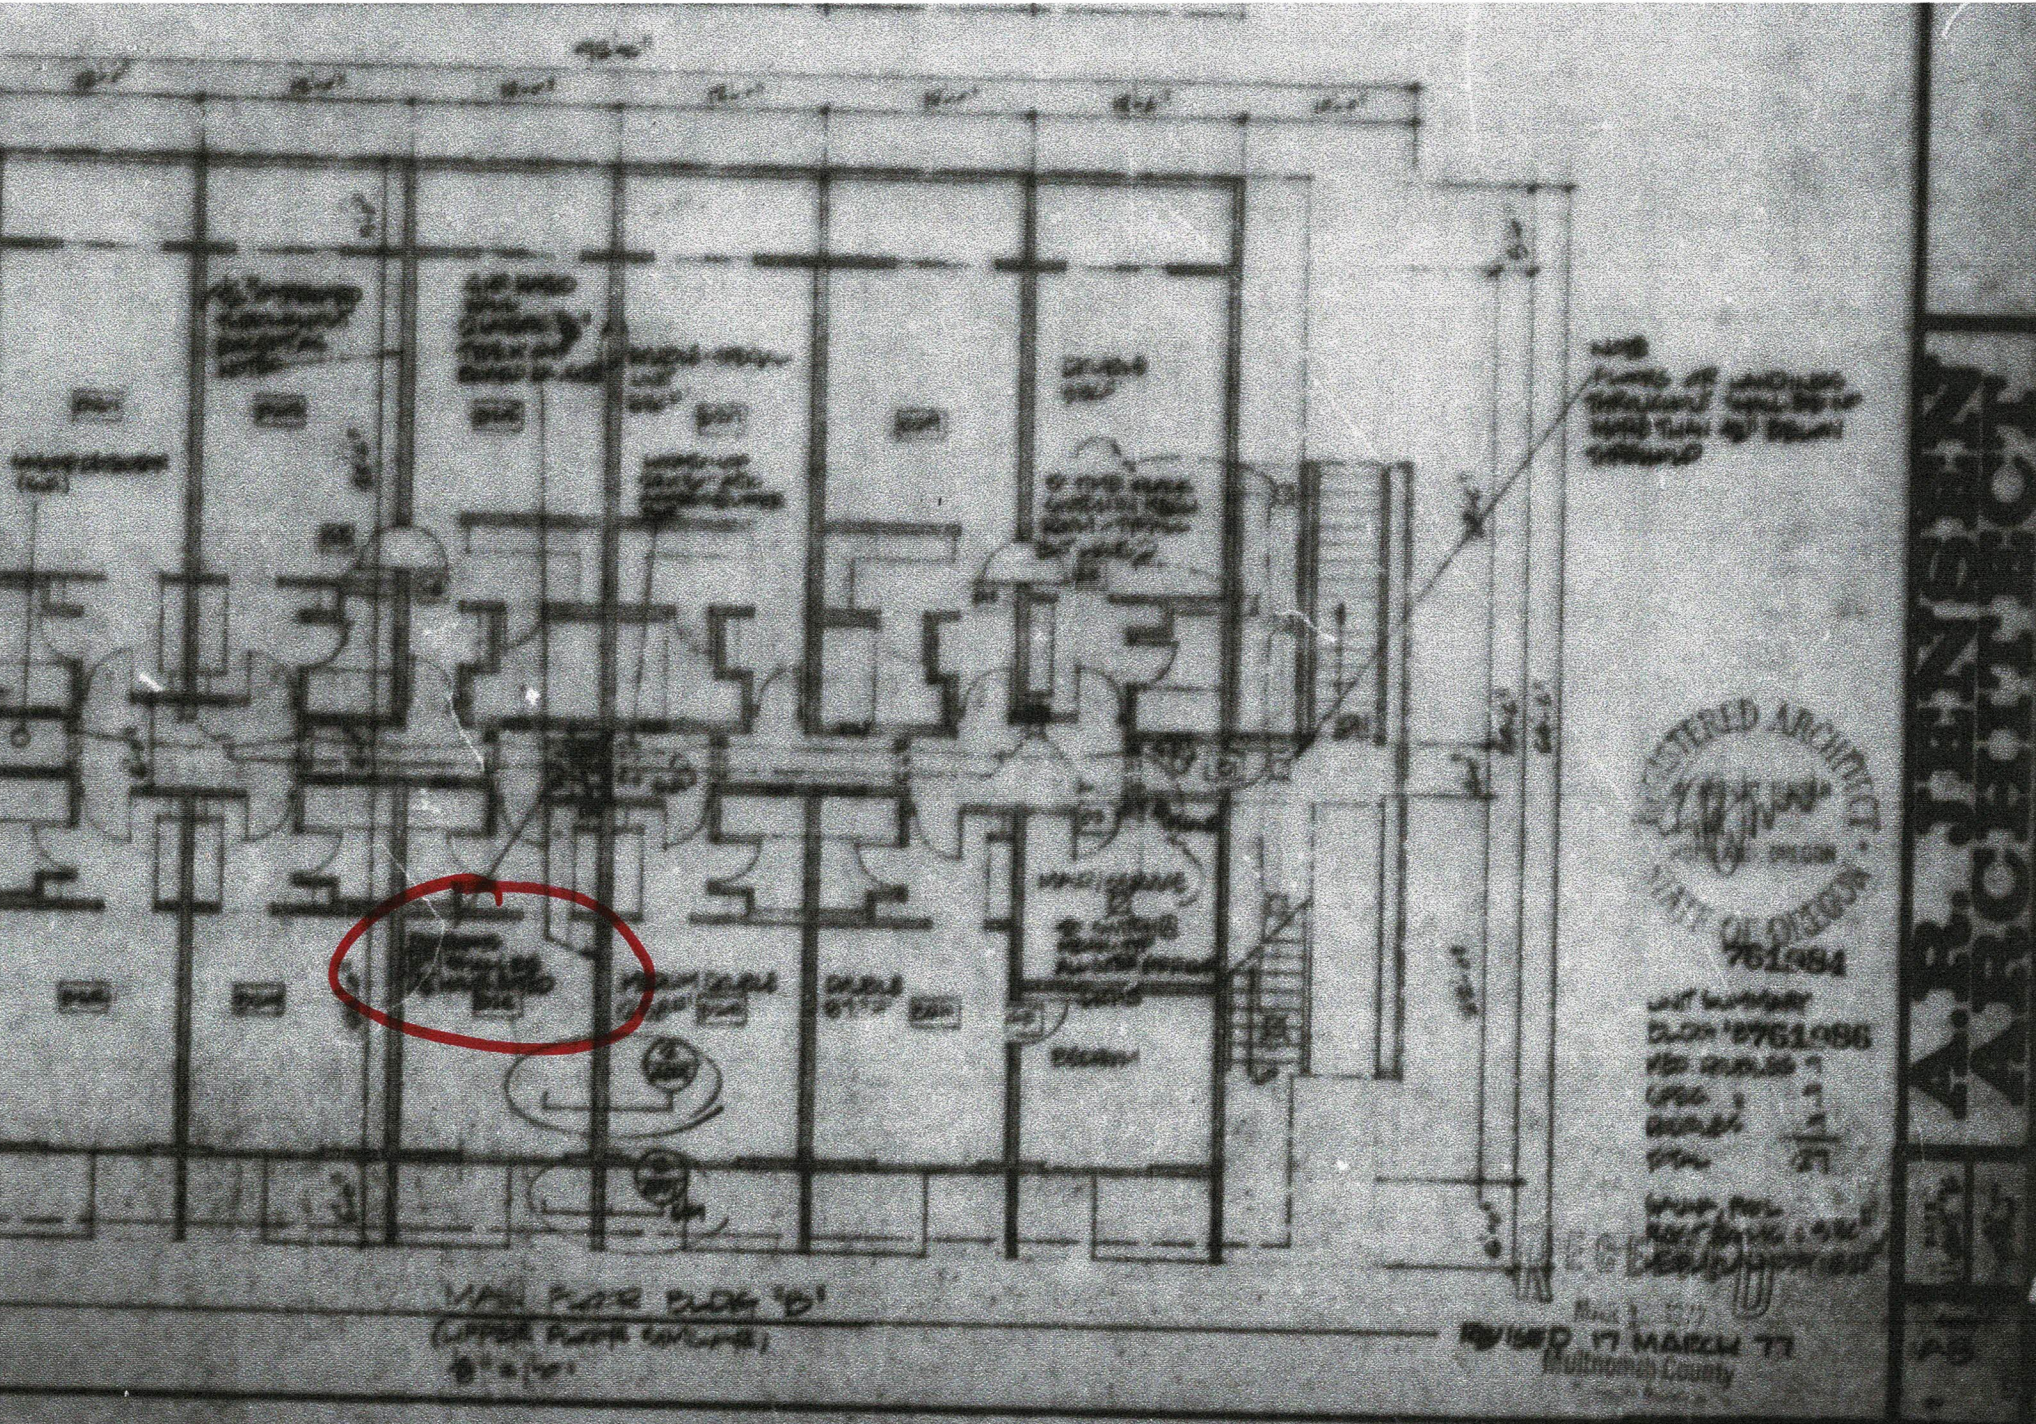

THIS FLOOR IS AN ADDED
TWO-STORY BUILDING
ADDED TO THE
ORIGINAL




JOHN W. BARNETT
BLOCK 18761086
1000 N. BROAD ST.
PORTLAND, OREGON
97201

STAMP NO. 1
NOT VALID FOR
RENEWAL

PLAN FOR BLOCK 'D'
(UPPER FLOOR CONTINUED)
1/2" = 1'-0"

REVISED 17 MARCH 77
Multnomah County



A3

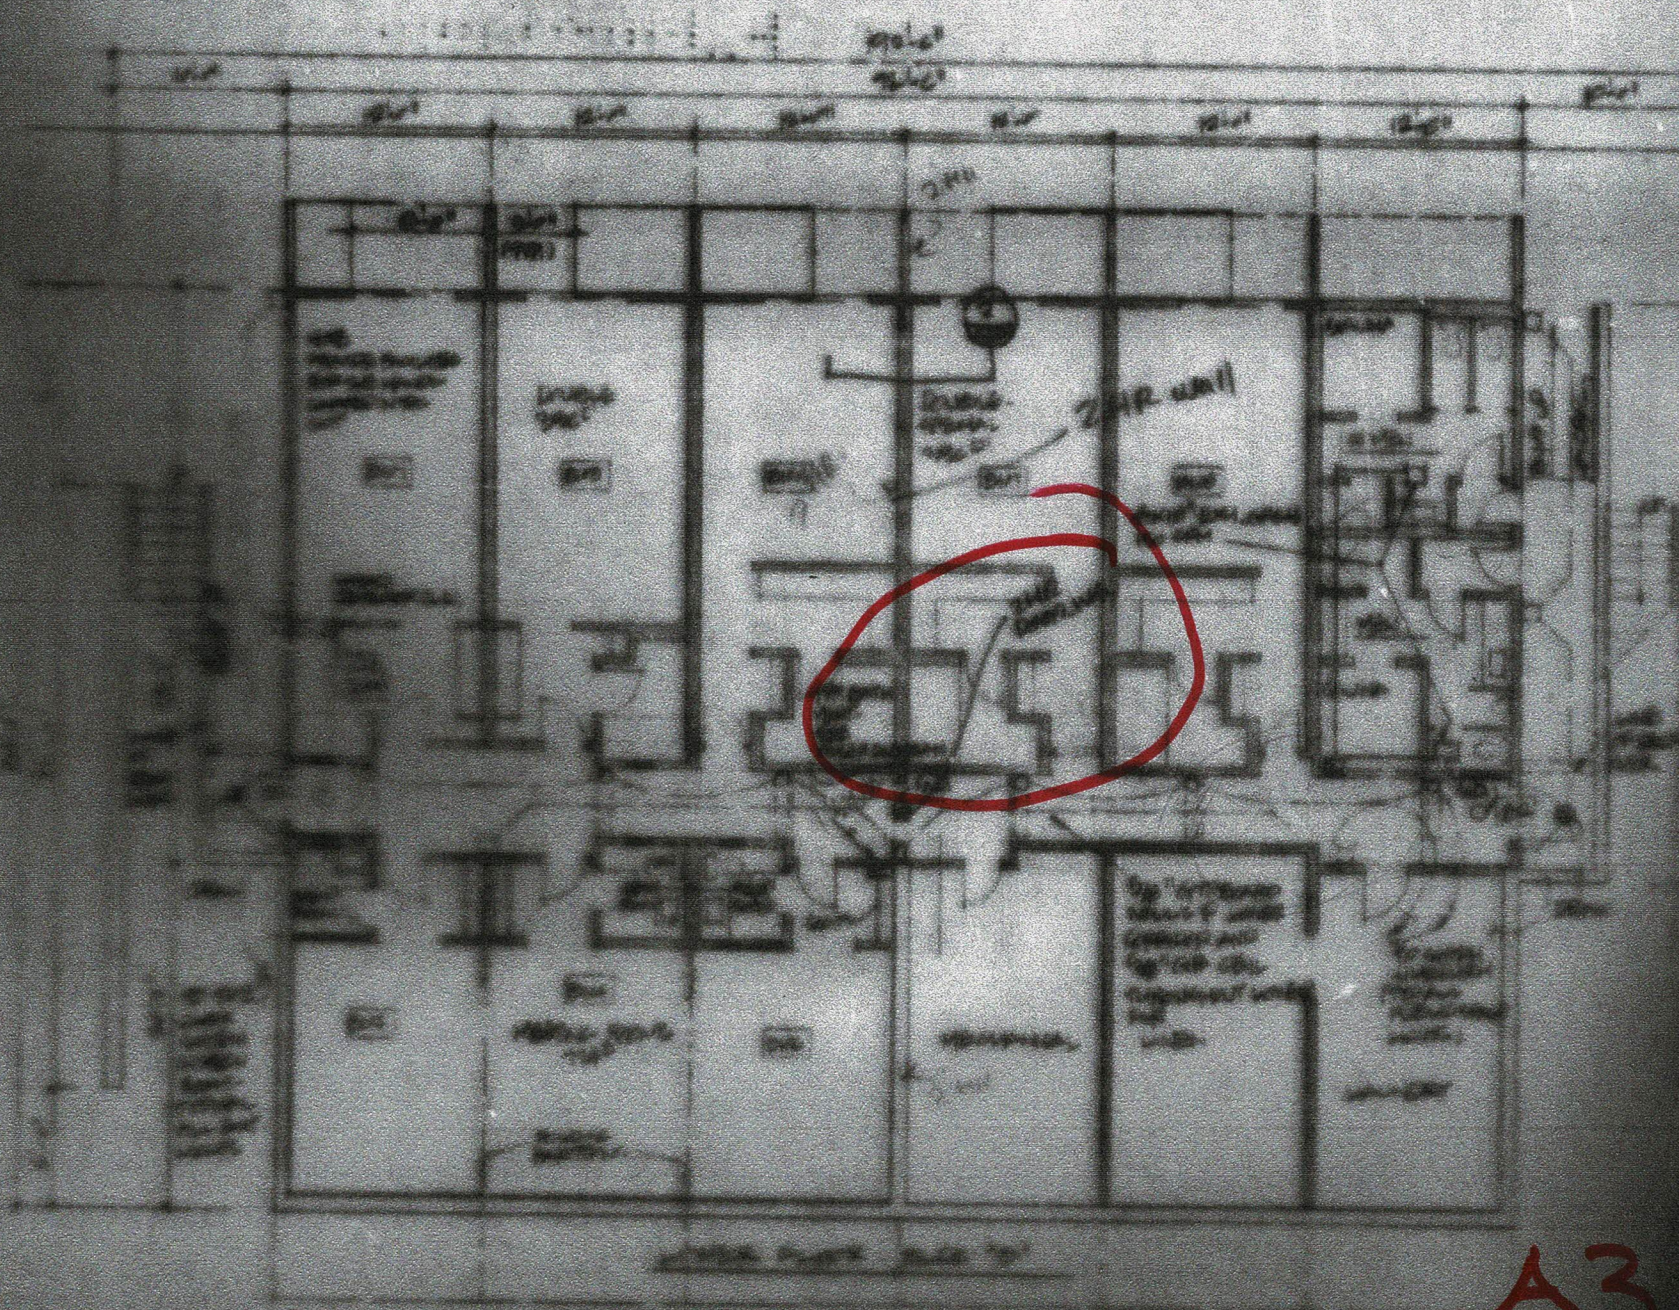



A3

DPR SCHEDULE

DPR				OFFICE			REMARKS
NO.	DATE	TIME	PERSON	NO.	DATE	TIME	
1	1/1	10:00	-	1	1/1	10:00	STARTING AT UNDER THE GROUND
2	1/1	10:00	-	2	1/1	10:00	
3	1/1	10:00	-	3	1/1	10:00	
4	1/1	10:00	-	4	1/1	10:00	
100	1/1	10:00	-	100	1/1	10:00	

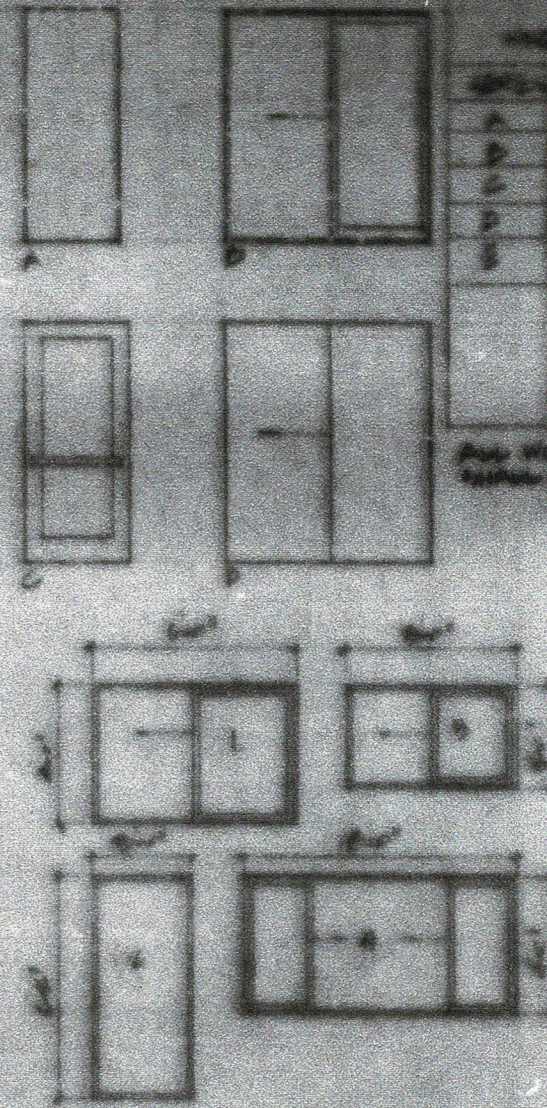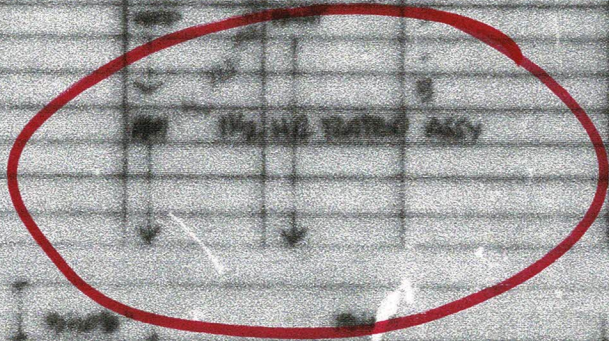


A5

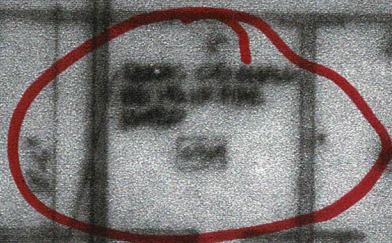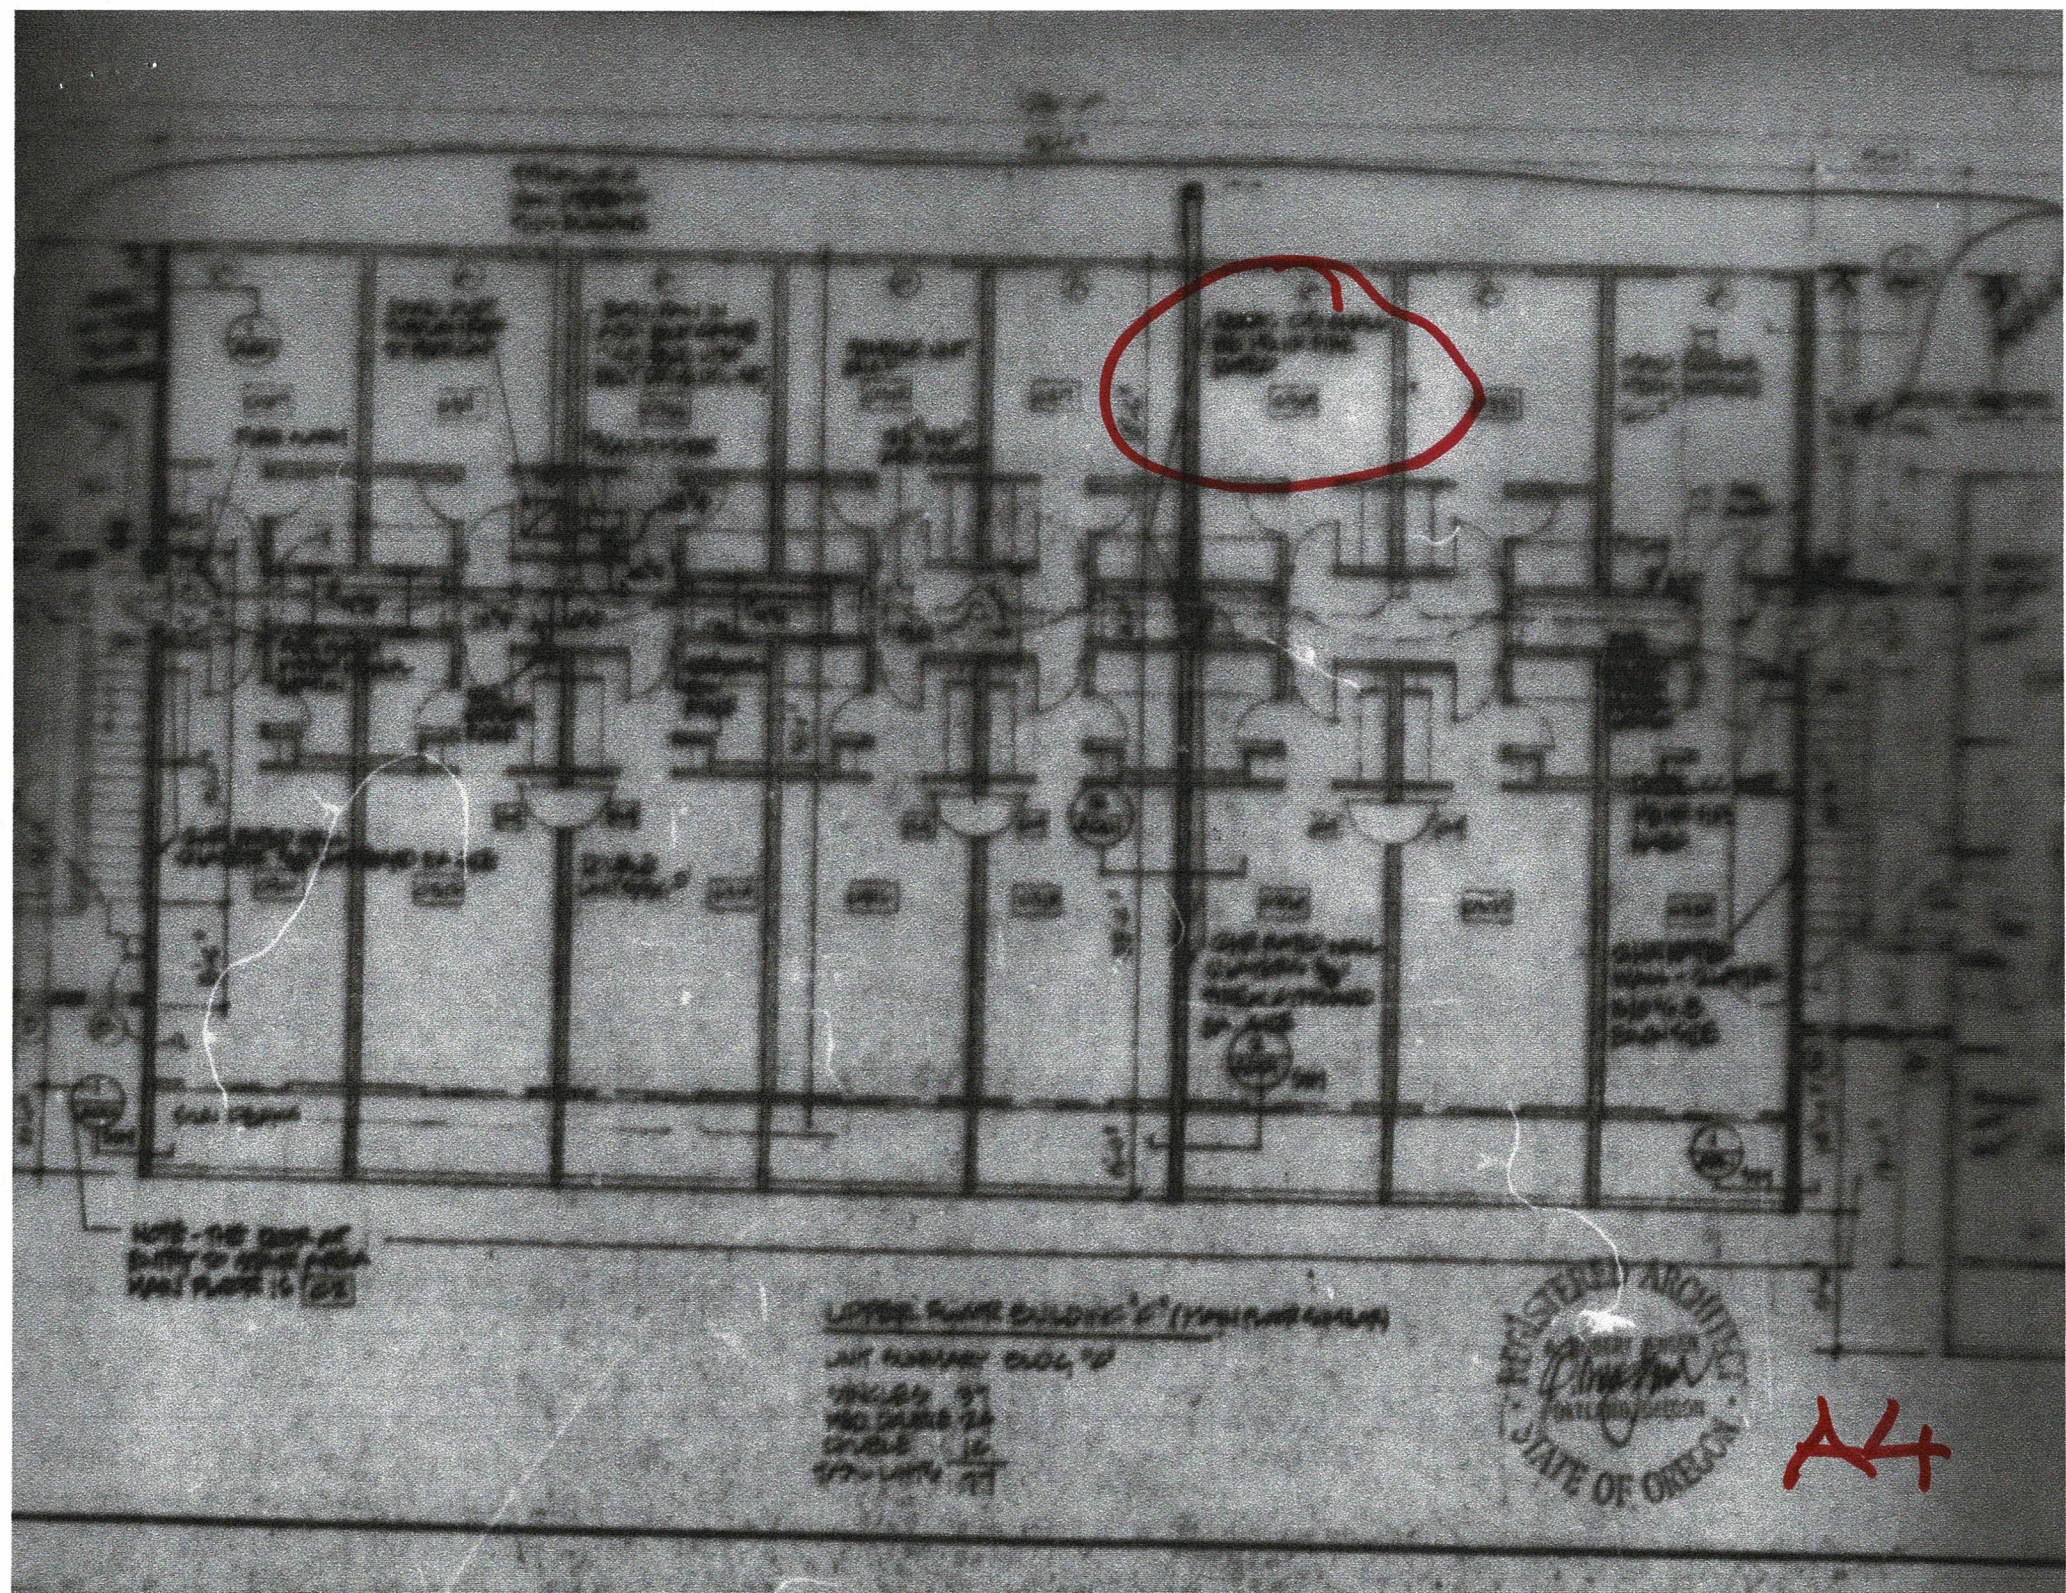

NOTE - THE PLAN OF
BUILDING IS SUBJECT TO CHANGE.
THIS PLAN IS [unclear]

LOWER FLOOR BUILDING C (1901-1902)
JANUARY 1904
THURSDAY 31
FRI. 1
SAT. 2
SUNDAY 3
TOTAL 7

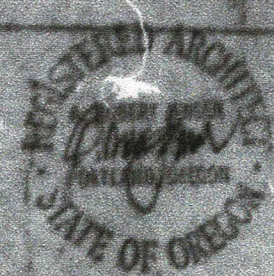

AT