Development Services

From Concept to Construction







APPEAL SUMMARY

Status:	Decision Re	endered

Appeal ID: 21963	Project Address: 515 NE Holladay St
Hearing Date: 10/9/19	Appellant Name: Michael Stanner
Case No.: B-001	Appellant Phone: 503.265.1555
Appeal Type: Building	Plans Examiner/Inspector: Natalie Didion
Project Type: commercial	Stories: 12 Occupancy: R-2, M Construction Type: I-A
Building/Business Name: Grand Avenue Apartments	Fire Sprinklers: Yes - entire building
Appeal Involves: Erection of a new structure	LUR or Permit Application No.: 17-204627-CO
Plan Submitted Option: pdf [File 1] [File 2]	Proposed use: Multifamily Apartment

APPEAL INFORMATION SHEET

Appeal item 1

Code Section

Section 909.21.1 of the 2014 Edition of the OSSC

Requires

909.21.1 Elevator hoistways shall be pressurized to maintain a minimum positive pressure of 0.10 inches of water (25 Pa) and a maximum positive pressure of 0.25 inches of water (67 Pa) with respect to adjacent occupied space on all floors. This pressure shall be measured at the midpoint of each hoistway door, with all elevator cars at the floor of recall and all hoistway doors on the floor of recall open and all other hoistway doors closed. The opening and closing of hoistway doors at each level must be demonstrated during this test. The supply air intake shall be from an outside, uncontaminated source located a minimum distance of 20 feet (6096mm) from any air exhaust system or outlet.

Proposed Design

In lieu of providing enclosed elevator lobbies, hoistway pressurization is permitted. Elevator hoistways are pressurized to keep smoke from entering shafts and spreading throughout a building. Requiring a minimum positive pressure of 0.10 inches of water ensures that stack effect is overcome and the elevator shafts can be protected from smoke. The upper limits of positive pressure are required to allow the doors to close.

The request is use the provisions of Section 909.21.1 of the 2019 Edition of the OSSC in lieu of section 909.21.1 of the 2014 OSSC.

Reason for alternative Section 909.21.1 of the 2014 Edition of the OSSC requires that the pressure differential be measured at all elevator hoistway doors simultaneously. The 2019 Edition of the OSSC is anticipated to be adopted by the end of 2019 and adds four exceptions to Section 909.21.1. The section and new exceptions read as follows:

> Elevator hoistways shall be pressurized to maintain a minimum positive pressure of 0.10 inches of water (25 Pa) and a maximum positive pressure of 0.25 inches of water (67 Pa) with respect to

adjacent occupied space on all floors. This pressure shall be measured at the midpoint of each hoistway door, with all elevator cars at the floor of recall and all hoistway doors on the floor of recall open and all other hoistway doors closed. The pressure differentials shall be measured between the hoistway and the adjacent elevator landing. The opening and closing of hoistway doors at each level must be demonstrated during this test. The supply air intake shall be from an outside, uncontaminated source located a minimum distance of 20 feet (6096mm) from any air exhaust system or outlet.

Exceptions:

On floors containing only Group R occupancies, the pressure differential is permitted to be measured between the hoistway and dwelling unit or sleeping unit.

Where an elevator opens into a lobby enclosed in accordance with Section 3007.6 or 3008.6, the pressure differential is permitted to be measured between the hoistway and the space immediately outside the door(s) from the floor to the enclosed lobby.

The pressure differential is permitted to be measured relative to the outdoor atmosphere on floors other than the following:

- 3.1. The fire floor.
- 3.2. The two floors immediately below the fire floor.
- 3.3. The floor immediately above the fire floor.

The minimum positive pressure of 0.10 inch of water (25 Pa) and a maximum positive pressure of 0.25 inch of water (67 Pa) with respect to occupied floors are not required at the floor of recall with the doors open.

The building's smoke control model will utilize Exceptions 3 and 4 to achieve code compliance.

This request provides a level of protection and safety that is at least equivalent to that prescribed by the technical code requirements for the Grand Avenue Apartments.

APPEAL DECISION

Use of hoistway pressurization in lieu of enclosed elevator lobbies per 2019 OSSC: Granted as proposed.

The Administrative Appeal Board finds that the information submitted by the appellant demonstrates that the approved modifications or alternate methods are consistent with the intent of the code; do not lessen health, safety, accessibility, life, fire safety or structural requirements; and that special conditions unique to this project make strict application of those code sections impractical.

Pursuant to City Code Chapter 24.10, you may appeal this decision to the Building Code Board of Appeal within 90 calendar days of the date this decision is published. For information on the appeals process, go to www.portlandoregon.gov/bds/appealsinfo, call (503) 823-7300 or come in to the Development Services Center.



Request for Alternate Methods and Materials (RFAM) GRAND AVENUE APARTMENTS

Section 909.21.1 Pressurization Requirements

Introduction: The Grand Avenue Apartments is a mixed-use high-rise building with housing over first

floor mercantile space. The building is provided with sprinkler protection. The building was designed under the 2014 Edition of the Oregon Structural Specialty Code (OSSC). The building contains two elevator shafts and two stairways that are required to be

pressurized.

Code Reference: Section 909.21.1 of the 2014 Edition of the OSSC

Code Intent:

Code Requirement: Elevator hoistways shall be pressurized to maintain a minimum positive pressure of 0.10

inches of water (25 Pa) and a maximum positive pressure of 0.25 inches of water (67 Pa) with respect to adjacent occupied space on all floors. This pressure shall be measured at the midpoint of each hoistway door, with all elevator cars at the floor of recall and all hoistway doors on the floor of recall open and all other hoistway doors closed. The opening and closing of hoist-way doors at each level must be demonstrated during this test. The supply air intake shall be from an outside, uncontaminated source

located a minimum distance of 20 feet (6096 mm) from any air exhaust system or outlet.

In lieu of providing enclosed elevator lobbies, hoistway pressurization is permitted. Elevator hoistways are pressurized to keep smoke from entering shafts and spreading throughout a building. Requiring a minimum positive pressure of 0.10 inches of water ensures that stack effect is overcome and the elevator shafts can be protected from

smoke. The upper limits of positive pressure are required to allow the doors to close

Request: To use the provisions of Section 909.21.1 of the 2019 Edition of the OSSC in lieu of

section 909.21.1 of the 2014 OSSC

Justification: Section 909.21.1 of the 2014 Edition of the OSSC requires that the pressure differential

be measured at all elevator hoistway doors simultaneously. The 2019 Edition of the OSSC is anticipated to be adopted by the end of 2019 and adds four exceptions to

Section 909.21.1. The section and new exceptions read as follows:

Elevator hoistways shall be pressurized to maintain a minimum positive pressure of 0.10 inch of water (25 Pa) and a maximum positive pressure of 0.25 inch of water (67 Pa) with respect to adjacent occupied space on all floors. This pressure shall be measured at the midpoint of each hoistway door, with all elevator cars at the floor of recall and all hoistway doors on the floor of recall open and all other hoistway doors closed. The pressure differentials shall be measured between the hoistway and the adjacent elevator landing. The opening and closing of hoistway doors at each level must be demonstrated during this test. The supply air intake shall be from an outside, uncontaminated source located a minimum distance of 20 feet (6096 mm) from any air exhaust system or outlet.

Exceptions:

- 1. On floors containing only Group R occupancies, the pressure differential is permitted to be measured between the hoistway and a dwelling unit or sleeping unit.
- 2. Where an elevator opens into a lobby enclosed in accordance with Section 3007.6 or 3008.6, the pressure differential is permitted to be measured between the hoistway and the space immediately outside the door(s) from the floor to the enclosed lobby.
- 3. The pressure differential is permitted to be measured relative to the outdoor atmosphere on floors other than the following:
 - 3.1. The fire floor.
 - 3.2. The two floors immediately below the fire floor.
 - 3.3. The floor immediately above the fire floor.
- 4. The minimum positive pressure of 0.10 inch of water (25 Pa) and a maximum positive pressure of 0.25 inch of water (67 Pa) with respect to occupied floors are not required at the floor of recall with the doors open.

The building's smoke control model will utilize Exceptions 3 and 4 to achieve code compliance.

S	u.	m	m	a	n	1

This request provides a level of protection and safety that is at least equivalent to that prescribed by the technical code requirements for the Grand Avenue Apartments. We respectfully request your approval.

Prepared by:

JENSEN HUGHES, INC.

David A. Valdez

Associate

Reviewed by:

August 13, 2019

Date

TO MAP. 11. 2014 3

EXP. 12/31/2019 AS V. B

August 13, 2019

Thomas V. Barnum, P.E.

Senior Fire Protection Engineer

Date

Reviewed by:

August 13, 2019

Authority Having Jurisdiction

Date

DAV/TVB:dv/ba

1MWA00038/RFAM & Amendments/2019-08-13-RFAM OSSC Section 909

Γ				T
MECHANK	CAL LEGEND	AND SYMBOLS	HVAC GENERAL NOTES:	GENERAL SPECIFICATIONS:
MECHANK SA RA OSA CD CD CR CE SWS SWR CD SINGLE LINE S		SUPPLY AIR DUCT RETURN AIR DUCT EXHAUST AIR DUCT OUTSIDE AIR DUCT CEILING DIFFUSER, 2 WAY CEILING DIFFUSER, 4 WAY CELING RETURN AIR GRILLE CELING EXHAUST AIR GRILLE SIDE WALL SUPPLY REGISTER SIDE WALL RETURN GRILLE CONDENSATE DRAIN ROOM THERMOSTAT EQUPIMENT IDENTIFICATION DESCRIPTION VOLUME DAMPER FIRE DAMPER FIRE/SMOKE DAMPER SMOKE DAMPER MOTORIZED DAMPER MITERED ELBOW WITH TURNING VANES RADIUSED ELBOW RECTANGULAR MAIN W/ ROUND BRANCH RECTANGULAR MAIN WITH RECTANGULAR BRANCH CONCENTRIC SQUARE TO ROUND ECCENTRIC TRANSITION, RECTANGULAR OR ROUND NON—SYMMETRICAL WYE SYMMETRICAL WYE RECTANGULAR DUCT RISER ROUND DUCT RISER RECTANGULAR DUCT DROP	1. DUCTS SHALL BE SUPPORTED WITH APPROVED DUCT SUPPORT SYSTEMS DESIGNED IN ACCORDANCE WITH THE BUILDING CODE. FLEXIBLE AND OTHER PACTORY—MADE DUCTS SHALL BE SUPPORTED IN ACCORDANCE WITH THE MANUFACTURER'S INSTALLATION INSTRUCTIONS. 2. THIS CORRECTOR SHALL DAY FOR ALL PERMISS AND FESS. 3. CONTROL LOW YOLTAGE WIRING. PY MECHANICAL CONTRACTOR AND CONDUIT BY ELECTRICAL CONTRACTOR. WIRING, CASEL AND RACEWAYS SHALL BE LISTED AND LABELED AS PLENIMA—RATED AND SHALL BE INSTALLED IN ACCORDANCE WITH THE ELECTRICAL CODE, 2013 CMC. NEW CONDUITS SHALL BE INSTALLED IN THE NEW SHAFTS. 4. CONDENSATE DRAIN PIPING AND FINAL CONNECTION TO UNIT BY MECHANICAL CONTRACTOR. 5. DUCT PENETRATION, CUTTING AND PATCHING BY GENERAL CONTRACTOR, UNLESS OTHERWISE NOTED ON PLAN. 6. 7-DAY PROGRAMABLE THERMOSTAT SHALL BE 24 VOLT, COULING WITH MICHINGS SUBBASE AND TRAFFER PROOF COVER. 7. PROMDE FILTER FOR AIR CONDITIONING AND/OR AIR SIDE UNITS AS REQUIRED PER ASHREA AND CODE. 8. THIS CONTRACTOR SHALL COORDINATE WITH GENERAL CONTRACTOR FOR SIZE AND LOCATION OF DUCTIVORK WILL DEPKINSS AND WITH LECTRICAL COLUMBERY AND ARCHITECTURAL REQUIREMENTS OF ALL MICHIAMOSTAL COLUMBERY AND ARCHITECTURAL REQUIREMENTS OF ALL MICHIAMOSTAL COLUMBERY AND ARCHITECTURAL REQUIREMENTS OF ALL MICHIAMOSTAL COLUMBERY AND ARCHITECTURAL REPLIECTED CEILUNG PLAN, ELECTRICAL COLUMBERY AND ARCHITECTURAL REPLIECTED CEILUNG PLAN, ELECTRICAL LIGHTING LAYOUT AND ARCHITECTURAL REPLIECTED CEILUNG PLAN, ELECTRICAL LIGHTING LAYOUT AND ARCHITECTURAL REPLIECTED CEILUNG PLAN, ELECTRICAL LIGHTING LAYOUT AND ARCHITECTURAL REPLIECTED CEILUNG PLAN, ELECTRICAL LIGHTING SYDEAD AND SHALL BE SUPPORTED WITH IT "WIDE 18-CAULOE HANGER STRAPS AND SHALL BE SUPPORTED WITH IT "WIDE 18-CAULOE HANGER STRAPS AND SHALL BE SUPPORTED WITH IT "WIDE 18-CAULOE HANGER STRAPS AND SHALL BE SUPPORTED WITH IT "WIDE 18-CAULOE HANGER STRAPS AND SHALL BE SUPPORTED WITH IT WILL BE AND SHALL BE SHALL ON SHAPE AND SHALL BE SETTION ARCHITECTURAL REPLIECTED CEILUNG PLAN, ELECTRICAL LIGHTING SAPEL AND MICHIGAN SHAPE AND S	1. EVERY DUCT AND PLENUM WHICH IS A PORTION OF THE COMPORT HEATING AND OR COOLING SYSTEM SHALL COMPLY WITH THE REQUIREMENTS OF 2014 OREGON MECHANICAL CODE. AND/OR ASHRE. THIS CONSTRUCTION INSULATION AND SUPPORT OF EVERY DUCT AND PLENUM SHALL COMPLY WITH LOCAL CODE. 2. CONCEALED SPACES, CIRCULATION AR NO COMBUSTIBLE MATERIAL (SUCH AS DIPOSED COMMUNICATION CABLES, INSULATED WIRES, PLYSTIC TUBING OR PIPMS, PIPE INSULATION, CONDENSE PAY INSULATION, WOOLD TOO, ASS AND OTHER TASKS) TO BELL REPORT PAY INSULATION, WOOLD TOO, ASS AND OTHER PAYSICS) TO SHALL BE APPROVED FOR SUCH INSULATION. 3. INSULATION OF DUCTS EVERY CONDITIONED AIR SUPPLY AND PLEMUM SHALL BE INSULATED WITH NO LESS THAN THE AMOUNT OF INSULATION INDICATED BELOW (EXCEPT FOR DUCTS AND PLEMUMS DIRECTLY EXPOSED TO THE COMMONICATED PROPES). ONLY APPROVED MATERIALS SHALL BE USED WITHIN DUCTS OR PLEMUMS FOR INSULATION, SOUND DEADENING OR OTHER PURPOSES. DUCT LOCATION ROOF OR EXPOSED TO OSA ATICS SERVERA AND UNDER PLOYERS OF THE CONTINUE OF PLANTING ONLY 1/2 NG., 3 LB/CU. FT. MINERAL FIBER BLANKET 1/2 NG., 3 LB/CU. FT. MINERAL FIBER BLANKET (DUCT LINER) 1/2 NG., 3 LB/CU. FT. MINERAL FIBER BLANKET (DUCT LINER) 1/2 NG., 3 LB/CU. FT. MINERAL FIBER BLANKET (DUCT LINER) 1/2 NG., 3 LB/CU. FT. MINERAL FIBER BLANKET (DUCT LINER) 1/2 NG., 3 LB/CU. FT. MINERAL FIBER BLANKET (DUCT LINER) 1/2 NG., 3 LB/CU. FT. MINERAL FIBER BLANKET (DUCT LINER) 1/2 NG., 3 LB/CU. FT. MINERAL FIBER BLANKET (DUCT LINER) 1/2 NG., 3 LB/CU. FT. MINERAL FIBER BLANKET (DUCT LINER) 1/2 NG., 3 LB/CU. FT. MINERAL FIBER BLANKET (DUCT LINER) 1/2 NG., 3 LB/CU. FT. MINERAL FIBER BLANKET (DUCT LINER) 1/2 NG., 3 LB/CU. FT. MINERAL FIBER BLANKET (DUCT LINER) 1/2 NG., 3 LB/CU. FT. MINERAL FIBER BLANKET (DUCT LINER) 1/2 NG., 3 LB/CU. FT. MINERAL FIBER BLANKET (DUCT LINER) 1/2 NG., 3 LB/CU. FT. MINERAL FIBER BLANKET (DUCT LINER) 1/2 NG., 3 LB/CU. FT. MINERAL FIBER BLANKET (DUCT LINER) 1/2 NG., 3 LB/CU. FT. MINERAL FIBER BLANKET (DUCT LINER) 1/2 NG., 3 LB/CU. FT. MINERAL FIBER BLANKET (
		ROUND ECCENTRIC TRANSITION, RECTANGULAR OR ROUND NON-SYMMETRICAL WYE SYMMETRICAL WYE RECTANGULAR DUCT RISER ROUND DUCT RISER	C) COOLING AND HEATING SUPPLY AND RETURN AIR TEMPERATURES AT EACH AIR CONDITIONING UNIT. 17. ALL LINED DUCT DIMENSIONS ARE NET CLEAR DIMENSION AFTER LINING HAS BEEN INSTALLED. 18. ANY MATERIAL, ARTICLE OR PIECE OF EQUIPMENT OTHER THAN THAT INDICATED SHALL NOT BE USED UNLESS APPROVED IN WRITING BY THE ENGINEER AND ANY CHANGES IN MECHANICAL, ELECTRICAL AND/OR OTHER SYSTEMS REQUIRED DUE TO SUCH SUBSTITUTION SHALL BE THE RESPONSIBILITY OF THE HVAC CONTRACTOR; AND AT NO ADDITIONAL COST TO THE OWNER. 19. EXHAUST TERMINATION SHALL BE MINIMUM 10'-0" AWAY OR 3'-0" ABOVE FROM ANY FRESH AIR INTAKE, OPENABLE WINDOWS, DOORS AND 10'-0" MINIMUM ABOVE GRADE. 20. THE CONTRACTOR SHALL FURNISH AND INSTALL ACCESS DOORS AND/OR ACCESS PANELS AT LOCATIONS AS NECESSARY TO SERVICE FIRE DAMPERS AND PROVIDE MAINTENANCE FOR EQUIPMENT. ALL ACCESS DOORS AND PANEL LOCATIONS SHALL BE VERIFIED WITH THE ARCHITECT PRIOR TO INSTALLATION.	EACH HVAC SYSTEM SHALL BE PROVIDED WITH AT LEAST ONE AUTOMATIC TEMPERATURE CONTROL DEVICE FOR THE REGULATION OF TEMPERATURE THESE AUTOMATIC TEMPERATURE CONTROL DEVICES SHALL BE CAPABLE OF BEING SET TO MAINTAIN SPACE TEMPERATURE SET POINTS FROM 55 DEGREES F TO 85 DEGREES F, SHALL BE CAPABLE OF OPERATING THE SYSTEM HEATING AND/OR COOLING IN SEQUENCE. EXCEPT AS ALLOWED, THESE CONTROLS SHALL BE ADJUSTABLE TO PROVIDE A DEAD BAND OF 5 DEGREES F BETWEEN FULL HEATING AND FULL COOLING. CONTROLS SHALL HAVE THE CAPABILITY OF TERMINATING ALL HEATING AT A TEMPERATURE NO MORE THAN 70 DEGREES F AND OF TERMINATING ALL COOLING AT A TEMPERATURE NOT LESS THAN 78 DEGREES F. 7. AN AUTOMATIC TIME SWITCH CONTROL DEVICE WITH AN ACCESSIBLE FOUR (4) HOUR MANUAL OVERRIDE SHALL BE PROVIDED. 8. A MAINTENANCE LABEL SHALL BE AFFIXED TO MECHANICAL EQUIPMENT AND A MAINTENANCE MANUAL SHALL BE PROVIDED TO THE OWNER PER STANDARDS.

OMSC 2014 TABLE 403.3 - MIN. VENTILATION RATES											
Area Served	OCCUPANT DENSITY 1000/SF	AREA SQ/FT	OCCUPANTS	OSA CFM/SF	OSA CFM/PERSON	CODE REQ'D OSA (SF)	CODE REQ'D OSA (PERSON)	DESIGN OSA			
Community Building											
Corridor/Lobby 101	10	1,050	11	0.06	5.0	63	53	63			
Office 102	5	170	1	0.06	5.0	10	4	10			
Office 103	5	175	1	0.06	5.0	11	4	11			
Parcel/Storage 104	5	135	1	0.06	5.0	8	3	8			
Mailroom 105	5	270	1	0.06	5.0	16	7	16			
Meeting 106	50	300	15	0.06	5.0	18	75	75			
FCC 107	5	200	1	0.06	5.0	12	5	12			
Elev Vestibule 072	0	575	0	0.06	0.0	35	0	35			
Bike Room 003	0	1,000	0	0.06	0.0	60	0	60			
Corridor 200 - 1200	0	1,450	0	0.06	0.0	87	0	87			
•		5,325	30			320	151	377			

DIFF	USERS, REC	GISTERS AN	D F	RETUR	N A	R GRIL	LES	3			
SYMBOL	MODEL NO.	TYPE		DEL NO. TYPE		ACE	MOE	DULE SIZ	E F	RAME	REMARKS
CD-1	TITUS PSS	CEILING SUPPLY	CEILING SUPPLY PERFORAT			12x12		URFACE	1,2		
SWS-1	TITUS 301RL	SIDEWALL SUPPLY	LOI	JVERED	SE	E DRAWING	S	URFACE	1,4		
SWR-1	TITUS 350RL	SIDEWALL RETURN	LOI	OUVERED SE		E DRAWING	S	URFACE	1,4		
	EE DRAWINGS FOR I		4	. PROVIDE		POLISHED SILVER ME			H.		
DRAWING	TITLE			DRAW	/ING	TITLE					
M001 M002 M200 M201 M202 M203 M204 M205 M206	HVAC SCHEDULE HVAC SCHEDULE HVAC BASEMENT HVAC FIRST FLC HVAC SECOND I HVAC THIRD FLC HVAC FOURTH I HVAC FIFTH FLC HVAC SIXTH FLC	ES T PLAN DOR PLAN FLOOR PLAN DOR PLAN FLOOR PLAN DOR PLAN		M20 M20 M20 M21 M21 M21 M30 M60	B 9 0 1 2 1	HVAC E HVAC N HVAC T HVAC E	CIGHTH INTH F ENTH I EVENTH WELFTH ROOF P		AN IN IN LAN		
				M90	0	HVAC F	TRE CO	NTROL PA	NEL DIAGRAM		

	FCU		DAIKING		0.05									1		1	
	\1.1/	FX	(ZQ12MVJU9	335/265	0.25	_	12,000	_	_	14,000	42	208	1	60	0.80	15	1,2,4
<u>,</u>	FCU FCU 1.3	FX	DAIKING (ZQ12MVJU9	290/180	0.25	_	12,000	-	-	13,500	50	208	1	60	0.40	15	5 1,2,4
97	FCU		DAIKING (MQ30PBVJU	1095/81:		_	30,000	_	+_	34,000	105	208	1	60	2.80	15	5 1,2
	1.4 FCU 1.5		DAIKING			_		+_	 _	·	85	208		60	1.80	15	<u> </u>
	1.5 G FCU		XSQ24TAVJU DAIKING	745/510		-	24,000	 -	 -	27,000			+ '				<u> </u>
	1.6 FCU\FCU\	FX	(ZQ12MVJU9 DAIKING	335/265		_	12,000	 -	 -	14,000	42	208	+ '	60	0.80	15	
	1.7/1.8/	F.	XAQ18PVJU	290/180	0.25	-	18,000	-	-	20,000	31	208	1	60	0.50	15	5 1,2
	FCU\FCU\ 1.9\\ 1.10\	Ð	DAIKING (ZQ15MVJU9	388/282	0.25	-	15,000	-	-	17,500	50	208	1	60	0.80	15	5 1,2
	HP 3	R	DAIKIN MXS48LVJU	-	-	-	48,000	18.8	11.3	54,000	290	208	3	60	27	30	1,3,5
	FCU FCU 3.1 3.2	F	DAIKING TXS18LVJU	500/400	0.25	-	18,000	_	_	20,000	31	208	1	60	0.40	15	5 1,2,5
	FCU 3.3	F	DAIKING TXS12LVJU	290/180	0.25	-	12,000	-	_	13,500	26	208	1	60	0.40	15	1,2,5
	HP 4	R	DAIKIN REYQ96TTJU	_	_	_	96,000	29.3	4.3	108,000	700	208	3	60	38	45	5 1,3,5
	FCU\FCU\	F	DAIKING EXFQ48TVJU	500/400	0.25	_	48,000	_	_	54,000	60	208	1	60	1.80	15	5 1,2,5
	4.1 4.2 HP		DAIKIN XN12NMVJU		 _		12,000	15.0	8.2	12,000	60	208	1	60	10.1	15	
•	5 FCU		DAIKING	424 444	0.05		12,000	10.0	<u> </u>	12,000			' 	\vdash	10.1		
2	FCU 5.1 NOTES: 1. I		TXS18LVJU DISCONNECT	424/141	0.25	-			- BRANCH S		18	208		60	TO DE O	N STAND	,,,,,,,
			PROVIDED BY	MECHANICAL,	INSTALLED	BY MECHA		PROVIDE PROVIDE	BRANCH S	IR KIT.	HANGEUV	ER BUX					D-BY POWER. D BY OUDOOR UNIT
							å		PUMP (CHED		-		**		•
	MARK		IFACTURER EL NUMBE	CFM	JNIT FAN	MTR.	BTUH	LING SEER		TING BTUH	UNIT WEIGH		ER UT			MOC	P NOTES
	HP		DAIKIN FAQ24PVJU	<u> </u>	IN WG.	WATTS -	24,000	17.3	9.4	27,600	175	208	1	60	16.50		
2	FCU 2.1		DAIKING	635/470	0.25	_					50	208	+ +	60	0.60		
			ZQ24PVJU8 DISCONNECT	635/4/0	0.25				POWERED 6	EX OUTDOO		208	<u> </u>	60	0.60		2,3
			PROVIDED BY	MECHANICAL,	INSTALLED	BY MECHA	NICAL.		- FOWERED I		ONII.						
					E	LECTI			SCHE	DULE							
	MARK		MANUFAC' MODEL N	TURER & UMBER	BTU/HR	WATTS	AMPS -	POWER S	PH Hz	NOTES	S						
	EWH 1		CADET: CMT20)8T	6,825	2,000W	9.6	120V	1ø 60	2,3							
				/2 - HW051	1710	500W	4.2	120V	1ø 60	2,3							
	EWH 2		CADET: APEX7														
	2 EH		CADET: APEX7		34,120	10KW	_	208V	1ø 60	2,3							
	EH 1		ELECTROMODE ·	- EUH10B34CT	34,120 6,825	10KW		208V 208V	1ø 60 1ø 60	2,3 1,2							
	ECH 1			- EUH10B34CT .EY: SENW	6,825	2,000W	9.6	208V		1,2	FREEZE P	ROTECTION	N OF S	SHELL	SPACE.		
Y	EH 1 ECH 1 NOTES:	1. CEILI	Q-MARK/MARI CDF 548/CDF	- EUH10B34CT EY: SENW MOUNTED EL	6,825	2,000W	9.6 IDE T-STAT	208V 3.	1ø 60	1,2	FREEZE P	ROTECTION	N OF S	SHELL	SPACE.		
\	EH 1 ECH 1 NOTES:	1. CEILI	ELECTROMODE Q-MARK/MARI CDF 548/CDF	- EUH10B34CT EY: SENW MOUNTED EL	6,825	2,000W	9.6 IDE T-STAT ELECTRCIA	208V 3.	1ø 60 TEMP. HEA	1,2 TER FOR F							
	EH 1 1 NOTES:	1. CEILI 2. PROV	ELECTROMODE Q-MARK/MARI CDF 548/CDF	- EUH10B34CT EY: SENW MOUNTED EL	6,825	2,000W TER. PROV WIRING BY	9.6 IDE T-STAT	208V 3.	1ø 60 TEMP. HEA	1,2	RPM V	EIGHT <u>F</u>	OF S	SUF	PPLY I	NOTES	3
	EH 1 1 NOTES:	1. CEILI 2. PROV	Q-MARK/MARI CDF 548/CDF ING SURFACE VIDE AND INS	- EUH10B34CT EY: SENW MOUNTED EL FALLED BY MI	6,825 ECTRIC HEA	2,000W TER. PROV WIRING BY	9.6 IDE T-STAT	208V 3. SCHE	1ø 60 TEMP. HEA	1,2 TER FOR F	RPM V	EIGHT F	POWER	SUF	PPLY	NOTES	5
	EH 1 ECH 1 NOTES:	1. CEILI 2. PROV	Q-MARK/MARI CDF 548/CDF ING SURFACE VIDE AND INS	- EUH10B34CT EY: SENW MOUNTED EL FALLED BY MI LOCATION BATHROOM	6,825 ECTRIC HEA ECHANICAL,	2,000W TER. PROV WIRING BY	9.6 IDE T-STAT ELECTROIA FAN CFM	208V 3. SCHE OTAL SP IN. WG.	1¢ 60 TEMP. HEA	1,2 TER FOR F	RPM V	EIGHT F LBS.	POWER VOLT	SUF	PPLY Hz		3
	EH 1 ECH 1 NOTES:	1. CEILI 2. PROV	Q-MARK/MAR CDF 548/CDF ING SURFACE VIDE AND INS	- EUH10B34CT EY: SENW MOUNTED ELITALLED BY MI LOCATION BATHROOM CEILING BATHROOM	6,825 ECTRIC HEAECHANICAL, SER	2,000W TER. PROV WIRING BY	9.6 IDE T-STAT ELECTRCIA FAN CFM T 30/80	208V 3. SCHE OTAL SP IN. WG.	1¢ 60 TEMP. HEA DRIVE DIRECT	1,2 TER FOR F HP or WATTS 31W	RPM V	ZEIGHT F LBS. 1	POWER VOLT 115	SUF	PPLY Hz 60 1	1,5,7	
	EH 1 ECH 1 NOTES: MARK BEF 2 EPF SPF 1 EPF SPF	1. CEILI 2. PROV	Q-MARK/MARI CDF 548/CDF ING SURFACE VIDE AND INS EE/MODEL ANASONIC 05-11VKSL1 REENHECK AP-A200	EY: SENW MOUNTED ELITALLED BY MI LOCATION BATHROOM CEILING BATHROOM CEILING	6,825 ECTRIC HEAECHANICAL, SERV	2,000W TER. PROV WIRING BY VES DOMS DOMS	9.6 IDE T-STAT ELECTRCIA FAN CFM 30/80 170	208V 3. 3. SCHE OTAL SP IN. WG25	1¢ 60 TEMP. HEA DULE DRIVE DIRECT DIRECT	HP or WATTS 31W 51.3W	RPM V	ZEIGHT F LBS. 24 24 24 675	POWER VOLT 115 115	SUP PH 1	PPLY Hz 60 1	1,5,7 1,5	3,10,11
	EH 1 ECH 1 NOTES: MARK BEF 1 EPF SPF 1 EPF SPF 2 EF EF EF	1. CEILI 2. PROV	Q-MARK/MARI CDF 548/CDF ING SURFACE VIDE AND INS E/MODEL ANASONIC 05-11VKSL1 REENHECK AP-A200 REENHECK B-25-100 REENHECK B-25-100	EY: SENW MOUNTED EL FALLED BY MI LOCATION BATHROOM CEILING ROOF	6,825 ECTRIC HEAECHANICAL, SERVER RESTRO	2,000W TER. PROV WIRING BY VES DOMS DOMS R/STAIR I/RANGE	9.6 IDE T-STAT ELECTRCIA FAN CFM 30/80 170 11,000	208V 3. 3. COTAL SP IN. WG25 .35	1¢ 60 TEMP. HEA DULE DRIVE DIRECT BELT	HP or WATTS 31W 51.3W	RPM V 1112 900 1725	ZEIGHT FLBS. 24 24 675 675	POWER VOLT 115 115 460	SUP PH 1	PPLY Hz 60 1 60 1 60 1	1,5,7 1,5 1,2,3,4,6	3,10,11 3,10,11
	ECH 1 NOTES: MARK BEF 1 EPF SPF 1 EPF SPF 2 EF EF 1 10 EF	1. CEILI 2. PROV	Q-MARK/MAR CDF 548/CDF ING SURFACE VIDE AND INS EENHECK AP-A200 REENHECK B-25-100 REENHECK B-25-100 REENHECK B-25-100	EY: SENW MOUNTED ELITALLED BY MI LOCATION BATHROOM CEILING ROOF ROOF	6,825 ECTRIC HEAECHANICAL, SERVERICAL RESTRO	2,000W TER. PROV WIRING BY VES DOMS DOMS R/STAIR R/STAIR I/RANGE IRS	9.6 IDE T-STATE ELECTROINE FAN CFM 30/80 170 11,000	208V 3. 3. CAL. SCHE OTAL SP IN. WG25 .35 2.0 2.0	1¢ 60 TEMP. HEA DULE DRIVE DIRECT BELT BELT	1,2 TER FOR F HP or WATTS 31W 51.3W 10HP	RPM V 1112 900 1725	24 24 675 675 100	POWER VOLT 115 115 460	SUPPH 1 1 3 3	PPLY Hz 60 1 60 1 60 1 60 1	1,5,7 1,5 1,2,3,4,6 1,2,3,4,6	3,10,11 3,10,11 3,10
	EH 1 ECH 1 NOTES: MARK BEF 1 EPF SPF 1 EPF SPF 2 EF EF 1 10 EF 2 EF EF 1 10	1. CEILI 2. PROV	ELECTROMODE Q-MARK/MAR CDF 548/CDF ING SURFACE VIDE AND INS ELEMODEL ANASONIC 05-11VKSL1 REENHECK AP-A200 REENHECK B-25-100 REENHECK B-180-7 REENHECK B-141-5 REENHECK B-141-5	EY: SENW MOUNTED ELITALLED BY MI LOCATION BATHROOM CEILING ROOF ROOF ROOF ROOF	6,825 ECTRIC HEAECHANICAL, SERVER RESTROOM RESTROOM DRYE	2,000W TER. PROV WIRING BY VES DOMS DOMS R/STAIR R/STAIR I/RANGE I/RANGE	9.6 IDE T-STATE ELECTROIN FAN CFM 30/80 170 11,000 2,000 1,000	208V 3. 3. 1. 2. 3. 3. 3. 3. 3. 3. 3. 3. 3. 3. 3. 3. 3.	1¢ 60 TEMP. HEA DULE DRIVE DIRECT BELT BELT BELT	1,2 TER FOR F HP or WATTS 31W 51.3W 10HP 10HP 0.75HP 0.50HP	RPM V 1112 900 1725 1725 967 1725	ZEIGHT FLBS. 24 24 675 675 100 65	POWER VOLT 115 115 460 460 460	SUP PH 1 3 3 3 3 3	PPLY Hz 60 1 60 1 60 1 60 1	1,5,7 1,5 1,2,3,4,6 1,2,3,4,6 1,2,3,4,6	5,10,11 5,10,11 5,10
	EH 1 ECH 1 NOTES: MARK BEF 1 EPF SPF 1 EPF SPF 2 EF EF 1 10 EF 2 EF 2 EF 3	1. CEILI 2. PROV	Q-MARK/MAR CDF 548/CDF ING SURFACE VIDE AND INS EENHECK AP-A200 REENHECK B-25-100 REENHECK B-25-100 REENHECK B-180-7 REENHECK B-180-7	EY: SENW MOUNTED ELITALLED BY MI LOCATION BATHROOM CEILING ROOF ROOF ROOF ROOF ROOF ROOF	6,825 ECTRIC HEAECHANICAL, SERVER RESTRO RESTRO ELEVATOR RESTROOM DRYE RESTROOM	2,000W TER. PROV WIRING BY VES DOMS DOMS R/STAIR R/STAIR I/RANGE I/RANGE I/RANGE	9.6 IDE T-STAT ELECTROIA FAN CFM 30/80 170 11,000 2,000 1,000 500	208V 3. 3. 1. SCHE OTAL SP IN. WG25 .35 2.0 2.0 1.0 1.0 0.5	1¢ 60 TEMP. HEA DIRECT DIRECT BELT BELT BELT BELT BELT	1,2 TER FOR F HP or WATTS 31W 51.3W 10HP 10HP 0.75HP 0.50HP	RPM V 1112 900 1725 1725 1725 1,369	24 24 675 100 65 50	POWER VOLT 115 115 460 460 460	SUP PH 1 3 3 3 3 3	PPLY Hz 60 1 60 1 60 1 60 1 60 1 60 1 60 1 60	1,5,7 1,5 1,2,3,4,6 1,2,3,4,6 1,2,3,4,6 1,2,3,4,6	5,10,11 5,10,11 5,10 5,10
	ECH 1 NOTES: MARK BEF 1 EPF SPF 1 EPF SPF 2 EFF EF 1 10 EFF 2 EFF 4	1. CEILI 2. PROV	ELECTROMODE Q-MARK/MAR CDF 548/CDF ING SURFACE VIDE AND INS ELEMODEL ANASONIC 05-11VKSL1 REENHECK AP-A200 REENHECK B-25-100 REENHECK B-180-7 REENHECK B-141-5 REENHECK B-091-4 REENHECK B-091-4 REENHECK B-121-5	EY: SENW MOUNTED ELITALLED BY MI LOCATION BATHROOM CEILING ROOF ROOF ROOF ROOF ROOF ROOF ROOF ROOF	6,825 ECTRIC HEAECHANICAL, SERVER RESTROOM RESTROOM RESTROOM RESTROOM RESTROOM	2,000W TER. PROV WIRING BY VES DOMS R/STAIR R/STAIR I/RANGE RS I/RANGE OOM ROOM	9.6 IDE T-STATE ELECTROIN FAN CFM 30/80 170 11,000 2,000 1,000 500 825	208V 3. 3. 1. 2. 3. 2. 2. 2. 2. 0 2. 0 1. 0 1. 0 0. 5 1. 0	1# 60 TEMP. HEA DIRECT DIRECT BELT BELT BELT BELT BELT	1,2 TER FOR F HP or WATTS 31W 51.3W 10HP 10HP 0.75HP 0.50HP 0.25HP	RPM V 1112 900 1725 1725 967 1725 1,369 1725	ZEIGHT FLBS. 24 24 675 675 100 65 50 65	POWER VOLT 115 115 460 460 460 460	SUP PH 1 3 3 3 3 3 3	PPLY Hz 60 1 60 1 60 1 60 1 60 1	1,5,7 1,5 1,2,3,4,6 1,2,3,4,6 1,2,3,4,6 1,2,3,4,6	3,10,11 3,10,11 3,10 3,10 3,10
	EH 1 ECH 1 NOTES: MARK BEF 1 EPF SPF 1 1 EPF SPF 1 1 EFF 2 EFF 1 10 EFF 2 EFF 4 EFF 4 EFF 5 EFF 1 10 EFF 2 EFF 1 EFF 1 10 EFF 2 EFF 1	1. CEILI 2. PROV	ELECTROMODE Q-MARK/MAR CDF 548/CDF ING SURFACE VIDE AND INS EE/MODEL ANASONIC 05-11VKSL1 REENHECK AP-A200 REENHECK B-25-100 REENHECK B-141-5 REENHECK B-141-5 REENHECK B-121-5 REENHECK B-121-5 REENHECK B-121-5 REENHECK B-141-7	EY: SENW MOUNTED ELITALLED BY MI LOCATION BATHROOM CEILING ROOF ROOF ROOF ROOF ROOF ROOF	6,825 ECTRIC HEAECHANICAL, SERVER RESTRO RESTRO ELEVATOR RESTROOM DRYE RESTROOM	2,000W TER. PROV WIRING BY VES DOMS R/STAIR R/STAIR I/RANGE RS I/RANGE OOM ROOM	9.6 IDE T-STAT ELECTROIA FAN CFM 30/80 170 11,000 2,000 1,000 500	208V 3. 3. 1. SCHE OTAL SP IN. WG25 .35 2.0 2.0 1.0 1.0 0.5	1¢ 60 TEMP. HEA DIRECT DIRECT BELT BELT BELT BELT BELT	1,2 TER FOR F HP or WATTS 31W 51.3W 10HP 10HP 0.75HP 0.50HP	RPM V 1112 900 1725 1725 1725 1,369	FIGHT FLBS. 24 24 675 675 100 65 50 65	POWER VOLT 115 115 460 460 460	SUP PH 1 3 3 3 3 3	PPLY Hz 60 1 60 1 60 1 60 1 60 1	1,5,7 1,5 1,2,3,4,6 1,2,3,4,6 1,2,3,4,6 1,2,3,4,6	3,10,11 3,10,11 3,10 3,10 3,10
	EH 1 ECH 1 NOTES: MARK BEF 2 EPF SPF 1 EPF SPF 2 EF 10 EF 2 EF 4 EF 6	1. CEILI 2. PROV	ELECTROMODE Q-MARK/MAR CDF 548/CDF ING SURFACE VIDE AND INS ELEMODEL ANASONIC 05-11VKSL1 REENHECK AP-A200 REENHECK B-25-100 REENHECK B-180-7 REENHECK B-141-5 REENHECK B-091-4 REENHECK B-121-5 REENHECK B-121-5	EY: SENW MOUNTED ELITALLED BY MI LOCATION BATHROOM CEILING ROOF ROOF ROOF ROOF ROOF ROOF ROOF ROOF	6,825 ECTRIC HEAECHANICAL, SERVER RESTROOM RESTROOM RESTROOM RESTROOM RESTROOM	2,000W TER. PROV WIRING BY VES DOMS COMS R/STAIR R/STAIR I/RANGE I/RANGE I/RANGE OOM ROOM HOODS	9.6 IDE T-STATE ELECTROIN FAN CFM 30/80 170 11,000 2,000 1,000 500 825	208V 3. 3. 1. 2. 3. 2. 2. 2. 2. 0 2. 0 1. 0 1. 0 0. 5 1. 0	1# 60 TEMP. HEA DIRECT DIRECT BELT BELT BELT BELT BELT	1,2 TER FOR F HP or WATTS 31W 51.3W 10HP 10HP 0.75HP 0.50HP 0.25HP	RPM V 1112 900 1725 1725 967 1725 1,369 1725	EIGHT ELBS. 24 24 675 675 100 65 50 65 75	POWER VOLT 115 115 460 460 460 460	SUP PH 1 3 3 3 3 3 3	PPLY Hz 60 1 60 1 60 1 60 1 60 1	1,5,7 1,5 1,2,3,4,6 1,2,3,4,6 1,2,3,4,6 1,2,3,4,6	5,10,11 5,10,11 5,10 5,10 6,10
	EH 1 ECH 1 NOTES: MARK BEF 2 EPF SPF 2 EF 1 10 EF 2 EF 4 EF 5 EF 4	1. CEILI 2. PROV GR SFI GR	ELECTROMODE Q-MARK/MARI CDF 548/CDF ING SURFACE VIDE AND INS EE/MODEL ANASONIC 05-11VKSL1 REENHECK AP-A200 REENHECK B-25-100 REENHECK B-25-100 REENHECK B-180-7 REENHECK B-141-5 REENHECK B-121-5 REENHECK B-121-5 REENHECK B-141-7 REENHECK	EY: SENW MOUNTED ELITALLED BY MI LOCATION BATHROOM CEILING ROOF	6,825 ECTRIC HEAECHANICAL, SERY RESTRO ELEVATOR ELEVATOR RESTROON DRYE RESTROON RESTROON RESTROON RESTROON RESTROON RESTROON RESTROON	2,000W TER. PROV WIRING BY VES DOMS R/STAIR R/STAIR I/RANGE	9.6 IDE T-STATELECTROIA FAN CFM 30/80 170 11,000 2,000 1,000 500 825 1,650	208V 208V 3. AL. SCHE OTAL SP IN. WG. 25 2.0 2.0 1.0 1.0 1.0 1.0	1# 60 TEMP. HEA DULE DRIVE DIRECT BELT BELT BELT BELT BELT BELT BELT BELT	1,2 TER FOR F HP or WATTS 31W 51.3W 10HP 10HP 0.75HP 0.25HP 0.33HP 0.75HP	RPM V 1112 900 1725 1725 1725 1,369 1725 1,374	EIGHT ELBS. 24 24 675 675 100 65 50 65 75 25	POWER VOLT 115 115 460 460 460 460 460	SUP PH 1 3 3 3 3 3 3	PPLY Hz 60 1 60 1 60 1 60 1 60 1 60 1 60 1	1,5,7 1,5 1,2,3,4,6 1,2,3,4,6 1,2,3,4,6 1,2,3,4,6 1,2,3,4,6	5,10,11 5,10,11 5,10 5,10 6,10
	ECH 1 ECH 1 NOTES: MARK BEF 2 EPF SPF 1 EPF SPF 2 EF 1 10 EF 2 EF 4 EF 6 EF 6 EF EF	1. CEILI 2. PROV GF GF GF GF GF GF GF GF GF G	ELECTROMODE Q-MARK/MAR CDF 548/CDF ING SURFACE VIDE AND INS ELEMODEL ANASONIC 05-11VKSL1 REENHECK AP-A200 REENHECK B-25-100 REENHECK B-180-7 REENHECK B-141-5 REENHECK B-141-5 REENHECK B-141-7 REENHECK B-141-7 REENHECK B-141-7 REENHECK B-141-7 REENHECK B-141-7	EY: SENW MOUNTED ELITALLED BY MI LOCATION BATHROOM CEILING ROOF	6,825 ECTRIC HEAECHANICAL, SERVER RESTROOM	2,000W TER. PROV WIRING BY VES DOMS R/STAIR R/STAIR I/RANGE I/RANGE IOOM ROOM HOODS LOSET	9.6 IDE T-STATE ELECTROIN FAN CFM 30/80 170 11,000 2,000 1,000 500 825 1,650 200	208V 208V 3. 3. 1. SCHE OTAL SP IN. WG. .25 .35 2.0 1.0 1.0 1.0 0.5 1.0 1.0	1# 60 TEMP. HEA DIRECT DIRECT BELT BELT BELT BELT BELT BELT BELT BELT BELT	1,2 TER FOR F HP or WATTS 31W 51.3W 10HP 10HP 0.75HP 0.25HP 0.33HP 0.75HP 1/10HP	RPM V 1112 900 1725 1725 1725 1,369 1725 1,374 1,436	EIGHT ELBS. 24 24 675 675 100 65 50 65 75 25	POWER VOLT 115 115 460 460 460 460 460 115	SUP PH 1 1 3 3 3 3 3 3 1	PPLY Hz 60 1 60 1 60 1 60 1 60 1 60 1 60 1	1,5,7 1,5 1,2,3,4,6 1,2,3,4,6 1,2,3,4,6 1,2,3,4,6 1,2,3,4,6 1,2,3,4,1	5,10,11 5,10,11 5,10 5,10 6,10
	ECH 1 NOTES: MARK BEF 2 EPF SPF 1 EPF SPF 2 EF 10 EF 2 EF 4 EF 9 EF 9	1. CEILI 2. PROV MAK P/ FV-C GF GF GF GF GF GF GF GF GF G	ELECTROMODE Q-MARK/MAR CDF 548/CDF ING SURFACE VIDE AND INS EE/MODEL ANASONIC 05-11VKSL1 REENHECK B-25-100 REENHECK B-25-100 REENHECK B-180-7 REENHECK B-141-5 REENHECK B-141-5 REENHECK B-141-7	EY: SENW MOUNTED ELITALLED BY MI LOCATION BATHROOM CEILING ROOF	6,825 ECTRIC HEAECHANICAL, SERVER RESTROOM AND CI	2,000W TER. PROV WIRING BY VES DOMS R/STAIR R/STAIR R/STAIR R/RANGE ROOM ROOM HOODS LOSET ROOM	9.6 IDE T-STATELECTROIA FAN CFM 30/80 170 11,000 2,000 1,000 500 825 1,650 200 75	208V 3. 3. 3. 3. 3. 3. 3. 3. 3. 3. 3. 3. 3. 3	1# 60 TEMP. HEA DULE DRIVE DIRECT BELT	1,2 TER FOR F HP or WATTS 31W 51.3W 10HP 10HP 0.75HP 0.25HP 0.33HP 0.75HP 1/10HP 1/10HP	RPM V 1112 900 1725 1725 1725 1,369 1725 1,374 1,436 935	FIGHT FLBS. 24 24 675 675 100 65 50 65 75 25 15 31	POWER VOLT 115 115 460 460 460 460 115 115	SUP PH 1 1 3 3 3 3 3 3 1	PLY Hz 60 1 60 1 60 1 60 1 60 1 60 1 60 1 60 1	1,5,7 1,5 1,2,3,4,6 1,2,3,4,6 1,2,3,4,6 1,2,3,4,6 1,2,3,4,1 1,2,3,4,1 1,2,3,4,1	3,10,11 3,10,11 3,10 3,10 10 3,10
	ECH 1 ECH 1 NOTES: MARK BEF 2 EPF SPF 1 EPF SPF 2 EF 10 EF 2 EF 4 EF 8 EF 9 EF 8	1. CEILI 2. PROV	ELECTROMODE Q-MARK/MAR CDF 548/CDF ING SURFACE VIDE AND INS ELEMODEL ANASONIC 05-11VKSL1 REENHECK AP-A200 REENHECK B-25-100 REENHECK B-141-5 REENHECK B-141-5 REENHECK B-141-7	EY: SENW MOUNTED ELITALLED BY MI LOCATION BATHROOM CEILING ROOF ROOF ROOF ROOF ROOF ROOF ROOF ROOF CEILING CEILING	6,825 ECTRIC HEAECHANICAL, SERVER RESTROOM RESTROOM RESTROOM RESTROOM RESTROOM RESTROOM RESTROOM RESTROOM RESTROOM TRASH JAN. CI	2,000W TER. PROV WIRING BY VES DOMS DOMS R/STAIR R/STAIR R/STAIR R/RANGE ROOM ROOM HOODS LOSET ROOM EMOVAL SURE	9.6 IDE T-STATE ELECTROIN FAN CFM 30/80 170 11,000 2,000 1,000 500 825 1,650 200 75 400	208V 2.3. COTAL SP IN. WG. 2.25 2.0 1.0 1.0 1.0 0.5 1.0 0.5 0.35 0.35	1# 60 TEMP. HEA DIRECT DIRECT BELT BELT BELT BELT BELT BELT DIRECT DIRECT DIRECT DIRECT DIRECT DIRECT	1,2 TER FOR F HP or WATTS 31W 51.3W 10HP 10HP 0.75HP 0.50HP 0.25HP 0.75HP 1/10HP 6.1W 224W	RPM V 1112 900 1725 1725 1725 1,369 1725 1,374 1,436 935 1,070	EIGHT ELBS. 24 24 675 675 100 65 50 65 75 25 15 31	POWER VOLT 115 115 460 460 460 460 460 115 115	SUP PH 1 1 3 3 3 3 1 1 3 1	PLY Hz 60 1 60 1 60 1 60 1 60 1 60 1 60 1 60 1	1,5,7 1,5 1,2,3,4,6 1,2,3,4,6 1,2,3,4,6 1,2,3,4,6 1,2,3,4,6 1,2,3,4,1 1,2,3,4,1 1,2,3,4,1	3,10,11 3,10,11 3,10 3,10 10 3,10
	ECH 1 NOTES: MARK BEF 2 EPF SPF 2 EF 10 EF 2 EF 3 EF 4 EF 3 EF 4 EF 9 EF 8	1. CEILI 2. PROV MAK P/FV-C GF GF GF GF GF GF GF GF GF G	ELECTROMODE Q-MARK/MAR CDF 548/CDF ING SURFACE VIDE AND INS EE/MODEL ANASONIC 05-11VKSL1 REENHECK AP-A200 REENHECK B-25-100 REENHECK B-25-100 REENHECK B-180-7 REENHECK B-141-5 REENHECK B-141-5 REENHECK B-141-7	EY: SENW MOUNTED ELITALLED BY MI LOCATION BATHROOM CEILING ROOF	6,825 ECTRIC HEAE ECHANICAL, SERY RESTRO RESTROOM RESTROOM RESTROOM RESTROOM RESTROOM RESTROOM TRASH SMOKE R PRESS RELL	2,000W TER. PROV WIRING BY VES DOMS COMS R/STAIR R/STAIR I/RANGE I/	9.6 IDE T-STATELECTROIA FAN CFM 30/80 170 11,000 2,000 1,000 500 825 1,650 200 75 400 1,000	208V C. 3. C.	1# 60 TEMP. HEA DULE DRIVE DIRECT BELT	1,2 TER FOR F HP or WATTS 31W 51.3W 10HP 10HP 0.75HP 0.50HP 0.25HP 0.33HP 1/10HP 6.1W 224W 1HP .599HP	RPM V 1112 900 1725 1725 1725 1,369 1725 1,374 1,436 935 1,070 1,070 1,725	EIGHT FLBS. 24 24 675 675 65 75 25 15 31 125 57 9. FAN C	POWER VOLT 115 115 460 460 460 460 460 115 115 115 220 CONTRO	SUP PH 1 3 3 3 1 3 1 3 3 1 3 3 1 3 3 1 3 3 1 3 3 1 3 3 1 3 3 3 3 1 3	PLY Hz 60 1 60 1 60 1 60 1 60 1 60 1 60 1 60	1,5,7 1,5 1,2,3,4,6 1,2,3,4,6 1,2,3,4,6 1,2,3,4,6 1,2,3,4,1 1,2,3,4,1 1,4,5,8 1,4,5,8 1,4,5,8 1,4,5,8 1,4,5,8 1,4,5,8	3,10,11 3,10,11 3,10 3,10 10 3,10
	EH 1 ECH 1 NOTES: MARK BEF 2 EPF SPF 1 EPF SPF 2 EF 10 EF 2 EF 4 EF 3 EF 4 EF 3 EF 4 EF 3 EF 3 EF 4 EF 3 EF 8 EF 7 9 EF 8 EF 12 NOTES: 1. PR 2. FUI 3. VFI	1. CEILI 2. PROV GF GF GF GF GF GF GF GF GF G	ELECTROMODE Q-MARK/MAR CDF 548/CDF ING SURFACE VIDE AND INS EE/MODEL ANASONIC 05-11VKSL1 REENHECK AP-A200 REENHECK B-25-100 REENHECK B-25-100 REENHECK B-180-7 REENHECK B-141-5 REENHECK B-141-5 REENHECK B-141-7	EY: SENW MOUNTED ELITALLED BY MI LOCATION BATHROOM CEILING ROOF ROO	6,825 ECTRIC HEAD ECHANICAL, SER' RESTRO RESTROOM RESTROOM RESTROOM RESTROOM RESTROOM RESTROOM TRASH SMOKE R PRESS RELL 6. 7.	2,000W TER. PROV WIRING BY VES DOMS R/STAIR R/STAIR I/RANGE	9.6 IDE T-STATE ELECTROP FAN CFM	208V C. 3. C.	1# 60 TEMP. HEAD DULE DRIVE DIRECT BELT	1,2 TER FOR F HP or WATTS 31W 51.3W 10HP 10HP 0.75HP 0.25HP 0.33HP 0.75HP 1/10HP 6.1W 224W 1HP .599HP	RPM V 1112 900 1725 1725 1725 1,369 1725 1,374 1,436 935 1,070 1,070 1,725	EIGHT ELBS. 24 24 675 675 100 65 50 65 75 25 15 31 125	POWER VOLT 115 115 460 460 460 460 460 115 115 115 115 115	SUP PH 1 1 3 3 3 3 1 3 1 3 1 3 1 3 1 3 1 3 1	PLY Hz 60 1 60 1 60 1 60 1 60 1 60 1 60 1 60	1,5,7 1,5 1,2,3,4,6 1,2,3,4,6 1,2,3,4,6 1,2,3,4,6 1,2,3,4,1 1,2,3,4,6 1,2,3,4,6 1,2,3,4,6 1,4,5,8 1,4,5,8 1,4,5,8	3,10,11 3,10,11 3,10 3,10 10 3,10
	ECH 1 ECH 1 NOTES: MARK BEF 2 EPF SPF 1 EPF SPF 2 EF 4 EF 3 EF 4 EF 7 F 9 EF 8 EF 7 F 9 EF 8 EF 12 NOTES: 1. PRO 2. FUI 3. VFU 4. FUI	1. CEILI 2. PROV GF GF GF GF GF GF GF GF GF G	ELECTROMODE Q-MARK/MAR CDF 548/CDF ING SURFACE VIDE AND INS ELEMODEL ANASONIC 05-11VKSL1 REENHECK AP-A200 REENHECK B-25-100 REENHECK B-25-100 REENHECK B-141-5 REENHECK B-141-5 REENHECK B-141-7	EY: SENW MOUNTED ELITALLED BY MI LOCATION BATHROOM CEILING ROOF ROO	6,825 ECTRIC HEAD ECHANICAL, SER' RESTRO RESTROON RESTROON RESTROON RESTROON RESTROON TRASH SMOKE R PRESS PRESS RELI CH.	2,000W TER. PROV WIRING BY VES DOMS DOMS R/STAIR R/STAIR I/RANGE I/RANGE I/RANGE ROOM HOODS LOSET ROOM EMOVAL SURE IFF PROVIDE VI TO RUN C (80 CFM)	9.6 IDE T-STATE ELECTROP FAN CFM	208V 3. 3. 1. 3.	1# 60 TEMP. HEA DULE DRIVE DIRECT BELT	1,2 TER FOR F HP or WATTS 31W 51.3W 10HP 10HP 0.75HP 0.25HP 0.33HP 0.75HP 1/10HP 6.1W 224W 1HP .599HP	RPM V 1112 900 1725 1725 1725 1,369 1725 1,374 1,436 935 1,070 1,070 1,725	EIGHT FLBS. 24 24 675 675 100 65 50 65 75 25 15 31 125 57 9. FAN C110. FAN	POWER VOLT 115 115 460 460 460 460 460 115 115 115 115 115	SUP PH 1 1 3 3 3 3 1 3 1 3 1 3 1 3 1 3 1 3 1	PLY Hz 60 1 60 1 60 1 60 1 60 1 60 1 60 1 60	1,5,7 1,5 1,2,3,4,6 1,2,3,4,6 1,2,3,4,6 1,2,3,4,6 1,2,3,4,1 1,2,3,4,6 1,2,3,4,6 1,2,3,4,6 1,4,5,8 1,4,5,8 1,4,5,8	3,10,11 3,10,11 3,10 3,10 10 3,10
	ECH 1 ECH 1 NOTES: MARK BEF 2 EPF SPF 1 EPF SPF 2 EF 4 EF 3 EF 4 EF 7 F 9 EF 8 EF 7 F 9 EF 8 EF 12 NOTES: 1. PRO 2. FUI 3. VFU 4. FUI	1. CEILI 2. PROV GF GF GF GF GF GF GF GF GF G	ELECTROMODE Q-MARK/MAR CDF 548/CDF ING SURFACE VIDE AND INS ELEMODEL ANASONIC 05-11VKSL1 REENHECK AP-A200 REENHECK B-25-100 REENHECK B-121-5 REENHECK B-141-5 REENHECK B-141-7	EY: SENW MOUNTED ELITALLED BY MI LOCATION BATHROOM CEILING ROOF ROO	6,825 ECTRIC HEAD ECHANICAL, SER' RESTRO RESTROON RESTROON RESTROON RESTROON RESTROON RESTROON TRASH SMOKE R PRESS RELI CH. T. CH. T. 8.	2,000W TER. PROV WIRING BY VES DOMS COMS R/STAIR R/STAIR I/RANGE I/RANGE I/RANGE ROOM HOODS LOSET ROOM EMOVAL GURE FIF PROVIDE VI PRE—SET I TO RUN C (80 CFM) FAN TO RU FAN TO RU FAN TO RU TO RUN C TO	9.6 IDE T-STATE ELECTRON FAN CFM T 30/80 170 11,000 1,000 1,000 500 825 1,650 200 75 400 1,000 4,000 FD. FAN COLONINUOUS WHEN WALL UN CONTINUOUS WHEN WALL WHEN WALL UN CONTINUOUS WHEN WALL WHEN WALL WHEN WALL WHEN WALL WALL WHEN	208V 3. 3. 1 SCHE OTAL SP IN. WG25 .35 .2.0 .2.0 .1.0 .1.0 .5 .1.0 .5 .504 ONTROLLED W/ TIME (30 CFM) SWITCH JOUSLY.	1# 60 TEMP. HEAD DULE DRIVE DIRECT BELT	1,2 TER FOR F HP or WATTS 31W 51.3W 10HP 10HP 0.75HP 0.25HP 0.33HP 0.75HP 1/10HP 6.1W 224W 1HP .599HP JRE SENSO EVEL ON.	RPM V 1112 900 1725 1725 1725 1,369 1725 1,374 1,436 935 1,070 1,070 1,725 DR	EIGHT FLBS. 24 24 675 675 100 65 50 65 75 25 15 31 125 57 9. FAN C110. FAN	POWER VOLT 115 115 460 460 460 460 460 115 115 115 115 115	SUP PH 1 1 3 3 3 3 1 3 1 3 1 3 1 3 1 3 1 3 1	PLY Hz 60 1 60 1 60 1 60 1 60 1 60 1 60 1 60	1,5,7 1,5 1,2,3,4,6 1,2,3,4,6 1,2,3,4,6 1,2,3,4,6 1,2,3,4,1 1,2,3,4,6 1,2,3,4,6 1,2,3,4,6 1,4,5,8 1,4,5,8 1,4,5,8	3,10,11 3,10,11 3,10 3,10 10 3,10
	EH 1 ECH 1 NOTES: MARK BEF 2 EPF SPF 1 EPF SPF 2 EF 10 EF 2 EF 8 EF 9 EF 8 EF 10 EF 2 EF 8 EF 10 EF 8 EF 7 B 1 EF 10 EF 2 EF 8 EF 11 EF 12 NOTES: 1. PR 2. FUI 3. FUI 5. CEI	1. CEILI 2. PROV GF GF GF GF GF GF GF GF GF G	ELECTROMODE Q-MARK/MAR CDF 548/CDF ING SURFACE VIDE AND INS ELEMODEL ANASONIC 05-11VKSL1 REENHECK AP-A200 REENHECK B-25-100 REENHECK B-25-100 REENHECK B-180-7 REENHECK B-141-5 REENHECK B-141-5 REENHECK B-141-7 REENHE	EY: SENW MOUNTED ELITALLED BY MI LOCATION BATHROOM CEILING ROOF ROO	6,825 ECTRIC HEAD ECHANICAL, SERY RESTRO RESTROON R	2,000W TER. PROV WIRING BY VES DOMS DOMS R/STAIR R/STAIR I/RANGE IROOM HOODS LOSET ROOM EMOVAL SURE IFO RUN C (80 CFM) FAN TO RU MAKE COOLIN	9.6 IDE T-STATE ELECTRON FAN CFM T 30/80 170 11,000 1,000 1,000 500 825 1,650 200 75 400 1,000 4,000 FD. FAN COLONINUOUS WHEN WALL UN CONTINUOUS WHEN WALL UN	208V 3. 3. 3. 3. 3. 3. 3. 3. 3. 3. 3. 3. 3.	1# 60 TEMP. HEA DULE DRIVE DIRECT BELT BELT BELT BELT BELT BELT BELT BELT CONTRICT DIRECT DIRECT CONTRICT CON	1,2 TER FOR F HP or WATTS 31W 51.3W 10HP 10HP 0.75HP 0.25HP 0.33HP 0.75HP 1/10HP 6.1W 224W 1HP .599HP JRE SENSO EVEL ON.	RPM V 1112 900 1725 1725 1725 1,369 1725 1,374 1,436 935 1,070 1,070 1,725 WEIGHT	EIGHT FLBS. 24 24 675 675 65 75 25 15 31 125 57 9. FAN C10. FAN 11. FAN EPO	POWER VOLT 115 115 460 460 460 460 115 115 115 115 115 115 115 115 115 11	SUP PH 1 1 3 3 3 3 1 3 1 3 ITILIZ	PLY	1,5,7 1,5 1,2,3,4,6 1,2,3,4,6 1,2,3,4,6 1,2,3,4,6 1,2,3,4,1 1,4,5,8 1,4,5,8 1,4,5,8 1,4,5,8 1,4,5,8 1,4,5,8 1,4,5,8 1,4,5,8 1,4,5,8	3,10,11 3,10 3,10 3,10 3,10 10
	ECH 1 ECH 1 NOTES: MARK BEF 2 EPF SPF 1 EPF SPF 2 EF 10 EF 2 EF 3 EF 4 EF 5 EF 6 EF 7 F 9 EF 8 EF 12 NOTES: 1. PR 2. FUI 3. FUI 5. CEI MARK	1. CEILI 2. PROV GRA GRG GRG GRG GRG GRG GRG GR	ELECTROMODE Q-MARK/MAR CDF 548/CDF ING SURFACE VIDE AND INS ELEMODEL ANASONIC 05-11VKSL1 REENHECK AP-A200 REENHECK B-25-100 REENHECK B-121-5 REENHECK B-141-5 REENHECK B-141-7	EY: SENW MOUNTED ELITALLED BY MI LOCATION BATHROOM CEILING ROOF ROO	6,825 ECTRIC HEAD ECHANICAL, SERY RESTRO RESTROOM R	2,000W TER. PROV WIRING BY VES DOMS DOMS R/STAIR R/S	9.6 IDE T-STATELECTROM FAN CFM 30/80 170 11,000 2,000 1,000 300 1,000 4,000 75 400 1,000 1,000 75 400 1,000 1,000 4,000 TO FAN CONTINUOUS WHEN WALL ON CONTINUOUS WHEN WALL ON TOUTH OF THE PAIR OF THE P	208V 208V 3. 3. 3. 3. 3. 3. 3. 3. 3. 3. 3. 3. 3.	1# 60 TEMP. HEA DULE DRIVE DIRECT BELT BELT BELT BELT BELT BELT BELT BELT CONTRICT DIRECT DIRECT CONTRICT CON	1,2 TER FOR F HP or WATTS 31W 51.3W 10HP 10HP 0.75HP 0.25HP 0.33HP 0.75HP 1/10HP 6.1W 224W 1HP .599HP JRE SENSO EVEL ON.	RPM V 1112 900 1725 1725 1,369 1725 1,374 1,436 935 1,070 1,070 1,725 DR	EIGHT FLBS. 7 7 7 7 7 7 7 7 7	POWER VOLT 115 115 460 460 460 460 115 115 115 115 115 115 115 115 115 11	SUP PH 1 1 3 3 3 3 1 3 3 1 3 3 1 3 3 1 3 3 1 3 3 1 3 3 1 3 3 3 3 1 3	PLY	1,5,7 1,5 1,2,3,4,6 1,2,3,4,6 1,2,3,4,6 1,2,3,4,6 1,2,3,4,1 1,4,5,8 1,4,5,8 1,4,5,8 1,4,5,8 1,4,5,8 1,4,5,8 1,4,5,8 1,4,5,8 1,4,5,8	3,10,11 3,10,11 3,10 3,10 10 3,10
	ECH 1 NOTES: MARK BEF 2 EPF SPF 2 EF 10 EF 3 EF 4 EF 5 EF 8 EF 10	1. CEILI 2. PROV GROSFI GROS	ELECTROMODE Q-MARK/MAR CDF 548/CDF ING SURFACE VIDE AND INS E/MODEL ANASONIC 05-11VKSL1 REENHECK AP-A200 REENHECK B-25-100 REENHECK B-121-5 REENHECK B-141-5 REENHECK B-141-7 REENHECK	EY: SENW MOUNTED ELITALLED BY MI LOCATION BATHROOM CEILING ROOF SUPPLY CFM ESF	6,825 ECTRIC HEAD ECHANICAL, SERY RESTRO RESTROOM R	2,000W TER. PROV WIRING BY VES DOMS DOMS RYSTAIR RY	9.6 IDE T-STATE ELECTRICATE FAN CFM	208V	TEMP. HEAD DULE DRIVE DIRECT BELT BELT BELT BELT BELT BELT BELT BELT COUTPUT ATING OUTPUT	1,2 TER FOR F HP or WATTS 31W 51.3W 10HP 10HP 0.75HP 0.25HP 0.33HP 0.75HP 1/10HP 6.1W 224W 1HP .599HP JRE SENSO EVEL ON.	RPM V 1112 900 1725 1725 1725 1,369 1725 1,374 1,436 935 1,070 1,070 1,725 DR WEIGHT LBS. 3,150	EIGHT FLBS. 24 24 675 675 65 75 25 15 31 125 57 9. FAN C10. FAN 11.	POWER VOLT 115 115 160 460 460 460 115 115 115 115 115 115 115 115 115 11	SUP PH 1 1 3 3 3 3 1 3 3 1 3 3 1 3 3 1 1 3 3 1	PLY	1,5,7 1,5 1,2,3,4,6 1,2,3,4,6 1,2,3,4,6 1,2,3,4,6 1,2,3,4,6 1,4,5,8 1,4,5,8 1,4,5,8 1,4,5,8 1,4,5,8 1,4,5,8 1,4,5,8	3,10,11 3,10 3,10 3,10 3,10 10

VRF SPLIT SYSTEM HEAT PUMP UNIT SCHEDULE

COOLING

168,000 19.5

HEATING
UNIT
COP/ BTUH WEIGHT VOLT PH Hz MCA MOCP

780

3.3 188,000

NOTES

MANUFACTURER & CFM ESP MTR.
H/L IN WG. WATTS

MARK

ARCHITECTS

720 NW Davis 503.221.1121 Suite 300 503.221.2077 Portland OR 97209 www.lrsarchitects.com



LEVERARCHITECTURE

239 NW 13TH AVE, PDX OR 97209 T 503 928 6040 www.leverarchitecture.com

CONSULTANT:

ANDERSEN HEATING, Inc.

16285 SW 85th AVE #410
TIGARD, OREGON 97224
PHONE: 503.841.0742

PHONE: 503.841.0742

CONSULTING

9220 SW BARBUR BLVD. #119-324

PORTLAND, OREGON 97219

PH: (503)718-7699

EMAIL: INFO@MEPCON.COM

PROJECT NUMBER: 215349

GRAND AVENUE

APARTMENTS

1010 NE GRAND AVE. PORTLAND, OR 97232

SHEET TITLE:

MECHANICAL

COVER

SHEET

KEY PLAN:

Plan Check Review - 09.01.2017
Plan Check Review - 01.26.2018
Plan Check Review - 03.20.2018
Plan Check Review - 04.17.2018
Plan Check Review - 04.17.2018
Owner Revisions - 05.09.2018
Plan Check Review - 08.17.2018
Plan Check Review - 10.12.2018
Revisions -01.04.2019
Revisions -02.04.2019

Revisions -08.21.2019
SHEET:

SHEET:

CONSTRCUTION SET
08-17-2018

Plan Check Review -02.28.2019

LRS Architects, Inc. ©2016

OMSC 2014 SECTION 402 - NATURAL VENTILATION											
Space (Room Name)	Room(s) Area (sqft)	OMSC Table 403.3 (persons per unit)	CFM/person (Table 403.3)	Required Ventilation CFM	Window Area (sqft)	Opening Area / Floor Area					
UNIT 1/1-E (1-Bed)	130	2	15	30	12	9%					
UNIT 1/1-H (1-Bed)	130	2	15	30	12	9%					
UNIT 1/1-I (1-Bed)	145	2	15	30	12	8%					
UNIT 1/1-J (1-Bed)	130	2	15	30	12	9%					
UNIT 1/1-K (1-Bed)	130	2	15	30	12	9%					
UNIT 1/1-F (1-Bed)	115	2	15	30	12	10%					
UNIT 1/1-G (1-Bed)	115	2	15	30	12	10%					
UNIT 2/1-A (2-Bed)	210	3	15	45	20	10%					
UNIT 2/1-B (2-Bed)	210	3	15	45	20	10%					
UNIT 2/1-C (2-Bed)	260	3	15	45	20	8%					
UNIT 2/1-D (2-Bed)	260	3	15	45	20	8%					

GENERAL NOTES

- 1. ALL DUCTS AND VENTS PENETRATING EXTERIOR WALLS SHALL BE 26 GAUGE MINIMUM.
- 2. ALL DRYER DUCT MATERIAL SHALL HAVE A SMOOTH INTERIOR FINISH AND 0.016 INCH THINK. NO RIVETS OR SCREWS SHALL PENETRATE THE DUCT WALL. DRYER DUCT SHALL BE SUPPORT EVERY 4 FOOT INTERVALS.

KEYED NOTES

- 36x16 GREASE DUCT WITH 3" FIRE WRAP INSTALLED WITH CURRENT PROJECT. CONNECTION OF THE DUCTS AT LEVEL 1 AND THE ROOF WILL BE "FUTURE" CONNECTIONS.
- ② INTERMITTENT RANGE HOOD >300 CFM.
- 3 6" RANGE HOOD EXHAUST SUB-DUCT IN SHAFT, TERMINATE 22" UP IN SHAFT.

 4 4" BATHROOM EXHAUST SUB-DUCT IN SHAFT, TERMINATE 22"
- UP IN SHAFT.

 5 24x14 GREASE DUCT WITH 3" FIRE WRAP INSTALLED WITH CURRENT PROJECT. CONNECTION OF THE DUCTS AT LEVEL 1
- AND THE ROOF WILL BE "FUTURE" CONNECTIONS.


 (6) CONNECT DRYER DUCT TO DRYER DUCT MANAFOLD PER MANUFACTURES REQUIREMENTS. (TYPICAL 20)
- RELIEF LOUVER. PROVIDE COUNTER WEIGHTED BACKDRAFT DAMPER AT 0.05" DIFFERENTIAL PRESSURE.






Suite 300 503.221.2077

Portland OR 97209 www.lrsarchitects.com

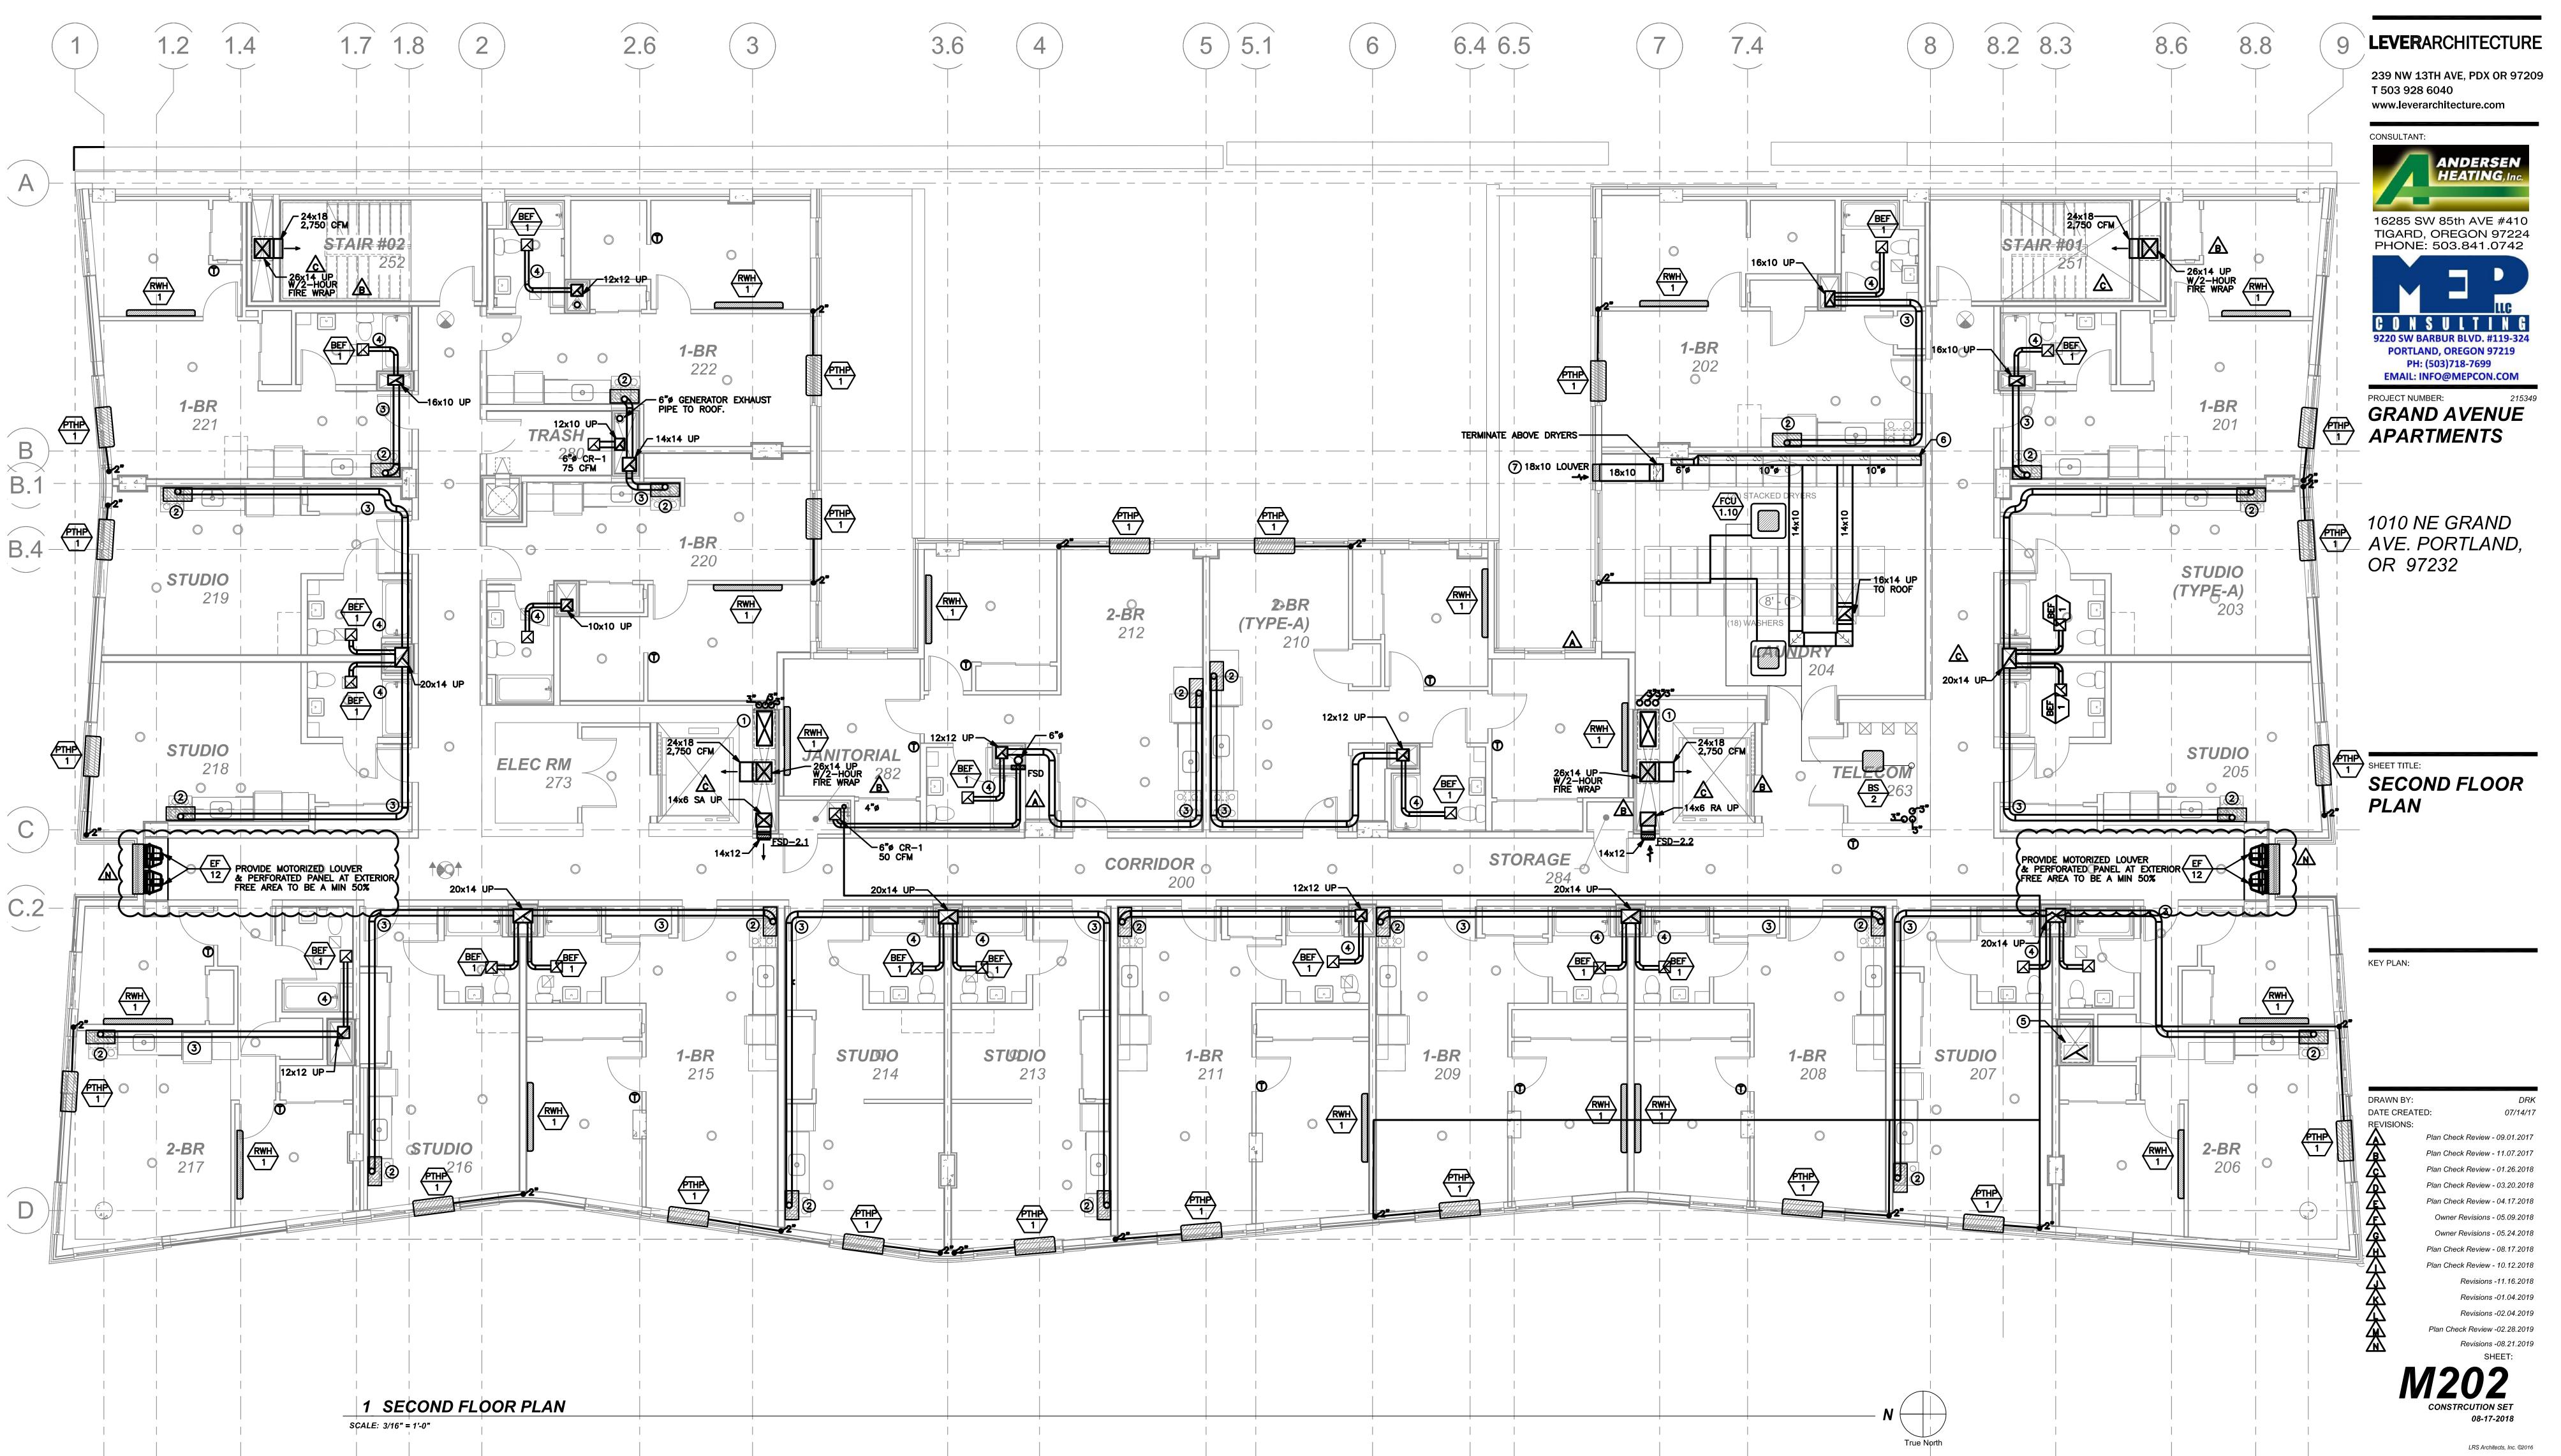

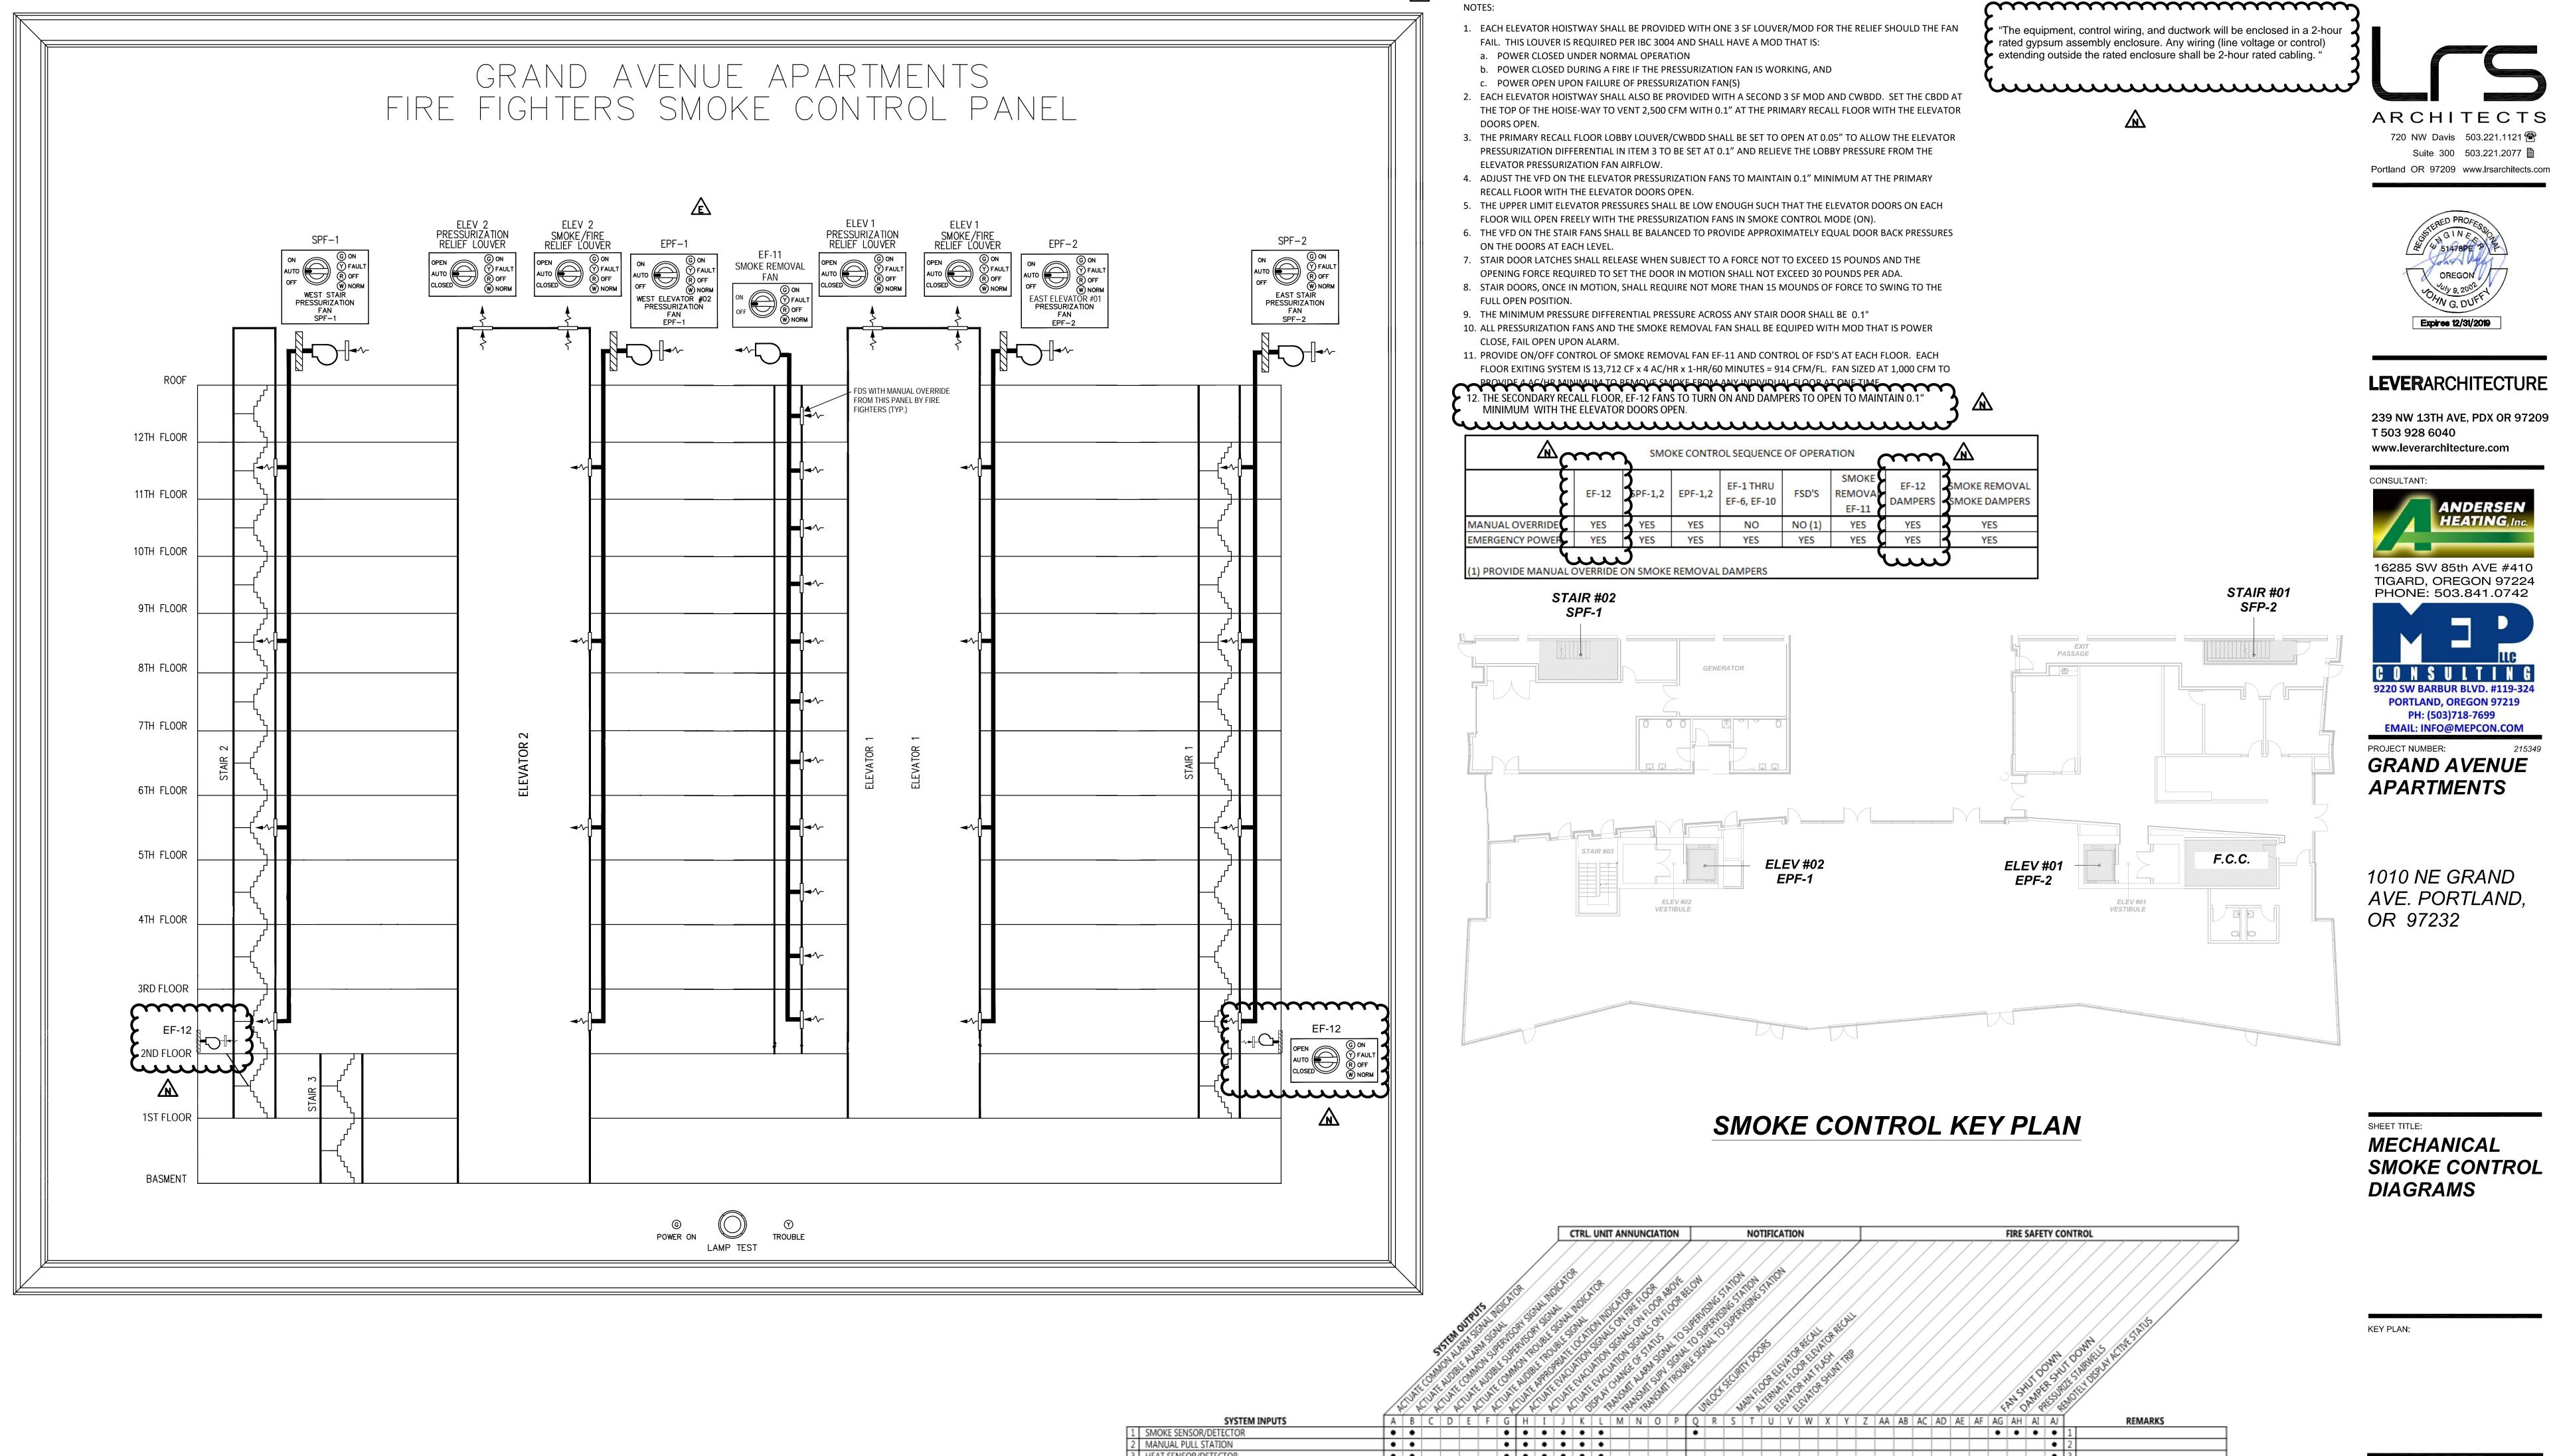

LAMINATE AND POST IN FIRE COMMAND CENTER

MAIN FLR. ELEV. LOBBY SMOKE DETECTOR EVATOR MECH, ROOM HEAT DETECTOR ELEVATOR MECH. ROOM SMOKE DETECTOR WATERFLOW SWITCH TAMPER SWITCH FIRE PUMP RUNNING FIRE PUMP POWER FROM ALTERNATE SOURCE FIRE PUMP PHASE LOSS/REVERSAL GENERATOR RUNNING GENERATOR FAULT FIRE ALARM AC POWER FAILURE O OPEN CIRCUIT OR GROUND FAULT FIRE ALARM SYSTEM LOW BATTERY CLASS B NOTIFICATION CIRCUIT (NAC) - SHORT DAS ANTENNA MALFFUNCTION 24 DAS SIGNAL BOOST FAILURE 5 DAS LOW BATT CAPACITY DAS LOSS OF AC 28 IP COMMUNICATOR - TROUBLE 9 IP COMMUNICATOR - COMM LOSS | | | • | • | | | • | 0 WATER STORAGE TANK LEVEL A B C D E F G H I J K L M N O P Q R S T U V W X Y Z AA AB AC AD AE AF AG AH AI AJ



LEVERARCHITECTURE

239 NW 13TH AVE, PDX OR 97209



PHONE: 503.841.0742 **PORTLAND, OREGON 97219**

GRAND AVENUE APARTMENTS

1010 NE GRAND AVE. PORTLAND,

MECHANICAL SMOKE CONTROL

DATE CREATED:

Plan Check Review - 09.01.2017 Plan Check Review - 11.07.2017 Plan Check Review - 01.26.2018 Plan Check Review - 04.17.2018 Owner Revisions - 05.09.2018 Owner Revisions - 05.24.2018 Plan Check Review - 08.17.2018 Plan Check Review - 10.12.2018

Revisions -11.16.2018 Revisions -01.04.2019 Revisions -02.04.2019 Plan Check Review -02.28.2019

Revisions -08.21.2019

LRS Architects, Inc. ©2016

08-17-2018