

Development Services

From Concept to Construction

Phone: 503-823-7300 Email: bds@portlandoregon.gov 1900 SW 4th Ave, Portland, OR 97201

More Contact Info (<http://www.portlandoregon.gov/bds/article/519984>)



APPEAL SUMMARY

Status: Hold for Additional Information - Reconsideration of ID 22001

Appeal ID: 22157

Project Address: 5510 N Denver Ave

Hearing Date: 11/20/19

Appellant Name: LUCY O'SULLIVAN

Case No.: B-019

Appellant Phone: 5032342945

Appeal Type: Building

Plans Examiner/Inspector: Robert Keal

Project Type: commercial

Stories: 4 **Occupancy:** M, S-2, R-2 **Construction Type:** V-A

Building/Business Name: Kaya Camilla

Fire Sprinklers: Yes - entire building

Appeal Involves: Reconsideration of appeal

LUR or Permit Application No.: 18-272167-CO

Plan Submitted Option: pdf [File 1] [File 2] [File 3]
[File 4] [File 5] [File 6] [File 7]

Proposed use: Mixed-use Development

APPEAL INFORMATION SHEET

Appeal item 1

Code Section

OSSC 704.2

Requires

704.2 requires: Where columns are required to have protection to be fire-resistance rated, the entire column shall be provided individual encasement protection by protecting it on all sides for the full column length, including connections to other structural members, with materials having the required fire-resistance rating.

Proposed Design

The proposed design will allow for posts and columns occurring in walls to be protected from fire by the fire—resistance rating of the wall, in accordance with forthcoming OSSC 2019 code update.

RECONSIDERATION TEXT:

The proposed design will allow for posts and columns occurring in walls to be protected from fire by the fire—resistance rating of the wall, in accordance with forthcoming OSSC 2019 code update.

We have split the appeal into 2 parts, (1) wood posts and (2) steel posts for clarity and to make the exhibits and associated details easier to track.

We have corresponded with both the life safety plans examiner, Robert Keal, and the structural plans examiner, Kevin White, in the preparation of the revised markups and details. We were asked to provide specific revised details demonstrating the ability to encapsulate the column completely within the top and bottom plate of the wall.

1/ Wood Posts

There are (2) conditions for the wood posts; with glu-lam beam above, and no beam above. Exhibits 1&2 show architectural and structural L1 plans with each a markup calling out the condition of each wood post, and referencing the details for head and base conditions.

We were asked to demonstrate that the wood posts in both conditions meet the requirement that the column be completely within the top and bottom plate of the wall, and that the base plate is wood. The detail shown on 12/s6.01 on Exhibit 6 shows the base detail for both conditions. The post sits on a pressure-treated wood plate which sits fully within the wall.

The details shown on a8.01, Exhibit 5, details 12 and 13 show the head details for the condition with and without glulam beam.

We were also asked to demonstrate that the post can be in-line with the wall, which is now the case with the revised details (previously the gypsum wrap was pushing the post out of line with the wall).

2/ Steel Posts

We were asked to demonstrate that the base plate for the posts would rest on a wood bottom plate, not grout. A revised sketch detail is provided that demonstrates this, exhibit 7.

Exhibit 3 shows each steel post marked up to show the rating requirement within the wall. A number of posts cannot meet the requirements to encapsulate the base plate, and these posts are indicated in the markup.

Exhibit 4 shows the structural plan with markups indicating the base plate revisions required to withstand wood crushing for the wood bottom plate. Kevin White, the structural reviewer, has reviewed the detail and indicated that the concept is feasible provided a revision to the permitted drawings be submitted and approved; the structural calculations submitted with this revision will address the sizing and anchorage of the revised steel base plates, and crushing of the wood sill plate for all updated/ revised conditions.

EXHIBITS:

EXHIBIT 1a2.00Architectural L1 -Wood posts

EXHIBIT 2s2.00Structural L1 - Wood posts

EXHIBIT 3a2.00Architectural L1 -Steel posts

EXHIBIT 4s2.01Structural L1 - Steel postS

EXHIBIT 5a8.01DETAILS

EXHIBIT 6s6.01DETAIL

EXHIBIT 7 - SSK - 001 Steel Post on 2x bottom plate

Reason for alternative OSSC 2019 will adopt IBC 2018 Section 704 in its entirety, specifically section 704.4.1 which states « Studs, Columns and boundary elements that are integral elements in walls of light-frame construction and are located entirely between the top and bottom plates or tracks shall be permitted to have required fire-resistance ratings provided by the membrane protection provided for the wall. »

This code section has been successfully appealed on other projects in the City of Portland.


APPEAL DECISION

Fire rated protection of columns fully contained within fire rated wall membrane per 2018 IBC: Hold for additional information.

Appellant may contact John Butler (503 823-7339) with questions.

Additional information is submitted as a no fee reconsideration, following the same submittal process and using the same appeals form as the original appeal. Indicate at the beginning of the appeal form that you are filing a reconsideration and include the original assigned Appeal ID number. The reconsideration will receive a new appeal number.

Include the original attachments and appeal language. Provide new text with only that information that is specific to the reconsideration in a separate paragraph(s) clearly identified as "Reconsideration Text" with any new attachments also referenced. No additional fee is required.

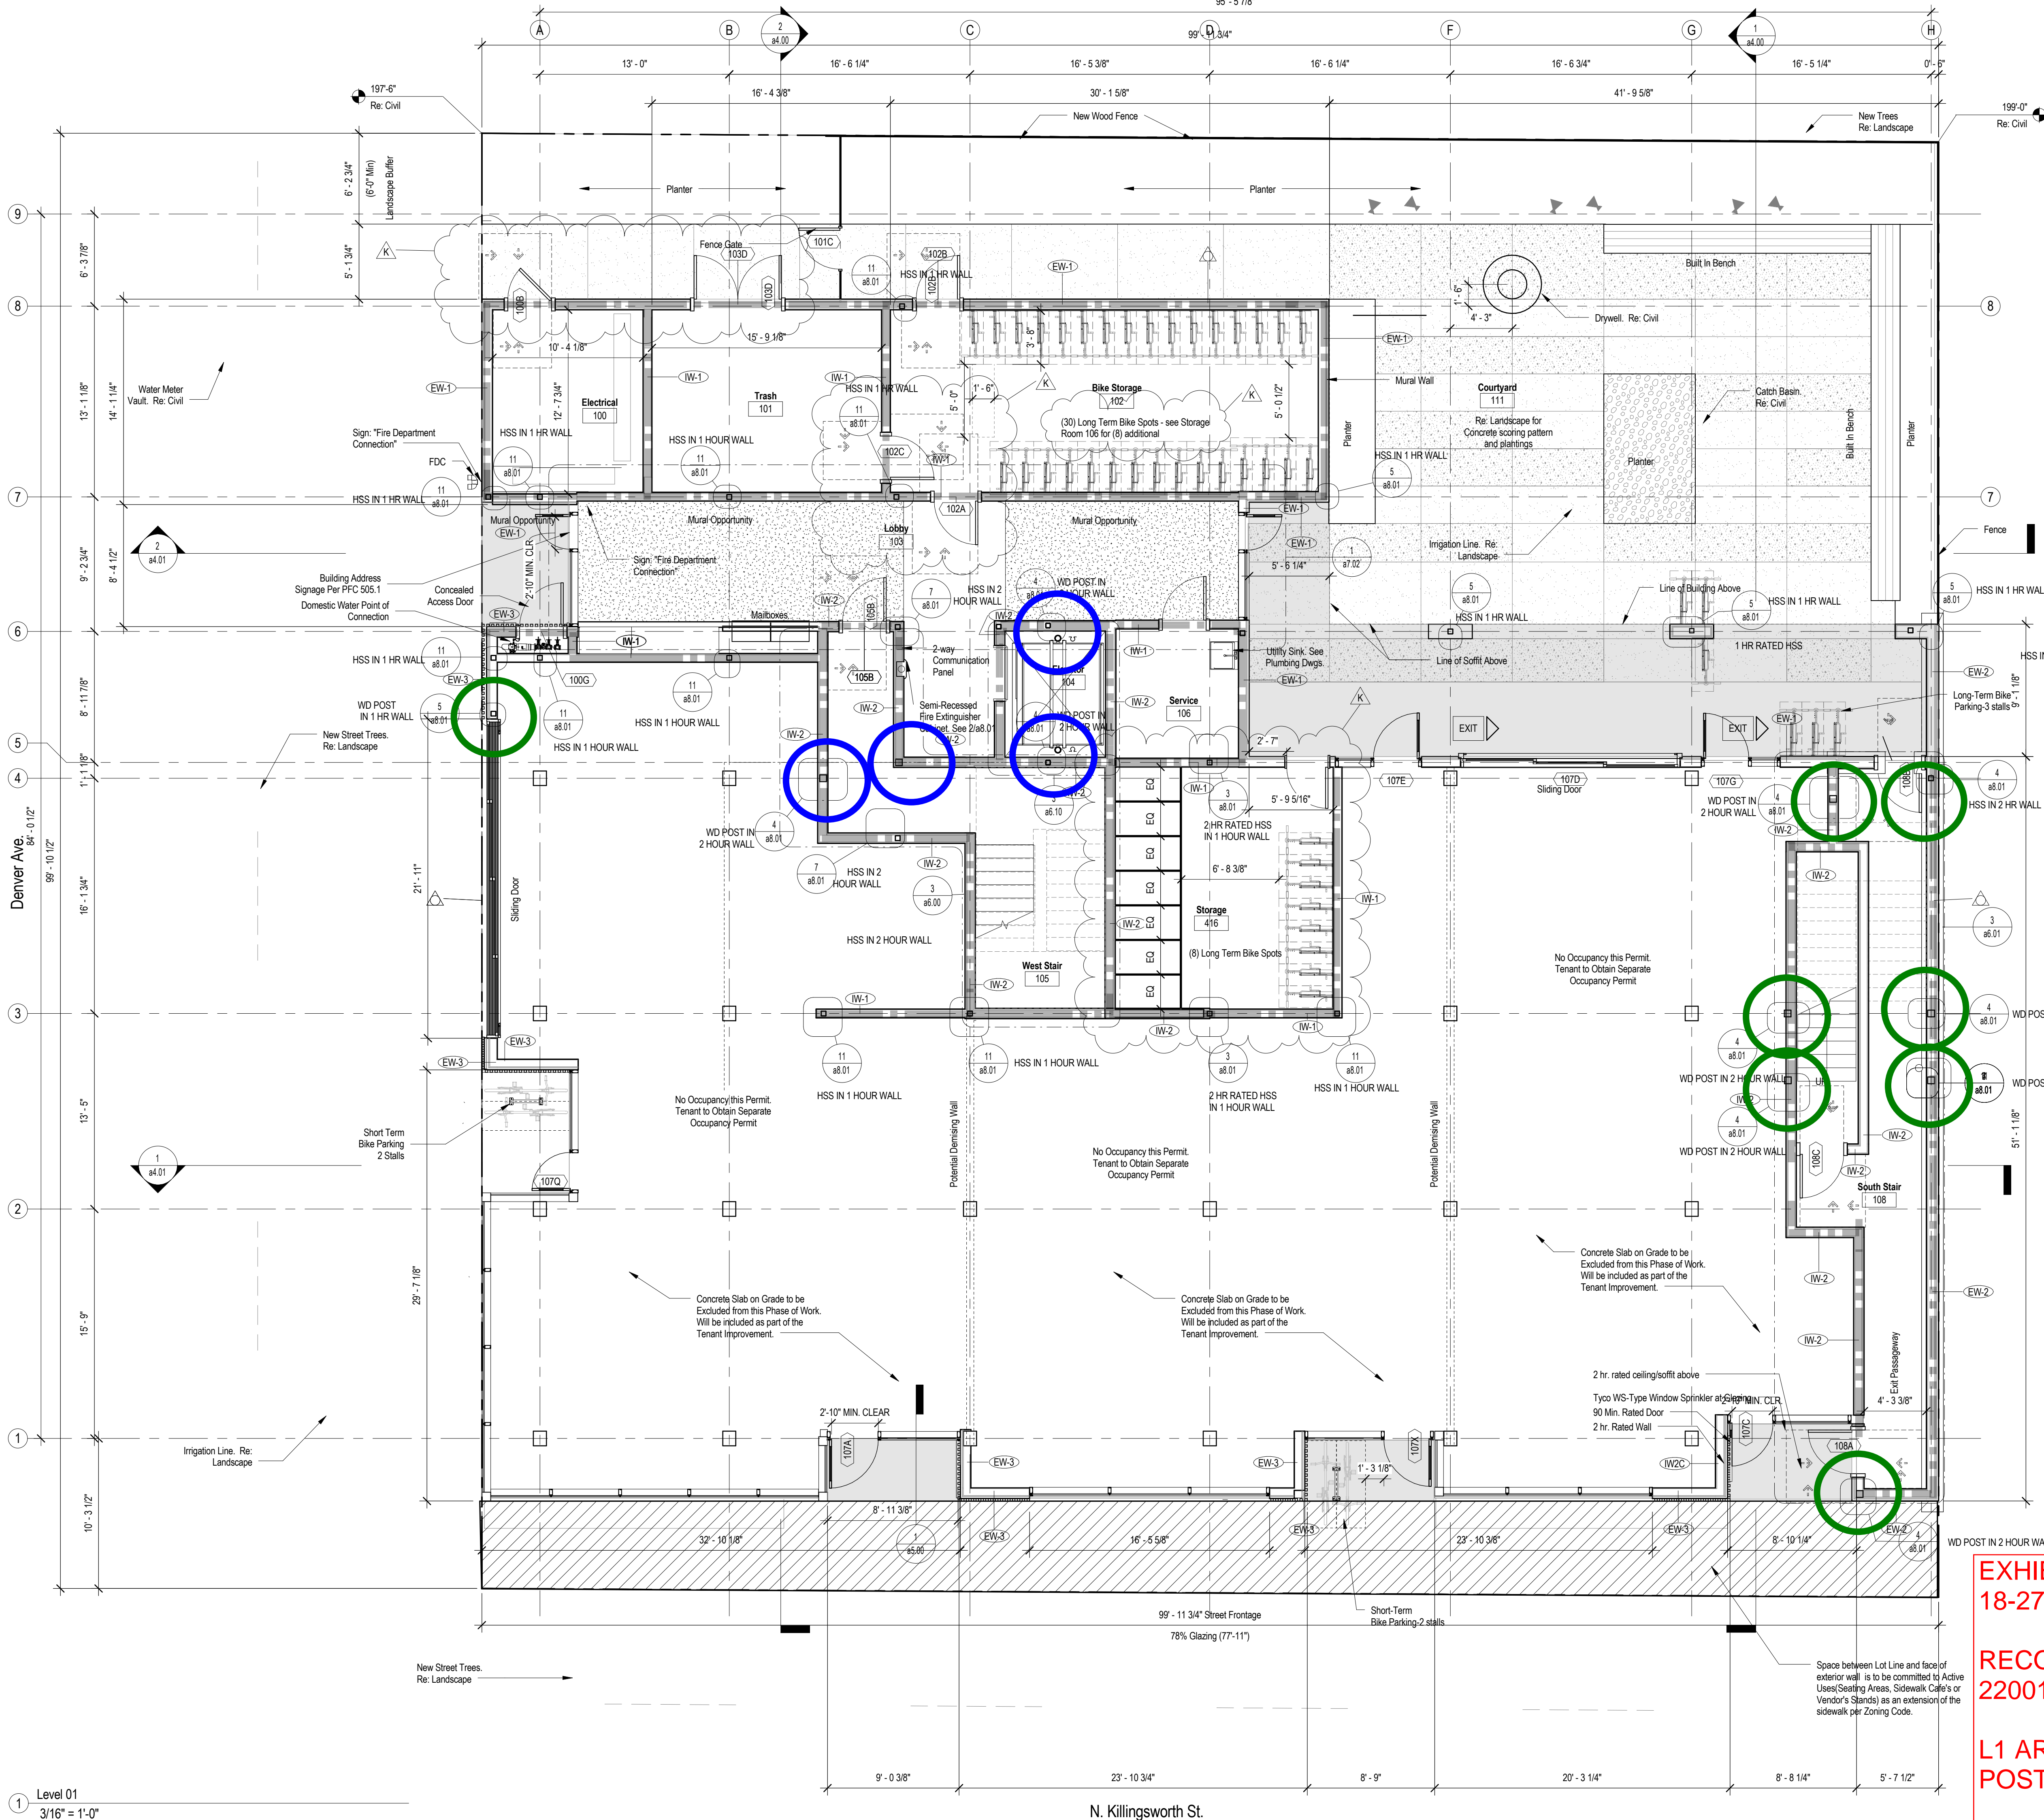

KEY

WOOD POST WITHIN 2-HR FIRE-RATED WALL ASSEMBLY WITH GLULAM BEAM ABOVE:
REF DETAILS
12/ a8.01 (head) -EXHIBIT 3
12/s6.01 (base) - EXHIBIT 4

WOOD POST WITHIN 2-HR FIRE-RATED WALL ASSEMBLY WITH NO GLULAM BEAM ABOVE:
REF DETAILS
13/a8.01 (head) - EXHIBIT 3
12/s6.01 (base) -EXHIBIT 4

REFERENCE DETAIL 4/a8.01 ON EXHIBIT 3 FOR POST WITHIN 2-HR WALL FOR ALL MARKED UP POSTS

Legend

EXIT

Wall Mounted Directional Exit Sign

1 Hour Fire Partition

2 Hour Fire Barrier

Area Schedule (Occupancy and Egress Plans)	
Name	Area
Area	595 SF
Bike Room	478 SF
Corridor 4	595 SF
Corridor 4	595 SF
Courtyard	1890 SF
Electrical	169 SF
Exit	419 SF
Exit	368 SF
Lobby	489 SF
Parking	Not Placed
Retail 1	1812 SF
Retail 2	1213 SF
Retail 3	1318 SF
S-1 Storage	243 SF
Storage	79 SF
Trash	159 SF
Unit 200	460 SF
Unit 201	462 SF
Unit 202	478 SF
Unit 203	736 SF
Unit 206	632 SF
Unit 207	543 SF
Unit 209	479 SF
Unit 210	473 SF
Unit 211	472 SF
Unit 212	472 SF
Unit 213	472 SF
Unit 214	484 SF
Unit 300	460 SF
Unit 301	462 SF
Unit 302	478 SF
Unit 303	736 SF
Unit 306	632 SF
Unit 307	543 SF
Unit 309	479 SF
Unit 310	473 SF
Unit 311	472 SF
Unit 312	472 SF

W.P.A

works progress architecture

811 SE Stark Street, Suite 210
Portland OR, 97214
(503) 234-2945
www.worksarchitecture.net

Killingsworth N D Block

W.P.A Job Number 1232

© 2018 Works Progress Architecture, LLP
ALL RIGHTS RESERVED
All drawings are the property of Works Progress Architecture LLP and are not to be used or reproduced in any manner without prior written permission.

Sheet 8
Sheet 9

REGISTERED ARCHITECT
CARRIE STRICKLAND
PORTLAND, OR
4952

Permit Set

11.28.2018

Floor Plan -
Level 01

a2.00

SET ISSUE

1/22/19	Revision A
2/7/19	Revision B
2/28/19	Revision C
Date 4	Revision D
06/19/19	Revision E
9/18/19	ASI-002
9/25/19	Permit Revision 02

EXHIBIT 1: ARCHITECTURAL PLAN L1
18-272167-CO

RECONSIDERATION OF APPEAL ID:
22001

L1 ARCHITECTURAL PLAN - WOOD
POST MARKUP

FOUNDATION PLAN NOTES:

FOUNDATION NOTES:


- STRUCTURAL GENERAL NOTES, DESIGN CRITERIA, ABBREVIATIONS AND LEGEND PER s1.00, s1.01, s1.02 AND s1.03.
- VERIFY ALL DIMENSIONS AND ELEVATIONS WITH THE ARCHITECTURAL DRAWINGS.
- CONTRACTOR SHALL LOCATE AND VERIFY THE FOLLOWING WITH OTHERS PRIOR TO POURING CONCRETE:
ALL DOOR OPENINGS IN FOUNDATION WALLS; DRAINS AND SLOPES; BLOCKOUTS FOR (POOLS, SPAS, FREEZERS, COOLERS, PLUMBING, SPRINKLERS AND HVAC); ALL DUCTS, CHASES AND PIPES PER MECHANICAL, PLUMBING, ELECTRICAL AND SPRINKLER DRAWINGS, STAIR DETAILS AND GUARDRAILS PER ARCHITECTURAL DRAWINGS. CONCRETE CURBS AND LOCATIONS PER ARCHITECTURAL REPORT.
- TOP OF SLAB (T/SLAB) ELEVATION ASSUMED 0'-0", FOR ACTUAL T/SLAB ELEVATION REFER TO CIVIL AND ARCHITECTURAL DRAWINGS. PROVIDE 6 MIL VAPOR BARRIER BELOW SLAB AT INTERIOR SPACES. PROVIDE FREE-DRAINING GRANULAR FILL PER GEOTECH REPORT.
- TYPICAL TOP OF INTERIOR (I/INTERIOR) FOOTING ELEVATION = -0'-6", UNO. TYPICAL TOP OF EXTERIOR (E/EXTERIOR) FOOTING ELEVATIONS = -0'-8", UNO.
- ALL FOOTINGS AND SLABS TO BEAR ON COMPETENT NATIVE SOIL AND/OR STRUCTURAL FILL. SUBGRADE PREPARATION, STRUCTURAL FILL, FOOTING DRAINS, AND OTHER REQUIREMENTS PER GEOTECH REPORT AS NOTED IN THE STRUCTURAL GENERAL NOTES.
- CJ INDICATES CONTROL JOINT PER PLAN.
- CONTRACTOR TO VERIFY TOP OF CONCRETE (T/CONC) WALL ELEVATIONS ON ALL PARTIAL HEIGHT RETAINING WALLS. MAINTAIN T/WALL ELEVATION A MINIMUM OF 8" ABOVE FINISH GRADE PER 12/s4.01.
- ALL WOOD EXPOSED TO CONCRETE, WEATHER, OR WITHIN 8" OF FINISHED GRADE SHALL BE PRESSURE-TREATED.
- MOISTURE PROOF ALL CONCRETE STEM AND BASEMENT WALLS PER ARCHITECT.
- TYPICAL DETAILS PER:

1/s4.00	STANDARD HOOKS AND BAR BENDS
3/s4.00	TYPICAL ANCHOR BOLT SCHEDULE
4/s4.00	TYPICAL LAP SPLICE AND DEVELOPMENT LENGTH SCHEDULE
5/s4.00	PIPE OR CONDUIT EMBEDDED IN SLAB ON GRADE
6/s4.00	TYPICAL CORNER REINFORCING AT CORNER FOOTING
7/s4.00	TYPICAL STEPPED FOOTING
5/s4.01	TYPICAL BASE PLATE CONFIGURATIONS
10/s4.01	TYPICAL PIPE AND TRENCH LOCATIONS AT CONCRETE STEM/WALL/FTG
9/s4.01	TYPICAL BASEPLATE TO CONCRETE WALL
7/s4.01	TYPICAL THICKENED SLAB EDGE

STUD AND SHEAR WALL NOTES:


- LUMBER GRADE PER STRUCTURAL GENERAL NOTES.
- BALLOON FRAME ALL WALLS GREATER THAN ONE LEVEL 10'-0" WITH (2) 2x @ 16"OC.
- ALL INTERIOR NON-BEARING, NON-STRUCTURAL WALL STUD REQUIREMENTS PER STRUCTURAL GENERAL NOTES.
- HEADERS SHOWN ON FRAMING PLAN SHALL BE SUPPORTED BY (1) TRIMMER AND (1) KING STUD MINIMUM, UNO. WHERE MORE THAN (1) TRIMMER IS REQUIRED, THE NUMBER OF TRIMMER STUDS SHALL BE NOTED THUS: ■(2) TRIMMERS TO BE CONTINUOUS TO THE FOUNDATION. BLOCK SOLID AT FLOOR FRAMING.
- BEAMS SHOWN ON FRAMING PLAN SHALL BE SUPPORTED BY (2) BUNDLED STUDS MINIMUM, UNO. WHERE MORE THAN (2) BUNDLED STUDS ARE REQUIRED, THE NUMBER OF BUNDLED STUDS SHALL BE NOTED THUS: ■(3). BUNDLED STUDS TO BE CONTINUOUS TO THE FOUNDATION. BLOCK SOLID AT FLOOR FRAMING.
- SHEAR WALL AND NAILING REQUIREMENTS PER SHEAR WALL SCHEDULE 5/s6.00.
- ALL EXTERIOR WALLS REQUIRING WOOD SHEATHING PER ARCHITECT SHALL BE SHEAR WALL TYPE W6 UNO.
- AT STAGGERED STUD WALLS, BUNDLED STUDS, TRIMMER STUDS, KING STUDS AND SHEAR WALL COMPRESSION STUDS ARE TO MATCH THE WIDTH OF WALL PLATES.
- HD (2) 2x INDICATES HOLD-DOWN TYPE PER HOLD-DOWN SCHEDULE 9/s6.01. CIRCLED NUMBER INDICATES NUMBER OF TRIM STUDS REQUIRED AND BOTTOM NUMBER INDICATES NUMBER OF FULL HEIGHT (KING) STUDS REQUIRED IN ADDITION TO BUNDLED OR TRIM STUDS OR POSTS SHOWN ON PLAN.
- XXT INDICATES TENSION LOADS REQUIRED (IN KIPS), CIRCLED NUMBER INDICATES NUMBER OF STUDS REQUIRED FOR TDS HOLD-DOWN.
- TYPICAL HOLD-DOWN ELEVATION PER 5/s6.01 AND 12/s6.01.
- ANCHOR BOLTS TO BE 5/8" DIA x 7" MINIMUM EMBEDMENT PER 10/s6.00. PROVIDE HOT-DIPPED GALVANIZED ANCHOR BOLTS AT PRESSURE-TREATED SILL PLATES. HOT-DIPPED GALVANIZED ANCHOR BOLTS ARE NOT REQUIRED AT SODIUM BORATE PRESSURE-TREATED PLATES PER STRUCTURAL GENERAL NOTES.
- INDICATES WOOD POST OR GLULAM COLUMN. FOR RECTANGULAR GLULAM COLUMNS, ARROWS INDICATE ORIENTATION OF LONG SIDE OF COLUMN.
- TYPICAL DETAILS PER:

7/s6.00	TYPICAL STUD WALL OPENING (HEADER) DETAIL
3/s6.00	TYPICAL TOP PLATE SPLICE DETAIL
8/s6.00	TYPICAL HOLES AND NOTCHES IN WOOD STUDS
1 & 11/s6.01	TYPICAL SHEAR WALL ELEVATION
5/s6.04	TYPICAL INTERIOR STAIRWELL ELEVATION
9 & 10/s6.04	NON-STRUCTURAL PARTITION WALL CONNECTION
12/s6.00	PLAN - INTERSECTING SHEAR WALLS

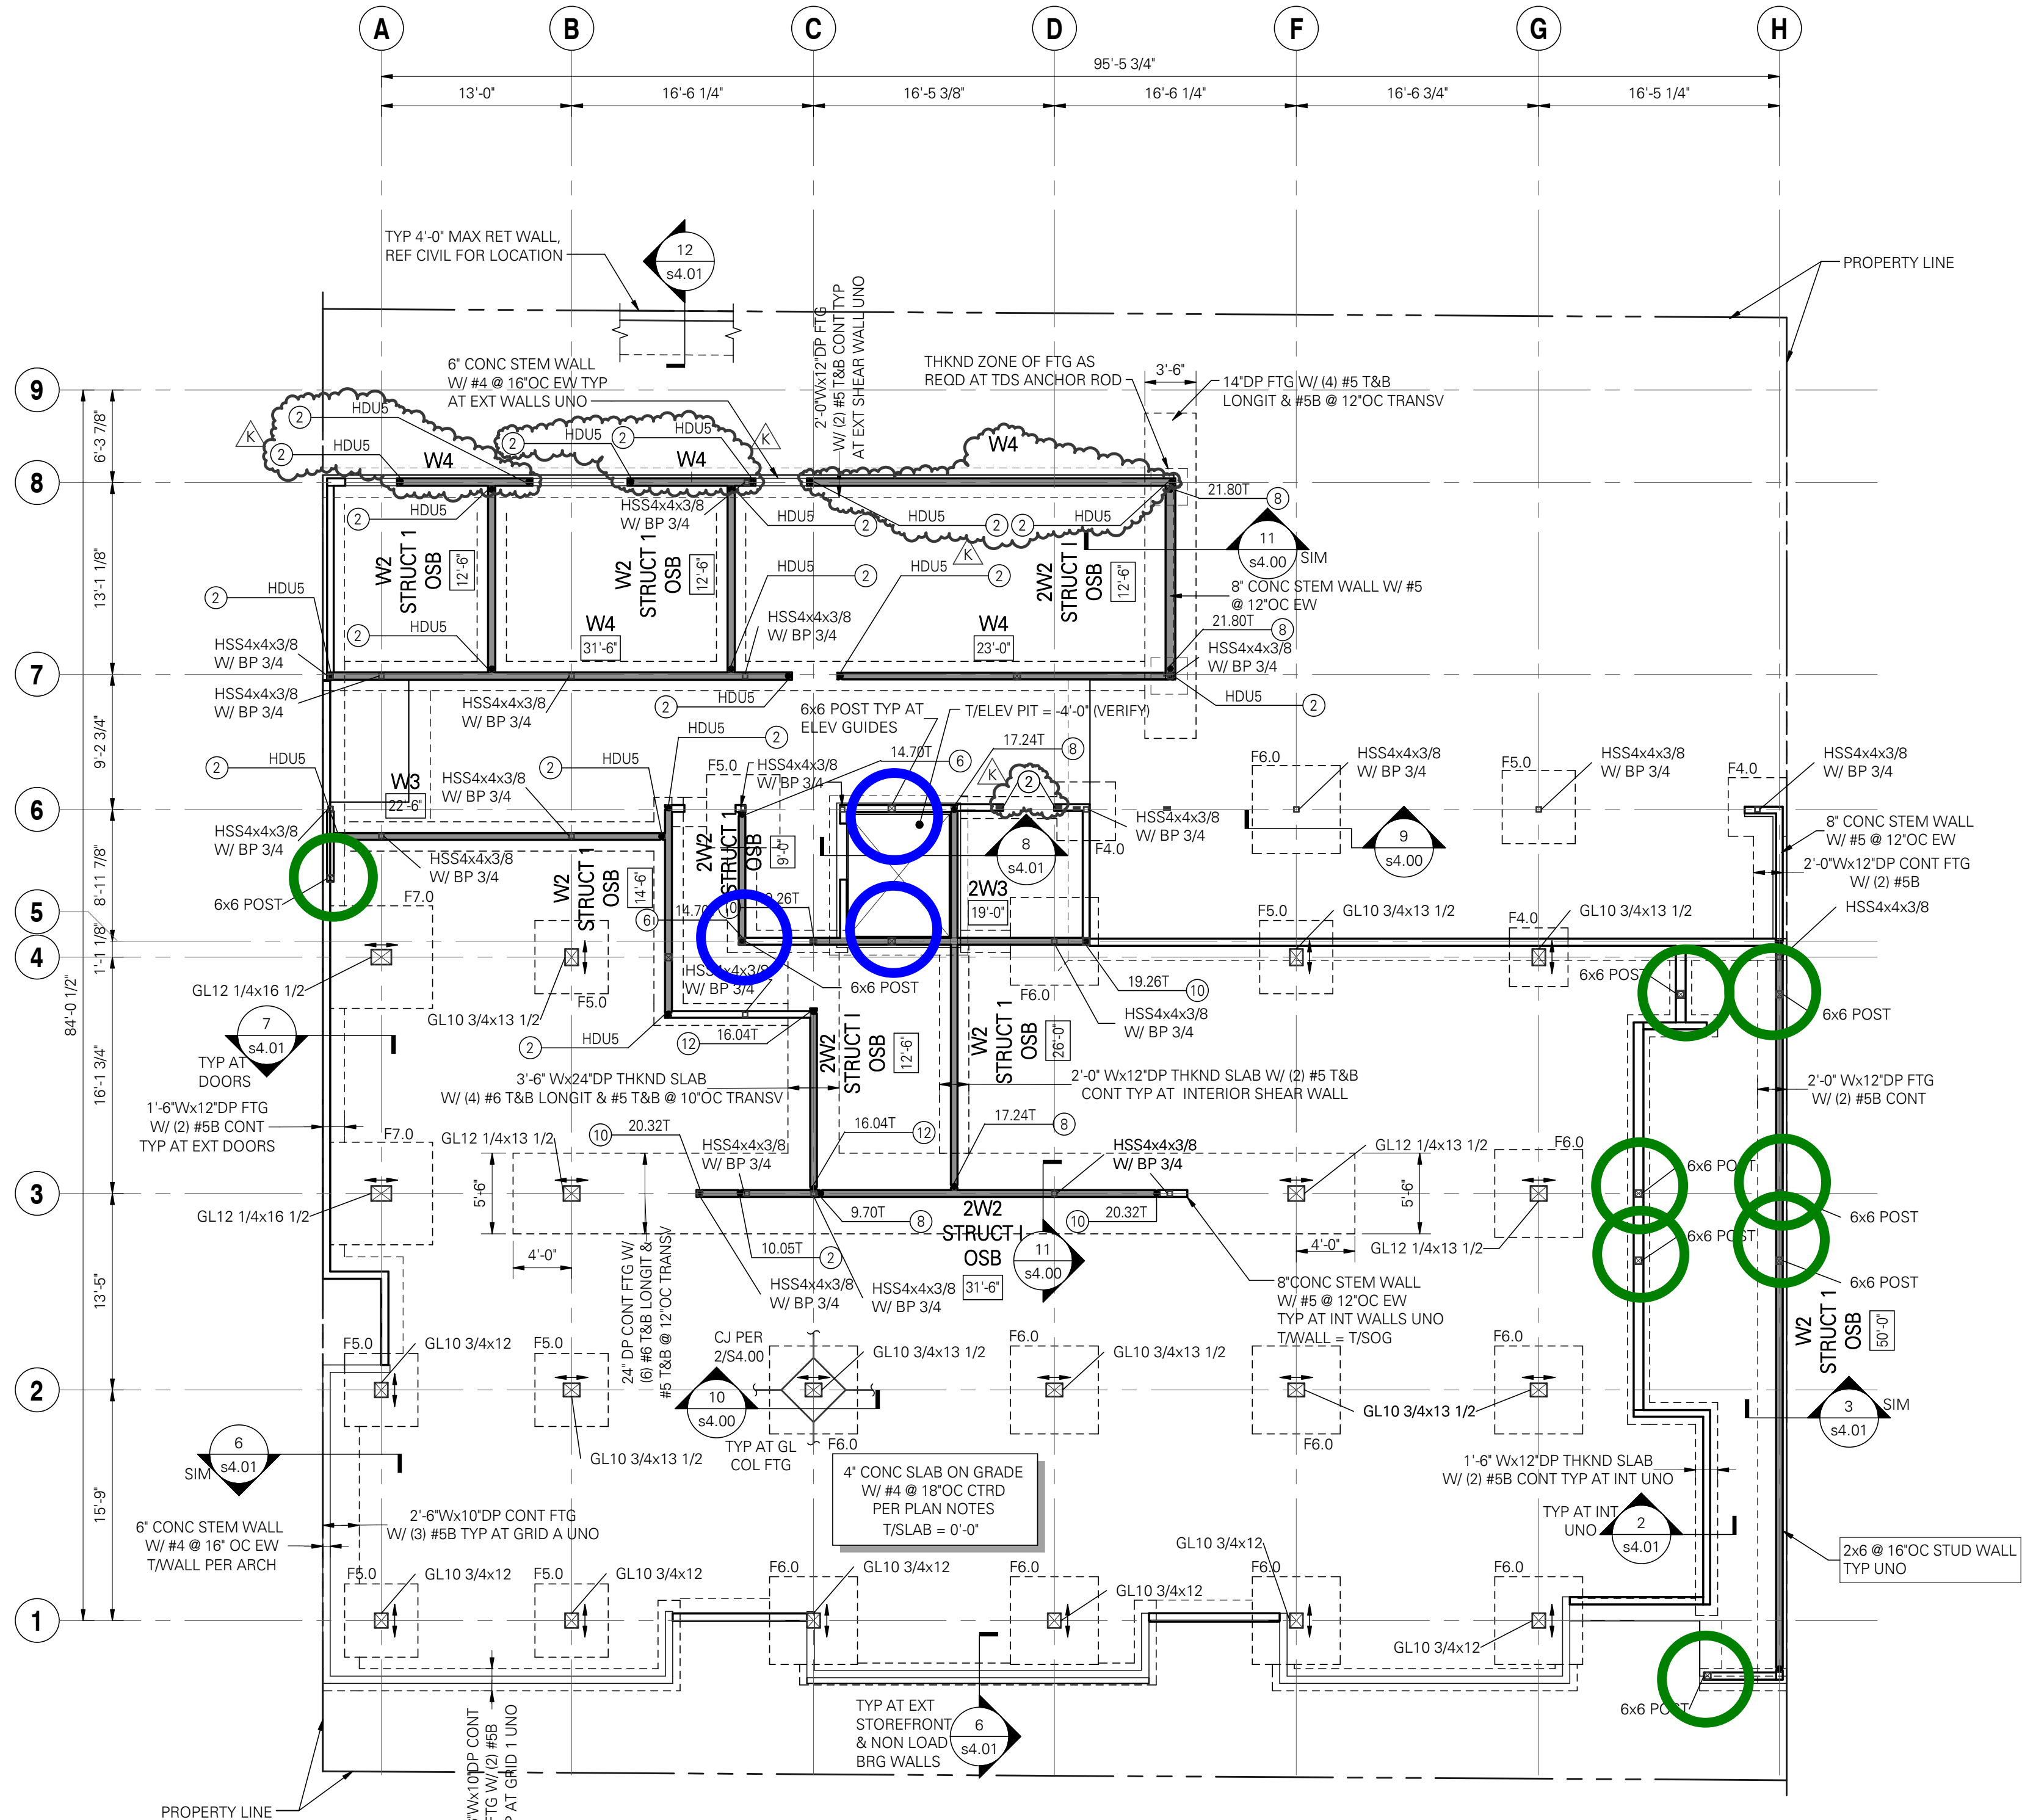


SPREAD FOOTING SCHEDULE					
TYPE	LENGTH	WIDTH	DEPTH	REINFORCING	COMMENTS
F4.0	4'-0"	4'-0"	1'-0"	(5) #5B EW	---
F5.0	5'-0"	5'-0"	1'-2"	(6) #5B EW	---
F6.0	6'-0"	6'-0"	1'-4"	(7) #6B EW	---
F7.0	7'-0"	7'-0"	1'-6"	(8) #6B EW	---

KEY

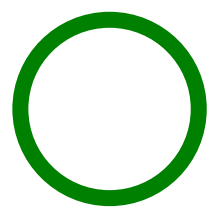

WOOD POST WITHIN
FIRE-RATED WALL
ASSEMBLY WITH GLULAM
BEAM ABOVE:
REF DETAILS
12/ a8.01 (head) - EXHIBIT 3
12/s6.01 (base) - EXHIBIT 4

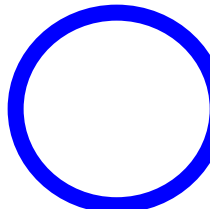

WOOD POST WITHIN
FIRE-RATED WALL
ASSEMBLY WITH NO
GLULAM BEAM ABOVE:
REF DETAILS
xxxxxx (head) - EXHIBIT 3
12/s6.01 (base) - EXHIBIT 4

REFERENCE DETAIL 4/a8.01 ON
EXHIBIT 3 FOR POST WITHIN 2-HR
WALL FOR ALL MARKED UP POSTS

W.P.A

works progress architecture

811 SE Stark Street, Suite 210
Portland OR, 97214
(503) 234-2945
www.worksarchitecture.net

Killingsworth N D
Block

1935 N. Killingsworth St. Portland, OR
DCI Job Number 18031-0010



11.28.2018

PERMIT SET

EDCI
ENGINEERS®

921 SW Washington Street, Suite 560
Portland, Oregon 97205
P: (503) 242-2448 www.dci-engineers.com
© Copyright 05.2018 © Amato Conversano Inc. All Rights Reserved
This document and the ideas and designs may not be reused, in whole or
in part, without written permission from D'Amato Conversano Inc. or Amato
Conversano Inc. All other rights are reserved for its unauthorised use.

SET ISSUE

A	02/21/2019	Revision 1
C	03/19/2019	Revision C
D	04/18/2019	Revision D
F	05/09/2019	Revision F
G	05/24/2019	Revision G
H	06/13/2019	Plan Check
J	09/04/2019	Revision J
K	09/25/2019	Permit Revision

EXHIBIT 2: STRUCTURAL PLAN L1
18-272167-CO

RECONSIDERATION OF APPEAL ID:
22001

L1 STRUCTURAL PLAN - MARKUP


STRUCTURAL FOUNDATION, STUD AND SHEAR WALL PLAN

SCALE: 1/8" = 1'-0"



STRUCTURAL
FOUNDATION,
STUD AND
SHEAR WALL
PLAN

s2.00

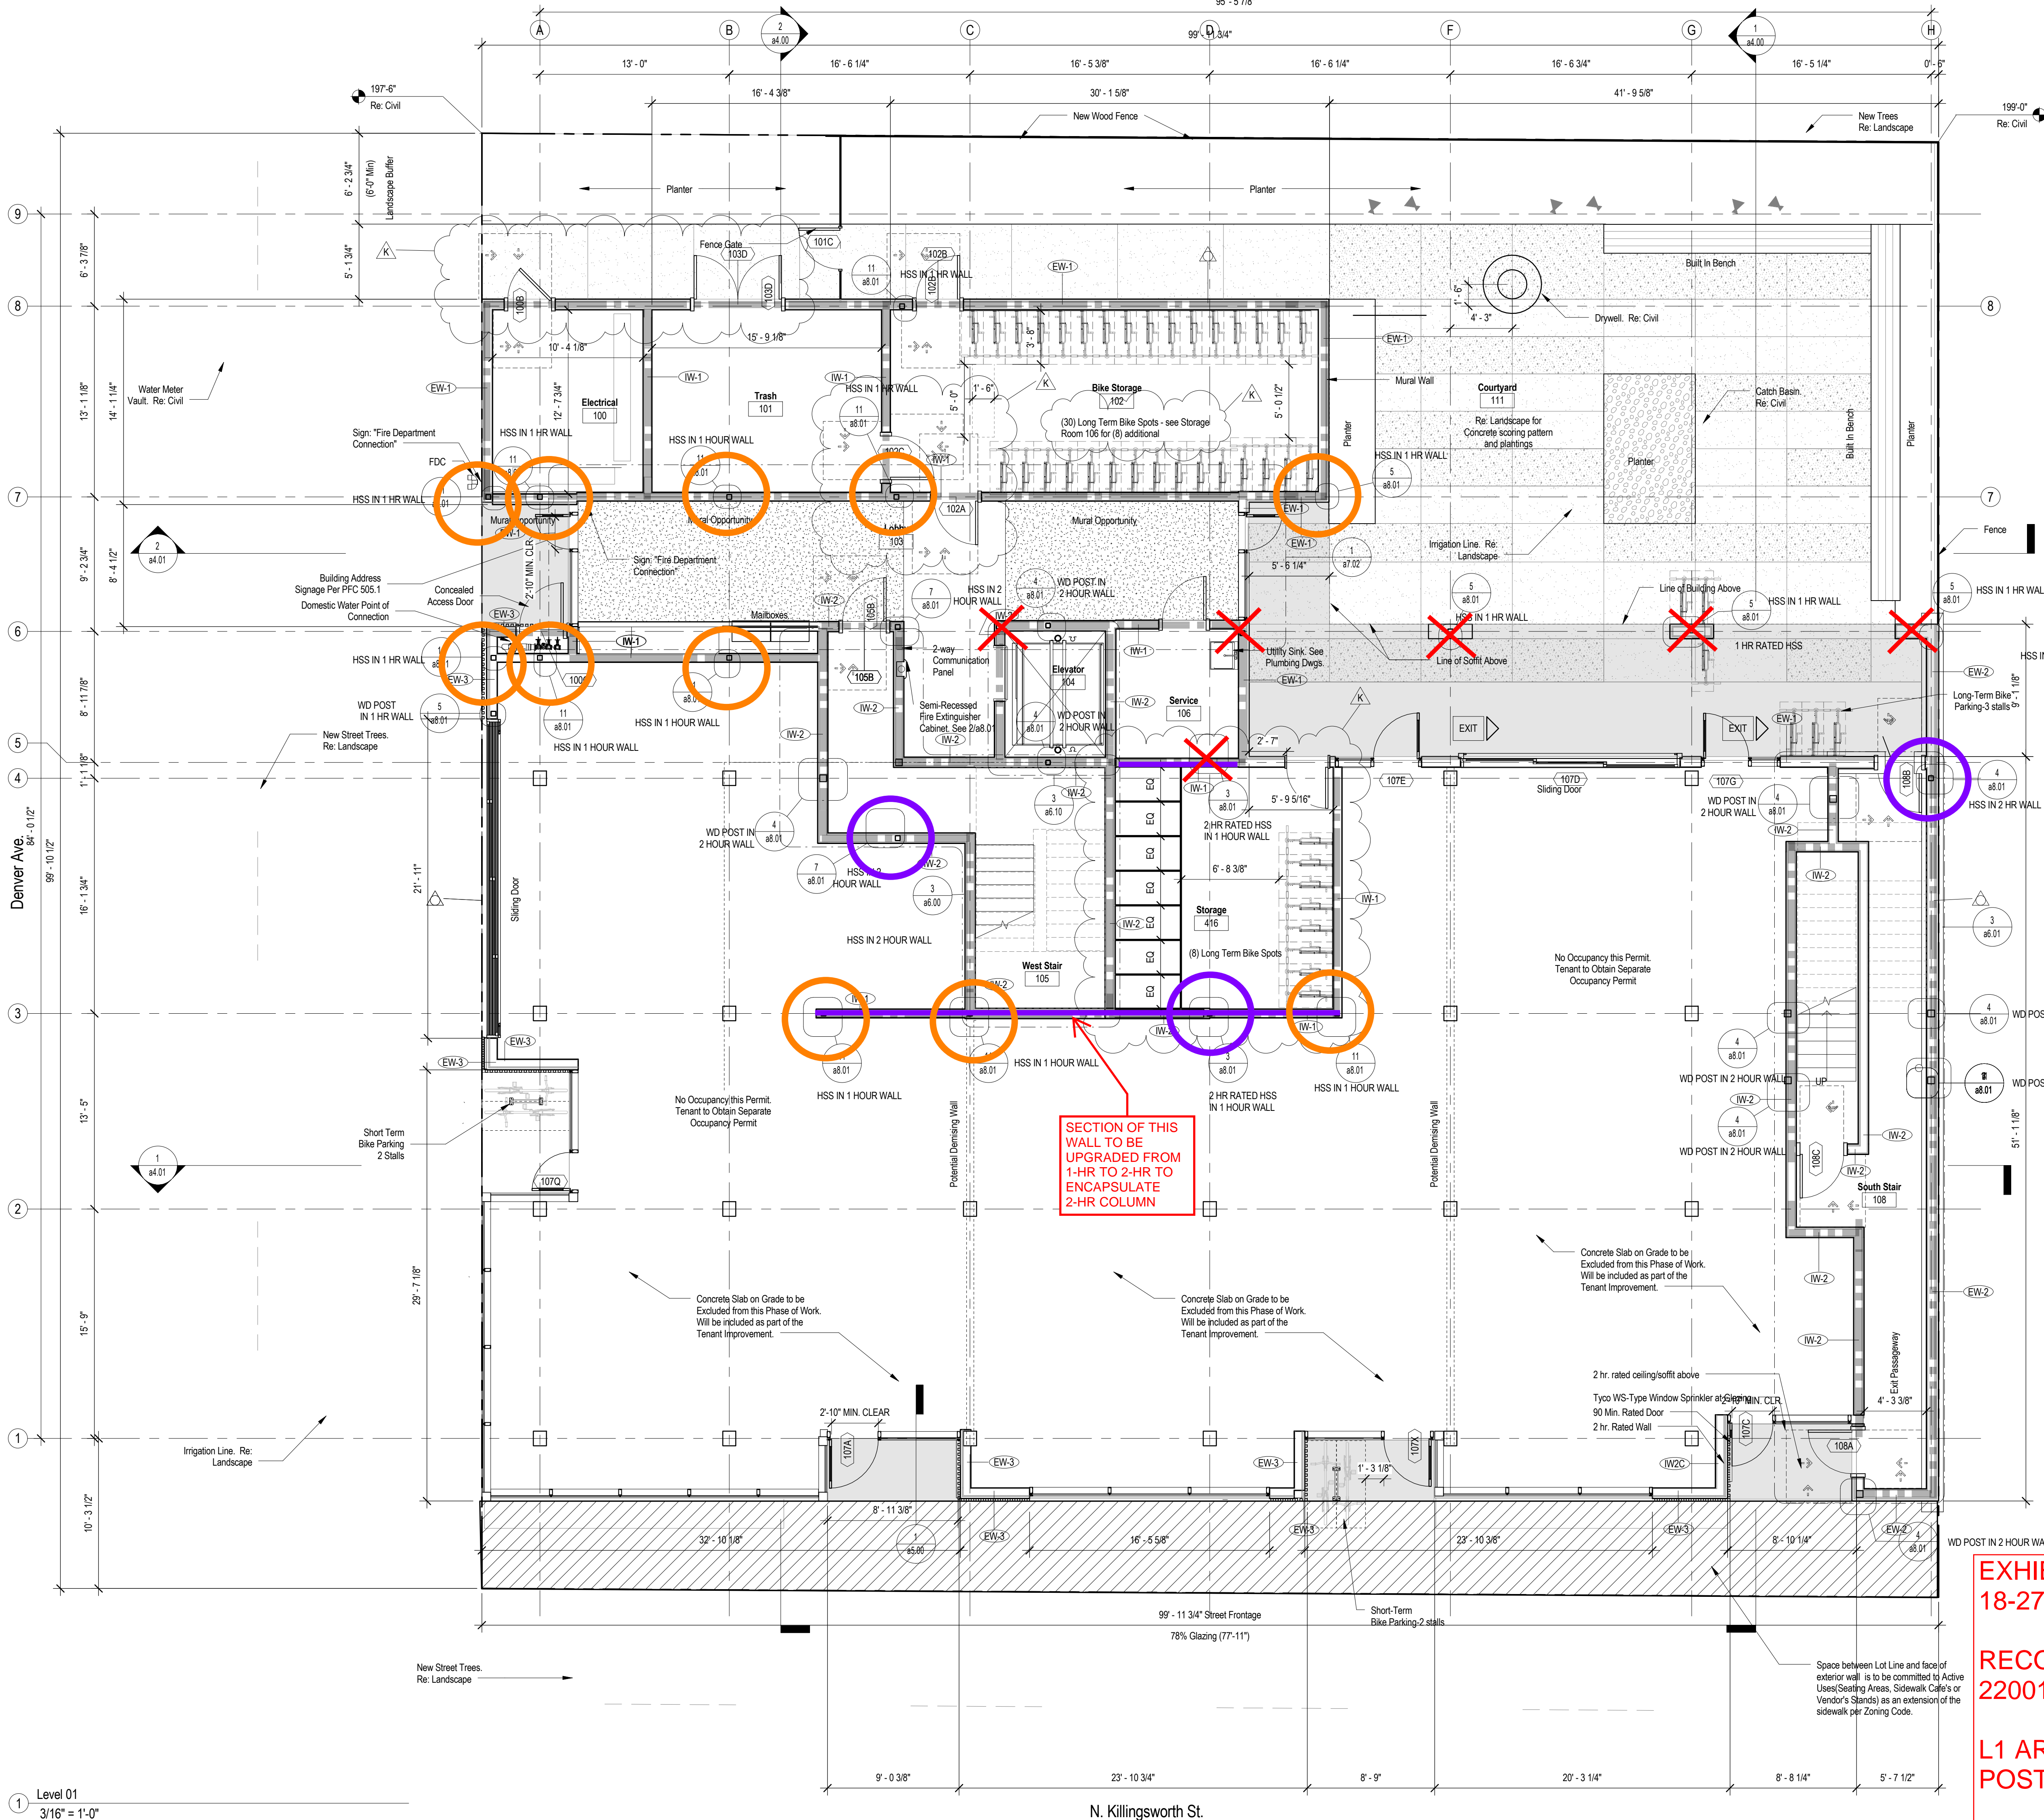

KEY

STEEL POST WITHIN 1-HR FIRE-RATED WALL ASSEMBLY:

GLULAM BEAM ABOVE:
12/ a8.01 (head) - EXHIBIT 5
SSK-001 (base) - EXHIBIT 7
NO GLULAM BEAM ABOVE:
13/ a8.01 (head) - EXHIBIT 5
SSK-001 (base) - EXHIBIT 7

STEEL POST WITHIN 2-HR FIRE-RATED WALL ASSEMBLY:


GLULAM BEAM ABOVE:
12/ a8.01 (head) - EXHIBIT 5
SSK-001 (base) - EXHIBIT 7
NO GLULAM BEAM ABOVE:
13/ a8.01 (head) - EXHIBIT 5
SSK-001 (base) - EXHIBIT 7

THESE POSTS WILL NEED TO BE ENCASED INDIVIDUALLY AND DO NOT FORM PART OF THIS APPEAL

FOR PLAN DETAILS:

REFERENCE DETAIL 6/a8.01 ON EXHIBIT 5 FOR POST WITHIN 1-HR WALL

REFERENCE DETAIL 2/a8.01 ON EXHIBIT 5 FOR POST WITHIN 2-HR WALL

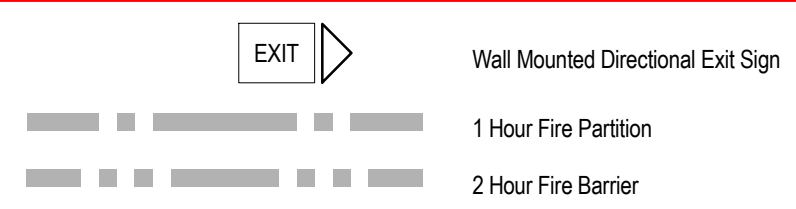

Area Schedule (Occupancy and Egress Plans)	
Name	Area
Area	595 SF
Bike Room	478 SF
Corridor 4	595 SF
Corridor 4	595 SF
Courtyard	1890 SF
Electrical	169 SF
Exit	419 SF
Exit	368 SF
Lobby	489 SF
Parking	Not Placed
Retail 1	1812 SF
Retail 2	1213 SF
Retail 3	1318 SF
S-1 Storage	243 SF
Storage	79 SF
Trash	159 SF
Unit 200	460 SF
Unit 201	462 SF
Unit 202	478 SF
Unit 203	736 SF
Unit 206	632 SF
Unit 207	543 SF
Unit 209	479 SF
Unit 210	473 SF
Unit 211	472 SF
Unit 212	472 SF
Unit 213	472 SF
Unit 214	484 SF
Unit 300	460 SF
Unit 301	462 SF
Unit 302	478 SF
Unit 303	736 SF
Unit 306	632 SF
Unit 307	543 SF
Unit 309	479 SF
Unit 310	473 SF
Unit 311	472 SF
Unit 312	472 SF

EXHIBIT 3: ARCHITECTURAL PLAN L1 18-272167-CO

RECONSIDERATION OF APPEAL ID: 22001

L1 ARCHITECTURAL PLAN - STEEL POST MARKUP

SET ISSUE	
1/22/19	Revision A
2/7/19	Revision B
2/28/19	Revision C
Date 4	Revision D
06/19/19	Revision E
9/18/19	ASI-002
9/25/19	Permit Revision 02



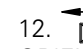
FOUNDATION PLAN NOTES:

FOUNDATION NOTES:

- STRUCTURAL GENERAL NOTES, DESIGN CRITERIA, ABBREVIATIONS AND LEGEND PER s1.00, s1.01, s1.02 AND s1.03.
- VERIFY ALL DIMENSIONS AND ELEVATIONS WITH THE ARCHITECTURAL DRAWINGS.
- CONTRACTOR SHALL LOCATE AND VERIFY THE FOLLOWING WITH OTHERS PRIOR TO POURING CONCRETE:
ALL DOOR OPENINGS IN FOUNDATION WALLS; DRAINS AND SLOPES; BLOCKOUTS FOR (POOLS, SPAS, FREEZERS, COOLERS, PLUMBING, SPRINKLERS AND HVAC); ALL DUCTS, CHASES AND PIPES PER MECHANICAL, PLUMBING, ELECTRICAL AND SPRINKLER DRAWINGS, STAIR DETAILS AND GUARDRAILS PER ARCHITECTURAL DRAWINGS. CONCRETE CURBS AND LOCATIONS PER ARCHITECTURAL DRAWINGS.
- TOP OF SLAB (T/SLAB) ELEVATION ASSUMED 0'-0", FOR ACTUAL T/SLAB ELEVATION REFER TO CIVIL AND ARCHITECTURAL DRAWINGS. PROVIDE 6 MIL VAPOR BARRIER BELOW SLAB AT INTERIOR SPACES. PROVIDE FREE-DRAINING GRANULAR FILL PER GEOTECH REPORT.
- TYPICAL TOP OF INTERIOR (I/INTERIOR) FOOTING ELEVATION = -0'-6", UNO. TYPICAL TOP OF EXTERIOR (E/EXTERIOR) FOOTING ELEVATIONS = -0'-8", UNO.
- ALL FOOTINGS AND SLABS TO BEAR ON COMPETENT NATIVE SOIL AND/OR STRUCTURAL FILL. SUBGRADE PREPARATION, STRUCTURAL FILL, FOOTING DRAINS, AND OTHER REQUIREMENTS PER GEOTECH REPORT AS NOTED IN THE STRUCTURAL GENERAL NOTES.
- CJ INDICATES CONTROL JOINT PER PLAN.
- CONTRACTOR TO VERIFY TOP OF CONCRETE (T/CONC) WALL ELEVATIONS ON ALL PARTIAL HEIGHT RETAINING WALLS. MAINTAIN T/WALL ELEVATION A MINIMUM OF 8" ABOVE FINISH GRADE PER 12/s4.01.
- ALL WOOD EXPOSED TO CONCRETE, WEATHER, OR WITHIN 8" OF FINISHED GRADE SHALL BE PRESSURE-TREATED.
- MOISTURE PROOF ALL CONCRETE STEM AND BASEMENT WALLS PER ARCHITECT.
- TYPICAL DETAILS PER:


1/s4.00	STANDARD HOOKS AND BAR BENDS
3/s4.00	TYPICAL ANCHOR BOLT SCHEDULE
4/s4.00	TYPICAL LAP SPLICE AND DEVELOPMENT LENGTH SCHEDULE
5/s4.00	PIPE OR CONDUIT EMBEDDED IN SLAB ON GRADE
6/s4.00	TYPICAL CORNER REINFORCING AT CORNER FOOTING
7/s4.00	TYPICAL STEPPED FOOTING
5/s4.01	TYPICAL BASE PLATE CONFIGURATIONS
10/s4.01	TYPICAL PIPE AND TRENCH LOCATIONS AT CONCRETE STEM/WALL/FTG
9/s4.01	TYPICAL BASEPLATE TO CONCRETE WALL
7/s4.01	TYPICAL THICKENED SLAB EDGE

STUD AND SHEAR WALL NOTES:

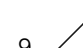- LUMBER GRADE PER STRUCTURAL GENERAL NOTES.
- BALLOON FRAME ALL WALLS GREATER THAN ONE LEVEL 10'-0" WITH (2) 2x @ 16"OC.
- ALL INTERIOR NON-BEARING, NON-STRUCTURAL WALL STUD REQUIREMENTS PER STRUCTURAL GENERAL NOTES.
- HEADERS SHOWN ON FRAMING PLAN SHALL BE SUPPORTED BY (1) TRIMMER AND (1) KING STUD MINIMUM, UNO. WHERE MORE THAN (1) TRIMMER IS REQUIRED, THE NUMBER OF TRIMMER STUDS SHALL BE NOTED THUS: ■(2) TRIMMERS TO BE CONTINUOUS TO THE FOUNDATION. BLOCK SOLID AT FLOOR FRAMING.
- BEAMS SHOWN ON FRAMING PLAN SHALL BE SUPPORTED BY (2) BUNDLED STUDS MINIMUM, UNO. WHERE MORE THAN (2) BUNDLED STUDS ARE REQUIRED, THE NUMBER OF BUNDLED STUDS SHALL BE NOTED THUS: ■(3). BUNDLED STUDS TO BE CONTINUOUS TO THE FOUNDATION. BLOCK SOLID AT FLOOR FRAMING.
- SHEAR WALL AND NAILING REQUIREMENTS PER SHEAR WALL SCHEDULE 5/s6.00.
- ALL EXTERIOR WALLS REQUIRING WOOD SHEATHING PER ARCHITECT SHALL BE SHEAR WALL TYPE W6 UNO.
- AT STAGGERED STUD WALLS, BUNDLED STUDS, TRIMMER STUDS, KING STUDS AND SHEAR WALL COMPRESSION STUDS ARE TO MATCH THE WIDTH OF WALL PLATES.
-  (2) 2x INDICATES HOLD-DOWN TYPE PER HOLD-DOWN SCHEDULE 9/s6.01. CIRCLED NUMBER INDICATES NUMBER OF TRIM STUDS REQUIRED AND BOTTOM NUMBER INDICATES NUMBER OF FULL HEIGHT (KING) STUDS REQUIRED IN ADDITION TO BUNDLED OR TRIM STUDS OR POSTS SHOWN ON PLAN.
-  INDICATES TENSION LOADS REQUIRED (IN KIPS), CIRCLED NUMBER INDICATES NUMBER OF STUDS REQUIRED FOR TDS HOLD-DOWN.
- TYPICAL HOLD-DOWN ELEVATION PER 5/s6.01 AND 12/s6.01.
- ANCHOR BOLTS TO BE 5/8" DIA x 7" MINIMUM EMBEDMENT PER 10/s6.00. PROVIDE HOT-DIPPED GALVANIZED ANCHOR BOLTS AT PRESSURE-TREATED SILL PLATES. HOT-DIPPED GALVANIZED ANCHOR BOLTS ARE NOT REQUIRED AT SODIUM BORATE PRESSURE-TREATED PLATES PER STRUCTURAL GENERAL NOTES.
-  INDICATES WOOD POST OR GLULAM COLUMN. FOR RECTANGULAR GLULAM COLUMNS, ARROWS INDICATE ORIENTATION OF LONG SIDE OF COLUMN.
- TYPICAL DETAILS PER:

7/s6.00	TYPICAL STUD WALL OPENING (HEADER) DETAIL
3/s6.00	TYPICAL TOP PLATE SPLICE DETAIL
8/s6.00	TYPICAL HOLES AND NOTCHES IN WOOD STUDS
1 & 11/s6.01	TYPICAL SHEAR WALL ELEVATION
5/s6.04	TYPICAL INTERIOR STAIRWELL ELEVATION
9 & 10/s6.04	NON-STRUCTURAL PARTITION WALL CONNECTION
12/s6.00	PLAN - INTERSECTING SHEAR WALLS

Wood crushing OK with custom baseplate

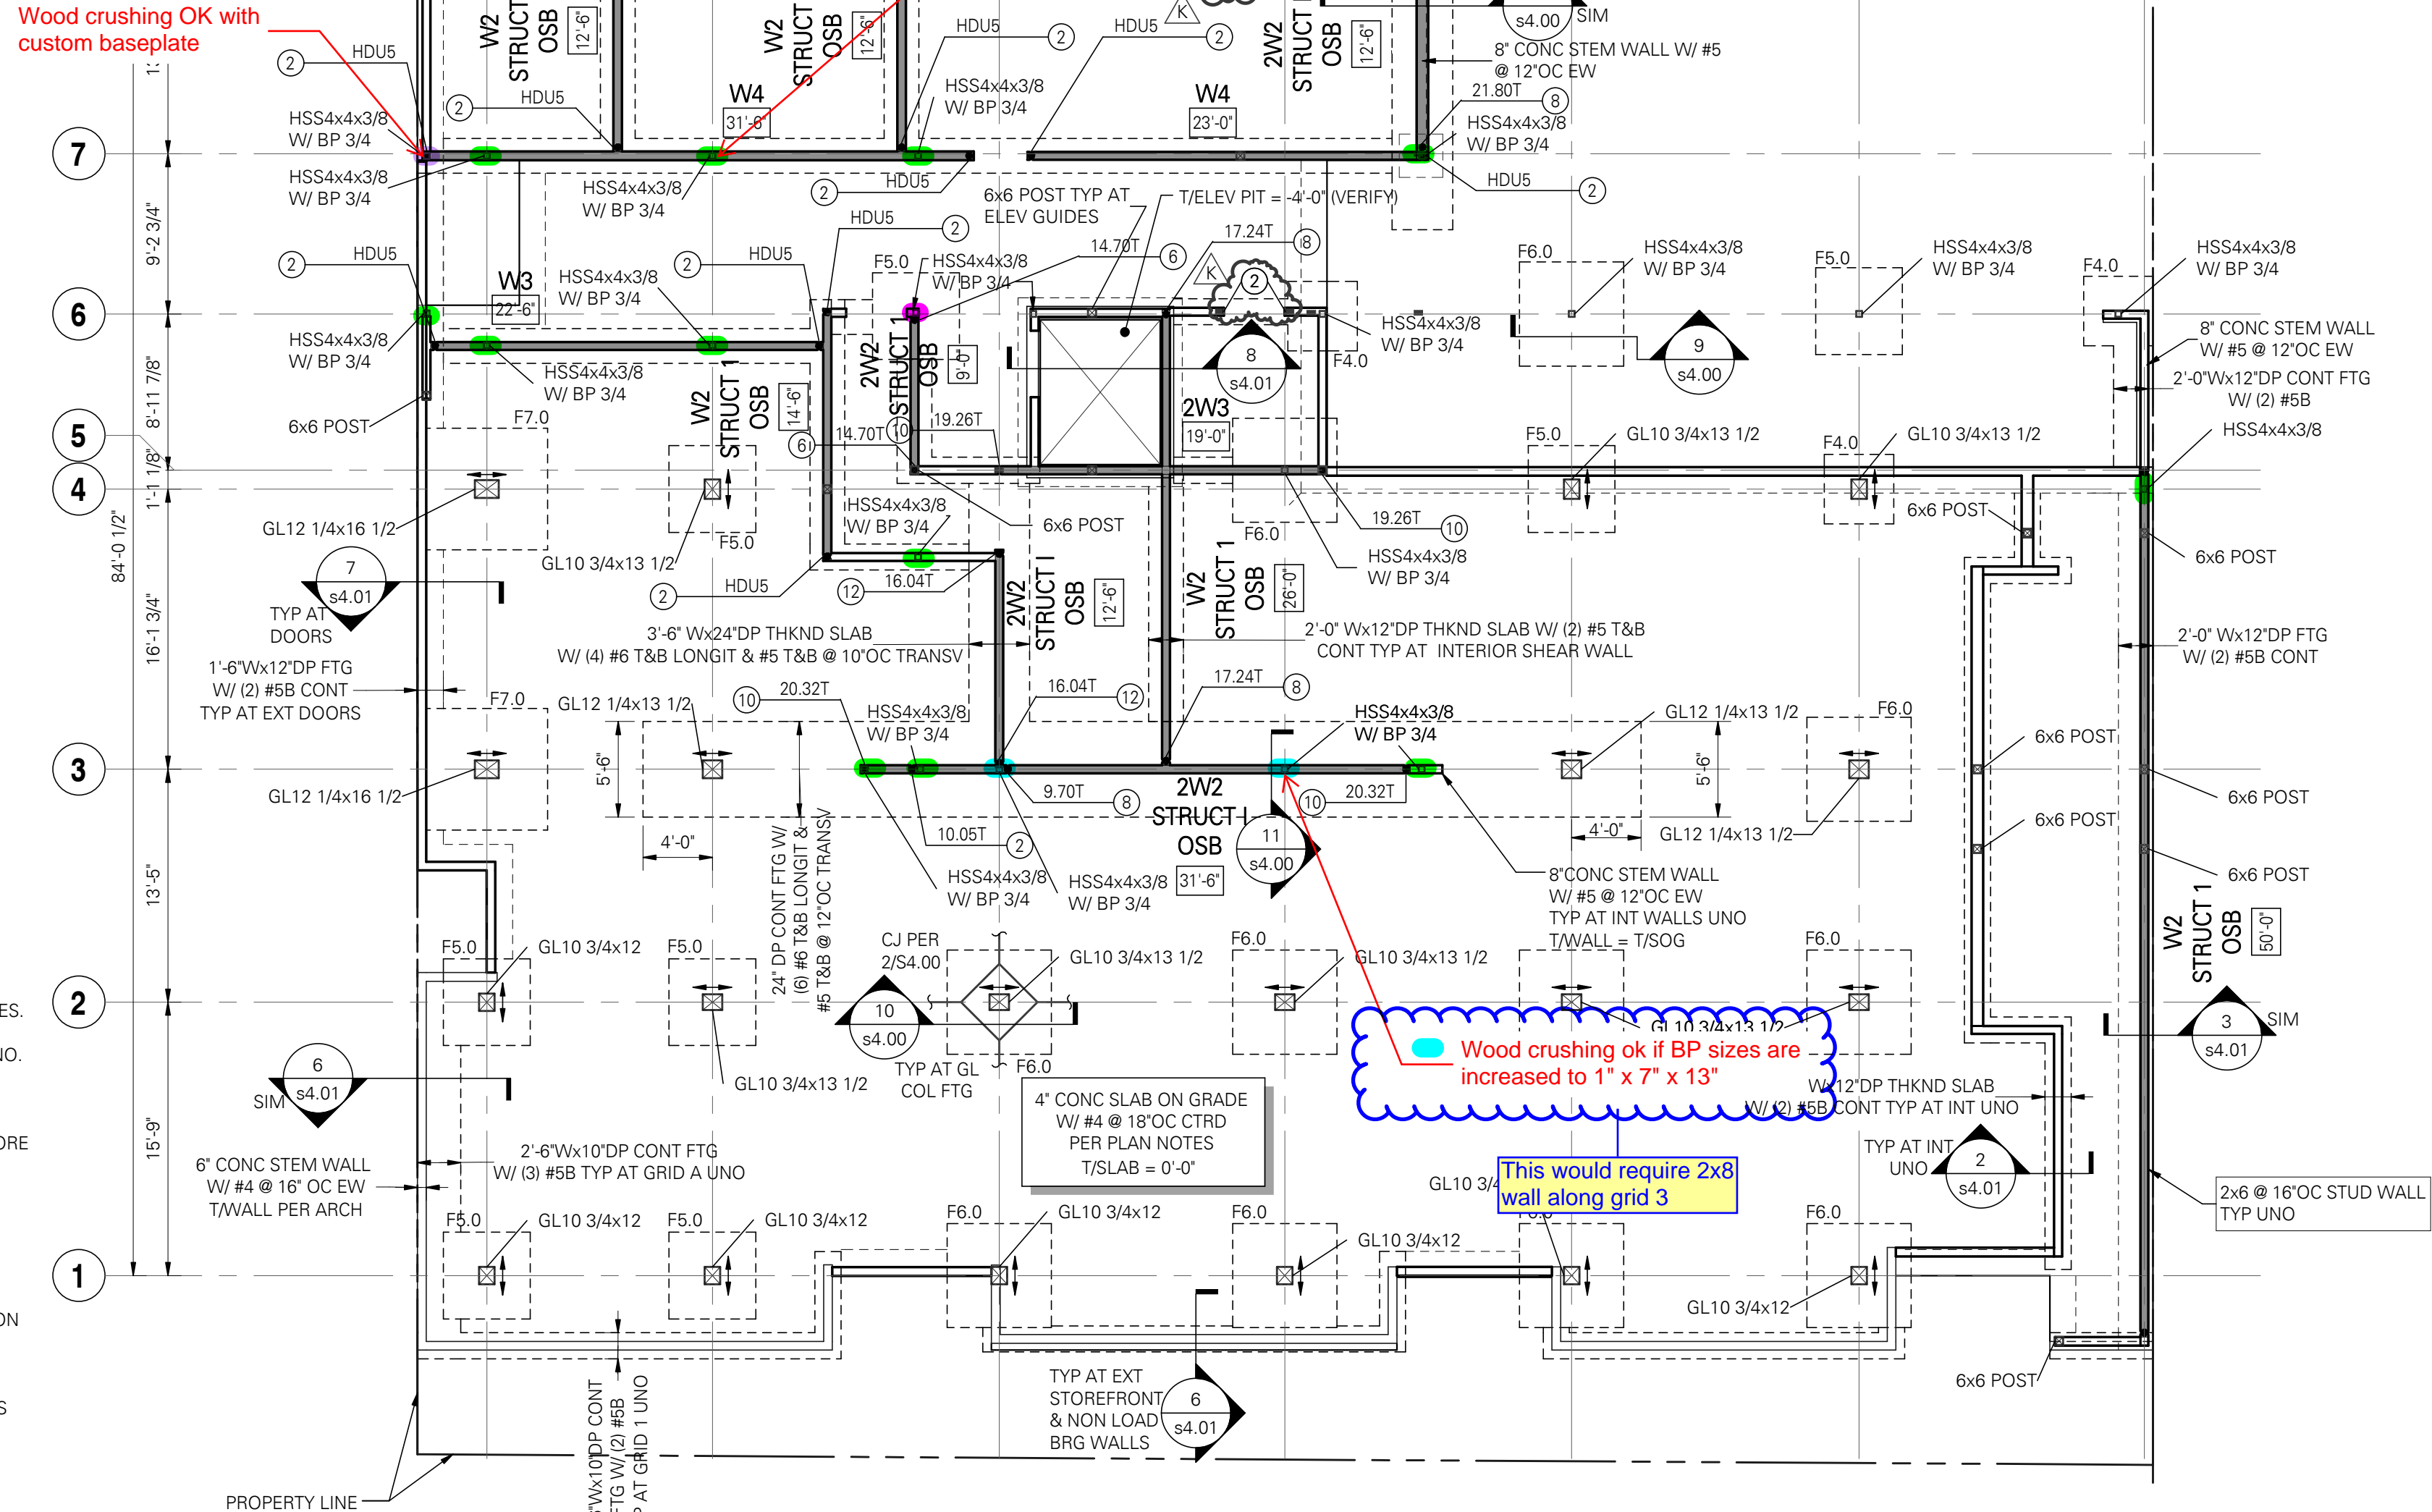

SPREAD FOOTING SCHEDULE					
TYPE	LENGTH	WIDTH	DEPTH	REINFORCING	COMMENTS
F4.0	4'-0"	4'-0"	1'-0"	(5) #5B EW	---
F5.0	5'-0"	5'-0"	1'-2"	(6) #5B EW	---
F6.0	6'-0"	6'-0"	1'-4"	(7) #6B EW	---
F7.0	7'-0"	7'-0"	1'-6"	(8) #6B EW	---

REFER TO INDIVIDUAL NOTES FOR NEW BASE-PLATE SIZES.

A FULL REVISED BASE PLATE SCHEDULE WILL BE PROVIDED WITH THE PERMIT REVISION.

W.P.A

works progress architecture

811 SE Stark Street, Suite 210
Portland OR, 97214
(503) 234-2945
www.worksarchitecture.net

Killingsworth N D Block

1935 N. Killingsworth St. Portland, OR
DCI Job Number 18031-0010



11.28.2018

PERMIT SET

EDCI ENGINEERS

921 SW Washington Street, Suite 560
Portland, Oregon 97205
P: (503) 242-2448 www.dci-engineers.com
CIVIL / STRUCTURAL
© Copyright 05.2018 © Amato Convensano Inc. All Rights Reserved
This document and the ideas and designs may not be reused, in whole or in part, without written permission from D'Amato Convensano Inc. or Amato Convensano Inc. No liability is assumed for any unauthorized use.

SET ISSUE

A	02/21/2019	Revision 1
C	03/19/2019	Revision C
D	04/18/2019	Revision D
F	05/09/2019	Revision F
G	05/24/2019	Revision G
H	06/13/2019	Plan Check
J	09/04/2019	Revision J
K	09/25/2019	Permit Revision

EXHIBIT 4: STRUCTURAL PLAN L1
18-272167-CO

RECONSIDERATION OF APPEAL ID:
22001

L1 STRUCTURAL PLAN - STEEL POST
MARKUP

STRUCTURAL

STRUCTURAL
FOUNDATION,
STUD AND
SHEAR WALL
PLAN

s2.00

Date 4	Revision D
06/19/19	Revision E
10/30/19	Appeal











EXHIBIT 5: DETAILS
18-272167-CO


RECONSIDERATION OF APPEAL ID:
22001

HIGHLIGHTED DETAILS ON A8.01


General Interior
Details

a8.01

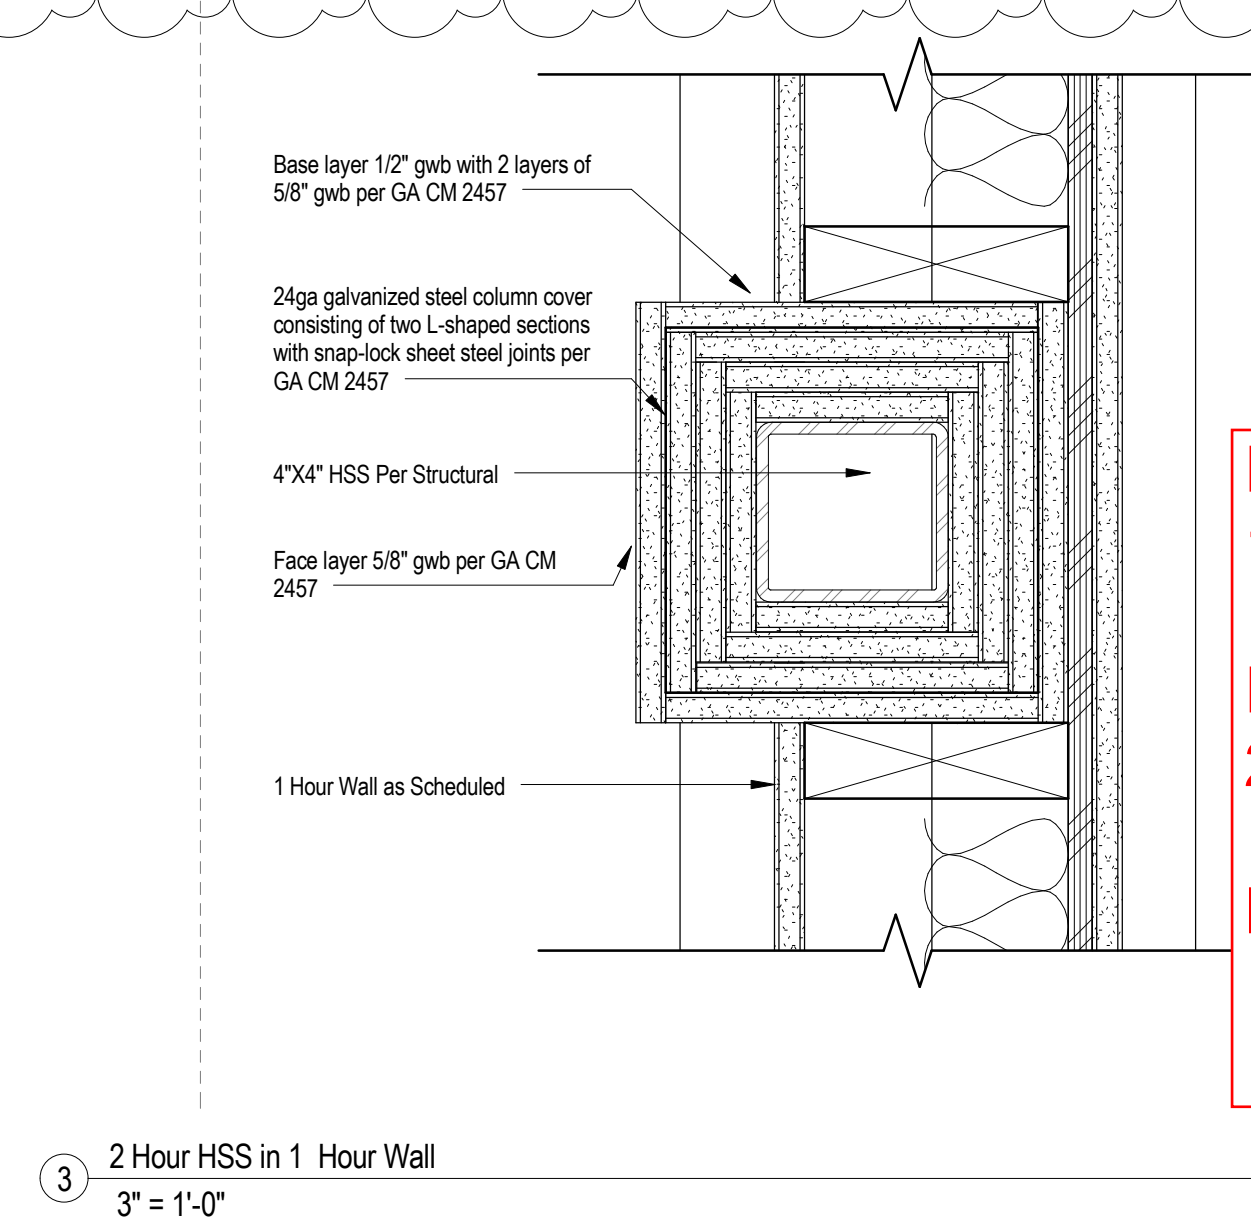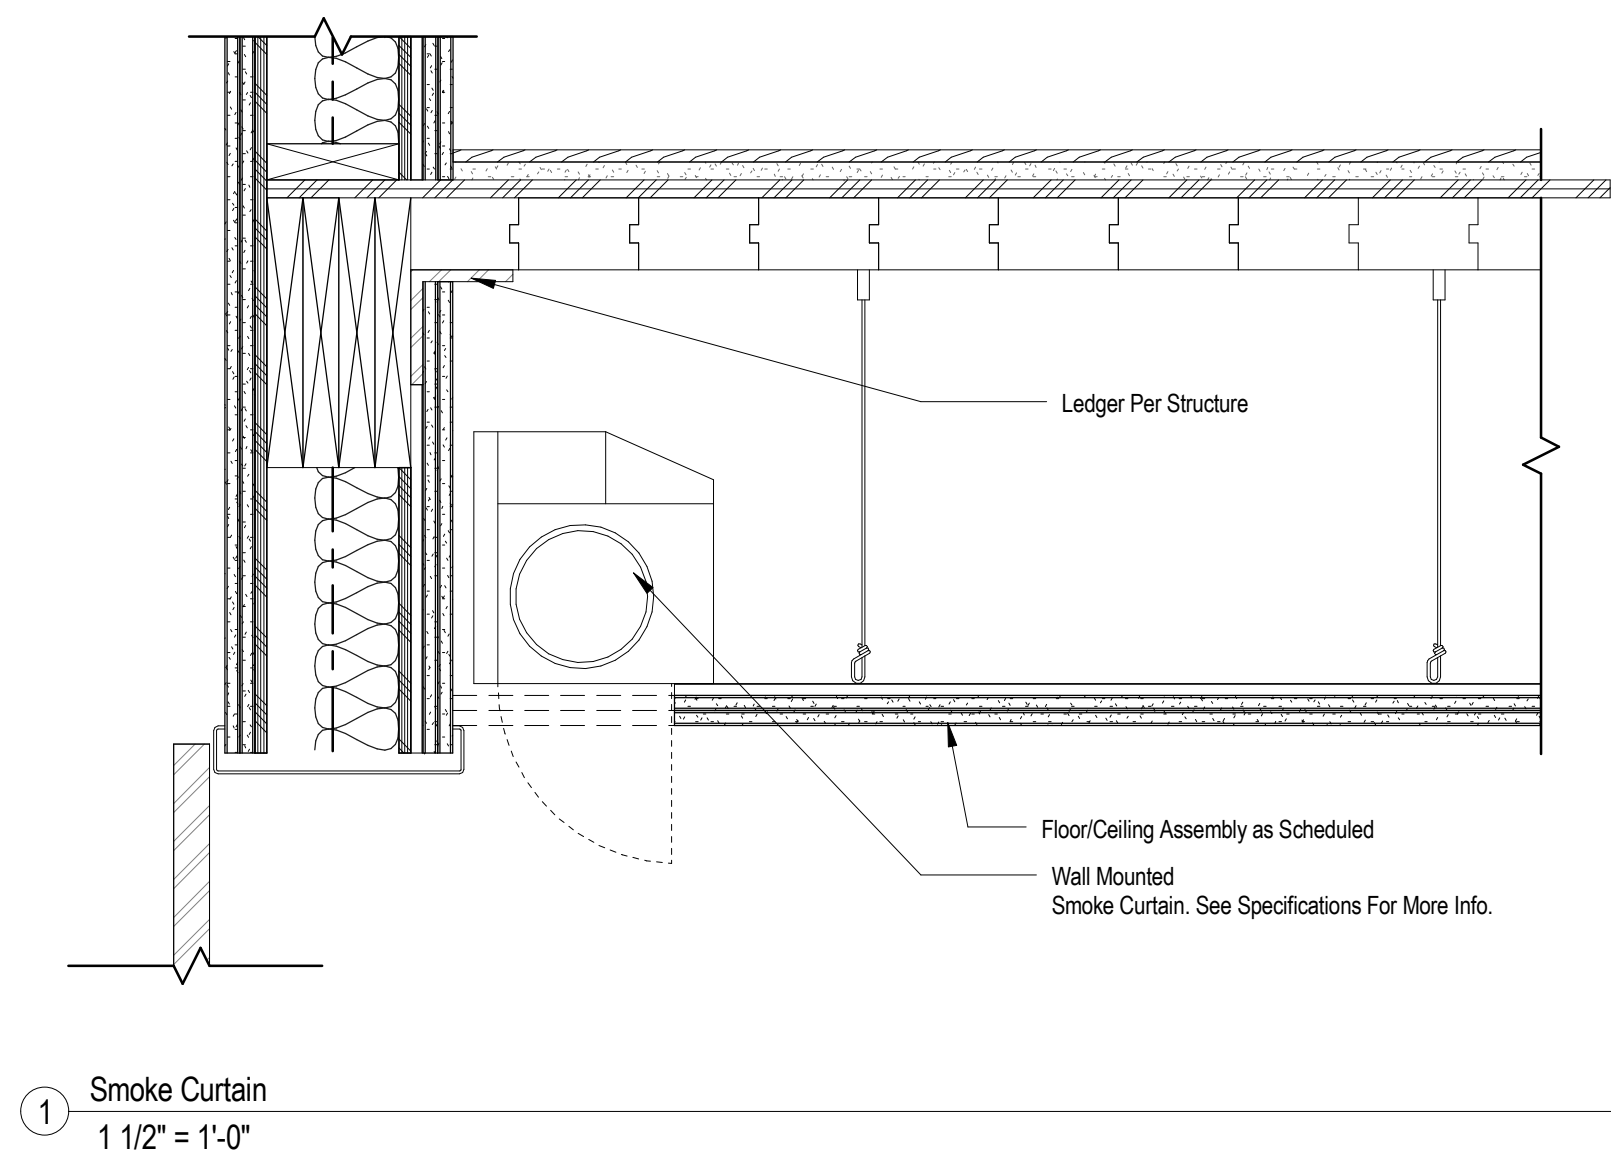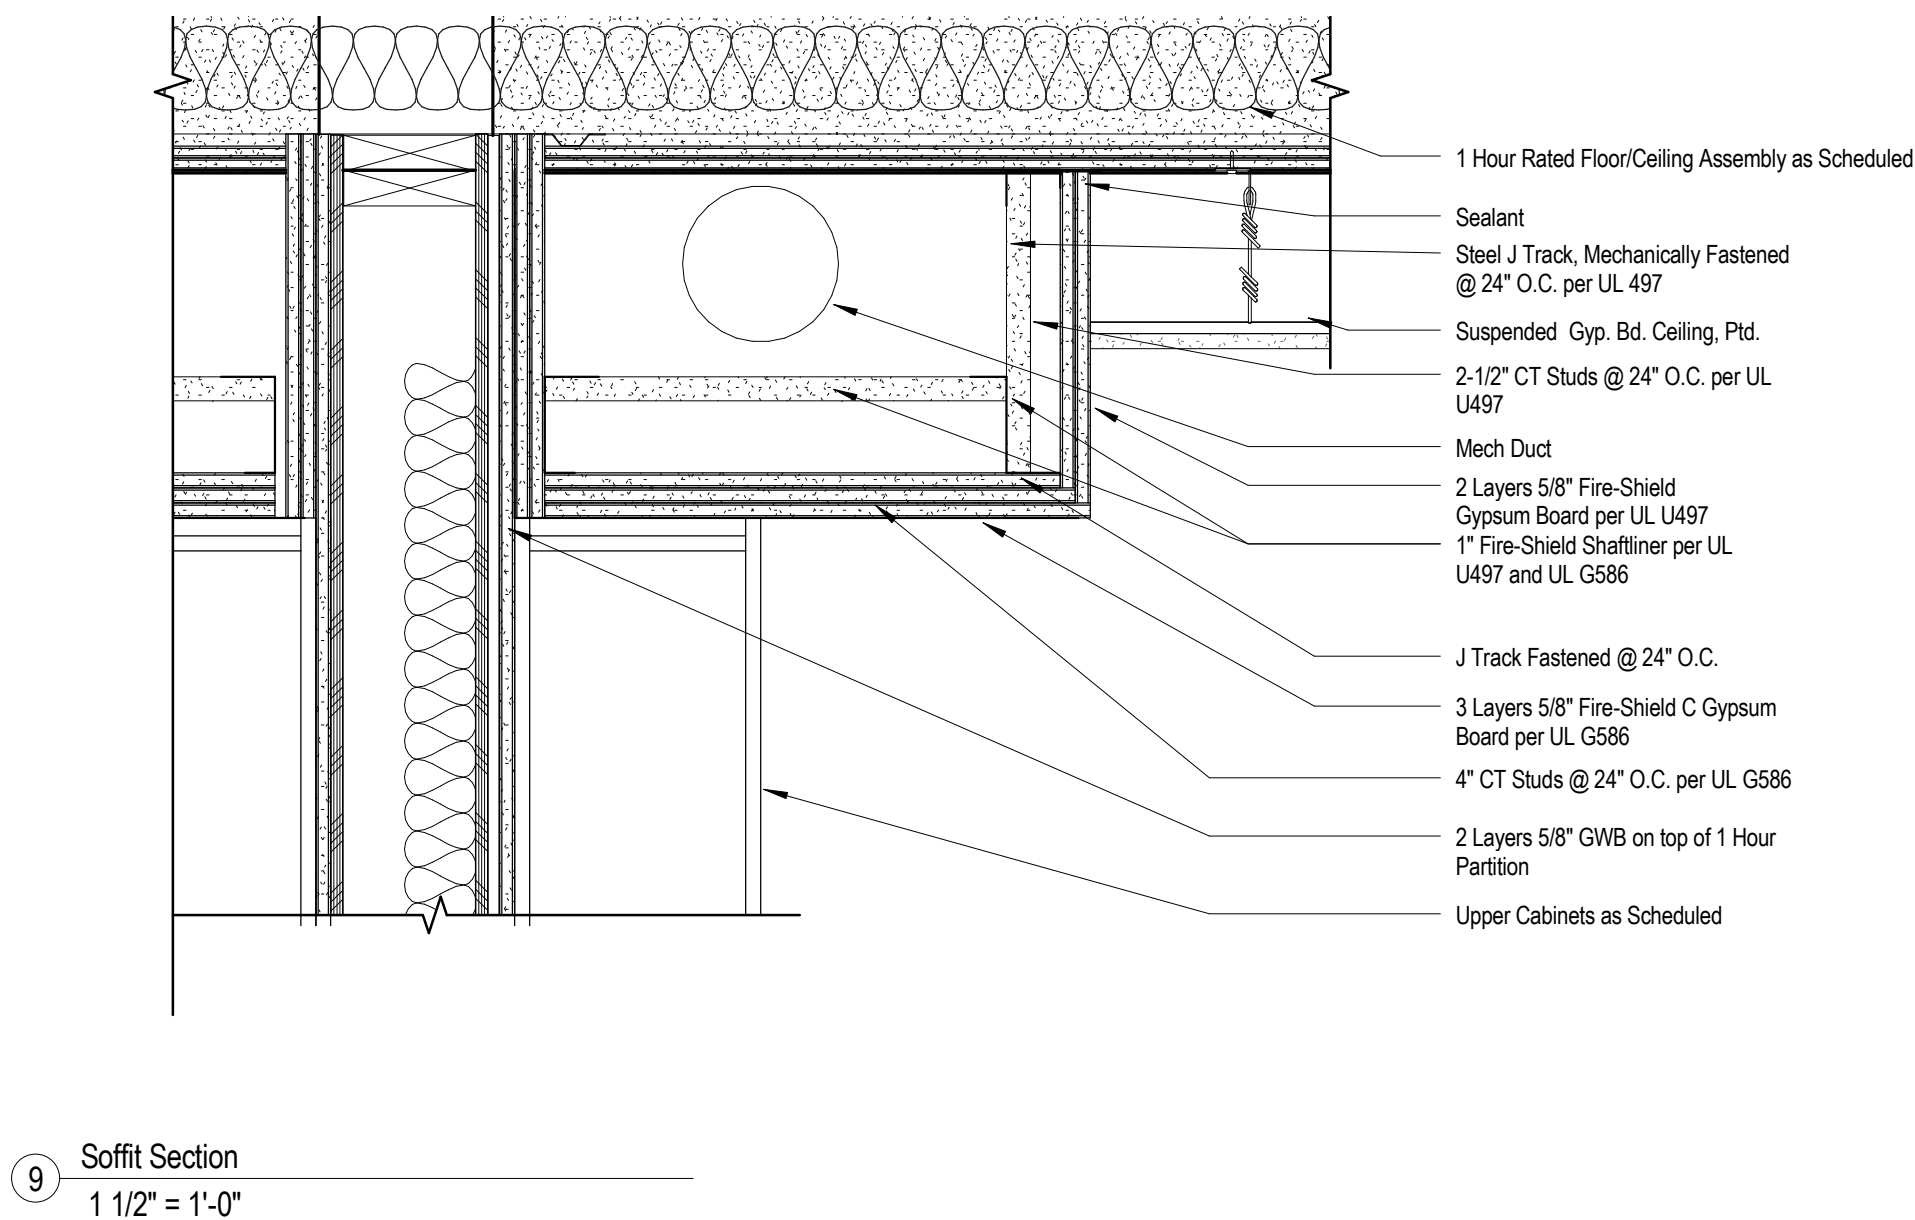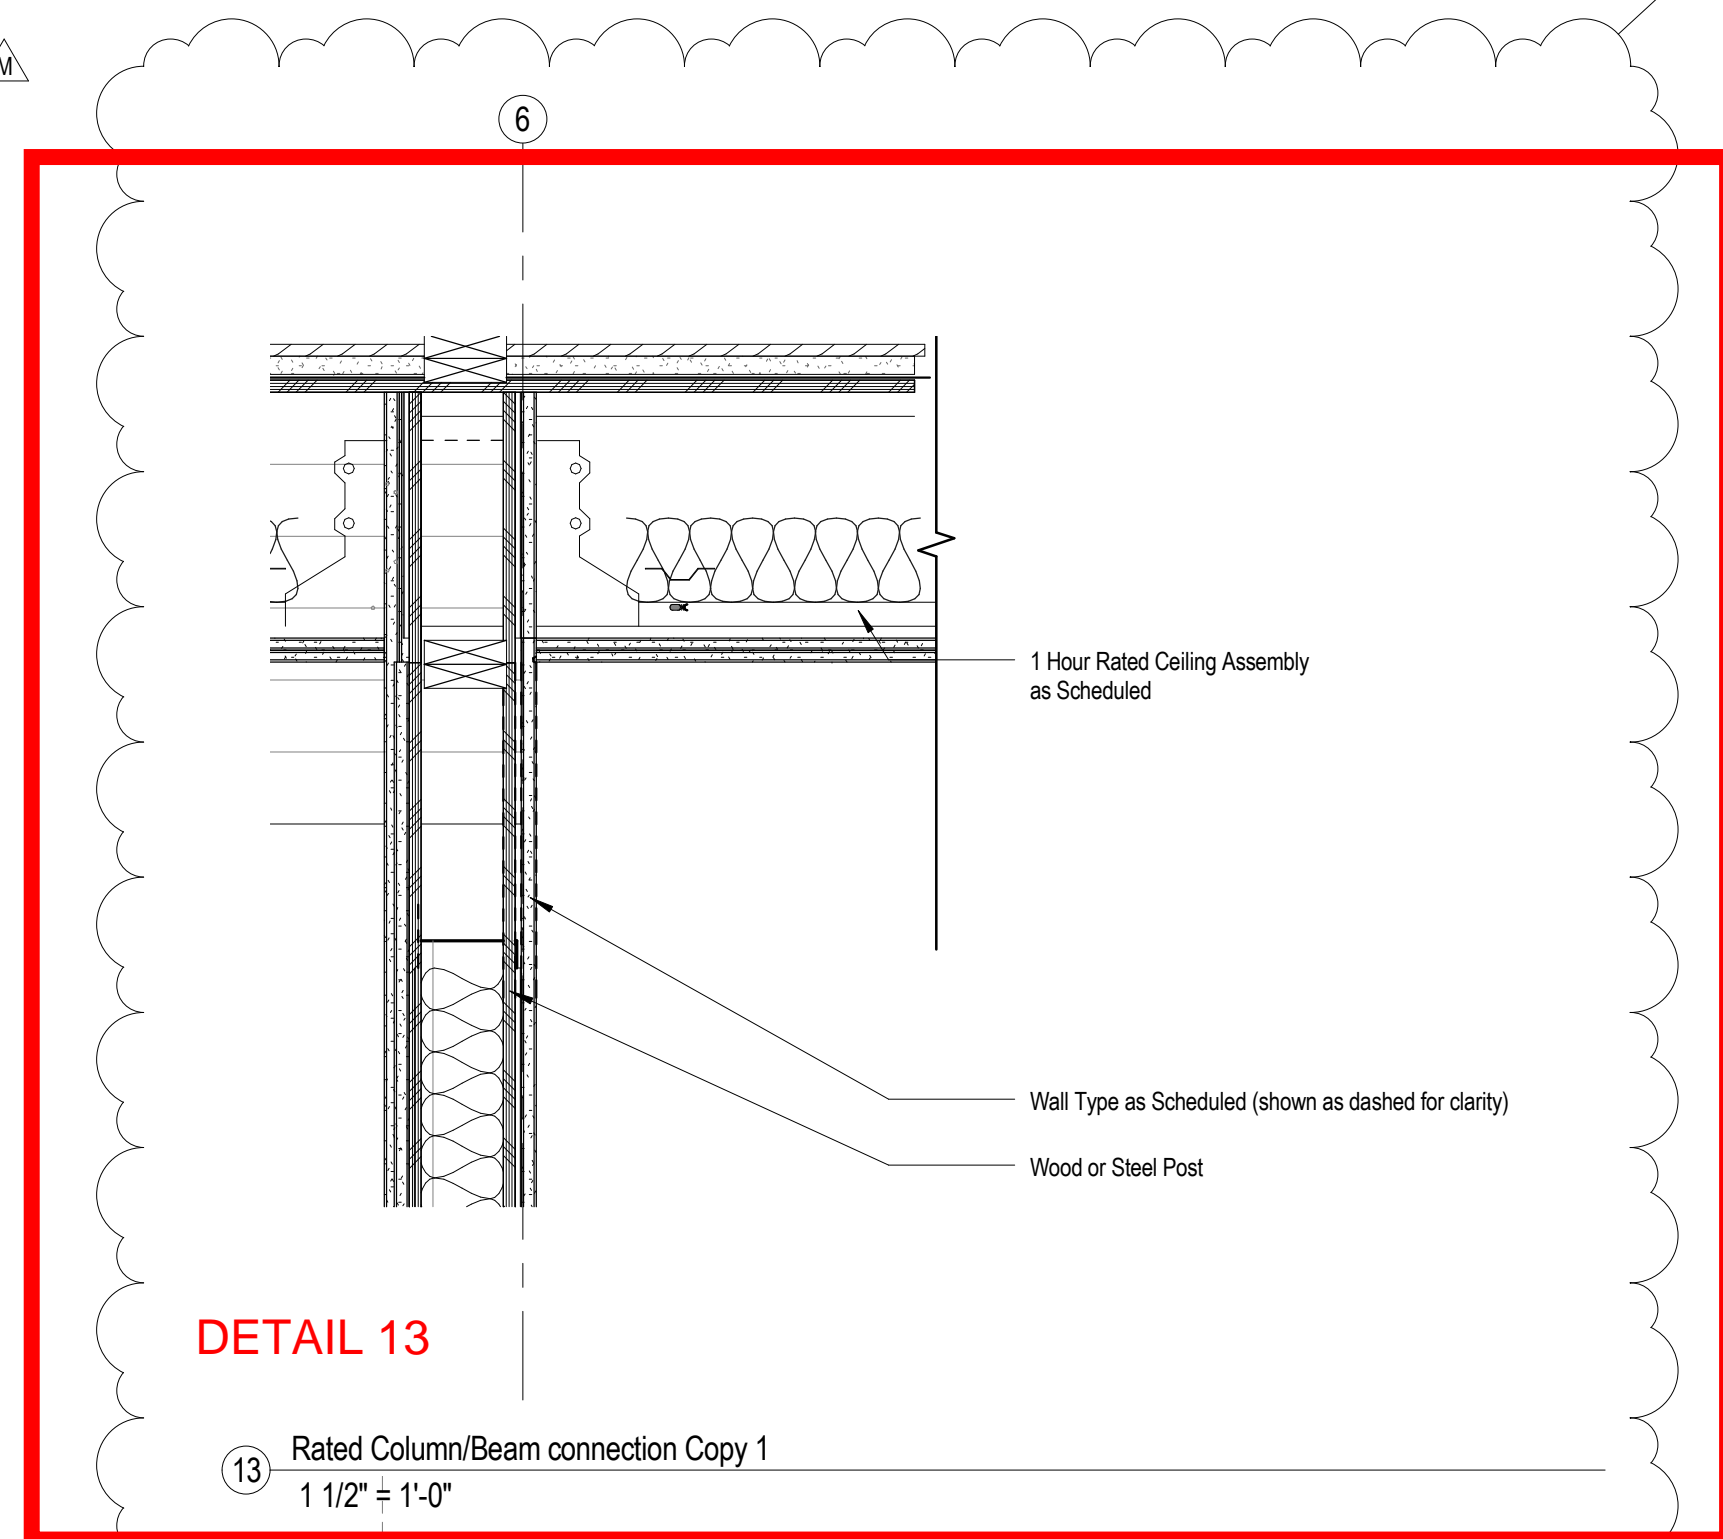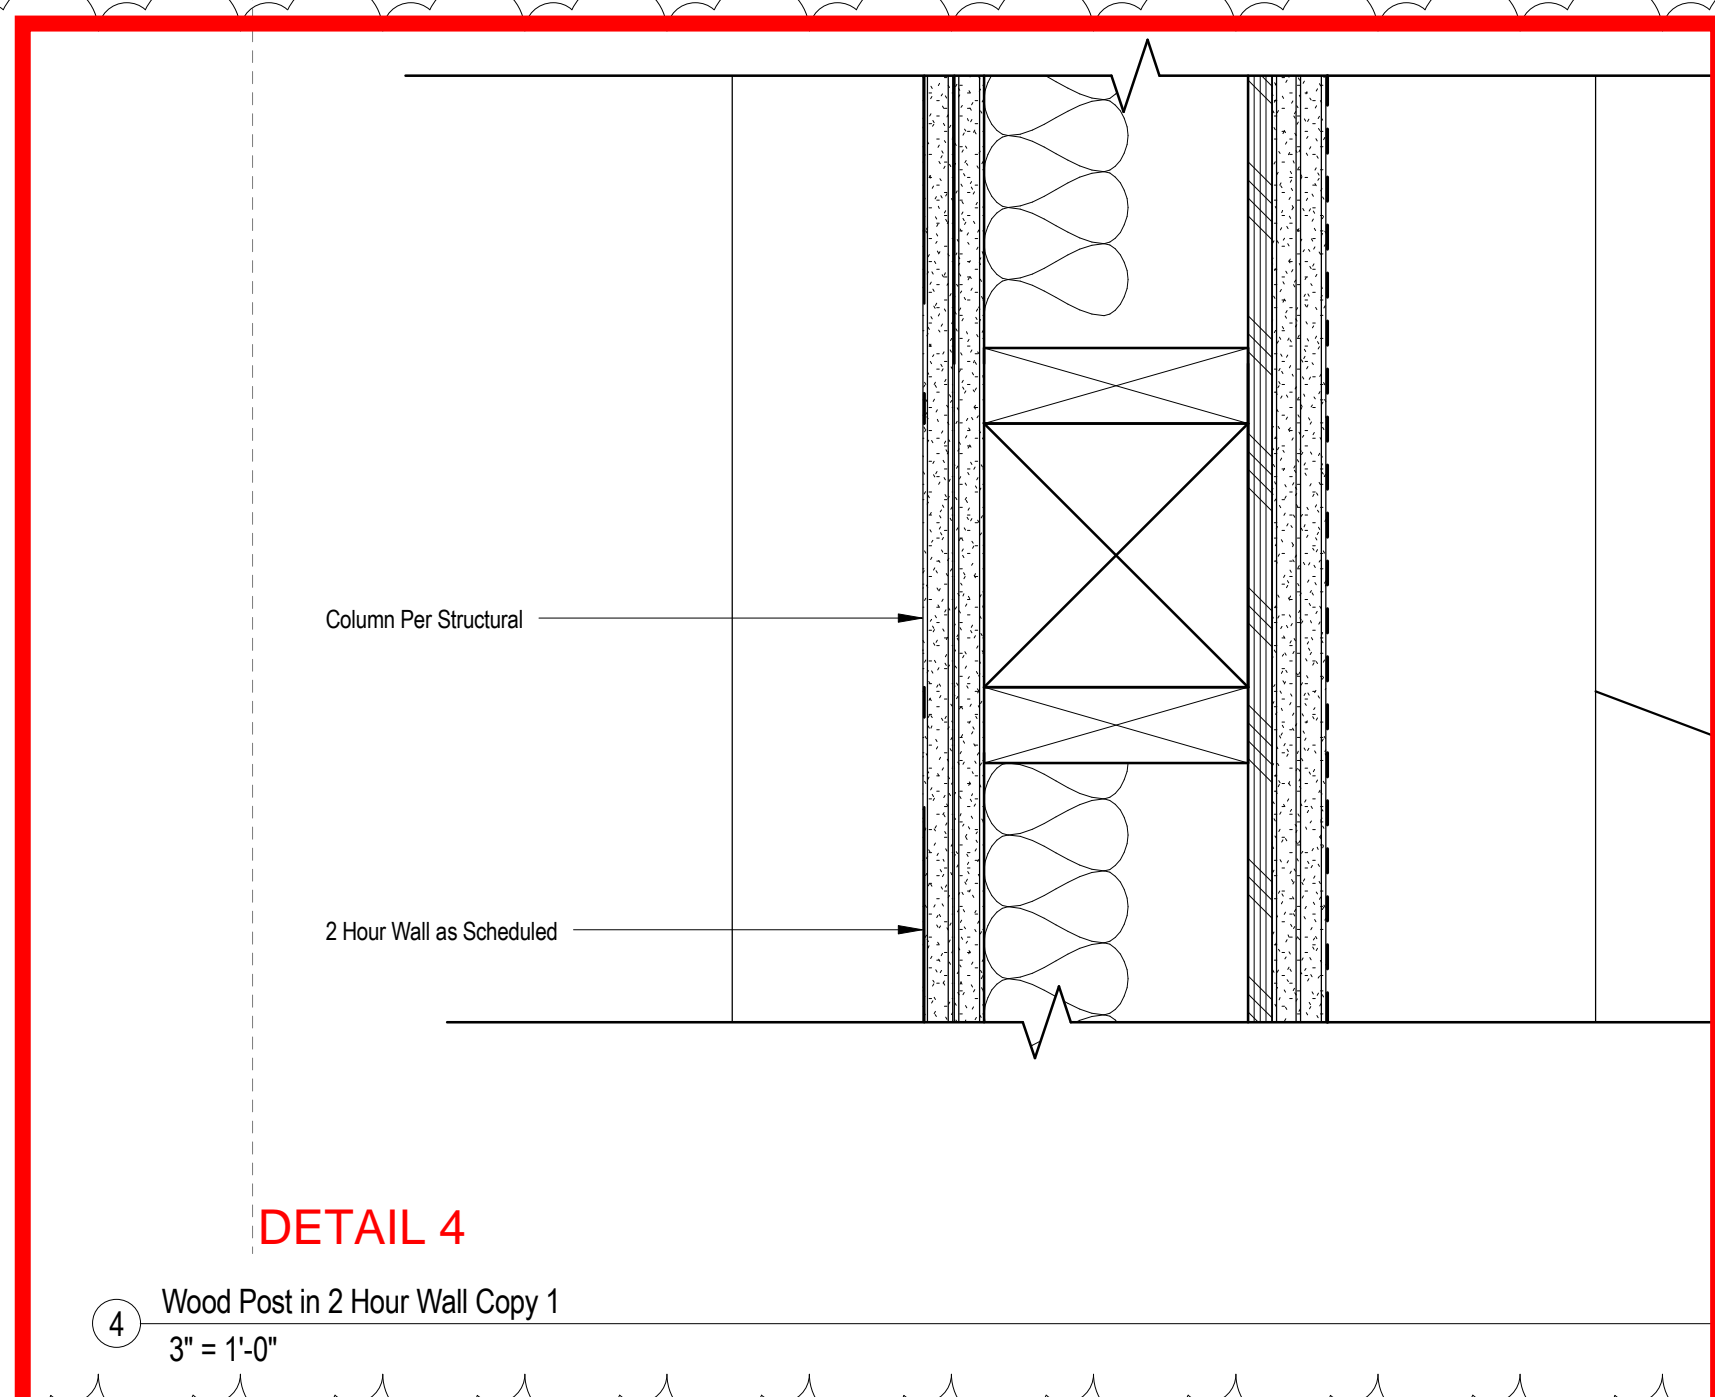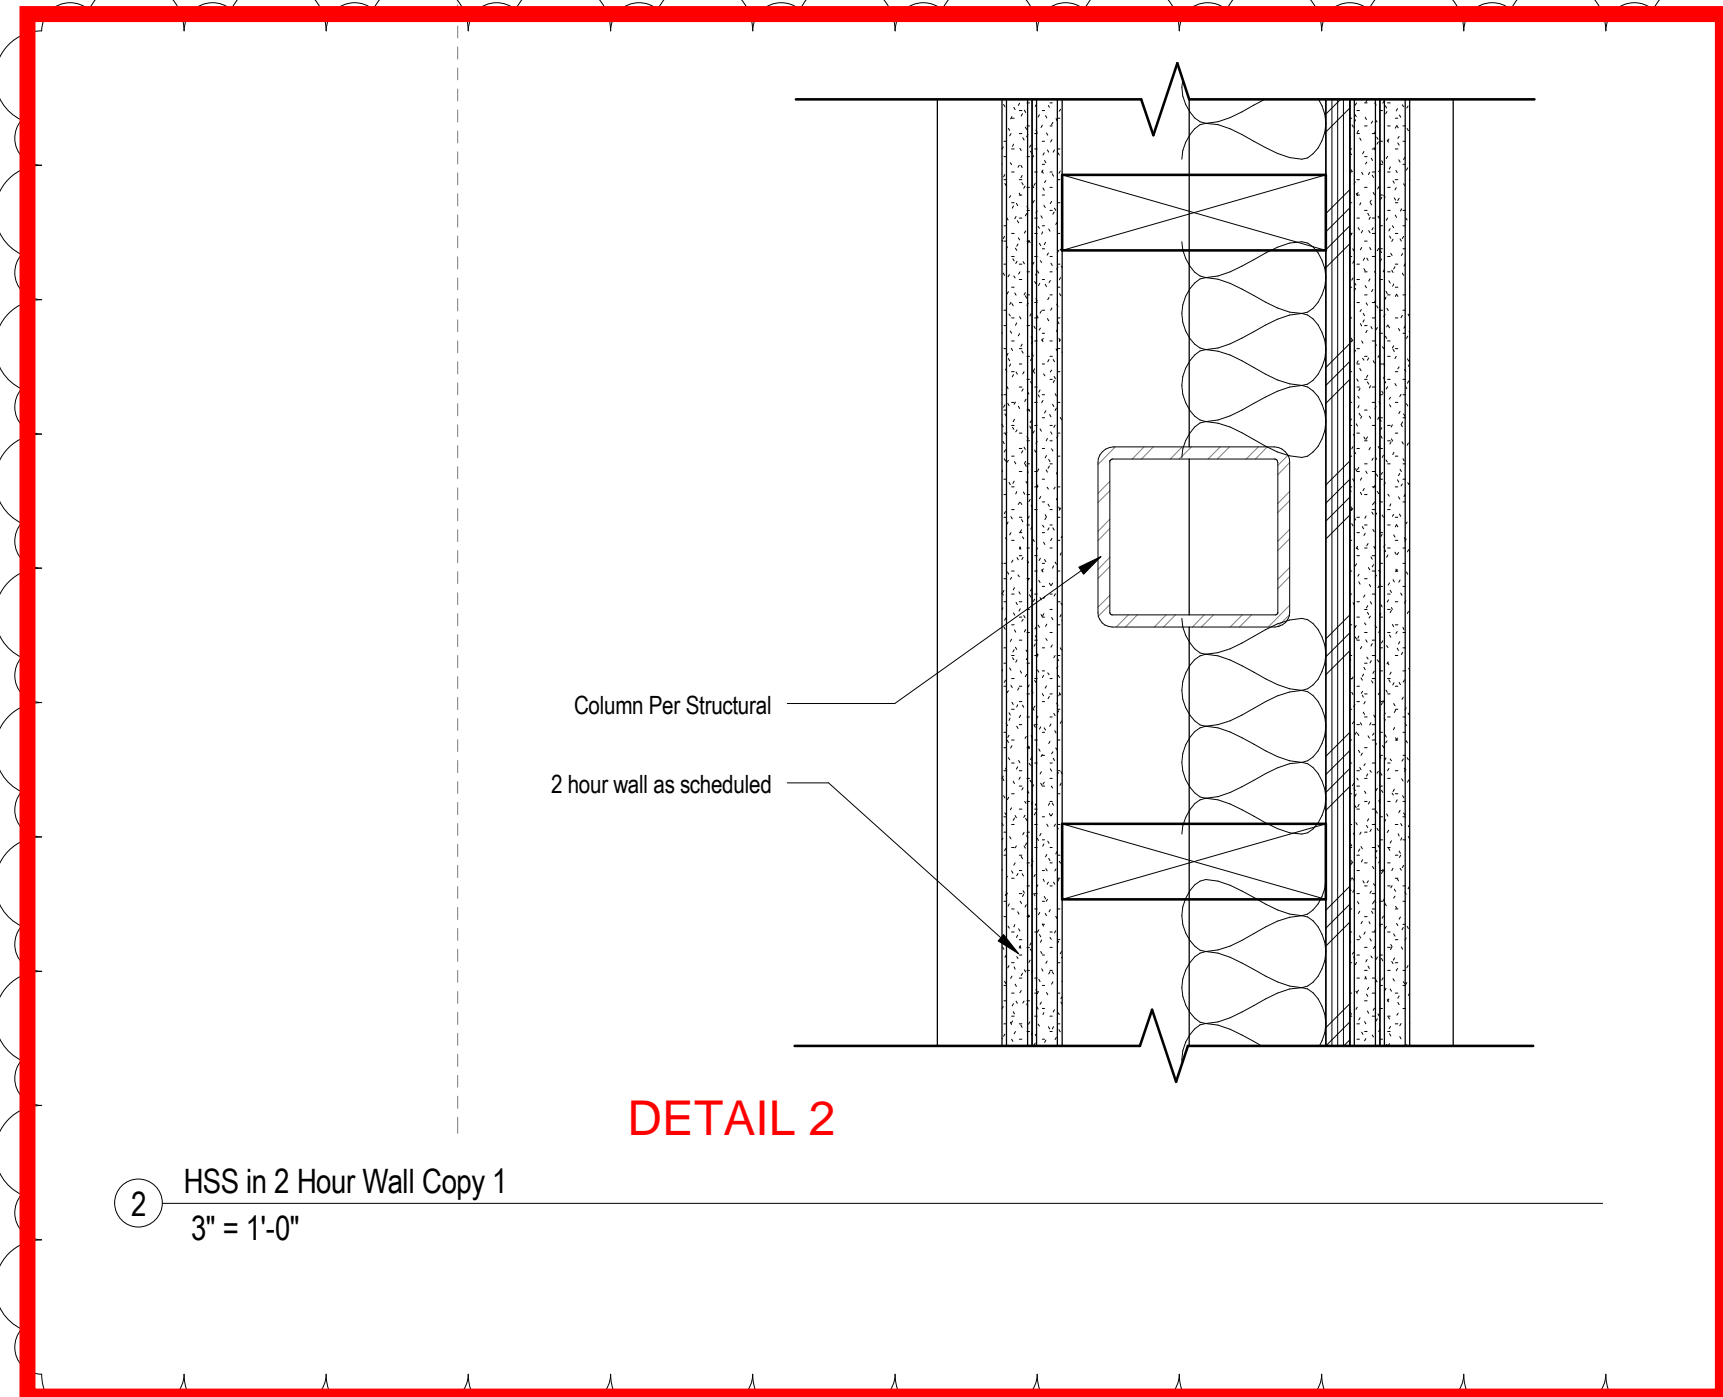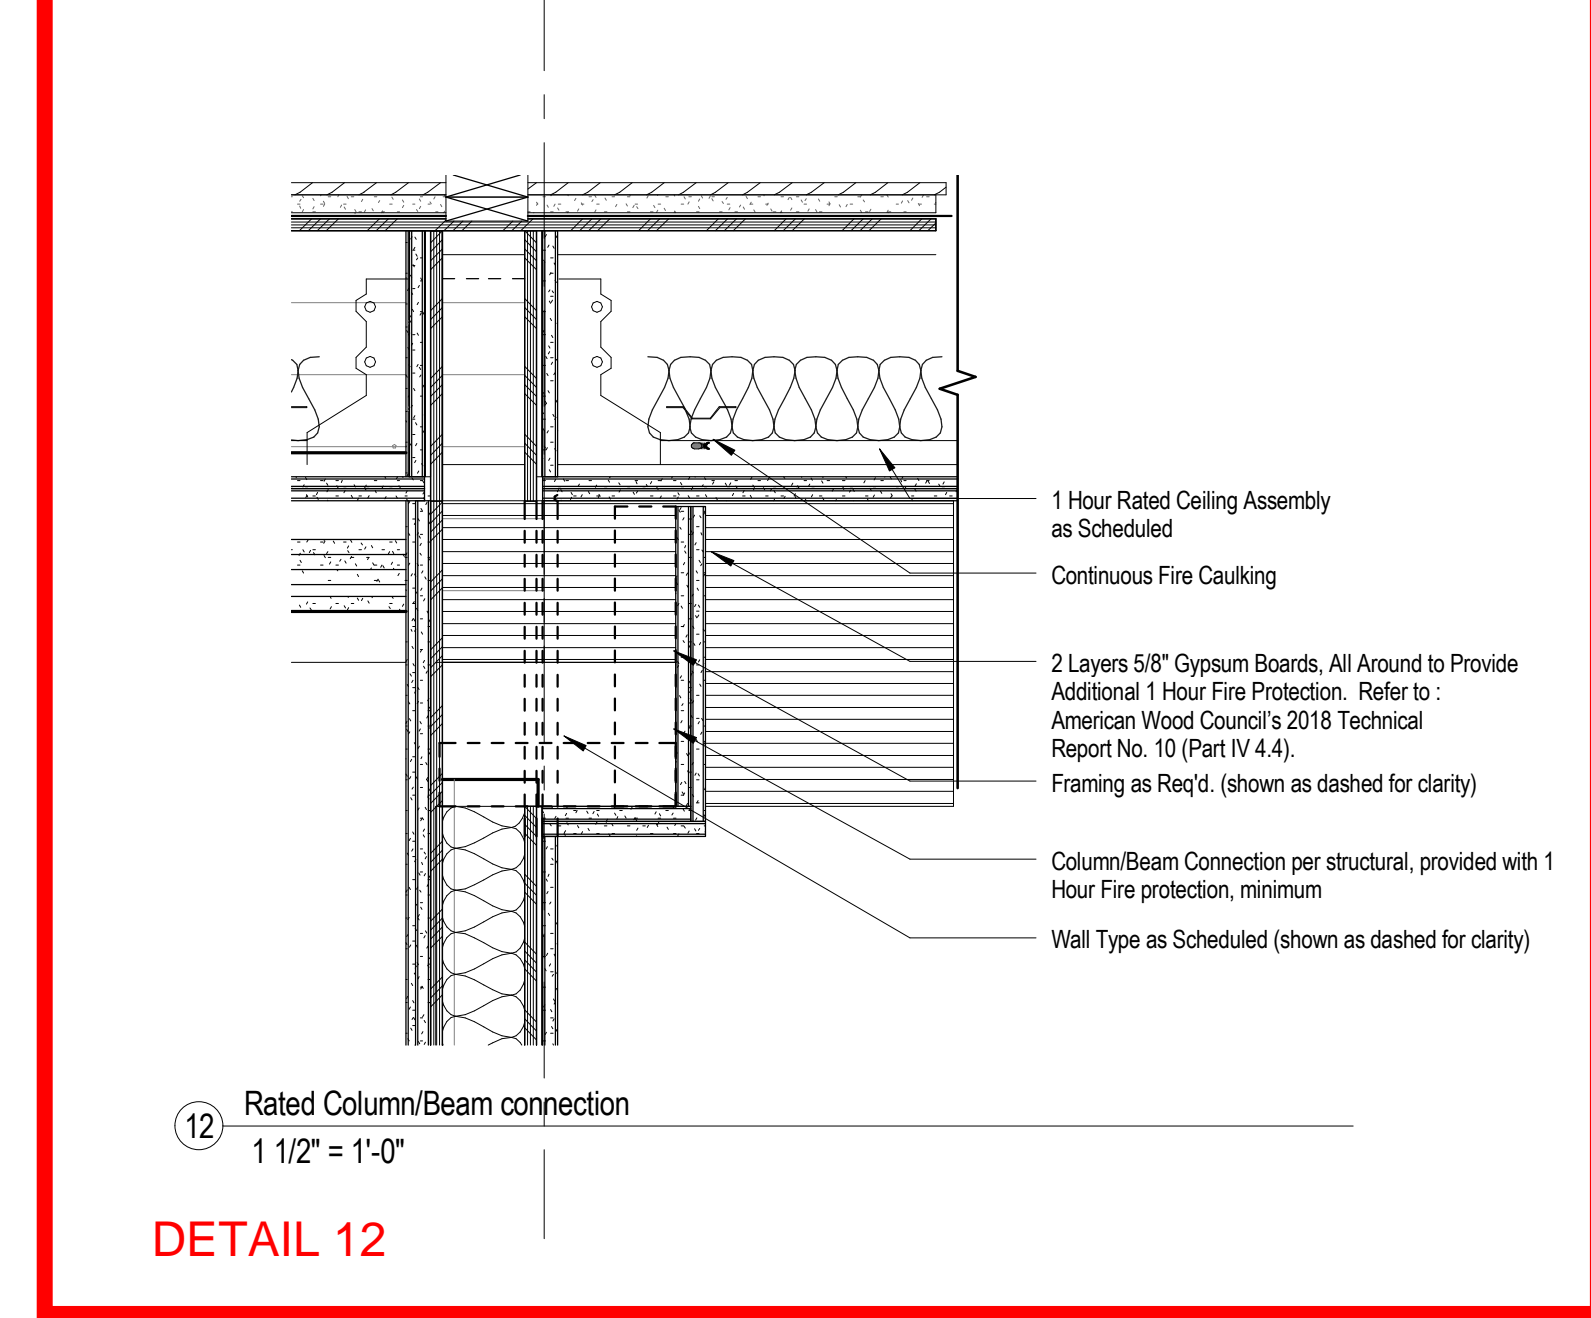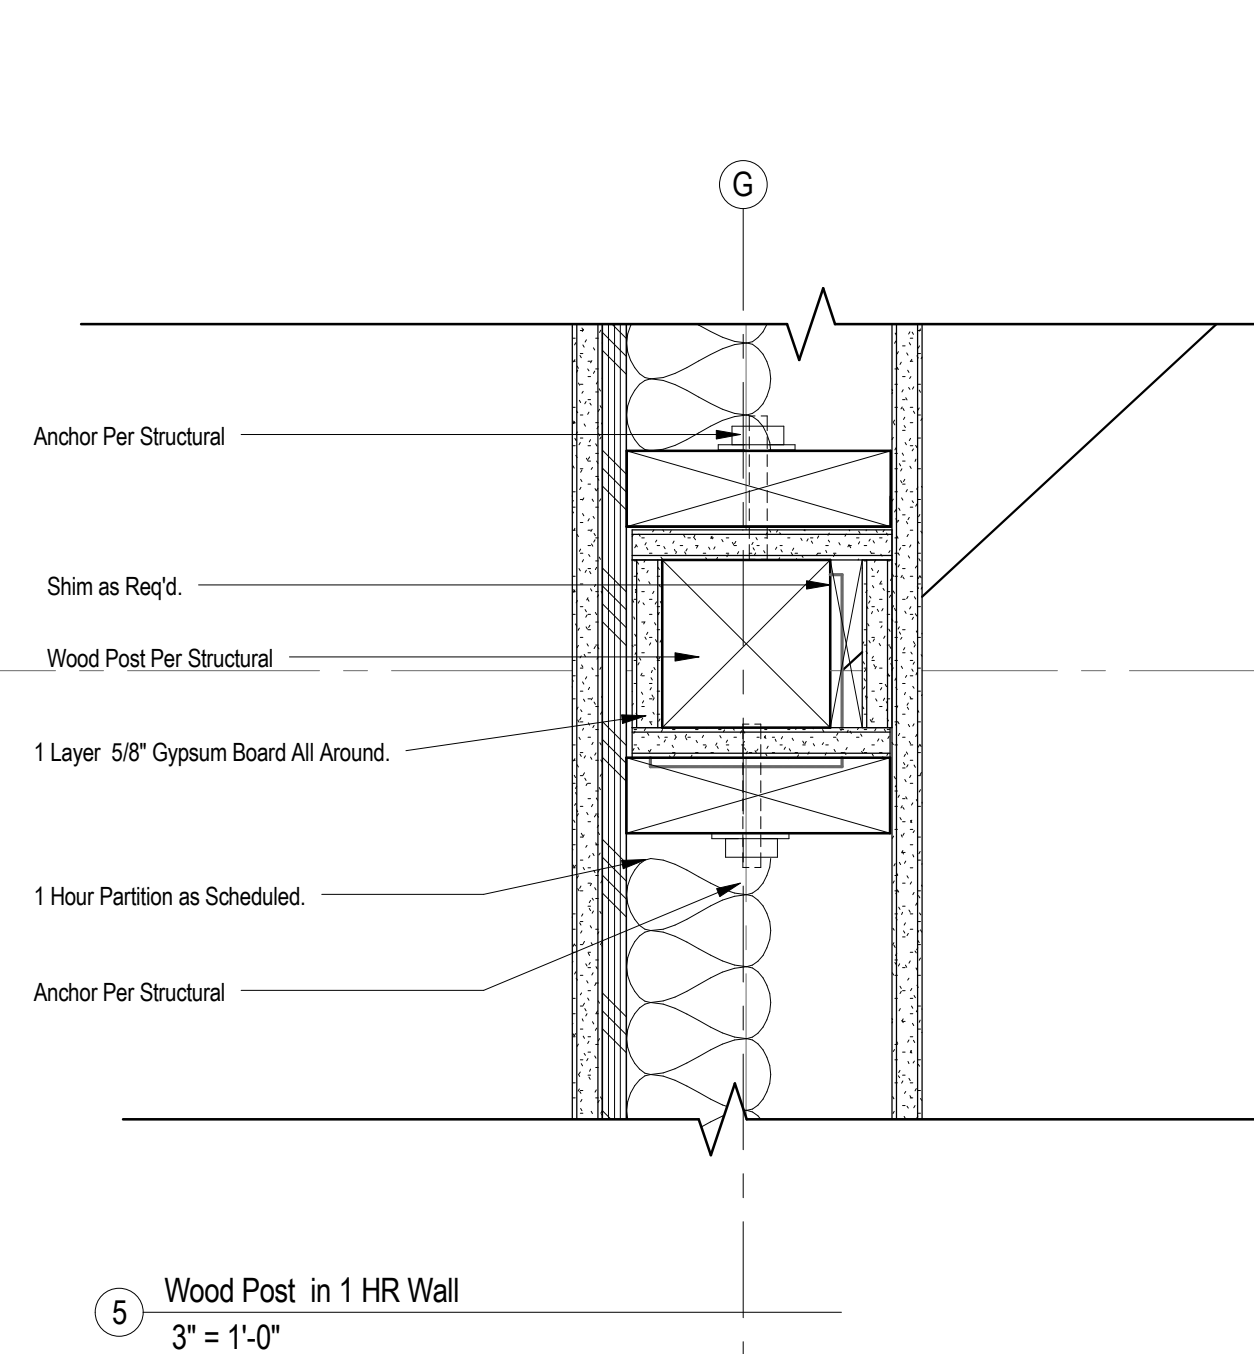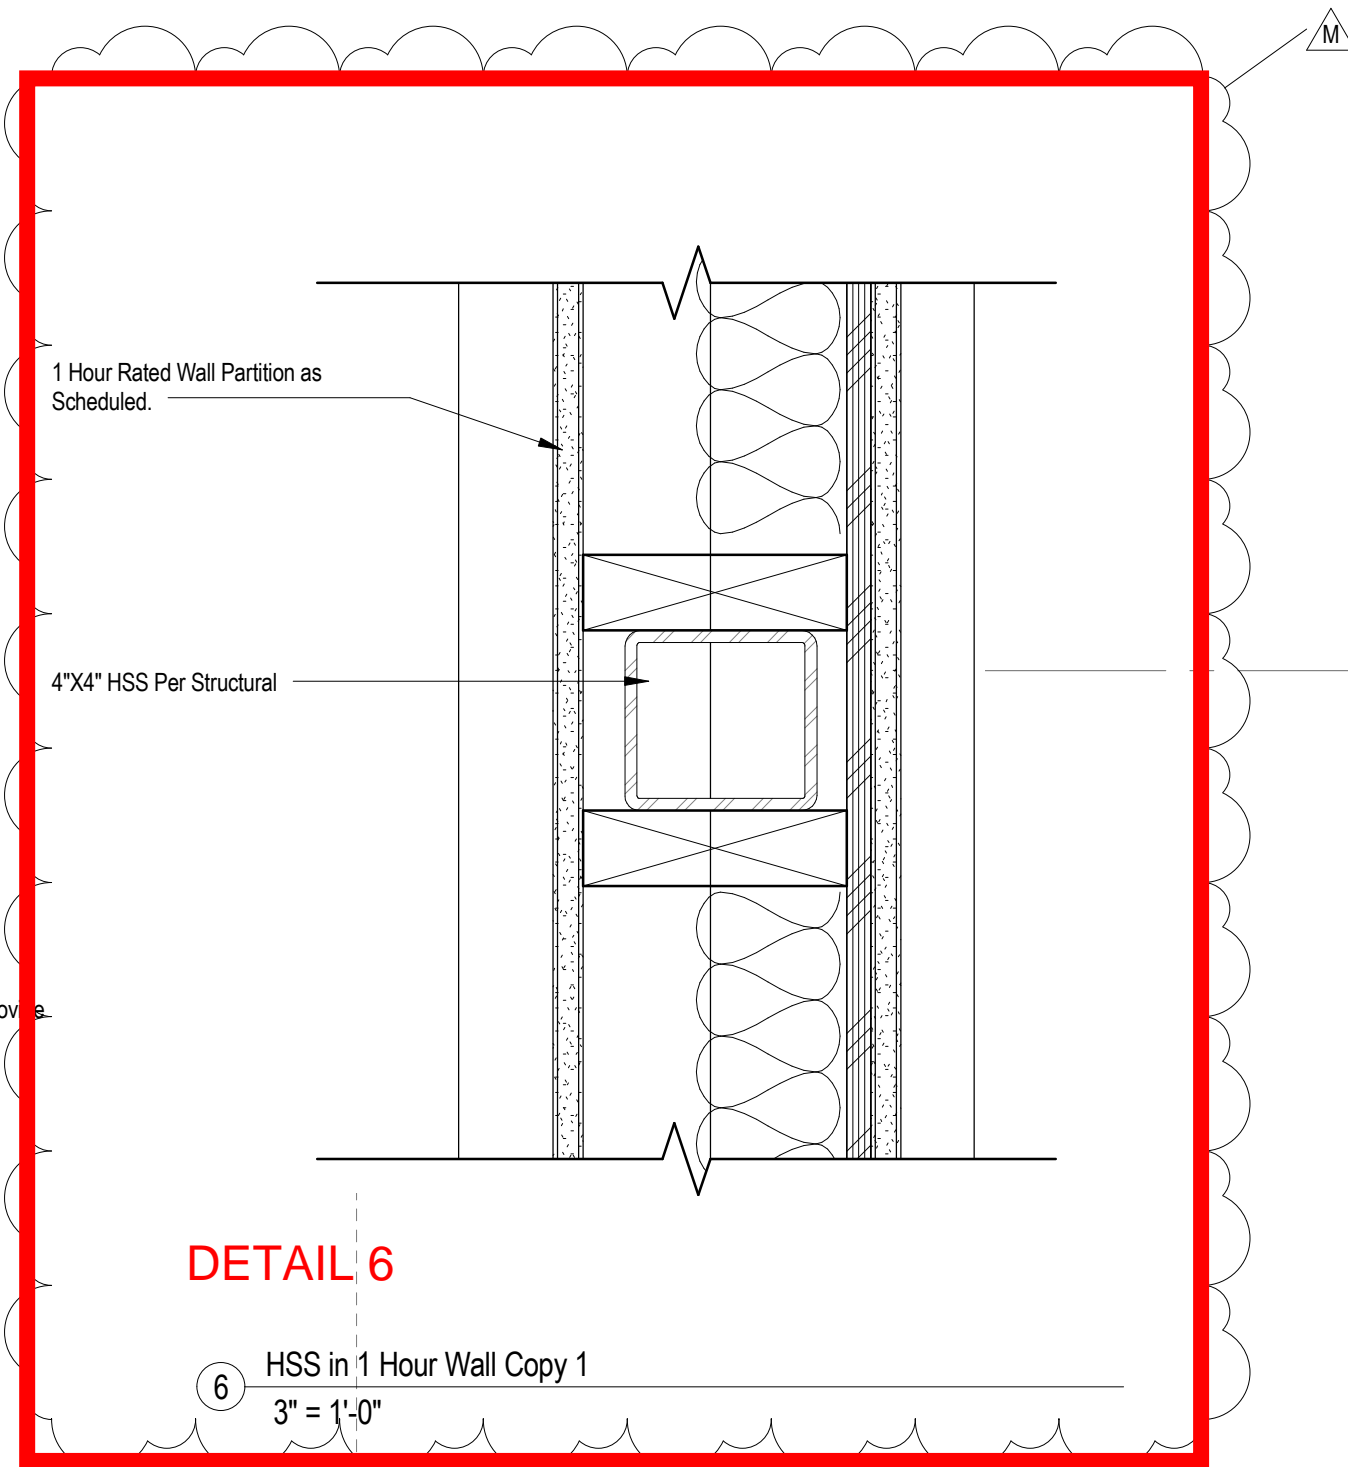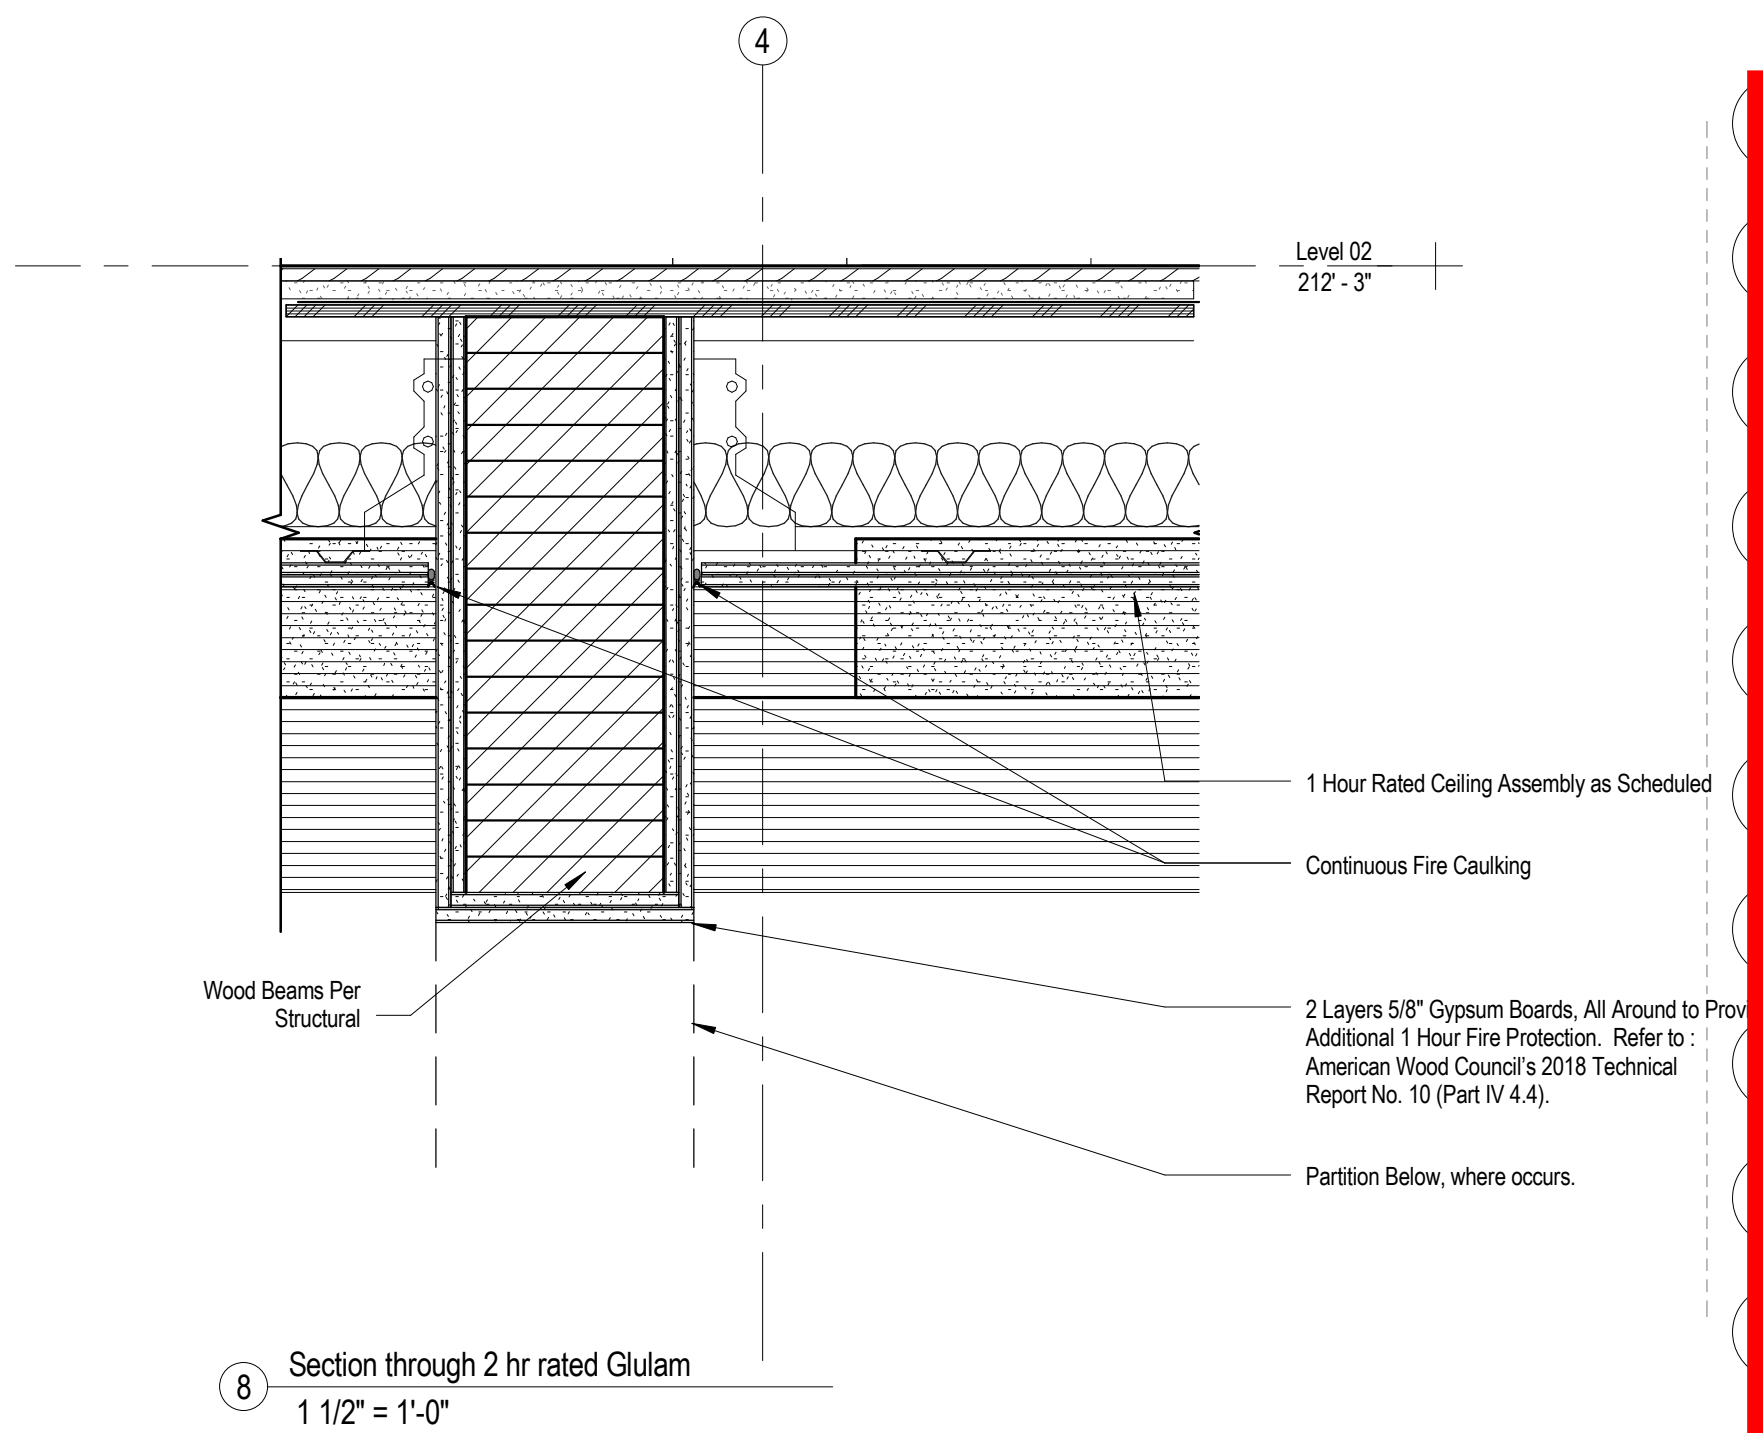


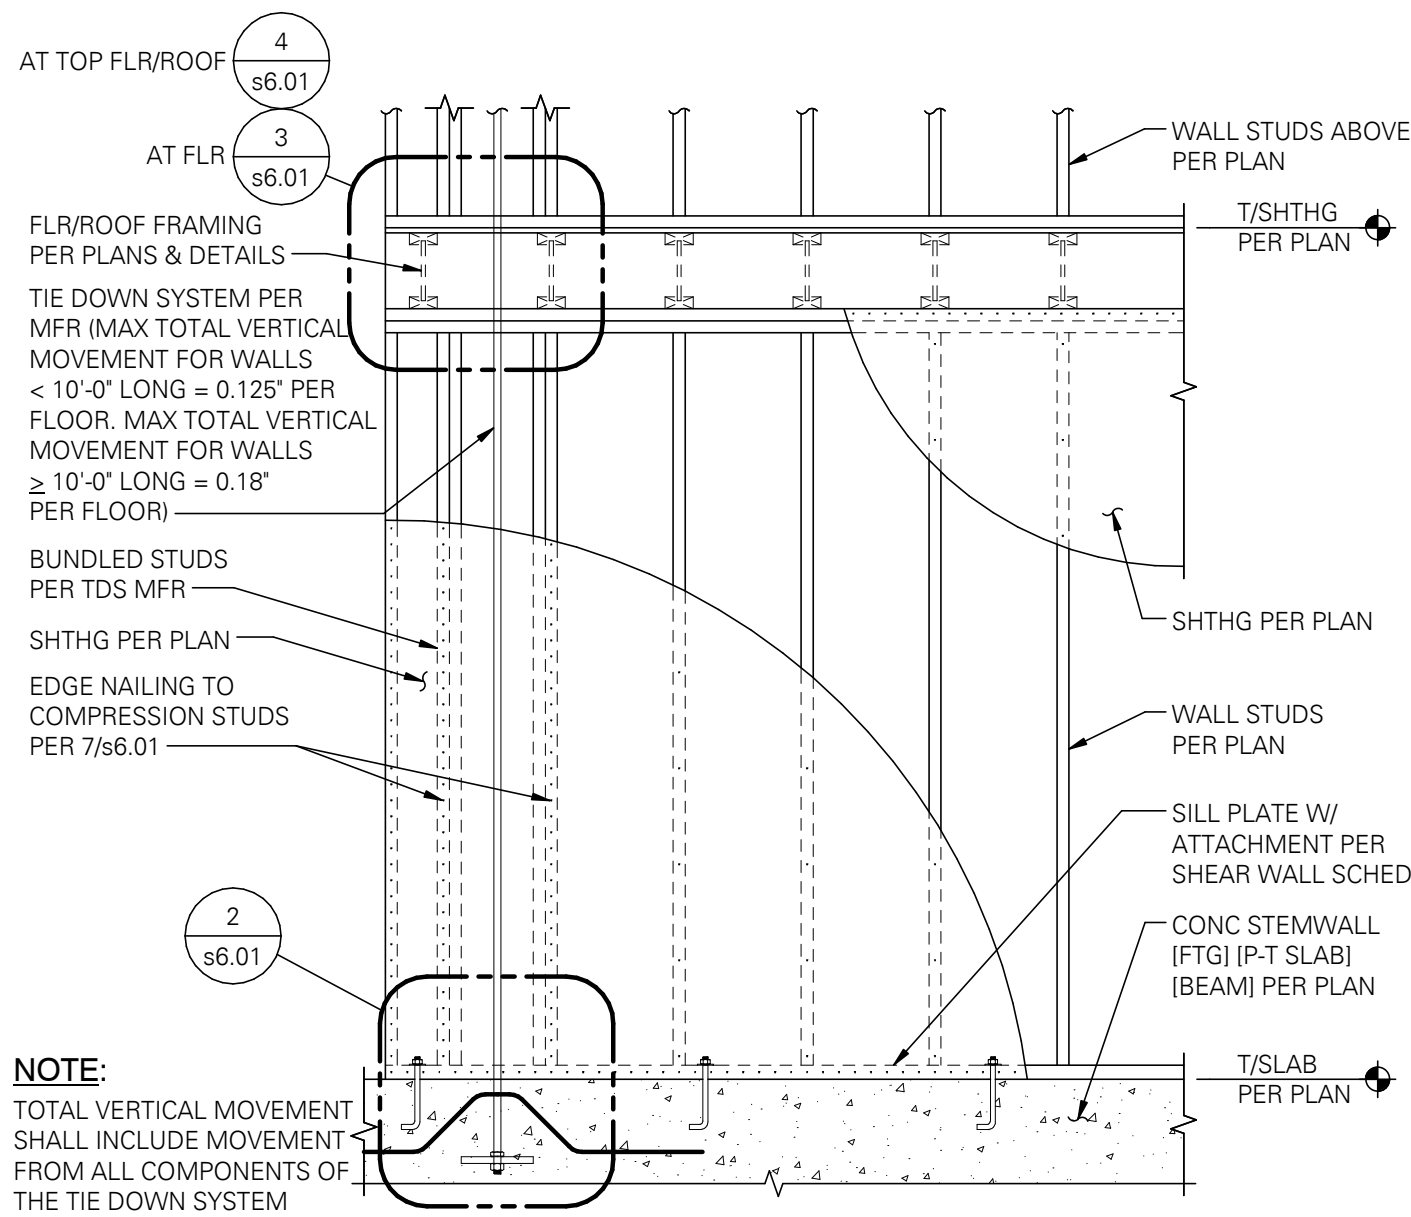


1 TYPICAL TDS SHEAR WALL ELEVATION
SCALE: 1/2" = 1'-0" (06090B)

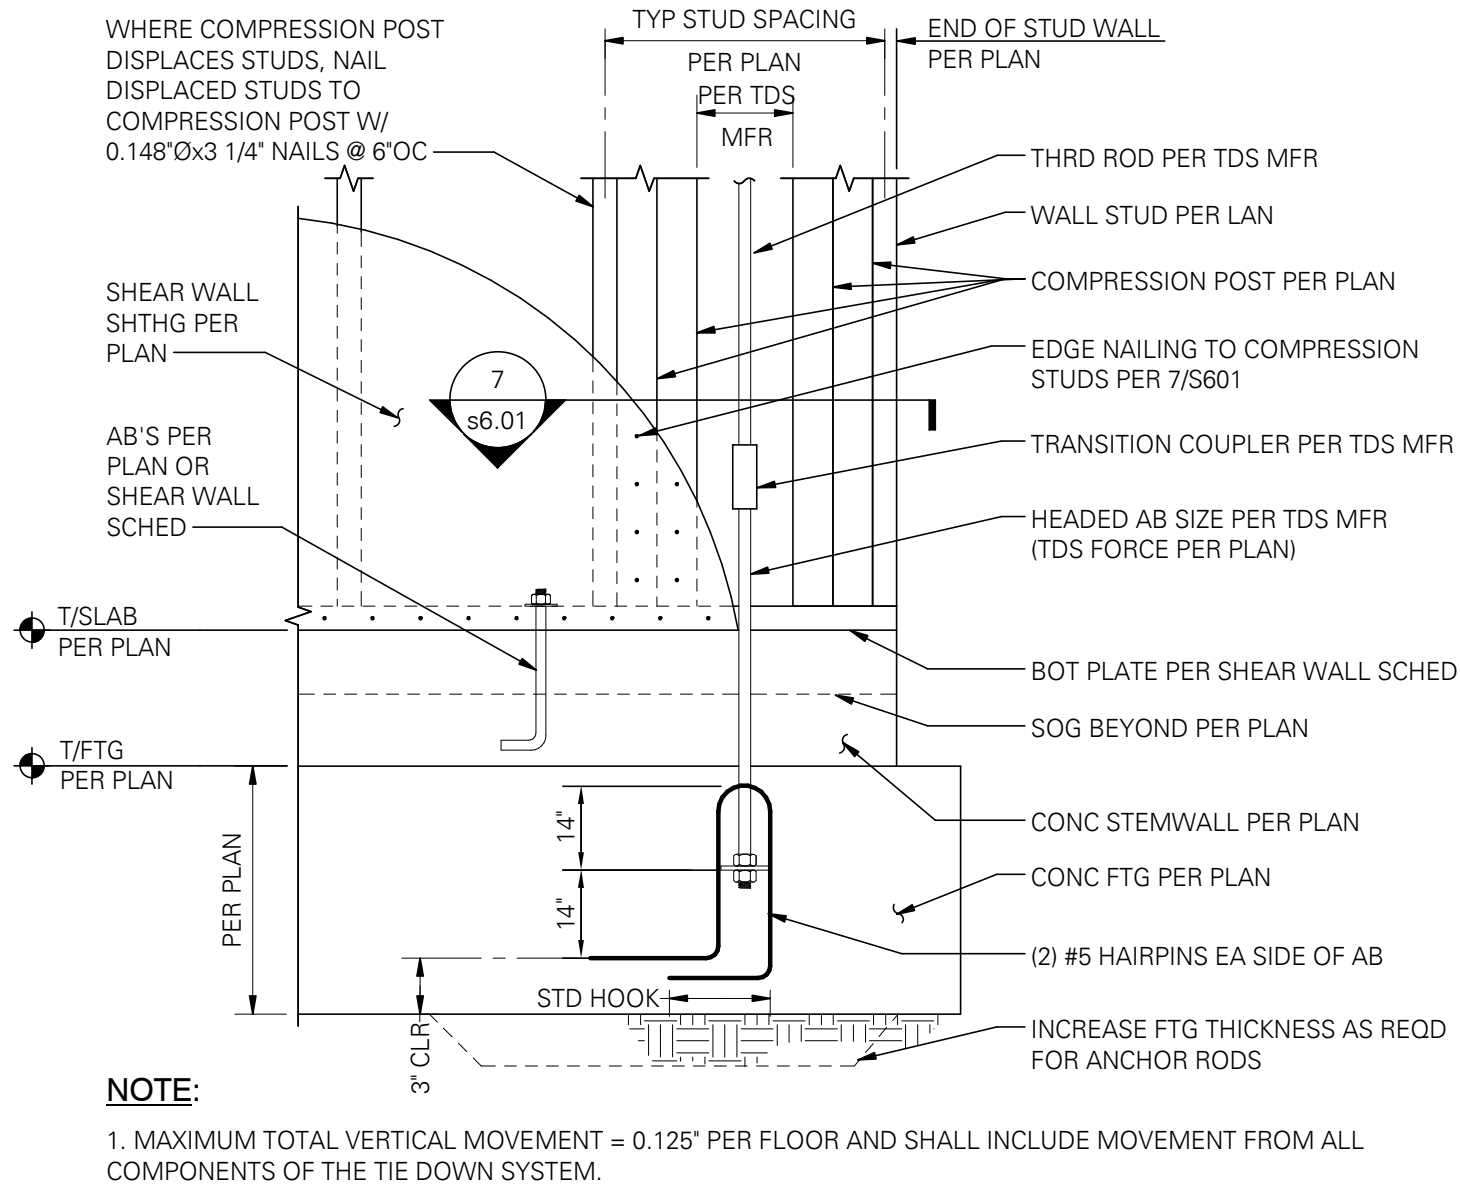

2 TYPICAL TIE-DOWN SYSTEM (TDS) AT FOUNDATION
SCALE: 1" = 1'-0" (06100)

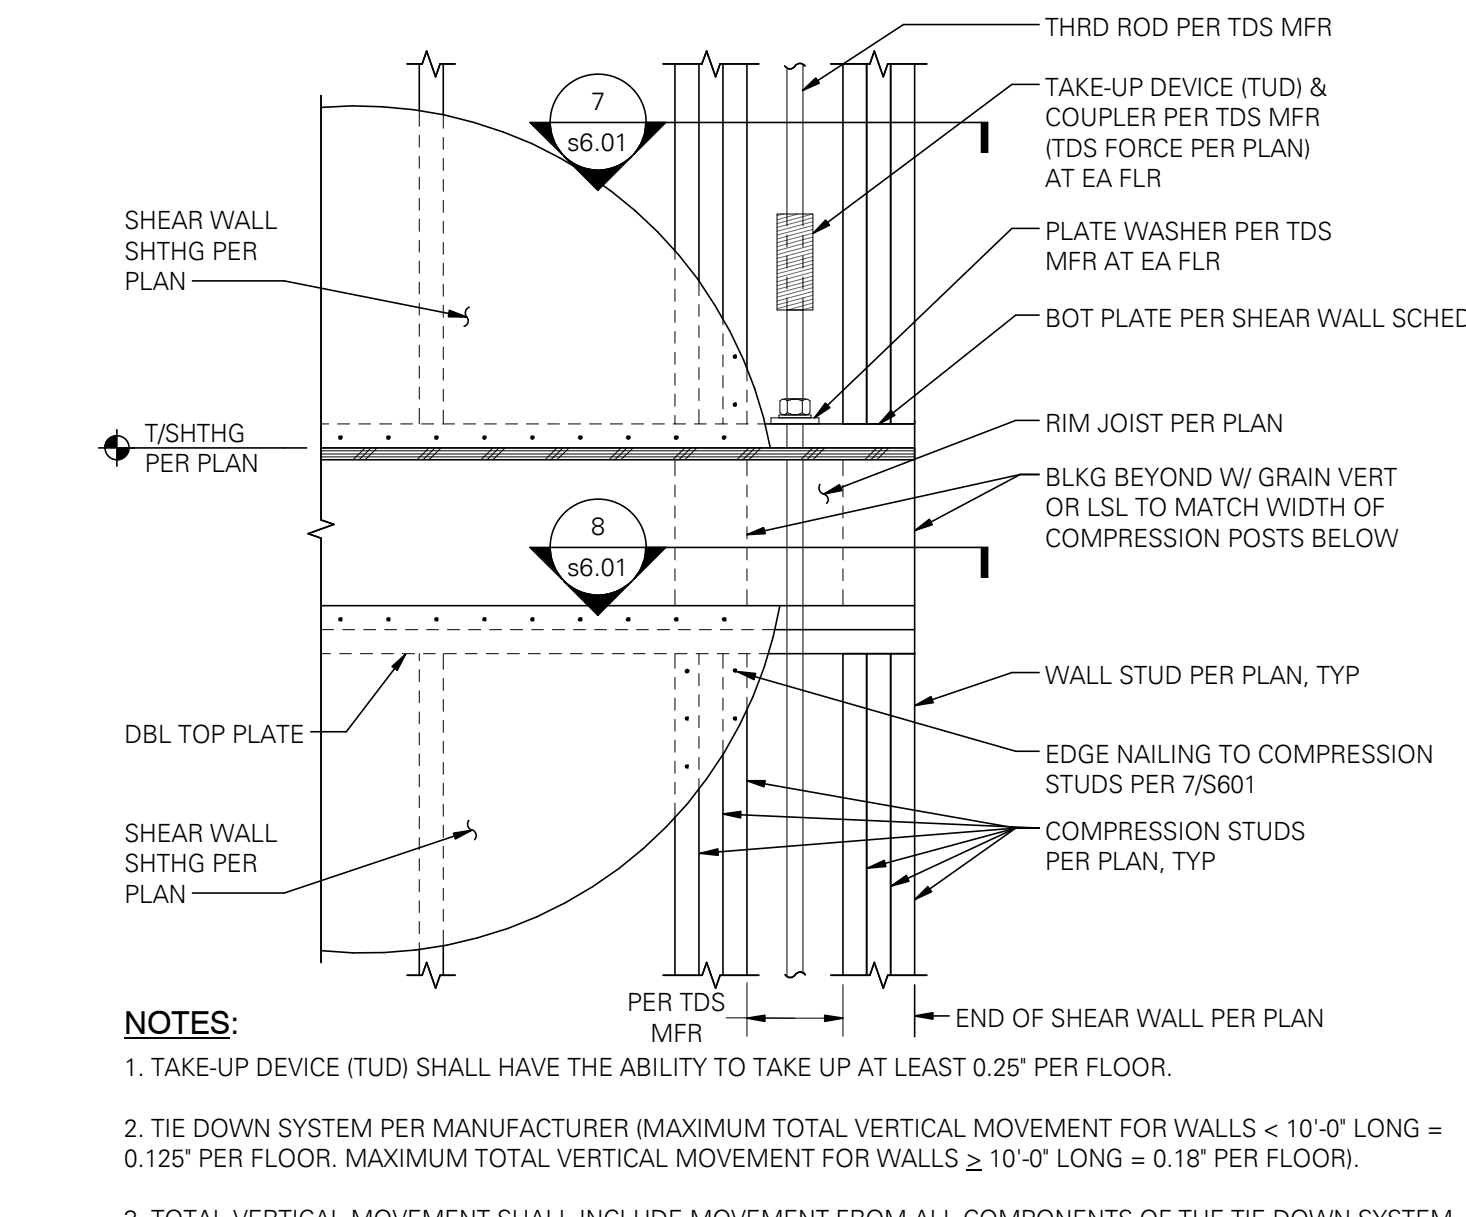


3 TYPICAL TIE DOWN SYSTEM (TDS) AT MID-STORY
SCALE: 1" = 1'-0" (06101)

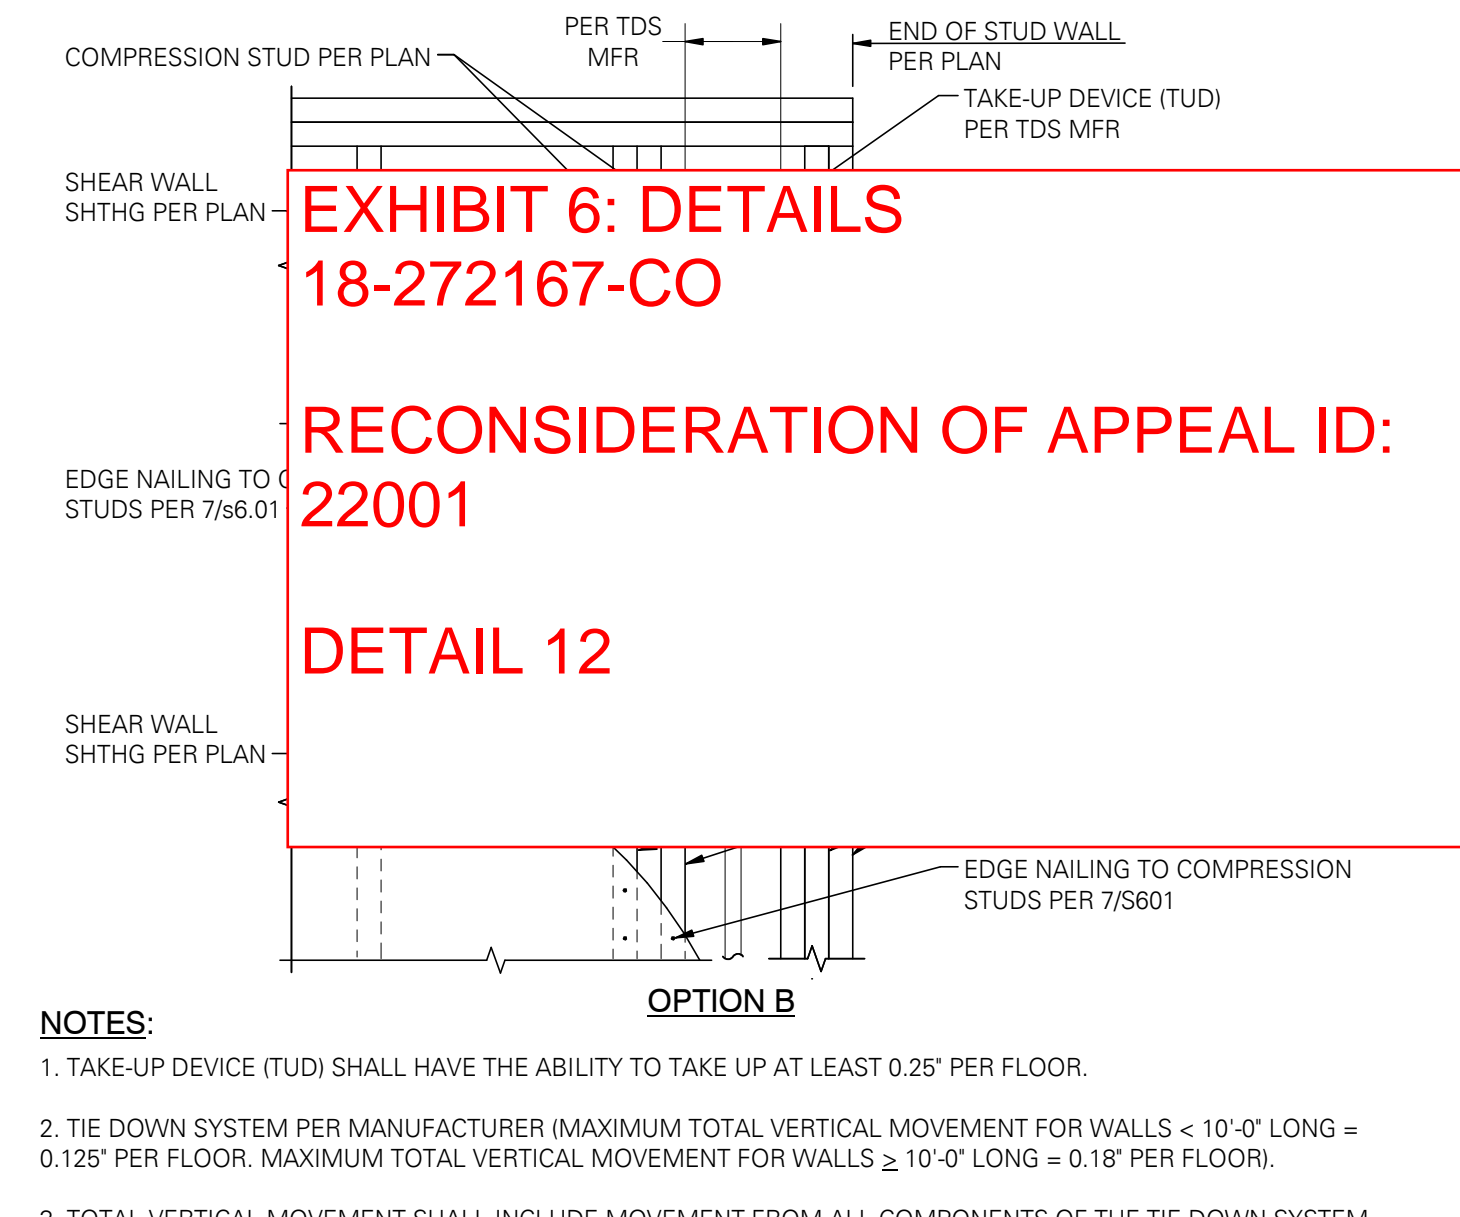


4 TYPICAL TIE DOWN SYSTEM (TDS) AT TOP STORY
SCALE: 1" = 1'-0" (Revised 06102)


SET ISSUE	
A	02/21/2019 Revision 1
D	04/18/2019 Revision D
E	04/29/2019 Revision E
G	05/24/2019 Revision G
H	06/13/2019 Plan Check

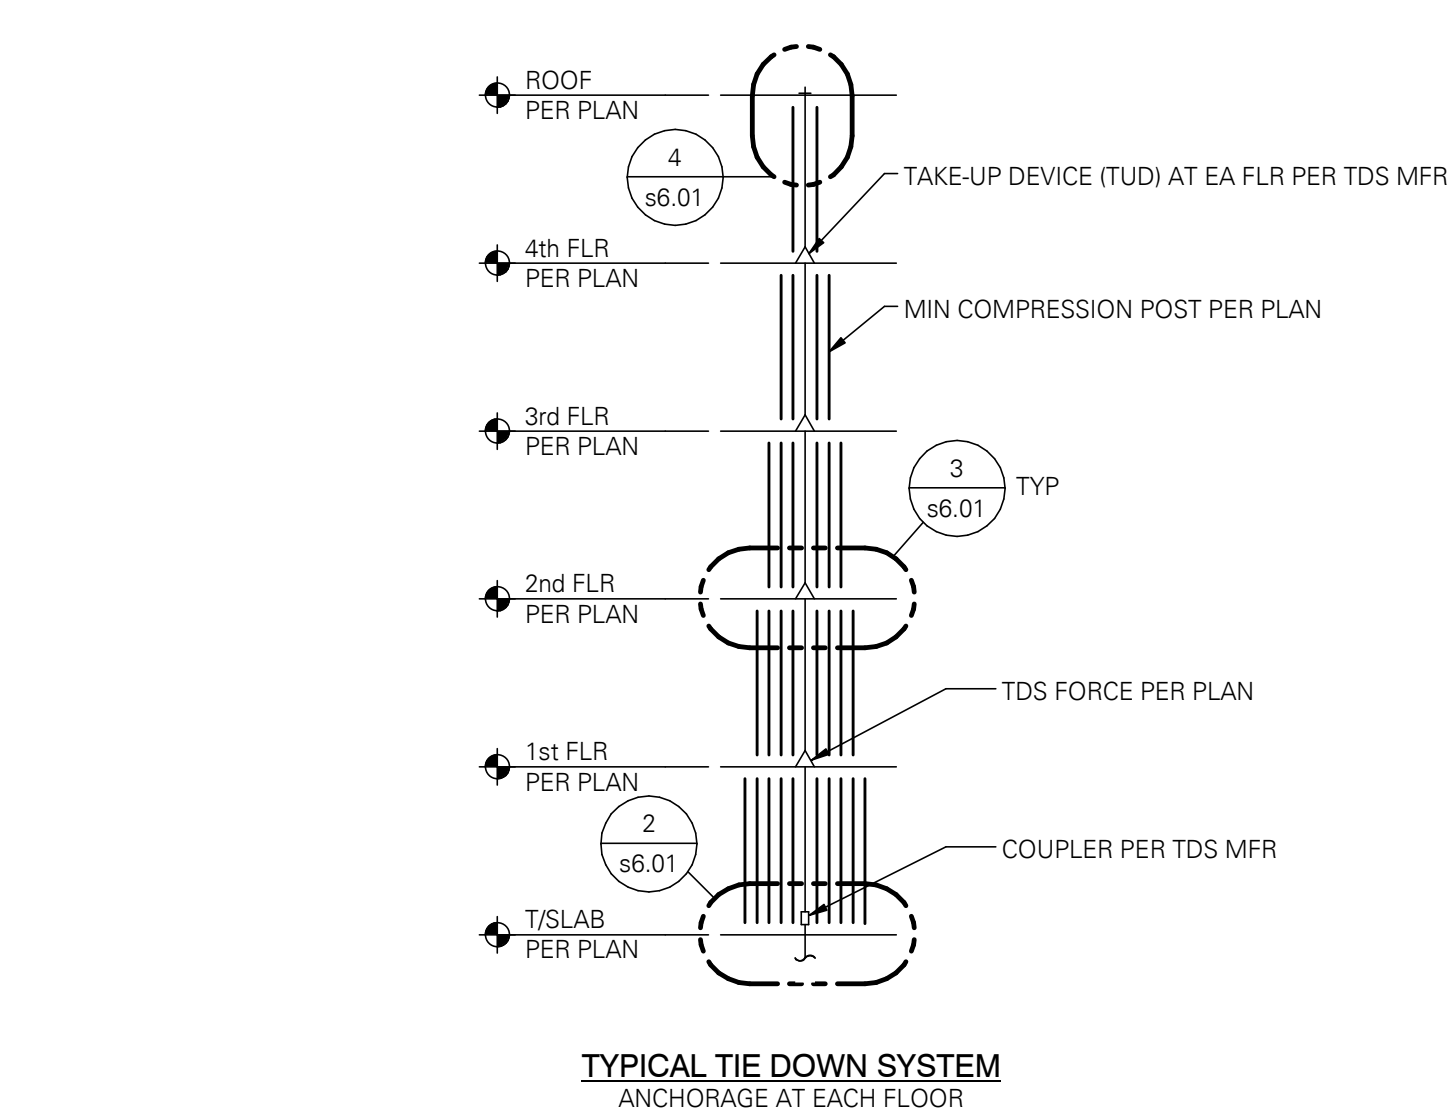


5 TYPICAL TIE DOWN SYSTEM (TDS) ELEVATION
SCALE: 1/8" = 1'-0" (06103)

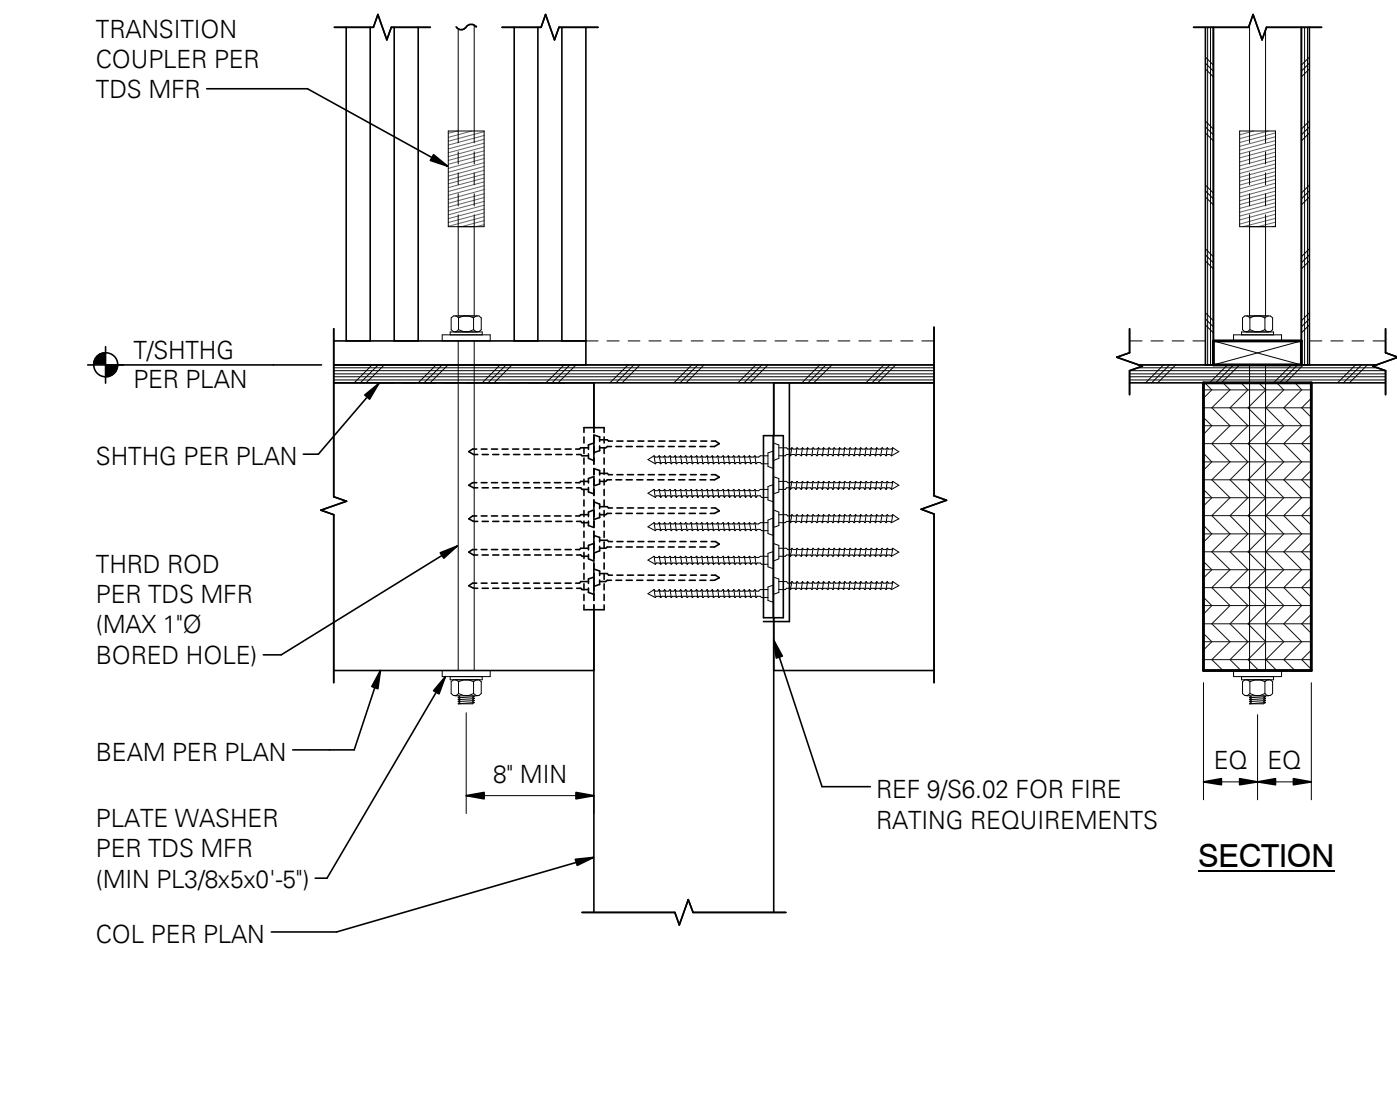

6 TYPICAL TDS CONNECTION TO GLULAM
SCALE: 1" = 1'-0"

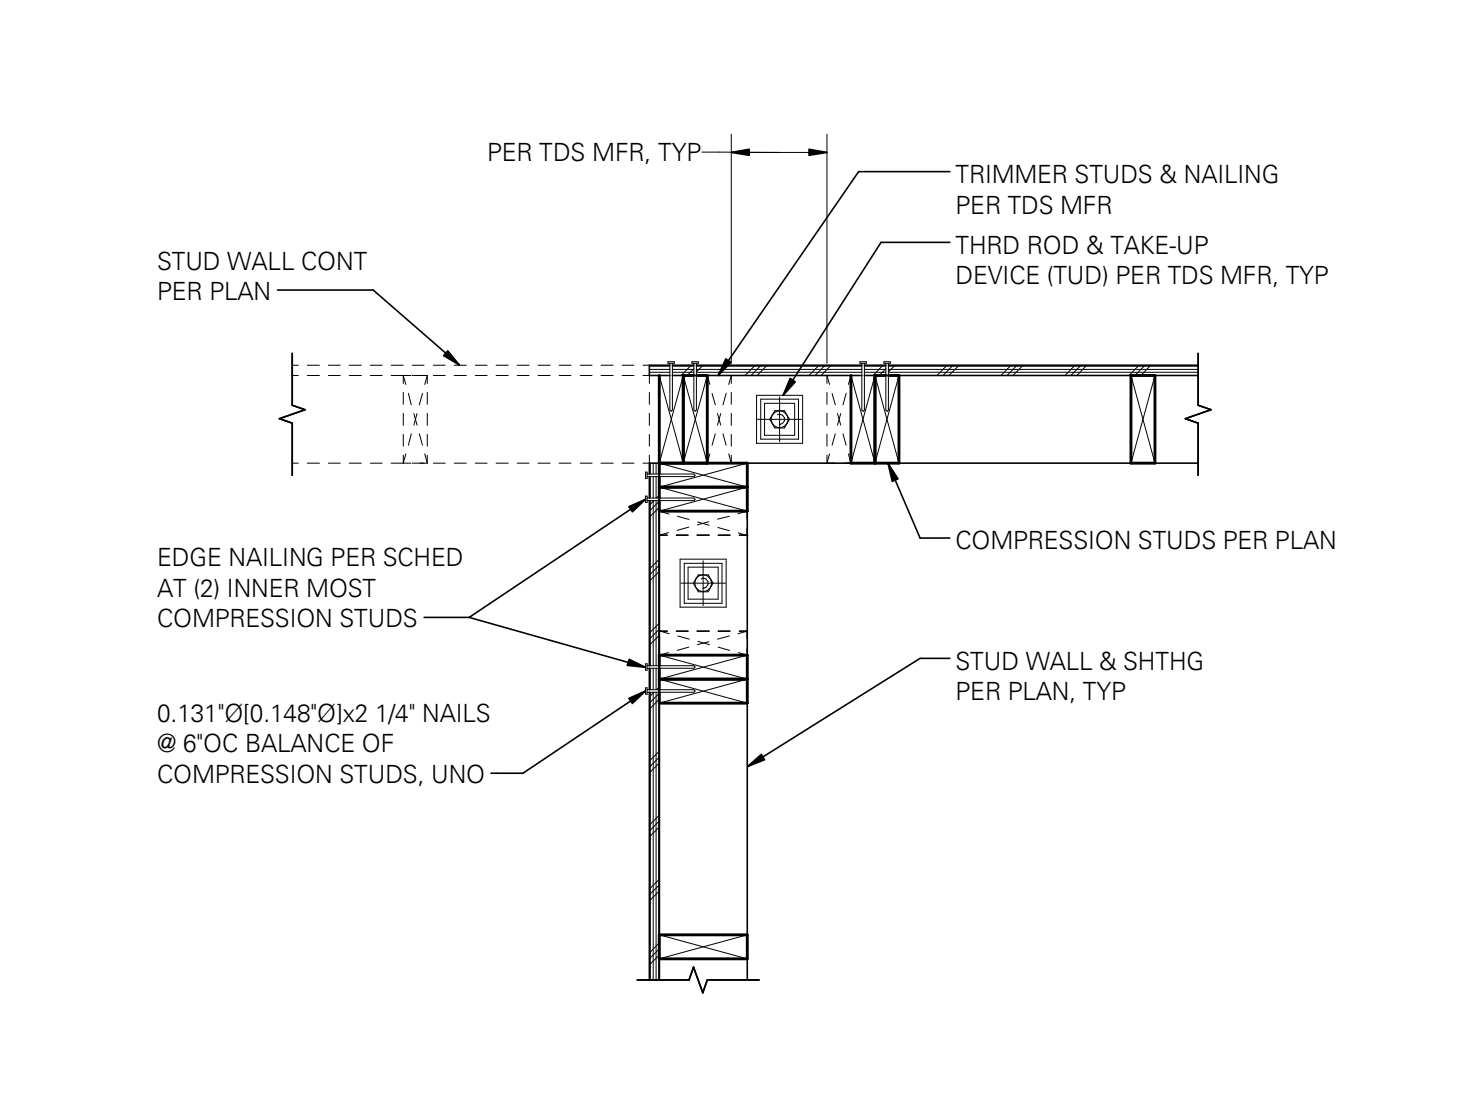

7 PLAN - INTERSECTING SHEAR WALLS AND
SHEAR WALL END TIE-DOWN ANCHOR LOCATIONS
SCALE: 1" = 1'-0" (06120)

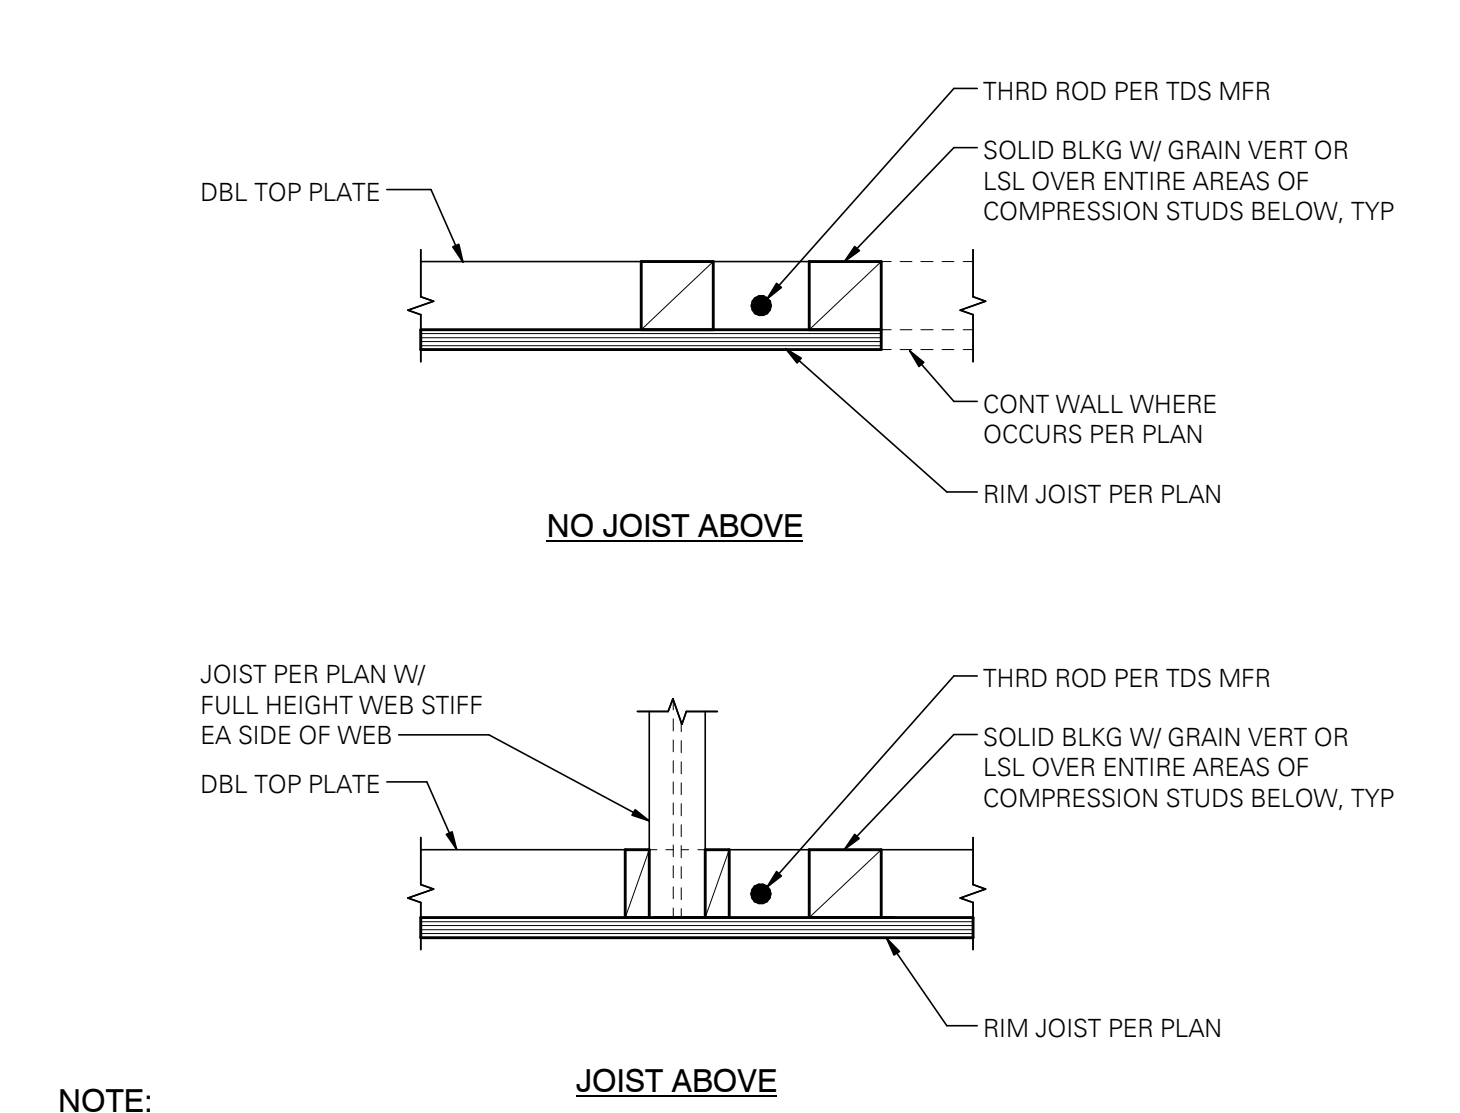


8 PLAN - BLOCKING AT
TIE DOWN SYSTEM (TDS) AT RIM JOIST
SCALE: 1" = 1'-0" (06122)


HOLD-DOWN/STRAP SCHEDULE - DOUG-FIR STUDS								
[1, 2, 7, 11] INDICATES FOOTNOTES								
	TYPE	NUMBER OF STUDS/POST [3, 12]	NAILS, SCREWS OR BOLTS	DIAMETER [10]	ANCHOR [4]			NOTES
					CONCRETE EMBEDMENT/CAPACITY	STEMWALL [5]	FOOTING	
CONCRETE TO WOOD	HDU5	(2) 2x	(14) SDS1/4x2 1/2	5/8"Ø	EMBED CIP [6, 14]	CAPACITY	EMBED CIP [6]	CAPACITY
					10"	5.2k	8"	5.6k

9 HOLD-DOWN/STRAP SCHEDULE - DOUG-FIR STUDS
SCALE: 1" = 1'-0" (01420)

- NOTES:
- [1] SOME HOLD-DOWN TYPES MAY NOT BE USED ON THIS PROJECT.
 - [2] TYPICAL HOLD-DOWN DETAILS PER 12/s6.01. ANCHOR REINFORCEMENT REQUIRED AT STEMWALLS.
 - [3] PROVIDE PANEL EDGE NAILING PER SHEAR WALL SCHEDULE AT HOLD-DOWN STUDS/POSTS.
 - [4] BASED ON MINIMUM $f'_c = 3000$ PSI CONCRETE.
 - [6] CAST-IN-PLACE (CIP) TYPE THREADED RODS AT HOLD-DOWNS SHALL HAVE TWO HEX HEAD NUTS WITH OVERSIZED WASHERS.
 - [7] INCLUDES 1.6 LOAD DURATION INCREASE FOR WOOD.
 - [10] AT PRESSURE TREATED SILLS, USE HOT DIPPED GALVANIZED BOLTS.
 - [11] POST INSTALLED HOLD-DOWN OPTIONS MAY BE AVAILABLE AT SOME CONDITIONS. CONTACT ENGINEER OF RECORD PRIOR TO CONSTRUCTION.
 - [12] NAIL LAMINATE MULTIPLE 2x STUDS WITH PLATE NAILING PER SHEAR WALL SCHEDULE.
 - [13] MIDWALL/CORNER WALL END

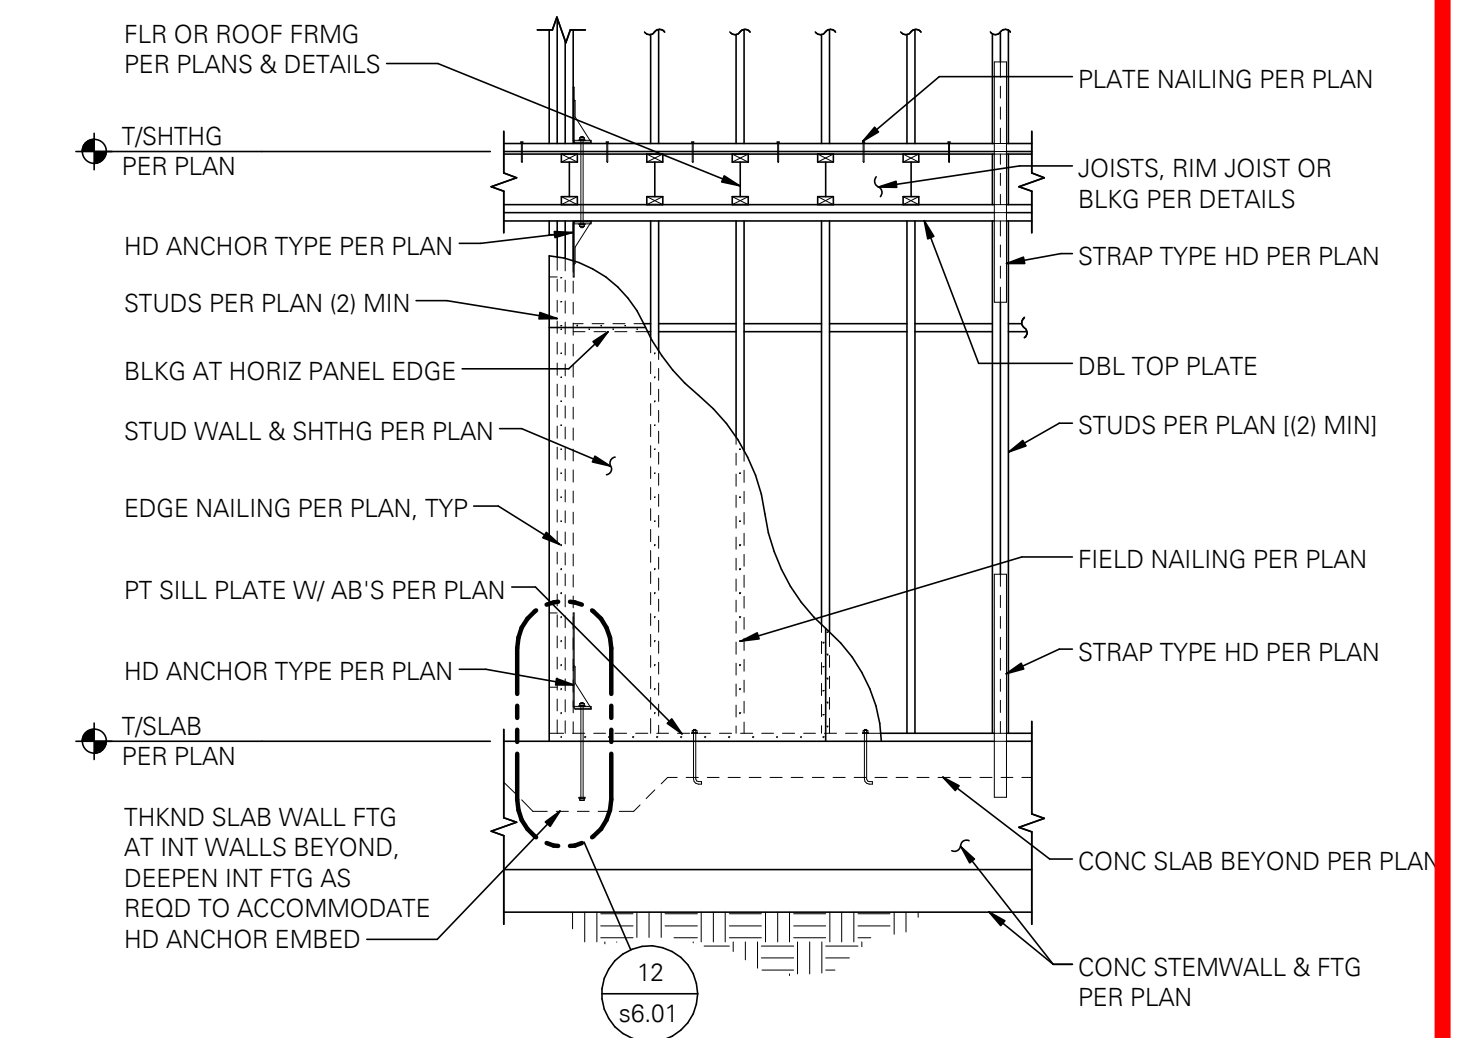

11 TYPICAL SHEAR WALL ELEVATION
SCALE: 1" = 1'-0" (06090)

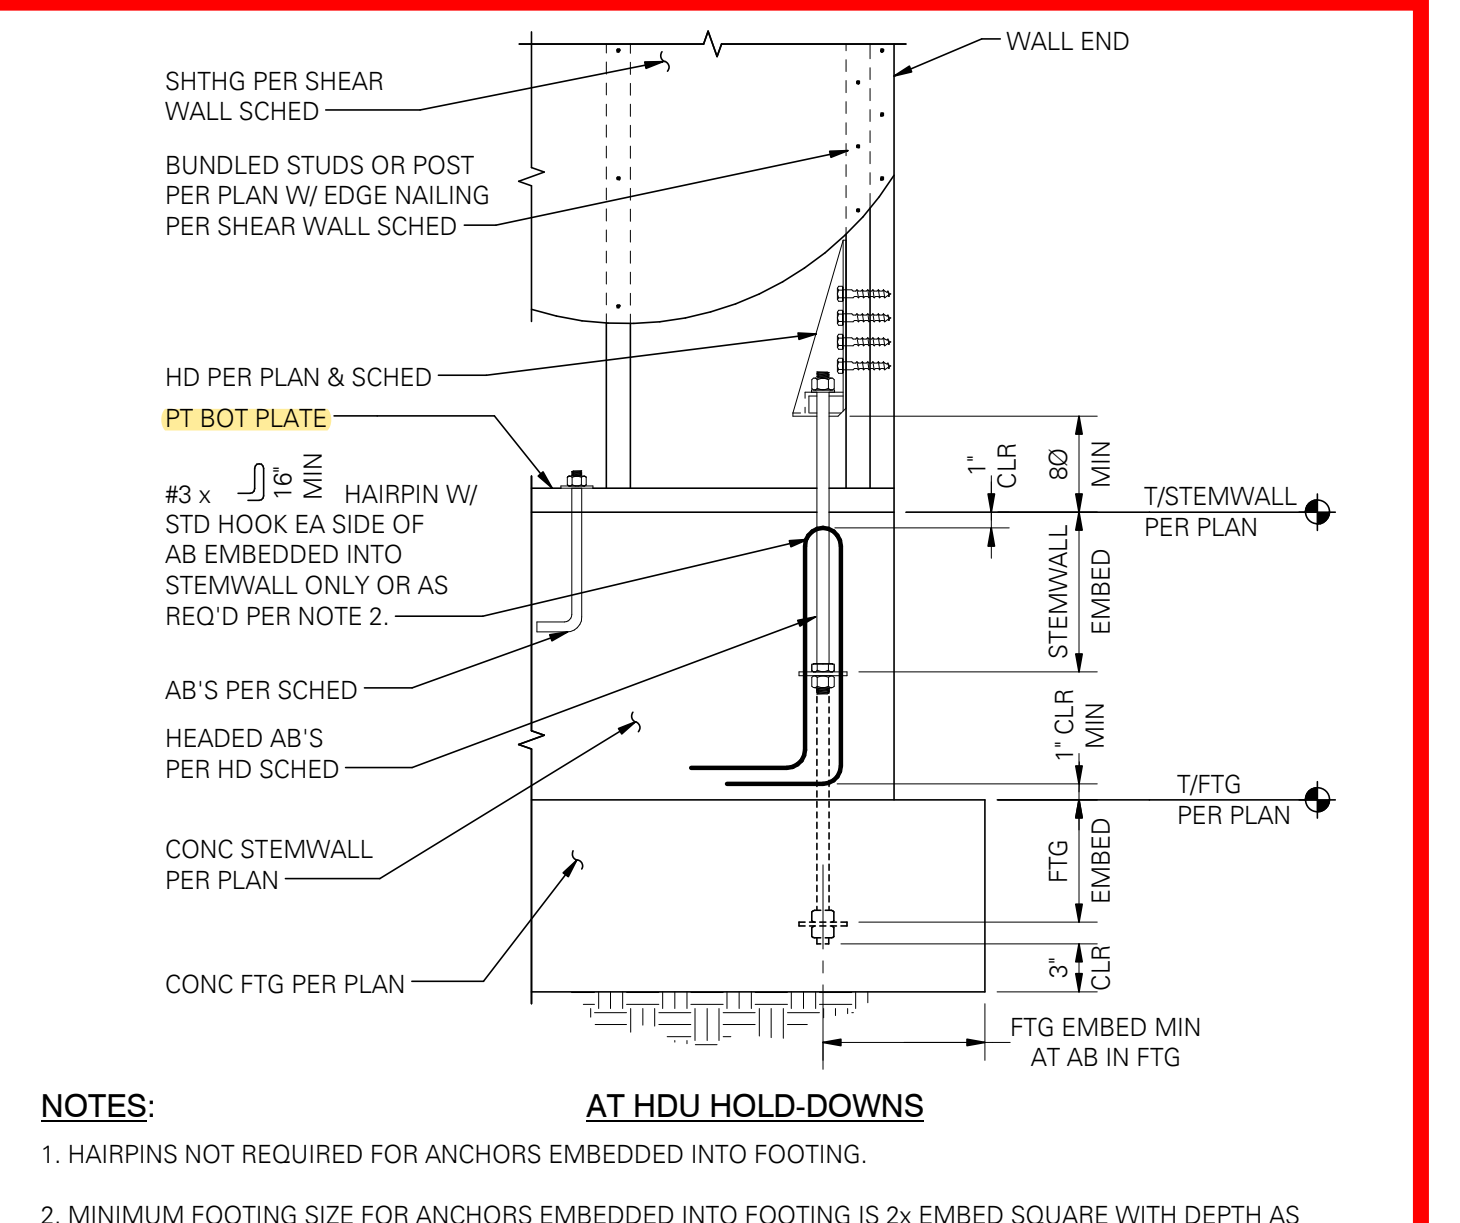

12 TYPICAL HOLD-DOWN AT FOUNDATION -
CONCRETE STEMWALL
SCALE: 1" = 1'-0" (06091)

