Development Services

From Concept to Construction

Phone: 503-823-7300 Email: bds@portlandoregon.gov 1900 SW 4th Ave, Portland, OR 97201 More Contact Info (http://www.portlandoregon.gov//bds/article/519984)

APPEAL SUMMARY
Status: Decision Rendered
Appeal ID: 23410

Hearing Date: 2/5/20	Appellant Name: Sinan Gumusoglu
Case No.: B-006	Appellant Phone: 9713368179
Appeal Type: Building	Plans Examiner/Inspector: Steven Mortensen
Project Type: commercial	Stories: 3 Occupancy: R-2 Construction Type: V-B
Building/Business Name: Greenwich Ave. apartme	nts Fire Sprinklers: Yes - Throuhout
Appeal Involves: Erection of a new structure	LUR or Permit Application No.: 19-217558-CO
Plan Submitted Option: pdf [File 1]	Proposed use: Apartment building

Project Address: 7336 N Greenwich Ave

APPEAL INFORMATION SHEET

Appeal item 1

Appear item 1		
Code Section	1027.4.2	
Requires	OSSC 2902.2 exception 2 requires a single unisex toilet	
Code Modification or Alternate Requested	Requesting an approval to not provide a toilet in the Community room	
Proposed Design	The community room (496sf.), as designed, is located on the ground floor, easily accessible to the tenants of the building. The small community room is private and not open to the public. Community room users will be either residents or guests of residents living in the apartment building, all of whom have convenient access to private toilets and lavatory facilities in the bathrooms of their apartment units.	
Reason for alternative	We are submitting this request for appeal based on the fact that this small housing project with limited common space can't afford to lose valuable "amenity" floor space in the community room. Even a small bathroom would diminish the minimal usable community space by at least 15%. Further, because apartment residents and their guests will have access to restrooms in their private units, and because there will be no public access to the community room, the addition of a restroom in the community room would be both redundant and wasteful.	

APPEAL DECISION

Omission of toilet room to serve Community Room: Granted as proposed based on limited number of occupants and use by tenants only.

The Administrative Appeal Board finds that the information submitted by the appellant demonstrates that the approved modifications or alternate methods are consistent with the intent of the code; do not lessen health,

https://www.portlandoregon.gov/bds/appeals/index.cfm?action=entry&appeal_id=23410






Appeals | The City of Portland, Oregon


safety, accessibility, life, fire safety or structural requirements; and that special conditions unique to this project make strict application of those code sections impractical.

Pursuant to City Code Chapter 24.10, you may appeal this decision to the Building Code Board of Appeal within 90 calendar days of the date this decision is published. For information on the appeals process, go to www.portlandoregon.gov/bds/appealsinfo, call (503) 823-7300 or come in to the Development Services Center.

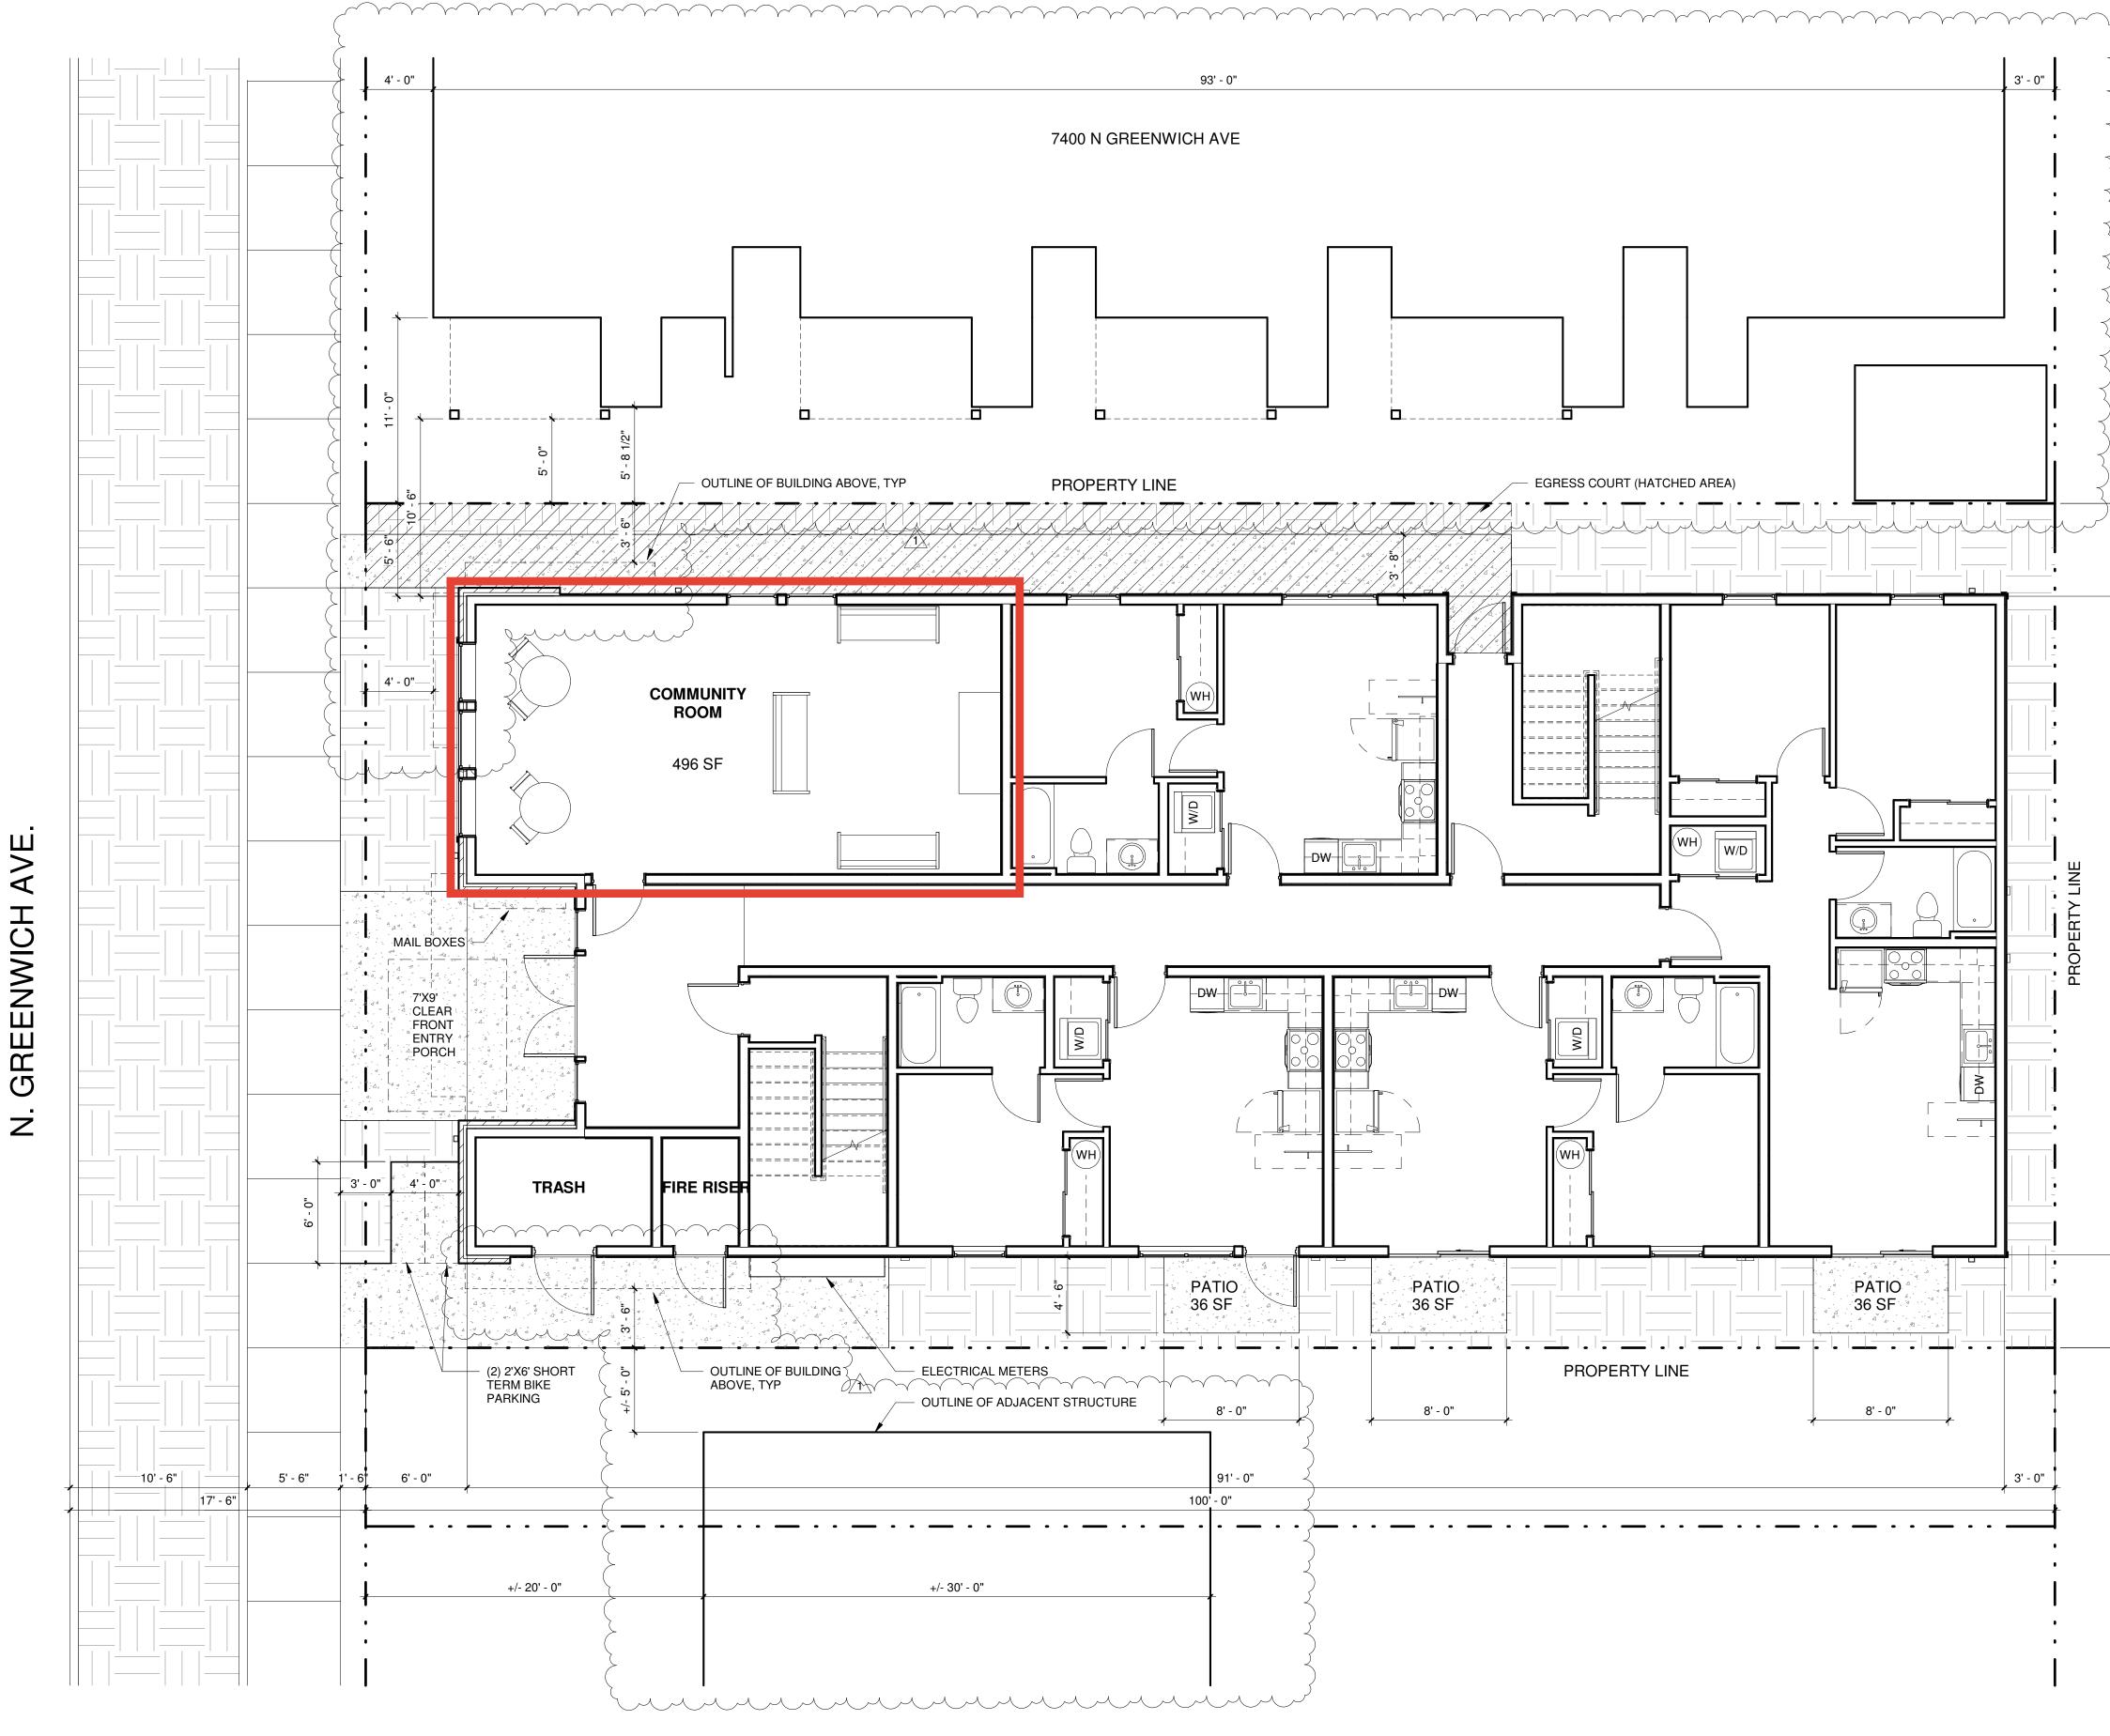

Ч Ш Х **GREENWICH**

1 SITE PLAN A0.02 3/16" = 1'-0"

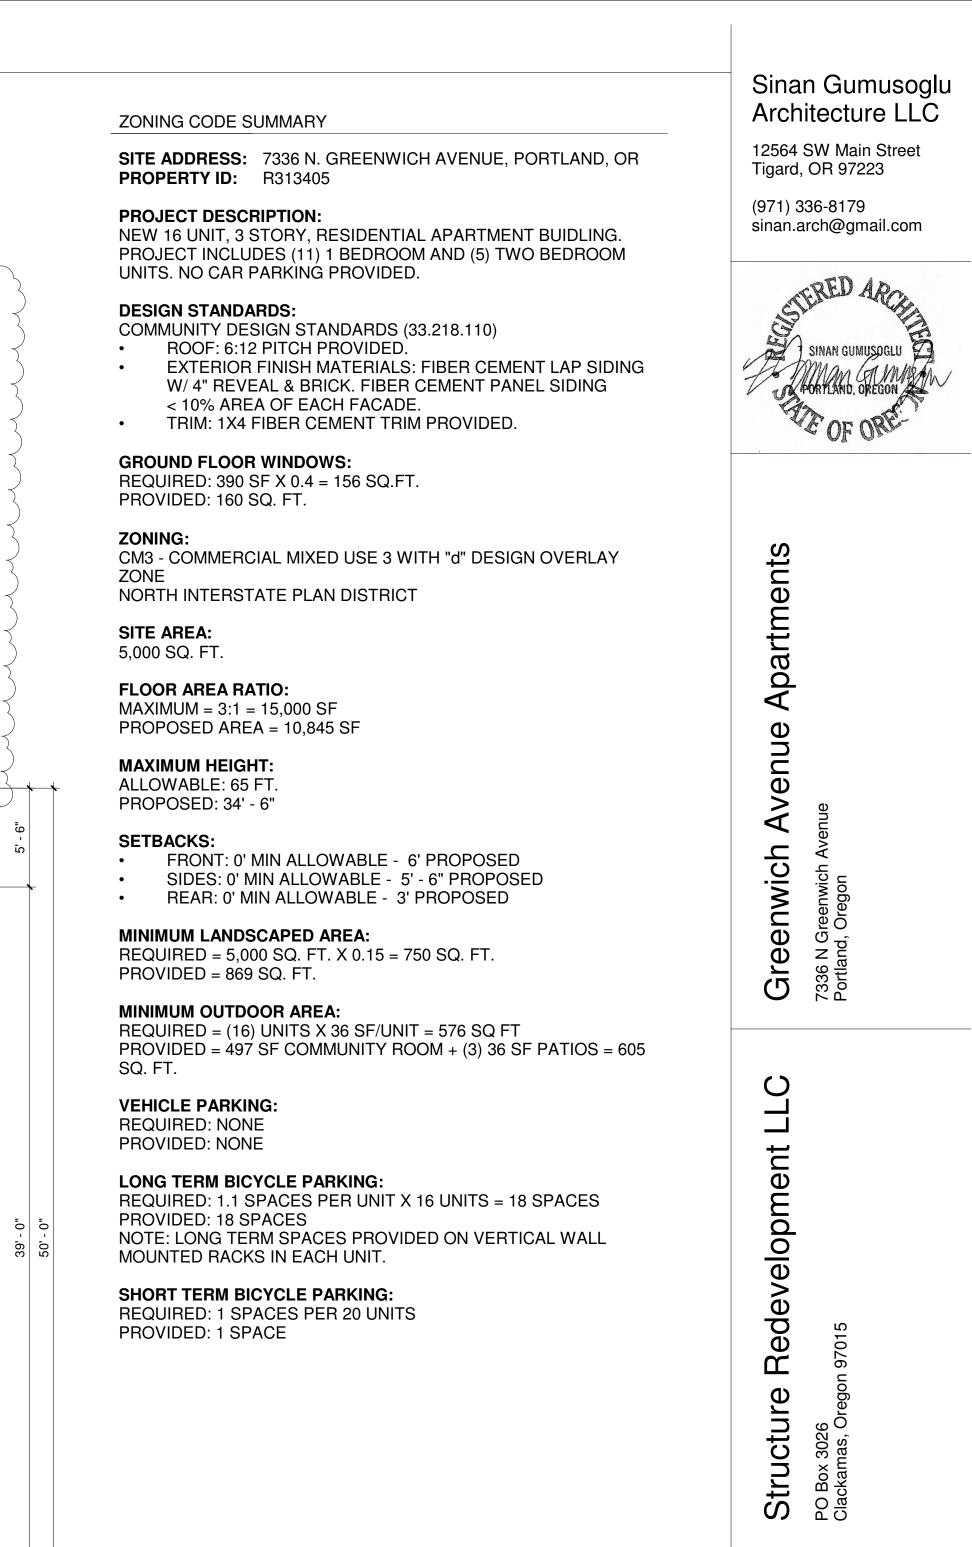

REVISIONS

1 1/6/2020 Plan Check

PERMIT SET AUGUST 19, 2019 ISSUE DATE

SITE PLAN & ZONING SUMMARY

A0.02