

DETAIL RAIL
w/ SKATE STOP


462 BINS
6 HIGH
(458 PR SHOE SKATES)

4/8/69
PHONE FROM H.B


— PROVIDE 300 SKATE
BINS FOR ACTIVE
USE,

— PROVIDE DEAD STO-
RAGE UNDER
STAIRS.


— CHECK W/ OPER-
TOR FOR PARTS
STORAGE RE-
QUIREMENTS.

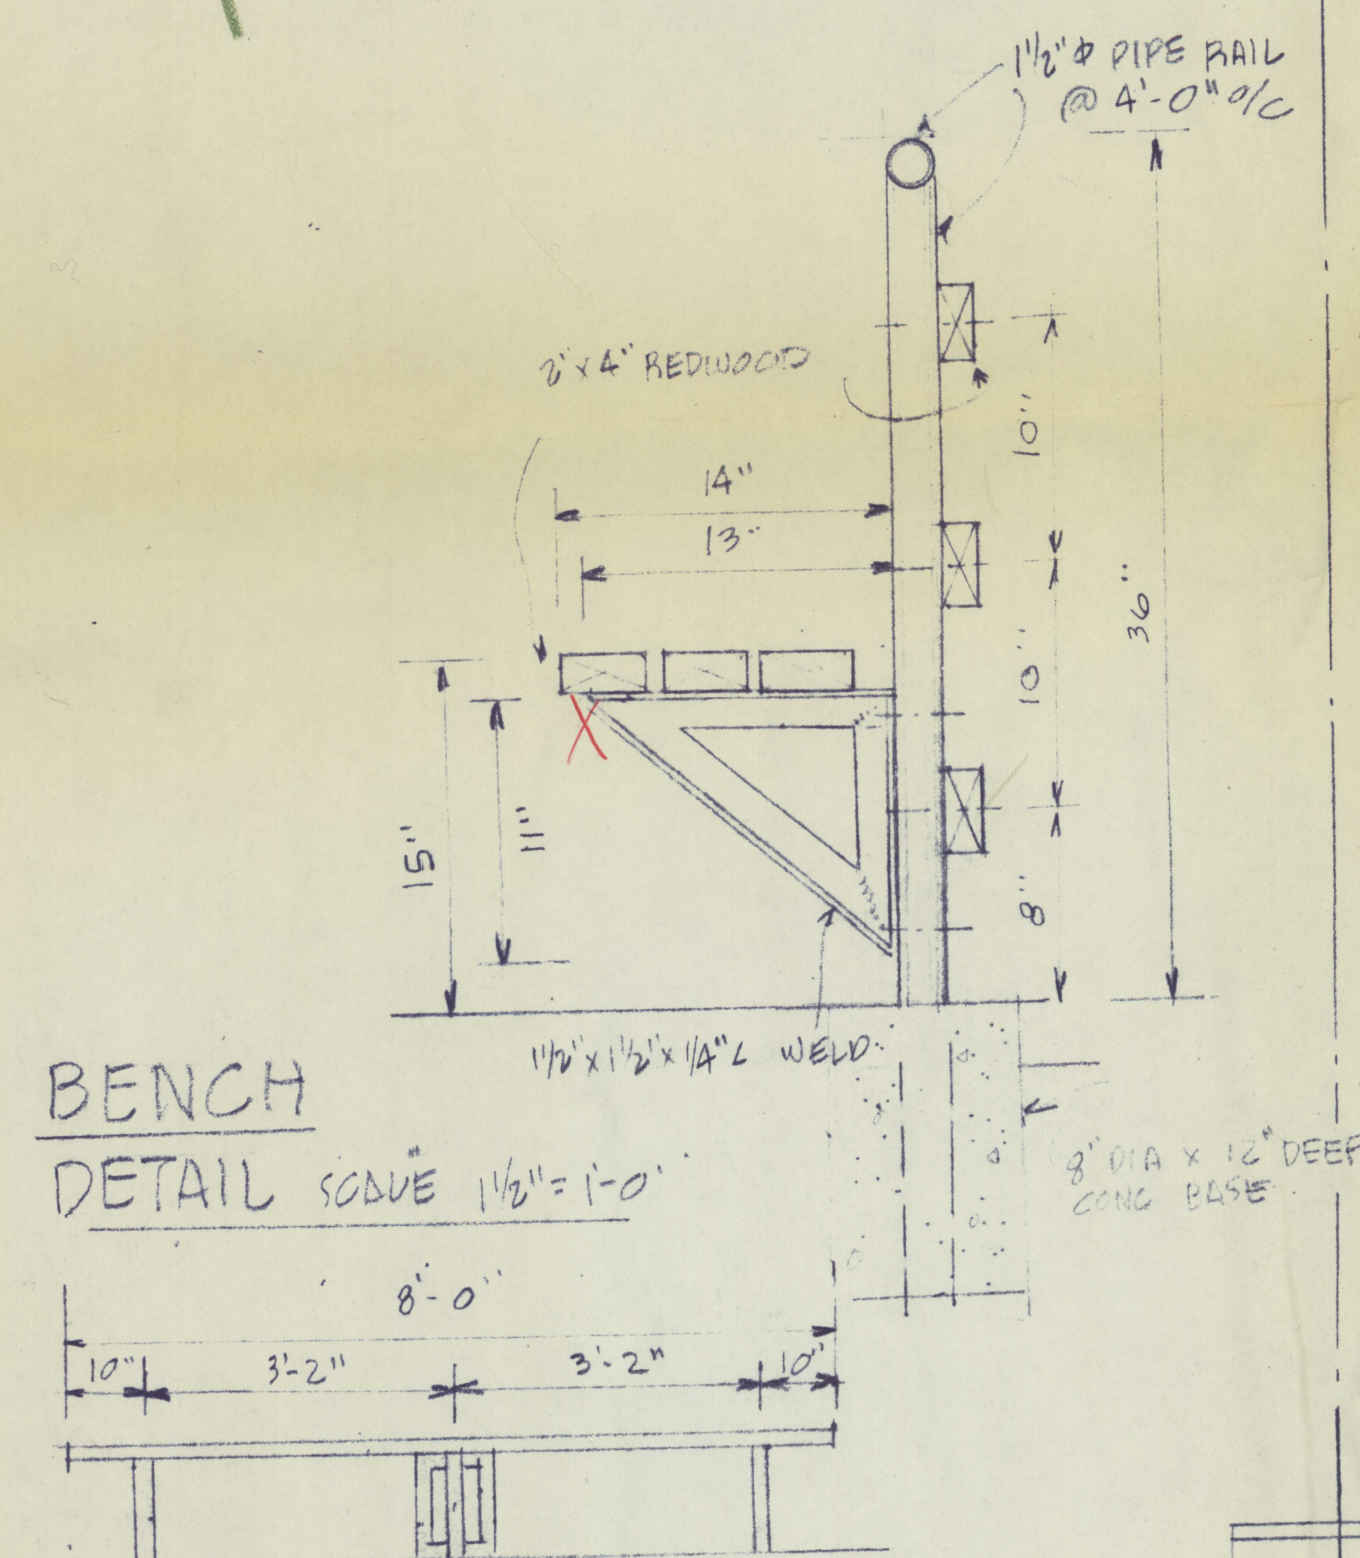


BENCH- SIDE ELEVATION
SCALE 1/2" = 1'-0"

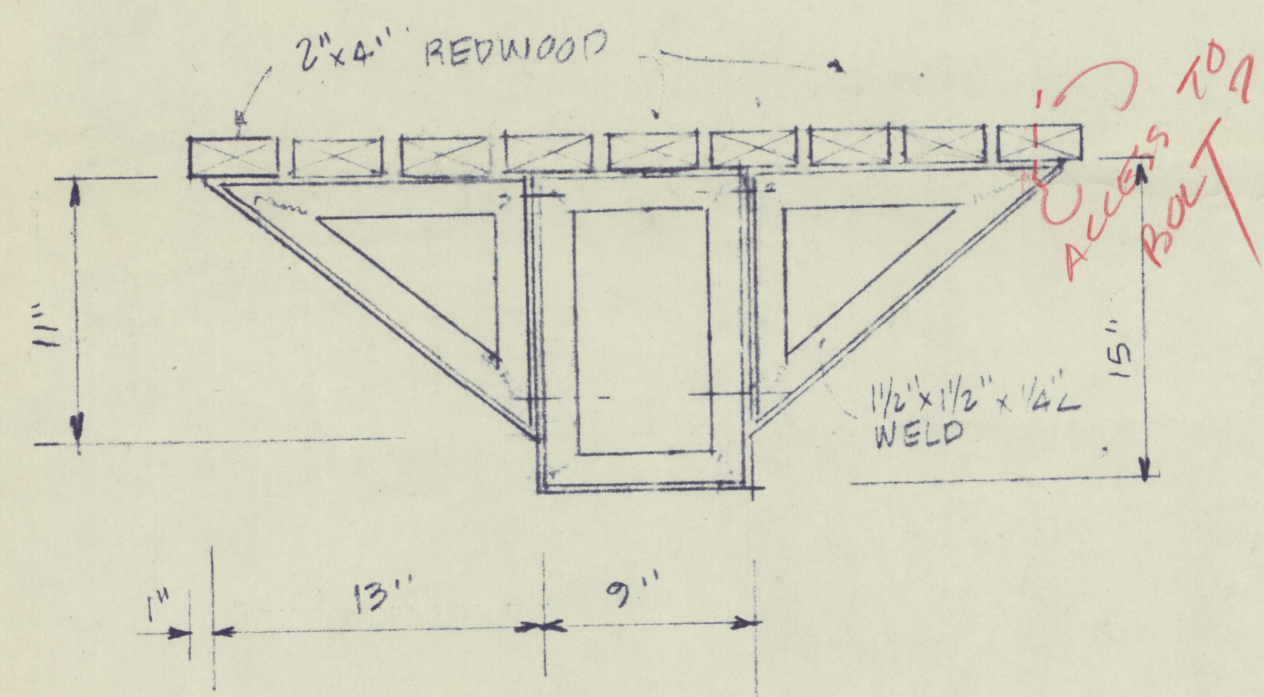

BENCH DETAIL
SCALE 1/2" = 1'-0"

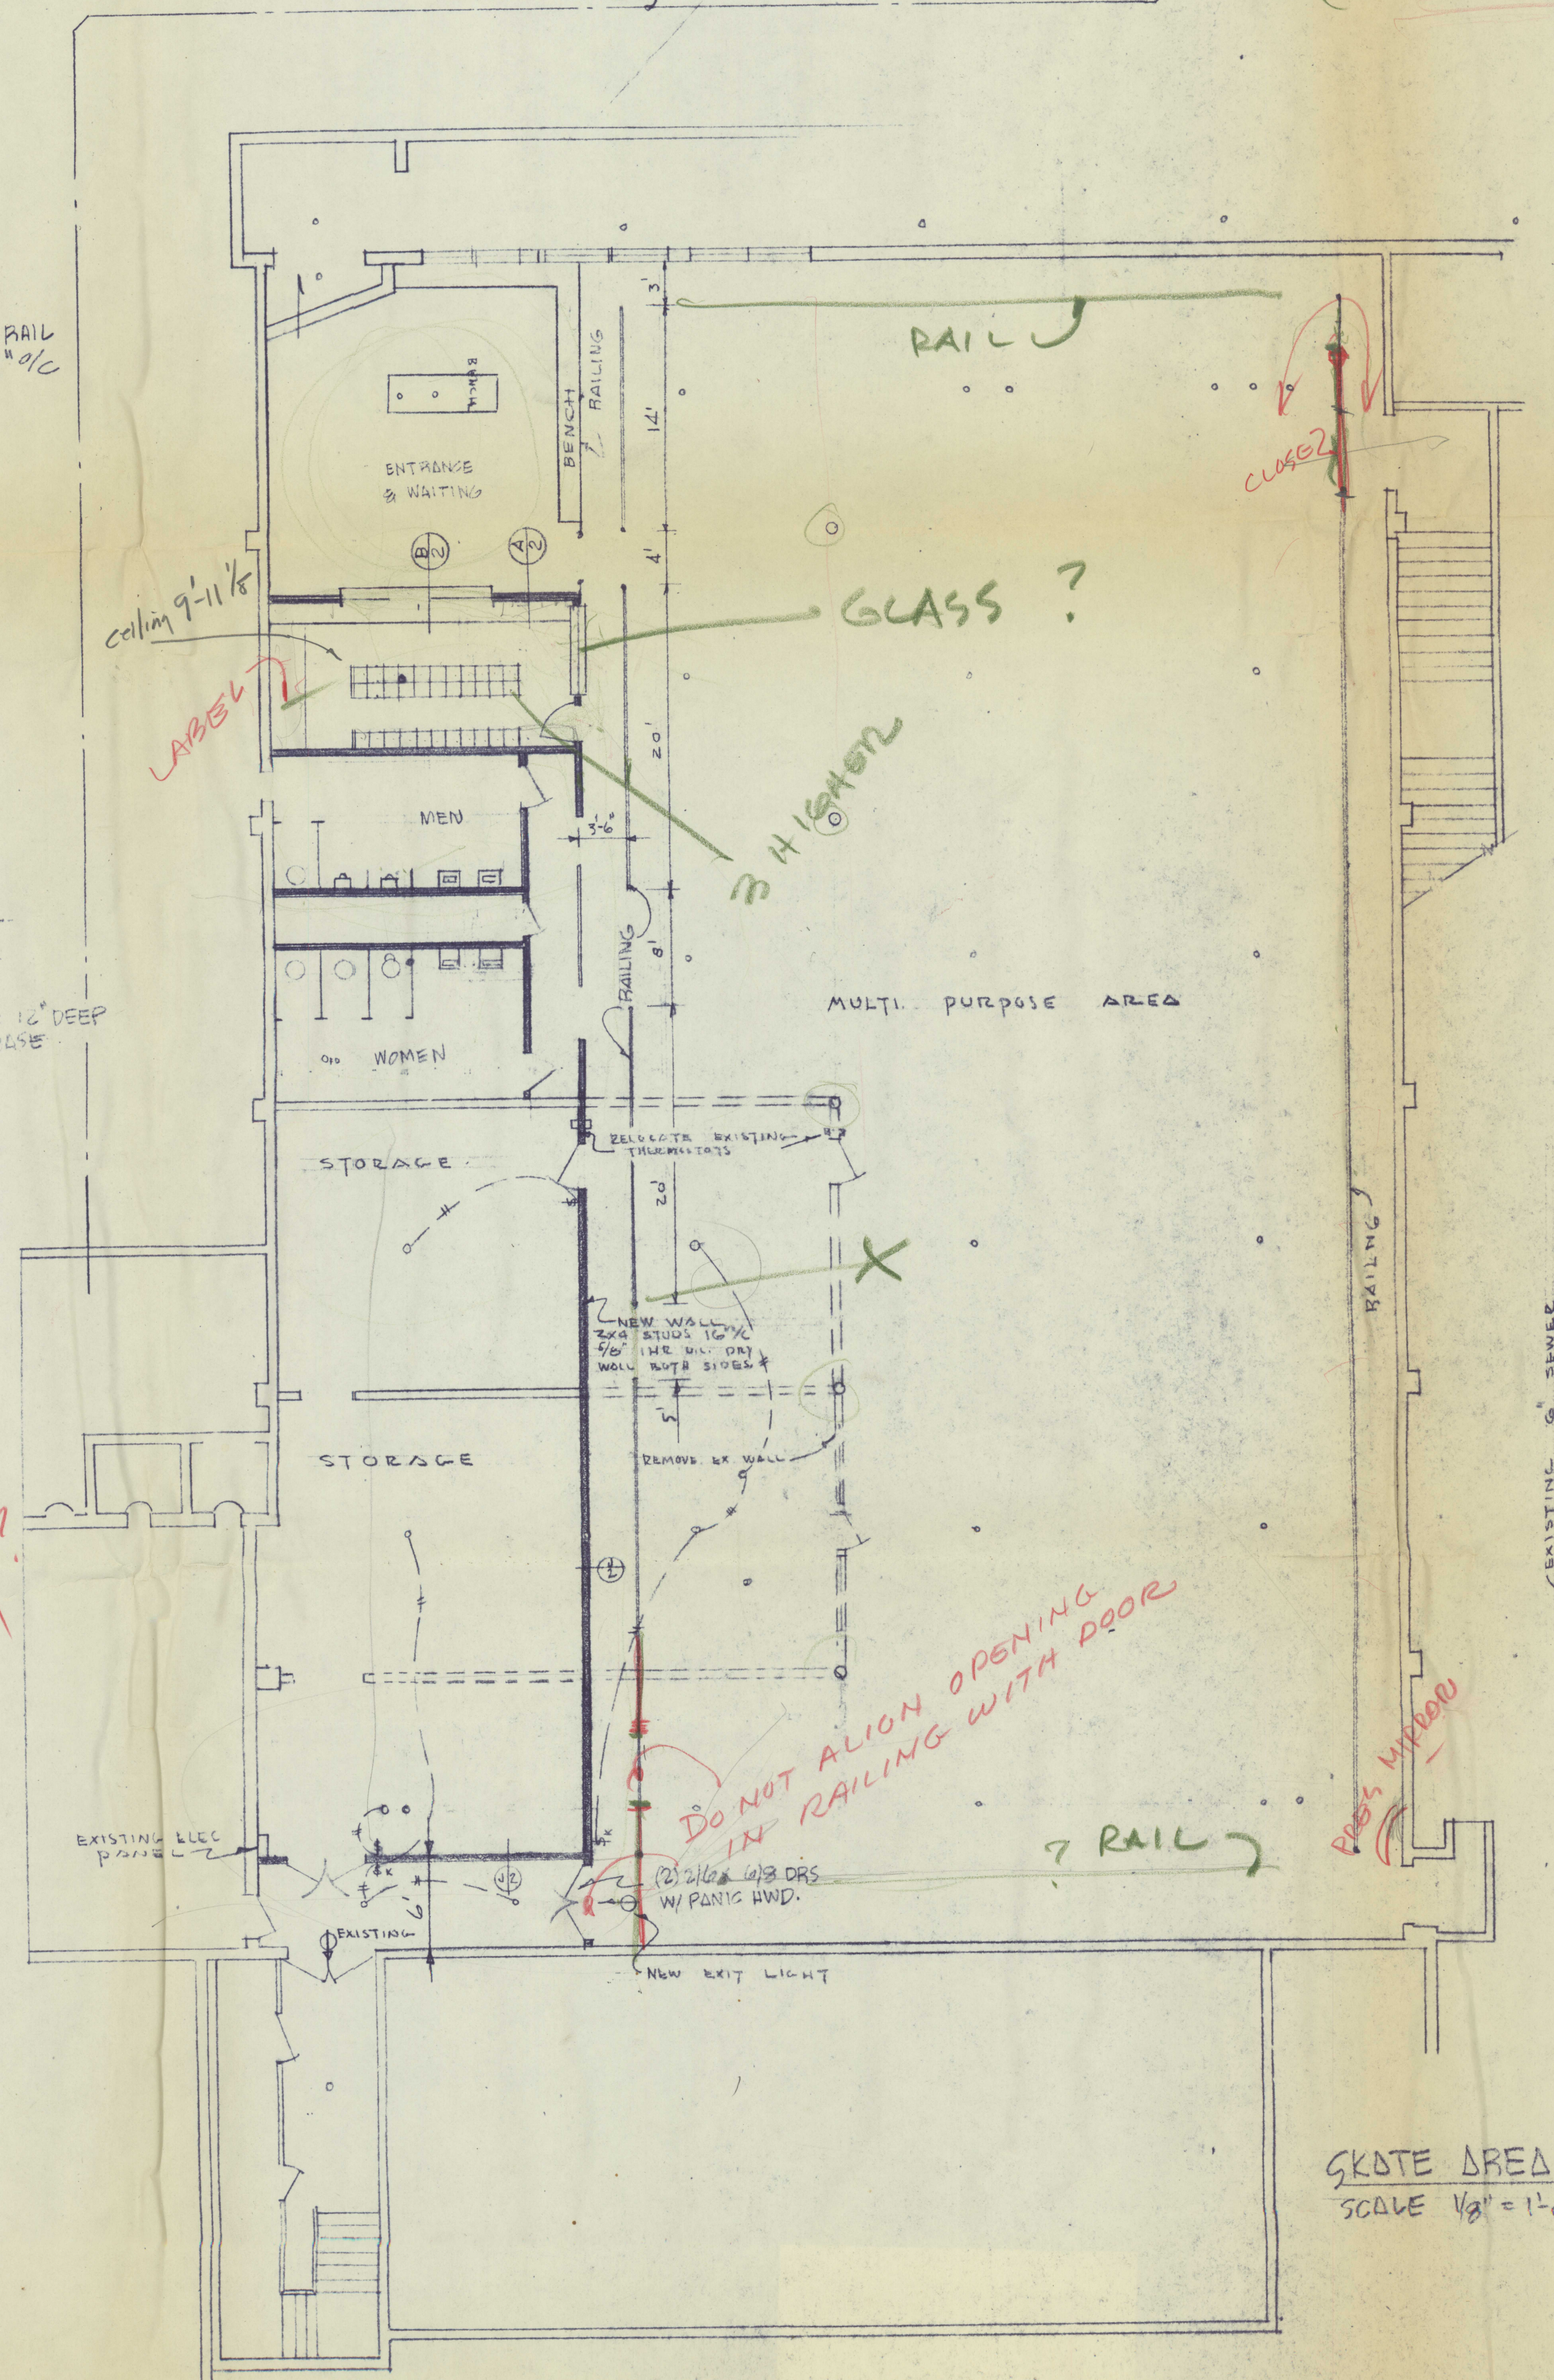

SKATE AREA FLOOR PLAN
SCALE 1/8" = 1'-0"

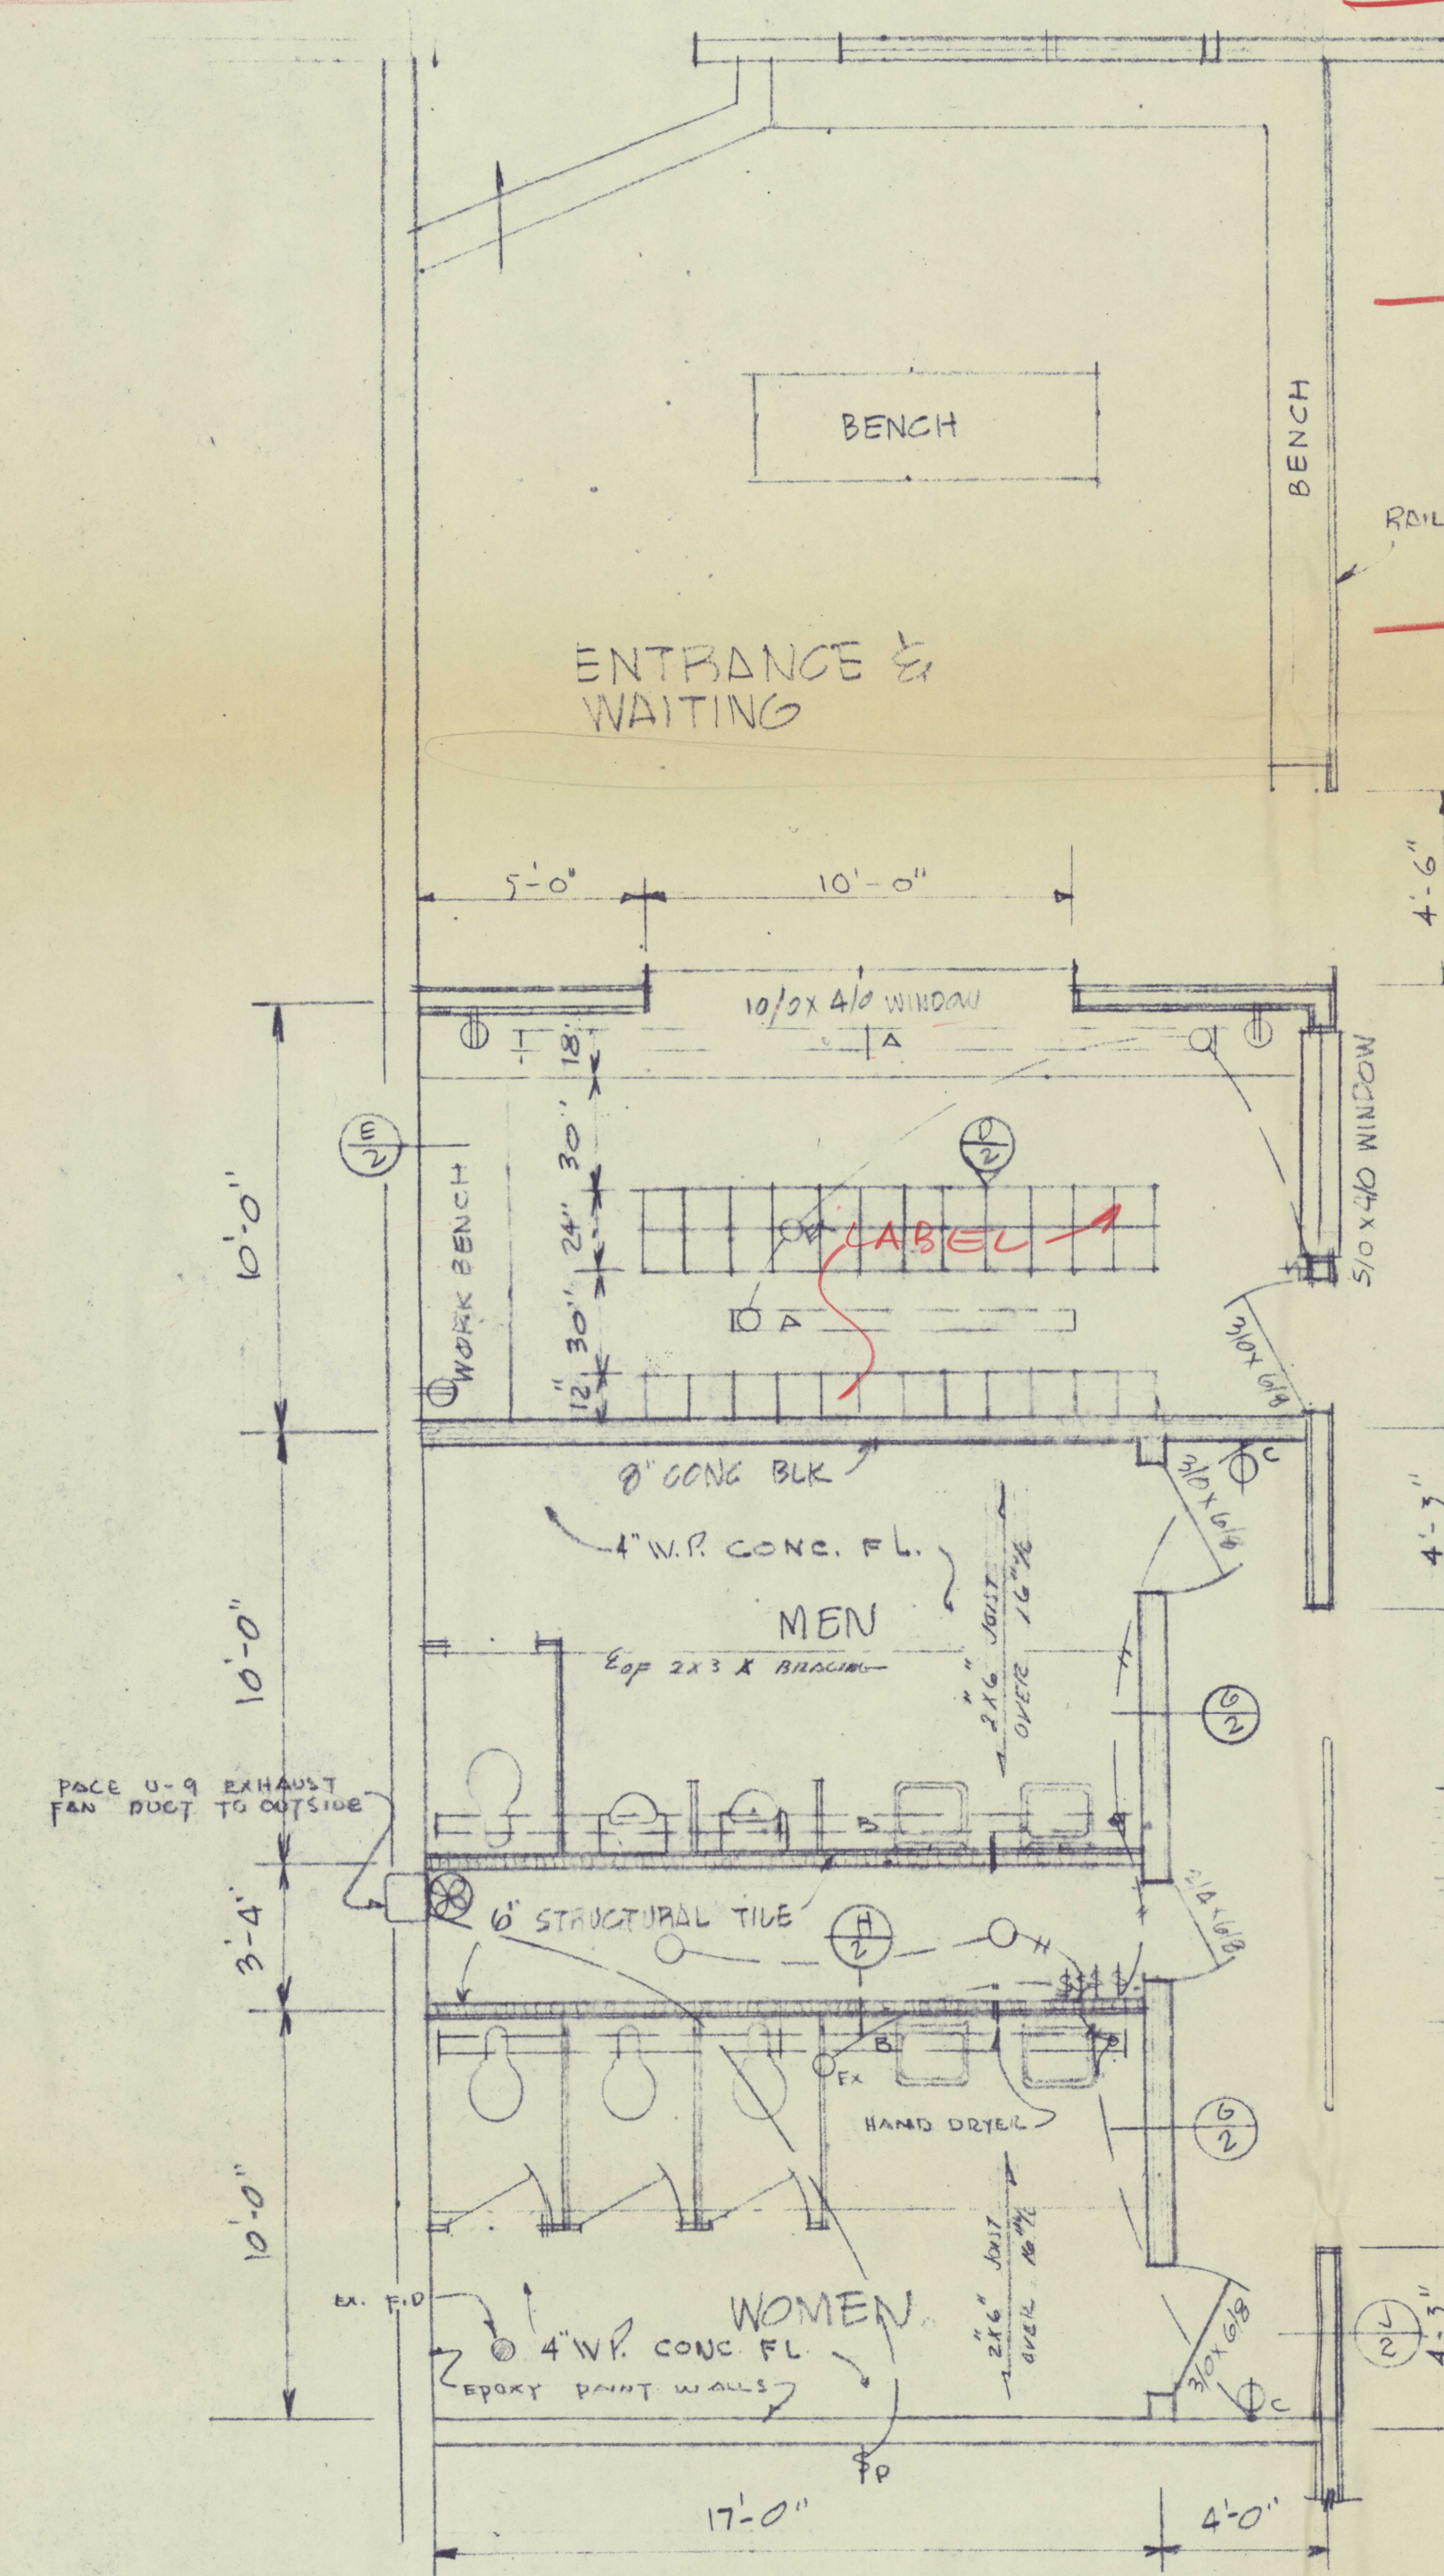

REST ROOMS & SKATE RM
SCALE 1/4" = 1'-0"

COAT HOOK (200)
ON STRIP BEHIND RAILING


LIGHT FIXTURE SCHEDULE

A	SP 6-275-M19	COLUMBIA
B	SP 3-275-M1	COLUMBIA
C	VC-71-GD	PERFECTITE
D	P-934	PERFECTITE


HAND DRYER - FASTAIRE - VANDAL-PROOF
DASH 2 MODEL
EXHAUST FAN - PAGE U-9 DUCT TO OUTSIDE

PRELIMINARY
DO NOT USE FOR BIDDING
OR CONSTRUCTION


1 00 3	MT. SCOTT COMMUNITY CENTER	SKATE AREA FLOOR PLAN	1
	BUREAU OF PARKS AND PUBLIC RECREATION PORTLAND, OREGON		3
	FRANK J. FRANK ARCHITECT	COMMISSIONER SUPT. OF PARKS	
	DATE DEC 68 SCALE NOTED 4 SEC.	DESIGNED BY JACK P. STUHL DRAWN BY APPROVED BY	

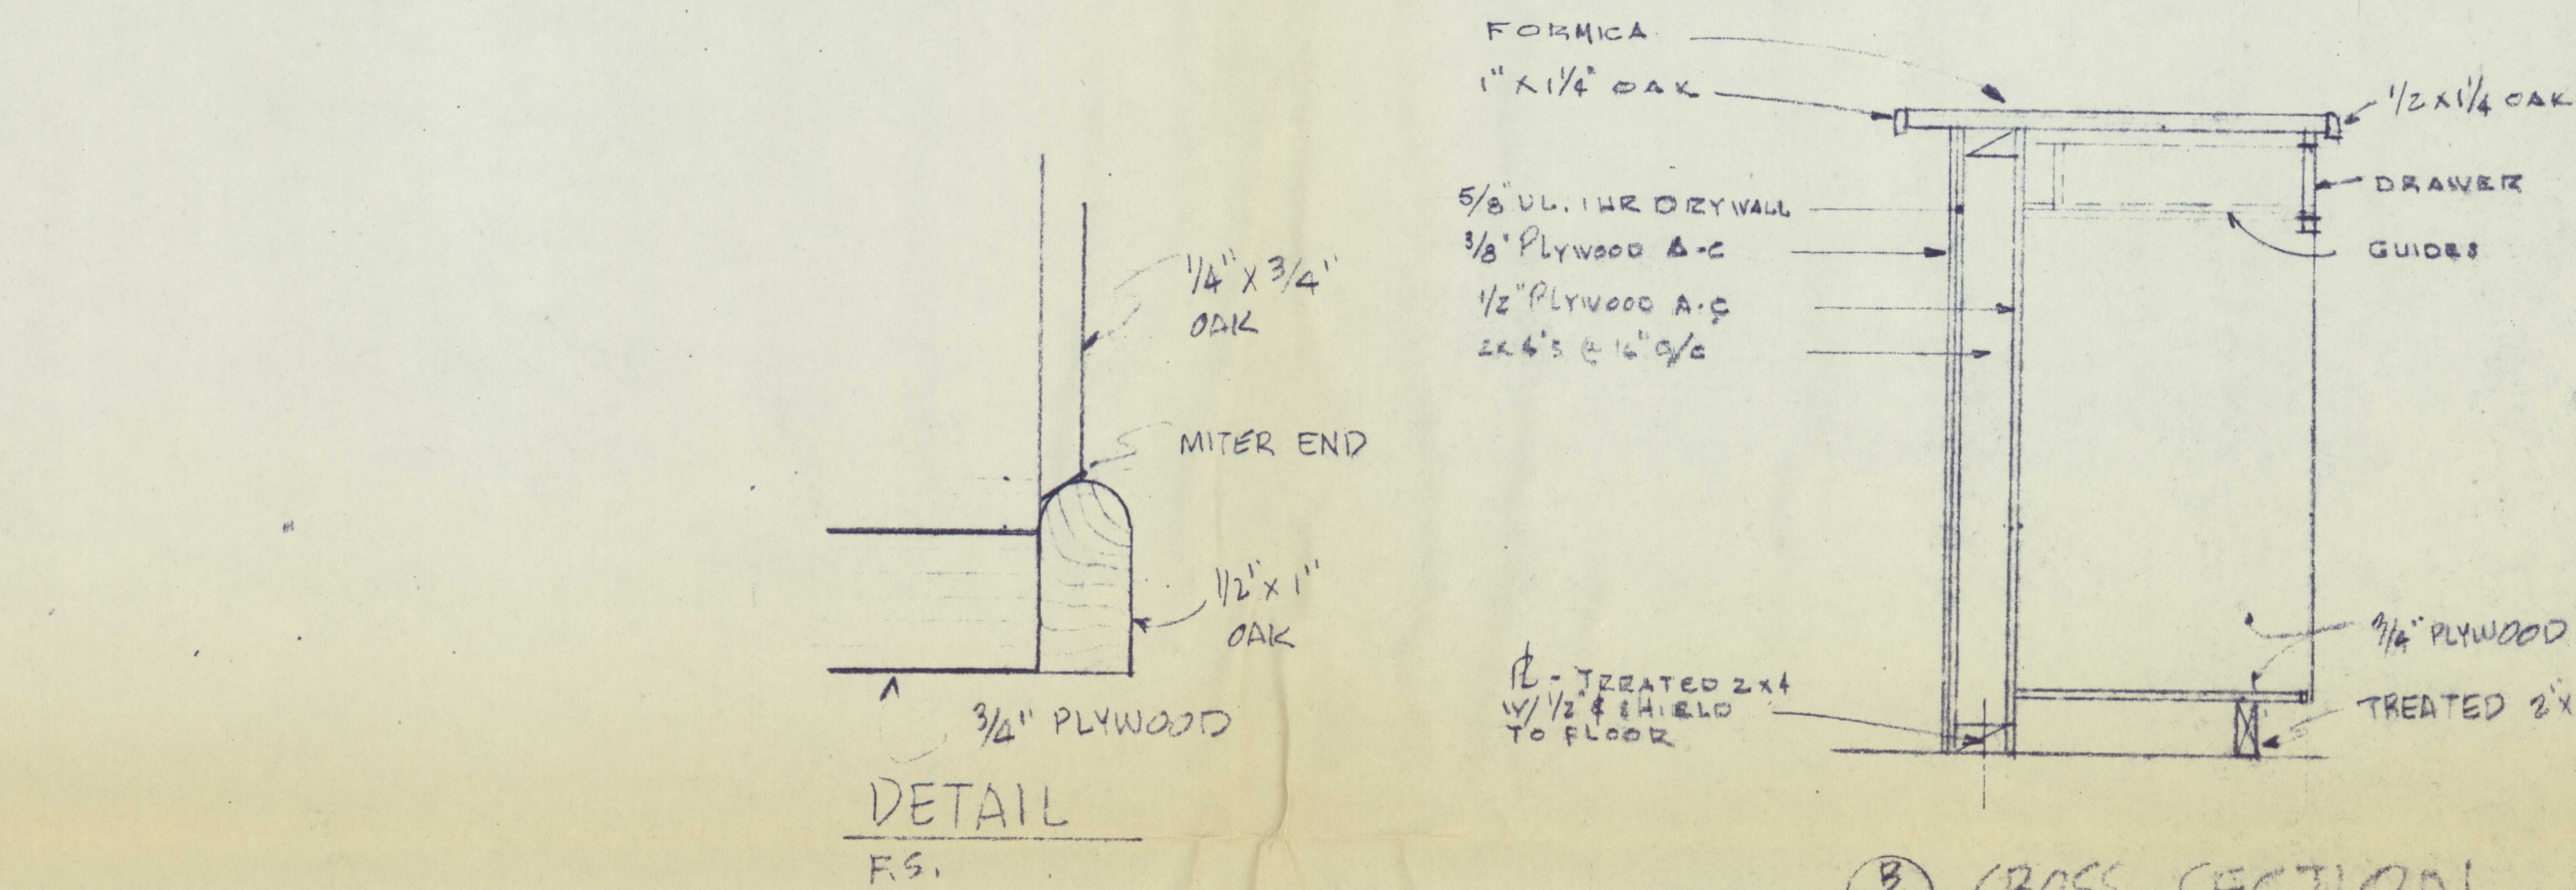


⑧ CROSS SECTION COUNTER
SCALE 1/2" = 1'-0"

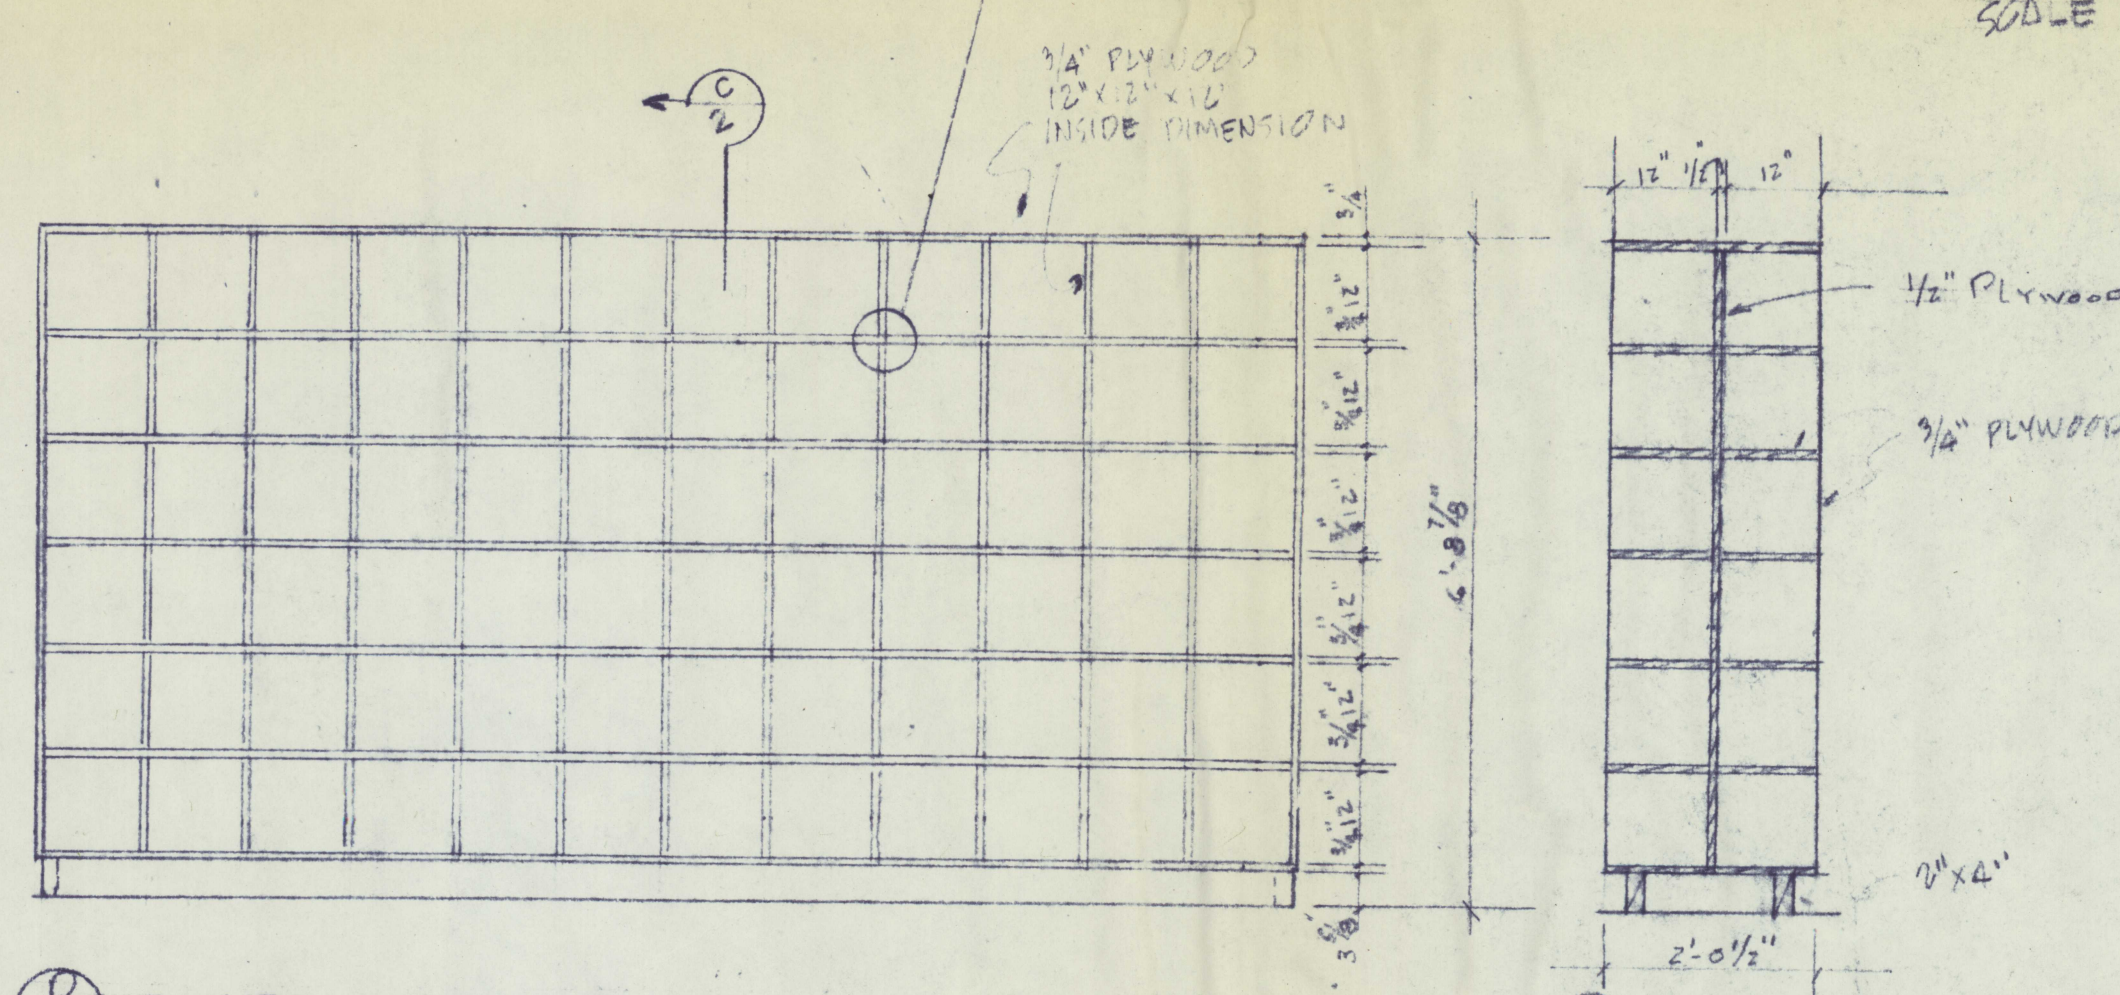


② SKATE STORAGE RACK
SCALE 1/2" = 1'-0"

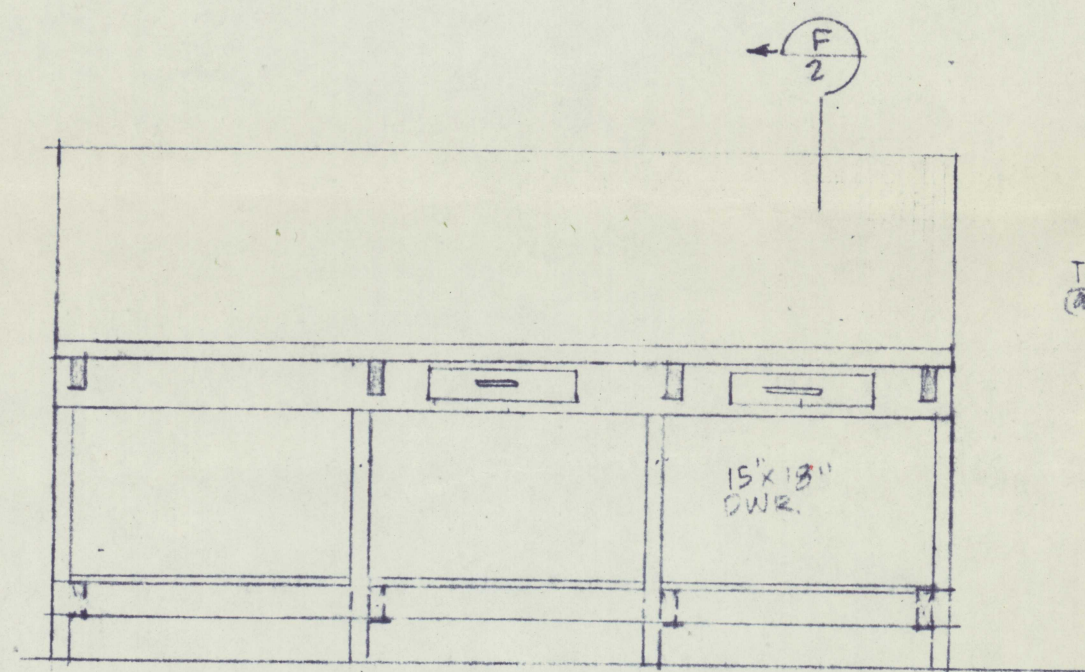


⑤ WORK BENCH
SCALE 1/2" = 1'-0"

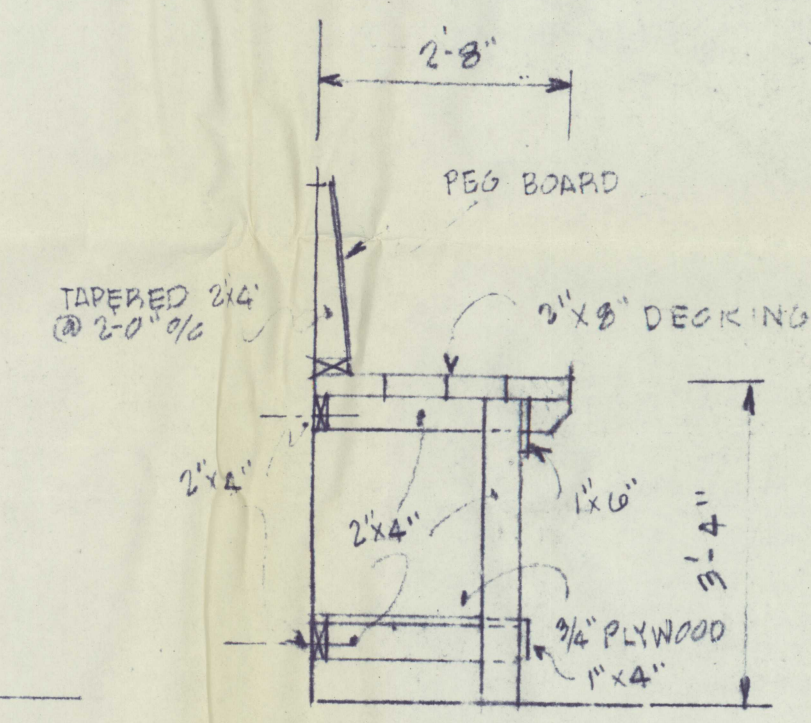

⑦ CROSS SECTION
SCALE 1/2" = 1'-0"

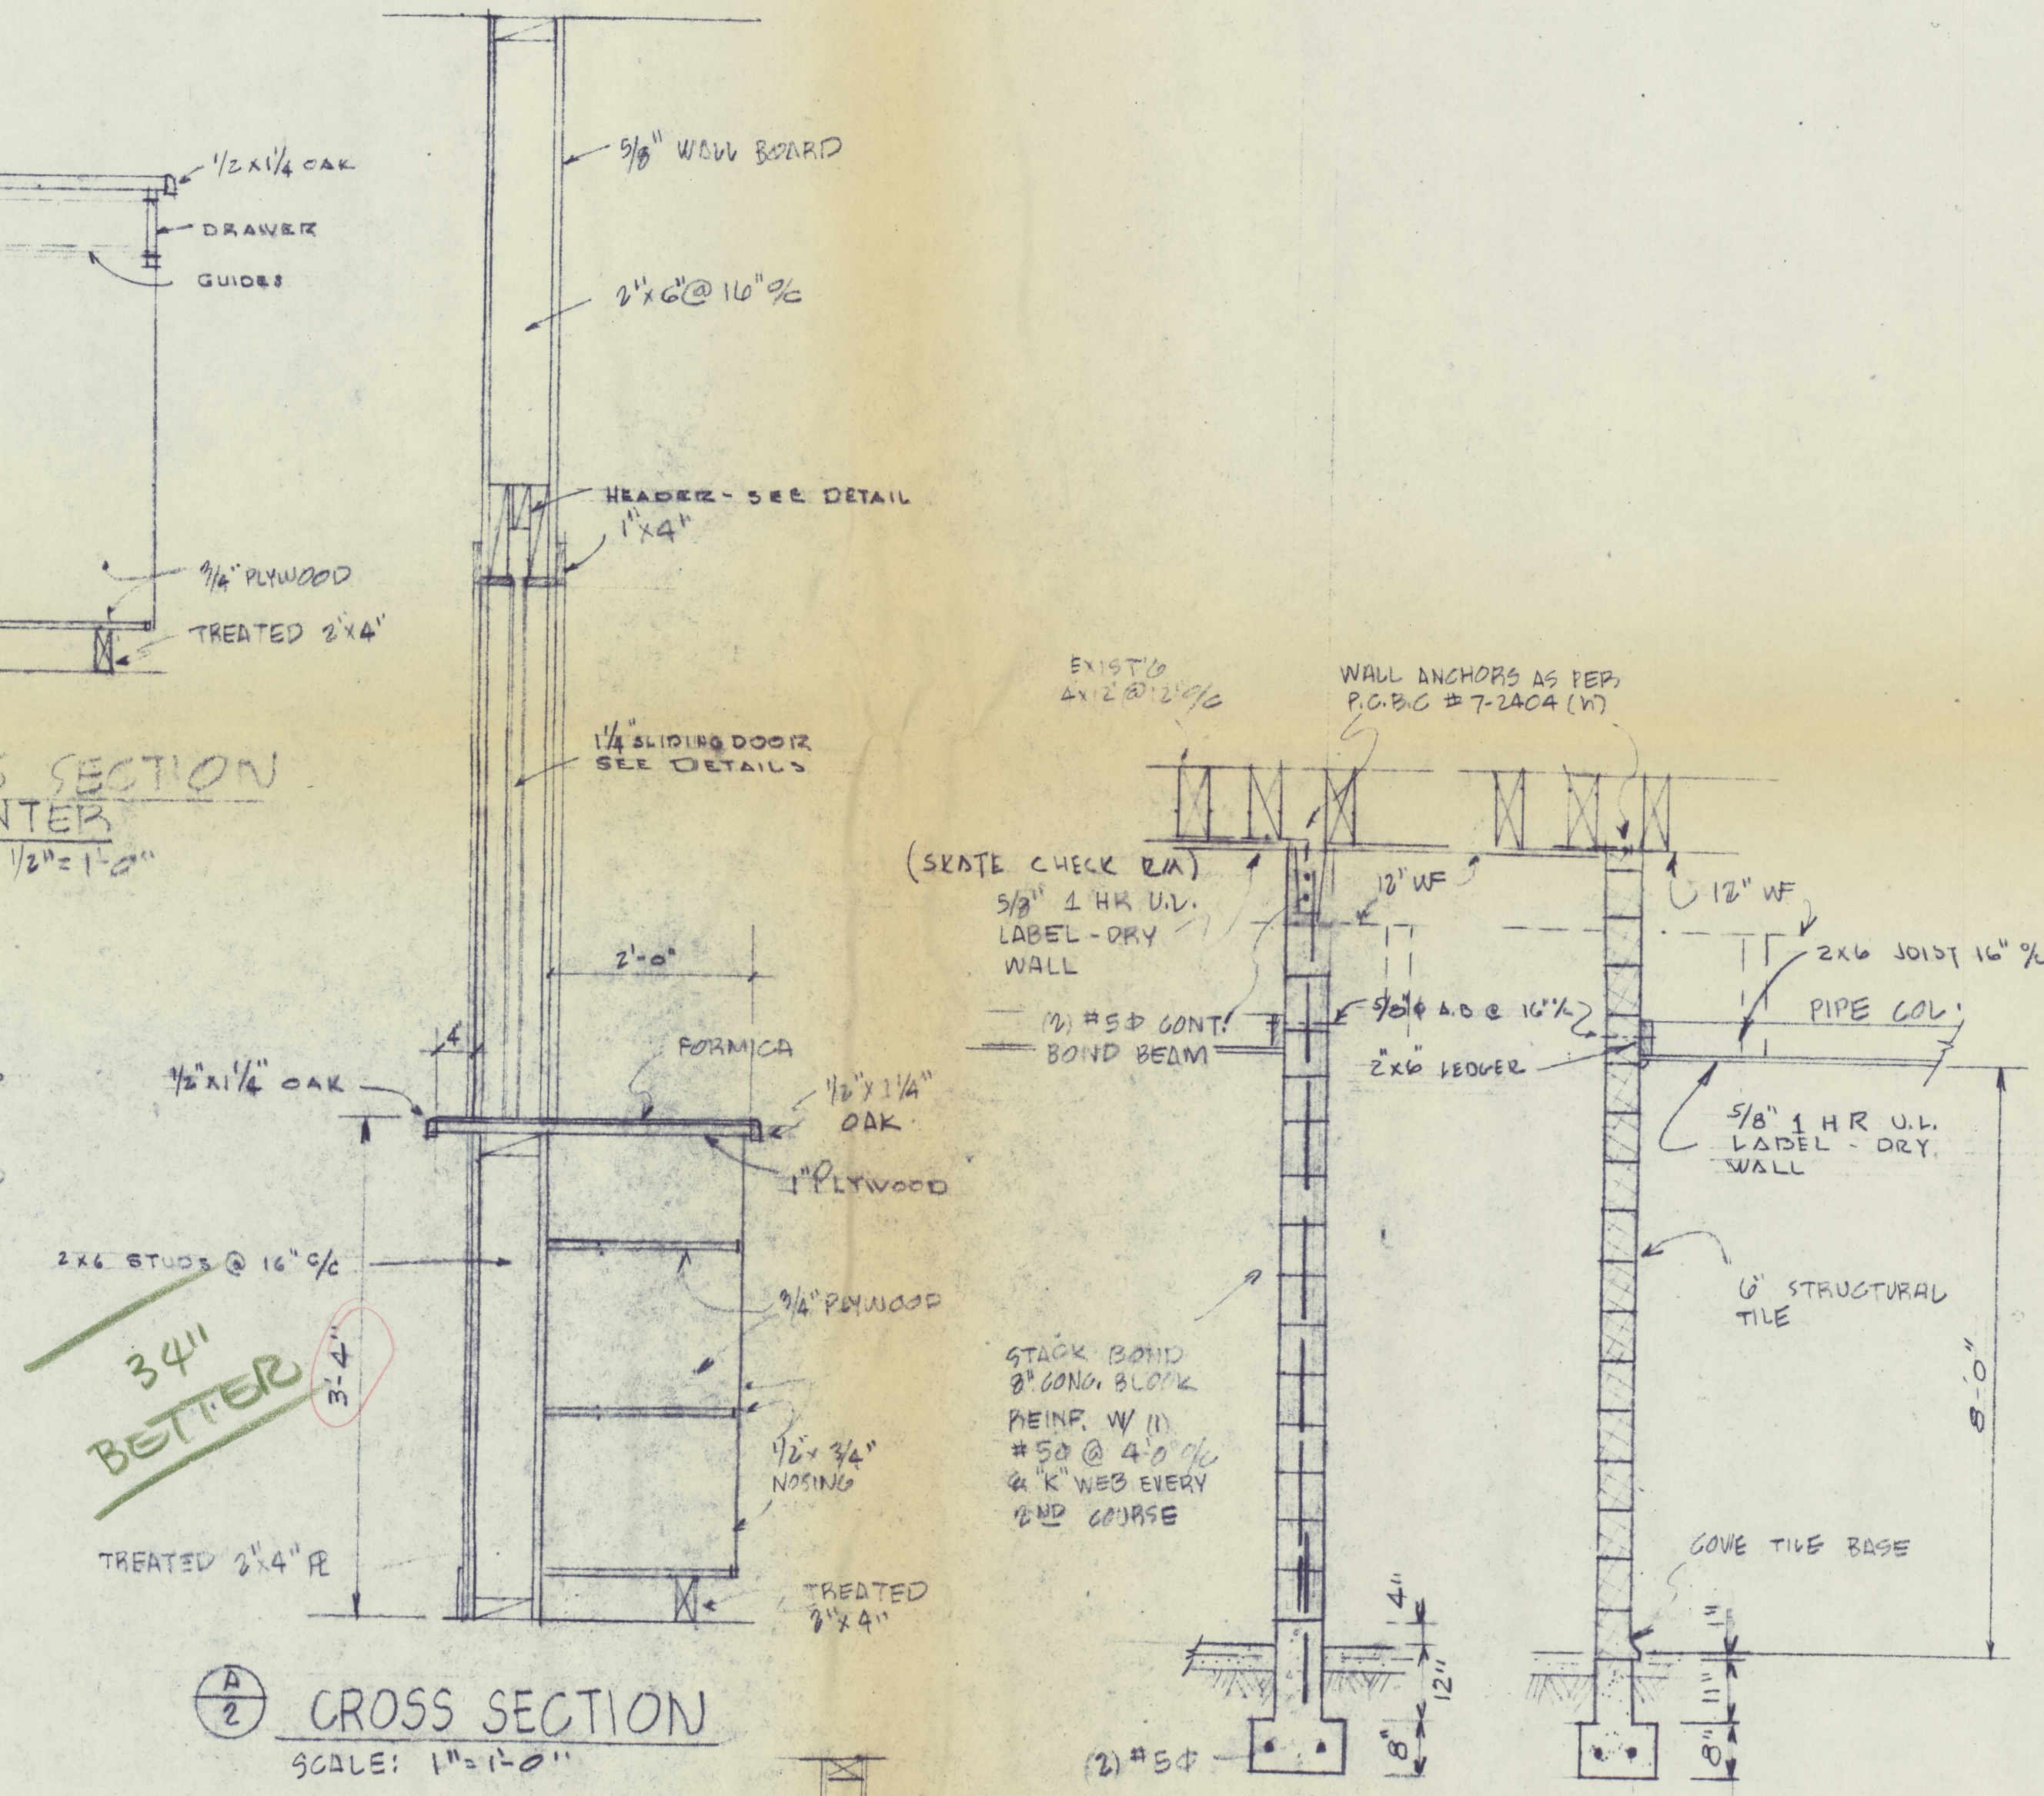


② CROSS SECTION
SCALE: 1" = 1'-0"

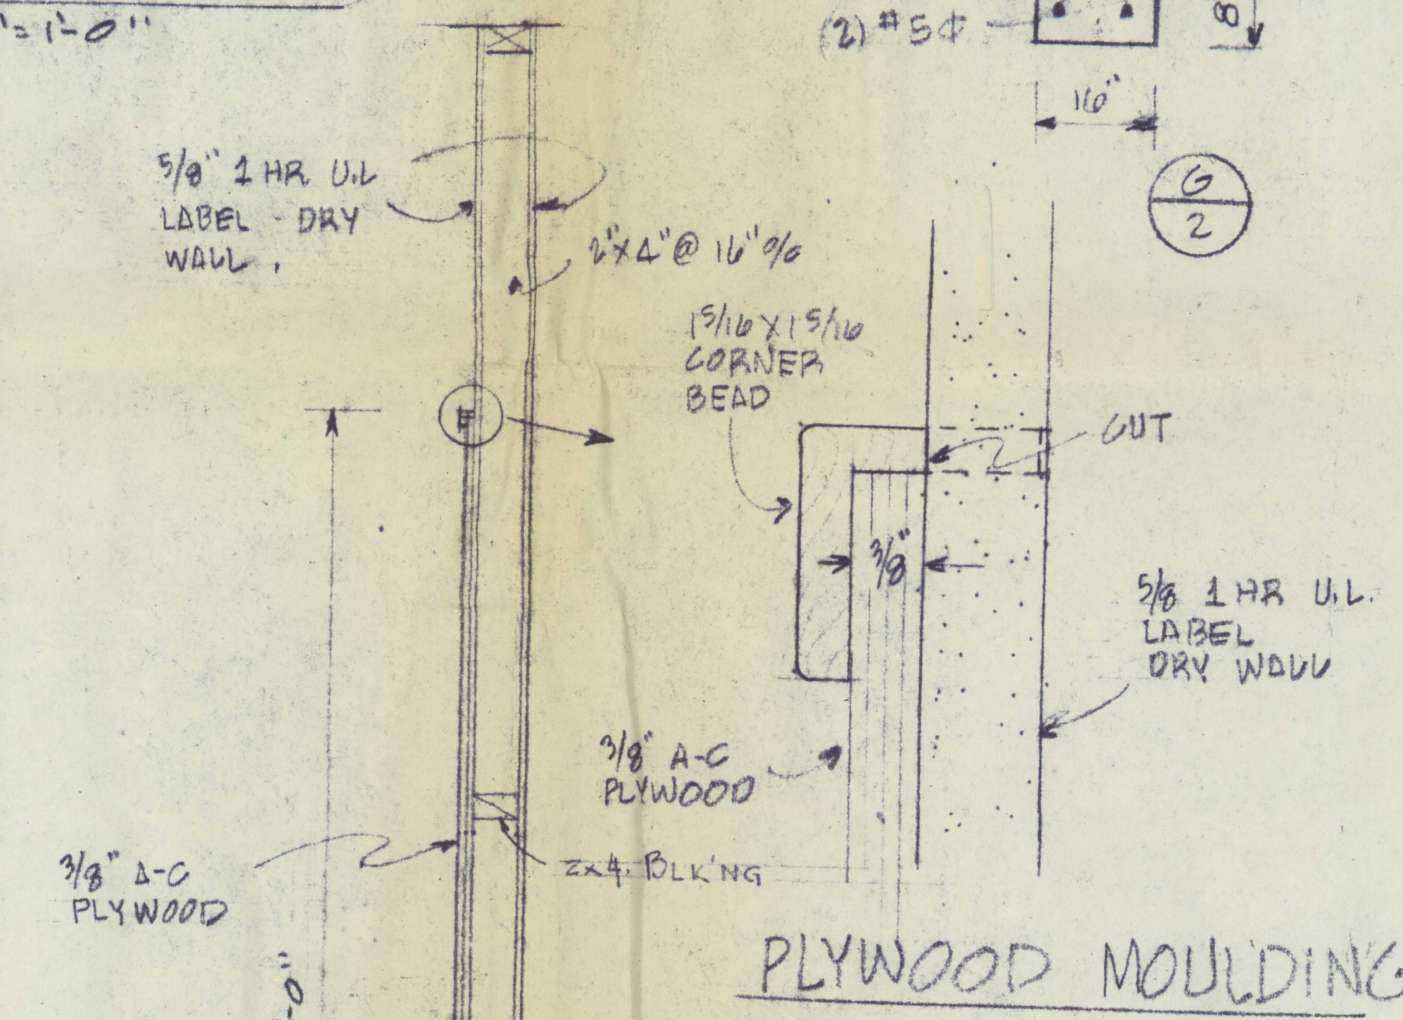


② WALL SECTION
SCALE 3/4" = 1'-0"

NOTE:
ALL NEW WOOD PARTITIONS
ANCHORED AT FLOOR
W/ 1/2" STAR SHIELD & BOLT
@ 6'-0" O.C.

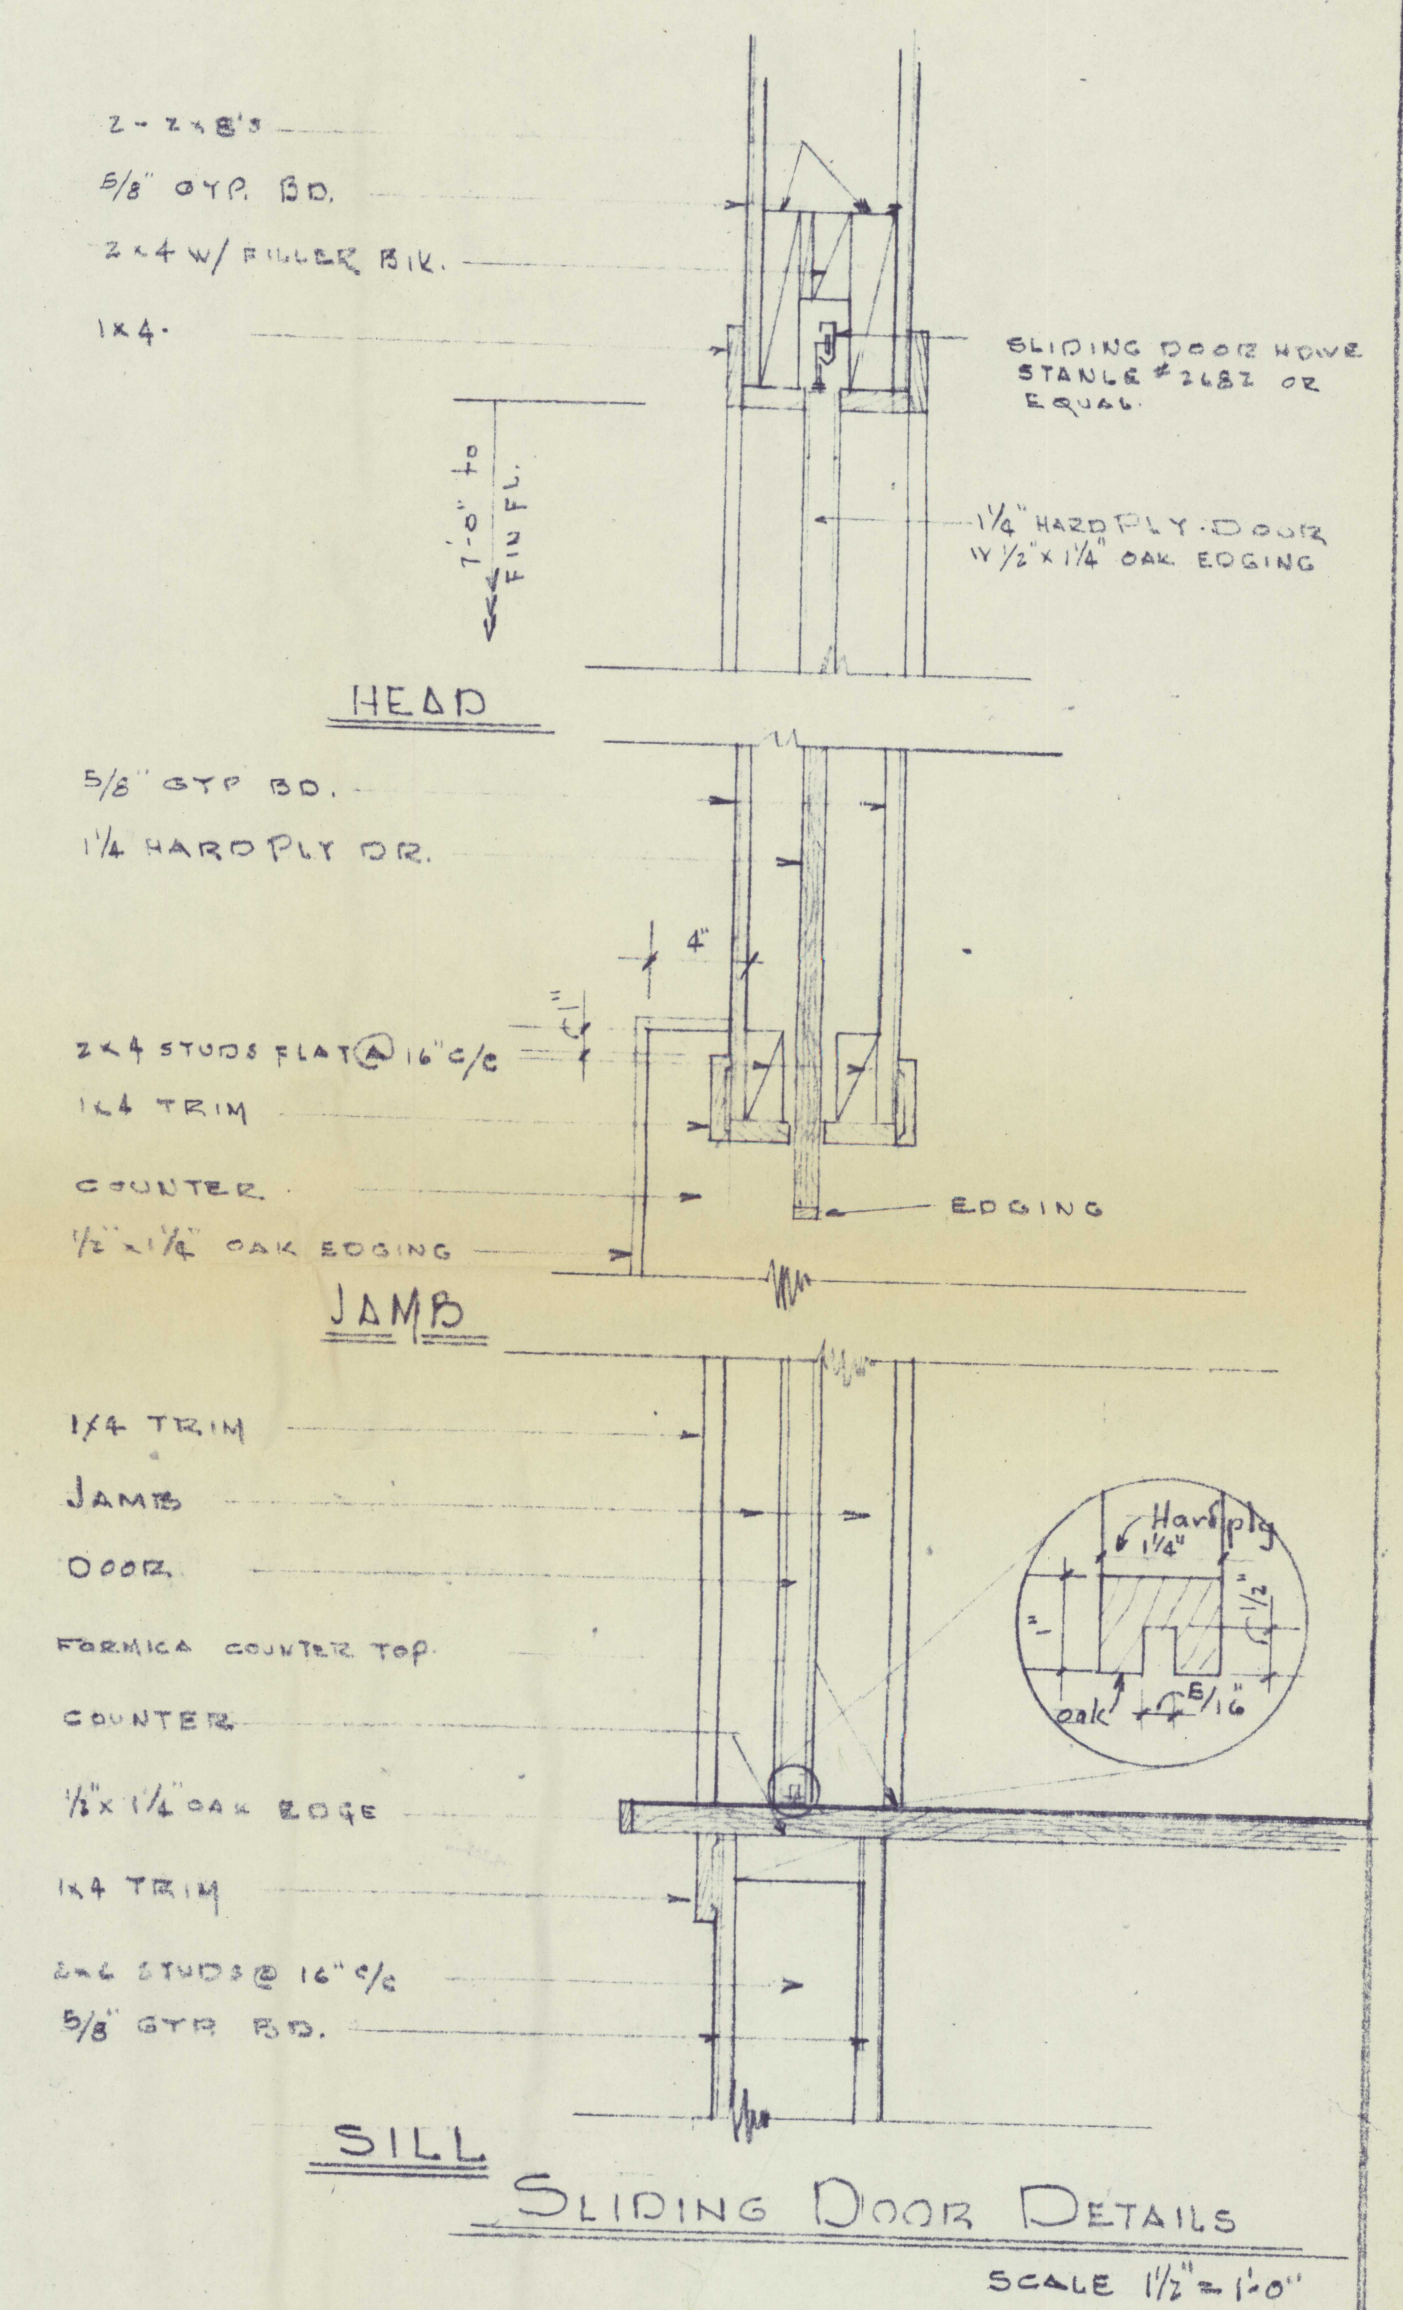


PRELIMINARY
DO NOT USE FOR BIDDING
OR CONSTRUCTION


68.37	MIT SCOTT COMMUNITY CENTER	*SKATE AREA FLOOR PLAN REMODEL		2 3	
	BUREAU OF PARKS AND PUBLIC RECREATION PORTLAND, OREGON				
	FRANCIS J. HANCOCK MAYOR, PORTLAND	COMMISSIONER SUITE OF PARKS			
	DATE: DEC. 68	DESIGNED BY: JACK P. STUHL	AREA NO.		REV.
	SCALE: NOTED	DRAWN BY:			
	N. SEC.	APPROVED BY:			

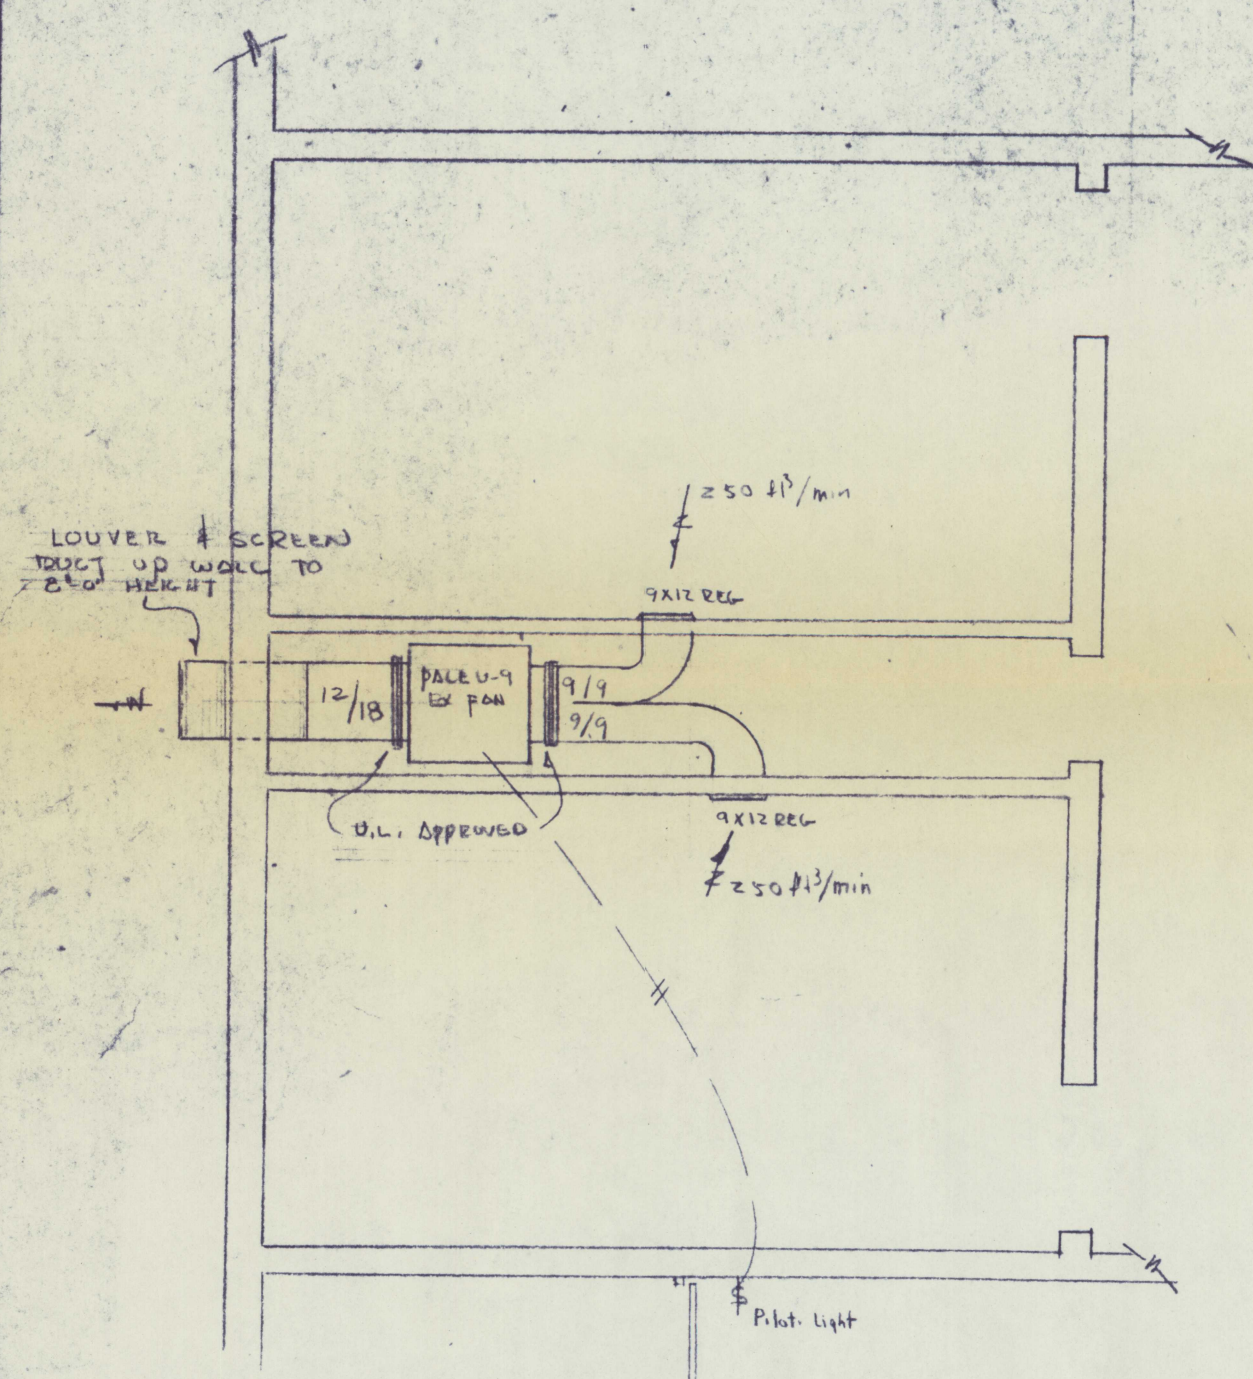

EXHAUST FAN PLAN

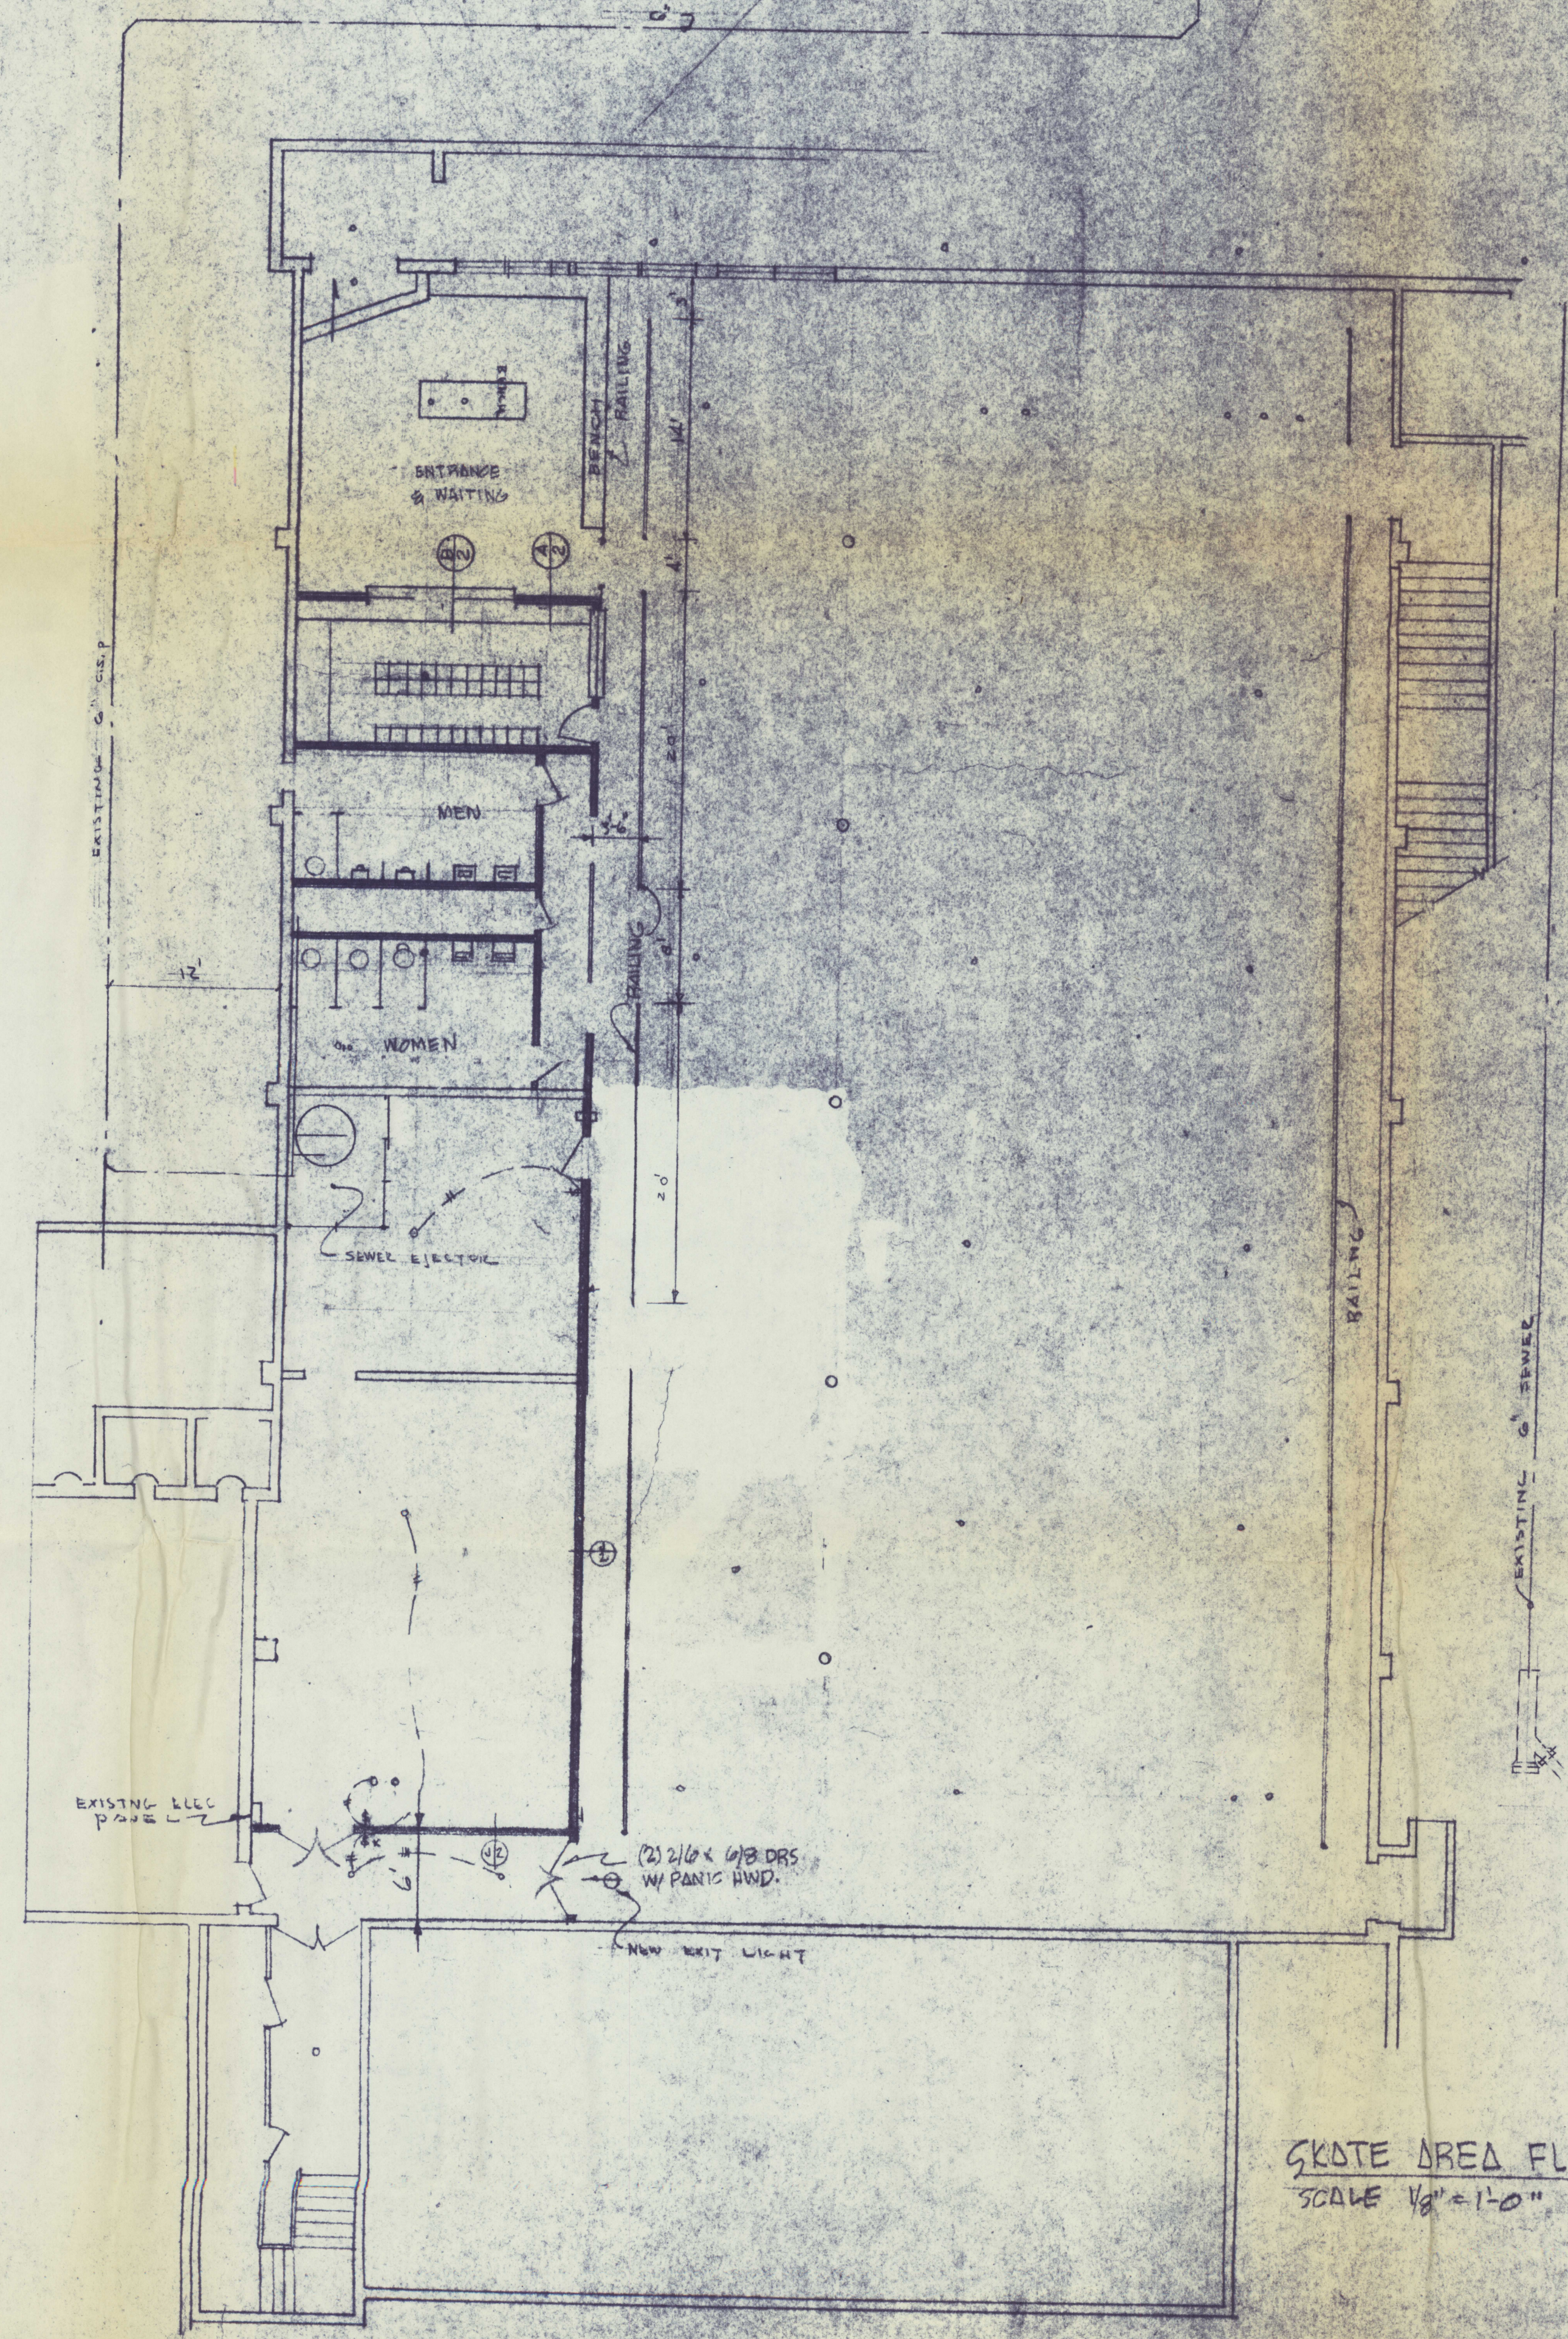

SKATE AREA FLOOR PLAN
SCALE 1/8" = 1'-0"

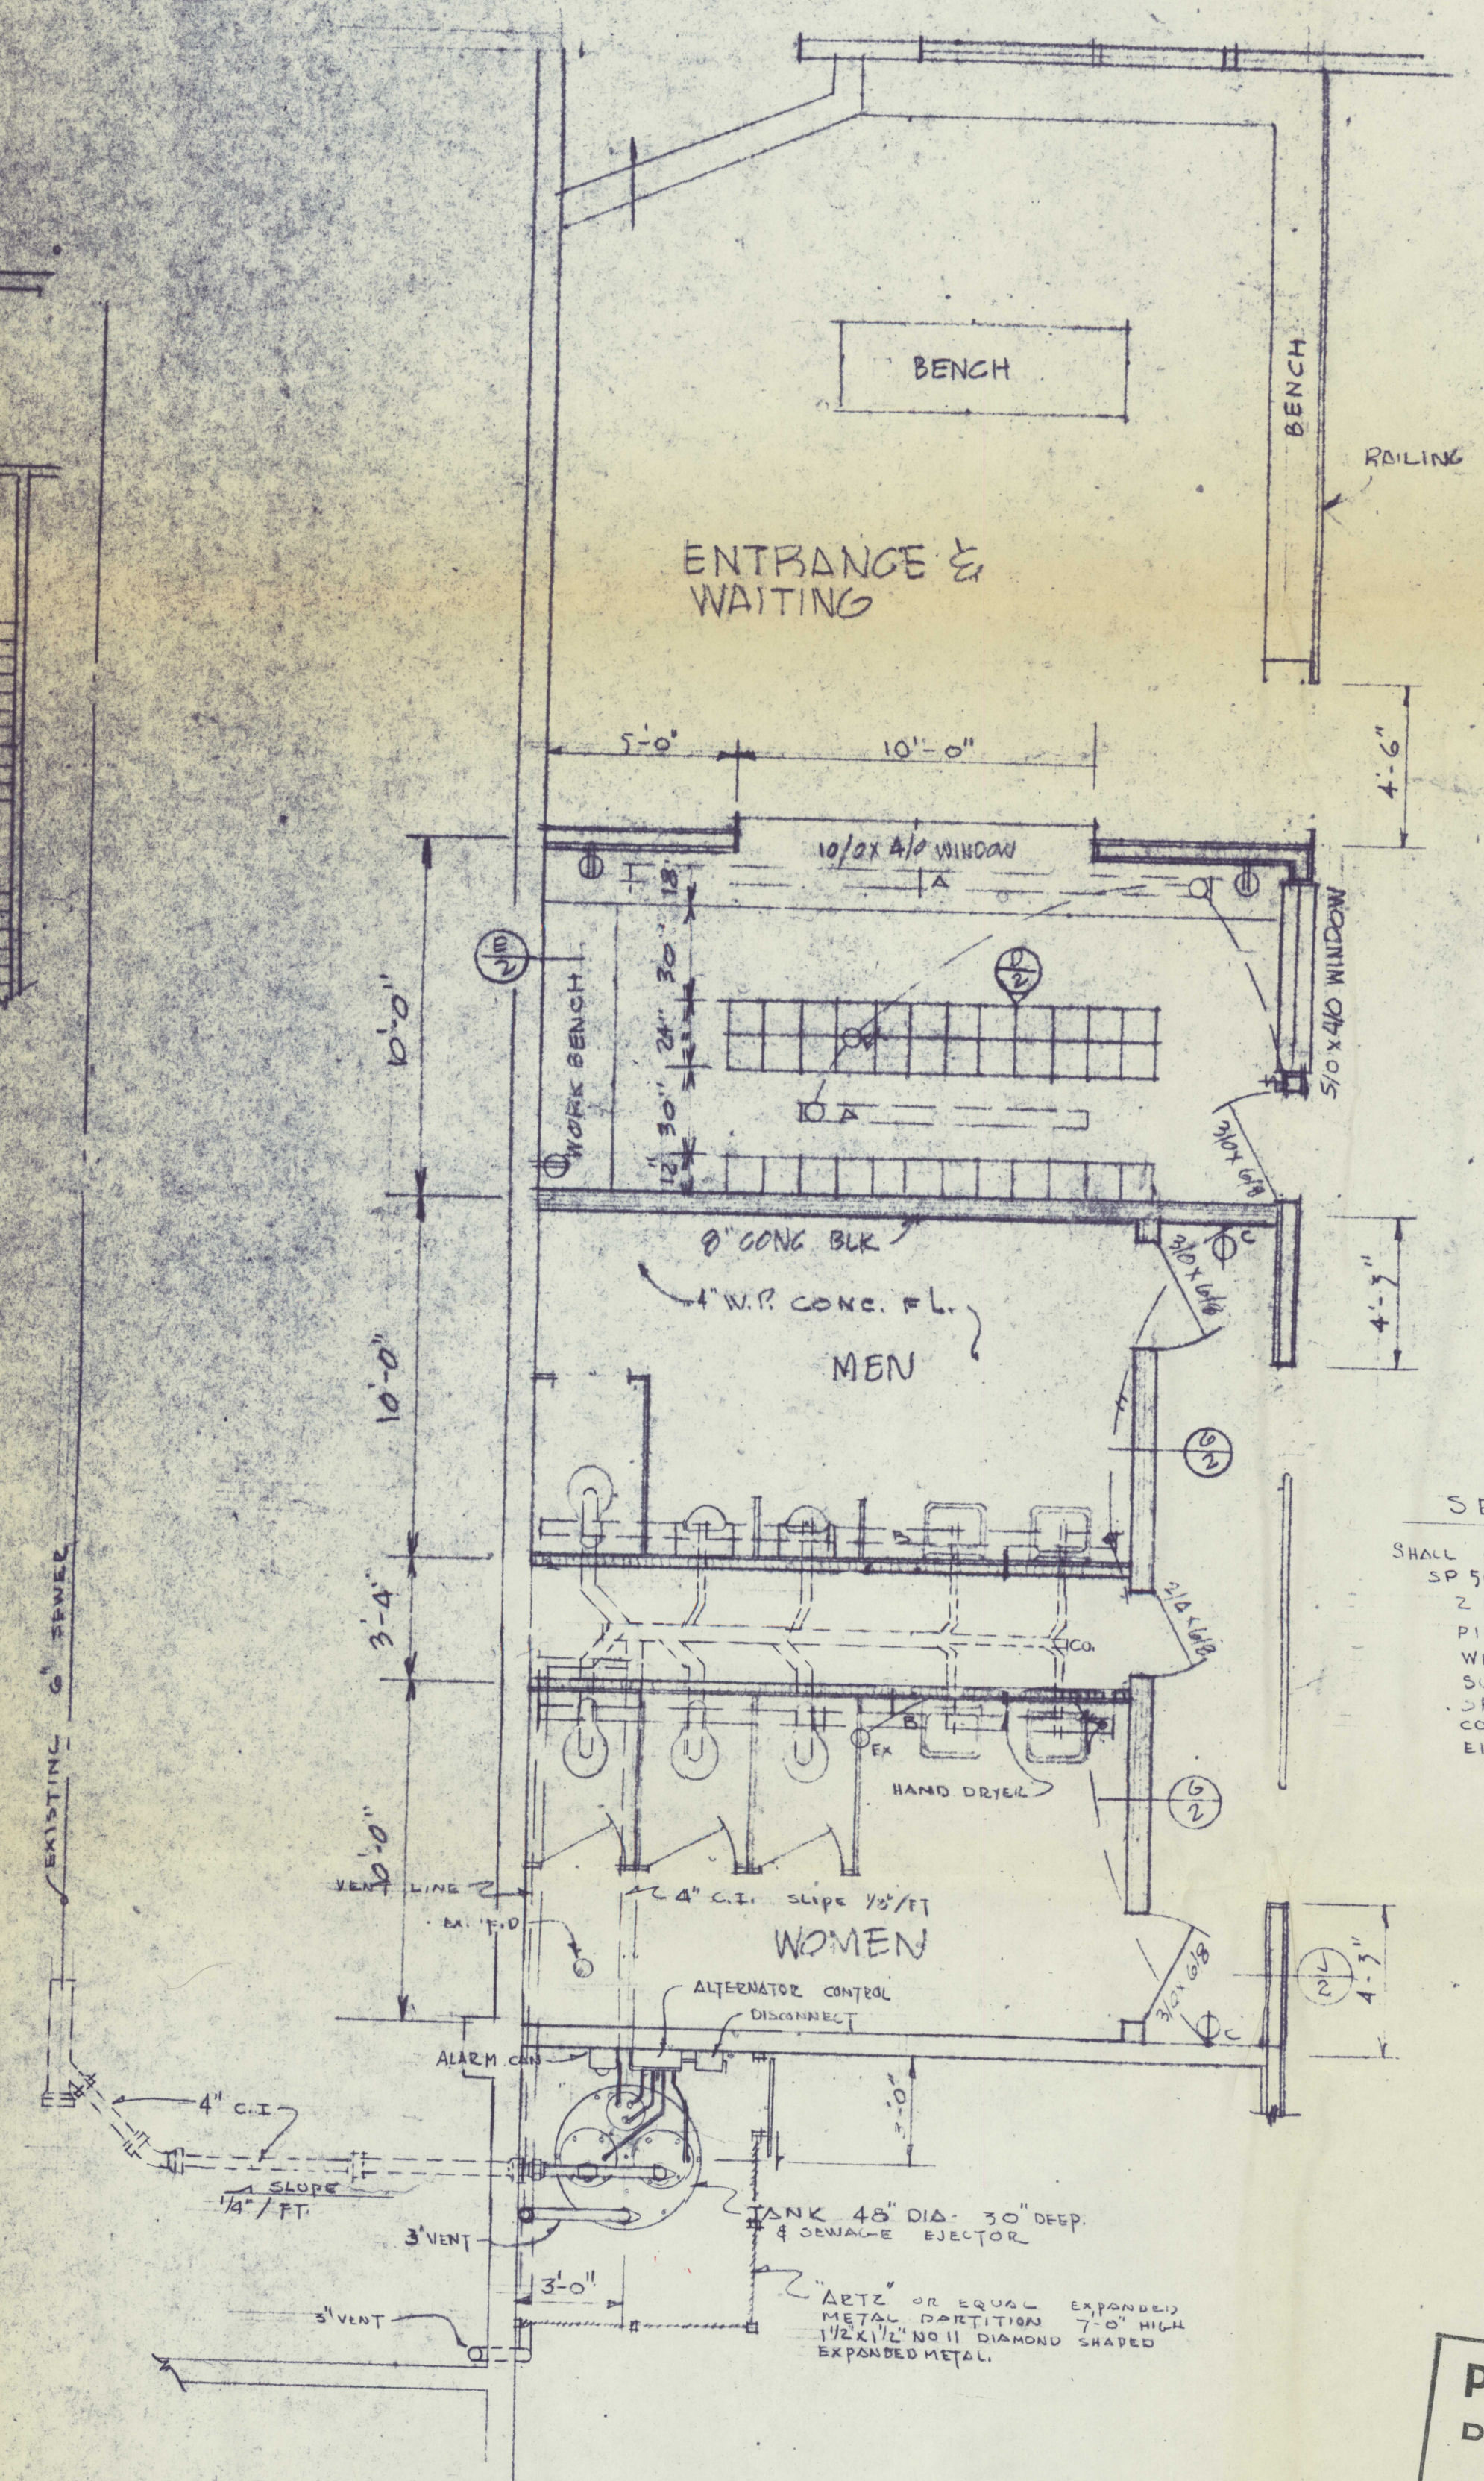

SEWAGE EJECTOR
SHALL BE OR EQUAL TO A HYDRO-MATIC
SP 50AD-30 WITH 3" - 4" FOLLOWS
2 PUMPS, 2 PUMP COVERS, 2 DISCHARGE
PIPES, 2 LEVEL CONTROLS & 1 ALTERNATOR
WITH LEVEL CONTROL. 44" DIA. 30" DEEP
SUMP BASIN & COVER. ALSO THREE
CONTROL & SINGLE BY BELL IF
EITHER PUMP SHOULD FAIL.

PRELIMINARY
DO NOT USE FOR BIDDING
OR CONSTRUCTION

68-37	MT. SCOTT COMMUNITY CENTER	MECHANICAL PLAN.		3	3
	BUREAU OF PARKS AND PUBLIC RECREATION PORTLAND, OREGON				
	FRANK J. FRANCIS HARRY B. BUCKLEY		COMMISSIONER SUPT. OF PARKS		
	DATE: MARCH 69 SCALE: NOTED 1/4" = 1' - 0"	DESIGNED BY: JACK P. STUHL DRAWN BY: APPROVED BY:		ASLA NO.	REV.

68-37	MT. SCOTT COMMUNITY CENTER	*SKATE AREA FLOOR PLAN		1	3
	BUREAU OF PARKS AND PUBLIC RECREATION PORTLAND, OREGON				
	FRANK J. IVANCIE NIGHT B. BUCKLEY	COMMISSIONER SUPT. OF PARKS			
	DATE 5/22/69 SCALE: NOTED 1/4" SEC.	DESIGNED BY: JACK P. STUHL DRAWN BY: APPROVED BY:	AREA NO.	REV.	

34" counter - Long

Rails on 4 sides

200 coat Hooks

Benches on North side
+ South side

Use Montavilla Bins

Need Telephone Extension

Need 462 Bins -
6 High only

For Safety reasons.

77 Rows

458 Pr. Shoe
Skates

No waiting Room

3' wide For Spectators

3' " " Skaters

Rail Between

Mt. Scott Community Center

Spring Program

May 14, 1969


8:00 - 9:30 p.m.

BALLET
GYMNASTICS
TRAMPOLINE
GIRLS FITNESS


PRE-SCHOOL FITNESS
BATON
BOXING
PRE-SCHOOL MUSICAL

Free Admission

Bureau of Parks and Public Recreation
City of Portland

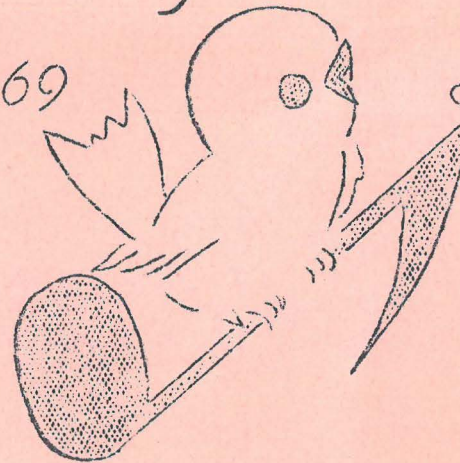

3" x 4" Line Down Center
15' From End Rails

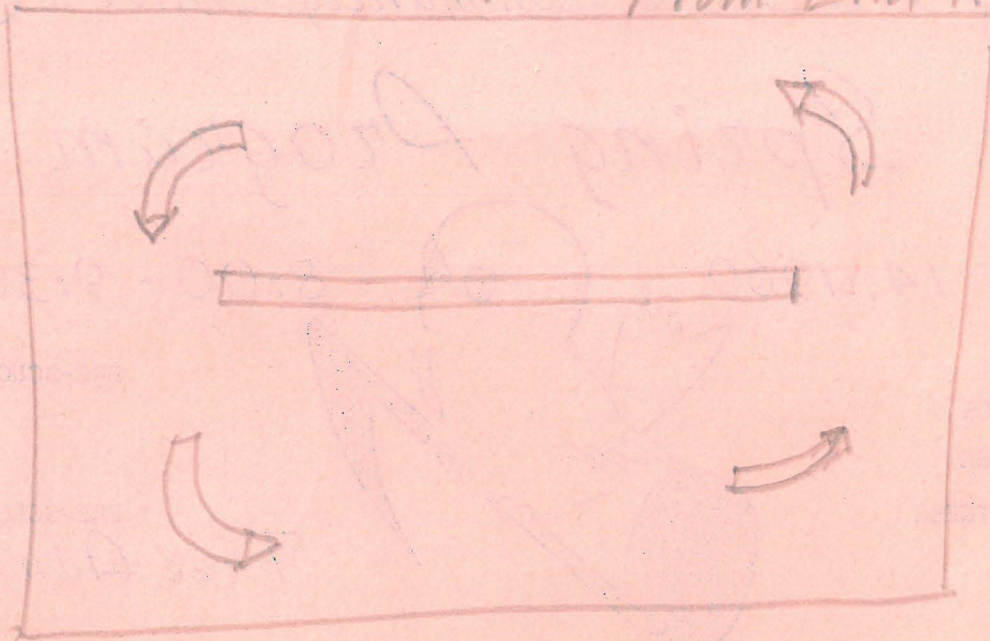


~~white~~
~~or~~
yellow

Arrows on 4 corners
3" x 4" Thick

2 Hockey Creases

10' From End Rail
in center

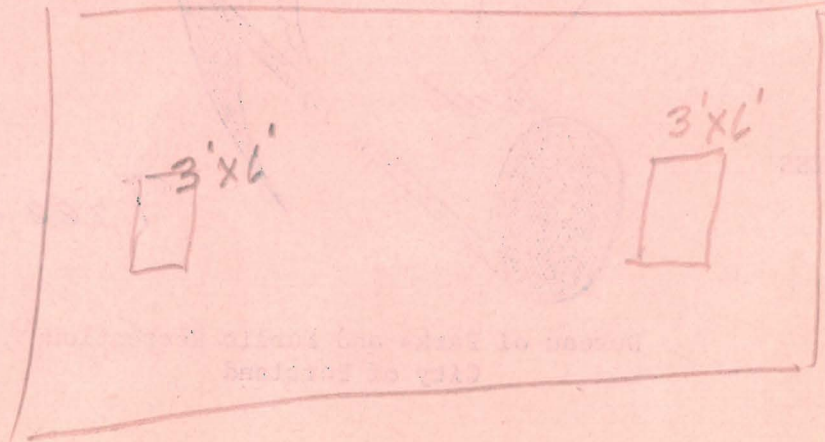

Bench on West End -
Rail (4') From Wall



Benches on 3 sides

Ext.
Phone
in
Skate
Room
X

clock



counter


Skate
Room

Rail
3' From counter

Door

Skate Counter

No Dutch Door needed
open In.

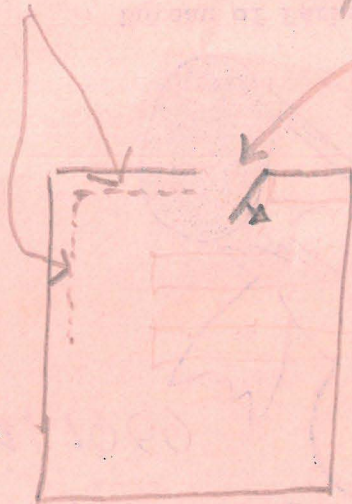

From Floor
↓ 6'
↓ 2'

Intersect

Foam Rubber
Posts around

X

Keep existing Bench
South wall



X

Buzzer
Emergency
only



Emergency
only

Buzzer