



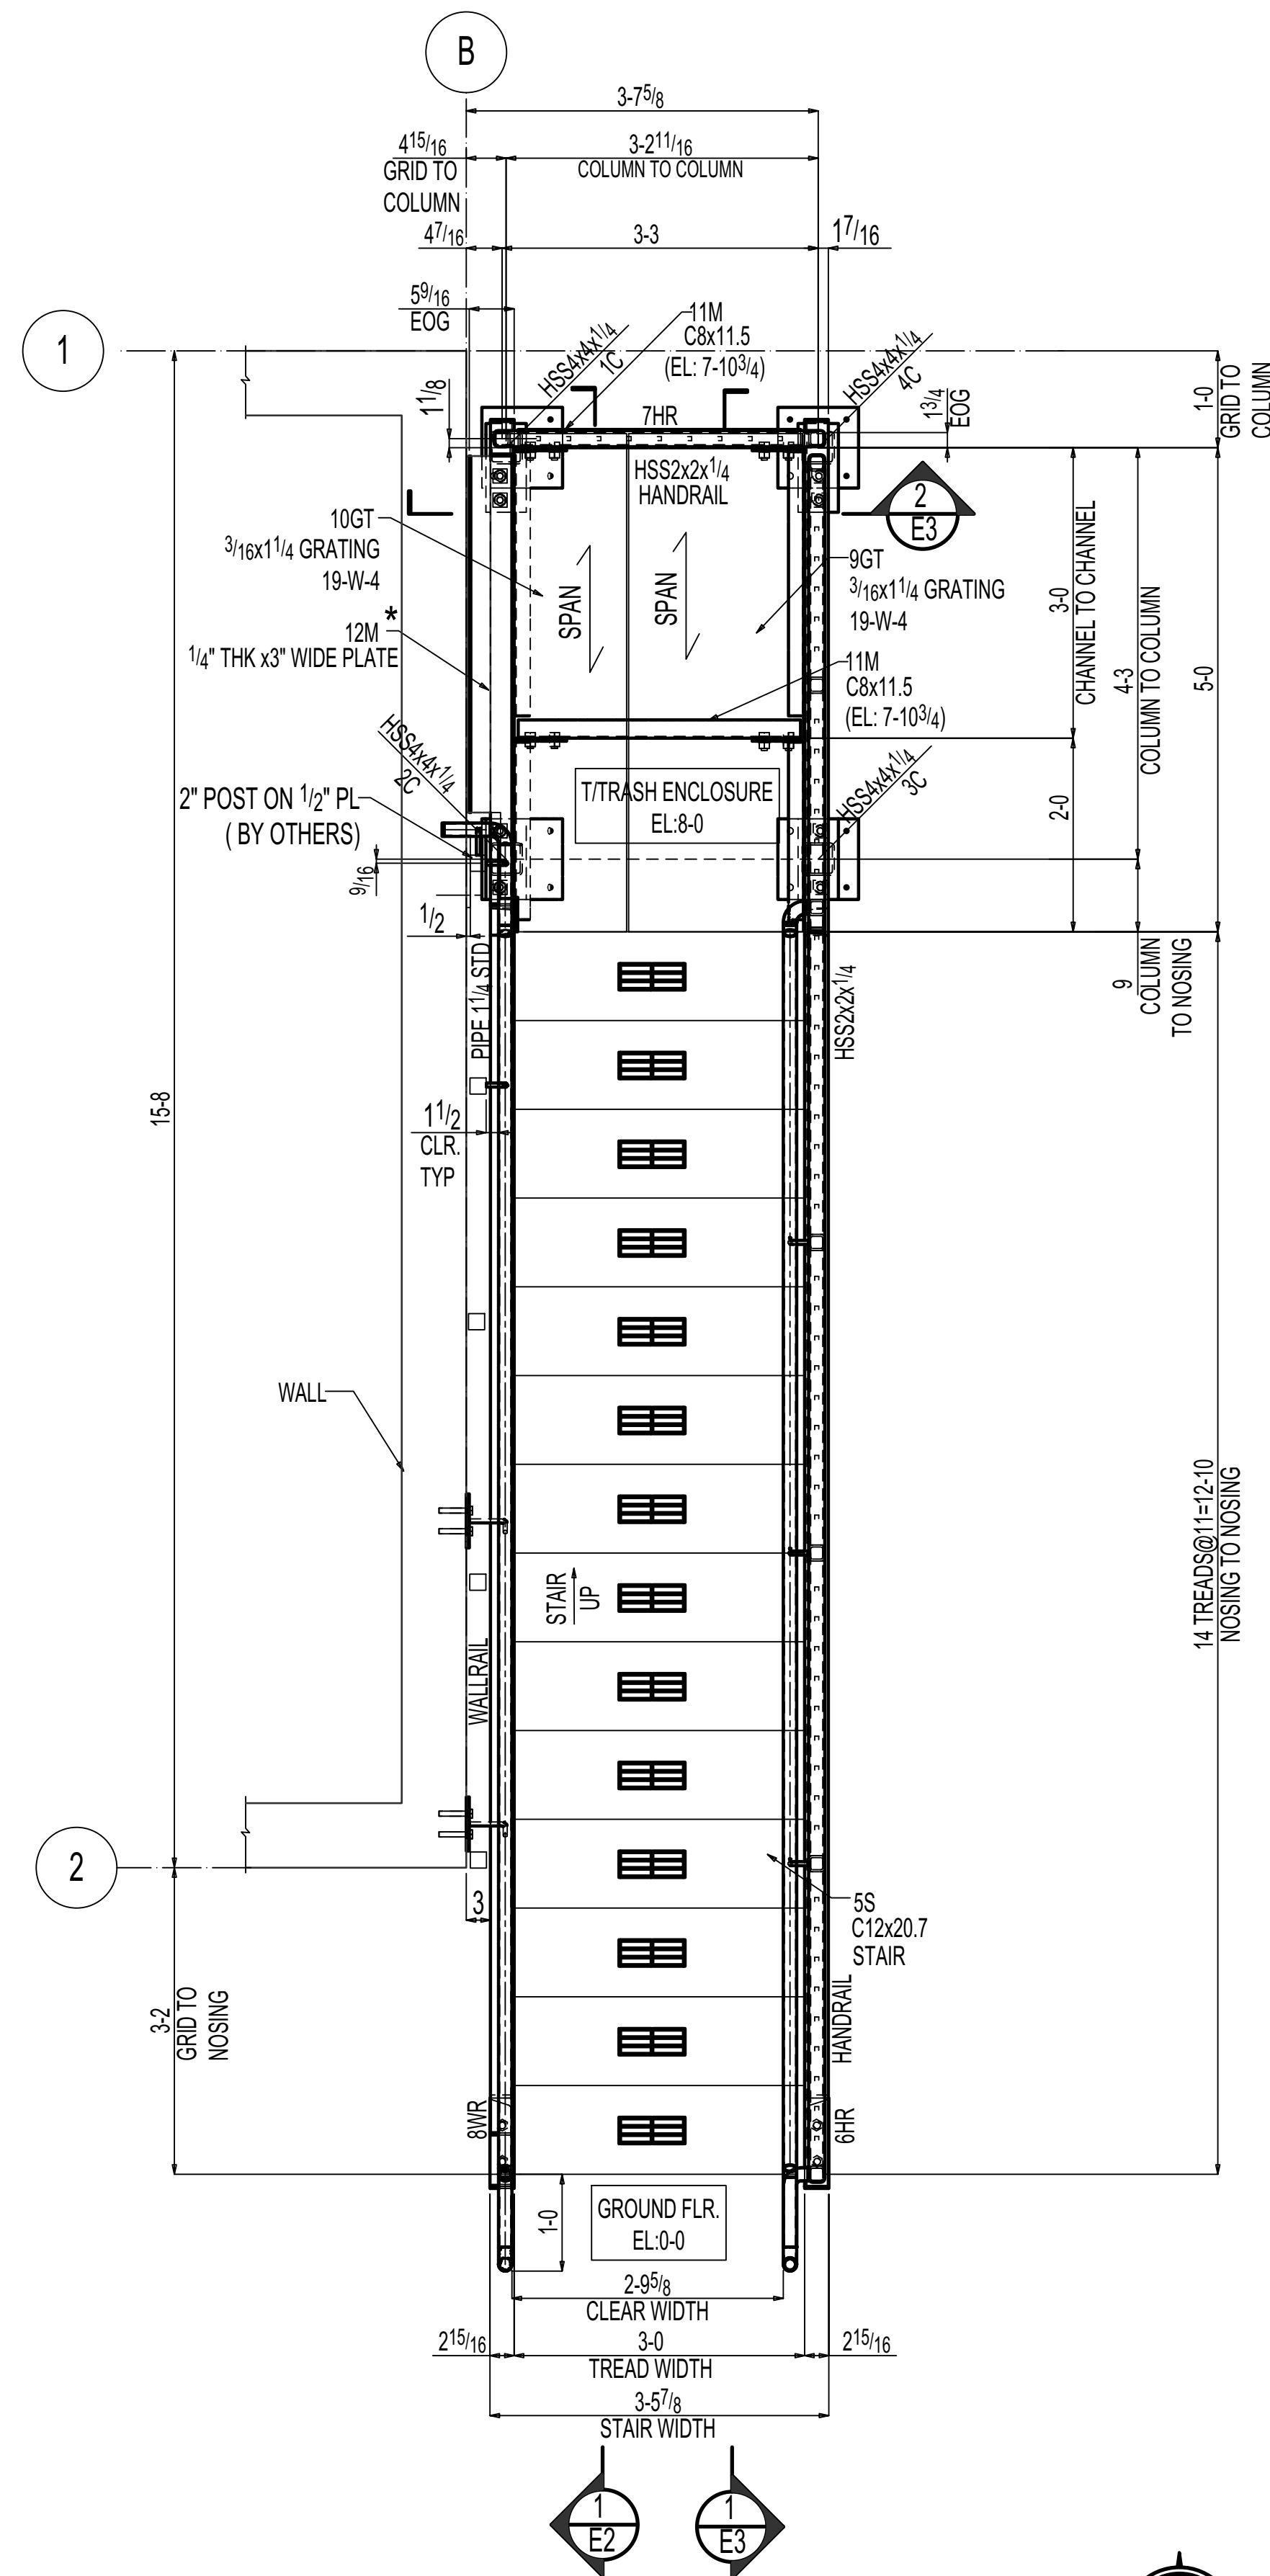

TRASH ENCLOSURE STAIR PLAN


- NOTES:
1. EOG - INDICATES EDGE OF GRATING.
 2. - INDICATES SPAN OF GRATING.
 3. FOR ELEVATION VIEWS & SECTION VIEWS REFER SHEETS E2 THRU E4.
 4. * - INDICATES CUT TO SUIT IN FIELD AS REQUIRED.

REF: 2/A6.02

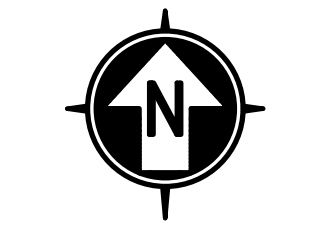

JOB NORTH

22-130202-DFS-01-CO

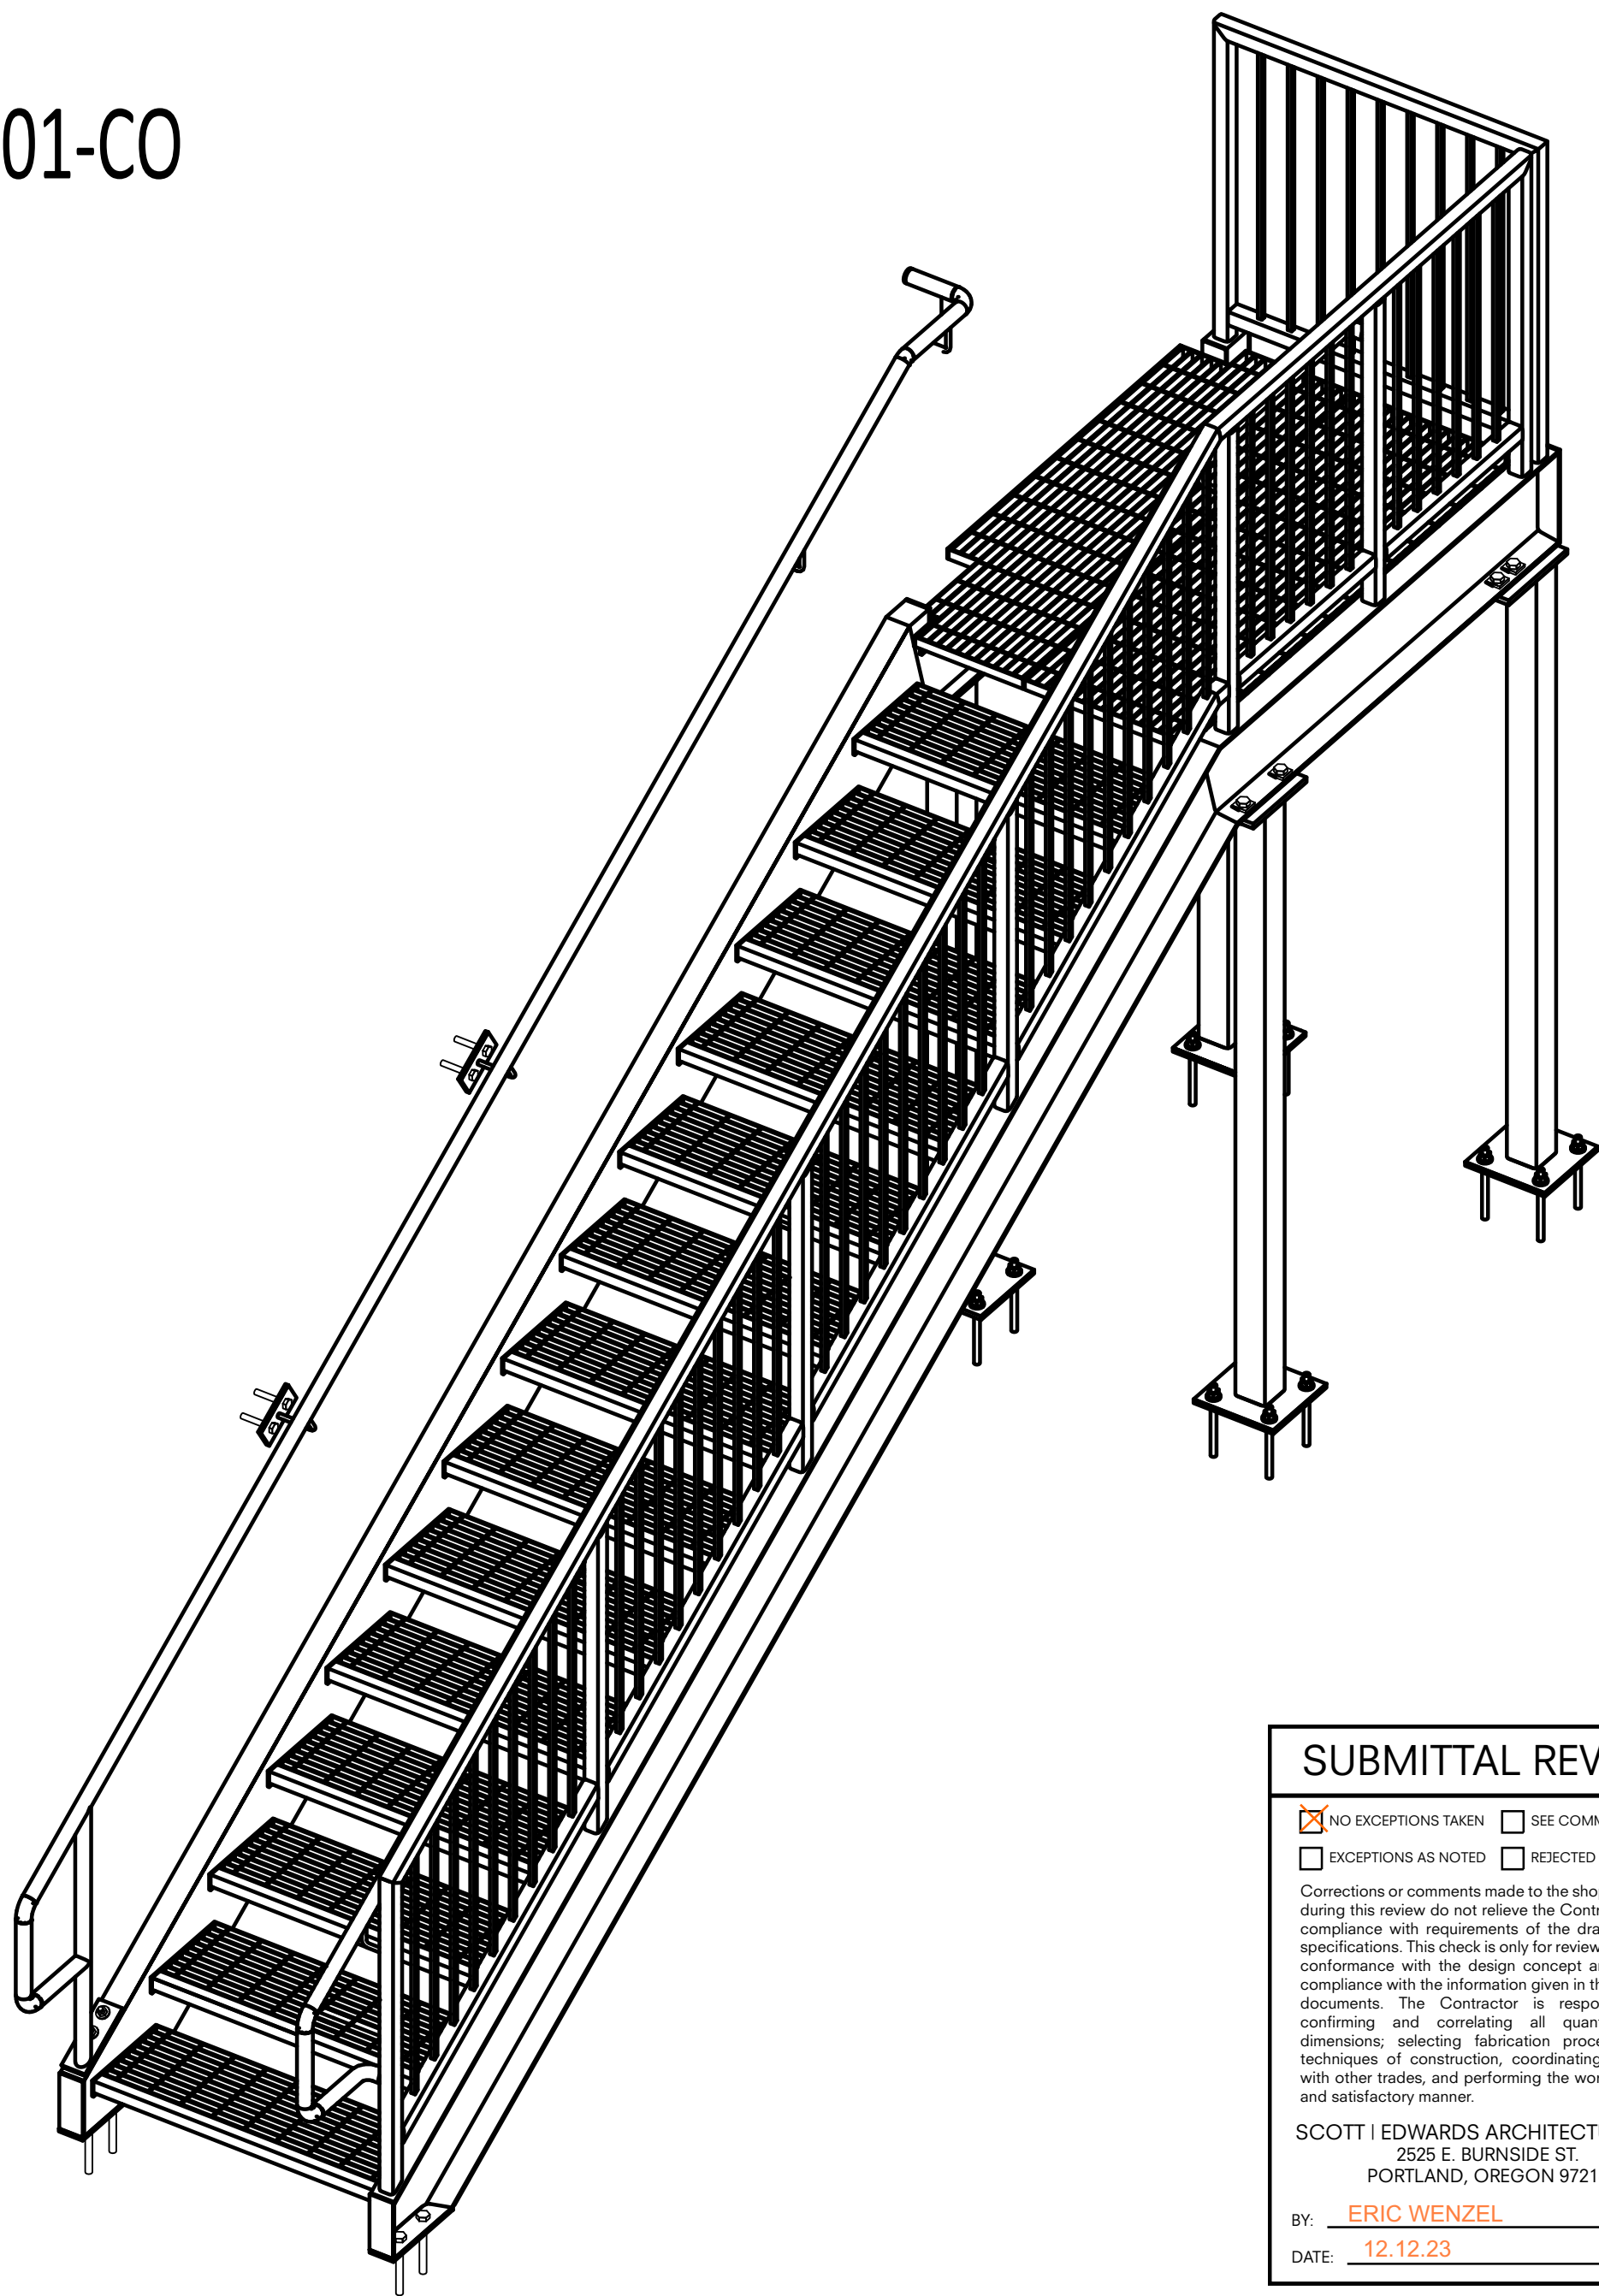

ISOMETRIC VIEW


SUBMITTAL REVIEW

NO EXCEPTIONS TAKEN
EXCEPTIONS AS NOTED
REJECTED / RESUBMIT
CORRECTIONS OR COMMENTS MADE TO THE SHOP DRAWINGS DURING THIS REVIEW DO NOT RELIEVE THE CONTRACTOR FROM COMPLIANCE WITH REQUIREMENTS OF THE DRAWINGS AND SPECIFICATIONS. THIS CHECK IS ONLY FOR REVIEW OF GENERAL CONFORMANCE WITH THE DESIGN CONCEPT AND GENERAL COMPLIANCE WITH THE INFORMATION GIVEN IN THE CONTRACT DOCUMENTS. THE CONTRACTOR IS RESPONSIBLE FOR CONFIRMING AND CORRECTING ALL QUANTITIES AND DIMENSIONS, SELECTING FABRICATION PROCESSES AND TECHNIQUES OF CONSTRUCTION, COORDINATING THE WORK WITH OTHER TRADES, AND PERFORMING THE WORK IN A SAFE AND SATISFACTORY MANNER.

SCOTT | EDWARDS ARCHITECTURE, LLP
2525 E BURNSIDE ST.
PORTLAND, OREGON 97214
BY: ERIC WENZEL
DATE: 12.12.23

No Exception Taken
Submit Additional/Specified Items
Make Corrections Noted
Revise and Resubmit
Checking by GSE is only for general conformance with the design concept of the project and general compliance with the information given in the contract documents. Any action shown is subject to the requirements of the plans and specifications. The general contractor is responsible for: Dimensions which shall be confirmed at the jobsite; fabrication processes and techniques of construction; coordination of his work with that of all other trades; and the satisfactory performance of his work.
GSE, Inc.
Date: 11/6/23
By: Jim Gipe, S.E.



REVISION	DATE	BY	DESCRIPTION
1	09-08-2023	KRK	ISSUED FOR FIELD USE
2	08-30-2023	KRK	ISSUED FOR APPROVAL
PROJECT: WONDERLOVE STAIRS 1300 SE 2ND AVE PORTLAND, OR 97214			
ITEM: TRASH ENCLOSURE STAIR PLAN & ISOMETRIC VIEW			
CONTRACTOR: ---		DETAILER: SUPERIOR METAL FAB	PROJECT MANAGER: JUSTIN
DR. BY: MMR	DATE: 07-12-2023	CHK'D BY: KRK	DATE: 07-12-2023
SCALE: NTS	JOB NO.: 220617	DWG. NO.: E1	

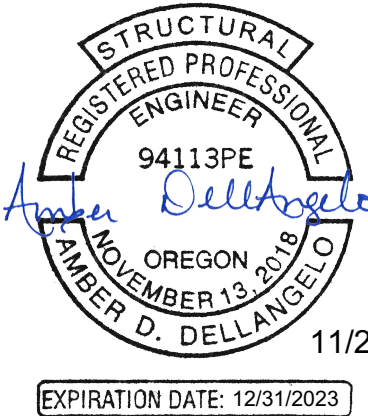

Larson Engineering Inc
1488 Bond Street, Suite 100
Naperville, Illinois 60563-6503
(P) 630.357.0540 (F) 630.357.0164
LEI COMM NO. 21230501.000
SEALED LIMITED TO STAIR ONLY.
LAYOUT, MATERIALS, QUANTITIES ARE EXCLUDED.


City of Portland
Reviewed for
Code Compliance

Date: 01/24/24
Permit #: 22-130202-DFS-01-CO

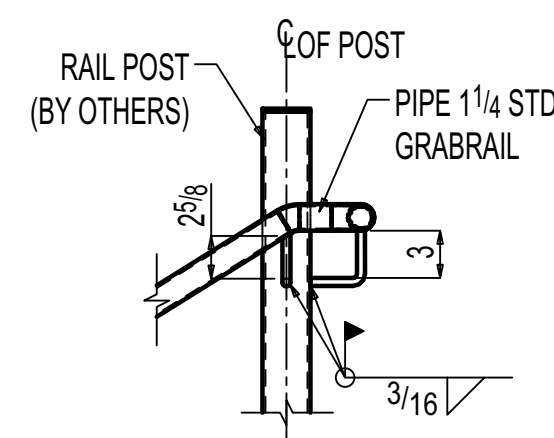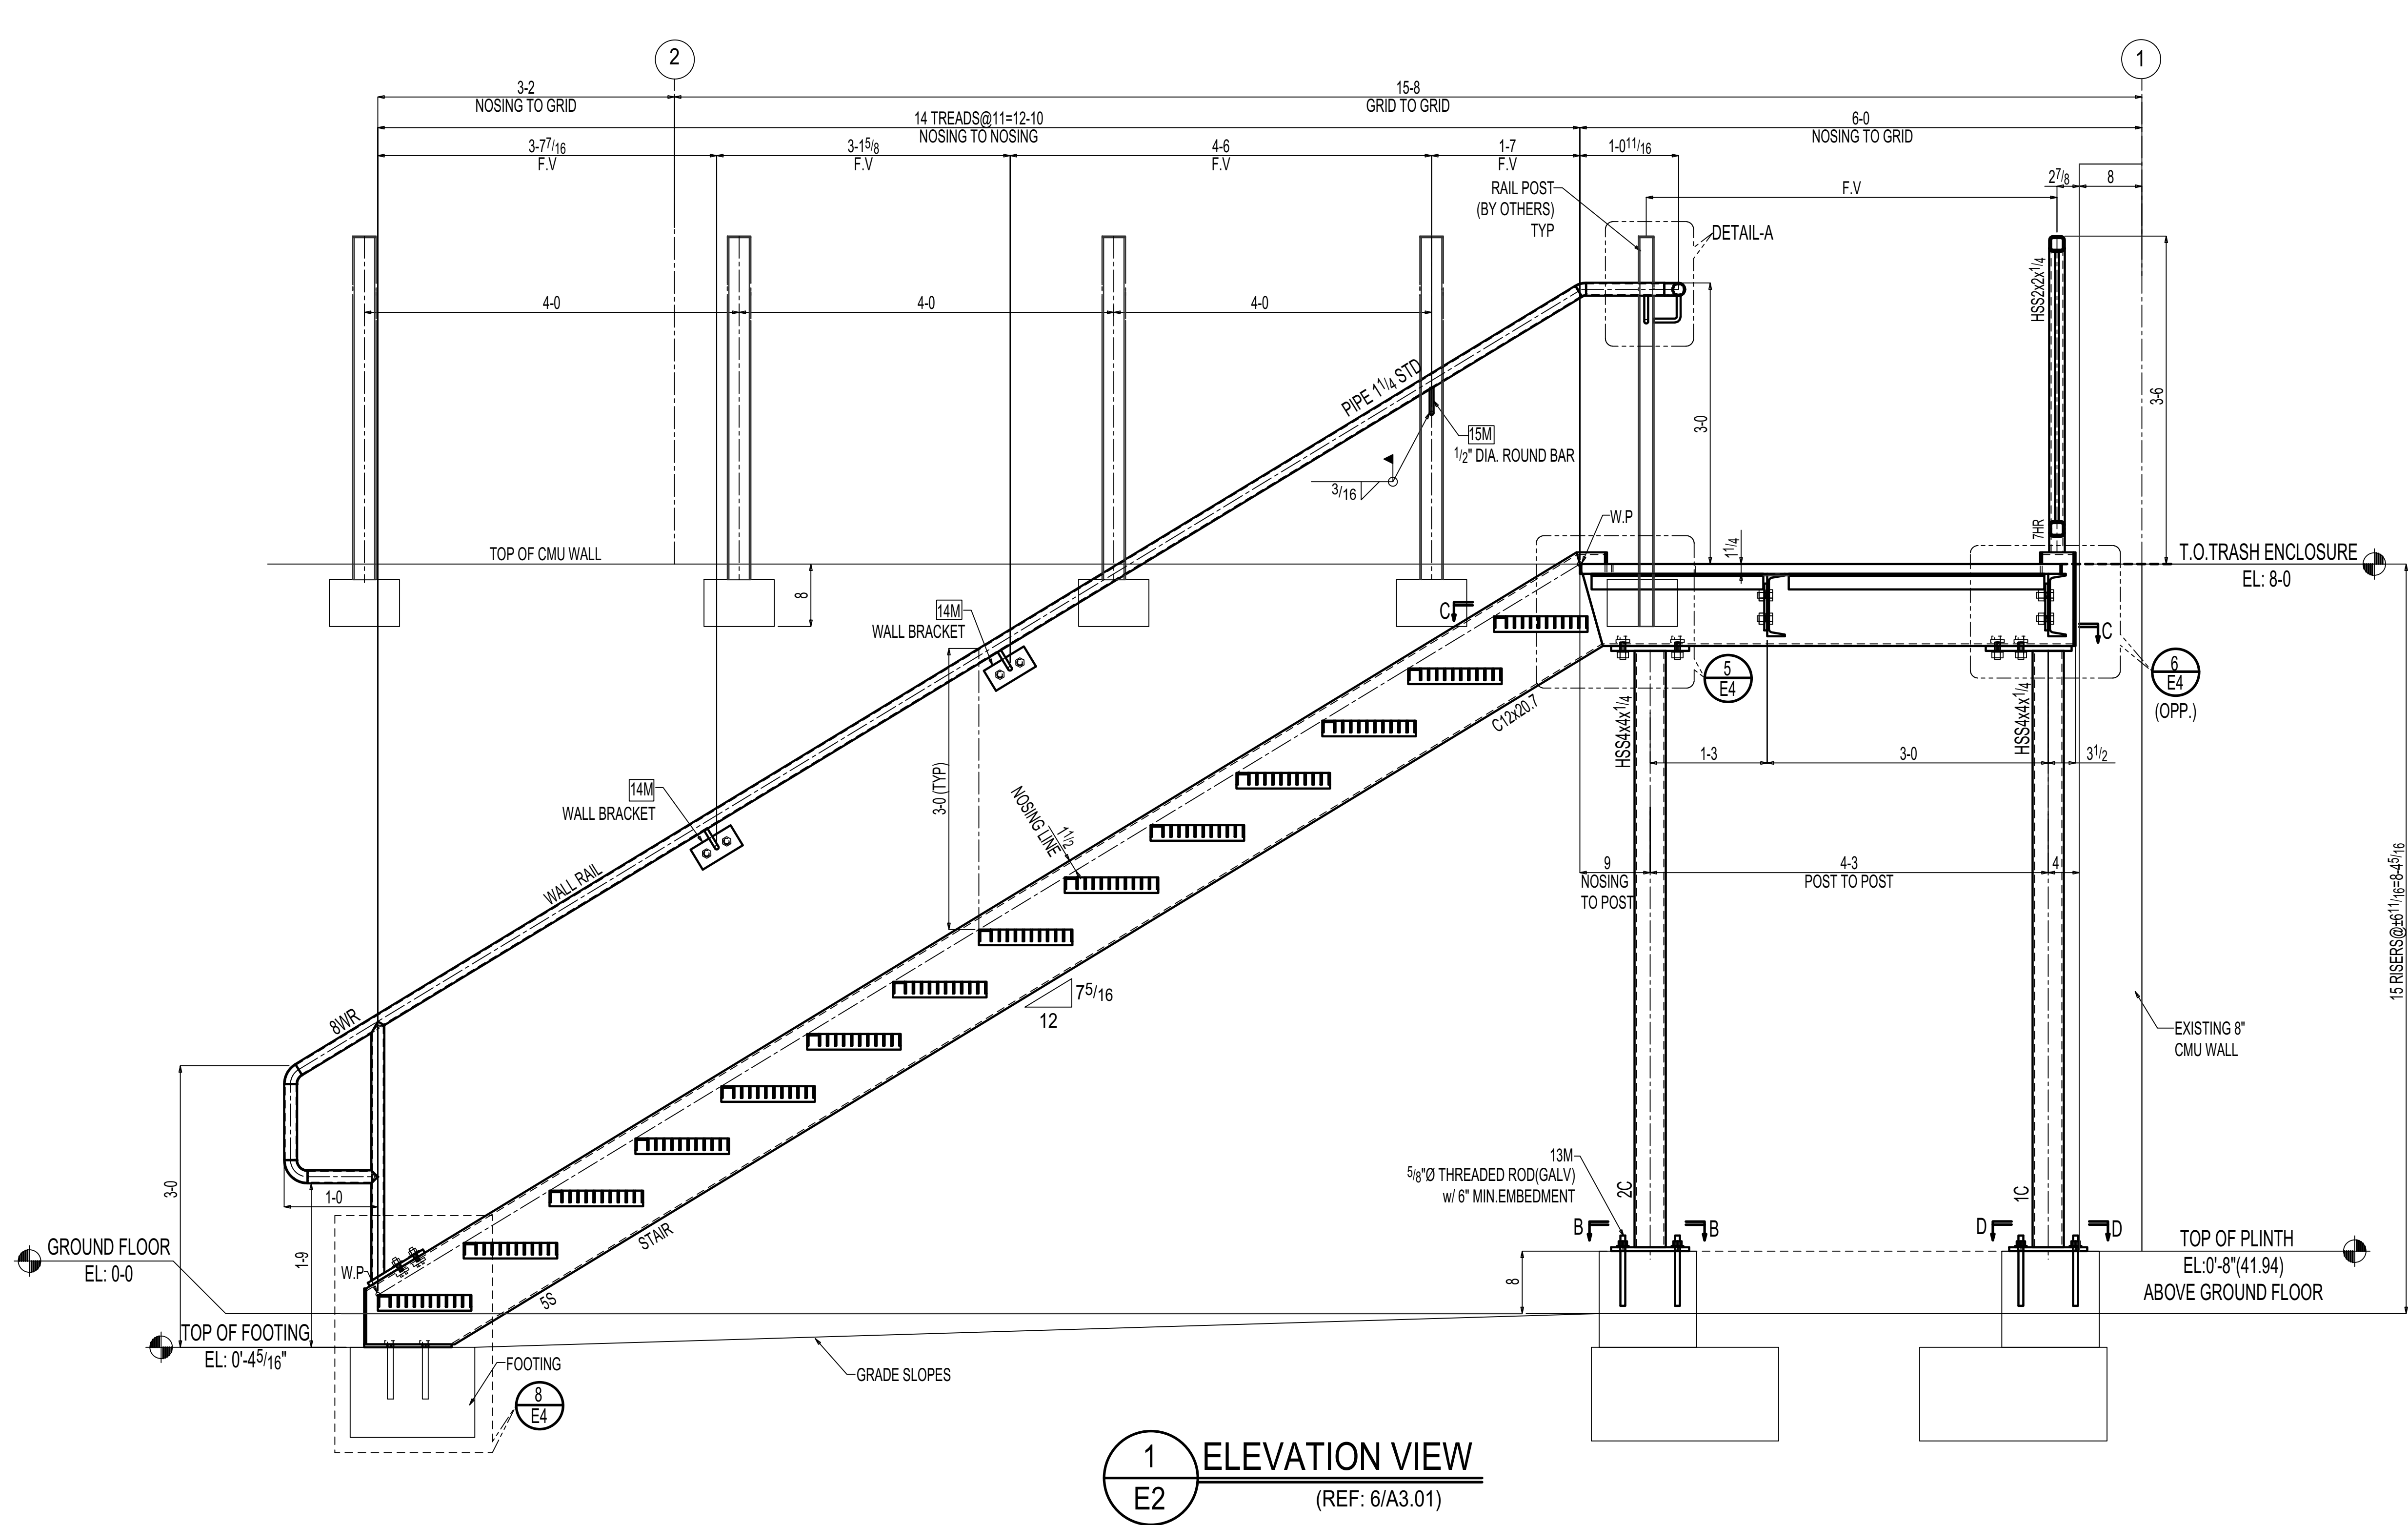


DETAIL-A


SECTION A-A
DELETED

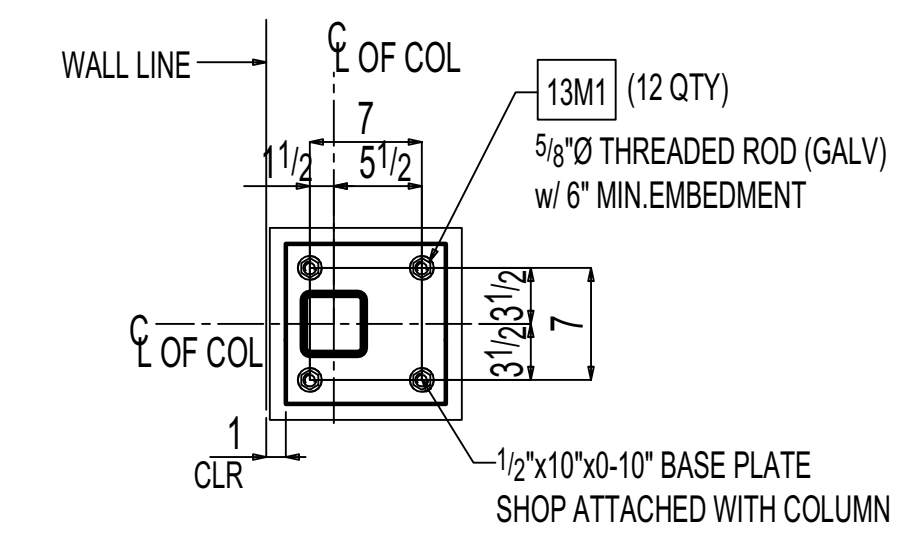

SECTION B-B

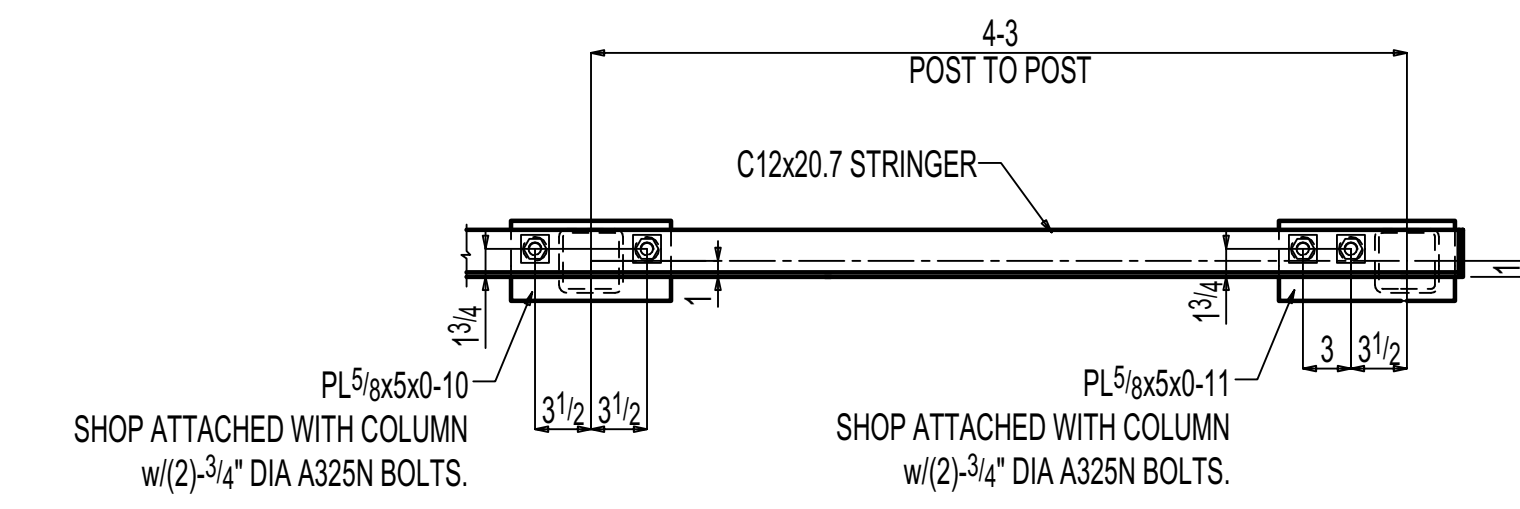


SECTION C-C

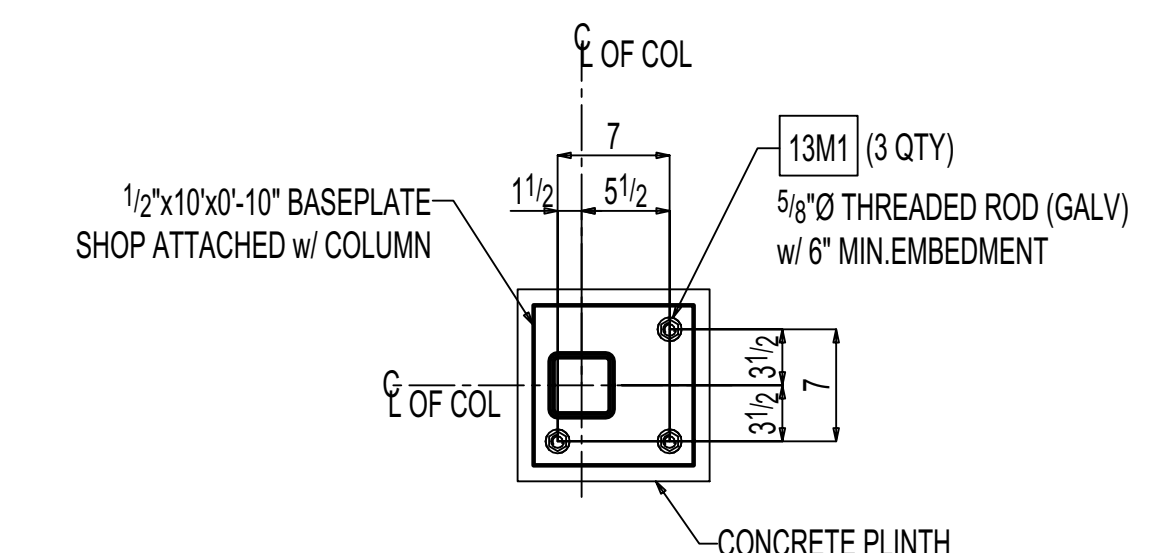

SECTION D-D


City of Portland
Reviewed for
Code Compliance
Date: 01/24/24
Permit # 22-138282-DFG-01-00

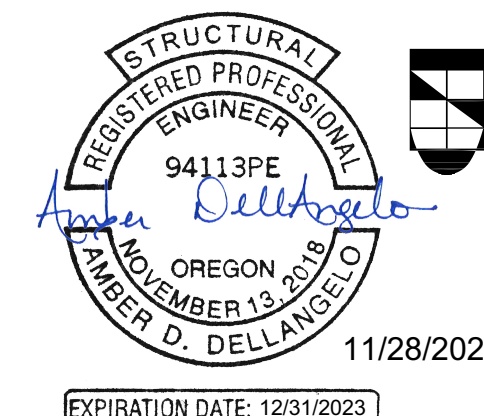

Larson Engineering Inc
1488 Bond Street, Suite 100
Naperville, Illinois 60563-6503
(P) 630.357.0540 (F) 630.357.0164
LEI COMM NO. 21230501.000
SEALED LIMITED TO STAIR ONLY.
LAYOUT, MATERIALS, QUANTITIES
ARE EXCLUDED.




PROJECT: WONDERLOVE STAIRS 1300 SE 2ND AVE PORTLAND, OR 97214			
ITEM: ELEVATION VIEW			
CONTRACTOR: ---	DETAILER: SUPERIOR METAL FAB	PROJECT MANAGER: JUSTIN	
DR. BY: MMR	DATE: 07-12-2023	CHK'D BY: KRK	DATE: 07-12-2023
SCALE: NTS	JOB NO.: 220617	DWG. NO.: E2	ERECTOR REF.: 6/A3.01

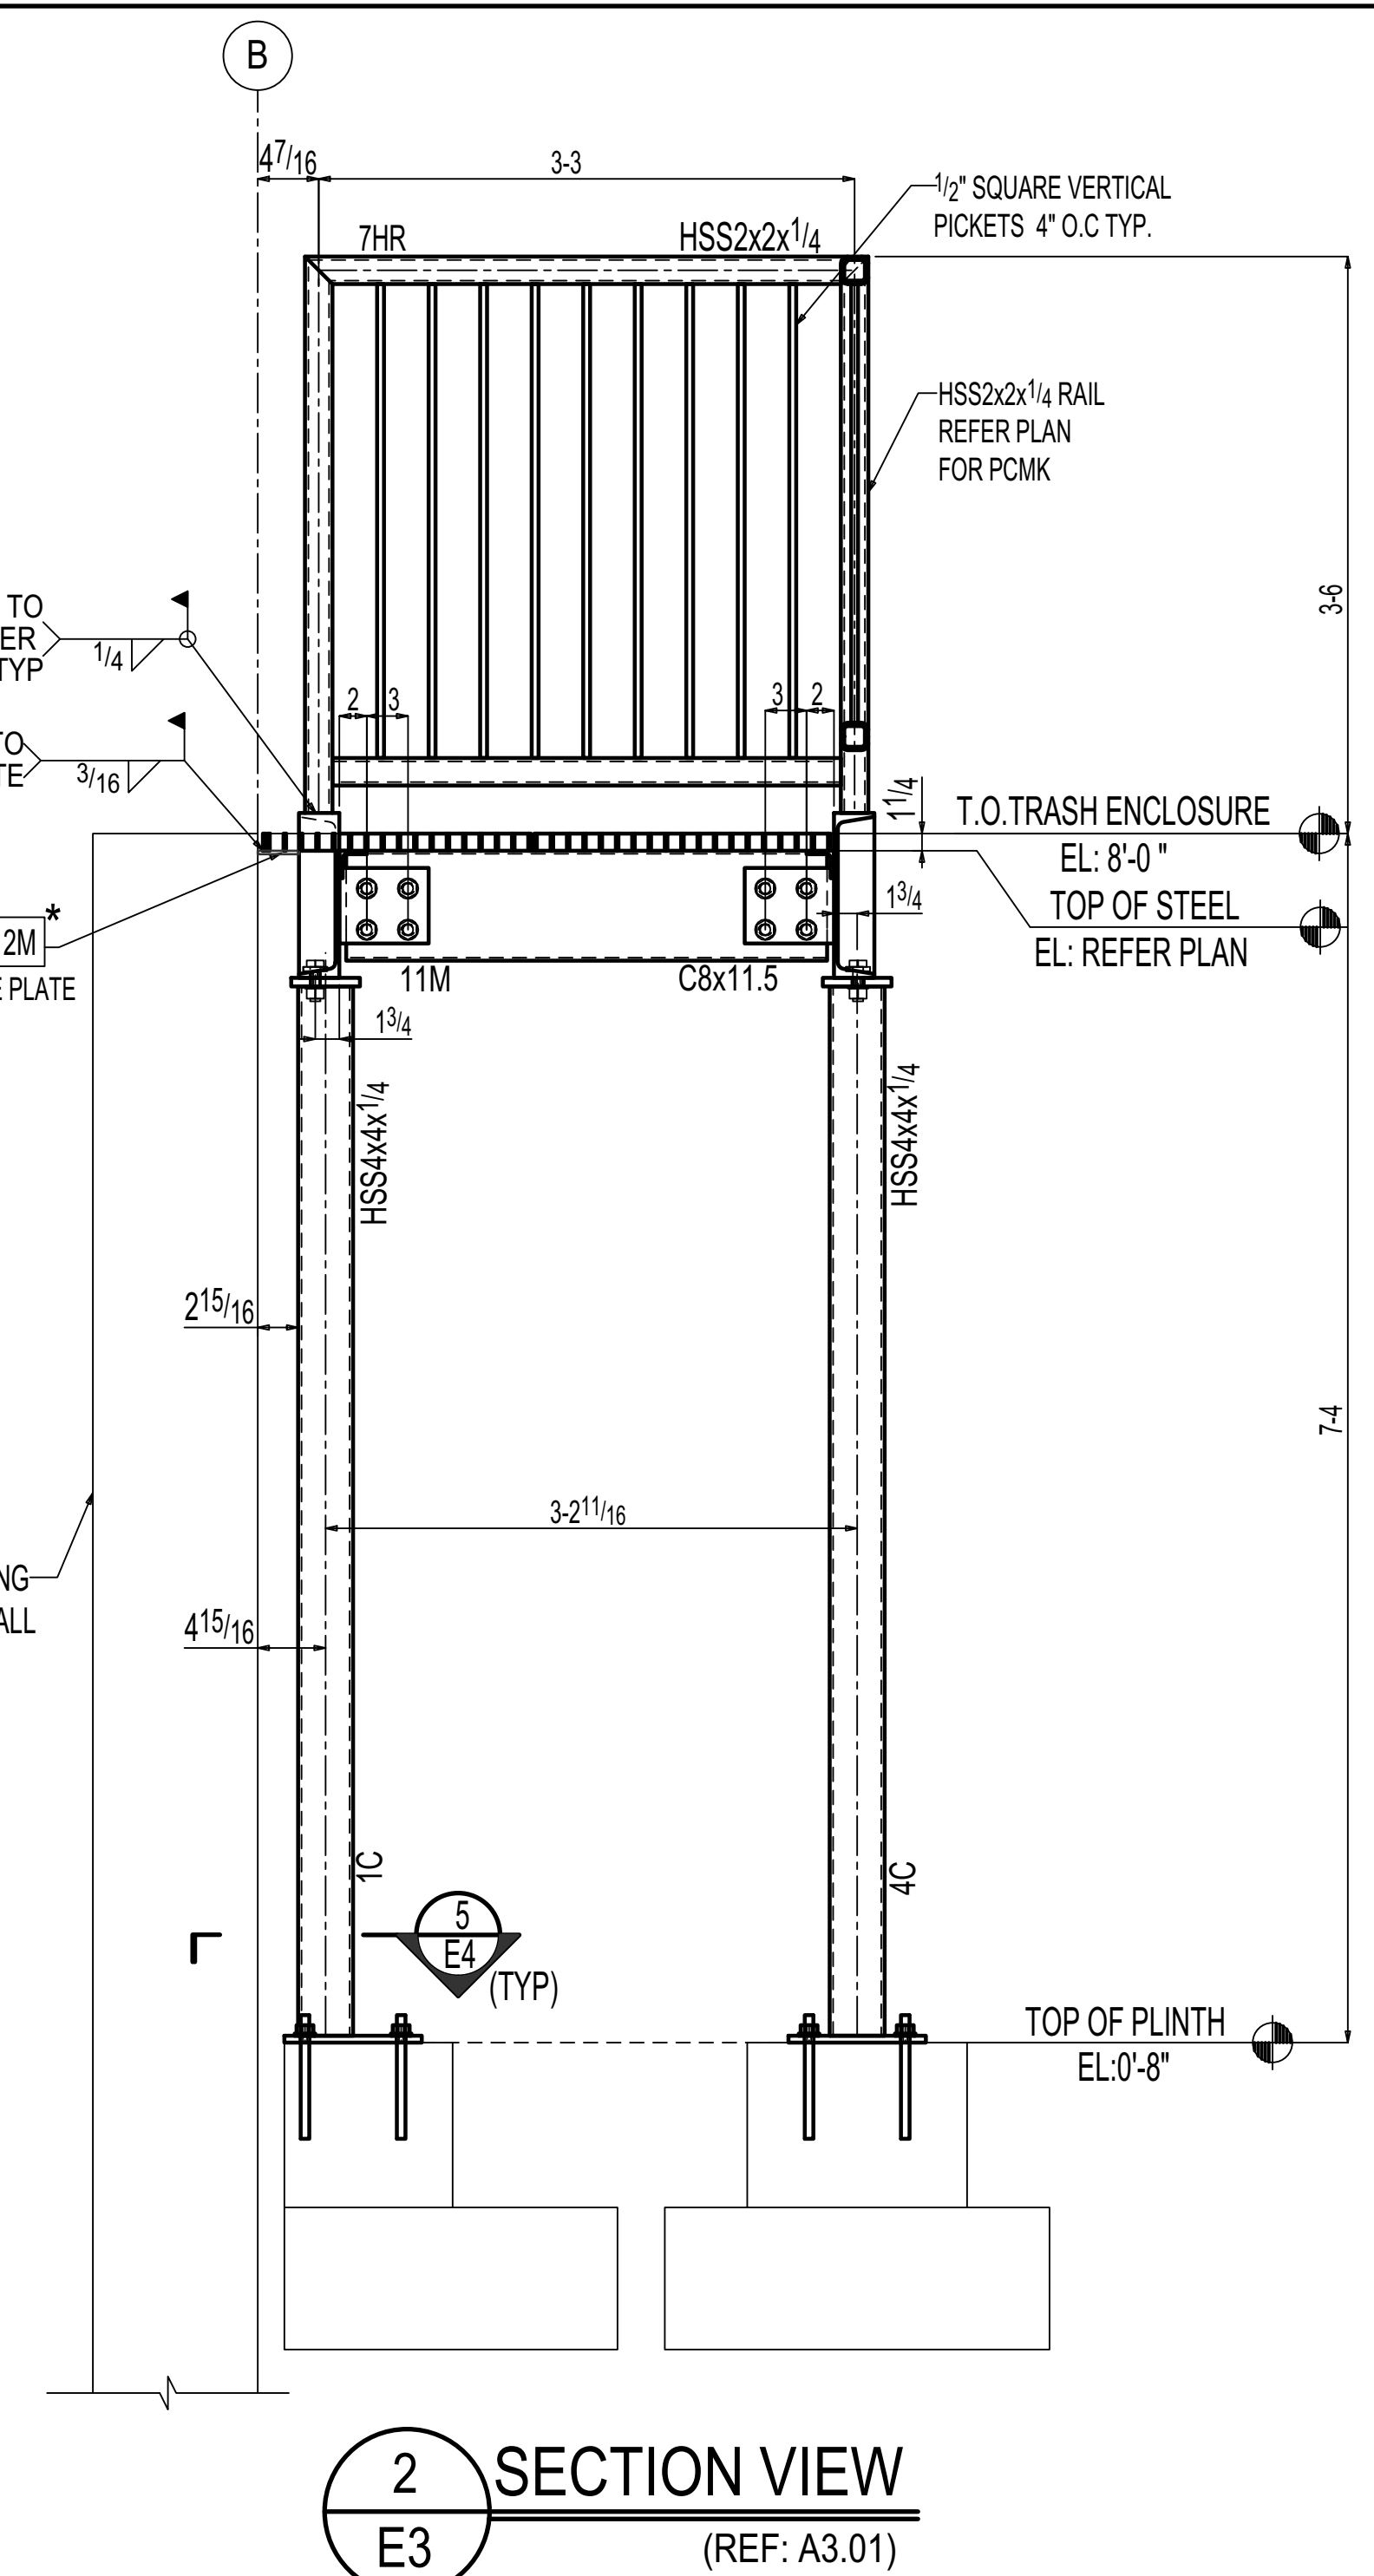

2 SECTION VIEW
E3 (REF: A3.01)

NOTES:
1. * - INDICATES CUT TO SUIT IN FIELD AS REQUIRED.

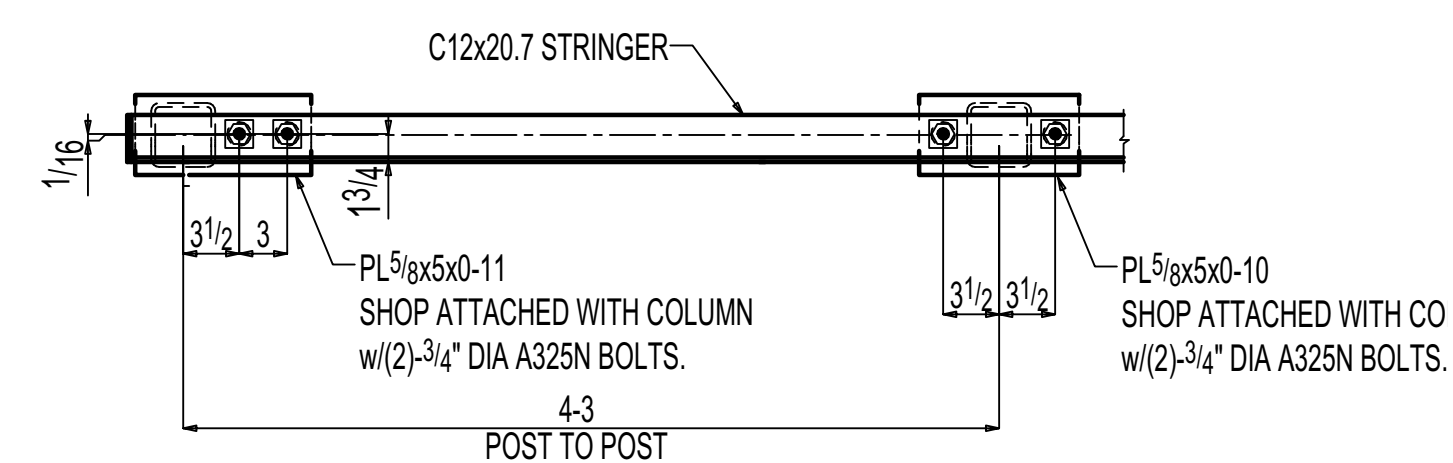


SECTION B-B




PROJECT:		WONDERLOVE STAIRS	
		1300 SE 2ND AVE PORTLAND, OR 97214	
ITEM: ELEVATION VIEWS			
CONTRACTOR: ----		DETAILER: SUPERIOR METAL FAB	PROJECT MANAGER: JUSTIN
DR. BY: MMR	DATE: 07-12-2023	CHK'D BY: KRK	DATE: 07-12-2023
ERECTOR REF.: ----			
SCALE: NTS	JOB NO.: 220617	DWG. NO.: E3	

Date: 01/24/24


Permit #: 22-130202-DFS-01-00

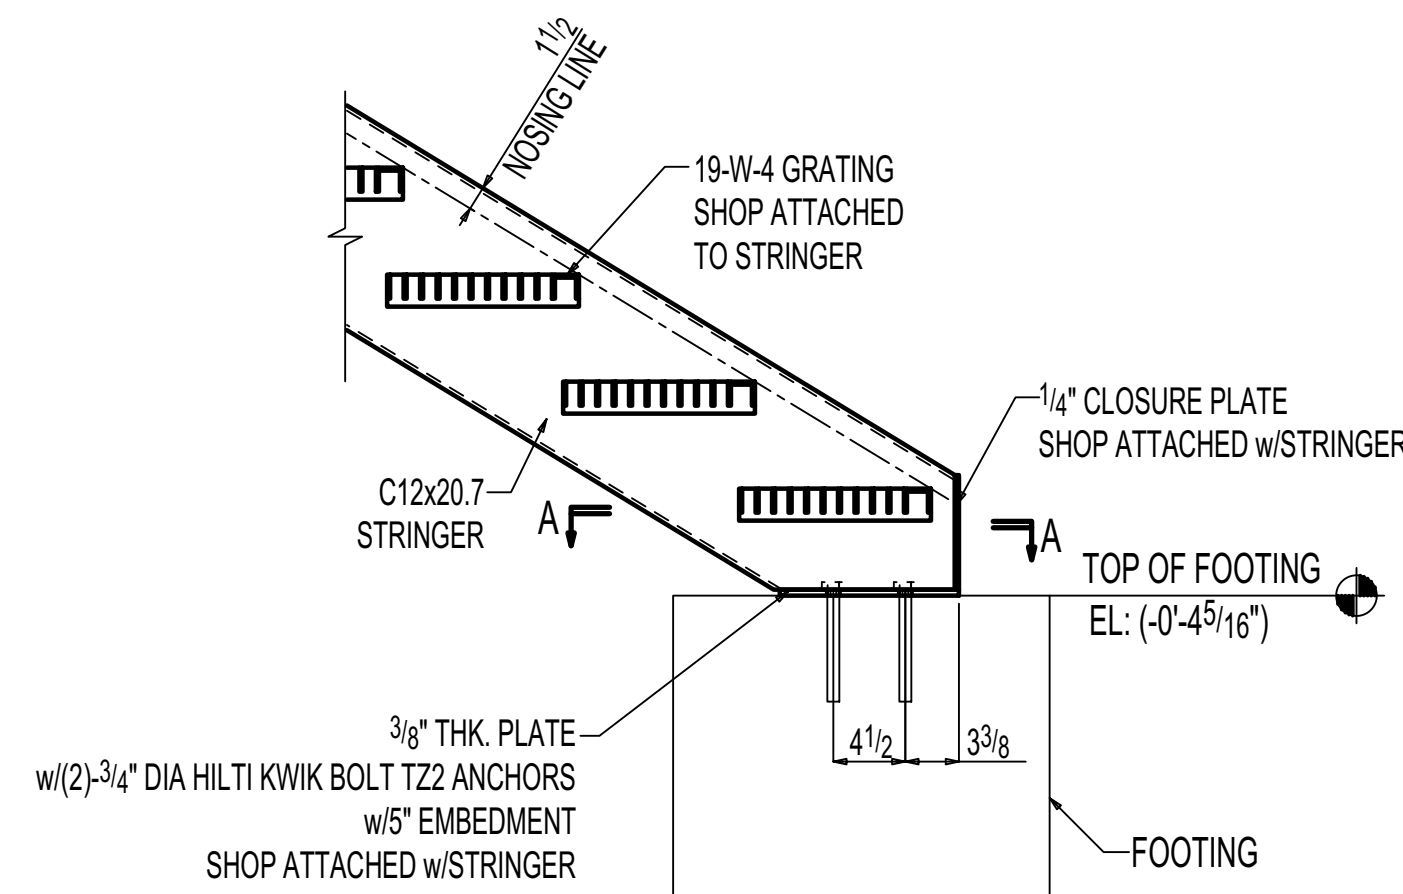


1
E4
TYPICAL STRINGER BOTTOM
CONNECTION

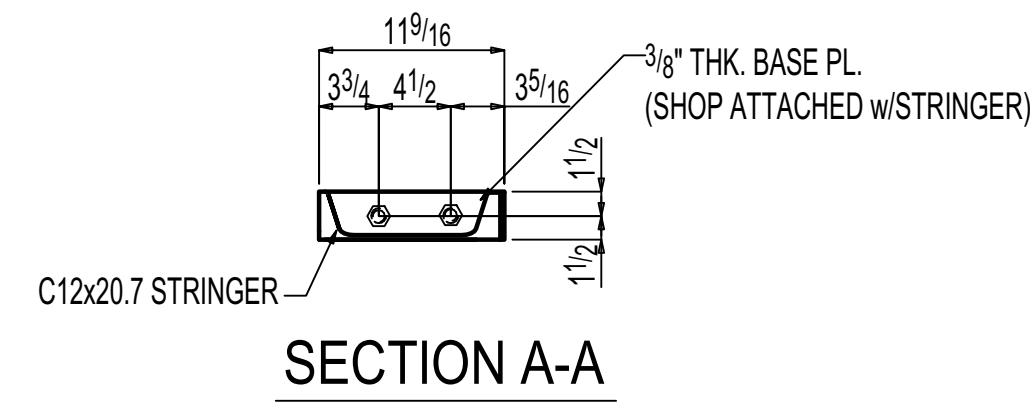


SECTION A-A

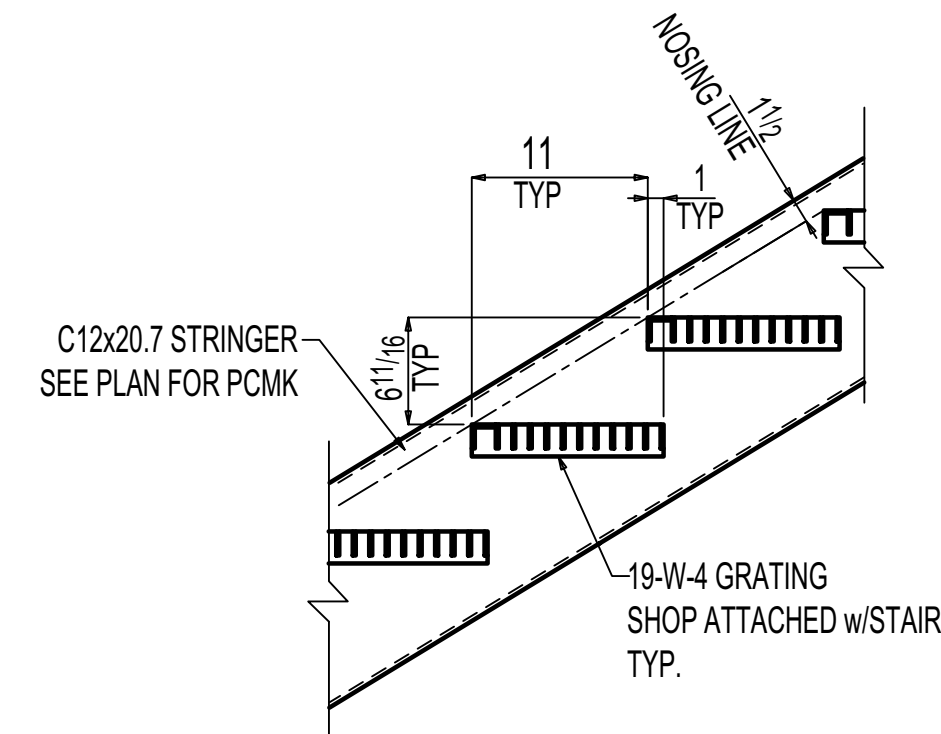


2
E4
TYPICAL STRINGER TREAD DETAIL

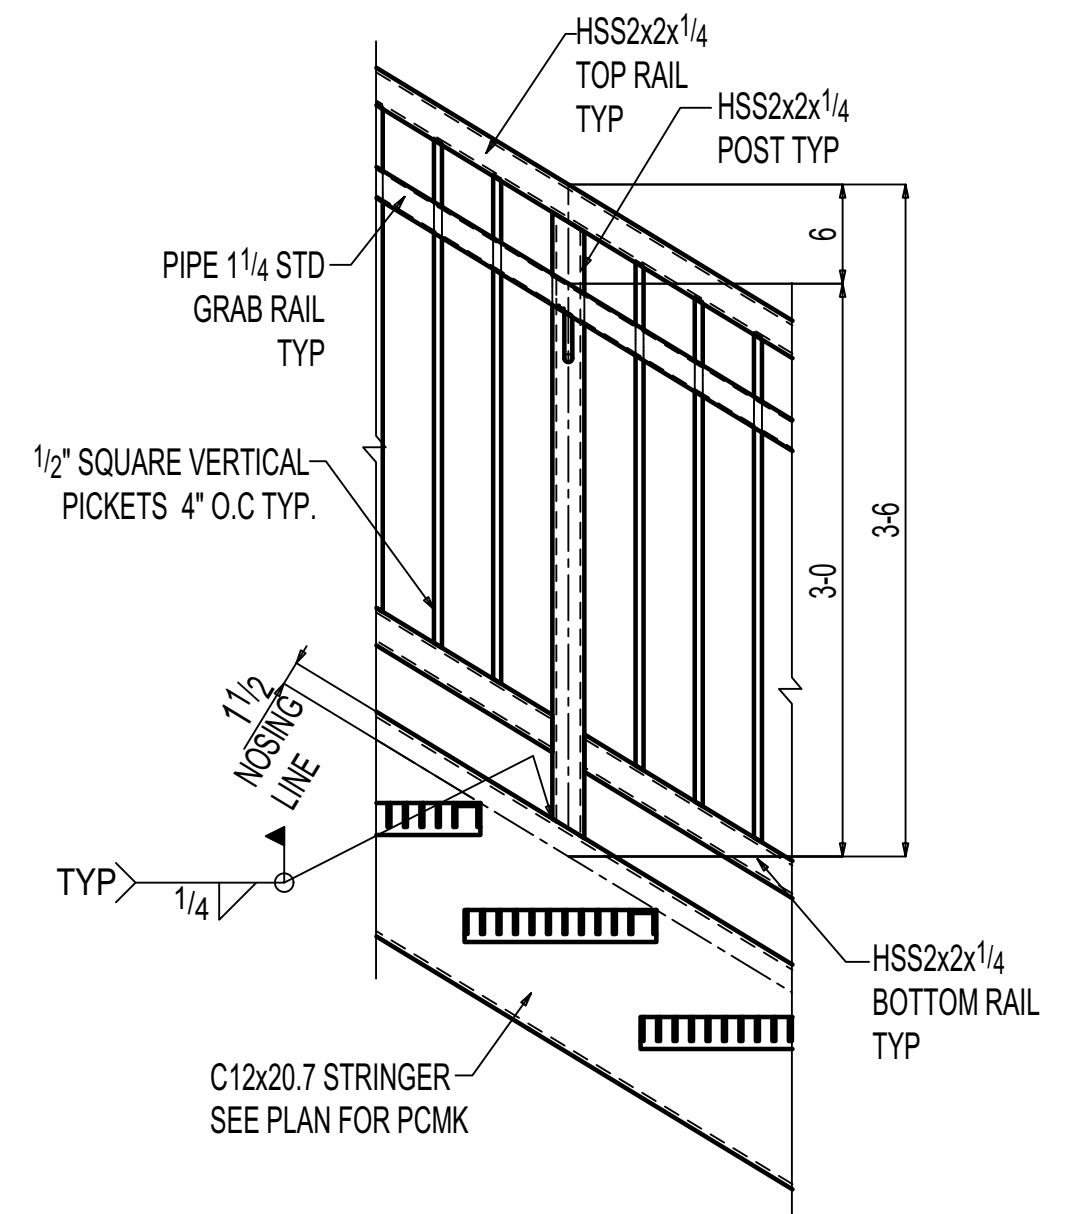


3
E4
TYPICAL HANDRAIL
DETAIL VIEW

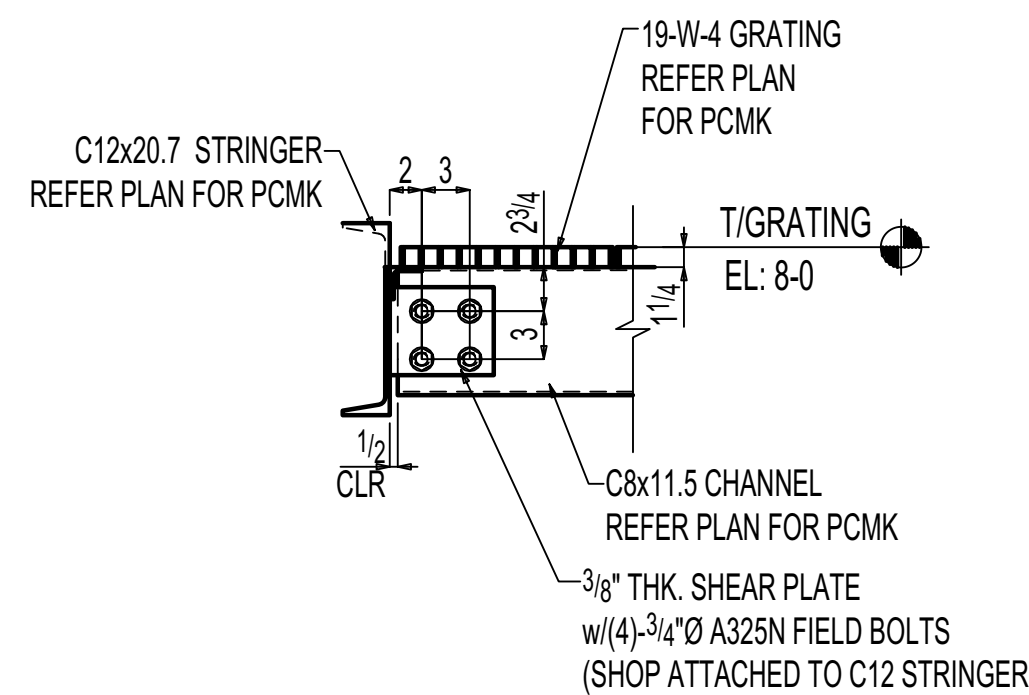


4
E4
TYPICAL CHANNEL TO STRINGER
CONNECTION

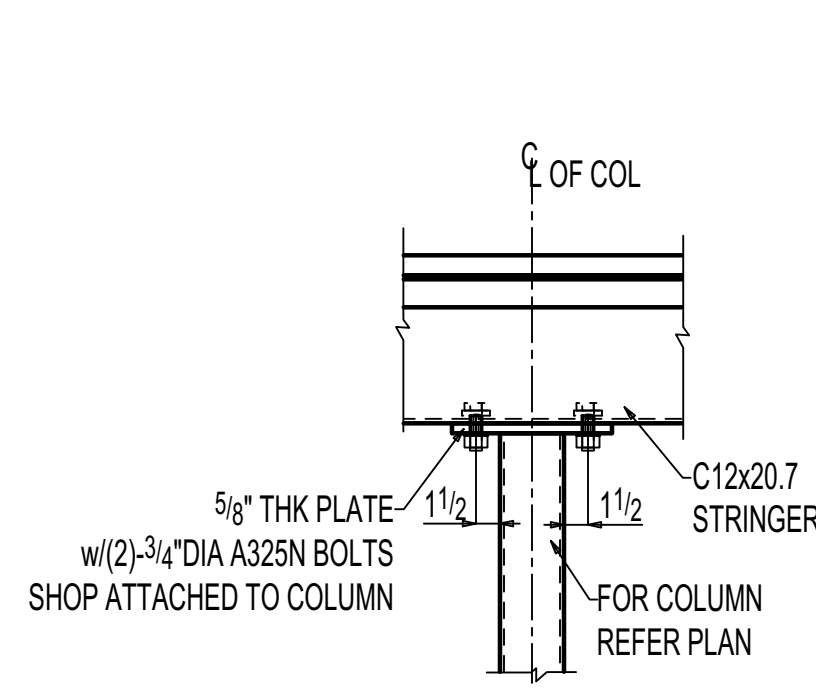


5
E4
SECTION VIEW

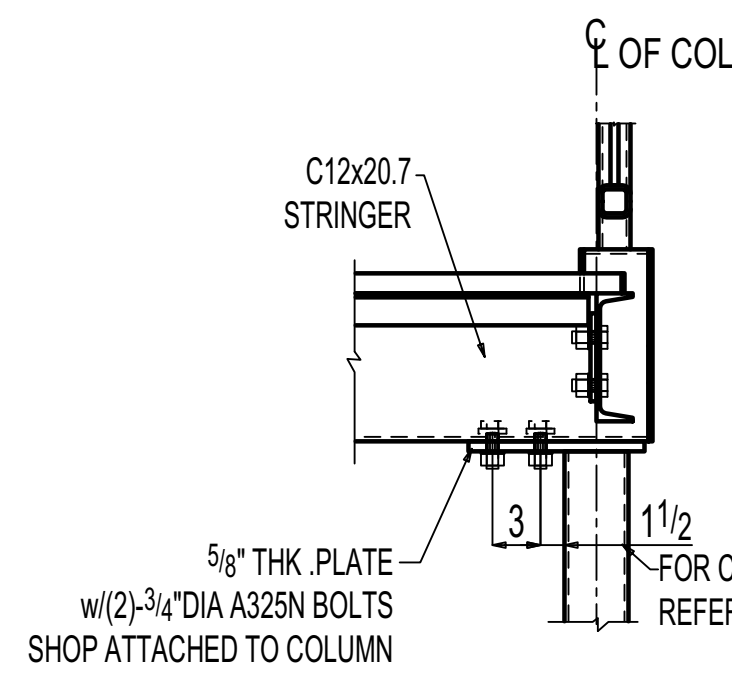


6
E4
SECTION VIEW

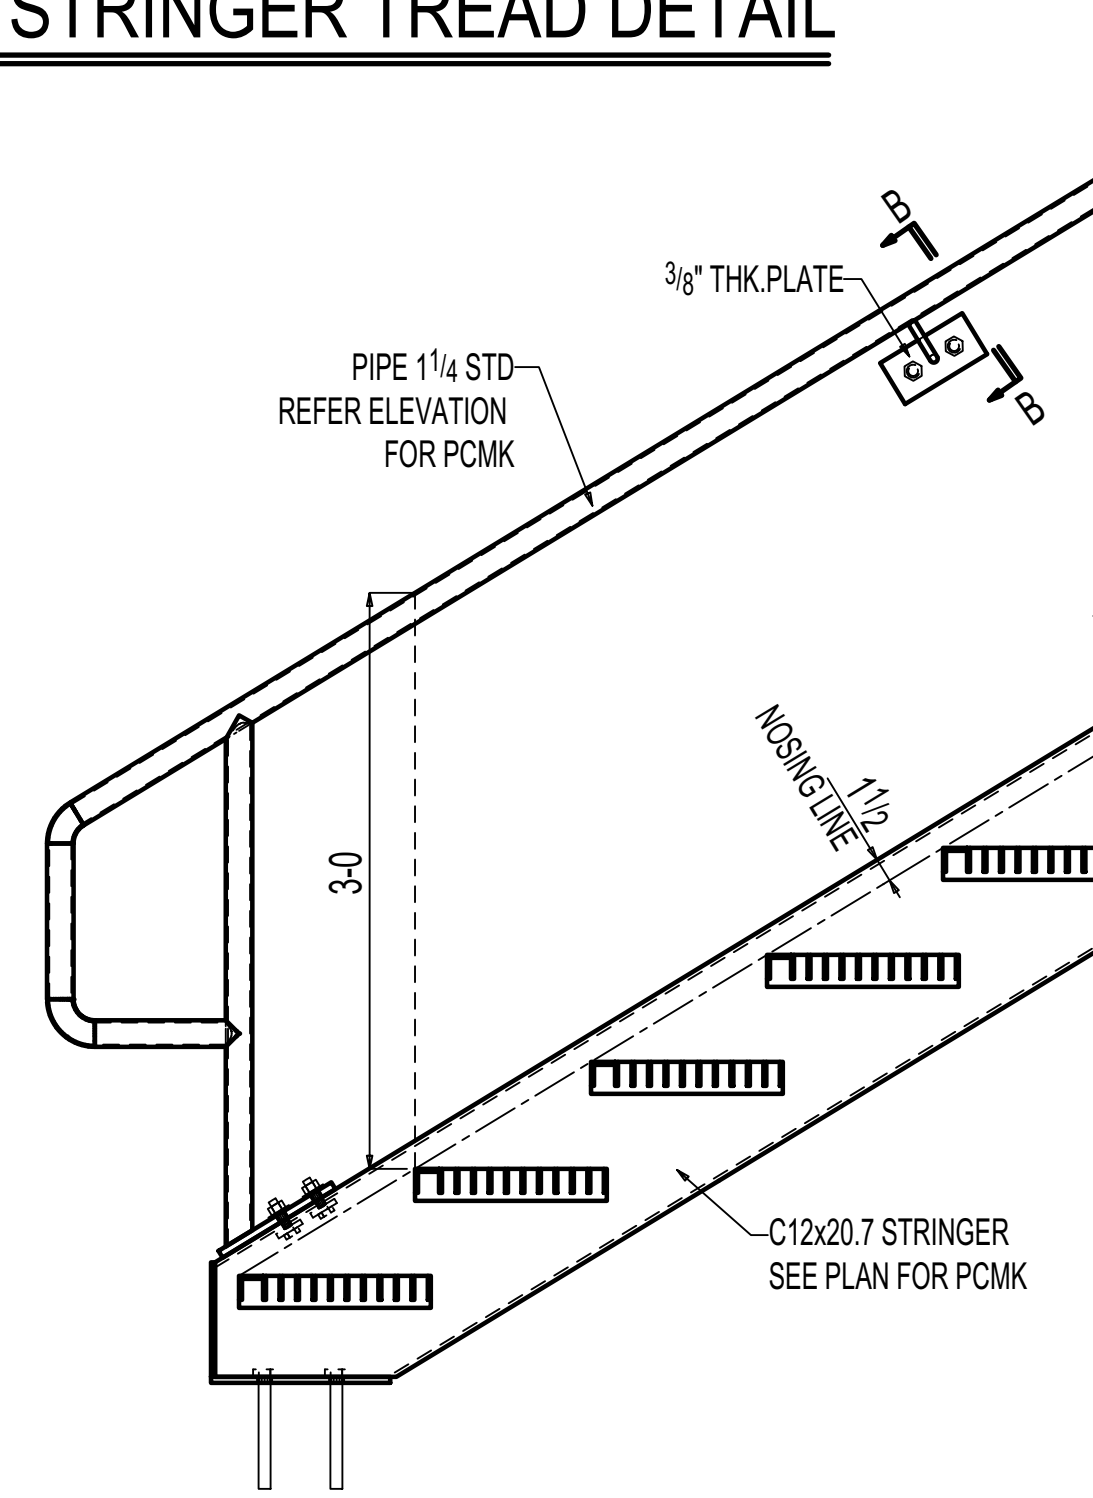

7
E4
TYPICAL WALLRAIL DETAIL

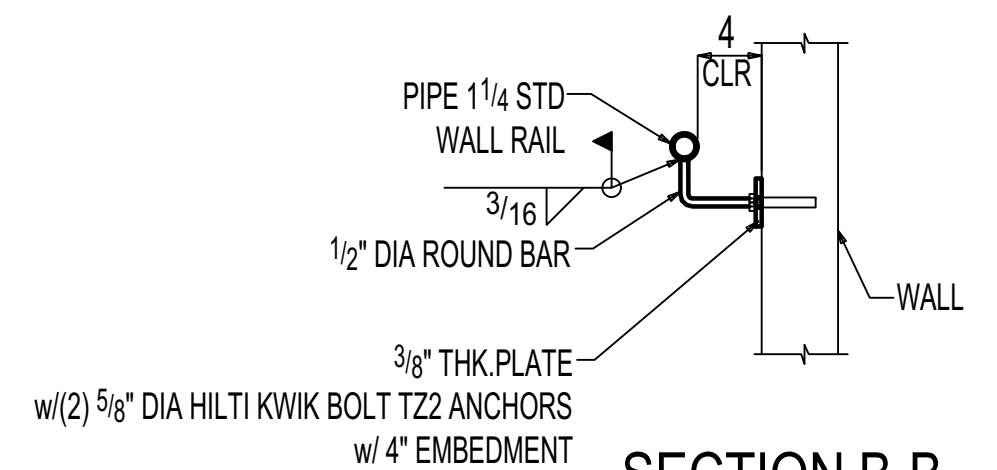


SECTION B-B

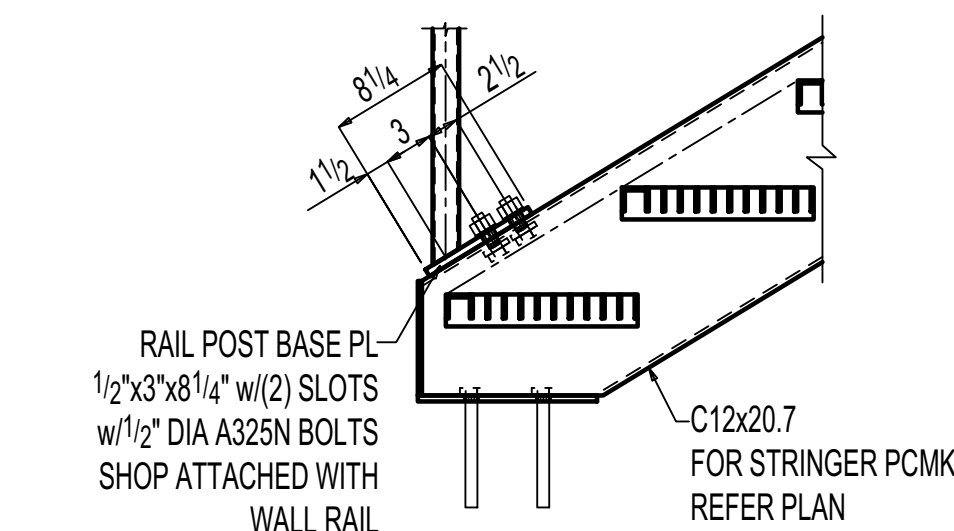

8
E4
SECTION VIEW

City of Portland
Reviewed for
Code Compliance

Date: 01/24/24
Permit #: 22-138282-DFG-01-GG

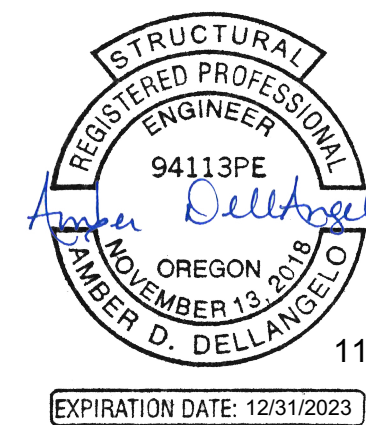

Larson Engineering Inc
1488 Bond Street, Suite 100
Naperville, Illinois 60563-6503
(P) 630.357.0540 (F) 630.357.0164
LEI COMM NO. 21230501.000
SEALED LIMITED TO STAIR ONLY.
LAYOUT, MATERIALS, QUANTITIES
ARE EXCLUDED.



PROJECT: WONDERLOVE STAIRS 1300 SE 2ND AVE PORTLAND, OR 97214			
ITEM: SECTION VIEWS			
CONTRACTOR: ---	DETAILER: SUPERIOR METAL FAB	PROJECT MANAGER: JUSTIN	
DR. BY: MMR	DATE: 07-12-2023	CHK'D BY: KRK	DATE: 07-12-2023
SCALE: NTS	JOB NO.: 220617	DWG. NO.: E4	

1. ALL WELDS FOR STRENGTH ARE TO BE MADE AS SHOWN ON DETAILS.
2. IN ADDITION TO STRENGTH WELDS ALL MATERIAL IS TO BE SEAL WELD.
3. PROVIDE VENT HOLES AS REQUIRED.

[illegible]

City of Portland
AT GRID:
Reviewed for Code Compliance
I & B
Date: 01/24/24
Permit #:
22-130202-DFS-01-CO

OPEN HOLES ARE TO BE 13/16 UNLESS NOTED		WELDING ELECTRODE = E70XX U/N	
FINISH U.N.O	HOT DIPPED GALVANIZED		CLEANING : SSPC-SP6
MATERIAL U.N.O	A36 PL,CH & AN - A500 B HSS - A992 WF-PIPE STD-A53		
	09-08-2023	MMR	ISSUED FOR FABRICATION
	08-30-2023	MMR	ISSUED FOR APPROVAL
REVISION	DATE	BY	DESCRIPTION
			
PROJECT: WONDERLOVE STAIRS 1300 SE 2ND AVE PORTLAND, OR 97214			
ITEM: COLUMN DETAIL			
CONTRACTOR: ----		DETAILER: SUPERIOR METAL FAB	PROJECT MANAGER: JUSTIN
DR. BY: MMR	DATE: 07-12-2023	CHK'D BY: KVR	DATE: 07-12-2023
ERECTION REF.: E1			
SCALE: NTS	JOB NO.: 220617	DWG. NO.: 1C	



1. ALL WELDS FOR STRENGTH ARE TO BE MADE AS SHOWN ON DETAILS.
2. IN ADDITION TO STRENGTH WELDS ALL MATERIAL IS TO BE SEAL WELD.
3. PROVIDE VENT HOLES AS REQUIRED.

[illegible]

City of Portland
AT GRID:
I & B
Reviewed for Code Compliance
Date: 01/24/24
Permit #:
22-130202-DFS-01-CO

OPEN HOLES ARE TO BE 13/16 UNLESS NOTED			WELDING ELECTRODE = E70XX U/N		
FINISH U.N.O	HOT DIPPED GALVANIZED			CLEANING : SSPC-SP6	
MATERIAL U.N.O	A36 PL,CH & AN - A500 B HSS - A992 WF-PIPE STD-A53				
	09-08-2023	MMR	ISSUED FOR FABRICATION		
	08-30-2023	MMR	ISSUED FOR APPROVAL		
REVISION	DATE	BY	DESCRIPTION		
					
PROJECT: WONDERLOVE STAIRS					
1300 SE 2ND AVE PORTLAND, OR 97214					
ITEM: COLUMN DETAIL					
CONTRACTOR: ----		DETAILER: SUPERIOR METAL FAB		PROJECT MANAGER: JUSTIN	
DR. BY: MMR		DATE: 07-12-2023		CHK'D BY: KVR DATE: 07-12-2023	
ERECTION REF.:		E1			
SCALE: NTS		JOB NO.: 220617		DWG. NO.: 2C	
					

- 1.ALL WELDS FOR STRENGTH ARE TO BE MADE AS SHOWN ON DETAILS.
- 2.IN ADDITION TO STRENGTH WELDS ALL MATERIAL IS TO BE SEAL WELD.
- 3.PROVIDE VENT HOLES AS REQUIRED.

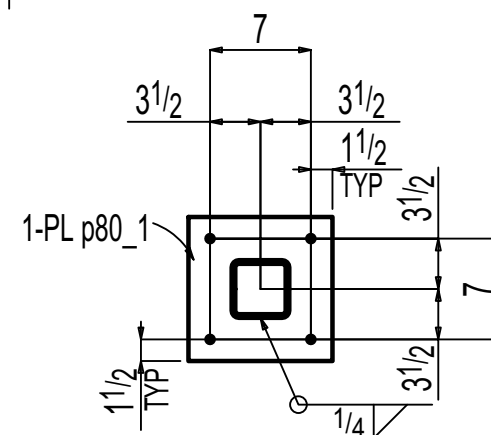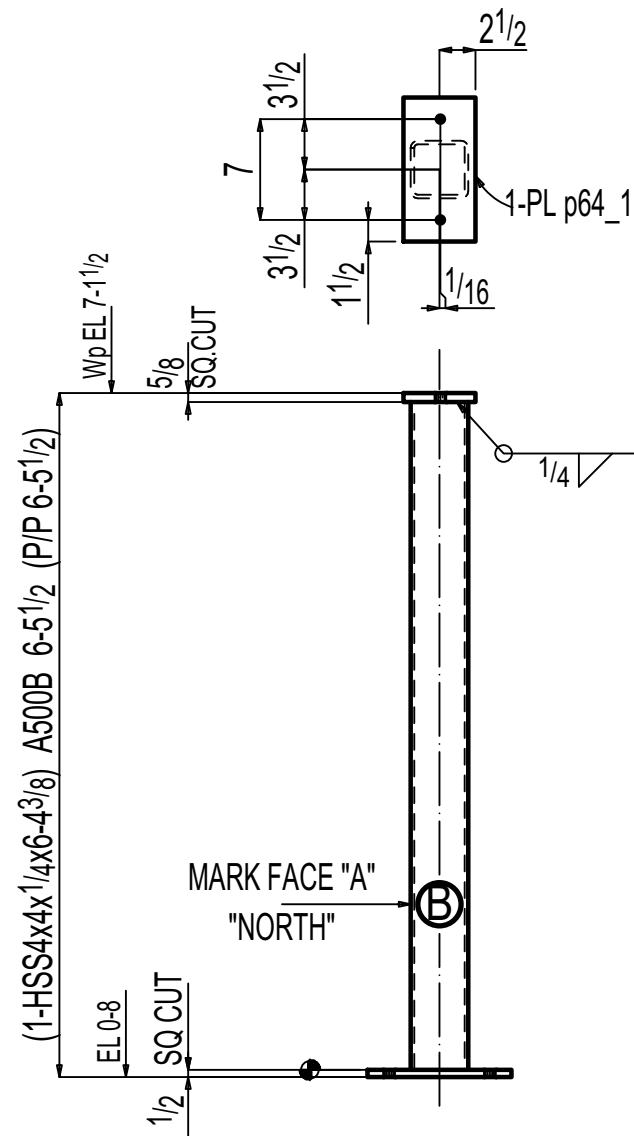[illegible]

ONE COLUMN 3C

1 & B
Reviewed for Code Compliance

Date: 01/24/24

Permit #:
22-130202-DFS-01-CO


OPEN HOLES ARE TO BE 13/16 UNLESS NOTED		WELDING ELECTRODE = E70XX U/N	
FINISH U.N.O	HOT DIPPED GALVANIZED	CLEANING : SSPC-SP6	
MATERIAL U.N.O	A36 PL,CH & AN - A500 B HSS - A992 WF-PIPE STD-A53		
	09-08-2023	MMR	ISSUED FOR FABRICATION
	08-30-2023	MMR	ISSUED FOR APPROVAL
REVISION	DATE	BY	DESCRIPTION
			
PROJECT: WONDERLOVE STAIRS			
1300 SE 2ND AVE PORTLAND, OR 97214			
ITEM: COLUMN DETAIL			
CONTRACTOR: ----		DETAILER: SUPERIOR METAL FAB	PROJECT MANAGER: JUSTIN
DR. BY: MMR	DATE: 07-12-2023	CHK'D BY: KVR DATE: 07-12-2023	ERECTION REF.: E1
SCALE: NTS	JOB NO.: 220617	DWG. NO.: 3C	

- 1.ALL WELDS FOR STRENGTH ARE TO BE MADE AS SHOWN ON DETAILS.
- 2.IN ADDITION TO STRENGTH WELDS ALL MATERIAL IS TO BE SEAL WELD.
- 3.PROVIDE VENT HOLES AS REQUIRED.

[illegible]Permit #:
22-130202-DFS-01-CO


PROJECT:		WONDERLOVE STAIRS	
		1300 SE 2ND AVE PORTLAND, OR 97214	
ITEM:		COLUMN DETAIL	
CONTRACTOR: ----		DETAILER: SUPERIOR METAL FAB	PROJECT MANAGER: JUSTIN
DR. BY: MMR	DATE: 07-12-2023	CHK'D BY: KVR	DATE: 07-12-2023
		ERECTION REF.: E1	
SCALE: NTS	JOB NO.: 220617	DWG. NO.: 4C	
			

BILL OF MATERIAL							
LINE	QTY	PC		LENGTH		WEIGHT	ADVANCE
#	TOTAL	MARK	DESCRIPTION		REMARKS	TOTAL	MILL #
	ONE	5S	STAIR		Galv	1528	
	1	5SL1	C12x20.7	5	3 11/16 A36	110	
	1	5SR1	C12x20.7	5	3 11/16 A36	110	
	1	5SL	C12x20.7	15	5 9/16 A36	326	
	1	5SR	C12x20.7	15	5 9/16 A36	326	
	2	a15 1	L2x2x1/4	2	8 3/4 A36	17	
	2	a23 1	L2x2x1/4	1	10 A36	12	
	4	p96 1	PL 3/8x6	0	6 1/2 A36	17	
	2	p68 1	PL 3/8x3	0	11 3/16 A36	7	
	2	p55 1	PL 1/4x2 3/4	0	2 15/16 A36	1	
	2	p21 1	PL 1/4x2 15/16	1	0 A36	5	
	2	p79 1	PL 1/4x2 15/16	0	7 1/8 A36	3	
	14	q12 1	GT1 1/2x12	3	0 A-1011	595	
			FIELD BOLTS				
	4		3/4 DIA HILTI KWIK	0	7		
			BOLT T22 ANCHORS				
	8		3/4 Dia A325	0	2 1/2 +1BVL1HD WASH		
	2		1/2 Dia A325	0	2 1/4 +1BVL1HD WASH		

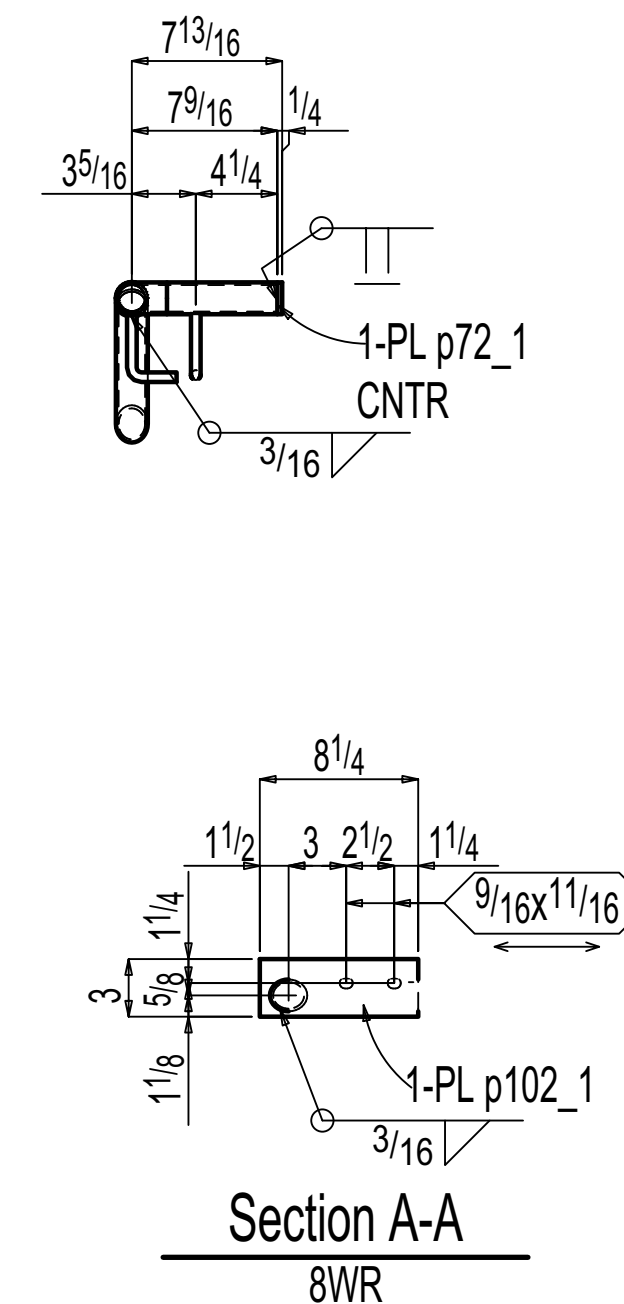

Total weight :59

GALV. NOTES:
1.ALL WELDS FOR STRENGTH ARE TO BE MADE AS SHOWN ON DETAILS.
2.IN ADDITION TO STRENGTH WELDS ALL MATERIAL IS TO BE SEAL WELD.
3.PROVIDE VENT HOLES AS REQUIRED.

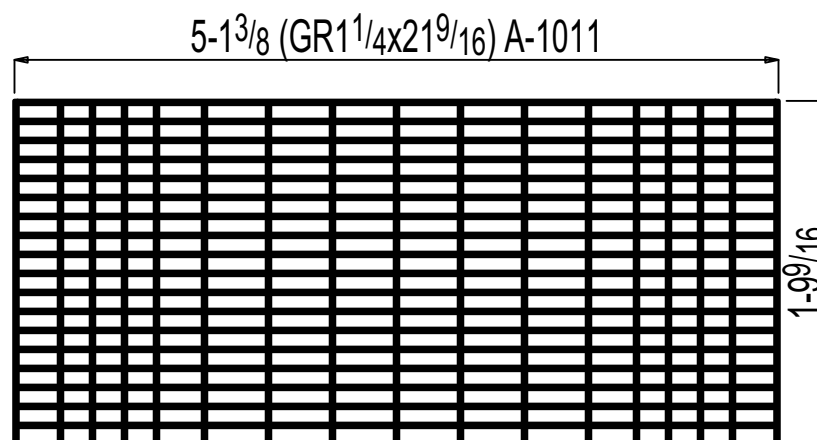

SPAN

ONE GRATING 9GT

GALV. NOTES:

- 1.ALL WELDS FOR STRENGTH ARE TO BE MADE AS SHOWN ON DETAILS.
- 2.IN ADDITION TO STRENGTH WELDS ALL MATERIAL IS TO BE SEAL WELD.
- 3.PROVIDE VENT HOLES AS REQUIRED.

BILL OF MATERIAL

[illegible]


City of Portland

Reviewed for Code Compliance

Date: 01/24/24

Permit #:
22-130202-DFS-01-CO

OPEN HOLES ARE TO BE 13/16 UNLESS NOTED				WELDING ELECTRODE = E70XX U/N					
FINISH U.N.O		HOT DIPPED GALVANIZED				CLEANING : SSPC-SP6			
MATERIAL U.N.O		A36 PL,CH & AN - A500 B HSS - A992 WF-PIPE STD-A53							

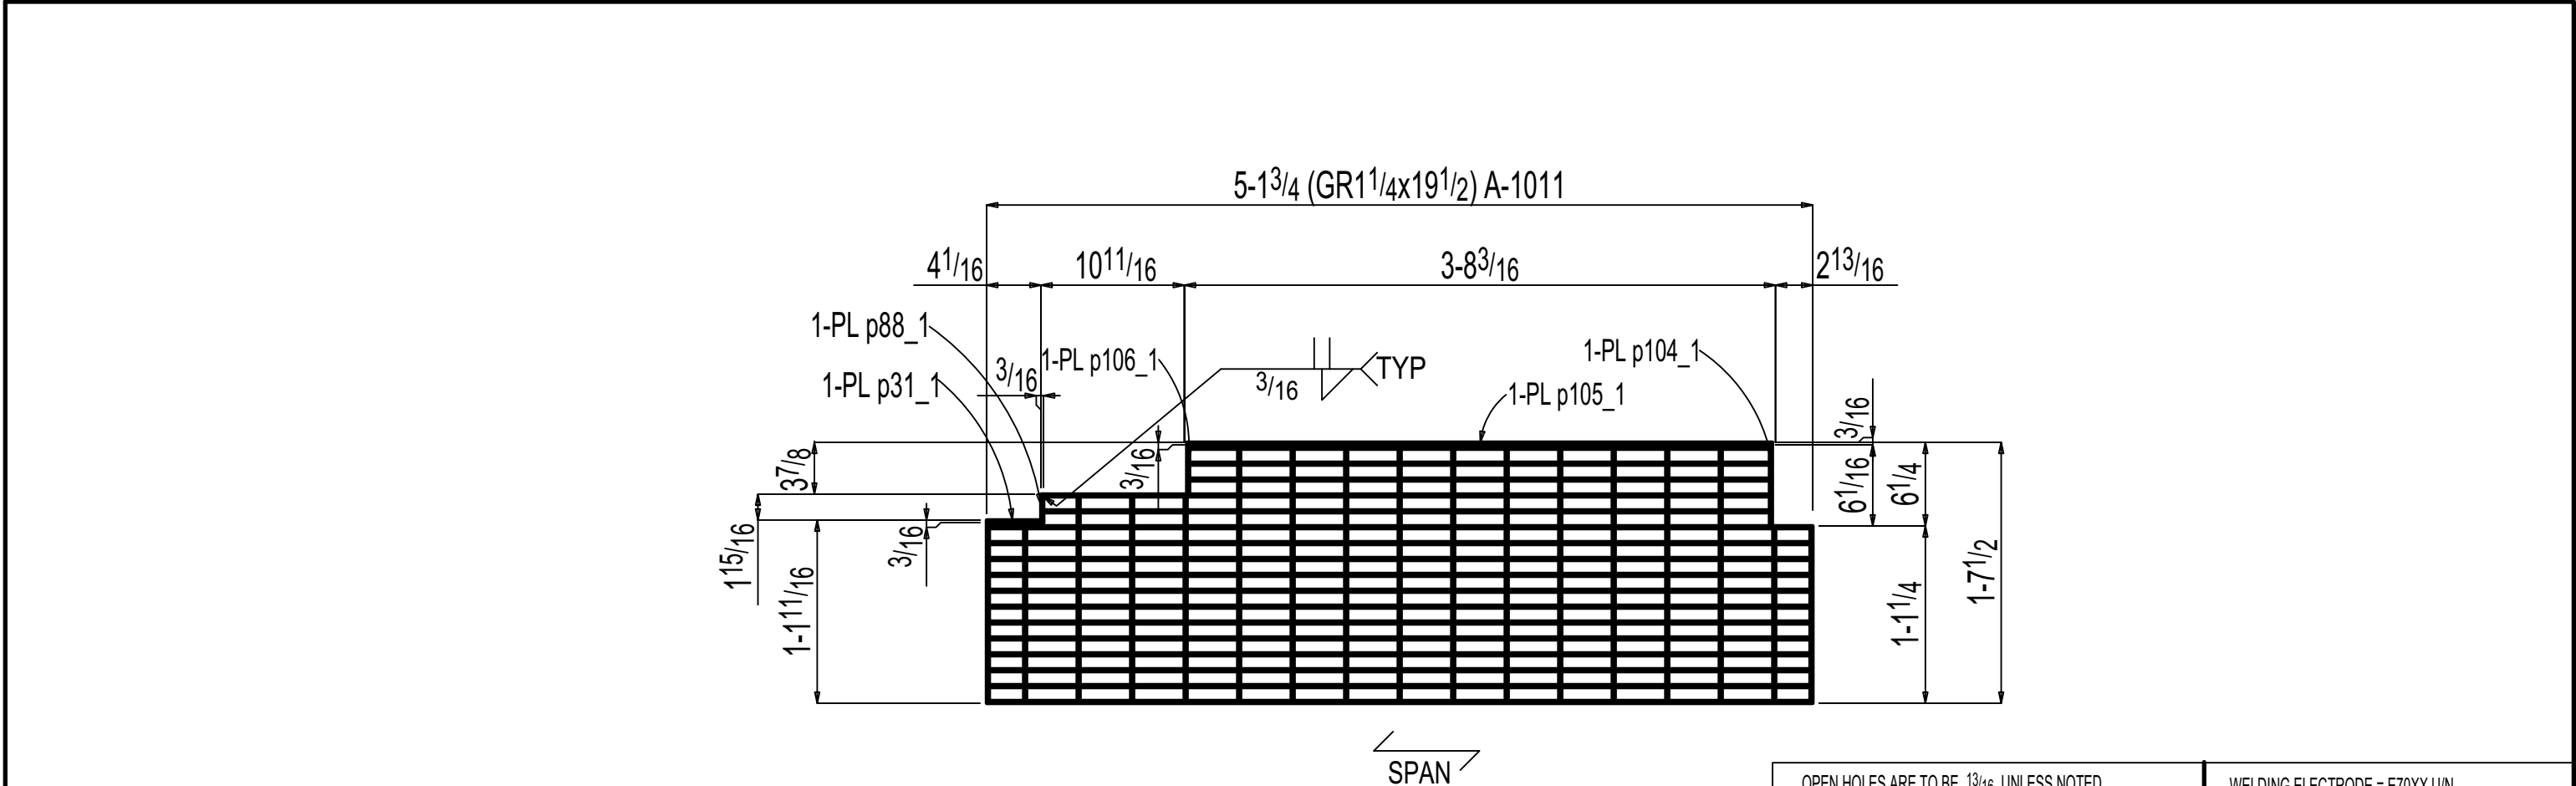

GALV. NOTES:
1.ALL WELDS FOR STRENGTH ARE TO BE MADE AS SHOWN ON DETAILS.
2.IN ADDITION TO STRENGTH WELDS ALL MATERIAL IS TO BE SEAL WELD.
3.PROVIDE VENT HOLES AS REQUIRED.

ONE GRATING 10GT

BILL OF MATERIAL

SEQ	QTY	PC			LENGTH		WEIGHT	ADVANCE
#	TOTAL	MARK	DESCRIPTION			REMARKS	TOTAL	MILL #
1	ONE	10GT	GRATING			GALV	87	
	1	10GT	GR1 1/4 x 19 1/2		5	13/4 A-1011	83	
	1	p104 1	PL 3/16 x 1 1/4		0	6 1/16 A36	0	
	1	p106 1	PL 3/16 x 1 1/4		0	3 11/16 A36	0	
	1	p88 1	PL 3/16 x 1 1/4		0	1 15/16 A36	0	
	1	p105 1	PL 3/16 x 1 1/4		3	7 3/4 A36	3	
	1	p31 1	PL 3/16 x 1 1/4		0	4 1/4 A36	0	

City of Portland

Reviewed for Code Compliance

Date: 01/24/24


Permit #:
22-130202-DFS-01-CO

OPEN HOLES ARE TO BE 13/16 UNLESS NOTED		WELDING ELECTRODE = E70XX U/N	
FINISH U.N.O	HOT DIPPED GALVANIZED	CLEANING : SSPC-SP6	
MATERIAL U.N.O	A36 PL,CH & AN - A500 B HSS - A992 WF-PIPE STD-A53		
	09-08-2023	MMR	ISSUED FOR FABRICATION
	08-30-2023	MMR	ISSUED FOR APPROVAL
REVISION	DATE	BY	DESCRIPTION
			
PROJECT: WONDERLOVE STAIRS 1300 SE 2ND AVE PORTLAND, OR 97214			
ITEM: GRATING DETAIL			
CONTRACTOR: ----		DETAILER: SUPERIOR METAL FAB	PROJECT MANAGER: JUSTIN
DR. BY: MMR	DATE: 07-12-2023	CHK'D BY: KVR	DATE: 07-12-2023
ERECTION REF.: E1			
SCALE: NTS	JOB NO.: 220617	DWG. NO.:	10GT



GALV. NOTES:
1.ALL WELDS FOR STRENGTH ARE TO BE MADE AS SHOWN ON DETAILS.
2.IN ADDITION TO STRENGTH WELDS ALL MATERIAL IS TO BE SEAL WELD.
3.PROVIDE VENT HOLES AS REQUIRED.

[illegible]Permit #:
22-130202-DFS-01-CO

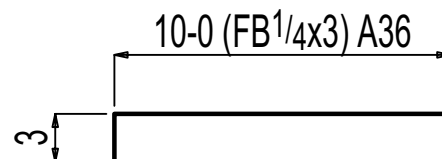

ONE PLATE 12M

GALV. NOTES:
1.ALL WELDS FOR STRENGTH ARE TO BE MADE AS SHOWN ON DETAILS.
2.IN ADDITION TO STRENGTH WELDS ALL MATERIAL IS TO BE SEAL WELD.
3.PROVIDE VENT HOLES AS REQUIRED.

- 1.ALL WELDS FOR STRENGTH ARE TO BE MADE AS SHOWN ON DETAILS.
- 2.IN ADDITION TO STRENGTH WELDS ALL MATERIAL IS TO BE SEAL WELD.
- 3.PROVIDE VENT HOLES AS REQUIRED.

BILL OF MATERIAL

[illegible]

City of Portland

Reviewed for Code Compliance

Date: 01/24/24

Permit #:
22-130202-DFS-01-CO

OPEN HOLES ARE TO BE $\frac{13}{16}$ UNLESS NOTED		WELDING ELECTRODE = E70XX U/N	
FINISH U.N.O	HOT DIPPED GALVANIZED		CLEANING : SSPC-SP6
MATERIAL U.N.O	A36 PL,CH & AN - A500 B HSS - A992 WF-PIPE STD-A53		
	09-08-2023	MMR	ISSUED FOR FABRICATION
	08-30-2023	MMR	ISSUED FOR APPROVAL
REVISION	DATE	BY	DESCRIPTION
			
PROJECT: WONDERLOVE STAIRS			
1300 SE 2ND AVE PORTLAND, OR 97214			
ITEM: FLATBAR DETAIL			
CONTRACTOR: ----		DETAILER: SUPERIOR METAL FAB	PROJECT MANAGER: JUSTIN
DR. BY: MMR	DATE: 08-28-2023	CHK'D BY: KVR DATE: 08-28-2023	ERECTION REF.: E1
SCALE: NTS	JOB NO.: 220617	DWG. NO.: 12M	
			



1. ALL WELDS FOR STRENGTH ARE TO BE MADE AS SHOWN ON DETAILS.
2. IN ADDITION TO STRENGTH WELDS ALL MATERIAL IS TO BE SEAL WELD.
3. PROVIDE VENT HOLES AS REQUIRED.

[illegible]Permit #:
22-130202-DFS-01-CO



1. ALL WELDS FOR STRENGTH ARE TO BE MADE AS SHOWN ON DETAILS.
2. IN ADDITION TO STRENGTH WELDS ALL MATERIAL IS TO BE SEAL WELD.
3. PROVIDE VENT HOLES AS REQUIRED.

BILL OF MATERIAL

[illegible]Permit #:
22-130202-DFS-01-CO

NEW SHEET

OPEN HOLES ARE TO BE 13/16 UNLESS NOTED				WELDING ELECTRODE = E70XX U/N			
FINISH U.N.O		HOT DIPPED GALVANIZED				CLEANING : SSPC-SP6	
MATERIAL U.N.O		A36 PL,CH & AN - A500 B HSS - A992 WF-PIPE STD-A53					
		09-07-2023		MMR		ISSUED FOR FABRICATION	
REVISION		DATE		BY		DESCRIPTION	
							
PROJECT: WONDERLOVE STAIRS 1300 SE 2ND AVE PORTLAND, OR 97214							
ITEM: THREADED ROD DETAIL							
CONTRACTOR: ----				DETAILER: SUPERIOR METAL FAB		PROJECT MANAGER: JUSTIN	
DR. BY: MMR		DATE: 08-28-2023		CHK'D BY: KVR		DATE: 08-28-2023	
ERECTON REF.: E1							
SCALE: NTS		JOB NO.: 220617		DWG. NO.:		15M	
							

(E) 4'-0"x4'-0"x1'-6"
FOOTING

1'-0"

1

SK
22

SK
21

SK
20

10"

COORDINATE FOOTING
AND PIER LOCATIONS W/
STAIR SHOP DRAWINGS
TYP.

16" WIDE x 18" DEEP FTG
W/ (2) #4 LONG DIR. AND
#4 @ 12" O.C SHORT DIR.
W/ 8" CLR BOTTOM

2

FACE OF STAIR
STRINGER



EXPIRES: 06-30-2025

DETAIL: Stair Foundation Plan at East Side of Trash Enclosure
SCALE: 3/8"=1'-0"

Job Name: Wonderlove

Job No.: 22011

Client: SEA

City of Portland

Reviewed for Code Compliance

Date: 01/31/24

Permit #:

22-130202-DFS-01-CO

Date: 08/03/23

Drawn: JG


Sheet:



GIPE STRUCTURAL ENGINEERING


ph:503.460.5584 jim.gipe.engineering@gmail.com

SK-19

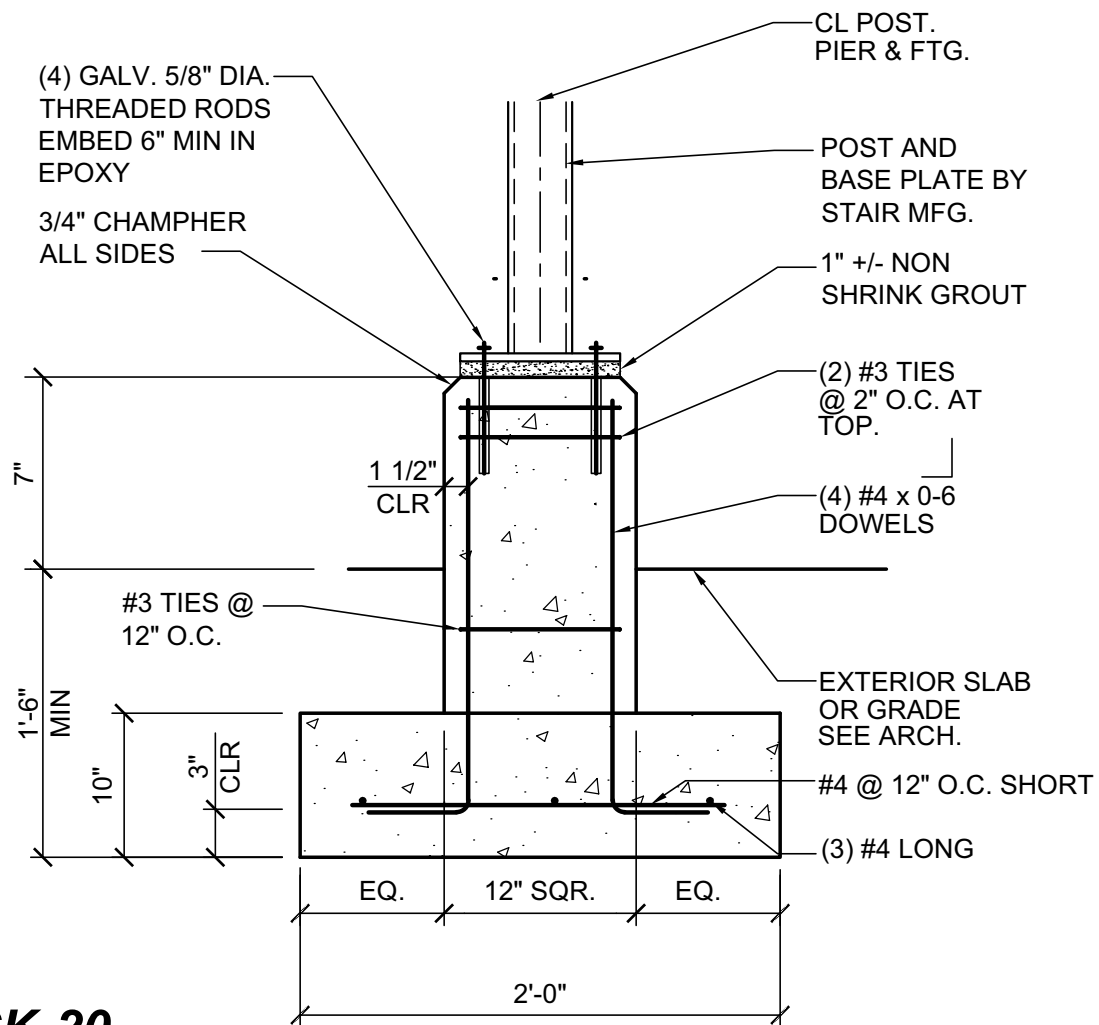

SK-20

SCALE: 1" = 1'-0"

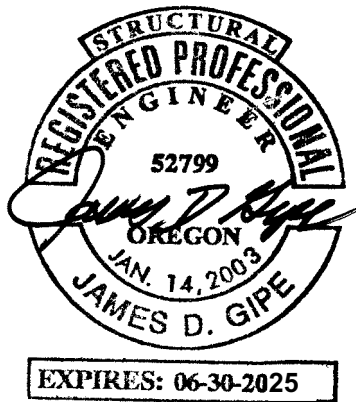

DETAIL: Stair Footing
SCALE: 1"=1'-0"

Job Name: Wonderlove
Job No.: 22011
Client: SEA

City of Portland

Reviewed for Code Compliance

Date: 08/03/23

Drawn: JG

Sheet:

SK-20




GIPE STRUCTURAL ENGINEERING

ph:541.460.5584 jim.gipe.engineering@gmail.com

Date: 01/31/24

Permit #: 22-130202-DFS-01-CO

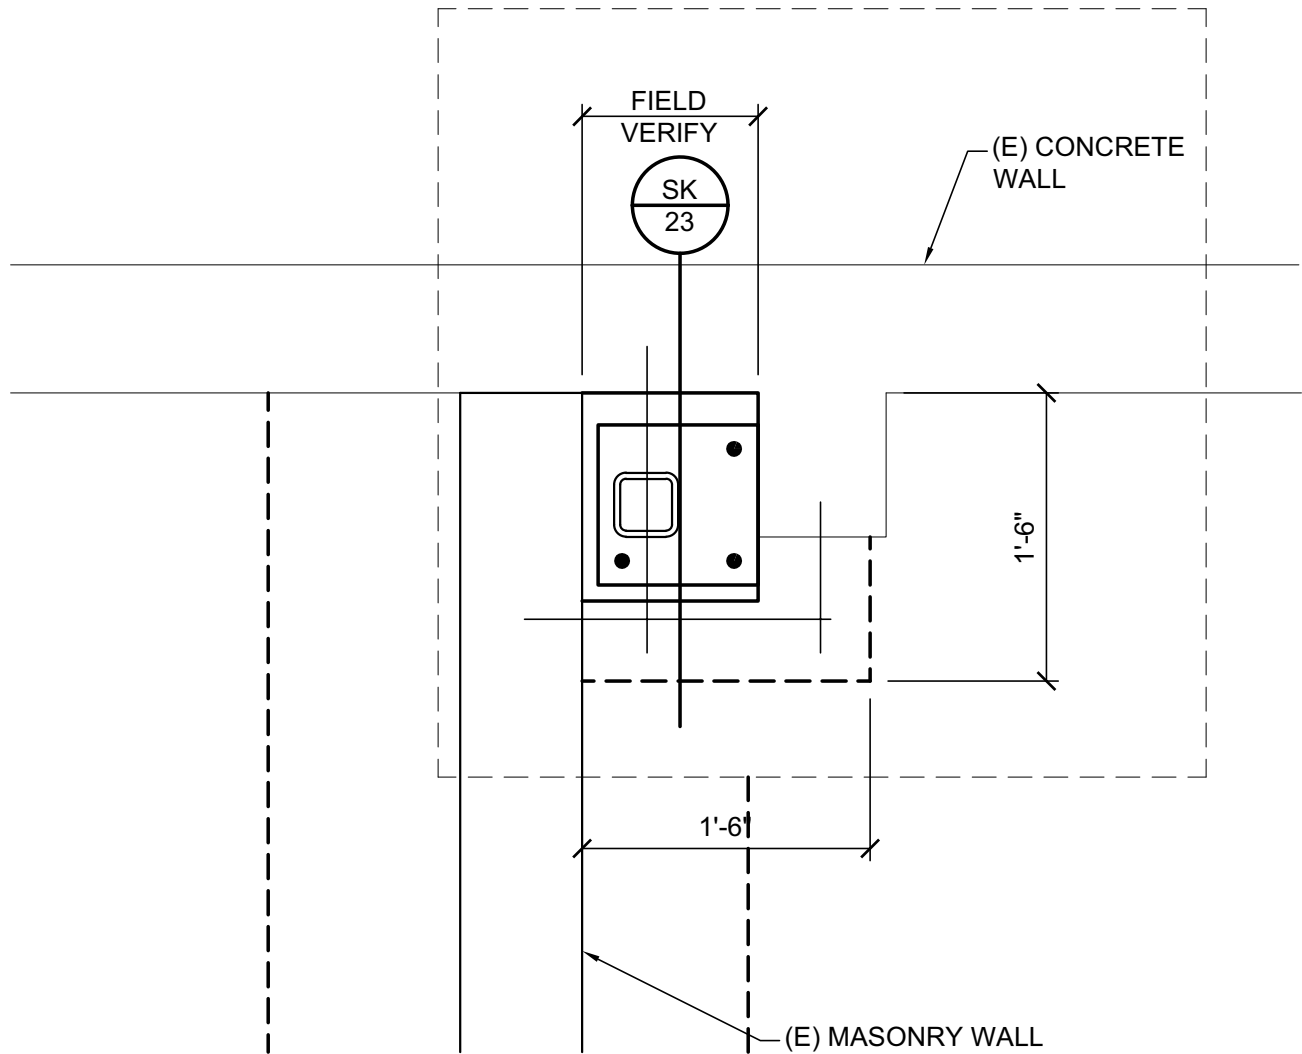

SK-22

PLAN VIEW

SCALE: 1" = 1'-0"



EXPIRES: 06-30-2025

DETAIL: Stair Footing
SCALE: 1"=1'-0"

Job Name: Wonderlove
Job No.: 22011
Client: SEA

City of Portland

Reviewed for Code Compliance

Date: 08/03/23

Drawn: JG

Sheet:

SK-22




GIPE STRUCTURAL ENGINEERING

ph:541.460.5584 jim.gipe.engineering@gmail.com

Date: 01/31/24

Permit #: 22-130202-DFS-01-CO

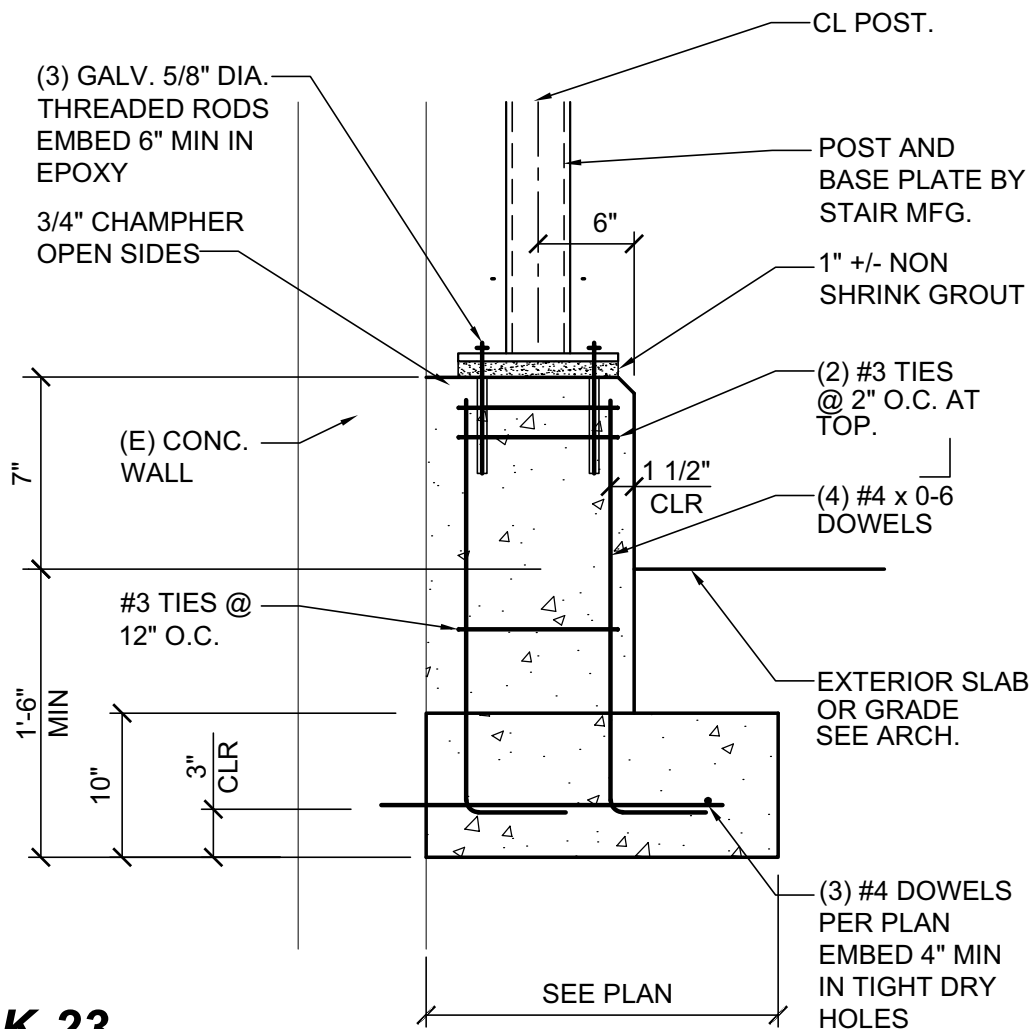

SK-23

SCALE: 1" = 1'-0"



DETAIL: Stair Footing
SCALE: 1"=1'-0"

Job Name: Wonderlove
Job No.: 22011
Client: SEA

City of Portland

Reviewed for Code Compliance

Date: 08/03/23

Drawn: JG

Sheet:

SK-23

GIPE STRUCTURAL ENGINEERING

ph: 541.460.5584 jim.gipe.engineering@gmail.com

Date: 01/31/24

Permit #: 22-130202-DFS-01-CO