



Details

<input checked="" type="checkbox"/> APPROVED	<input type="checkbox"/> REVISE & RESUBMIT				
<input type="checkbox"/> REVISE AS NOTED	<input type="checkbox"/> REJECTED				
<p>This shop drawing review is for general conformance with the design concept and information given in the Construction Documents only. Corrections or comments made on the shop drawings during this review do not relieve the contractor from compliance with the requirements of the plans and specifications. The Contractor is responsible for dimensions to be correlated at the job site and information that pertains solely to the fabrication processes or to the means, methods, techniques, sequences and procedures of construction.</p>					
<p align="center">ABHT Structural Engineers</p> <table><tr><td><u>ANDREW KELLEY</u></td><td><u>02/14/2023</u></td></tr><tr><td>Reviewed By</td><td>Date</td></tr></table>		<u>ANDREW KELLEY</u>	<u>02/14/2023</u>	Reviewed By	Date
<u>ANDREW KELLEY</u>	<u>02/14/2023</u>				
Reviewed By	Date				

STRUCTURAL APPROVAL IS CONTIGENT ON APPROVAL FROM LARRY LANG FOR LOADS APPLIED TO ROOF FRAMING MEMBERS. THESE LOADS ARE DEAD LOADS AND VERTICAL SEISMIC LOADS APPLIED TO THE JOISTS BY THE HANGING RODS. HORIZONTAL SEISMIC FORCES, BOTH PARALLEL AND PERPENDICULAR TO THE SHEATHED WALL, ARE APPLIED TO THE WALL AND NOT THE JOISTS ABOVE.


PRODUCT SUBMITTAL	
<input checked="" type="checkbox"/> NO EXCEPTION TAKEN	<input type="checkbox"/> REJECTED
<input type="checkbox"/> MAKE CORRECTIONS NOTED	<input type="checkbox"/> FOR INFORMATION ONLY
<input type="checkbox"/> REVISE AND RESUBMIT	<input type="checkbox"/> SUBMIT SPECIFIED ITEM
<p>THIS REVIEW IS FOR GENERAL CONFORMANCE WITH DESIGN CONCEPT ONLY. ANY DEVIATION FROM PLANS OR SPECIFICATIONS NOT CLEARLY NOTED BY THE CONTRACTOR HAS NOT BEEN REVIEWED. REVIEW SHALL NOT CONSTITUTE A COMPLETE CHECK OF ALL DETAILED DIMENSIONS OR COUNT OR SERVE TO RELIEVE THE CONTRACTOR OF CONTRACTUAL RESPONSIBILITY FOR ANY ERROR OR DEVIATION FROM CONTRACT REQUIREMENTS.</p>	
<p>Digitally signed by Michael Miller DN: C=US, E=michael.miller@carletonhart.com, O=Carleton Hart Architecture, CN=Michael Miller</p> <p>BY  DATE </p> <p>Location: Portland, OR, 97204 Contact Info: 503.206.3196 Date: 2024.02.26 11:51:07-08'00'</p> <p>CARLETON HART ARCHITECTURE, PC 830 SW 10th Ave #200, Portland, OR 97205 503.243.2252</p>	

*Reviewed by Lang Joist, Inc. for
vertical loads to the Joists only.
02/14/2024*

Larry W. Lang

City of Portland
Reviewed for code compliance


Date: 03/18/24
Project #: 22-148551-DFS-01-CO

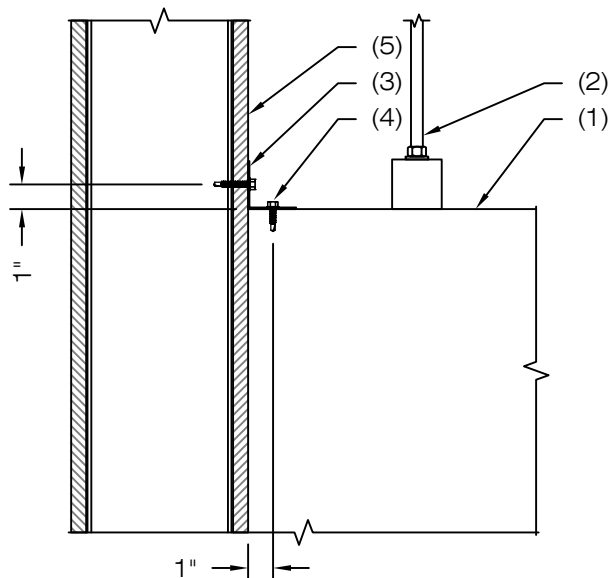

SECTION A-A

SCALE: 1-1/2" = 1'-0"

A
A

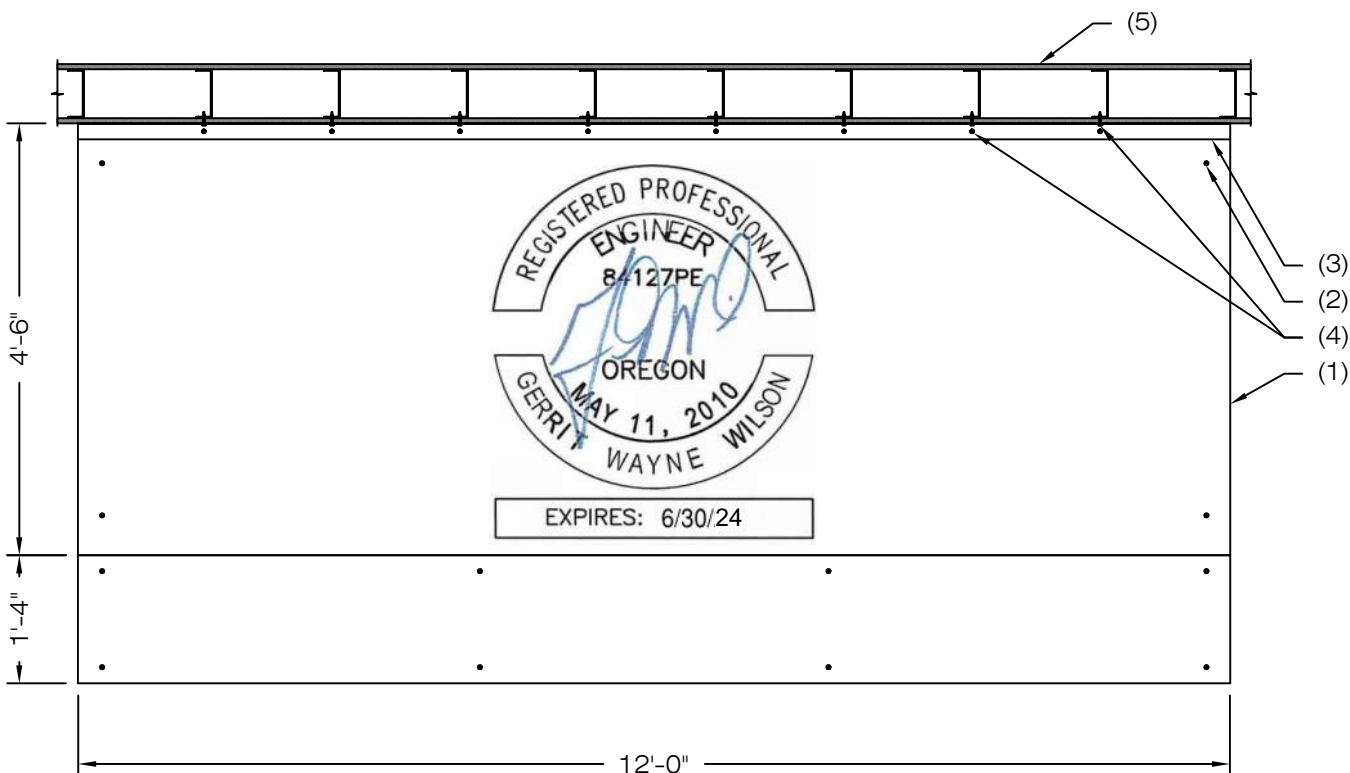

1

HOOD #1 ANCHORAGE PLAN

SCALE: 1/2" = 1'-0"



14325 NE AIRPORT WAY, STE. 101
503-252-4423 (Toll Free) 503-252-4427 (fax)
www.isatsb.com

PROJECT
ARBOR LODGE SHELTER

CONTRACTOR
CURTIS RESTAURANT EQUIPMENT

DETAIL NUMBER

SK1

DATE

12/5/23

DRAWN BY

DS



City of Portland

Reviewed for code compliance

Date: 03/18/24

TASK NUMBER
241485

Project #: 22-148551-DFS-01-CO

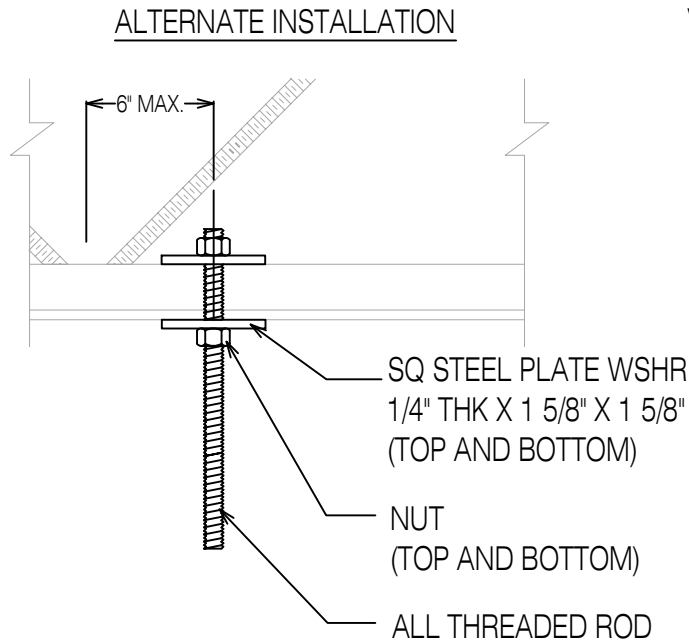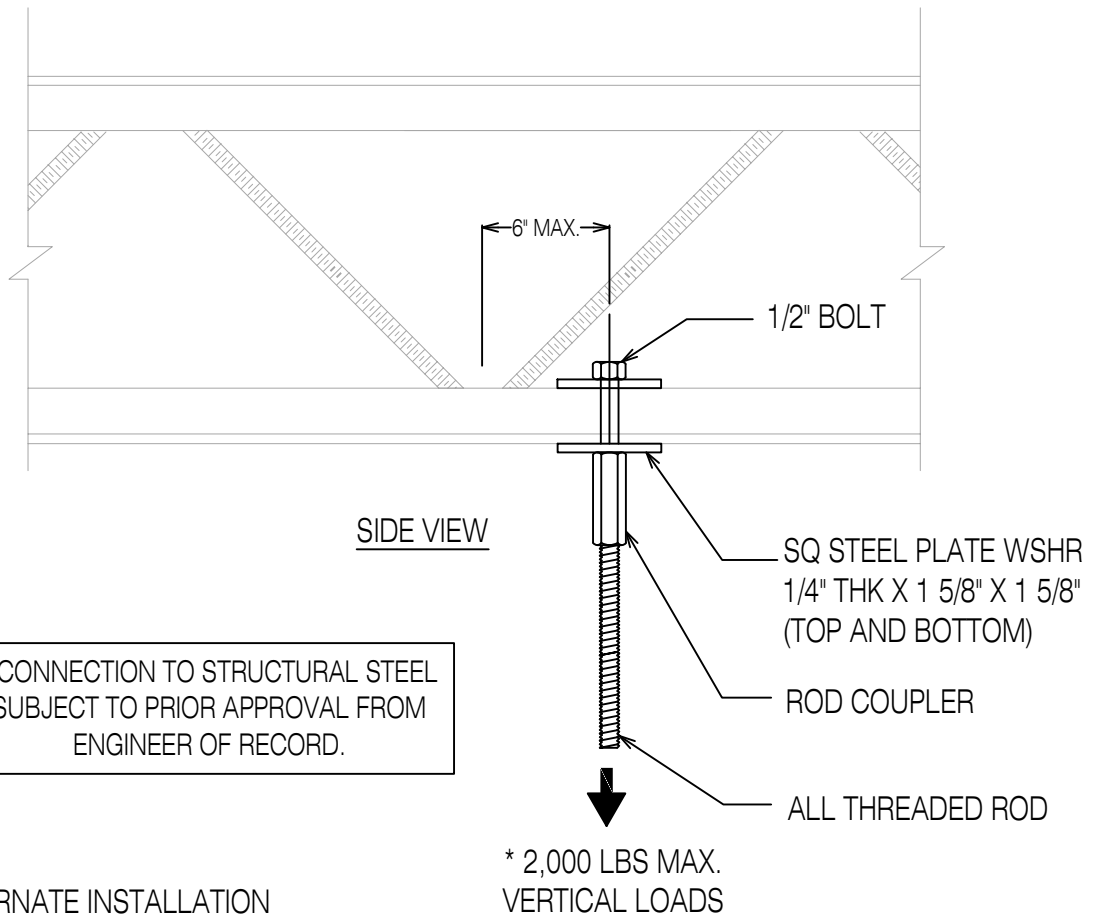

IN-LINE VERTICAL SUPPORT CONNECTION BOTTOM OF CHORDS OF OPEN WEB STEEL JOIST



**International Seismic
Application Technology**
14848 Northam Street,
La Mirada, CA 90638
877-999-4728 (Toll Free)
714-523-0845 (fax)
www.isatsb.com

**CODES
APPLIES TO ALL
CODES**


DATE:
04/12/23

PAGE:

City of Portland
Reviewed for code compliance

Date: 03/18/24

Project #: 22-148551-DFS-01-CO

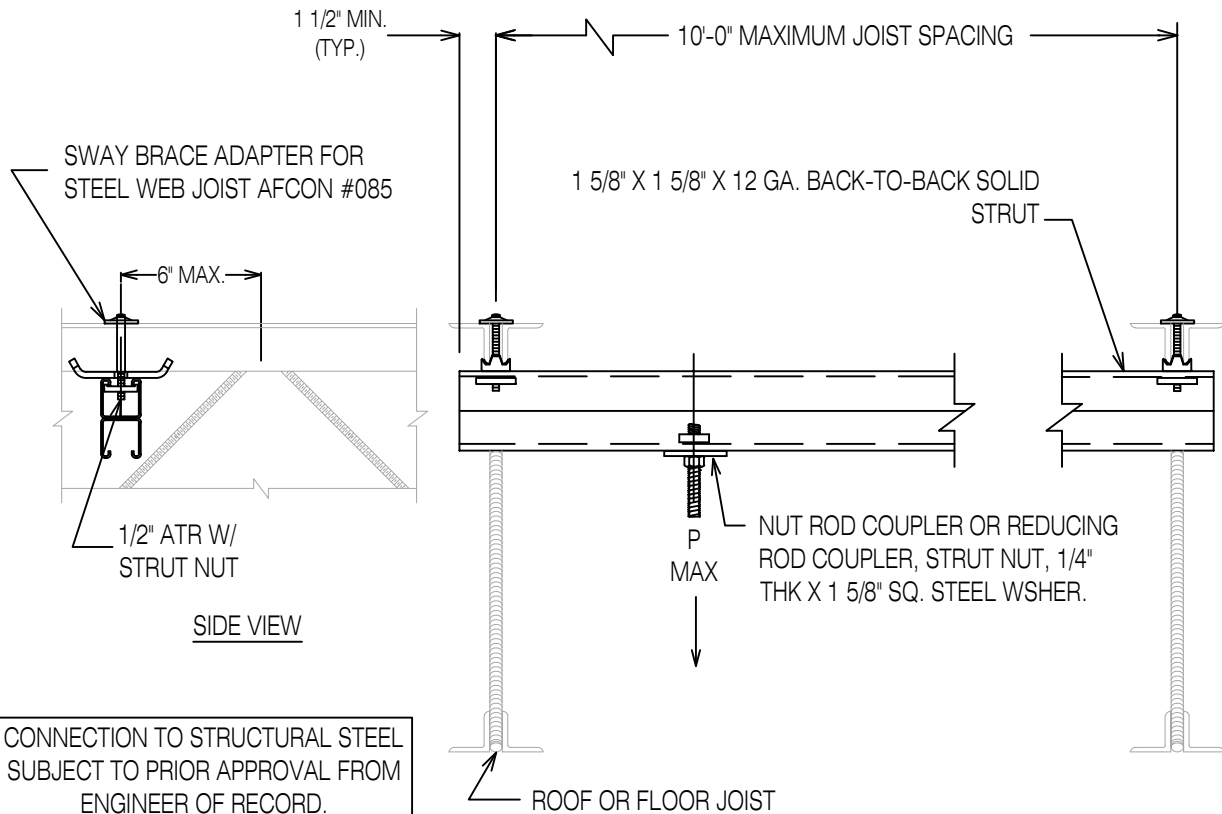

MAXIMUM VERTICAL SUPPORT LOAD		
JOIST SPACING	MAX. TOTAL VERTICAL LOAD	
	SOLID STRUT	SLOTTED STRUT
6' - 0"	700 LBS	600 LBS
8' - 0"	500 LBS	400 LBS
10' - 0"	350 LBS	300 LBS

SWAY BRACE ADAPTER FOR STEEL WEB JOIST AFCON #085

1/2" ATR W/ STRUT NUT

BOTTOM CHORD CONNECTION DETAILS
LOCATE CENTER WITHIN 6" OF JOIST PANEL POINT

STRUT CONNECTION TO STEEL BAR JOIST VERTICAL SUPPORT CONNECTION



**International Seismic
Application Technology**
14848 Northam Street,
La Mirada, CA 90638
877-999-4728 (Toll Free)
714-523-0845 (fax)
www.isatsb.com

**CODES
APPLIES TO ALL
CODES**

DATE:
10/06/20

PAGE:

City of Portland
Reviewed for code compliance

Date: 03/18/24

Project #: 22-148551-DFS-01-CO