


☒ REVIEWED    ☐ REVISE AND RESUBMIT  
☐ REJECTED    ☐ FURNISH AS CORRECTED

Corrections or comments made on the shop drawings during this review do not relieve contractor from compliance with requirements of the drawings and specifications. This check is only for review of general conformance with the design concept of the project and general compliance with the information given in the contract documents. This contractor is responsible for confirming and correlating all quantities and dimensions; selecting fabrication processes and techniques of construction; coordinating his work with that of all other trades; and performing his work in a safe and satisfactory manner.

FROELICH ENGINEERS, INC.  
DATE: 11/09/2023    BY: BJH

Project Name  
Garden Park Estates - 219324



☐ No Exception Taken

☐ Make Corrections Noted

☐ Revise & Resubmit

☐ Record Only


BY: Brudson

DATE: 11/10/2023

SUBMITTAL#

06 1733-2.0

This submittal has been reviewed only for conformance with the design concept and for compliance with information given in the Contract Documents, and does not extend to means, methods, techniques, sequence of construction, dimensions, or safety precautions thereof. Review does not relieve the Contractor from responsibility for deviations from Drawings or Specifications unless the LRS Architect's attention has been called to such deviations in writing at the time of submission. Corrections have been made on submittal material by LRS Architect's in accordance with Article 4.2.7 of the General Conditions of the Contract for Construction, with additional comments above.

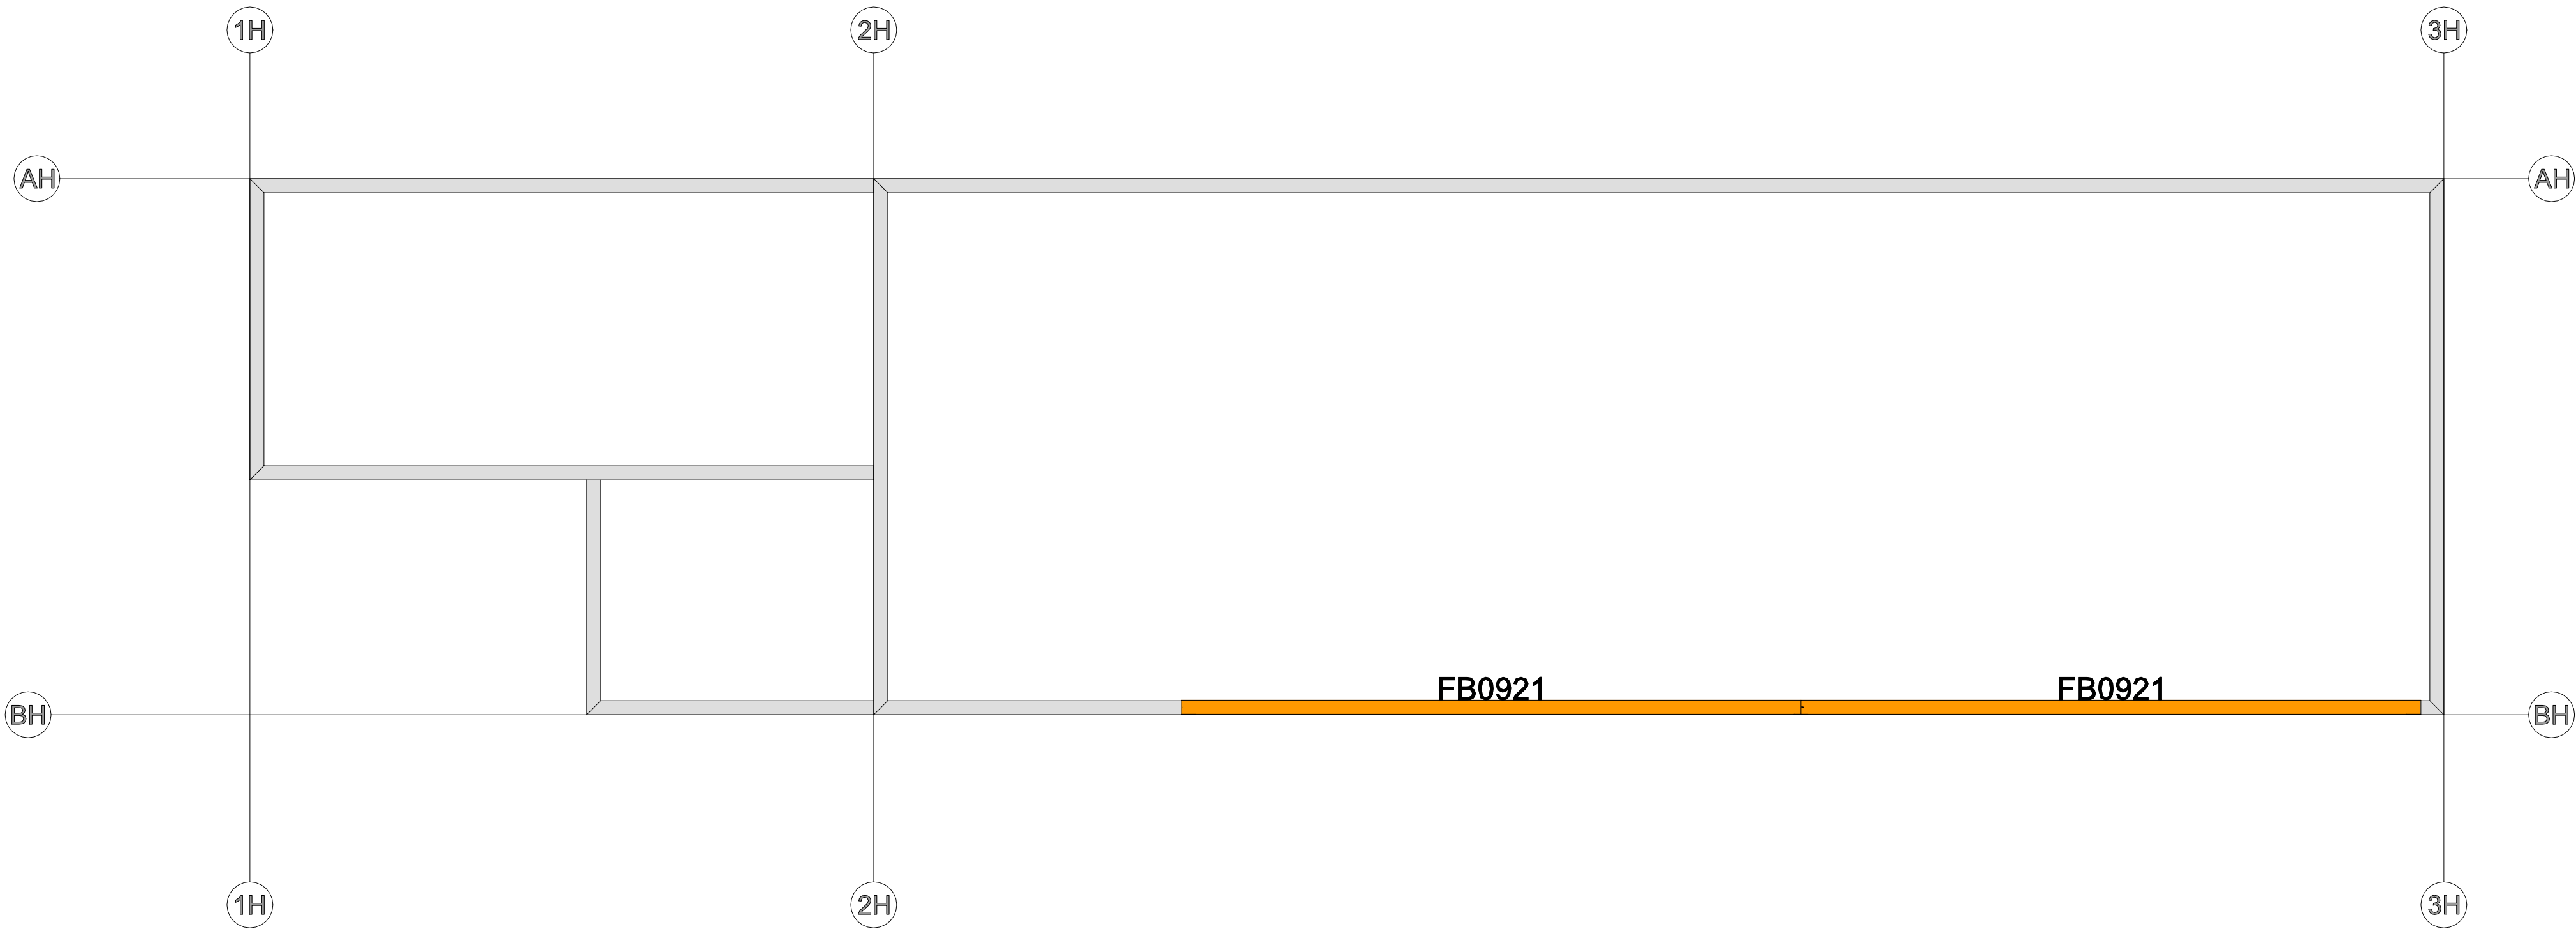

REVISION					FE REVISION	10/25/23
Mark	Product	City Of Portland	Length	LF		
FB0921	5-1/2" X 13-1/4" ARCH 24F-V4 GLB C-STD		2	21		
REVIEWED FOR CODE COMPLIANCE						
Date: 03/08/24						
Pemit #: 22-181351-DFS-01-CO						



PLEASE NOTE:  
BOISE CASCADE IS PROVIDING THESE PRODUCT PLACING DRAWINGS AS A SUPPLEMENT TO THE SET OF STRUCTURAL PLANS PROVIDED BY THE ARCHITECT/ENGINEER OF RECORD ON THIS PROJECT. THESE PRODUCT PLACING PLANS DO NOT REPLACE, SUBSTITUTE OR SUPERCEDE THE ARCHITECT/ENGINEERS DRAWINGS. FOR COMPLETE INFORMATION AND DETAILS CONCERNING THE PROJECT REFER TO THE ARCHITECT/ENGINEERS DRAWINGS.

GARDEN PARK ESTATES  
BLDG H - ROOF PLACEMENT PLAN  
BOISE CASCADE BMD  
VANCOUVER, WA

PLACING PLAN NOTES:	
1. DO NOT NOTCH BCI JOIST FLANGES FOR ANY REASON, TYP.	
2. SHIFT BCI JOISTS UP TO 3" TO AVOID PLUMBING DROP, TYP.	
3. REFER TO THE STRUCTURAL DRAWINGS FOR ALL NECESSARY DETAILS, TYP.	
LEGEND:	
ADD = ADDITIONAL JOIST BBO = BEAM BY OTHERS BK = BLOCKING PANELS (FIELD CUT) C = COLUMN DB = DROPPED BEAM FB = FLUSH BEAM H = HANGER ( ) J = QTY AND BCI JOIST LGR = LEDGER RM = RIM BOARD SS = STAIR STRINGER	
SPACE BCI JOISTS AT 24" OC UON, TYPICAL.	
FLOOR UNIFORM DESIGN LOADS: 40 PSF LL, 25 PSF DL	

FINAL LAYOUTS  
FOR CONSTRUCTION

THESE PRODUCT PLACING PLANS WERE PRODUCED FROM  
DRAWINGS BY Froelich Consulting Engineers, Inc.  
DATED 8/4/2023, IFC SET

BLDG H - ROOF PLACEMENT PLAN

Job#: 23-000372
October 31, 2023
By: ALAINA DAHL
Scale: 1/4" = 1'
Sheet 14/16