## CITY OF PORTLAND

## INTER-OFFICE CORRESPONDENCE

(NOT FOR MAILING)

From

Bureau of City Engineer

To

Dept. of Public Works

Addressed to

Commissioner Wm. A. Bowes

Subject

Change of Name of S.W. Riverside Drive within present City boundary to S.W. Macadam Ave.

February 4, 1964

Dear Sir:

We have prepared and submit herewith an ordinance changing the name of that portion of S.W. Riverside Drive (State Highway 43) within the recently annexed Lewis and Clark College area, to S.W. Macadam Avenue.

The change of name was suggested by the City Traffic Engineer to prevent confusion in traffic accident coding operations. Also, this street is actually the southerly continuation of S.W. Macadam Avenue as it is designated north of the former south City boundary. Since there is no improved or developed property on either side of the section of street in question, no difficulties concerning addresses or the mails should arise.

It is recommended that this ordinance be passed by the Council and that the State Highway Commission and the Multnomah County Road Department be notified by the Auditor of the City's action.


Very truly yours,

L. H. ROSENTHAL, P. E.

City Engineer

ಾ CS/dr

Encl.

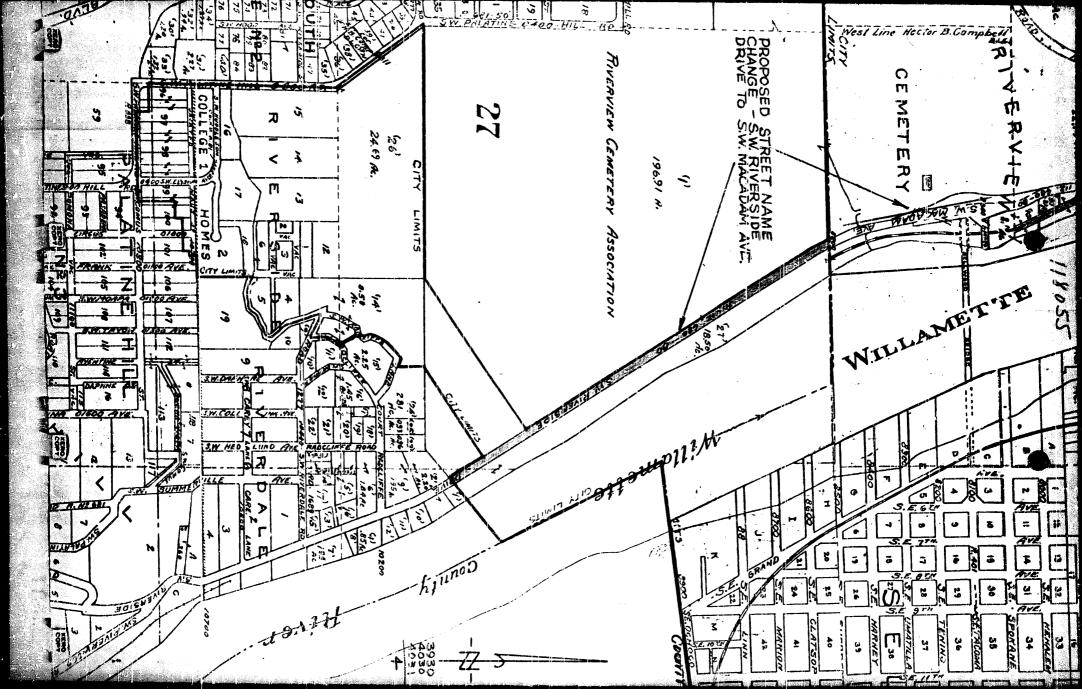

## ORDINANCE No. 118055

An Ordinance changing the name of that portion of S.W. Riverside Drive (State Highway No. 43) from the south line of Section 22, T.1S., R.1E., W.M. (former City of Portland boundary); thence southerly to the northeasterly extension of the southeasterly line of the Riverview Cemetery Association property as described in Book 452 at Page 267, Multnomah County deed records (present City of Portland boundary) to S.W. Macadam Avenue, and declaring an emergency.

The City of Portland ordains:

Section 1. The Council finds that a section of S.W. Riverside Drive (State Highway No. 43) between its northerly end at the former City boundary and its southerly end at the new City boundary was recently annexed along with other properties to the City of Portland, and that a name change of this section of S.W. Riverside Drive (State Highway No. 43) to S.W. Macadam Avenue would serve to eliminate confusion to the City in regard to traffic accident coding operations and other matters and would present no difficulties concerning addresses or mail delivery; now, therefore, the name of that portion of S.W. Riverside Drive (State Highway No. 43) from the south line of Section 22, T.1S., R.1E., W.M. (former City of Portland boundary); thence southerly to the northeasterly extension of the southeasterly line of the Riverview Cemetery Association property as described in Book 452 at Page 267, Multnomah County deed records (present City of Portland boundary) is hereby changed and the said portion of street shall hereafter be known and designated as S.W. Macadam Avenue.

Section 2. Nothing contained in this Ordinance shall in any way affect the validity of any proceedings for improvement, opening, laying out, establishing or widening of the above-mentioned streets or for the construction of sewers or water mains, or for the establishing of grades thereon, but such proceedings continue and be completed as though the name of said streets had not been changed or fixed.

Section 3. Inasmuch as this Ordinance is necessary for the immediate preservation of the public health, peace and safety of the City of Portland in this: That there should be no unreasonable delay in designating these streets under the new designation; therefore, an emergency is hereby declared to exist and this Ordinance shall be in force and effect from and after its passage by the Council.

Passed by the Council, FEB 13 1964

Attest.

Auditor of the City of Portland

Commissioner Bowns

INTRODUCED BY

THE COMMISSIONERS VOTED AS FOLLOWS:	MMISSIONERS AS FOLLOWS:	RS VOTED 'S:
	Yeas	Nays
Bean		
Bowes		
Earl	1	
Grayson	_	
Schrunk		

## ORDINANCE No. 118055

Title

An Ordinance changing the name of that portion of S.W. Riverside Drive (State Highway No. 43) from the south line of Section 22, T.JS., R.IE., W.M. (former City of Portland boundary); thence southerly to the northeasterly extension of the southeeasterly line of the Riverview Cemetery Association property as described in Book 452 at Page 267, Multnomah County deed records (present City of Portland boundary) to S.W. Macadam Avenue, and declaring an emergency.

By Clex	RIAN SMIT	Filed
P ( Deputy	SMITH THE SMITH	

FEB 7 - 1964

Grayson

Schruck

Earl

Bowes

Bean

EQUR-FIFTHS CALENDAR

DRAWN BY
CS:J
Date 2-4-64
TOTAL BY THE COMMISSIONER
Affairs
Finance
Safety
Utilities
Works //// //

N N N	
TED	
POR C	
A ALI	
NOTED FOR CITY AUDITOR	

City Attorney

	Ву	Date	City Engineer	By Manutas	The s	Date 7 2/2 (0:1	APPROVED
--	----	------	---------------	------------	-------	-----------------	----------