




THE SURVEY INFORMATION SHOWN AS A BACKGROUND SCREEN ON THIS SHEET IS SHOWN FOR REFERENCE ONLY AND IS BASED ON A SURVEY BY: NW SURVEYING INC. DATE: AUGUST, 2012

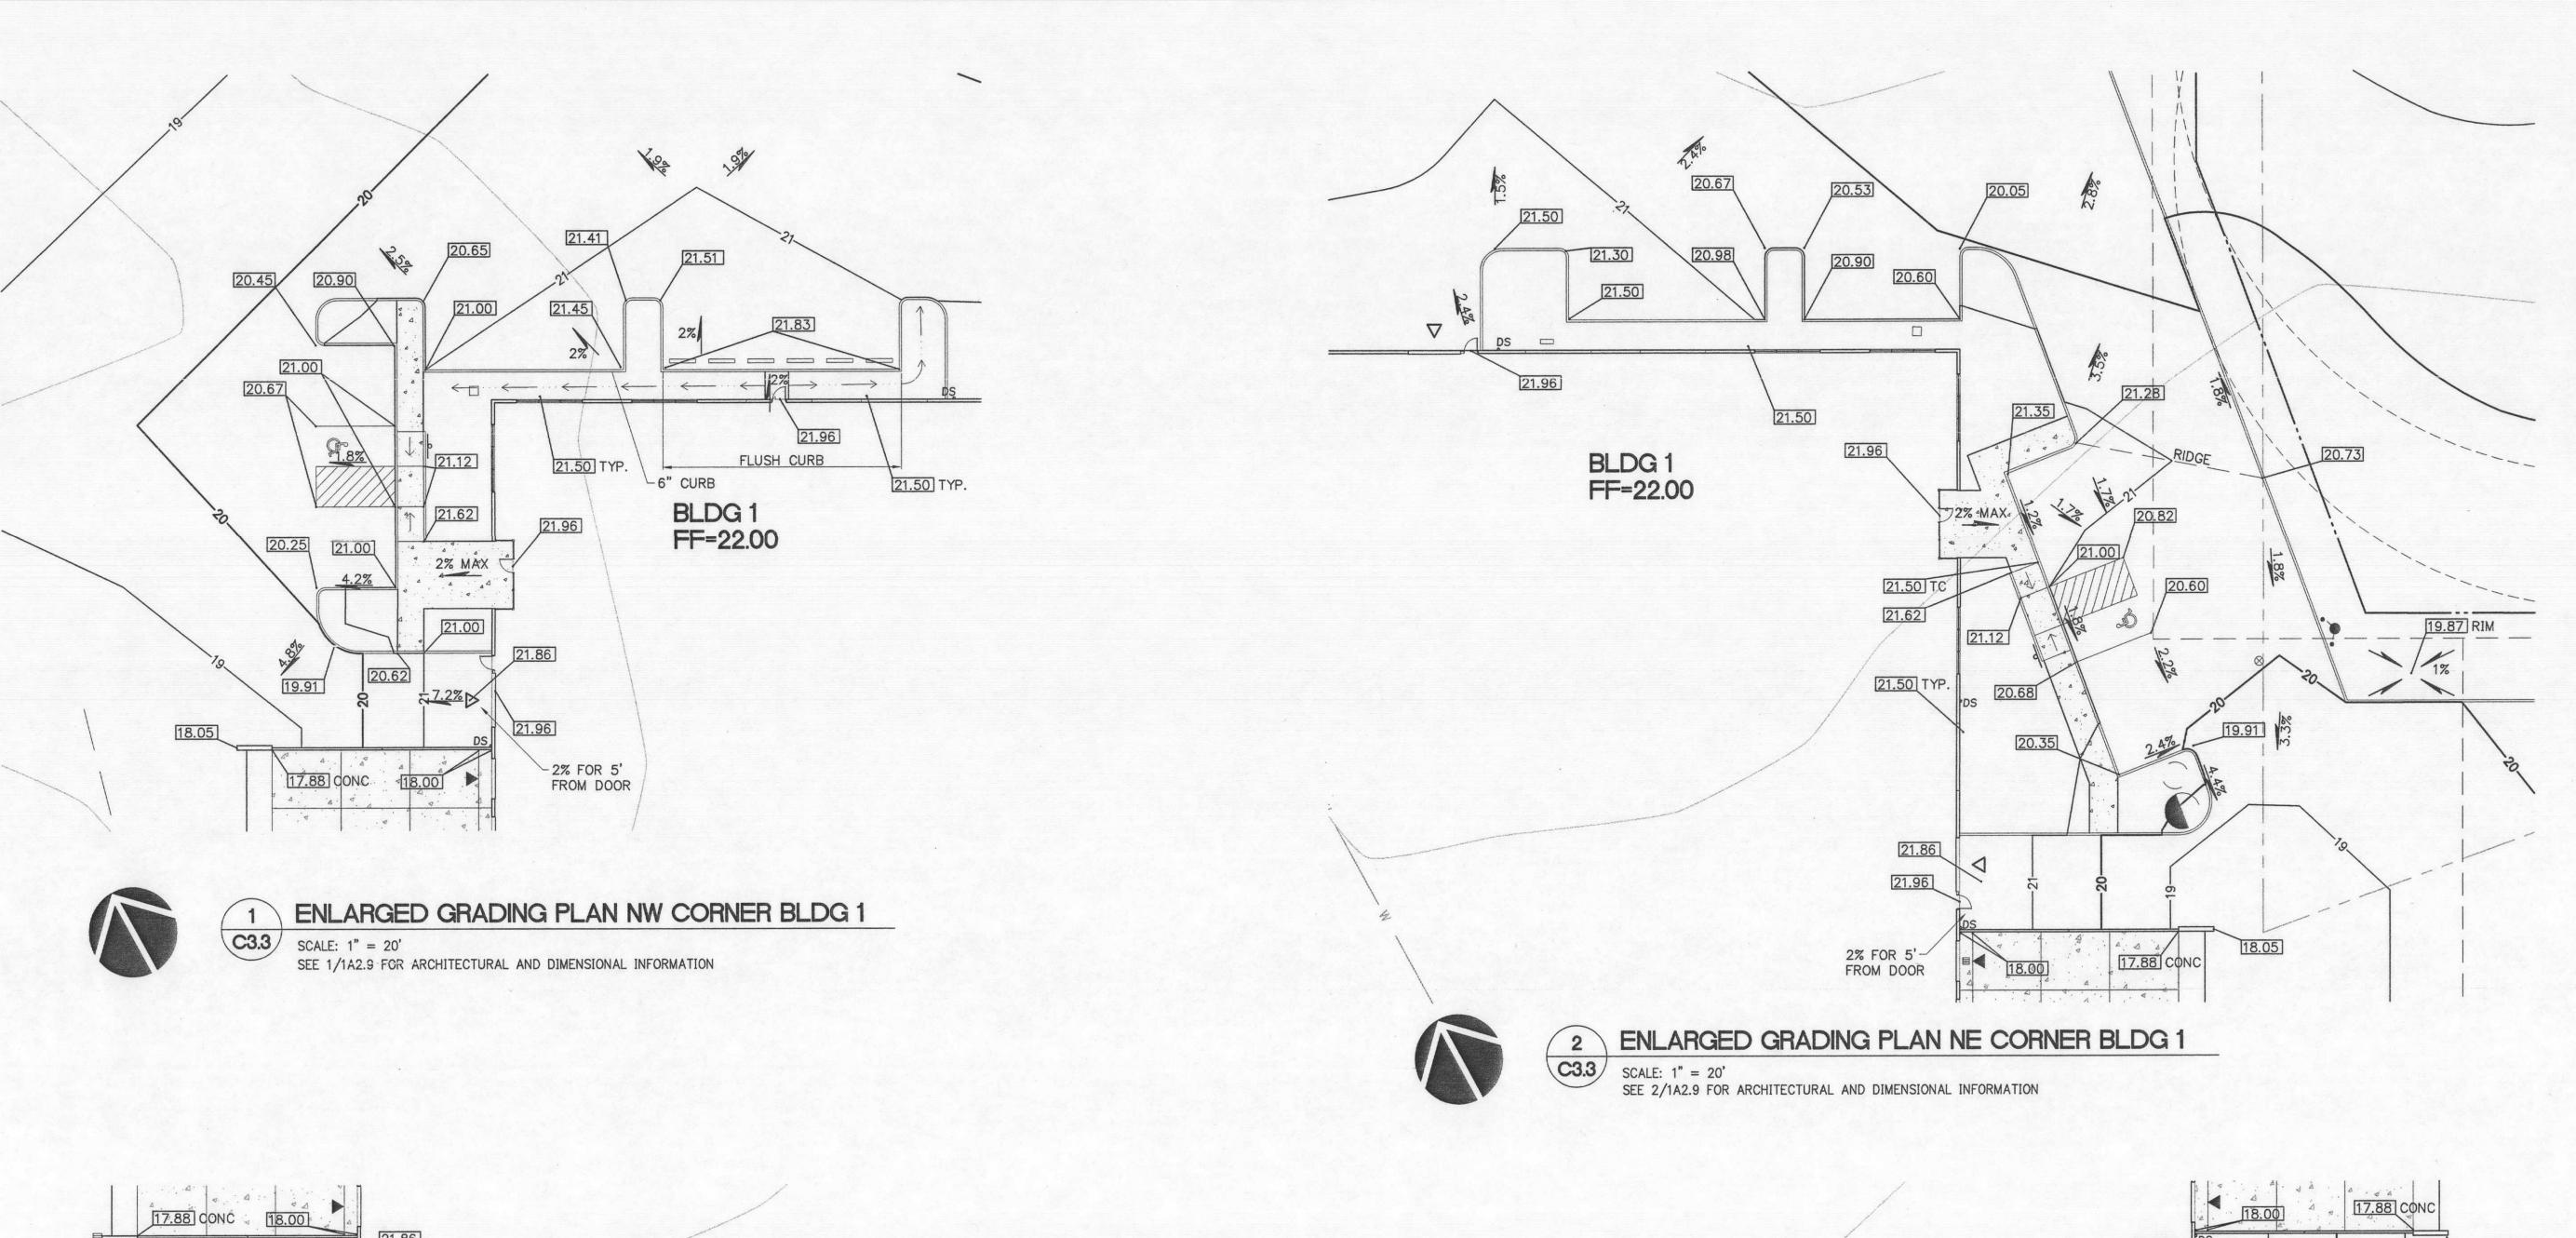

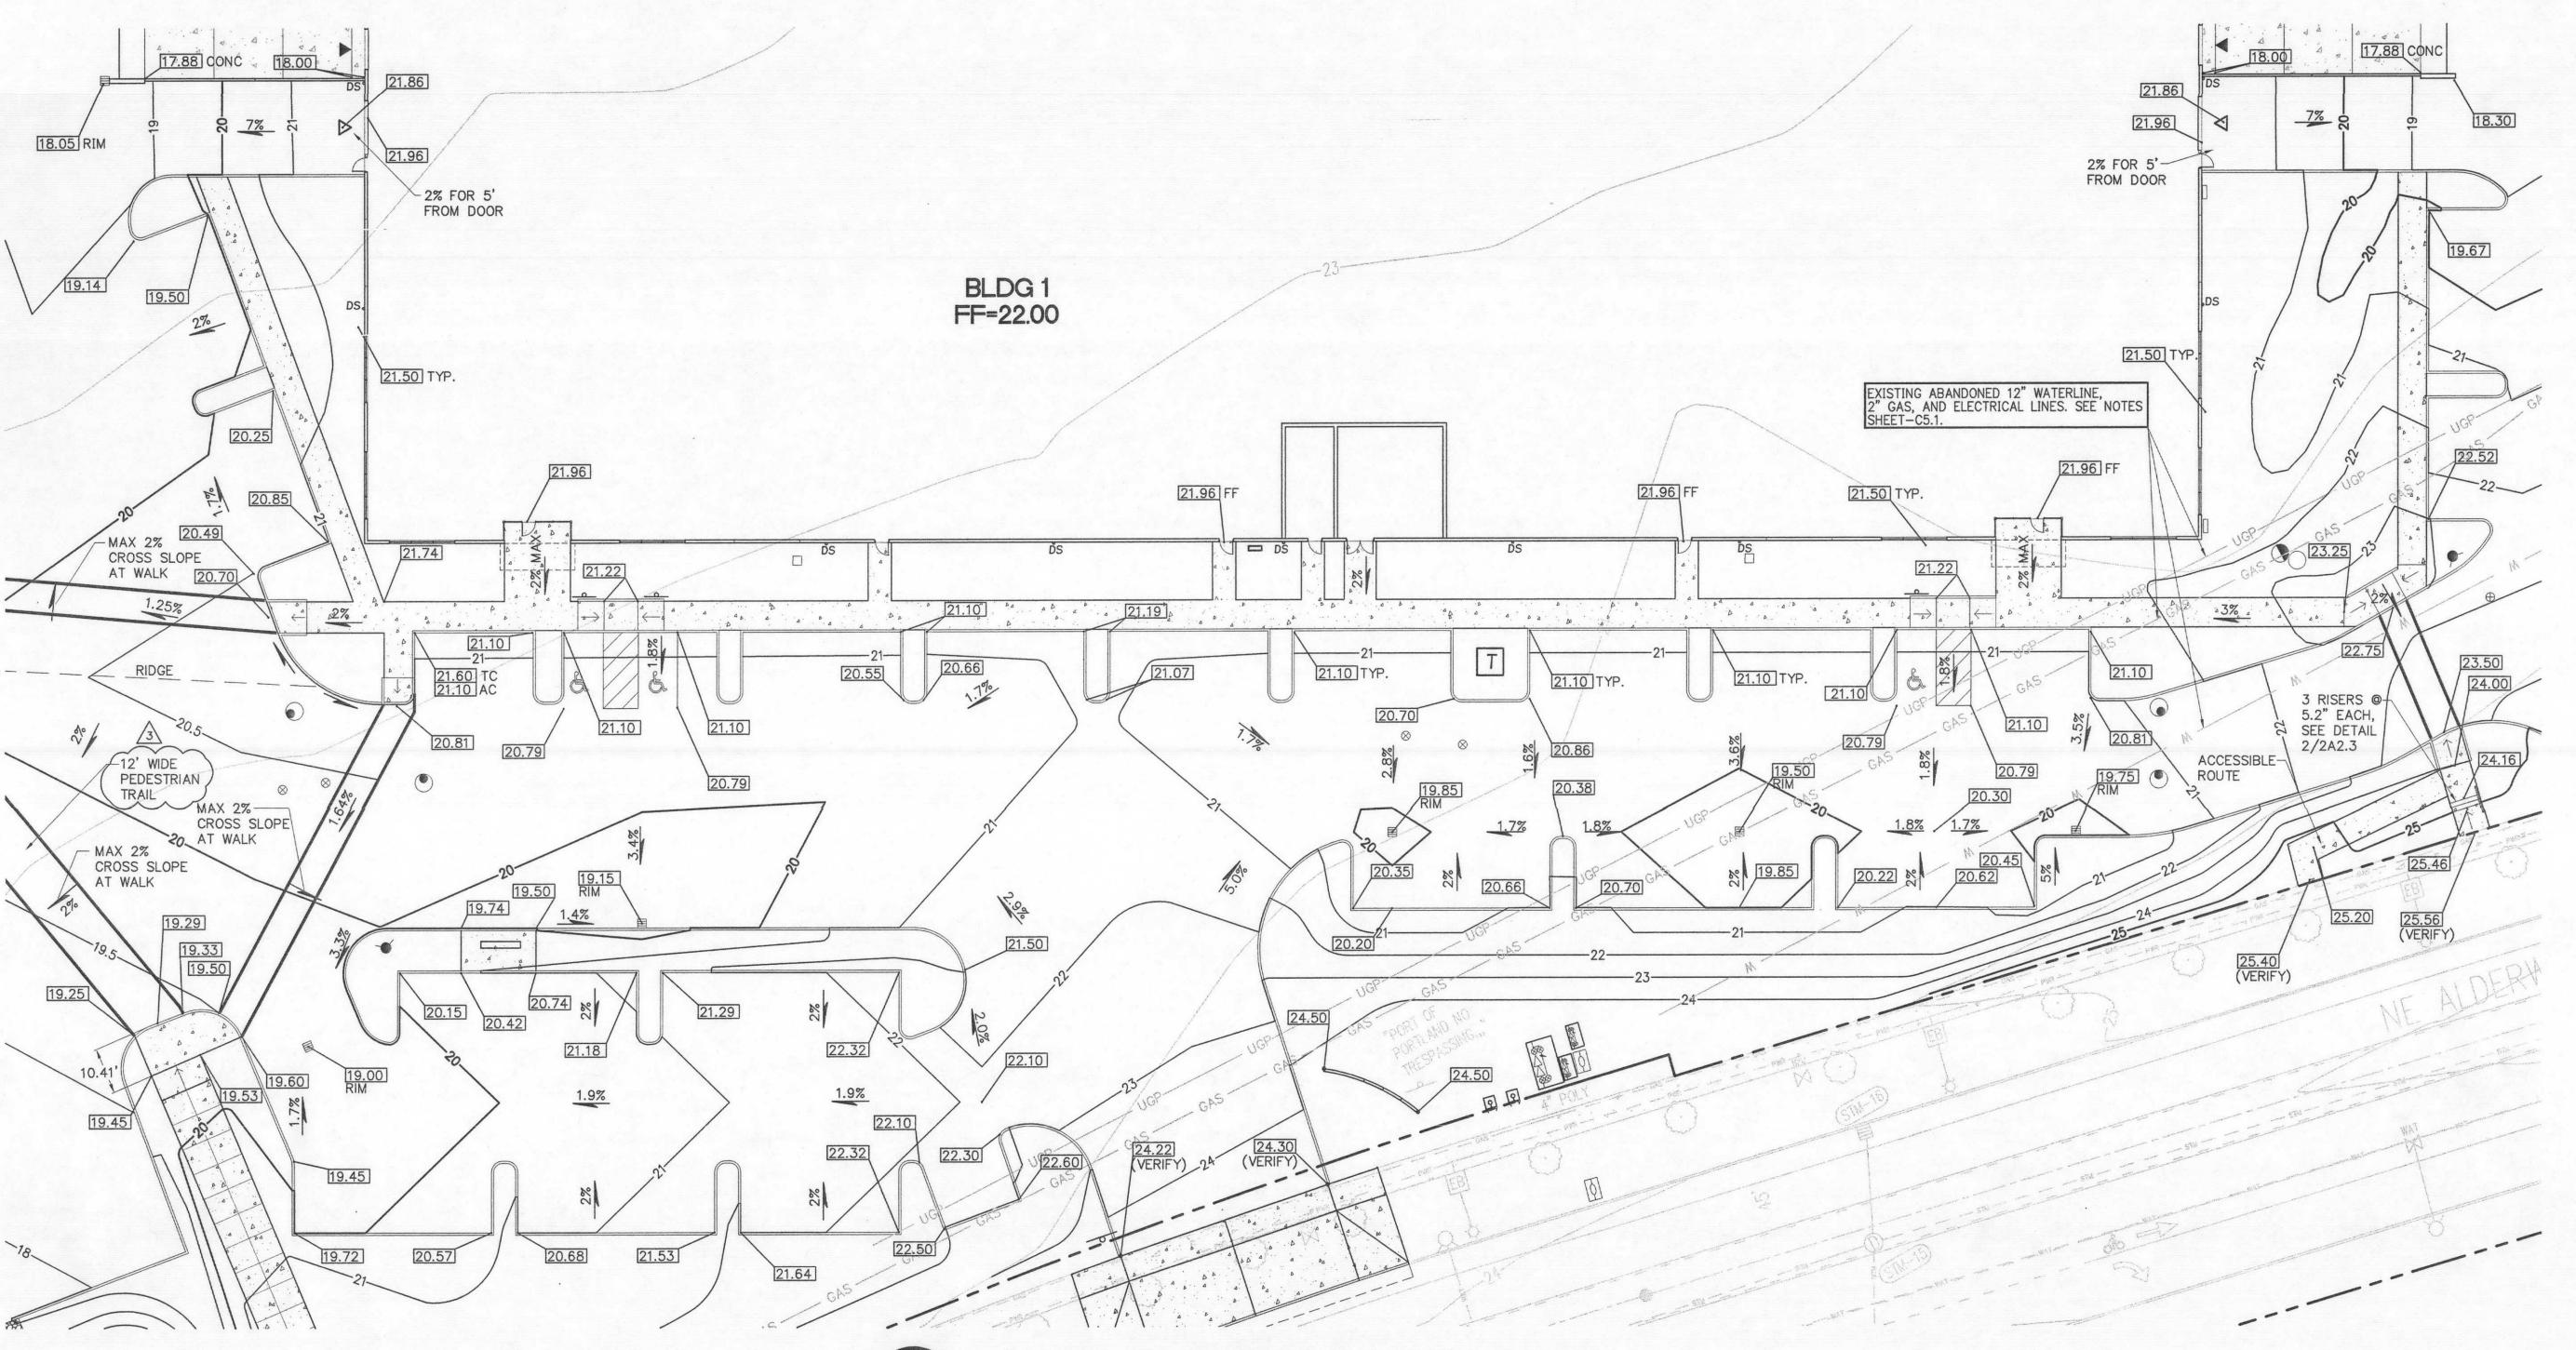

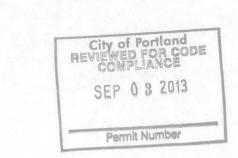

LEGEND

GROUP MACKENZIE 2013
ALL RIGHTS RESERVED

THESE DRAWINGS ARE THE PROPERTY OF
GROUP MACKENZIE AND ARE NOT TO BE
USED OR REPRODUCED IN ANY MANNER,
WITHOUT PRIOR WRITTEN PERMISSION

REVISIONS REVISION DELTA

REVISIONS REVISION DELTA CLOSING DATE

1 05/21/2013
2 06/19/2013
3 X IN PROGRESS

SHEET TITLE:
BUILDING 1
GRADING
DETAILS

DRAWN BY: MJS

CHECKED BY: TWM

SHEET

C3.3

3.3 SCALE: 1" = 20'
SEE 1/1A2.8 AND 2/1A2.8 FOR ARCHITECTURAL AND DIMENSIONAL INFORMATION

CHECK SHEET RESPONSE - JULY 23, 2013

PERMIT SET - 06/19/2013

212016700\CIVIL\16703-3.DWG:4230 BTS 07/23/13 07:42 1:20.00

SPOT GRADE

EXISTING CONTOUR

PROPOSED 1-FT CONTOUR

PROPOSED 5-FT CONTOUR

Partnets LC Transportation Devitand OR

Client

Project
PDX LOGISTICS
CENTER

Project

PDX LOGISTICS

CENTER

PHASE ONE

NE ALDERWOOD RD.

PORTLAND, OREGON

CAPSTONE PARTNERS




1 ENLARGED GRADING PLAN SW CORNER BLDG 2

SCALE: 1" = 20'
SEE 1/2A2.3 FOR ARCHITECTURAL AND DIMENSIONAL INFORMATION

ENVIRONMENTAL REVIEW NOTE:

REFER TO ENVIRONMENTAL REVIEW DECISION CITY OF PORTLAND CASE
FILE: LU 12-214260 EN SEE SHEETS ER-1 AND ER-2

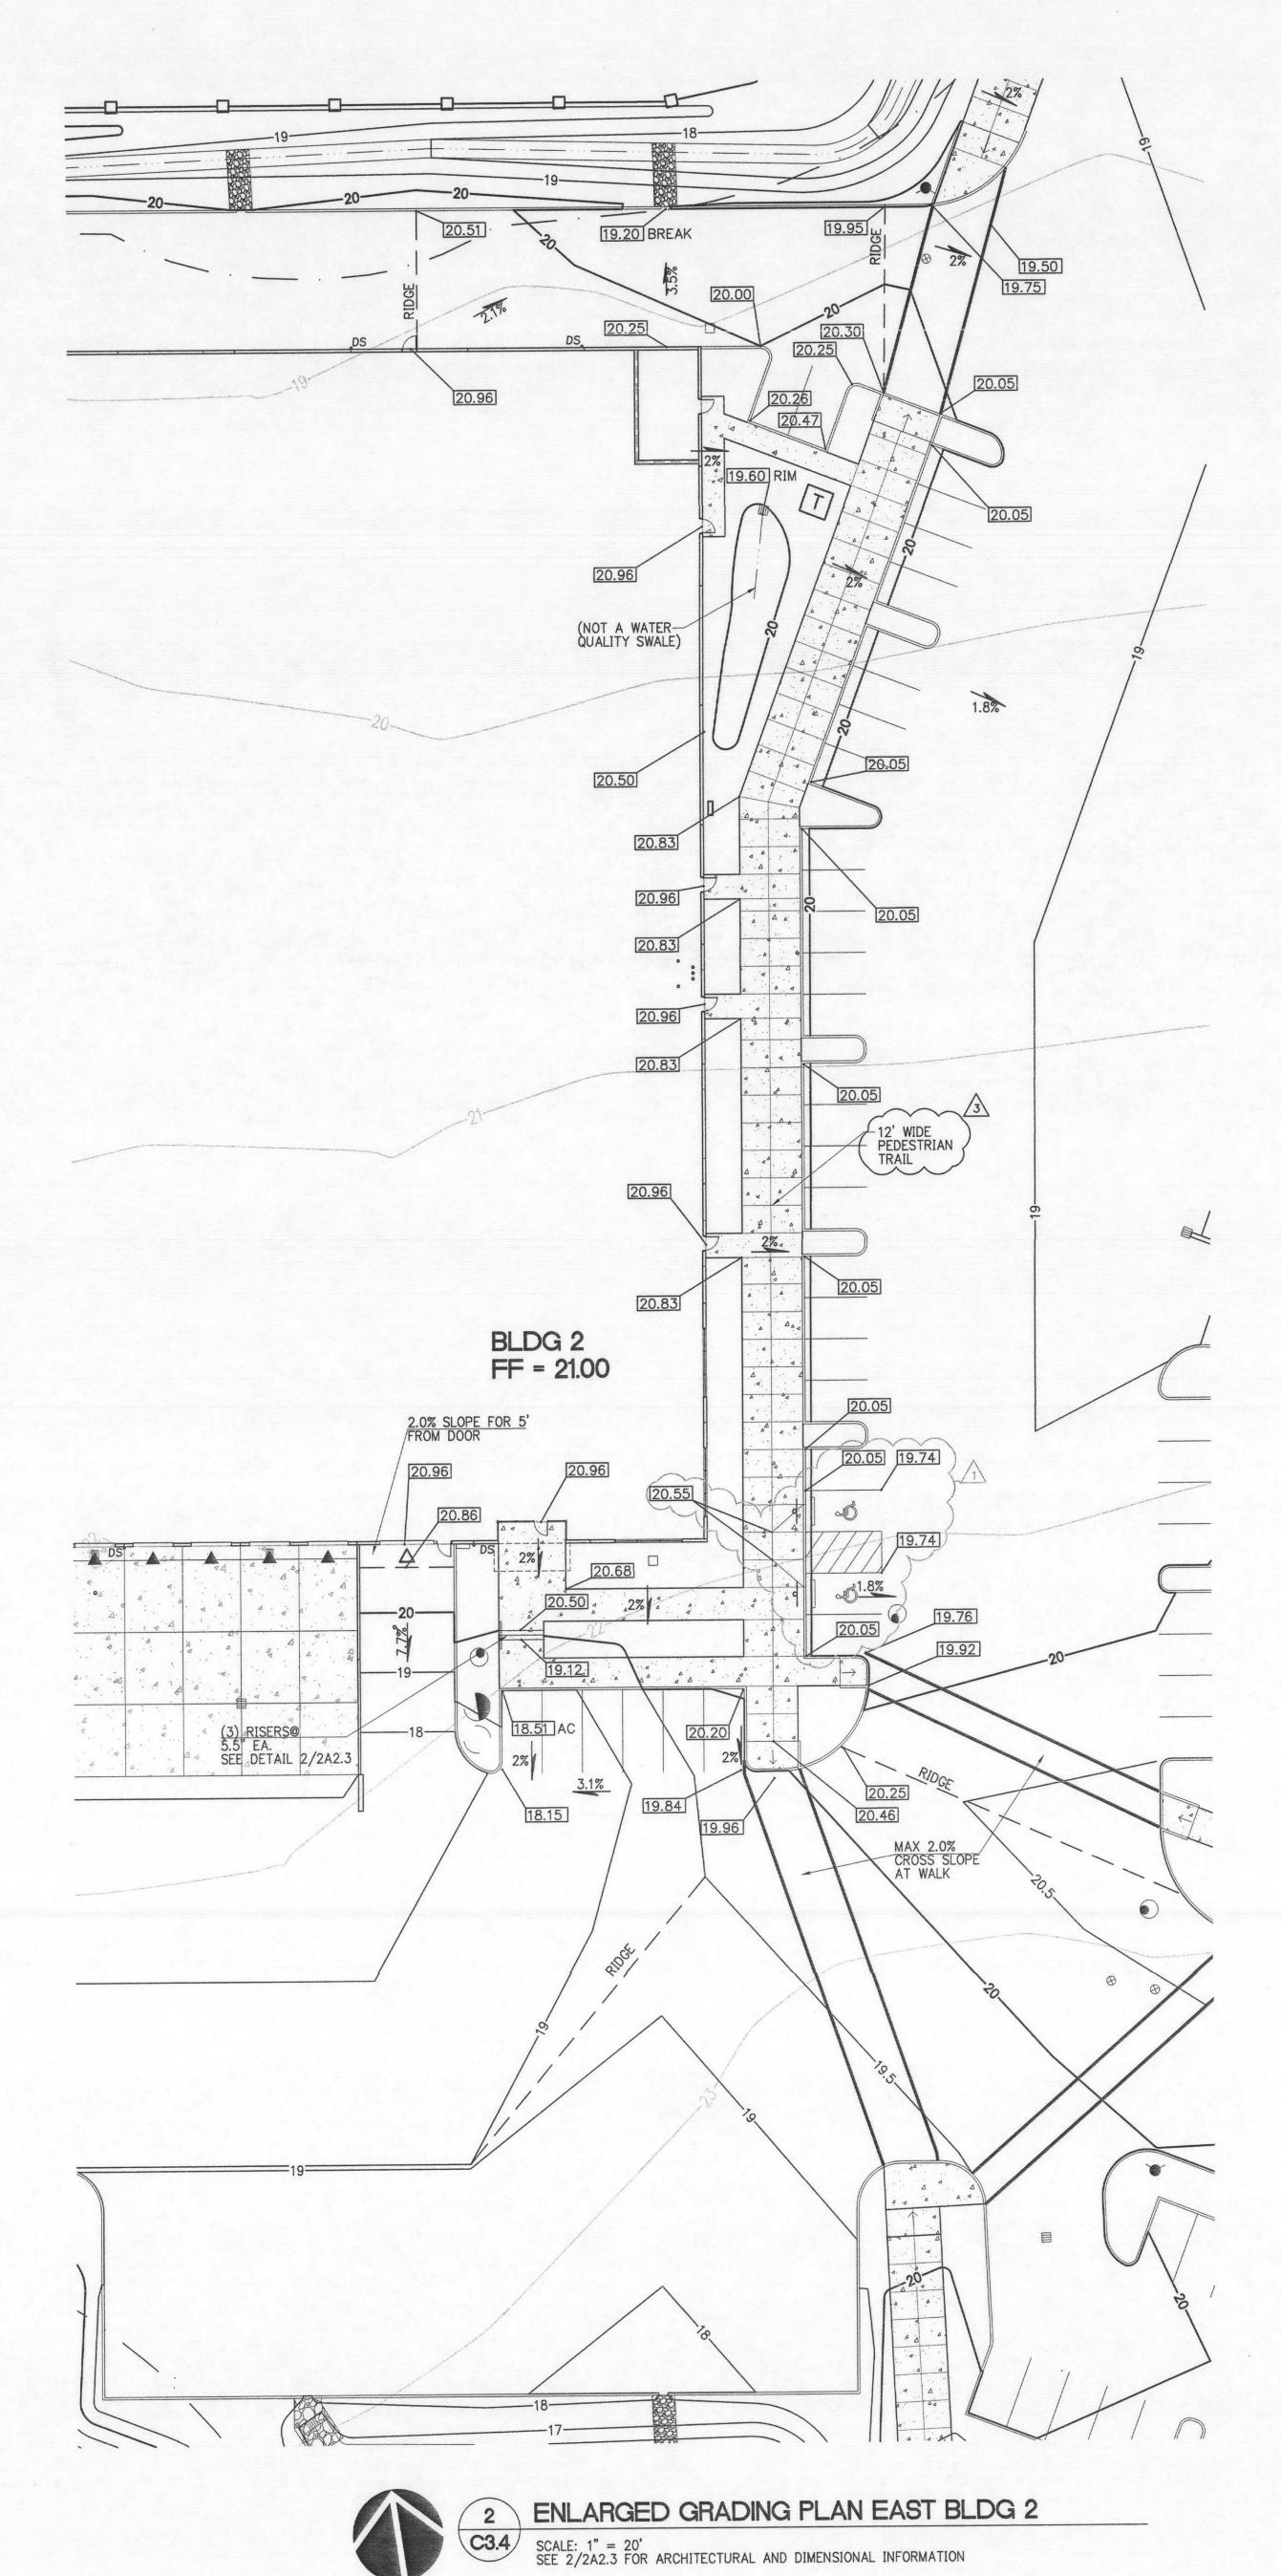



LEGEND SPOT GRADE EXISTING CONTOUR PROPOSED 1-FT CONTOUR PROPOSED 5-FT CONTOUR

C3.4

JOB NO. 2120167.00 CHECK SHEET RESPONSE - JULY 23, 2013

PERMIT SET - 06/19/2013

2120167.000

2120167.000

2120167.000

Project

PDX LOGISTICS

CENTER

PHASE ONE

NE ALDERWOOD RD.

PORTLAND, OREGON

CAPSTONE PARTNERS

GROUP MACKENZIE 2013
ALL RIGHTS RESERVED

THESE DRAWINGS ARE THE PROPERTY OF
GROUP MACKENZIE AND ARE NOT TO BE
USED OR REPRODUCED IN ANY MANNER,
WITHOUT PRIOR WRITTEN PERMISSION


REVISIONS: REVISIONS REVISION DELTA CLOSING DATE SHEET

1 X 05/21/2013 06/19/2013 3 X IN PROGRESS


SHEET TITLE:
BUILDING 2
GRADING
DETAILS

DRAWN BY: MJS CHECKED BY: TWM

SHEET

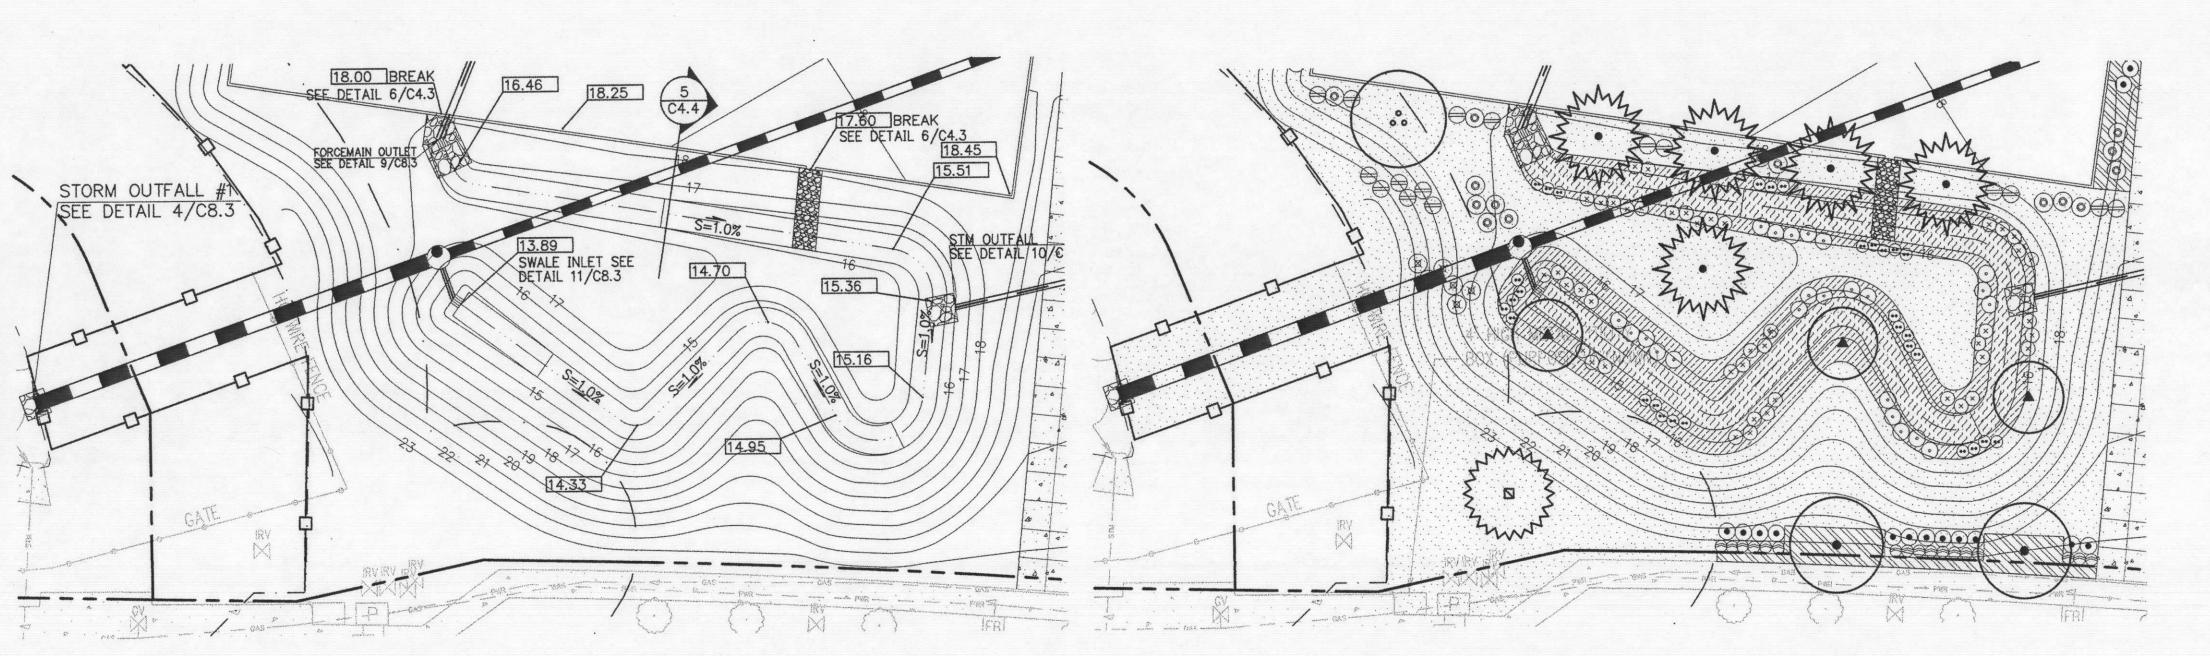


SWALE A BOTTOM WIDTH = 6' WIDE LONGITUDINAL SLOPE = 1.0% 1 SWALE A - PLAN

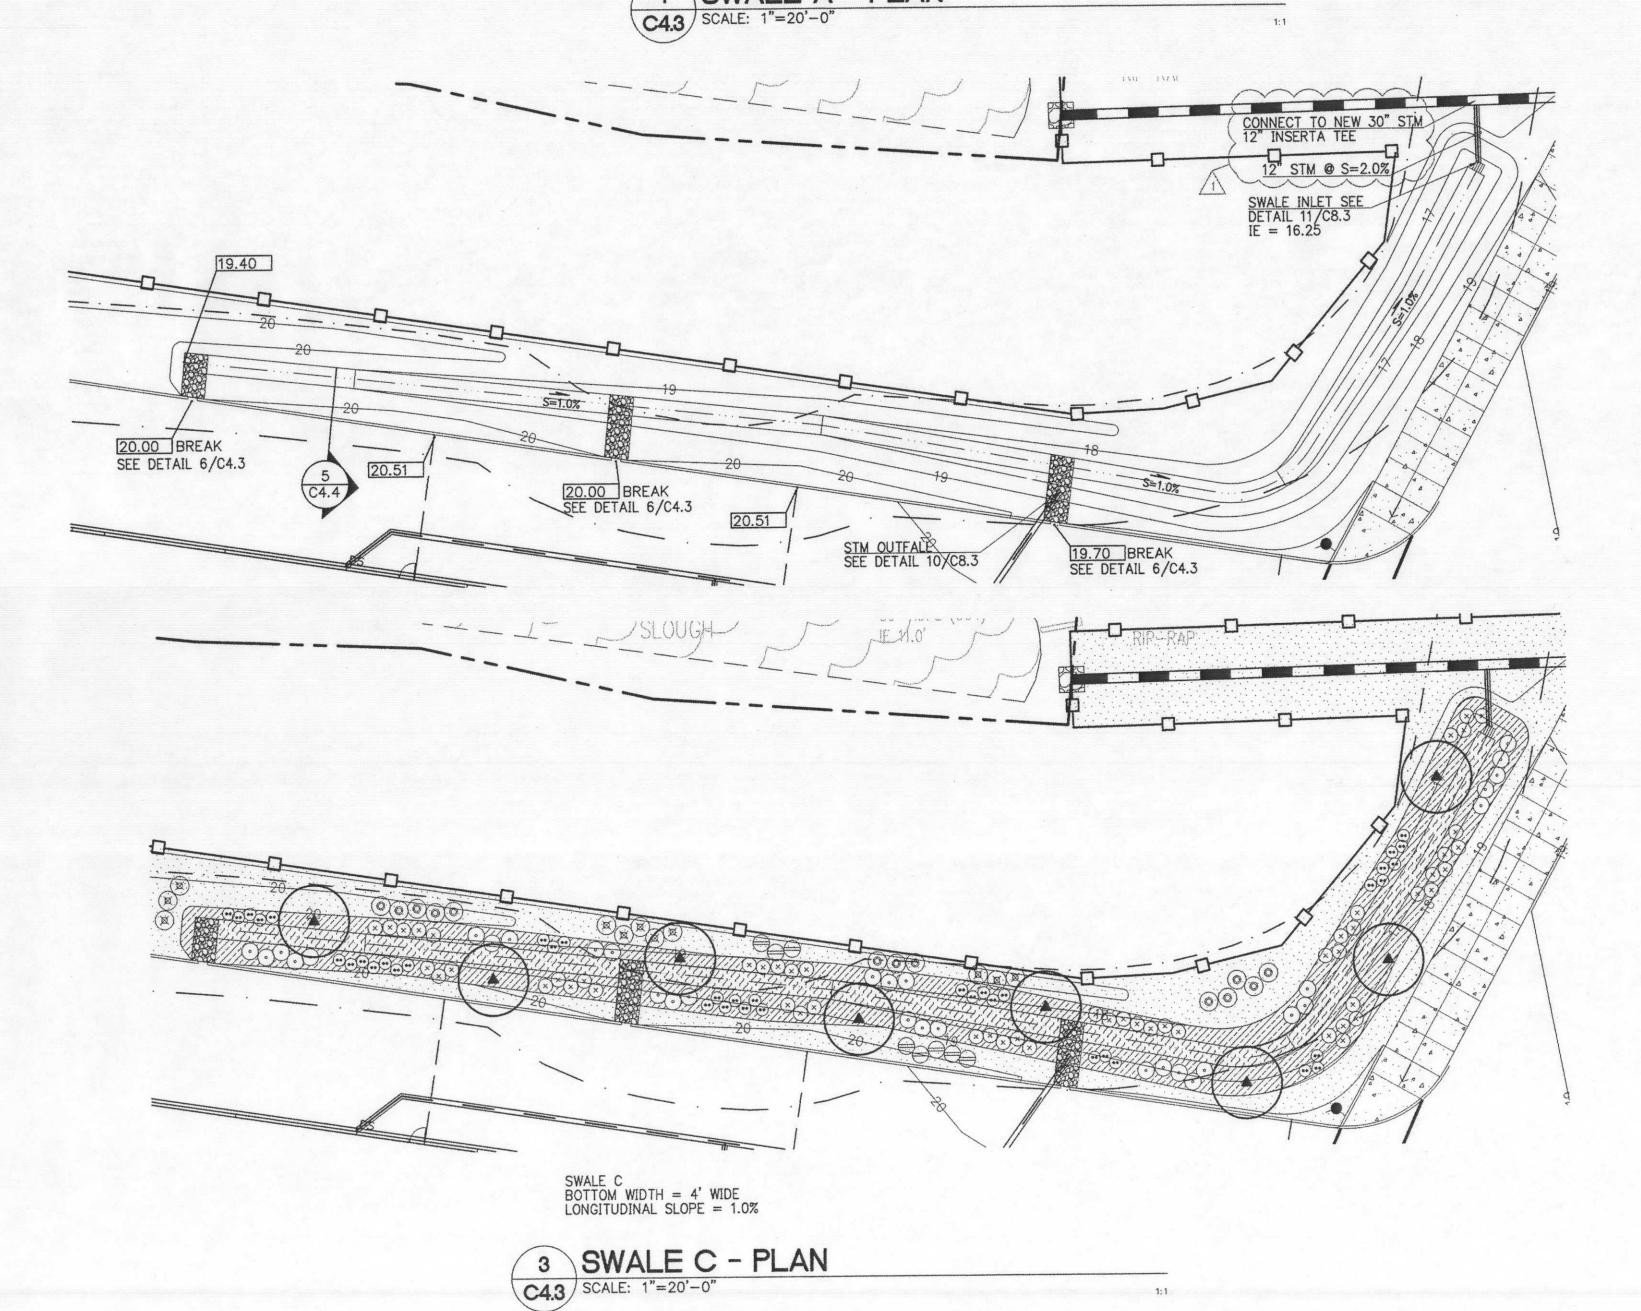


CONNECT TO EXIST 30" STM


SWALE E BOTTOM WIDTH = 3' WIDE LONGITUDINAL SLOPE = 0.50% 5 SWALE E - PLAN
C4.3 SCALE: 1"=20'-0"

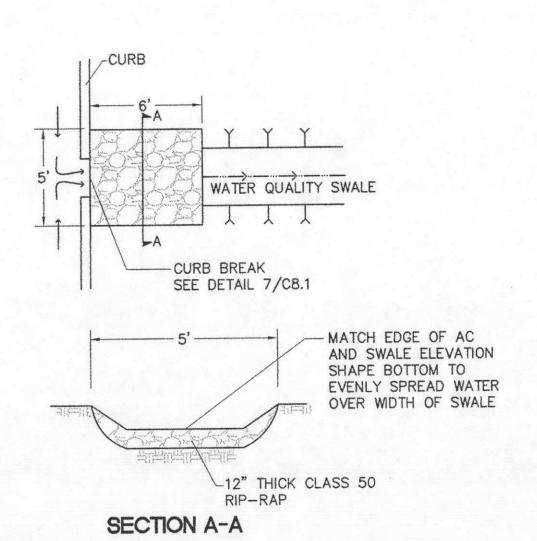

6 RIP-RAP AT WATER QUALITY SWALE C4.3 N.T.S.

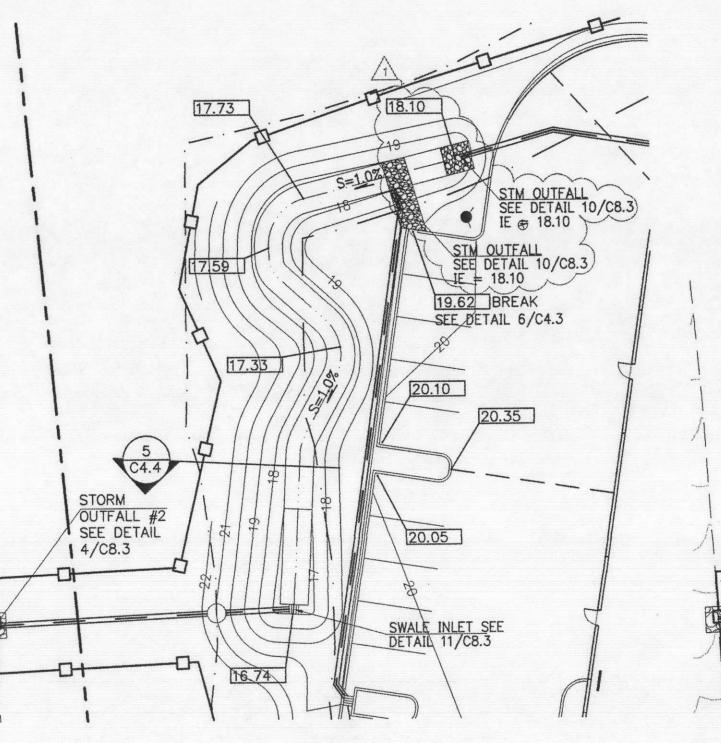

SWALE B
BOTTOM WIDTH = 6' WIDE
LONGITUDINAL SLOPE = 1.0% 2 SWALE B - PLAN
C4.3 SCALE: 1"=20'-0"

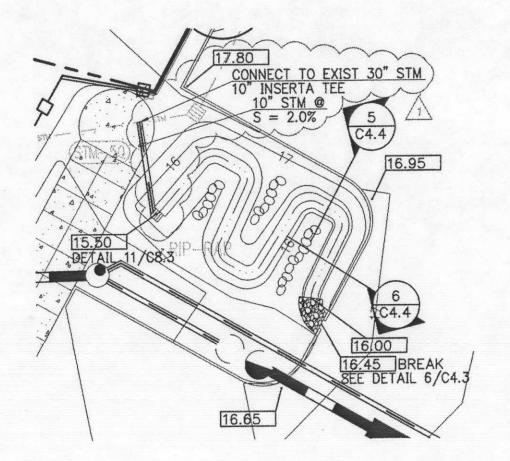

SWALE D BOTTOM WIDTH = 3' WIDE LONGITUDINAL SLOPE = 0.50%

4 SWALE D - PLAN
C4.3 SCALE: 1"=20'-0"

City of Portland REVIEWED FOR CODE COMPLIANCE SEP 0 8 2013 Permit Number

LANT MATERIA	AL SCHEDULE - VEGETATED WATER QU	ALITY FACILITIES	Α	В	С	D	E	F	G	Н	1
SYMBOL	BOTANICAL NAME COMMON NAME	SIZE/ SPACING	#	#	#	#	#	#	#	#	#
	TREES										
•	ACER GRISEUM PAPERBARK MAPLE	1.5" CAL. B&B 6" ABOVE BASE AS SHOWN	3	3	8	1	1	1	3	3	2
	SHRUBS										
O	NANDINA DOMESTICA 'GULF STREAM' GULF STREAM NANDINA	1 GAL. CONT. AS SHOWN	23	14	33	9	9	9	11	9	8
⊗	CORNUS SERICEA 'KELSEYI' KELSEY DOGWOOD	1 GAL. CONT. AS SHOWN	47	21	55	12	12	12	20	31	10
••	CALAMAGROSTIS X ACUTIFLORA 'OVERDAM' OVERDAM FEATHER REED GRASS	1 GAL. CONT. AS SHOWN	30	27	40	10	10	10	15	18	13
	GROUNDCOVER										
	ARCTOSTAPHYLOS UVA-URSI KINNIKINNICK	1 GAL. CONT. 12" O.C.	1,447	1,795	2,070	549	549	549	1,115	812	278
	COMPANION SEED MIX HOBBS AND HOPKINS	7 LBS./1,000 SF AS SHOWN									
	NATIVE SEED MIX										
	CLEAN WATER WET AREA MIX HOBBS AND HOPKINS	1 LB./4,000 SF AS SHOWN	1,576 SF	765 SF	1,229 SF	318 SF	318 SF	318 SF	386 SF	655 SF	337 SF

GENERAL NOTES - VEGETATED WATER QUALITY FACILITY

- 1. TREES ARE TO BE PLANTED AT MINIMUM 40 FT. APART PER PORT OF PORTLAND STANDARDS.
- 2. SHRUBS ARE TO BE PLANTED AT MINIMUM 10 FT. FROM THE TRUNK OF ANY TREE PER PORT OF 3. INSTALL JUTE MATTING ON ALL SLOPES 2.5:1 OR GREATER.

GROWING MEDIUM - VEGETATED WATER QUALITY FACILITY IMPORTED SOIL SHALL BE A SANDY LOAM MIXED WITH COMPOST OR A SAND/SOIL/COMPOST BLEND.


IT SHALL BE ROUGHLY ONE-THIRD COMPOST BY VOLUME, FREE-DRAINING, AND SUPPORT PLANT GROWTH. THE COMPOST SHALL BE DERIVED FROM PLANT MATERIAL; ANIMAL WASTE IS NOT ALLOWED. THE GROWING MEDIUM SHALL BE 18 INCHES DEEP.

PDX LOGISTICS
CENTER
PHASE ONE
NE ALDERWOOD RD.
PORTLAND, OREGON

CAPSTONE PARTNERS

THE LANDSCAPE PLANS AND RELATED DETAILS AND NOTES SHOWN OF THIS SHEET HAVE BEEN PREPARED OR REVIEWED UNDER THE DIRECT SUPERVISION OF THE LANDSCAPE ARCHITECT OF RECORD.

THE GRADING PLANS AND DETAIL 6/C4.3 SHOWN ON THIS SHEET HAVE BEEN PREPARED OR REVIEWED UNDER THE DIRECT SUPERVISION OF THE CIVIL ENGINEER OF RECORD.

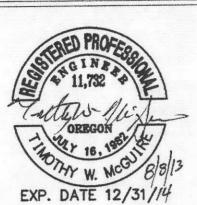

GROUP MACKENZIE 2013
ALL RIGHTS RESERVED

THESE DRAWINGS ARE THE PROPERTY OF
GROUP MACKENZIE AND ARE NOT TO BE
USED OR REPRODUCED IN ANY MANNER,
WITHOUT PRIOR WRITTEN PERMISSION

REVISIONS:

REVISIONS REVISION DELTA
THIS CLOSING DATE
SHEET

1 X 05/21/2013 06/19/2013 IN PROGRESS

SHEET TITLE:

WATER QUALITY
SWALE GRADING
+ LANDSCAPE
DETAILS


DRAWN BY: MJS CHECKED BY: TWM


SHEET

C4.3

JOB NO. 2120167.00

CHECK SHEET RESPONSE - AUGUST 8, 2013-PERMIT SET - 06/19/2013

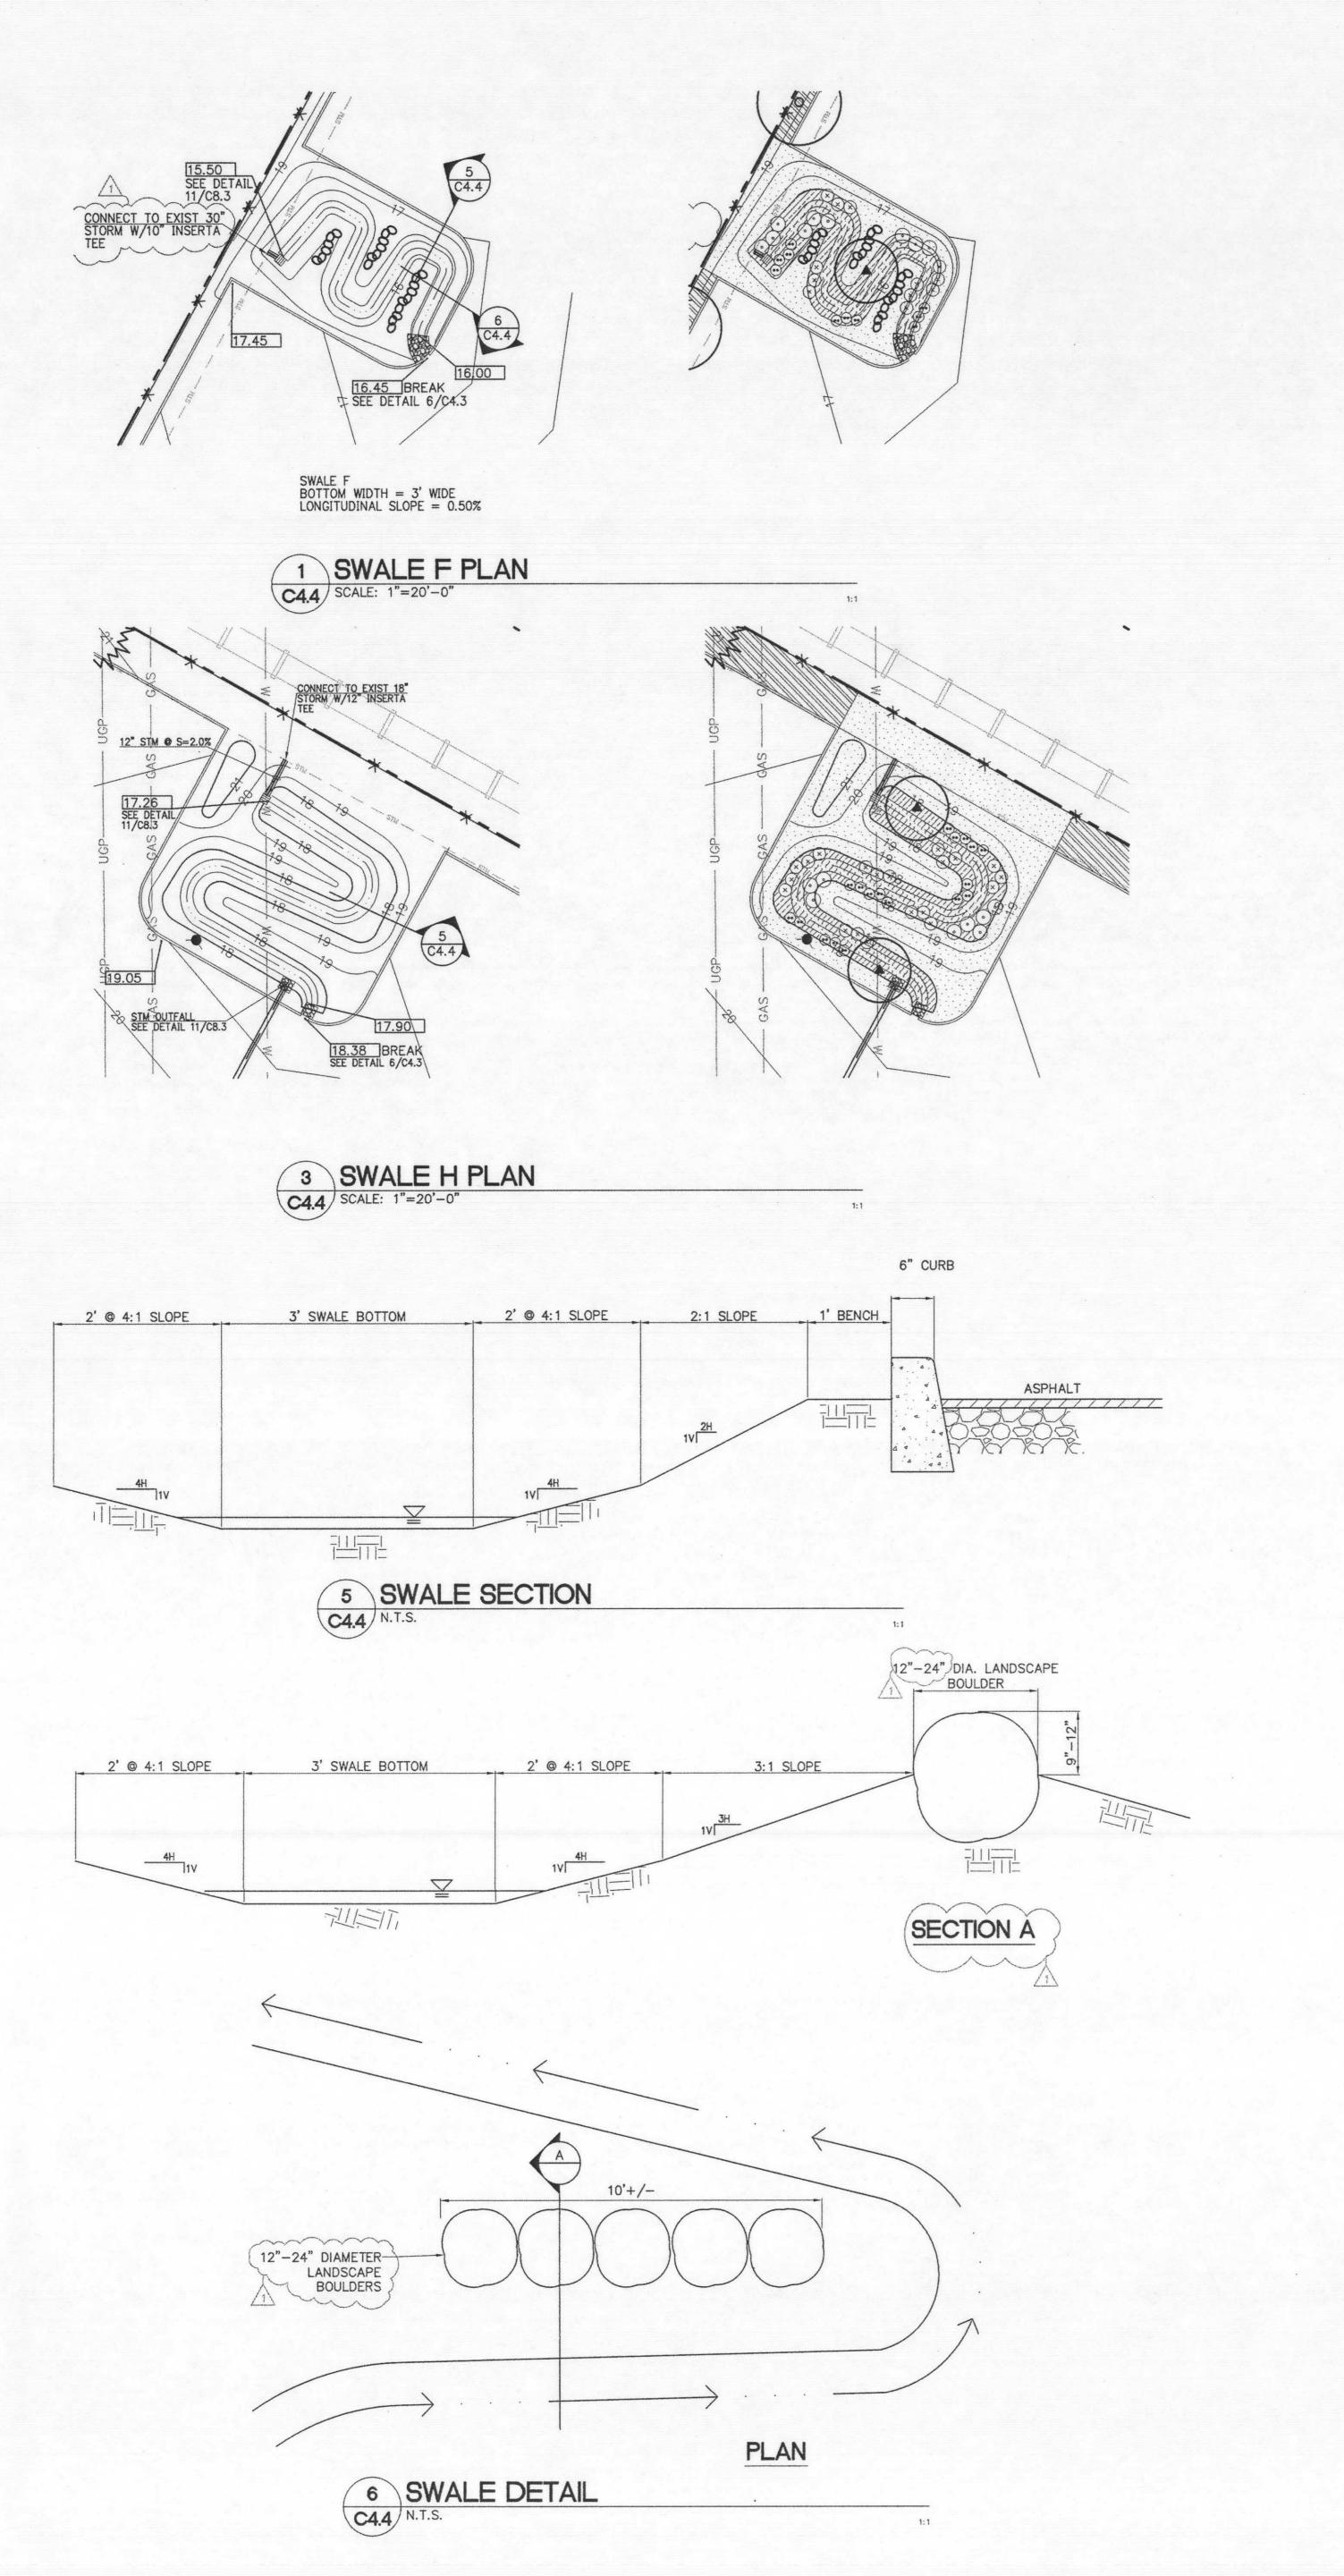

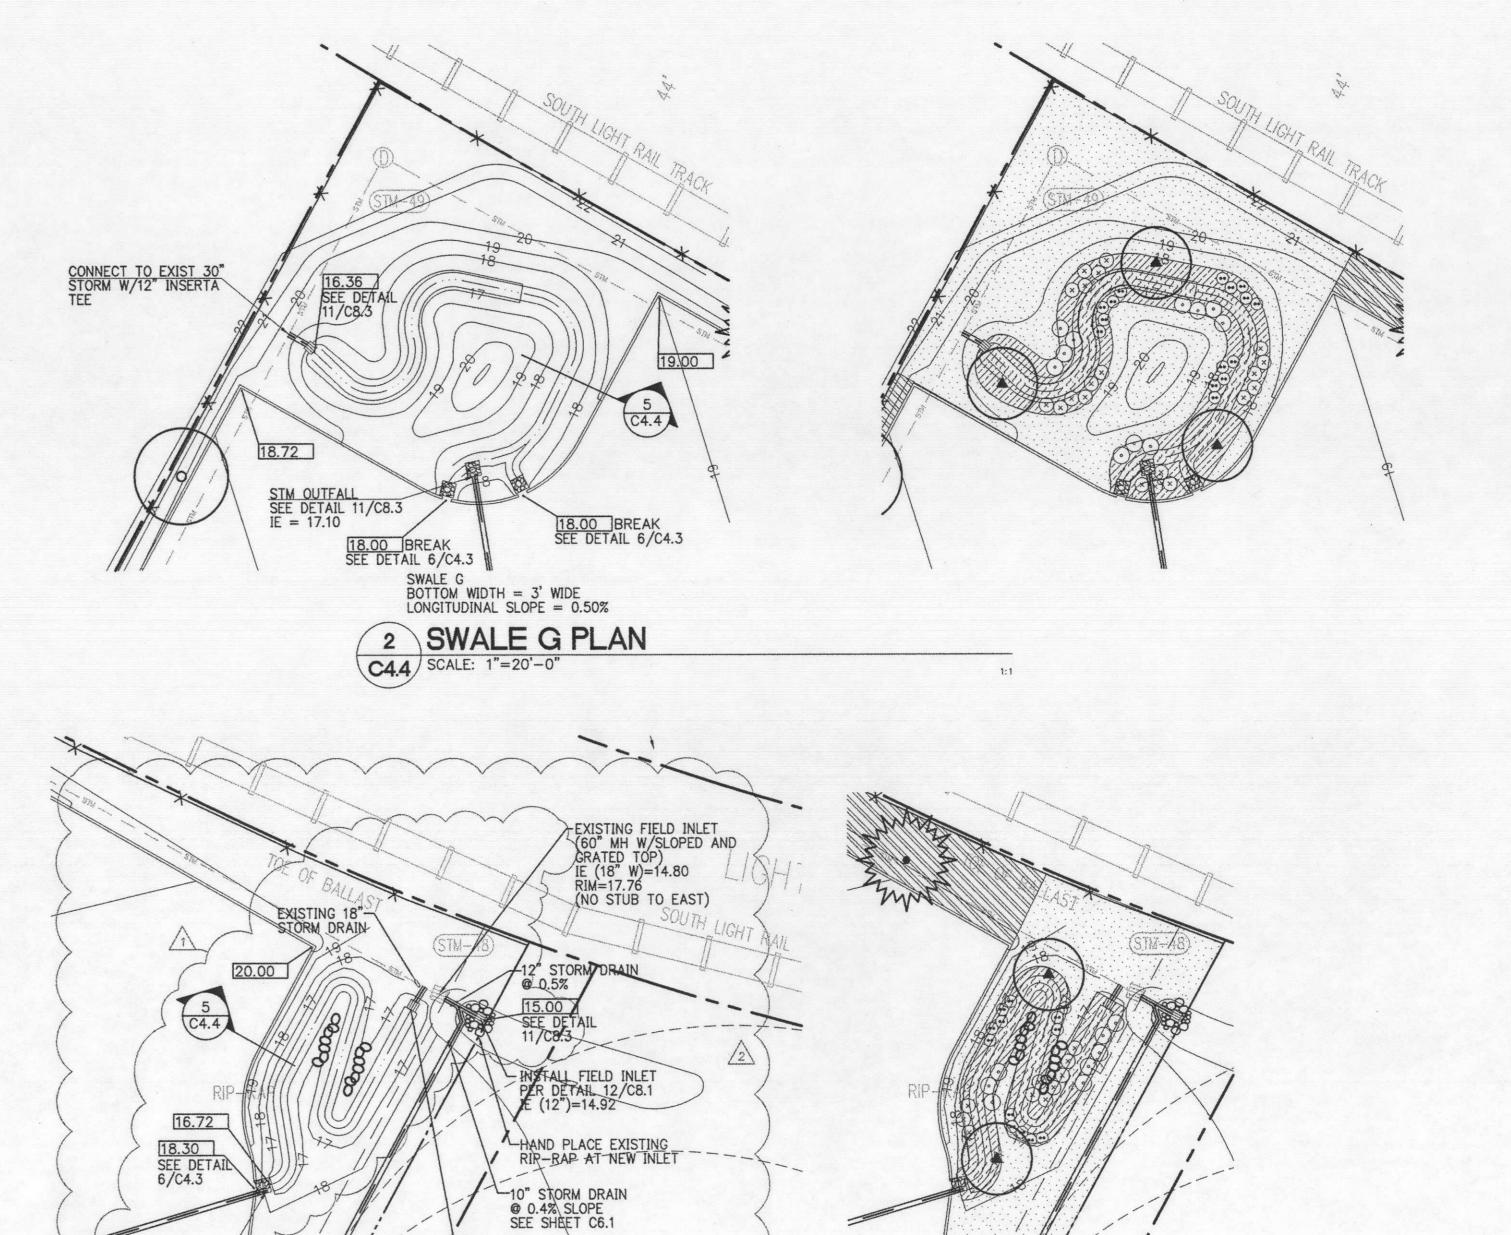

SWALE I BOTTOM WIDTH = 3' WIDE LONGITUDINAL SLOPE = 0.50%

4 SWALE I PLAN
C4.4 SCALE: 1"=20'-0"

City of Portland
REV WED FOR CODE
COMPLIANCE
SEP 0 3 2013

LANT MATERIA	AL SCHEDULE - VEGETATED WATER QU	IALITY FACILITIES	Α	В	C	D	E	F	G	Н	1
SYMBOL	BOTANICAL NAME - COMMON NAME	SIZE/ SPACING	#	#	#	#	#	#	#	#	#
	TREES										
	ACER GRISEUM PAPERBARK MAPLE	1.5" CAL. B&B 6" ABOVE BASE AS SHOWN	3	3	8	1	1	1	3	3	2
	SHRUBS										
0	NANDINA DOMESTICA 'GULF STREAM' GULF STREAM NANDINA	1 GAL. CONT. AS SHOWN	23	14	33	9	9	9	11	9	8
(×)	CORNUS SERICEA 'KELSEYI' KELSEY DOGWOOD	1 GAL. CONT. AS SHOWN	47	21	55	12	12	12	20	31	10
•	CALAMAGROSTIS X ACUTIFLORA 'OVERDAM' OVERDAM FEATHER REED GRASS	1 GAL. CONT. AS SHOWN	30	27	40	10	10	10	15	18	13
	GROUNDCOVER										
	ARCTOSTAPHYLOS UVA-URSI KINNIKINNICK	1 GAL. CONT. 12" O.C.	1,447	1,795	2,070	549	549	549	1,115	812	278
	COMPANION SEED MIX HOBBS AND HOPKINS	7 LBS./1,000 SF AS SHOWN									
	NATIVE SEED MIX										
	CLEAN WATER WET AREA MIX HOBBS AND HOPKINS	1 LB./4,000 SF AS SHOWN	1,576 SF	765 SF	1,229 SF	318 SF	318 SF	318 SF	386 SF	655 SF	337 SF

GENERAL NOTES - VEGETATED WATER QUALITY FACILITY

- 1. TREES ARE TO BE PLANTED AT MINIMUM 40 FT. APART PER PORT OF PORTLAND STANDARDS.

 2. SHRUBS ARE TO BE PLANTED AT MINIMUM 10 FT. FROM THE TRUNK OF ANY TREE PER PORT OF
- 3. INSTALL JUTE MATTING ON ALL SLOPES 2.5:1 OR GREATER.

GROWING MEDIUM - VEGETATED WATER QUALITY FACILITY


IMPORTED SOIL SHALL BE A SANDY LOAM MIXED WITH COMPOST OR A SAND/SOIL/COMPOST BLEND.

IT SHALL BE ROUGHLY ONE—THIRD COMPOST BY VOLUME, FREE—DRAINING, AND SUPPORT PLANT GROWTH.

THE COMPOST SHALL BE DERIVED FROM PLANT MATERIAL; ANIMAL WASTE IS NOT ALLOWED. THE GROWING

MEDIUM SHALL BE 18 INCHES DEEP.

THE GRADING PLANS AND DETAILS 5/C4.4
AND 6/C4.4 SHOWN ON THIS SHEET HAVE BEEN PREPARED OR REVIEWED UNDER THE DIRECT SUPERVISION OF THE CIVIL ENGINEER OF RECORD.

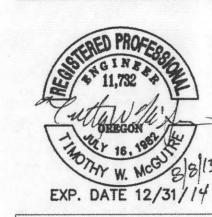

Project

PDX LOGISTICS

CENTER

PHASE ONE

NE ALDERWOOD RD.

PORTLAND, OREGON

CAPSTONE PARTNERS

GROUP MACKENZIE 2013
ALL RIGHTS RESERVED

THESE DRAWINGS ARE THE PROPERTY OF GROUP MACKENZIE AND ARE NOT TO BE USED OR REPRODUCED IN ANY MANNER, WITHOUT PRIOR WRITTEN PERMISSION

REVISIONS:

REVISIONS REVISION DELTA
THIS CLOSING DATE
SHEET

1 X 05/21/2013 2 X 06/19/2013 3 IN PROGRESS

WATER QUALITY
SWALE GRADING
+ LANDSCAPE
DETAILS

DRAWN BY: MJS

CHECKED BY: TWM

SHEET

C4.4


CHECK SHEET RESPONSE - AUGUST 8, 2013

PERMIT SET - 06/19/2013

2120167.00


2120167.00


1:20.00

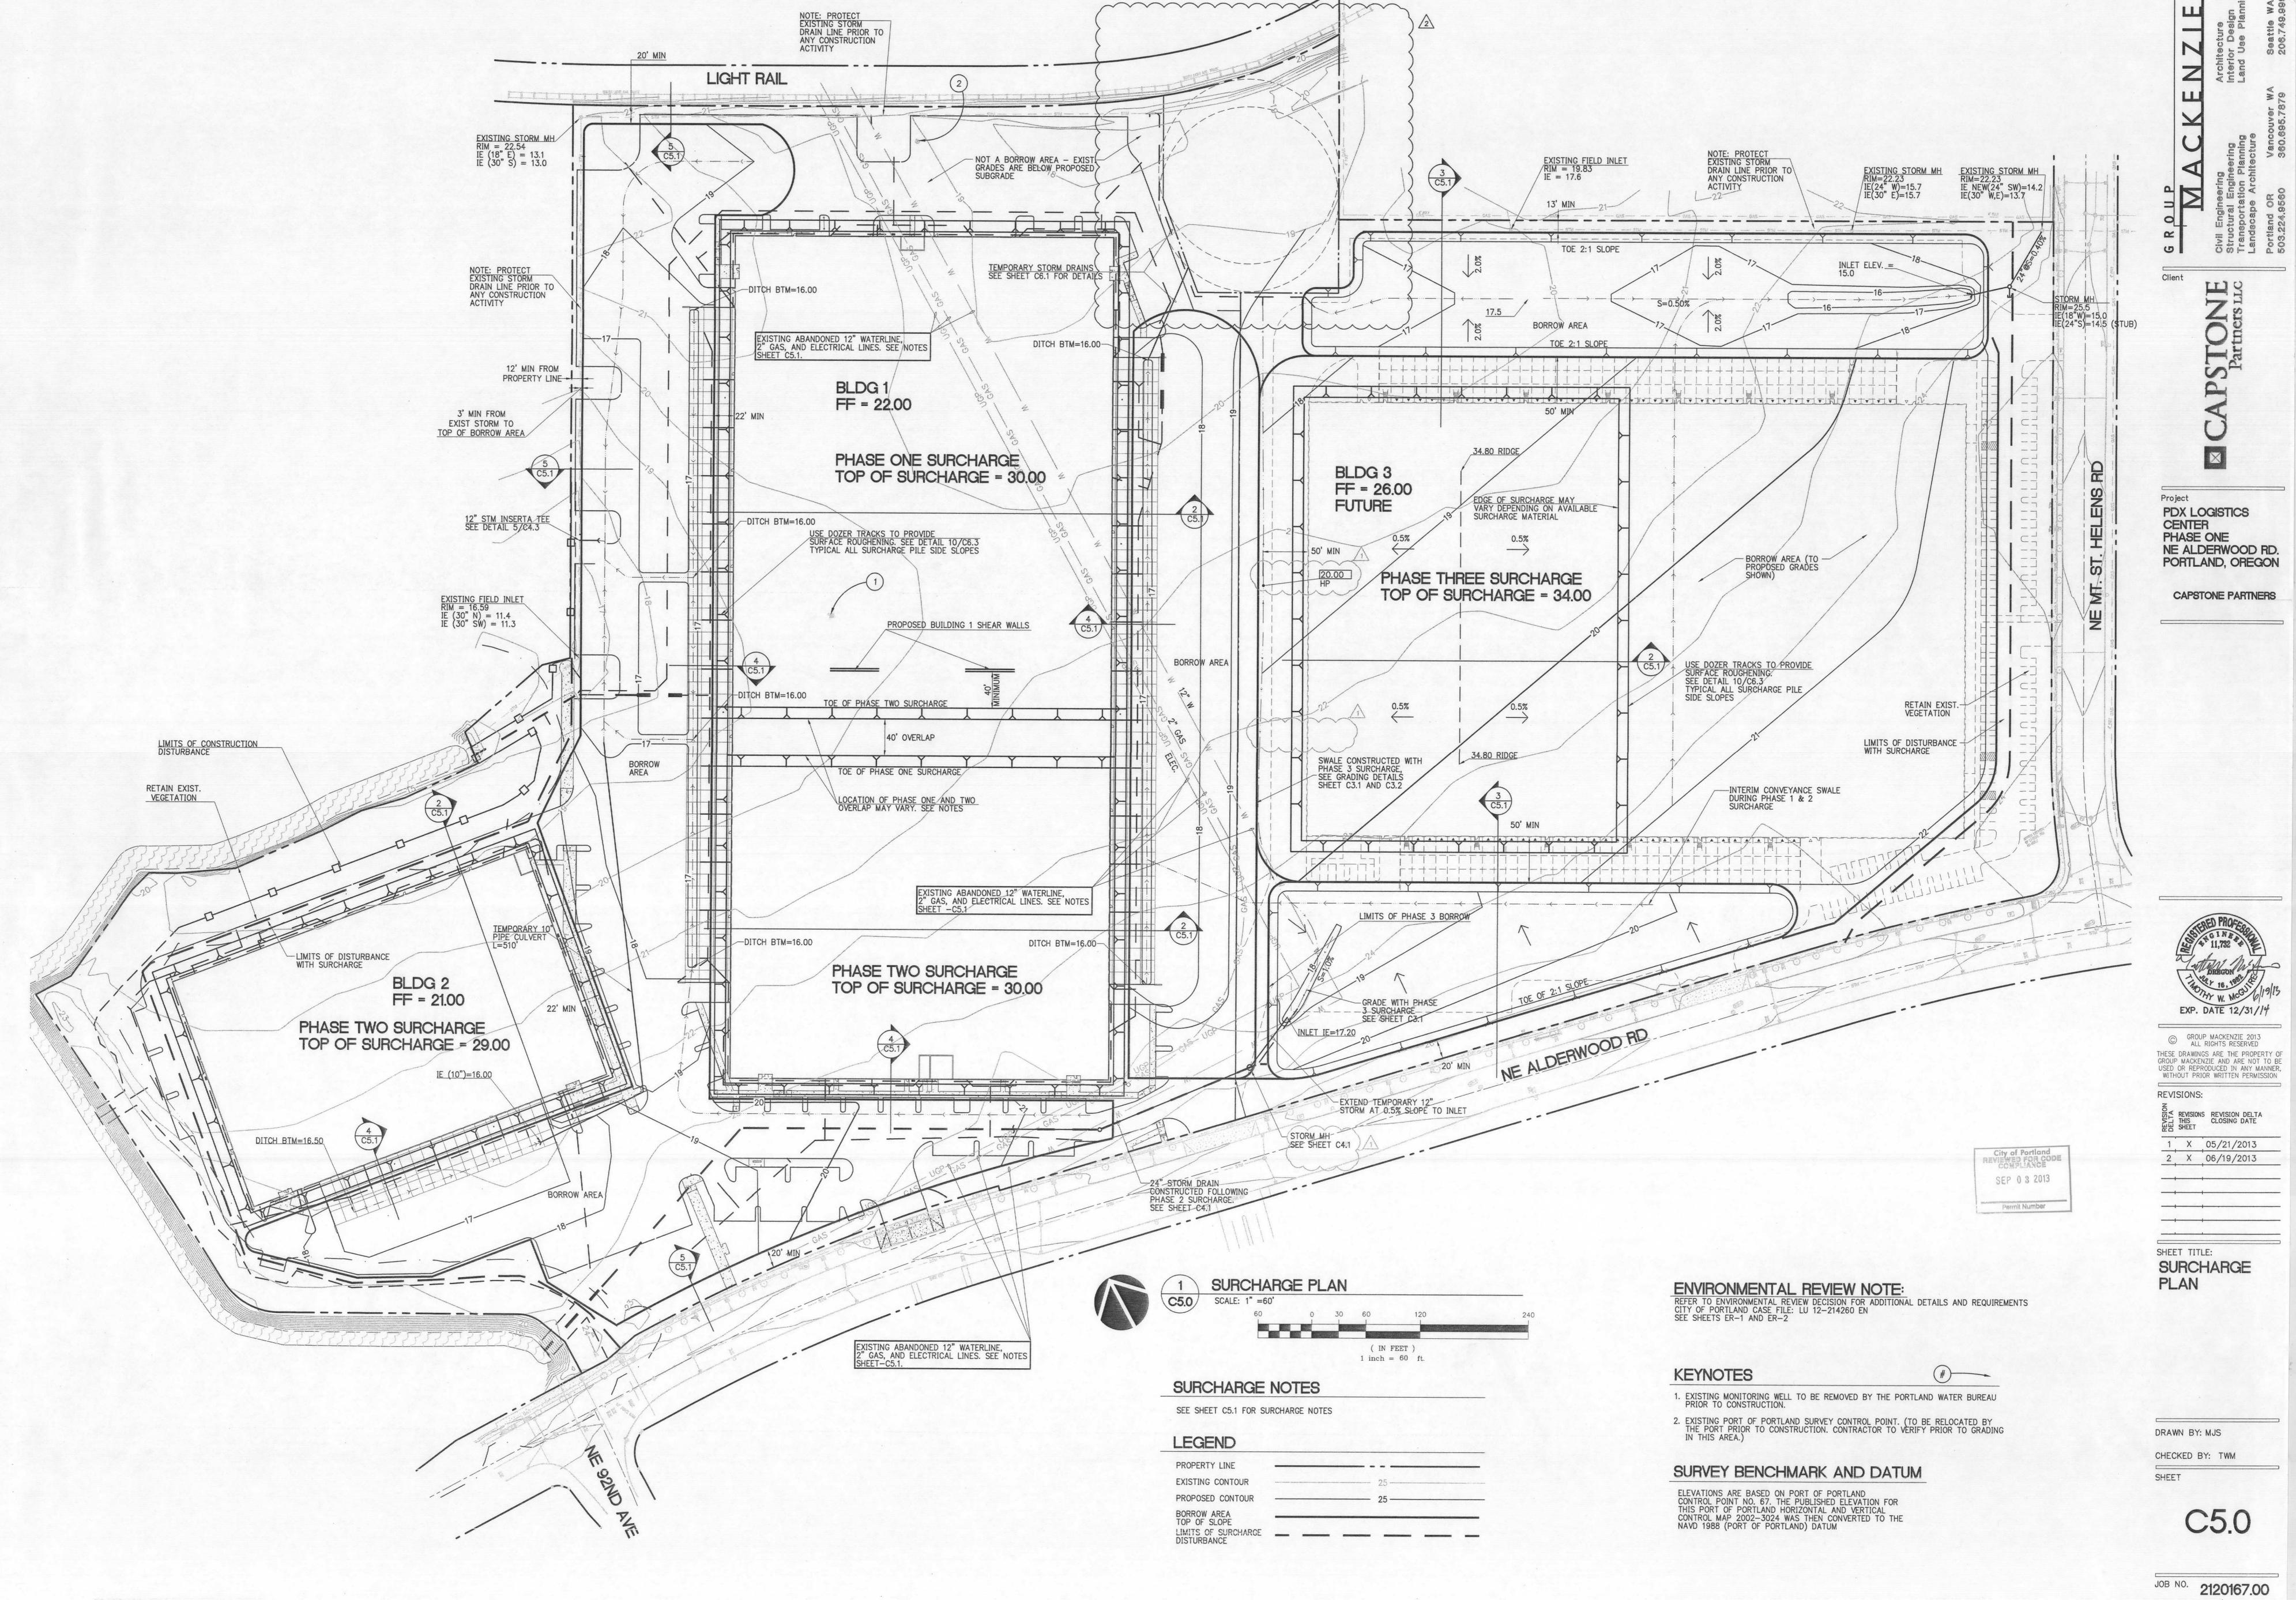


THE SURVEY INFORMATION SHOWN AS A BACKGROUND SCREEN ON THIS SHEET IS SHOWN FOR REFERENCE ONLY AND IS BASED ON A SURVEY BY: NW SURVEYING INC. DATE: AUGUST, 2012

PERMIT SET - 06/19/2013
212016700\CIVIL\167C5-0.DWG BTS 06/19/13 08:31 1:60.00

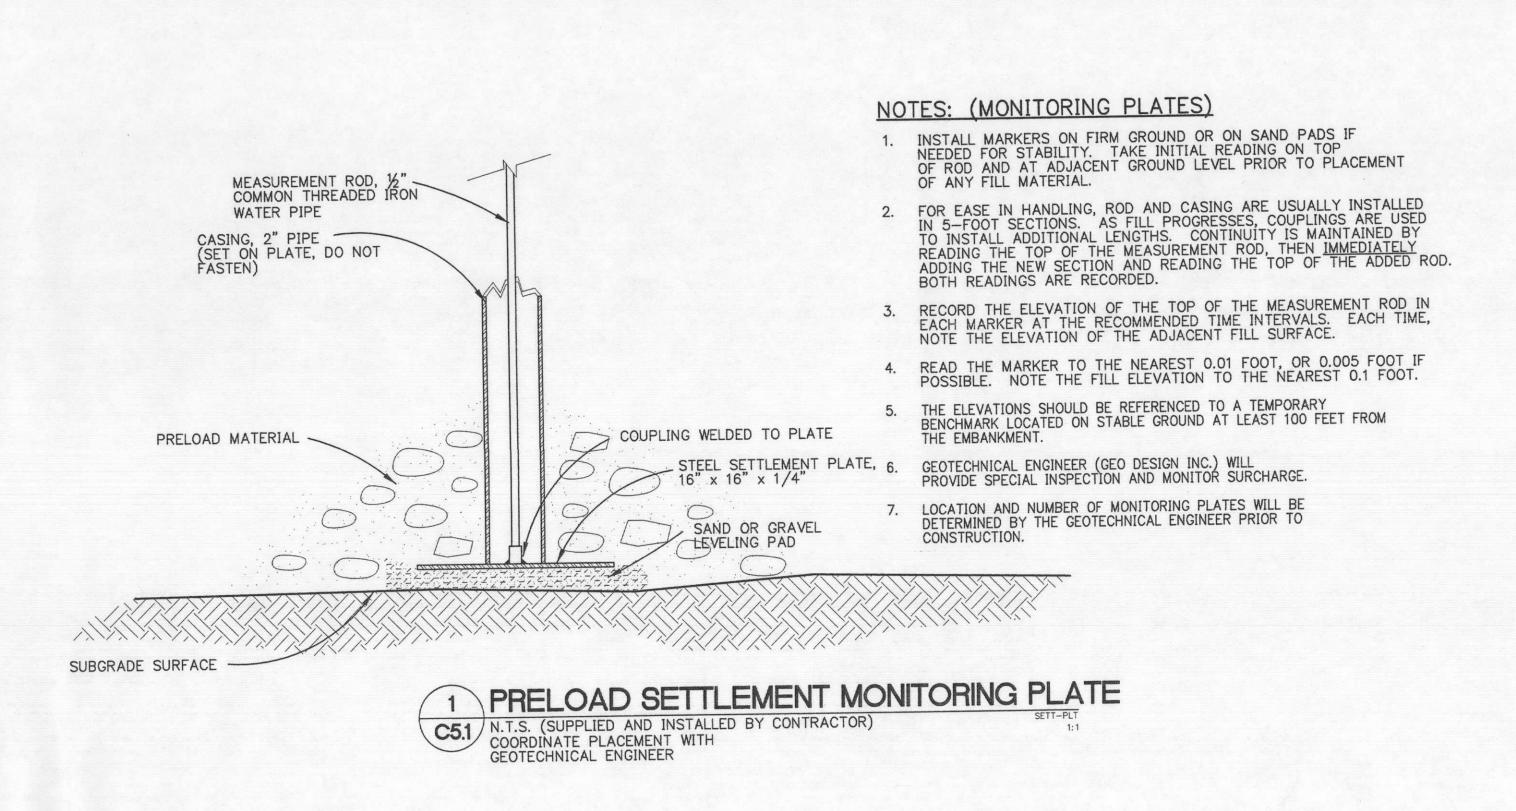

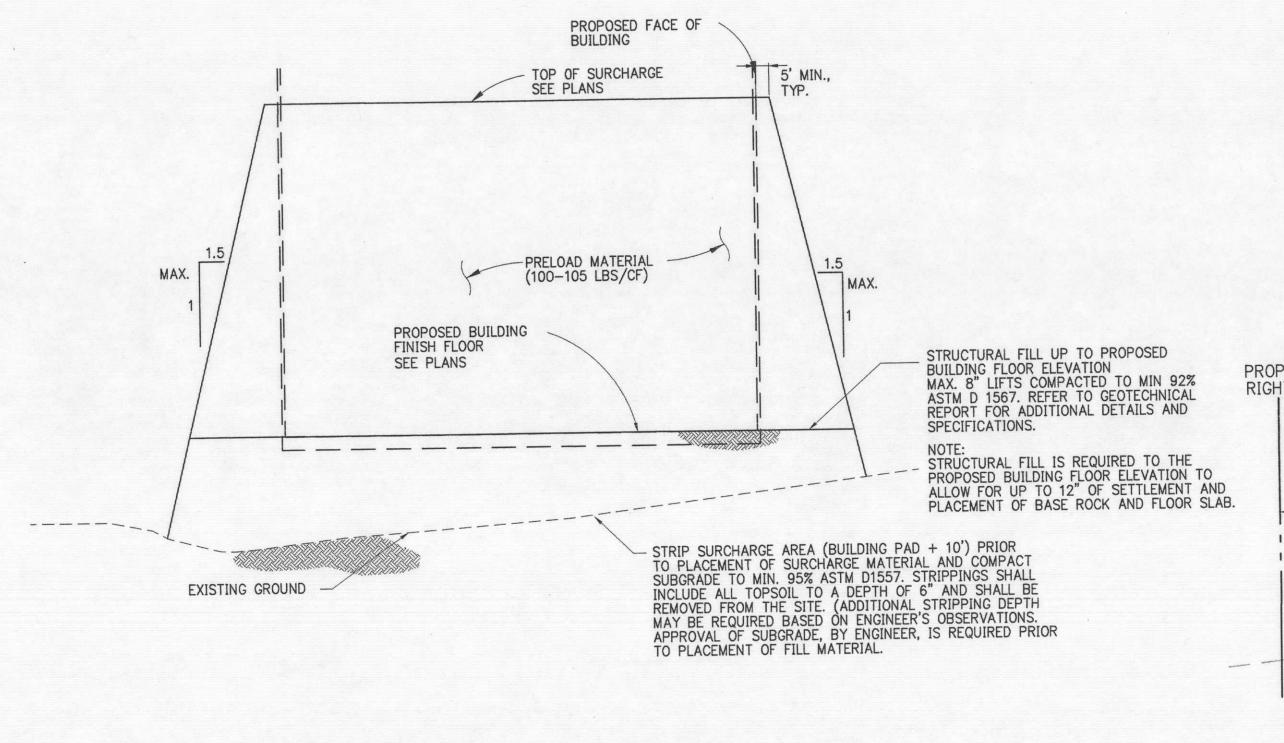

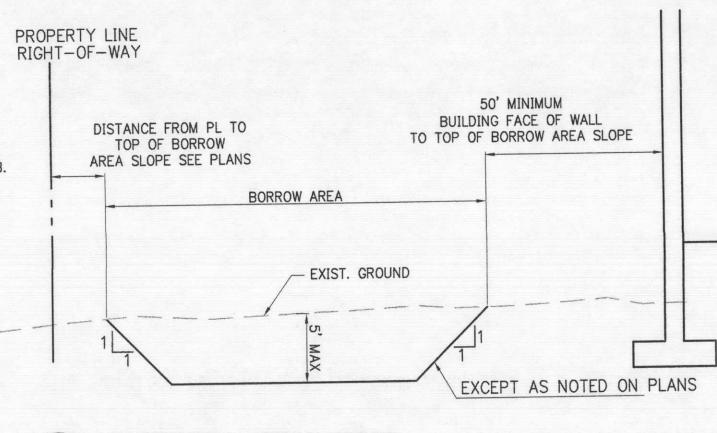

3 BORROW AREA DETAIL
C5.1 N.T.S.

2 SURCHARGE PILE TYP. SECTION C5.1 N.T.S.

TOP OF SURCHARGE

PAVEMENT SUBGRADE

1'
TYP. 2:1 SIDE SLOPES
1' MAX. DEPTH

BORROW AREA DETAIL

C5:1 N.T.S.

LIMITS OF BORROW AREA

AS SHOWN ON PLAN

MAXIMUM DEPTH =
PAVEMENT SUBGRADE

PAVEMENT SUBGRADE

LIMITS OF BORROW AREA

EXIST. GROUND

RETAIN EXIST. VEGETATION
BEYOND BORROW AREA

5 BORROW AREA DETAIL
C5.1 N.T.S.

City of Portland
REVIEWED FOR COD
COMPLIANCE
SEP 0 3 2013

GENERAL SURCHARGE SEQUENCE NOTES:

PHASE 1 SURCHARGE:

- CONSTRUCTS THE SURCHARGE PILE LOCATED ON THE NORTHERLY PART OF BUILDING 1.
 BORROW MATERIAL WILL COME FROM THE TRUCK DOCK AND ASPHALT AREAS SURROUNDING BUILDINGS 1, 2 AND 3 AS SHOWN. ADDITIONAL BORROW MATERIAL WILL COME FROM THE BUILDING 3 FOOTPRINT AS SHOWN. THE
- DEPTH OF THE ALLOWED BORROW IS SHOWN ON THE PLAN AND NOTES.

 3. PHASE 1 SURCHARGE REMAINS IN PLACE FOR APPROXIMATELY 3-4 MONTHS AS DIRECTED BY THE GEOTECHNICAL ENGINEER.

PHASE 2 SURCHARGE:

- 1. MOVES THE PHASE 1 SURCHARGE TO THE SOUTH HALF OF BUILDING 1 AND
- 2. ALL THE MATERIAL TO CONSTRUCT THE PHASE 2 SURCHARGE IS ANTICIPATED TO COME FROM THE PHASE 1 SURCHARGE PILE. NO ADDITIONAL BORROW
- 3. PHASE 2 SURCHARGE REMAINS IN PLACE FOR APPROXIMATELY 3-4 MONTHS AS DIRECTED BY THE GEOTECHNICAL ENGINEER.

PHASE 3 SURCHARGE:

- MOVES THE PHASE 2 SURCHARGE FROM BUILDINGS 1 AND 2 TO THE SURCHARGE LOCATION SHOWN ON THE BUILDING 3 FOOTPRINT.
 THE SURCHARGE IS PLACED AS A STRUCTURAL FILL UP TO THE PROPOSED FLOOR ELEVATION, HOWEVER, DEPENDING ON WEATHER CONDITIONS THIS MAY HAPPEN FOLLOWING THE INITIAL PLACEMENT OF THE BUILDING 3 SURCHARGE.
 THE BORROW AREAS SURROUNDING BUILDING 3 REMAIN AT THE BORROW GRADES SHOWN.
- 4. THE PHASE 3 SURCHARGE REMAINS IN PLACE WITH THE COMPLETION OF BUILDINGS 1 AND 2.

SURCHARGE NOTES

- 1. EXCAVATOR(S) MUST COMPLY WITH O.R.S. 757.541 THROUGH 757.571; EXCAVATOR(S)
 SHALL NOTIFY ALL UTILITY COMPANIES FOR LINE LOCATIONS 72 HOURS (MINIMUM) PRIOR
 TO START OF WORK. DAMAGE TO UTILITIES SHALL BE CORRECTED AT THE CONTRACTOR'S
 EXPENSE. ONE—CALL UTILITY NOTIFICATION CENTER FOR OREGON: 503—246—6699 OR 1—800—332—2344.

 2. THE CONTRACTOR SHALL BE RESPONSIBLE TO NOTIFY THE GEOTECHNICAL ENGINEER 3 DAYS PRIOR TO PLACEM
- 2. THE CONTRACTOR SHALL BE RESPONSIBLE TO NOTIFY THE GEOTECHNICAL ENGINEER 3 DAYS PRIOR TO PLACEMENT OF THE MONITORING PLATES TO ALLOW COORDINATION OF INITIAL READINGS.

 3. THE OWNER WILL PROVIDE A COPY OF THE GEOTECHNICAL REPORT PREPARED BY GEODESIGN.
- 4. EXISTING TOPOGRAPHIC INFORMATION IS BASED ON A SURVEY BY NW SURVEYING INC. DATED AUGUST 2012.
- 5. SETTLEMENT PLATES SHALL BE SURVEYED TWICE PER WEEK DURING SURCHARGE CONSTRUCTION AND IMMEDIATELY FOLLOWING PLACEMENT. CONTINUE TWICE WEEKLY READINGS FOR ONE MONTH FOLLOWING SURCHARGE COMPLETION FOLLOWED BY ONCE WEEKLY THEREAFTER. CONTRACTOR SHALL VERIFY THE SURVEY SCHEDULE WITH THE GEOTECHNICAL ENGINEER PRIOR TO STARTING WORK.
- MONTH FOLLOWING SURCHARGE COMPLETION FOLLOWED BY ONCE WEEKLY THEREAFTER. CONTRACTOR SHALL VERIFY THE SURVEY SCHEDULE WITH THE GEOTECHNICAL ENGINEER PRIOR TO STARTING WORK.

 6. BORROW AREA SHALL BE GRADED AND MAINTAINED SUCH THAT NO STANDING WATER IS ALLOWED TO REMAIN FOLLOWING A RAINFALL EVENT.
- 7. THE LOCATION OF THE PHASE ONE/TWO SURCHARGE OVERLAP MAY VARY DEPENDING ON AVAILABLE MATERIAL. GEOTECHNICAL ENGINEER'S APPROVAL IS REQUIRED PRIOR TO ANY CHANGE IN LOCATION.

EROSION CONTROL

- THE CONTRACTOR SHALL BE RESPONSIBLE TO COMPLY WITH ALL PROVISIONS OF THE DEQ 1200—C PERMIT ISSUED FOR THE PROJECT. IN ADDITION, THE CONTRACTOR SHALL BE RESPONSIBLE TO COMPLY WITH ALL APPLICABLE CITY OF PORTLAND CODES AND REQUIREMENTS RELATED TO SEDIMENT AND EROSION CONTROL.
- 2. SEE THE SURCHARGE EROSION AND SEDIMENT CONTROL PLANS FOR ADDITIONAL DETAILS AND REQUIREMENTS.

MONITORING PLATES

 THE NUMBER AND LOCATION OF MONITORING PLATES WILL BE DETERMINED BY THE GEOTECHNICAL ENGINEER PRIOR TO CONSTRUCTION OF THE SURCHARGE PILE. THE CONTRACTOR SHALL BE RESPONSIBLE TO COORDINATE THIS PRIOR TO CONSTRUCTION.

BORROW AREAS

- 1. BORROW FROM THE AREAS SURROUNDING BUILDINGS 1 AND 2 IS LIMITED TO NO DEEPER THAN THE PROPOSED SUBGRADE DEPTH. (WITH THE EXCEPTIONS OF DRAINAGE DITCHES.
- BORROW FROM THE AREAS NORTH AND SOUTH OF BUILDING 3 IS LIMITED TO NO DEEPER THAN 5 FEET BELOW EXISTING GRADES AND NO CLOSER THAN 50 FEET FROM THE BUILDING FOOTPRINT AS SHOWN.
 BORROW FROM THE BUILDING 3 FOOTPRINT AREA IS LIMITED TO 3 FEET BELOW
- EXISTING GRADES.

 4. RETAIN EXISTING VEGETATION IN ALL AREAS BEYOND THE DESIGNATED BORROW

EXISTING UTILITIES


- PORT GIS RECORDS INDICATE THERE ARE ABANDONED WATER, GAS, AND ELECTRICAL LINES AS SHOWN ON THE PLAN.
- 2. THE CONTRACTOR SHALL BE RESPONSIBLE TO POTHOLE, IN A MINIMUM OF 3 LOCATIONS, AND CONFIRM THE LOCATION OF THE UTILITIES (IT IS UNKNOWN IF THE UTILITIES HAVE BEEN REMOVED OR ARE ABANDONED IN PLACE).
- THE 12" WATERLINE SHALL BE REMOVED (IF IT EXISTS) AND ALL EXCAVATIONS BACKFILLED AS REQUIRED BY THE SPECIFICATIONS AND GEOTECHNICAL REPORT.

SEEDING NOTES

- 1. ALL BUILDING 3 AREA SEEDED W/ INITIAL EXCAVATION
- 2. BUILDING 3 SURCHARGE PILE SEEDED ONCE PLACED

PRECONSTRUCTION MEETING

- 1. A PRECONSTRUCTION MEETING INCLUDING, AT A MINIMUM, PORT STAFF, GENERAL CONTRACTOR, AND EXCAVATOR IS REQUIRED PRIOR TO CONSTRUCTION. THE CONTRACT SHALL BE RESPONSIBLE TO SCHEDULE THE FOLLOWING MEETINGS.
 - A. MEETING PRIOR TO FIRST SURCHARGING
 - B. MEETING PRIOR TO MOVING FIRST SURCHARGE PILE
 - C. MEETING PRIOR TO MOVING SURCHARGE TO PHASE TWO

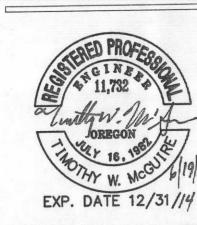

N

Project

CENTER

PHASE ONE

PDX LOGISTICS

NE ALDERWOOD RD. PORTLAND, OREGON

CAPSTONE PARTNERS

GROUP MACKENZIE 2013
ALL RIGHTS RESERVED

THESE DRAWINGS ARE THE PROPERTY OF
GROUP MACKENZIE AND ARE NOT TO BE
USED OR REPRODUCED IN ANY MANNER,
WITHOUT PRIOR WRITTEN PERMISSION

REVISIONS:

REVISIONS REVISION DELTA CLOSING DATE

1 X 05/21/2013
2 06/19/2013

SHEET TITLE:

SURCHARGE


DRAWN BY: MJS


SHEET

CHECKED BY: TWM

JOB NO. **2120167.00**

EROSION AND SEDIMENT CONTROL PLANS

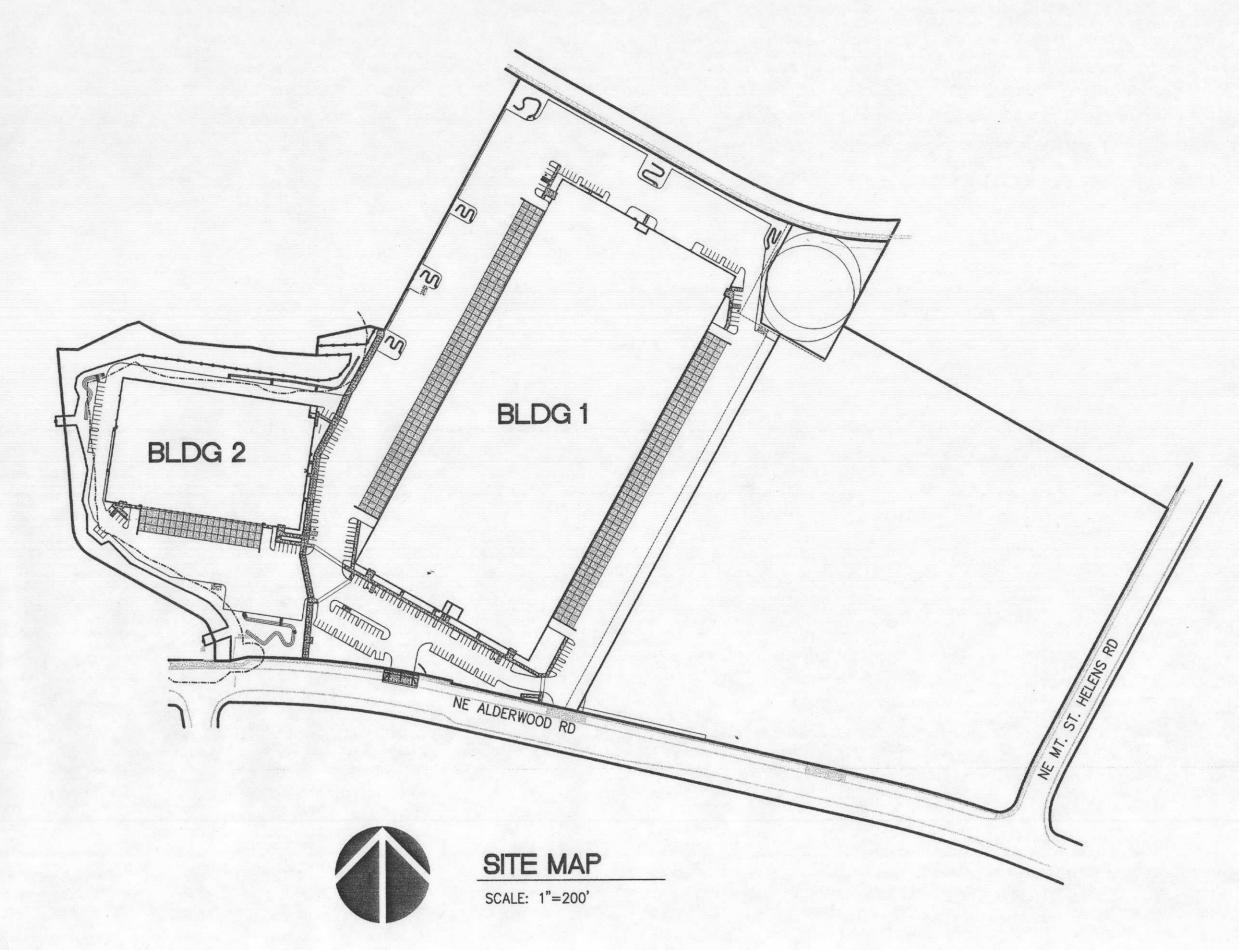

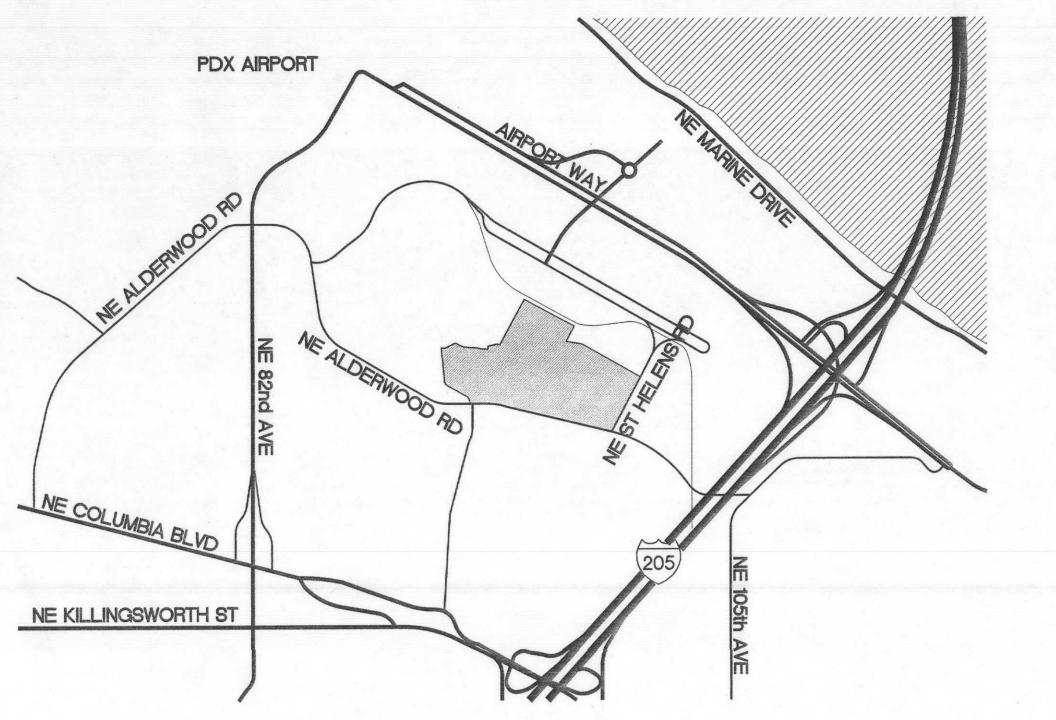



NW CORNER OF INTERSECTION OF NE ALDERWOOD RD AND NE MT. ST. HELENS RD PORTLAND, OR LATITUDE = 45'34'16" N LONGITUDE = -122'33'57" W

PROPERTY DESCRIPTION: TAX LOTS 100 AND 200 SECTION 16, TOWNSHIP 1 NORTH, RANGE 2 EAST, WILLAMETTE MERIDIAN, MULTNOMAH COUNTY, OREGON

ATTENTION EXCAVATORS: OREGON LAW REQUIRES YOU TO FOLLOW RULES ADOPTED BY THE OREGON UTILITY NOTIFICATION CENTER. THOSE RULES ARE SET FORTH IN OAR 952-001-0010 THROUGH OAR 952-001-0090. YOU MAY OBTAIN COPIES OF THESE RULES FROM THE CENTER BY CALLING 503-232-1987. IF YOU HAVE ANY QUESTIONS ABOUT THE RULES, YOU MAY CONTACT THE CENTER. YOU MUST NOTIFY THE CENTER AT LEAST TWO BUSINESS DAYS, BEFORE COMMENCING AN EXCAVATION. CALL 503-246-6699.

DEVELOPER CAPSTONE PARTNERS LLC CONTACT: LAUREN GOLDEN-JONES 1015 NW 11TH AVENUE, SUITE 243 PORTLADN OR 97209 PHONE: 503-228-1972

PHONE: 503-224-9560

PHONE: 503-848-2127

FAX: 503-848-2179

FAX: 503-228-1285

ARCHITECT GROUP MACKENZIE CONTACT: BOB THOMPSON 1515 SE WATER AVE, SUITE 100 PORTLAND, OR 97214 PHONE: 503-224-9560 FAX: 503-228-1285

CIVIL ENGINEER GROUP MACKENZIE CONTACT: TIM MCGUIRE 1515 SE WATER AVE, SUITE 100 PORTLAND, OR 97214

LANDSCAPE ARCHITECT GROUP MACKENZIE CONTACT: ROBIN LAUGHLIN 1515 SE WATER AVE, SUITE 100 PORTLAND, OR 97214 PHONE: 503-224-9560 FAX: 503-228-1285

NORTHWEST SURVEYING, INC. CONTACT: SCOTT FIELD 1815 NW 169TH PLACE, SUITE 2090 BEAVERTON, OR 97006

GEOTECHNICAL CONTACT: GEORGE SAUNDERS 15575 SW SEQUOIA PRKY PORTLAND, OR 97224 PHONE: 503-968-8787

NARRATIVE DESCRIPTION EXISTING SITE CONDITIONS

* VACANT FIELD

1% TO 5% SLOPES , DEVELOPED CONDITIONS

* TWO INDUSTRIAL BUILDINGS AND PARKING FACILITIES

NATURE OF CONSTRUCTION ACTIVITY AND ESTIMATED TIME TABLE

* CLEARING AND DEMOLITION (JULY 2013) * GRADING/SURCHARGE (JULY 2013- JANUARY 2014)

* UTILITY INSTALLATION (MARCH 2014 - JUNE 2014) * SITE CONSTRUCTION (NOVEMBER 2013- SEPTEMBER 2014) * FINAL STABILIZATION (SEPTEMBER 2014)

TOTAL SITE AREA = 1,949,100 SF = 44.7 ACRES

TOTAL DISTURBED AREA = 1,949,100 SF = 44.7 ACRES

SITE SOIL CLASSIFICATION:

SAUVIE SILT-LOAM

ON-SITE SOILS HAVE A SLIGHT EROSION POTENTIAL. ALL FILL MATERIAL SHALL BE GENERATED ON-SITE FROM GRADING EXCAVATION AND UTILITY TRENCH SPOILS.

RECEIVING WATER BODIES:

ALL STORM RUNOFF TO BE TREATED ON SITE AND CONVEYED TO THE PUBLIC STORM SEWER. EVENTUALLY STORMWATER IS RECEIVED BY THE COLUMBIA RIVER.

PERMITTEE'S SITE INSPECTOR: FRED LUTZ
COMPANY/AGENCY: PERLO CONSTRUCTION
PHONE: (503) 704-0967
FAX: (503) 639-4134
E-MAIL: FLUTZ@PERLO.BIZ
DESCRIPTION OF EXPERIENCE: OVER 15 YEARS IN THE COMMERCIAL
CONSTRUCTION BUSINESS. OVER 200 HOURS OF INSPECTION AND
OBSERVATION OF EROSION MEASURES.

STANDARD EROSION AND SEDIMENT CONTROL PLAN DRAWING NOTES:

TO DISCUSS EROSION AND SEDIMENT CONTROL MEASURES AND CONSTRUCTION LIMITS. (SCHEDULE A.8.C.I.(3)) ALL INSPECTIONS MUST BE MADE IN ACCORDANCE WITH DEQ 1200-C PERMIT REQUIREMENTS. INSPECTION LOGS MUST BE KEPT IN ACCORDANCE WITH DEQ'S 1200-C PERMIT REQUIREMENTS RETAIN A COPY OF THE ESCP AND ALL REVISIONS ON SITE AND MAKE IT AVAILABLE ON REQUEST TO DEQ. AGENT, OR THE LOCAL MUNICIPALITY. DURING INACTIVE PERIODS OF GREATER THAN SEVEN (7) CONSECUTIVE CALENDAR DAYS, RETAIN THE ESCP AT THE CONSTRUCTION SITE OR AT ANOTHER LOCATION. (SCHEDULE B.2.A) ALL PERMIT REGISTRANTS MUST IMPLEMENT THE ESCP. FAILURE TO IMPLEMENT ANY OF THE CONTROL MEASURÉS OR PRACTICES DESCRIBED IN THE ESCP IS A VIOLATION OF THE PERMIT. (SCHEDULE A 8.A) THE ESCP MEASURES SHOWN ON THIS PLAN ARE MINIMUM REQUIREMENTS FOR ANTICIPATED SITE CONDITIONS DURING THE CONSTRUCTION PERIOD, UPGRADE THESE MEASURES AS NEEDED TO COMPLY WITH ALL APPLICABLE LOCAL, STATE, AND FEDERAL EROSION AND SEDIMENT CONTROL REGULATIONS. (SCHEDULE A.B.C.II.(1)(C)) SUBMISSION OF ALL ESCP REVISIONS IS NOT REQUIRED. SUBMITTAL OF THE ESCP REVISIONS IS ONLY UNDER SPECIFIC CONDITIONS. SUBMIT ALL NECESSARY REVISION TO DEQ OR AGENT. (SCHEDULE A.12.C.III) PHASE CLEARING AND GRADING TO THE MAXIMUM EXTENT PRACTICAL TO PREVENT EXPOSED INACTIVE AREAS FROM BECOMING A SOURCE OF EROSION. (SCHEDULE A 8.C.II.(1)(D))

IDENTIFY, MARK, AND PROTECT (BY FENCING OFF OR OTHER MEANS) CRITICAL RIPARIAN AREAS AND VEGETATION INCLUDING IMPORTANT TREES AND ASSOCIATED ROOTING ZONES, AND VEGETATION AREAS TO BE PRESERVED. IDENTIFY VEGETATIVE BUFFER ZONES BETWEEN THE SITE AND SENSITIVE AREAS (E.G., WETLANDS), AND OTHER AREAS TO BE PRESERVED, ESPECIALLY IN PERIMETER AREAS. (SCHEDULE A.8.C.I.(1) & (2)) PRESERVE EXISTING VEGETATION WHEN PRACTICAL AND RE-VEGETATE OPEN AREAS. RE-VEGETATE OPEN AREAS

WHEN PRACTICABLE BEFORE AND AFTER GRADING OR CONSTRUCTION. IDENTIFY THE TYPE OF VEGETATIVE SEED MIX USED. (SCHEDULE A.7.B.III(1) AND A.7.B.III(3)) EROSION AND SEDIMENT CONTROL MEASURES INCLUDING PERIMETER SEDIMENT CONTROL MUST BE IN PLACE BEFORE VEGETATION IS DISTURBED AND MUST REMAIN IN PLACE AND BE MAINTAINED, REPAIRED, AND PROMPTLY MPLEMENTED FOLLOWING PROCEDURES ESTABLISHED FOR THE DURATION OF CONSTRUCTION, INCLUDING

PROTECTION FOR ACTIVE STORM DRAIN INLETS AND CATCH BASINS AND APPROPRIATE NON-STORMWATER POLLUTION CONTROLS. (SCHEDULE A.7.D.I AND A.8.C) 12. ESTABLISH CONCRETE TRUCK AND OTHER CONCRETE EQUIPMENT WASHOUT AREAS BEFORE BEGINNING CONCRETE WORK. (SCHEDULE A.8.C.I.(6))

13. APPLY TEMPORARY AND/OR PERMANENT SOIL STABILIZATION MEASURES IMMEDIATELY ON ALL DISTURBED AREAS AS GRADING PROGRESSES AND FOR ALL ROADWAYS INCLUDING GRAVEL ROADWAYS. (SCHEDULE A.8.C.II.(2)) 14. ESTABLISH MATERIAL AND WASTE STORAGE AREAS, AND OTHER NON-STORMWATER CONTROLS. (SCHEDULE

15. PREVENT TRACKING OF SEDIMENT ONTO PUBLIC OR PRIVATE ROADS USING BMPS SUCH AS: GRAVELED (OF PAVED) EXITS AND PARKING AREAS, GRAVEL ALL UNPAVED ROADS LOCATED ONSITE, OR USE AN EXIT TIRE WASH. THESE BMPS MUST BE IN PLACE PRIOR TO LAND-DISTURBING ACTIVITIES. (SCHEDULE A 7.D.II.(1) AND A.8.C.I(4)) 16. WHEN TRUCKING SATURATED SOILS FROM THE SITE, EITHER USE WATER-TIGHT TRUCKS OR DRAIN LOADS ON

SITE. (SCHEDULE A.7.D.II.(3)) 7. USE BMPS TO PREVENT OR MINIMIZE STORMWATER EXPOSURE TO POLLUTANTS FROM SPILLS; VEHICLE, AND EQUIPMENT FUELING, MAINTENANCE, AND STORAGE; OTHER CLEANING AND MAINTENANCE ACTIVITIES; AND WASTE HANDLING ACTIVITIES. THESE POLLUTANTS INCLUDE FUEL, HYDRAULIC FLUID, AND OTHER OILS FROM VEHICLES AND MACHINERY, AS WELL AS DEBRIS, LEFTOVER PAINTS, SOLVENTS, AND GLUES FROM CONSTRUCTION

OPERATIONS. (SCHEDULE A.7.E.I.(2)) 18. IMPLEMENT THE FOLLOWING BMPS WHEN APPLICABLE: WRITTEN SPILL PREVENTION AND RESPONSE PROCEDURES, EMPLOYEE TRAINING ON SPILL PREVENTION AND PROPER DISPOSAL PROCEDURES, SPILL KITS IN ALL VEHICLES, REGULAR MAINTENANCE SCHEDULE FOR VEHICLES AND MACHINERY, MATERIAL DELIVERY AND STORAGE CONTROL TRAINING AND SIGNAGE, AND COVERED STORAGE AREAS FOR WASTE AND SUPPLIES. (SCH A 7.E.III.) 19. USE WATER, SOIL-BINDING AGENT OR OTHER DUST CONTROL TECHNIQUE AS NEEDED TO AVOID WIND-BLOWN

SOIL. (SCHEDULE A 7.B.II) 20. THE APPLICATION RATE OF FERTILIZERS USED TO REESTABLISH VEGETATION MUST FOLLOW MANUFACTURER'S RECOMMENDATIONS TO MINIMIZE NUTRIENT RELEASES TO SURFACE WATERS. EXERCISE CAUTION WHEN USING TIME-RELEASE FERTILIZERS WITHIN ANY WATERWAY RIPARIAN ZONE. (SCHEDULE A.9.B.III) 21. IF A STORMWATER TREATMENT SYSTEM (FOR EXAMPLE, ELECTRO-COAGULATION, FLOCCULATION, FILTRATION, ETC.) FOR SEDIMENT OR OTHER POLLUTANT REMOVAL IS EMPLOYED, SUBMIT AN OPERATION AND MAINTENANCE PLAN (INCLUDING SYSTEM SCHEMATIC, LOCATION OF SYSTEM, LOCATION OF INLET, LOCATION OF DISCHARGE, DISCHARGE DISPERSION DEVICE DESIGN, AND A SAMPLING PLAN AND FREQUENCY) BEFORE OPERATING THE

TREATMENT SYSTEM, OBTAIN PLAN APPROVAL BEFORE OPERATING THE TREATMENT SYSTEM. OPERATE AND MAINTAIN THE TREATMENT SYSTEM ACCORDING TO MANUFACTURER 1/16S SPECIFICATIONS. (SCHEDULE A.9.D) 22. TEMPORARILY STABILIZE SOILS AT THE END OF THE SHIFT BEFORE HOLIDAYS AND WEEKENDS, IF NEEDED. TH REGISTRANT IS RESPONSIBLE FOR ENSURING THAT SOILS ARE STABLE DURING RAIN EVENTS AT ALL TIMES OF

23. AT THE END OF EACH WORKDAY SOIL STOCKPILES MUST BE STABILIZED OR COVERED, OR OTHER BMPS MUST B IMPLEMENTED TO PREVENT DISCHARGES TO SURFACE WATERS OR CONVEYANCE SYSTEMS LEADING TO SURFACE 24. CONSTRUCTION ACTIVITIES MUST AVOID OR MINIMIZE EXCAVATION AND CREATION OF BARE GROUND DURING WE

WEATHER. (SCHEDULE A.7.A.I) 25. SEDIMENT FENCE: REMOVE TRÁPPED SEDIMENT BEFORE IT REACHES ONE THIRD OF THE ABOVE GROUND FENCE HEIGHT AND BEFORE FENCE REMOVAL. (SCHEDULE A.9.C.I) 26. OTHER SEDIMENT BARRIERS (SUCH AS BIOBAGS): REMOVE SEDIMENT BEFORE IT REACHES TWO INCHES DEPTH ABOVE GROUND HEIGHT, AND BEFORE BMP REMOVAL. (SCHEDULE A.9.C.II)

27. CATCH BASINS: CLEAN BEFORE RETENTION CAPACITY HAS BEEN REDUCED BY FIFTY PERCENT. SEDIMENT BASINS AND SEDIMENT TRAPS: REMOVE TRAPPED SEDIMENTS BEFORE DESIGN CAPACITY HAS BEEN REDUCED BY FIFTY PERCENT AND AT COMPLETION OF PROJECT. (SCHEDULE A.9.C.III & IV)
28. WITHIN 24 HOURS, SIGNIFICANT SEDIMENT THAT HAS LEFT THE CONSTRUCTION SITE, MUST BE REMEDIATED.

INVESTIGATE THE CAUSE OF THE SEDIMENT RELEASE AND IMPLEMENT STEPS TO PREVENT A RECURRENCE O THE DISCHARGE WITHIN THE SAME 24 HOURS. ANY IN-STREAM CLEAN UP OF SEDIMENT SHALL BE PERFORMED ACCORDING TO THE OREGON DIVISION OF STATE LANDS REQUIRED TIMEFRAME. (SCHEDULE A.9.B.I) 29. THE INTENTIONAL WASHING OF SEDIMENT INTO STORM SEWERS OR DRAINAGE WAYS MUST NOT OCCUR.

VACUUMING OR DRY SWEEPING AND MATERIAL PICKUP MUST BE USED TO CLEANUP RELEASED SEDIMENTS. 30. THE ENTIRE SITE MUST BE TEMPORARILY STABILIZED USING VEGETATION OR A HEAVY MULCH LAYER, TEMPORARY SEEDING, OR OTHER METHOD SHOULD ALL CONSTRUCTION ACTIVITIES CEASE FOR 30 DAYS OR MORE.

1. PROVIDE TEMPORARY STABILIZATION FOR THAT PORTION OF THE SITE WHERE CONSTRUCTION ACTIVITIES CEASE FOR 14 DAYS OR MORE WITH A COVERING OF BLOWN STRAW AND A TACKIFIER, LOOSE STRAW, OR AN ADEQUATE COVERING OF COMPOST MULCH UNTIL WORK RESUMES ON THAT PORTION OF THE SITE. (SCHEDULE A.7.F.II) PROVIDE PERMANENT EROSION CONTROL MEASURES ON ALL EXPOSED AREAS. DO NOT REMOVE TEMPORARY SEDIMENT CONTROL PRACTICES UNTIL PERMANENT VEGETATION OR OTHER COVER OF EXPOSED AREAS IS ESTABLISHED. HOWEVER, DO REMOVE ALL TEMPORARY EROSION CONTROL MEASURES AS EXPOSED AREAS BECOME STABILIZED, UNLESS DOING SO CONFLICTS WITH LOCAL REQUIREMENTS. PROPERLY DISPOSE OF CONSTRUCTION MATERIALS AND WASTE, INCLUDING SEDIMENT RETAINED BY TEMPORARY BMPS. (SCHEDULE A.7.B.III(2) AND

LOCAL AGENCY-SPECIFIC EROSION CONTROL NOTES:

OWNER OR DESIGNATED PERSON SHALL BE RESPONSIBLE FOR PROPER INSTALLATION AND MAINTENANCE OF ALL EROSION AND SEDIMENT CONTROL MEASURES, IN ACCORDANCE WITH LOCAL, STATE, AND FEDERAL REGULATIONS. PRIOR TO ANY LAND DISTURBING ACTIVITIES, THE BOUNDARIES OF THE CLEARING LIMITS, VEGETATED BUFFERS, AND ANY SENSITIVE AREAS SHOWN ON THIS PLAN SHALL BE CLEARLY DELINEATED IN THE FIELD. DURING THE CONSTRUCTION PERIOD, NO DISTURBANCE IS PERMITTED BEYOND THE CLEARING LIMITS. THE OWNER/PERMITTEE MUS MAINTAIN THE DELINEATION FOR THE DURATION OF THE PROJECT. NOTE: VEGETATED CORRIDORS TO BE DELINEATED WITH ORANGE CONSTRUCTION FENCE OR APPROVED EQUAL. 3. PRIOR TO ANY LAND DISTURBING ACTIVITIES, THE BMP'S THAT MUST BE INSTALLED ARE A GRAVEL CONSTRUCTION

ENTRANCE, PERIMETER SEDIMENT CONTROL, AND INLET PROTECTION. THESE BMP'S MUST BE MAINTAINED FOR THE 4. IF VEGETATIVE SEED MIXES ARE SPECIFIED, SEEDING MUST TAKE PLACE NO LATER THAT SEPTEMBER 1; THE TYPE AND

PERCENTAGES OF SEED IN THE MIX MUST BE IDENTIFIED ON THE PLANS. THE ESC PLAN MUST BE KEPT ON SITE. ALL MEASURES SHOWN ON THE PLAN MUST BE INSTALLED PROPERLY TO

THE CONSTRUCTION PERIOD, THESE MEASURES SHALL BE UPGRADED AS NEEDED TO COMPLY WITH ALL APPLICABLE LOCAL STATE, AND FEDERAL EROSION CONTROL REGULATIONS. CHANGES TO THE APPROVED ESC PLAN MUST BE SUBMITTED IN THE FORM OF AN ACTION PLAN TO DEQ PER THE 1200 C PERMIT.

8. IN AREAS SUBJECT TO WIND EROSION, APPROPRIATE BMP'S MUST BE USED WHICH MAY INCLUDE THE APPLICATION OF FINE WATER SPRAYING, PLASTIC SHEETING, MULCHING, OR OTHER APPROVED MEASURES. 9. ALL EXPOSED SOILS MUST BE COVERED DURING THE WET WEATHER PERIOD.

BMP MATRIX FOR CONSTRUCTION PHASES

REFER TO DEQ GUIDANCE MANUAL FOR A COMPREHENSIVE LIST OF

YEAR:	2013	3						2014	1							To and			
BMPs Month#:	06	07	08	09	10	11	12	01	02	03	04	05	06	07	08	09	10		
Pipe Slope Drains																			
Energy Dissipaters																			
Temporary Diversion Dikes																	77		
Check Dams	X	X	X	X	X	X	X	X	X	X	X	X	X	X	X	X	X		,
Temporary Seeding and Planting		A	-		X	X	X	X	X.	_X	X	X	X	X	X	X	X		
Permanent Seeding and Planting	1000	111	(X	X	Х	X	X	X	X	X)	X	X	X	X	X	X	X		
Mycorrhizae/ Biofertilizers														100					
Mulches (Specify Type)	- :	1										100				100			
Construction Entrance	X	X	X	X	X	X	X	X	X	X	X	X	X	X	X	X	X		
Compost Blankets													100				.0		-
Compost Socks											111111111111111111111111111111111111111	Jan 19							
Compost Berm																			-
Soil Tackifiers	X	X	X	X	X	X	X	X	X	X	X	X	X	X	X	X	X		_
Sodding Vegetative Buffer Strips															-				
Sediment Fencing	X	X	X	X	X	X	X	X	X	X	X	X	X	X	X	X	X		
Erosion Control Blankets & Mats (Specify type)																			-
Earth Dikes (Stabilized)																77	77		
Drainage Swales	X	X	X	X	X	X	X	X	X	X	X	X	X	X	X	X	X	4	
Rock Outlet Protection	X	X	X	X	X	X	X	X	X	X	X	X	X	X	X	X	X		*
Plastic Sheeting																			-
Sediment Trap																			_
Straw Wattles (Loose compaction rice straw)													-	-					
Storm Drain Inlet Protection	X	X	X	X	X	X	X	X	X	X	X	X	X	X	X	X	X		
Temporary or Permanent Sedimentation Basins							1								-				
Unpaved roads graveled or other BMP on the road		1	1	TV	1	1		1	1	1				-	-	-			-
Dewatering (treatment location, schematic, & sampling plan required)										X	X	X	X	X	X	X	X		_
Paving Operations Controls							-			K	X	X	X	X	X	X	X		
Concrete Truck Washout										/X	X	X	X	X	X	X	X		



INSPECTION FREQUENCY:

	SITE CONDITION	MINIMUM FREQUENCY
1.	ACTIVE PERIOD	DAILY WHEN STORMWATER RUNOFF, INCLUDING RUNOFF FROM SNOWMELT, IS OCCURRING. AT LEAST ONCE EVERY TWO WEEKS, REGARDLESS OF WHETHER OR NOT RUNOFF IS OCCURRING.
2.	PRIOR TO SITE BECOMING INACTIVE OR IN ANTICIPATION OF SITE INACCESSIBILITY	ONCE TO ENSURE THAT EROSION AND SEDIMENT CONTROL MEASURES ARE IN WORKING ORDER. ANY NECESSARY MAINTENANCE AND REPAIR MUST BE MADE PRIOR TO LEAVING THE SITE
3.	INACTIVE PERIODS GREATER THAN (7) CONSECUTIVE CALENDAR DAYS	ONCE EVERY (2) TWO WEEKS
4.	PERIODS AT WHICH THE SITE IS INACCESSIBLE DUE TO INCLEMENT WEATHER	IF PRACTICAL, INSPECTIONS MUST OCCUR DAILY AT A RELEVANT AND ACCESSIBLE DISCHARGE POINT OR DOWNSTREAM LOCATION.

DEQ 1200-C PERMIT

THE PERMITTEE IS REQUIRED TO MEET ALL THE CONDITIONS OF THE 1200C PERMIT ISSUED FOR THIS PROJECT. THIS ESCP AND GENERAL CONDITIONS HAVE BEEN DEVELOPED TO FACILITATE COMPLIANCE WITH THE 1200C PERMIT REQUIREMENTS. IN CASES OF DISCREPANCIES OR OMISSIONS, THE 1200C PERMIT REQUIREMENTS SUPERCEDE REQUIREMENTS OF THIS PLAN.

RATIONALE STATEMENT

A COMPREHENSIVE LIST OF AVAILABLE BEST MANAGEMENT PRACTICES (BMP) OPTIONS BASED ON DEQ'S GUIDANCE MANUAL HAS BEEN REVIEWED TO COMPLETE THIS EROSION AND SEDIMENT CONTROL PLAN. SOME OF THE ABOVE LISTED BMP's WERE NOT CHOSEN BECAUSE THEY WERE DETERMINED TO NOT EFFECTIVELY MANAGE EROSION PREVENTION AND SEDIMENT CONTROL FOR THIS PROJECT BASED ON SPECIFIC SITE CONDITIONS, INCLUDING SOIL CONDITIONS TOPOGRAPHIC CONSTRAINTS, ACCESSIBILITY TO THE SITE, AND OTHER RELATED CONDITIONS, AS THE PROJECT PROGRESSES AND THERE IS A NEED TO REVISE THE ESC PLAN, AN ACTION PLAN WILL BE SUBMITTED. TIM MCGUIRE

SHEET INDEX

CLEARING AND SURCHARGE EROSION AND SEDIMENT CONTROL PLAN

BUILDING AND UTILITY CONSTRUCTION

C6.3 EROSION AND SEDIMENT CONTROL DETAILS

EROSION AND SEDIMENT CONTROL PLANS

C6.0 EROSION AND SEDIMENT CONTROL COVER SHEET

EROSION AND SEDIMENT CONTROL PLAN

JOB NO. **2120167.00**


PERMIT SET - 06/19/2013

Client

PDX LOGISTICS CENTER PHASE ONE NE ALDERWOOD RD.

CAPSTONE PARTNERS

PORTLAND, OREGON

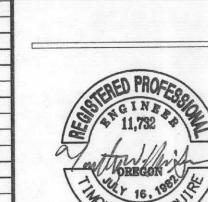

ALL RIGHTS RESERVED

THESE DRAWINGS ARE THE PROPERTY C

GROUP MACKENZIE AND ARE NOT TO BE USED OR REPRODUCED IN ANY MANNER. WITHOUT PRIOR WRITTEN PERMISSION **REVISIONS:**

REVISIONS REVISION DELTA
THIS CLOSING DATE
SHEET


1 X 05/21/2013 06/19/2013


SHEET TITLE: **EROSION AND** SEDIMENT

DRAWN BY: MJS

CHECKED BY: TWM SHEET


12016700\CIVIL\167C6-0.DWG BTS 06/18/13 15:13 1:200.00

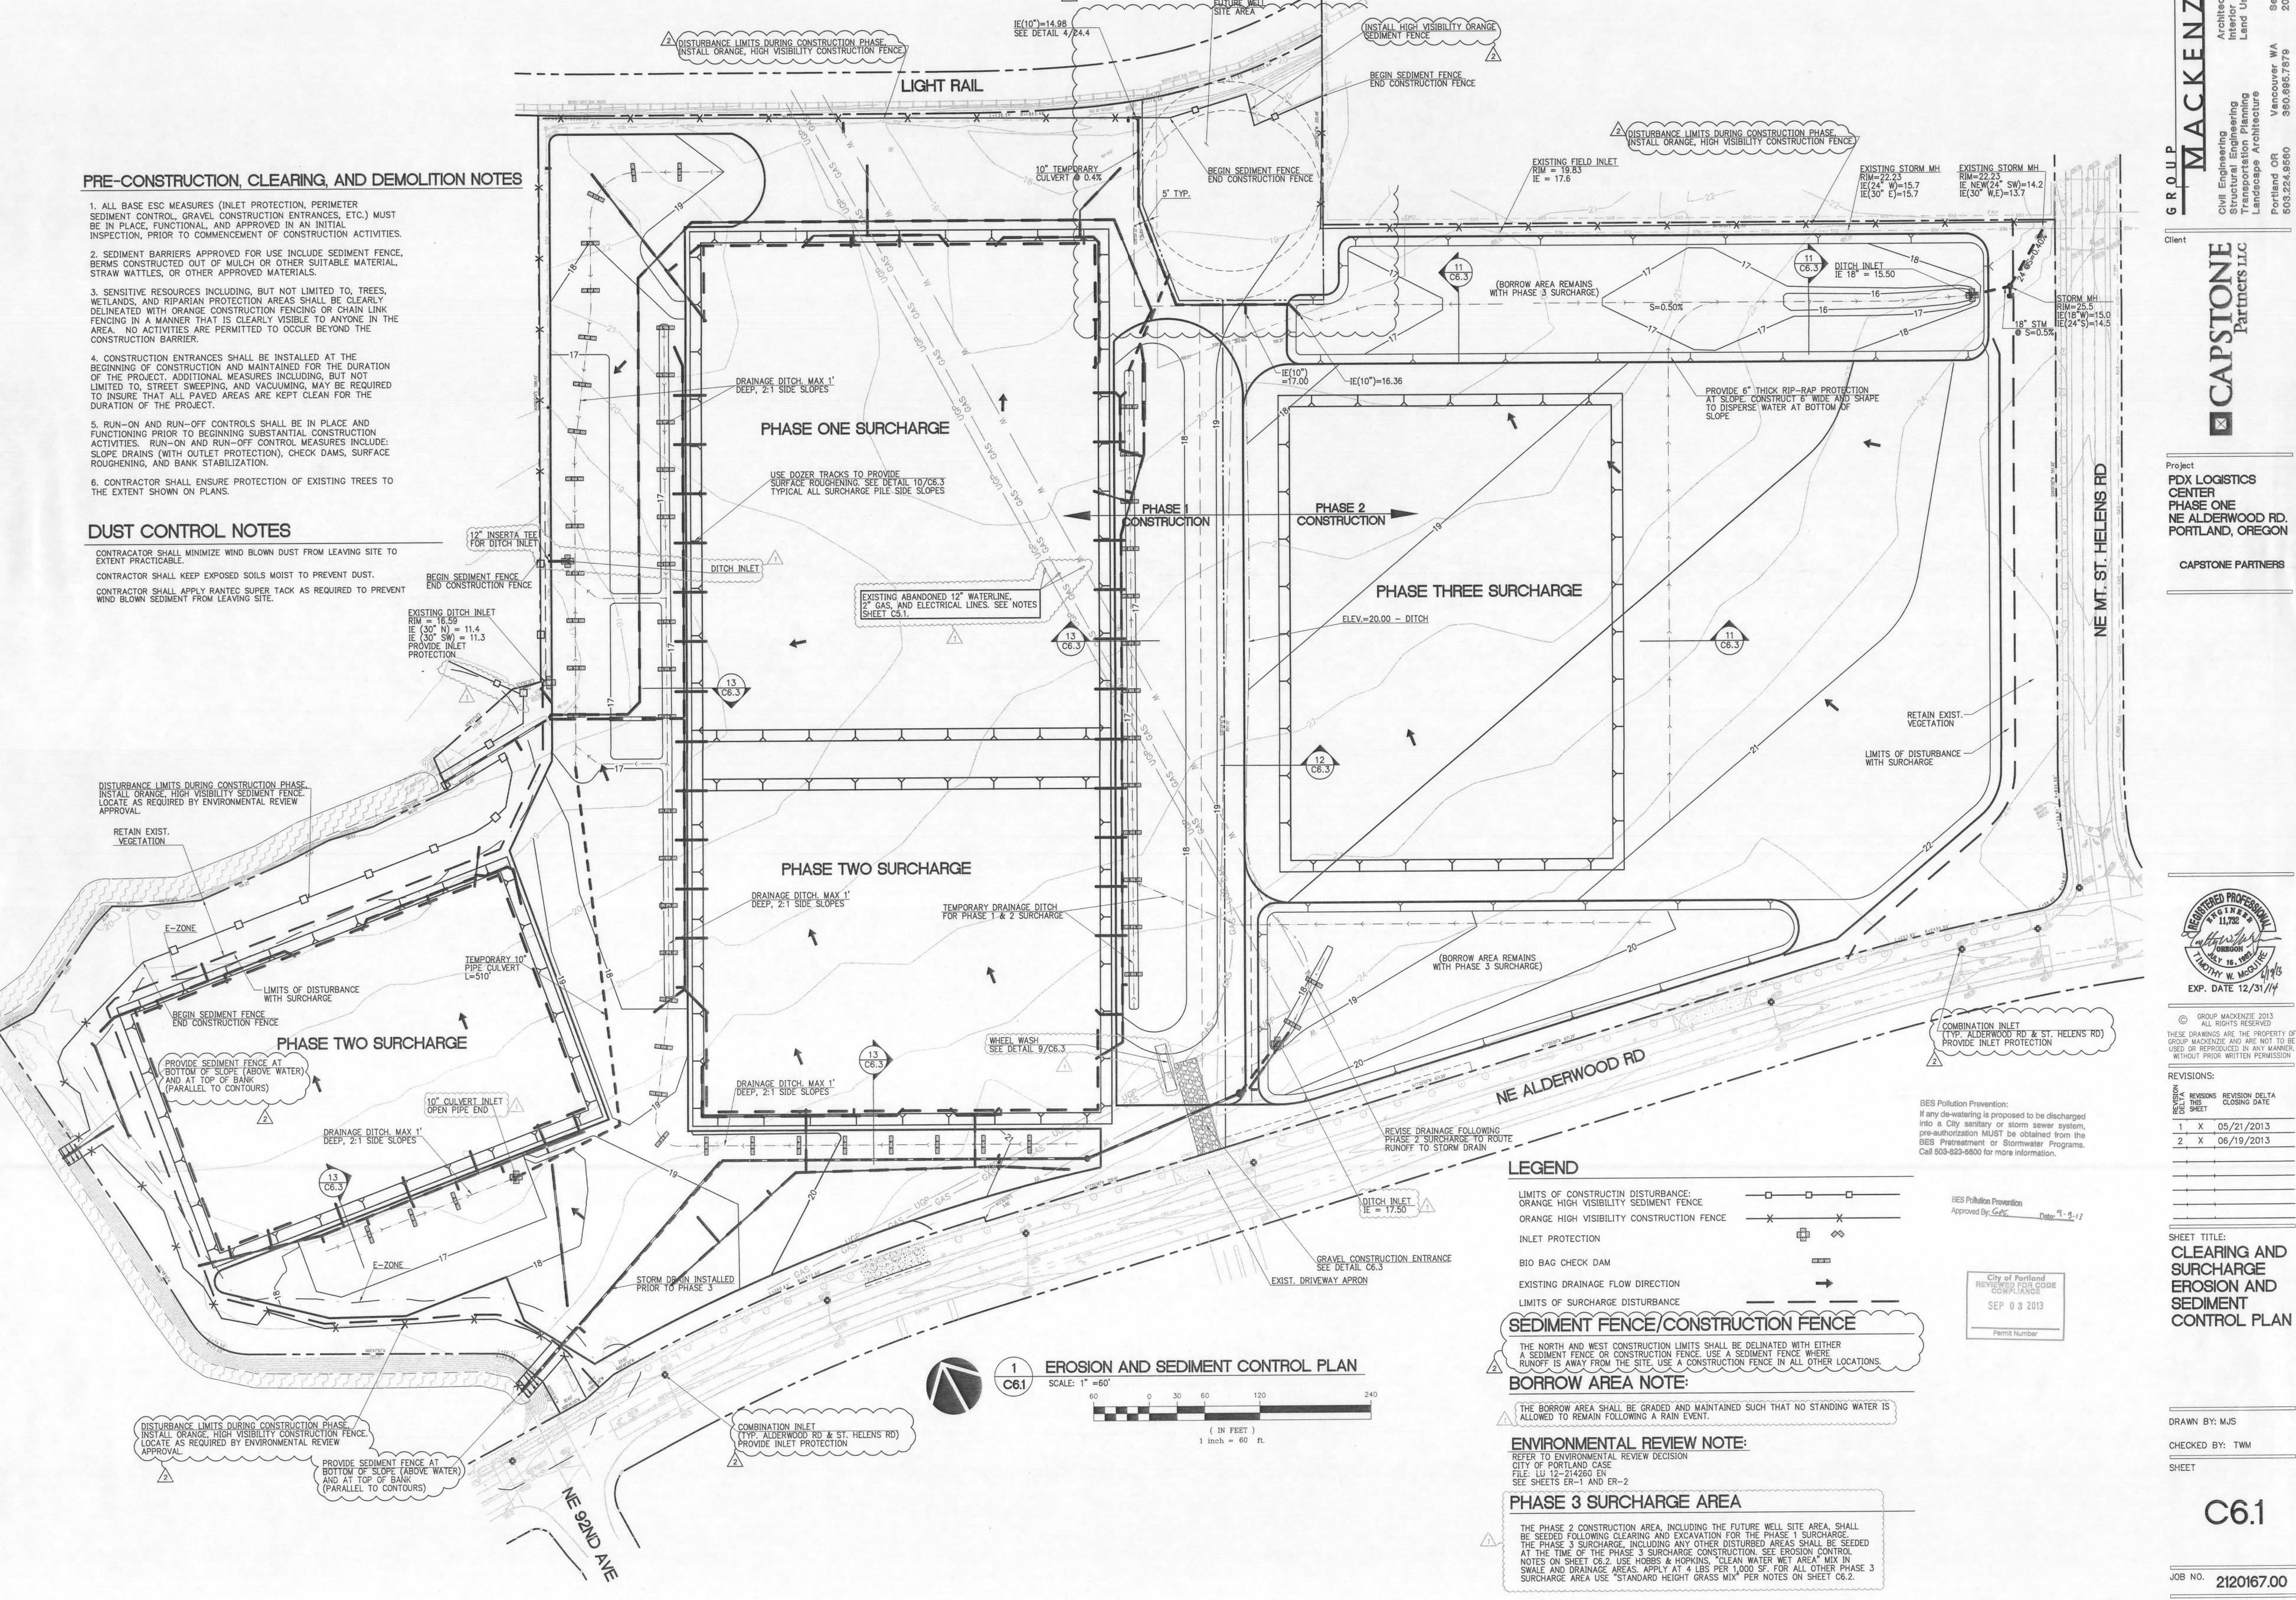

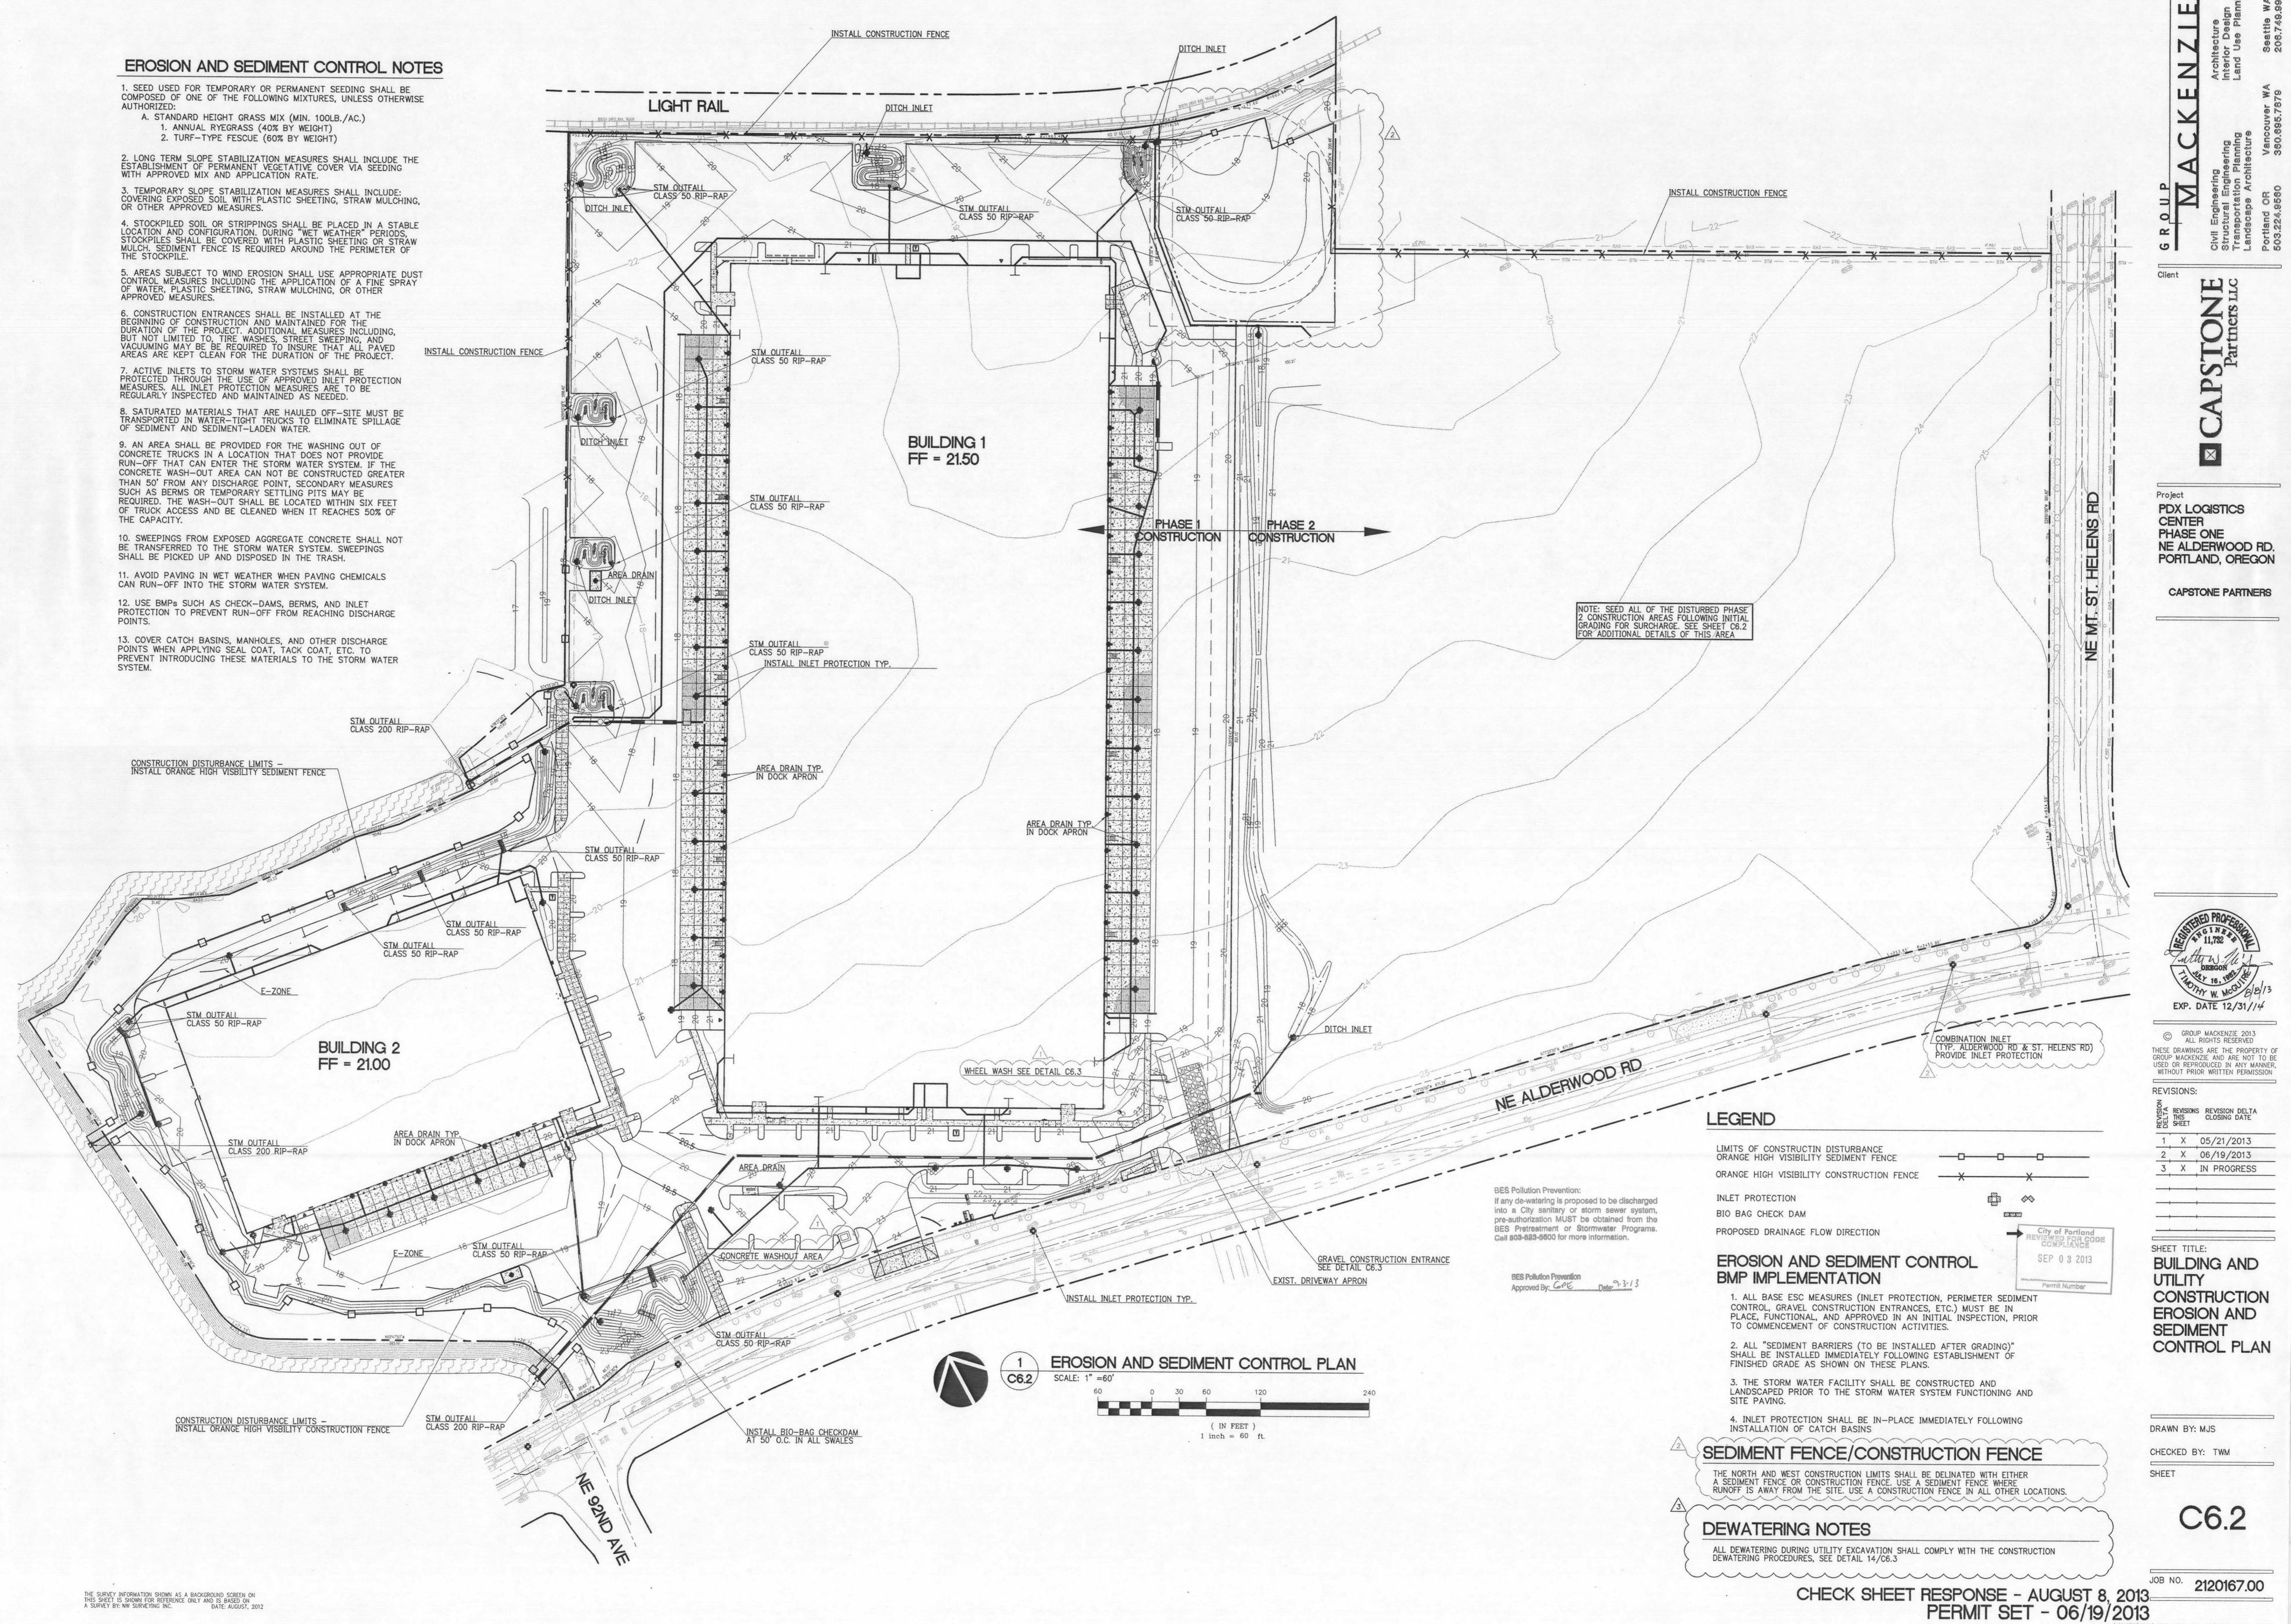

THE SURVEY INFORMATION SHOWN AS A BACKGROUND SCREEN ON THIS SHEET IS SHOWN FOR REFERENCE ONLY AND IS BASED ON A SURVEY BY: NW SURVEYING INC. DATE: AUGUST, 2012

2016700\CIVIL\167C6-2.DWG SKE 08/08/13 08:05 1:60.00

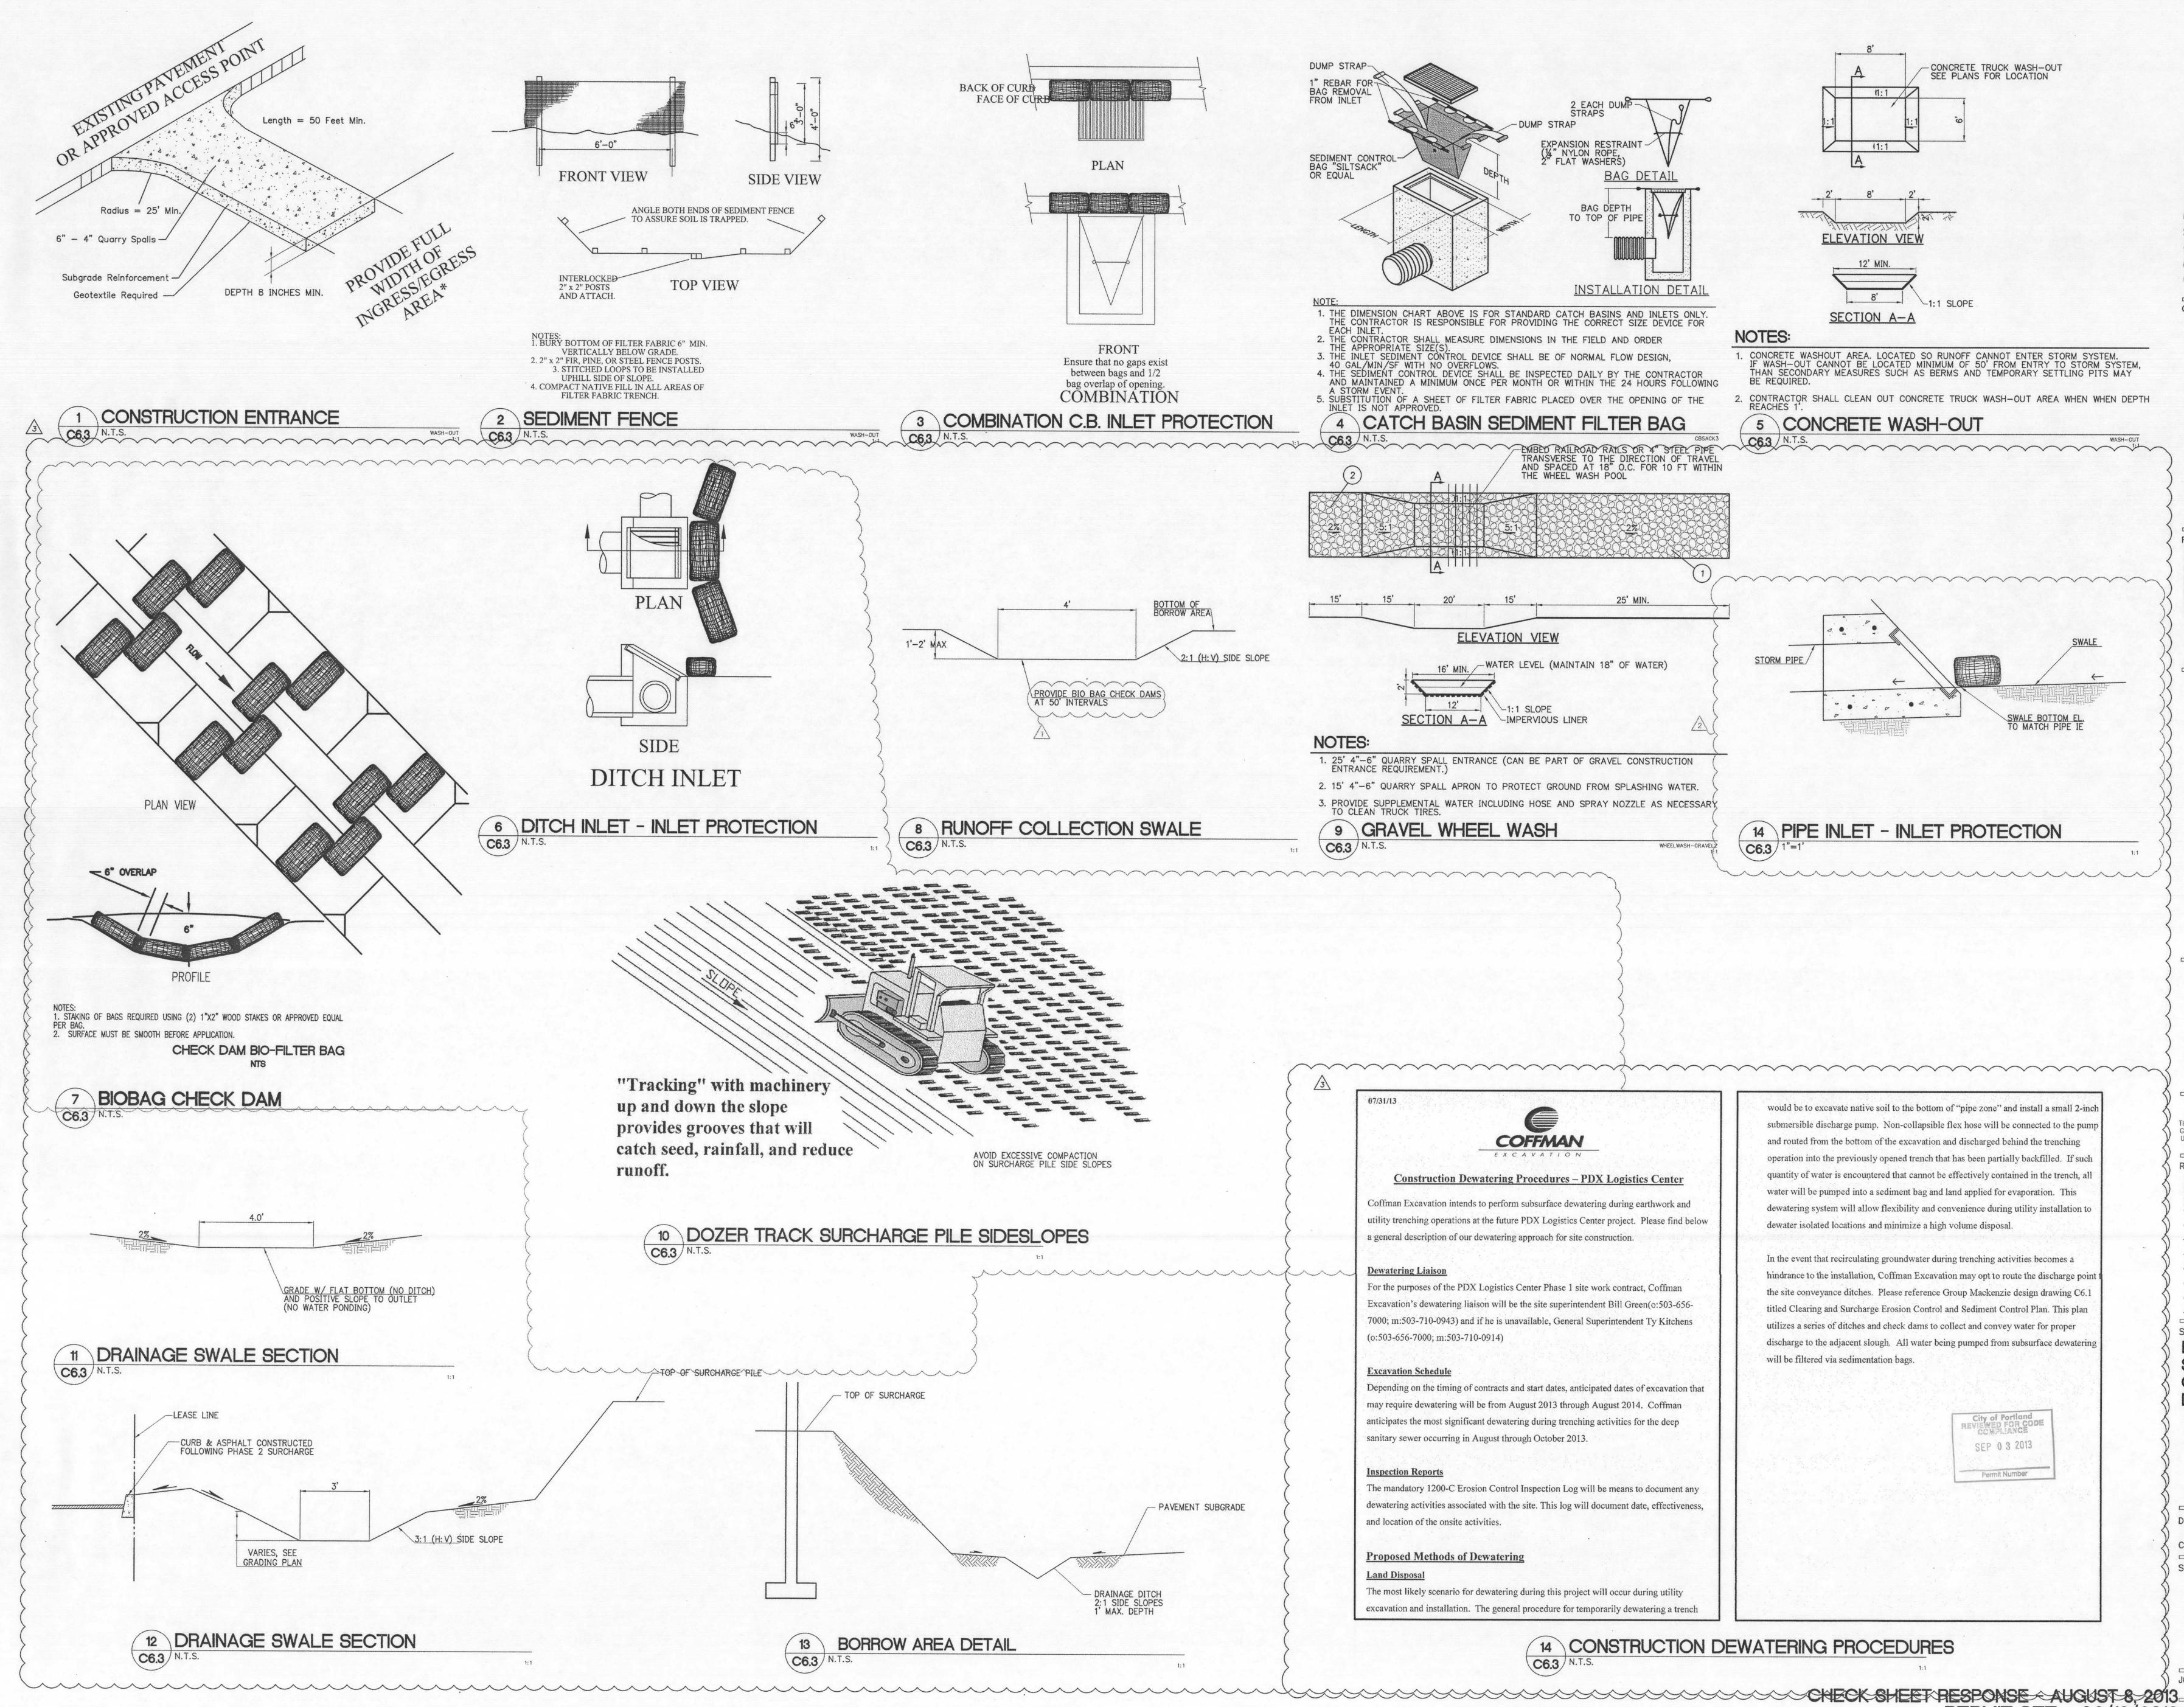

Project PDX LOGISTICS CENTER PHASE ONE NE ALDERWOOD RD. PORTLAND, OREGON

CAPSTONE PARTNERS

GROUP MACKENZIE AND ARE NOT TO BE USED OR REPRODUCED IN ANY MANNER, WITHOUT PRIOR WRITTEN PERMISSION

REVISIONS:

1 X 05/21/2013

2 X 06/19/2013 3 X IN PROGRESS

SHEET TITLE: **EROSION AND** SEDIMENT CONTROL **DETAILS**

DRAWN BY: MJS

CHECKED BY: TWM SHEET

C6.3

JOB NO. 2120167.00

PERMIT SET - 06/19/2013

City of Portland, Oregon **Bureau of Development Services** Land Use Services

Charlie Hales, Mayor Paul L. Scarlett, Director Phone: (503) 823-7300 Fax: (503) 823-5630 TTY: (503) 823-6868 www.portlandoregon.gov/bds

A

UOL>

FROM CONCEPT TO CONSTRUCTION

Your LU Decision may be recorded on or after March 27, 2013. You will need a check payable to the Multnomah Recorder in the amount of \$ 116.00 Please stamp the County Recorder's copy of the recording sheet and return with the attached decision to City of Portland, BDS 299/4500/BDS LUR Multnomah County Official Records 2013-043732 R Weldon, Deputy Clerk

03/29/2013 01:54:37 PM

March 12, 2013 Date: Interested Person Stacey Castleberry, Land Use Services 503-823-7586 / Stacey.Castleberry@portlandoregon.gov

\$90 00 \$11.00 \$15.00

NOTICE OF A TYPE II DECISION ON A PROPOSAL IN YOUR NEIGHBORHOOD

Pgs=18 Stn=11 ATLJH

The Bureau of Development Services has approved a proposal in your neighborhood.

CASE FILE NUMBER: LU 12-214260 EN GENERAL INFORMATION

Port of Portland / Attn: Sam Ruda 7200 NE Airport Way / Portland, OR 97209

Capstone Partners, LLC / Attn: Lauren Golden Jones / Chris Nelson

1015 NW 11th Avenue, Suite 243 / Portland, OR 97209

Group Mackenzie, Inc. / Attn: Ryan Schera Representative: 1515 SE Water Avenue, Suite 100 / Portland, OR 97214

8922 NE Alderwood Road, and 9600 NE Cascades Parkway

Legal Description: TL 100 53.57 ACRES SPLIT LEVY R317194 (R94216-0540), SECTION 16 1N 2E; TL 200 37.21 ACRES SPLIT LEVY R317166 (R94216-0010), SECTION 16 1N 2E.

Tax Account No.: R942160010, R942160540 1N2E16 00100, 1N2E16 00200 Quarter Section: 2339, 2440

Decision Notice for LU 12-214260 EN

Neighborhood: None District Coalition: None Business District: Columbia Corridor Association, Peter Livingston at 503-796-2892. Parkrose Business Association, David Ableidinger at 503-258-2607. Plan District: Cascade Station/Portland International Center Plan Dist. - Subdistrict B Zoning: IG2, EG2h, c, p, x—General Industrial 2 and General Employment 2 base zones, with Aircraft Landing Zone, Environmental Conservation, Environmental Protection, and Portland International Airport Noise

Impact Zone overlay zones. Case Type: EN -Environmental Review Type II, an administrative decision with appeal to the Hearings Officer. Procedure:

Proposal: The applicant proposes development of a new industrial distribution center south of NE Airport Way, between the Portland International Airport and Interstate 205. Accessory to the new distribution center, the applicant proposes three new stormwater outfalls, water quality swales, a new public trail, wetland fill, landscaping, and truck circulation and maneuvering areas.

The proposed drainage system consists of three new stormwater outfalls. A combination of both vegetated facilities and "manufactured treatment technologies" (stormwater filters) are proposed to treat the stormwater prior to discharge into the adjacent drainage channel. The stormwater outfalls will collect treated stormwater runoff from the water quality facilities and convey the stormwater runoff to the adjacent drainage channel. The outfalls will be sized 30 inches, 24 inches and 36 inches in diameter, respectively, to convey the 25-year return period. Each outfall exceeds the 4-inch diameter allowed outright by the Zoning Code, therefore requiring an environmental review.

Water Quality Swales Water quality swales are proposed throughout the site in an effort to treat stormwater runoff from the development prior to discharge into the adjacent drainage channel. Three of the water quality swales and associated grading are proposed to be located in transition areas of the Environmental Conservation overlay zone.

In accordance with the Wildlife Hazard Management Plan, all water quality swales will be designed as "flow through" in order to deter water from ponding, which may attract wildlife hazardous to aviation.

The City's Transportation Systems Plan (TSP) designates an "off-street path" to bisect the site on the west side of the property. Section 33.508.290.B.2 of the Zoning Code implements this

designation and requires a new off-road public recreational trail to be constructed as illustrated in Figure 508-13. In an effort to conform to the Zoning Code, a new public trail is proposed with this project. The new public trail will be hard-surfaced (concrete), 12 feet in width, and clear of any obstructions. A small portion (25 square feet) of the trail is to be within the transition area of the Environmental Conservation overlay zone.

The Port of Portland filled wetlands on the site as permitted by the Army Corps of Engineers and the Division of State Lands in 2003. Subsequent to filling the wetlands, the site remained vacant and three small wetlands reformed on the west side of the site in the same location as the wetlands that were filled in 2003. Construction of the proposed development will cover much of the wetland areas with building or paved areas. Therefore, the project will result in permanent impacts to three wetlands. There will be no temporary wetland impacts. Remaining wetland areas are proposed to be graded, planted and maintained to discourage reestablishment of wetlands for aviation wildlife hazard purposes.

A small portion (637 square feet) of the wetlands proposed to be filled is within the resource area of the environmental zone. Because the wetland fill is located within the resource area an environmental review is required.

Decision Notice for LU 12-214260 EN

Parking, Loading and Maneuvering Areas A portion of the parking and maneuvering areas (8,243 square feet) and associated grading are proposed adjacent to Building 2 and within the transition area of the Environmental Conservation overlay zone.

Parking, Maneuvering and Exterior Storage Area Buffers Sections 33.430.140.Q and S of the zoning code require a 10-foot wide landscape buffer between the resource area of the Environmental Conservation overlay zone and any parking, maneuvering and exterior storage areas. To meet these standards, a 10 foot wide buffer landscaped to the L3 standard with plants selected from the Airport List of the Portland Plant List is proposed within the transition area.

The entire site is within the Cascade Station/Portland International Center (CS/PIC) Plan District and a portion of the site is within the City's Environmental Conservation or Environmental Protection overlay zone. The CS/PIC Plan District standards do not apply to the work proposed in the environmental zone by the applicant, and therefore only the regulations in Zoning Code Chapter 33.430 apply to the proposed activities in the environmental zones.

The standards listed in the Environmental Zone chapter of the Zoning Code (33.430.140 through .190) apply to the proposal, and must be met, to allow the work to occur by right. If these standards are not met, an Environmental Review is required. In this case, the proposed outfalls exceed the standards for outfalls in environmental zones listed in 33.430.180; and the wetland fill exceeds the general standards listed in 33.430.140; therefore the work must be approved through an Environmental Review.

Relevant Approval Criteria: In order to be approved, this proposal must comply with the approval criteria of Title 33. The

relevant criteria are: ■ Section 33.430.250 A Public safety facilities, roads, driveways, walkways, outfalls, utilities, land divisions, Property Line Adjustments, Planned Developments, and Planned Unit Developments

■ Section 33.430.250 E Other Development in the Environmental Conservation zone

CONCLUSIONS

The applicant proposes three new stormwater outfalls, water quality swales, a new public trail, wetland fill, landscaping, and truck circulation and maneuvering areas. These improvements are accessory to a new industrial distribution center to be constructed on the balance of the site. They occur within the environmental zones that cover the drainage channels on the

The applicants and the above findings have shown that the proposal meets the applicable approval criteria with conditions. Therefore, this proposal should be approved, subject to the following conditions.

ADMINISTRATIVE DECISION

Approval of an Environmental Review for: Construction of three new stormwater outfalls;

 Three water quality swales; A portion of a public recreational trail;

637 square feet of wetland fill associated with these improvements.

 8,243 square feet of parking/maneuvering area, and associated landscape buffers. all within the Environmental Conservation overlay zone, and in substantial conformance with Exhibits C.4through C.15, as signed, and dated by the City of Portland Bureau of Development Services on March 7, 2013. Approval is subject to the following conditions:

Decision Notice for LU 12-214260 EN

A. All permits: A Building Permit is required. Copies of the stamped Exhibits C.4 through C.15 from LU 12-214260 EN and Conditions of Approval listed below, shall be included within all plan sets submitted for permits (building, grading, Site Development, erosion control, etc. See "Other Technical Requirements" listed above). These exhibits shall be included on a sheet that is the same size as the plans submitted for the permit and shall include the following statement, "Any field changes shall be in substantial conformance with approved Exhibits C.4 through C.15."

- B. Temporary construction fencing shall be installed according to Section 33.248.068 (Tree Protection Requirements), except as noted below. Construction fencing shall be placed along the Limits of Construction Disturbance for the approved development, as depicted on Exhibit C.6 and C.7 Construction Management Plan, [Arborists Report,] or as required by inspection staff during the plan review and/or inspection stages.
 - 1. No mechanized construction vehicles are permitted outside of the approved "Limits of Construction Disturbance" delineated by the temporary construction fence. All planting work, invasive vegetation removal, and other work to be done outside the Limits of Construction Disturbance, shall be conducted using hand held equipment.
- C. A Final Mitigation Planting Plan shall be submitted as part of City permit applications for the project, and shall include the area between ordinary high water, and the edge of the Environmental overlay zone on the site. The plan shall depict native plants selected from the Portland Plant List, planted at a minimum density of 1 tree, 3 shrubs and 4 other native plants, per every 100 square feet of environmental zone above Ordinary High Water on the site. Remaining unplanted areas shall be seeded with a native seed mix. All plantings within the environmental overlay zone will be required to be native and selected from the Portland Plant List. The Final Mitigation Planting Plan shall include the following

1. The official City of Portland Environmental overlay boundaries of the Environmental

Protection and/or Conservation zones, including the 25 foot transition area. 2. Ordinary High Water Line (OHWL) of all water bodies

3. Surveyed top-of-bank of all water bodies

4. Location of all trees, shrubs and ground covers to be planted, using standard landscaping symbols and notation typical of landscape plans

5. Species names (scientific and common), sizes, and quantities of all required trees, shrubs, and ground covers, listed in a standard plant legend 6. Note that plantings shall be installed between October 1 and March 31 (the planting

7. Note that prior to installing required mitigation plantings, non-native invasive plants shall be removed from all areas within 10 feet of mitigation plantings, using handheld

8. Note that all mitigation and remediation shrubs and trees shall be marked in the field by a tag attached to the top of the plant for easy identification All tape shall be a contrasting color that is easily seen and identified.

D. An inspection of Permanent Erosion Control Measures shall be required to document installation of the required mitigation plantings.

1. The Permanent Erosion Control Measures inspection (IVR 210) shall not be approved until the required mitigation plantings have been installed (as described in Condition C

2. If the Permanent Erosion Control Measures inspection (IVR 210) occurs outside the planting season (as described in Condition C above), then the Permanent Erosion Control Measures inspection may be approved prior to installation of the required mitigation plantings - if the applicant obtains a separate Zoning Permit for the purpose of ensuring an inspection of the required mitigation plantings by March 31 of the

E. The land owner shall maintain the required plantings for two years to ensure survival

during and beyond the designated two-year monitoring period. The landowner shall: 1. Obtain a Zoning Permit for a final inspection at the end of the 2-year maintenance and monitoring period. The permit must be finaled no later than 2 years from the final inspection for the installation of mitigation planting, for the purpose of ensuring that the required plantings remain. Any required plantings that have not survived must be

F. Failure to comply with any of these conditions may result in the City's reconsideration of this land use approval pursuant to Portland Zoning Code Section 33.700.040 and /or enforcement of these conditions in any manner authorized by law.

Note: In addition to the requirements of the Zoning Code, all uses and development must comply with other applicable City, regional, state and federal regulations.

This decision applies to only the City's environmental regulations. Activities which the City regulates through PCC 33.430 may also be regulated by other agencies. In cases of overlapping City, Special District, Regional, State, or Federal regulations, the more stringent regulations will control. City approval does not imply approval by other agencies.

Staff Planner: Stacey Castleberry

Page 4 Decision Notice for LU 12-214260 EN

Decision mailed: March 12, 2013

Last date to Appeal: March 26, 2013 by 4:30 pm Effective Date (if no appeal): March 27, 2013 Decision may be recorded on this date

Rebecca Esau, Principal Planner

City of Portland Bureau of Development Services 1900 SW Fourth Ave, #4500 Portland, OR 97201

Date:March 27, 2013

PDX LOGISTICS CENTER PHASE ONE NE ALDERWOOD RD. PORTLAND, OREGON

Page 5

CAPSTONE PARTNERS

GROUP MACKENZIE 201; ALL RIGHTS RESERVED

REVISIONS:


05/21/2013 06/19/2013


SHEET TITLE: **ENVIRONMENTAL REVIEW** COMPLIANCE

DRAWN BY: MJS


ER-1

PERMIT SET - 06/19/2013

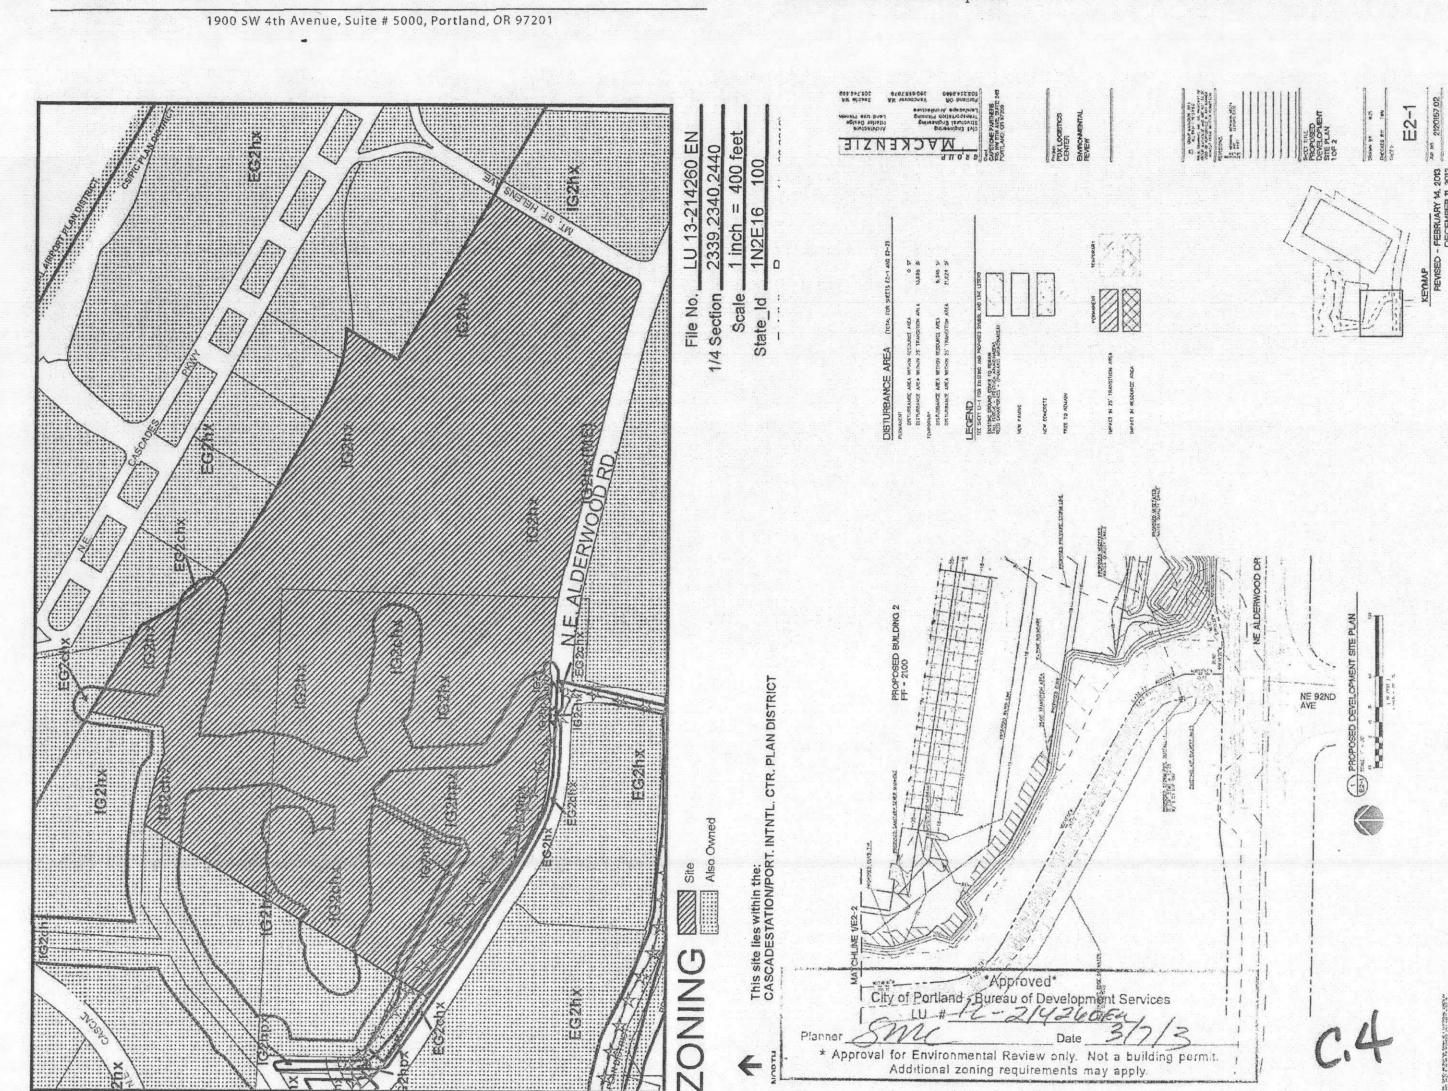

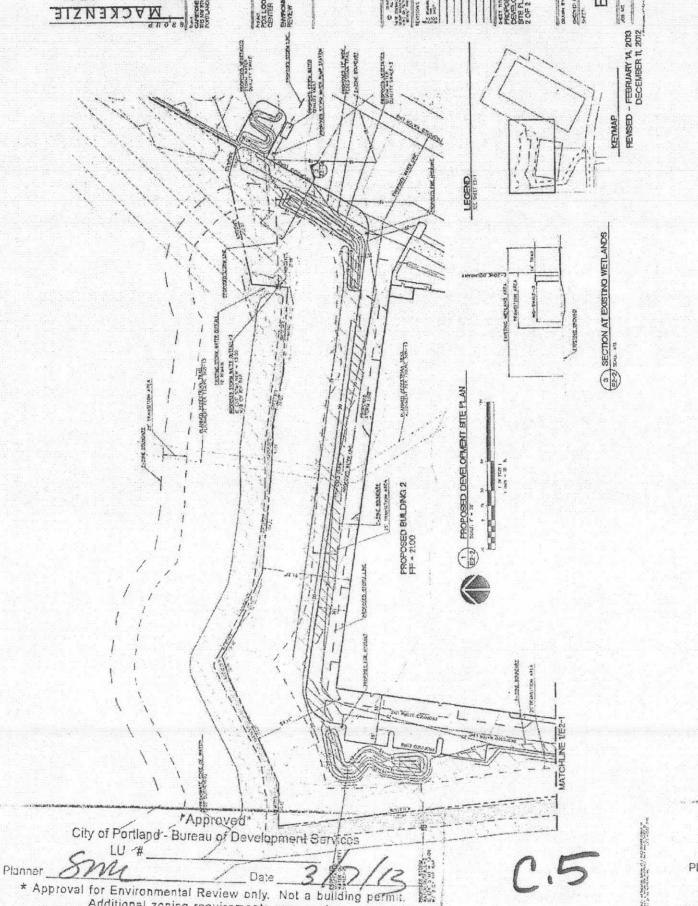

Additional zoning requirements may apply

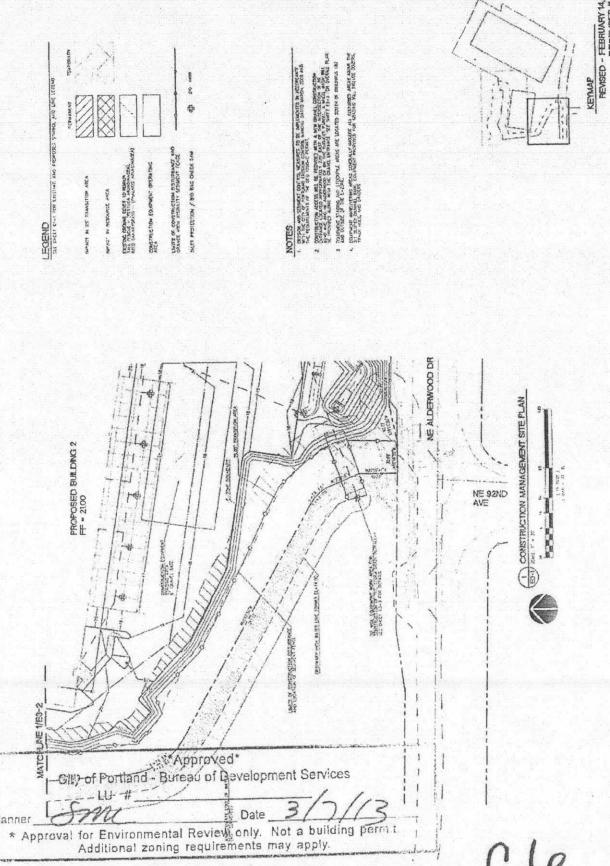

NOTES:


THIS SHEET IS PROVIDED IN ACCORDANCE WITH LU-12-214260 EN.

2. ANY FIELD CHANGES SHALL BE IN SUBSTANTIAL COMFORMANCE WITH APPROVED EXHIBITS C.4-C.15

3. THE ENGINEER WILL PROVIDE FULL SIZE COPIES OF THE CITY APPROVED SHEETS UPON REQUEST.

CHECKED BY: TWM

SEP 0 3 2013

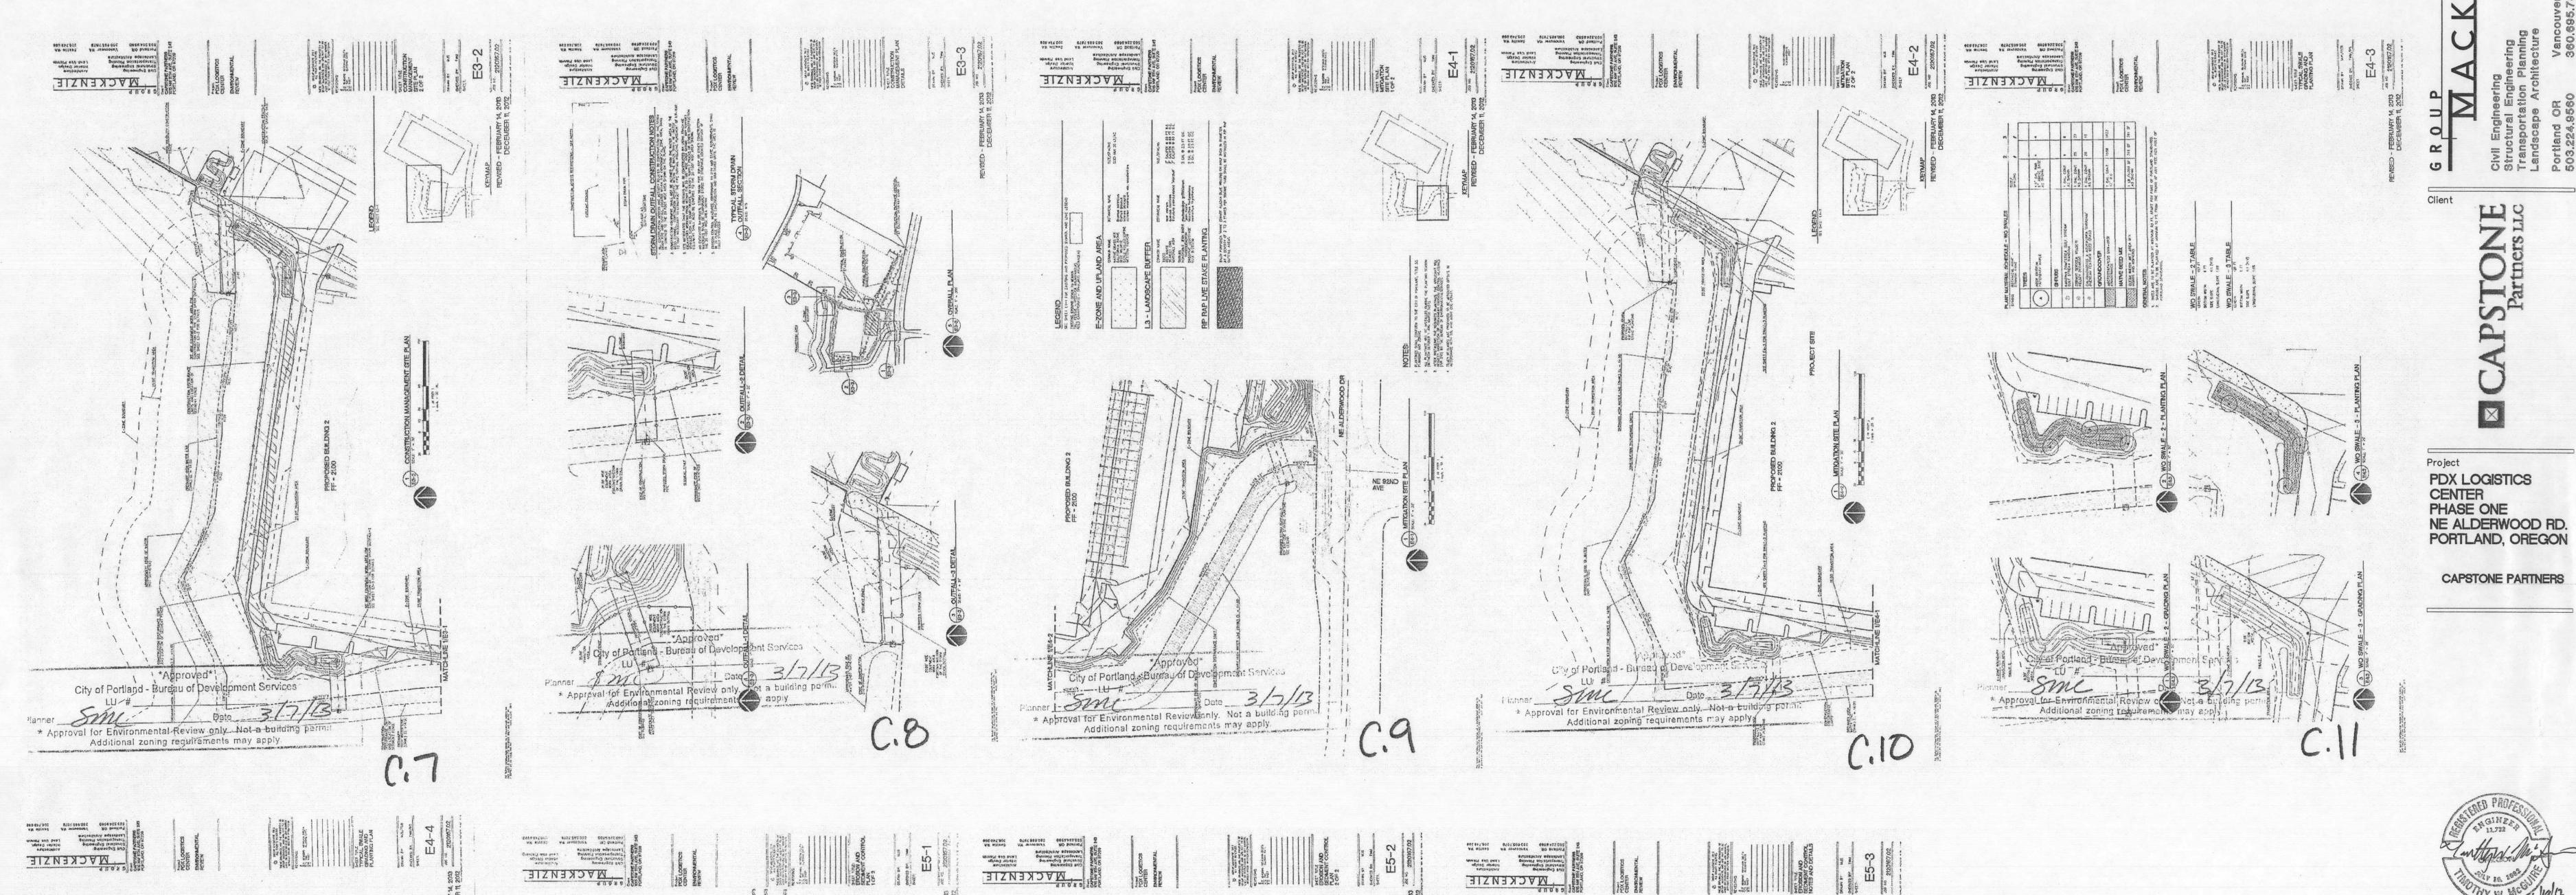

GROUP MACKENZIE 2013
ALL RIGHTS RESERVED

THESE DRAWINGS ARE THE PROPERTY OF
GROUP MACKENZIE AND ARE NOT TO BE
USED OR REPRODUCED IN ANY MANNER,
WITHOUT PRIOR WRITTEN PERMISSION REVISIONS:

> SET REVISIONS REVISION DELTA CLOSING DATE SHEET 05/21/2013 06/19/2013

SHEET TITLE:
ENVIRONMENTAL
REVIEW
COMPLIANCE

1. THIS SHEET IS PROVIDED IN ACCORDANCE WITH LU-12-214260 EN. 2. ANY FIELD CHANGES SHALL BE IN SUBSTANTIAL 2 OF 2 COMFORMANCE WITH APPROVED EXHIBITS C.4-C.15

SEP 0 3 2013

Permit Number

3. THE ENGINEER WILL PROVIDE FULL SIZE COPIES OF THE CITY APPROVED SHEETS UPON REQUEST.

NOTES:

DRAWN BY: MJS CHECKED BY: TWM SHEET

ER-2

JOB NO. **2120167.00**

PERMIT SET - 06/19/2013

