
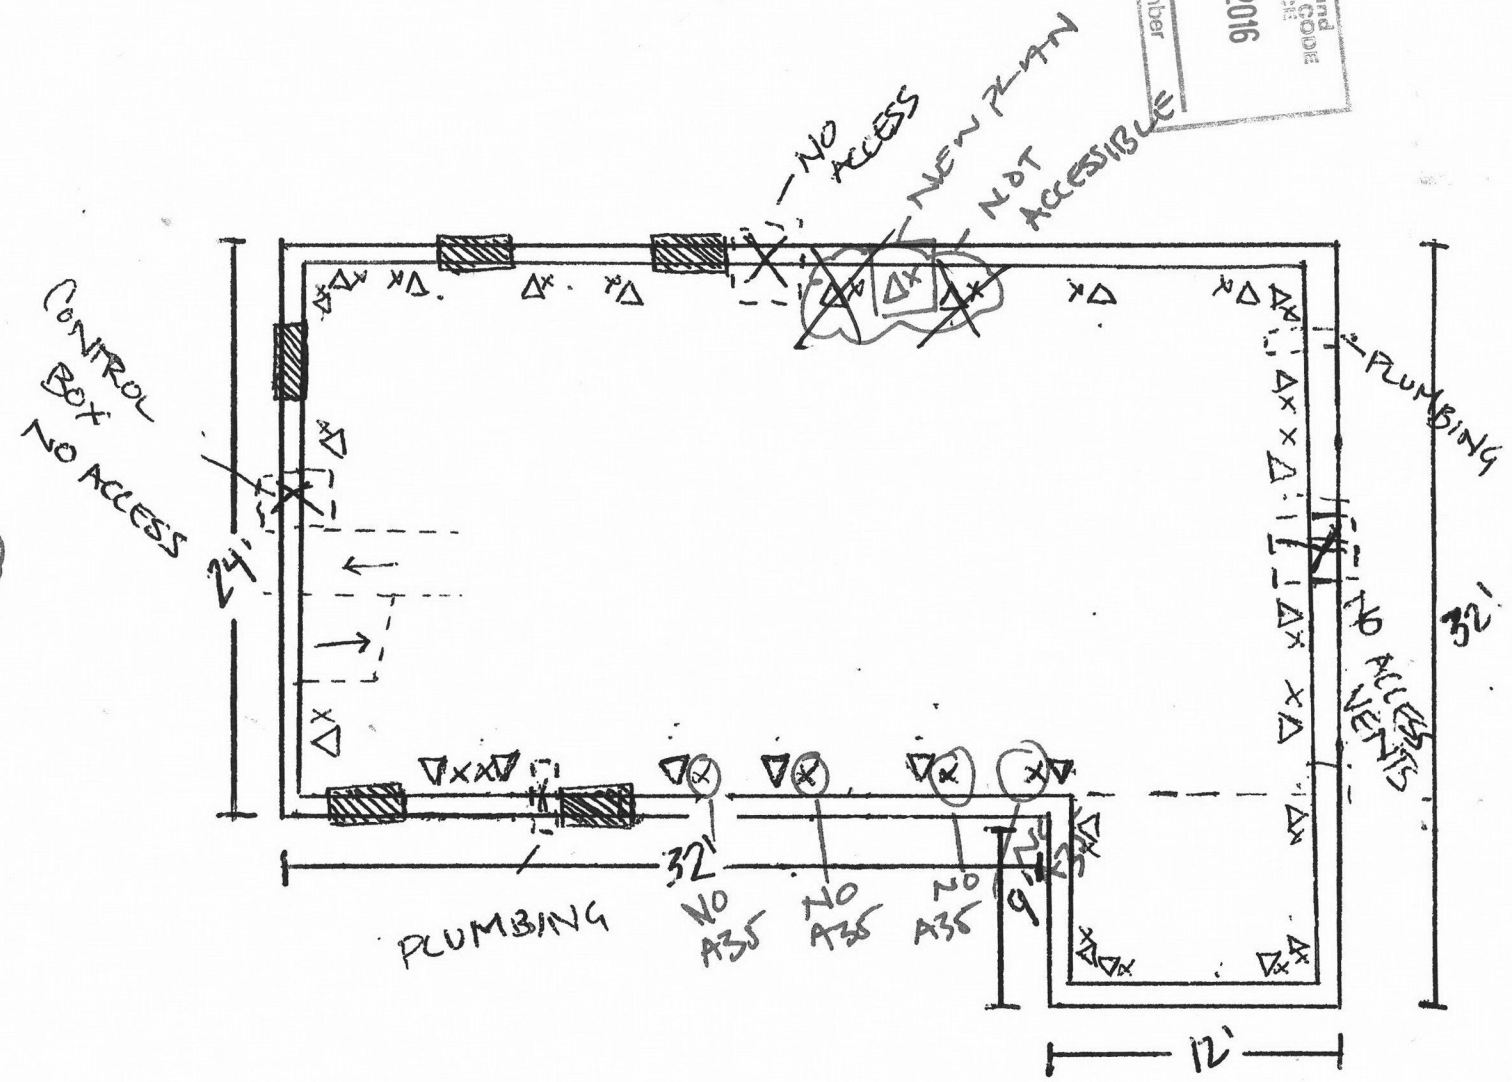


City of Portland
 REVIEWED FOR CODE
 COMPLIANCE
 SEP 15 2016
 Permit Number

Δ = UFP's @ 6' o.c.

X = A35's @ 4' o.c.
 6' o.c.

 = WINDOWS



JULIA COHEN

7117 N SEWARD AVE
 PORTLAND, OR 97217

SCALE = 1/8" = 1'-0"

↑
 N 2

16-215551-REV-1-15



City of Portland, Oregon - Bureau of Development Services

1900 SW Fourth Avenue • Portland, Oregon 97201 • 503-823-7300 • www.portlandoregon.gov/bds



Permit Revision Application and Submittal Requirements

A Permit Revision is required when there are proposed changes to the project after the permit has been issued. This may arise due to discrepancies between the city-approved permit drawings and actual field conditions, or the customer has changed their mind about an aspect of the project. In all cases, a revision to the existing permit must be submitted, reviewed and approved.

Applicants will provide:

☒ A copy of this application

☒ Three (3) sets of plans that clearly reflect the proposed change(s).

Drawings and calculations must be stamped and signed by the Architect and/or the Engineer of Record, if applicable.

☒ One (1) copy of the original city approved permit drawings. (NOTE: If your project has an assigned process manager please contact them regarding submittal of the revision).

☐ Two (2) sets of calculations, if applicable

☐ Inspector's correction notice, if revision is due to an inspection correction

☐ Revision fee (paid at time of submittal)

Contact Information:

Contact name MOLLY KEMP

Address 2869 NE SANDY BLVD SUITE A

City PORTLAND State OR Zip Code 97232

Phone 503 307 6949 Email mollyk@greensaversusa.usa

Value of proposed revision 0 Issued permit # 16-215551 - RS

Description of revision REMOVAL OF HARDWARE ON PLANS DUE TO OBSTRUCTIONS AS WELL AS CHANGE TO ABS SPACING AND NUMBER OF HARDWARE IN N SIDE ROOM

Fees:

The Permit Revisions are subject to fees associated with plan review, processing and any increase in project value. Additional fees may apply if adding plumbing fixtures.

The Bureau of Development Services fee schedule is available under the fees tab on the BDS web site at: www.portlandoregon.gov/bds. Fees are updated annually on July 1st.

Helpful Information:

Bureau of Development Services
City of Portland, Oregon
1900 SW 4th Avenue, Portland, OR 97201
www.portlandoregon.gov/bds

Submit your plans in person to:

Development Services Center (DSC), First Floor,
For Hours Call 503-823-7310 | Select option 1

Important Telephone Numbers:

BDS main number503-823-7300
DSC automated information line503-823-7310
Building code information503-823-1456
BDS 24 hour inspection request line503-823-7000
Residential information for
one and two family dwelling503-823-7388
General Permit Processing and
Fee Estimate info503-823-7357
City of Portland TTY503-823-6868