General Notes & Supplemental Information The attached 8 1/2 x 11 sheets are part of this plan approval. Plans are considered null and void without this information attached to the approved set of plans.

SEPARATE SEWER CONNECTION PERMIT REQUIRED. CONNECTION IS IN THE

TIME OF CONSTRUCTION. SEE GREEN BES INSPECTION CARD. To schedule, contact the automated inspection request (IVR) system at 503-823-7000 and request (INR) system at 503-823-7000 and request (INR) system at 503-823-7000 and request you may contact our office directly at 503-823-2059

> BDS COMBINATION INSPECTOR APPROVAL REQUIRED FOR DOWNSPOUTS AND PRIVATE STORMWATER PIPING OUTSIDE OF STORM

> > APPROVED

ELEVATION PROJECT DATA

"ELEVATION IS AN ARCHITECTURAL RENDERING NOT

INTENDED TO REPRESENT ACTUAL CONDITIONS OR

PROJECT ADDRESS:

PARCEL 1, SE RAYMOND AVE, PORTLAND, OR

DK HOMES, LLC

**ENERGY CODE DATA:** 

ALL CONSTRUCTION SHALL CONFORM TO 2011 OREGON RESIDENTIAL SPECIALTY CODE AND 2010 OREGON ENERGY EFFICIENCY SPECIALTY CODE.

TABLE N1101.1(1)

PRESCRIPTIVE ENVELOPE REQUIREMENTS

| BUILDING COMPONENT              | REQUIRED PERFORMAN   | ICEEQUIV. VA | LUE |
|---------------------------------|----------------------|--------------|-----|
| WALL INSULATION-ABOVE GRADE     | U-0.060              | R-21         | (   |
| WALL INSULATION-BELOW GRADE     | F-0.565 <sup>6</sup> | R-15         |     |
| FLAT CEILING f                  | U-0.031              | R-38         |     |
| VAULTED CEILING 9               | U-0.042              | R-38         | g   |
| UNDERFLOORS                     | U-0.028              | R-30         |     |
| SLAB EDGE PERIMETER             | F-0.520              | R-15         |     |
| HEATED SLAB INTERIOR            | N/A                  | R-10         |     |
| WINDOWS                         | U-0.35               | U-0.35       |     |
| WINDOW AREA LIMITATION          | N/A                  | N/A          |     |
| SKYLIGHTS                       | U-0.60               | U-0.60       |     |
| EXTERIOR DOORS <sup>m</sup>     | U-0.20               | U-0.20       |     |
| EXTERIOR DOORS W/ MORE THAN 2.5 | 5 SF.                |              |     |
| GLAZING <sup>"</sup>            | U-0.40               | U-0.40       |     |
| FORCED AIR DUCT INSULATION      | N/A                  | R-8          |     |
| NOTES: REF. TO GENERAL NOTES FO | OR FOOTNOTES         |              |     |

TABLE N1101.1(2)

ADDITIONAL MEASURES

ENVELOPE ENHANCEMENT MEASURE MEASURE: 2

HIGH EFFICIENCY ENVELOPE:

EXTERIOR WALLS - U-0.058/R-21 INTERMEDIATE FRAMING.AND

AVAULTED CEILINGS - U-0.33/R-30, AND

FLAT CEILING - U-0.025/R-49, AND d,e FRAMED FLOORS - U-0.025/R-38, AND

WINDOWS - U-0.30, AND

DOORS - ALL DOORS U-0.20, OR

ADDITIONAL 15 % OF PERMANENTLY INSTALLED LIGHTING FIXTURES AS HIGH-EFFICACY LAMPS OR CONSERVATION MEASURE D AND E

NOTES: REF. TO GENERAL NOTES FOR FOOTNOTES

**CONSERVATION MEASURE:** 

MEASURE: A

HIGH EFFICIENCY HVAC SYSTEM:

-GAS-FIRED FURNACE OR BOILER WITH MINIMUM AFUE OF 90% A, OR AIR-SOURCE HEAT PUMP WITH MINIMUM HSPF OF 8.5 OR -CLOSED-LOOP GROUND SOURCE HEAT PUMP WITH MINIMUM

COP OF 3.0 FLOOR PLAN INFORMATION:

| FIRST FLOOR LIVING AREA: | 860 SF   |
|--------------------------|----------|
| 2ND FLOOR LIVING AREA:   | 1,120 SF |
| GARAGE:                  | 248 SF.  |
| TOTAL LIVING AREA:       | 1,980 SF |

# GENERAL NOTES

1. GENERAL CONTRACTOR SHALL REVIEW ALL SITE CONDITIONS AND CONSTRUCTION DOCUMENTS PRIOR TO COMMENCING WORK. REPORT ANY DISCREPANCIES IN THE PROPOSED WORK TO THE CONCEPT DESIGN & ASSOCIATES, OWNER/BUILDER IMMEDIATELY. PROCEED ONLY AFTER WRITTEN CLARIFICATIONS ARE

2. PROVIDE HVAC TO MEET BLDG. & MECH. CODES. HVAC SYSTEM DESIGN, DRAWINGS, CALCULATIONS AND PERMIT TO BE PROVIDED BY LICENSED MECHANICAL CONTRACTOR.

3. PROVIDE ELECTRICAL WIRING, OUTLETS AND DEVICES TO MEET BLDG. & ELEC. CODES. ELECTRICAL DESIGN, DRAWINGS, CALCULATIONS AND PERMIT TO BE PROVIDED BY LICENSED ELECTRICAL CONTRACTOR.

4. DRAWINGS, CALCULATIONS AND PERMIT TO BE PROVIDED BY LICENSED PLUMBING CONTRACTOR.

5. THIS IS PERMIT SET FOR ONE (1) SITE ADDRESS ABOVE ONLY. A COPY OF THESE CONSTRUCTION DRAWING FOR ANY FORM OF PRODUCTION WITHOUT AUTHORIZED BY CONCEPT DESIGN & ASSOCIATES IS PROHIBITIT

**Urban Forestry** MATERIAL DISPLAYED. FINAL ELEVATION AND CHOICE OF MATERIALS ARE SUBJECT TO LOCAL JURISDICTION REQUIREMENTS AND BUILDER'S DISCRETION

VICINITY MAP



SITE PLAN (AND EROSION CONTROL PLAN)

PROJECT ADDRESS: PARCEL 1, SE RAYMOND ST PORTLAND, OR PROJECT LEGAL:

> TAX ID: R214023 STATE ID: TAX ROLL: PARCEL 1

BLOCK:

FLATWORK AREA: CONCRETE DRIVEWAY & SIDE WALK LOT COVERAGE:

1" DIA PVC WATER LINE -

EXISTING WATER METER APPR. 5.0' OFF WESTERN

PROPERTY LINE

2,810 SF LOT AREA: **BUILDING AREA (NOT INCLUDING EAVES)** 1,208 SF MAX BUILDING COVERAGE ALLOWABLE: 1,405 SF **IMPERVIOUS AREA: ROOF AREA INCLUDING OVERHANGS:** 1,560 SF

**ZONING:** R2 - OVERLAY: NA

CONTACT INFO. INDEX OF SHEETS

**CONCEPT DESIGN & ASSOCIATES** P.O. BOX 8464 PORTLAND, OR 97207 PH: (503) 515-7418 kymcad@gmail.com

**RESIDENTIAL DESIGN:** 

## **BUILDER & DEVELOPER:**

contact: Kym Nguyen

D K HOMES LLC

P.O. BOX 90277 PORTLAND, OR 97290 PH: (503) 380-5959 Fax: (503) 762-1996 CCB#: 159237

DESCRIPTION

SITE PLAN **COVER SHEET EXTERIOR BUILDING ELEVATIONS** FIRST FLOOR PLAN/2NDFLOOR FRAMING PLAN & SECOND FLOOR PLAN FOUNDATION PLAN, ROOF PLAN **CROSS SECTION A & B** 

INTERIOR STAIR DETAIL, FOOTING DETAIL POST & BEAM DETAIL. ALTERNATE BRACING FOR 1ST & 2ND FLOOR DETAIL & PORTAL FRAME DETAIL

**GENERAL NOTES & SPECIFICATION** DOCUMENT FOR GRAVITY ANALYSIS MANUFACTURE ROOF TRUSS (BY OTHER)

City of Portland Bureau of Davalapment Services By L. Dawking Date 4/25/18 Approved by Planning and Zoning Review

6' TALL CHAIN LINK FENCE

W/8' POST AT EVERY 6' O/C.
16 FOOT AWAY FROM ROOT

12' x 12'

**NEW SINGLE** 

**FAMILY DWELLING** 

2 LEVEL

STRUCTURE

F.F.E. = 1.5'

/ STOCK

PILE DIRT

DRIVEWAY

EXISTING W.M.

22 CONTRACTOR SHALL LOCATE

m....

(60.00' WIDTH)

REPORT WITH PROJECT'S OWNER OR KYM NGUYEN WHEN DECREPENCIES

3" DIA ABS SEWER LINE -

S.E. RAYMOND ST.

222 SF

ALL UTILITIES LINES, 4"PVC

BUILDING COVERAGE

DEC 8"

DEC 15"

DEC 12

- TO REMOVE

FENCE\

OFF PROPERTY

LINES, 10' FOOT FOUNDATION

4" ABS PIPE —


1.0' ROOF

BUILDING

FOOTPRINT

N 89°50'40"E

OVERHANG, TYP.

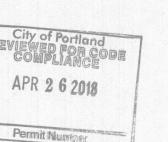


DECEIVED UU MAR 16 2018 BDS DOCUMENT SERVICES


P-1980 SINGLE DWELLING SE Raymond Ave Portland, Or. **DK Homes LLC** Revisions REV: 09-10-2017 PER CITY


REV: 03-13-2018


PER BES


Drawn & Checked By 17-190 6-13-2017 P1980PLAN.DWG

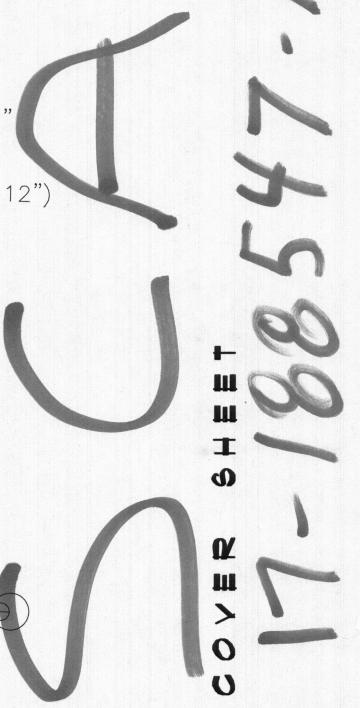

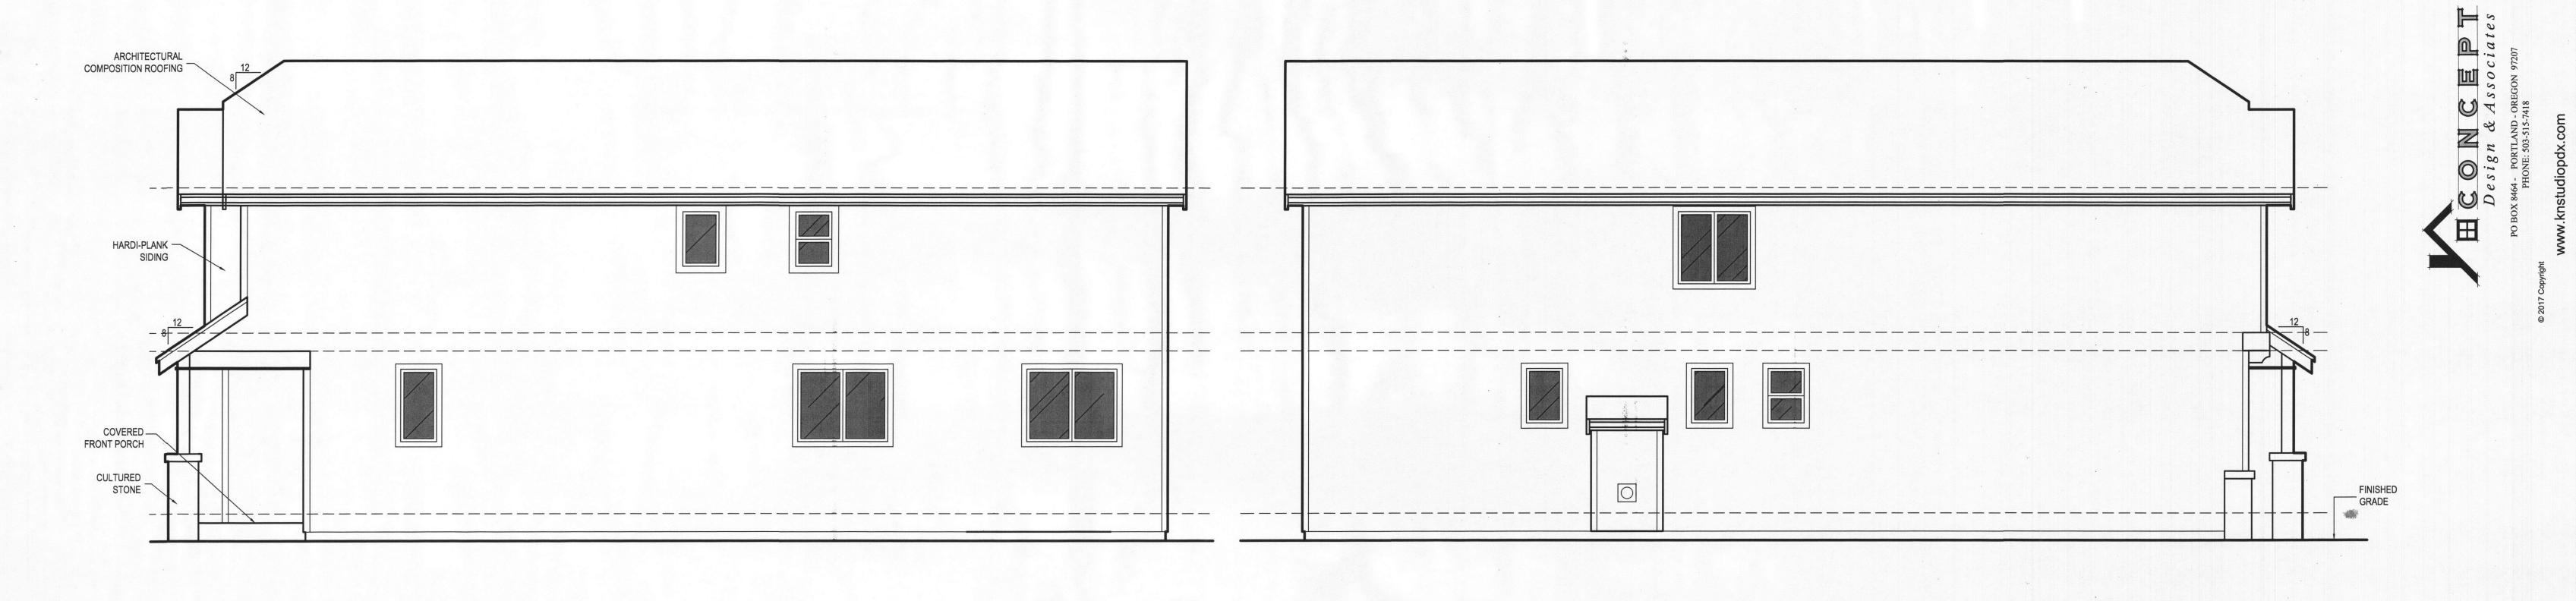

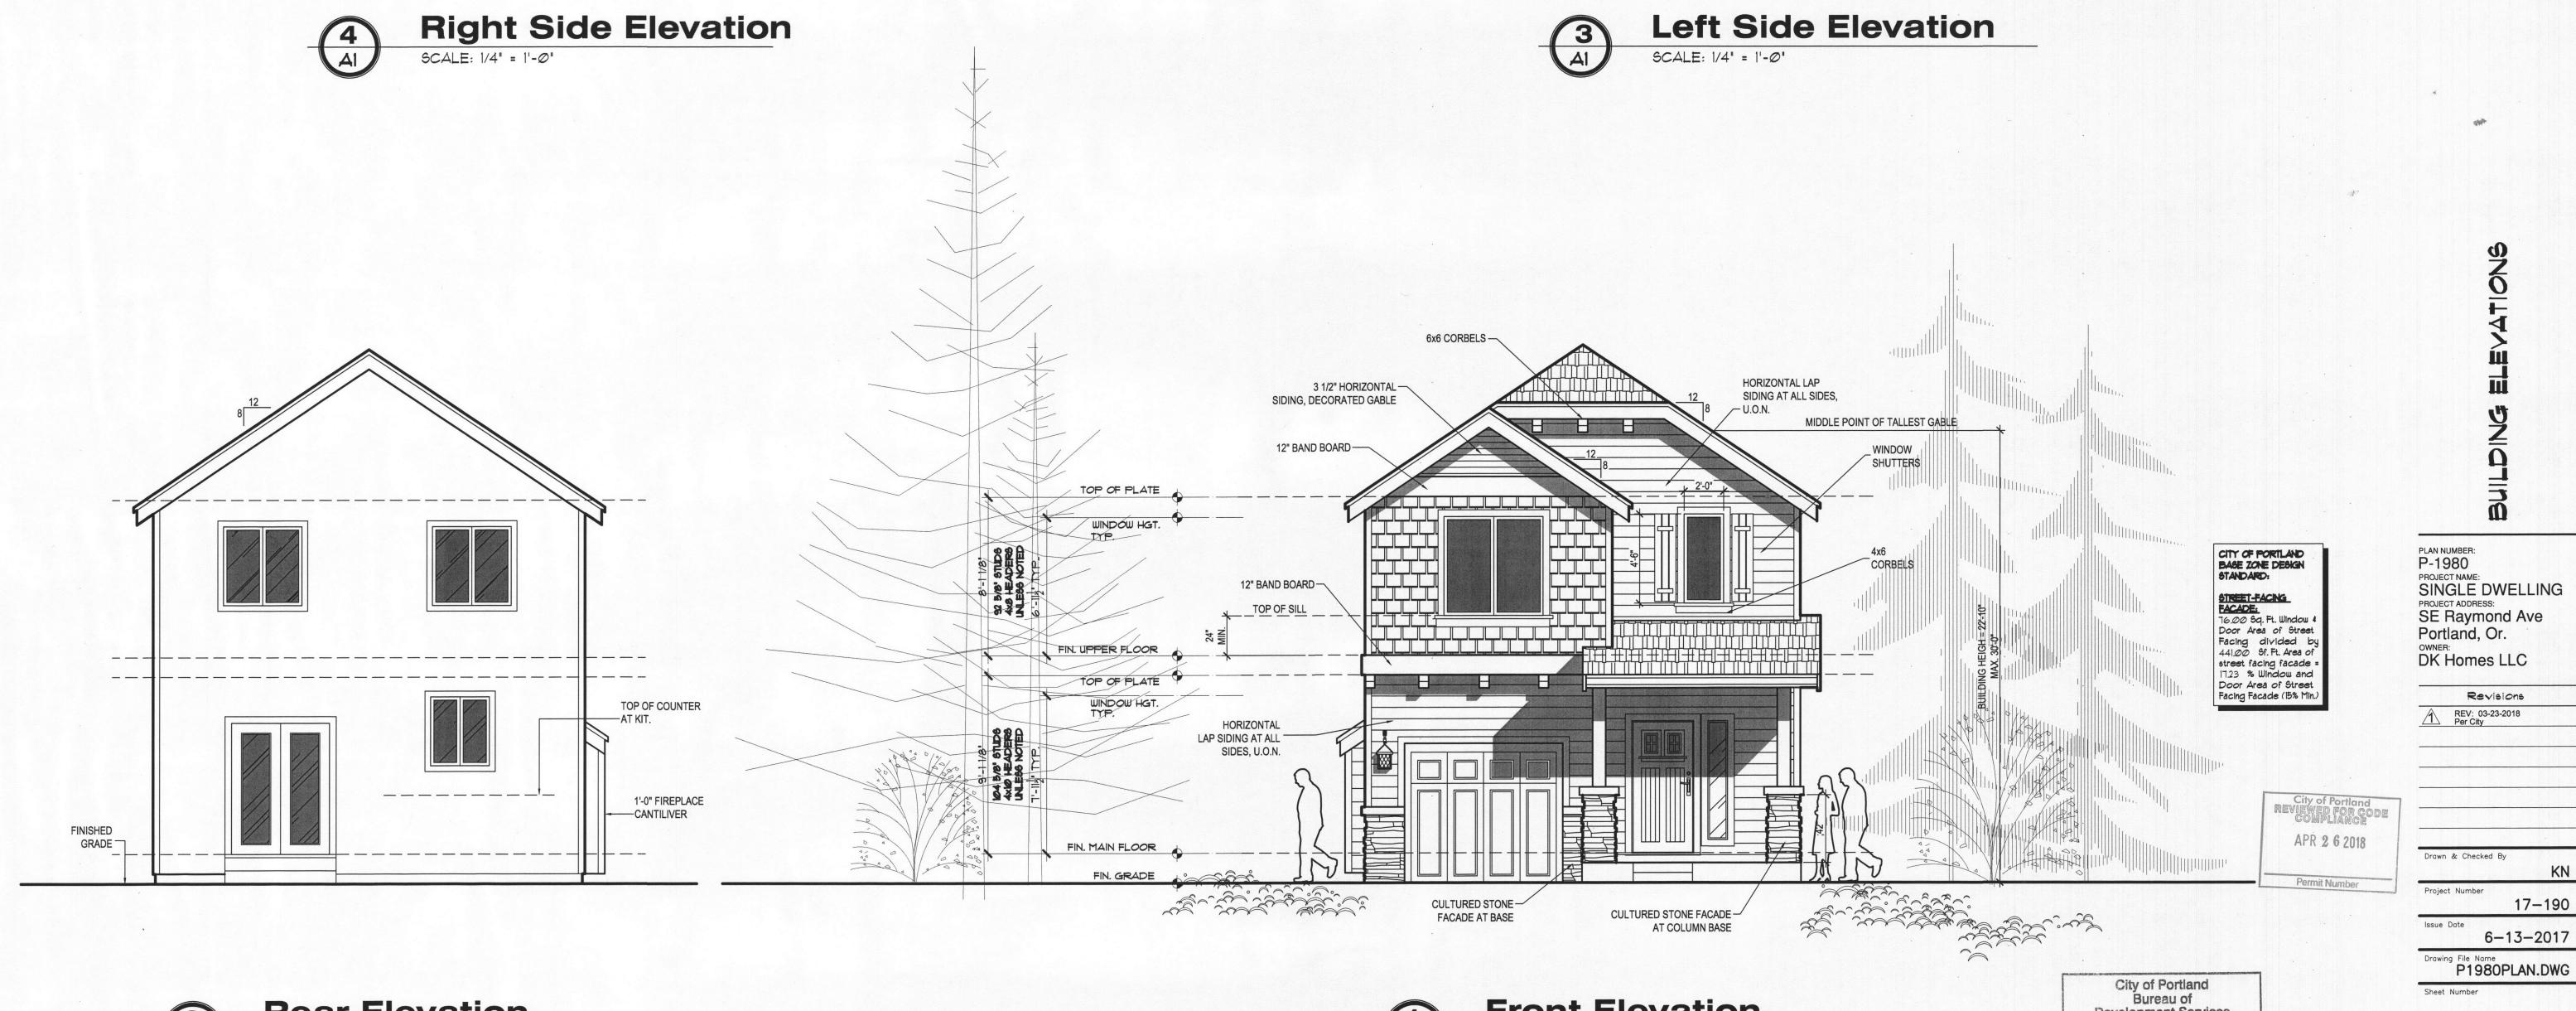

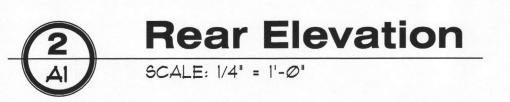

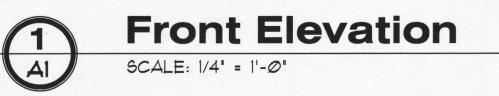


**Development Services** By 1. Mushing Date 4/25/18 Approved by Planning and Zoning Review

Sheet Number DOCUMENT SERVICES

Revisions

6-13-2017

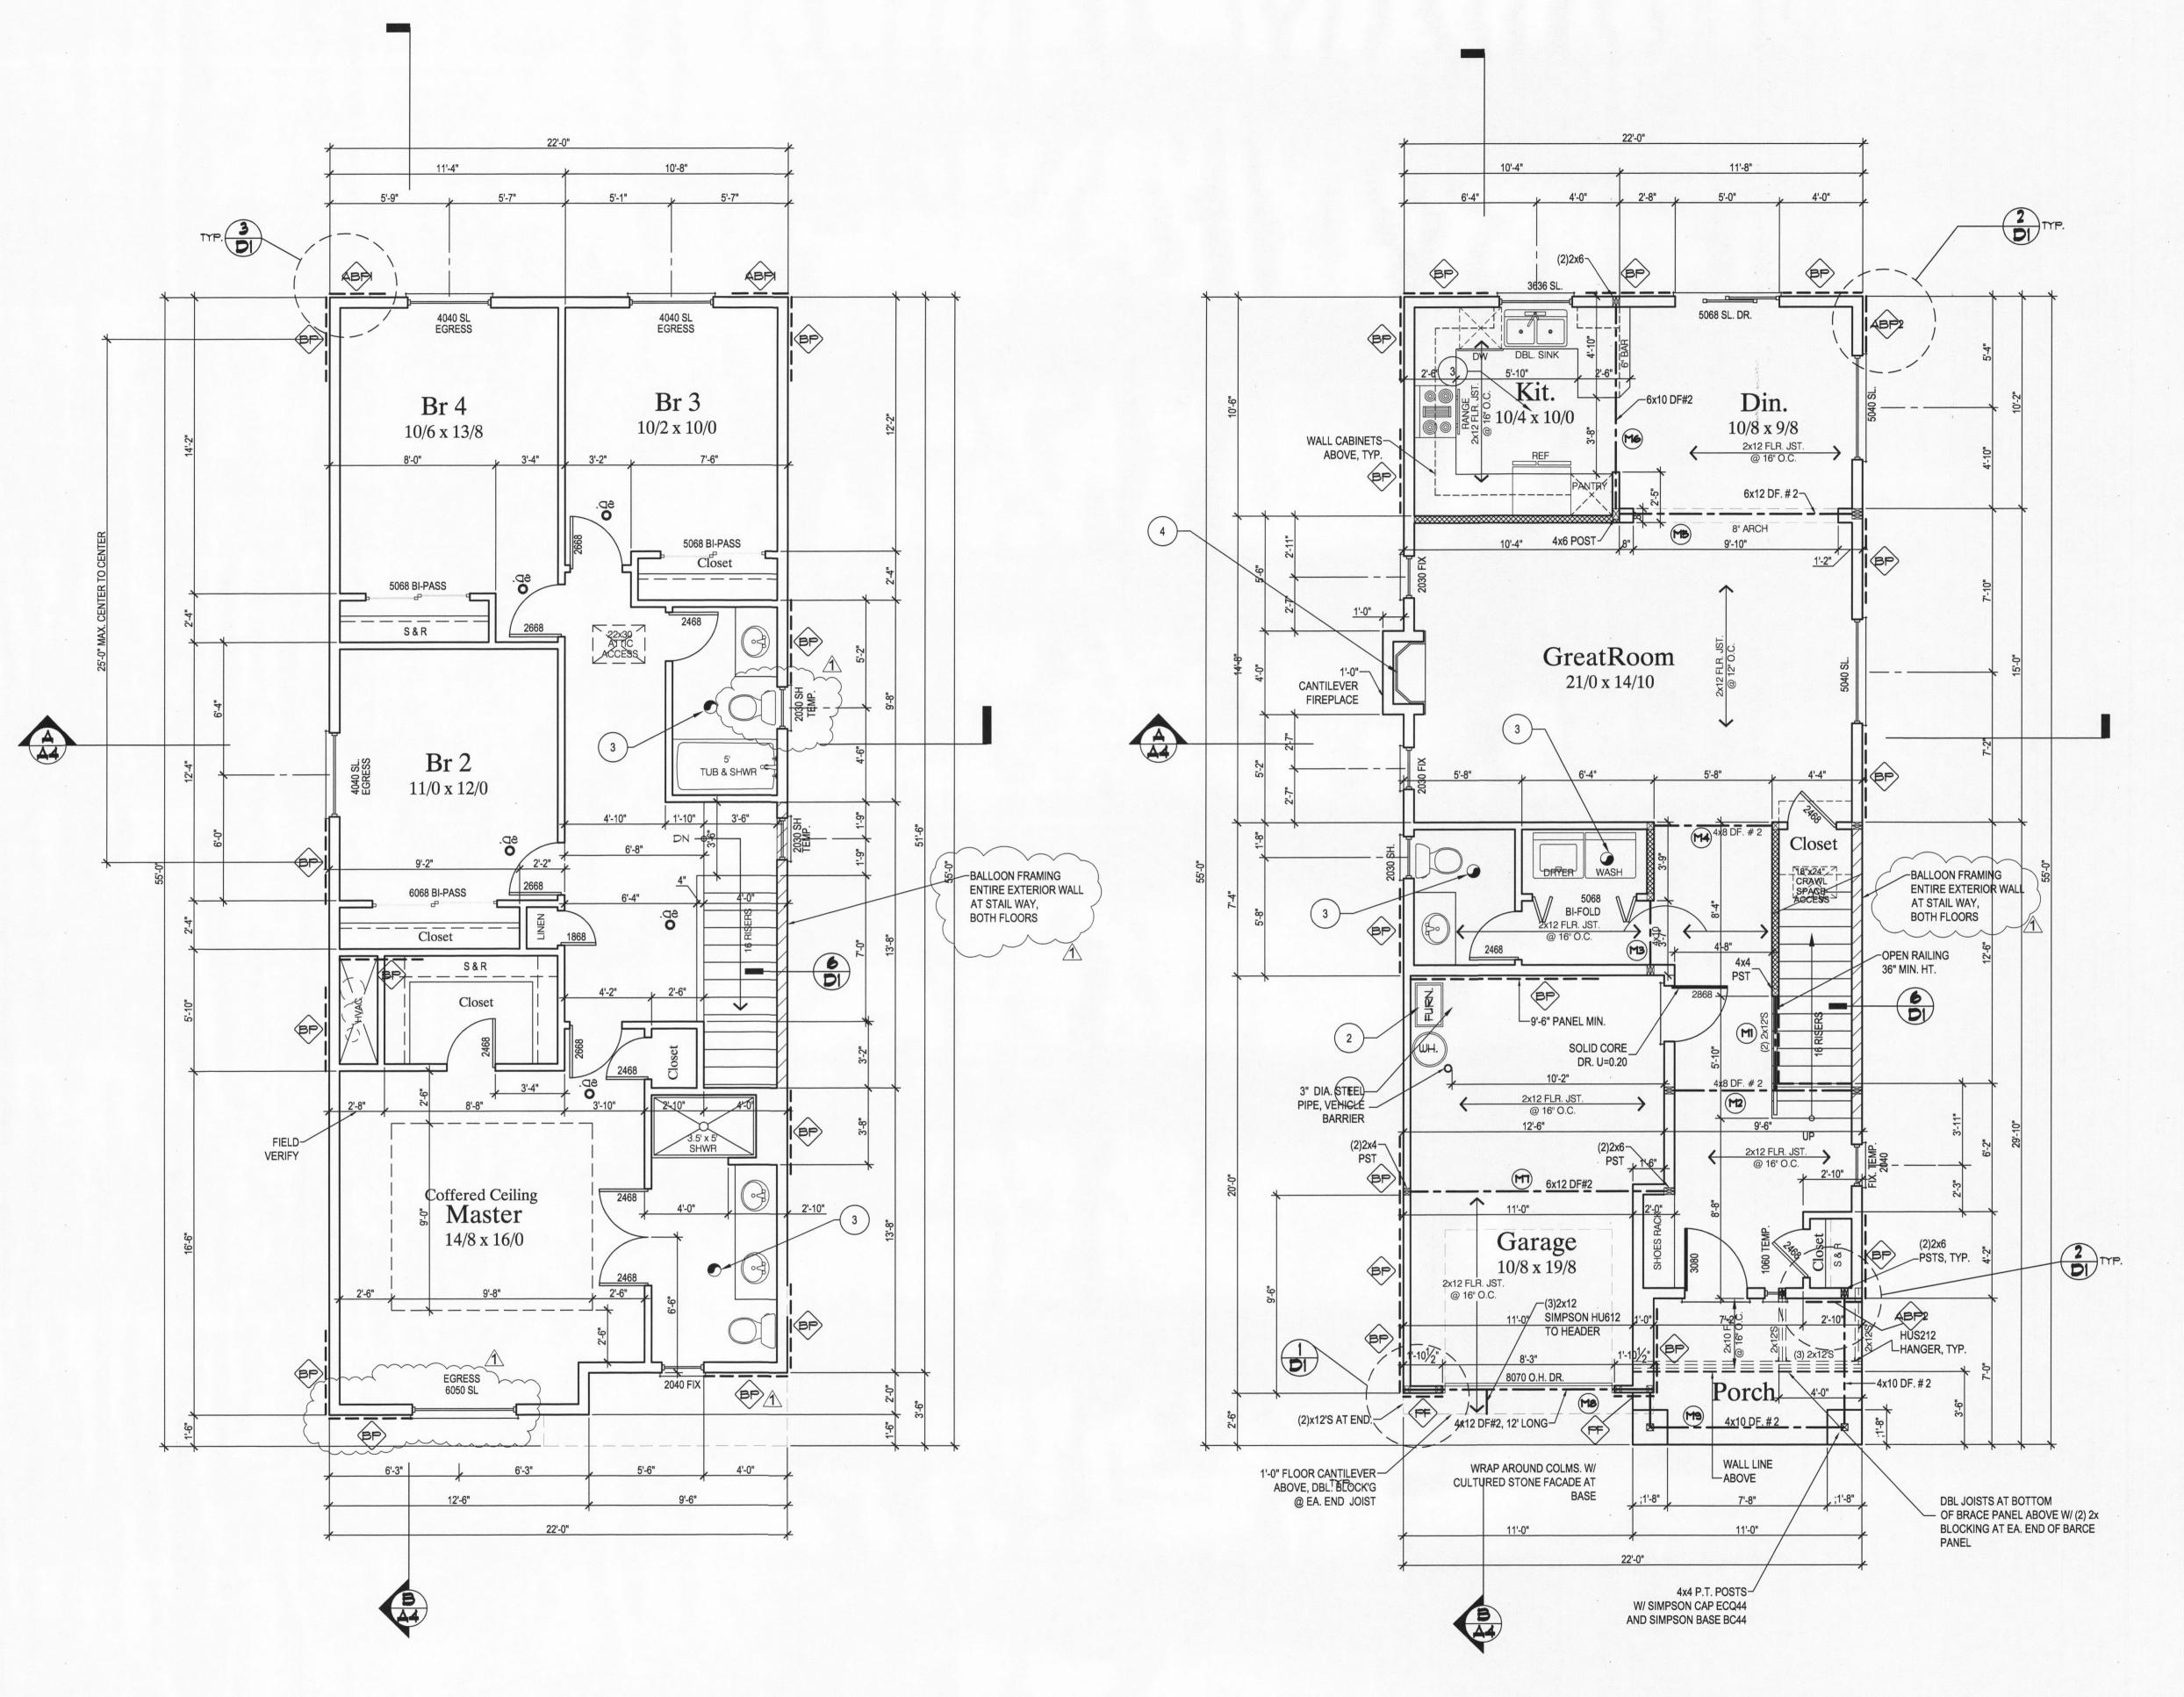

**2ND FLOOR PLAN** SCALE: 1/4" = 1'-0"



LEGEND

INTERIOR BEARING WALL (SUPPORTING STRUCTURE ABOVE)

POINT LOAD FROM ABOVE BEARING POINT LOCATION AT WALL

PROVIDE SOLID BEARING, MIN. OF MEMBER WIDTH, UNLESS NOTED

110Y SMOKE/HEAT DETECTOR W/ BATTERY BACKUP-INNER CONNECT SD. CARBON MONOXIDE ALARM SHALL BE INSTALLED IN EACH SLEEPING ROOM OR WITHIN 15 FEET OUT SIDE EACH SLEEPING ROOM DOOR. CO ALARMS MAY BE HARD-WIRED OR BATTERY-POWERED, CO ALARMS MAY BE COMBINATION SMOKE/ CO ALARMS WHEN INSTALLED AS REQUIRED FOR

# LATERAL BRACING LEGEND:



INDICATED REQUIRED BRACE PANEL, 48" WIDTH w/8d @ 6" O/C EDGES \$ 12" O/C FIELD 3/8" MIN. SHEATHING UNLESS OTHERWISE NOTED



NOTE: \* LOCATION OF ABP, 2=AT FIRST LEVEL, I= AT SECOND LEVEL. ALTERNATE BRACE PANEL, 32" MIN. LENGTH. UNLESS OTHERWISE NOTED



INDICATED PORTAL FRAME LOCATION. 22 1/2" MIN. WIDTH.

NOTE: PER TABLE R602.10.3(1) 1ST STORY 45% BRACING REQUIRED 2ND STORY 20% BRACING REQUIRED THE CENTER-TO-CENTER MAX. 25 FEET AT EACH BRACE PANEL

# KEY NOTES



HIGH EFFIENCY HVAC SYSTEM:
GAS-FIRED FURNACE BOILER WITH MINIMUM AFUE OF 90%

NOTE:
a: FURNACE LOCATED WITHIN THE BUILDING ENVELOPE SHALL HAVE SEALED COMBUSTION AIR INSTALLED. COMBUSTION AIR SHALL BE DUCTED DIRECTLY FROM THE OUTDOORS.

WATER HEATER SHALL ANCHORED OR STRAPPED TO RESIST HORIZONTAL DISPLACEMENT CAUSE BY EARTHQUAKE MOTION. STRAPPING SHALL BE AT POINTS WITHIN THE UPPER ONE-THIRD AND LOWER ONE-THIRD OF WATERHEATER TANK'S VERTICAL DIMENSIONS. STRAPPING SHALL 18" HIGH PLATFORM. INSTALLATION PER MANUFACTOR TO MEET BLDG & PLUMBING CODES.

VENT BATHS, RANGE HOOD W/ 150 CFM, UTILITY FANS TO OUT SIDE

BATHROOM FAN W/ MIN. 80 CFM ON TIMER OR HUMIDISTAT, TYP.

METAL GAS FIREPLACE TO BE INSTALLED FER MANUFACTURES SPECIFICATIONS, PROVIDE OUTSIDE COMBUSTIBLE AIR.

- TOP OF FINISHED SILL @ 24" MIN. TO FINISHED FLOOR AT 2ND LEVEL, TYP.
- PROVIDE STEPS TO FINISHED GRADE, FINISHED PATIO, EQ TREAD W/ MIN. 10" & EQ RISER W/ MAX 7 3/4"
- DOUBLE JOISTS AT END OF BRACE PANEL,

PLAN NUMBER: P-1980 PROJECT NAME: SINGLE DWELLING PROJECT ADDRESS:
SE Raymond Ave Portland, Or. OWNER: DK Homes LLC

| 1 | REV: 03-23-20<br>Per City |
|---|---------------------------|
|   |                           |
|   |                           |
|   |                           |

Drawn & Checked By

17-190

6-13-2017

Revisions

City of Portland Bureau of Development Services By L. Daskius Date 4/25/19 Approved by Planning and Zoning Review

APR 2 6 2018 Permit Number


Issue Date P1980PLAN.DWG

860 SF FIRST FLOOR LIVING AREA: 1,120 SF 2ND FLOOR LIVING AREA: 248 SF. GARAGE: 1,980 SF TOTAL LIVING AREA:

A2

Sheet Number


DOCUMENT SERVICES

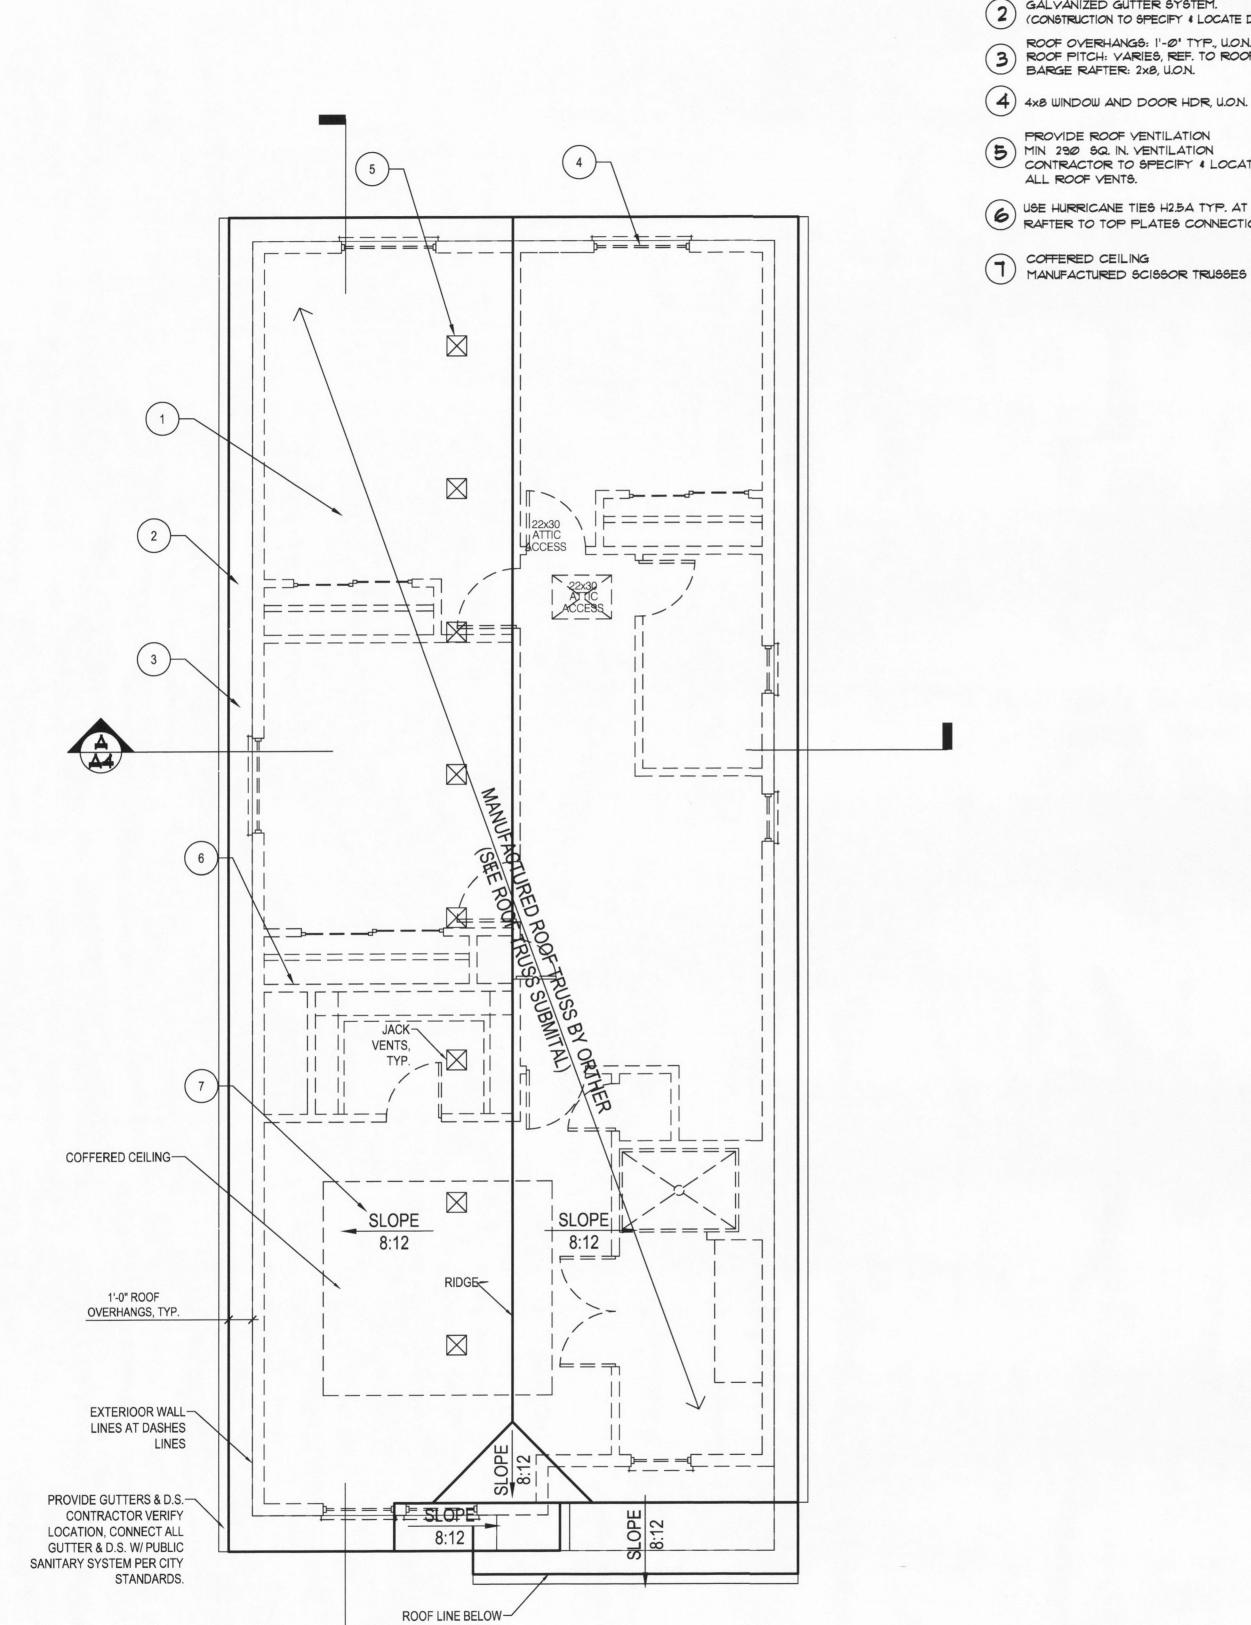

ROOF NOTES & LEGEND:

ARCHITECTURAL COMPOSITION ROOFING.
OVER I LAYER OF 15 \* FELT, UNLESS NOTED.
1/2" ROOF SHEATHING.

ALL ROOF VENTS.

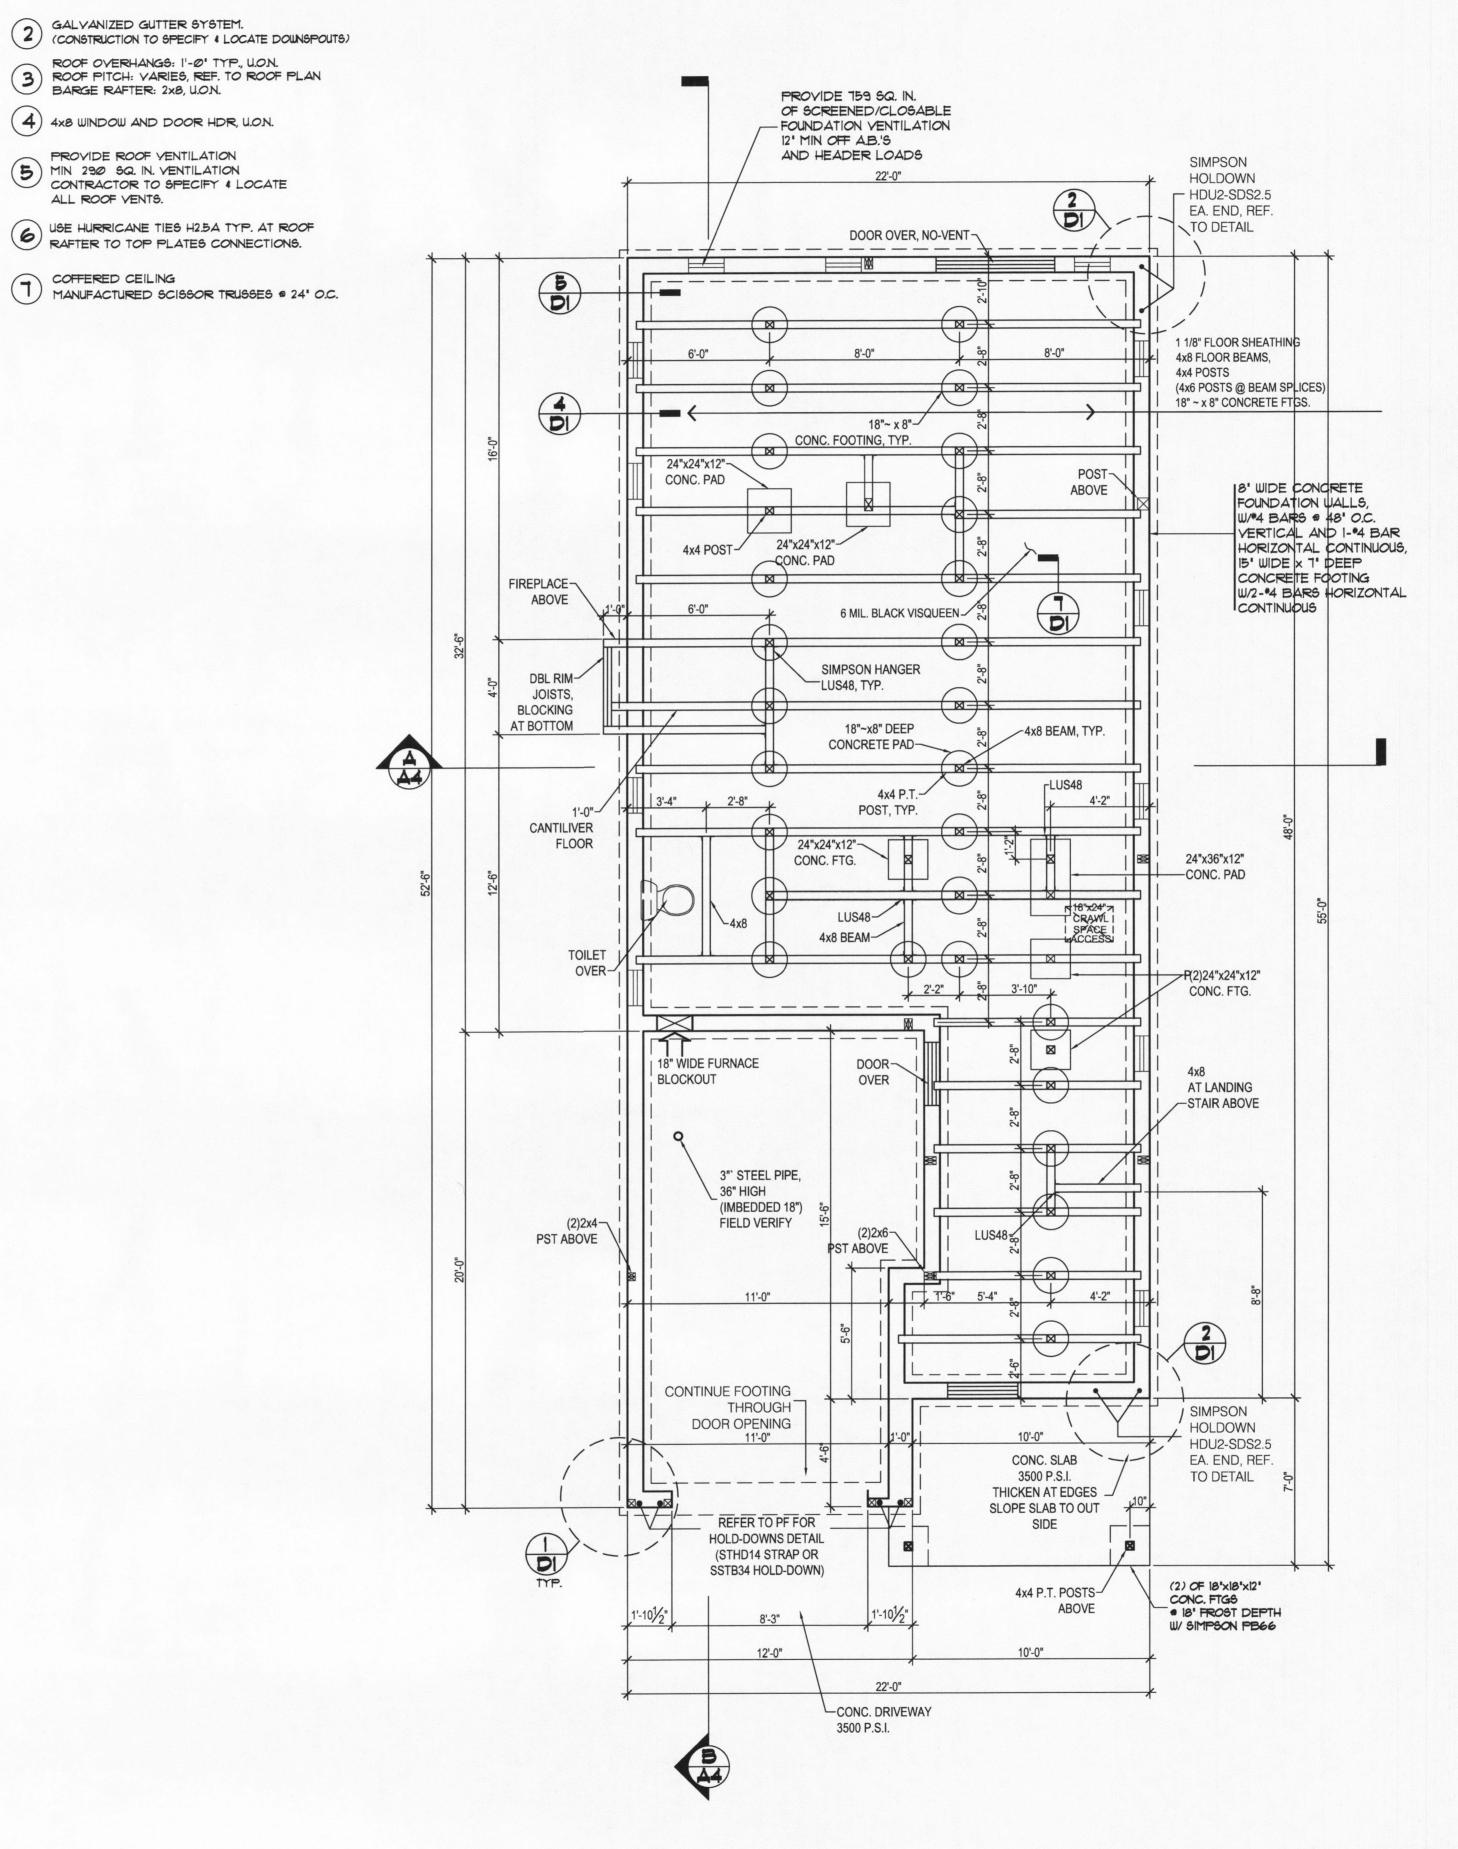

**FOUNDATION PLAN** SCALE: 1/4" = 1'-0"

DK Homes LLC

Drawn & Checked By

6-13-2017 P1980PLAN.DWG

ROOF PLAN

SCALE: 1/4' = 1'-0"

AT FRONT COVERED PORCH

PLAN NUMBER:
P-1980
PROJECT NAME:
SINGLE DWELLING
PROJECT ADDRESS:
SE Raymond Ave
Portland, Or.


Revisions

17-190


City of Portland REVIEWED FOR GODE COMPLIANCE

APR 2 6 2018

Permit Number

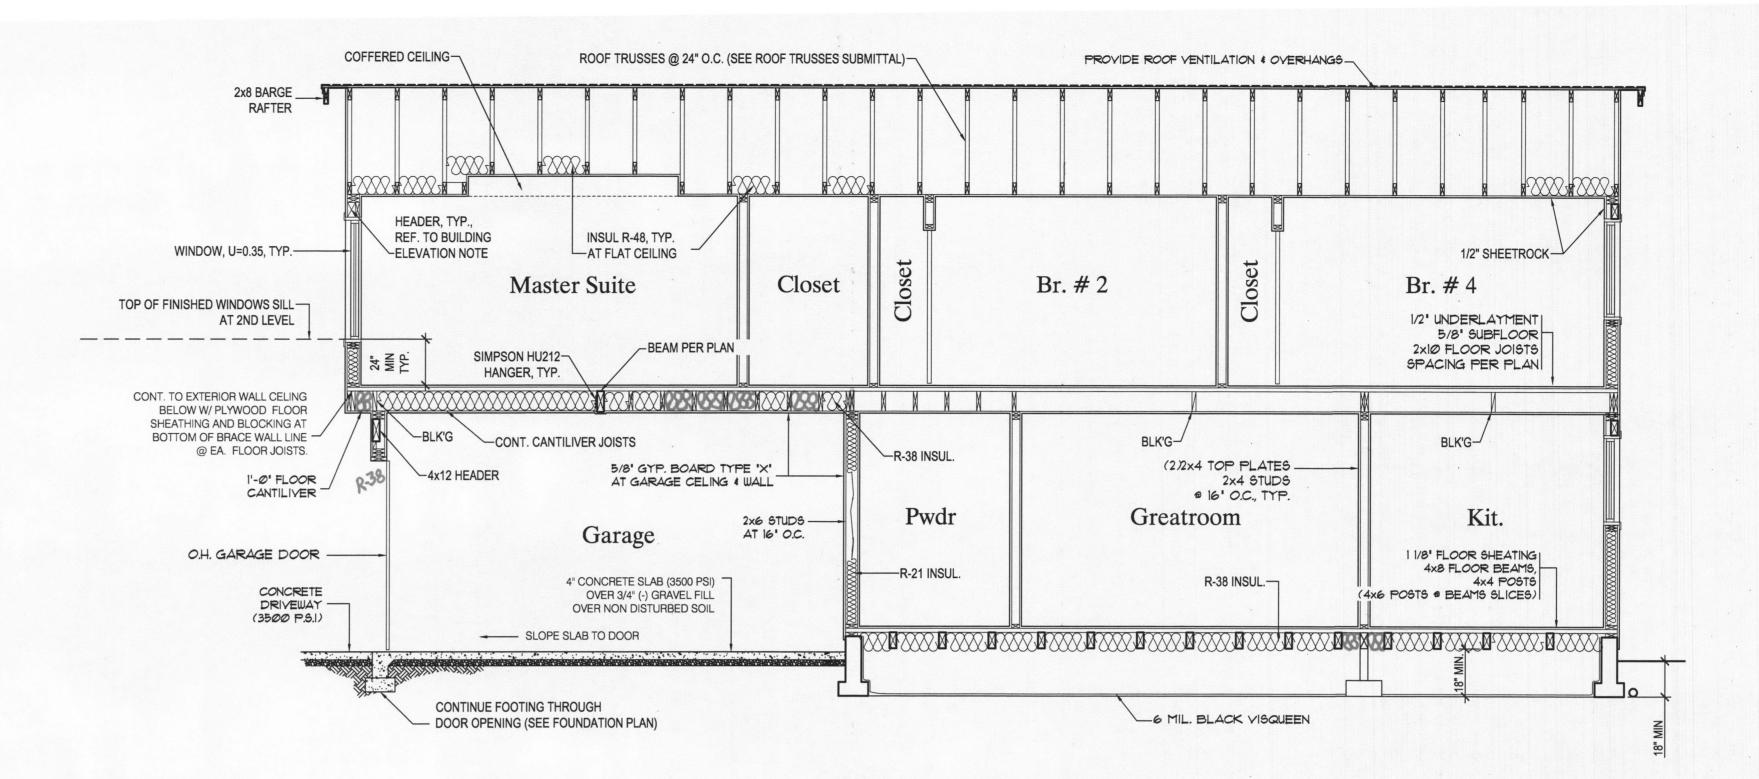



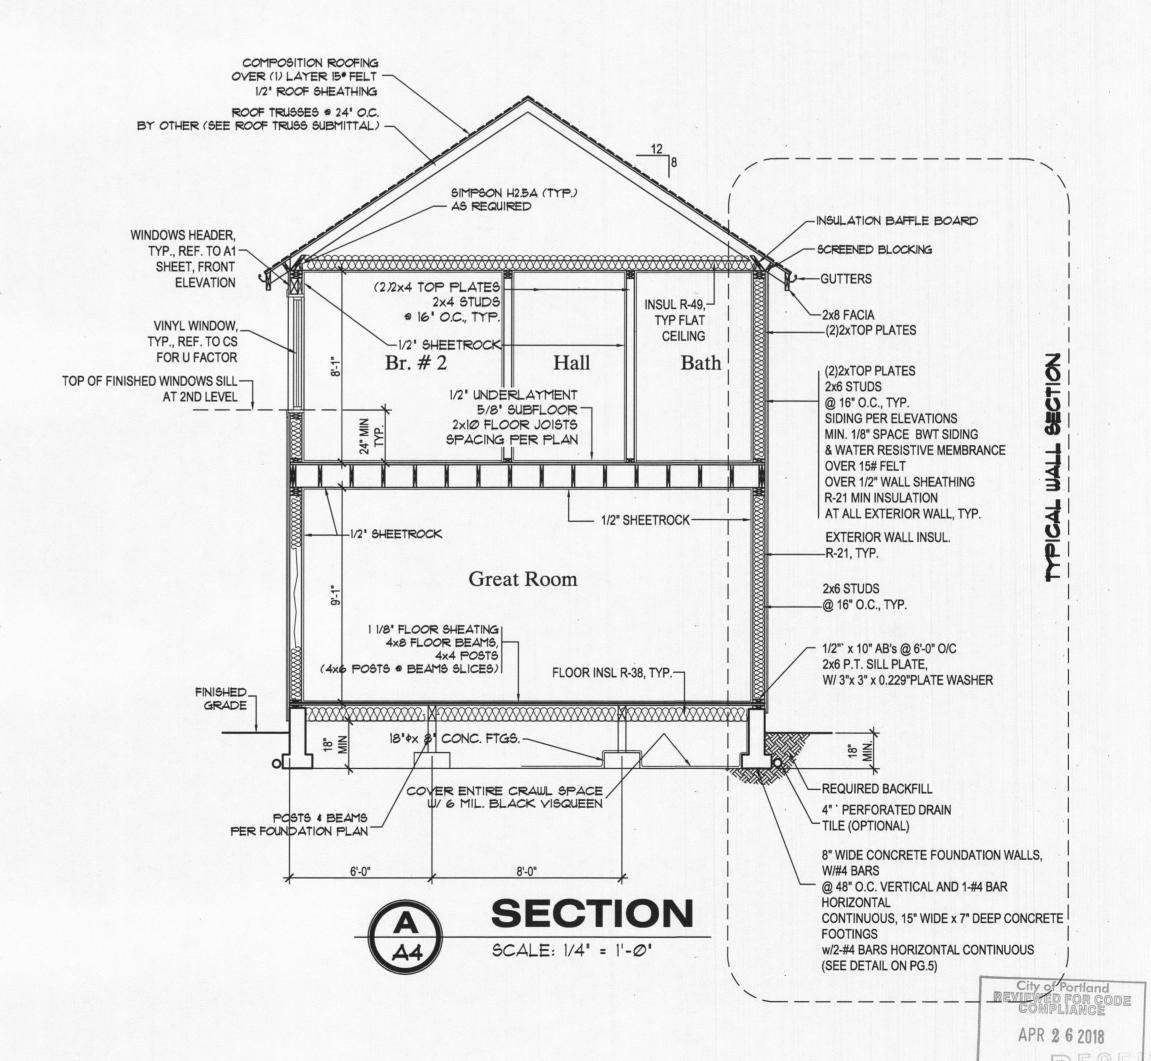

田

P-1980 PROJECT NAME: SINGLE DWELLING PROJECT ADDRESS: SE Raymond Ave Portland, Or. **DK Homes LLC** Revisions REV: 03-23-2018 Per City Drawn & Checked By

17-190

6-13-2017 Drawing File Name P1980PLAN.DWG

**A4** 

Sheet Number

DOCUMENT SERVICES

16 GAUGE (0.0598") STEEL SHEETING MIN 8d FOR 1/2" STRUCTURAL SHEATHING OR 1x (VARIES) NOMINAL MATERIAL, 10d FOR 2x (VARIES) NOMINAL MATERIAL & LARGER NAIL AND SCREW END OR EDGE DISTANCE 8d NAILS, 3/4" #8 SCREWS = 1 1/2-TOP OF FOOTING 10d NAILS, 13/16" #10 SCREWS = 1 5/8

WOOD SCREWS & STAPLES ARE AN ACCEPTABLE ALTERNATE.

NTS

Post & Beam Connections
At Crawl Space

POST 4' OR LESS

(OTHER EQUIVALENT METHODS OK)

SPLICE ONLY

FLOOR BEAM

FULL DEPTH


GUSSET BOTH

SIDES @ SPLICES.

FULL POST WIDTH

(PER PLAN)

STANDARD PRESCRIPTIVE FRAMING 25' ON CENTER MAXIMUM SPACING (STRUCTURAL) \_TOP OF WALL NO ADDITIONAL WALL FRAMING ALLOWED FLOOR FRAMING OPTIONAL ATTACHMENTS-MIN. 4x12 HEADER - CONTINUOUS MIN. 2-2000# STRAPS - NOTE: HEADER WIDTH MUST BE FRONT & BACK, 4 TOTAL THE SAME AS SUPPORT FRAMING. "SIMPSON" STRAP MSTC40 w/16d NAILS SHEATHING SHALL SHEATHING SHALL PROVIDED AT PROVIDED AT MIN. 4000# HOLDOWN, 2 PER PANEL, 4 TOTAL BOTH SIDES BOTH SIDES "SIMPSON" HOLDOWNS FASTENERS PROVIDED OF EACH PANEL OF EACH PANEL 5/8" ROD w/STANDARD NUTS, 2 1/2" O.D. WASHERS AT UPPER CONNECTION AND STANDARD NUTS AND WASHERS AT LOWER CONNECTION MIN. 4x4 EACH SIDE MIN. 5300# HOLDOWN, 2 PER PANEL, 4 TOTAL "SIMPSON" HOLDOWN & ANCHOR BOLTS, SSTB34 INSTALL STANDARD NUTS AND WASHERS AS REQ'D. REF. TO SIMPSON CATALOG. -DOUBLE BOTTOM PLATE \_(2) 1/2" DIA. x 12" AB'S EACH PANEL MINIMUM BUILDING WIDTH IS 12 FEET , 22 1/2" 22 1/2" ~3" CLEAR, MIN. MINIMUM 15"x7" FOOTING WITH MINIMUM MINIMUM ' (2) #4 CONTINUOUS, EXTEND PANEL PANEL WIDTH WIDTH 10' AROUND CORNER.

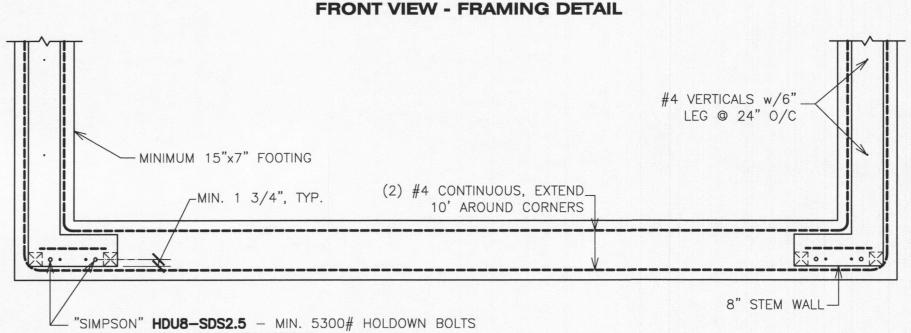


INSTALLED PER MFR. INSTRUCTIONS **TOP VIEW - FOUNDATION DETAIL** 


| NOTES:  1. VERTICAL DOWELS ARE #4 WITH 6" LEG  2. HORIZONTAL WALL REINF. MIN. (1) #4 OR PER HOLDOWN REQUIREMENT WHICH EVER IS MORE RESTRICTIVE.  3. ANCHOR BOLTS ARE (2) 1/2" x 12" MIN./PANEL  4. ROOF IS TO BE SHEATHED WITH A.P.A. RATED STRUCTURAL USE PANELS.  5. NO ADDITIONAL WALL FRAMING ALLOWED. |
|--|
| * THE PANELS AT THE END OF EACH PORTAL FRAME MUST BE EQUAL WIDTH AND HEIGHT  |

Portal Frame
2 Story Structure

City of Portland REVIEWED FOR CODE COMPLIANCE APR 2 6 2018 Permit Number

Project Number Sheet Number

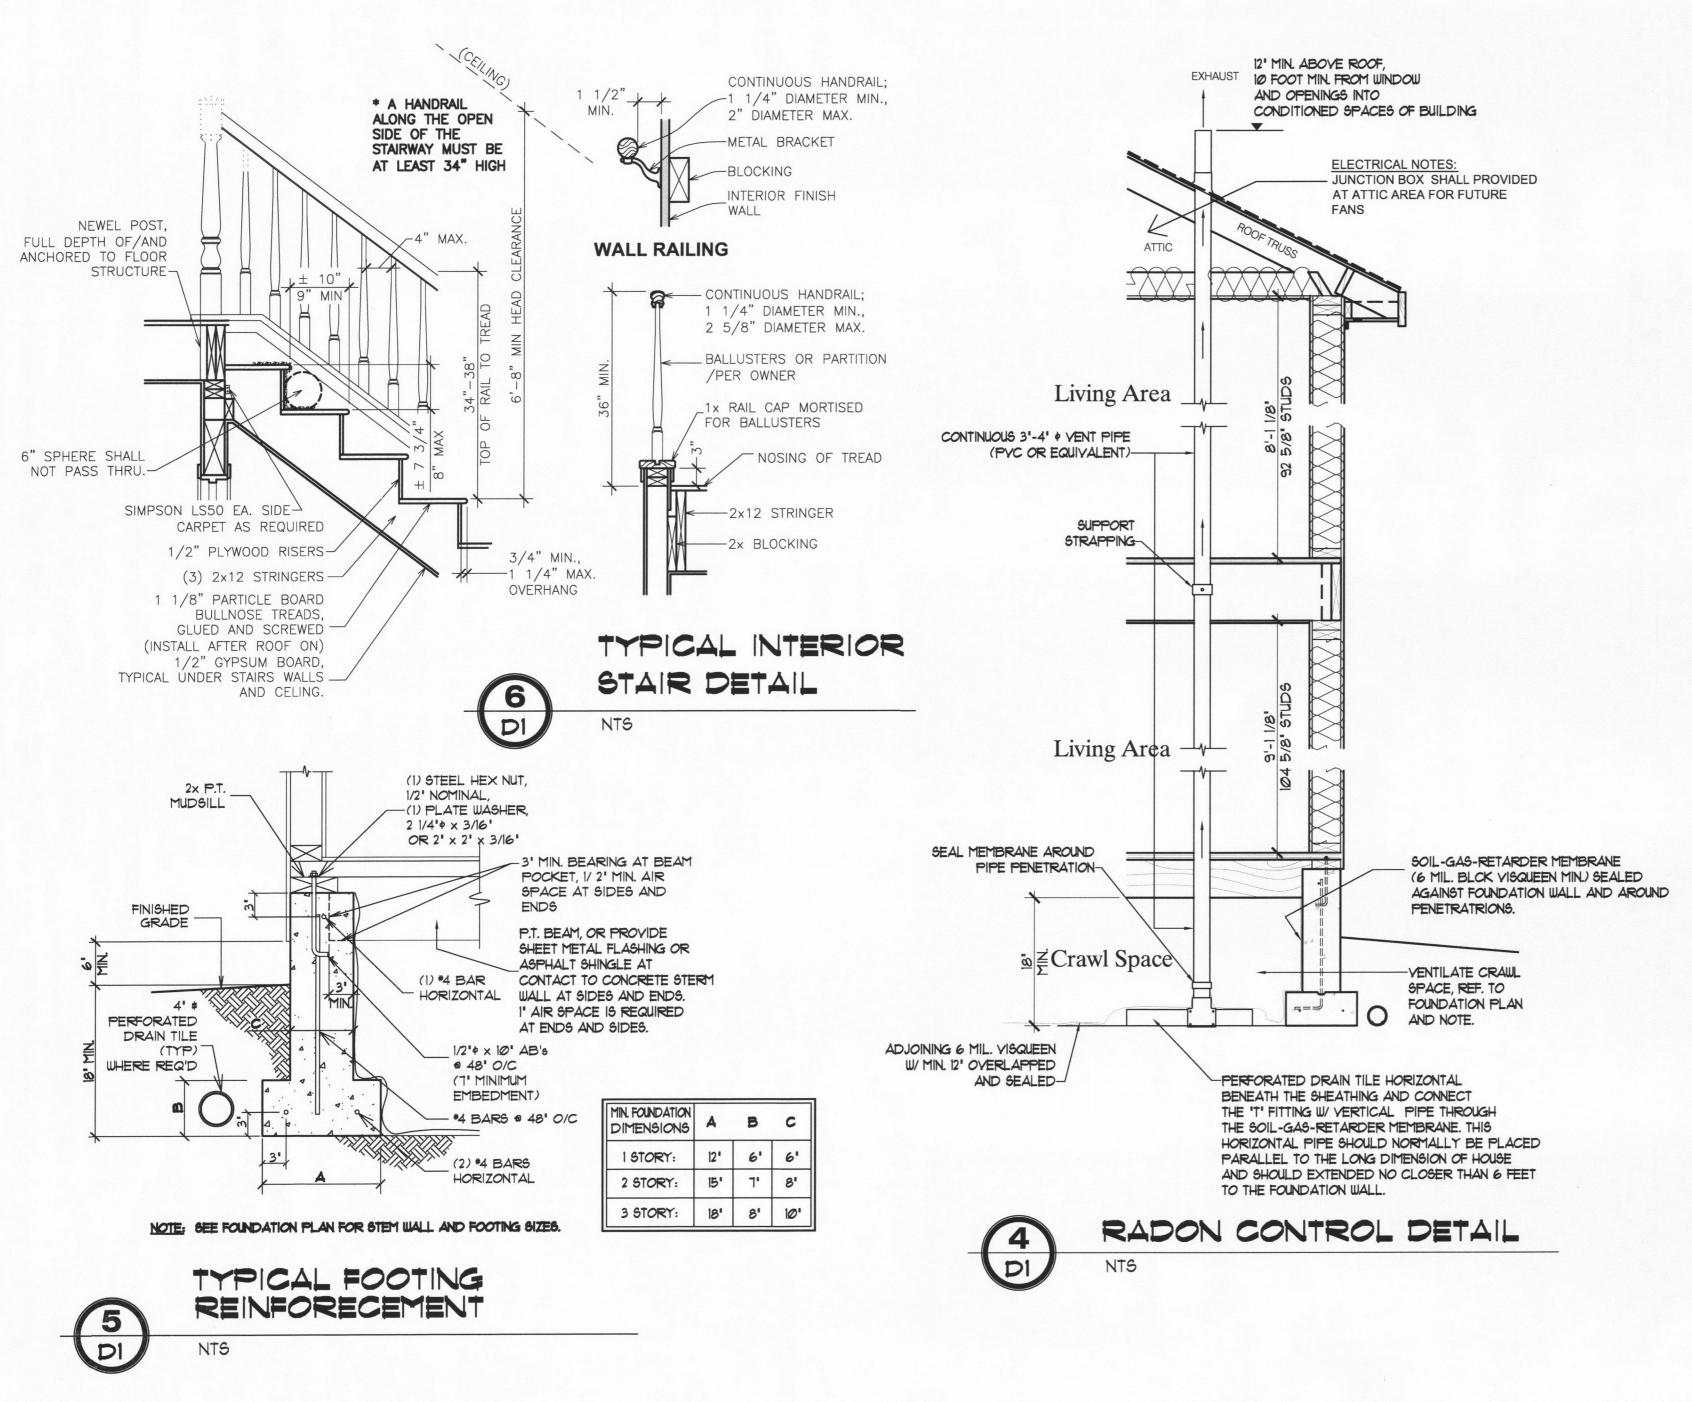

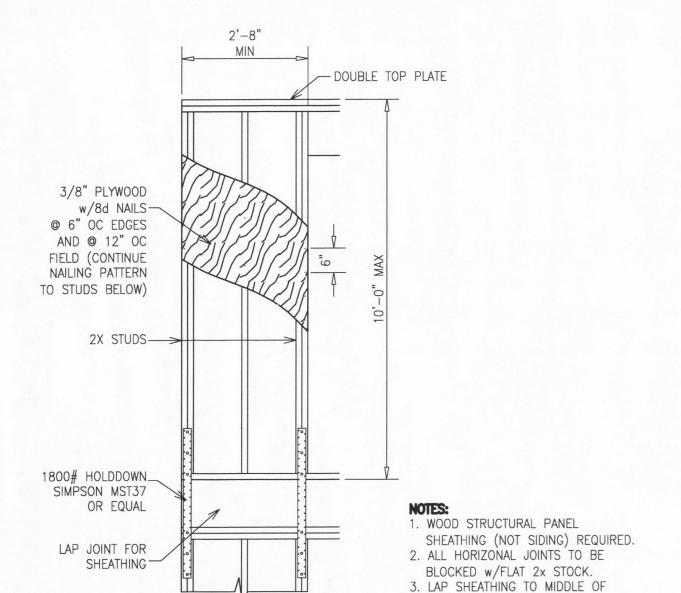


ALTERNATE BRACE PANEL 2ND STORY OF TWO STORY

RIM JOIST AT BASE AND OVER

DOUBLE TOP PLATE FULLY AT TOP.

ABPI DETAIL 3

**FRONT VIEW** 

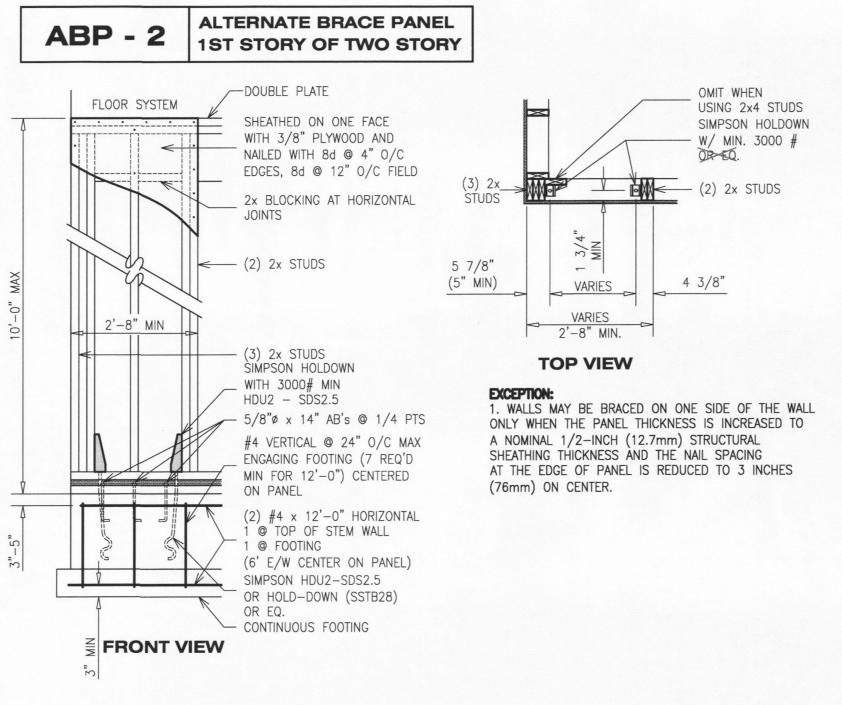



ABP2 DETAIL

5-21-2017 P1995AxPLAN.DWG

17-190

Drawn & Checked By

PLAN NUMBER:

P-1995-A

PROJECT NAME:

PROJECT ADDRESS:

Portland, Or.

SINGLE DWELLING

Revisions

SE Raymond Ave

DK Homes LLC

# General Specifications Sheet

# This sheet forms an integral part of these plans. Please do not detach.

## **GENERAL NOTES**

Thank you for chossing your new home plan from CONCEPT DESIGN & ASSOCITES. Your order for the attached drawing is accepted under the flowing conditions.

The number one cause of plan theft if ignoreance of copyright laws. Many people simply don't realize that is unethecial and illegal to copy the design and construction drawings, even when changes have been made.

All plans are copyrighted, and all rights are reserved uncluding the right of reproducing in whole or in part, except by Concept Design & Associates wrritten consent. These plans may not be reproduced by anyone, by any method including scanning, blueprint, photocopying, photography, tracing, redrawing or any other means. There plans may not be used by anyone for repeat construction, or sales brochures, adverting or any other purpose without the written consent of Concept Design & Associates. There plans may not be knowingly furnished to others for such purposes.

## The use of these plans is limited to specified projects and particular.

a. This right of building only one structure from the plan you have purchased is granted exclusively to the owner/builder except where you have purchased the reproducible master. Unlawfull reproduction of our plans absolves Concept Design & Associates from all responsibility as to accuracy of drawings and we may take suitable legal action against the copier under copyright laws.

b. If any building is constructed from our plans other than the one for which the plan was purchased, we have the right under copyright law to recover the value of building less the cost

RESALE OF THESE DRAWINGS IS STRICTLY PROHIBITED. IF FOUND IN POSSESSION OF ILLEGALLY COPIED PLANS YOU AND/OR YOUR BUILDER MAY BOTH FACE SERIOUS CIVIL AND CRIMINAL PENALTIES.

CONCEPT DESIGN & ASSOCIATES WON'T BE HELD ANY RESPONSIBILITIES IN ANY FORMS WHEN PLANS ARE DESIGNED WITHOUT ENGINEERING OREGON OR WASHINGTON LICENSE. PLAN THAT AREA DESIGNED PER PRESCRIPTIVE PATH THAT COMPLY WITH CHAPTER 6, 2008 ORSC, WITH MIN. REQUIREMENTS AND ARE APPROVED BY LOCAL JURISDICTION - BUILDING PERMIT DEPARTMENT.

### **CODES & STANDARDS**

• These plans are comply with the latest abopted version of INTERNATIONAL RESIDENTIAL CODE (IRC), 2014 OREGON RESIDENTIAL SPECIALTY CODE (2011 ORSC) and any applicable State, County or local Regulations.

 Building codes and requirements can change and may vary from jurisdiction to jurisdiction. It is the responsibility you and/ or your builder of this plan to see that the structure is built in compliance with local code requirements.

 The Contractor is responsible to check the plans for any error or omissions and notify Concept Design & Associates prior to the start of constructions.

Written dimensions have precedence over scaled dimensions. Do not scale drawings.

• In the case of high snow loads, wind loads, seismic requirements or unusual site conditions, non standard foundations or beam sizes beyond the scope of spand tables contained in Chapter 16 of the International Residential Code (IRC), the owner/builder may be required to provide at his/her expense an engineers report. Please consult with your local building authorities.

 Any variances from the structural drawings and specifications or from conditions encountered at the job site, shall be resolved by the owner/builder and such solutions shall be their sole responsibility. The builder is to provide all necessary temporary support for walls and floors prior to the completion of vertical and lateral load systems. All workmanship is to be of a standard equal in all respects to good building practice.

 CONCEPT DESIGN & ASSOCIATES shall not be liable for damages resulting from any deviation, variations and/or revisions whatsoever, undertaken by any party other than CONCEPT DESIGN & ASSOCIATES, in specifications, structure or other instructions contained in these plans.

- Truss layout to be confirmed by manufactor trusses prior to start of constructions. • Trusses to be engineered by truss fabricator and installed and braced as per fabricator's
- Owner/builder to obtain Engineer's certificate from manufacturer of floor and roof trusses.

**ROOF DESIGN** 

- All roofing shall be applied according to the manufaturer's recommendations and conform to Section R901 of 2011 ORSC
- Each course of wood shakes to be interlaid with 18" wide strip of No. 15 roofing felt. Lap 6" at hips and ridges in a manner that will prevent water from reaching the roof sheathing.

| Cedar Shakes<br>Asphalt Shingles | 25 PSF      | 15 PSF        | 42 PSF               |
|----------------------------------|-------------|---------------|----------------------|
| Concrete Tile                    | 25 PSF      | 20 PSF        | 52 PSF               |
| FLOOR DESIGN<br>LOAD             | Live Load   | Dead Load     | Total Design<br>Load |
| Carpet/Sheet vinyl flooring      | 40 PSF      | 12 PSF        | 50 PSF               |
| Ceramic tile over plywood        | 40 PSF      | 25 PSF        | 65 PSF               |
| Exterior<br>Balcony/Deck         | 60 PSF      | 7 PSF         | 67 PSF               |
| Ceilings                         | 10 PSF      | 5 PSF         | 15 PSF               |
| Garage floor                     | 50 PSF, 200 | 0# POINT LOAD |                      |
| Stair                            | 100 PSF     |               | 100 PSF              |

Design loads may vary in your area, consult with a local structural engineer for

| LUMBER GRADES (BEAM CA<br>GRADE | LCULATIONS TAKE PRECEDENCE OVER TABLE BELOW<br>STRUCTURAL MEMBER |
|---------------------------------|--|
| DF NO. 1                        | Beams  |
| DF NO. 1                        | Headers 8'-0" or Longer  |
| DF NO. 2                        | Headers less than 8'-0"  |
| DF NO. 2                        | Roof rafters, joists & posts                                     |
| 24F-V4                          | Glu-lam beams  |
| DF NO. 3                        | Sills, plates, blocking, brigding, etc.                          |
| STUD GRADE DF                   | Studs  |
| DF NO. 2                        | studs over 10'-0" high   |

## CONCRETE AND FOUNDATIONS

- 1. Soil bearing pressure assumed to be 1500 PSF
- 2. Footings to bear on undisturbed level soil devoide of organic materical and stepped as
- required to maintain a minimun of 18" below final grade. All slabs on grade shall bear on 4" compacted granular fill.
- Concrete: (28 dar compressive strength)
- 2500 PSI Basement walls and foundations not exposed to the weather; Basement, foundation and exterior walls;
- 3000 PSI Basement, foundation and exterior walls; Other vertical concrete work exposed to the weather
- 3500 PSI Porches, carport slabs and steps exposed to the weather; Garage floor slab 5. Concrete slabs to have control joints at 25' maximun intervals each way.
- 6. Reinforcing steel to be A-615 Grade 40, Welded wire mesh to be A-185 Cover entire crawl space with 6 mil. black "Visqueen" and extended up to foundation
- walls to pressure treeated sill plate. 8. Crawl space vents are to be closable with 1'4" openings in corrosive resistant screen.
- Post closable vent notice on electric panal door.
- 9. Provide crawl space drain & slope to low point for positive drainage. 10. Beam pockets in concrete to have 1/2" airspace at sides and end with a mininum bearing
- of 3 inches. 11. All wood in contact with concrete to be pressure treated or protected with 55# roll roofing

### **MISCELLANEOUS**

- For exact specifications & locations of lights, switches & outlets.
- Basement with habitable space and every sleeping room shall have at least one opening for emergency escape and every sleeping room shall have at least
- a. A sill height of not more than 44 inches above the floor.
- b. The minimun net clear opening shall be 5.7 sq. ft.
- c. Grade floor openings shall have a minimun net clear opening of 5 sq. ft. d. The minimun net cleat opening height shall be 20 inches.
- e. The minimun net clear opening width shall be 20 inches.
- All windows within 18" of the floor and 24" of doors to be tempereed glazing
- All skylight to be tempered glazing.
- All tub & shower glass enclosures are to be safty glazing. All windows & patio doors are to be double glazed. Exterior doors are to be solid core with
- Backfill for positive slope away fromt he structure with slope no less than 6 inches in the first
- 10 inches and no greater than 6:12 Do not excavate greater than a 1 1/2 : 2 slope below footings
- Maintain 6 inches minimun space from ground to wood siding.

### SIMPSON STRONG - TIE

Simpson recommends using this chart when selecting which product finish works best with the pressure treated wood you are using. If the pressure treated wood you are unsing does not appear by name, then Simpson recommends you use the "other presure-treated woods" column and use only stainless steel connectors and fasteners. Refer to current simpson products for more inforation.

| DESCRIPTION OF BUILDING ELEMENTS   | NUMBER & TYPE OF<br>FASTENER a, b, c        | SPACING OF FASTENERS  |  |
|--|---|---|--|
| JOIST TO SILL OR GIRDER, TOE NAIL  | 3-8d (2-1/2"X0.113")                        | -   |  |
| 1" x 6" SUBFLOOR OR LESS TO EACH JOIST, FACE NAIL                                    | 2-8d( 2 1/2" X 0.113"<br>2 STAPLES, 1 3/4"  |   |  |
| 2" SUBFLOOR TO JOIST OR GIRDER, BLIND AND FACE NAIL                                  | 2-16d(3 1/2"X0.035")                        | -   |  |
| SOLE PLATE TO JOIST, SOLID DECK OR BLOCKING, FACE NAIL                               | 16d(3 1/2"X0.135")                          | 16" O/C   |  |
| TOP OR SOLE PLATE TO STUD, END NAIL  | 2-16d(3 1/2"X0.135")                        | -   |  |
| STUD TO SOLE PLATE, TOE NAIL   | 3-8d or 2-16d                               | -   |  |
| DOUBLE STUDS, FACE NAIL  | 10d(3"X0.128")                              | 24" O/C   |  |
| DOUBLE TOP PLATES, FACE NAIL   | 10d(3"X0.128")                              | 24" O/C   |  |
| SOLE PLATE TO JOIST, SOLID DECK OR BLOCKING AT BRACED WALL PANELS                    | 3-1/6d (3 1/2"X 0.135")                     | -   |  |
| DOUBLE TOP PLATES, MINIMUM 48-INCH OFFSET OF END JOINTS, FACE<br>NAIL IN LAPPED AREA | 8-16d(3 1/2"X0.135")                        | -   |  |
| BLOCKING BETWEEN JOISTS OR RAFTERS TO TOP PLATE, TOE NAIL                            | 3-8d(2 1/2"X0.113")                         | -   |  |
| RIM JOIST TO TOP PLATE, TOE NAIL   | 8d(2 1/2"X0.113")                           | 6" O/C  |  |
| TOP PLATES, LAPS AT CORNERS AND INTERSECTIONS, FACE NAIL                             | 2-10d(3"X0.128")                            | -   |  |
| BUILT-UP HEADER, TWO PIECES WITH 1/2" SPACER   | 16d(3 1/2"X0.135")                          | 16" O/C ALONG EACH EDGE   |  |
| CONTINUED HEADER, TWO PIECES   | 16d(3 1/2"X0.135")                          | 16" O/C ALONG EACH EDGE   |  |
| CEILING JOISTS TO PLATE, TOE NAIL  | 3-8d(2 1/2"X0.113")                         | -   |  |
| CONTINUOUS HEADER TO STUD, TOE NAIL  | 4-8d(2 1/2"X0.113")                         | - ·   |  |
| CEILING JOIST, LAPS OVER PARTITIONS, FACE NAIL                                       | 3-10d(3"X0.128")                            | -   |  |
| CEILING JOIST TO PARALLEL RAFTERS, FACE NAIL   | 3-10d(3"X0.128")                            | -   |  |
| RAFTER TO PLATE, TOE NAIL  | 2-16d(3 1/2"X0.135")                        | -   |  |
| 1" BRACE TO EACH STUD AND PLATE, FACE NAIL   | 2-8d(2 1/2" X 0.135"<br>2 STAPLES, 1 3/4"   | -   |  |
| 1" x 6" SHEATHING TO EACH BEARING, FACE NAIL   | 2-8d(2 1/2" X 0.135"<br>2 STAPLES, 1 3/4"   | -   |  |
| 1" x 8" SHEATHING TO EACH BEARING, FACE NAIL   | 2-8d(2 1/2" X 0.135"<br>3 STAPLES, 1 3/4"   | -   |  |
| WIDER THAN 1" x 8" SHEATHING TO EACH BEARING, FACE NAIL                              | 3-8d(2 1/2"X0.113")<br>4 STAPLES, 1 3/4"    |   |  |
| BUILT-UP CORNER STUDS  | 10d(3"X0.128")                              | 24" O/C   |  |
| BUILT-UP GIRDERS AND BEAMS, 2-INCH LUMBER LAYERS                                     | 10d(3"X0.128")                              | NAIL EACH LAYER AS FOLLOWS:<br>32" O/C AT TOP AND BOTTOM AND<br>STAGGERED. TWO NAILS AT ENDS<br>AND AT EACH SPLICE. |  |
| 2" PLANKS  | 2-16d(3 1/2"X0.135")                        | AT EACH BEARING   |  |
| ROOF RAFTERS TO RIDGE, VALLEY OR HIP RAFTERS:<br>TOE NAIL<br>FACE NAIL               | 4-16d(3 1/2"X0.135"<br>3-16d(3 1/2"X0.135") | _   |  |
| RAFTER TIES TO RAFTERS, FACE NAIL  | 3-8d(2 1/2"X0.113")                         | -   |  |
|  | 3-10d(3"X0.128")                            |   |  |

| DESCRIPTION OF BUILDING                           |         | DESCRIPTION OF FASTENER  | SPACING OF FASTENERS           |   |  |
|---|---------|--|--------------------------------|---|--|
| MATERIALS   |         | b, c, d, e   | EDGES <sup>i</sup><br>(INCHES) | INTERMEDIATE SUPPORTS <sup>c, e</sup><br>(INCHES) |  |
| WOOD STRUCTURAL PANEL                             | S, SUBF | LOOR, ROOF AND WALL SHEATHING TO FRAMING,  | AND PARTICLE BOARD W           | ALL SHEATHING TO FRAMING                          |  |
| 5/16" - 1/2"                                      |         | MMON NAIL(2"x0.113") NAIL (SUBFLOOR, WALL) MMON NAIL(2 1/2"x0.131") NAIL (ROOF) f  | 6                              | 12 <sup>g</sup>                                   |  |
| 19/32" - 1"                                       | 8d CON  | MMON NAIL(2 1/2"x0.131")   | 6                              | 12 <sup>g</sup>                                   |  |
| 1 1/8" - 1 1/4"                                   |         | MMON(3"x0.148") NAIL or<br>2'x0.131")DEFORMED NAIL   | 6                              | 12  |  |
|   |         | OTHER WALL SHEATHIN  | IG <sup>h</sup>                |   |  |
| 1/2" STRUCTURAL CELLULOS<br>FIBERBOARD SHEATHING  | SIC     | 1 1/2" GALVANIZED ROOFING NAIL 8d<br>COMMON NAIL (21/ 2"x0.131");<br>STAPLE 16 GA., 1 1/2" LONG  | 3                              | 6   |  |
| 25/32" STRUCTURAL CELLULOSIC FIBERBOARD SHEATHING |         | 1 3/4" GALVANIZED ROOFING NAIL 8d<br>(2 1/2"x0.131") NAIL<br>STAPLE 16 GAGE, 1 3/4" LONG   | 3                              | 6   |  |
| 1/2" GYPSUM SHEATHING                             |         | 1 1/2" GALVANIZED ROOFING NAIL;<br>6d COMMON NAIL(2"x0.131") NAIL<br>STAPLE GALVANIZED, 1 1/2" LONG;<br>1 1/4" SCREWS, TYPE W or S     | 4                              | 8   |  |
| 5/8" GYPSUM SHEATHING                             |         | 1 3/4" GALVANIZED ROOFING NAIL;<br>8d COMMON NAIL(2 1/2"x0.131") NAIL<br>STAPLE GALVANIZED, 1 5/8" LONG;<br>1 5/8" SCREWS, TYPE W or S | 4                              | 8   |  |
| WOOL  | STRU    | JCTURAL PANELS, COMBINATION SUBFLO   | OR UNDERLAYMENT                | TO FRAMING  |  |
| 3/4" AND LESS                                     |         | 6d DEFORMED(2'x0.120")NAIL or 8d COMMON<br>(2 1/2"x0.131") NAIL  | 6                              | 12  |  |
| 7/8" - 1"   |         | 8d COMMON(2 1/2"X0.131" NAIL or 8d DEFORMED<br>(2 1/2"X0.120" NAIL   | 6                              | 12  |  |
| 1 1/8" - 1 1/4"                                   |         | 10d COMMON(3"X0.148") NAIL or 8d DEFORMED<br>(2 1/2"X0.120")NAIL   | 6                              | 12  |  |

## FOR SI: 1 INCH = 25.4mm, 1 FOOT = 304.8mm, 1 MILE PER HOUR = 1.609 km/h

HEIGHT IS MORE THAN 25 FEET, UP TO 35 FEET MAXIMUM.

- a. ALL NAILS SHALL BE SMOOTH-COMMON, BOX OR DEFORMED SHANKS EXCEPT WHERE OTHERWISE STATED.
- b. STAPLES ARE 16 GAGE WIRE AND HAVE A MINIMUM 7/16-INCH ON DIAMETER CROWN WIDTH.
- C. NAILS SHALL BE SPACED AT NOT MORE THAN 6 INCHES ON CENTER AT ALL SUPPORTS WHERE SPANS ARE 48 INCHES OR GREATER.
- d. 4-FOOT-BY-8-FOOT or 4-FOOT-BY-9-FOOT PANELS SHALL BE APPLIED VERTICALLY. e. SPACING OF FASTENERS NOT INCLUDED IN THIS TABLE SHALL BE BASED ON TABLE R602.3(2).
- f. FOR REGIONS HAVING A BASIC WIND SPEED OF 110 MPH OR GREATER, 8d DEFORMED NAILS SHALL BE USED FOR ATTACHING PLYWOOD AND WOOD STRUCTURAL PANEL ROOF SHEATHING TO FRAMING WITHIN MINIMUM 48-INCH DISTANCE FROM GABLE END WALLS, IF MEAN ROOF
- g. FOR REGIONS HAVING A BASIC WIND SPEED OF LESS THAN 110 MPH, NAILS FOR ATTACHING WOOD STRUCTURAL PANEL ROOF SHEATHING TO GABLE END WALL FRAMING SHALL BE SPACED 6 INCHES ON CENTER WHEN BASIC WIND SPEED IS GREATER THAN 100 MPH, NAILS FOR ATTACHING PANEL ROOF SHEATHING TO INTERMEDIATE SUPPORTS SHALL BE SPACED 6 INCHES ON CENTER FOR MINIMUM 48-INCH DISTANCE FROM RIDGES, EAVES AND GABLE END WALLS; AND 4 INCHES ON CENTER TO GABLE END WALL FRAMING.
- h. GYPSUM SHEATHING SHALL CONFORM TO ASTM C 79 AND SHALL BE INSTALLED IN ACCORDANCE WITH GA 253. FIBERBOARD SHEATHING SHALL CONFORM TO ASTM C 208.
- SPACING OF FASTERNER ON FLOOR SHEATHING PANEL EDGES APPLIES TO PANEL EDGES SUPPORTED BY FRAMING MEMBERS AND REQUIRED BLOCKING AND AT ALL FLOOR PERIMETERS ONLY. SPACING OF FASTENERS ON ROOF SHEATHING PANEL EDGES APPLIES TO PANEL EDGES SUPPORTED BY FRAMING MEMBERS AND REQUIRED BLOCKING. BLOCKING OF ROOF OR FLOOR SHEATHING PANEL EDGES PERPENDICULAR TO THE FRAMING MEMBERS NEED NOT TO BE PROVIDED EXCEPT AS REQUIRED BY OTHER PROVISIONS OF THIS CODE. FLOOR PERIMETER SHALL
- BE SUPPORTED BY FRAMING MEMBERS OR SOLID BLOCKING. INTERIOR NONBRACED WALL LINES MAY BE NAILED WITH A MINUMUM 4-10d NAILS.

## TABLE N1101.1(1) PRESCRIPTIVE ENVELOPE REQUIREMENTS<sup>a</sup>

| BUILDING COMPONENT   | STANDARD BASE CASE LOG HOMES |                           | SONLY                |                    |
|--|------------------------------|---------------------------|----------------------|--------------------|
|  | Required Performance         | Equiv. Value <sup>b</sup> | Required Performance | Equiv. Value       |
| Wall insulation-above grade                                  | U-0.060                      | R-21c                     | Note d               | Note d             |
| Wall insulation-below grade <sup>e</sup>                     | F-0.565                      | R-15                      | F-0.565              | R-15               |
| Flat ceilings <sup>f</sup>                                   | U-0.031                      | R-38                      | U-0.025              | R-49               |
| Vaulted ceilings <sup>g</sup>                                | U-0.042                      | R-38 <sup>9</sup>         | U-0.027              | R-38A <sup>h</sup> |
| Underfloors  | U-0.028                      | R-30                      | U-0.028              | R-30               |
| Slab edge perimeter  | F-0.520                      | R-15                      | F-0.520              | R-15               |
| Heated slab interior <sup>i</sup>                            | n/a                          | R-10                      | n/a                  | R-10               |
| Windows <sup>j</sup>   | U-0.35                       | U-0.35                    | U-0.35               | U-0.35             |
| Window area limitation j, k                                  | n/a                          | n/a                       | n/a                  | n/a                |
| Skylights <sup>l</sup>                                       | U-0.60                       | U-0.060                   | U-0.060              | U-0.060            |
| Exterior doors <sup>m</sup>                                  | U-0.20                       | U-0.020                   | U-0.054              | U-0.054            |
| Exterior doors w/ > 2.5 ft <sup>2</sup> glazing <sup>n</sup> | U-0.40                       | U-0.040                   | U-0.40               | U-0.040            |
| Forced air duct insulation                                   | n/a                          | R-8                       | n/a                  | R-8                |

For SI: 1 inch = 25.4 mm, 1 square foot = 0.0929 m2, 1 degree = 0.0175 rad. a. As allowed in Section N1104.1, thermal performance of a component may be adjusted provided that overall heat loss does not exceed the total resulting from

conformance to the required U-value standards. Calculations to document equivalent heat loss shall be performed using the procedure and approved U-values

b. R-values used in this table are nominal for the insulation only in standard wood framed construction and not for the entire assembly. c. Wall insulation requirements apply to all exterior wood framed, concrete or masonry walls that are above grade. This includes cripple walls and rim joist areas.

R-19 Advanced Frame or 2 × 4 wall with rigid insulation may be substituted if total nominal insulation R-value is 18.5 or greater. d. The wall component shall be a minimum solid log or timber wall thickness of 3.5 inches (90 mm). e. Below-grade wood, concrete or masonry walls include all walls that are below grade and do not include those portions of such wall that extend more than 24

f. Insulation levels for ceilings that have limited attic/rafter depth such as dormers, bay windows or similar architectural features totaling not more than 150 square

feet (13.9 m2) in area may be reduced to not less than R-21. When reduced, the cavity shall be filled (except for required ventilation spaces). g. The maximum vaulted ceiling surface area shall not be greater than 50 percent of the total heated space floor area unless area has a U-factor no greater than U-0.031. The U-factor of 0.042 is representative of a vaulted scissor truss. A 10-inch (254 mm) deep rafter vaulted ceiling with R-30 insulation is U-0.033 and complies with this requirement, not to exceed 50 percent of the total heated space floor area.

h. A = Advanced frame construction, which shall provide full required insulating value to the outside of exterior walls.

i. Heated slab interior applies to concrete slab floors (both on and below grade) that incorporate a radiant heating system within the slab. Insulation shall be installed i. Sliding glass doors shall comply with window performance requirements. Windows exempt from testing in accordance with Section NF1111.2, Item 3 shall comply

with window performance requirements if constructed with thermal break aluminum or wood, or vinyl, or fiberglass frames and double-pane glazing with low-emissivity coatings of 0.10 or less. Buildings designed to incorporate passive solar elements may include glazing with a U-factor greater than 0.35 by using Table N1104.1(1) to demonstrate equivalence to building envelope requirements. k. Reduced window area may not be used as a trade-off criterion for thermal performance of any component.

I. Skylight area installed at 2 percent or less of total heated space floor area shall be deemed to satisfy this requirement with vinyl, wood or thermally broken aluminum frames and double-pane glazing with low-emissivity coatings. Skylight U-factor is tested in the 20 degree (0.35 rad) overhead plane in accordance with

m. A maximum of 28 square feet (2.6 m2) of exterior door area per dwelling unit can have a U-factor of 0.54 or less. n. Glazing that is either double pane with low-e coating on one surface, or triple pane shall be deemed to comply with this U-0.40 requirement.

## ADDITIONAL MEASURES

TABLE N1101.1(2)

|   | High officional walls & windows:   |
|---|--|
| 1 | High efficiency walls & windows:  Exterior walls—U-0.047/R-19+5 (insulation sheathing)/SIPS, and one of the following options:  Windows—Max 15 percent of conditioned area; or  Windows—U-0.30   |
|   | High efficiency envelope:  |
| 2 | Exterior walls—U-0.058/R-21 Intermediate framing, and Vaulted ceilings—U-0.033/R-30A <sup>d,e</sup> , and Flat ceilings—U-0.025/R-49, and Framed floors—U-0.025/R-38, and Windows—U-0.30; and Doors—All doors U-0.20, or Additional 15 percent of permanently installed lighting fixtures as high-efficacy lamps or Conservation Measure D and E   |
|   | High efficiency ceiling, windows & duct sealing: (Cannot be used with Conservation Measure E)  |
| 3 | Vaulted ceilings—U-0.033/R-30A <sup>d,e</sup> , and Flat ceilings—U-0.025/R-49, and Windows—U-0.30, and Performance tested duct systems <sup>b</sup>   |
|   | High efficiency thermal envelope UA:   |
| 4 | Proposed UA is 15% lower than the Code UA when calculated in Table N1 104.1(1)   |
|   | Building tightness testing, ventilation & duct sealing: (Cannot be used with Conservation Measure E)   |
| 5 | A mechanical exhaust, supply, or combination system providing whole-building ventilation rates specified in Table N1101.1(3), or ASHRAE 62.2, and  The dwelling shall be tested with a blower door and found to exhibit no more than:  1. 6.0 air changes per hour f, or and  2. 5.0 air changes per hour when used with Conservation Measure E, and  2. Performance tested duct systems b |
|   | Ducted HVAC systems within conditioned space: (Cannot be used with Conservation Measure B or C)  |
| 6 | All ducts and air handler are contained within building envelope   |

|                                     |     | High efficiency HVAC system:   |  |  |  |  |  |  |
|-------------------------------------|-----|--|--|--|--|--|--|--|
|                                     | (A) | Gas-fired furnace or boiler with minimum AFUE of 90% a, or Air-source heat pump with minimum HSPF of 8.5 or Closed-loop ground source heat pump with minimum COP of 3.0  |  |  |  |  |  |  |
|                                     |     | Ducted HVAC systems within conditioned space:  |  |  |  |  |  |  |
|                                     | В   | All ducts and air handler are contained within building envelope i   |  |  |  |  |  |  |
|                                     |     | Ductless heat pump:  |  |  |  |  |  |  |
| Conservation Measure (Selected One) | С   | Replace electric resistance heating in at least the primary zone of dwelling with at least one ductless mini-split heat pump having a minin HSPF of 8.5. Unit shall not have integrated backup resistance heat, and the unit (or units, if more than one is installed in the dwelling) shall be sized to have capacity to meet the entire dwelling design heat loss rate at outdoor design temperature condition. Conventional electric resistance heating may be provided for any secondary zones in the dwelling. A packaged terminal heat pump (PTHP) with comparable efficiency ratings may be used when no supplemental zonal heaters are installed in the building and integrated backup resistant heat is allowed in a PTHP |  |  |  |  |  |  |
|                                     |     | High efficiency water heating & lighting:  |  |  |  |  |  |  |
|                                     | D   | Natural gas/propane, on-demand water heating with min EF of 0.80, or heat pump water heater with min EF of 1.8 (northern climate) and minimum 75 percent of permanently installed lighting fixtures as CFL or linear fluorescent or a min efficacy of 40 lumens per watt as specified in Section N1107.2c  |  |  |  |  |  |  |
| Cons                                |     | Energy management device & duct sealing:   |  |  |  |  |  |  |
|                                     | Е   | Whole building energy management device that is capable of monitoring or controlling energy consumption, and Performance tested due systems <sup>b</sup> , and A minimum 75 percent of permanently installed lighting fixtures as high-efficacy lamps.   |  |  |  |  |  |  |
|                                     | _   | Solar photovoltaic:  |  |  |  |  |  |  |
|                                     | F   | Minimum 1 watt/sq ft conditioned floor space <sup>g</sup>  |  |  |  |  |  |  |
|                                     |     | Solar water heating:   |  |  |  |  |  |  |
|                                     | G   | Minimum of 40 ft2 of gross collector area h  |  |  |  |  |  |  |

For SI: 1 square foot = 0.093 m2, 1 watt per square foot = 10.8 W/m2.

a. Furnaces located within the building envelope shall have sealed combustion air installed. Combustion air shall be ducted directly from the outdoors. b. Documentation of Performance Tested Ductwork shall be submitted to the building official upon completion of work. This work shall be performed by a contractor technician certified by the Oregon Department of Energy's (ODOE) Residential Energy Tax Credit program and Performance Tested Comfort Systems (PTCS) program administered by the Bonneville Power Administration (BPA), documentation shall be provided that work demonstrates conformance to ODOE PTCS duct

c. Section N1 107.2 requires 50 percent of permanently installed lighting fixtures to contain high efficacy lamps. Each of these additional measures adds an additional percent to the Section N1 107.2 requirement.

e. The maximum vaulted ceiling surface area shall not be greater than 50 percent of the total heated space floor area unless vaulted area has a U-factor no greater

d. A = advanced frame construction, which shall provide full required ceiling insulation value to the outside of exterior walls.

f. Building tightness test shall be conducted with a blower door depressurizing the dwelling 50 Pascal 's from ambient conditions. Documentation of blower door test shall be submitted to the Building Official upon completion of work.

g. Solar electric system size shall include documentation indicating that Total Solar Resource Fraction is not less than 75 percent. h. Solar water heating panels shall be Solar Rating and Certification Corporation (SRCC) Standard OG-300 certified and labeled, with documentation indicating that

Total Solar Resource Fraction is not less than 75 percent. i. A total of 5 percent of an HVAC systems ductwork shall be permitted to be located outside of the conditioned space. Ducts located outside the conditioned space shall have insulation installed as required in this code.

Revisions

APR 2 6 2018

Drawn & Checked By

1/2016-12/2016 Drawing File Name **GENERAL.DWG** 





MiTek USA, Inc.

250 Klug Circle Corona, CA 92880 951-245-9525

Re: B1701644 DK Homes

The truss drawing(s) referenced below have been prepared by MiTek USA, Inc. under my direct supervision based on the parameters provided by ProBuild West - Beaverton, OR.

Pages or sheets covered by this seal: K3247589 thru K3247599

My license renewal date for the state of Oregon is December 31, 2017.



May 30,2017

Baxter, David

**IMPORTANT NOTE:** Truss Engineer's responsibility is solely for design of individual trusses based upon design parameters shown on referenced truss drawings. Parameters have not been verified as appropriate for any use. Any location identification specified is for file reference only and has not been used in preparing design. Suitability of truss designs for any particular building is the responsibility of the building designer, not the Truss Engineer, per ANSI/TPI-1, Chapter 2.



| Job *    | Truss | Truss Type | Qty | Ply | DK Homes                 | K00 47500 |
|----------|-------|------------|-----|-----|--------------------------|-----------|
| B1701644 | A01   | GABLE      | 1   | 1   | Job Reference (optional) | K3247589  |

ProBuild Beaverton Truss.

Beaverton, oR 97007

7.640 s Sep 29 2015 MiTek Industries, Inc. Mon May 29 13:26:52 2017 Page 2 ID:DjKklw\_csBnsEStNLVN55?zBeiX-BDpIAPEHmfMIW6PfgmELglqtjQUNzbU0fHWa0QzBce1

#### NOTES-

12) "Fix heels only" Member end fixity model was used in the analysis and design of this truss.

13) Graphical purlin representation does not depict the size or the orientation of the purlin along the top and/or bottom chord.

City of Portland REVIEWED FOR CODE COMPLIANCE

APR 2 6 2018

Permit Number

ARNING - Verify design parameters and READ NOTES ON THIS AND INCLUDED MITEK REFERENCE PAGE MI-7473 rev. 10/03/2015 BEFORE USE.

Design valid for use only with MiTek® connectors. This design is based only upon parameters shown, and is for an individual building component, not a truss system. Before use, the building designer must verify the applicability of design parameters and properly incorporate this design into the overall building design. Bracing indicated is to prevent buckling of individual truss web and/or chord members only. Additional temporary and permanent bracing is always required for stability and to prevent collapse with possible personal injury and property damage. For general guidance regarding the fabrication, storage, delivery, erection and bracing of trusses and truss systems, see \_\_ANSI/TPH Quality Criteria, DSB-89 and BCSI Building Component Safety Information available from Truss Plate Institute, 218 N. Lee Street, Suite 312, Alexandria, VA 22314.



Job Truss Truss Type Qty Ply DK Homes K3247590 A02 B1701644 California Job Reference (optional) 7.640 s Sep 29 2015 MiTek Industries, Inc. Mon May 29 13:26:53 2017 Page 1 ProBuild Beaverton Truss, Beaverton, oR 97007 ID:DjKklw\_csBnsEStNLVN55?zBeiX-gPN7OIFvXyUb7F\_sDTlaDzM2NqnQi1i9uxG7YtzBce0 10-8-11 11-3-5 12-10-3 1-6-14 0-6-10 1-6-14 1-0-0 22-0-0 23-0-0 4-5-15 4-7-14 1-0-0 Scale = 1:45.0 4x4 / 4x8 // X 16 17 8.00 12 2x4 > 2x4 / 12 13 4x6 3x6 = 4x6 3x8 = 3x4 = 9-1-13 12-10-3 22-0-0 9-1-13 Plate Offsets (X,Y)-- [4:0-1-12,0-2-0], [6:0-3-8,0-1-12] LOADING (psf) SPACING. DEFL CRIP CSI. (loc) I/defl I/d **PLATES** TCLL Plate Grip DOL 220/195 0.27 1 15 TC Vert(LL) -0 13 9-11 >999 240 MT20 (Roof Snow=25.0) BC Lumber DOL 1.15 0.41 Vert(CT) -0.39 9-11 >657 180 TCDL 7.0 WB 0 18 Rep Stress Incr Horz(CT) 0.04 YES 9 n/a n/a BCLL 0.0 \* Code IBC2015/TPI2014 (Matrix) Weight: 115 lb FT = 10% BCDL 10.0 LUMBER-BRACING-TOP CHORD 2x4 DF No.1&Btr G TOP CHORD Structural wood sheathing directly applied or 5-4-12 oc purlins, except BOT CHORD 2x4 DF No.1&Btr G 2-0-0 oc purlins (6-0-0 max.): 4-6. 2x4 DF Std G **BOT CHORD** WEBS Rigid ceiling directly applied or 10-0-0 oc bracing. MiTek recommends that Stabilizers and required cross bracing

be installed during truss erection, in accordance with Stabilizer Installation guide

REACTIONS. (lb/size) 2=1075/0-5-8, 9=1075/0-5-8

Max Horz 2=235(LC 7)

Max Uplift 2=-253(LC 10), 9=-258(LC 11)

FORCES. (lb) - Max. Comp./Max. Ten. - All forces 250 (lb) or less except when shown. TOP CHORD

2-14=-1445/605, 3-14=-1395/623, 3-15=-1208/592, 4-15=-1115/606, 4-16=-937/729,

16-17=-937/729, 6-17=-937/729, 6-18=-1115/606, 8-18=-1208/592, 8-19=-1394/624,

9-19=-1445/605

**BOT CHORD** 2-13=-389/1146, 12-13=-308/937, 11-12=-308/937, 9-11=-390/1146

**WEBS** 3-13=-333/223, 4-13=-55/305, 6-11=-44/304, 8-11=-333/223

1) Wind: ASCE 7-10; Vult=140mph (3-second gust) Vasd=111mph; TCDL=4.2psf; BCDL=6.0psf; h=25ft; Cat. II; Exp B; enclosed; MWFRS (envelope) automatic zone and C-C Exterior(2) -1-0-0 to 2-0-0, Interior(1) 2-0-0 to 6-5-13, Exterior(2) 6-5-13 to 15-6-3, Interior(1) 15-6-3 to 20-0-0 zone; cantilever left and right exposed; end vertical left and right exposed; C-C for members and forces & MWFRS for reactions shown; Lumber DOL=1.60 plate grip DOL=1.60

2) TCLL: ASCE 7-10; Pf=25.0 psf (flat roof snow); Category II; Exp B; Fully Exp.; Ct=1.1

3) This truss has been designed for greater of min roof live load of 16.0 psf or 2.00 times flat roof load of 25.0 psf on overhangs non-concurrent with other live loads.

Provide adequate drainage to prevent water ponding.
 This truss has been designed for a 10.0 psf bottom chord live load nonconcurrent with any other live loads.

6) \* This truss has been designed for a live load of 20.0psf on the bottom chord in all areas where a rectangle 3-6-0 tall by 2-0-0 wide will fit between the bottom chord and any other members.

7) A plate rating reduction of 20% has been applied for the green lumber members.

8) Provide mechanical connection (by others) of truss to bearing plate capable of withstanding 100 lb uplift at joint(s) except (jt=lb) 2=253, 9=258.

9) "Fix heels only" Member end fixity model was used in the analysis and design of this truss.

10) Graphical purlin representation does not depict the size or the orientation of the purlin along the top and/or bottom chord.

City of Portland APR 2 6 2018

> ERED PROFES 146/5

EXPIRES: 12/31/2017 May 30,2017

BA

WARNING - Verify design parameters and READ NOTES ON THIS AND INCLUDED MITEK REFERENCE PAGE MII-7473 rev. 10/03/2015 BEFORE USE. Design valid for use only with MiTek® connectors. This design is based only upon parameters shown, and is for an individual building component, not a truss system. Before use, the building designer must verify the applicability of design parameters and properly incorporate this design into the overall building design. Bracing indicated is to prevent buckling of individual truss web and/or chord members only. Additional temporary and permanent bracing is always required for stability and to prevent collapse with possible personal injury and property damage. For general guidance regarding the fabrication, storage, delivery, erection and bracing of trusses and truss systems, see

ANSITPH Quality Criteria, DSB-89 and BCSI Building Component Safety Information available from Truss Plate Institute, 218 N. Lee Street, Suite 312, Alexandria, VA 22314.



Job Truss Truss Type Qty Ply K3247591 B1701644 403 Roof Special Job Reference (optional)
7.640 s Nov 10 2015 MiTek Industries. Inc. Mon May 29 16:36:05 2017 Page 1 ProBuild Beaverton Truss, Beaverton, oR 97007 9-4-8 3-10-8 11-0-0 1-7-8 Scale: 1/4"=1" 4x4 = 8.00 12 2x4 \\ 2x4 // 3 11 10 16 8 7x14 MT18H 4x8 || 8×8 = 4x8 || 7-0-0 9-4-8 14-8-0 19-0-8 22-0-0 7-0-0 [2:0-4-0,0-1-10], [4:0-2-0,0-1-12], [11:0-3-8,0-4-0] Plate Offsets (X,Y)-LOADING (psf) GRIP SPACING-DEFI **PLATES** 2-0-0 CSI. in (loc) I/defl 1/1 TCLL Plate Grip DOL 220/195 1.15 TC 0.29 Vert(LL) -0.05 9-11 >999 240 MT20 (Roof Snow=25.0) Lumber DOL 1.15 BC 0.66 Vert(CT) -0.15 6-9 >999 180 **MT18H** 220/195 TCDL 7.0 Rep Stress Incr YES WB 0.29 Horz(CT) 0.05 6 n/a n/a BCLL 0.0 \* Code IBC2015/TPI2014 FT = 10% (Matrix) Weight: 135 lb BCDL LUMBER-BRACING-TOP CHORD 2x4 DF No.1&Btr G TOP CHORD Structural wood sheathing directly applied or 5-3-4 oc purlins. 2x8 DF SS \*Except\* **BOT CHORD BOT CHORD** Rigid ceiling directly applied or 10-0-0 oc bracing. 6-11: 2x6 DF No.2 MiTek recommends that Stabilizers and required cross bracing WEBS 2x4 DF Std G be installed during truss erection, in accordance with Stabilizer Installation guide.

**REACTIONS.** (lb/size) 2=983/0-5-8, 6=983/0-5-8

Max Horz 2=-229(LC 8)

Max Uplift 2=-225(LC 10), 6=-225(LC 11)

FORCES. (lb) - Max. Comp./Max. Ten. - All forces 250 (lb) or less except when shown.

TOP CHORD

2-12=-1413/275, 3-12=-1245/291, 3-13=-1250/320, 4-13=-1140/331, 4-14=-1235/345,

5-14=-1354/334, 5-15=-1366/318, 6-15=-1534/302 2-11=-280/1221, 10-11=-56/748, 10-16=-49/762, 9-16=-49/762, 8-9=-158/1206,

**BOT CHORD** 6-8=-166/1203

WEBS 4-11=-184/607, 3-11=-347/291, 4-9=-197/726, 5-9=-354/290

#### NOTES-

- 1) Wind: ASCE 7-10; Vult=140mph (3-second gust) Vasd=111mph; TCDL=4.2psf; BCDL=6.0psf; h=25ft; Cat. II; Exp B; enclosed; MWFRS (envelope) automatic zone and C-C Exterior(2) -1-0-0 to 2-0-0, Interior(1) 2-0-0 to 8-0-0, Exterior(2) 8-0-0 to 11-0-0, Interior(1) 14-0-0 to 20-0-0 zone; cantilever left and right exposed; end vertical left and right exposed; C-C for members and forces & MWFRS for reactions shown; Lumber DOL=1.60 plate grip DOL=1.60
- 2) TCLL: ASCE 7-10; Pf=25.0 psf (flat roof snow); Category II; Exp B; Fully Exp.; Ct=1.1
- 3) This truss has been designed for greater of min roof live load of 16.0 psf or 2.00 times flat roof load of 25.0 psf on overhangs non-concurrent with other live loads.
- 4) All plates are MT20 plates unless otherwise indicated.
- 5) This truss has been designed for a 10.0 psf bottom chord live load nonconcurrent with any other live loads.
- 6) \* This truss has been designed for a live load of 20.0psf on the bottom chord in all areas where a rectangle 3-6-0 tall by 2-0-0 wide will fit between the bottom chord and any other members, with BCDL = 10.0psf.
- 7) A plate rating reduction of 20% has been applied for the green lumber members
- 8) Provide mechanical connection (by others) of truss to bearing plate capable of withstanding 225 lb uplift at joint 2 and 225 lb uplift at
- 9) This truss is designed in accordance with the 2015 International Building Code section 2306.1 and referenced standard ANSI/TPI 1.
- 10) "Fix heels only" Member end fixity model was used in the analysis and design of this truss.

LOAD CASE(S) Standard

City of Portland WED FOR CODE OMPLIANCE APR 2 6 2018 Permit Number



EXPIRES: 12/31/2017 May 30,2017

A WARNING - Verify design parameters and READ NOTES ON THIS AND INCLUDED MITEK REFERENCE PAGE MII-7473 rev. 10/03/2015 BEFORE USE. Design valid for use only with MITek® connectors. This design is based only upon parameters shown, and is for an individual building component, not a truss system. Before use, the building designer must verify the applicability of design parameters and property incorporate this design into the overall building design. Bracing indicated is to prevent buckling of individual truss web and/or chord members only. Additional temporary and permanent bracing is always required for stability and to prevent collapse with possible personal injury and property damage. For general guidance regarding the fabrication, storage, delivery, erection and bracing of trusses and truss systems, see

ANSI/TP11 Quality Criteria, DSB-89 and BCSI Building Component Safety Information available from Truss Plate Institute, 218 N. Lee Street, Suite 312, Alexandria, VA 22314.



.lob Qty Ply Truss Truss Type DK Homes K3247592 B1701644 A04 20 Common Job Reference (optional) 7.640 s Sep 29 2015 MiTek Industries, Inc. Mon May 29 13:26:54 2017 Page 1 ID:DjKklw\_csBnsEStNLVN55?zBeiX-8bxWb5GXIGcSIPZ2nBGplAvDqE9ART6J6b?h4JzBce? ProBuild Beaverton Truss Beaverton, oR 97007 1-0-0 16-6-0 22-0-0 23-0-0 5-6-0 11-0-0 Scale: 1/4"=1" 4v4 = 8 00 12 2x4 \\ 2x4 // 9 3x4 = 3x4 3x4 = 3x6 = 3x4 = 7-4-0 14-8-0 22-0-0 7-4-0 7-4-0 7-4-0 Plate Offsets (X,Y)-- [2:0-2-0.0-1-8], [4:0-2-0.0-1-12], [6:0-2-0.0-1-8] LOADING (psf) SPACING-2-0-0 DEFL. I/defl L/d **PLATES** GRIP (loc) TCLL Plate Grip DOL 220/195 TC BC 1.15 0.29 Vert(LL) -0.10 8-10 >999 240 MT20 (Roof Snow=25.0) Lumber DOL 1 15 0.31 Vert(CT) -0.19 8-10 >999 180 TCDL 7.0 WB Rep Stress Incr YES 0.23 Horz(CT) 0.03 6 n/a n/a BCLL 0.0 Code IBC2015/TPI2014 (Matrix) Weight: 103 lb FT = 10% BCDL 10.0 LUMBER-BRACING-TOP CHORD 2x4 DF No.1&Btr G TOP CHORD Structural wood sheathing directly applied or 5-7-13 oc purlins. Rigid ceiling directly applied or 10-0-0 oc bracing. BOT CHORD 2x4 DF No.1&Btr G BOT CHORD 2x4 DF Std G

REACTIONS. (lb/size) 2=983/0-5-8, 6=983/0-5-8

Max Horz 2=229(LC 9)

Max Uplift 2=-224(LC 10), 6=-224(LC 11)

FORCES. (lb) - Max. Comp./Max. Ten. - All forces 250 (lb) or less except when shown.

TOP CHORD 2-11=-1312/267, 3-11=-1140/290, 3-12=-1159/329, 4-12=-1039/340, 4-13=-1039/340,

5-13=-1159/329, 5-14=-1140/290, 6-14=-1312/267

**BOT CHORD** 2-10=-267/1117, 10-15=-47/701, 9-15=-47/701, 9-16=-47/701, 8-16=-47/701,

6-8=-130/1010

**WEBS** 4-8=-194/581, 5-8=-341/291, 4-10=-194/581, 3-10=-341/291

NOTES-

WEBS

- 1) Wind: ASCE 7-10; Vult=140mph (3-second gust) Vasd=111mph; TCDL=4.2psf; BCDL=6.0psf; h=25ft; Cat. II; Exp B; enclosed; MWFRS (envelope) automatic zone and C-C Exterior(2) -1-0-0 to 2-0-0, Interior(1) 2-0-0 to 8-0-0, Exterior(2) 8-0-0 to 11-0-0, Interior(1) 14-0-0 to 20-0-0 zone; cantilever left and right exposed; end vertical left and right exposed; C-C for members and forces & MWFRS for reactions shown; Lumber DOL=1.60 plate grip DOL=1.60
- 2) TCLL: ASCE 7-10; Pf=25.0 psf (flat roof snow); Category II; Exp B; Fully Exp.; Ct=1.1
- 3) This truss has been designed for greater of min roof live load of 16.0 psf or 2.00 times flat roof load of 25.0 psf on overhangs non-concurrent with other live loads
- 4) This truss has been designed for a 10.0 psf bottom chord live load nonconcurrent with any other live loads.
- 5) \* This truss has been designed for a live load of 20.0psf on the bottom chord in all areas where a rectangle 3-6-0 tall by 2-0-0 wide will fit between the bottom chord and any other members, with BCDL = 10.0psf.
- 6) A plate rating reduction of 20% has been applied for the green lumber members.
- 7) Provide mechanical connection (by others) of truss to bearing plate capable of withstanding 100 lb uplift at joint(s) except (jt=lb) 2=224, 6=224
- 8) "Fix heels only" Member end fixity model was used in the analysis and design of this truss.

City of Portland APR 2 6 2018

Permit Number

MiTek recommends that Stabilizers and required cross bracing be installed during truss erection, in accordance with Stabilizer

Installation guide.

ERED PROFES

EXPIRES: 12/31/2017 May 30,2017

🔔 WARNING - Verify design parameters and READ NOTES ON THIS AND INCLUDED MITEK REFERENCE PAGE MII-7473 rev. 10/03/2015 BEFORE USE. Design valid for use only with MTTek® connectors. This design is based only upon parameters shown, and is for an individual building component, not a truss system. Before use, the building designer must verify the applicability of design parameters and properly incorporate this design into the overall building design. Bracing indicated is to prevent buckling of individual truss web and/or chord members only. Additional temporary and permanent bracing is always required for stability and to prevent collapse with possible personal injury and properly damage. For general guidance regarding the fabrication, storage, delivery, erection and bracing of trusses and truss systems, see 

ANSI/TP11 Quality Criteria, DSB-89 and BCSI Building Component Safety Information available from Truss Plate Institute, 218 N. Lee Street, Suite 312, Alexandria, VA 22314.



| Job               | Truss                   | Truss Type | Qty    | Ply     | DK Homes                 | K3247593   |
|-------------------|-------------------------|------------|--------|---------|--------------------------|--|
| B1701644          | A05                     | GABLE      | 1      | 1       |                          | N324/393   |
| ProBuild Beaverto | T D                     | 107007     |        | 7.040   | Job Reference (optional) |  |
| Probuild Beavert  | on Truss, Beaverton, oF | (9/00/     | ID:DiK | /.640 s | StNLVN55?zBeiX-coVupQG9  | es, Inc. Mon May 29 13:26:55 2017 Page 1<br>33alJNZ8ELuo2IOSRseZeAxLSLFIEdlzBce_ |
|                   | -1-0-0                  | 11-0-0     |        |         | 22-0-0                   |  |
|                   | 1-0-0                   | 11-0-0     |        |         | 11-0-0                   | 23-0-0<br>1-0-0  |
|                   |                         |            | 4x4 =  |         |                          | Scale = 1:49.4   |
|                   |                         |            |        |         |                          |  |
|                   | I                       |            | 9      |         |                          |  |
|                   |                         | 8          | 10     |         |                          |  |
|                   |                         | - //       |        | 11      |                          |  |
|                   |                         | 8.00 12    |        | a la    |                          |  |
|                   |                         | 6          |        | 1       | 12                       |  |
|                   |                         | 5          |        |         | 13                       |  |
|                   | о<br>Ф                  |            |        |         | The second               |  |
|                   | 7                       | 4          |        |         | 14                       |  |
|                   |                         | 3          |        |         | 15                       |  |
|                   |                         |            |        |         | I I                      |  |
|                   | 1//                     |            |        |         |                          |  |

22-0-0 22-0-0 LOADING (psf) SPACING-2-0-0 CSI. DEFL. L/d PLATES GRIP (loc) TCLL 25.0 TC BC Plate Grip DOL 1.15 0.08 Vert(LL) 0.00 90 MT20 220/195 16 n/r (Roof Snow =25.0) Lumber DOL 1.15 0.04 Vert(CT) 0.00 17 n/r 120 TCDL 7.0 WB Rep Stress Incr YES 0.17 Horz(CT) 0.01 16 n/a n/a BCLL 0.0 \*

25 2423

3x4 =

22

21

20

19

18

BCDL I IIMBER.

TOP CHORD 2x4 DF No.1&Btr G BOT CHORD 2x4 DF No.1&Btr G OTHERS

10.0

2x4 DF Std G

BRACING-

TOP CHORD **BOT CHORD**  Structural wood sheathing directly applied or 6-0-0 oc purlins. Rigid ceiling directly applied or 10-0-0 oc bracing.

MiTek recommends that Stabilizers and required cross bracing be installed during truss erection, in accordance with Stabilizer Installation guide.

Weight: 147 lb

REACTIONS. All bearings 22-0-0.

(lb) - Max Horz 2=-229(LC 8)

Max Uplift All uplift 100 lb or less at joint(s) 2, 25, 26, 27, 28, 29, 30, 23, 22, 21, 20, 19, 16 except

31=-121(LC 10), 18=-121(LC 11)

Max Grav All reactions 250 lb or less at joint(s) 2, 25, 26, 27, 28, 29, 30, 23, 22, 21, 20, 19, 18, 16 except 31=250(LC 18)

28

(Matrix)

27

26

FORCES. (lb) - Max. Comp./Max. Ten. - All forces 250 (lb) or less except when shown.

31

Code IBC2015/TPI2014

30

#### NOTES-

- 1) Wind: ASCE 7-10; Vult=140mph (3-second gust) Vasd=111mph; TCDL=4.2psf; BCDL=6.0psf; h=25ft; Cat. II; Exp B; enclosed; MWFRS (envelope) automatic zone and C-C Corner(3) -1-0-0 to 2-0-0, Exterior(2) 2-0-0 to 8-0-0, Corner(3) 8-0-0 to 11-0-0, Exterior(2) 14-0-0 to 20-0-0 zone; cantilever left and right exposed; end vertical left and right exposed; C-C for members and forces & MWFRS for reactions shown; Lumber DOL=1.60 plate grip DOL=1.60
- 2) Truss designed for wind loads in the plane of the truss only. For studs exposed to wind (normal to the face), see Standard Industry Gable End Details as applicable, or consult qualified building designer as per ANSI/TPI 1.
- 3) TCLL: ASCE 7-10; Pf=25.0 psf (flat roof snow); Category II; Exp B; Fully Exp.; Ct=1.1
- 4) This truss has been designed for greater of min roof live load of 16.0 psf or 2.00 times flat roof load of 25.0 psf on overhangs non-concurrent with other live loads.
- 5) All plates are 2x4 MT20 unless otherwise indicated.
- 6) Gable requires continuous bottom chord bearing.
- 7) Gable studs spaced at 1-4-0 oc.
- 8) This truss has been designed for a 10.0 psf bottom chord live load nonconcurrent with any other live loads.
- 9) \* This truss has been designed for a live load of 20 0psf on the bottom chord in all areas where a rectangle 3-6-0 tall by 2-0-0 wide will fit between the bottom chord and any other members.
- 10) A plate rating reduction of 20% has been applied for the green lumber members.
- 11) Provide mechanical connection (by others) of truss to bearing plate capable of withstanding 100 lb uplift at joint(s) 2, 25, 26, 27, 28, 29, 30, 23, 22, 21, 20, 19, 16 except (jt=lb) 31=121, 18=121.
- 12) "Fix heels only" Member end fixity model was used in the analysis and design of this truss.

City of Portland CODE

FT = 10%

APR 2 6 2018

Permit Number



EXPIRES: 12/31/2017 May 30,2017

A WARNING - Verify design parameters and READ NOTES ON THIS AND INCLUDED MITEK REFERENCE PAGE MIL-7473 rev. 10/03/2015 BEFORE USE. Design valid for use only with MiTek® connectors. This design is based only upon parameters shown, and is for an individual building component, not a truss system. Before use, the building designer must verify the applicability of design parameters and property incorporate this design into the overall building design. Bracing indicated is to prevent buckling of individual truss web and/or chord members only. Additional temporary and permanent bracing is always required for stability and to prevent collapse with possible personal injury and property damage. For general guidance regarding the fabrication, storage, delivery, erection and bracing of trusses and truss systems, see

ANSI/TP11 Quality Criteria, DSB-89 and BCSI Building Component Safety Information available from Truss Plate Institute, 218 N. Lee Street, Suite 312, Alexandria, VA 22314.



Job Truss Truss Type Qty **DK Homes** K3247594 B1701644 B01 GABLE Job Reference (optional) 7.640 s Sep 29 2015 MiTek Industries, Inc. Mon May 29 13:26:56 2017 Page 1 ProBuild Beaverton Truss Beaverton, oR 97007 ID:DjKklw\_csBnsEStNLVN55?zBeiX-4\_2G0mHnqttA\_jjQvcJHrb\_cc1vuvQjcavUo8CzBcdz 13-6-0 -1-0-0 6-3-0 12-6-0 1-0-0 6-3-0 1-0-0 Scale = 1:28.1 6 8.00 12 10 11 18 17 16 15 14 13 12 3x4 = 3x4 = 12-6-0 12-6-0 LOADING (psf) SPACING-2-0-0 CSI. DEFL. L/d **PLATES** GRIP I/def TCLL 25.0 Plate Grip DOL 1.15 TC 0.08 Vert(LL) 0.00 90 MT20 220/195 n/r (Roof Snow=25.0) BC Lumber DOL 1.15 0.04 Vert(CT) 0.00 11 n/r 120 TCDL 7.0 Rep Stress Incr YES WB 0.03 Horz(CT) 0.00 10 n/a n/a BCLL 0.0 \* Code IBC2015/TPI2014 (Matrix) Weight: 65 lb FT = 10% BCDL 10.0 LUMBER-**BRACING-**TOP CHORD 2x4 DF No.1&Btr G TOP CHORD Structural wood sheathing directly applied or 6-0-0 oc purlins. BOT CHORD 2x4 DF No.1&Btr G BOT CHORD Rigid ceiling directly applied or 10-0-0 oc bracing. 2x4 DF Std G OTHERS MiTek recommends that Stabilizers and required cross bracing be installed during truss erection, in accordance with Stabilizer

Installation guide.

REACTIONS. All bearings 12-6-0.

(lb) - Max Horz 2=139(LC 9)

Max Uplift All uplift 100 lb or less at joint(s) 2, 10, 16, 17, 18, 14, 13, 12

Max Grav All reactions 250 lb or less at joint(s) 2, 10, 15, 16, 17, 18, 14, 13, 12

FORCES. (lb) - Max. Comp./Max. Ten. - All forces 250 (lb) or less except when shown.

#### NOTES-

- 1) Wind: ASCE 7-10; Vult=140mph (3-second gust) Vasd=111mph; TCDL=4.2psf; BCDL=6.0psf; h=25ft; Cat. II; Exp B; enclosed; MWFRS (envelope) automatic zone and C-C Corner(3) -1-0-0 to 2-3-0, Exterior(2) 2-3-0 to 3-3-0, Corner(3) 3-3-0 to 6-3-0, Exterior(2) 9-3-0 to 10-3-0 zone; cantilever left and right exposed; end vertical left and right exposed; C-C for members and forces & MWFRS for reactions shown; Lumber DOL=1.60 plate grip DOL=1.60
- 2) Truss designed for wind loads in the plane of the truss only. For studs exposed to wind (normal to the face), see Standard Industry Gable End Details as applicable, or consult qualified building designer as per ANSI/TPI 1.
- 3) TCLL: ASCE 7-10; Pf=25.0 psf (flat roof snow); Category II; Exp B; Fully Exp.; Ct=1.1
- 4) This truss has been designed for greater of min roof live load of 16.0 psf or 2.00 times flat roof load of 25.0 psf on overhangs non-concurrent with other live loads.
- 5) All plates are 2x4 MT20 unless otherwise indicated.
- 6) Gable requires continuous bottom chord bearing.
- 7) Gable studs spaced at 1-4-0 oc.
- 8) This truss has been designed for a 10.0 psf bottom chord live load nonconcurrent with any other live loads.
- 9) \* This truss has been designed for a live load of 20.0psf on the bottom chord in all areas where a rectangle 3-6-0 tall by 2-0-0 wide will fit between the bottom chord and any other members.
- 10) A plate rating reduction of 20% has been applied for the green lumber members.
- 11) Provide mechanical connection (by others) of truss to bearing plate capable of withstanding 100 lb uplift at joint(s) 2, 10, 16, 17, 18, 14, 13, 12.
- 12) "Fix heels only" Member end fixity model was used in the analysis and design of this truss.

City of Portland REVIEWED FOR CODE COMPLIANCE APR 2 6 2018 Permit Number




EXPIRES: 12/31/2017 May 30,2017

🔔 WARNING - Verify design parameters and READ NOTES ON THIS AND INCLUDED MITEK REFERENCE PAGE MII-7473 rev. 10/03/2015 BEFORE USE. 



Job Truss Truss Type Qty Ply **DK Homes** K3247595 B1701644 D01 GABLE Job Reference (optional) ProBuild Beaverton Truss, Beaverton, oR 97007 7.640 s Sep 29 2015 MiTek Industries, Inc. Mon May 29 13:26:57 2017 Page 1 ID:DjKklw\_csBnsEStNLVN55?zBeiX-YAceD6IPbB?1ctIdSJqWNpXmRRFfetUlpZELgezBcdy -1-0-0 1-0-0 1-0-0 1-0-0 Scale = 1:9.1 3

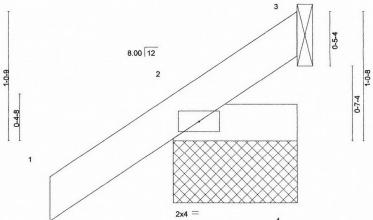

1-0-0 LOADING (psf) SPACING-2-0-0 CSI. DEFL I/defl L/d **PLATES** GRIP TCLL 25.0 TC BC Plate Grip DOL 1.15 0.14 Vert(LL) -0.00 >999 240 MT20 220/195 =25.0) (Roof Snow Lumber DOL 1.15 0.01 Vert(CT) -0.00 >999 180 TCDL 7.0 Rep Stress Incr YES WB 0.00 Horz(CT) -0.00 3 n/a n/a 0.0 \* BCLL Code IBC2015/TPI2014 (Matrix) Weight: 5 lb FT = 10% BCDI 10.0

LUMBER-

TOP CHORD 2x4 DF No.1&Btr G BOT CHORD 2x4 DF Std G BRACING-

1-0-0

TOP CHORD BOT CHORD Structural wood sheathing directly applied or 1-0-0 oc purlins. Rigid ceiling directly applied or 10-0-0 oc bracing.

MiTek recommends that Stabilizers and required cross bracing be installed during truss erection, in accordance with Stabilizer Installation guide.

REACTIONS. (lb/size) 2=200/1-0-0, 4=7/1-0-0, 3=-66/Mechanical Max Horz 2=55(LC 10) Max Uplift 2=-82(LC 10), 3=-150(LC 16) Max Grav 2=318(LC 16), 4=13(LC 3), 3=26(LC 14)

FORCES. (lb) - Max. Comp./Max. Ten. - All forces 250 (lb) or less except when shown.

#### NOTES-

- 1) Wind: ASCE 7-10; Vult=140mph (3-second gust) Vasd=111mph; TCDL=4.2psf; BCDL=6.0psf; h=25ft; Cat. II; Exp B; enclosed; MWFRS (envelope) automatic zone and C-C Corner(3) zone; cantilever left and right exposed; end vertical left and right exposed; C-C for members and forces & MWFRS for reactions shown; Lumber DOL=1.60 plate grip DOL=1.60
- 2) Truss designed for wind loads in the plane of the truss only. For studs exposed to wind (normal to the face), see Standard Industry Gable End Details as applicable, or consult qualified building designer as per ANSI/TPI 1.
- 3) TCLL: ASCE 7-10; Pf=25.0 psf (flat roof snow); Category II; Exp B; Fully Exp.; Ct=1.1
- 4) This truss has been designed for greater of min roof live load of 16.0 psf or 2.00 times flat roof load of 25.0 psf on overhangs non-concurrent with other live loads.
- 5) Gable studs spaced at 1-4-0 oc.
- 6) This truss has been designed for a 10.0 psf bottom chord live load nonconcurrent with any other live loads.
- 7) \* This truss has been designed for a live load of 20.0psf on the bottom chord in all areas where a rectangle 3-6-0 tall by 2-0-0 wide will fit between the bottom chord and any other members.
- 8) A plate rating reduction of 20% has been applied for the green lumber members.
- 9) Refer to girder(s) for truss to truss connections.
- 10) Provide mechanical connection (by others) of truss to bearing plate capable of withstanding 100 lb uplift at joint(s) 2 except (jt=lb) 3=150.
- 11) "Fix heels only" Member end fixity model was used in the analysis and design of this truss.

City of Portland
REVIEWED FOR CODE
COMPLIANCE

APR 2 6 2018

Permit Number



EXPIRES: 12/31/2017 May 30,2017



Job Truss Truss Type Qty DK Homes Ply K3247596 D02 B1701644 Monopitch 1 Job Reference (optional)


ProBuild Beaverton Truss,

Beaverton, oR 97007

7.640 s Sep 29 2015 MiTek Industries, Inc. Mon May 29 13:26:57 2017 Page 1 ID:DjKklw\_csBnsEStNLVN55?zBeiX-YAceD6IPbB?1ctIdSJqWNpXnFRFXetUlpZELgezBcdy

1-0-0 1-0-0

Scale = 1:9 1

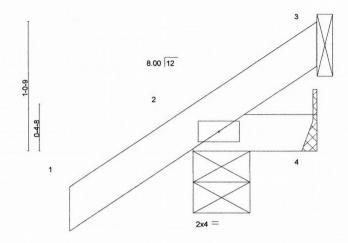

|                            |                                       |                 | 1-0-0   |                             |
|----------------------------|---------------------------------------|-----------------|---|-----------------------------|
| LOADING (psf)<br>TCLL 25.0 | SPACING- 2-0-0<br>Plate Grip DOL 1.15 | CSI.<br>TC 0.09 | <b>DEFL.</b> in (loc) I/defl L/d<br>Vert(LL) -0.00 2 >999 240 | PLATES GRIP<br>MT20 220/195 |
| (Roof Snow=25.0)           | Lumber DOL 1.15                       | BC 0.02         | Vert(CT) -0.00 2 >999 180                                     | Witzo ELSITO                |
| TCDL 7.0<br>BCLL 0.0 *     | Rep Stress Incr YES                   | WB 0.00         | Horz(CT) -0.00 3 n/a n/a                                      | M-1-1-1 5 Ib 5T - 400/      |
|                            | Code IBC2015/TPI2014                  | (Matrix)        |   | Weight: 5 lb FT = 10%       |

BCDL LUMBER-

TOP CHORD 2x4 DF No.1&Btr G BOT CHORD 2x4 DF Std G

10 0

BRACING-

1-0-0

TOP CHORD **BOT CHORD**  Structural wood sheathing directly applied or 1-0-0 oc purlins. Rigid ceiling directly applied or 10-0-0 oc bracing.

MiTek recommends that Stabilizers and required cross bracing be installed during truss erection, in accordance with Stabilizer Installation guide.

REACTIONS. (lb/size) 2=144/0-5-8, 4=9/Mechanical, 3=-7/Mechanical

Max Horz 2=55(LC 10)

Max Uplift 2=-56(LC 10), 3=-60(LC 16) Max Grav 2=201(LC 16), 4=19(LC 3), 3=11(LC 6)

FORCES. (lb) - Max. Comp./Max. Ten. - All forces 250 (lb) or less except when shown.

#### NOTES-

- 1) Wind: ASCE 7-10; Vult=140mph (3-second gust) Vasd=111mph; TCDL=4.2psf; BCDL=6.0psf; h=25ft; Cat. II; Exp B; enclosed; MWFRS (envelope) automatic zone and C-C Exterior(2) zone; cantilever left and right exposed; end vertical left and right exposed; C-C for members and forces & MWFRS for reactions shown; Lumber DOL=1.60 plate grip DOL=1.60
- 2) TCLL: ASCE 7-10; Pf=25.0 psf (flat roof snow); Category II; Exp B; Fully Exp.; Ct=1.1
- 3) This truss has been designed for greater of min roof live load of 16.0 psf or 2.00 times flat roof load of 25.0 psf on overhangs non-concurrent with other live loads.
- 4) This truss has been designed for a 10.0 psf bottom chord live load nonconcurrent with any other live loads.
- 5) \* This truss has been designed for a live load of 20.0psf on the bottom chord in all areas where a rectangle 3-6-0 tall by 2-0-0 wide will fit between the bottom chord and any other members.
- 6) A plate rating reduction of 20% has been applied for the green lumber members.
- 7) Refer to girder(s) for truss to truss connections.
- 8) Refer to girder(s) for truss to truss connections.
- 9) Provide mechanical connection (by others) of truss to bearing plate capable of withstanding 100 lb uplift at joint(s) 2, 3.
- 10) "Fix heels only" Member end fixity model was used in the analysis and design of this truss.

City of Portland APR 2 6 2018 Permit Number



EXPIRES: 12/31/2017 May 30,2017

A WARNING - Verify design parameters and READ NOTES ON THIS AND INCLUDED MITEK REFERENCE PAGE MII-7473 rev. 10/03/2015 BEFORE USE. Design valid for use only with MiTek® connectors. This design is based only upon parameters shown, and is for an individual building component, not a truss system. Before use, the building designer must verify the applicability of design parameters and properly incorporate this design into the overall building design. Bracing indicated is to prevent buckling of individual truss web and/or chord members only. Additional temporary and permanent bracing is always required for stability and to prevent collapse with possible personal injury and property damage. For general guidance regarding the fabrication, storage, delivery, erection and bracing of trusses and truss systems, see

ANSI/TP11 Quality Criteria, DSB-89 and BCSI Building Component Safety Information available from Truss Plate Institute, 218 N. Lee Street, Suite 312, Alexandria, VA 22314.



Job Truss Truss Type Qty Ply DK Homes K3247597 Jack-Open Girder B1701644 JC01 Job Reference (optional) ProBuild Beaverton Truss, Beaverton, oR 97007 7.640 s Sep 29 2015 MiTek Industries, Inc. Mon May 29 13:26:58 2017 Page 1 ID:DjKklw\_csBnsEStNLVN55?zBeiX-0NA0RSJ1LV7uE1tp00Llw04yWrWwNKku1DzuD4zBcdx -1-0-0 1-10-15 3-6-0 1-10-15 1-0-0 Scale = 1:8.8 5.00 12 2 0-3-9 0-4-2 6 2x4 = 1-10-3 1-10-15 0-0-12 3-6-0 1-10-3 1-7-1 LOADING (psf) SPACING-2-0-0 CSI. DEFL in (loc) I/def L/d **PLATES** GRIP TCLL 25 0 Plate Grip DOL 1.15 TC BC WB 0.12 Vert(LL) -0.01 2-4 >999 240 MT20 220/195 (Roof Snow=25.0) Lumber DOL 1 15 0.26 Vert(CT) -0.02 2-4 >999 180 TCDL Rep Stress Incr 0.00 NO Horz(CT) -0.003 n/a n/a BCLL 0.0 \* Code IBC2015/TPI2014 (Matrix) Weight: 9 lb FT = 10% BCDL 10.0 LUMBER-BRACING-TOP CHORD TOP CHORD 2x4 DF No.1&Btr G Structural wood sheathing directly applied or 3-6-0 oc purlins. **BOT CHORD** BOT CHORD 2x4 DF Std G Rigid ceiling directly applied or 10-0-0 oc bracing. MiTek recommends that Stabilizers and required cross bracing be installed during truss erection, in accordance with Stabilizer Installation guide REACTIONS. (lb/size) 3=29/Mechanical, 2=186/0-3-12, 4=42/Mechanical Max Horz 2=51(LC 10)

Max Uplift 3=-33(LC 16), 2=-57(LC 6)

Max Grav 3=30(LC 17), 2=221(LC 16), 4=85(LC 5)

FORCES. (lb) - Max. Comp./Max. Ten. - All forces 250 (lb) or less except when shown.

#### NOTES-

1) Wind: ASCE 7-10; Vult=140mph (3-second gust) Vasd=111mph; TCDL=4,2psf; BCDL=6,0psf; h=25ft; Cat. II; Exp B; enclosed; MWFRS (envelope) gable end zone; cantilever left and right exposed; end vertical left and right exposed; Lumber DOL=1.60 plate grip DOL=1.60

2) TCLL: ASCE 7-10; Pf=25.0 psf (flat roof snow); Category II; Exp B; Fully Exp.; Ct=1.1

3) Unbalanced snow loads have been considered for this design.

4) This truss has been designed for greater of min roof live load of 19.0 psf or 2.00 times flat roof load of 25.0 psf on overhangs non-concurrent with other live loads.

5) This truss has been designed for a 10.0 psf bottom chord live load nonconcurrent with any other live loads.

6) \* This truss has been designed for a live load of 20.0psf on the bottom chord in all areas where a rectangle 3-6-0 tall by 2-0-0 wide will fit between the bottom chord and any other members.

7) A plate rating reduction of 20% has been applied for the green lumber members.

8) Refer to girder(s) for truss to truss connections.

9) Provide mechanical connection (by others) of truss to bearing plate capable of withstanding 100 lb uplift at joint(s) 3, 2.

10) "Fix heels only" Member end fixity model was used in the analysis and design of this truss.

11) Hanger(s) or other connection device(s) shall be provided sufficient to support concentrated load(s) 8 lb down at 2-0-12, and 19 lb down at 3-5-4 on bottom chord. The design/selection of such connection device(s) is the responsibility of others.

12) In the LOAD CASE(S) section, loads applied to the face of the truss are noted as front (F) or back (B).

LOAD CASE(S) Standard

1) Dead + Snow (balanced): Lumber Increase=1.15, Plate Increase=1.15

Uniform Loads (plf)

Vert: 1-3=-64, 2-4=-20

Concentrated Loads (lb)

Vert: 4=-10(B)

City of Portland EWED FOR CODE OMPLIANCE APR 2 6 2018 Permit Number



EXPIRES: 12/31/2017 May 30,2017

eters and READ NOTES ON THIS AND INCLUDED MITEK REFERENCE PAGE MII-7473 rev. 10/03/2015 BEFORE USE. Design valid for use only with MiTek® connectors. This design is based only upon parameters shown, and is for an individual building component, not a truss system. Before use, the building designer must verify the applicability of design parameters and properly incorporate this design into the overall building design. Bracing indicated is to prevent buckling of individual truss web and/or chord members only. Additional temporary and permanent bracing is always required for stability and to prevent collapse with possible personal injury and property damage. For general guidance regarding the fabrication, storage, delivery, erection and bracing of trusses and truss systems, see 
ANSITTPI Quality Criteria, DSB-89 and BCSI Building Component Safety Information available from Truss Plate Institute, 218 N. Lee Street, Suite 312, Alexandria, VA 22314.



Ply DK Homes Job Truss Truss Type Qty K3247598 B1701644 JC02 Monopitch 3 Job Reference (optional) 7.640 s Sep 29 2015 MiTek Industries, Inc. Mon May 29 13:26:58 2017 Page 1 ID:DjKklw csBnsEStNLVN55?zBeiX-0NA0RSJ1LV7uE1tp00Llw04ylrXrNKHu1DzuD4zBcdx **ProBuild Beaverton Truss** Beaverton, oR 97007 -1-0-0 3-6-0 Scale = 1:12.1 3 2x4 || 5.00 12 0-4-2 2x4 || 5 2x4 = 3-6-0 3-6-0 LOADING (psf) PLATES GRIP SPACING-DEFL I/defl 1 /d 2-0-0 CSL in (loc) TCLL 220/195 0.10 Plate Grip DOL TC Vert(LL) -0.01 >999 1.15 2-6 240 MT20 (Roof Snow 25.0) BC -0.02 >999 180 Lumber DOL 1 15 0.20 Vert(CT) 2-6

Horz(CT)

BRACING-

TOP CHORD

BOT CHORD

0.00

n/a

Installation guide.

n/a

Structural wood sheathing directly applied or 3-6-0 oc purlins.

MiTek recommends that Stabilizers and required cross bracing be installed during truss erection, in accordance with Stabilizer

Rigid ceiling directly applied or 10-0-0 oc bracing.

LUMBER-

TCDL

BCLL

BCDL

TOP CHORD 2x4 DF No.1&Btr G BOT CHORD 2x4 DF Std G

7.0

10.0

0.0 \*

BOT CHORD 2x4 DF Std G WEBS 2x4 DF Std G

REACTIONS. (lb/size) 2=216/0-3-12, 6=139/Mechanical

Max Horz 2=81(LC 12)

Max Uplift 2=-63(LC 12), 6=-51(LC 12) Max Grav 2=218(LC 19), 6=149(LC 19)

Rep Stress Incr

Code IBC2015/TPI2014

YES

FORCES. (lb) - Max. Comp./Max. Ten. - All forces 250 (lb) or less except when shown.

#### NOTES-

1) Wind: ASCE 7-10; Vult=140mph (3-second gust) Vasd=111mph; TCDL=4.2psf; BCDL=6.0psf; h=25ft; Cat. II; Exp B; enclosed; MWFRS (envelope) automatic zone and C-C Exterior(2) zone; cantilever left and right exposed; end vertical left and right exposed; C-C for members and forces & MWFRS for reactions shown; Lumber DOL=1.60 plate grip DOL=1.60

WB 0.03

(Matrix)

- 2) TCLL: ASCE 7-10; Pf=25.0 psf (flat roof snow); Category II; Exp B; Fully Exp.; Ct=1.1
- 3) Unbalanced snow loads have been considered for this design.
- 4) This truss has been designed for greater of min roof live load of 19.0 psf or 2.00 times flat roof load of 25.0 psf on overhangs non-concurrent with other live loads.
- 5) This truss has been designed for a 10.0 psf bottom chord live load nonconcurrent with any other live loads.
- 6) \* This truss has been designed for a live load of 20.0psf on the bottom chord in all areas where a rectangle 3-6-0 tall by 2-0-0 wide will fit between the bottom chord and any other members.
- 7) A plate rating reduction of 20% has been applied for the green lumber members.
- 8) Refer to girder(s) for truss to truss connections.
- 9) Provide mechanical connection (by others) of truss to bearing plate capable of withstanding 100 lb uplift at joint(s) 2, 6.
- 10) "Fix heels only" Member end fixity model was used in the analysis and design of this truss.

City of Portland
REVIEWED FOR CODE
COMPLIANCE

APR 2 6 2018

Permit Number

FT = 10%

Weight: 13 lb



EXPIRES: 12/31/2017 May 30,2017



Job Truss Truss Type Qty Ply **DK Homes** K3247599 B1701644 SC02 Jack-Open Job Reference (optional) Beaverton, oR 97007 7.640 s Sep 29 2015 MiTek Industries, Inc. Mon May 29 13:26:59 2017 Page 1 ProBuild Beaverton Truss, ID:DjKklw\_csBnsEStNLVN55?zBeiX-UZkPeoJg6oFlrAS?aks\_SEc7UFv26nz2GtjSlWzBcdw -1-0-0 2-0-0 3-3-7 1-0-0 2-0-0 Scale = 1:11.8 0-4-8 5.00 12 4 0-4-2 2x4 = 2-0-0 2-0-0 LOADING (psf) SPACING-PLATES GRIP DEFL. (loc) I/defl TCLL 25.0 Plate Grip DOL 0.10 Vert(LL) -0.00 240 MT20 220/195 1.15 TC >999 (Roof Snow =25 0) Lumber DOL 1.15 BC 0.08 Vert(CT) -0.00 >999 180 TCDL 7.0 Rep Stress Incr YES WB 0.00 Horz(CT) -0.00 3 n/a n/a BCLL 0.0 Code IBC2015/TPI2014 (Matrix) Weight: 9 lb FT = 10%BCDI 10.0 LUMBER-**BRACING-**TOP CHORD 2x4 DF No.1&Btr G TOP CHORD Structural wood sheathing directly applied or 2-0-0 oc purlins. BOT CHORD 2x4 DF Std G **BOT CHORD** Rigid ceiling directly applied or 10-0-0 oc bracing. MiTek recommends that Stabilizers and required cross bracing be installed during truss erection, in accordance with Stabilizer Installation guide.

REACTIONS. (lb/size) 3=92/Mechanical, 2=198/0-3-12, 4=20/Mechanical

Max Horz 2=76(LC 12)

Max Uplift3=-66(LC 12), 2=-70(LC 12)

Max Grav 3=99(LC 19), 2=200(LC 19), 4=39(LC 5)

FORCES. (lb) - Max. Comp./Max. Ten. - All forces 250 (lb) or less except when shown.

#### NOTES-

- Wind: ASCE 7-10; Vult=140mph (3-second gust) Vasd=111mph; TCDL=4.2psf; BCDL=6.0psf; h=25ft; Cat. II; Exp B; enclosed; MWFRS (envelope) gable end zone and C-C Exterior(2) zone; cantilever left and right exposed; end vertical left and right exposed; C-C for members and forces & MWFRS for reactions shown; Lumber DOL=1.60 plate grip DOL=1.60
- 2) TCLL: ASCE 7-10; Pf=25.0 psf (flat roof snow); Category II; Exp B; Fully Exp.; Ct=1.1
- 3) Unbalanced snow loads have been considered for this design.
- 4) This truss has been designed for greater of min roof live load of 19.0 psf or 2.00 times flat roof load of 25.0 psf on overhangs non-concurrent with other live loads.
- 5) This truss has been designed for a 10.0 psf bottom chord live load nonconcurrent with any other live loads.
- 6) \* This truss has been designed for a live load of 20.0psf on the bottom chord in all areas where a rectangle 3-6-0 tall by 2-0-0 wide will fit between the bottom chord and any other members.
- 7) A plate rating reduction of 20% has been applied for the green lumber members.
- 8) Refer to girder(s) for truss to truss connections.
- 9) Provide mechanical connection (by others) of truss to bearing plate capable of withstanding 100 lb uplift at joint(s) 3, 2.
- 10) "Fix heels only" Member end fixity model was used in the analysis and design of this truss.

City of Portland
REVIEWED FOR CODE
COMPLIANCE

APR 2 6 2018

Permit Number



EXPIRES: 12/31/2017 May 30,2017




## **Symbols**

#### PLATE LOCATION AND ORIENTATION



Center plate on joint unless x, v offsets are indicated. Dimensions are in ft-in-sixteenths. Apply plates to both sides of truss and fully embed teeth.

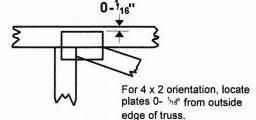

This symbol indicates the required direction of slots in connector plates.

\* Plate location details available in MiTek 20/20 software or upon request.

#### **PLATE SIZE**

 $4 \times 4$ 

The first dimension is the plate width measured perpendicular to slots. Second dimension is the length parallel to slots.

#### LATERAL BRACING LOCATION



Indicated by symbol shown and/or by text in the bracing section of the output. Use T or I bracing if indicated.

#### BEARING



Indicates location where bearings (supports) occur. Icons vary but reaction section indicates joint number where bearings occur. Min size shown is for crushing only.

#### **Industry Standards:**


ANSI/TPI1: National Design Specification for Metal Plate Connected Wood Truss Construction.

DSB-89: Design Standard for Bracing.

BCSI:

Building Component Safety Information, Guide to Good Practice for Handling, Installing & Bracing of Metal Plate Connected Wood Trusses.

## **Numbering System**

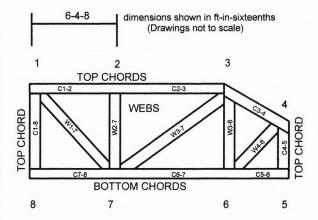

JOINTS ARE GENERALLY NUMBERED/LETTERED CLOCKWISE AROUND THE TRUSS STARTING AT THE JOINT FARTHEST TO THE LEFT.

CHORDS AND WEBS ARE IDENTIFIED BY END JOINT NUMBERS/LETTERS.

#### PRODUCT CODE APPROVALS

**ICC-ES Reports:** 

ESR-1311, ESR-1352, ESR1988 ER-3907, ESR-2362, ESR-1397, ESR-3282

Trusses are designed for wind loads in the plane of the truss unless otherwise shown.

Lumber design values are in accordance with ANSI/TPI 1 section 6.3 These truss designs rely on lumber values established by others.

© 2012 MiTek® All Rights Reserved



MiTek Engineering Reference Sheet: MII-7473 rev. 10/03/2015




## **General Safety Notes**

### Failure to Follow Could Cause Property Damage or Personal Injury

- 1. Additional stability bracing for truss system, e.g. diagonal or X-bracing, is always required. See BCSI.
- 2. Truss bracing must be designed by an engineer. For wide truss spacing, individual lateral braces themselves may require bracing, or atternative Tor I bracing should be considered.
- 3. Never exceed the design loading shown and never stack materials on inadequately braced trusses.
- 4. Provide copies of this truss design to the building designer, erection supervisor, property owner and all other interested parties.
- 5. Cut members to bear tightly against each other.
- 6. Place plates on each face of truss at each joint and embed fully. Knots and wane at joint locations are regulated by ANSI/TPI 1.
- 7. Design assumes trusses will be suitably protected from the environment in accord with ANSI/TPI 1.
- 8. Unless otherwise noted, moisture content of lumber shall not exceed 19% at time of fabrication.
- 9. Unless expressly noted, this design is not applicable for use with fire retardant, preservative treated, or green lumber.
- 10. Camber is a non-structural consideration and is the responsibility of truss fabricator. General practice is to camber for dead load deflection.
- 11. Plate type, size, orientation and location dimensions indicated are minimum plating requirements.
- 12. Lumber used shall be of the species and size, and in all respects, equal to or better than that specified.
- 13. Top chords must be sheathed or purlins provided at spacing indicated on design.
- 14. Bottom chords require lateral bracing at 10 ft. spacing, or less, if no ceiling is installed, unless otherwise noted.
- 15. Connections not shown are the responsibility of others.
- 16. Do not cut or alter truss member or plate without prior approval of an engineer.
- 17. Install and load vertically unless indicated otherwise.
- 18. Use of green or treated lumber may pose unacceptable environmental, health or performance risks. Consult with project engineer before use.
- Review all portions of this design (front, back, words and pictures) before use. Reviewing pictures alone. is not sufficient.
- 20. Design assumes manufacture in accordance with ANSI/TPI 1 Quality Criteria.

Permit Number

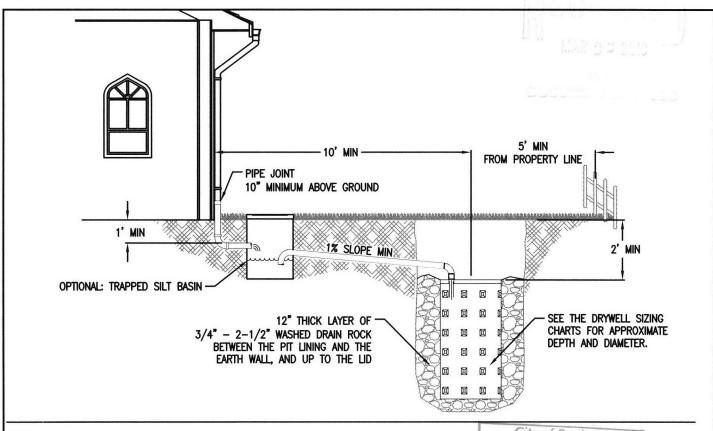

- Detail intended as an example. Detail must match design report.
- Provide protection from all vehicle traffic, equipment staging, and foot traffic in proposed infiltration areas prior to, during and after construction.
- Siting Criteria: Gravelly sand, gravelly loamy sand or other equally porous material must occur in a continuous 5' deep stratum within 12' of the ground surface. Drywell must not be placed where base of facility has less than 5' of separation to water table.
- Sizing: Exhibit 2-36 is used as guidance to size drywells. Sizing per stormwater report.
- 5. Top of drywell must be below lowest finished floor.
- 6. Setbacks: Measured from center of drywell, must be 10' from foundations, 5' from property lines, and 20' from cesspools. Drywells sized using the performance approach that use a significantly sized rock gallery must measure setbacks from the edge of the rock gallery or get approval from geotechnical and structural engineers to place drywell closer to the foundation.
- Piping: must be ABS Sch.40, cast iron, or PVC Sch.40.
   pipe required for up to 1,500 sq ft of impervious area, otherwise 4" min. Piping must have 1% grade and follow the Uniform Plumbing Code.

8. Trapped Silt Basin: Option only paved areas.

Optional for roof runoff of pedestrian
COMPLIANCE
APR 2 6 2018

Permit Number

Exhibit 2-36: Drywell Sizing Table

Once approval has been given by BES for onsite infiltration of stormwater, the following chart shall be used as a general guide for sizing. Sizing per stormwater report.

| IMPERVIOUS | 28" Diameter<br>Drywell Depth |     |     |     | 48" Diameter Drywell Depth |     |     |     |  |
|------------|-------------------------------|-----|-----|-----|----------------------------|-----|-----|-----|--|
| Area       |                               |     |     |     |                            |     |     |     |  |
| (sq-ft)    | 5'                            | 10' | 15' | 20' | 5'                         | 10' | 15' | 20' |  |
| 1000       |                               |     |     |     |                            |     |     |     |  |
| 2000       |                               |     |     |     |                            |     |     |     |  |
| 3000       |                               |     |     |     |                            |     |     |     |  |
| 4000       |                               |     |     |     |                            |     |     |     |  |
| 5000       |                               |     |     |     |                            |     |     |     |  |
| 6000       |                               |     |     |     |                            |     |     |     |  |
| 7000       |                               |     |     |     |                            |     |     |     |  |
| 8000       |                               |     |     |     |                            |     |     |     |  |
| 9000       |                               |     |     |     |                            |     |     |     |  |
| 10000      |                               |     |     |     |                            |     |     |     |  |

- DRAWING NOT TO SCALE -

#### STORMWATER MANAGEMENT TYPICAL DETAILS

Performance Design Approach – Drywell




NUMBER SW-280 7-1-16






## TRIANGLE SHAPE 🛕 INDICATES LEFT END ON LAYOUT AND TRUSS DRAWING ON STAMPED ENGINEERING PAGE

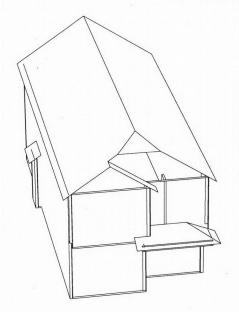

Garage Left
Use LUS24 Hangers UNO

TC LL = 25
TC DL = 7
BC LL = 0
BC DL = 10
Total Load = 42
Wind Speed = 140 mph
Exposure = B
Roof pitch = 5/12,8/12
Overhang = 12"

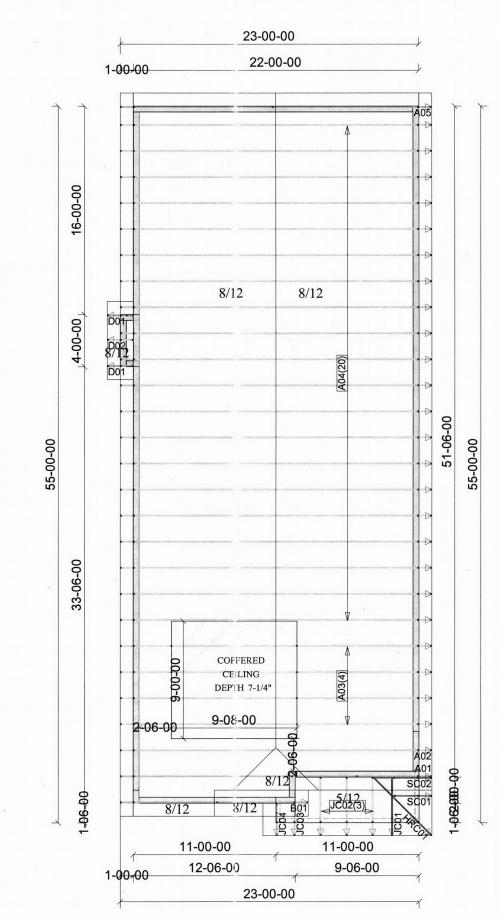

PRGSUIL STATE STAT

B1701644

Marielka Villegas

, Portland, OR

DK Homes

P1980

ROJECT:

NTS

05/29/2017

Jody Platta

DO NOT CUT, DRILL, NOTCH OR MODIFY TRUSS MEMBERS WITHOUT PRIOR APPROVAL FROM PROBUILD TRUSS