


THIS MAP TO BE RETURNED TO H. O. FREEMAN - PORTLAND - ONLY ONE COPY LEFT! NOTE HARBOUR LINES & NATURAL WATER LINES

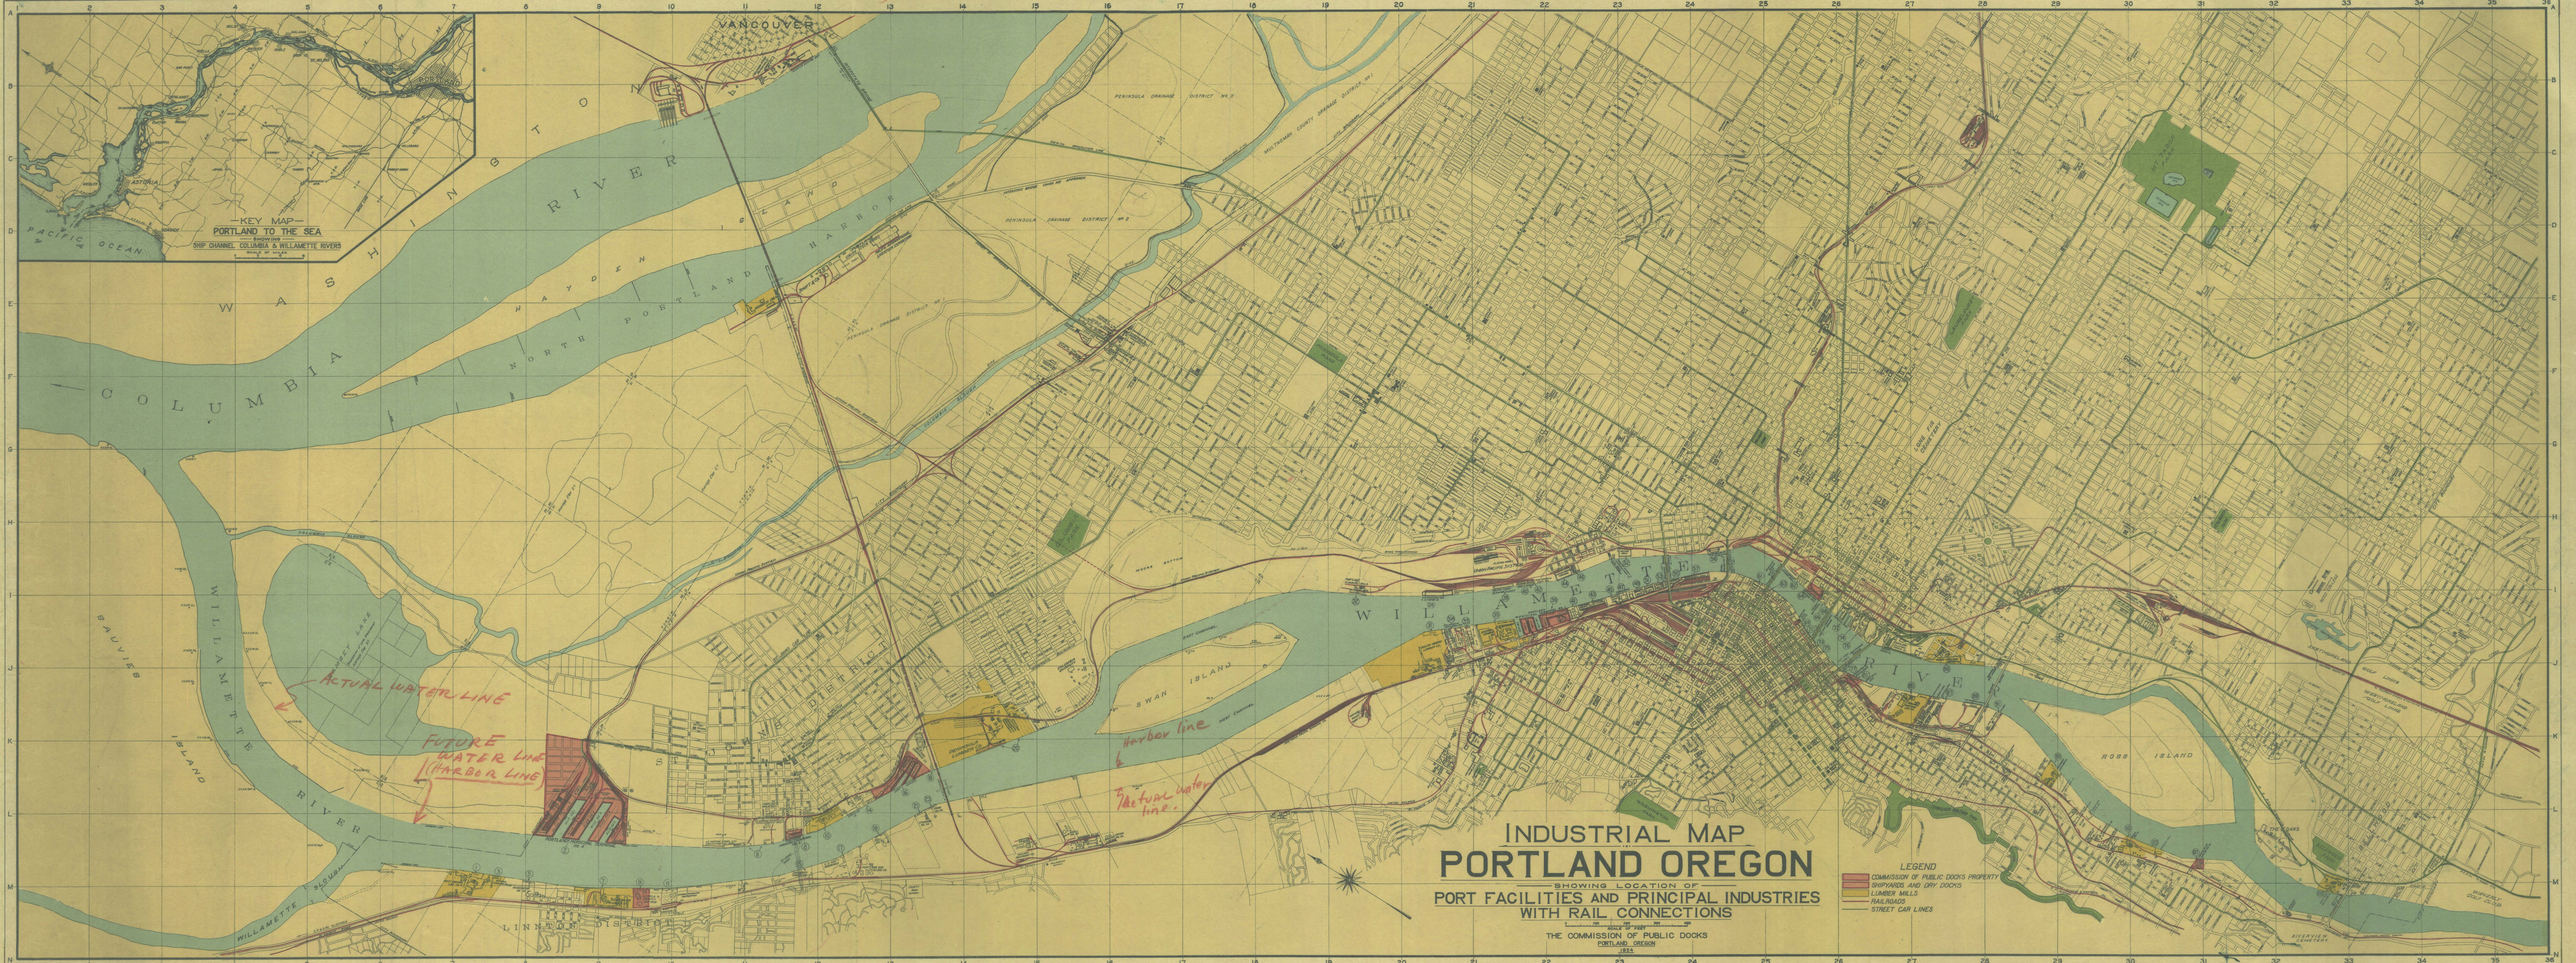

INDEX TO PORT FACILITIES—PORTLAND HARBOR

List of Principal Docks, Portland, Oregon, for Over-Seas and Coastwise Shipping			List of Principal Docks, Portland, Oregon, for Over-Seas and Coastwise Shipping—Continued			List of Principal Docks, Portland, Oregon, for River Shipping			List of Ship Repair and Outfitting Plants, Portland Harbor			Miscellaneous Industries Using Harbor Frontage			Miscellaneous Industries Using Harbor Frontage—Continued			
Location Indicated on Map by	Name of Dock	Dock Frontage in Ft.	Location Indicated on Map by	Name of Dock	Dock Frontage in Ft.	Location Indicated on Map by	Name of Dock	Dock Frontage in Ft.	Location Indicated on Map by	Name of Plant	Build and Service	Location Indicated on Map by	Name of Plant	Dock is Used for the Handling of	Location Indicated on Map by	Name of Plant	Dock is Used for the Handling of	
2	Portland Municipal Terminal No. 4, Grain Elevator, Bulk Storage Plant, Oil Storage Plant and Piers, Pier No. 1	2,105	44	Luteshamb Terminal	500	61	Allen & Lewis Dock	200	31A	Willamette Iron & Steel Works	Outfitting Yards	17	U. S. Government Mooring	Shops and Material	18	Western Coppage Co.	Fuel and Material	
3	Pier No. 2	1,828	47	Crown Mills	400	62	Washington Street Dock	200	9	United States Shipping Board, Emergency Fleet Corporation	Storage Yard	14	Portland Manufacturing Co.	Manufactured Products	23	Portland Vegetable Oil Mills Co.	Vegetable Oil Products	
4	Pier No. 3	1,965	49	Messy Dock	400	71	Alder Street Dock	200	6	Supple & Martin Shipyard	Wooden Yards and Berges	24	American Can Co.	Cans	41	Korn-Cloff & Co.	Gravel Mill	
5	West Oregon Lumber Co.	370	51	Columbia Dock No. 1	315	75	Yanhill Street Dock	200	107	Portland Shipbuilding Co.	River Boats	46	Star Saut Company	Shed and Gravel Bankers	46	Star Saut Company	Shed and Gravel Bankers	
6	Baevre Lumber Mills	300	53	Albers Dock No. 1	310	77	Taylor Street Dock	200	74	Columbia Contract Co.	Shed and Gravel Bankers	63	Nickum & Kelly	Shed and Gravel Bankers	63	Nickum & Kelly	Shed and Gravel Bankers	
7	Clark & Wilson Lumber Co.	880	55	Albers Dock No. 2	178		American Exchange Dock	200	76	Portland Municipal Paving Plant No. 1	Paving Plant	74	Pacific Bridge Co.	Shed and Gravel Bankers	76	Pacific Bridge Co.	Shed and Gravel Bankers	

List of Fuel Oil and Coal Docks, Portland Harbor

Location Indicated on Map by	Name of Dock	Dock Frontage in Ft.	Location Indicated on Map by	Name of Dock	Dock Frontage in Ft.
2	Municipal Coal Plant, Pier No. 5, Terminal No. 4	665	1	General Petroleum Corporation	229

Port Terminals and Properties of Commission of Public Docks are shown in red

Compiled and Distributed by the COMMISSION OF PUBLIC DOCKS Portland, Oregon 1924