(12) 2

CITY OF PORTLAND, OREGON - BUREAU OF DEVELOPMENT SERVICES

1900 SW Fourth Avenue, Suite 5000 • Portland, Oregon 97201 • www.portlandonline.com/bds • Fax 503-823-7425

Facility Permit Plan Intake Form

FOR INTAKE, STAFF USE ONLY

Date Received 8/8/13

Building Registration #

Fixed Bid

Bin # B1

Building Permit #

Mechanical # 13-191666-FA

Plumbing Permit #

Electrical Permit #

Building/Mechanical Scott 1

Electrical Lee 3

Plumbing

Fire Jerry 2

Planning

BES

PDOT

Structural

Other

APPLICANT: Complete all sections below that apply to the project. Please print legibly.

Print Name Clint Latimer Sign Name Clint

Street Address PO Box 241

City Dundee State Or Zip Code 97115

Day Phone 503 849 8162 FAX email clintl@oregonheating.com

Plans / permits available for pick up at 1900 SW 4th Avenue, 2nd floor between 8:00 am to 5:00 pm

Contact Name for plan/permit pick up Clint Latimer

Day Phone 503-849-8162 email clintl@oregonheating.com

Project Building Name / # Pacific Business Park Bldg 9

Project Address or Location 12403 NE Mark St

Project Name and Description Spec Vacancy

Bldg permit # 13-185620

Total Project Value Project Reference #/Billing ID #

Building Contractor CCB #

MechanicalContractor OHDC CCB # 172126

Electrical Contractor CCB# License #

Plumbing Contractor CCB# License #

13-191666-FA

☐ **Building Permit**

No. of Stories

Const. Type

[Y] [N] Alarms Required

[Y] [N] Smoke Det. Req'd

[Y] [N] Sprinklers Req'd

[Y] [N] Struct. Eng / Calcs Submitted

☒ **Mechanical Permit**

Mechanical Valuation $1300

Description duct modifications

restroom Fan

☐ **Electrical Permit**

Please provide a completed standard electrical permit application form. You may mail or deliver it to 1900 SW 4th Avenue, Portland, Oregon 97201 or FAX to 503-823-7425.

☐ **Plumbing Permit**

Number of Fixtures

Back Flow Devices

Water Service (# of Feet)

Medical Gas

Other

City of Portland
REVIEWED FOR CODE COMPLIANCE
AUG 13 2013
13-191666-FA
Permit Number

BI

Scope: 1. Demo duct from reduction of offices.
2. relocate grills to balance OFFICE AREA (X3).
3. INSTALL Restroom exhaust FAN

EQUIPMENT: Rtu1 - Existing 3.5 ton - 1400cfm NOMINAL
EF1 - Nutone QT80, 80CFM

OHAC
CCB#172126

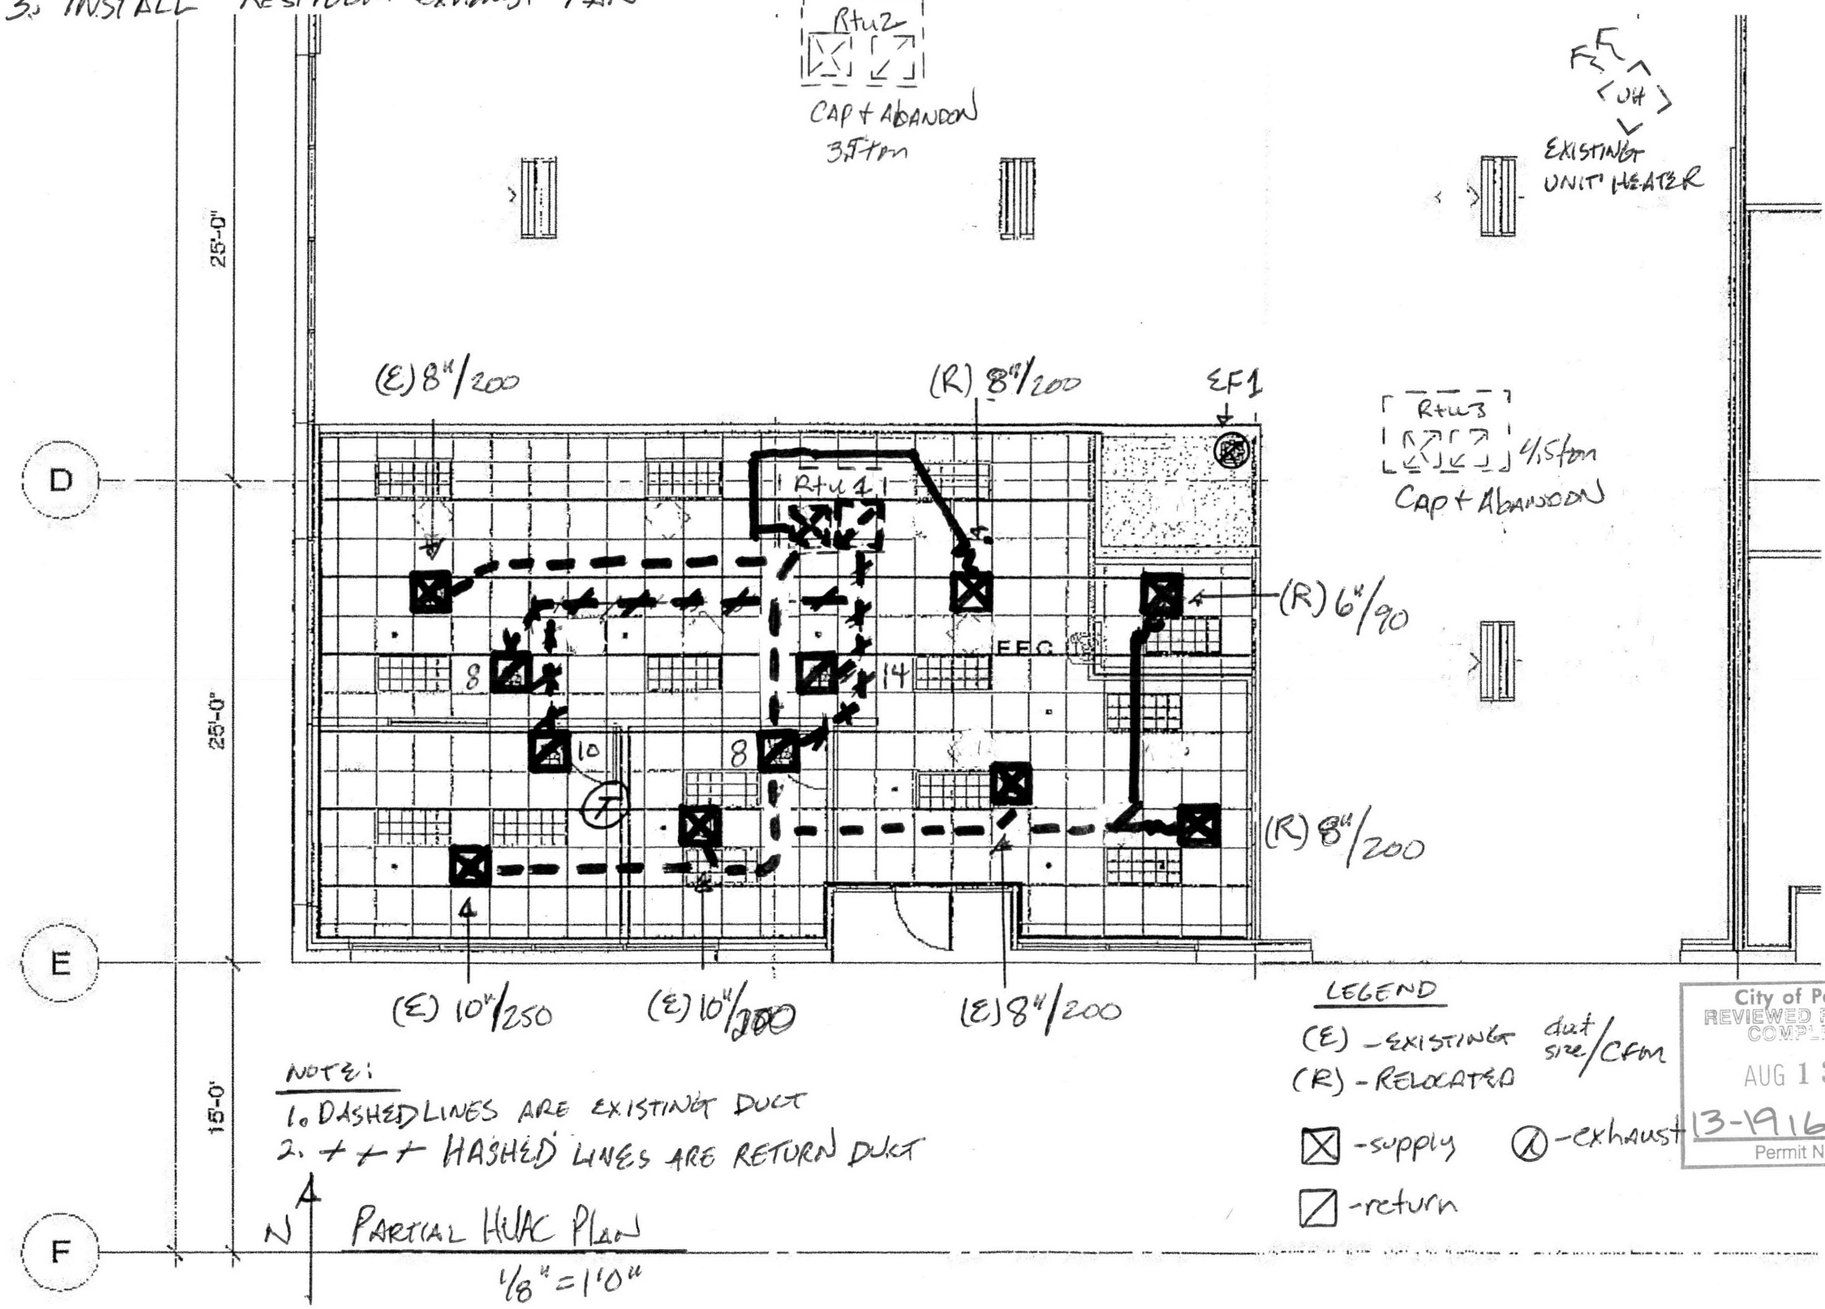

NOTE:
1. DASHED LINES ARE EXISTING DUCT
2. + + + HASHED LINES ARE RETURN DUCT

PARTIAL HVAC PLAN
1/8" = 1'0"

LEGEND
(E) - EXISTING duct size/CFM
(R) - RELOCATED
☒ - supply
Ⓐ - exhaust
☐ - return

City of Portland
REVIEWED FOR CODE COMPLIANCE
AUG 13 2013
13-191666FA
Permit Number

SPACE FOR:
SPEC VACANCY
PACIFIC BUSINESS PARK
12403 NE MARX ST
PORTLAND, OR 97230

13-191666-FA

M1

Bldg Permit #13-185628-FA

B-1