



Know what's below.  
Call before you dig.



THIS IS AN EXISTING SPRINT WIRELESS TELECOMMUNICATION FACILITY NETWORK VISION EQUIPMENT UPGRADE

# NETWORK VISION MMBS LAUNCH BURLINGAME 2

## PO03XC067

9700 CAPITAL HWY  
PORTLAND, OR 97219  
MULTNOMAH COUNTY

LATITUDE: 45.454925 / 45° 27' 17.73" (NAD 83) (GPS READING)  
LONGITUDE: -122.719231 / -122° 43' 9.23" (NAD 83) (GPS READING)

ROOFTOP

PORTLAND MARKET

RECEIVED  
AUG 02 2013  
BDS  
DOCUMENT SERVICES

Sprint



GENERAL DYNAMICS  
WIRELESS SERVICES



POWDER RIVER  
Development Services, LLC  
100 E. SHENANGO STREET  
SHARPSVILLE, PA 16150  
724.962.5999  
www.powderriverdev.com

PROJECT INFORMATION:

NETWORK VISION MMBS LAUNCH

### BURLINGAME 2

#### PO03XC067

9700 CAPITAL HWY  
PORTLAND, OR 97219  
MULTNOMAH, COUNTY

ISSUE DATE 06-27-2013

ISSUED FOR: CONSTRUCTION DWGS

REVISIONS				
REV.	DATE	DESCRIPTION	INITIALS	
A	08/22/12	ISSUED FOR CDs 90%	DM	
B	08/30/12	ISSUED FOR CDs 100%	CCM	
C	09/10/12	ISSUED FOR CDs FINALS	JED	
D	05/24/13	ISSUED FOR REVISED CDs FINALS	CCM	
E	06/27/13	ISSUED FOR REVISED CDs FINALS	JED	

NOT FOR CONSTRUCTION UNLESS  
LABELED AS CONSTRUCTION SET

LICENSURE:



SHEET TITLE:

TITLE SHEET

SHEET NUMBER:

# T-1

REVISION:

# E

PROJ. NO. 1678-02112

SHEET	DESCRIPTION
T-1	TITLE SHEET
N-1	GENERAL NOTES
N-2	GENERAL NOTES
A-1	OVERALL SITE PLAN
A-2	ENLARGED SITE PLAN
A-3	ENLARGED EQUIPMENT PLANS
A-3.1	EQUIPMENT DETAILS
A-4	ANTENNA PLANS AND SCHEDULES
A-5	NEW SOUTH & EAST ELEVATIONS
A-6	EQUIPMENT DETAILS
A-7	EQUIPMENT DETAILS (INDOOR SPECIFICATIONS)
A-8	EQUIPMENT DETAILS
A-9	EQUIPMENT DETAILS
A-10	EQUIPMENT DETAILS
A-11	EQUIPMENT DETAILS
RF-1	ANTENNA AND CABLE COLOR CODING DETAILS
E-1	ONE-LINE DIAGRAM & POWER PANEL SCHEDULE
E-2	DC POWER ONE-LINE DIAGRAM
E-3	ELECTRICAL DETAILS (INDOOR SPECIFICATIONS)
E-4	CONDUIT ROUTING
E-5	GROUNDING PLAN
E-6	GROUNDING DETAILS
E-7	GROUNDING DETAILS

### SHEET INDEX

#### APPLICANT:

GENERAL DYNAMICS WIRELESS SERVICES ON BEHALF OF SPRINT  
8880 SW NIMBUS AVENUE - SUITE B  
BEAVERTON, OR 97008-7111  
CONTACT: JAY GRATCHNER  
PH: 503.602.2703

#### PROPERTY INFORMATION:

PROPERTY OWNER: CASCADE SUMMIT LLC  
ADDRESS: 22400 S. SALAMO RD  
WEST LINN, OR 97068  
CONTACT: DAVID BAKER  
PH: (503) 657-6010  
TOWER OWNER: CASCADE SUMMIT LLC  
SITE ID: PO03XC067

ZONING CLASSIFICATION: GC (GENERAL COMMERCIAL)

CONSTRUCTION TYPE: VB

OCCUPANCY: U

JURISDICTION: CLACKAMAS COUNTY

CURRENT USE: UNMANNED WIRELESS TELECOMMUNICATIONS FACILITY

NEW USE: UNMANNED WIRELESS TELECOMMUNICATIONS FACILITY

#### PARCEL NUMBER(S):

21E260

#### LEASE AREA:

15'-2 1/2" x 14'-9"

### PROJECT SUMMARY

#### ARCHITECT & ELECTRICAL ENGINEER:

POWDER RIVER DEVELOPMENT SERVICES, LLC  
100 EAST SHENANGO STREET  
SHARPSVILLE, PA 16150  
CONTACT: JASON DOCTER  
PHONE: 724-977-2317  
EMAIL: jason.docter@powderriverdev.com

#### STRUCTURAL ENGINEER:

POWDER RIVER DEVELOPMENT SERVICES, LLC  
100 EAST SHENANGO STREET  
SHARPSVILLE, PA 16150  
CONTACT: GARY CLOWER  
PH: 724-962-5999  
EMAIL: gary.clower@powderriverdev.com

#### SITE ACQ. PROJECT MANAGER:

GENERAL DYNAMICS WIRELESS SERVICES  
8880 SW NIMBUS AVENUE - SUITE B  
BEAVERTON, OR 97008-7111  
CONTACT: BRIAN FLORES  
PH: (503) 207-7572  
EMAIL: brian.flores@gdt.com

#### CONSTRUCTION MANAGER:

GENERAL DYNAMICS WIRELESS SERVICES  
8880 SW NIMBUS AVENUE - SUITE B  
BEAVERTON, OR 97008-7111  
CONTACT: TIM JAMES  
PH: (503) 207-7570  
EMAIL: timothy.james@gdt.com

#### BUILDING DEPARTMENT:

CITY OF PORTLAND  
BUREAU OF DEVELOPMENTAL SERVICES  
CONTACT: MARTI MONTEZ  
PHONE: 503.823.7941

#### ELECTRICAL COMPANY:

PGE  
CONTACT: AVAILABLE REP  
PH: 503-736-5450

#### TELCO COMPANY:

GTE  
CONTACT: AVAILABLE REP  
PH: UNKNOWN

#### AAV MANAGER:

GENERAL DYNAMICS WIRELESS SERVICES  
8880 SW NIMBUS AVENUE - SUITE B  
BEAVERTON, OR 97008-7111  
CONTACT: VANCE WARHURST  
PH: UNKNOWN  
EMAIL: vance.warhurst@gdt.com

#### RF ENGINEER:

STA NETWORKS SERVICES  
8880 SW NIMBUS, SUITE B  
BEAVERTON, OR 97008  
CONTACT: DONNY BUI  
PH: 503.750.9870  
EMAIL: d.bui@sta.samsung.com

### PROJECT TEAM

**OREGON STATE CODE COMPLIANCE:**


ALL WORK AND MATERIALS SHALL BE PERFORMED AND INSTALLED IN ACCORDANCE WITH THE CURRENT EDITIONS OF THE FOLLOWING CODES AS ADOPTED BY THE LOCAL GOVERNING AUTHORITIES. NOTHING IN THESE PLANS IS TO BE CONSTRUCTED TO PERMIT WORK NOT CONFORMING TO THESE CODES.

- 2010 IBC, 2010 OREGON BUILDING CODE
- 2010 IMC, 2010 OREGON MECHANICAL CODE
- 2009 IFC, 2009 OREGON MECHANICAL CODE
- 2011 IPC, 2011 OREGON PLUMBING CODE

**ACCESSIBILITY REQUIREMENTS:**

FACILITY IS UNMANNED AND NOT FOR HUMAN HABITATION. HANDICAPPED ACCESS REQUIREMENTS ARE NOT REQUIRED IN ACCORDANCE WITH THE 2009 IBC BUILDING CODE.


**CODE BLOCK**

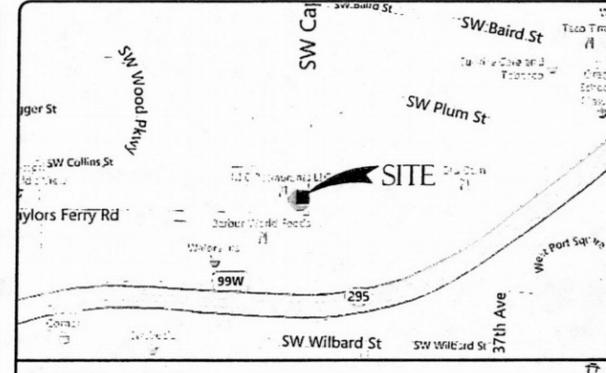

SPRINT PROPOSES TO MODIFY AN EXISTING UNMANNED TELECOMMUNICATIONS FACILITY

- REMOVE (3) EXISTING PANEL ANTENNAS (1 PER SECTOR)
- INSTALL (3) NEW PANEL ANTENNAS (1 PER SECTOR)
- REMOVE (1) POWER AND BATTERY CABINET
- REMOVE (1) MODCELL CABINETS
- INSTALL (1) NEW MMBS CABINET
- INSTALL (1) NEW BBU CABINET
- INSTALL (1) NEW FIBER JUNCTION BOX
- REMOVE ALL EXISTING SPRINT ANTENNA COAXIAL CABLES
- INSTALL (3) NEW HYBRIFLEX FIBER OPTIC CABLES USING EXISTING COAX ROUTE (1 PER SECTOR)
- INSTALL (3) NEW RRU'S

**PROJECT DESCRIPTION**

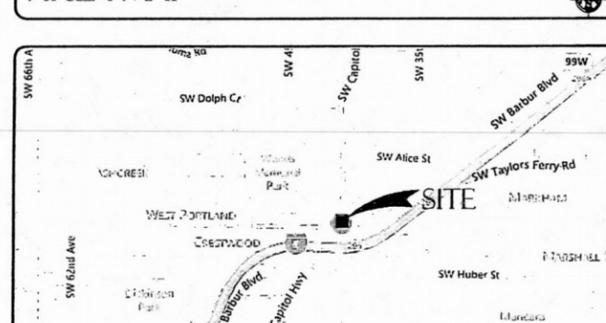

APPROVAL	SIGNATURE	DATE
SITE ACQUISITION MANAGER		
CONSTRUCTION MANAGER		
A&E MANAGER		
PLANNING CONSULTANT		
RF MANAGER		
RF ENGINEER		
PROPERTY OWNER		
SPRINT REPRESENTATIVE		
AAV MANAGER		

### SIGNATURE BLOCK

**DRIVING DIRECTIONS**

FROM SPRINT OFFICE IN BEAVERTON, OR (8880 SW NIMBUS AVENUE)  
DEPART SW NIMBUS AVE TOWARD SW STRATUS ST  
TURN RIGHT ONTO SW HALL BLVD  
TAKE RAMP LEFT FOR OR-217 SOUTH TOWARD TIGARD / SALEM  
AT EXIT 6, TAKE RAMP RIGHT FOR OR-99W TOWARD MCMINNVILLE / TIGARD 0.3 MI  
TURN LEFT ONTO OR-99W / SW PACIFIC HWY  
TAKE RAMP LEFT, TURN RIGHT ONTO SW CAPITOL HWY  
ARRIVE AT 9700 SW CAPITOL HWY, PORTLAND, OR 97219

13-131290-00

## GENERAL CONSTRUCTION NOTES

- ALL WORK SHALL CONFORM TO THE REQUIREMENTS OF THE LOCAL BUILDING CODE, THE LATEST EDITION AND ALL OTHER APPLICABLE CODES AND ORDINANCES.
- CONTRACTOR SHALL CONSTRUCT SITE IN ACCORDANCE WITH THESE DRAWINGS AND SPRINT INTEGRATED CONSTRUCTION STANDARDS FOR WIRELESS SITES (LATEST REVISION). THE SPECIFICATION IS THE RULING DOCUMENT AND ANY DISCREPANCIES BETWEEN THE SPECIFICATION AND THESE DRAWINGS SHOULD BE BROUGHT TO THE ATTENTION OF THE ENGINEER PRIOR TO PROCEEDING WITH CONSTRUCTION.
- CONTRACTOR SHALL VISIT THE JOB SITE AND SHALL FAMILIARIZE HIMSELF WITH ALL CONDITIONS AFFECTING THE NEW WORK AND SHALL MAKE PROVISIONS AS TO THE COST THEREOF. FIELD CONDITIONS AND DIMENSIONS AND CONFIRMING THAT THE WORK MAY BE ACCOMPLISHED AS SHOWN PRIOR TO PROCEEDING WITH CONSTRUCTION. ANY DISCREPANCIES SHALL BE BROUGHT TO THE ATTENTION OF THE ENGINEER PRIOR TO THE COMMENCEMENT OF WORK. NO COMPENSATION WILL BE AWARDED BASED ON CLAIM OF LACK OF KNOWLEDGE OF FIELD CONDITIONS.
- PLANS ARE NOT TO BE SCALED. THESE PLANS ARE INTENDED TO BE A DIAGRAMMATIC OUTLINE ONLY UNLESS OTHERWISE NOTED. THE WORK SHALL INCLUDE FURNISHING MATERIALS, EQUIPMENT AND APPURTENANCES, AND LABOR NECESSARY TO EFFECT ALL INSTALLATIONS AS INDICATED ON THE DRAWINGS.
- DIMENSIONS SHOWN ARE TO FINISH SURFACES UNLESS OTHERWISE NOTED. SPACING BETWEEN EQUIPMENT IS REQUIRED CLEARANCE. THEREFORE, IT IS CRITICAL TO FIELD VERIFY DIMENSIONS. SHOULD THERE BE ANY QUESTIONS REGARDING THE CONTRACT DOCUMENTS, EXISTING CONDITIONS AND/OR DESIGN INTENT, THE CONTRACTOR SHALL BE RESPONSIBLE FOR OBTAINING THE WORK.
- DETAILS ARE INTENDED TO SHOW DESIGN INTENT. MODIFICATIONS MAY BE REQUIRED TO SUIT JOB DIMENSIONS OR CONDITIONS, AND SUCH MODIFICATIONS SHALL BE INCLUDED AS PART OF THE WORK.
- CONTRACTOR SHALL RECEIVE CLARIFICATION IN WRITING, AND SHALL RECEIVE IN WRITING AUTHORIZATION TO PROCEED BEFORE STARTING WORK ON ANY ITEMS NOT CLEARLY DEFINED OR IDENTIFIED BY THE CONTRACT DOCUMENTS.
- CONTRACTOR SHALL SUPERVISE AND DIRECT THE WORK USING THE BEST CONSTRUCTION SKILLS AND ATTENTION. CONTRACTOR SHALL BE SOLELY RESPONSIBLE FOR CONSTRUCTION MEANS, METHODS, TECHNIQUES, SEQUENCES AND PROCEDURES AND FOR COORDINATING ALL PORTIONS OF THE WORK UNDER CONTRACT, UNLESS OTHERWISE NOTED.
- CONTRACTOR SHALL BE RESPONSIBLE FOR THE SAFETY OF THE WORK AREA, ADJACENT AREAS AND BUILDING OCCUPANTS THAT ARE LIKELY TO BE AFFECTED BY THE WORK UNDER THIS CONTRACT. WORK SHALL CONFORM TO ALL OSHA REQUIREMENTS.
- CONTRACTOR SHALL COORDINATE HIS WORK WITH THE SUPERINTENDENT OF BUILDINGS & GROUNDS AND SCHEDULE HIS ACTIVITIES AND WORKING HOURS IN ACCORDANCE WITH THE REQUIREMENTS.
- CONTRACTOR SHALL BE RESPONSIBLE FOR COORDINATING HIS WORK WITH THE WORK OF OTHERS AS IT MAY RELATE TO RADIO EQUIPMENT, ANTENNAS AND ANY OTHER PORTIONS OF THE WORK.
- INSTALL ALL EQUIPMENT AND MATERIALS IN ACCORDANCE WITH MANUFACTURERS RECOMMENDATIONS UNLESS SPECIFICALLY OTHERWISE INDICATED OR WHERE LOCAL CODES OR REGULATIONS TAKE PRECEDENCE.
- MAKE NECESSARY PROVISIONS TO PROTECT EXISTING SURFACES, EQUIPMENT, IMPROVEMENTS, PIPING ETC. AND IMMEDIATELY REPAIR ANY DAMAGE THAT OCCURS DURING CONSTRUCTION.
- IN DRILLING HOLES INTO CONCRETE WHETHER FOR FASTENING OR ANCHORING PURPOSES, OR PENETRATIONS THROUGH THE FLOOR FOR CONDUIT RUNS, PIPE RUNS, ETC., MUST BE CLEARLY UNDERSTOOD THAT REINFORCING STEEL SHALL NOT BE DRILLED INTO, CUT OR DAMAGED UNDER ANY CIRCUMSTANCES (UNLESS NOTED OTHERWISE). LOCATIONS OF REINFORCING STEEL ARE NOT DEFINITELY KNOWN AND THEREFORE MUST BE SEARCHED FOR BY APPROPRIATE METHODS AND EQUIPMENT.
- REPAIR ALL EXISTING WALL SURFACES DAMAGED DURING CONSTRUCTION SUCH THAT THEY MATCH AND BLEND IN WITH ADJACENT SURFACES.
- SEAL PENETRATIONS THROUGH FIRE RATED AREAS WITH U.L. LISTED AND FIRE CODE APPROVED MATERIALS.
- KEEP CONTRACT AREA CLEAN, HAZARD FREE, AND DISPOSE OF ALL DIRT, DEBRIS, AND RUBBISH. EQUIPMENT NOT SPECIFIED AS REMAINING ON THE PROPERTY OF THE OWNER SHALL BE REMOVED. LEAVE PREMISES IN CLEAN CONDITION AND FREE FROM PAINT SPOTS, DUST, OR SMUDGES OF ANY NATURE. CONTRACTOR SHALL BE RESPONSIBLE FOR MAINTAINING ALL ITEMS UNTIL COMPLETION OF CONSTRUCTION.
- MINIMUM BEND RADIUS OF ANTENNA CABLES SHALL BE IN ACCORDANCE WITH CABLE MANUFACTURERS RECOMMENDATIONS.
- ALL EXISTING INACTIVE SEWER, WATER, GAS, ELECTRIC AND OTHER UTILITIES, WHICH INTERFERE WITH THE EXECUTION OF THE WORK, SHALL BE REMOVED AND/OR CAPPED, PLUGGED OR OTHERWISE DISCONTINUED AT POINTS WHICH WILL NOT INTERFERE WITH THE EXECUTION OF THE WORK, SUBJECT TO THE APPROVAL OF THE ENGINEER.
- CONTRACTOR SHALL MINIMIZE DISTURBANCE TO EXISTING SITE DURING CONSTRUCTION. EROSION CONTROL MEASURES, IF REQUIRED DURING CONSTRUCTION SHALL BE IN CONFORMANCE WITH JURISDICTIONAL OR STATE AND LOCAL GUIDELINES FOR EROSION AND SEDIMENT CONTROL AND COORDINATED WITH LOCAL REGULATORY AUTHORITIES.
- LIGHT SHADED LINES AND NOTES REPRESENT WORK PREVIOUSLY DONE. DARK SHADED LINES AND NOTES REPRESENT THE SCOPE OF WORK FOR THIS PROJECT. CONTRACTOR SHALL VERIFY IF EXISTING CONSTRUCTION IS COMPLETE. CONTRACTOR SHALL NOTIFY ENGINEER OF ANY EXISTING CONDITIONS THAT DEVIATE FROM THE DRAWINGS PRIOR TO BEGINNING CONSTRUCTION.
- CONTRACTOR SHALL SECURE ALL NECESSARY PERMITS AND/OR WIRING CERTIFICATES REQUIRED FOR THE ELECTRICAL SERVICE UPGRADE. IN ADDITION, CONTRACTOR SHALL PROVIDE ALL NECESSARY COORDINATION AND SCHEDULING WITH THE SERVING ELECTRICAL UTILITY AND LOCAL INSPECTION AUTHORITIES.

## ELECTRICAL NOTES

- ELECTRICAL CONTRACTOR SHALL SUPPLY AND INSTALL ANY/ALL ELECTRICAL WORK INDICATED. ANY/ALL CONSTRUCTION SHALL BE IN ACCORDANCE WITH DRAWINGS AND ANY/ALL APPLICABLE SPECIFICATIONS. IF ANY PROBLEMS ARE ENCOUNTERED BY COMPLYING WITH THESE REQUIREMENTS, CONTRACTOR SHALL NOTIFY "CONSTRUCTION MANAGER" AS SOON AS POSSIBLE, AFTER THE DISCOVERY OF THE PROBLEMS, AND SHALL NOT PROCEED WITH THAT PORTION OF WORK, UNTIL THE "CONSTRUCTION MANAGER" HAS DIRECTED THE CORRECTIVE ACTIONS TO BE TAKEN.
- ELECTRICAL CONTRACTOR SHALL VISIT THE JOB SITE AND FAMILIARIZE HIMSELF WITH ANY/ALL CONDITIONS AFFECTING ELECTRICAL AND COMMUNICATION INSTALLATION AND MAKE PROVISIONS AS TO THE COST THEREOF. ALL EXISTING CONDITIONS OF ELECTRICAL EQUIP., LIGHT FIXTURES, ETC., THAT ARE PART OF THE FINAL SYSTEM, SHALL BE VERIFIED BY THE CONTRACTOR, PRIOR TO THE SUBMITTAL OF HIS BID. FAILURE TO COMPLY WITH THIS PARAGRAPH WILL IN NO WAY RELIEVE CONTRACTOR OF PERFORMING ALL WORK NECESSARY FOR A COMPLETE AND WORKING SYSTEM.
- ALL WORK SHALL BE PERFORMED IN ACCORDANCE WITH THE LATEST EDITION OF THE NEC AND ALL CODES AND LOCAL ORDINANCES OF THE LOCAL POWER & TELEPHONE COMPANIES HAVING JURISDICTION AND SHALL INCLUDE BUT NOT BE LIMITED TO:
  - UL -- UNDERWRITERS LABORATORIES
  - NEC -- NATIONAL ELECTRICAL CODE
  - NEMA -- NATIONAL ELECTRICAL MANUFACTURERS ASSOC.
  - OSHA -- OCCUPATIONAL SAFETY AND HEALTH ACT
  - IBC -- INTERNATIONAL BUILDING CODE
  - NFPA -- NATIONAL FIRE CODES

- DO NOT SCALE ELECTRICAL DRAWINGS, REFER TO SITE PLANS AND ELEVATIONS FOR EXACT LOCATIONS OF ALL EQUIPMENT, AND CONFIRM WITH "CONSTRUCTION MANAGER" ANY SIZES AND LOCATIONS WHEN NEEDED.
- EXISTING SERVICES: CONTRACTOR SHALL NOT INTERRUPT EXISTING SERVICES WITHOUT WRITTEN PERMISSION OF THE GDIT.
- CONTRACTOR SHALL PAY FOR ANY/ALL PERMITS, FEES, INSPECTIONS AND TESTING. CONTRACTOR IS TO OBTAIN PERMITS AND APPROVED SUBMITTALS PRIOR TO THE WORK BEGINNING OR ORDERING EQUIPMENT.
- THE TERM "PROVIDE" USED IN CONSTRUCTION DOCUMENTS AND SPECIFICATIONS, INDICATES THAT THE CONTRACTOR SHALL FURNISH AND INSTALL.
- CONTRACTOR SHALL CONFIRM WITH LOCAL UTILITY COMPANY ANY/ALL REQUIREMENTS SUCH AS THE: LUG SIZE RESTRICTIONS, CONDUIT ENTRY, SIZE OF TRANSFORMERS, SCHEDULED DOWNTIME FOR THE OWNERS' CONFIRMATION, ETC. ANY/ALL CONFLICTS SHALL BE BROUGHT TO THE ATTENTION OF THE CONSTRUCTION MANAGER, PRIOR TO BEGINNING ANY WORK.
- MINIMUM WIRE SIZE SHALL BE #12 AWG, NOT INCLUDING CONTROL WIRING, UNLESS NOTED OTHERWISE. ALL CONDUCTORS SHALL BE COPPER WITH THWN INSULATION.
- OUTLET BOXES SHALL BE PRESSED STEEL IN DRY LOCATIONS, CAST ALLOY WITH THREADED HUBS IN WET/DAMP LOCATIONS AND SPECIAL ENCLOSURES FOR OTHER CLASSIFIED AREAS.
- IT IS NOT THE INTENT OF THESE PLANS TO SHOW EVERY MINOR DETAIL OF THE CONSTRUCTION. CONTRACTOR IS EXPECTED TO FURNISH AND INSTALL ALL ITEMS FOR A COMPLETE ELECTRICAL SYSTEM AND PROVIDE ALL REQUIREMENTS FOR THE EQUIPMENT TO BE PLACED IN PROPER WORKING ORDER.
- ELECTRICAL SYSTEM SHALL BE AS COMPLETELY AND EFFECTIVELY GROUNDED, AS REQUIRED BY SPECIFICATION, SET FORTH BY SPRINT.
- ALL WORK SHALL BE PERFORMED BY A LICENSED ELECTRICAL CONTRACTOR IN A FIRST CLASS, WORKMANLIKE MANNER. THE COMPLETED SYSTEM SHALL BE FULL OPERATIVE AND SUBJECT TO REGULATORY INSPECTION AND APPROVAL BY CONSTRUCTION MANAGER.
- ALL WORK SHALL BE COORDINATED WITH OTHER TRADES TO AVOID INTERFERENCE WITH THE PROGRESS OF CONSTRUCTION.
- CONTRACTOR SHALL GUARANTEE ANY/ALL MATERIALS AND WORK FREE FROM DEFECTS OR A PERIOD OF NOT LESS THAN TWO YEARS FROM DATE OF CUSTOMER'S ACCEPTANCE.
- THE CORRECTION OF ANY DEFECTS SHALL BE COMPLETED WITHOUT ANY ADDITIONAL CHARGE AND SHALL INCLUDE THE REPLACEMENT OF THE REPAIR OF ANY OTHER PHASE OF THE INSTALLATION, WHICH MAY HAVE BEEN DAMAGED THEREIN WITHIN 48 HOURS.
- ADEQUATE AND REQUIRED LIABILITY INSURANCE SHALL BE PROVIDED FOR PROTECTION AGAINST PUBLIC LOSS AND ANY/ALL PROPERTY DAMAGE FOR THE DURATION OF WORK.
- PROVIDE AND INSTALL CONDUIT, CONDUCTORS, PULL WIRES, BOXES, COVER PLATES AND DEVICES FOR ALL OUTLETS AS INDICATED.
- DITCHING AND BACK FILL: CONTRACTOR SHALL PROVIDE FOR ALL UNDERGROUND INSTALLED CONDUIT AND/OR CABLES INCLUDING EXCAVATION AND BACKFILLING AND COMPACTION. REFER TO NOTES AND REQUIREMENTS, EXCAVATION, AND BACKFILLING.
- MATERIALS, PRODUCTS AND EQUIPMENT, INCLUDING ALL COMPONENTS THEREOF, SHALL BE NEW AND SHALL APPEAR ON THE LIST OF U.L. APPROVED ITEMS AND SHALL MEET OR EXCEED THE REQUIREMENTS OF THE NEC, NEMA AND IEEE.
- CONTRACTOR SHALL SUBMIT SHOP DRAWINGS OR MANUFACTURERS CATALOG INFORMATION OF ANY/ALL LIGHTING FIXTURES, SWITCHES AND ALL OTHER ELECTRICAL ITEMS FOR APPROVAL BY THE CONSTRUCTION MANAGER PRIOR TO INSTALLATION.
- ANY CUTTING OR PATCHING DEEMED NECESSARY FOR ELECTRICAL WORK IS THE ELECTRICAL CONTRACTORS RESPONSIBILITY AND SHALL BE INCLUDED IN THE COST FOR WORK AND PERFORMED TO THE SATISFACTION OF THE "CONSTRUCTION MANAGER" UPON FINAL ACCEPTANCE.
- THE ELECTRICAL CONTRACTOR SHALL LABEL ALL PANELS WITH ONLY TYPEWRITTEN DIRECTORIES. ALL ELECTRICAL WIRING SHALL BE THE RESPONSIBILITY OF THE ELECTRICAL CONTRACTOR.
- DISCONNECT SWITCHES SHALL BE H.P. RATED HEAVY-DUTY, QUICK-MAKE AND QUICK-BREAK ENCLOSURES, AS REQUIRED BY EXPOSURE TYPE.
- ALL CONNECTIONS SHALL BE MADE WITH A PROTECTIVE COATING OF AN ANTI-OXIDE COMPOUND SUCH AS "NO-OXIDE A" BY DEARBORNE CHEMICAL CO. COAT ALL WIRE SURFACES BEFORE CONNECTING. EXPOSED COPPER SURFACES, INCLUDING GROUND BARS, SHALL BE TREATED - NO SUBSTITUTIONS.
- REACEWAYS: CONDUIT SHALL BE SCHEDULE 40 PVC MEETING OR EXCEEDING NEMA TC2 - 1990. CONTRACTOR SHALL PLUG AND CAP EACH END OF SPARE AND EMPTY CONDUITS AND PROVIDE TWO SEPARATE PULL STRINGS - 200 LBS TEST POLYETHYLENE CORD. ALL CONDUIT BENDS SHALL BE A MINIMUM OF 2 FT. RADIUS. RGS CONDUITS WHEN SPECIFIED, SHALL MEET UL-6 FOR GALVANIZED STEEL. ALL FITTINGS SHALL BE SUITABLE FOR USE WITH THREADED RIGID CONDUIT. COAT ALL THREADS WITH 'BRITZ ZINC' OR 'GOLD CALV'.
- SUPPORT OF ALL ELECTRICAL WORK SHALL BE AS REQUIRED BY NEC.
- CONDUCTORS: CONTRACTOR SHALL USE 98% CONDUCTIVITY COPPER WITH TYPE THWN INSULATION, 600 VOLT, COLOR CODED. USE SOLID CONDUCTORS FOR WIRE UP TO AND INCLUDING NO. 8 AWG. USE STRANDED CONDUCTORS FOR WIRE ABOVE NO. 8 AWG.
- CONNECTORS FOR POWER CONDUCTORS: CONTRACTOR SHALL USE PRESSURE TYPE INSULATED TWIST-ON CONNECTORS FOR NO. 10 AWG AND SMALLER. USE SOLDERLESS MECHANICAL TERMINAL LUGS FOR NO. 8 AWG AND LARGER.
- SERVICE: 240/120V, SINGLE PHASE, 3 WIRE CONNECTIONS AVAILABLE FROM UTILITY COMPANY. OWNER OR OWNERS AGENT WILL APPLY FOR POWER.
- TELEPHONE SERVICE: CONTRACTOR SHALL PROVIDE EMPTY CONDUITS WITH MULE TAPE AS INDICATED ON DRAWINGS.
- ELECTRICAL AND TELCO RACEWAYS TO BE BURIED A MINIMUM OF 2' DEPTH.
- CONTRACTOR SHALL PLACE TWO LENGTHS OF WARNING TAPE AT A DEPTH OF 12" BELOW GROUND AND DIRECTLY ABOVE ELECTRICAL AND TELCO SERVICE CONDUITS. CAUTIONS TAPE TO READ "CAUTION BURIED ELECTRIC" OR "BURIED TELECOM".
- ALL BOLTS SHALL BE STAINLESS STEEL.

## ANTENNA & COAX NOTES

- VERIFY EACH COAXIAL CABLE LENGTH, DIAMETER, ROUTING, COLOR CODING AND ALL APPURTENANCES WITH GDIT.
- THE MAXIMUM COAXIAL CABLE LENGTH AND CORRESPONDING COAXIAL CABLE DIAMETER IS SHOWN ON SHEET A-4. THIS CABLE LENGTH IS TO BE USED FOR FABRICATION OR CONSTRUCTION. ACTUAL ANTENNA CABLE LENGTH(S) MUST BE VERIFIED. COAXIAL CABLE SHALL BE PROVIDED BY GDIT.
- ALL COAX CABLES SHALL UTILIZE GROUND KITS, GROUNDED AS FOLLOWS:
  - NEAR ANTENNA RAD CENTER ELEVATION.
  - MIDDLE OF TOWER (MID-HEIGHT OF ANTENNA), IF CABLE RUN IS OVER 200'.
  - BOTTOM OF TOWER,
  - AT MASTER GROUND BAR 3'-0" FROM MMBS-BBU CABINET

- ALL TOP JUMPERS SHALL BE LENGTHS AS SHOWN AND INSTALLED BY CONTRACTOR.
- ALL CABLES SHALL BE COLOR CODED AS SHOWN ON SHEET RF-1 AND IN ACCORDANCE WITH SPRINT SPECIFICATIONS.
- BANDING SHALL BE IN ACCORDANCE WITH SHEET A-4, RF-1 AND AS FOLLOWS:
  - MAIN LINE COLOR BANDS SHALL BE 2" WIDE. MAINTAIN 1" SPACING BETWEEN COLORS.
  - FREQUENCY COLOR BANDS SHALL BE 2" WIDE WITH NO SPACE BETWEEN COLORS.
  - JUMPER COLOR BANDS SHALL BE 1" WIDE WITH 1" SPACE.
  - START COLOR BANDS 2" BEYOND WEATHERPROOFING.
  - START SELECTOR COLOR NEXT TO END CONNECTORS.
- FINAL COAXIAL ANTENNA CABLE SIZES SHALL BE DETERMINED BY SAMSUNG RF ENGINEER. SEE ANTENNA SCHEDULE SHEET A-4. BASED ON FINAL CABLE RUN LENGTHS DETERMINED BY GD.
- SEE CONSTRUCTION MANAGER FOR ANTENNA SUPPORT ASSEMBLY TYPE.
- ALL COAXIAL CABLE WILL BE SECURED TO THE DESIGNED SUPPORT STRUCTURE AT DISTANCES NOT TO EXCEED 3' OR THE CABLE MANUFACTURERS SPECIFICATIONS WHICHEVER IS LESS, WITH HARDWARE SPECIFIED IN THE COAXIAL CABLE ROUTING DETAILS OF THE SUPPLIED STRUCTURAL REPORT.
- PROVIDE AT LEAST 6" OF SLACK IN THE MAIN COAXIAL CABLES AT THE ANTENNA MOUNTING ELEVATION TO PROVIDE FOR FUTURE CONNECTOR REPLACEMENT.

## ANTENNA & HYBRID CABLE NOTES

- VERIFY EACH HYBRID CABLE LENGTH, ROUTING, DIAMETER, COLOR CODING AND ALL APPURTENANCES WITH GDIT.
- THE HYBRID CABLE AND DIAMETER LENGTH IS SHOWN ON A-4. EXCESS CABLE LENGTHS TO BE DRESSED IN A MANNER APPROVED BY GDIT. CABLES CANNOT BE CUT TO FIT.
- HYBRID CABLE INTERNAL GROUND WIRE TO BE GROUNDED AT TOP AND BOTTOM PER SAMSUNG'S (SPRINT) SPECIFICATIONS.
- EXCESS TOP 15' HYBRID CABLE FIBER JUMPERS TO BE DRESSED IN A MANNER APPROVED BY GDIT, CANNOT BE COILED, MUST BE SECURED TO TOWER MOUNTS..
- ALL MAIN CABLES SHALL BE COLOR CODED AS SHOWN ON SHEET RF-1 & IN ACCORDANCE WITH SPRINT SPECIFICATIONS.
- BANDING SHALL BE IN ACCORDANCE WITH SHEET A-4, RF-1.
  - MAIN LINE COLOR BANDS SHALL BE 2" WIDE. MAINTAIN 1" SPACING BETWEEN.
  - JUMPER COLOR BANDS SHALL BE 1" WIDE WITH 1" SPACE.
  - START COLOR BANDS 2" BEFORE MAIN CABLE END.
- FINAL HYBRID CABLE SIZES SHALL BE DETERMINED BY SAMSUNG RF ENGINEER. SEE HYBRID CABLE SCHEDULE SHEET RF-1, BASED ON FINAL CABLE RUN LENGTHS DETERMINED BY GDIT.
- ALL HYBRID CABLE WILL BE SECURED TO THE DESIGNED SUPPORT STRUCTURE AT DISTANCES NOT TO EXCEED 3' HORIZONTALLY OR 4' VERTICALLY OR THE CABLE MANUFACTURER'S SPECIFICATIONS WHICHEVER IS LESS, WITH HARDWARE SPECIFIED IN THE HYBRID CABLE ROUTING DETAILS OF THE SUPPLIED STRUCTURAL SUPPORT.

## SITE WORK NOTES

- DO NOT EXCAVATE OR DISTURB BEYOND THE PROPERTY LINES OR LEASE LINES, UNLESS OTHERWISE NOTED.
- DO NOT SCALE BUILDING DIMENSIONS FROM DRAWING.
- SIZE, LOCATION AND TYPE OF ANY UNDERGROUND UTILITIES OR IMPROVEMENTS SHALL BE ACCURATELY NOTED AND PLACED ON AS-BUILT DRAWINGS BY GENERAL CONTRACTOR AND ISSUED TO ARCHITECT/ENGINEER AT COMPLETION OF PROJECT.
- ALL EXISTING UTILITIES, FACILITIES, CONDITIONS AND THEIR DIMENSIONS SHOWN ON PLANS HAVE BEEN PLOTTED FROM AVAILABLE RECORDS. THE ENGINEER AND OWNER ASSUME NOT RESPONSIBILITY WHATSOEVER AS TO THE SUFFICIENCY OR ACCURACY OF THE INFORMATION SHOWN ON THE PLANS OR THE MANNER OF THEIR REMOVAL OR ADJUSTMENT. CONTRACTOR SHALL BE RESPONSIBLE FOR DETERMINING EXACT LOCATION OF ALL EXISTING UTILITIES AND FACILITIES PRIOR TO START OF CONSTRUCTION. CONTRACTOR SHALL ALSO OBTAIN FROM EACH UTILITY COMPANY DETAILED INFORMATION RELATIVE TO WORKING SCHEDULES AND METHODS OF REMOVING OR ADJUSTING EXISTING UTILITIES.
- CONTRACTOR SHALL VERIFY ALL EXISTING UTILITIES BOTH HORIZONTALLY AND VERTICALLY PRIOR TO START OF CONSTRUCTION. ANY DISCREPANCIES OR DOUBTS AS TO THE INTERPRETATION OF PLANS SHALL BE IMMEDIATELY REPORTED TO THE ARCHITECT/ENGINEER FOR RESOLUTION AND INSTRUCTION, AND NO FURTHER WORK SHALL BE PERFORMED UNTIL THE DISCREPANCY IS CHECKED AND CORRECTED BY THE ARCHITECT/ENGINEER. FAILURE TO SECURE SUCH INSTRUCTION MEANS CONTRACTOR WILL HAVE WORKED AT HIS/HER OWN RISK AND EXPENSE.
- CONTRACTOR SHALL CALL LOCAL DIGGER HOT LINE FOR UTILITY LOCATIONS 48 HOURS PRIOR TO START OF CONSTRUCTION.
- ALL NEW AND EXISTING UTILITY STRUCTURES ON SITE AND IN AREAS TO BE DISTURBED BY CONSTRUCTION SHALL BE ADJUSTED TO FINISH ELEVATIONS PRIOR TO FINAL INSPECTION OF WORK.
- GRADING OF THE SITE WORK AREA IS TO BE SMOOTH AND CONTINUOUS IN SLOPE AND IS TO FEATHER INTO EXISTING GRADES AT THE GRADING LIMITS.
- ALL TEMPORARY EXCAVATIONS FOR THE INSTALLATION OF FOUNDATIONS, UTILITIES, ETC., SHALL BE PROPERLY LAID BACK OR BRACED IN ACCORDANCE WITH CORRECT OCCUPATIONAL SAFETY AND HEALTH ADMINISTRATION (OSHA) REQUIREMENTS.
- STRUCTURAL FILLS SUPPORTING PAVEMENTS SHALL BE COMPACTED TO 95% OF MAXIMUM STANDARD PROCTOR DRY DENSITY.
- NEW GRADES NOT IN BUILDING AND DRIVEWAY IMPROVEMENT AREA TO BE ACHIEVED BY FILLING WITH APPROVED CLEAN FILL AND COMPACTED TO 95% OF STANDARD PROCTOR DENSITY.
- ALL FILL SHALL BE PLACED IN UNIFORM LIFTS. THE LIFTS THICKNESS SHOULD NOT EXCEED THAT WHICH CAN BE PROPERLY COMPACTED THROUGHOUT ITS ENTIRE DEPTH WITH THE EQUIPMENT AVAILABLE.
- ANY FILLS PLACED ON EXISTING SLOPES THAT ARE STEEPER THAN 10 HORIZONTAL TO 1 VERTICAL SHALL BE PROPERLY BENCHED INTO THE EXISTING SLOPE AS DIRECTED BY A GEOTECHNICAL ENGINEER.
- CONTRACTOR SHALL CLEAN ENTIRE SITE DAILY AFTER CONSTRUCTION SUCH THAT NO PAPERS, THRASH, WEEDS, DURING CLEANING OPERATIONS SHALL BE DISPOSED OF OFF-SITE BY THE GENERAL CONTRACTOR.
- ALL TREES AND SHRUBS WHICH ARE NOT IN DIRECT CONFLICT WITH THE IMPROVEMENTS SHALL BE PROTECTED BY THE GENERAL CONTRACTOR.
- ALL SITE WORK SHALL BE CAREFULLY COORDINATED BY GENERAL CONTRACTOR WITH LOCAL UTILITY COMPANY, TELEPHONE COMPANY, AND ANY OTHER UTILITY COMPANIES HAVING JURISDICTION OVER THIS LOCATION.

Sprint

SAMSUNG

GENERAL DYNAMICS  
WIRELESS SERVICES

POWDER RIVER  
Development Services, LLC  
100 E. SHENANGO STREET  
SHARPSVILLE, PA 16150  
724.962.5999  
www.powderriverdev.com

PROJECT INFORMATION:

NETWORK VISION MMBS LAUNCH

BURLINGAME 2

PO03XC067

9700 CAPITAL HWY  
PORTLAND, OR 97219  
MULTNOMAH, COUNTY

ISSUE DATE 06-27-2013

ISSUED FOR: CONSTRUCTION DWGS

REVISIONS			
REV.	DATE	DESCRIPTION	INITIALS
A	08/22/12	ISSUED FOR CDs 90%	DM
B	08/30/12	ISSUED FOR CDs 100%	CCM
C	09/10/12	ISSUED FOR CDs FINALS	JED
D	05/24/13	ISSUED FOR REVISED CDs FINALS	CCM
E	06/27/13	ISSUED FOR REVISED CDs FINALS	JED

NOT FOR CONSTRUCTION UNLESS  
LABELED AS CONSTRUCTION SET

LICENSURE



SHEET TITLE:

GENERAL NOTES

SHEET NUMBER:

N-1

REVISION:

E

PRDS PROJ.NO.  
1678-021112

**FOUNDATION, EXCAVATION AND BACKFILL NOTES**

- ALL FINAL GRADED SLOPES SHALL BE A MAXIMUM OF 3 HORIZONTAL TO 1 VERTICAL.
- ALL EXCAVATIONS PREPARED FOR PLACEMENT OF CONCRETE SHALL BE OF UNDISTURBED SOILS, SUBSTANTIALLY HORIZONTAL AND FREE FROM ANY LOOSE, UNSUITABLE MATERIAL OR FROZEN SOILS, AND WITHOUT THE PRESENCE OF POUNDING WATER. DEWATERING FOR EXCESS GROUND WATER SHALL BE PROVIDED WHEN REQUIRED. COMPACTION OF SOILS UNDER CONCRETE PAD FOUNDATIONS SHALL NOT BE LESS THAN 95% OF THE MODIFIED PROCTOR MAXIMUM DRY DENSITY FOR THE SOIL IN ACCORDANCE WITH ASTM D1557.
- CONCRETE FOUNDATIONS SHALL NOT BE PLACED ON ORGANIC OR UNSUITABLE MATERIAL. IF INADEQUATE BEARING CAPACITY IS REACHED AT THE DESIGNED EXCAVATION DEPTH, THE UNSATISFACTORY SOIL SHALL BE EXCAVATED TO ITS FULL DEPTH AND EITHER BE REPLACED WITH MECHANICALLY COMPACTED GRANULAR MATERIAL OR THE EXCAVATION SHALL BE FILLED WITH CONCRETE OF THE SAME TYPE SPECIFIED FOR THE FOUNDATION. CRUSHED STONE MAY BE USED TO STABILIZE THE BOTTOM OF THE EXCAVATION. ANY STONE SUB BASE MATERIAL, IF USED, SHALL NOT SUBSTITUTE FOR REQUIRED THICKNESS OF CONCRETE.
- ALL EXCAVATIONS SHALL BE CLEAN OF UNSUITABLE MATERIAL SUCH AS VEGETATION, TRASH, DEBRIS, AND SO FORTH PRIOR TO BACK FILLING. BACK FILL SHALL CONSIST OF APPROVED MATERIALS SUCH AS EARTH, LOAM SANDY CLAY, SAND AND GRAVEL, OR SOFT SHALE, FREE FROM CLODS OR LARGE STONES OVER 2 1/2" MAX DIMENSIONS. ALL BACK FILL SHALL BE PLACED IN COMPACTED LAYERS.
- ALL FILL MATERIALS AND FOUNDATION BACK FILL SHALL BE PLACED MAXIMUM 6" THICK LIFTS BEFORE COMPACTION. EACH LIFT SHALL BE WETTED IF REQUIRED AND COMPACTED TO NOT LESS THAN 95% OF THE MODIFIED PROCTOR MAXIMUM DRY DENSITY FOR SOIL IN ACCORDANCE WITH ASTM D1557.
- NEWLY PLACED CONCRETE FOUNDATIONS SHALL CURE A MINIMUM OF 72 HRS PRIOR TO BACK FILLING.
- FINISHED GRADING SHALL BE SLOPED TO PROVIDE POSITIVE DRAINAGE AND PREVENT STANDING WATER. THE FINAL (FINISH) ELEVATION OF SLAB FOUNDATIONS SHALL SLOPE AWAY IN ALL DIRECTIONS FROM THE CENTER. FINISH GRADE OF CONCRETE PADS SHALL BE A MAXIMUM OF 4 INCHES ABOVE FINAL FINISH GRADE ELEVATIONS. PROVIDE SURFACE FILL GRAVEL TO ESTABLISH SPECIFIED ELEVATIONS WHERE REQUIRED.
- NEWLY GRADED SURFACE AREAS TO RECEIVE GRAVEL SHALL BE COVERED WITH GEOTEXTILE FABRIC TYPE: TYPAR-3401 AS MANUFACTURED BY "CONSTRUCTION MATERIAL 1-800-239-3841" OR AN APPROVED EQUIVALENT. SHOWN ON PLANS. THE GEOTEXTILE FABRIC SHALL BE BLACK IN COLOR TO CONTROL THE RECURRENT OF VEGETATIVE GROWTH AND EXTEND TO WITHIN 1 FOOT OUTSIDE THE SITE FENCING OR ELECTRICAL GROUNDING SYSTEM PERIMETER WHICH EVER IS GREATER. ALL FABRIC SHALL BE COVERED WITH A MINIMUM OF 4" DEEP COMPACTED STONE OR GRAVEL AS SPECIFIED. I.E. FDOT TYPE No. 57 FOR FENCED COMPOUND; FDOT TYPE No. 67 FOR ACCESS DRIVE AREA.
- IN ALL AREAS TO RECEIVE FILL, REMOVE ALL VEGETATION, TOPSOIL, DEBRIS, WET AND UNSATISFACTORY SOIL MATERIALS, OBSTRUCTIONS, AND DELETERIOUS MATERIALS FROM GROUND SURFACE. PLOW STRIP OR BREAK UP SLOPED SURFACES STEEPER THAN 1 VERTICAL TO 4 HORIZONTAL SUCH THAT FILL MATERIAL WILL BIND WITH EXISTING/PREPARED SOIL SURFACE.
- WHEN SUB GRADE OR PREPARED GROUND SURFACE HAS A DENSITY LESS THAN THAT REQUIRED FOR THE FILL MATERIAL, SCARIFY THE GROUND SURFACE TO DEPTH REQUIRED, PULVERIZE, MOISTURE-CONDITION AND/OR AERATE THE SOILS AND RE-COMPACT TO THE REQUIRED DENSITY PRIOR TO PLACEMENT OF FILLS.
- IN AREAS WHICH EXISTING GRAVEL SURFACING IS REMOVED OR DISTURBED DURING CONSTRUCTION OPERATIONS, REPLACE GRAVEL SURFACING TO MATCH ADJACENT GRAVEL SURFACING AND RESTORED TO THE SAME THICKNESS AND COMPACTION AS SPECIFIED. ALL RESTORED GRAVEL SURFACING SHALL BE FREE FROM CORRUGATIONS AND WAVES.
- EXISTING GRAVEL SURFACING MAY BE EXCAVATED SEPARATELY AND REUSED WITH THE CONDITION THAT ANY UNFAVORABLE AMOUNTS OF ORGANIC MATTER, OR OTHER DELETERIOUS MATERIALS ARE REMOVED PRIOR TO REUSE. FURNISH ANY ADDITIONAL GRAVEL RESURFACING MATERIAL AS NEEDED TO PROVIDE A FULL DEPTH COMPACTED SURFACE THROUGHOUT SITE.
- GRAVEL SUB SURFACE SHALL BE PREPARED TO REQUIRED COMPACTION AND SUB GRADE ELEVATIONS BEFORE GRAVEL SURFACING IS PLACED AND/OR RESTORED. ANY LOOSE OR DISTURBED MATERIALS SHALL BE THOROUGHLY COMPACTED AND ANY DEPRESSIONS IN THE SUB GRADE SHALL BE FILLED AND COMPACTED WITH APPROVED SELECTED MATERIAL. GRAVEL SURFACING MATERIAL SHALL NOT BE USED FOR FILLING DEPRESSIONS IN THE SUB GRADE.
- PROTECT EXISTING GRAVEL SURFACING AND SUB GRADE IN AREAS WHERE EQUIPMENT LOADS WILL OPERATE.
- DAMAGE TO EXISTING STRUCTURES AND/OR UTILITIES RESULTING FROM CONTRACTORS NEGLIGENCE SHALL BE REPAIRED AND/OR REPLACED TO THE OWNERS SATISFACTION AT NO ADDITIONAL COST TO THE CONTRACT.
- ALL SUITABLE BORROW MATERIAL FOR BACK FILL OF THE SITE SHALL BE INCLUDED IN THE BID. EXCESS TOPSOIL AND UNSUITABLE MATERIAL SHALL BE DISPOSED OF OFF SITE AT LOCATIONS APPROVED BY GOVERNING AGENCIES AT NO ADDITIONAL COST TO THE CONTRACT.

**ENVIRONMENTAL NOTES**

- ALL WORK PERFORMED SHALL BE DONE IN ACCORDANCE WITH ISSUED PERMITS. THE CONTRACTOR SHALL BE RESPONSIBLE FOR PAYMENT OF FINES AND PROPER CLEAN UP FOR AREAS IN VIOLATION.
- CONTRACTOR AND/OR DEVELOPER SHALL BE RESPONSIBLE FOR CONSTRUCTION AND MAINTENANCE OF EROSION AND SEDIMENTATION CONTROLS DURING CONSTRUCTION FOR PROTECTION OF ADJACENT PROPERTIES, ROADWAYS AND WATERWAYS AND SHALL BE MAINTAINED IN PLACE THROUGH FINAL JURISDICTIONAL INSPECTION & RELEASE OF SITE.
- CONTRACTOR SHALL INSTALL/CONSTRUCT ALL NECESSARY SEDIMENT/SILT CONTROL FENCING AND PROTECTIVE MEASURES WITHIN THE LIMITS OF SITE DISTURBANCE PRIOR TO CONSTRUCTION.
- NO SEDIMENT SHALL BE ALLOWED TO EXIT THE PROPERTY. THE CONTRACTOR IS RESPONSIBLE FOR TAKING ADEQUATE MEASURES FOR CONTROLLING EROSION. ADDITIONAL SEDIMENT CONTROL FENCING MAY BE REQUIRED IN ANY AREAS SUBJECT TO EROSION.
- THE CONTRACTOR IS RESPONSIBLE FOR MAINTAINING POSITIVE DRAINAGE ON THE SITE AT ALL TIMES WITH SILT AND EROSION CONTROL MEASURES MAINTAINED ON THE DOWNSTREAM SIDE OF SITE DRAINAGE. ANY DAMAGE TO ADJACENT PROPERTY AS A RESULT OF EROSION WILL BE CORRECTED AT THE CONTRACTORS EXPENSE.
- CONTRACTOR SHALL BE RESPONSIBLE FOR DAILY INSPECTIONS AND ANY REPAIRS OF ALL SEDIMENT CONTROL MEASURES INCLUDING SEDIMENT REMOVAL AS NECESSARY.
- CLEARING OF VEGETATION AND TREE REMOVAL SHALL BE ONLY AS PERMITTED AND BE HELD TO A MINIMUM. ONLY TREES NECESSARY FOR CONSTRUCTION OF THE FACILITIES SHALL BE REMOVED.
- SEEDING SAND MULCHING AND/OR SODDING OF THE SITE WILL BE ACCOMPLISHED AS SOON AS POSSIBLE AFTER COMPLETION OF THE PROJECT FACILITIES AFFECTING LAND DISTURBANCE.
- CONTRACTOR SHALL PROVIDE ALL EROSION AND SEDIMENTATION CONTROL MEASURES AS REQUIRED BY LOCAL COUNTY AND STATE CODES AND ORDINANCES TO PROTECT EMBANKMENTS FROM SOIL LOSS AND TO PREVENT ACCUMULATION OF SOIL AND SILT IN STREAMS AND DRAINAGE PATHS LEAVING THE CONSTRUCTION AREA. THIS MAY INCLUDE SUCH MEASURES AS SILT FENCES, STRAW BALE SEDIMENT BARRIERS, AND CHECK DAMS.
- RIP RAP OF SIZES INDICATED SHALL CONSIST OF CLEAN, HARD, SOUND, DURABLE, UNIFORM IN QUALITY STONE FREE OF ANY DETRIMENTAL QUANTITY OF SOFT, FRIABLE, THIN, ELONGATED OR LAMINATED PIECES, DISINTEGRATED MATERIAL, ORGANIC MATTER, OIL, ALKALI, OR OTHER DELETERIOUS SUBSTANCES.

**STRUCTURAL STEEL NOTES**

- ALL STEEL WORK SHALL BE IN ACCORDANCE WITH THE LATEST EDITION OF THE AISC MANUAL OF STEEL CONSTRUCTION. STEEL SECTIONS SHALL BE IN ACCORDANCE WITH ASTM AS INDICATED BELOW:  
W-SHAPES: ASTM A992, 50 KSI  
ANGLES, BARS CHANNELS: ASTM A36, 36 KSI  
HSS SECTIONS: ASTM 500, 46 KSI  
PIPE SECTIONS: ASTM A53-E, 35 KSI
- ALL EXTERIOR EXPOSED STEEL AND HARDWARE SHALL BE HOT DIPPED GALVANIZED.
- ALL WELDING SHALL BE PERFORMED USING E70XX ELECTRODES AND WELDING SHALL CONFORM TO AISC. WHERE FILLET WELD SIZES ARE NOT SHOWN, PROVIDE THE MINIMUM SIZE PER TABLE J2.4 IN THE AISC "MANUAL OF STEEL CONSTRUCTION". PAINTED SURFACES SHALL BE TOUCHED UP.
- NON-STURCTURAL CONNECTIONS FOR STEEL GRATING MAY USE 5/8" ASTM A 307 BOLTS UNLESS NOTED OTHERWISE.
- FIELD MODIFICATIONS ARE TO BE COATED WITH ZINC ENRICHED PAINT.

**CONCRETE MASONRY NOTES**

- CONCRETE MASONRY UNITS SHALL BE MEDIUM WEIGHT UNITS CONFORMING TO ASTM C90, GRADE N-1, (F<sub>m</sub>=1,500 PS). MEDIUM WEIGHT (115 PCF).
- MORTAR SHALL BE TYPE "S" (MINIMUM 1,800 PSI AT 28 DAYS).
- GROUT SHALL HAVE A MINIMUM COMPRESSIVE STRENGTH OF 3,000 PSI AT 28 DAYS.
- ALL CELLS CONTAINING REINFORCING STEEL OR EMBEDDED ITEMS AND ALL CELLS IN RETAINING WALLS AND WALLS BELOW GRADE SHALL BE SOLID GROUTED.
- ALL HORIZONTAL REINFORCEMENT SHALL BE PLACED IN BOND BEAM OR LINTEL BEAM UNITS.
- WHEN GROUTING IS STOPPED FOR ONE HOUR OR LONGER, HORIZONTAL CONSTRUCTION JOINTS SHALL BE FORMED BY STOPPING THE GROUT POUR 1-1/2" BELOW TOP OF THE UPPERMOST UNIT.
- ALL BOND BEAM BLOCK SHALL BE "DEEP CUT" UNITS.
- PROVIDE INSPECTION AND CLEAN-OUT HOLES AT BASE OF VERTICAL CELLS HAVING GROUT LIFTS IN EXCESS OF 4'-0" OF HEIGHT.
- ALL GROUT SHALL BE CONSOLIDATED WITH A MECHANICAL VIBRATOR.
- CEMENT SHALL BE AS SPECIFIED FOR CONCRETE.
- REINFORCING BARS - SEE NOTES UNDER "STRUCTURAL CONCRETE NOTES" FOR REQUIREMENTS.
- PROVIDE ONE BAR DIAMETER (A MINIMUM OF 1/2") GROUT BETWEEN MAIN REINFORCING AND MASONRY UNITS.
- LOW LIFT CONSTRUCTION, MAXIMUM GROUT POUR HEIGHT IS 4 FEET.
- HIGH LIFT GROUTED CONSTRUCTION MAY BE USED IN CONFORMANCE WITH PROJECT SPECIFICATIONS AND SECTION 2104.6.1 OF U.B.C.
- ALL CELLS IN CONCRETE BLOCKS SHALL BE FILLED SOLID WITH GROUT, EXCEPT AS NOTED IN THE DRAWINGS OR SPECIFICATIONS.
- CELLS SHALL BE IN VERTICAL ALIGNMENT. DOWELS IN FOOTINGS SHALL BE SET TO ALIGN WITH CORES CONTAINING REINFORCING STEEL.
- REFER TO ARCHITECTURAL DRAWINGS FOR SURFACE AND HEIGHT OF UNITS, LAYING PATTERN AND JOINT TYPE.
- SAND SHALL BE CLEAN, SHARP AND WELL GRADED, FREE FROM INJURIOUS AMOUNTS OF DUST, LUMPS, SHALE, ALKALI OR ORGANIC MATERIAL.
- BRICK SHALL CONFORM TO ASTM C-62 AND SHALL BE GRADE MW OR BETTER.

**STRUCTURAL CONCRETE NOTES**

- ALL CONCRETE WORK SHALL BE IN ACCORDANCE WITH THE ACI 301-05, ACI 318-05 AND THE SPECIFICATION FOR CAST-IN-PLACE CONCRETE.
- ALL CONCRETE SHALL HAVE A MINIMUM COMPRESSIVE STRENGTH f<sub>c</sub>'=3,000 PSI AT 28 DAYS UNLESS NOTED OTHERWISE.
- REINFORCING STEEL SHALL CONFORM TO ASTM A 615, GRADE 60, DEFORMED UNLESS NOTED OTHERWISE. WELDED WIRE FABRIC SHALL CONFORM TO ASTM A 185 WELDED STEEL WIRE FABRIC UNLESS NOTED OTHERWISE. SPLICES CLASS "B" AND ALL HOOKS SHALL BE STANDARD UNLESS NOTED OTHERWISE.
- THE FOLLOWING MINIMUM CONCRETE COVER SHALL BE PROVIDED FOR REINFORCING STEEL UNLESS SHOWN OTHERWISE ON DRAWINGS:  
CONCRETE CAST AGAINST EARTH.....3 IN.  
CONCRETE EXPOSED TO EARTH OR WEATHER:  
#6 AND LARGER.....2 IN.  
#5 AND SMALLER & WWF.....1 1/2 IN.  
CONCRETE NOT EXPOSED TO EARTH OR WEATHER OR NOT CAST AGAINST THE GROUND:  
SLAB AND WALL.....3/4 IN.  
BEAMS AND COLUMNS.....1 1/2 IN.
- A 3/4" CHAMFER SHALL BE PROVIDED AT ALL EXPOSED EDGES OF CONCRETE U.N.O. IN ACCORDANCE WITH ACI 301 SECTION 4.2.4
- HOLES TO RECEIVE EXPANSION/WEDGE ANCHORS SHALL BE 1/8" LARGER IN DIAMETER THAN THE ANCHOR BOLT, DOWEL OR ROD AND SHALL CONFORM TO MANUFACTURER'S RECOMMENDATION FOR EMBEDMENT DEPTH OR AS SHOWN ON THE DRAWINGS. LOCATE AND AVOID CUTTING EXISTING REBAR WHEN DRILLING HOLES IN ELEVATED CONCRETE SLABS.
- USE AND INSTALLATION OF CONCRETE EXPANSION/WEDGE ANCHOR, SHALL BE PER ICBO & MANUFACTURER'S WRITTEN RECOMMENDED PROCEDURES.

**WEATHERPROOFING NOTES**

- STANDARD CONSTRUCTION SPECIFICATIONS FOR WIRELESS SITES
- WEATHERPROOFING CONNECTORS AND GROUND KITS:
    - ALL CONNECTORS AND GROUND KITS SHALL BE WEATHERPROOFED USING BUTYL RUBBER WEATHERPROOFING AND TAPE. THIS INSTALLATION MUST BE DONE IN ACCORDANCE WITH THE MANUFACTURER'S RECOMMENDATION OR AS SHOWN ON THE CONSTRUCTION DRAWINGS (WHICHEVER IS GREATER). IF NO DIRECTION IS PROVIDED, WEATHERPROOFING MUST BE DONE PER THE FOLLOWING INSTRUCTIONS.
      - THE COAXIAL CABLE CONNECTION OR GROUND KIT CAN BE ENCOMPASSED INTO COLD SHRINK AND COMPLETELY WRAPPED WITH 2 INCH WIDE ELECTRICAL TAPE OVERLAPPING EACH ROW BY APPROXIMATELY 1/2" AND EXTENDING PAST THE CONNECTION BY TWO INCHES AS DISCUSSED BELOW;
      - THE COAXIAL CABLE CONNECTION OR GROUND KIT CAN BE WRAPPED WITH LAYERS OF ELECTRICAL/BUTYL RUBBER/ELECTRICAL TAPE AS DISCUSSED BELOW; OR
      - THE COAXIAL CABLE CONNECTION OR GROUND KIT CAN BE WRAPPED WITH TWO LAYERS OF 1.5 INCH WIDE SELF-AMALGAMATING TAPE COVERED WITH TWO LAYERS OF ELECTRICAL TAPE AS DISCUSSED BELOW.
    - COLD SHRINK INSTALLATION PROCEDURE:
      - REQUIRED MATERIAL: COLD SHRINK TUBE, SPACERS AS NEEDED, BLACK ELECTRICAL TAPE-2 INCHES WIDE
      - REQUIRED TOOLS: KNIFE AND TAPE MEASURE
  - REQUIRED TOOLS: KNIFE AND TAPE MEASURE
  - STEP 1: THOROUGHLY CLEAN AND DRY THE SURFACE OF COAXIAL CABLE AND CONNECTOR TO REMOVE ALL GREASE AND DIRT. MARK THE MAIN FEED (LARGER DIAMETER) COAXIAL CABLE AT LEAST TWO INCHES ABOVE THE CONNECTION AS THE SPECIFIED START DIMENSION FOR THE COLD SHRINK.
  - STEP 2: SLIDE THE COLD SHRINK TUBE OVER THE PRE-CONNECTORIZED END OF THE LARGER DIAMETER COAXIAL CABLE PRIOR TO MATING CONNECTOR INTERFACES. MAKE THE CONNECTION.
  - STEP 3: WITH YOUR FREE HAND, BEGIN REMOVING COLD SHRINK TUBE CORE. THE CORE WILL BE REMOVED BY UNWINDING IN A COUNTERCLOCKWISE DIRECTION WHILE LIGHTLY PULLING THE ATTACHED CORD AWAY FROM THE TUBE.
  - STEP 4: USE BOTH HANDS TO CONTINUE THE UNWINDING PROCESS AS THE COLD SHRINK TUBE BEGINS TO COLLAPSE INTO POSITION. CONTINUE THE UNWINDING PROCESS UNTIL THE CORE IS COMPLETELY REMOVED AND THE COLD SHRINK TUBE IS INSTALLED.
  - STEP 5: EXCESS COLD SHRINK TUBE TWO INCHES BEYOND THE SPACER HALVES CAN BE REMOVED OR LEFT IN PLACE. EXCESS COLD SHRINK TUBE CAN BE CAREFULLY CUT OFF WITH A KNIFE.
  - STEP 6: WRAP OVER THE COLD SHRINK TUBE WITH ONE LAYER OF BLACK ELECTRICAL TAPE 2 INCH WIDE OVERLAPPING EACH ROW BY 1/2 INCH. THIS TOP LAYER MUST BE WRAPPED USING A SHINGLED EFFECT. THE LAYER SHALL BE WRAPPED SO THAT THE ENDS ARE IN THE UPWARD DIRECTION CREATING A SHINGLED EFFECT WITH THE TAPE SO WATER WILL BE REPELLED AND NOT ALLOWED TO COLLECT AND POOL. THIS TOP LAYER OF ELECTRICAL TAPE MUST EXTEND TWO INCHES (THE TAPE WIDTH) PAST THE COLD SHRINK TUBE ONTO THE UNDERLYING CABLE. TAPE SHALL BE WRAPPED SO THAT NO VOIDS OR AIR PACKETS ARE PRESENT. TAPE SHALL BE CUT WITH A SHARP KNIFE.
  - STEP 7: BUTYL RUBBER TAPE INSTALLATION PROCEDURE:
    - REQUIRED MATERIAL: BLACK ELECTRICAL TAPE-2 INCH WIDE AND BUTYL RUBBER TAPE 2 TO 3 INCHES WIDE
    - REQUIRED TOOLS: KNIFE OR SCISSORS
  - STEP 1: THOROUGHLY CLEAN AND DRY THE SURFACE OF COAXIAL CABLE AND CONNECTOR TO REMOVE ALL GREASE AND DIRT. WRAP CONNECTOR/GROUND KIT WITH TWO LAYERS OF BLACK ELECTRICAL TAPE-2 INCH WIDE OVERLAPPING EACH ROW BY APPROXIMATELY 1/2 INCH. THESE LAYERS OF TAPE MUST BE WRAPPED TIGHT ENOUGH SO THAT NO VOIDS OR AIR PACKETS ARE PRESENT AND MUST EXTEND ONE INCH PAST THE CONNECTOR/GROUND KIT ON EACH SIDE. TWO ROWS SHALL BE APPLIED, ONE IN EACH DIRECTION, WITH THE TOP ROW SHINGLED TO PROMOTE WATER RUNOFF.
  - STEP 2: WRAP CONNECTOR/GROUND KIT WITH ONE LAYER OF BUTYL RUBBER TAPE (2 TO 3 INCHES WIDE) OVER THE BLACK ELECTRICAL TAPE OVERLAPPING EACH ROW BY APPROXIMATELY 1/2 INCH. THE BUTYL RUBBER TAPE MUST EXTEND 2 TO 3 INCHES (THE TAPE WIDTH) PAST THE ELECTRICAL TAPE AND COME IN GOOD CONTACT WITH THE UNDERLYING CABLE. ON CONNECTORS, WHEN WEATHERPROOFING FROM THE MAIN LINE TO THE JUMPER, BUILD UP THIS AREA WITH EXTRA BUTYL RUBBER TAPE TO INSURE A SMOOTH TRANSITION FREE OF VOIDS AND AIR PACKETS DOWN TO THE SMALLER DIAMETER CABLE.
  - STEP 3: WRAP CONNECTOR/GROUND KIT WITH TWO LAYERS OF BLACK ELECTRICAL TAPE 2 INCH WIDE OVERLAPPING EACH ROW BY 1 INCH. THESE LAST TWO LAYERS MUST BE WRAPPED USING A SHINGLED EFFECT. THE TOP LAYER SHALL BE WRAPPED SO THAT THE ENDS ARE IN THE UPWARD DIRECTION CREATING A SHINGLED EFFECT WITH THE TAPE SO WATER WILL BE REPELLED AND NOT ALLOWED TO COLLECT AND POOL. THESE TOP LAYERS OF ELECTRICAL TAPE MUST EXTEND TWO INCHES (THE TAPE WIDTH) PAST THE BUTYL RUBBER TAPE ONTO THE UNDERLYING CABLE.
  - STEP 4: ALL LAYERS OF TAPE SHALL BE WRAPPED SO THAT NO VOIDS OR AIR PACKETS ARE PRESENT. THE LAST WRAP OF TAPE SHALL NOT BE PULLED OR STRETCHED. ALL TAPE SHALL BE CUT WITH A SHARP KNIFE OR SCISSORS.
  - STEP 5: WRAP OVER AND PAST THE CONNECTOR/GROUND KIT AT LEAST 2 INCHES.
  - STEP 6: TO TERMINATE THE SELF-AMALGAMATING TAPE, WRAP THE TAPE AT LEAST ONE FULL ROUND OVER THE CABLE STRETCHING THE TAPE TIGHT. CUT THE TAPE USING KNIFE OR SCISSORS AND APPLY THE LOOSE END TO THE UNDERLYING SELF-AMALGAMATING TAPE USING THUMB PRESSURE.
  - STEP 7: TWO ROWS OF SELF-AMALGAMATING TAPE SHALL BE APPLIED IN THIS MANNER, IN ALTERNATING DIRECTIONS. THE TOP LAYER SHALL BE WRAPPED SO THAT THE ENDS ARE IN AN UPWARD DIRECTION CREATING A SHINGLED EFFECT WITH THE TAPE SO WATER WILL BE REPELLED.
  - STEP 8: WRAP OVER SELF-AMALGAMATING TAPE WITH TWO LAYERS OF BLACK ELECTRICAL TAPE- 2 INCH WIDE OVERLAPPING EACH ROW BY 1 INCH. THESE TOP TWO LAYERS MUST ALSO BE WRAPPED USING A SHINGLED EFFECT. THE LAYERS SHALL BE WRAPPED SO THAT THE ENDS ARE IN THE UPWARD DIRECTION CREATING A SHINGLED EFFECT WITH THE TAPE SO WATER WILL BE REPELLED AND NOT ALLOWED TO COLLECT AND POOL. THESE TOP LAYERS OF ELECTRICAL TAPE MUST EXTEND TWO INCHES (THE TAPE WIDTH) PAST THE SELF-AMALGAMATING TAPE ONTO THE UNDERLYING CABLE. ALL LAYERS OF TAPE SHALL BE WRAPPED SO THAT NO VOIDS OR AIR PACKETS ARE PRESENT. THE LAST WRAP OF TAPE SHALL NOT BE PULLED OR STRETCHED. ALL TAPE SHALL BE CUT WITH A SHARP KNIFE OR SCISSORS.



**GENERAL DYNAMICS WIRELESS SERVICES**



**POWDER RIVER**  
Development Services, LLC  
100 E. SHENANGO STREET  
SHARPSVILLE, PA 16150  
724.962.5999  
www.powderriverdev.com

PROJECT INFORMATION:  
NETWORK: VISION MMBS LAUNCH


**BURLINGAME 2**  
PO03XC067  
9700 CAPITAL HWY  
PORTLAND, OR 97219  
MULTNOMAH, COUNTY

ISSUE DATE: 06-27-2013

ISSUED FOR: CONSTRUCTION DWGS

REV.	DATE	DESCRIPTION	INITIALS
A	08/22/12	ISSUED FOR CDs 90%	DM
B	08/30/12	ISSUED FOR CDs 100%	CCM
C	09/10/12	ISSUED FOR CDs FINALS	JED
D	05/24/13	ISSUED FOR REVISED CDs FINALS	CCM
E	06/27/13	ISSUED FOR REVISED CDs FINALS	JED


NOT FOR CONSTRUCTION UNLESS LABELED AS CONSTRUCTION SET

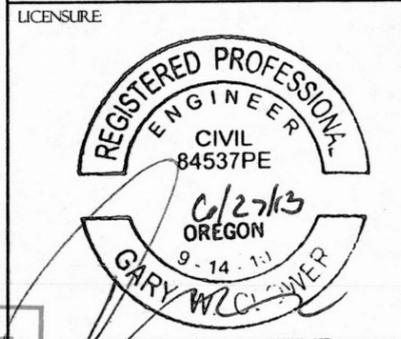

RECEIVED  
AUG 02 2013  
City of Portland  
Reviewed for Code Compliance  
SEP 30 2013  
Permit Number

SHEET TITLE: GENERAL NOTES  
SHEET NUMBER: N-2  
REVISION: E  
PRDS PROJ. NO. 1678-021112


**GENERAL NOTES**  
 THIS IS NOT A SITE SURVEY.  
 ALL PROPERTY BOUNDARIES, ORIENTATION OF TRUE NORTH AND STREET HALF-WIDTHS HAVE BEEN OBTAINED FROM A TAX PARCEL MAP AND ARE APPROXIMATE.

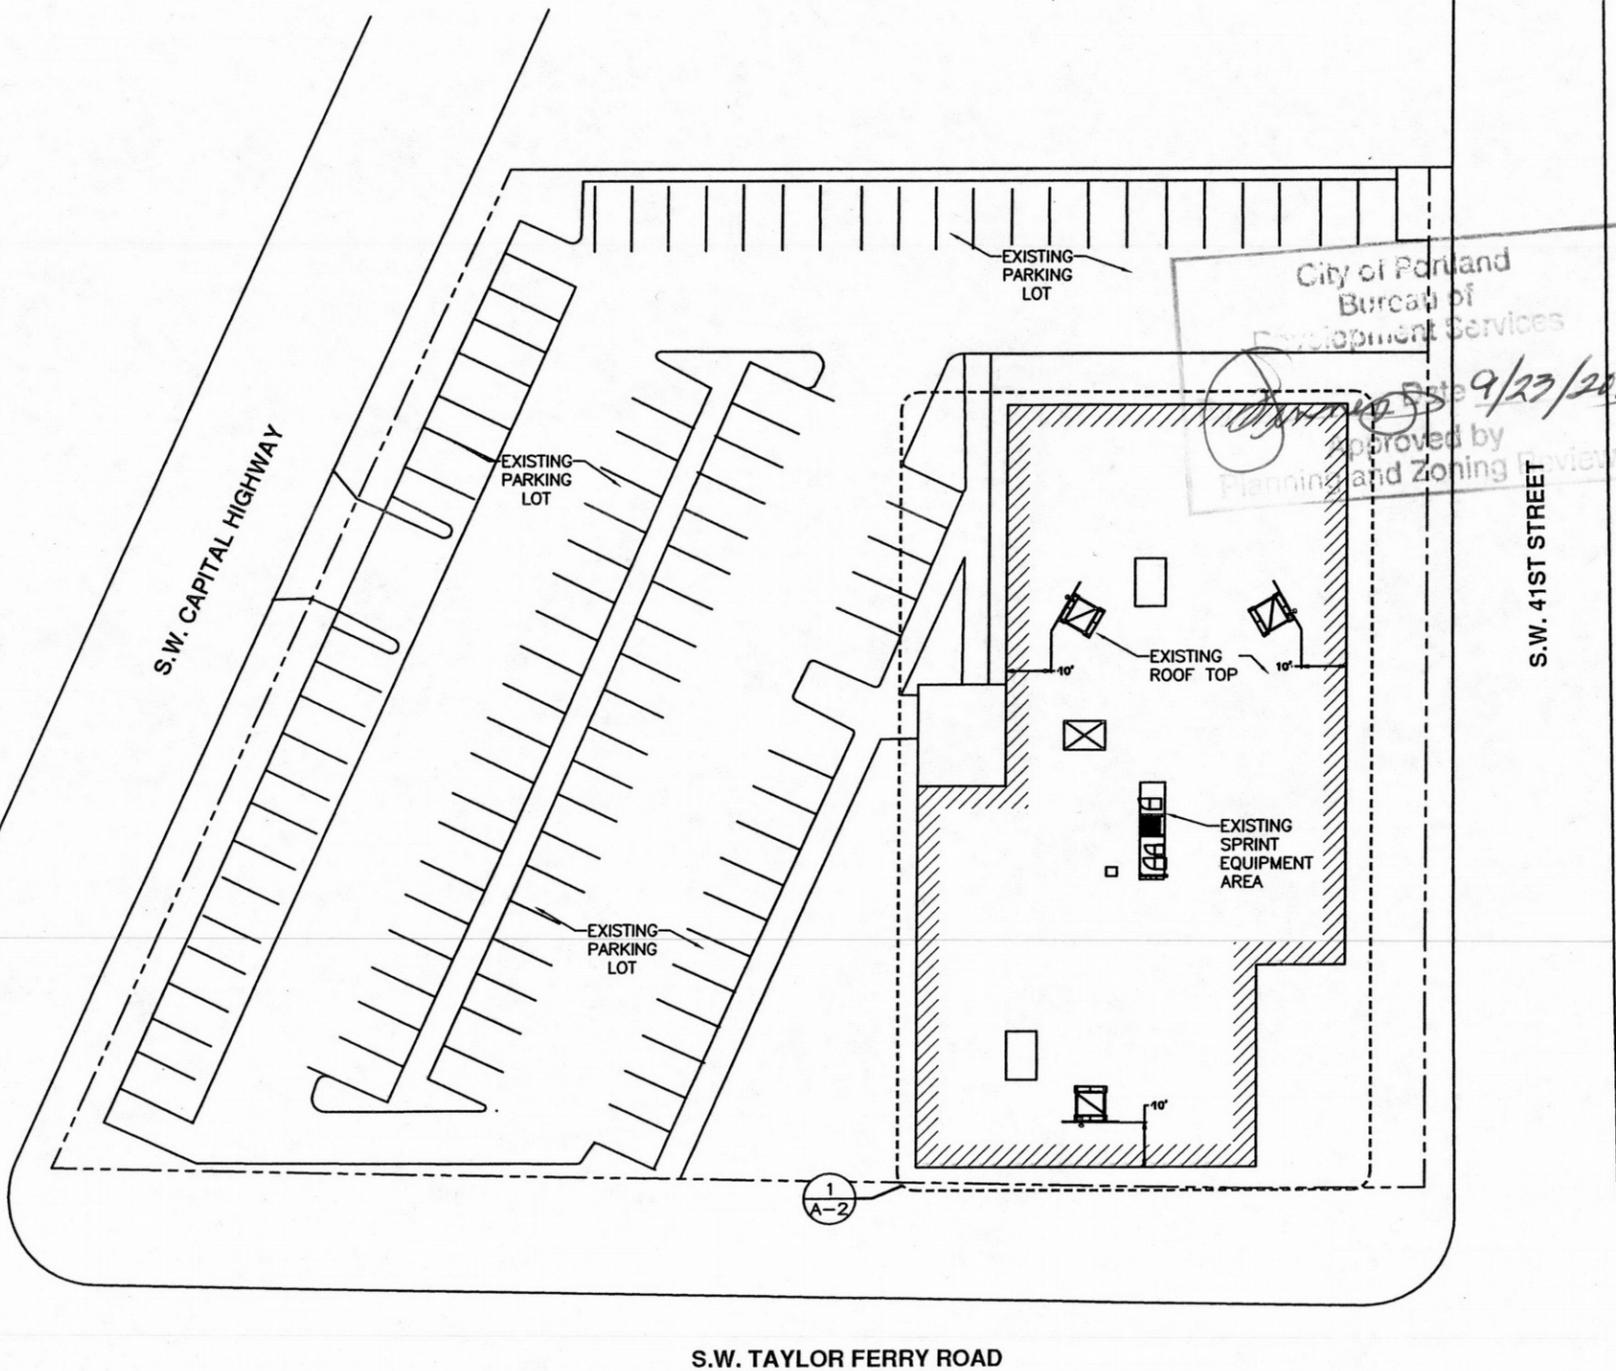

City of Portland  
 Bureau of  
 Development Services  
 Approved by  
 Planning and Zoning Review  
 9/23/2013

City of Portland  
 REVIEWED FOR CODE COMPLIANCE  
 SEP 30 2013  
 Permit Number

RECEIVED  
 AUG 02 2013  
 EDS  
 DOCUMENT SERVICES

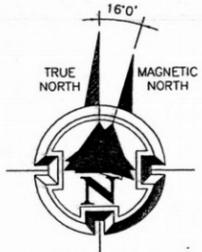

22"x34" SCALE: 1" = 20'-0"  
 11"x17" SCALE: 1" = 40'-0"  
 20' 10' 20'

THE INFORMATION CONTAINED IN THIS SET OF CONSTRUCTION DOCUMENTS IS PROPRIETARY BY NATURE. ANY USE OR DISCLOSURE OTHER THAN THAT WHICH RELATES TO CARRIER SERVICES IS STRICTLY PROHIBITED.

OVERALL SITE PLAN | 1



**GENERAL DYNAMICS WIRELESS SERVICES**

**POWDER RIVER**  
 Development Services, LLC  
 100 E. SHENANGO STREET  
 SHARPSVILLE, PA 16150  
 724.962.5999  
 www.powderriverdev.com

PROJECT INFORMATION:  
 NETWORK VISION MMBS LAUNCH  
**BURLINGAME 2**  
 PO03XC067  
 9700 CAPITAL HWY  
 PORTLAND, OR 97219  
 MULTNOMAH, COUNTY

ISSUE DATE: 06-27-2013

ISSUED FOR: CONSTRUCTION DWGS

REVISIONS				
REV.	DATE	DESCRIPTION	INITIALS	
A	08/22/12	ISSUED FOR CDs 90%	DM	
B	08/30/12	ISSUED FOR CDs 100%	CCM	
C	09/10/12	ISSUED FOR CDs FINALS	JED	
D	05/24/13	ISSUED FOR REVISED CDs FINALS	CCM	
E	06/27/13	ISSUED FOR REVISED CDs FINALS	JED	

NOT FOR CONSTRUCTION UNLESS LABELED AS CONSTRUCTION SET


LICENSURE:

SHEET TITLE:  
**OVERALL SITE PLAN**

SHEET NUMBER:  
**A-1**

REVISION:  
**E**

PROJ. PROJ. NO.  
 1678-021112

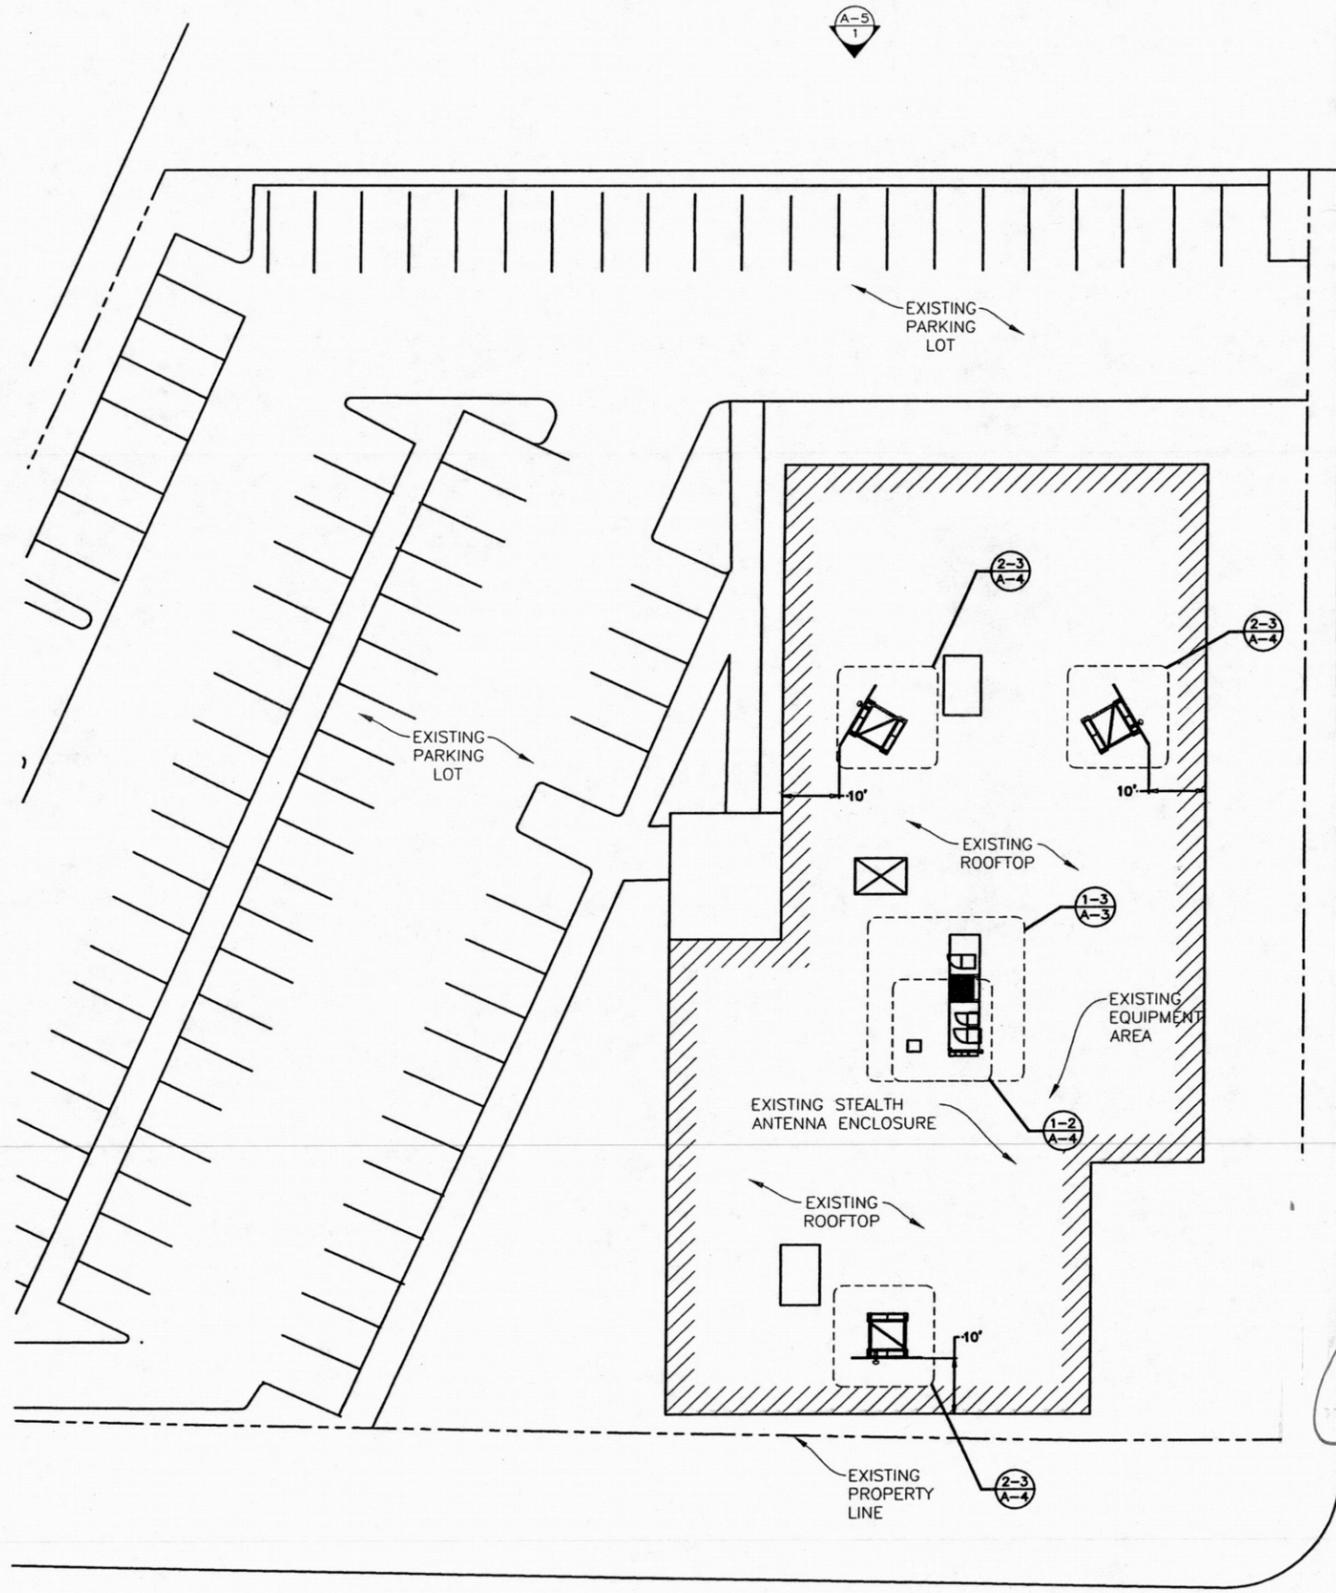


NOTE: STRUCTURAL ANALYSIS MUST BE PERFORMED ON ALL ROOFTOPS, FLAGPOLES AND TOWER SITES BEFORE INSTALLATION OF NEW ANTENNAS, NEW RRUS, & NEW CABINETS/TEMPORARY PLATFORMS.

NOTE: WALK PADS TO BE INSTALLED ON THE ROOF FOR TECH TO WALK ON DURING ROUTINE MAINTENANCE. LOCATION OF PADS TO BE DETERMINED DURING INSTALLATION.

City of Portland  
 REVIEWED FOR CODE COMPLIANCE  
 SEP 30 2013  
 Permit Number

City of Portland  
 Bureau of  
 Development Services  
 Approved by  
 Planning and Zoning Director  
 Date 9/23/2013

RECEIVED  
 AUG 02 2013  
 BDS  
 DOCUMENT SERVICES

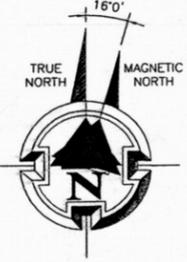

22"x34" SCALE: 1/16" = 1'-0"  
 11"x17" SCALE: 1/32" = 1'-0"  
 16' 12' 8' 4' 0' 16'

THE INFORMATION CONTAINED IN THIS SET OF CONSTRUCTION DOCUMENTS IS PROPRIETARY BY NATURE. ANY USE OR DISCLOSURE OTHER THAN THAT WHICH RELATES TO CARRIER SERVICES IS STRICTLY PROHIBITED.

ENLARGED SITE PLAN | 1



GENERAL DYNAMICS  
 WIRELESS SERVICES

POWDER RIVER  
 Development Services, LLC  
 100 E. SHENANGO STREET  
 SHARPSVILLE, PA 16150  
 724.962.5999  
 www.powderriverdev.com


PROJECT INFORMATION:  
 NETWORK VISION MMBS LAUNCH  
**BURLINGAME 2**  
 PO03XC067  
 9700 CAPITAL HWY  
 PORTLAND, OR 97219  
 MULTNOMAH, COUNTY

ISSUE DATE: 06-27-2013

ISSUED FOR: CONSTRUCTION DWGS

REVISIONS			
REV.	DATE	DESCRIPTION	INITIALS
A	08/22/12	ISSUED FOR CDs 90%	DM
B	08/30/12	ISSUED FOR CDs 100%	CCM
C	09/10/12	ISSUED FOR CDs FINALS	JED
D	05/24/13	ISSUED FOR REVISED CDs FINALS	CCM
E	06/27/13	ISSUED FOR REVISED CDs FINALS	JED


NOT FOR CONSTRUCTION UNLESS LABELED AS CONSTRUCTION SET

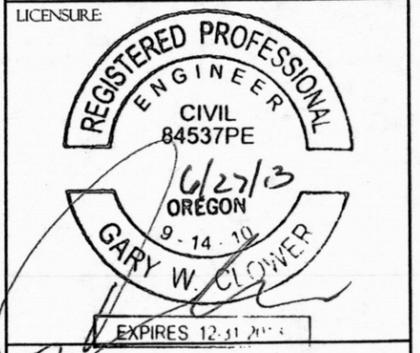


SHEET TITLE

ENLARGED SITE PLAN


SHEET NUMBER: **A-2** REVISION: **E**  
 PRDS PROJ. NO. 1678-021112

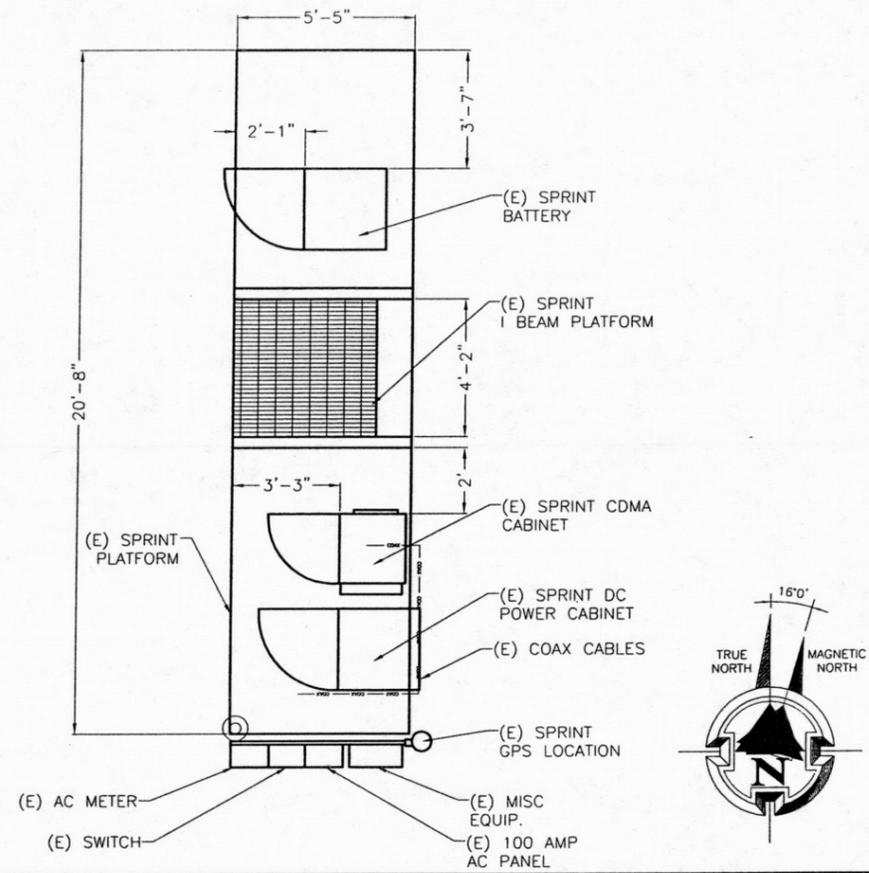

22"x34" SCALE: 1/2" = 1'-0"  
11"x17" SCALE: 1/4" = 1'-0"  
EXISTING EQUIPMENT PLAN 1

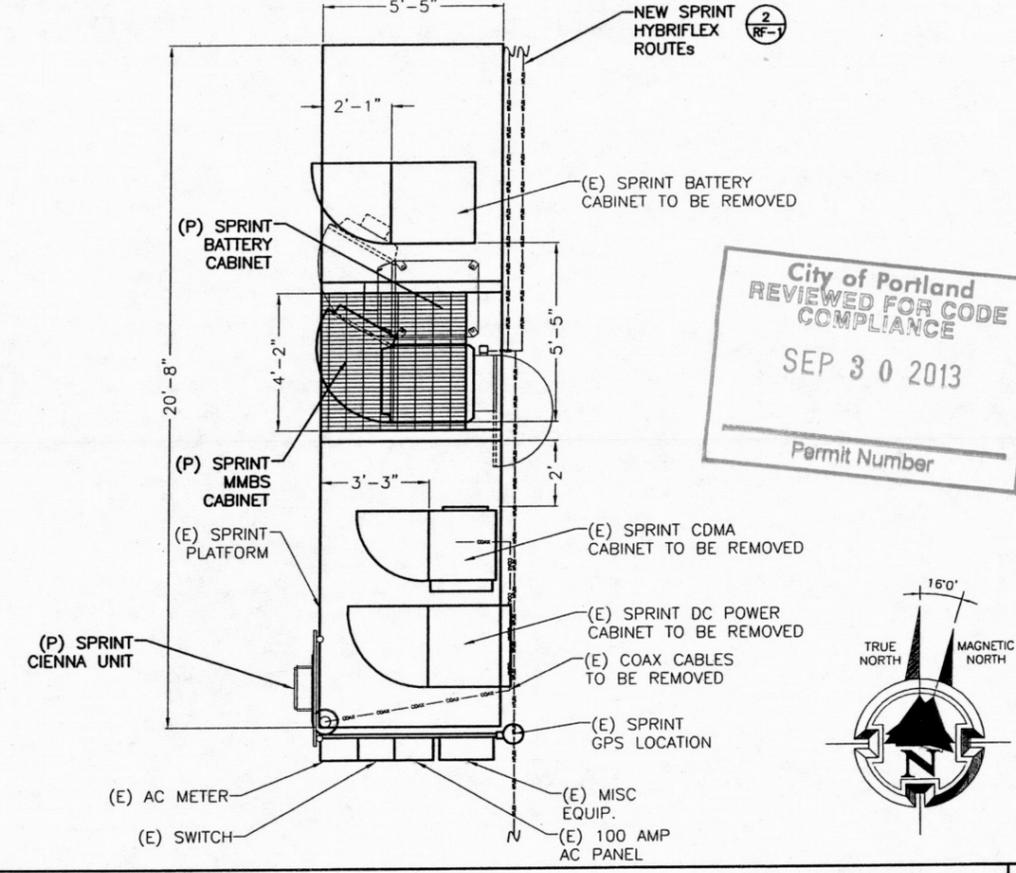

22"x34" SCALE: 3/8" = 1'-0"  
11"x17" SCALE: 3/16" = 1'-0"  
NEW TEMP. EQUIPMENT PLAN (INTERIM) 2

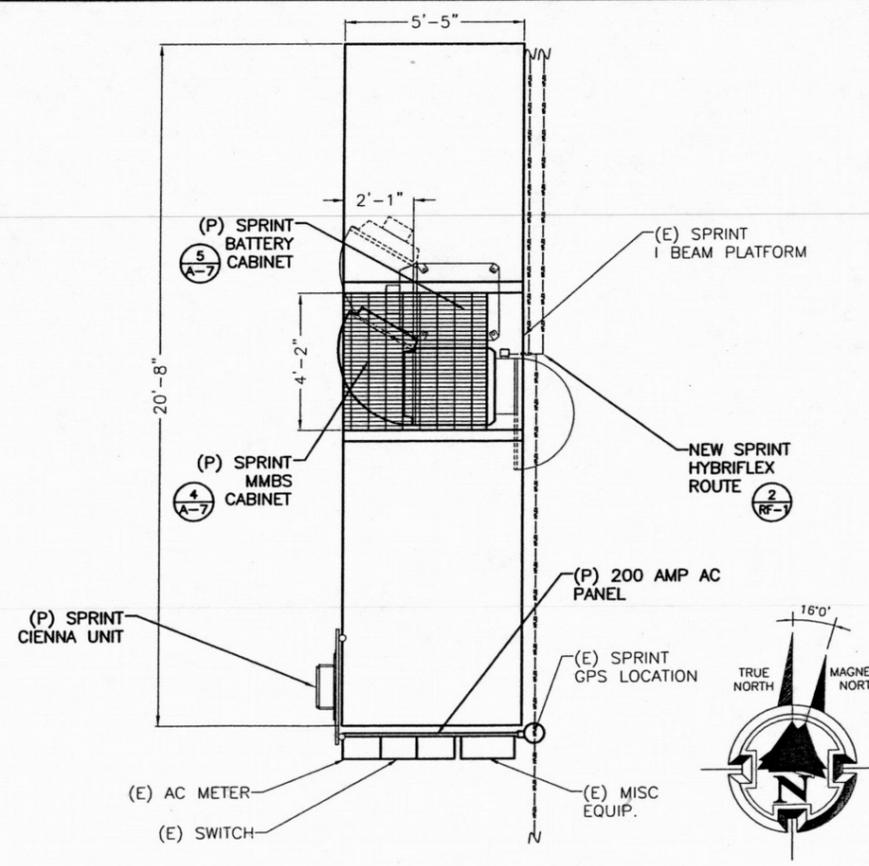

22"x34" SCALE: 3/8" = 1'-0"  
11"x17" SCALE: 3/16" = 1'-0"  
NEW EQUIPMENT PLAN (FINAL) 3

NOTE: STRUCTURAL ANALYSIS MUST BE PERFORMED ON ALL ROOFTOPS, FLAGPOLES AND TOWER SITES BEFORE INSTALLATION OF NEW ANTENNAS, NEW RRUS, & NEW CABINETS/TEMPORARY PLATFORMS.

EXISTING ITEMS TO BE REMOVED	
CDMA ANTENNA	(3 TOTAL, 1 PER SECTOR)
CDMA CABINET	1
BBU CABINET	1
MICROWAVE CABINET	0
COAX CABLE	(6 TOTAL, 2 PER SECTOR)

City of Portland  
Bureau of  
Development Services  
*[Signature]*  
Approved by  
Date: 9/23/2013  
AUG 02 2013  
BDS  
DOCUMENT SERVICES



GENERAL DYNAMICS  
WIRELESS SERVICES

**POWDER RIVER**  
Development Services, LLC  
100 E. SHENANGO STREET  
SHARPSVILLE, PA 16150  
724.962.5999  
www.powderriverdev.com


PROJECT INFORMATION:  
NETWORK VISION MMBS LAUNCH  
**BURLINGAME 2**  
PO03XC067  
9700 CAPITAL HWY  
PORTLAND, OR 97219  
MULTNOMAH, COUNTY

ISSUE DATE: 06-27-2013

ISSUED FOR: CONSTRUCTION DWGS

REVISIONS			
REV.	DATE	DESCRIPTION	INITIALS
A	08/22/12	ISSUED FOR CDs 90%	DM
B	08/30/12	ISSUED FOR CDs 100%	CCM
C	09/10/12	ISSUED FOR CDs FINALS	JED
D	05/24/13	ISSUED FOR REVISED CDs FINALS	CCM
E	06/27/13	ISSUED FOR REVISED CDs FINALS	JED

NOT FOR CONSTRUCTION UNLESS  
LABELED AS CONSTRUCTION SET


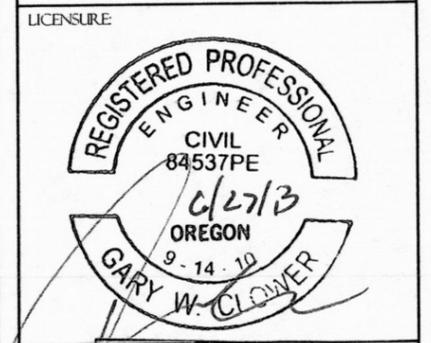


SHEET NO. EXPIRES 12-31-2013


ENLARGED  
EQUIPMENT PLANS

SHEET NUMBER: <b>A-3</b>	REVISION: <b>E</b>
-----------------------------	-----------------------

NOT USED 4

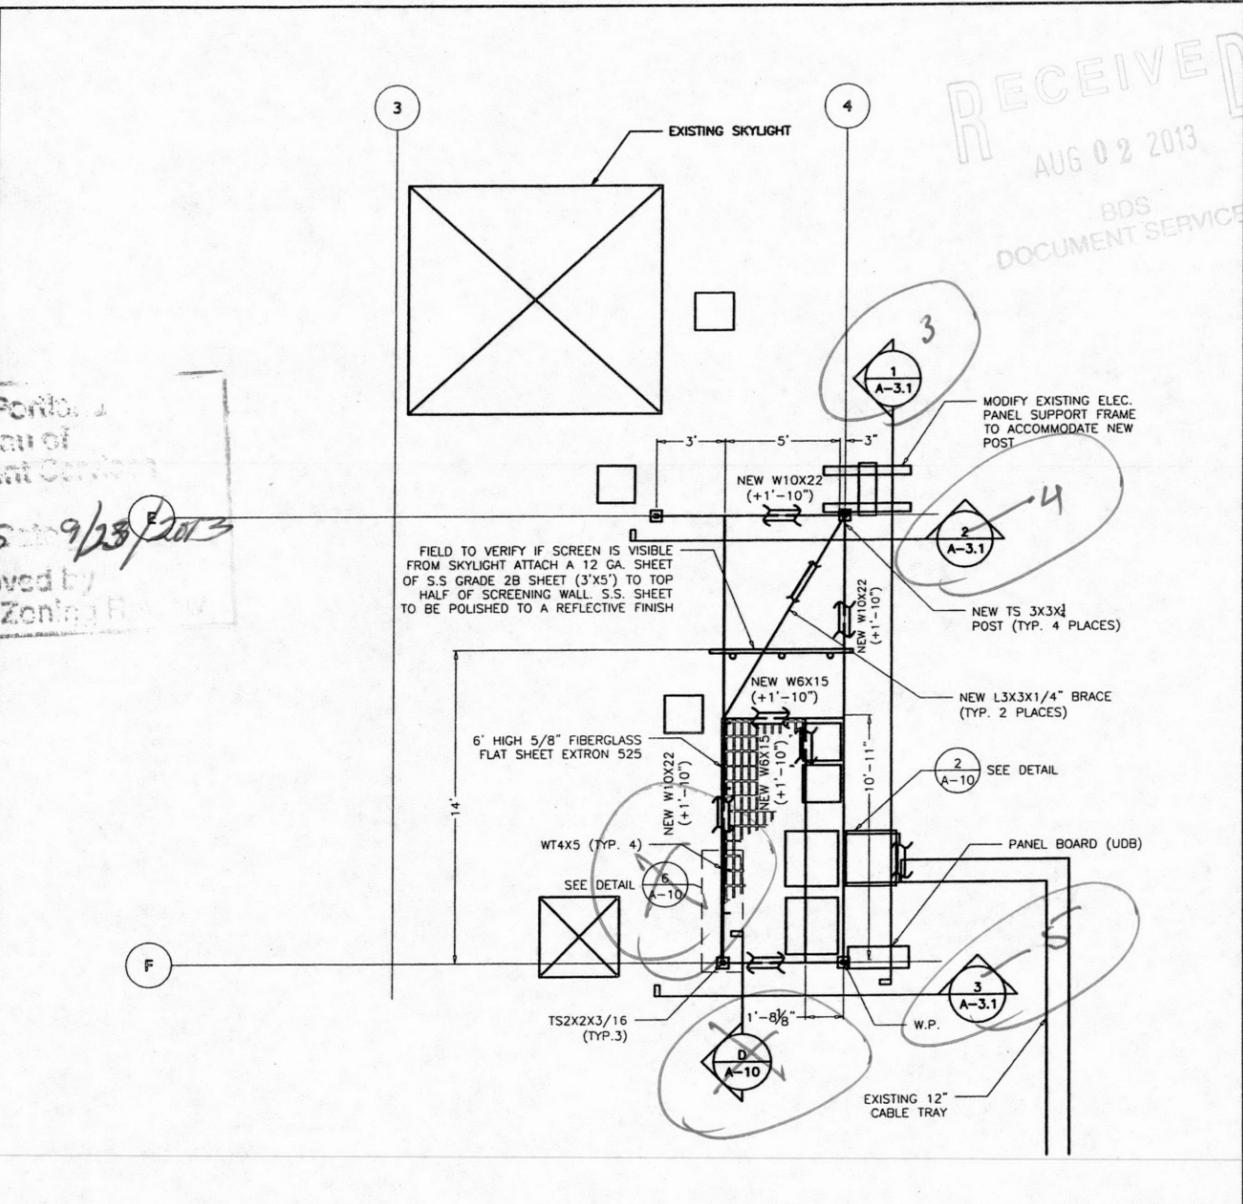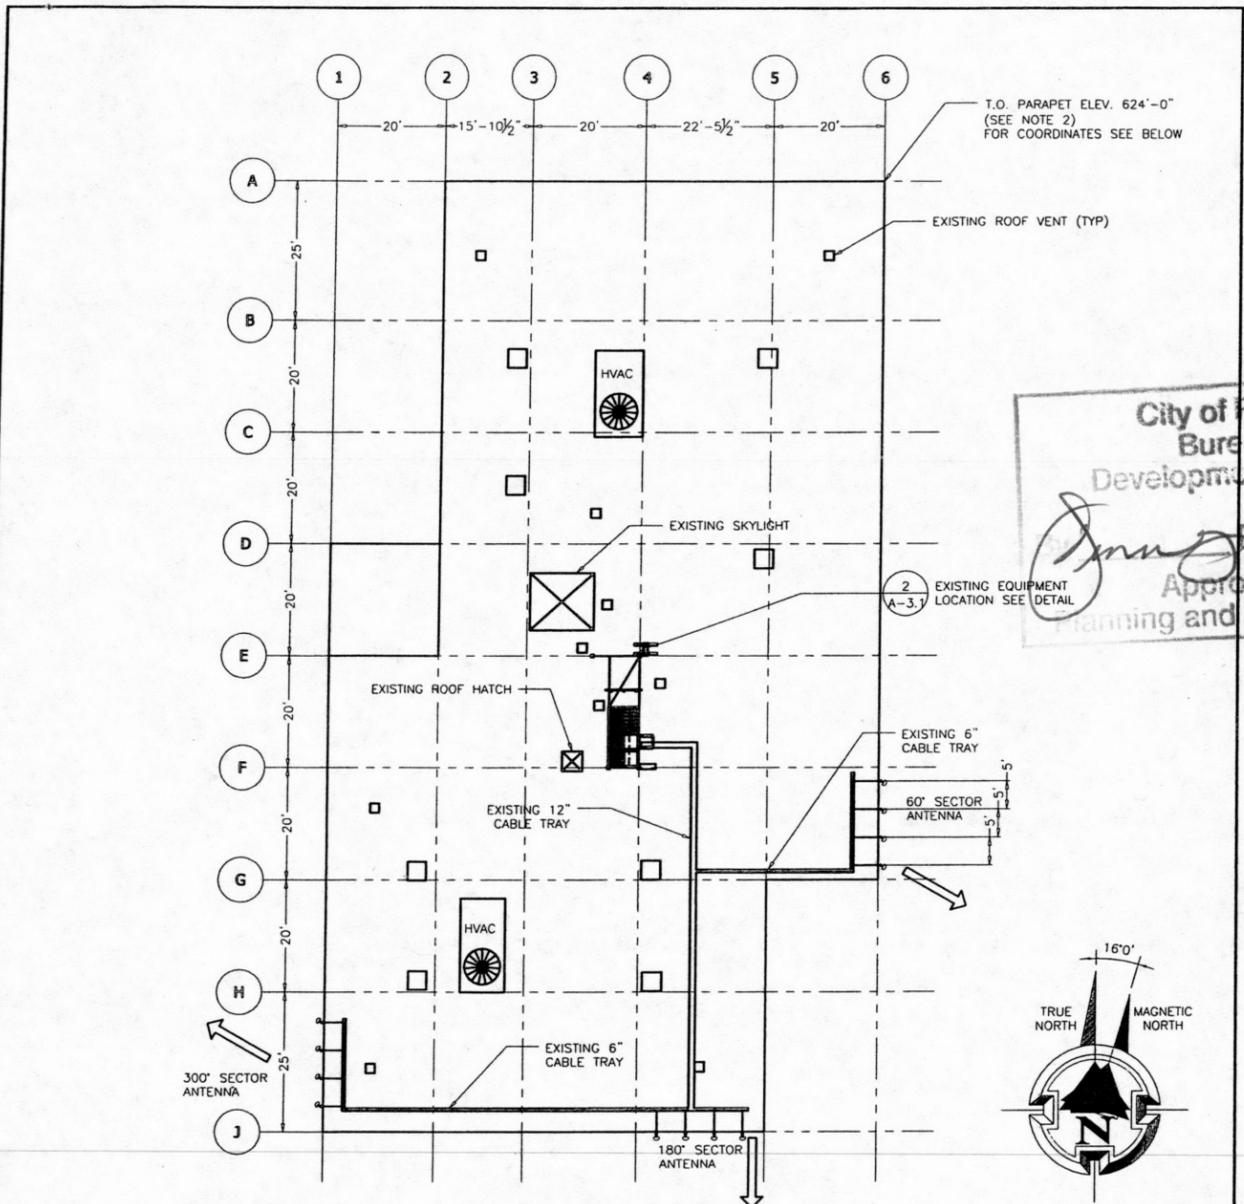

City of Portland  
Bureau of  
Development Services  
Approved by  
Planning and Zoning

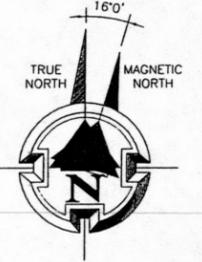




22"x34" SCALE: 1/16" = 1'-0"  
11"x17" SCALE: 1/32" = 1'-0"

ROOF PLAN 1

22"x34" SCALE: 1/4" = 1'-0"  
11"x17" SCALE: 1/8" = 1'-0"

City of Portland  
REVIEWED FOR CODE  
COMPLIANCE  
SEP 30 2013  
Permit Number

ENLARGED ROOF PLAN 2

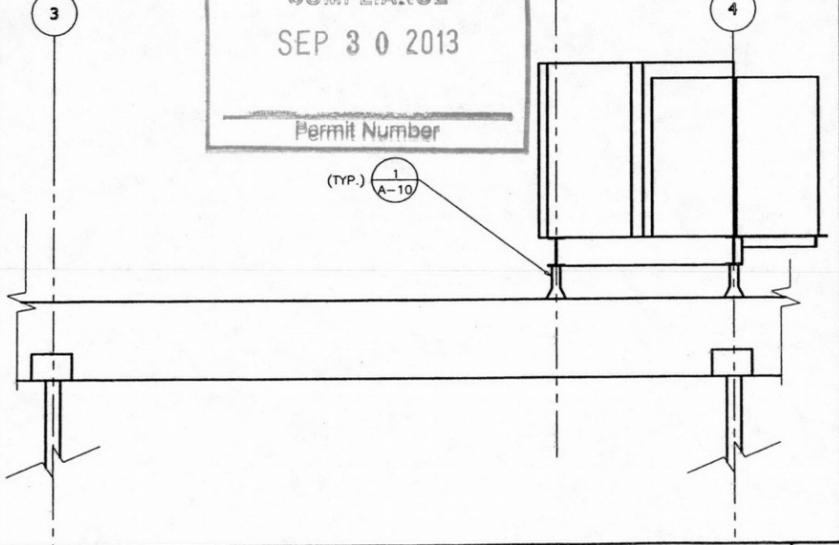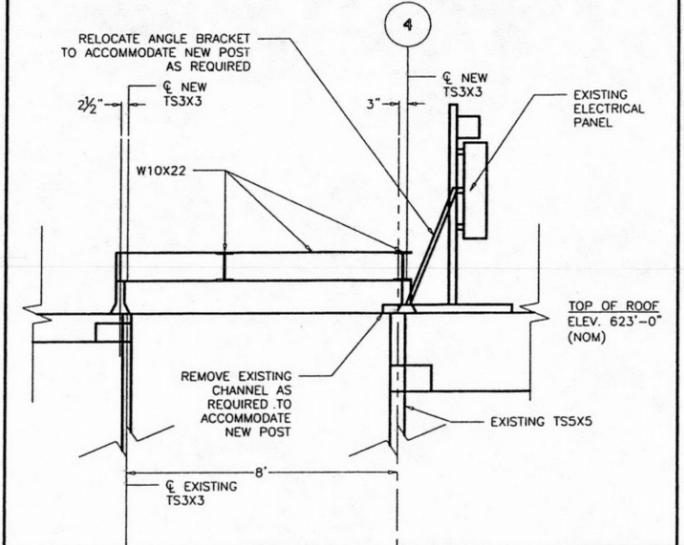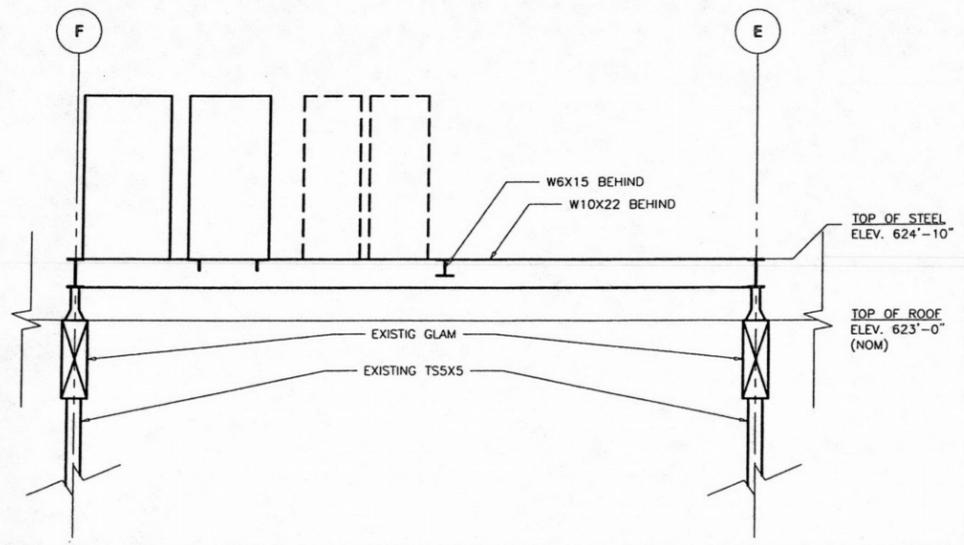

22"x34" SCALE: 3/8" = 1'-0"  
11"x17" SCALE: 3/16" = 1'-0"

SECTION 3

22"x34" SCALE: 3/8" = 1'-0"  
11"x17" SCALE: 3/16" = 1'-0"

SECTION 4

22"x34" SCALE: 3/8" = 1'-0"  
11"x17" SCALE: 3/16" = 1'-0"

SECTION 5

THE INFORMATION CONTAINED IN THIS SET OF CONSTRUCTION DOCUMENTS IS PROPRIETARY BY NATURE. ANY USE OR DISCLOSURE OTHER THAN THAT WHICH RELATES TO CARRIER SERVICES IS STRICTLY PROHIBITED.



GENERAL DYNAMICS  
WIRELESS SERVICES

POWDER RIVER  
Development Services, LLC  
100 E. SHENANGO STREET  
SHARPSVILLE, PA 16150  
724.962.5999  
www.powderriverdev.com

PROJECT INFORMATION:  
NETWORK: VISION MMBS LAUNCH  
**BURLINGAME 2**  
PO03XC067  
9700 CAPITAL HWY  
PORTLAND, OR 97219  
MULTNOMAH, COUNTY

ISSUE DATE: 06-27-2013

ISSUED FOR: CONSTRUCTION DWGS

REVISIONS			
REV.	DATE	DESCRIPTION	INITIALS
A	08/22/12	ISSUED FOR CDs 90%	DM
B	08/30/12	ISSUED FOR CDs 100%	CCM
C	09/10/12	ISSUED FOR CDs FINALS	JED
D	05/24/13	ISSUED FOR REVISED CDs FINALS	CCM
E	06/27/13	ISSUED FOR REVISED CDs FINALS	JED

NOT FOR CONSTRUCTION UNLESS  
LABELED AS CONSTRUCTION SET


LICENSURE:  
  
FOR REFERENCE ONLY  
ORIGINAL DESIGN DONE  
BY:  
URS CONSULTANTS  
SEALED BY REGISTERED  
ENGINEER:  
JAMES H. STOHR

SHEET TITLE:  
**EQUIPMENT DETAILS**


SHEET NUMBER:  
**A-3.1**

REVISION:  
**E**


PRDS PROJ. NO.  
1678-021112

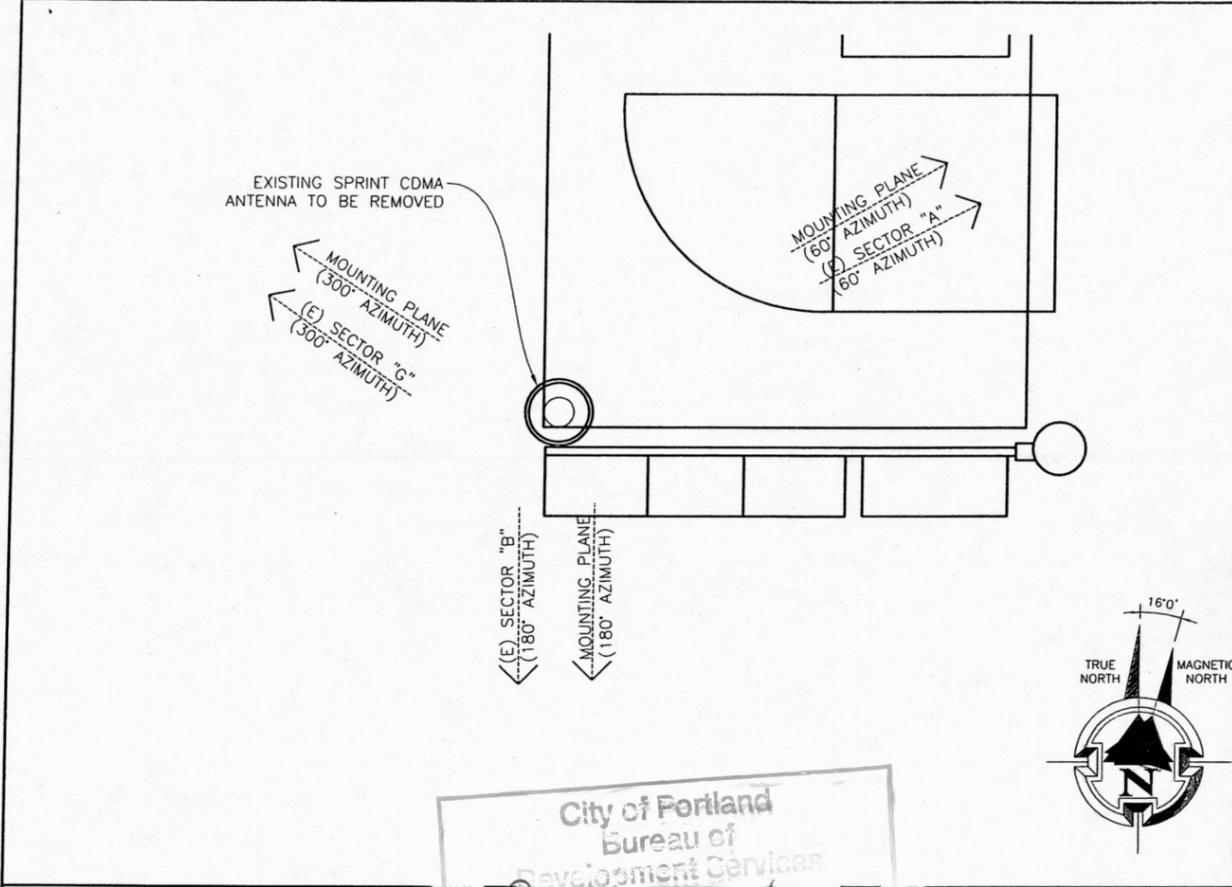

22"x34" SCALE: 1" = 1'-0"  
11"x17" SCALE: 1/2" = 1'-0"  
City of Portland Bureau of Development Services  
Approved by [Signature] Date 9/23/2013  
EXISTING ANTENNA PLAN | 1

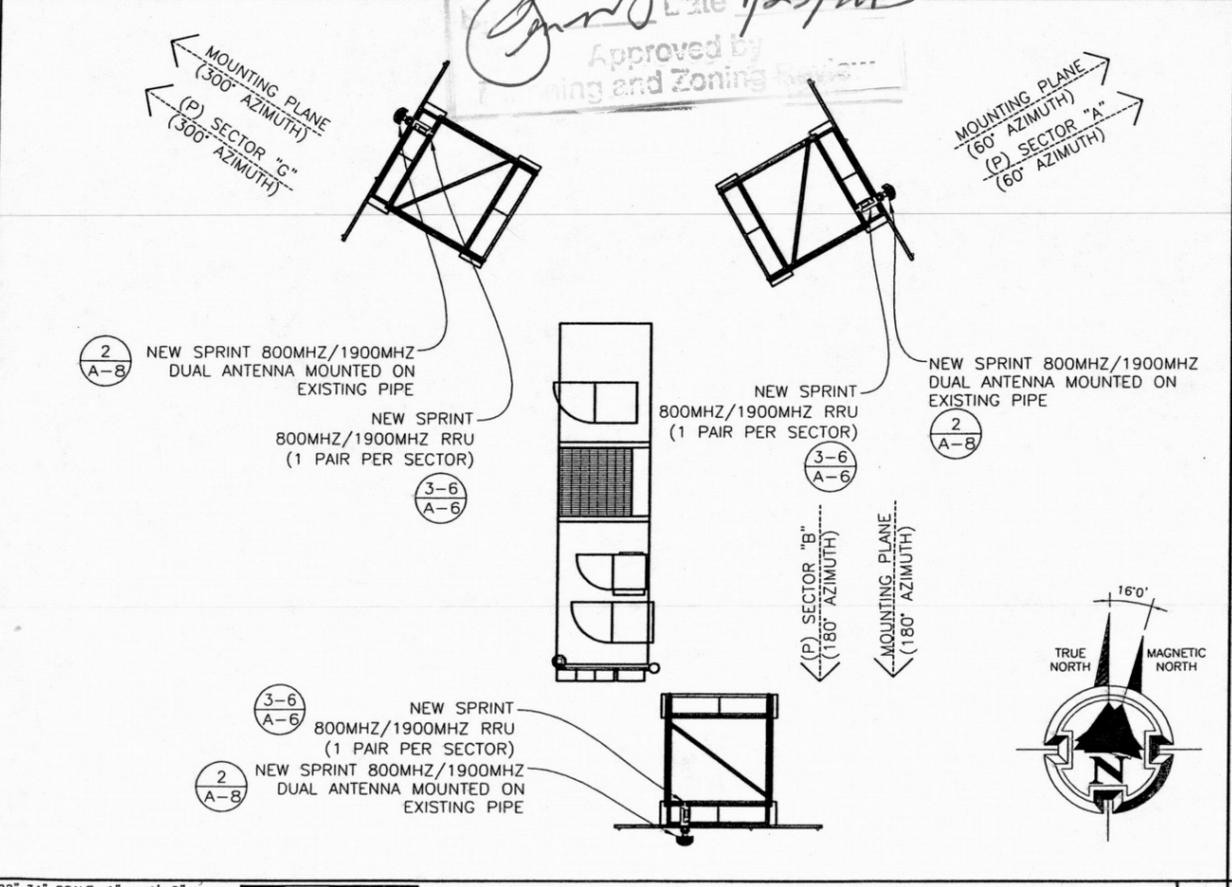

22"x34" SCALE: 1" = 1'-0"  
11"x17" SCALE: 1/2" = 1'-0"  
NEW ANTENNA PLAN (FINAL) | 3

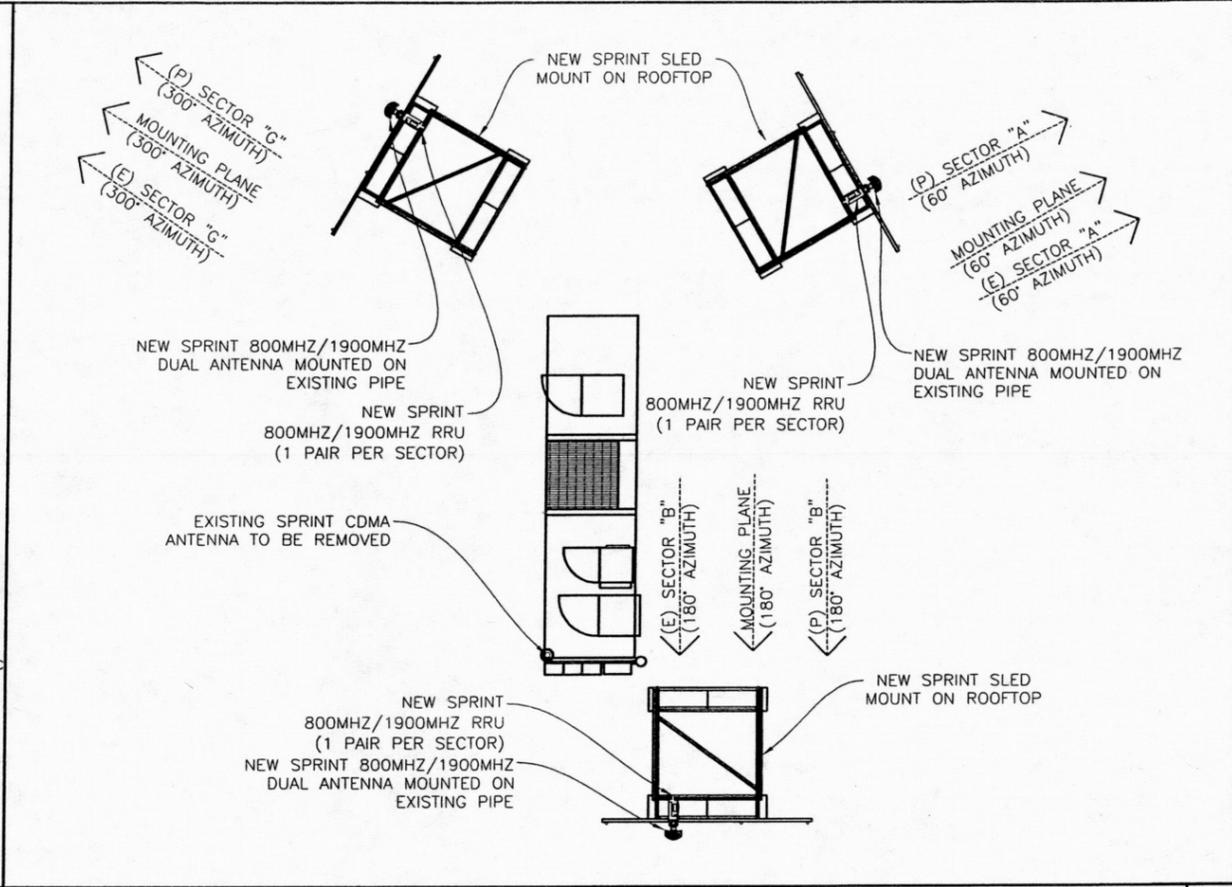

NOT USED | 2

**800/1900 EQUIPMENT**

**NOTE:** STRUCTURAL ANALYSIS MUST BE PERFORMED ON ALL ROOFTOPS, FLAGPOLES AND TOWER SITES BEFORE INSTALLATION OF NEW ANTENNAS, NEW RRUS, & NEW CABINETS/TEMPORARY PLATFORM.

**NOTE:** EXISTING ANTENNAS ARE CDMA UNLESS NOTED OTHERWISE.

NEW SPRINT ANTENNAS INCLUDE RESPECTIVE RRU'S WHICH SHALL BE MOUNTED ON THE PIPE BEHIND THE ANTENNA SIMILAR TO THAT SHOWN ON DETAIL 1, SHEET A-6.

FIELD VERIFY EXISTING AZIMUTH BEFORE RELOCATING THE ANTENNA, IF REQUIRED. PRIOR APPROVAL FROM SPRINT TO BE GRANTED BEFORE RELOCATION OF ANTENNAS.

**NOTES:** ALL AZIMUTHS ARE TO BE ESTABLISHED CLOCKWISE FROM THE TRUE NORTH HEADING. CONTRACTOR SHALL VERIFY NEW ANTENNA RAD CENTER AND ORIENTATIONS WITH SPRINT PCS PRIOR TO INSTALLATION OF ANTENNAS. PRIOR TO ATTACHING ANTENNAS AND MOUNTING SECTIONS, EXISTING TOWER AND TOWER FOUNDATION MUST BE ANALYZED BY A LICENSED STRUCTURAL ENGINEER TO VERIFY TOWER IS CAPABLE OF SUPPORTING THE NEW LOADS. REFER TO STRUCTURAL ANALYSIS BY OTHERS. CONTRACTOR SHALL REFER TO TOWER STRUCTURAL CALCULATIONS FOR ADDITIONAL LOADS. NO ERECTION OF MODIFICATION OF TOWER SHALL BE MADE WITHOUT APPROVAL OF STRUCTURAL ENGINEER.

RRU / HYBRID CABLE SCHEDULE									
SECTOR	RRU MODEL	RRU FREQUENCY	HYBRID CABLE LENGTH	HYBRID CABLE DIAMETER	JUMPER SIZE	JUMPER LENGTH	RET LENGTH	RET CABLE MANUFACTURER	RET CABLE MODEL NUMBER
ALPHA	RRH-C2A & RRH-P4	(1)800MHz & (1)1900MHz	75'	N/A	1/2"	6'	9.8'	COMMSCOPE	iRET AISGv1.1
BETA	RRH-C2A & RRH-P4	(1)800MHz & (1)1900MHz	75'	N/A	1/2"	6'	9.8'	COMMSCOPE	iRET AISGv1.1
GAMMA	RRH-C2A & RRH-P4	(1)800MHz & (1)1900MHz	75'	N/A	1/2"	6'	9.8'	COMMSCOPE	iRET AISGv1.1

ANTENNA SCHEDULE									
SECTOR	ANTENNA FREQUENCY	ANTENNA MFR.	ANTENNA MODEL	ANTENNA QUANTITY	AZIMUTH	RAD CENTER	ANT. SIZE	ELECT TILT	MECH TILT
ALPHA	800/1900 MHz	KMW	ET-X-TS-70-15-62-IR-RD	1 (PER SECTOR)	60°	33'-0"	73.8"	-4°	0°
BETA	800/1900 MHz	KMW	ET-X-TS-70-15-62-IR-RD	1 (PER SECTOR)	180°	33'-0"	73.8"	-4°	0°
GAMMA	800/1900 MHz	POWERWAVE	P90-15-XLPP-RR	1 (PER SECTOR)	300°	33'-0"	72.0"	-1°	0°

Permit Number: [Stamp] SEP 30 2013

RECEIVED AUG 02 2013 BDS DOCUMENT SERVICES

NOTES & ANTENNA SCHEDULE | 4

**Sprint**

**SAMSUNG**

**GENERAL DYNAMICS WIRELESS SERVICES**

**POWDER RIVER**  
Development Services, LLC  
100 E. SHENANGO STREET  
SHARPSVILLE, PA 16150  
724.962.5999  
www.powderriverdev.com

PROJECT INFORMATION:  
NETWORK: VISION MMBS LAUNCH

**BURLINGAME 2**  
PO03XC067  
9700 CAPITAL HWY  
PORTLAND, OR 97219  
MULTNOMAH, COUNTY

ISSUE DATE: 06-27-2013

ISSUED FOR: CONSTRUCTION DWGS

REVISIONS			
REV.	DATE	DESCRIPTION	INITIALS
A	08/22/12	ISSUED FOR CDs 90%	DM
B	08/30/12	ISSUED FOR CDs 100%	CCM
C	09/10/12	ISSUED FOR CDs FINALS	JED
D	05/24/13	ISSUED FOR REVISED CDs FINALS	CCM
E	06/27/13	ISSUED FOR REVISED CDs FINALS	JED

NOT FOR CONSTRUCTION UNLESS LABELED AS CONSTRUCTION SET


LICENSURE:  
**REGISTERED PROFESSIONAL ENGINEER CIVIL 84537PE**  
GARY W. CLOWEY  
OREGON 9-14-10  
EXPIRES 12-31-2013

SHEET TITLE: ANTENNA PLANS & SCHEDULES

SHEET NUMBER: **A-4** REVISION: **E**

PRDS PROJNO: 1678-021112


NOTE: STRUCTURAL ANALYSIS MUST BE PERFORMED ON ALL ROOFTOPS, FLAGPOLES AND TOWER SITES BEFORE INSTALLATION OF NEW ANTENNAS, NEW RRUS, & NEW CABINETS/TEMPORARY PLATFORMS.

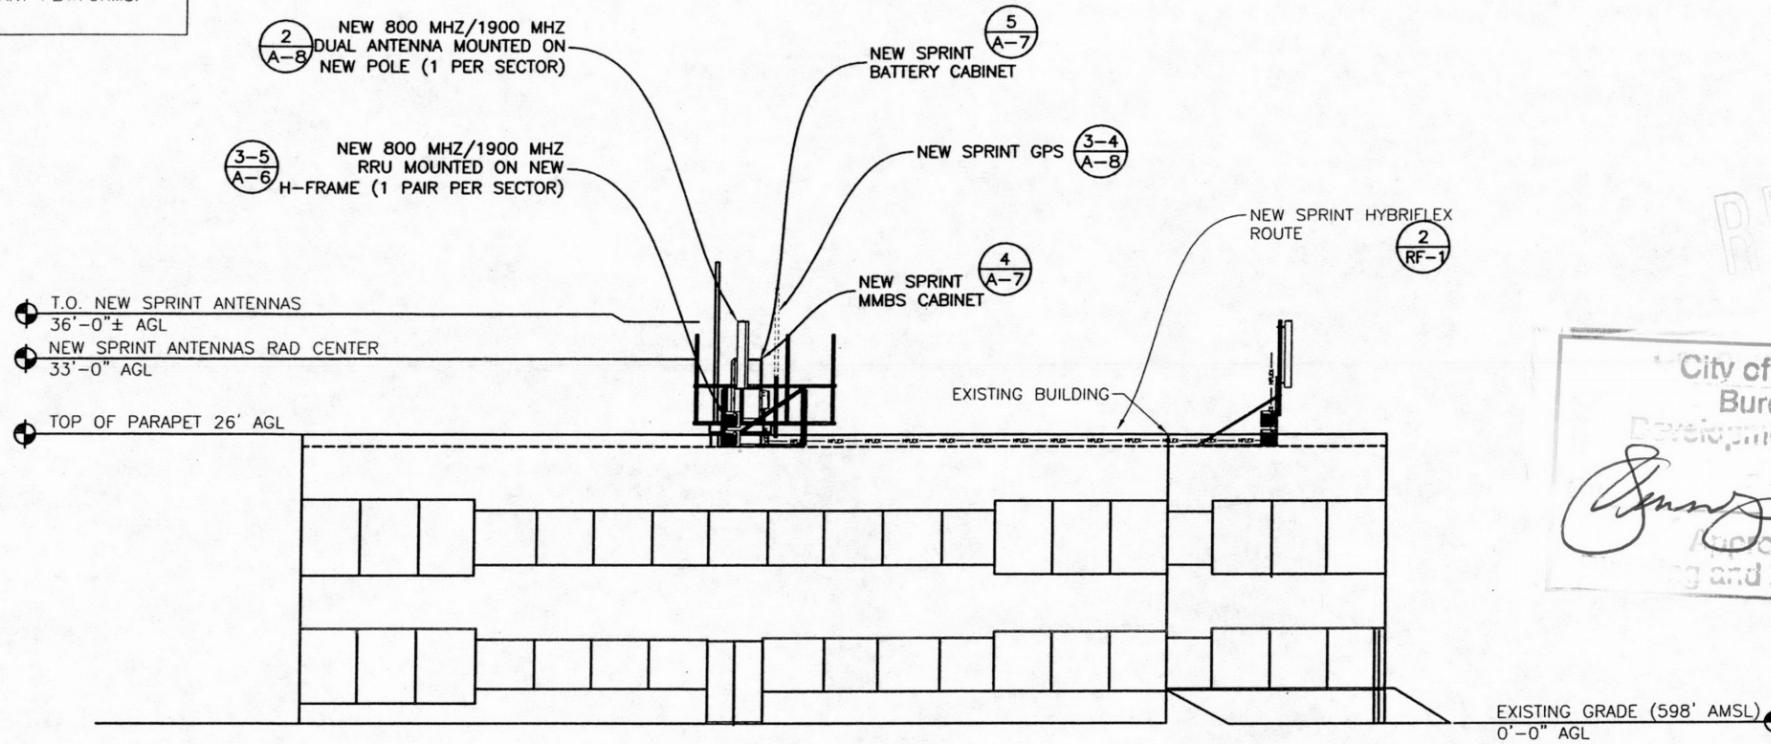

RECEIVED  
AUG 02 2013  
City of Portland  
Bureau of  
Development Services  
Approved by  
[Signature] Date 9/23/2013  
[Signature] and Zoning

22"x34" SCALE: 3/16" = 1'-0"  
11"x17" SCALE: 3/32" = 1'-0"

NEW NORTH ELEVATION 1

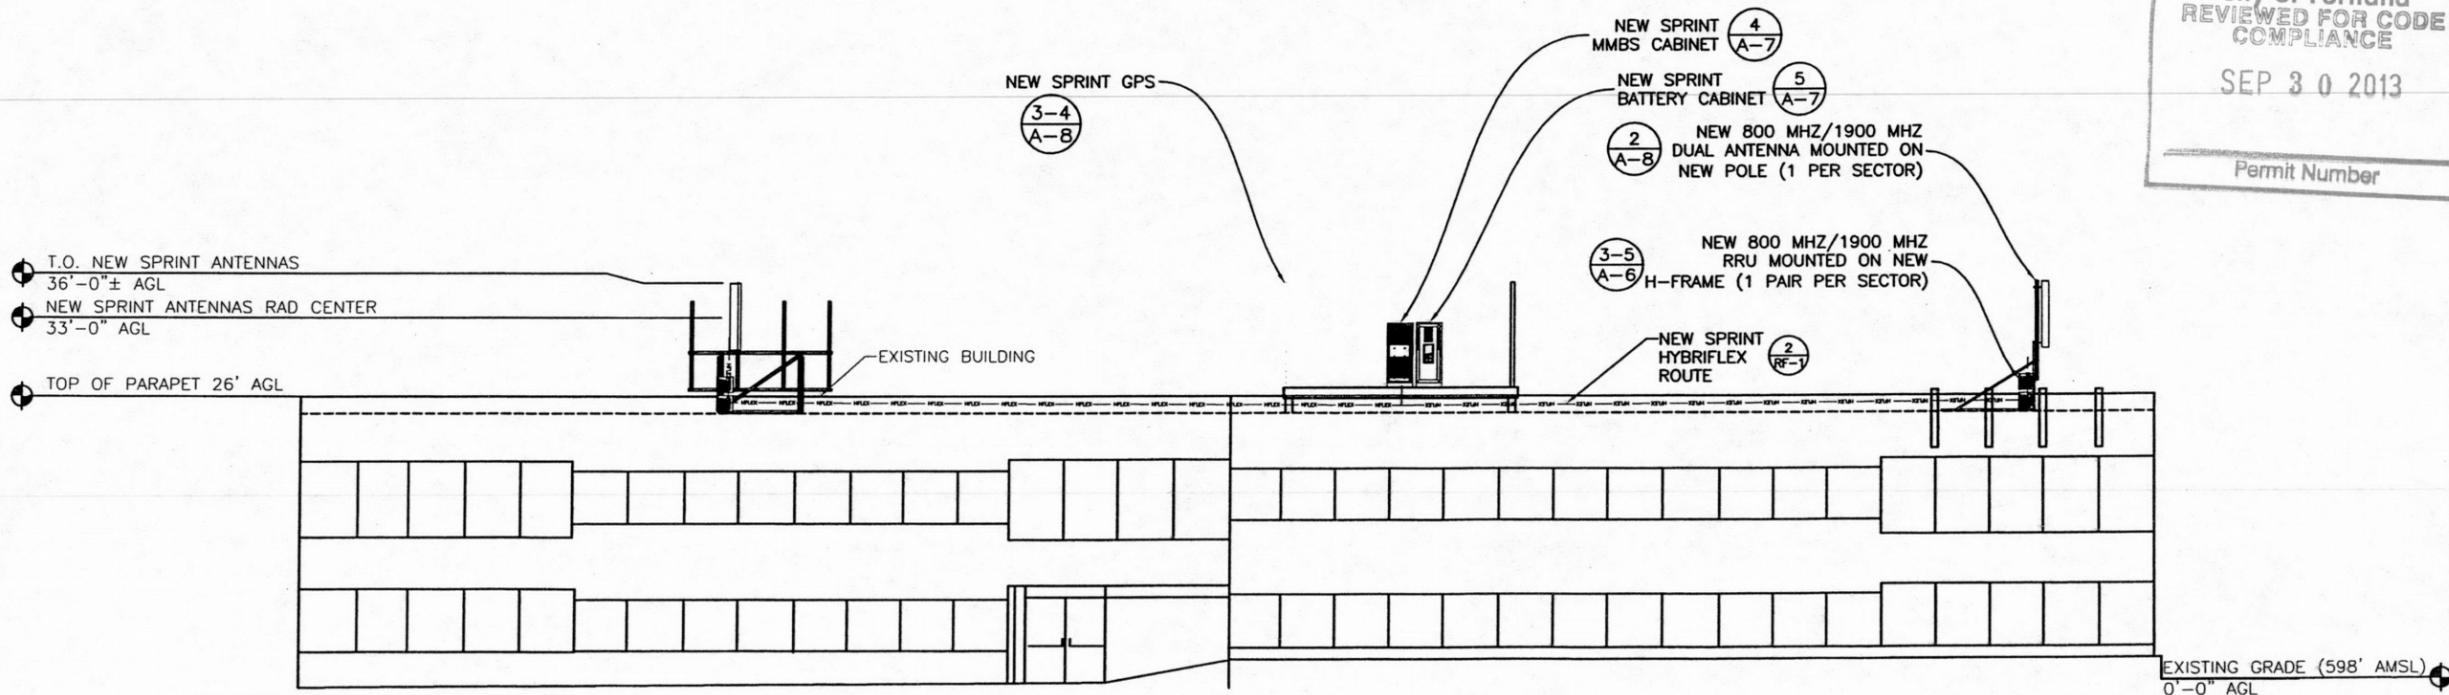

City of Portland  
REVIEWED FOR CODE  
COMPLIANCE  
SEP 30 2013  
Permit Number

22"x34" SCALE: 3/16" = 1'-0"  
11"x17" SCALE: 3/32" = 1'-0"

NEW WEST ELEVATION 2



GENERAL DYNAMICS  
WIRELESS SERVICES



POWDER RIVER  
Development Services, LLC  
100 E. SHENANGO STREET  
SHARPSVILLE, PA 16150  
724.962.5999  
www.powderriverdev.com


PROJECT INFORMATION:  
NETWORK VISION MMBS LAUNCH  
**BURLINGAME 2**  
PO03XC067  
9700 CAPITAL HWY  
PORTLAND, OR 97219  
MULTNOMAH, COUNTY

ISSUE DATE: 06-27-2013

ISSUED FOR: CONSTRUCTION DWGS

REVISIONS			
REV.	DATE	DESCRIPTION	INITIALS
A	08/22/12	ISSUED FOR CDs 90%	DM
B	08/30/12	ISSUED FOR CDs 100%	CCM
C	09/10/12	ISSUED FOR CDs FINALS	JED
D	05/24/13	ISSUED FOR REVISED CDs FINALS	CCM
E	06/27/13	ISSUED FOR REVISED CDs FINALS	JED





NOT FOR CONSTRUCTION UNLESS LABELED AS CONSTRUCTION SET

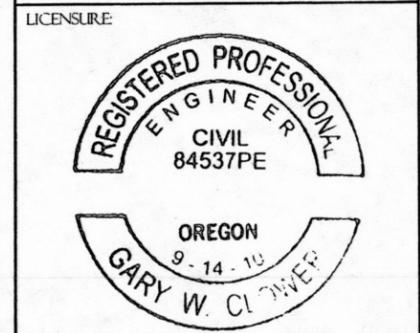

SHEET TITLE: EXPIRES 12/31/2013

NEW NORTH & WEST ELEVATIONS

SHEET NUMBER: **A-5** REVISION: **E**  
PROJ. NO. 1678-021112

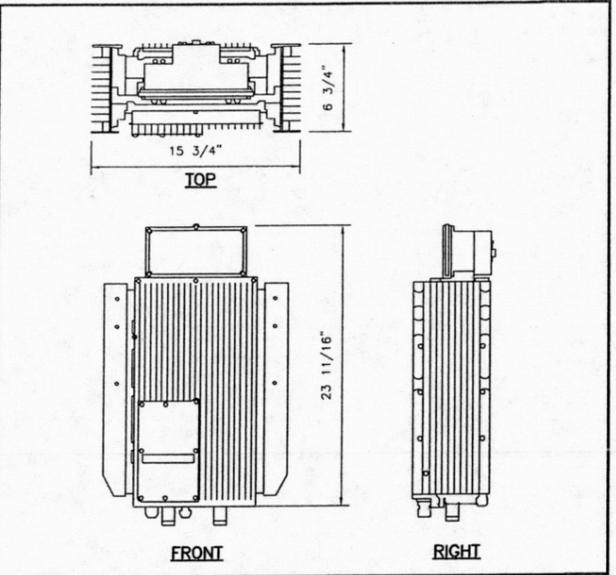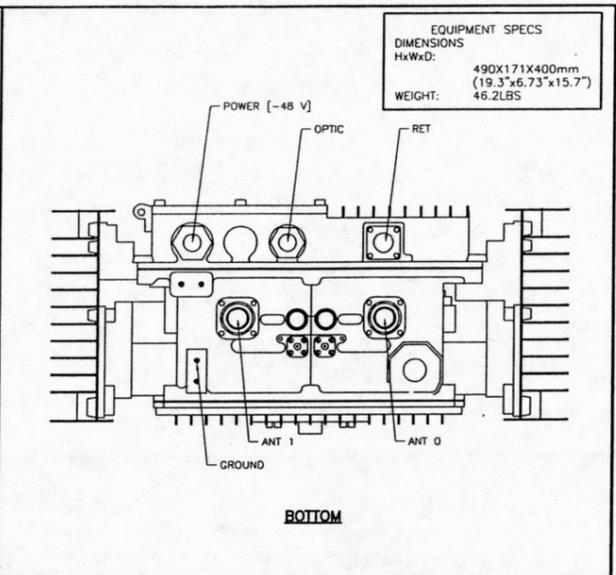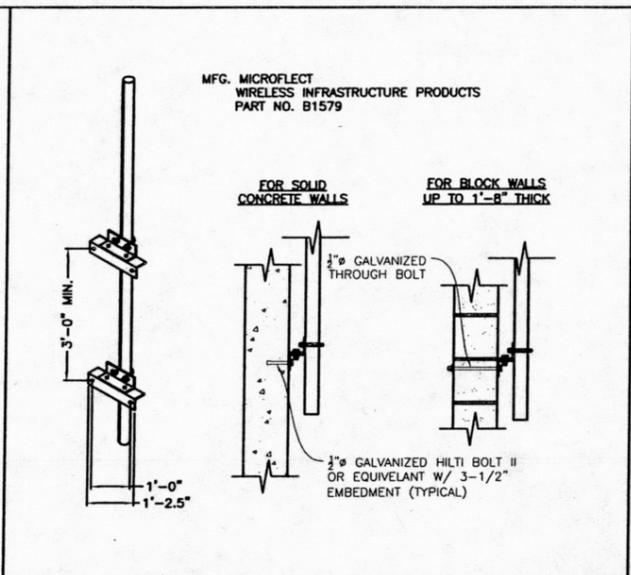
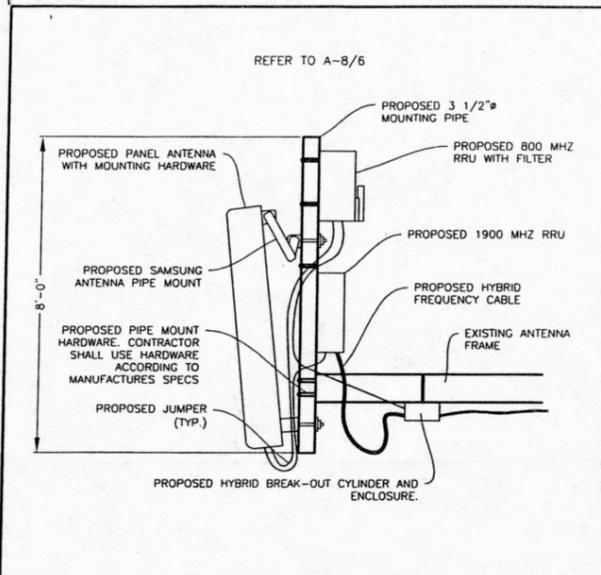


22"x34" SCALE: N.T.S. 11"x17" SCALE: N.T.S. ANTENNA & HYBRID CABLE 1

22"x34" SCALE: NOT TO SCALE 11"x17" SCALE: NOT TO SCALE WALL MOUNT DETAIL 2



22"x34" SCALE: NOT TO SCALE 11"x17" SCALE: NOT TO SCALE 800 MHZ RRH-C2A 3

22"x34" SCALE: NOT TO SCALE 11"x17" SCALE: NOT TO SCALE 800 MHZ RRH-C2A 4

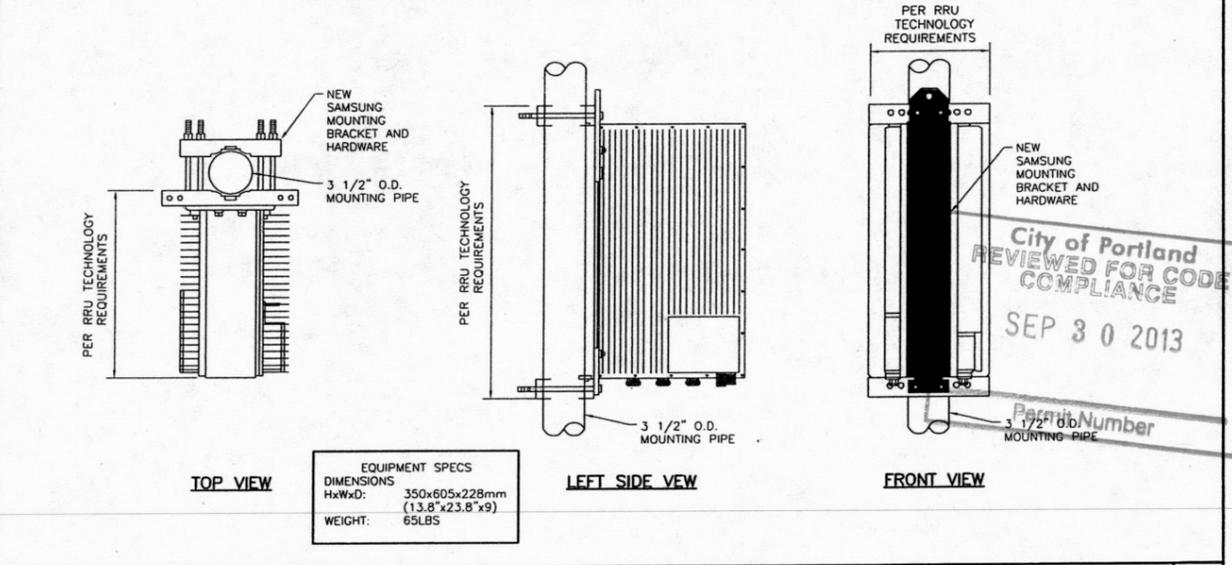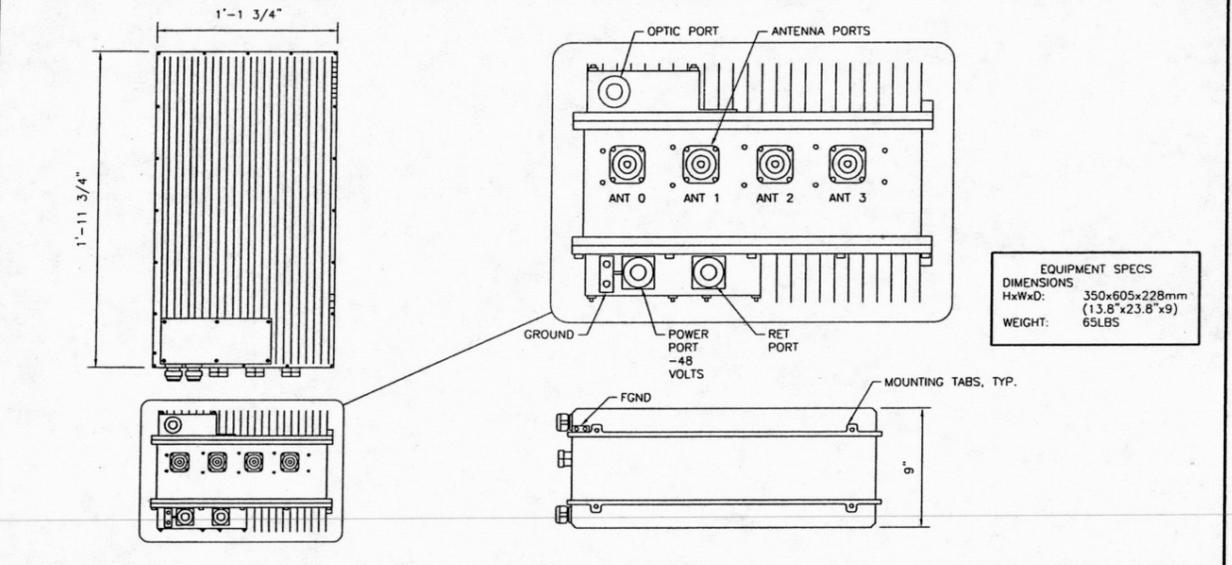

22"x34" SCALE: NOT TO SCALE 11"x17" SCALE: NOT TO SCALE 1900 MHZ RRH-P4 MECHANICAL SPECIFICATIONS 5

22"x34" SCALE: NOT TO SCALE 11"x17" SCALE: NOT TO SCALE RRU POLE INSTALLATION DETAIL 6

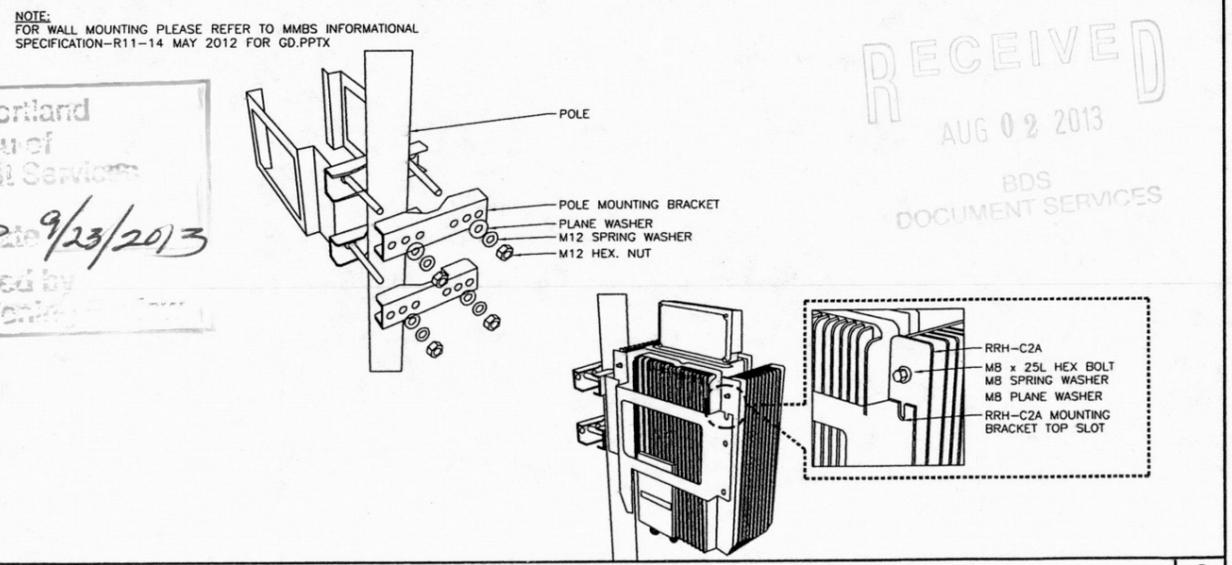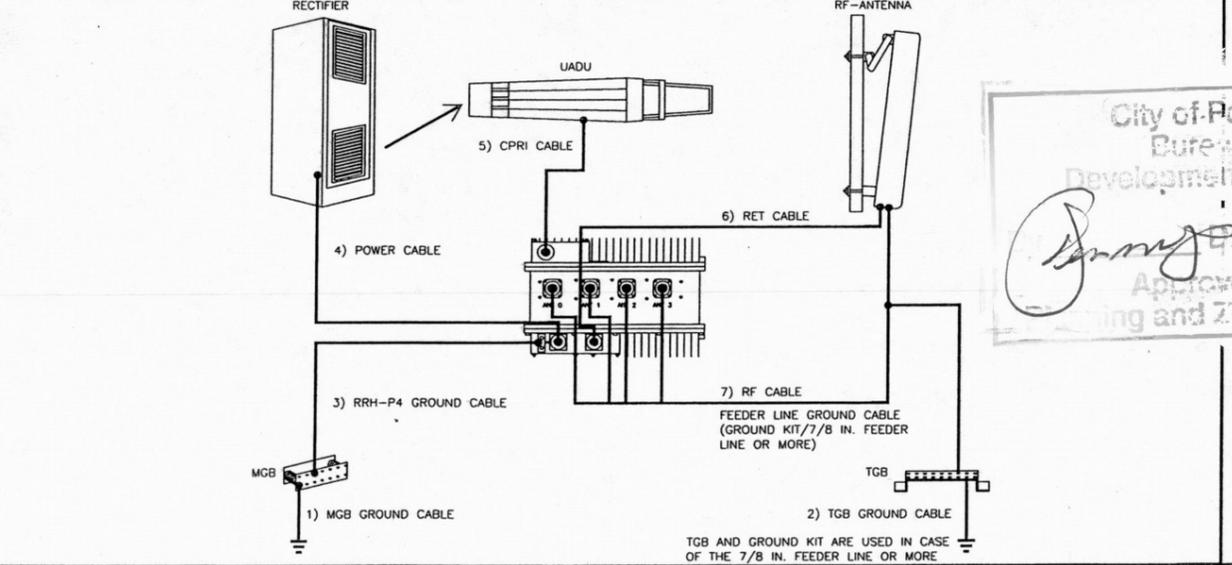

22"x34" SCALE: NOT TO SCALE 11"x17" SCALE: NOT TO SCALE SAMSUNG MMBS WIRING DIAGRAM 7

22"x34" SCALE: NOT TO SCALE 11"x17" SCALE: NOT TO SCALE 800MHZ RRH 2ND GEN POLE MOUNT 8

**Sprint**

**SAMSUNG**

**GENERAL DYNAMICS WIRELESS SERVICES**

**POWDER RIVER**  
Development Services, LLC  
100 E. SHENANGO STREET  
SHARPSVILLE, PA 16150  
724.962.5999  
www.powderriverdev.com

PROJECT INFORMATION:  
NETWORK VISION MMBS LAUNCH

**BURLINGAME 2**  
PO03XC067  
9700 CAPITAL HWY  
PORTLAND, OR 97219  
MULTNOMAH, COUNTY

ISSUE DATE: 06-27-2013

ISSUED FOR: CONSTRUCTION DWGS


REV.	DATE	DESCRIPTION	INITIALS
A	08/22/12	ISSUED FOR CDs 90%	DM
B	08/30/12	ISSUED FOR CDs 100%	CCM
C	09/10/12	ISSUED FOR CDs FINALS	JED
D	05/24/13	ISSUED FOR REVISED CDs FINALS	CCM
E	06/27/13	ISSUED FOR REVISED CDs FINALS	JED

NOT FOR CONSTRUCTION UNLESS LABELED AS CONSTRUCTION SET


LICENSURE:  
REGISTERED PROFESSIONAL ENGINEER CIVIL 84537PE  
6/27/13 OREGON 9 14 11  
GARY W. CLAYTON  
EXPIRES 12/31/2017

SHEET TITLE: EQUIPMENT DETAILS

SHEET NUMBER: A-6 REVISION: E  
PROJ. NO. 1678-021112

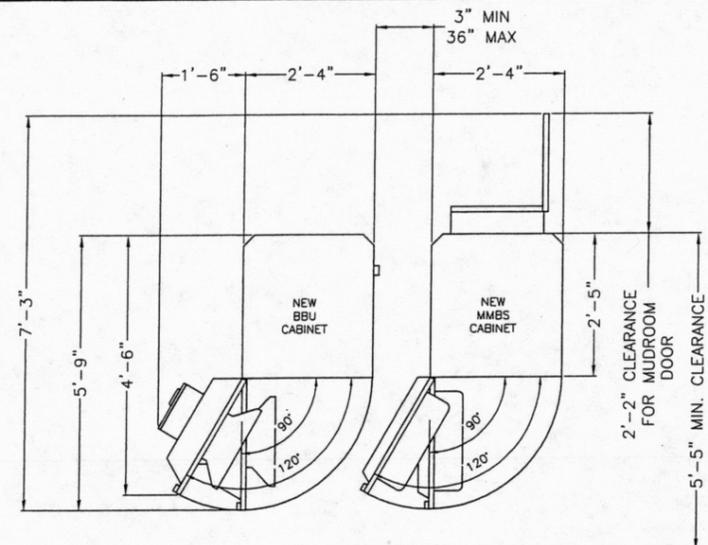

ITEM	SPECIFICATIONS
CAPACITY	MAX. 4 BATTERY STRINGS
COOLING	AIR-CONDITIONER/COOLING WITH FAN FOR EMERGENCY MODE (MCLEAN T20 HVAC)
SOUND LEVEL	65BA @1.5m
SIZE	71(H) x 41.25(D) x 27.6(W) INCH 1800(H) x 1048(D) x 700(W) mm
CABINET WEIGHT	370 LBS
PER BATTERY STRING WEIGHT	529 LBS
BATTERY	NARADA 190AH (12NDT190) AGM TYPE (VRLA)
AC POWER	220VAC, 3.5AMP TYP. 14.4AMP STARTING
DC POWER	10A MAX @48VDC

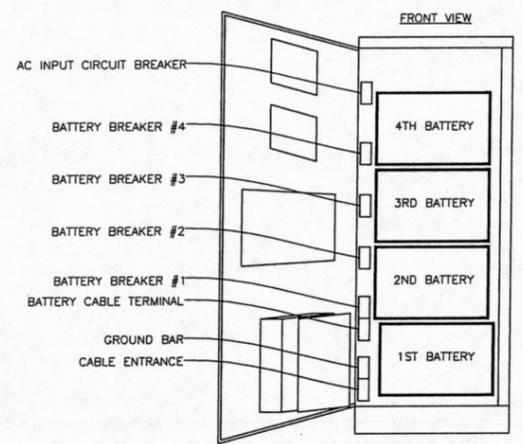

RECEIVED  
AUG 02 2013  
City of Portland  
REVIEWED FOR CODE COMPLIANCE  
SEP 30 2013  
MMBS CABINET

22"x34" SCALE: NOT TO SCALE  
11"x17" SCALE: NOT TO SCALE

MMBS & BBU TYPICAL LAYOUT

22"x34" SCALE: NOT TO SCALE  
11"x17" SCALE: NOT TO SCALE



GENERAL DYNAMICS WIRELESS SERVICES



POWDER RIVER Development Services, LLC  
100 E. SHENANGO STREET  
SHARPSVILLE, PA 16150  
724.962.5999  
www.powderriverdev.com

PROJECT INFORMATION:  
NETWORK VISION MMBS LAUNCH

BURLINGAME 2

PO03XC067  
9700 CAPITAL HWY  
PORTLAND, OR 97219  
MULTNOMAH, COUNTY

ISSUE DATE: 06-27-2013

ISSUED FOR: CONSTRUCTION DWGS

REVISIONS				
REV.	DATE	DESCRIPTION	INITIALS	
A	08/22/12	ISSUED FOR CDs 90%	DM	
B	08/30/12	ISSUED FOR CDs 100%	CCM	
C	09/10/12	ISSUED FOR CDs FINALS	JED	
D	05/24/13	ISSUED FOR REVISED CDs FINALS	CCM	
E	06/27/13	ISSUED FOR REVISED CDs FINALS	JED	


NOT FOR CONSTRUCTION UNLESS LABELED AS CONSTRUCTION SET

LICENSURE:



EQUIPMENT DETAILS  
OUTDOOR SPECIFICATIONS

SHEET NUMBER: A-7  
REVISION: E  
PRDS PROJ NO: 1678-021112

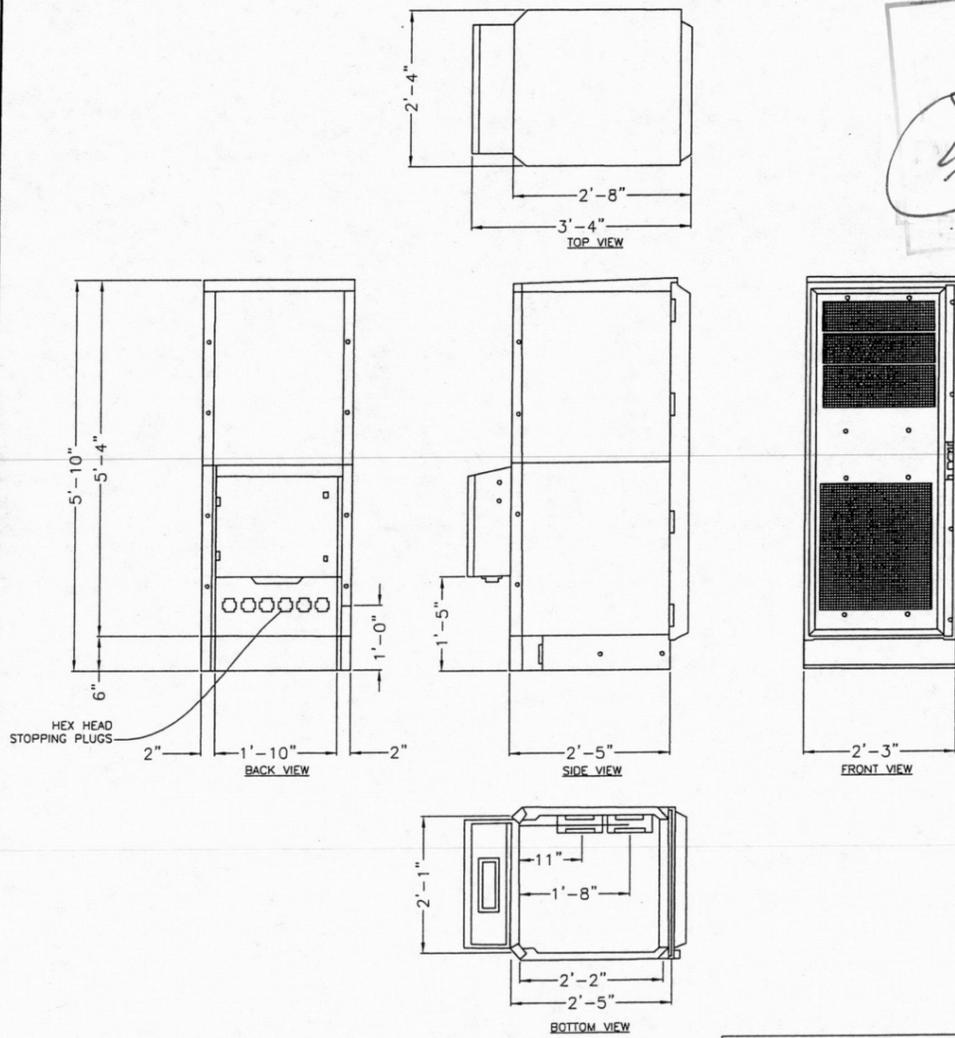


MMBS EQUIPMENT WEIGHT & DIMENSIONS	
MMBS CABINET	1800x700x1018(820)mm/70.8in x 29.5in x 40.1(37.0)in
MMBS CABINET	251kg (553lbs) W/O DU SHELF   300kg W/4 DU SHELF

22"x34" SCALE: NOT TO SCALE  
11"x17" SCALE: NOT TO SCALE

MMBS MECHANICAL SPECIFICATIONS

3

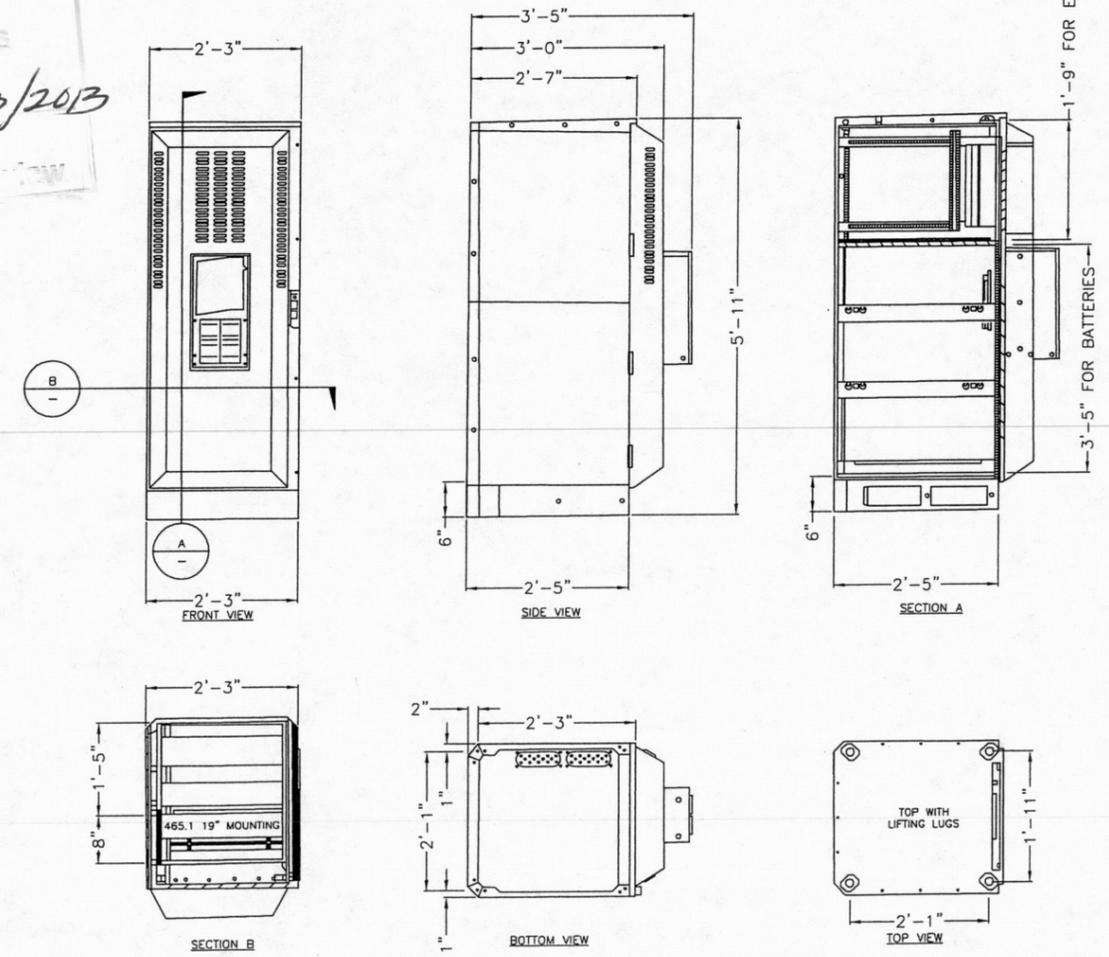


BBU EQUIPMENT WEIGHT & DIMENSIONS	
BBU CABINET	1800x700x1018(820)mm/70.8in x 29.5in x 40.1(37.0)in
BBU CABINET	168kg (370lbs) W/O BATTERY   1136kg WITH BATTERY

22"x34" SCALE: NOT TO SCALE  
11"x17" SCALE: NOT TO SCALE

BBU MECHANICAL SPECIFICATIONS


4

MANUFACTURER: POWERWAVE  
 MODEL: P90-15-XLPP-RR  
 WEIGHT: 50.0 LBS  
 DIMENSIONS: 72.0" X 12.0" X 6"  
 FREQUENCY: REFER TO RF DATA SHEET

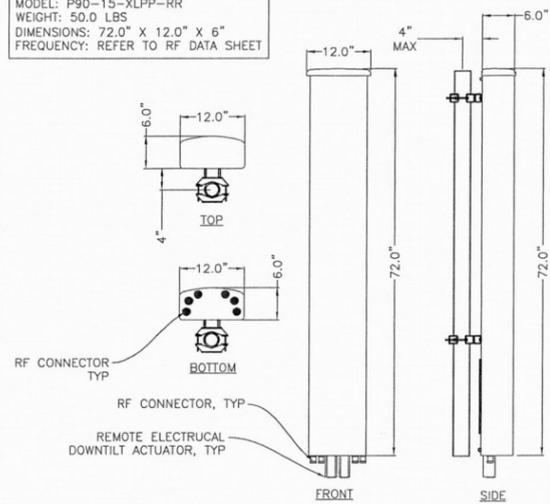


22"x34" SCALE: NOT TO SCALE  
 11"x17" SCALE: NOT TO SCALE  
**800/1900 ANTENNA DETAIL** 1

MANUFACTURER: KMW  
 MODEL: ET-X-TS-70-15-62-18-IR-RD  
 WEIGHT: 41.9 LBS  
 DIMENSIONS: 73.8" X 11.8" X 5.9"  
 FREQUENCY: REFER TO RF DATA SHEET

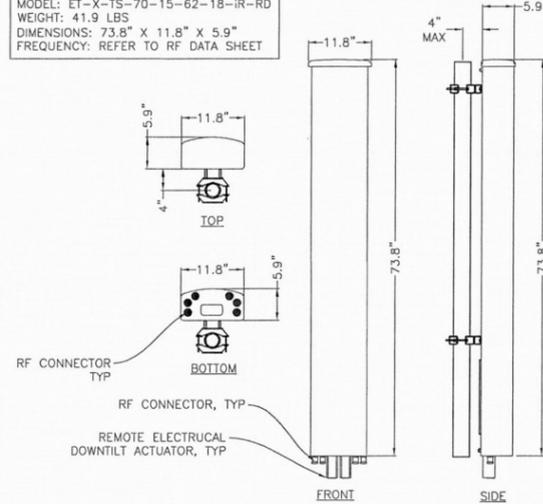


22"x34" SCALE: N.T.S.  
 11"x17" SCALE: N.T.S.  
**800/1900 ANTENNA DETAIL** 2


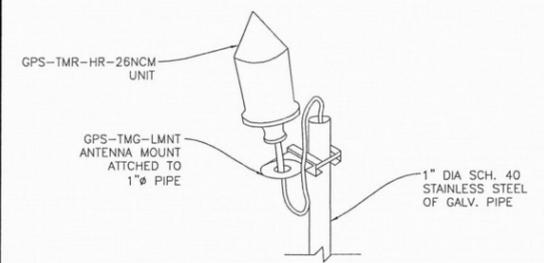


NOTES  
 1. THE GPS ANTENNA MOUNT IS DESIGNED TO FASTEN TO A STANDARD 1", SCH. 40, GALVANIZED STEEL OF STAINLESS STEEL PIPE. THE PIPE MUST NOT BE THREADED AT THE ANTENNA MOUNT END. THE PIPE SHALL BE CUT TO THE REQUIRED LENGTH (MIN. OF 18", 8'-0" IF MOUNTING TO NEW MMBS-BBU) USING A HAND OR ROTARY PIPE CUTTER TO ASSURE A SMOOTH AND PERPENDICULAR CUT. A HACK SAW SHALL NOT BE USED. THE CUT PIPE END SHALL BE DEBURRED.  
 2. IT IS CRITICAL THAT THE GPS ANTENNA IS MOUNTED SUCH THAT IT IS WITHIN 2 DEGREES OF VERTICAL AND THE BASE OF THE ANTENNA IS WITHIN 2' OF LEVEL.  
 3. DO NOT SWEEP TEST GPS ANTENNA  
 4. ATTACH GPS MOUNTING PIPE TO NEW MMBS-BBU USING (4) 8MMx15MM SS BOLTS AND (4) 1" PIPE STRAPS. GPS TO BE MOUNTED A MIN. OF 2'-0" ABOVE MMBS-BBU CABINET.


22"x34" SCALE: NOT TO SCALE  
 11"x17" SCALE: NOT TO SCALE  
**GPS UNIT PIPE MOUNT** 3

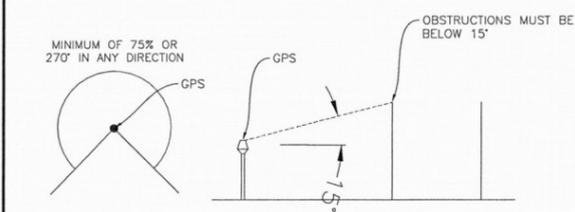

22"x34" SCALE: NOT TO SCALE  
 11"x17" SCALE: NOT TO SCALE  
**GPS REQUIREMENTS** 4

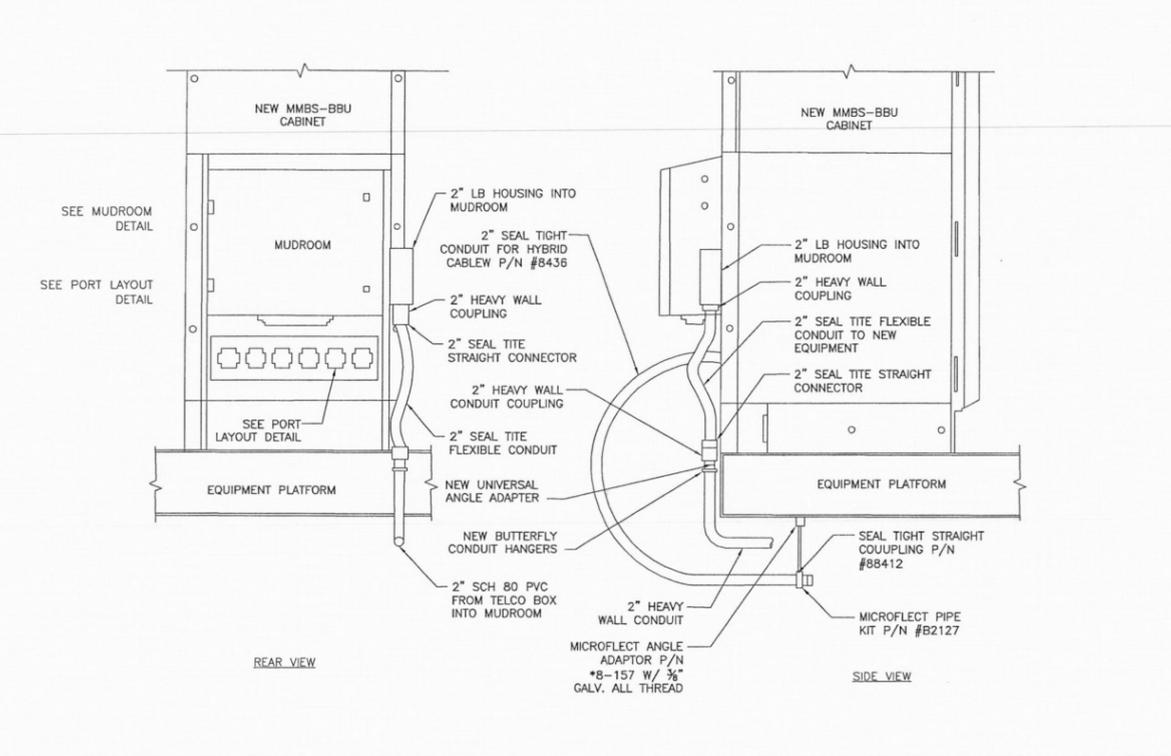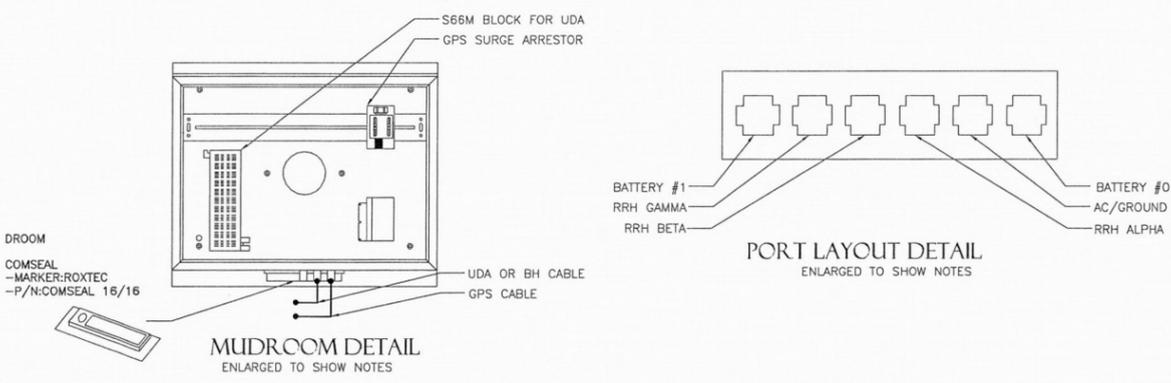

22"x34" SCALE: NOT TO SCALE  
 11"x17" SCALE: NOT TO SCALE  
**HYBRID & TELCO LINE SUPPORT DETAIL** 5

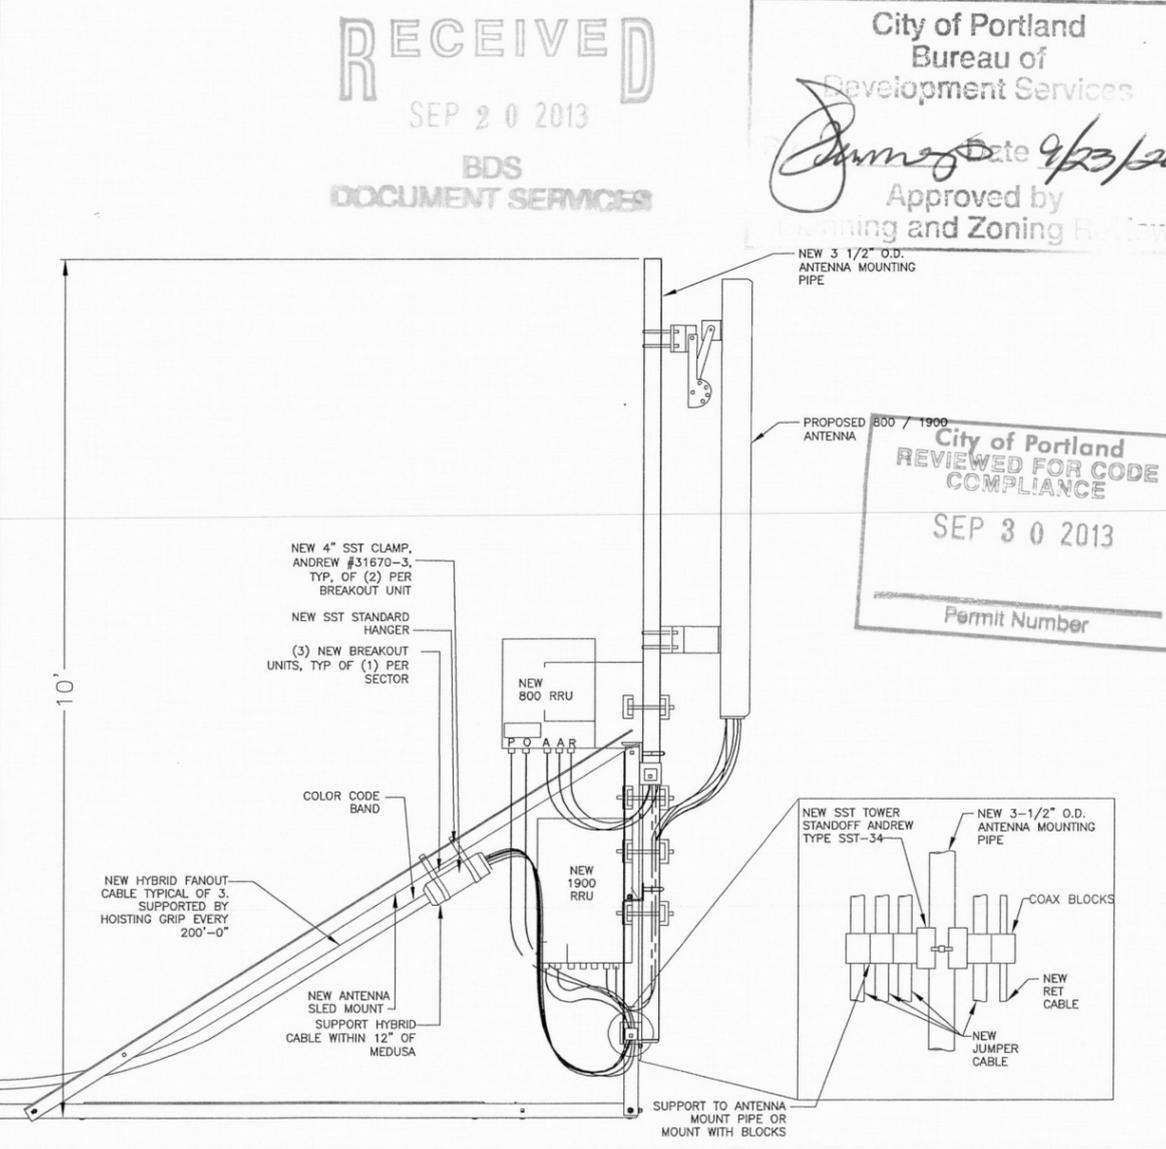

22"x34" SCALE: NOT TO SCALE  
 11"x17" SCALE: NOT TO SCALE  
**TYPICAL BOOM & STAND-OFF DETAIL** 6



**GENERAL DYNAMICS**  
 WIRELESS SERVICES



**POWDER RIVER**  
 Development Services, LLC  
 100 E. SHENANGO STREET  
 SHARPSVILLE, PA 16150  
 724.962.5999  
 www.powderriverdev.com

PROJECT INFORMATION:  
 NETWORK VISION MMBS LAUNCH

**BURLINGAME 2**  
 PO03XC067  
 9700 CAPITAL HWY  
 PORTLAND, OR 97219  
 MULTNOMAH, COUNTY

ISSUE DATE: 06-27-2013

ISSUED FOR: CONSTRUCTION DWGS


REVISIONS			
REV.	DATE	DESCRIPTION	INITIALS
A	08/22/12	ISSUED FOR CD's 90%	DM
B	08/30/12	ISSUED FOR CD's 100%	CCM
C	09/10/12	ISSUED FOR CD's FINALS	JED
D	05/24/13	ISSUED FOR REVISED CD's FINALS	CCM
E	06/27/13	ISSUED FOR REVISED CD's FINALS	JED



NOT FOR CONSTRUCTION UNLESS LABELED AS CONSTRUCTION SET



SHEET TITLE:  
**EQUIPMENT DETAILS**

SHEET NUMBER: **A-8**  
 REVISION: **E**  
 PRDS PROJ.NO. 1678-021112

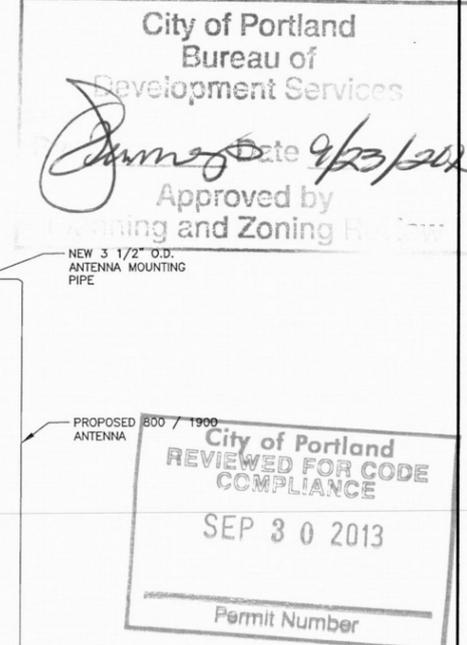

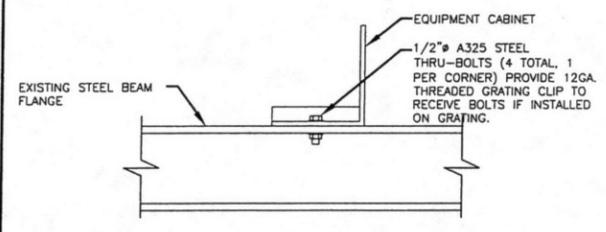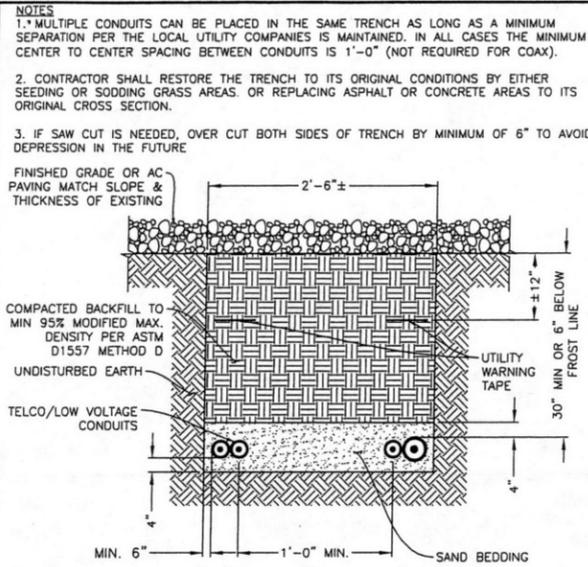

22"x34" SCALE: NOT TO SCALE  
11"x17" SCALE: NOT TO SCALE

**UTILITY TRENCH DETAIL**      1

22"x34" SCALE: NOT TO SCALE  
11"x17" SCALE: NOT TO SCALE

**CABINET ANCHOR DETAIL**      2

22"x34" SCALE: NOT TO SCALE  
11"x17" SCALE: NOT TO SCALE

**NOT USED**      3



**GENERAL DYNAMICS WIRELESS SERVICES**



**POWDER RIVER**  
Development Services, LLC  
100 E. SHENANGO STREET  
SHARPSVILLE, PA 16150  
724.962.5999  
www.powderriverdev.com

PROJECT INFORMATION:  
NETWORK VISION MMBS LAUNCH

**BURLINGAME 2**  
PO03XC067  
9700 CAPITAL HWY  
PORTLAND, OR 97219  
MULTNOMAH, COUNTY

ISSUE DATE: 06-27-2013

ISSUED FOR: CONSTRUCTION DWGS

REVISIONS			
REV.	DATE	DESCRIPTION	INITIALS
A	08/22/12	ISSUED FOR CDs 90%	DM
B	08/30/12	ISSUED FOR CDs 100%	CCM
C	09/10/12	ISSUED FOR CDs FINALS	JED
D	05/24/13	ISSUED FOR REVISED CDs FINALS	CCM
E	06/27/13	ISSUED FOR REVISED CDs FINALS	JED

NOT FOR CONSTRUCTION UNLESS LABELED AS CONSTRUCTION SET


LICENSURE:



SHEET TITLE EXPIRES: 12/31/2013




**EQUIPMENT DETAILS**

SHEET NUMBER: **A-9**      REVISION: **E**  
PROJ. NO. 1678-021112

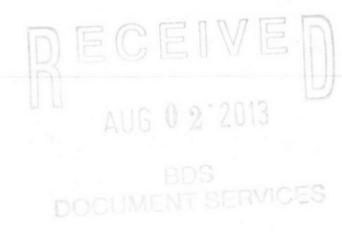

22"x34" SCALE: NOT TO SCALE  
11"x17" SCALE: NOT TO SCALE

**NOT USED**      4

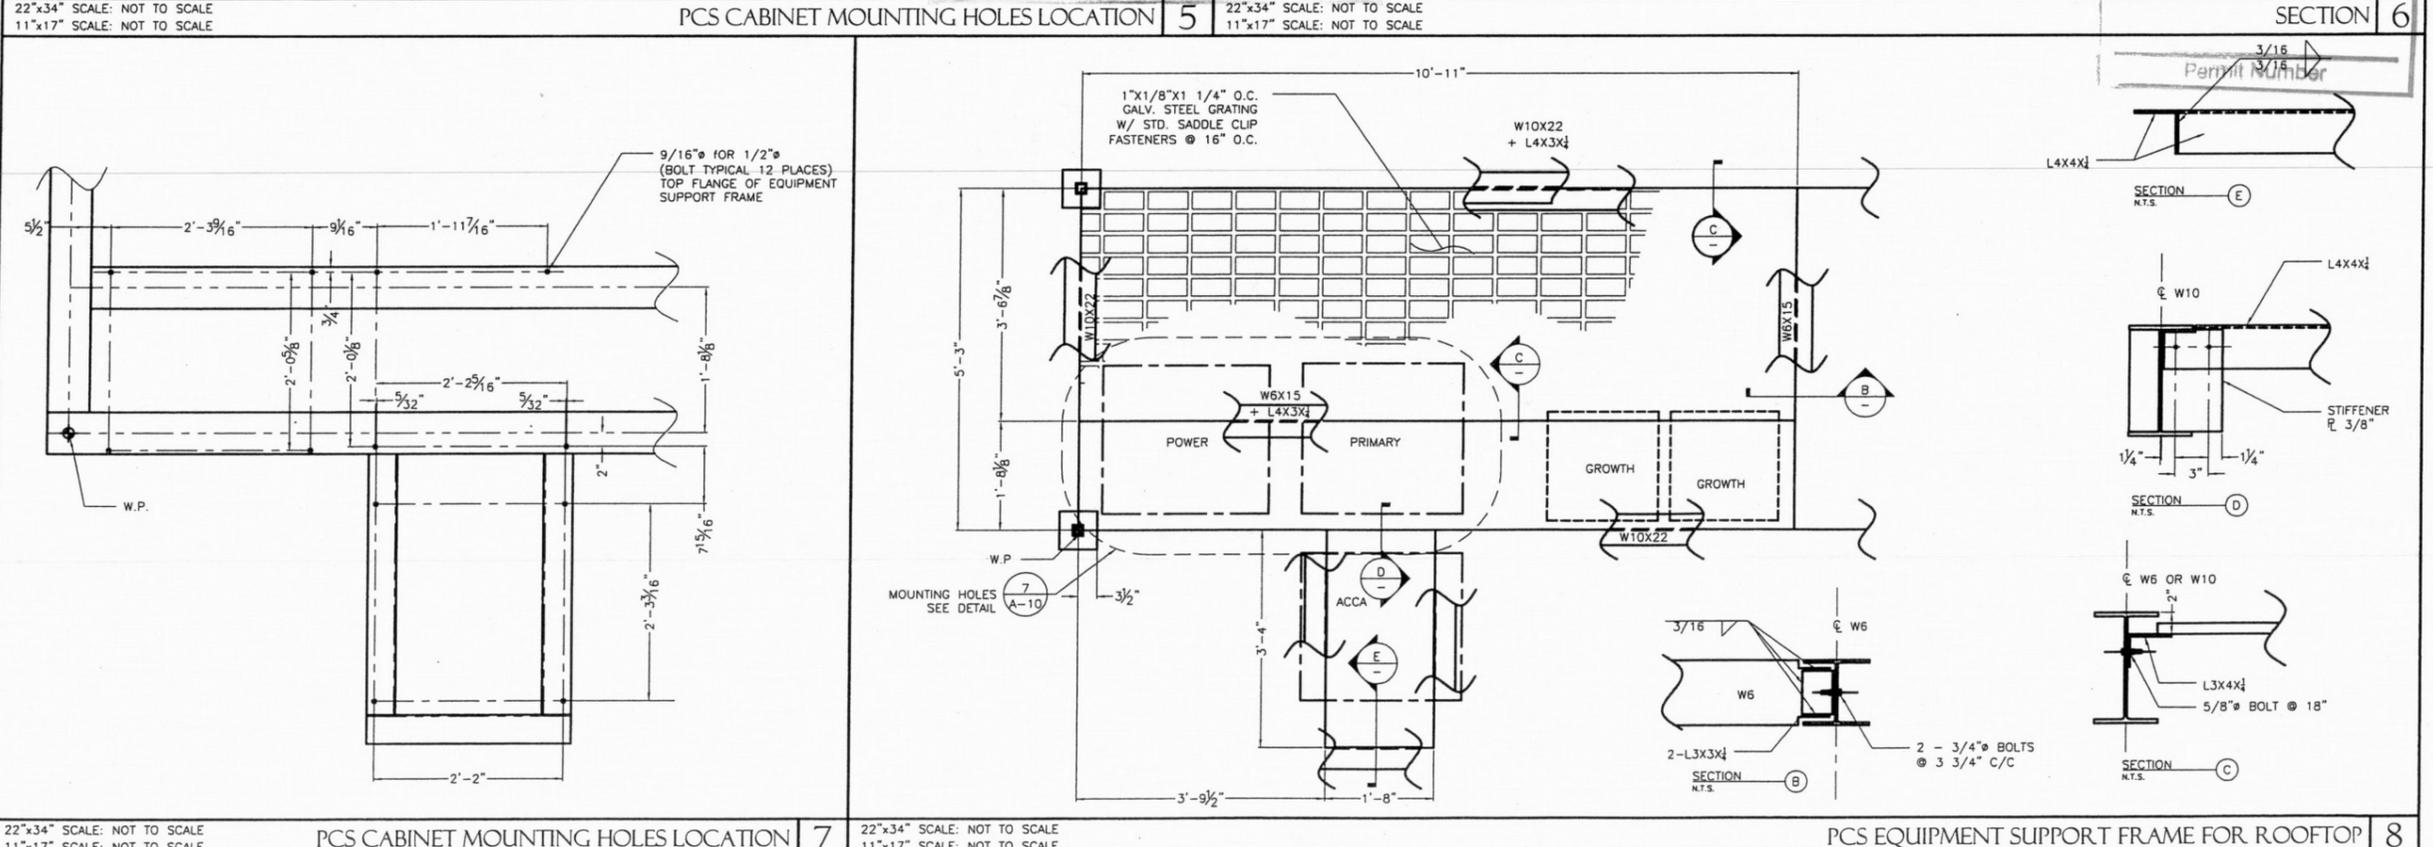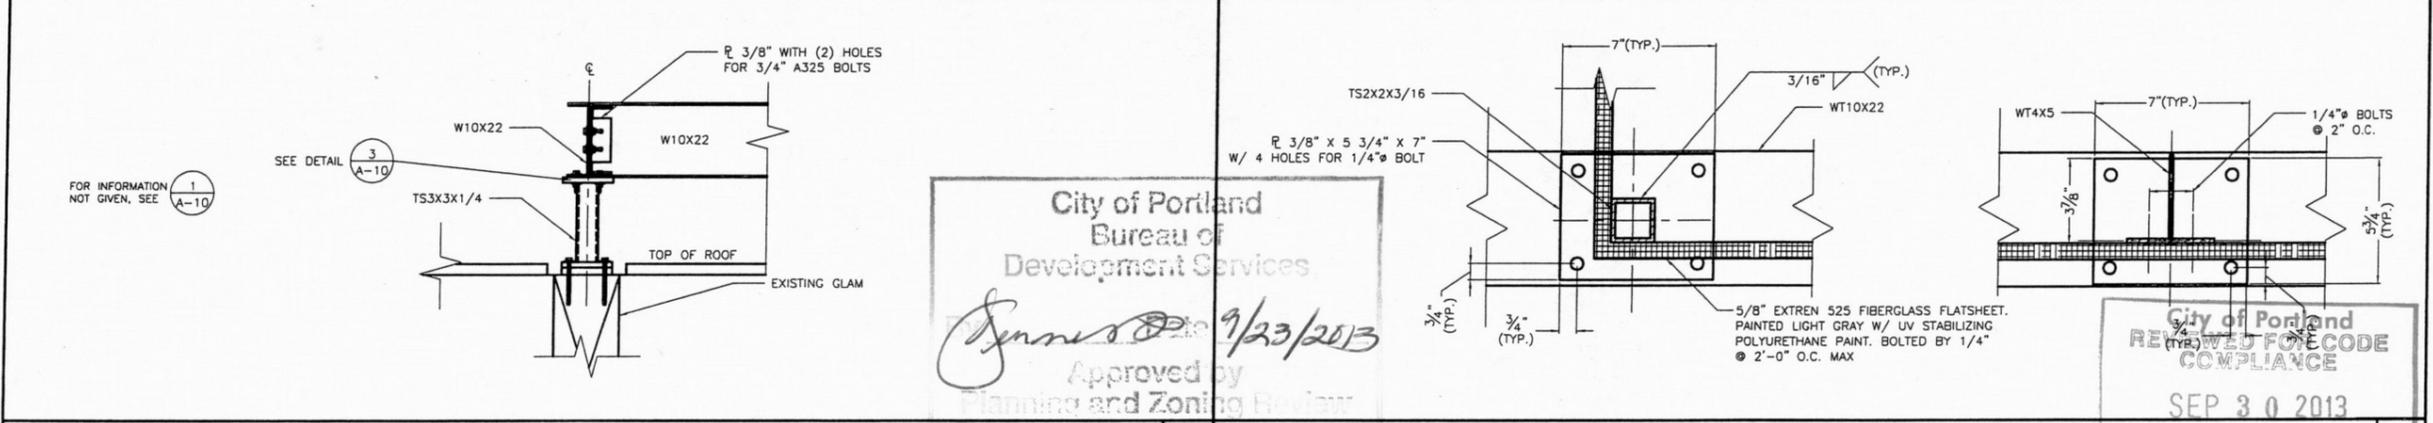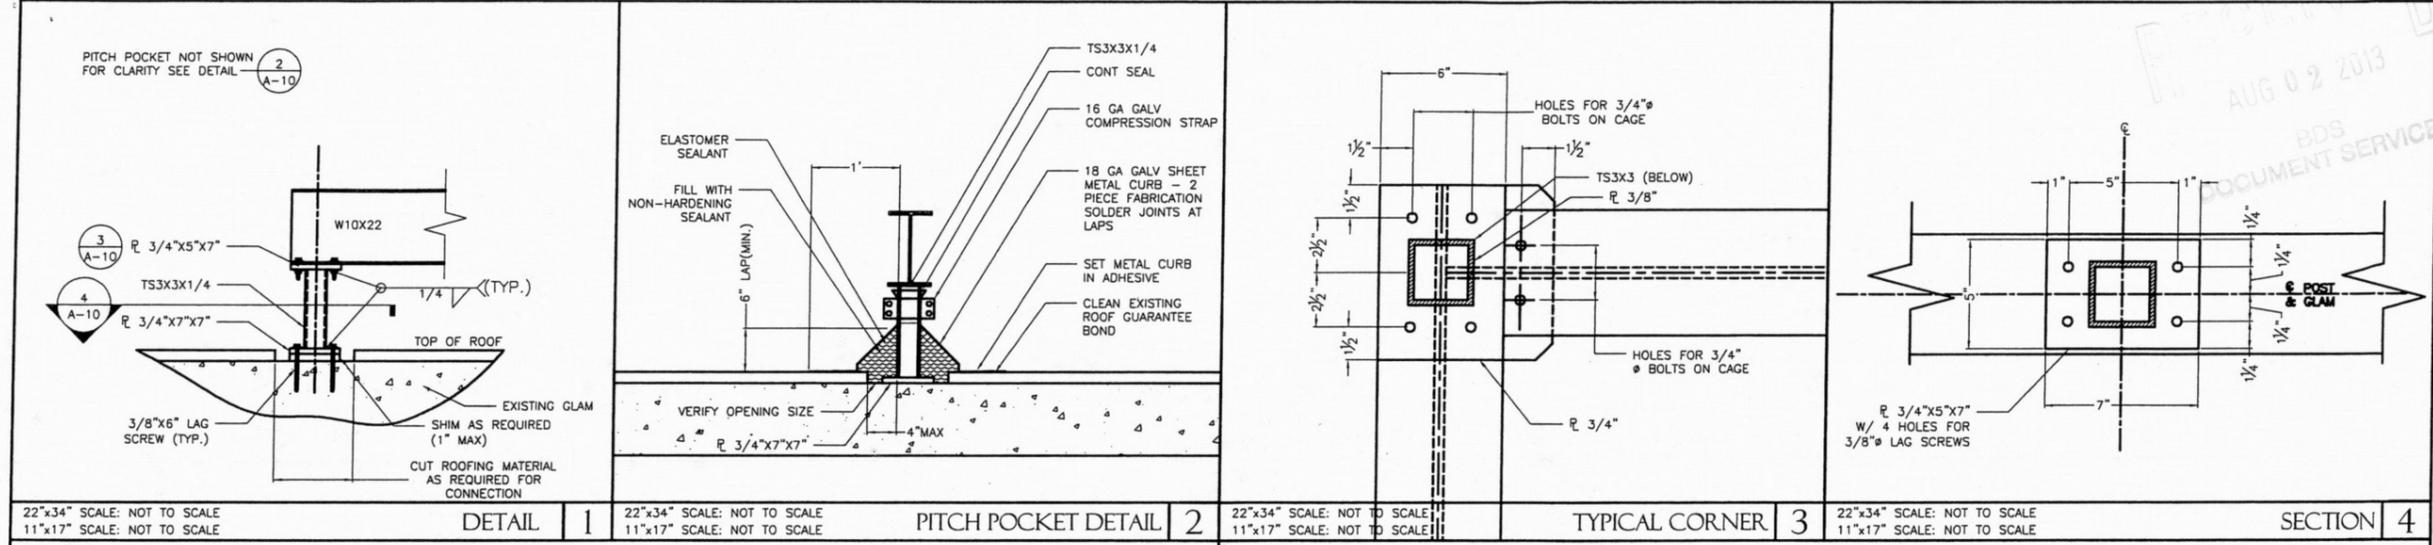

**GENERAL DYNAMICS**  
WIRELESS SERVICES

**POWDER RIVER**  
Development Services, LLC  
100 E. SHENANGO STREET  
SHARPSVILLE, PA 16150  
724.962.5999  
www.powderriverdev.com

PROJECT INFORMATION:  
NETWORK VISION MMBS LAUNCH  
**BURLINGAME 2**  
PO03XC067  
9700 CAPITAL HWY  
PORTLAND, OR 97219  
MULTNOMAH, COUNTY

ISSUE DATE: 06-27-2013

ISSUED FOR: CONSTRUCTION DWGS

REVISIONS			
REV.	DATE	DESCRIPTION	INITIALS
A	08/22/12	ISSUED FOR CD'S 90%	DM
B	08/30/12	ISSUED FOR CD'S 100%	CCM
C	09/10/12	ISSUED FOR CD'S FINALS	JED
D	05/24/13	ISSUED FOR REVISED CD'S FINALS	CCM
E	06/27/13	ISSUED FOR REVISED CD'S FINALS	JED

NOT FOR CONSTRUCTION UNLESS LABELED AS CONSTRUCTION SET


LICENSURE:  
  
FOR REFERENCE ONLY  
ORIGINAL DESIGN DONE BY:  
URS CONSULTANTS  
SEALED BY REGISTERED ENGINEER:  
JAMES H. STOHR

SHEET TITLE:  
**EQUIPMENT DETAILS**


SHEET NUMBER: **A-10**  
REVISION: **E**  
PROJ. NO. 1678-021112

City of Portland  
Bureau of  
Development Services  
Approved by  
Planning and Zoning


City of Portland  
REVIEWED FOR CODE  
COMPLIANCE  
SEP 30 2013

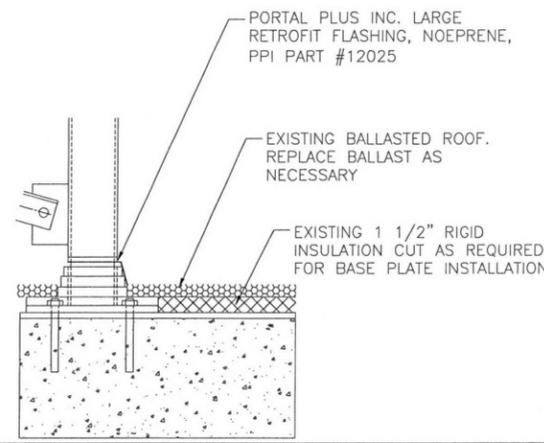


FLASHING @ POST BASE 1

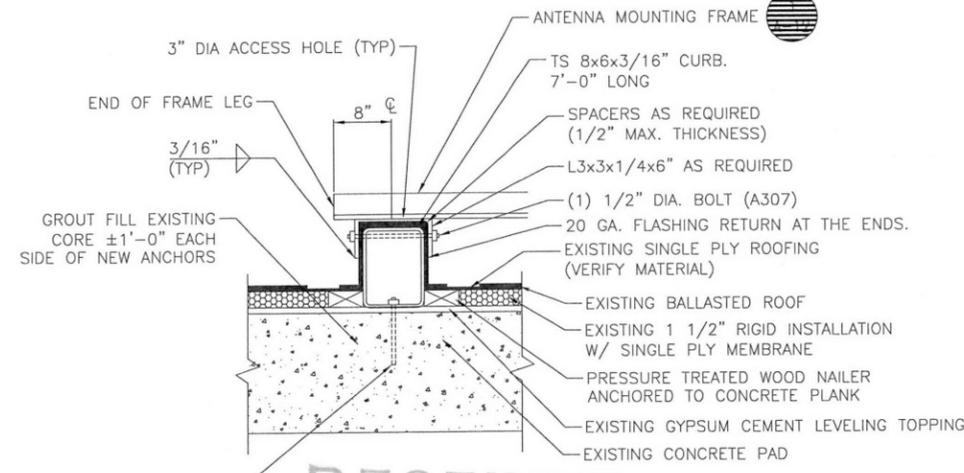

SECTION - ANTENNA FRAME 2

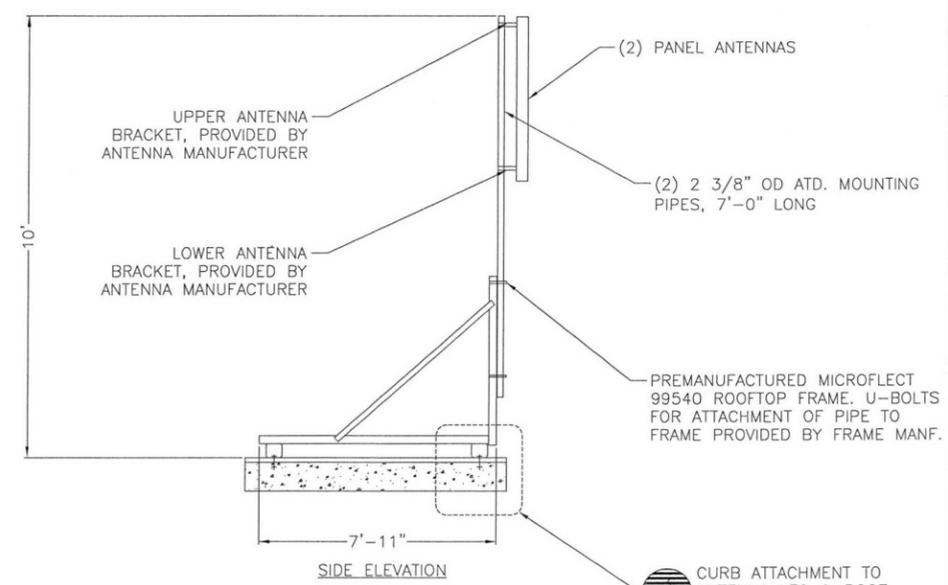


SIDE ELEVATION

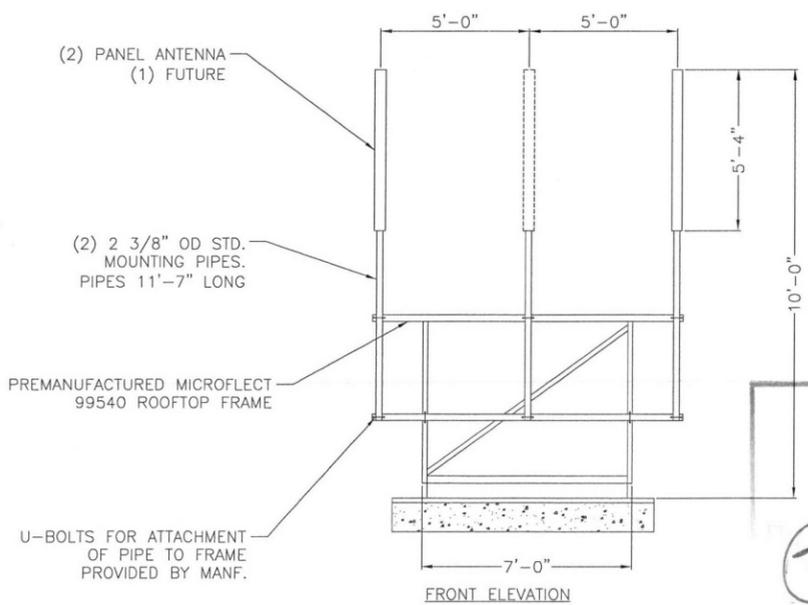

FRONT ELEVATION

22"x34" SCALE: NOT TO SCALE  
11"x17" SCALE: NOT TO SCALE

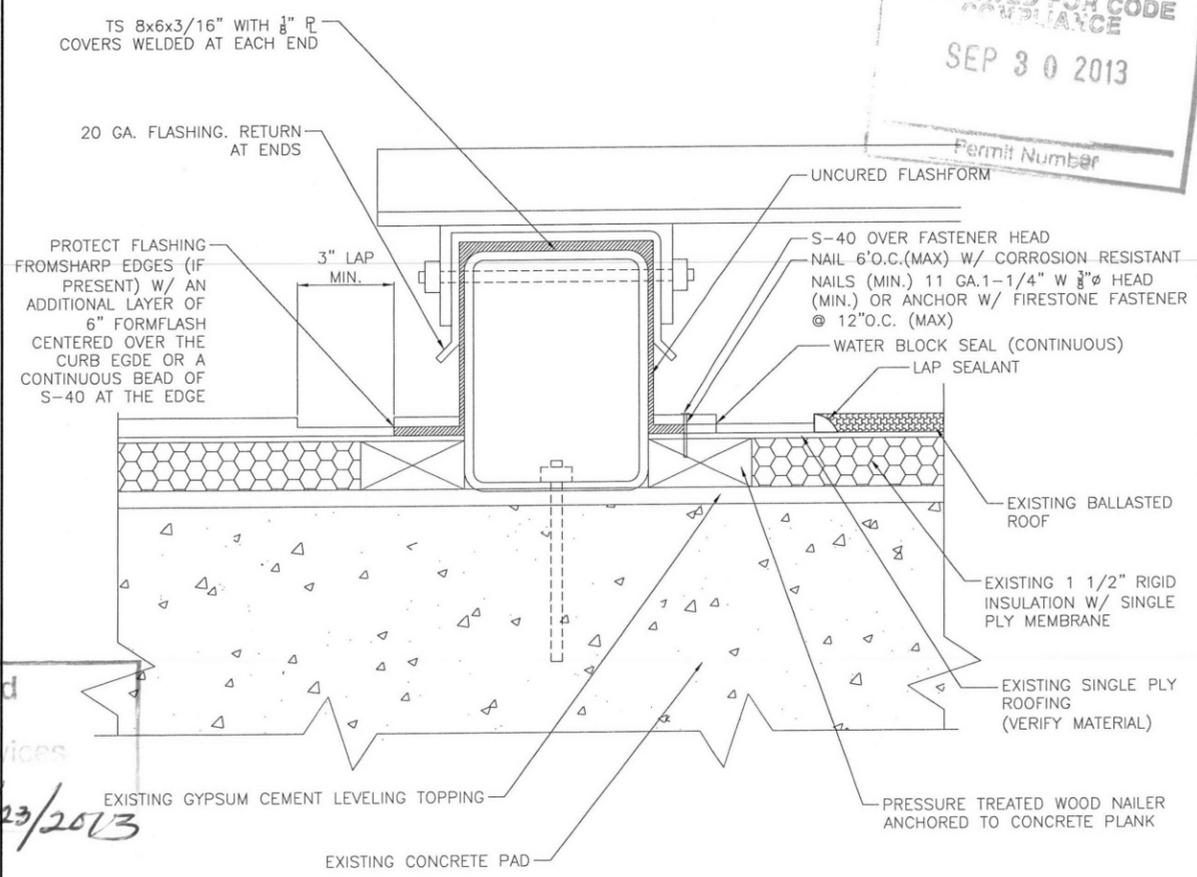

FLASHING @ EQUIPMENT CURB 4

City of Portland  
Bureau of  
Development Services  
Approved by  
Date 9/23/2013  
Planning and Zoning

ANTENNA MOUNTING FRAME 3

22"x34" SCALE: NOT TO SCALE  
11"x17" SCALE: NOT TO SCALE

22"x34" SCALE: NOT TO SCALE  
11"x17" SCALE: NOT TO SCALE

22"x34" SCALE: NOT TO SCALE  
11"x17" SCALE: NOT TO SCALE



GENERAL DYNAMICS  
WIRELESS SERVICES



POWDER RIVER  
Development Services, LLC  
100 E. SHENANGO STREET  
SHARPSVILLE, PA 16150  
724.962.5999  
www.powderriverdev.com

PROJECT INFORMATION:

NETWORK VISION MMBS LAUNCH

BURLINGAME 2

PO03XC067

9700 CAPITAL HWY  
PORTLAND, OR 97219  
MULTNOMAH, COUNTY

ISSUE DATE: 06-27-2013

ISSUED FOR: CONSTRUCTION DWGS

REVISIONS

REV.	DATE	DESCRIPTION	INITIALS
A	08/22/12	ISSUED FOR CDs 90%	DM
B	08/30/12	ISSUED FOR CDs 100%	CCM
C	09/10/12	ISSUED FOR CDs FINALS	JED
D	05/24/13	ISSUED FOR REVISED CDs FINALS	CCM
E	06/27/13	ISSUED FOR REVISED CDs FINALS	JED

NOT FOR CONSTRUCTION UNLESS  
LABELED AS CONSTRUCTION SET



SHEET TITLE:

EQUIPMENT DETAILS

SHEET NUMBER: A-11 REVISION: E

A-11

E

PRDS PROJ. NO.  
1678-021112

SECTOR	FIRST RING	SECOND RING	THIRD RING
A	GREEN	NO TAPE	NO TAPE
B	GREEN	GREEN	NO TAPE
G	GREEN	GREEN	GREEN

FREQUENCY COLOR CODE	FIRST RING	SECOND RING
800 MHz	YELLOW	GREEN
1900 MHz	YELLOW	RED

FREQUENCY	ANTENNA PORT	RRU PORT	CABLE COLOR
800 MHz	RET	RET	N/A
	800 MHz +45°	ANT 1	WHITE
	800 MHz -45°	ANT 0	BLUE
1900 MHz	PCS1 -45°	ANT 0	BLUE
	PCS1 +45°	ANT 1	WHITE
	PCS2 -45°	ANT 2	GREEN
	PCS2 +45°	ANT 3	BROWN
	RET	RET	RED

SUPPLIER	SAMSUNG FIBEROPTICS					ASIA TAI				
	LENGTH (FT)	TOTAL WEIGHT (KG)	WEIGHT/LF (LBS)	WEIGHT/LF (KG)	WEIGHT/LF (LBS)	TOTAL WEIGHT (KG)	WEIGHT/LF (LBS)	WEIGHT/LF (KG)	WEIGHT/LF (LBS)	
TYPE 1	60	13	28	0.2	0.5	19	41	0.3	0.7	
	75	16	35	0.2	0.5	22	49	0.3	0.7	
	90	19	42	0.2	0.5	26	57	0.3	0.7	
	105	30	66	0.3	0.6	29	65	0.3	0.7	
	120	34	75	0.3	0.6	33	73	0.3	0.7	
TYPE 2	135	38	85	0.3	0.6	46	101	0.3	0.7	
	150	43	94	0.3	0.6	51	112	0.3	0.7	
	165	47	104	0.3	0.6	55	122	0.3	0.7	
	180	69	151	0.4	0.8	72	160	0.3	0.7	
	195	75	164	0.4	0.8	78	173	0.3	0.7	
TYPE 3	210	80	177	0.4	0.8	85	187	0.3	0.7	
	225	89	196	0.4	0.9	102	224	0.3	0.7	
	240	95	209	0.4	0.9	109	239	0.3	0.7	
	255	101	222	0.4	0.9	115	254	0.3	0.7	
	270	133	293	0.5	1.1	122	270	0.3	0.7	
TYPE 4	285	141	310	0.5	1.1	152	335	0.3	0.7	
	300	148	326	0.5	1.1	160	353	0.3	0.7	
	315	155	342	0.5	1.1	168	371	0.3	0.7	
	330	163	359	0.5	1.1	176	388	0.3	0.7	


	TYPE 1	TYPE 2	TYPE 3	TYPE 4	TYPE 5	TYPE 6	TYPE 7
TOTAL LENGTH	~114'-9.95"	~180'-5.35"	~213'-3.05"	~262'-5.60"	~328'-1"	~420'-0"	~550'-0"
HYBRID POWER CABLE CONFIGURATION	AWG 10 1 PAIR, AWG 12 3 PAIR	AWG 8 1 PAIR, AWG 10 3 PAIR	AWG 6 1 PAIR, AWG 8 1 PAIR, AWG 10 2 PAIR	AWG 6 1 PAIR, AWG 8 3 PAIR	AWG 4 1 PAIR, AWG 6 1 PAIR, AWG 8 2 PAIR	AWG 4 1 PAIR, AWG 6 3 PAIR	AWG 2 1 PAIR, AWG 4 3 PAIR
CABLE DIAMETER	0.98"	1.06"	1.18"	1.18"/1.25"	1.25"	1.56"	1.69"
BENDING RADIUS	11.81"	12.99"	15.35"	17.71"	17.71"	18.00"/30.00"	21.00"/35.00"
OPTIC CABLE	LC/PC-to-LC/PC, SINGLE MODE						
DU CABINET (POWER CABLE TERMINAL MAX SIZE AWG 4)	2 PAIR POWER AND OPTIC CABLE WITH PE PIPE						
RRU POWER CABLE SPEC	AWG 8, 0.57"-0.60"			8 AWG CABLES 4 PAIRS			
NON OPTIC CABLE AND OPTIC CABLE PROTECTION	2 PAIR POWER AND OPTIC CABLE WITH PE PIPE	2 PAIR POWER AND OPTIC CABLE WITH PE PIPE	2 PAIR POWER AND OPTIC CABLE WITH PE PIPE	2 PAIR POWER AND OPTIC CABLE WITH PE PIPE	2 PAIR POWER AND OPTIC CABLE WITH PE PIPE	2 PAIR POWER AND OPTIC CABLE WITH PE PIPE	2 PAIR POWER AND OPTIC CABLE WITH PE PIPE

SUPPLIER	TESSCO		
TYPE	LENGTH (FT)	TOTAL WEIGHT (KG)	TOTAL WEIGHT (LBS)
TYPE 6	1	0.73	1.6
	1000	732	1613
TYPE 7	1	1	2.2
	1000	1006	2218


NOTES:  
ON HIGH CAPACITY SITES OR ON FOUR-SECTOR SITES NEEDING AN ADDITIONAL LINE AND RRU CONTACT GDT SITE SUPERVISOR FOR COLOR CODE INFORMATION ON ADDITIONAL LINES.

22"x34" SCALE: NOT TO SCALE  
11"x17" SCALE: NOT TO SCALE

22"x34" SCALE: NOT TO SCALE  
11"x17" SCALE: NOT TO SCALE

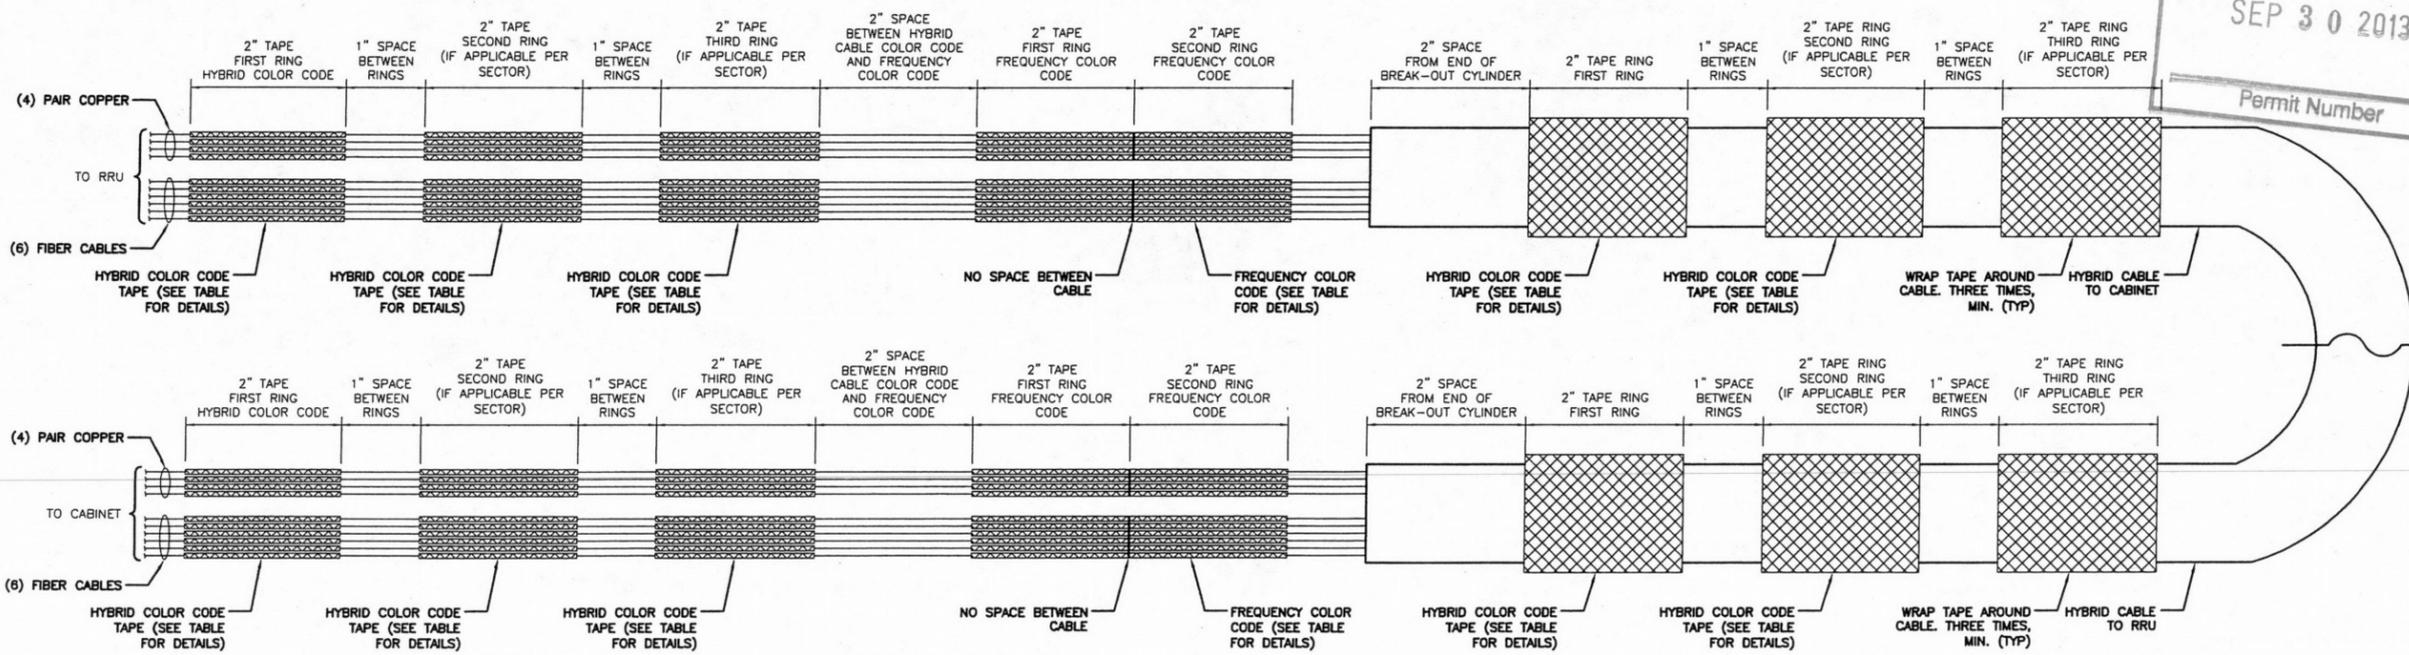

HYBRID CABLE CONNECTION AT CABINET

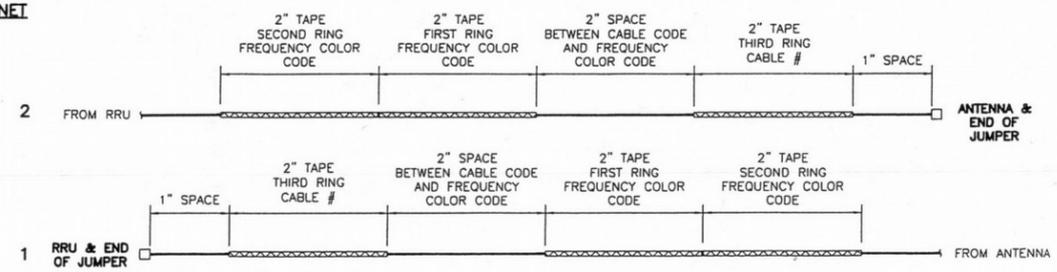

JUMPER CABLE CONNECTION AT RRU AND ANTENNA

- NOTE:
- ALL CABLES SHALL BE MARKED AT THE TOP AND BOTTOM WITH 2" COLORED TAPE OR STENCIL TAG. COLOR TAPE SHALL BE OBTAINED FROM GRAYBAR ELECTRIC.
  - THE FIRST RING SHALL BE CLOSEST TO THE END OF THE CABLE AND SPACED APPROXIMATELY 2" FROM AN END CONNECTOR, WEATHERPROOFING, OR BREAK-OUT CYLINDER, WITH 1" SPACE BETWEEN EACH RING.
  - THE HYBRID CABLE COLOR SHALL BE APPLIED IN ACCORDANCE WITH THE "TYPICAL HYBRID CABLE COLOR CODE" TABLE ABOVE FOR THE RESPECTIVE SECTOR.
  - INDIVIDUAL POWER PAIRS AND FIBER CABLES SHALL BE LABELED WITH BOTH THE HYBRID CABLE COLOR FOR THE RESPECTIVE SECTOR AND A FREQUENCY COLOR CODE IN ACCORDANCE WITH THE "FREQUENCY COLOR CODE FOR PAIRS AND FIBER CABLES OF HYBRID CABLE" TABLE ABOVE.
  - A 2" GAP SHALL SEPARATE THE HYBRID CABLE COLOR CODE FROM THE FREQUENCY COLOR CODE.
  - THE 2" COLOR RINGS FOR THE FREQUENCY COLOR SHALL BE PLACED NEXT TO EACH OTHER WITH NO SPACES.
  - THE 2" COLORED TAPE(S) SHALL EACH BE WRAPPED A MINIMUM OF 3 TIMES AROUND THE HYBRID CABLE OR INDIVIDUAL CABLES, AND THE TAPE SHALL BE KEPT IN THE SAME LOCATION AS MUCH AS POSSIBLE.
  - COLOR BAND ON JUMPERS SHALL BE 2" WIDE WITH A 2" SPACE.

City of Portland  
Bureau of  
Development Services  
Approved by  
9/23/2013  
Planning and Zoning

RECEIVED  
AUG 02 2013  
BDS  
DOCUMENT SERVICES



GENERAL DYNAMICS  
WIRELESS SERVICES



POWDER RIVER  
Development Services, LLC  
100 E. SHENANGO STREET  
SHARPSVILLE, PA 16150  
724.962.5999  
www.powderriverdev.com

PROJECT INFORMATION:  
NETWORK VISION MMBS LAUNCH


BURLINGAME 2  
PO03XC067  
9700 CAPITAL HWY  
PORTLAND, OR 97219  
MULTNOMAH, COUNTY

ISSUE DATE: 06-27-2013

ISSUED FOR: CONSTRUCTION DWGS

REV.	DATE	DESCRIPTION	INITIALS
A	08/22/12	ISSUED FOR CDs 90%	DM
B	08/30/12	ISSUED FOR CDs 100%	CCM
C	09/10/12	ISSUED FOR CDs FINALS	JED
D	05/24/13	ISSUED FOR REVISED CDs FINALS	CCM
E	06/27/13	ISSUED FOR REVISED CDs FINALS	JED

NOT FOR CONSTRUCTION UNLESS LABELED AS CONSTRUCTION SET

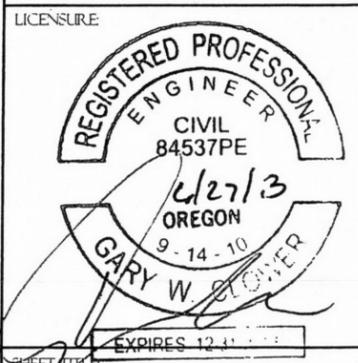

ANTENNA AND CABLE  
COLOR CODING DETAILS

SHEET NUMBER: RF-1  
REVISION: E  
PRDS PROJ NO 1678-021112

22"x34" SCALE: NOT TO SCALE  
11"x17" SCALE: NOT TO SCALE

HYBRID CABLE COLOR SCHEME DETAIL

3

**ELECTRICAL NOTES**

- ALL ELECTRICAL WORK SHALL BE DONE IN ACCORDANCE WITH CURRENT NATIONAL ELECTRICAL CODES AND ALL LOCAL AND STATE CODE, LAWS, AND ORDINANCES. PROVIDE ALL COMPONENTS AND WIRING SIZES AS REQUIRED TO MEET NEC STANDARDS.
- CONTRACTOR SHALL COORDINATE WITH LOCAL POWER COMPANY FOR REQUIREMENTS OF POWER SERVICE LINE TO THE METER BASE, WHEN REQUIRED. POWER SERVICE REQUIREMENT IS COMMERCIAL AC NOMINAL 120/208 VOLT OR 120/240 VOLT, SINGLE PHASE WITH 200 AMP RATING.
- CONTRACTOR SHALL COORDINATE WITH LOCAL TELEPHONE COMPANY FOR SERVICE LINE REQUIREMENTS TO TERMINATE AT THE PPC CABINET.
- CONTRACTOR SHALL FURNISH AND INSTALL ELECTRIC METER BASE AND 200A DISCONNECT SWITCH PER SITE PLAN DETAIL DRAWINGS AND PER LOCAL UTILITY COMPANIES SPECIFICATION, WHEN REQUIRED. THE METER BASE SHOULD BE LOCATED IN A MANNER WHERE ACCESSIBLE BY THE LOCAL POWER COMPANY.
- LOCAL POWER COMPANY SHALL PROVIDE 200 AMP ELECTRIC METER. CONTRACTOR SHALL COORDINATE INSTALLATION OF METER WITH LOCAL POWER COMPANY.
- UNDERGROUND POWER AND TELCO SERVICE LINES SHALL BE ROUTED IN A COMMON TRENCH. ALL UNDERGROUND CONDUIT SHALL BE PVC SCHEDULE 40 AND CONDUIT EXPOSED ABOVE GROUND SHALL BE GALVANIZED RIGID STEEL TUBING UNLESS OTHERWISE INDICATED.
- ALL TELCO CONDUIT LINES SHALL BE 4" SCH. 40 PVC CONDUIT UNLESS OTHERWISE INDICATED. THE TELCO CONDUIT FROM THE PPC SHALL BE ROUTED AND TERMINATED AT DESIGNATED TELCO DEMARCATION OR 2-FEET OUTSIDE FENCED AREA, NEAR UTILITY POLE (IN FENCED AREA), OR END CAP OFF AND PROVIDE MARKER STAKE PAINTED BRIGHT ORANGE WITH DESIGNATION FOR TELCO SERVICE.
- CONDUITS INSTALLED AT PCS EQUIPMENT ENDS PRIOR TO THE EQUIPMENT INSTALLATION SHALL BE STUBBED AND CAPPED AT 6" ABOVE GRADE OR PLATFORM. IF SERVICE LINES CAN'T BE INSTALLED INITIALLY, PROVIDE NYLON PULL CORD IN CONDUITS.
- THE SPRINT CABINET, INCLUDING 200 AMP LOAD PANEL AND TELCO PANEL, SHALL BE PROVIDED BY OWNER AND INSTALLED BY THE CONTRACTOR. CONTRACTOR IS TO INSTALL BREAKER(S) NOT PROVIDED BY MANUFACTURER. SEE PANEL SCHEDULE ON THIS SHEET FOR BREAKER REQUIREMENTS.
- LOCATION OF ELECTRIC METER AND DISCONNECT SWITCH TO BE PROVIDED BY GENERAL CONTRACTOR.
- CONTRACTOR SHALL INSPECT THE EXISTING CONDITIONS PRIOR TO SUBMITTING BID. ANY QUESTIONS ARISING DURING THE BID PERIOD IN REGARDS TO THE CONTRACTORS FUNCTIONS, THE SCOPE OF WORK, OR ANY OTHER ISSUE RELATED TO THIS PROJECT SHALL BE BROUGHT UP DURING THE BID PERIOD WITH THE PROJECT MANAGER FOR CLARIFICATION, NOT AFTER THE CONTRACT HAS BEEN AWARDED.
- LOCATION OF EQUIPMENT, CONDUIT AND DEVICES SHOWN ON THE DRAWINGS ARE APPROXIMATE AND SHALL BE COORDINATED WITH FIELD CONDITIONS PRIOR TO ROUGH-IN.
- THE CONDUIT RUNS AS SHOWN ON THE PLANS ARE APPROXIMATE. EXACT LOCATION AND ROUTING SHALL BE PER EXISTING FIELD CONDITIONS.
- PROVIDE PULL BOXES AND JUNCTION BOXES WHERE SHOWN OR REQUIRED BY NEC.

22"x34" SCALE: NOT TO SCALE  
11"x17" SCALE: NOT TO SCALE

**ELECTRICAL NOTES (CON'T)**

- ALL CONDUITS SHALL BE MET WITH BENDS MADE IN ACCORDANCE WITH NEC TABLE 346-10. NO RIGHT ANGLE DEVICE OTHER THAN STANDARD CONDUIT ELBOWS WITH 12" MINIMUM INSIDE SWEEPS FOR ALL CONDUITS 2" OR LARGER.
- ALL CONDUIT TERMINATIONS SHALL BE PROVIDED WITH PLASTIC THROAT INSULATING GROUNDING BUSHINGS.
- ALL WIRE SHALL BE TYPE THWN, SOLID, ANNEALED COPPER UP TO SIZE 1/10 AWG (18 AND LARGER SHALL BE CONCENTRIC STRANDED) 75 DEGREE C, (167 DEGREES F), 98" CONDUCTIVITY, MINIMUM #12.
- ALL WIRES SHALL BE TAGGED AT ALL PULL BOXES, J-BOXES, EQUIPMENT BOXES AND CABINETS WITH APPROVED PLASTIC TAGS, ACTION CRAFT, BRADY, OR APPROVED EQUAL.
- ALL NEW MATERIAL SHALL HAVE A U.L. LABEL.
- CONDUIT ROUGH-IN SHALL BE COORDINATED WITH THE MECHANICAL EQUIPMENT TO AVOID LOCATION TO CONFLICTS. VERIFY WITH MECHANICAL CONTRACTOR AND COMPLY AS REQUIRED.
- ALL PANEL DIRECTORIES SHALL BE TYPEWRITTEN NOT HAND WRITTEN.
- INSTALL AN EQUIPMENT GROUNDING CONDUCTOR IN ALL CONDUITS PER THE SPECIFICATIONS AND NEC. THE EQUIPMENT GROUNDING CONDUCTORS SHALL BE BONDED AT ALL JUNCTION BOXES, PULLBOXES, AND ALL DISCONNECT SWITCHES, STARTERS, AND EQUIPMENT CABINETS.
- THE CONTRACTOR SHALL PREPARE AS-BUILT DRAWINGS. DOCUMENT ANY AND ALL WIRING AND EQUIPMENT CONDITIONS AND CHANGES WHILE COMPLETING THIS CONTRACT. SUBMIT AT SUBSTANTIAL COMPLETION.
- ALL DISCONNECT SWITCHES AND OTHER CONTROLLING DEVICES SHALL BE PROVIDED WITH ENGRAVED PHENOLIC NAMEPLATES INDICATING EQUIPMENT CONTROLLED, BRANCH CIRCUITS INSTALLED ON, AND PANEL FIELD LOCATIONS FED FROM (NO EXCEPTIONS.) PROVIDE SAMPLE FOR CONSTRUCTION MANAGER'S APPROVAL.
- ALL ELECTRICAL DEVICES AND INSTALLATIONS OF THE DEVICES SHALL COMPLY WITH (ADA) AMERICANS WITH DISABILITIES ACT AS ADOPTED BY THE APPLICABLE STATE.
- PROVIDE CORE DRILLING AS NECESSARY FOR PENETRATIONS OR RISERS THROUGH BUILDING. DO NOT PENETRATE STRUCTURAL MEMBERS WITHOUT CONSTRUCTION MANAGERS APPROVAL. SLEEVES AND/OR PENETRATIONS IN FIRE RATED CONSTRUCTION SHALL BE PACKED WITH FIRE RATED MATERIAL WHICH SHALL MAINTAIN THE FIRE RATING OF THE WALL OR STRUCTURE. FILL FOR FLOOR PENETRATIONS SHALL PREVENT PASSAGE OF WATER, SMOKE, FIRE AND FUMES. ALL MATERIAL SHALL BE UL APPROVED FOR THIS PURPOSE.
- ELECTRICAL CHARACTERISTICS OF ALL EQUIPMENT (NEW AND EXISTING) SHALL BE FIELD VERIFIED WITH THE OWNER'S REPRESENTATIVE AND EQUIPMENT SUPPLIER PRIOR TO ROUGH-IN OF CONDUIT AND WIRE. ALL EQUIPMENT SHALL BE PROPERLY CONNECTED ACCORDING TO THE NAMEPLATE DATA FURNISHED ON THE EQUIPMENT (THE DESIGN OF THESE PLANS ARE BASED UPON BEST AVAILABLE INFORMATION AT THE TIME OF DESIGN AND SOME EQUIPMENT CHARACTERISTICS MAY VARY FROM DESIGN AS SHOWN ON THESE DRAWINGS).
- LOCATION OF ALL OUTLET, BOXES, ETC., AND THE TYPE OF CONNECTION (PLUG OR DIRECT) SHALL BE CONFIRMED WITH THE OWNER'S REPRESENTATIVE PRIOR TO ROUGH-IN.

ELECTRICAL NOTES | 1

SITE NUMBER:	T.B.D.	MODEL NUMBER:	TBD	WIRE:	3
VOLTAGE:	240V/120	PHASE:	1	A/C:	YES
MAIN BREAKER:	200 AMP	BUSS RATING:	200 AMPS	GROUND BAR:	FIELD VERIFY
MOUNT:	SURFACE	NEUTRAL BAR:	YES		
ENCLOSURE TYPE:	NEMA 3R	N to GROUND BOND:	FIELD VERIFY		
PANEL STATUS:	EXISTING	INTERNAL TVSS:	YES		




  

GKT	LOAD DESCRIPTION	BREAKER AMPS	BREAKER POLES	BREAKER STATUS	BREAKER STATUS	BREAKER POLES	BREAKER AMPS	LOAD DESCRIPTION	GKT
1	BTS	100	2	ON	ON	2	60	SURGE PROTECTION	2
3	---	---	---	ON	ON	---	---	---	4
5	BLANK	---	---	N/A	ON	1	10	TELCO FAN	6
7	SAMSUNG MMBS CABINET	100	2	NEW	ON	1	20	GFCI	8
9	---	---	---	NEW	ON	1	20	LIGHT	10
11	SAMSUNG BBU CABINET	15	1	NEW	N/A	---	---	BLANK	12
13	BLANK	---	---	N/A	N/A	---	---	BLANK	14
15	BLANK	---	---	N/A	N/A	---	---	BLANK	16
17	BLANK	---	---	N/A	N/A	---	---	BLANK	18
19	BLANK	---	---	N/A	N/A	---	---	BLANK	20
21	BLANK	---	---	N/A	N/A	---	---	BLANK	22
23	BLANK	---	---	N/A	N/A	---	---	BLANK	24

**NOTES**

GENERAL CONTRACTOR TO CHECK REQUIREMENTS WITH LOCAL POWER COMPANY AND JURISDICTION. ADDITIONAL SUB PANEL OFF THE PPC CABINET MIGHT BE REQUIRED TO FEED NEW NETWORK VISION EQUIPMENT.

ELECTRICAL PANEL SCHEDULE | 2

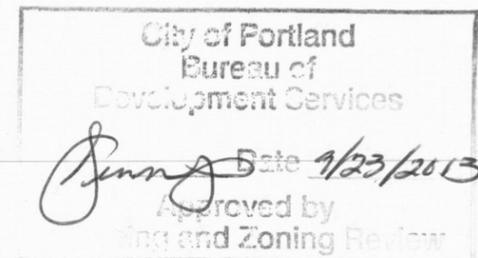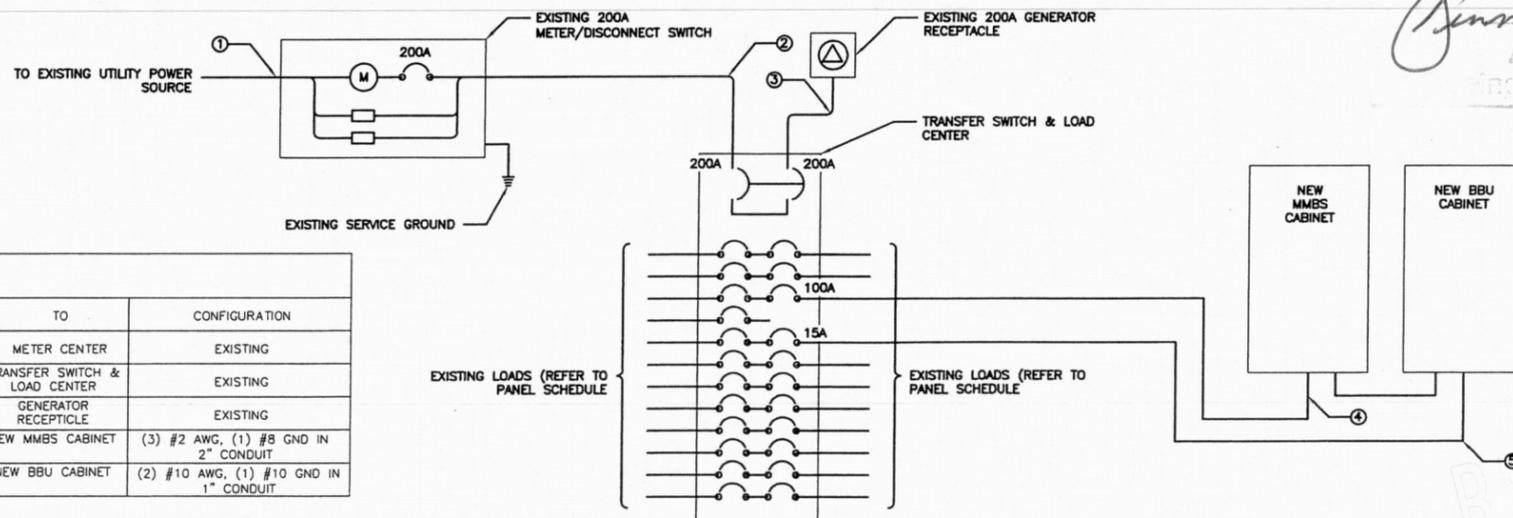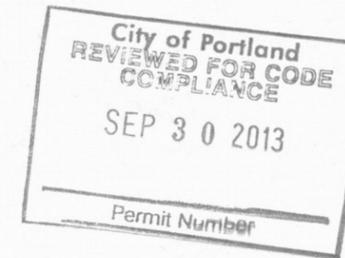

ELECTRICAL ONE-LINE DIAGRAM | 3

22"x34" SCALE: NOT TO SCALE  
11"x17" SCALE: NOT TO SCALE



**GENERAL DYNAMICS**  
WIRELESS SERVICES



**POWDER RIVER**  
Development Services, LLC  
100 E. SHENANGO STREET  
SHARPSVILLE, PA 16150  
724.962.5999  
www.powderriverdev.com

**PROJECT INFORMATION:**

NETWORK VISION MMBS LAUNCH

**BURLINGAME 2**

PO03XC067  
9700 CAPITAL HWY  
PORTLAND, OR 97219  
MULTNOMAH, COUNTY

ISSUE DATE: 06-27-2013


ISSUED FOR: CONSTRUCTION DWGS

**REVISIONS**

REV.	DATE	DESCRIPTION	INITIALS
A	08/22/12	ISSUED FOR CD's 90%	DM
B	08/30/12	ISSUED FOR CD's 100%	CCM
C	09/10/12	ISSUED FOR CD's FINALS	JED
D	05/24/13	ISSUED FOR REVISED CD's FINALS	CCM
E	06/27/13	ISSUED FOR REVISED CD's FINALS	JED

NOT FOR CONSTRUCTION UNLESS LABELED AS CONSTRUCTION SET


**LICENSURE**

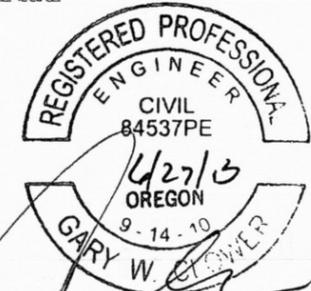

ONE-LINE DIAGRAM & POWER PANEL SCHED.

SHEET NUMBER: E-1 REVISION: E

PROJ PROJ NO 1678-021112

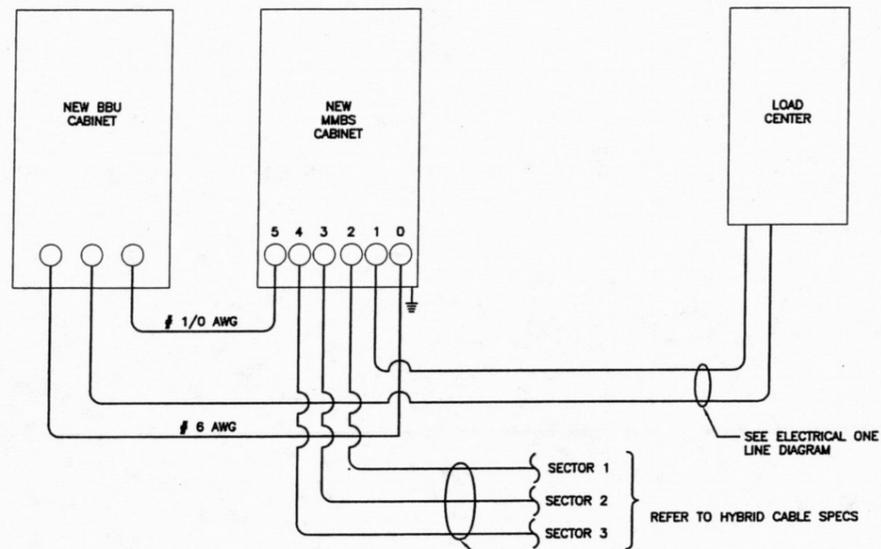

MMBS PORT LAYOUT	
CONDUIT NO	USAGE
0	BATTERY
1	AC/GROUND
2	RRU SECTOR 1
3	RRU SECTOR 2
4	RRU SECTOR 3
5	BATTERY

**DC POWER ELECTRICAL NOTES:**


1. MINIMUM CABLE LENGTH BETWEEN THE OU AND BATTERY IS 70MM (2.75 in)
2. MAXIMUM CABLE LENGTH DISTANCE IS 900mm (35.43 in). WEATHER PROOFING SHALL INCORPORATE PPC WEATHERPROOFING TAPE KIT, COLD SHRINK SHALL NOT BE USED.
3. ROUTE DC CONDUCTORS IN CONDUITS TO NEW MMBS CABINET 48VDC POWER DISTRIBUTION PANEL TO AND FROM NEW BBU CABINET.
4. -48 VDC CABLES BETWEEN NEW MMBS CABINET & RRU'S ARE FACTORY ASSEMBLED AND EQUIPPED WITH ONE PRE-TERMINATED END.
5. ALL FIELD INSTALLED DC CABLING SHALL BE TYPE RHH/RHW AND SHALL BE UL THERMOSET INSULATED.

22"x34" SCALE: NOT TO SCALE  
11"x17" SCALE: NOT TO SCALE

DC POWER DIAGRAM 1

22"x34" SCALE: NOT TO SCALE  
11"x17" SCALE: NOT TO SCALE

NOT USED 2

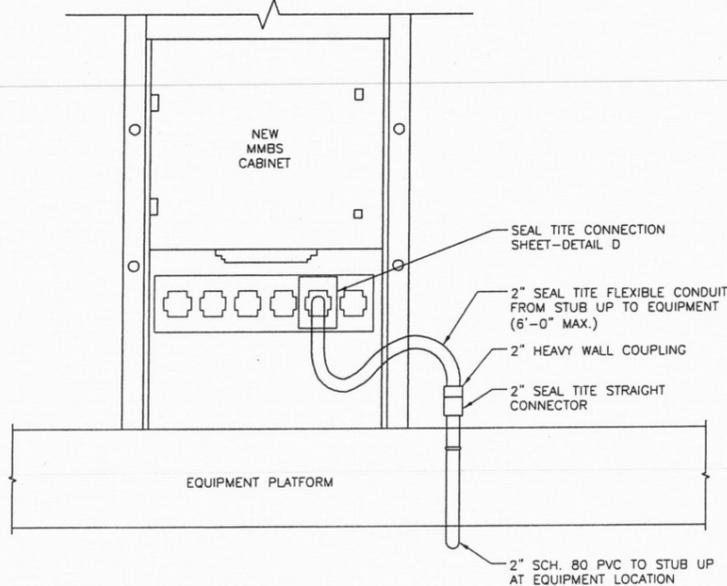

22"x34" SCALE: NOT TO SCALE  
11"x17" SCALE: NOT TO SCALE

EQUIP. POWER CONDUIT CONNECTIONS 3

22"x34" SCALE: NOT TO SCALE  
11"x17" SCALE: NOT TO SCALE

SEAL TITE POWER CONDUIT CONNECTION 4

22"x34" SCALE: NOT TO SCALE  
11"x17" SCALE: NOT TO SCALE

NOT USED 5

Sprint

SAMSUNG

GENERAL DYNAMICS  
WIRELESS SERVICES

POWDER RIVER  
Development Services, LLC  
100 E. SHENANGO STREET  
SHARPSVILLE, PA 16150  
724.962.5999  
www.powderriverdev.com

PROJECT INFORMATION:

NETWORK VISION MMBS LAUNCH

BURLINGAME 2

PO03XC067  
9700 CAPITAL HWY  
PORTLAND, OR 97219  
MULTNOMAH, COUNTY

ISSUE DATE: 06-27-2013

ISSUED FOR: CONSTRUCTION DWGS

REVISIONS			
REV.	DATE	DESCRIPTION	INITIALS
A	08/22/12	ISSUED FOR CDs 90%	DM
B	08/30/12	ISSUED FOR CDs 100%	CCM
C	09/10/12	ISSUED FOR CDs FINALS	JED
D	05/24/13	ISSUED FOR REVISED CDs FINALS	CCM
E	06/27/13	ISSUED FOR REVISED CDs FINALS	JED

NOT FOR CONSTRUCTION UNLESS  
LABELED AS CONSTRUCTION SET

LICENSURE



SHEET TITLE:

DC POWER ONE-LINE  
DIAGRAM

SHEET NUMBER:



E-2

REVISION:

E

PROJ. NO.  
1678-021112

RECEIVED  
AUG 02 2013  
BDS  
DOCUMENT SERVICES

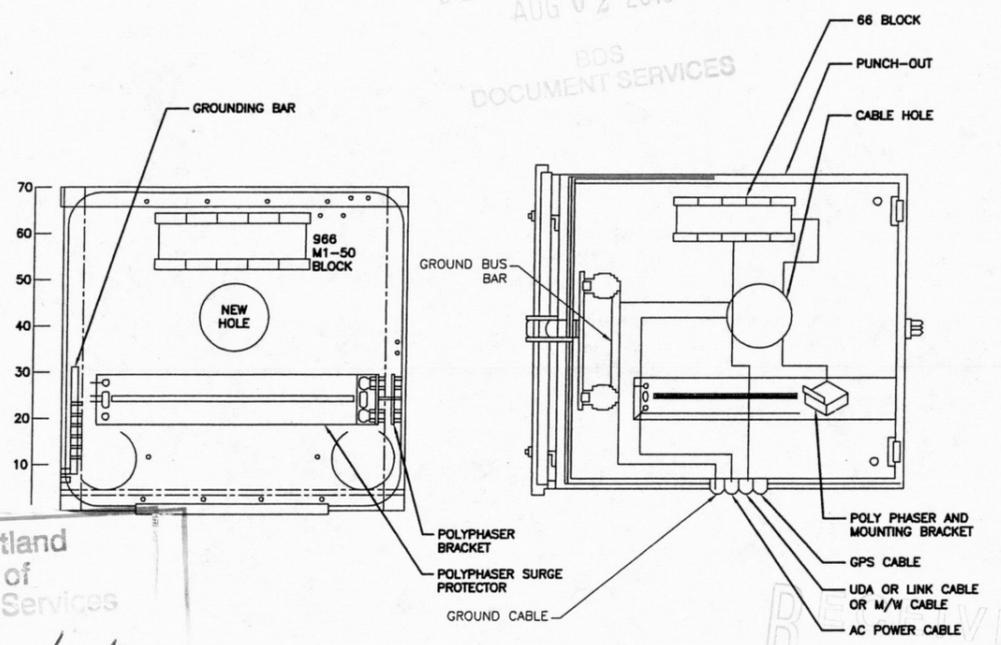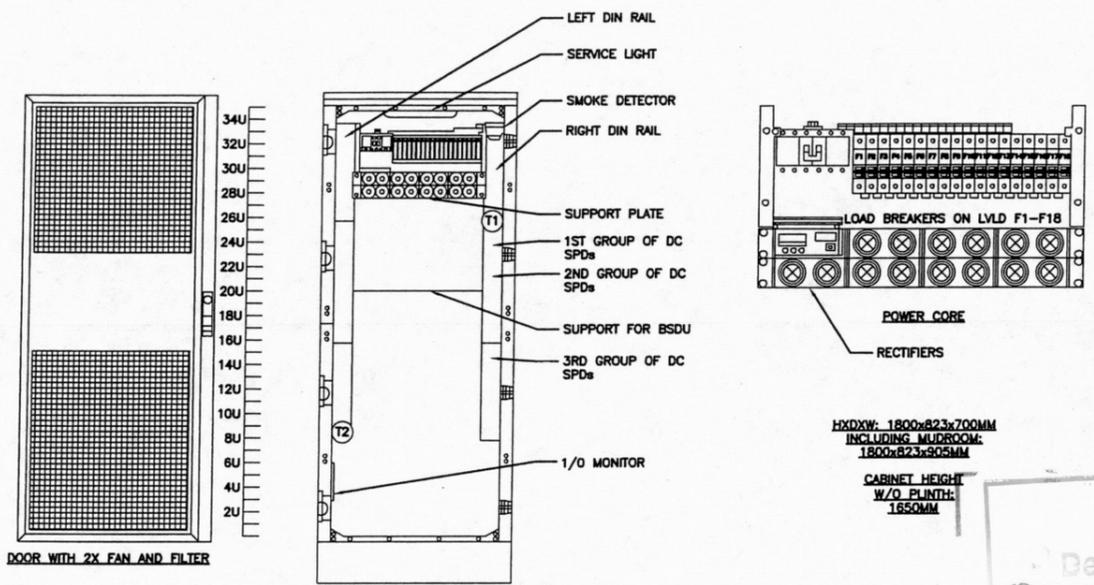

City of Portland  
Bureau of  
Development Services  
Approved by  
Date 9/23/2013  
and Zoning

RECEIVED  
AUG 02 2013  
BDS  
DOCUMENT SERVICES



GENERAL DYNAMICS  
WIRELESS SERVICES

POWDER RIVER  
Development Services, LLC  
100 E. SHENANGO STREET  
SHARPSVILLE, PA 16150  
724.962.5999  
www.powderriverdev.com

PROJECT INFORMATION:  
NETWORK VISION MMBS LAUNCH  
**BURLINGAME 2**  
PO03XC067  
9700 CAPITAL HWY  
PORTLAND, OR 97219  
MULTNOMAH, COUNTY

ISSUE DATE: 06-27-2013

ISSUED FOR: CONSTRUCTION DWGS

REVISIONS			
REV.	DATE	DESCRIPTION	INITIALS
A	08/22/12	ISSUED FOR CD's 90%	DM
B	08/30/12	ISSUED FOR CD's 100%	CCM
C	09/10/12	ISSUED FOR CD's FINALS	JED
D	05/24/13	ISSUED FOR REVISED CD's FINALS	CCM
E	06/27/13	ISSUED FOR REVISED CD's FINALS	JED

NOT FOR CONSTRUCTION UNLESS LABELED AS CONSTRUCTION SET


LICENSURE  
REGISTERED PROFESSIONAL ENGINEER  
CIVIL  
84537PE  
GARY W. [Signature]  
EXPIRES 12/31/13

EQUIPMENT DETAILS  
OUTDOOR SPECIFICATIONS


SHEET NUMBER: **E-3**  
REVISION: **E**  
PRDS PROJ. NO. 1678-021112

22"x34" SCALE: NOT TO SCALE  
11"x17" SCALE: NOT TO SCALE  
MMBS-BBU ELECTRICAL DETAILS 1

22"x34" SCALE: NOT TO SCALE  
11"x17" SCALE: NOT TO SCALE  
MUDROOM ELECTRICAL DETAIL 2

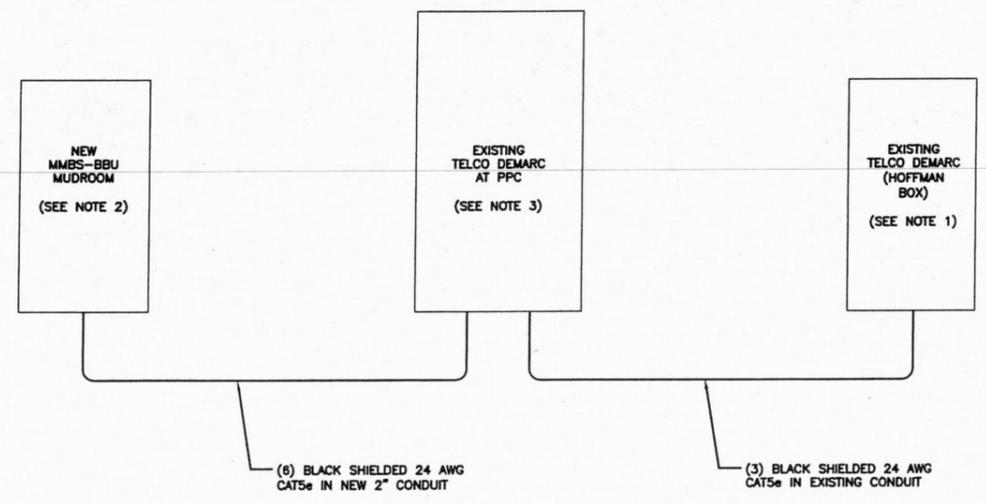


- NOTES:
- CONTRACTOR TO INSTALL NEW 66 BLOCK IN EXISTING HOFFMAN BOX AT SITES MAIN TELCO DEMARC.
  - CONTRACTOR SHALL INSTALL RJ-45 ENDS ON ALL (6) RUNS OF CAT5e INTO MMBS-BBU MUDROOM.
  - CONTRACTOR TO INSTALL NEW 66 BLOCK IN EXISTING TELCO BOX NEXT TO EXISTING PPC CABINET.

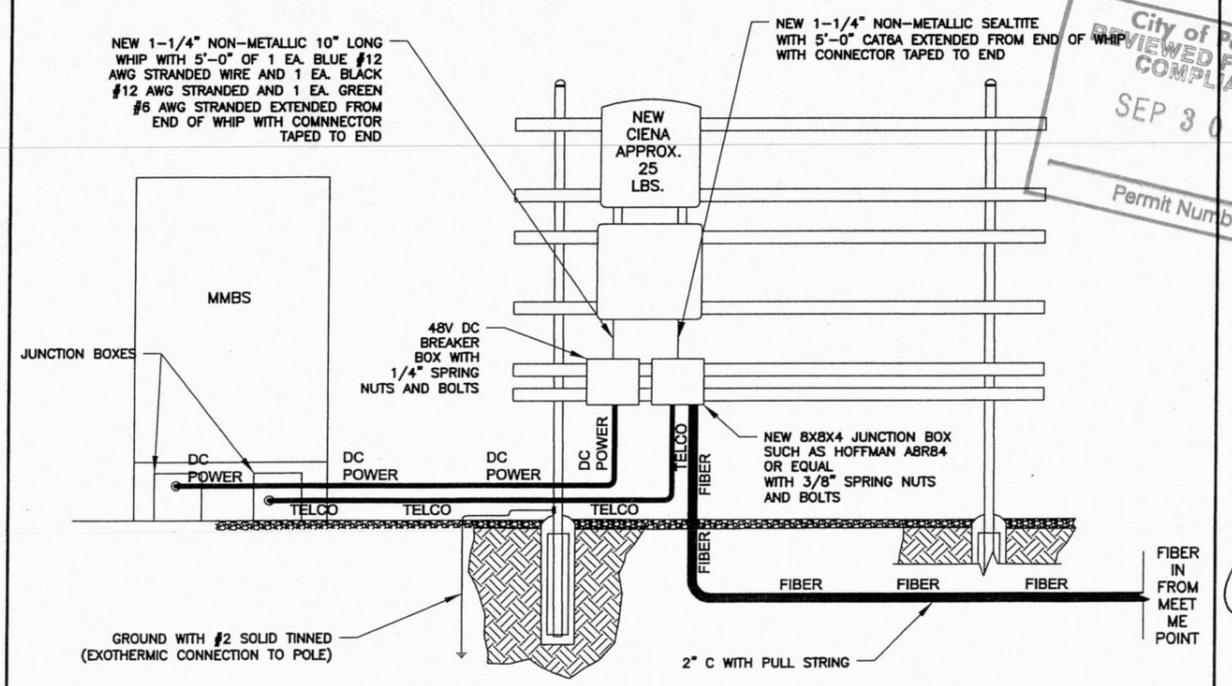


City of Portland  
REVIEWED FOR COMPLIANCE  
SEP 30 2013  
Permit Number

22"x34" SCALE: NOT TO SCALE  
11"x17" SCALE: NOT TO SCALE  
TELCO RISER DETAIL 3


22"x34" SCALE: NOT TO SCALE  
11"x17" SCALE: NOT TO SCALE  
AAV MOUNTING DETAIL EXAMPLE 4

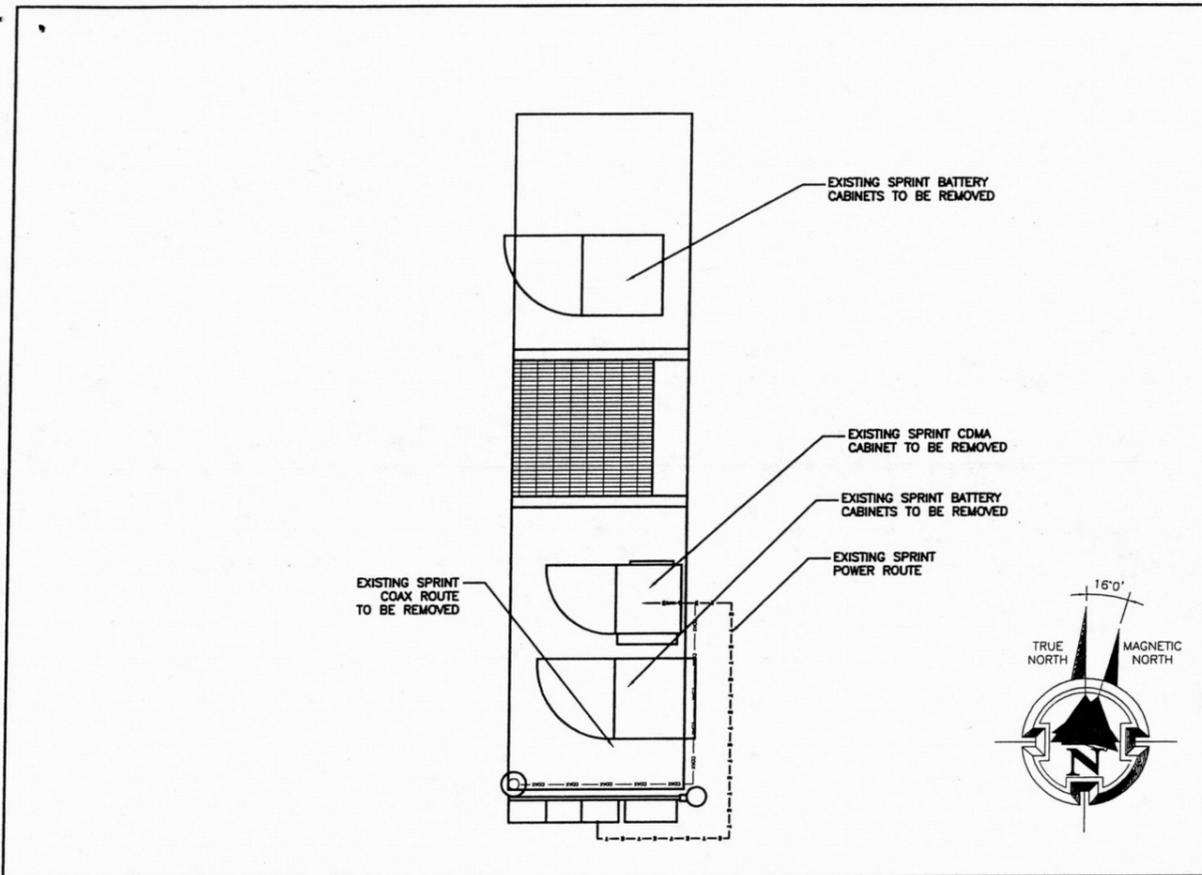

22"x34" SCALE: 3/8" = 1'-0"  
11"x17" SCALE: 3/16" = 1'-0"  
EXISTING ROUTING PLAN 1

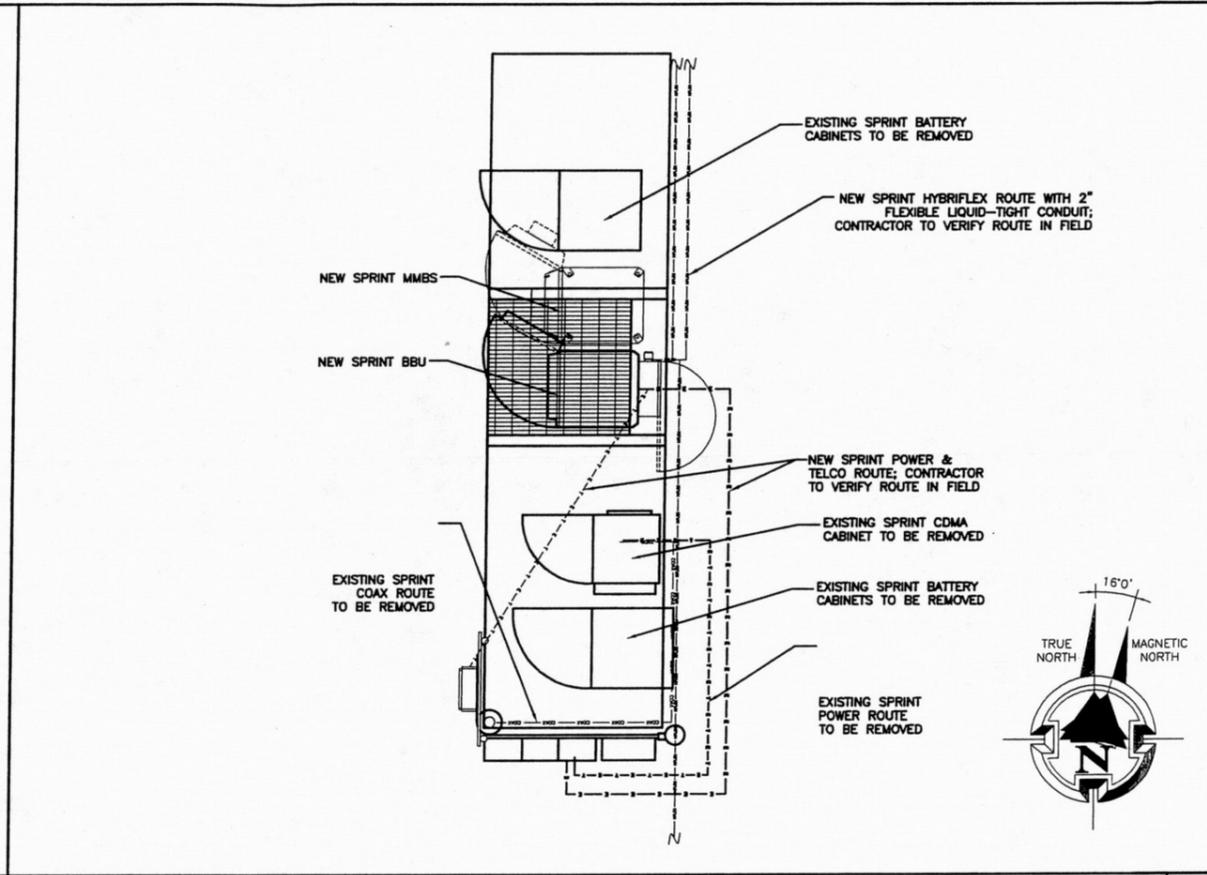

22"x34" SCALE: 3/8" = 1'-0"  
11"x17" SCALE: 3/16" = 1'-0"  
NEW TEMP. ROUTING PLAN (INTERIM) 2

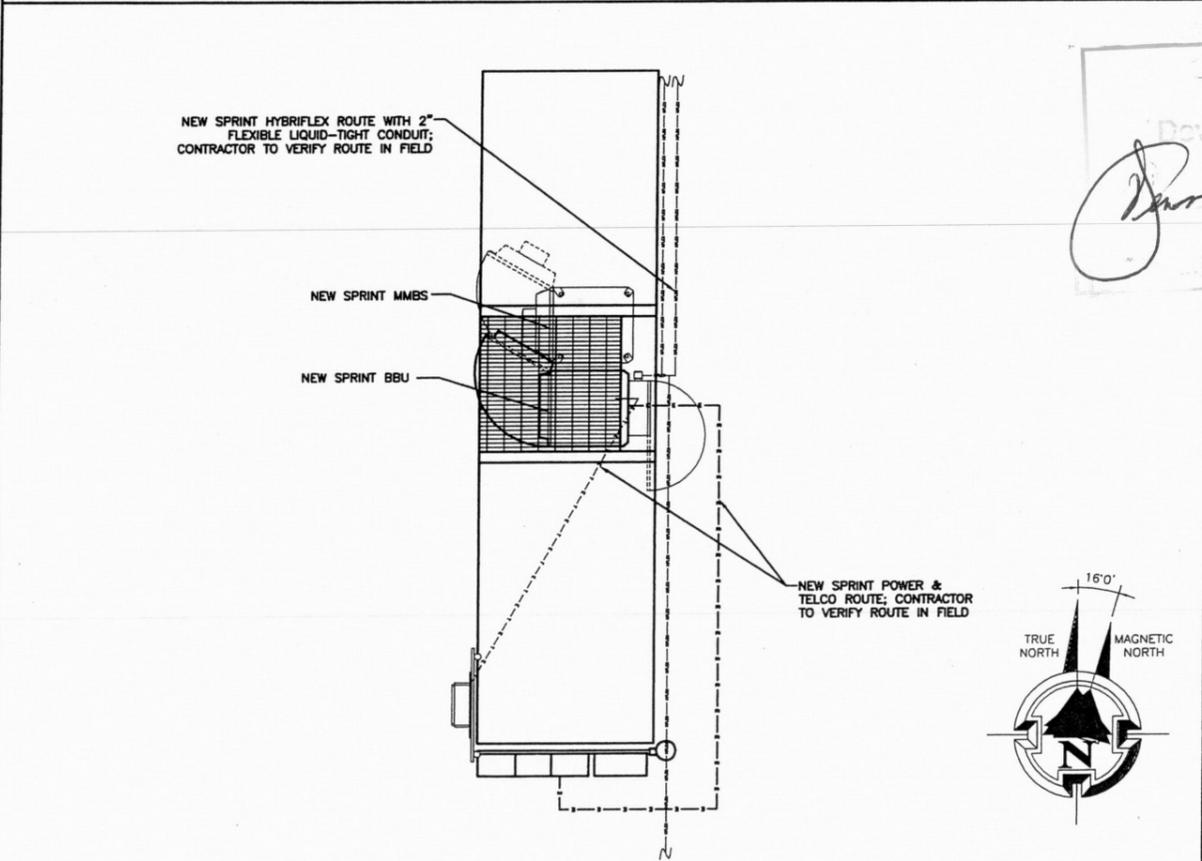

22"x34" SCALE: 3/8" = 1'-0"  
11"x17" SCALE: 3/16" = 1'-0"  
NEW ROUTING PLAN (FINAL) 3

City of Portland  
Bureau of  
Development Services

*Approved by [Signature] 9/23/2013*

Approved by  
[Signature] and Zoning

City of Portland  
REVIEWED FOR CODE  
COMPLIANCE  
SEP 30 2013  
Permit Number

NOTE: STRUCTURAL ANALYSIS MUST BE  
PERFORMED ON ALL ROOFTOPS, FLAGPOLES  
AND TOWER SITES BEFORE INSTALLATION OF NEW ANTENNAS,  
NEW RRUS, & NEW CABINETS/TEMPORARY PLATFORMS.

NOT USED 4

Sprint

SAMSUNG

GENERAL DYNAMICS  
WIRELESS SERVICES

**POWDER RIVER**  
Development Services, LLC  
100 E. SHENANGO STREET  
SHARPSVILLE, PA 16150  
724.962.5999  
www.powderriverdev.com

PROJECT INFORMATION:  
NETWORK VISION MMBS LAUNCH  
**BURLINGAME 2**  
PO03XC067  
9700 CAPITAL HWY  
PORTLAND, OR 97219  
MULTNOMAH, COUNTY

ISSUE DATE: 06-27-2013

ISSUED FOR: CONSTRUCTION DWGS

REVISIONS			
REV.	DATE	DESCRIPTION	INITIALS
A	08/22/12	ISSUED FOR CD's 90%	DM
B	08/30/12	ISSUED FOR CD's 100%	CCM
C	09/10/12	ISSUED FOR CD's FINALS	JED
D	05/24/13	ISSUED FOR REVISED CD's FINALS	CCM
E	06/27/13	ISSUED FOR REVISED CD's FINALS	JED


NOT FOR CONSTRUCTION UNLESS  
LABELED AS CONSTRUCTION SET

LICENSURE:  
**REGISTERED PROFESSIONAL  
ENGINEER**  
CIVIL  
84537PE  
6/27/13  
OREGON  
9-14-10  
GARY W. CLOVER

SHEET TITLE: EXPIRES 12-31-13

CONDUIT ROUTING

SHEET NUMBER: **E-4** REVISION: **E**  
PRDS PROJ. NO. 1678-021112

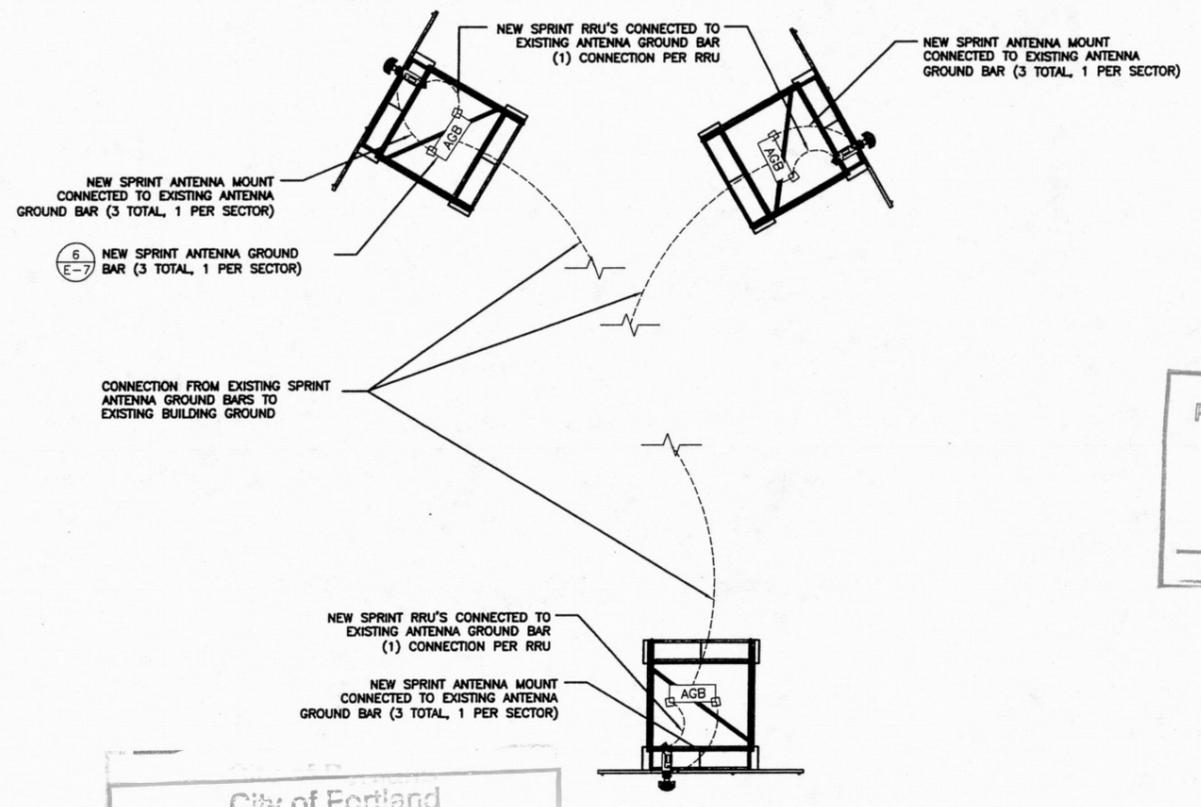

- LEGEND**
- EXOTHERMIC CONNECTION
  - MECHANICAL CONNECTION
  - COMPRESSION CONNECTION
  - CGB COLLECTOR GROUND BAR
  - MGB EXTERNAL GROUND BAR

22"x34" SCALE: 1" = 1'-0"  
 11"x17" SCALE: 1/2" = 1'-0"

City of Portland  
 Bureau of  
 Development Services  
*Jan 9/23/2013*  
 Approved by  
 Planning and Zoning

ANTENNA GROUNDING PLAN 1

1. ALL DETAILS ARE SHOWN IN GENERAL TERMS. ACTUAL INSTALLATION AND CONSTRUCTION MAY VARY DUE TO SITE SPECIFIC CONDITIONS.
2. GROUND ALL ANTENNA BASES, FRAMES, CABLE RUNS, AND OTHER METALLIC COMPONENTS USING GROUND WIRES AND CONNECT TO SURFACE MOUNTED BUS BARS. FOLLOW ANTENNA AND BTS MANUFACTURERS PRACTICES FOR GROUNDING REQUIREMENTS. GROUND COAX SHIELD AT BOTH ENDS AND EXIT FROM TOWER OR POLE USING MFR'S PRACTICES.
3. ALL GROUND CONNECTIONS SHALL BE EXOTHERMIC. ALL WIRES SHALL BE COPPER THIN/THWN. ALL GROUND WIRE SHALL BE GREEN INSULATED WIRE ABOVE GROUND.
4. CONTRACTOR TO VERIFY AND TEST GROUND TO SOURCE. GROUNDING AND OTHER OPERATIONAL TESTING WILL BE WITNESSED BY SPRINT WIRELESS, LLC. REPRESENTATIVE.
5. REFER TO DIVISION 16 GENERAL ELECTRIC; GENERAL ELECTRICAL PROVISION AND COMPLY WITH ALL REQUIREMENTS OF GROUNDING STANDARDS.
6. ELECTRICAL CONTRACTOR TO PROVIDE DETAILED DESIGN OF GROUNDING SYSTEM PER SPRINT STANDARD GROUNDING METHOD, AND RECEIVE APPROVAL OF DESIGN BY AUTHORIZED SPRINT MOBILITY REPRESENTATIVE, PRIOR TO INSTALLATION OF GROUNDING SYSTEM. PHOTO DOCUMENT ALL EXOTHERMIC AND GROUND RING.
7. NOTIFY CONSTRUCTION MANAGER IF THERE ARE ANY DIFFICULTIES INSTALLING GROUNDING SYSTEM DUE TO SITE SOIL CONDITIONS.
8. ALL EXISTING GROUND BARS, WIRES & CONNECTIONS SHALL BE FIELD VERIFIED. ANY DEFICIENT ITEMS SHALL BE REPLACED AS REQUIRED TO ACHIEVE ADEQUATE GROUNDING REQUIRED BY SPRINT.

GENERAL GROUNDING NOTES

GROUNDING NOTES

1. EXOTHERMIC WELDS (2). 2 AWG BARE TINNED SOLID COPPER CONDUCTORS TO GROUNDING BAR. ROUTE CONDUCTORS TO BURIED GROUNDING RING AND PROVIDE PARALLEL EXOTHERMIC WELD.
2. EC SHALL USE PERMANENT MARKER TO DRAW THE LINES BETWEEN EACH SECTION AND LABEL EACH SECTION ("P", "A", "N", "I") WITH 1" HIGH LETTERS.
3. ALL HARDWARE 18-8 STAINLESS STEEL, INCLUDING LOCK WASHERS, COAT ALL SURFACES WITH AN ANTI-OXIDANT COMPOUND BEFORE MATING. ALL HARDWARE SHALL BE STAINLESS STEEL 3/8 INCH DIAMETER OR LARGER.
4. FOR GROUND BOND TO STEEL ONLY: INSERT A CADMIUM FLAT WASHER BETWEEN LUG AND STEEL, COAT ALL SURFACES WITH AN ANTI-OXIDANT COMPOUND BEFORE MATING.
5. NUT & WASHER SHALL BE PLACED ON THE FRONT SIDE OF THE GROUNDING BAR AND BOLTED ON THE BACK SIDE. INSTALL BLACK HEAT-SHRINKING TUBE, 600 VOLT INSULATION ON ALL GROUNDING TERMINATIONS. THE INTENT IS TO WEATHERPROOF THE COMPRESSION CONNECTION.
6. NUMBER OF GROUNDING BARS MAY VARY DEPENDING ON THE TYPE OF TOWER, ANTENNA LOCATION, AND CONNECTION ORIENTATION. PROVIDE AS REQUIRED.
7. GROUNDING KIT SHALL BE TYPE AND PART NUMBER AS SUPPLIED OR RECOMMENDED BY CABLE MANUFACTURER.
8. WEATHERPROOFING SHALL BE TYPE AND PART NUMBER AS SUPPLIED OR RECOMMENDED BY CABLE MANUFACTURER.
9. SUPPLIED AND INSTALLED BY CONTRACTOR.
10. WHEN THE SCOPE OF WORK REQUIRES THE ADDITION OF A GROUNDING BAR TO AN EXISTING TOWER, THE SUBCONTRACTOR SHALL OBTAIN APPROVAL FROM THE TOWER OWNER PRIOR TO MOUNTING THE GROUNDING BAR TO THE TOWER.
11. EXTEND TWO (2) 2 AWG TINNED CU CONDUCTOR FROM BURIED GROUNDING RING AND CONNECT TO THE NEW TOWER. FOLLOW MANUFACTURERS RECOMMENDATIONS FOR GROUNDING CONNECTIONS TO THE TOWER. (APPLICABLE TO NEW TOWERS ONLY.)
12. NUMBER OF GROUNDING BARS MAY VARY DEPENDING ON THE TYPE OF TOWER, ANTENNA LOCATION, AND CONNECTION ORIENTATION. THE SUBCONTRACTOR SHALL BE RESPONSIBLE FOR INSTALLING ADDITIONAL GROUNDING BARS AS REQUIRED, PROVIDING 50% SPARE CONNECTION POINTS.
13. EXPOSED GROUND WIRES TO BE NON METALLIC LIQUID TIGHT.

ISSUE DATE: 06-27-2013


ISSUED FOR: CONSTRUCTION DWGS

REVISIONS

REV.	DATE	DESCRIPTION	INITIALS
A	08/22/12	ISSUED FOR CD's 90%	DM
B	08/30/12	ISSUED FOR CD's 100%	CCM
C	09/10/12	ISSUED FOR CD's FINALS	JED
D	05/24/13	ISSUED FOR REVISED CD's FINALS	CCM
E	06/27/13	ISSUED FOR REVISED CD's FINALS	JED


NOT FOR CONSTRUCTION UNLESS LABELED AS CONSTRUCTION SET

LICENSURE:

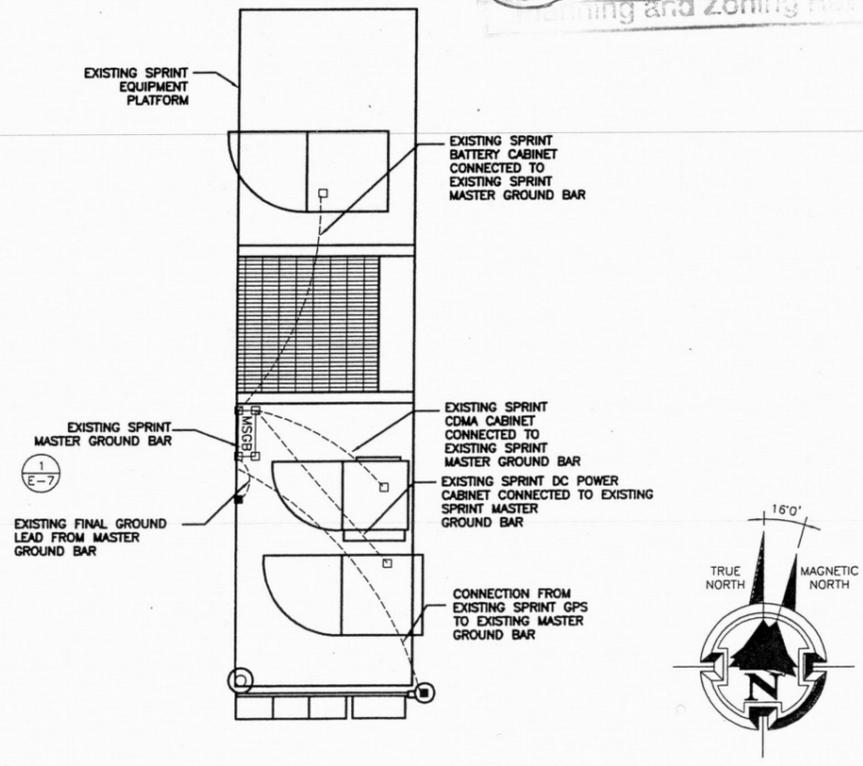

22"x34" SCALE: 3/8" = 1'-0"  
 11"x17" SCALE: 3/16" = 1'-0"

EQUIP. GROUNDING PLAN (EXISTING) 2

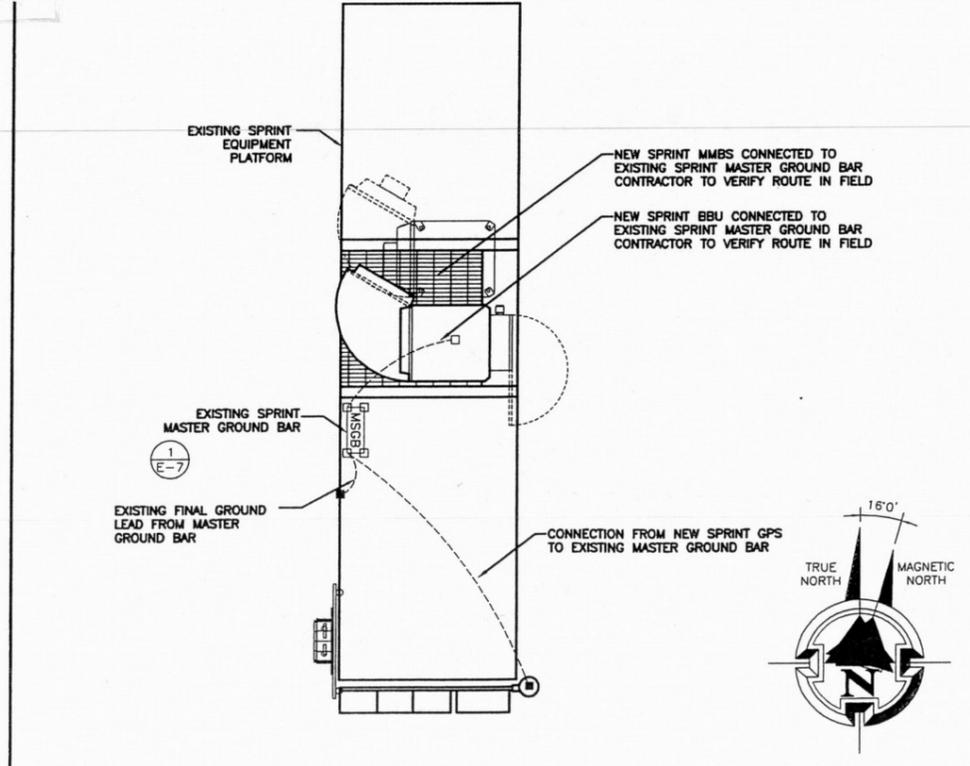

22"x34" SCALE: 3/8" = 1'-0"  
 11"x17" SCALE: 3/16" = 1'-0"

EQUIPMENT GROUNDING PLAN (FINAL) 3





SHEET TITLE:

GROUNDING PLAN

SHEET NUMBER: E-5

REVISION: E

PROJ. NO. 1678-021112





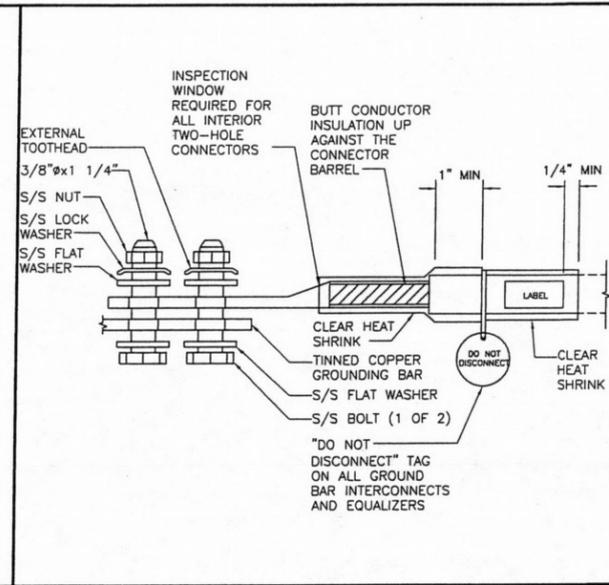
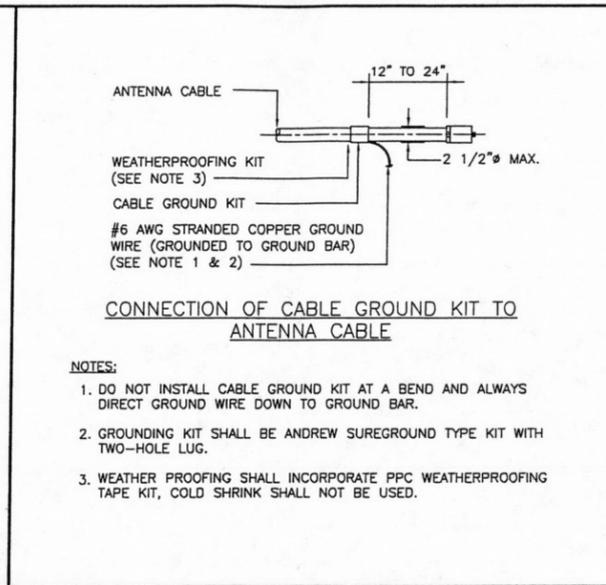
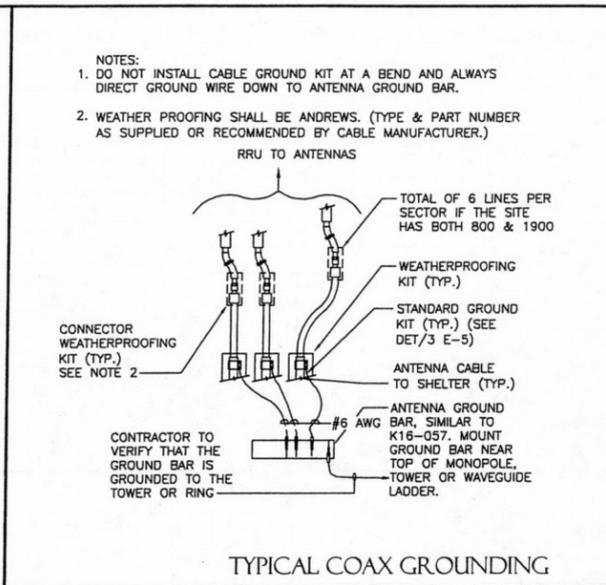
 


22"x34" SCALE: NOT TO SCALE  
 11"x17" SCALE: NOT TO SCALE

22"x34" SCALE: NOT TO SCALE  
 11"x17" SCALE: NOT TO SCALE

22"x34" SCALE: NOT TO SCALE  
 11"x17" SCALE: NOT TO SCALE

22"x34" SCALE: NOT TO SCALE  
 11"x17" SCALE: NOT TO SCALE

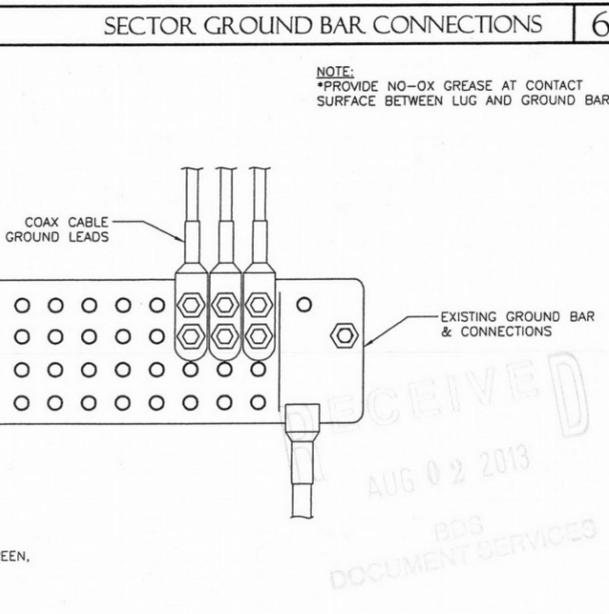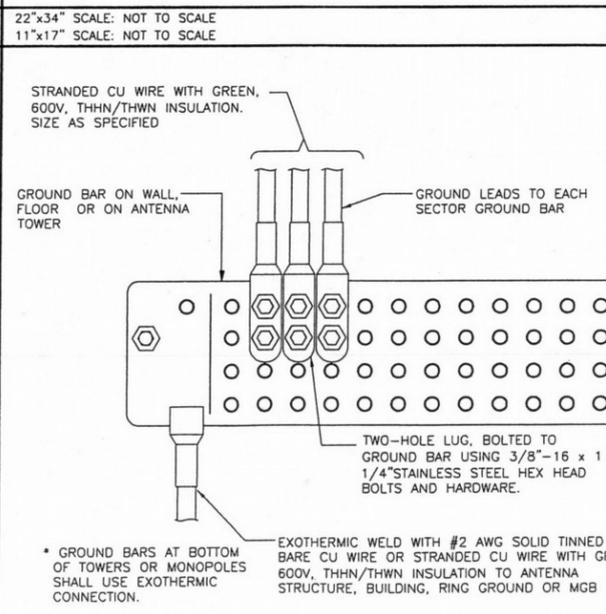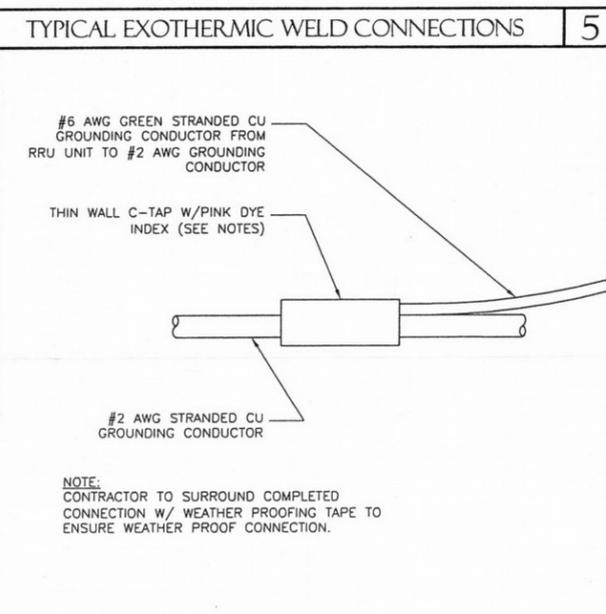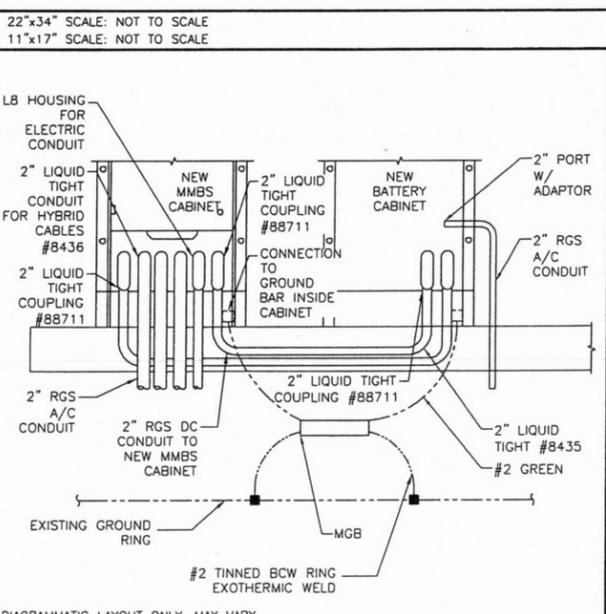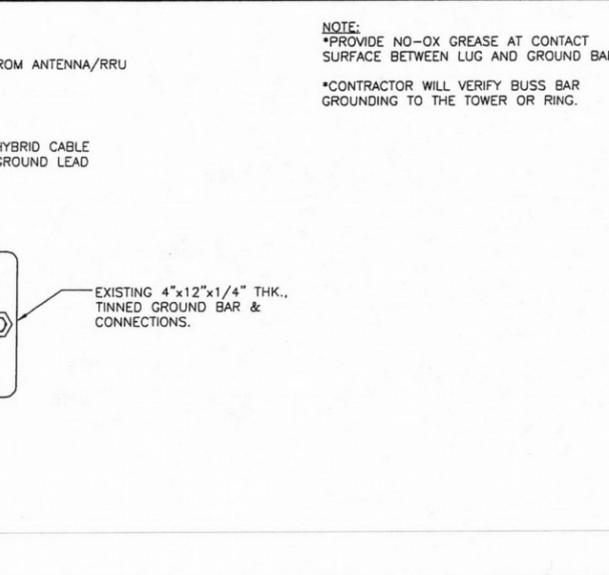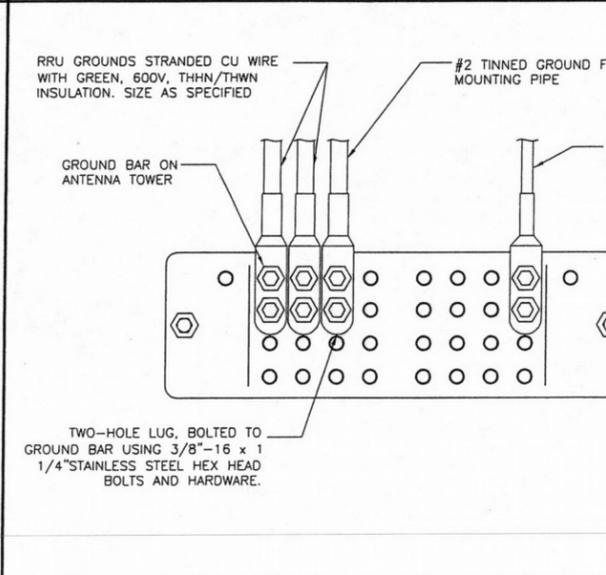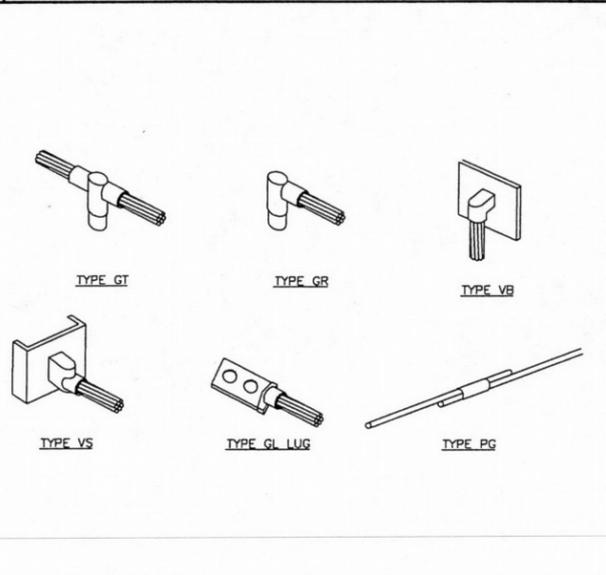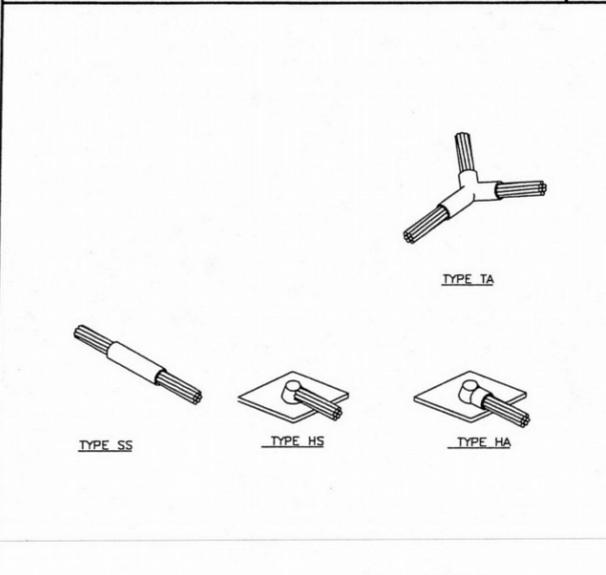

22"x34" SCALE: NOT TO SCALE  
 11"x17" SCALE: NOT TO SCALE

22"x34" SCALE: NOT TO SCALE  
 11"x17" SCALE: NOT TO SCALE

22"x34" SCALE: NOT TO SCALE  
 11"x17" SCALE: NOT TO SCALE

22"x34" SCALE: NOT TO SCALE  
 11"x17" SCALE: NOT TO SCALE

**Sprint**

**SAMSUNG**

**GENERAL DYNAMICS WIRELESS SERVICES**

**POWDER RIVER**  
 Development Services, LLC  
 100 E. SHENANGO STREET  
 SHARPSVILLE, PA 16150  
 724.962.5999  
 www.powderriverdev.com

PROJECT INFORMATION:  
 NETWORK VISION MMBS LAUNCH

**BURLINGAME 2**  
 PO03XC067  
 9700 CAPITAL HWY  
 PORTLAND, OR 97219  
 MULTNOMAH, COUNTY

ISSUE DATE: 06-27-2013

ISSUED FOR: CONSTRUCTION DWGS

REVISIONS

REV.	DATE	DESCRIPTION	INITIALS
A	08/22/12	ISSUED FOR CDs 90%	DM
B	08/30/12	ISSUED FOR CDs 100%	CCM
C	09/10/12	ISSUED FOR CDs FINALS	JED
D	05/24/13	ISSUED FOR REVISED CDs FINALS	CCM
E	06/27/13	ISSUED FOR REVISED CDs FINALS	JED

NOT FOR CONSTRUCTION UNLESS LABELED AS CONSTRUCTION SET

LICENSEURE

**REGISTERED PROFESSIONAL ENGINEER**  
 CIVIL  
 84537PE  
 6/27/13  
 OREGON  
 9-14-10  
 GARY W. CLOWER  
 EXPIRES 12-31-2013

SHEET TITLE:  
**GROUNDING DETAILS**


SHEET NUMBER:  
**E-7**

REVISION:  
**E**

PROJ PROJ NO.  
 1678-021112

**GENERAL NOTES**

THIS IS NOT A SITE SURVEY.  
ALL PROPERTY BOUNDARIES, ORIENTATION OF TRUE NORTH AND STREET HALF-WIDTHS HAVE BEEN OBTAINED FROM A TAX PARCEL MAP AND ARE APPROXIMATE.

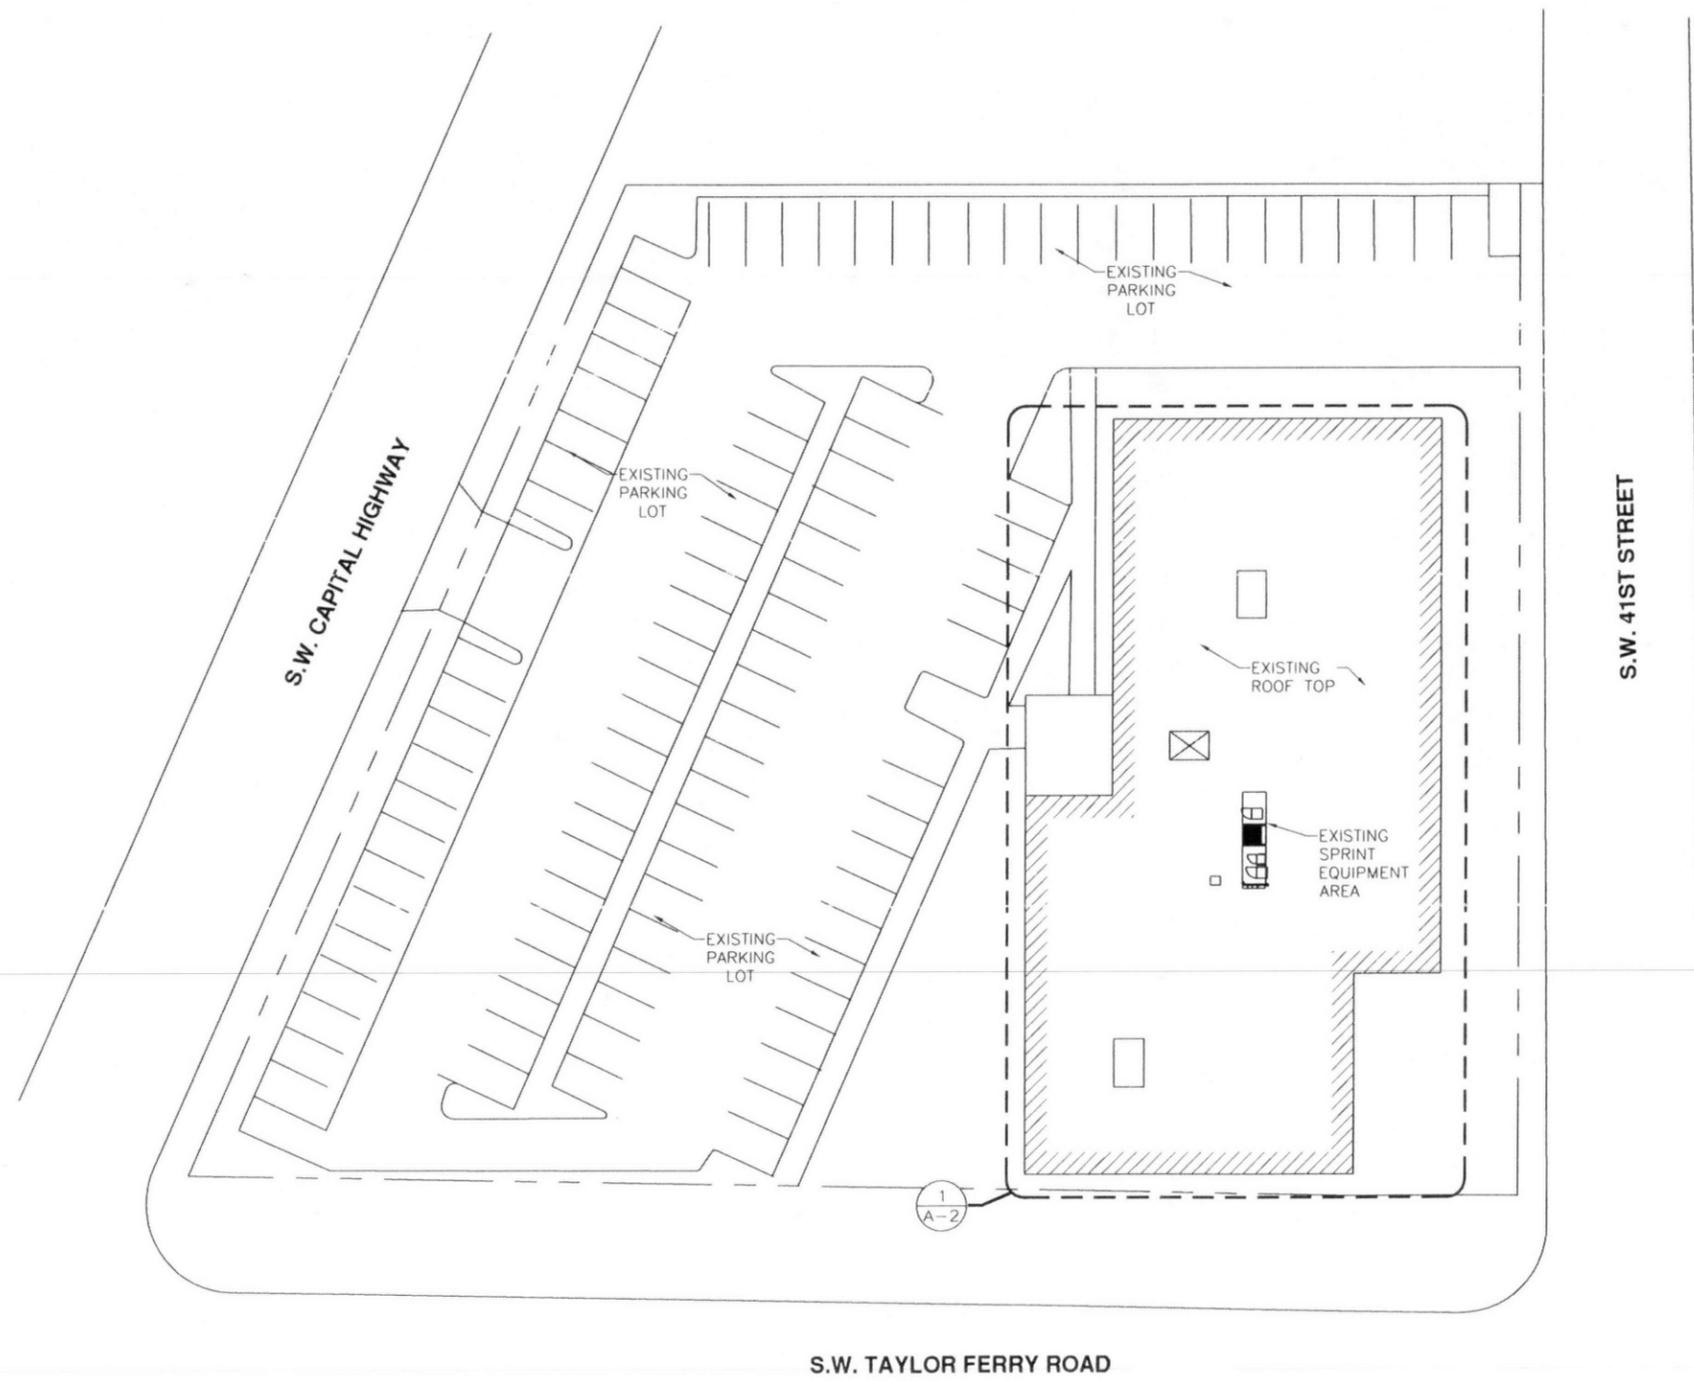

**WORK IN  
PUBLIC RIGHT - OF - WAY IS  
NOT APPROVED AS PART OF  
THIS BUILDING PERMIT**

**City of Portland  
REVIEWED FOR CODE  
COMPLIANCE**  
**SEP 30 2013**  
 Permit Number \_\_\_\_\_



**GENERAL DYNAMICS  
WIRELESS SERVICES**



PROJECT INFORMATION:  
 NETWORK VISION AMBS LAUNCH  
**BURLINGAME 2**  
 PO03XC067  
 9700 CAPITAL HWY  
 PORTLAND, OR 97219  
 MULTNOMAH, COUNTY

ISSUE DATE: 09-10-12

ISSUED FOR: CONSTRUCTION DWGS

REVISIONS				
REV	DATE	DESCRIPTION	INITIALS	
A	08/22/12	ISSUED FOR CDs 90%	DM	
B	08/30/12	ISSUED FOR CDs 100%	CCM	
C	09/10/12	ISSUED FOR CDs FINALS	JED	

NOT FOR CONSTRUCTION UNLESS LABELED AS CONSTRUCTION SET

LICENSURE:

SHEET TITLE:  
**OVERALL SITE PLAN**

SHEET NUMBER: **A-1**  
 REVISION: **C**  
PROJ PROJ NO 1678-021112



OVERALL SITE PLAN | 1