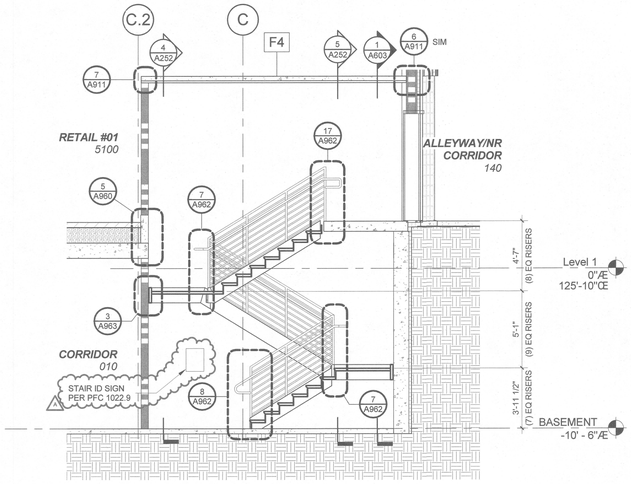

3 STAIR #03 - SECTION 1

SCALE: 1/4" = 1'-0"

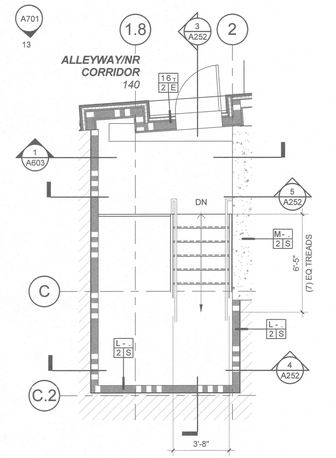

1 STAIR #03 - GROUND LEVEL PLAN

SCALE: 1/4" = 1'-0"

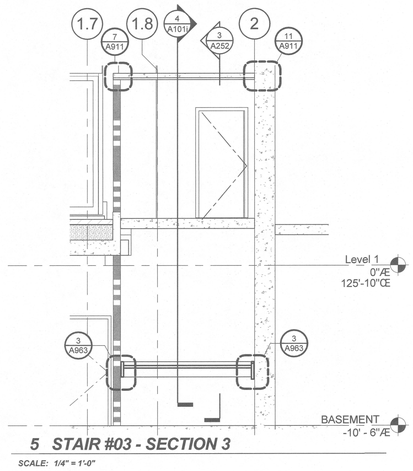

5 STAIR #03 - SECTION 3

SCALE: 1/4" = 1'-0"

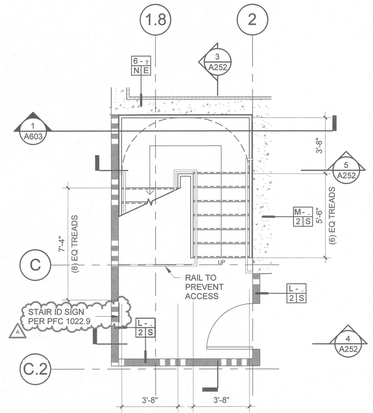

2 STAIR #03 -BASEMENT LEVEL PLAN

SCALE: 1/4" = 1'-0"

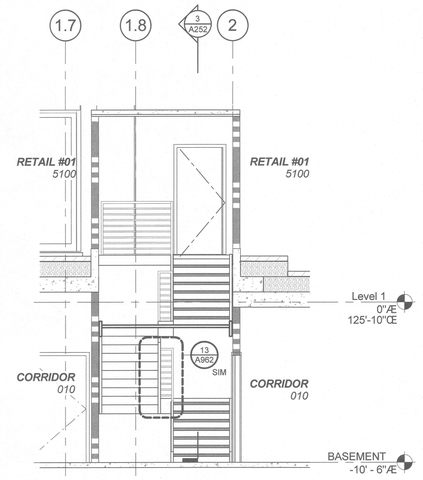

4 STAIR #03 - SECTION 2

SCALE: 1/4" = 1'-0"

LRS ARCHITECTS
720 NW Davis 503.221.1121
Suite 300 503.221.2077
Portland OR 97209 www.lrsarchitects.com

REGISTERED ARCHITECT
THOMAS PAUL LEVER
PORTLAND, OR
STATE OF OREGON

LEVERARCHITECTURE
4713 N ALBINA AVE, PDX OR 97217
T 503 928 6040
www.leverarchitecture.com

CONSULTANT:

PROJECT NUMBER: 215349

GRAND AVENUE APARTMENTS

1010 NE GRAND AVE. PORTLAND, OR 97232

SHEET TITLE:

ENLARGED STAIR PLANS AND SECTIONS

KEY PLAN:

DRAWN BY: KWS
DATE CREATED: 08/30/16

2	ADDENDUM #02	XX/XX/XXXX
A	PLAN CHECK	09/01/2017

Special Inspection Required
Construction Change
DEC 22 2017
BDS

RECEIVED
SEP 06 2017
BDS
DOCUMENT SERVICES

SHEET:
A252
PERMIT SET
07-14-2017

LRS Architects, Inc. ©2017

C:\300 Revit Local Files\BIM Support\215349_Grand Ave Apts_Arch_R17_kschneider.rvt
9/5/2017 3:25:28 PM

KEYNOTES

213 BLOCKOUT FOR DAS CONDUITS - COORDINATE W/ ELECTRICAL.
214 BLOCKOUT FOR FIRE ALARM CONDUITS - COORDINATE W/ ELECTRICAL.
215 BLOCKOUT FOR TELECOMM CONDUITS - COORDINATE W/ ELECTRICAL.
216 DAS EQUIPMENT - SEE ELECTRICAL.
217 SEE FIRESTOPPING DETAILS ON SHEET A911 FOR FIRESTOP REQUIREMENTS AT CONDUITS IN BLOCKOUTS.

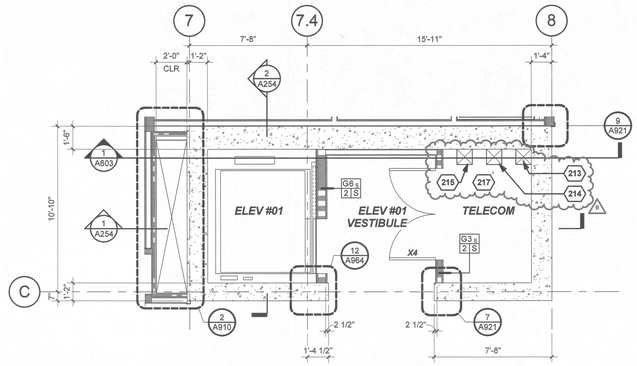

4 ELEVATOR #01 - LEVELS 3 THRU 6 FLOOR PLAN

SCALE: 1/4" = 1'-0"

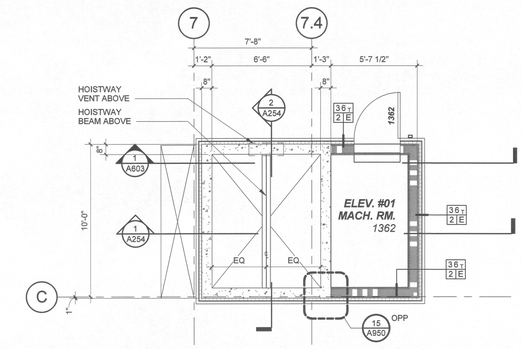

1 ELEVATOR #01 - ROOF LEVEL PLAN

SCALE: 1/4" = 1'-0"

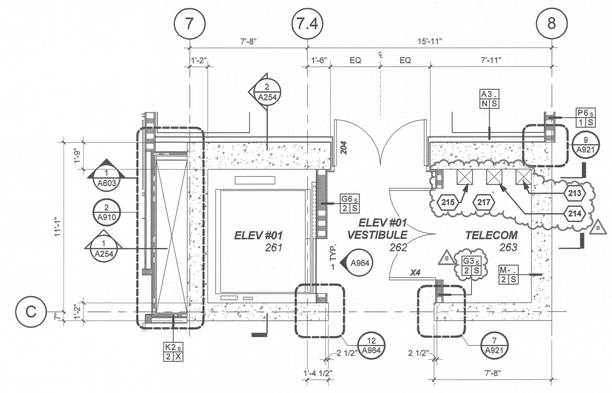

5 ELEVATOR #01 - LEVEL 2 FLOOR PLAN

SCALE: 1/4" = 1'-0"

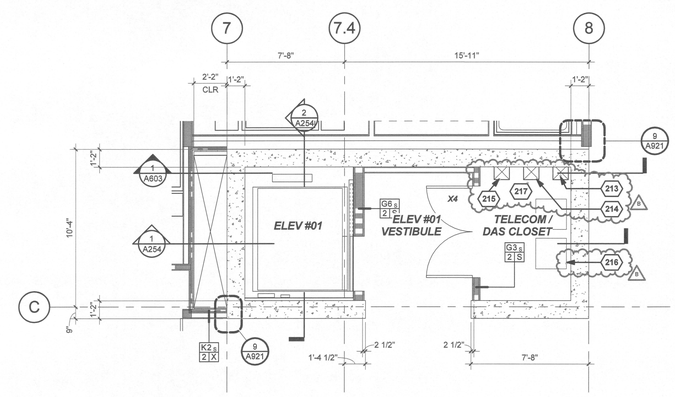

2 ELEVATOR #01 - LEVEL 12 FLOOR PLAN

SCALE: 1/4" = 1'-0"

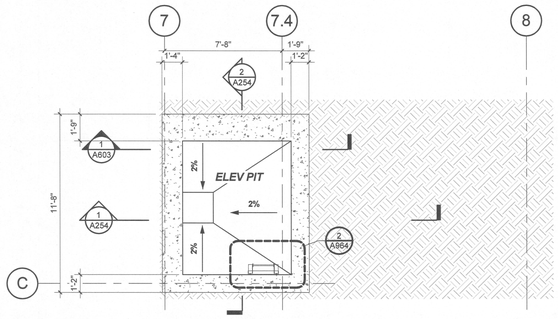

7 ELEVATOR #01 - PIT PLAN

SCALE: 1/4" = 1'-0"

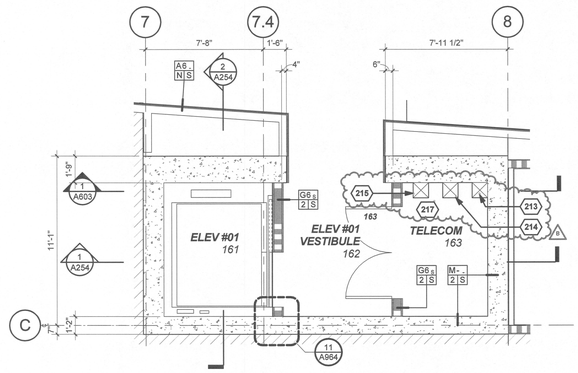

6 ELEVATOR #01 - GROUND LEVEL FLOOR PLAN

SCALE: 1/4" = 1'-0"

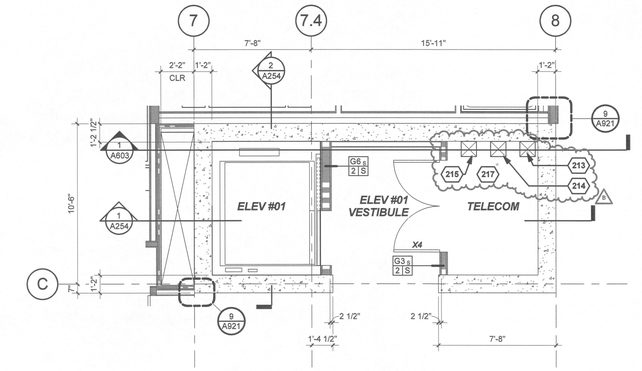

3 ELEVATOR #01 - LEVELS 7 THRU 11 FLOOR PLAN

SCALE: 1/4" = 1'-0"

LRS ARCHITECTS
720 NW Davis
Suite 300
Portland OR 97209 www.lrsarchitects.co

REGISTERED ARCHITECT THOMAS PAUL FRANK PORTLAND, OR STATE OF OREGON

LEVERARCHITECTURE
4713 N ALBINA AVE, PDX OR 97217
T 503 928 6040

CONSULTANT:

PROJECT NUMBER: 215349

1010 NE GRAND AVE. PORTLAND, OR 97232

SHEET TITLE:
SOUTH ELEVATOR #01 ENLARGED PLANS

KEY PLAN:

DRAWN BY: KS, SB
DATE CREATED: 04/25/17

B PLAN CHECK #02 09/22/2017

CITY OF PORTLAND BUREAU OF DEVELOPMENT SERVICES DEC 22 2017 APPROVED

RECEIVED OCT 10 2017 BDS DOCUMENT SERVICES

SHEET:
A253
PERMIT SET
07-14-2017

LRS Architects, Inc. ©2017

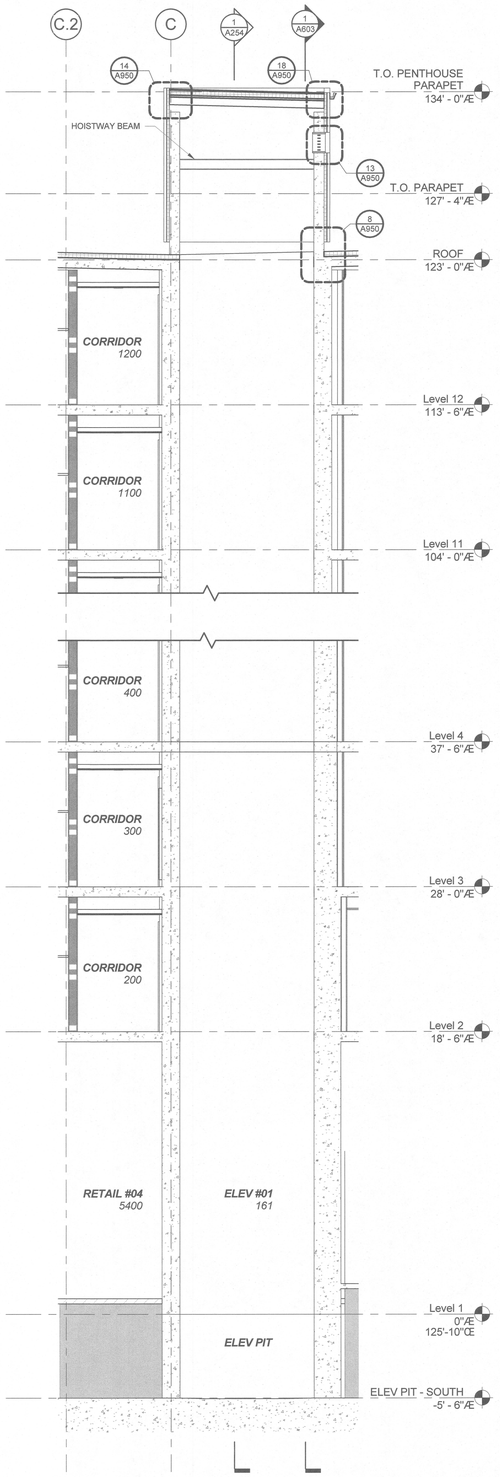

2 ELEVATOR #01 - SECTION 2

SCALE: 1/4" = 1'-0"

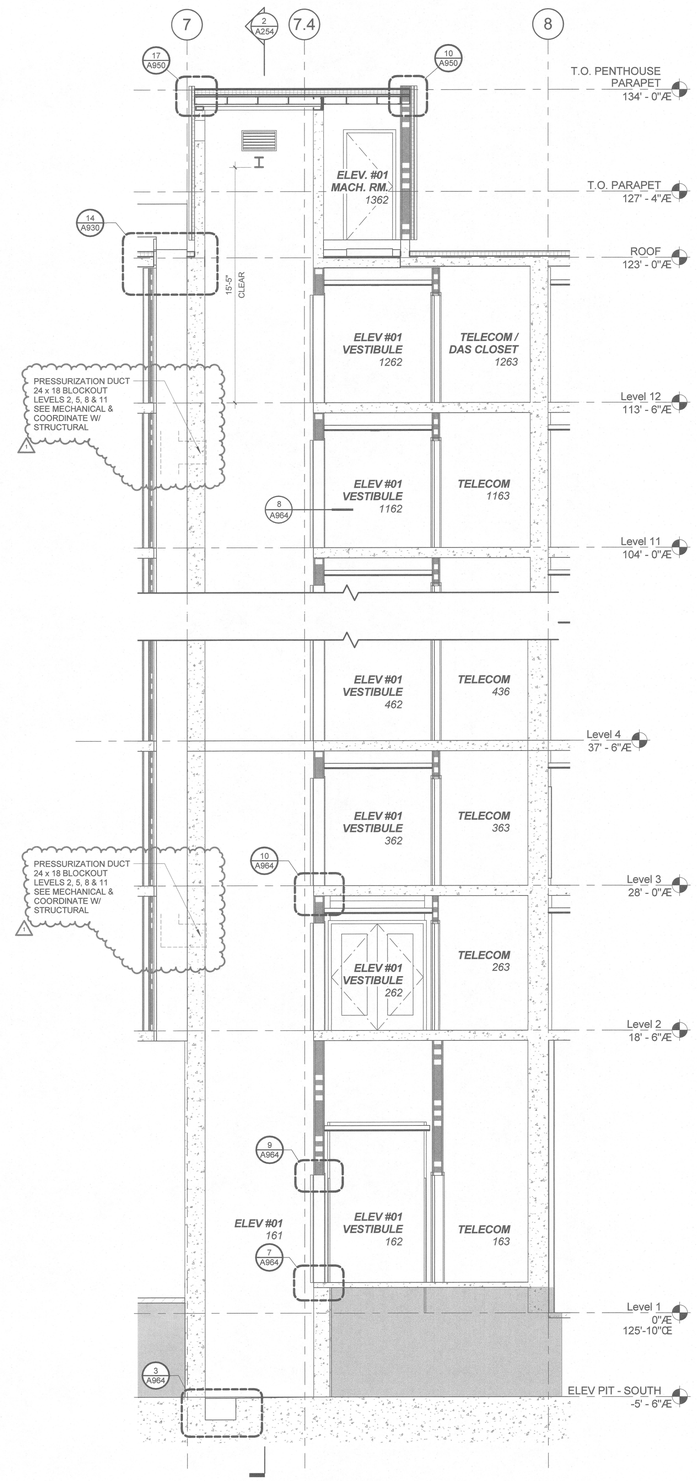

1 ELEVATOR #01 - SECTION 1

SCALE: 1/4" = 1'-0"

LRS ARCHITECTS
720 NW Davis 503.221.1121
Suite 300 503.221.2077
Portland OR 97209 www.lrsarchitects.com

REGISTERED ARCHITECT THOMAS PAUL LEVER PORTLAND, OR STATE OF OREGON

LEVERARCHITECTURE
4713 N ALBINA AVE, PDX OR 97217
T 503 928 6040
www.leverarchitecture.com

CONSULTANT:

PROJECT NUMBER: 215349

GRAND AVENUE APARTMENTS

1010 NE GRAND AVE. PORTLAND, OR 97232

SHEET TITLE:

SOUTH ELEVATOR #01 SECTIONS

KEY PLAN:

DRAWN BY: Author
DATE CREATED: 05/03/17

1	ADDENDUM #01	08/11/2017
2	ADDENDUM #02	XX/XX/XXXX

City of Portland
REVIEWED FOR CODE COMPLIANCE
DEC 22 2017
Permit Required

RECEIVED
SEP 06 2017
BDS
DOCUMENT SERVICES

SHEET:

A254

PERMIT SET
07-14-2017

LRS Architects, Inc. ©2017

C:\300 Revit Local Files\BIM Support\215349_Grand Ave Apts_Arch_R17_kschneider.rvt
9/5/2017 3:25:39 PM

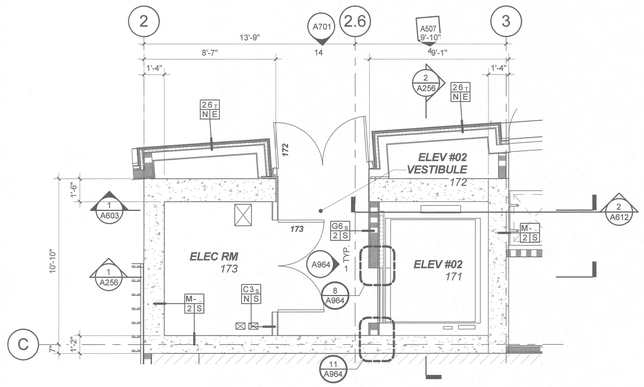

4 ELEVATOR #02 - GROUND LEVEL FLOOR PLAN

SCALE: 1/4" = 1'-0"

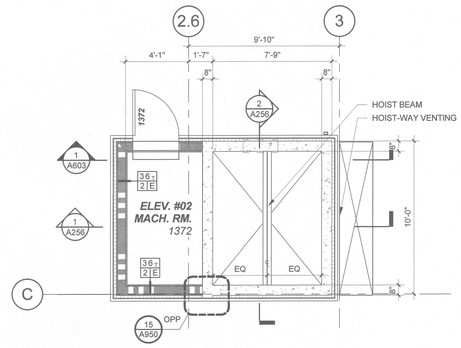

1 ELEVATOR #02 - ROOF LEVEL PLAN

SCALE: 1/4" = 1'-0"

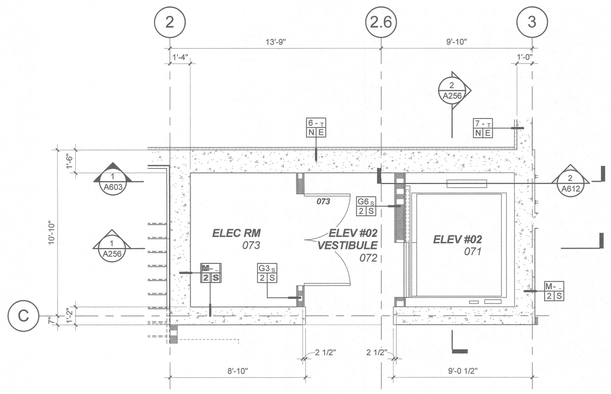

5 ELEVATOR #02 - BASEMENT LEVEL FLOOR PLAN

SCALE: 1/4" = 1'-0"

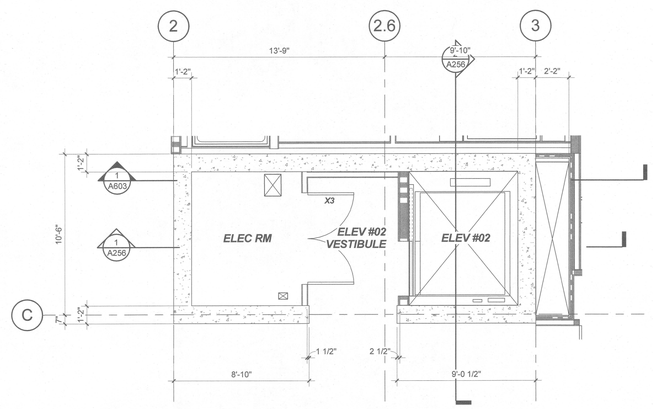

2 ELEVATOR #02 LEVELS 7 THRU 12 FLOOR PLAN

SCALE: 1/4" = 1'-0"

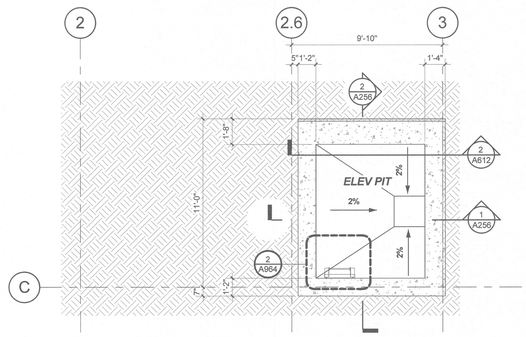

6 ELEVATOR #02 - PIT PLAN

SCALE: 1/4" = 1'-0"

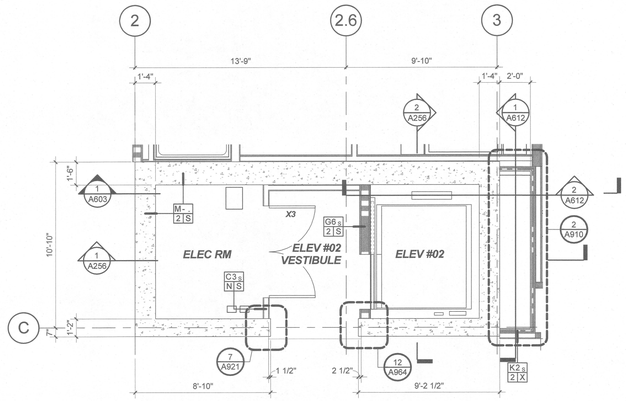

3 ELEVATOR #02 - LEVELS 2 THRU 6 FLOOR PLAN

SCALE: 1/4" = 1'-0"

LRS ARCHITECTS
720 NW Davis 503.221.1121
Suite 300 503.221.2077
Portland OR 97209 www.lrsarchitects.com

REGISTERED ARCHITECT
THOMAS PAUL FRANK
PORTLAND, OR
STATE OF OREGON

LEVERARCHITECTURE
4713 N ALBINA AVE, PDX OR 97217
T 503 928 6040
www.leverarchitecture.com

CONSULTANT:

PROJECT NUMBER: 215349

GRAND AVENUE APARTMENTS

1010 NE GRAND AVE. PORTLAND, OR 97232

SHEET TITLE:

NORTH ELEVATOR #02 ENLARGED PLANS

KEY PLAN:

DRAWN BY: Author
DATE CREATED: 08/18/16

City of Portland
REVIEWED FOR CODE COMPLIANCE
DEC 22 2017
Permit Number

SHEET:

A255

PERMIT SET
07-14-2017

LRS Architects, Inc. ©2017

C:\300 Revit Local Files\BIM Support\215349_Grand Ave Apts_Arch_R17_kschneider.rvt
9/5/2017 3:25:44 PM

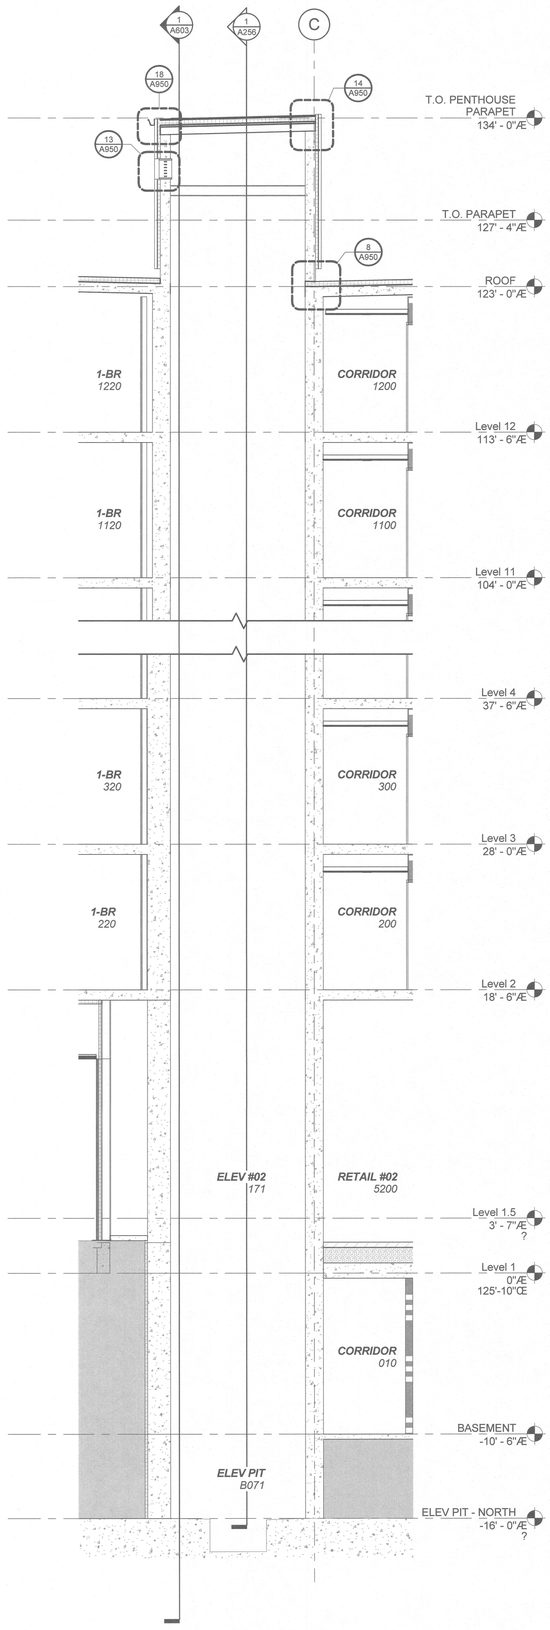

2 ELEVATOR #02 - SECTION 2

SCALE: 1/4" = 1'-0"

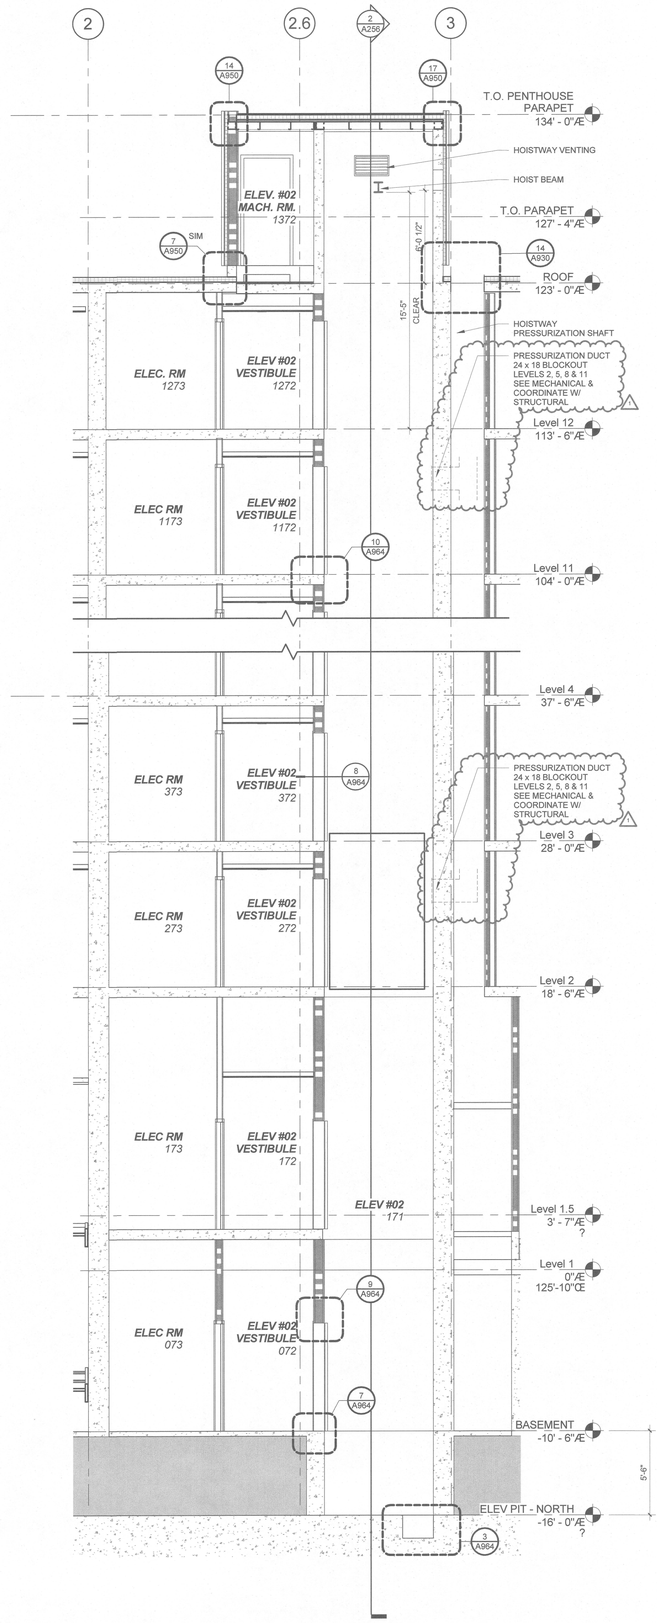

1 ELEVATOR #02 - SECTION 1

SCALE: 1/4" = 1'-0"

LRS ARCHITECTS
720 NW Davis 503.221.1121
Suite 300 503.221.2077
Portland OR 97209 www.lrsarchitects.com

REGISTERED ARCHITECT THOMAS PAUL CARR PORTLAND, OR STATE OF OREGON

LEVERARCHITECTURE
4713 N ALBINA AVE, PDX OR 97217
T 503 928 6040
www.leverarchitecture.com

CONSULTANT:

PROJECT NUMBER: 215349

GRAND AVENUE APARTMENTS

1010 NE GRAND AVE. PORTLAND, OR 97232

SHEET TITLE:

NORTH ELEVATOR #02 SECTIONS

KEY PLAN:

DRAWN BY: Author
DATE CREATED: 05/03/17

1	ADDENDUM #01	08/11/2017
2	ADDENDUM #02	XX/XX/XXXX

City of Portland RESIDENTIAL CODE COMPLIANCE DEC 22 2017 Bureau of Development Services

RECEIVED SEP 06 2017 BDS DOCUMENT SERVICES

SHEET: A256

PERMIT SET 07-14-2017

LRS Architects, Inc. ©2017

C:\300 Revit Local Files\BIM Support\215349_Grand Ave Apts_Arch_R17_kschneider.rvt
9/5/2017 3:25:49 PM

KEY PLAN

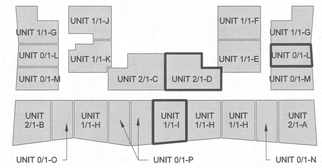

* HIGHLIGHTED UNITS RELATIVE TO VIEWS ON SHEET

GENERAL

A. DIMENSIONS ARE TO FACE OF FRAMING, UON, OR DIMENSIONS ARE TO CENTER OF WINDOW OPENING, COLUMN OR GRID, EXTERIOR DIMENSIONS ARE TO FACE OF FOUNDATION/FACE OF FRAMING.DIMENSIONS INDICATED AS "CLEAR MINIMUM" ARE TO FACE OF FINISH.
B. SEE A100 SHEET FOR STANDARD FIXTURE MOUNTING HEIGHTS AND REQUIREMENTS, UON.
C. SEE A700 WINDOW LOCATION PLANS & WINDOW SCHEDULE FOR SIZE & TYPE
D. ALL DOOR OPENINGS PERPENDICULAR TO A WALL ARE 5" TO THE WALL, UON.
E. DOTTED BOXES AND CIRCLES DESIGNATE ACCESSIBLE CLEAR FLOOR AREA SPACES FOR REFERENCE.
F. SEE 1/8" PLANS AND KEY PLAN FOR UNIT LOCATION AND ORIENTATION.
G. CEILING FIXTURES ARE SHOWN FOR REFERENCE ONLY FOR COORDINATION WITH CEILING FINISH SYSTEM. SEE MECHANICAL, ELECTRICAL AND SPRINKLER DRAWINGS FOR ALL CEILING FIXTURES AND TYPES.
H. SPOT ELEVATIONS ARE FROM FINISH FLOOR TO SURFACE FINISH OF CEILING AND ARE ROUNDED TO THE NEAREST INCH (TYP).
I. ALL CEILING HEIGHTS ARE 7' - 8", UON.
J. CEILING FIXTURES TO BE CENTERED OR EQUALLY SPACED AND ALIGNED IN ROOM, UON.
K. SEE A170 FOR RECESSED CEILING FIXTURE WRAP REQUIREMENTS.

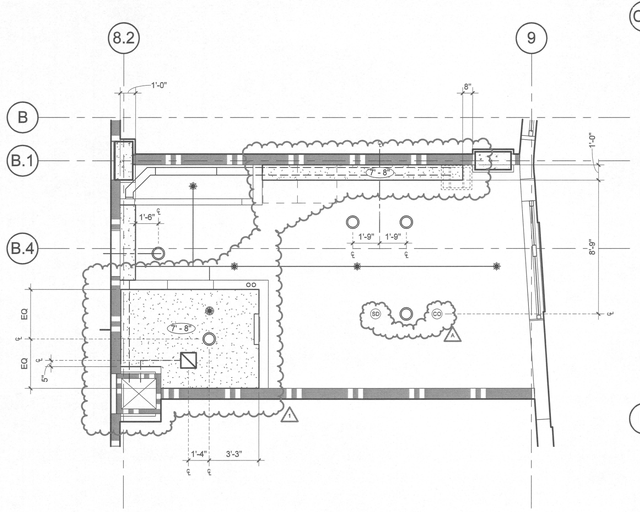

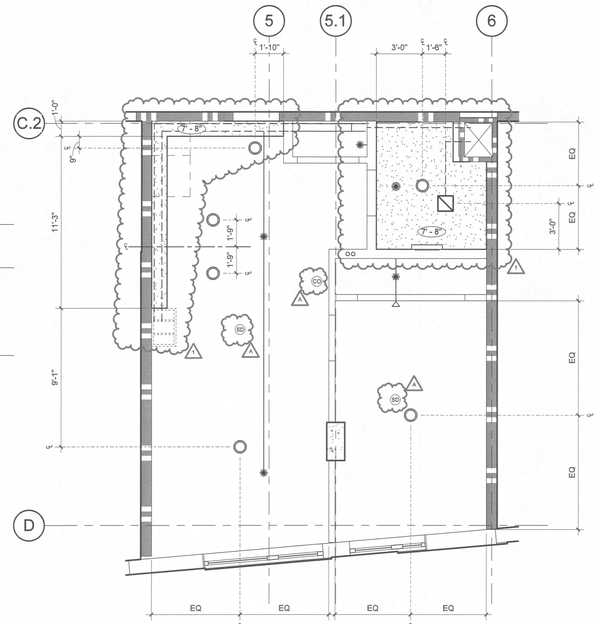

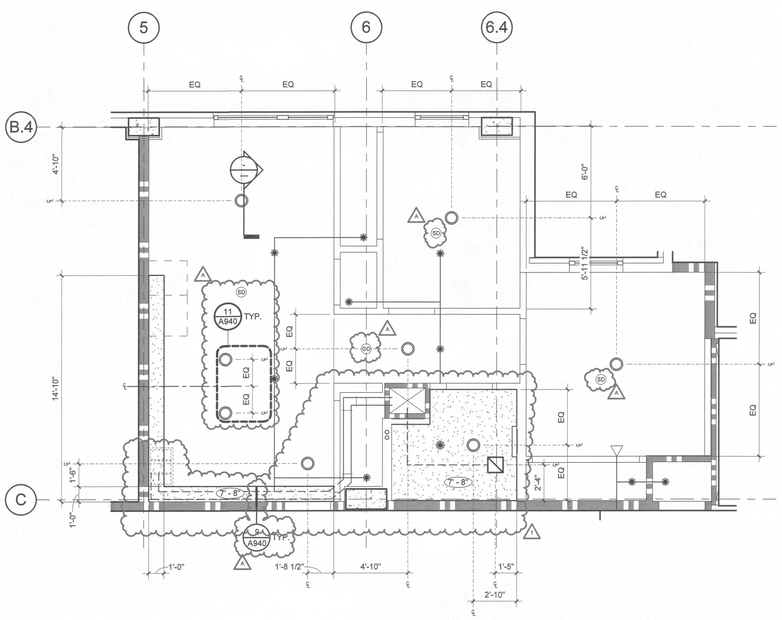

LEGEND: RCP

- X'-X" — FINISH CEILING HEIGHT, A.F.F.
- GYPSUM BOARD CEILING / SOFFIT
- STUCCO CEILING / SOFFIT
- EXPOSED DUCT
- RANGE HOOD
- EXHAUST FAN
- EXPOSED SPRINKLER HEAD
- CONCEALED SPRINKLER HEAD
- SIDE WALL MOUNTED SPRINKLER HEAD
- EXPOSED SPRINKLER PIPE
- LINEAR VANITY LIGHT
- WATER SUPPLY RISERS
- SURFACE MOUNTED ROUND LIGHT
- SD — SMOKE DETECTOR
- CO — CARBON MONOXIDE DETECTOR

RCP

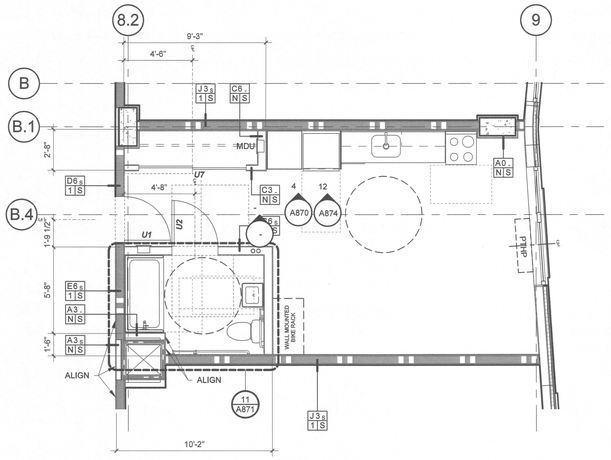

RCP

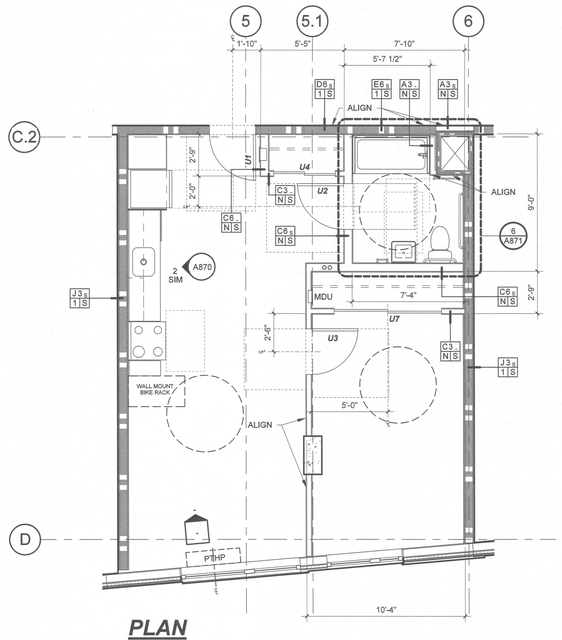

RCP

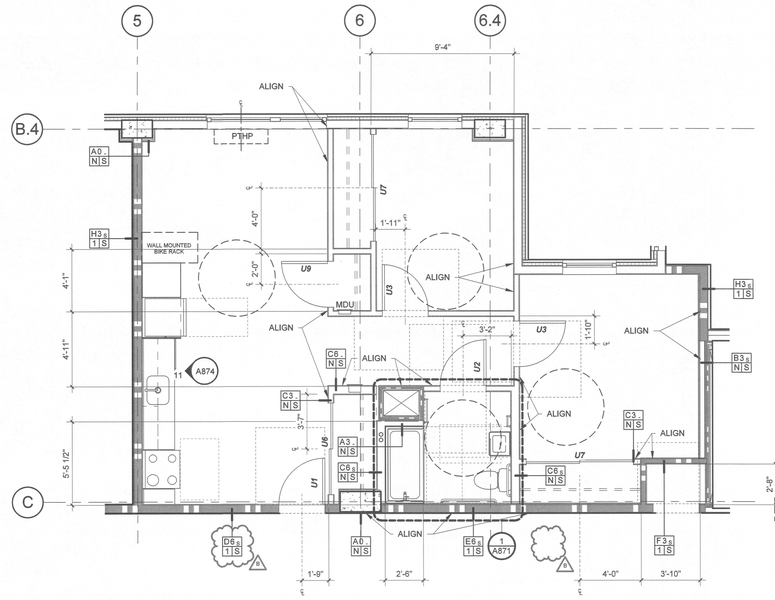

PLAN

3 UNIT 0/1-L TYPE-A

SCALE: 1/4" = 1'-0"

UNITS: 203, 403, 603, 703, 903, 1103

PLAN

2 UNIT 1/1-I TYPE-A

SCALE: 1/4" = 1'-0"

UNITS: 311, 411, 511, 811, 1011

PLAN

1 UNIT 2/1-D TYPE-A

SCALE: 1/4" = 1'-0"

UNITS: 210, 410, 610, 710, 910, 1110

WALL TYPES LEGEND

RESIDENTIAL UNIT WALL TYPES - TYP. UON

- C3 N S — -TYPICAL UNIT INTERIOR WALL
- C6 N S — -TYPICAL UNIT INTERIOR PLUMBING WALL
- K2 2 S — -TYPICAL SHAFT WALL

LEGEND:

- ELECTRICAL PANEL
- WATER SUPPLY RISERS
- MDU — MEDIA DISTRIBUTION UNIT (MDU)
- PTHP
- SHELF AND CLOTHES ROD
- WALL MOUNTED BIKE RACK — 2'-0" X 3'-8" VERTICAL BIKE RACK

This plan matches that approved by Planning and includes all notes from other reviews.
T. Rodgers-Ellis (name) (date) 11/29/17

RECEIVED
OCT 10 2017
BDS
DOCUMENT SERVICES

REVISIONS
DEC 22 2017
Permit Number:

LRS ARCHITECTS
720 NW Davis
Suite 300
Portland OR 97209 www.lrsarchitects.co

REGISTERED ARCHITECT
THOMAS PAUL FRANK
PORTLAND, OR
STATE OF OREGON

LEVERARCHITECTURE
4713 N ALBINA AVE, PDX OR 97217
T 503 928 6040

CONSULTANT:

PROJECT NUMBER: 215349

1010 NE GRAND AVE. PORTLAND, OR 97232

SHEET TITLE:
UNIT PLAN AND RCP - TYPE A UNITS

KEY PLAN:

DRAWN BY: KS,SB
DATE CREATED: 04/24/2017

1	ADDENDUM #01	08/11/2017
A	PLAN CHECK	09/01/2017
B	PLAN CHECK #02	09/22/2017

SHEET:
A260
PERMIT SET
07-14-2017

LRS Architects, Inc. ©2017

C:\300 Revit Local Files\BIM Support\215349_Grand Ave Apts_Arch_R17_mstanner.rvt
10/9/2017 11:32:52 AM

KEY PLAN

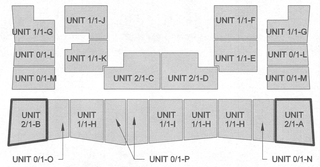

* HIGHLIGHTED UNITS RELATIVE TO VIEWS ON SHEET

GENERAL

A. DIMENSIONS ARE TO FACE OF FRAMING, UON, OR DIMENSIONS ARE TO CENTER OF WINDOW OPENING, COLUMN OR GRID. EXTERIOR DIMENSIONS ARE TO FACE OF FOUNDATION/FACE OF FRAMING.DIMENSIONS INDICATED AS "CLEAR MINIMUM" ARE TO FACE OF FINISH.
B. SEE A100 SHEET FOR STANDARD FIXTURE MOUNTING HEIGHTS AND REQUIREMENTS, UON.
C. SEE A700 WINDOW LOCATION PLANS & WINDOW SCHEDULE FOR SIZE & TYPE
D. ALL DOOR OPENINGS PERPENDICULAR TO A WALL ARE 5" TO THE WALL, UON.
E. DOTTED BOXES AND CIRCLES DESIGNATE ACCESSIBLE CLEAR FLOOR AREA SPACES FOR REFERENCE.
F. SEE 1/8" PLANS AND KEY PLAN FOR UNIT LOCATION AND ORIENTATION.
G. CEILING FIXTURES ARE SHOWN FOR REFERENCE ONLY FOR COORDINATION WITH CEILING FINISH SYSTEM. SEE MECHANICAL, ELECTRICAL AND SPRINKLER DRAWINGS FOR ALL CEILING FIXTURES AND TYPES.
H. SPOT ELEVATIONS ARE FROM FINISH FLOOR TO SURFACE FINISH OF CEILING AND ARE ROUNDED TO THE NEAREST INCH (TYP).
I. ALL CEILING HEIGHTS ARE 7' - 8", UON.
J. CEILING FIXTURES TO BE CENTERED OR EQUALLY SPACED AND ALIGNED IN ROOM, UON.
K. SEE A170 FOR RECESSED CEILING FIXTURE WRAP REQUIREMENTS.

LEGEND: RCP

- X'-X" — FINISH CEILING HEIGHT, A.F.F.
- GYPSUM BOARD CEILING / SOFFIT
- STUCCO CEILING / SOFFIT
- EXPOSED DUCT
- RANGE HOOD
- EXHAUST FAN
- EXPOSED SPRINKLER HEAD
- CONCEALED SPRINKLER HEAD
- SIDE WALL MOUNTED SPRINKLER HEAD
- EXPOSED SPRINKLER PIPE
- LINEAR VANITY LIGHT
- WATER SUPPLY RISERS
- SURFACE MOUNTED ROUND LIGHT
- SMOKE DETECTOR
- CARBON MONOXIDE DETECTOR

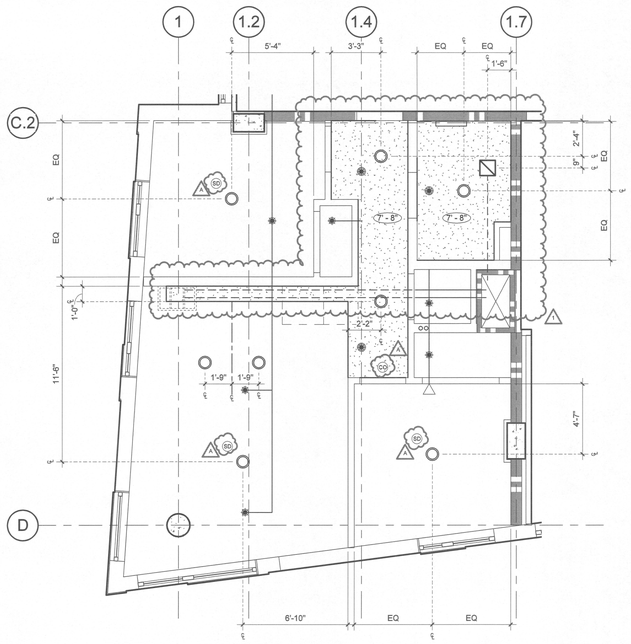

RCP

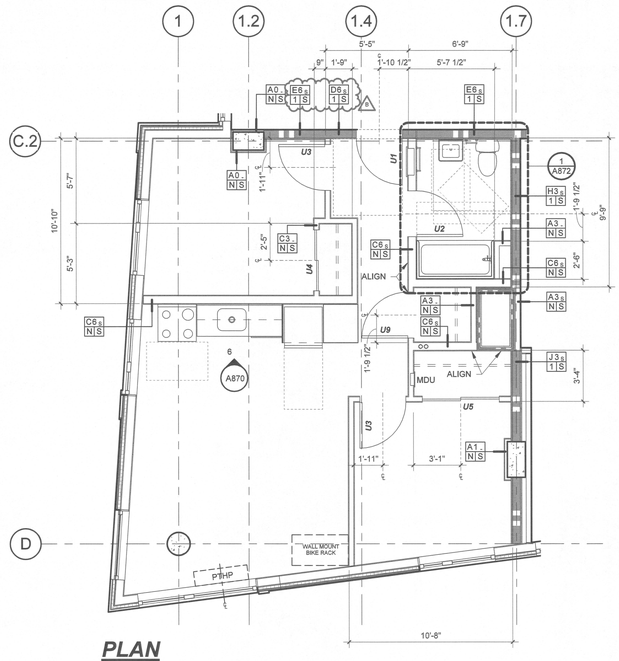

PLAN

2 UNIT 2/1-B
SCALE: 1/4" = 1'-0"

UNITS: X17 (LEVELS 2 THRU 12)

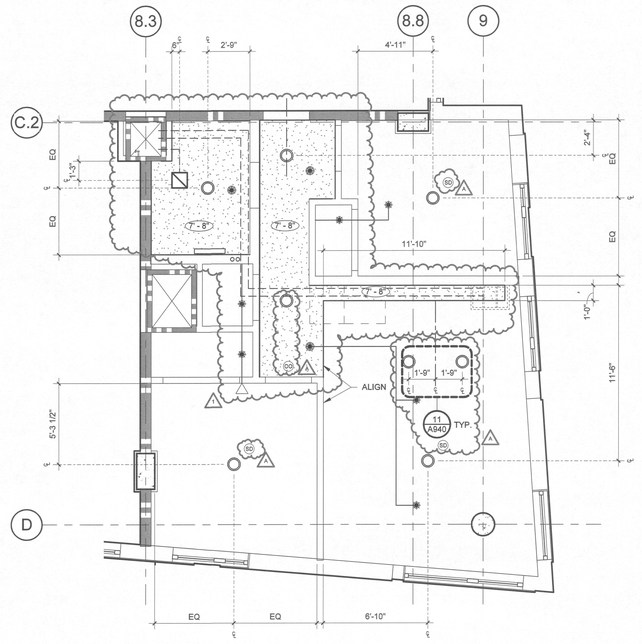

RCP

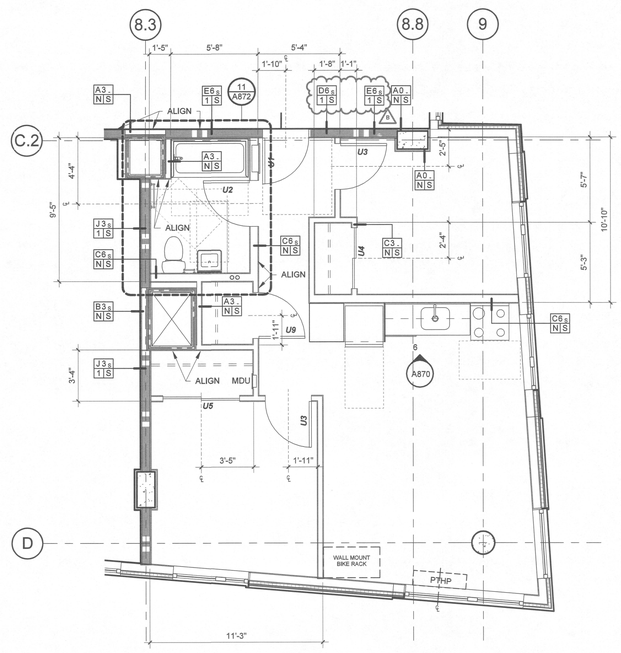

PLAN

1 UNIT 2/1-A
SCALE: 1/4" = 1'-0"

UNITS: X06 (LEVELS 2 THRU 11)

WALL TYPES LEGEND

RESIDENTIAL UNIT WALL TYPES - TYP. UON

- C3 N|S — -TYPICAL UNIT INTERIOR WALL
- C6 N|S — -TYPICAL UNIT INTERIOR PLUMBING WALL
- K2 2|S — -TYPICAL SHAFT WALL

This plan matches that approved by Planning and includes all notes from other reviews.
K. BOGEN-EARLY (name) (date) 11/29/17

LEGEND:

- ELECTRICAL PANEL
- WATER SUPPLY RISERS
- MDU — MEDIA DISTRIBUTION UNIT (MDU)
- PTHP
- SHELF AND CLOTHES ROD
- WALL MOUNTED BIKE RACK — 2'-0" X 3'-8" VERTICAL BIKE RACK

LRS ARCHITECTS
720 NW Davis
Suite 300
Portland OR 97209 www.lrsarchitects.co

REGISTERED ARCHITECT — THOMAS PAUL FRANK — PORTLAND, OR — STATE OF OREGON

LEVERARCHITECTURE
4713 N ALBINA AVE, PDX OR 97217
T 503 928 6040

CONSULTANT:

PROJECT NUMBER: 215349

1010 NE GRAND AVE. PORTLAND, OR 97232

SHEET TITLE:
UNIT PLANS AND RCP

KEY PLAN:

DRAWN BY: KS,SB
DATE CREATED: 04/24/2017

1	ADDENDUM #01	08/11/2017
A	PLAN CHECK	08/01/2017
B	PLAN CHECK #02	09/22/2017

City of Portland REVIEWED FOR CODE COMPLIANCE DEC 22 2017 Permit Number

RECEIVED OCT 10 2017 BDS DOCUMENT SERVICES

SHEET: **A261**
PERMIT SET 07-14-2017

LRS Architects, Inc. ©2017

C:\300 Revit Local Files\BIM Support\215349_Grand Ave Apts_Arch_R17_mstanner.rvt
10/9/2017 11:32:17 AM

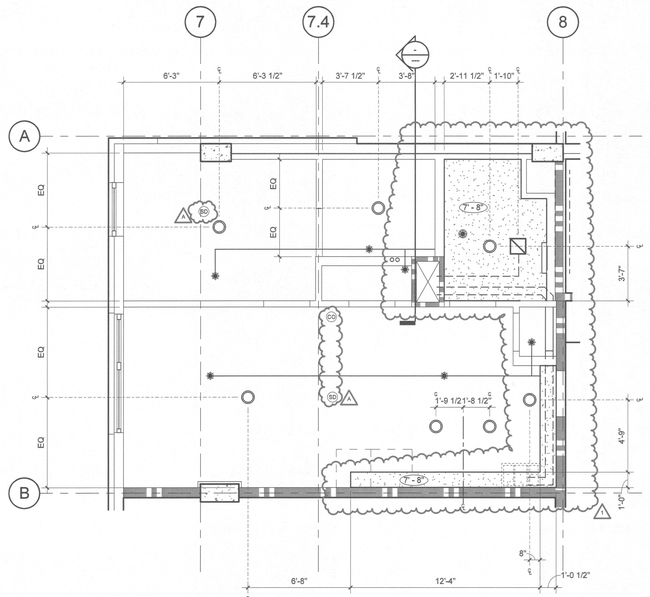

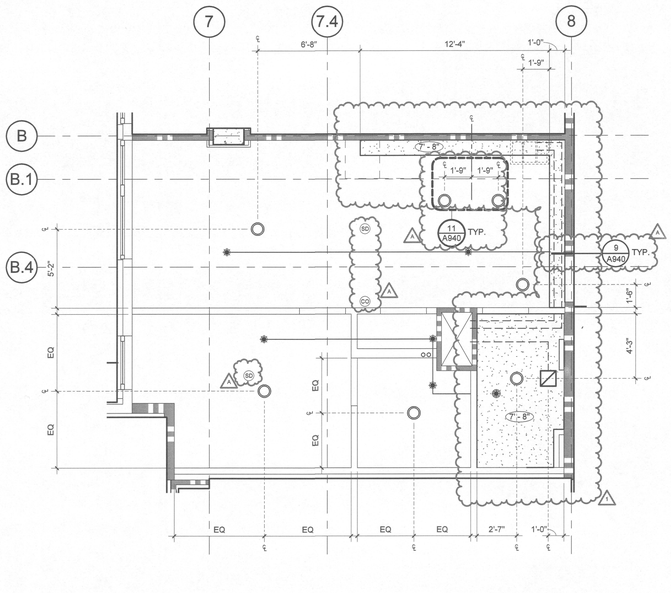

KEY PLAN

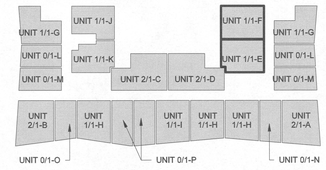

* HIGHLIGHTED UNITS RELATIVE TO VIEWS ON SHEET

GENERAL

A. DIMENSIONS ARE TO FACE OF FRAMING, UON, OR DIMENSIONS ARE TO CENTER OF WINDOW OPENING, COLUMN OR GRID. EXTERIOR DIMENSIONS ARE TO FACE OF FOUNDATION/FACE OF FRAMING.DIMENSIONS INDICATED AS "CLEAR MINIMUM" ARE TO FACE OF FINISH.
B. SEE A100 SHEET FOR STANDARD FIXTURE MOUNTING HEIGHTS AND REQUIREMENTS, UON.
C. SEE A700 WINDOW LOCATION PLANS & WINDOW SCHEDULE FOR SIZE & TYPE
D. ALL DOOR OPENINGS PERPENDICULAR TO A WALL ARE 5" TO THE WALL, UON.
E. DOTTED BOXES AND CIRCLES DESIGNATE ACCESSIBLE CLEAR FLOOR AREA SPACES FOR REFERENCE.
F. SEE 1/8" PLANS AND KEY PLAN FOR UNIT LOCATION AND ORIENTATION.
G. CEILING FIXTURES ARE SHOWN FOR REFERENCE ONLY FOR COORDINATION WITH CEILING FINISH SYSTEM. SEE MECHANICAL, ELECTRICAL AND SPRINKLER DRAWINGS FOR ALL CEILING FIXTURES AND TYPES.
H. SPOT ELEVATIONS ARE FROM FINISH FLOOR TO SURFACE FINISH OF CEILING AND ARE ROUNDED TO THE NEAREST INCH (TYP).
I. ALL CEILING HEIGHTS ARE 7' - 8", UON.
J. CEILING FIXTURES TO BE CENTERED OR EQUALLY SPACED AND ALIGNED IN ROOM, UON.
K. SEE A170 FOR RECESSED CEILING FIXTURE WRAP REQUIREMENTS.

LEGEND: RCP

- X'-X" — FINISH CEILING HEIGHT, A.F.F.
- GYPSUM BOARD CEILING / SOFFIT
- STUCCO CEILING / SOFFIT
- EXPOSED DUCT
- RANGE HOOD
- EXHAUST FAN
- EXPOSED SPRINKLER HEAD
- CONCEALED SPRINKLER HEAD
- SIDE WALL MOUNTED SPRINKLER HEAD
- EXPOSED SPRINKLER PIPE
- LINEAR VANITY LIGHT
- WATER SUPPLY RISERS
- SURFACE MOUNTED ROUND LIGHT
- SD — SMOKE DETECTOR
- CO — CARBON MONOXIDE DETECTOR

RCP

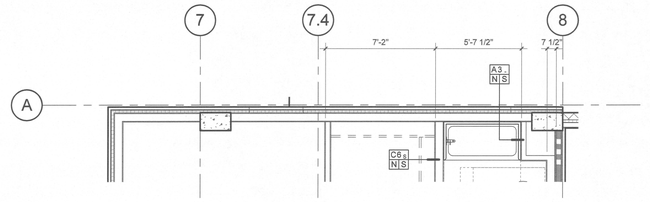

5 UNIT 1/1-F EAST WALL AT LEVELS 7 - 12

SCALE: 1/4" = 1'-0"

UNITS: 702, 802, 902, 1002, 1102, 1202

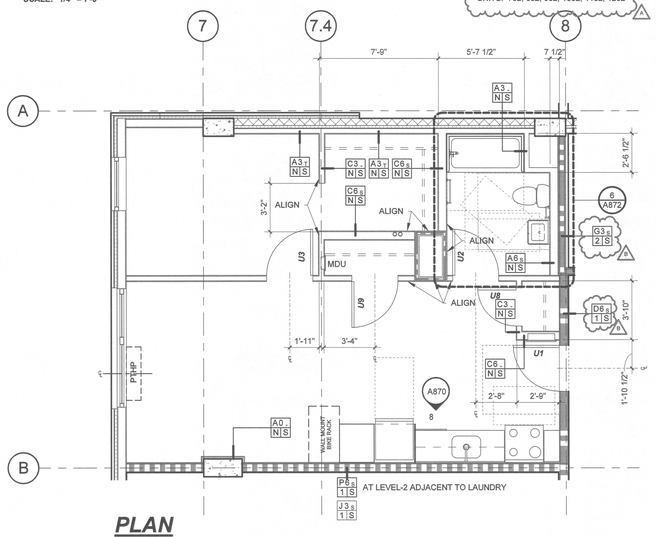

PLAN

3 UNIT 1/1-F EAST WALL AT LEVELS 2 - 6

SCALE: 1/4" = 1'-0"

UNITS: 202, 302, 402, 502, 602

RCP

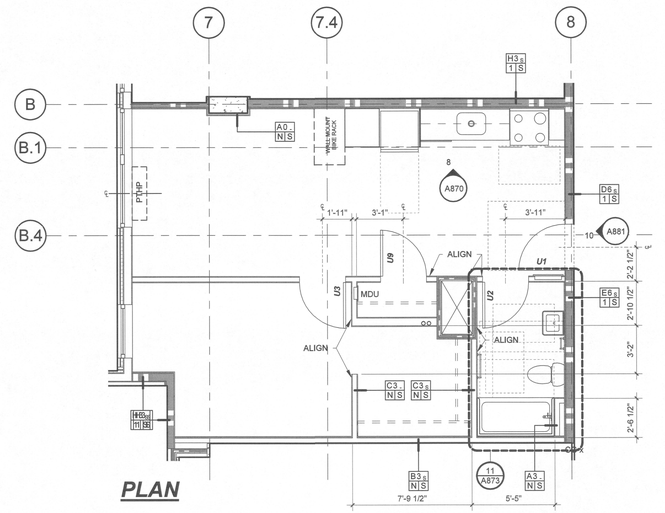

PLAN

1 UNIT 1/1-E

SCALE: 1/4" = 1'-0"

UNITS: X04 (LEVELS 3 THRU 12)

WALL TYPES LEGEND

RESIDENTIAL UNIT WALL TYPES - TYP. UON

- C3 N|S -TYPICAL UNIT INTERIOR WALL
- C6 N|S -TYPICAL UNIT INTERIOR PLUMBING WALL
- K2 2|S -TYPICAL SHAFT WALL

LEGEND:

- ELECTRICAL PANEL
- WATER SUPPLY RISERS
- MDU — MEDIA DISTRIBUTION UNIT (MDU)
- PTHP
- SHELF AND CLOTHES ROD
- WALL MOUNTED BIKE RACK — 2'-0" X 3'-8" VERTICAL BIKE RACK

This plan matches that approved by Planning and includes all notes from other reviews.
T. BORDEN-KING (name) DK (date) 11/29/17

LRS ARCHITECTS
720 NW Davis
Suite 300
Portland OR 97209 www.lrsarchitects.co

REGISTERED ARCHITECT — THOMAS PAUL FRANK — PORTLAND, OR — STATE OF OREGON

LEVERARCHITECTURE

4713 N ALBINA AVE, PDX OR 97217
T 503 928 6040

CONSULTANT:

PROJECT NUMBER: *215349*

1010 NE GRAND AVE. PORTLAND, OR 97232

SHEET TITLE:
UNIT PLANS AND RCP

KEY PLAN:

DRAWN BY: *KS,SB*
DATE CREATED: *04/24/2017*

1	ADDENDUM #01	08/11/2017
A	PLAN CHECK	09/01/2017
B	PLAN CHECK #02	09/22/2017

REVIEWED FOR CODE COMPLIANCE
DEC 22 2017
Permit Number

RECEIVED
OCT 10 2017
BDS DOCUMENT SERVICES

SHEET:
A262
PERMIT SET
07-14-2017

LRS Architects, Inc. ©2017

KEY PLAN

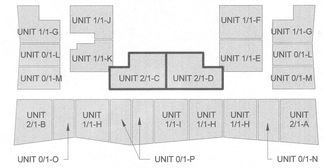

* HIGHLIGHTED UNITS RELATIVE TO VIEWS ON SHEET

GENERAL NOTES:

A. DIMENSIONS ARE TO FACE OF FRAMING, UON. OR DIMENSIONS ARE TO CENTER OF WINDOW OPENING, COLUMN OR GRID. EXTERIOR DIMENSIONS ARE TO FACE OF FOUNDATION/FACE OF FRAMING.DIMENSIONS INDICATED AS "CLEAR MINIMUM" ARE TO FACE OF FINISH.
B. SEE A100 SHEET FOR STANDARD FIXTURE MOUNTING HEIGHTS AND REQUIREMENTS, UON.
C. SEE A700 WINDOW LOCATION PLANS & WINDOW SCHEDULE FOR SIZE & TYPE
D. ALL DOOR OPENINGS PERPENDICULAR TO A WALL ARE 5° TO THE WALL, UON.
E. DOTTED BOXES AND CIRCLES DESIGNATE ACCESSIBLE CLEAR FLOOR AREA SPACES FOR REFERENCE.
F. SEE 1/8" PLANS AND KEY PLAN FOR UNIT LOCATION AND ORIENTATION.
G. CEILING FIXTURES ARE SHOWN FOR REFERENCE ONLY FOR COORDINATION WITH CEILING FINISH SYSTEM. SEE MECHANICAL, ELECTRICAL AND SPRINKLER DRAWINGS FOR ALL CEILING FIXTURES AND TYPES.
H. SPOT ELEVATIONS ARE FROM FINISH FLOOR TO SURFACE FINISH OF CEILING AND ARE ROUNDED TO THE NEAREST INCH (TYP).
I. ALL CEILING HEIGHTS ARE 7' - 8", UON.
J. CEILING FIXTURES TO BE CENTERED OR EQUALLY SPACED AND ALIGNED IN ROOM, UON.
K. SEE A170 FOR RECESSED CEILING FIXTURE WRAP REQUIREMENTS.

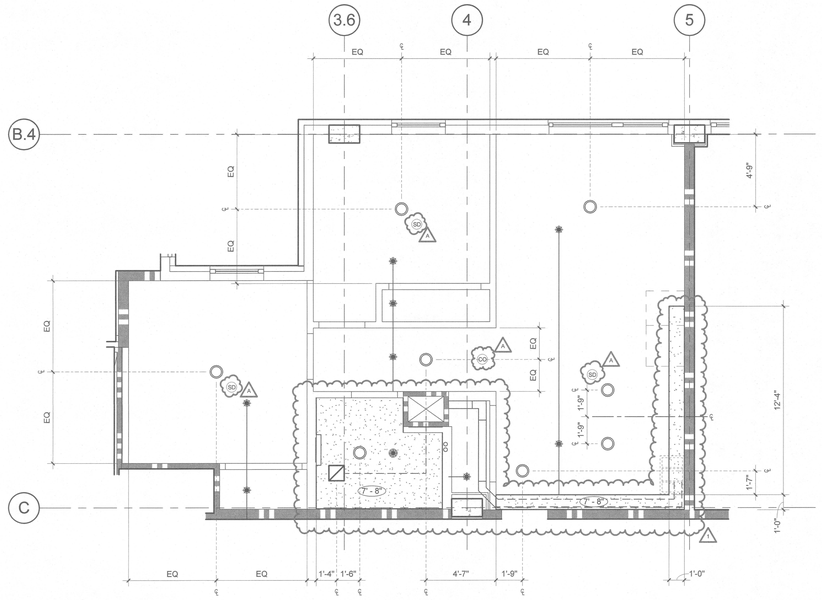

RCP

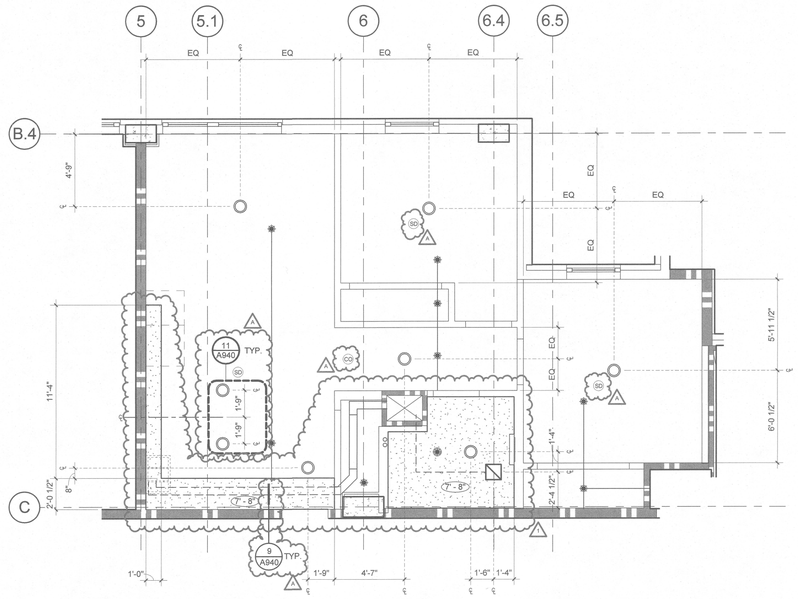

RCP

LEGEND: RCP

- FINISH CEILING HEIGHT, A.F.F.
- GYPSUM BOARD CEILING / SOFFIT
- STUCCO CEILING / SOFFIT
- EXPOSED DUCT
- RANGE HOOD
- EXHAUST FAN
- EXPOSED SPRINKLER HEAD
- CONCEALED SPRINKLER HEAD
- SIDE WALL MOUNTED SPRINKLER HEAD
- EXPOSED SPRINKLER PIPE
- LINEAR VANITY LIGHT
- WATER SUPPLY RISERS
- SURFACE MOUNTED ROUND LIGHT
- SMOKE DETECTOR
- CARBON MONOXIDE DETECTOR

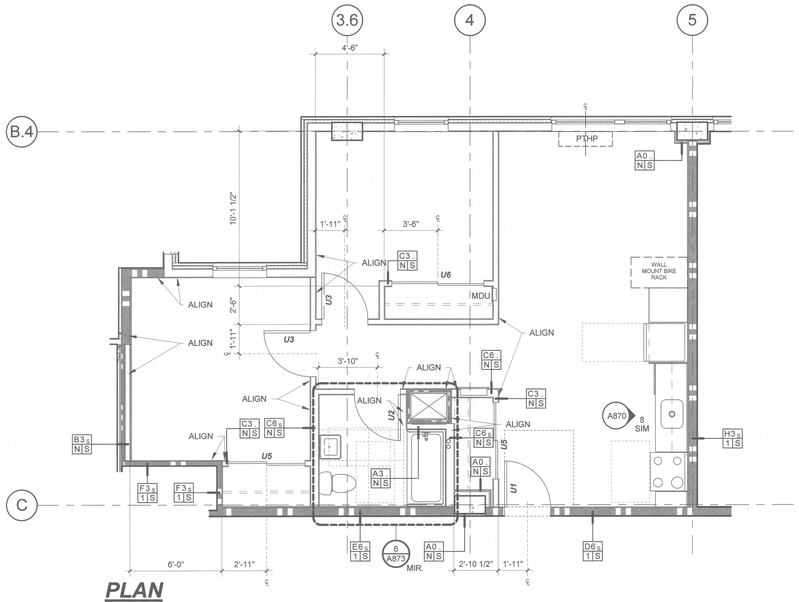

PLAN

2 UNIT 2/1-C

SCALE: 1/4" = 1'-0"

UNITS: X12 (LEVEL 2 THRU 12)

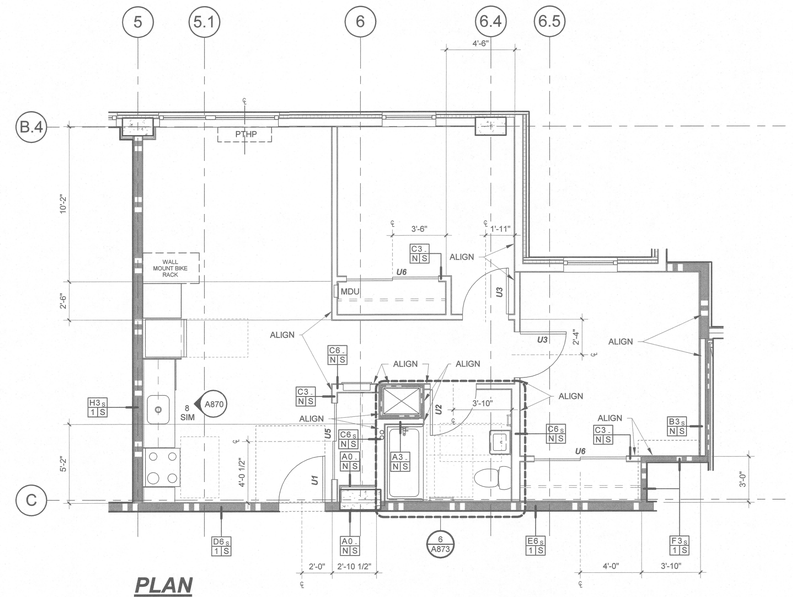

PLAN

1 UNIT 2/1-D

SCALE: 1/4" = 1'-0"

UNITS: 310, 510, 810, 1010, 1210

WALL TYPES LEGEND

RESIDENTIAL UNIT WALL TYPES - TYP. UON

- C3 N|S -TYPICAL UNIT INTERIOR WALL
- C6 N|S -TYPICAL UNIT INTERIOR PLUMBING WALL
- K2 2|S -TYPICAL SHAFT WALL

LEGEND: PLAN

- ELECTRICAL PANEL
- WATER SUPPLY RISERS
- MDU — MEDIA DISTRIBUTION UNIT (MDU)
- PTHP
- SHELF AND CLOTHES ROD
- WALL MOUNTED BIKE RACK — 2'-0" X 3'-8" VERTICAL BIKE RACK

This plan matches that approved by Planning and includes all notes from other reviews.
T. BORSUKOWSKI (name) DR (date) 11/25/17

LRS ARCHITECTS
720 NW Davis 503.221.1121
Suite 300 503.221.2077
Portland OR 97209 www.lrsarchitects.com

REGISTERED ARCHITECT — THOMAS PAUL BORSUKOWSKI — PORTLAND, OR — STATE OF OREGON

LEVERARCHITECTURE
4713 N ALBINA AVE, PDX OR 97217
T 503 928 6040
www.leverarchitecture.com

CONSULTANT:

PROJECT NUMBER: 215349

GRAND AVENUE APARTMENTS

1010 NE GRAND AVE. PORTLAND, OR 97232

SHEET TITLE:
UNIT PLANS AND RCP

KEY PLAN:

DRAWN BY: KS,SB
DATE CREATED: 04/24/2017

1	ADDENDUM #01	08/11/2017
A	PLAN CHECK	09/01/2017

CITY OF PORTLAND — REVIEWED FOR CODE COMPLIANCE — DEC 22 2017 — Kevin Hunter

RECEIVED — SEP 06 2017 — BDS DOCUMENT SERVICES

SHEET: A263

PERMIT SET 07-14-2017

LRS Architects, Inc. ©2017

C:\300 Revit Local Files\BIM Support\215349_Grand Ave Apts_Arch_R17_kschneider.rvt
9/5/2017 3:26:13 PM

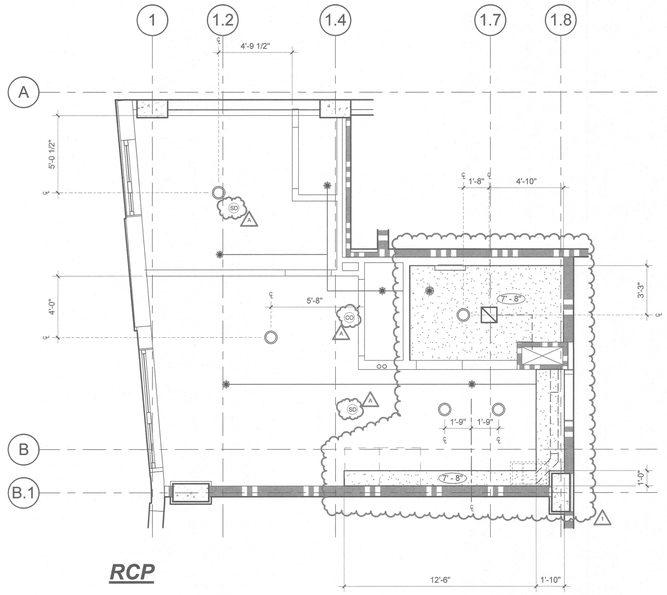

RCP

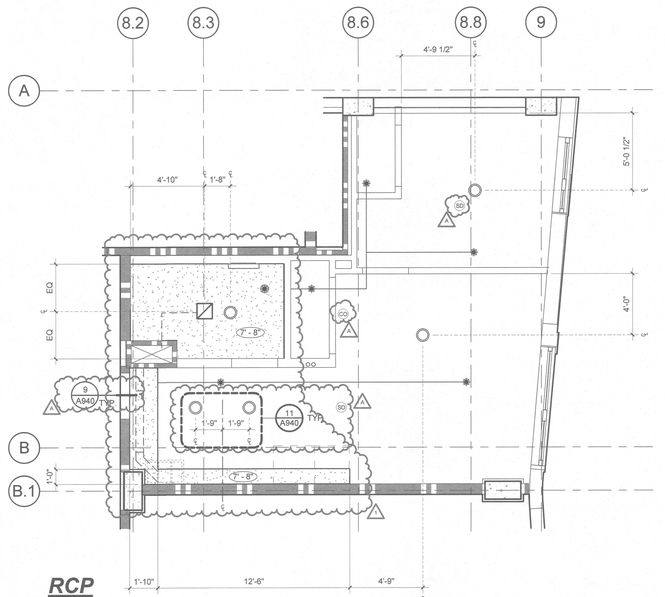

RCP

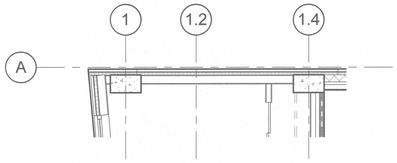

3 UNIT 1/1-G EAST WALL AT LEVELS 4 - 12

SCALE: 1/4" = 1'-0"

UNITS: 421, 521, 621, 721, 821, 921, 1021, 1121, 1221

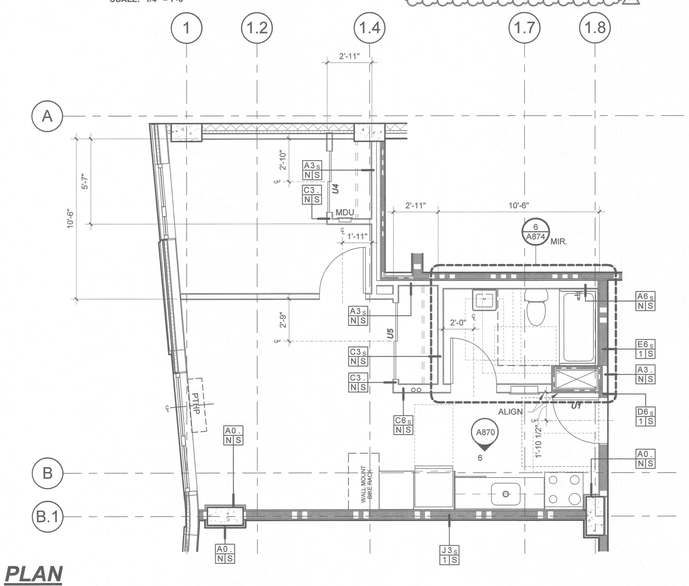

PLAN

4 UNIT 1/1-G EAST WALL AT LEVELS 2 - 3

SCALE: 1/4" = 1'-0"

UNITS: 221, 321

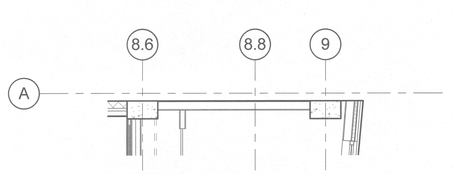

1 UNIT 1/1-G ALT EAST WALL AT LEVELS 9 - 12

SCALE: 1/4" = 1'-0"

UNITS: 901, 1001, 1101, 1201

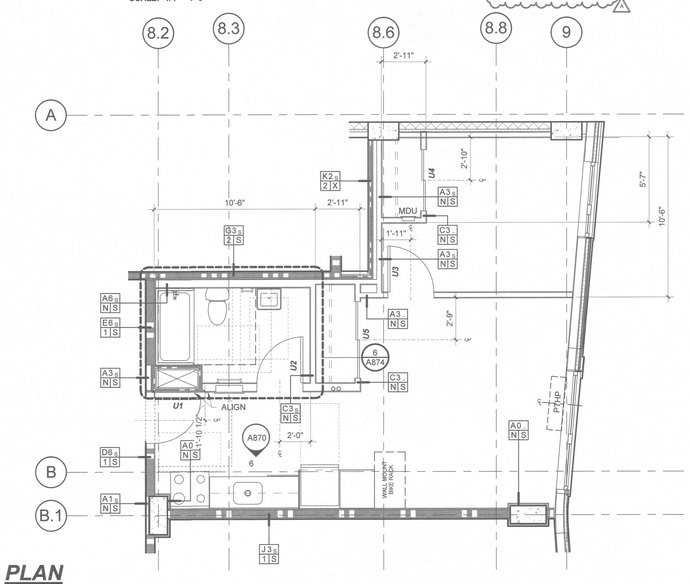

PLAN

2 UNIT 1/1-G EAST WALL AT LEVELS 2 - 8

SCALE: 1/4" = 1'-0"

UNITS: 201, 301, 401, 501, 601, 701, 801

KEY PLAN

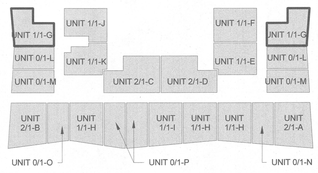

* HIGHLIGHTED UNITS RELATIVE TO VIEWS ON SHEET

GENERAL NOTES:

A. DIMENSIONS ARE TO FACE OF FRAMING, UON, OR DIMENSIONS ARE TO CENTER OF WINDOW OPENING, COLUMN OR GRID. EXTERIOR DIMENSIONS ARE TO FACE OF FOUNDATION/FACE OF FRAMING.DIMENSIONS INDICATED AS "CLEAR MINIMUM" ARE TO FACE OF FINISH.
B. SEE A100 SHEET FOR STANDARD FIXTURE MOUNTING HEIGHTS AND REQUIREMENTS, UON.
C. SEE A700 WINDOW LOCATION PLANS & WINDOW SCHEDULE FOR SIZE & TYPE
D. ALL DOOR OPENINGS PERPENDICULAR TO A WALL ARE 5" TO THE WALL, UON.
E. DOTTED BOXES AND CIRCLES DESIGNATE ACCESSIBLE CLEAR FLOOR AREA SPACES FOR REFERENCE.
F. SEE 1/8" PLANS AND KEY PLAN FOR UNIT LOCATION AND ORIENTATION.
G. CEILING FIXTURES ARE SHOWN FOR REFERENCE ONLY FOR COORDINATION WITH CEILING FINISH SYSTEM. SEE MECHANICAL, ELECTRICAL AND SPRINKLER DRAWINGS FOR ALL CEILING FIXTURES AND TYPES.
H. SPOT ELEVATIONS ARE FROM FINISH FLOOR TO SURFACE FINISH OF CEILING AND ARE ROUNDED TO THE NEAREST INCH (TYP).
I. ALL CEILING HEIGHTS ARE 7' - 8", UON.
J. CEILING FIXTURES TO BE CENTERED OR EQUALLY SPACED AND ALIGNED IN ROOM, UON.
K. SEE A170 FOR RECESSED CEILING FIXTURE WRAP REQUIREMENTS.

LEGEND: RCP

- X' - X' — FINISH CEILING HEIGHT, A.F.F.
- GYPSUM BOARD CEILING / SOFFIT
- STUCCO CEILING / SOFFIT
- EXPOSED DUCT
- RANGE HOOD
- EXHAUST FAN
- EXPOSED SPRINKLER HEAD
- CONCEALED SPRINKLER HEAD
- SIDE WALL MOUNTED SPRINKLER HEAD
- EXPOSED SPRINKLER PIPE
- LINEAR VANITY LIGHT
- WATER SUPPLY RISERS
- SURFACE MOUNTED ROUND LIGHT
- SMOKE DETECTOR
- CARBON MONOXIDE DETECTOR

WALL TYPES LEGEND

RESIDENTIAL UNIT WALL TYPES - TYP, UON

- C3 8 N S — -TYPICAL UNIT INTERIOR WALL
- C6 8 N S — -TYPICAL UNIT INTERIOR PLUMBING WALL
- K2 8 2 S — -TYPICAL SHAFT WALL

LEGEND: PLAN

- ELECTRICAL PANEL
- WATER SUPPLY RISERS
- MDU — MEDIA DISTRIBUTION UNIT (MDU)
- PTHP
- SHELF AND CLOTHES ROD
- WALL MOUNTED BIKE RACK — 2'-0" X 3'-8" VERTICAL BIKE RACK

This plan matches that approved by Planning and includes all notes from other reviews.
T. Bosken - LRS Arch (name) OK (date) 11/29/17

LRS ARCHITECTS
720 NW Davis 503.221.1121
Suite 300 503.221.2077
Portland OR 97209 www.lrsarchitects.com

REGISTERED ARCHITECT — THOMAS PAUL EARLY — PORTLAND, OR — STATE OF OREGON

LEVERARCHITECTURE
4713 N ALBINA AVE, PDX OR 97217
T 503 928 6040
www.leverarchitecture.com

CONSULTANT:

PROJECT NUMBER: 215349

GRAND AVENUE APARTMENTS

1010 NE GRAND AVE. PORTLAND, OR 97232

SHEET TITLE:

UNIT PLANS AND RCP

KEY PLAN:

DRAWN BY: KS,SB
DATE CREATED: 04/24/2017

1	ADDENDUM #01	08/11/2017
A	PLAN CHECK	09/01/2017

City of Portland BUREAU OF DEVELOPMENT SERVICES DEC 22 2017 Approved

RECEIVED SEP 06 2017 BDS DOCUMENT SERVICES

SHEET: **A264**

PERMIT SET 07-14-2017

LRS Architects, Inc. ©2017

C:\300 Revit Local Files\BIM Support\215349_Grand Ave Apts_Arch_R17_kschneider.rvt
9/5/2017 3:26:19 PM

KEY PLAN

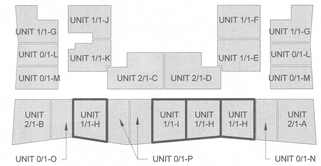

* HIGHLIGHTED UNITS RELATIVE TO VIEWS ON SHEET

GENERAL NOTES:

A. DIMENSIONS ARE TO FACE OF FRAMING, UON. OR DIMENSIONS ARE TO CENTER OF WINDOW OPENING, COLUMN OR GRID. EXTERIOR DIMENSIONS ARE TO FACE OF FOUNDATION/FACE OF FRAMING.DIMENSIONS INDICATED AS "CLEAR MINIMUM" ARE TO FACE OF FINISH.
B. SEE A100 SHEET FOR STANDARD FIXTURE MOUNTING HEIGHTS AND REQUIREMENTS, UON.
C. SEE A700 WINDOW LOCATION PLANS & WINDOW SCHEDULE FOR SIZE & TYPE.
D. ALL DOOR OPENINGS PERPENDICULAR TO A WALL ARE 5" TO THE WALL, UON.
E. DOTTED BOXES AND CIRCLES DESIGNATE ACCESSIBLE CLEAR FLOOR AREA SPACES FOR REFERENCE.
F. SEE 1/8" PLANS AND KEY PLAN FOR UNIT LOCATION AND ORIENTATION.
G. CEILING FIXTURES ARE SHOWN FOR REFERENCE ONLY FOR COORDINATION WITH CEILING FINISH SYSTEM. SEE MECHANICAL, ELECTRICAL AND SPRINKLER DRAWINGS FOR ALL CEILING FIXTURES AND TYPES.
H. SPOT ELEVATIONS ARE FROM FINISH FLOOR TO SURFACE FINISH OF CEILING AND ARE ROUNDED TO THE NEAREST INCH (TYP).
I. ALL CEILING HEIGHTS ARE 7' - 8", UON.
J. CEILING FIXTURES TO BE CENTERED OR EQUALLY SPACED AND ALIGNED IN ROOM, UON.
K. SEE A170 FOR RECESSED CEILING FIXTURE WRAP REQUIREMENTS.

LRS ARCHITECTS
720 NW Davis 503.221.1121
Suite 300 503.221.2077
Portland OR 97209 www.lrsarchitects.com

REGISTERED ARCHITECT
THOMAS PAUL KEARNS III
PORTLAND, OR
STATE OF OREGON

LEVERARCHITECTURE
4713 N ALBINA AVE, PDX OR 97217
T 503 928 6040
www.leverarchitecture.com
CONSULTANT:

LEGEND: RCP

- FINISH CEILING HEIGHT, A.F.F.
- GYPSUM BOARD CEILING / SOFFIT
- STUCCO CEILING / SOFFIT
- EXPOSED DUCT
- RANGE HOOD
- EXHAUST FAN
- EXPOSED SPRINKLER HEAD
- CONCEALED SPRINKLER HEAD
- SIDE WALL MOUNTED SPRINKLER HEAD
- EXPOSED SPRINKLER PIPE
- LINEAR VANITY LIGHT
- WATER SUPPLY RISERS
- SURFACE MOUNTED ROUND LIGHT
- SMOKE DETECTOR
- CARBON MONOXIDE DETECTOR

PROJECT NUMBER: 215349

GRAND AVENUE APARTMENTS

1010 NE GRAND AVE. PORTLAND, OR 97232

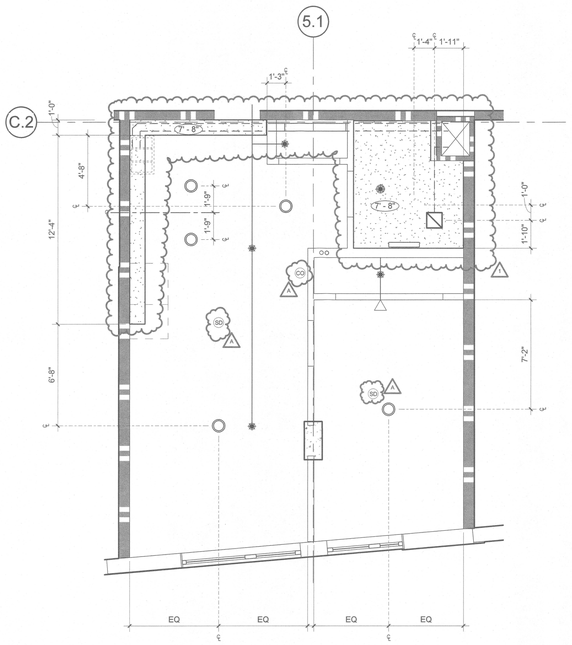

RCP

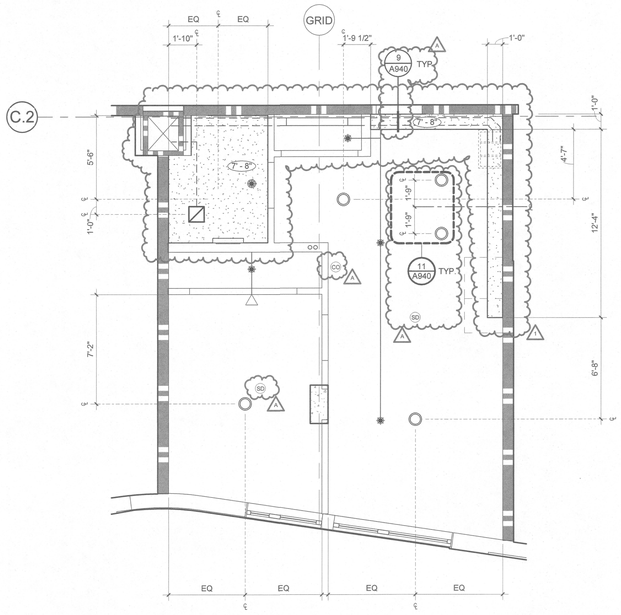

RCP

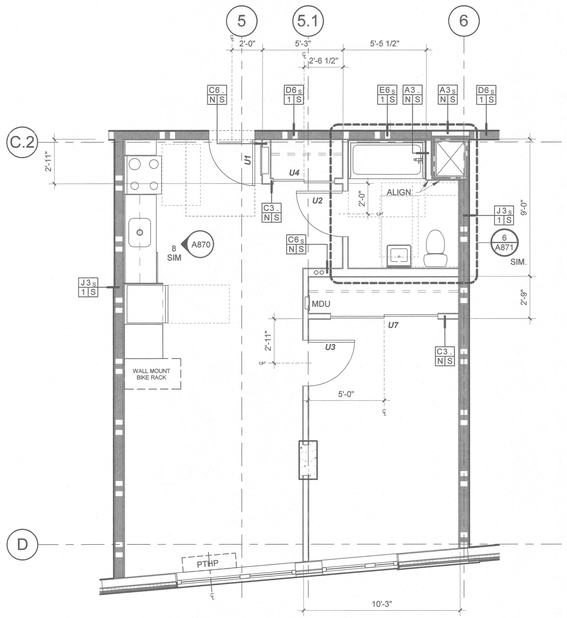

PLAN

2 UNIT 1/1-I

SCALE: 1/4" = 1'-0"

UNITS: 211, 611, 711, 911, 1111, 1211

RCP

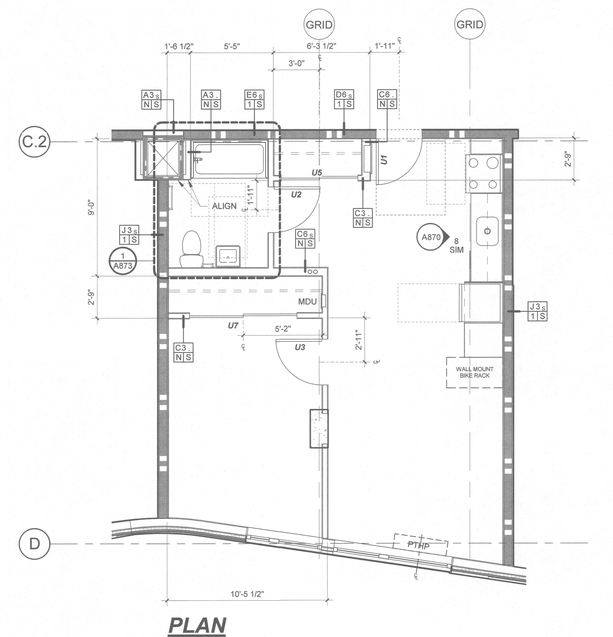

PLAN

1 UNIT 1/1-H

SCALE: 1/4" = 1'-0"

UNITS: X08 (LEVEL 2 THRU 12)
X15 (LEVEL 2 THRU 12)

UNITS (OPP):
X09 (LEVEL 2 THRU 12)

This plan matches that approved by Planning and includes all notes from other reviews.
T. Bosen-Ewalt (name) (date) 11/21/17

WALL TYPES LEGEND

RESIDENTIAL UNIT WALL TYPES - TYP. UON

- C3 N S -TYPICAL UNIT INTERIOR WALL
- C6 N S -TYPICAL UNIT INTERIOR PLUMBING WALL
- K2 2 S -TYPICAL SHAFT WALL

LEGEND: PLAN

- ELECTRICAL PANEL
- WATER SUPPLY RISERS
- MDU — MEDIA DISTRIBUTION UNIT (MDU)
- PTHP
- SHELF AND CLOTHES ROD
- WALL MOUNTED BIKE RACK — 2'-0" X 3'-8" VERTICAL BIKE RACK

SHEET TITLE:
UNIT PLANS AND RCP

KEY PLAN:

DRAWN BY: KS;SB
DATE CREATED: 04/24/2017

1	ADDENDUM #01	08/11/2017
A	PLAN CHECK	09/01/2017

City of Portland REVIEWED FOR CODE COMPLIANCE DEC 22 2017 Bureau of Development Services

RECEIVED SEP 06 2017 BDS DOCUMENT SERVICES

SHEET:
A265
PERMIT SET 07-14-2017

LRS Architects, Inc. ©2017

KEY PLAN

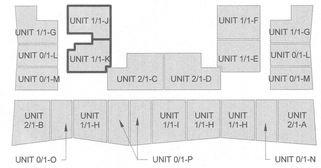

* HIGHLIGHTED UNITS RELATIVE TO VIEWS ON SHEET

GENERAL NOTES:

A. DIMENSIONS ARE TO FACE OF FRAMING, UON. OR DIMENSIONS ARE TO CENTER OF WINDOW OPENING, COLUMN OR GRID. EXTERIOR DIMENSIONS ARE TO FACE OF FOUNDATION/FACE OF FRAMING.DIMENSIONS INDICATED AS "CLEAR MINIMUM" ARE TO FACE OF FINISH.
B. SEE A100i SHEET FOR STANDARD FIXTURE MOUNTING HEIGHTS AND REQUIREMENTS, UON.
C. SEE A700 WINDOW LOCATION PLANS & WINDOW SCHEDULE FOR SIZE & TYPE
D. ALL DOOR OPENINGS PERPENDICULAR TO A WALL ARE 5" TO THE WALL, UON.
E. DOTTED BOXES AND CIRCLES DESIGNATE ACCESSIBLE CLEAR FLOOR AREA SPACES FOR REFERENCE
F. SEE 1/8" PLANS AND KEY PLAN FOR UNIT LOCATION AND ORIENTATION.
G. CEILING FIXTURES ARE SHOWN FOR REFERENCE ONLY FOR COORDINATION WITH CEILING FINISH SYSTEM. SEE MECHANICAL, ELECTRICAL AND SPRINKLER DRAWINGS FOR ALL CEILING FIXTURES AND TYPES.
H. SPOT ELEVATIONS ARE FROM FINISH FLOOR TO SURFACE FINISH OF CEILING AND ARE ROUNDED TO THE NEAREST INCH (TYP.).
I. ALL CEILING HEIGHTS ARE 7' - 8", UON.
J. CEILING FIXTURES TO BE CENTERED OR EQUALLY SPACED AND ALIGNED IN ROOM, UON.
K. SEE A170 FOR RECESSED CEILING FIXTURE WRAP REQUIREMENTS.

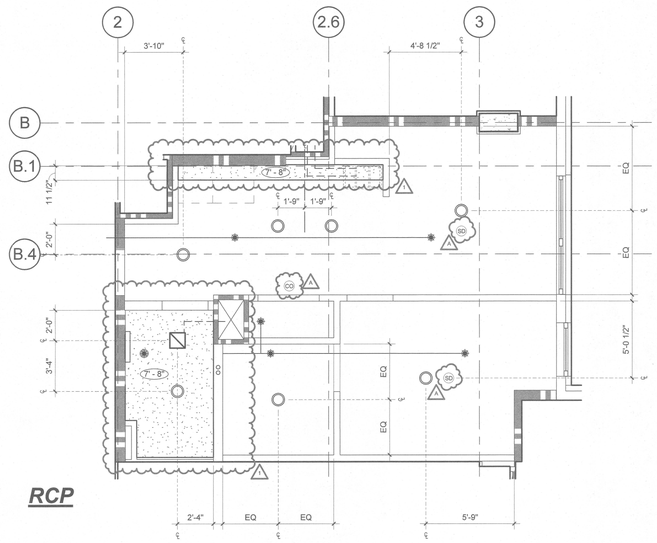

RCP

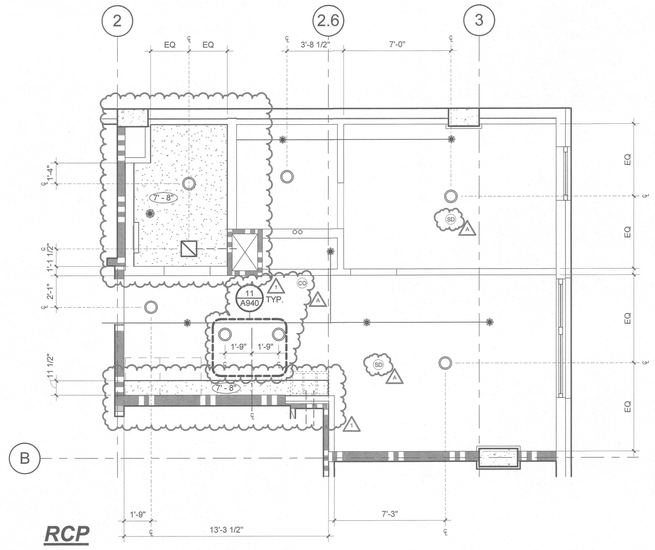

RCP

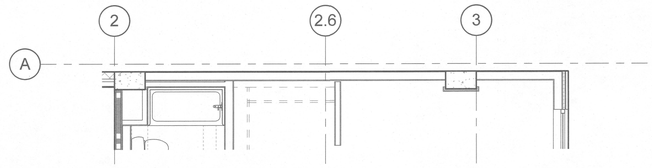

1 UNIT 1/1-J EAST WALL AT LEVELS 4 - 12

SCALE: 1/4" = 1'-0"

UNITS: 422, 522, 622, 722, 822, 922, 1022, 1122, 1222

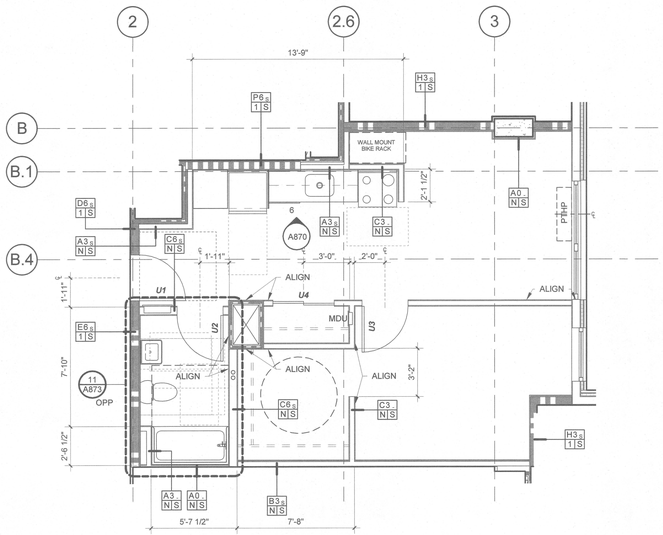

PLAN

3 UNIT 1/1-K

SCALE: 1/4" = 1'-0"

UNITS: X20 (LEVEL 2 THRU 12)

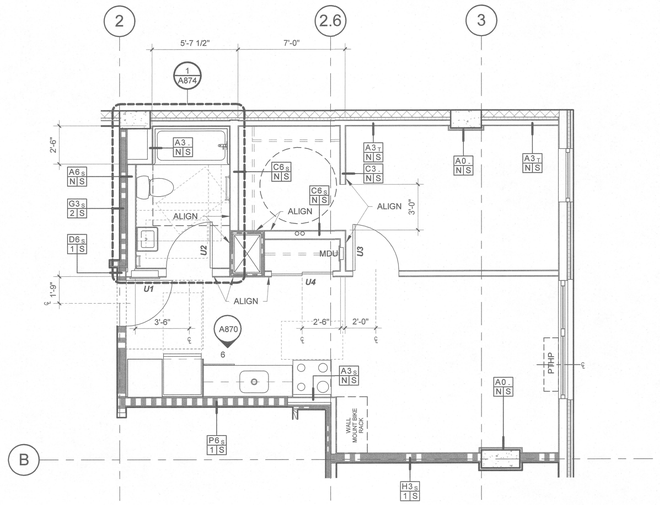

PLAN

2 UNIT 1/1-J EAST WALL AT LEVELS 2 - 3

SCALE: 1/4" = 1'-0"

UNITS: 222, 322

LEGEND: RCP

- FINISH CEILING HEIGHT, A.F.F.
- GYPSUM BOARD CEILING / SOFFIT
- STUCCO CEILING / SOFFIT
- EXPOSED DUCT
- RANGE HOOD
- EXHAUST FAN
- EXPOSED SPRINKLER HEAD
- CONCEALED SPRINKLER HEAD
- SIDE WALL MOUNTED SPRINKLER HEAD
- EXPOSED SPRINKLER PIPE
- LINEAR VANITY LIGHT
- WATER SUPPLY RISERS
- SURFACE MOUNTED ROUND LIGHT
- SMOKE DETECTOR
- CARBON MONOXIDE DETECTOR

WALL TYPES LEGEND

RESIDENTIAL UNIT WALL TYPES - TYP. UON

- C3.8 N S -TYPICAL UNIT INTERIOR WALL
- C6.8 N S -TYPICAL UNIT INTERIOR PLUMBING WALL
- K2.8 2 S -TYPICAL SHAFT WALL

LEGEND: PLAN

- ELECTRICAL PANEL
- WATER SUPPLY RISERS
- MDU — MEDIA DISTRIBUTION UNIT (MDU)
- PTHP
- SHELF AND CLOTHES ROD
- WALL MOUNTED BIKE RACK — 2'-0" X 3'-8" VERTICAL BIKE RACK

This plan matches that approved by Planning and includes all notes from other reviews.
T. Boden-King (name) (date) 11/15/17
DK 11/29/17

LRS ARCHITECTS
720 NW Davis 503.221.1121
Suite 300 503.221.2077
Portland OR 97209 www.lrsarchitects.com

REGISTERED ARCHITECT
THOMAS PAUL CRAWN
PORTLAND, OR
STATE OF OREGON

LEVERARCHITECTURE
4713 N ALBINA AVE, PDX OR 97217
T 503 928 6040
www.leverarchitecture.com

CONSULTANT:

PROJECT NUMBER: 215349

GRAND AVENUE APARTMENTS

1010 NE GRAND AVE. PORTLAND, OR 97232

SHEET TITLE:
UNIT PLANS AND RCP

KEY PLAN:

DRAWN BY: KS,SB
DATE CREATED: 04/24/2017

1	ADDENDUM #01	08/11/2017
A	PLAN CHECK	09/01/2017

City of Portland REVIEWED FOR CODE COMPLIANCE DEC 22 2017 Permit Services

RECEIVED SEP 06 2017 BDS DOCUMENT SERVICES

SHEET:
A266
PERMIT SET
07-14-2017

LRS Architects, Inc. ©2017

C:\300 Revit Local Files\BIM Support\215349_Grand Ave Apts_Arch_R17_kschneider.rvt
9/5/2017 3:26:31 PM

KEY PLAN

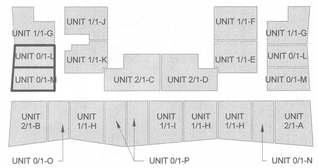

* HIGHLIGHTED UNITS RELATIVE TO VIEWS ON SHEET

GENERAL NOTES:

A. DIMENSIONS ARE TO FACE OF FRAMING, UON, OR DIMENSIONS ARE TO CENTER OF WINDOW OPENING, COLUMN OR GRID. EXTERIOR DIMENSIONS ARE TO FACE OF FOUNDATION/FACE OF FRAMING.DIMENSIONS INDICATED AS "CLEAR MINIMUM" ARE TO FACE OF FINISH.
B. SEE A100 SHEET FOR STANDARD FIXTURE MOUNTING HEIGHTS AND REQUIREMENTS, UON.
C. SEE A700 WINDOW LOCATION PLANS & WINDOW SCHEDULE FOR SIZE & TYPE
D. ALL DOOR OPENINGS PERPENDICULAR TO A WALL ARE 5" TO THE WALL, UON.
E. DOTTED BOXES AND CIRCLES DESIGNATE ACCESSIBLE CLEAR FLOOR AREA SPACES FOR REFERENCE.
F. SEE 1/8" PLANS AND KEY PLAN FOR UNIT LOCATION AND ORIENTATION.
G. CEILING FIXTURES ARE SHOWN FOR REFERENCE ONLY FOR COORDINATION WITH CEILING FINISH SYSTEM. SEE MECHANICAL, ELECTRICAL AND SPRINKLER DRAWINGS FOR ALL CEILING FIXTURES AND TYPES.
H. SPOT ELEVATIONS ARE FROM FINISH FLOOR TO SURFACE FINISH OF CEILING AND ARE ROUNDED TO THE NEAREST INCH (TYP).
I. ALL CEILING HEIGHTS ARE 7' - 8", UON.
J. CEILING FIXTURES TO BE CENTERED OR EQUALLY SPACED AND ALIGNED IN ROOM, UON.
K. SEE A170 FOR RECESSED CEILING FIXTURE WRAP REQUIREMENTS.

LEGEND: RCP

- (X - X') FINISH CEILING HEIGHT, A.F.F.
- GYPSUM BOARD CEILING / SOFFIT
- STUCCO CEILING / SOFFIT
- EXPOSED DUCT
- RANGE HOOD
- EXHAUST FAN
- EXPOSED SPRINKLER HEAD
- CONCEALED SPRINKLER HEAD
- SIDE WALL MOUNTED SPRINKLER HEAD
- EXPOSED SPRINKLER PIPE
- LINEAR VANITY LIGHT
- WATER SUPPLY RISERS
- SURFACE MOUNTED ROUND LIGHT
- SD SMOKE DETECTOR
- CO CARBON MONOXIDE DETECTOR

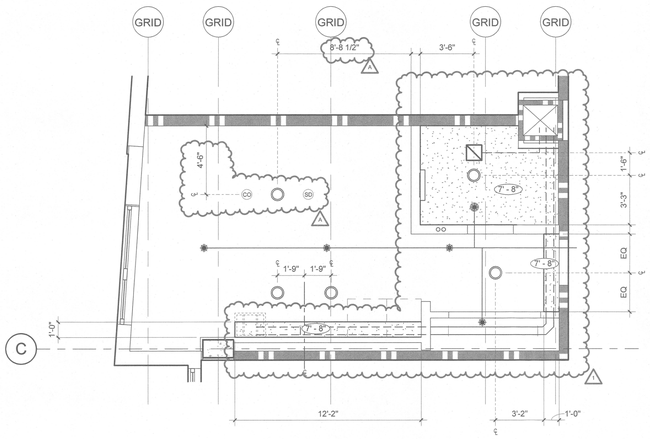

RCP

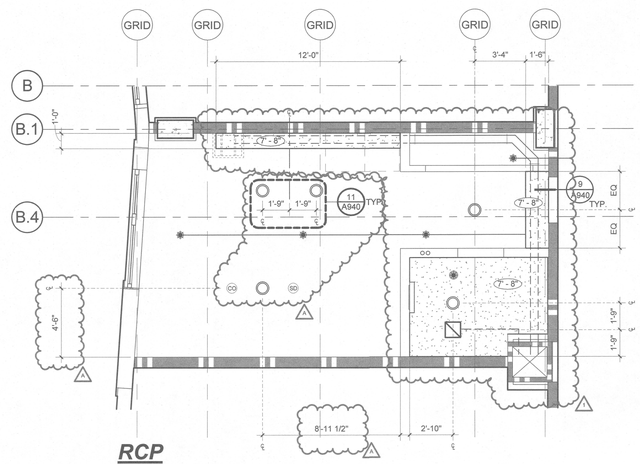

RCP

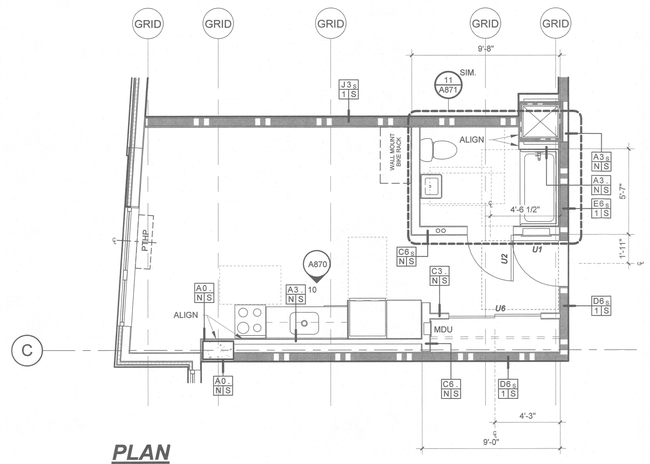

PLAN

2 UNIT 0/1-M

SCALE: 1/4" = 1'-0"

UNITS: X18 (LEVEL 2 THRU 12)
UNITS (OPP): X05 (LEVEL 2 THRU 12)

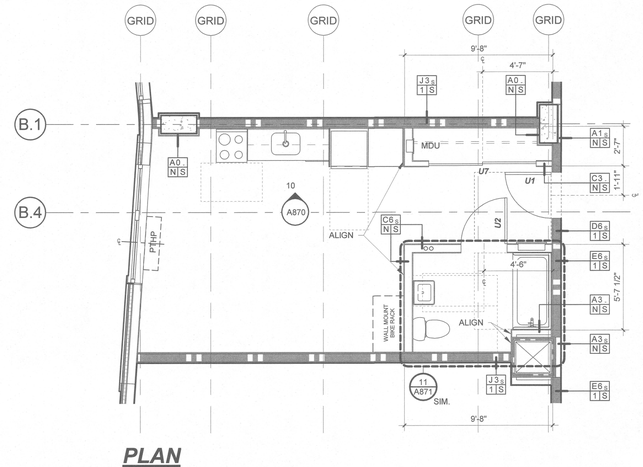

PLAN

1 UNIT 0/1-L

SCALE: 1/4" = 1'-0"

UNITS: 303, 503, 803, 1003, 1203
UNITS: X19 (LEVEL 2 THRU 12)

WALL TYPES LEGEND

RESIDENTIAL UNIT WALL TYPES - TYP. UON

- C3 N S -TYPICAL UNIT INTERIOR WALL
- C6 N S -TYPICAL UNIT INTERIOR PLUMBING WALL
- K2 2 S -TYPICAL SHAFT WALL

LEGEND: PLAN

- ELECTRICAL PANEL
- WATER SUPPLY RISERS
- MDU MEDIA DISTRIBUTION UNIT (MDU)
- PTHP
- SHELF AND CLOTHES ROD
- WALL MOUNTED BIKE RACK 2'-0" X 3'-8" VERTICAL BIKE RACK

This plan matches that approved by Planning and includes all notes from other reviews.
T. Robson-King (name) (date) 11/13/17
11/15/17

LRS ARCHITECTS
720 NW Davis 503.221.1121
Suite 300 503.221.2077
Portland OR 97209 www.lrsarchitects.com

REGISTERED ARCHITECT THOMAS PAUL KRAUSE PORTLAND, OR STATE OF OREGON

LEVERARCHITECTURE
4713 N ALBINA AVE, PDX OR 97217
T 503 928 6040
www.leverarchitecture.com

CONSULTANT:

PROJECT NUMBER: 215349

GRAND AVENUE APARTMENTS

1010 NE GRAND AVE. PORTLAND, OR 97232

SHEET TITLE:

UNIT PLANS AND RCP

KEY PLAN:

DRAWN BY: KS,SB
DATE CREATED: 04/24/2017

1	ADDENDUM #01	08/11/2017
A	PLAN CHECK	09/01/2017

CITY OF PORTLAND REVIEWED FOR CODE COMPLIANCE DEC 22 2017 Permit Attached

RECEIVED SEP 06 2017 BDS DOCUMENT SERVICES

SHEET:

A267

PERMIT SET 07-14-2017

LRS Architects, Inc. ©2017

C:\300 Revit Local Files\BIM Support\215349_Grand Ave Apts_Arch_R17_kschneider.rvt
9/5/2017 3:26:36 PM

KEY PLAN

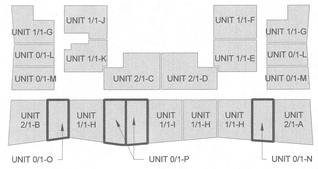

* HIGHLIGHTED UNITS RELATIVE TO VIEWS ON SHEET

GENERAL NOTES:

A. DIMENSIONS ARE TO FACE OF FRAMING, UON. OR DIMENSIONS ARE TO CENTER OF WINDOW OPENING, COLUMN OR GRID. EXTERIOR DIMENSIONS ARE TO FACE OF FOUNDATION/FACE OF FRAMING.DIMENSIONS INDICATED AS "CLEAR MINIMUM" ARE TO FACE OF FINISH.
B. SEE A100 SHEET FOR STANDARD FIXTURE MOUNTING HEIGHTS AND REQUIREMENTS, UON.
C. SEE A700 WINDOW LOCATION PLANS & WINDOW SCHEDULE FOR SIZE & TYPE
D. ALL DOOR OPENINGS PERPENDICULAR TO A WALL ARE 5" TO THE WALL, UON.
E. DOTTED BOXES AND CIRCLES DESIGNATE ACCESSIBLE CLEAR FLOOR AREA SPACES FOR REFERENCE.
F. SEE 1/8" PLANS AND KEY PLAN FOR UNIT LOCATION AND ORIENTATION.
G. CEILING FIXTURES ARE SHOWN FOR REFERENCE ONLY FOR COORDINATION WITH CEILING FINISH SYSTEM. SEE MECHANICAL, ELECTRICAL AND SPRINKLER DRAWINGS FOR ALL CEILING FIXTURES AND TYPES.
H. SPOT ELEVATIONS ARE FROM FINISH FLOOR TO SURFACE FINISH OF CEILING AND ARE ROUNDED TO THE NEAREST INCH (TYP).
I. ALL CEILING HEIGHTS ARE 7' - 8", UON.
J. CEILING FIXTURES TO BE CENTERED OR EQUALLY SPACED AND ALIGNED IN ROOM, UON.
K. SEE A170 FOR RECESSED CEILING FIXTURE WRAP REQUIREMENTS.

LEGEND: RCP

- X' - X" — FINISH CEILING HEIGHT, A.F.F.
- GYPSUM BOARD CEILING / SOFFIT
- STUCCO CEILING / SOFFIT
- EXPOSED DUCT
- RANGE HOOD
- EXHAUST FAN
- EXPOSED SPRINKLER HEAD
- CONCEALED SPRINKLER HEAD
- SIDE WALL MOUNTED SPRINKLER HEAD
- EXPOSED SPRINKLER PIPE
- LINEAR VANITY LIGHT
- WATER SUPPLY RISERS
- SURFACE MOUNTED ROUND LIGHT
- SD — SMOKE DETECTOR
- CO — CARBON MONOXIDE DETECTOR

LRS ARCHITECTS
720 NW Davis 503.221.1121
Suite 300 503.221.2077
Portland OR 97209 www.lrsarchitects.com

REGISTERED ARCHITECT — THOMAS PAUL LEVER — PORTLAND, OR — STATE OF OREGON

LEVERARCHITECTURE
4713 N ALBINA AVE, PDX OR 97217
T 503 928 6040
www.leverarchitecture.com

CONSULTANT:

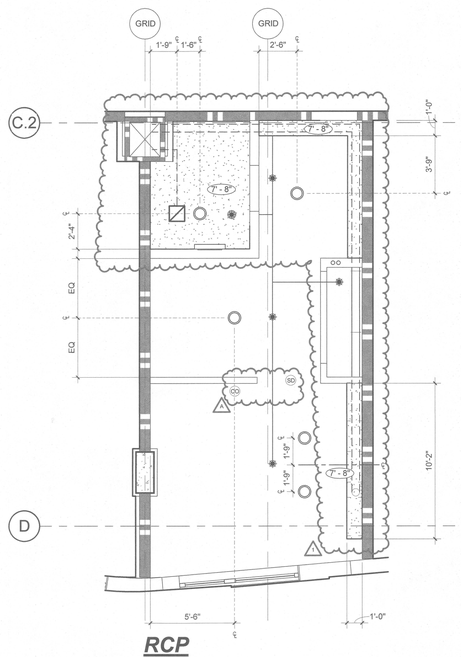

RCP

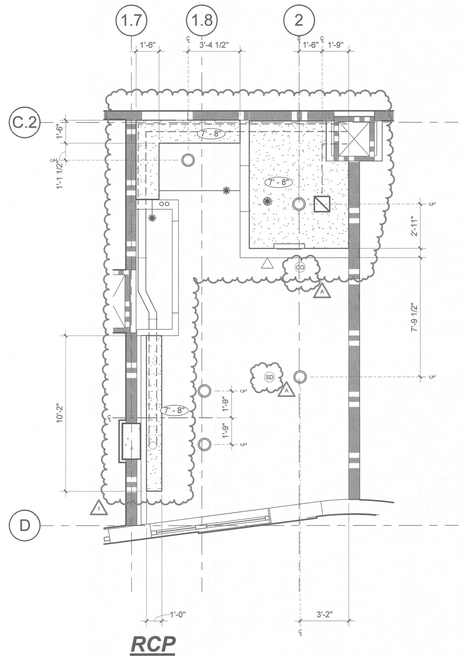

RCP

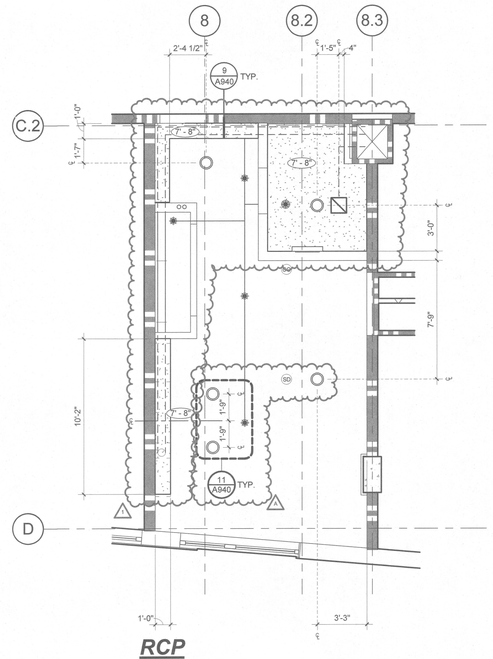

RCP

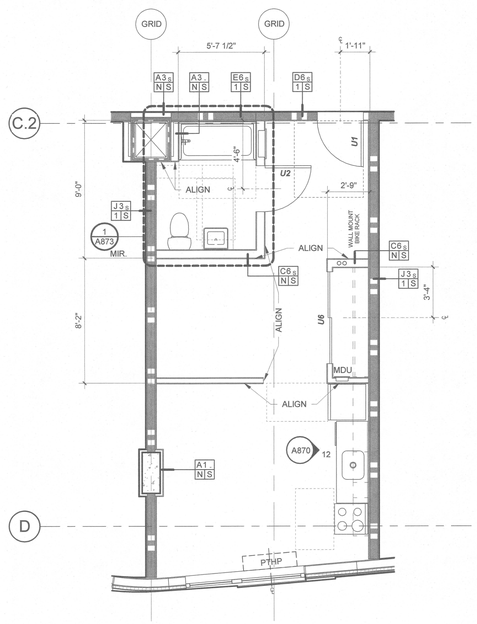

PLAN

3 UNIT 0/1-P

SCALE: 1/4" = 1'-0"

UNITS: X14 (LEVEL 2 THRU 12)
UNITS (OPP): X13 (LEVEL 2 THRU 12)

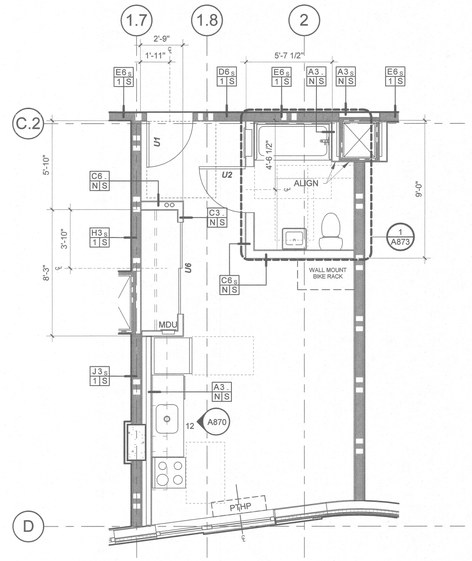

PLAN

2 UNIT 0/1-O

SCALE: 1/4" = 1'-0"

UNITS: X16 (LEVEL 2 THRU 12)

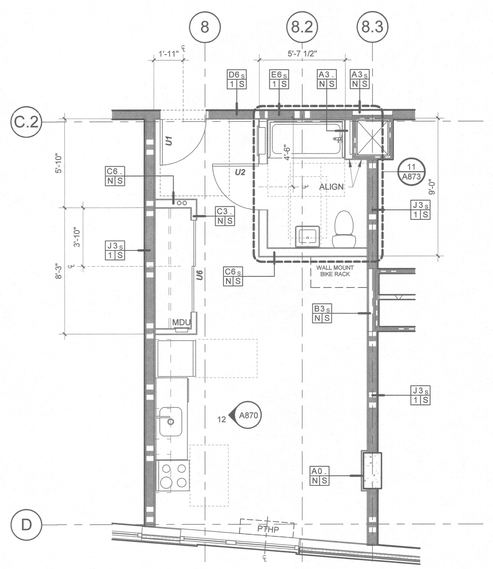

PLAN

1 UNIT 0/1-N

SCALE: 1/4" = 1'-0"

UNITS: X07 (LEVEL 2 THRU 12)

WALL TYPES LEGEND

RESIDENTIAL UNIT WALL TYPES - TYP. UON

- C3 N|S -TYPICAL UNIT INTERIOR WALL
- C6 N|S -TYPICAL UNIT INTERIOR PLUMBING WALL
- K2 2|S -TYPICAL SHAFT WALL

LEGEND: PLAN

- ELECTRICAL PANEL
- WATER SUPPLY RISERS
- MDU — MEDIA DISTRIBUTION UNIT (MDU)
- PTHP
- SHELF AND CLOTHES ROD
- WALL MOUNTED BIKE RACK — 2'-0" X 3'-8" VERTICAL BIKE RACK

This plan matches that approved by Planning and includes all notes from other reviews.
T. Scheinig (name) (date) 11/29/17

PROJECT NUMBER: 215349

GRAND AVENUE APARTMENTS

1010 NE GRAND AVE. PORTLAND, OR 97232

SHEET TITLE:
UNIT PLANS AND RCP

KEY PLAN:

DRAWN BY: KS, SB
DATE CREATED: 04/24/17

1	ADDENDUM #01	08/11/2017
A	PLAN CHECK	09/01/2017

RECEIVED
SEP 06 2017
BDS DOCUMENT SERVICES

SHEET:
A268
PERMIT SET
07-14-2017

LRS Architects, Inc. ©2017

C:\300 Revit Local Files\BIM Support\215349_Grand Ave Apts_Arch_R17_kschneider.rvt
9/5/2017 3:26:43 PM

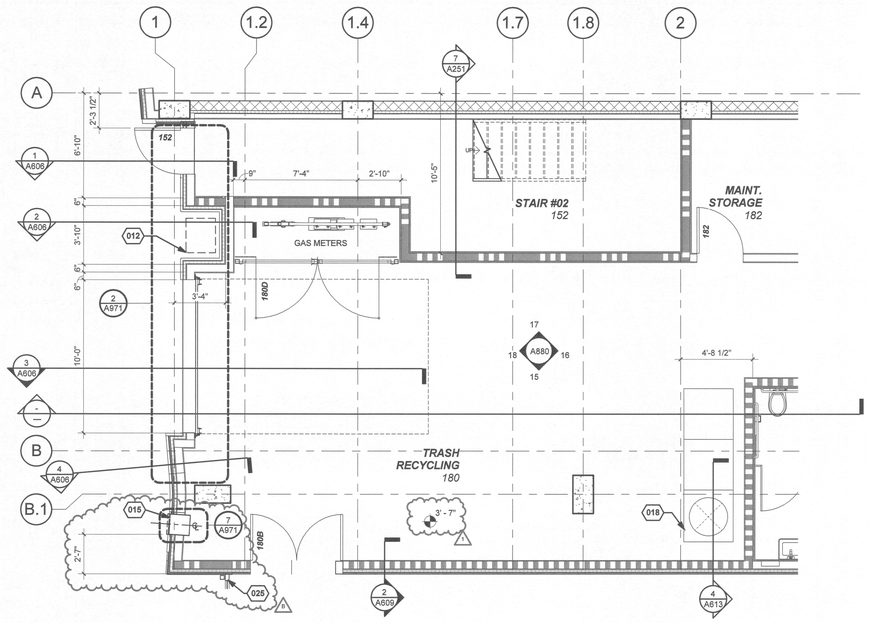

3 ENLARGED LOADING AREA PLAN

SCALE: 1/4" = 1'-0"

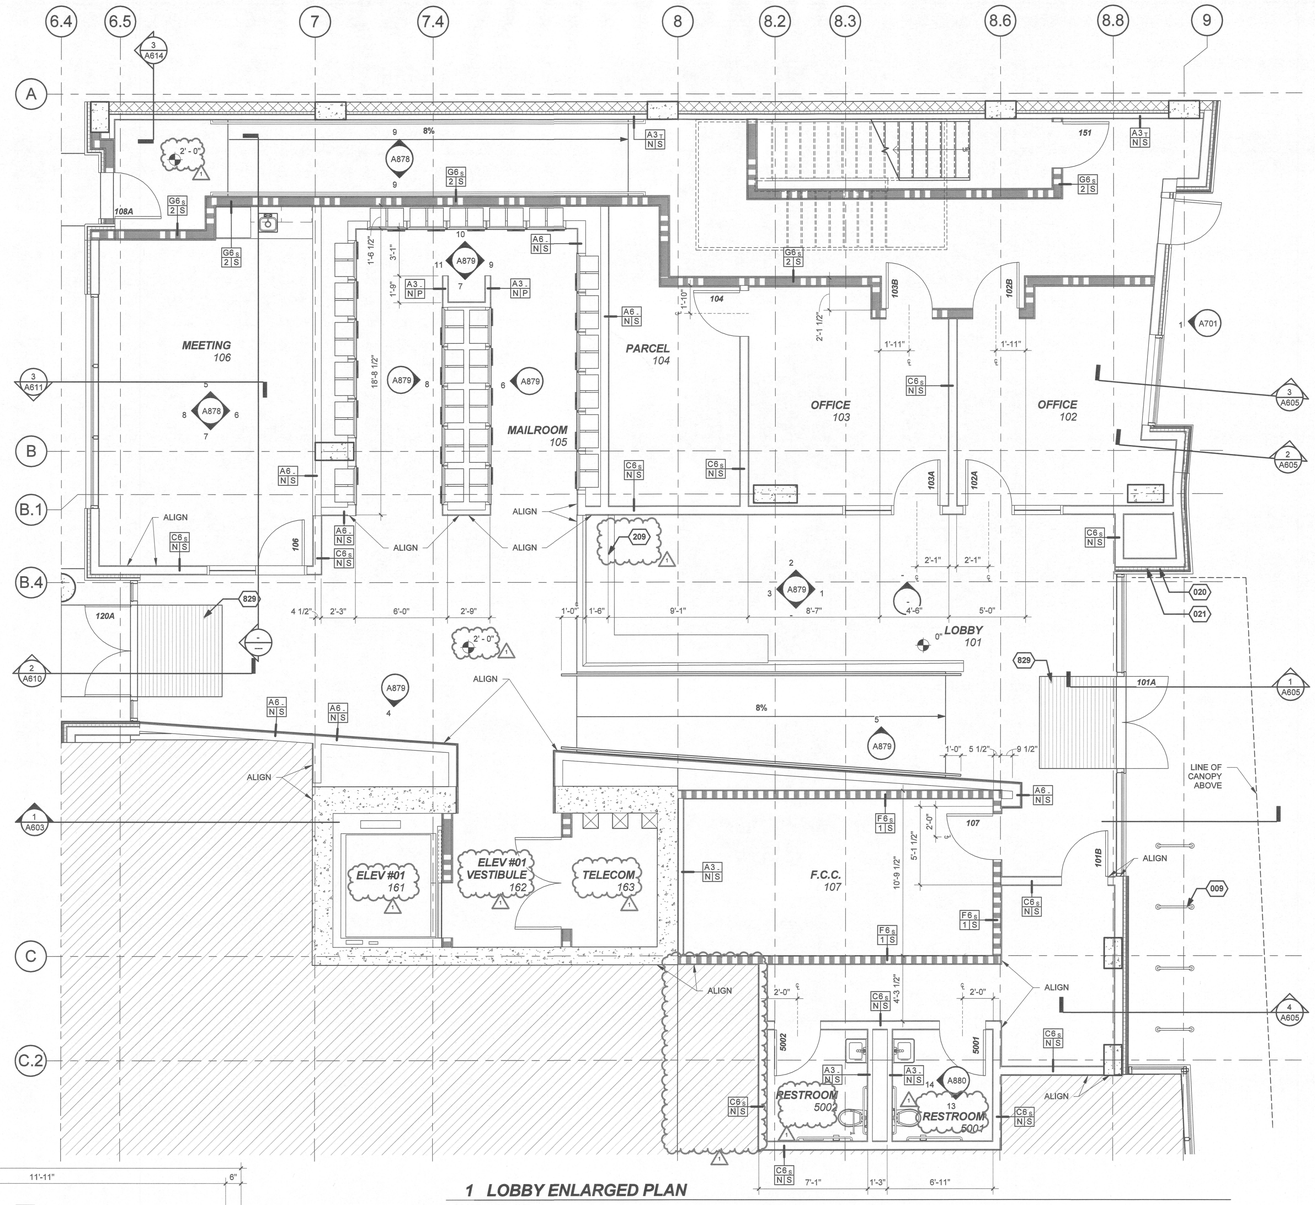

1 LOBBY ENLARGED PLAN

SCALE: 1/4" = 1'-0"

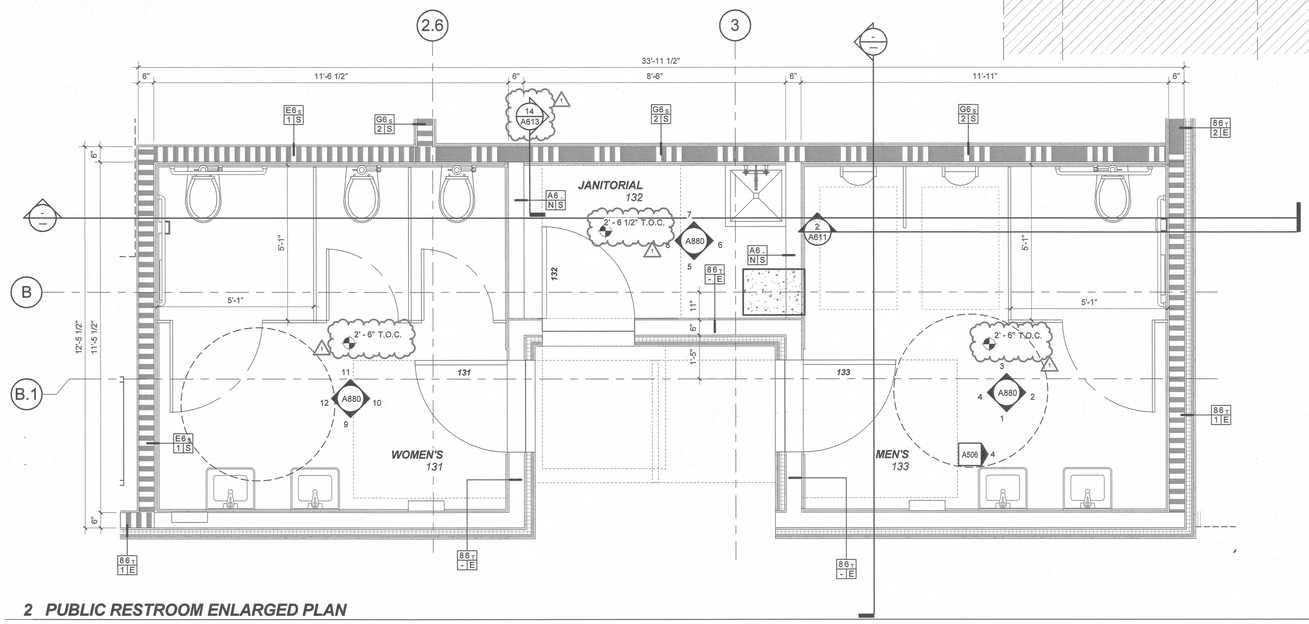

2 PUBLIC RESTROOM ENLARGED PLAN

SCALE: 1/2" = 1'-0"

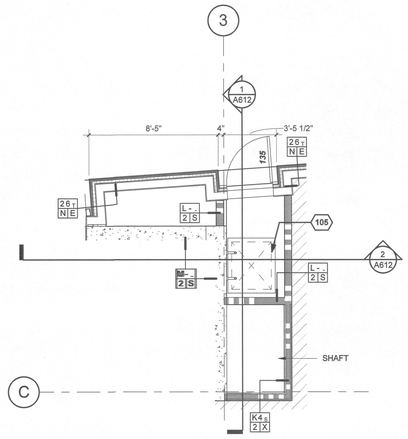

4 ENLARGE FIRE TANK ACCESS PLAN

SCALE: 1/4" = 1'-0"

KEYNOTES

009	BIKE RACK - SEE DTL. 2/A002
012	GAS REGULATOR - COORDINATE W/ UTILITY PROVIDER.
015	GENERATOR FUEL FILLING STATION.
018	TRASH COMPACTOR
020	KNOCKBOX MOUNTED AT 14'-0" A.F.F.
021	CALL BOX
025	ENTRY GATE - SEE SHEET A702 FOR FURTHER INFO
026	FIRE TANK ACCESS DOOR BLOCKOUT
209	BENCH - SEE SHEET A952 FOR FURTHER INFO.
829	WALK-OFF GRATE - FINISH: SS-1 - SEE DTL. 4/A980

LRS ARCHITECTS
720 NW Davis
Suite 300
Portland OR 97209 www.lrsarchitects.co

REGISTERED ARCHITECT
THOMAS PAUL FRANK
PORTLAND, OR
STATE OF OREGON

LEVERARCHITECTURE
4713 N ALBINA AVE, PDX OR 97217
T 503 928 6040

CONSULTANT:

PROJECT NUMBER: 215349

1010 NE GRAND AVE. PORTLAND, OR 97232

SHEET TITLE:
ENLARGED FLOOR PLANS

KEY PLAN:

DRAWN BY:		Author
DATE CREATED:		09/07/16
1	ADDENDUM #01	08/11/2017
B	PLAN CHECK #02	09/22/2017

City of Portland REVIEWED FOR CODE COMPLIANCE DEC 22 2017 Land Use Services

RECEIVED OCT 10 2017 BDS DOCUMENT SERVICES

SHEET:
A270
PERMIT SET
07-14-2017

LRS Architects, Inc. ©2017

C:\300 Revit Local Files\BIM Support\215349_Grand Ave Apts_Arch_R17_mstanner.rvt
10/9/2017 11:36:55 AM

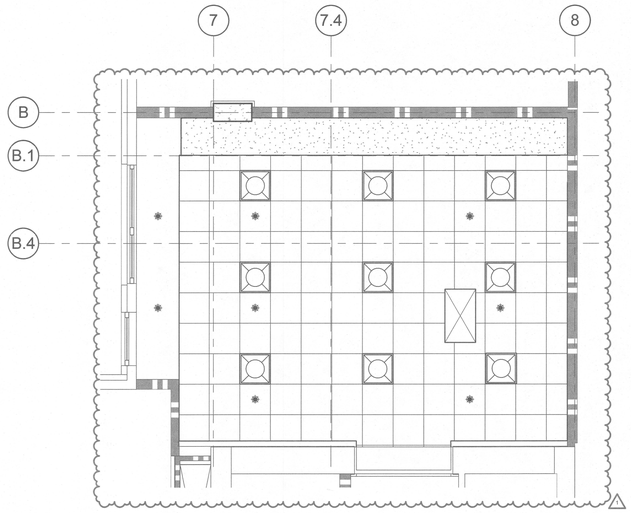

2 LAUNDRY ROOM ENLARGED RCP

SCALE: 1/4" = 1'-0"

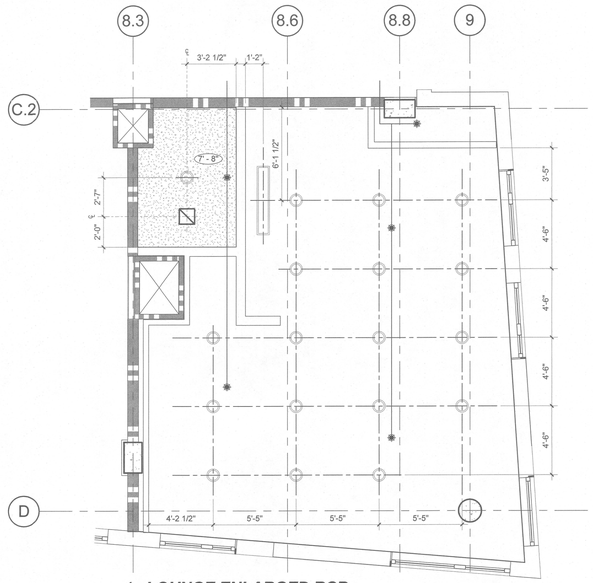

1 LOUNGE ENLARGED RCP

SCALE: 1/4" = 1'-0"

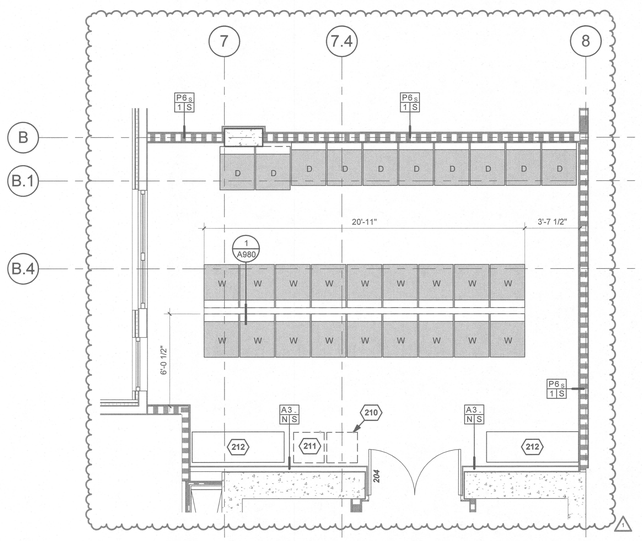

4 LAUNDRY ROOM ENLARGED PLAN

SCALE: 1/4" = 1'-0"

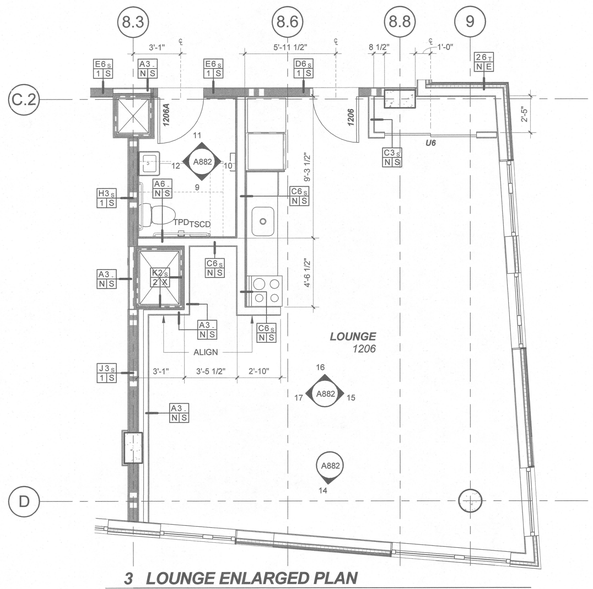

3 LOUNGE ENLARGED PLAN

SCALE: 1/4" = 1'-0"

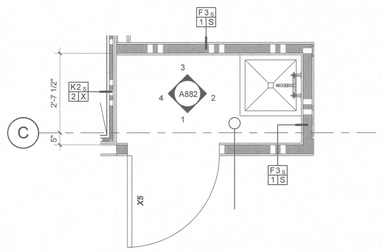

6 JAN. CLOSET LEVELS 2, 7, 12

SCALE: 1/2" = 1'-0"

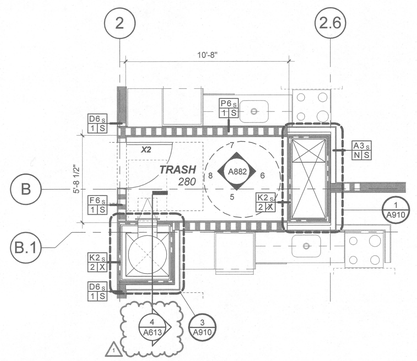

5 TYP TRASH ROOM ENLARGED PLAN

SCALE: 1/4" = 1'-0"

KEYNOTES

210	VENDING / ATM - COORDINATE W/ OWNER & VENDOR
211	VENDING SOAP DISPENSER - COORDINATE W/ OWNER & VENDOR
212	FOLDING TABLE

LRS ARCHITECTS
720 NW Davis 503.221.1121
Suite 300 503.221.2077
Portland OR 97209 www.lrsarchitects.com

REGISTERED ARCHITECT
THOMAS PAUL KEMPER
PORTLAND, OR
STATE OF OREGON

LEVERARCHITECTURE
4713 N ALBINA AVE, PDX OR 97217
T 503 928 6040
www.leverarchitecture.com

CONSULTANT:

PROJECT NUMBER: 215349

GRAND AVENUE APARTMENTS

1010 NE GRAND AVE. PORTLAND, OR 97232

SHEET TITLE:
ENLARGED FLOOR PLANS

KEY PLAN:

DRAWN BY: KWS
DATE CREATED: 08/30/16

1	ADDENDUM #01	08/11/2017

City of Portland RESIDENTIAL CODE COMPLIANCE DEC 22 2017 Permit Number

RECEIVED SEP 06 2017 BDS DOCUMENT SERVICES

SHEET:
A271
PERMIT SET
07-14-2017

LRS Architects, Inc. ©2017

C:\300 Revit Local Files\BIM Support\215349_Grand Ave Apts_Arch_R17_kschneider.rvt
9/5/2017 3:27:00 PM

GENERAL NOTES:

A. DIMENSIONS ARE FROM GRID LINE TO FACE OF SLAB, FACE OF OPENING.
B. CLEAR DIMENSIONS ARE FACE OF OPENING (SLAB) TO FACE OF OPENING (SLAB).
C. POINT ELEVATIONS ARE TO TOP OF CONCRETE DECK.

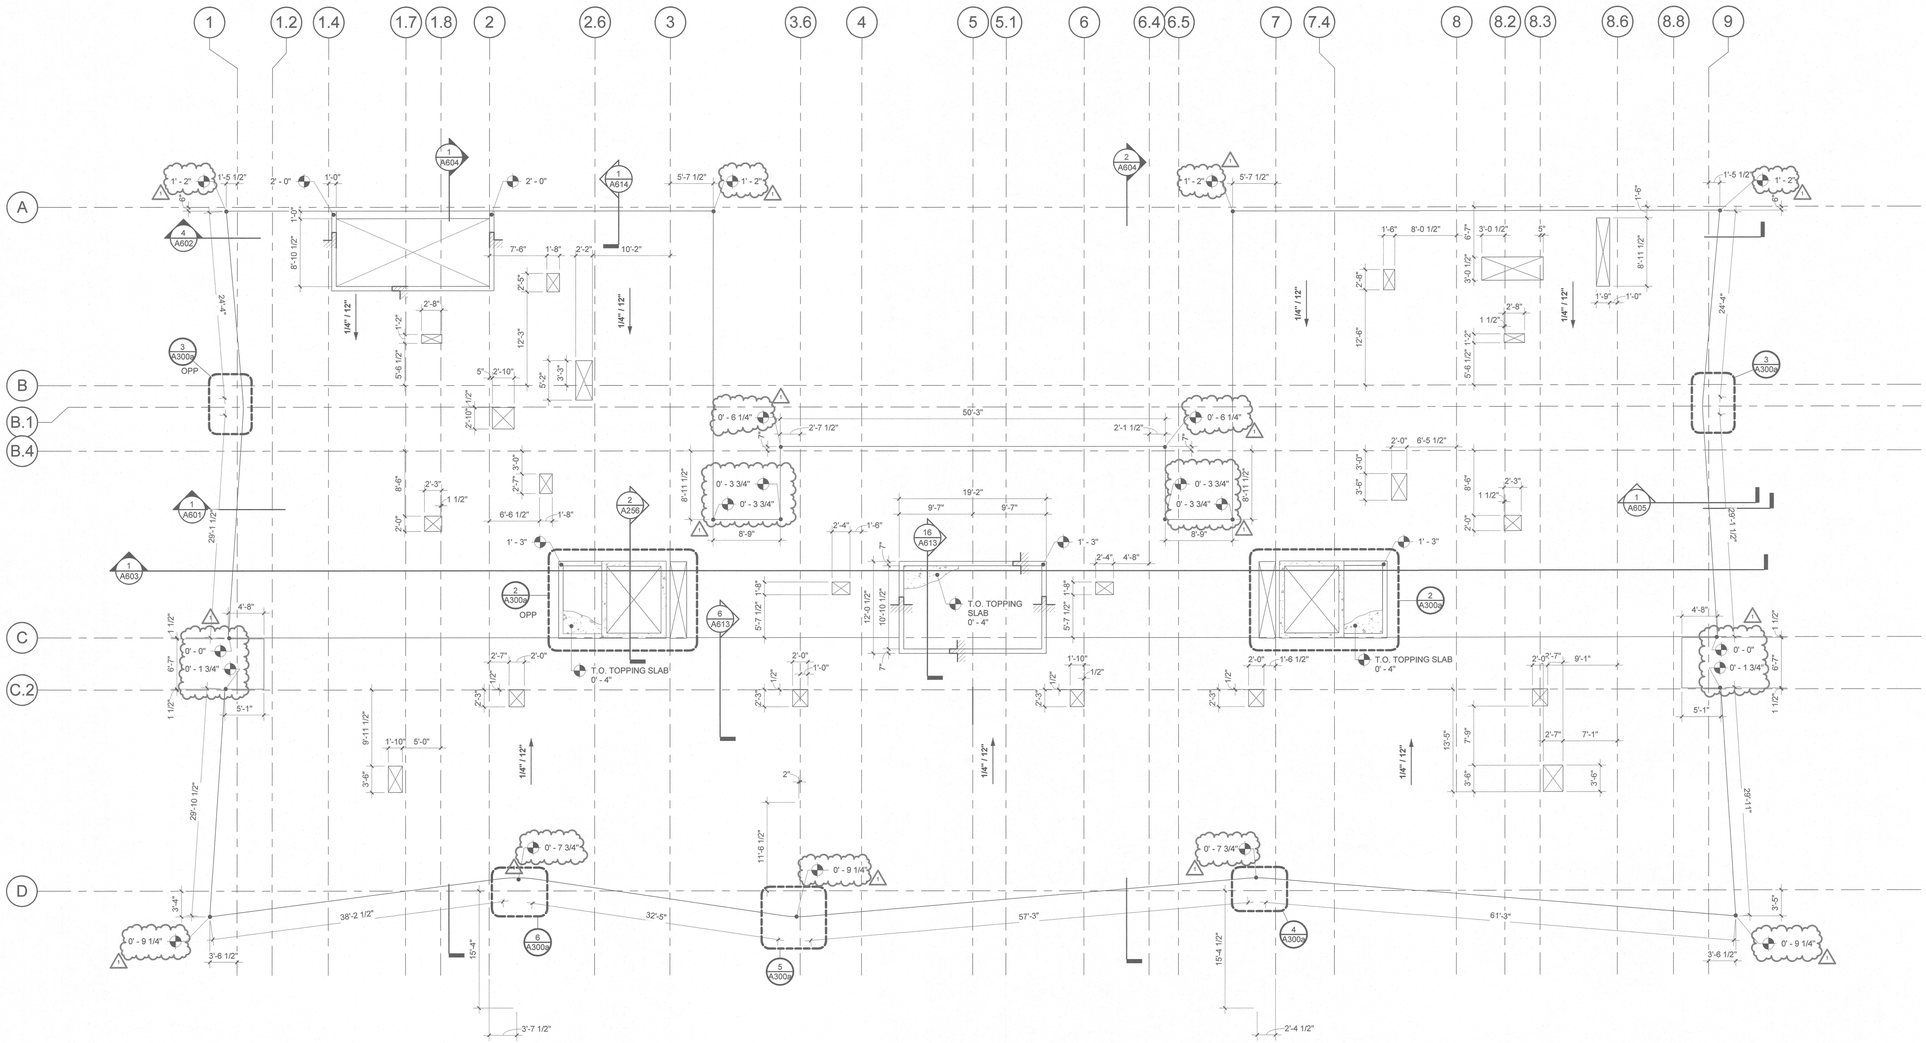

1 ROOF PLAN

SCALE: 1/8" = 1'-0"

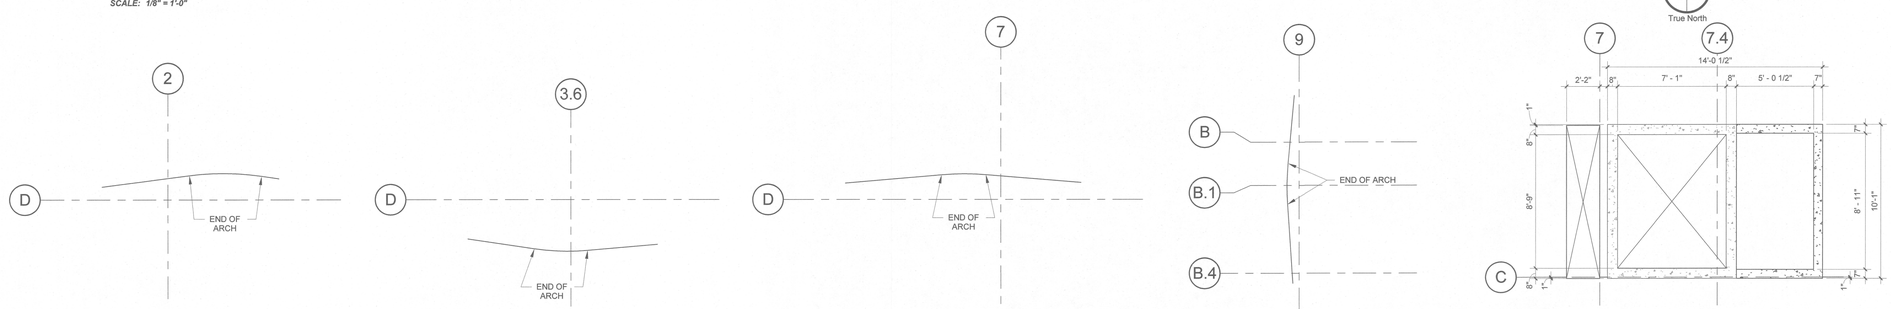

6 SLAB EDGE DETAIL

SCALE: 1/4" = 1'-0"

5 SLAB EDGE DETAIL

SCALE: 1/4" = 1'-0"

4 SLAB EDGE DETAIL

SCALE: 1/4" = 1'-0"

3 SLAB EDGE DETAIL

SCALE: 1/4" = 1'-0"

2 ELEVATOR CORE ENLARGED PLAN

SCALE: 1/4" = 1'-0"

C:\300 Revit Local Files\BIM Support\215349_Grand Ave Apts_Arch_R17_kschneider.rvt
9/5/2017 3:27:13 PM

LRS ARCHITECTS
720 NW Davis 503.221.1121
Suite 300 503.221.2077
Portland OR 97209 www.lrsarchitects.com

REGISTERED ARCHITECT
THOMAS PAUL CARR
PORTLAND, OR
STATE OF OREGON

LEVERARCHITECTURE
4713 N ALBINA AVE, PDX OR 97217
T 503 928 6040
www.leverarchitecture.com

CONSULTANT:

PROJECT NUMBER: 215349

GRAND AVENUE APARTMENTS

1010 NE GRAND AVE. PORTLAND, OR 97232

SHEET TITLE:
ROOF SLAB PLAN

KEY PLAN:

DRAWN BY: Author
DATE CREATED: 09/07/16

1	ADDENDUM #01	08/11/2017
2	ADDENDUM #02	XX/XX/XXXX

RECEIVED
DEC 22 2017
Revisions

RECEIVED
SEP 06 2017
BDS
DOCUMENT SERVICES

SHEET:
A300a
PERMIT SET
07-14-2017

LRS Architects, Inc ©2017

GENERAL NOTES:

A. COORDINATE ALL ROOF PENETRATIONS, (CONDUITS, PIPES, ANCHORS) WITH ASSOCIATED DISCIPLINES. MECHANICAL, ELECTRICAL, PLUMBING, RADON MITIGATION AND STRUCTURAL.
B. PROVIDE POSITIVE DRAINAGE AT CRICKETS. 1/8" SLOPE MINIMUM AT VALLEYS.
C. SEE SHEET 300a FOR T.O. CONCRETE ROOF DECK ELEVATIONS.
D. POINT ELEVATIONS SHOWN INDICATE T.O. INSULATION (ROOF SYSTEM).

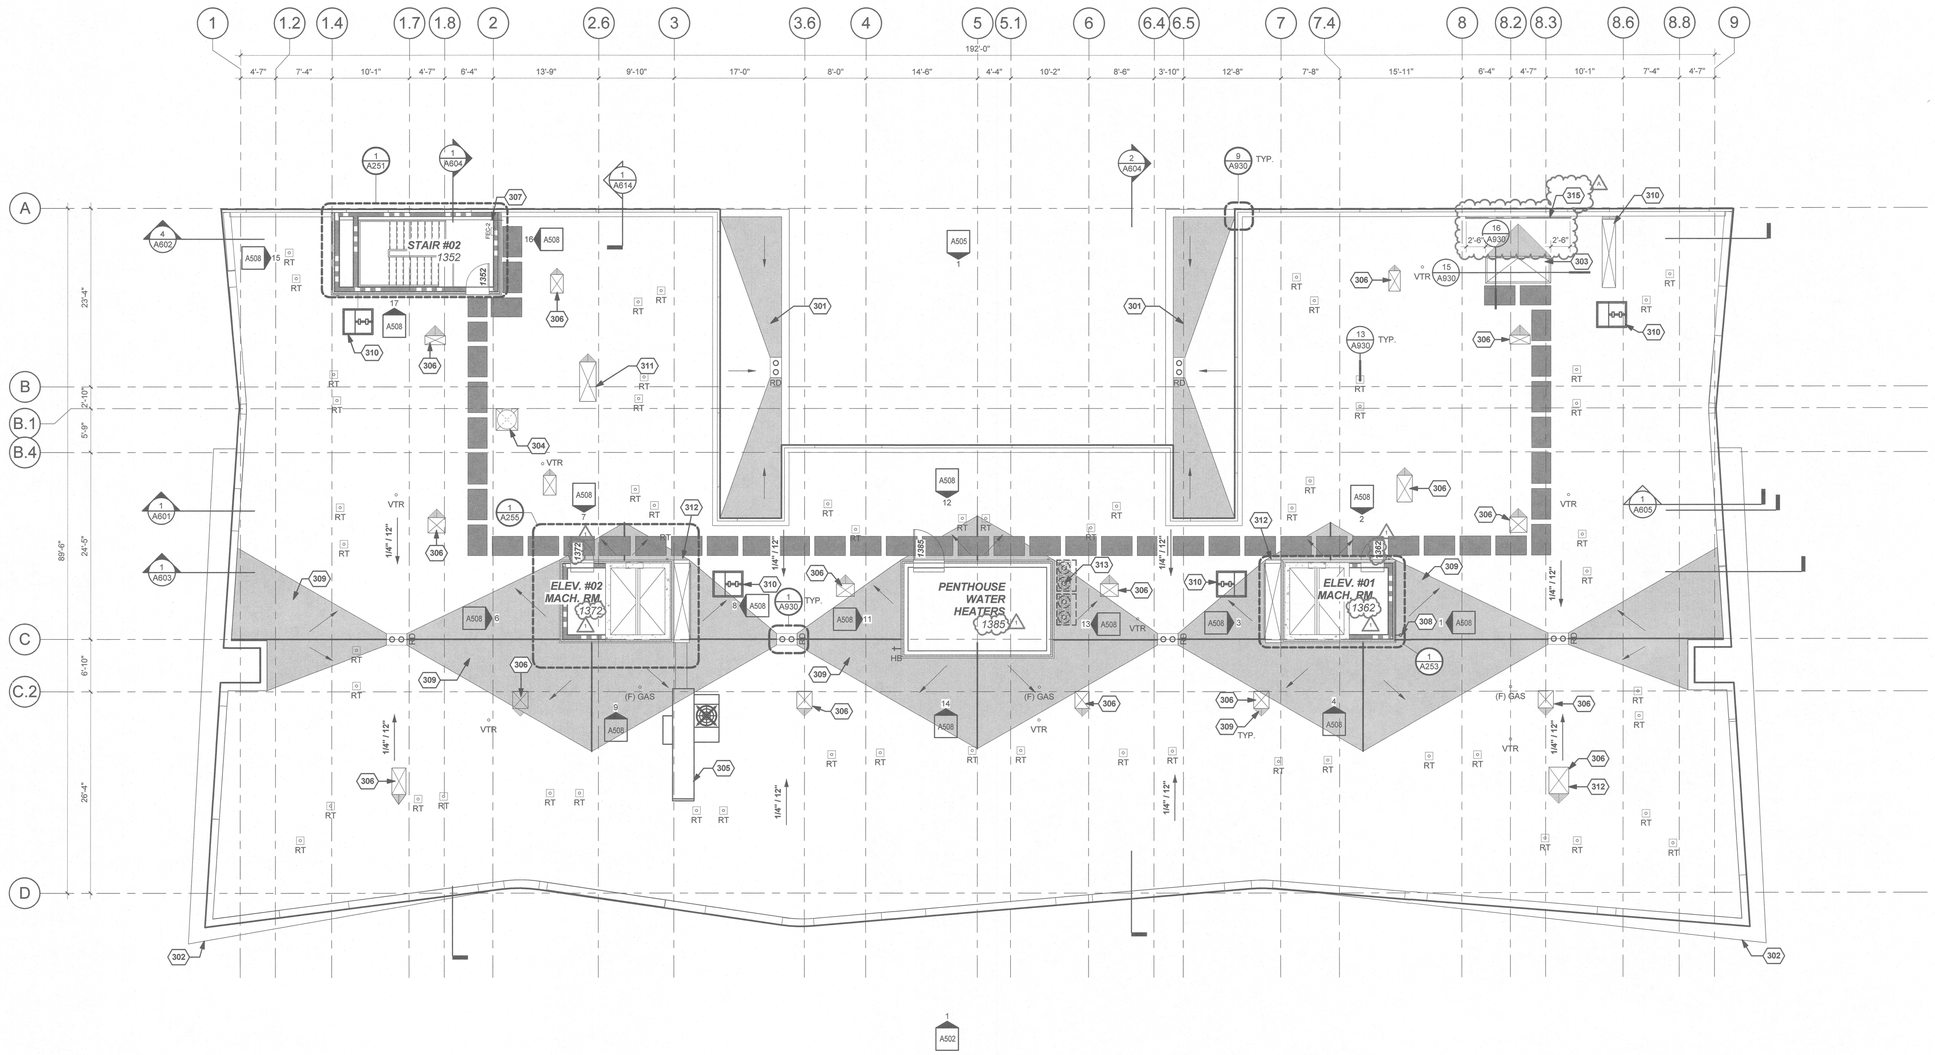

KEYNOTES

301	LOWER ROOF BELOW.
302	OUTLINE OF CANOPY BELOW.
303	ROOF HATCH.
304	TRASH CHUTE.
305	MECH. HVAC EQUIPMENT - SEE MECHANICAL.
306	EXHAUST FAN W/ SHROUD - SEE MECHANICAL.
307	STANDPIPE CONNECTION - SEE FIRE PROTECTION.
308	DAS ANTENNA - SEE ELECTRICAL.
309	CRICKET - TAPERED RIGID INSULATION AS REQ'D. PROVIDE POSITIVE DRAINAGE.
310	STAIR PRESSURIZATION SHAFT & EQUIPMENT - SEE MECHANICAL.
311	EXHAUST FAN W/ SHROUD FOR KITCHEN, TRASH ROOM & GENERATOR EXHAUST - SEE MECHANICAL.
312	GREASE DUCT - FUTURE TENANT IMPROVEMENT - PROVIDE CAP.
313	FUTURE MECH EQUIPMENT - FUTURE TENTANT IMPROVEMENT - SEE MECHANICAL.
314	ROOF HOOK.
315	42" HIGH METAL GUARD RAIL, FACE-MOUNTED TO PARAPET

1 ROOF LEVEL - PLAN

SCALE: 1/8" = 1'-0"

N True North

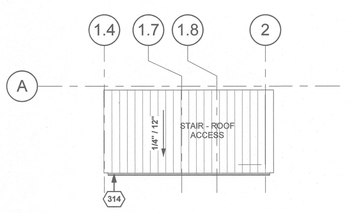

2 ROOF PLAN - STAIR #02

SCALE: 1/8" = 1'-0"

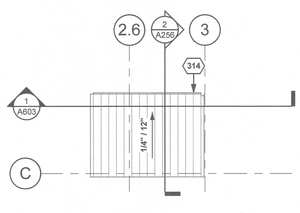

3 ROOF PLAN - ELEVATOR #02

SCALE: 1/8" = 1'-0"

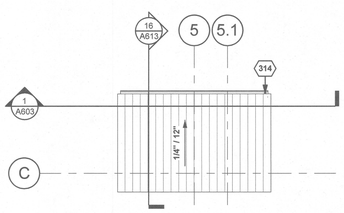

4 ROOF PLAN - MECH PENTHOUSE

SCALE: 1/8" = 1'-0"

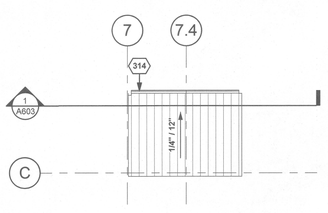

5 ROOF PLAN - ELEVATOR #01

SCALE: 1/8" = 1'-0"

LEGEND: ROOF PLAN

- TAPERED RIGID INSULATION, 1/4" SLOPE MINIMUM PROVIDE POSITIVE DRAINAIGE
- WALK PAD NOMINAL SIZES 30" X 40" AND 30" X 30"
- RD — ROOF DRAIN: SEE DETAIL 1/A930 COORDINATE WITH PLUMBING
- RT — ROOF TIE-OFF: SEE DETAIL 13/A930 COORDINATE WITH STRUCTURAL
- VTR — VENT TO ROOF: SEE DETAILS 10 AND 11/A930 COORDINATE WITH PLUMBING
- (F) GAS — GAS RISER (FUTURE CONNECTION) COORDINATE WITH PLUMBING
- DS — DOWN SPOUT TO DAYLIGHT AT LOWER ROOF
- HB — HOSE BIB: SEE PLUMBING
- STANDING SEAM MTL ROOF SYSTEM

LRS ARCHITECTS
720 NW Davis 503.221.1121
Suite 300 503.221.2077
Portland OR 97209 www.lrsarchitects.com

REGISTERED ARCHITECT THOMAS PAUL CRANK PORTLAND, OR STATE OF OREGON

LEVERARCHITECTURE
4713 N ALBINA AVE, PDX OR 97217
T 503 928 6040
www.leverarchitecture.com

CONSULTANT:

PROJECT NUMBER: 215349

GRAND AVENUE APARTMENTS

1010 NE GRAND AVE. PORTLAND, OR 97232

SHEET TITLE:
ROOF LEVEL PLAN

KEY PLAN:

DRAWN BY: KWS
DATE CREATED: 08/30/2016

1	ADDENDUM #01	08/11/2017
2	ADDENDUM #02	XX/XX/XXXX
A	PLAN CHECK	09/01/2017

RECEIVED COMPLIANCE DEC 22 2017

RECEIVED SEP 06 2017 BDS DOCUMENT SERVICES

SHEET:
A300
PERMIT SET
07-14-2017

LRS Architects, Inc. ©2017

C:\300 Revit Local Files\BIM Support\215349_Grand Ave Apts_Arch_R17_kschneider.rvt
9/5/2017 3:27:08 PM

GENERAL NOTES:

A. CEILING FIXTURES ARE SHOWN FOR REFERENCE ONLY FOR COORDINATION WITH CEILING FINISH SYSTEM. SEE MECHANICAL, ELECTRICAL AND SPRINKLER DRAWINGS FOR ALL CEILING FIXTURES AND TYPES.
B. SPOT ELEVATIONS ARE FROM FINISH FLOOR TO SURFACE FINISH OF CEILING AND ARE ROUNDED TO THE NEAREST INCH (TYP).
C. ALL CEILING HEIGHTS ARE 7' - 8", UON.
D. SEE A170 FOR RECESSED CEILING FIXTURE WRAP REQUIREMENTS.
E. SEE ENLARGED UNIT PLANS FOR UNIT RCP INFO SHEETS A260 - A268.

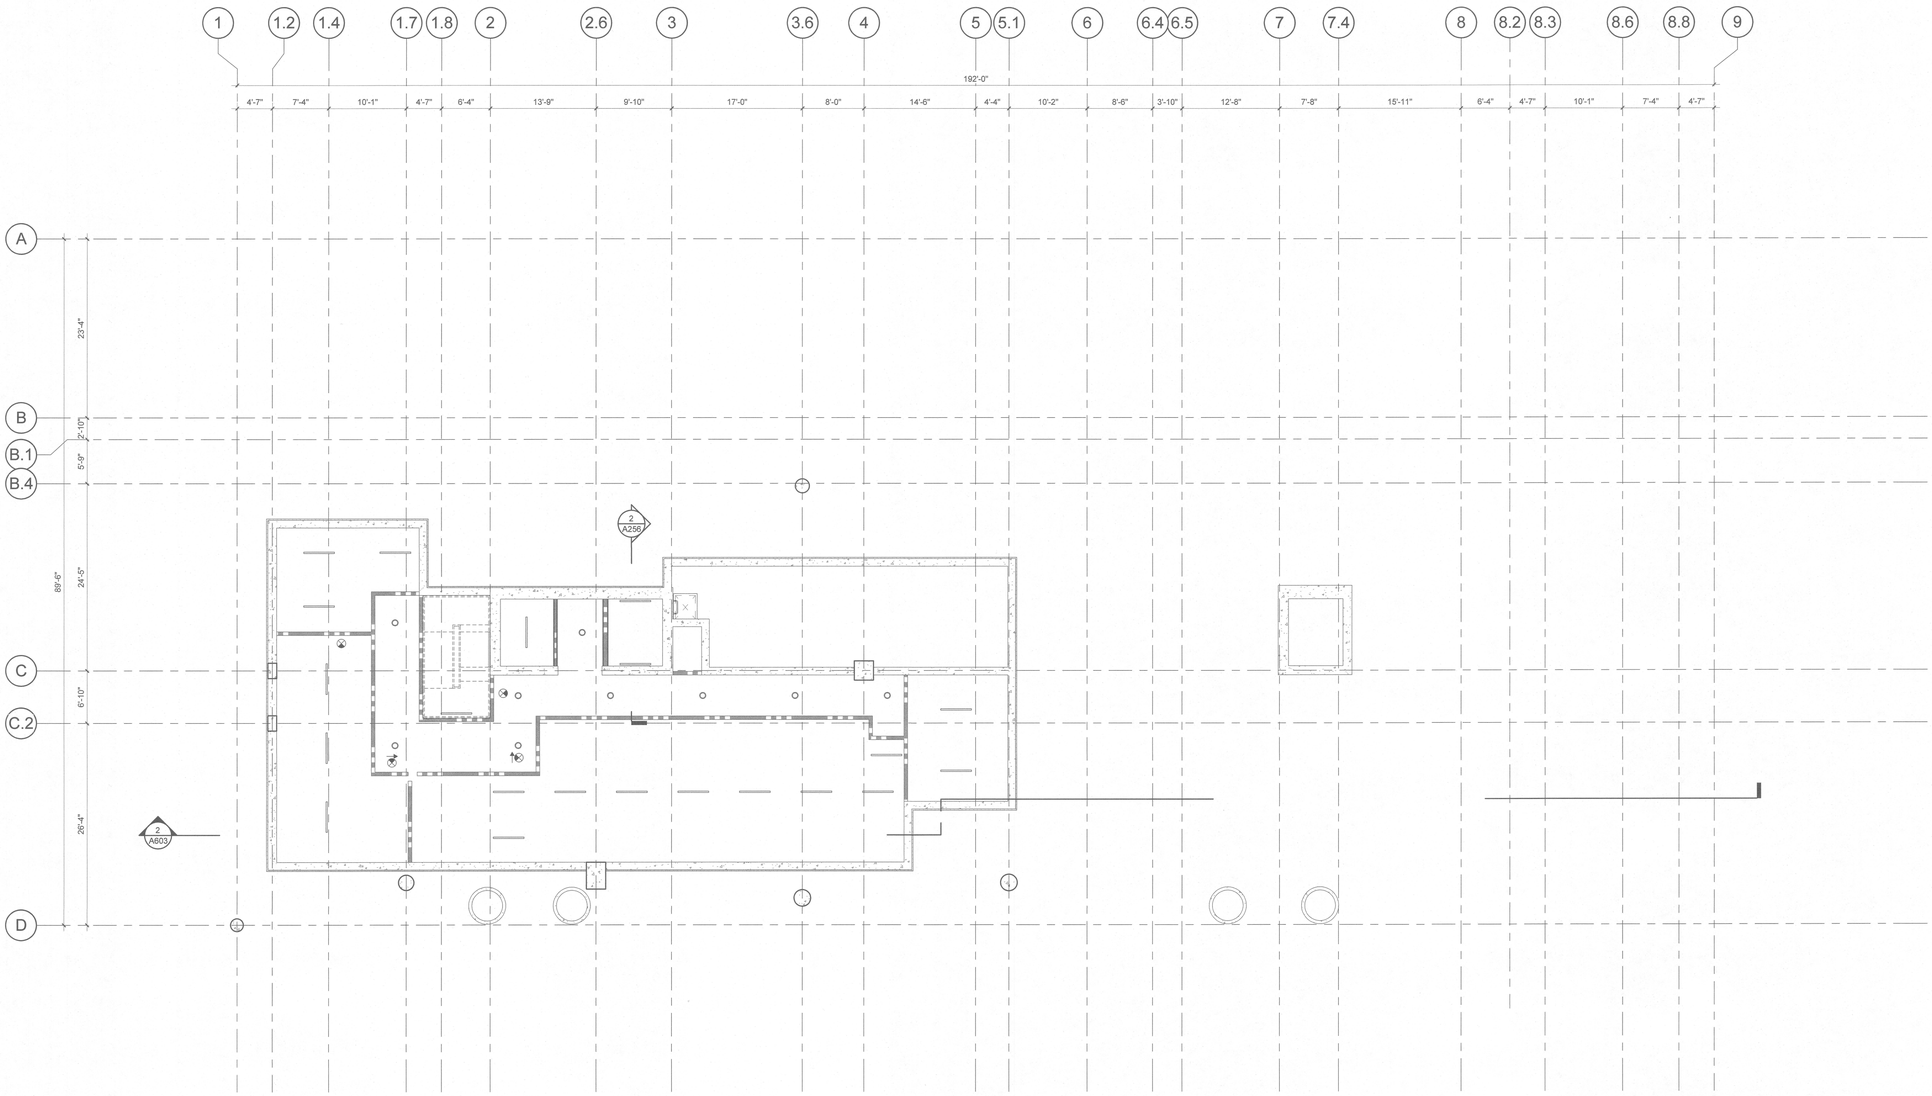

LEGEND: RCP

- X'-X" — FINISH CEILING HEIGHT, A.F.F.
- GYPSUM BOARD CEILING / SOFFIT
- STUCCO CEILING / SOFFIT
- CIRCULAR FIXTURE (SEE ELECTRICAL)
- LINEAR FIXTURE (SEE ELECTRICAL)
- 2x2 LAY-IN FIXTURE (SEE ELECTRICAL)
- EXIT LIGHT
- F# — FLOOR/CEILING ASSEMBLY TAG, SEE A151

KEYNOTES

1 BASEMENT LEVEL - REFLECTED CEILING PLAN

SCALE: 1/8" = 1'-0"

N True North

LRS ARCHITECTS
720 NW Davis 503.221.1121
Suite 300 503.221.2077
Portland OR 97209 www.lrsarchitects.com

REGISTERED ARCHITECT
THOMAS PAUL EARLS
PORTLAND, OR
STATE OF OREGON

LEVERARCHITECTURE
4713 N ALBINA AVE, PDX OR 97217
T 503 928 6040
www.leverarchitecture.com

CONSULTANT:

PROJECT NUMBER: 215349

GRAND AVENUE APARTMENTS

1010 NE GRAND AVE. PORTLAND, OR 97232

SHEET TITLE:
BASEMENT LEVEL - REFLECTED CEILING PLAN

KEY PLAN:

DRAWN BY: Author
DATE CREATED: 09/07/16

City of Portland
REVIEWED FOR CODE COMPLIANCE
DEC 22 2017

SHEET:
A400
PERMIT SET
07-14-2017

LRS Architects, Inc. ©2017

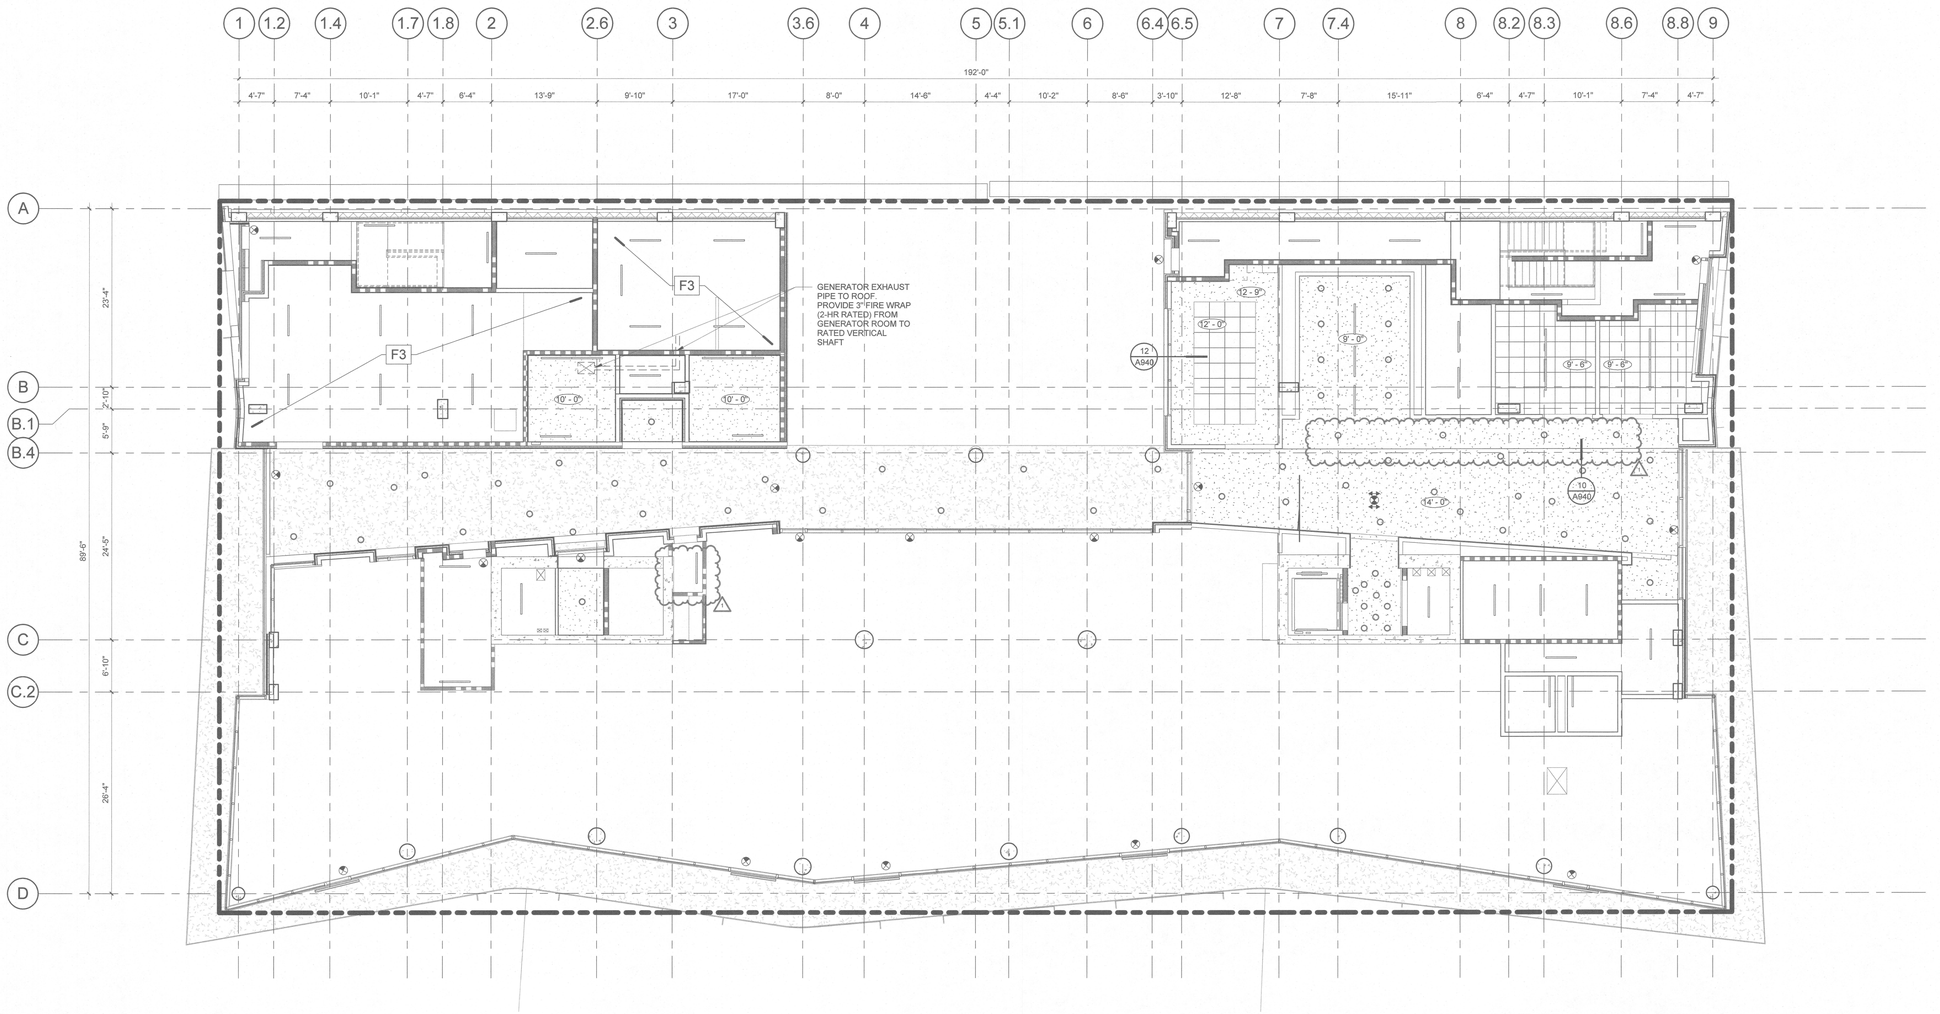

1 LEVEL 1 - REFLECTED CEILING PLAN

SCALE: 1/8" = 1'-0"

KEYNOTES

GENERAL NOTES:

A. CEILING FIXTURES ARE SHOWN FOR REFERENCE ONLY FOR COORDINATION WITH CEILING FINISH SYSTEM. SEE MECHANICAL, ELECTRICAL AND SPRINKLER DRAWINGS FOR ALL CEILING FIXTURES AND TYPES.
B. SPOT ELEVATIONS ARE FROM FINISH FLOOR TO SURFACE FINISH OF CEILING AND ARE ROUNDED TO THE NEAREST INCH (TYP).
C. ALL CEILING HEIGHTS ARE 7' - 8", UON.
D. SEE A170 FOR RECESSED CEILING FIXTURE WRAP REQUIREMENTS.
E. SEE ENLARGED UNIT PLANS FOR UNIT RCP INFO SHEETS A260 - A268.

LEGEND: RCP

- X' - X" — FINISH CEILING HEIGHT, A.F.F.
- GYPSUM BOARD CEILING / SOFFIT
- STUCCO CEILING / SOFFIT
- CIRCULAR FIXTURE (SEE ELECTRICAL)
- LINEAR FIXTURE (SEE ELECTRICAL)
- 2x2 LAY-IN FIXTURE (SEE ELECTRICAL)
- EXIT LIGHT
- F# — FLOOR/CEILING ASSEMBLY TAG, SEE A151

LRS ARCHITECTS
720 NW Davis 503.221.1121
Suite 300 503.221.2077
Portland OR 97209 www.lrsarchitects.com

REGISTERED ARCHITECT
THOMAS PAUL FRANK
PORTLAND, OR
STATE OF OREGON

LEVERARCHITECTURE
4713 N ALBINA AVE, PDX OR 97217
T 503 928 6040
www.leverarchitecture.com

CONSULTANT:

PROJECT NUMBER: 215349

GRAND AVENUE APARTMENTS

1010 NE GRAND AVE. PORTLAND, OR 97232

SHEET TITLE:
LEVEL 1 - REFLECTED CEILING PLAN

KEY PLAN:

DRAWN BY: Author
DATE CREATED: 06/24/13

1	ADDENDUM #01	08/11/2017
2	ADDENDUM #02	XX/XX/XXXX

City of Portland, Oregon
REVIEWED FOR CODE COMPLIANCE
DEC 22 2017
Project Set

RECEIVED
SEP 06 2017
BDS
DOCUMENT SERVICES

SHEET: **A401**
PERMIT SET
07-14-2017

LRS Architects, Inc. ©2017



1 LEVEL 1 - REFLECTED CEILING PLAN SLAB INSULATION EXTENTS

SCALE: 1/8" = 1'-0"

N
True North

LEGEND: INSULATION RCP

- 3" ROCK MINERAL WOOL BOARD INSULATION
- 9" SEMI-RIGID INSULATION
- F# FLOOR/CEILING ASSEMBLY TAG, SEE A151

LRS ARCHITECTS
720 NW Davis 503.221.1121
Suite 300 503.221.2077
Portland OR 97209 www.lrsarchitects.com

REGISTERED ARCHITECT
THOMAS PAUL FRANK, JR.
PORTLAND, OR
STATE OF OREGON

LEVERARCHITECTURE
4713 N ALBINA AVE, PDX OR 97217
T 503 928 6040
www.leverarchitecture.com

CONSULTANT:

PROJECT NUMBER: 215349

GRAND AVENUE APARTMENTS

1010 NE GRAND AVE. PORTLAND, OR 97232

SHEET TITLE:

LEVEL-1 REFLECTED CEILING PLAN - INSUL. EXTENTS

KEY PLAN:

DRAWN BY: Author
DATE CREATED: 07/04/17

1 ADDENDUM #01 08/11/2017

City of Portland
REVIEWED FOR CODE COMPLIANCE
DEC 22 2017
Permit Number

RECEIVED
SEP 06 2017
BDS
DOCUMENT SERVICES

SHEET:

A401a

PERMIT SET
07-14-2017

LRS Architects, Inc. ©2017

C:\300 Revit Local Files\BIM Support\215349_Grand Ave Apts_Arch_R17_kschneider.rvt
9/5/2017 3:27:32 PM



1 LEVEL 2 - REFLECTED CEILING PLAN

SCALE: 1/8" = 1'-0"

N
True North

GENERAL NOTES:

A. CEILING FIXTURES ARE SHOWN FOR REFERENCE ONLY FOR COORDINATION WITH CEILING FINISH SYSTEM. SEE MECHANICAL, ELECTRICAL AND SPRINKLER DRAWINGS FOR ALL CEILING FIXTURES AND TYPES.
B. SPOT ELEVATIONS ARE FROM FINISH FLOOR TO SURFACE FINISH OF CEILING AND ARE ROUNDED TO THE NEAREST INCH (TYP).
C. ALL CEILING HEIGHTS ARE 7' - 8", UON.
D. SEE A170 FOR RECESSED CEILING FIXTURE WRAP REQUIREMENTS.
E. SEE ENLARGED UNIT PLANS FOR UNIT RCP INFO SHEETS A260 - A268.

LEGEND: RCP

- X' - X" — FINISH CEILING HEIGHT, A.F.F.
- GYPSUM BOARD CEILING / SOFFIT
- STUCCO CEILING / SOFFIT
- CIRCULAR FIXTURE (SEE ELECTRICAL)
- LINEAR FIXTURE (SEE ELECTRICAL)
- 2x2 LAY-IN FIXTURE (SEE ELECTRICAL)
- EXIT LIGHT
- F# — FLOOR/CEILING ASSEMBLY TAG, SEE A151

KEYNOTES

LRS ARCHITECTS
720 NW Davis 503.221.1121
Suite 300 503.221.2077
Portland OR 97209 www.lrsarchitects.com

REGISTERED ARCHITECT
THOMAS PAUL CHARLES SCHNEIDER
PORTLAND, OR
STATE OF OREGON

LEVERARCHITECTURE
4713 N ALBINA AVE, PDX OR 97217
T 503 928 6040
www.leverarchitecture.com

CONSULTANT:

PROJECT NUMBER: 215349

GRAND AVENUE APARTMENTS

1010 NE GRAND AVE. PORTLAND, OR 97232

SHEET TITLE:
LEVEL 2 - REFLECTED CEILING PLAN

KEY PLAN:

DRAWN BY: Author
DATE CREATED: 09/07/16

1	ADDENDUM #01	08/11/2017

City of Portland
REVIEWED FOR CODE COMPLIANCE
DEC 22 2017
Permit Number

RECEIVED
SEP 06 2017
BDS
DOCUMENT SERVICES

SHEET:
A402
PERMIT SET
07-14-2017

LRS Architects, Inc. ©2017

C:\300 Revit Local Files\BIM Support\215349_Grand Ave Apts_Arch_R17_kschneider.rvt
9/5/2017 3:27:40 PM

GENERAL NOTES:

A. CEILING FIXTURES ARE SHOWN FOR REFERENCE ONLY FOR COORDINATION WITH CEILING FINISH SYSTEM. SEE MECHANICAL, ELECTRICAL AND SPRINKLER DRAWINGS FOR ALL CEILING FIXTURES AND TYPES.
B. SPOT ELEVATIONS ARE FROM FINISH FLOOR TO SURFACE FINISH OF CEILING AND ARE ROUNDED TO THE NEAREST INCH (TYP).
C. ALL CEILING HEIGHTS ARE 7' - 8", UON.
D. SEE A170 FOR RECESSED CEILING FIXTURE WRAP REQUIREMENTS.
E. SEE ENLARGED UNIT PLANS FOR UNIT RCP INFO SHEETS A260 - A268.



LEGEND: RCP

- X'-X" — FINISH CEILING HEIGHT, A.F.F.
- GYPSUM BOARD CEILING / SOFFIT
- STUCCO CEILING / SOFFIT
- CIRCULAR FIXTURE (SEE ELECTRICAL)
- LINEAR FIXTURE (SEE ELECTRICAL)
- 2x2 LAY-IN FIXTURE (SEE ELECTRICAL)
- EXIT LIGHT
- F# — FLOOR/CEILING ASSEMBLY TAG, SEE A151

KEYNOTES

1 LEVEL 3 - REFLECTED CEILING PLAN

SCALE: 1/8" = 1'-0"

N True North

LRS ARCHITECTS
720 NW Davis 503.221.1121
Suite 300 503.221.2077
Portland OR 97209 www.lrsarchitects.com

REGISTERED ARCHITECT THOMAS PAUL EARLY PORTLAND, OR STATE OF OREGON

LEVERARCHITECTURE
4713 N ALBINA AVE, PDX OR 97217
T 503 928 6040
www.leverarchitecture.com

CONSULTANT:

PROJECT NUMBER: 215349

GRAND AVENUE APARTMENTS

1010 NE GRAND AVE. PORTLAND, OR 97232

SHEET TITLE:
LEVEL 3 - REFLECTED CEILING PLAN

KEY PLAN:

DRAWN BY: Author
DATE CREATED: 09/07/16

1	ADDENDUM #01	08/11/2017

City of Portland REVIEWED FOR CODE COMPLIANCE DEC 22 2017

RECEIVED SEP 06 2017 BDS DOCUMENT SERVICES

SHEET:
A403

PERMIT SET
07-14-2017

LRS Architects, Inc. ©2017

C:\300 Revit Local Files\BIM Support\215349_Grand Ave Apts_Arch_R17_kschneider.rvt
9/5/2017 3:27:49 PM

GENERAL NOTES:

A. CEILING FIXTURES ARE SHOWN FOR REFERENCE ONLY FOR COORDINATION WITH CEILING FINISH SYSTEM. SEE MECHANICAL, ELECTRICAL AND SPRINKLER DRAWINGS FOR ALL CEILING FIXTURES AND TYPES.
B. SPOT ELEVATIONS ARE FROM FINISH FLOOR TO SURFACE FINISH OF CEILING AND ARE ROUNDED TO THE NEAREST INCH (TYP).
C. ALL CEILING HEIGHTS ARE 7' - 8", U.O.N.
D. SEE A170 FOR RECESSED CEILING FIXTURE WRAP REQUIREMENTS.
E. SEE ENLARGED UNIT PLANS FOR UNIT RCP INFO SHEETS A260 - A268.



LEGEND: RCP

- K' - K" — FINISH CEILING HEIGHT, A.F.F.
- GYPSUM BOARD CEILING / SOFFIT
- STUCCO CEILING / SOFFIT
- CIRCULAR FIXTURE (SEE ELECTRICAL)
- LINEAR FIXTURE (SEE ELECTRICAL)
- 2x2 LAY-IN FIXTURE (SEE ELECTRICAL)
- EXIT LIGHT
- F# — FLOOR/CEILING ASSEMBLY TAG, SEE A151

KEYNOTES

1 LEVEL 4 - REFLECTED CEILING PLAN

SCALE: 1/8" = 1'-0"

N True North

LRS ARCHITECTS
720 NW Davis 503.221.1121
Suite 300 503.221.2077
Portland OR 97209 www.lrsarchitects.com

REGISTERED ARCHITECT THOMAS PAUL FRANK PORTLAND, OR STATE OF OREGON

LEVERARCHITECTURE
4713 N ALBINA AVE, PDX OR 97217
T 503 928 6040
www.leverarchitecture.com

CONSULTANT:

PROJECT NUMBER: 215349

GRAND AVENUE APARTMENTS

1010 NE GRAND AVE. PORTLAND, OR 97232

SHEET TITLE:
LEVEL 4 - REFLECTED CEILING PLAN

KEY PLAN:

DRAWN BY: Author
DATE CREATED: 09/07/16

1	ADDENDUM #01	08/11/2017

City of Portland REVIEWED FOR CODE COMPLIANCE DEC 22 2017 By: [illegible]

RECEIVED SEP 06 2017 BDS DOCUMENT SERVICES

SHEET:
A404
PERMIT SET
07-14-2017

LRS Architects, Inc. ©2017

C:\300 Revit Local Files\BIM Support\215349_Grand Ave Apts_Arch_R17_kschneider.rvt
9/5/2017 3:27:57 PM

GENERAL NOTES:

A. CEILING FIXTURES ARE SHOWN FOR REFERENCE ONLY FOR COORDINATION WITH CEILING FINISH SYSTEM. SEE MECHANICAL, ELECTRICAL AND SPRINKLER DRAWINGS FOR ALL CEILING FIXTURES AND TYPES.
B. SPOT ELEVATIONS ARE FROM FINISH FLOOR TO SURFACE FINISH OF CEILING AND ARE ROUNDED TO THE NEAREST INCH (TYP).
C. ALL CEILING HEIGHTS ARE 7' - 8", U.O.N.
D. SEE A170 FOR RECESSED CEILING FIXTURE WRAP REQUIREMENTS.
E. SEE ENLARGED UNIT PLANS FOR UNIT RCP INFO SHEETS A260 - A268.



1 LEVEL 5 - REFLECTED CEILING PLAN

SCALE: 1/8" = 1'-0"

N True North

LEGEND: RCP

- X' - X" — FINISH CEILING HEIGHT, A.F.F.
- GYPSUM BOARD CEILING / SOFFIT
- STUCCO CEILING / SOFFIT
- CIRCULAR FIXTURE (SEE ELECTRICAL)
- LINEAR FIXTURE (SEE ELECTRICAL)
- 2x2 LAY-IN FIXTURE (SEE ELECTRICAL)
- EXIT LIGHT
- F# — FLOOR/CEILING ASSEMBLY TAG, SEE A151

KEYNOTES

LRS ARCHITECTS
720 NW Davis 503.221.1121
Suite 300 503.221.2077
Portland OR 97209 www.lrsarchitects.com

REGISTERED ARCHITECT THOMAS PAUL FRANK PORTLAND, OR STATE OF OREGON

LEVERARCHITECTURE
4713 N ALBINA AVE, PDX OR 97217
T 503 928 6040
www.leverarchitecture.com

CONSULTANT:

PROJECT NUMBER: 215349

GRAND AVENUE APARTMENTS

1010 NE GRAND AVE. PORTLAND, OR 97232

SHEET TITLE:
LEVEL 5 - REFLECTED CEILING PLAN

KEY PLAN:

DRAWN BY: Author
DATE CREATED: 09/07/16

1 ADDENDUM #01 08/11/2017

City of Portland REVIEWED FOR CODE COMPLIANCE DEC 22 2017 Permit Specialist

RECEIVED SEP 06 2017 BDS DOCUMENT SERVICES

SHEET:
A405
PERMIT SET
07-14-2017

LRS Architects, Inc. ©2017

C:\300 Revit Local Files\BIM Support\215349_Grand Ave Apts_Arch_R17_kschneider.rvt
9/5/2017 3:28:05 PM



1 LEVEL 6 - REFLECTED CEILING PLAN

SCALE: 1/8" = 1'-0"

N True North

GENERAL NOTES:

A. CEILING FIXTURES ARE SHOWN FOR REFERENCE ONLY FOR COORDINATION WITH CEILING FINISH SYSTEM. SEE MECHANICAL, ELECTRICAL AND SPRINKLER DRAWINGS FOR ALL CEILING FIXTURES AND TYPES.
B. SPOT ELEVATIONS ARE FROM FINISH FLOOR TO SURFACE FINISH OF CEILING AND ARE ROUNDED TO THE NEAREST INCH (TYP).
C. ALL CEILING HEIGHTS ARE 7' - 8", UON.
D. SEE A170 FOR RECESSED CEILING FIXTURE WRAP REQUIREMENTS.
E. SEE ENLARGED UNIT PLANS FOR UNIT RCP INFO SHEETS A260 - A268.

LEGEND: RCP

- X' - X" FINISH CEILING HEIGHT, A.F.F.
- GYPSUM BOARD CEILING / SOFFIT
- STUCCO CEILING / SOFFIT
- CIRCULAR FIXTURE (SEE ELECTRICAL)
- LINEAR FIXTURE (SEE ELECTRICAL)
- 2x2 LAY-IN FIXTURE (SEE ELECTRICAL)
- EXIT LIGHT
- F# FLOOR/CEILING ASSEMBLY TAG, SEE A151

KEYNOTES

LRS ARCHITECTS
720 NW Davis 503.221.1121
Suite 300 503.221.2077
Portland OR 97209 www.lrsarchitects.com

REGISTERED ARCHITECT THOMAS PAUL FRANK, JR. PORTLAND, OR STATE OF OREGON

LEVERARCHITECTURE
4713 N ALBINA AVE, PDX OR 97217
T 503 928 6040
www.leverarchitecture.com

CONSULTANT:

PROJECT NUMBER: 215349

GRAND AVENUE APARTMENTS

1010 NE GRAND AVE. PORTLAND, OR 97232

SHEET TITLE:

LEVEL 6 - REFLECTED CEILING PLAN

KEY PLAN:

DRAWN BY: Author
DATE CREATED: 09/07/16

1 ADDENDUM #01 08/11/2017

City of Portland REVIEWED FOR CODE COMPLIANCE DEC 22 2017 Permit Number

RECEIVED SEP 06 2017 BDS DOCUMENT SERVICES

SHEET:

A406

PERMIT SET 07-14-2017

LRS Architects, Inc. ©2017

C:\300 Revit Local Files\BIM Support\215349_Grand Ave Apts_Arch_R17_kschneider.rvt
9/5/2017 3:28:14 PM

GENERAL NOTES:

A. CEILING FIXTURES ARE SHOWN FOR REFERENCE ONLY FOR COORDINATION WITH CEILING FINISH SYSTEM. SEE MECHANICAL, ELECTRICAL AND SPRINKLER DRAWINGS FOR ALL CEILING FIXTURES AND TYPES.
B. SPOT ELEVATIONS ARE FROM FINISH FLOOR TO SURFACE FINISH OF CEILING AND ARE ROUNDED TO THE NEAREST INCH (TYP).
C. ALL CEILING HEIGHTS ARE 7' - 8", UON.
D. SEE A170 FOR RECESSED CEILING FIXTURE WRAP REQUIREMENTS.
E. SEE ENLARGED UNIT PLANS FOR UNIT RCP INFO SHEETS A280 - A288.



1 LEVEL 7 - REFLECTED CEILING PLAN

SCALE: 1/8" = 1'-0"

N True North

LEGEND: RCP

- X - X — FINISH CEILING HEIGHT, A.F.F.
- GYPSUM BOARD CEILING / SOFFIT
- STUCCO CEILING / SOFFIT
- CIRCULAR FIXTURE (SEE ELECTRICAL)
- LINEAR FIXTURE (SEE ELECTRICAL)
- 2x2 LAY-IN FIXTURE (SEE ELECTRICAL)
- EXIT LIGHT
- F# — FLOOR/CEILING ASSEMBLY TAG, SEE A151

KEYNOTES

LRS ARCHITECTS
720 NW Davis 503.221.1121
Suite 300 503.221.2077
Portland OR 97209 www.lrsarchitects.com

REGISTERED ARCHITECT THOMAS PAUL LEVER PORTLAND, OR STATE OF OREGON

LEVERARCHITECTURE
4713 N ALBINA AVE, PDX OR 97217
T 503 928 6040
www.leverarchitecture.com

CONSULTANT:

PROJECT NUMBER: 215349

GRAND AVENUE APARTMENTS

1010 NE GRAND AVE. PORTLAND, OR 97232

SHEET TITLE:
LEVEL 7 - REFLECTED CEILING PLAN

KEY PLAN:

DRAWN BY: Author
DATE CREATED: 09/07/16

1	ADDENDUM #01	08/11/2017

PERMIT SET COMPLIANCE DEC 22 2017

RECEIVED SEP 06 2017 BDS DOCUMENT SERVICES

SHEET: **A407**

PERMIT SET 07-14-2017

LRS Architects, Inc. ©2017

C:\300 Revit Local Files\BIM Support\215349_Grand Ave Apts_Arch_R17_kschneider.rvt
9/5/2017 3:28:22 PM



1 LEVEL 8 - REFLECTED CEILING PLAN

SCALE: 1/8" = 1'-0"

N True North

GENERAL NOTES:

A. CEILING FIXTURES ARE SHOWN FOR REFERENCE ONLY FOR COORDINATION WITH CEILING FINISH SYSTEM. SEE MECHANICAL, ELECTRICAL AND SPRINKLER DRAWINGS FOR ALL CEILING FIXTURES AND TYPES.
B. SPOT ELEVATIONS ARE FROM FINISH FLOOR TO SURFACE FINISH OF CEILING AND ARE ROUNDED TO THE NEAREST INCH (TYP).
C. ALL CEILING HEIGHTS ARE 7' - 8", UON.
D. SEE A170 FOR RECESSED CEILING FIXTURE WRAP REQUIREMENTS.
E. SEE ENLARGED UNIT PLANS FOR UNIT RCP INFO SHEETS A260 - A268.

LEGEND: RCP

- X' - X" FINISH CEILING HEIGHT, A.F.F.
- GYPSUM BOARD CEILING / SOFFIT
- STUCCO CEILING / SOFFIT
- CIRCULAR FIXTURE (SEE ELECTRICAL)
- LINEAR FIXTURE (SEE ELECTRICAL)
- 2x2 LAY-IN FIXTURE (SEE ELECTRICAL)
- EXIT LIGHT
- F# FLOOR/CEILING ASSEMBLY TAG, SEE A151

KEYNOTES

LRS ARCHITECTS
720 NW Davis 503.221.1121
Suite 300 503.221.2077
Portland OR 97209 www.lrsarchitects.com

REGISTERED ARCHITECT
THOMAS PAUL FRANK, JR.
PORTLAND, OR
STATE OF OREGON

LEVERARCHITECTURE
4713 N ALBINA AVE, PDX OR 97217
T 503 928 6040
www.leverarchitecture.com

CONSULTANT:

PROJECT NUMBER: 215349

GRAND AVENUE APARTMENTS

1010 NE GRAND AVE. PORTLAND, OR 97232

SHEET TITLE:

LEVEL 8 - REFLECTED CEILING PLAN

KEY PLAN:

DRAWN BY: Author
DATE CREATED: 09/07/16

1 ADDENDUM #01 08/11/2017

City of Portland REVIEWED FOR CODE COMPLIANCE DEC 22 2017 Permit Number

RECEIVED SEP 06 2017 BDS DOCUMENT SERVICES

SHEET:

A408

PERMIT SET 07-14-2017

LRS Architects, Inc. ©2017

C:\300 Revit Local Files\BIM Support\215349_Grand Ave Apts_Arch_R17_kschneider.rvt
9/5/2017 3:28:31 PM

GENERAL NOTES:

A. CEILING FIXTURES ARE SHOWN FOR REFERENCE ONLY FOR COORDINATION WITH CEILING FINISH SYSTEM. SEE MECHANICAL, ELECTRICAL AND SPRINKLER DRAWINGS FOR ALL CEILING FIXTURES AND TYPES.
B. SPOT ELEVATIONS ARE FROM FINISH FLOOR TO SURFACE FINISH OF CEILING AND ARE ROUNDED TO THE NEAREST INCH (TYP).
C. ALL CEILING HEIGHTS ARE 7' - 8" U.O.N.
D. SEE A170 FOR RECESSED CEILING FIXTURE WRAP REQUIREMENTS.
E. SEE ENLARGED UNIT PLANS FOR UNIT RCP INFO SHEETS A260 - A268.



1 LEVEL 9 - REFLECTED CEILING PLAN

SCALE: 1/8" = 1'-0"

N True North

LEGEND: RCP

- X'-X" — FINISH CEILING HEIGHT, A.F.F.
- GYPSUM BOARD CEILING / SOFFIT
- STUCCO CEILING / SOFFIT
- CIRCULAR FIXTURE (SEE ELECTRICAL)
- LINEAR FIXTURE (SEE ELECTRICAL)
- 2x2 LAY-IN FIXTURE (SEE ELECTRICAL)
- EXIT LIGHT
- F# — FLOOR/CEILING ASSEMBLY TAG, SEE A151

KEYNOTES

LRS ARCHITECTS
720 NW Davis 503.221.1121
Suite 300 503.221.2077
Portland OR 97209 www.lrsarchitects.com

REGISTERED ARCHITECT THOMAS PAUL CLARK PORTLAND, OR STATE OF OREGON

LEVERARCHITECTURE
4713 N ALBINA AVE, PDX OR 97217
T 503 928 6040
www.leverarchitecture.com

CONSULTANT:

PROJECT NUMBER: 215349

GRAND AVENUE APARTMENTS

1010 NE GRAND AVE. PORTLAND, OR 97232

SHEET TITLE:
LEVEL 9 - REFLECTED CEILING PLAN

KEY PLAN:

DRAWN BY: Author
DATE CREATED: 09/07/16

1	ADDENDUM #01	08/11/2017

City of Portland REVIEWED FOR CODE COMPLIANCE DEC 22 2017 Fire Bureau

RECEIVED SEP 06 2017 BDS DOCUMENT SERVICES

SHEET: **A409**
PERMIT SET 07-14-2017

LRS Architects, Inc ©2017

C:\300 Revit Local Files\BIM Support\215349_Grand Ave Apts_Arch_R17_kschneider.rvt
9/5/2017 3:28:39 PM

GENERAL NOTES:

A. CEILING FIXTURES ARE SHOWN FOR REFERENCE ONLY FOR COORDINATION WITH CEILING FINISH SYSTEM. SEE MECHANICAL, ELECTRICAL AND SPRINKLER DRAWINGS FOR ALL CEILING FIXTURES AND TYPES.
B. SPOT ELEVATIONS ARE FROM FINISH FLOOR TO SURFACE FINISH OF CEILING AND ARE ROUNDED TO THE NEAREST INCH (TYP).
C. ALL CEILING HEIGHTS ARE 7'-- 8", U.O.N.
D. SEE A170 FOR RECESSED CEILING FIXTURE WRAP REQUIREMENTS.
E. SEE ENLARGED UNIT PLANS FOR UNIT RCP INFO SHEETS A260 - A268.



1 LEVEL 10 - REFLECTED CEILING PLAN

SCALE: 1/8" = 1'-0"

N True North

LEGEND: RCP

- (X'-X") FINISH CEILING HEIGHT, A.F.F.
- GYPSUM BOARD CEILING / SOFFIT
- STUCCO CEILING / SOFFIT
- CIRCULAR FIXTURE (SEE ELECTRICAL)
- LINEAR FIXTURE (SEE ELECTRICAL)
- 2x2 LAY-IN FIXTURE (SEE ELECTRICAL)
- EXIT LIGHT
- F# FLOOR/CEILING ASSEMBLY TAG, SEE A151

KEYNOTES

LRS ARCHITECTS
720 NW Davis 503.221.1121
Suite 300 503.221.2077
Portland OR 97209 www.lrsarchitects.com

REGISTERED ARCHITECT
THOMAS PAUL FRANK
PORTLAND, OR
STATE OF OREGON

LEVERARCHITECTURE
4713 N ALBINA AVE, PDX OR 97217
T 503 928 6040
www.leverarchitecture.com

CONSULTANT:

PROJECT NUMBER: 215349

GRAND AVENUE APARTMENTS

1010 NE GRAND AVE. PORTLAND, OR 97232

SHEET TITLE:
LEVEL 10 - REFLECTED CEILING PLAN

KEY PLAN:

DRAWN BY: Author
DATE CREATED: 09/07/16

1 ADDENDUM #01 08/11/2017

CITY OF PORTLAND, OREGON
REVIEWED FOR CODE COMPLIANCE
DEC 22 2017
Permit Number

RECEIVED
SEP 06 2017
BDS
DOCUMENT SERVICES

SHEET:
A410
PERMIT SET
07-14-2017

LRS Architects, Inc. ©2017

GENERAL NOTES:

A. CEILING FIXTURES ARE SHOWN FOR REFERENCE ONLY FOR COORDINATION WITH CEILING FINISH SYSTEM. SEE MECHANICAL, ELECTRICAL AND SPRINKLER DRAWINGS FOR ALL CEILING FIXTURES AND TYPES.
B. SPOT ELEVATIONS ARE FROM FINISH FLOOR TO SURFACE FINISH OF CEILING AND ARE ROUNDED TO THE NEAREST INCH (TYP).
C. ALL CEILING HEIGHTS ARE 7' - 8". U.O.N.
D. SEE A170 FOR RECESSED CEILING FIXTURE WRAP REQUIREMENTS.
E. SEE ENLARGED UNIT PLANS FOR UNIT RCP INFO SHEETS A260 - A268.



1 LEVEL 11 - REFLECTED CEILING PLAN

SCALE: 1/8" = 1'-0"

N True North

LEGEND: RCP

- X'-X" — FINISH CEILING HEIGHT, A.F.F.
- GYPSUM BOARD CEILING / SOFFIT
- STUCCO CEILING / SOFFIT
- CIRCULAR FIXTURE (SEE ELECTRICAL)
- LINEAR FIXTURE (SEE ELECTRICAL)
- 2x2 LAY-IN FIXTURE (SEE ELECTRICAL)
- EXIT LIGHT
- F# — FLOOR/CEILING ASSEMBLY TAG, SEE A151

KEYNOTES

LRS ARCHITECTS
720 NW Davis 503.221.1121
Suite 300 503.221.2077
Portland OR 97209 www.lrsarchitects.com

REGISTERED ARCHITECT — THOMAS PAUL LEVER — PORTLAND, OR — STATE OF OREGON

LEVERARCHITECTURE
4713 N ALBINA AVE, PDX OR 97217
T 503 928 6040
www.leverarchitecture.com

CONSULTANT:

PROJECT NUMBER: 215349

GRAND AVENUE APARTMENTS

1010 NE GRAND AVE. PORTLAND, OR 97232

SHEET TITLE:
LEVEL 11 - REFLECTED CEILING PLAN

KEY PLAN:

DRAWN BY: Author
DATE CREATED: 09/07/16

1	ADDENDUM #01	08/11/2017

City of Portland, Oregon — BUREAU OF DEVELOPMENT SERVICES — DEC 22 2017 — Approved

RECEIVED — SEP 06 2017 — BDS DOCUMENT SERVICES

SHEET: **A411**

PERMIT SET 07-14-2017

LRS Architects, Inc. ©2017

GENERAL NOTES:

A. CEILING FIXTURES ARE SHOWN FOR REFERENCE ONLY FOR COORDINATION WITH CEILING FINISH SYSTEM. SEE MECHANICAL, ELECTRICAL AND SPRINKLER DRAWINGS FOR ALL CEILING FIXTURES AND TYPES.
B. SPOT ELEVATIONS ARE FROM FINISH FLOOR TO SURFACE FINISH OF CEILING AND ARE ROUNDED TO THE NEAREST INCH (TYP).
C. ALL CEILING HEIGHTS ARE 7' - 8", U.O.N.
D. SEE A170 FOR RECESSED CEILING FIXTURE WRAP REQUIREMENTS.
E. SEE ENLARGED UNIT PLANS FOR UNIT RCP INFO SHEETS A250 - A268.



KEYNOTES

LEGEND: RCP

- X'-X" — FINISH CEILING HEIGHT, A.F.F.
- GYPSUM BOARD CEILING / SOFFIT
- STUCCO CEILING / SOFFIT
- CIRCULAR FIXTURE (SEE ELECTRICAL)
- LINEAR FIXTURE (SEE ELECTRICAL)
- 2x2 LAY-IN FIXTURE (SEE ELECTRICAL)
- EXIT LIGHT
- F# — FLOOR/CEILING ASSEMBLY TAG, SEE A151

1 LEVEL 12 - REFLECTED CEILING PLAN

SCALE: 1/8" = 1'-0"

N True North

LRS ARCHITECTS
720 NW Davis 503.221.1121
Suite 300 503.221.2077
Portland OR 97209 www.lrsarchitects.com

REGISTERED ARCHITECT THOMAS PAUL CLARK PORTLAND, OR STATE OF OREGON

LEVERARCHITECTURE
4713 N ALBINA AVE, PDX OR 97217
T 503 928 6040
www.leverarchitecture.com

CONSULTANT:

PROJECT NUMBER: 215349

GRAND AVENUE APARTMENTS

1010 NE GRAND AVE. PORTLAND, OR 97232

SHEET TITLE:
LEVEL 12 - REFLECTED CEILING PLAN

KEY PLAN:

DRAWN BY: Author
DATE CREATED: 09/07/16

1	ADDENDUM #01	08/11/2017

City of Portland REVIEWED FOR CODE COMPLIANCE DEC 22 2017 Permit Number:

RECEIVED SEP 06 2017 BDS DOCUMENT SERVICES

SHEET:
A412
PERMIT SET 07-14-2017

LRS Architects, Inc. ©2017

C:\300 Revit Local Files\BIM Support\215349_Grand Ave Apts_Arch_R17_kschneider.rvt
9/5/2017 3:29:05 PM

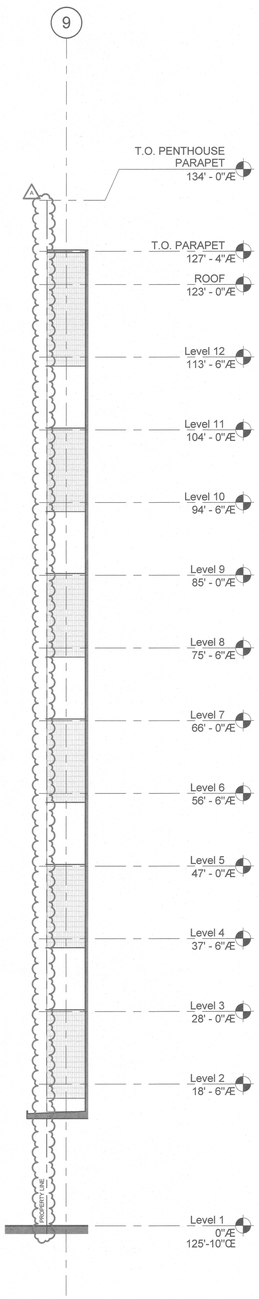

3 S. CORRIDOR INSET - W. ELEV.

SCALE: 1/8" = 1'-0"

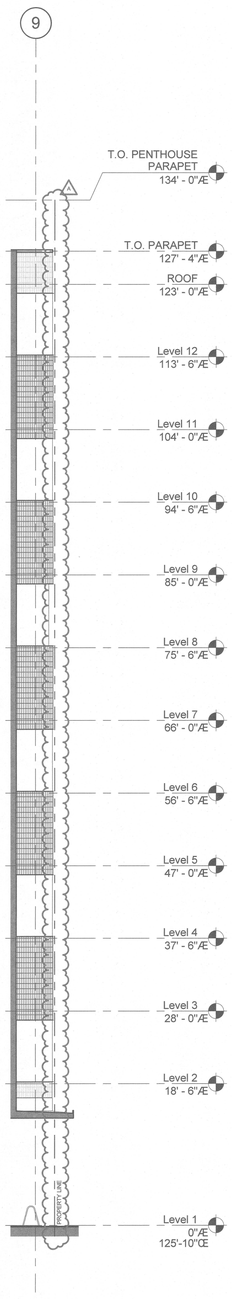

2 S. CORRIDOR INSET - E. ELEV

SCALE: 1/8" = 1'-0"

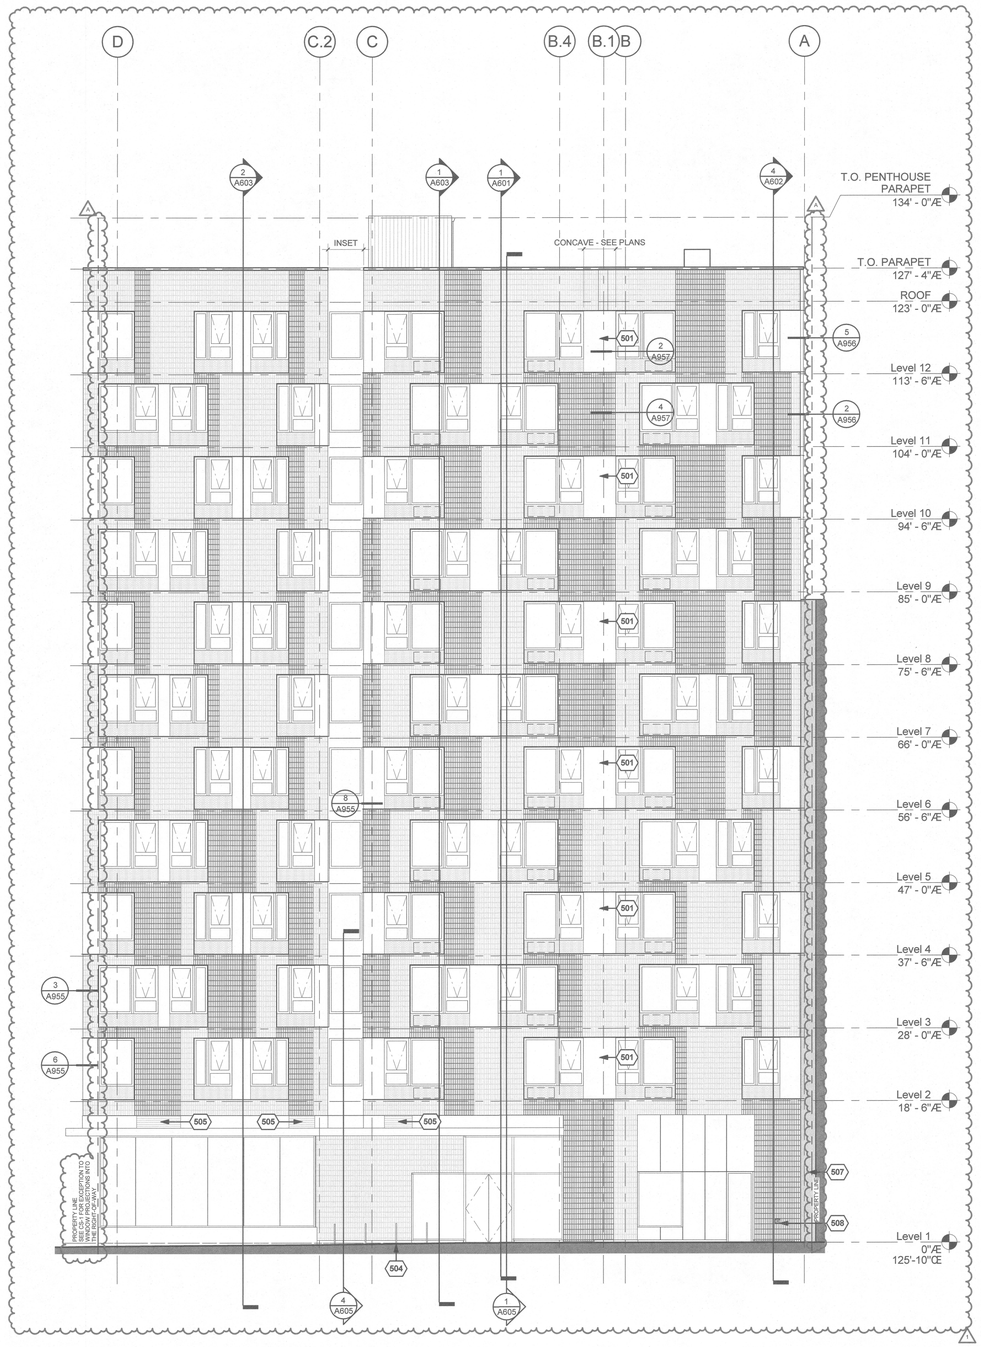

1 OVERALL SOUTH ELEVATION

SCALE: 1/8" = 1'-0"

GENERAL NOTES:

A. PAINT ALL NON-NOTED MISCELLANEOUS ITEMS TO MATCH ADJACENT REFERENCED FINISH, UON.
B. SEE WALL SECTIONS FOR PARTIAL ELEVATIONS NOT SHOWN.
C. SEE FLOOR PLANS, DOOR SCHEDULE & WINDOW TYPES FOR SIZES.
D. WINDOWS TO ALIGN VERTICALLY, TYPICAL, UON.
E. LOUVER & VENT LOCATIONS TO BE COORDINATED WITH ARCHITECT.
F. ELEVATIONS ARE NOT ORTHAGONAL TO ALL BUILDING FACES, SEE PLANS.

MATERIALS LEGEND:

- THIN FACE BRICK - 1 (PEWTER) (BRICK-1)
- THIN FACE BRICK - 2 (WHITE - GLAZED) (BRICK-2)
- COMPOSITE METAL PANEL - 1 (CMP-1)
- PREFINISHED METAL PANEL SYSTEM-3 (MP-3)
- PREFINISHED METAL PANEL SYSTEM-4 (MP-4)
- PERFORATED METAL PANEL (PMP-1)
- PREFINISHED METAL PANEL SYSTEM-3 PERFORATED (MP-3)
- PREFINISHED METAL PANEL SYSTEM-4 PERFORATED (MP-4)
- STUCCO
- CMU

KEYNOTES

501 PF. SHEET METAL PANEL AT CONCAVE/CONVEX
504 BIKE RACK - SEE LANDSCAPE.
505 LOUVER - COORDINATE W/ MECHANICAL.
507 P.F. METAL CLOSURE PANEL.
508 FIRE DEPARTMENT CONNECTION.

ZONING COMPLIANCE PAGE
CASE FILE LU-16-287887 DZM
REQUIRED - NO FIELD CHANGES ALLOWED

This plan matches that approved by Planning and includes all notes from other reviews.
T. Boden - kwa (name) 11/21/17 (date)
12/4/17

LRS ARCHITECTS
720 NW Davis 503.221.1121
Suite 300 503.221.2077
Portland OR 97209 www.lrsarchitects.com

REGISTERED ARCHITECT THOMAS PAUL KEMPER PORTLAND, OR STATE OF OREGON

LEVERARCHITECTURE
4713 N ALBINA AVE, PDX OR 97217
T 503 928 6040
www.leverarchitecture.com

CONSULTANT:

PROJECT NUMBER: 215349

GRAND AVENUE APARTMENTS

1010 NE GRAND AVE. PORTLAND, OR 97232

SHEET TITLE:
EXTERIOR ELEVATIONS

KEY PLAN:

DRAWN BY: Author
DATE CREATED: 07/25/16

1	ADDENDUM #01	08/11/2017
A	PLAN CHECK	09/01/2017

City of Portland, Oregon - Bureau of Development Services - FINAL INSPECTION - DEC 22 2017

RECEIVED SEP 06 2017 BDS DOCUMENT SERVICES

SHEET:
A501
PERMIT SET 07-14-2017

LRS Architects, Inc. ©2017

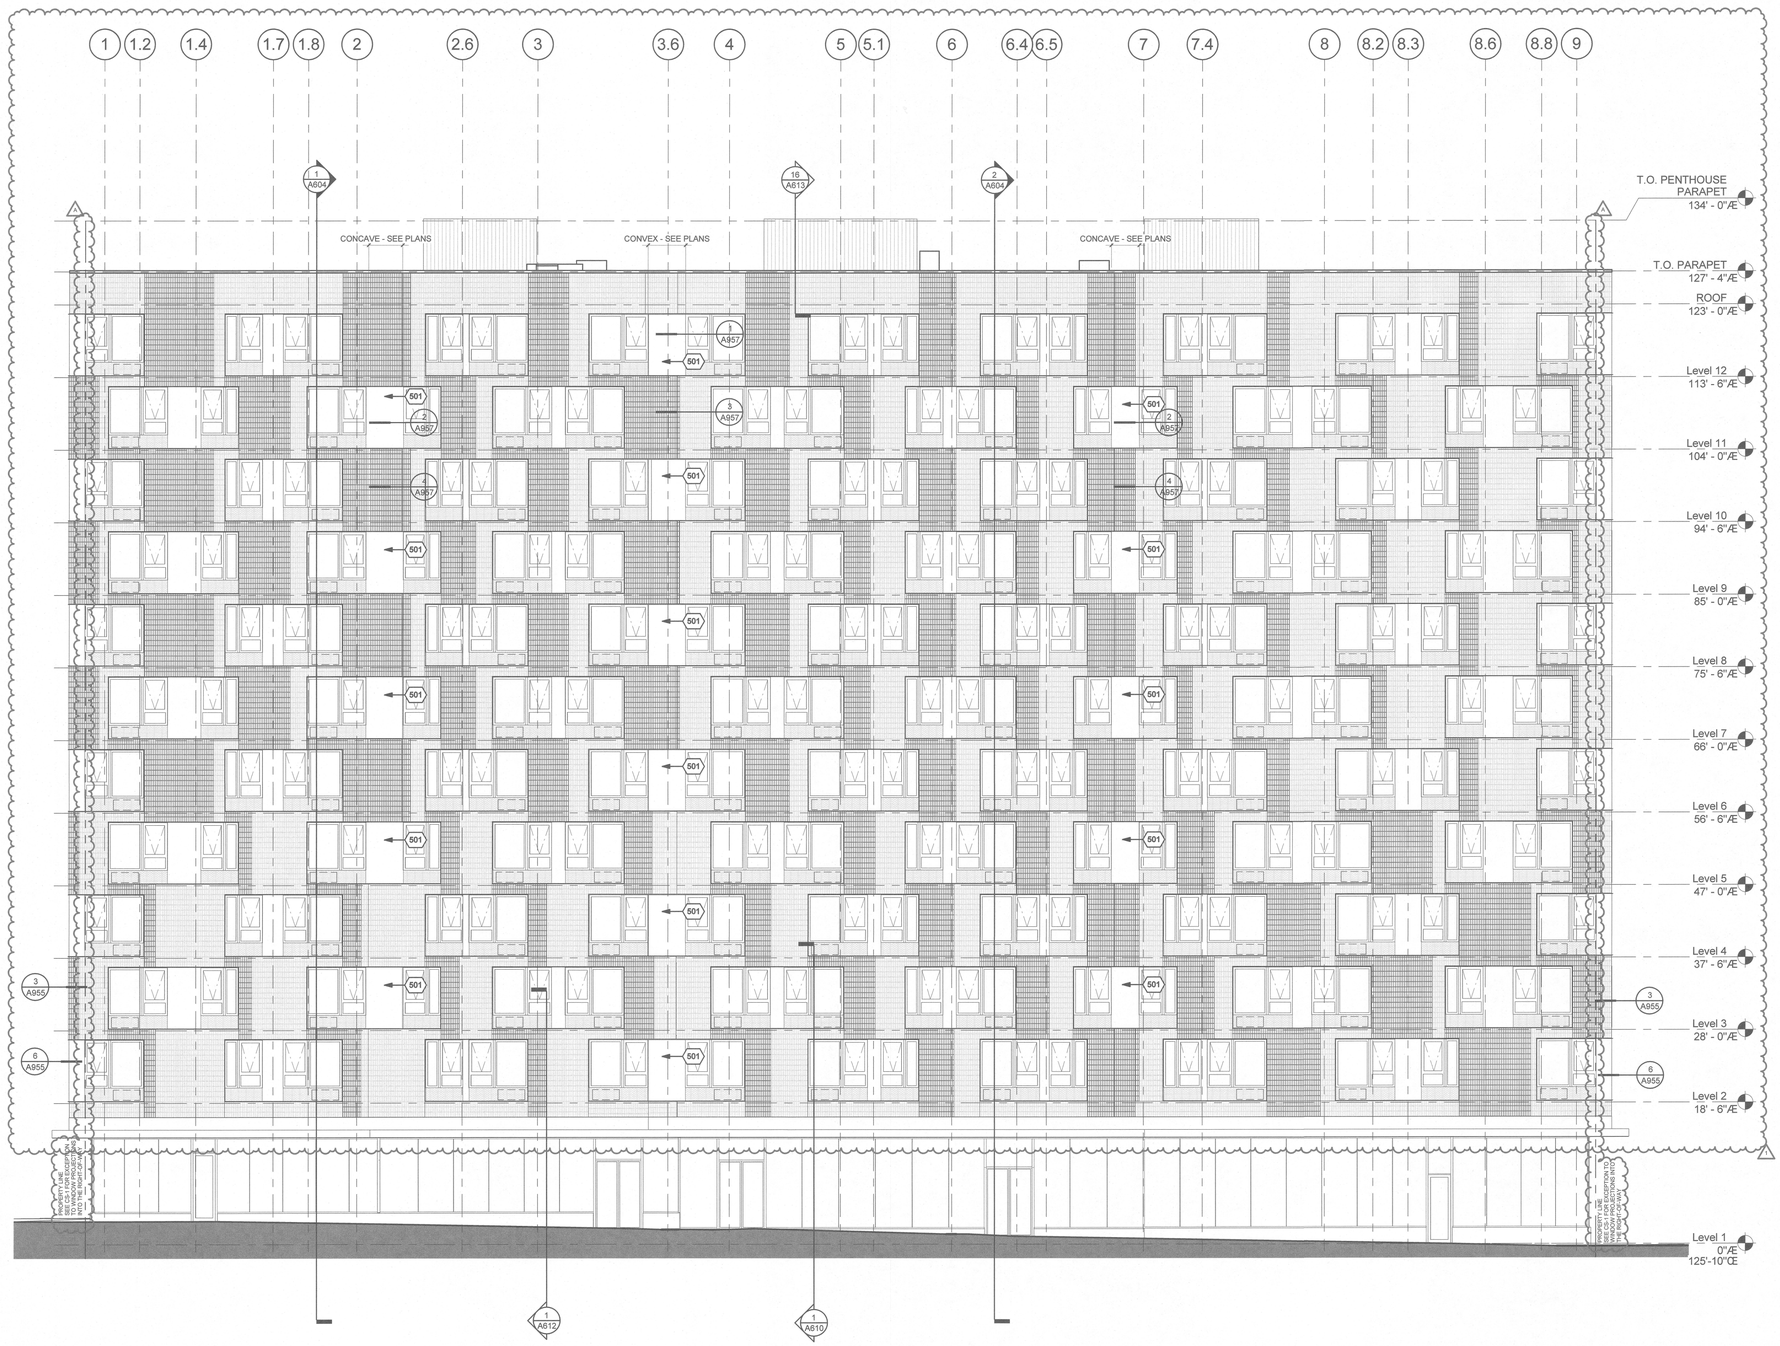

1 OVERALL WEST ELEVATION

SCALE: 1/8" = 1'-0"

GENERAL NOTES:

A. PAINT ALL NON-NOTED MISCELLANEOUS ITEMS TO MATCH ADJACENT REFERENCED FINISH, UON.
B. SEE WALL SECTIONS FOR PARTIAL ELEVATIONS NOT SHOWN.
C. SEE FLOOR PLANS, DOOR SCHEDULE & WINDOW TYPES FOR SIZES.
D. WINDOWS TO ALIGN VERTICALLY, TYPICAL, UON.
E. LOUVER & VENT LOCATIONS TO BE COORDINATED WITH ARCHITECT.
F. ELEVATIONS ARE NOT ORTHAGONAL TO ALL BUILDING FACES, SEE PLANS.

MATERIALS LEGEND:

- THIN FACE BRICK - 1 (PEWTER) (BRICK-1)
- THIN FACE BRICK - 2 (WHITE - GLAZED) (BRICK-2)
- COMPOSITE METAL PANEL - 1 (CMP-1)
- PREFINISHED METAL PANEL SYSTEM-3 (MP-3)
- PREFINISHED METAL PANEL SYSTEM-4 (MP-4)
- PERFORATED METAL PANEL (PMP-1)
- PREFINISHED METAL PANEL SYSTEM-3 PERFORATED (MP-3)
- PREFINISHED METAL PANEL SYSTEM-4 PERFORATED (MP-4)
- STUCCO
- CMU

KEYNOTES

501 PF. SHEET METAL PANEL AT CONCAVE/CONVEX

This plan matches that approved by Planning and includes all notes from other reviews.
T. BOREN-KUHN (name) 11/21/17 (date) 12/4/17

ZONING COMPLIANCE PAGE
CASE FILE LU-16-287887 DZM
REQUIRED - NO FIELD CHANGES ALLOWED

LRS ARCHITECTS
720 NW Davis 503.221.1121
Suite 300 503.221.2077
Portland OR 97209 www.lrsarchitects.com

REGISTERED ARCHITECT
THOMAS PAUL KUHN, AIA
PORTLAND, OR
STATE OF OREGON

LEVERARCHITECTURE
4713 N ALBINA AVE, PDX OR 97217
T 503 928 6040
www.leverarchitecture.com

CONSULTANT:

PROJECT NUMBER: 215349

GRAND AVENUE APARTMENTS

1010 NE GRAND AVE. PORTLAND, OR 97232

SHEET TITLE:
EXTERIOR ELEVATIONS

KEY PLAN:

DRAWN BY: Author
DATE CREATED: 06/24/13

1	ADDENDUM #01	08/11/2017
A	PLAN CHECK	09/01/2017

City of Portland REVIEWED FOR CODE COMPLIANCE DEC 22 2017 Permit Set

RECEIVED SEP 06 2017 BDS DOCUMENT SERVICES

SHEET: **A502**

City of Portland REVIEWED FOR CODE COMPLIANCE PERMIT SET 07-14-2017 DEC 22 2017 Permit Number

LRS Architects, Inc. ©2017

C:\300 Revit Local Files\BIM Support\215349_Grand Ave Apts_Arch_R17_kschneider.rvt
9/5/2017 3:29:40 PM

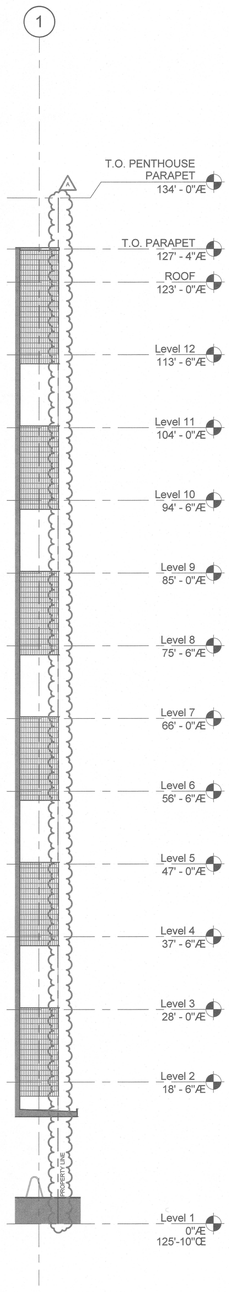

3 N. CORRDIOR INSET - W. ELEV.

SCALE: 1/8" = 1'-0"

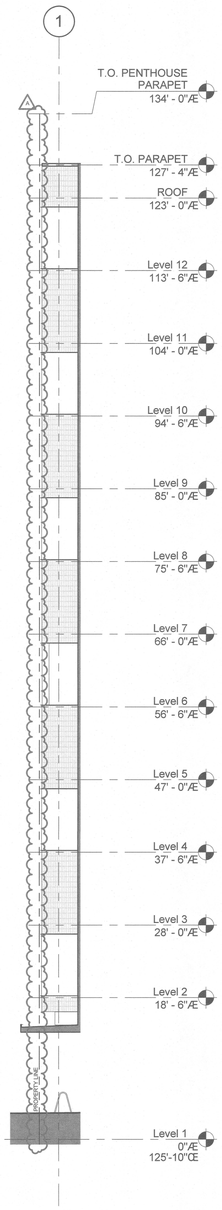

2 N. CORRIDOR INSET - E. ELEV.

SCALE: 1/8" = 1'-0"

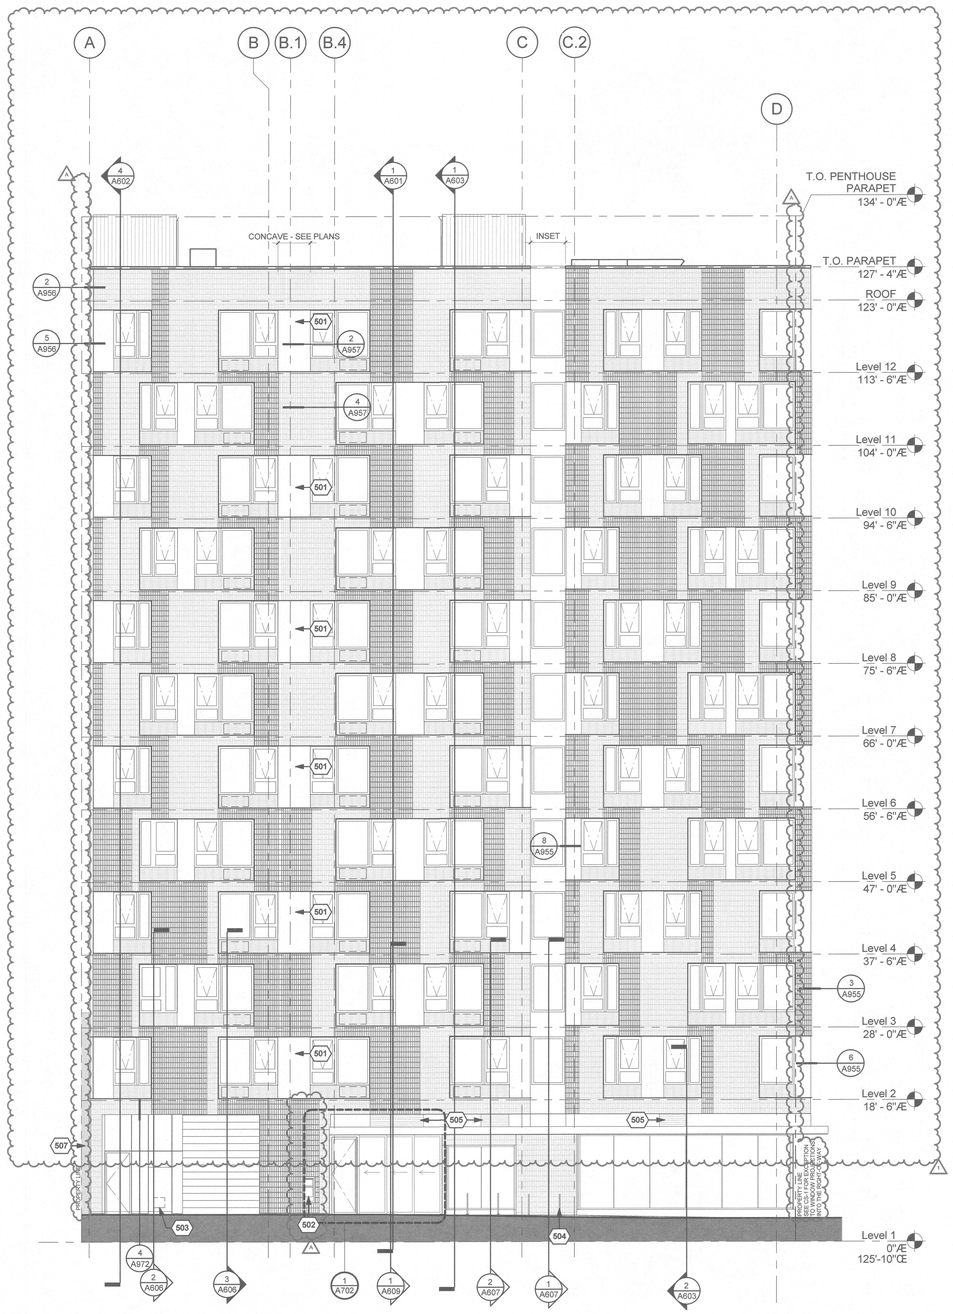

1 OVERALL NORTH ELEVATION

SCALE: 1/8" = 1'-0"

GENERAL NOTES:

A. PAINT ALL NON-NOTED MISCELLANEOUS ITEMS TO MATCH ADJACENT REFERENCED FINISH, UON.
B. SEE WALL SECTIONS FOR PARTIAL ELEVATIONS NOT SHOWN.
C. SEE FLOOR PLANS, DOOR SCHEDULE & WINDOW TYPES FOR SIZES.
D. WINDOWS TO ALIGN VERTICALLY, TYPICAL, UON.
E. LOUVER & VENT LOCATIONS TO BE COORDINATED WITH ARCHITECT.
F. ELEVATIONS ARE NOT ORTHAGONAL TO ALL BUILDING FACES, SEE PLANS.

MATERIALS LEGEND:

- THIN FACE BRICK - 1 (PEWTER) (BRICK-1)
- THIN FACE BRICK - 2 (WHITE - GLAZED) (BRICK-2)
- COMPOSITE METAL PANEL - 1 (CMP-1)
- PREFINISHED METAL PANEL SYSTEM-3 (MP-3)
- PREFINISHED METAL PANEL SYSTEM-4 (MP-4)
- PERFORATED METAL PANEL (PMP-1)
- PREFINISHED METAL PANEL SYSTEM-3 PERFORATED (MP-3)
- PREFINISHED METAL PANEL SYSTEM-4 PERFORATED (MP-4)
- STUCCO
- CMU

KEYNOTES

501 PF. SHEET METAL PANEL AT CONCAVE/CONVEX
502 GENERATOR FUEL FILL STATION.
503 GAS REGULATOR - COORDINATE W/ UTILITY PROVIDER.
504 BIKE RACK - SEE LANDSCAPE.
505 LOUVER - COORDINATE W/ MECHANICAL.
507 P.F. METAL CLOSURE PANEL.

ZONING COMPLIANCE PAGE
CASE FILE LU-16-287887 DZM
REQUIRED - NO FIELD CHANGES ALLOWED

This plan matches that approved by Planning and includes all notes from other reviews.
T. BARSYEKIAN (name) DE (date) 12/4/17

LRS ARCHITECTS
720 NW Davis 503.221.1121
Suite 300 503.221.2077
Portland OR 97209 www.lrsarchitects.com

REGISTERED ARCHITECT THOMAS PAUL FRANK PORTLAND, OR STATE OF OREGON

LEVERARCHITECTURE
4713 N ALBINA AVE, PDX OR 97217
T 503 928 6040
www.leverarchitecture.com

CONSULTANT:

PROJECT NUMBER: 215349

GRAND AVENUE APARTMENTS

1010 NE GRAND AVE. PORTLAND, OR 97232

SHEET TITLE:
EXTERIOR ELEVATIONS

KEY PLAN:

DRAWN BY: Author
DATE CREATED: 01/30/17

1	ADDENDUM #01	08/11/2017
2	ADDENDUM #02	XX/XX/XXXX
A	PLAN CHECK	09/01/2017

CITY OF PORTLAND DEC 22 2017 BUREAU OF DEVELOPMENT SERVICES

RECEIVED SEP 06 2017 BDS DOCUMENT SERVICES

SHEET: **A503**
PERMIT SET 07-14-2017

LRS Architects, Inc ©2017

C:\300 Revit Local Files\BIM Support\215349_Grand Ave Apts_Arch_R17_kschneider.rvt
9/5/2017 3:29:53 PM



1 OVERALL EAST ELEVATION

SCALE: 1/8" = 1'-0"

GENERAL NOTES:

A. PAINT ALL NON-NOTED MISCELLANEOUS ITEMS TO MATCH ADJACENT REFERENCED FINISH, UON.
B. SEE WALL SECTIONS FOR PARTIAL ELEVATIONS NOT SHOWN.
C. SEE FLOOR PLANS, DOOR SCHEDULE & WINDOW TYPES FOR SIZES.
D. WINDOWS TO ALIGN VERTICALLY, TYPICAL, UON.
E. LOUVER & VENT LOCATIONS TO BE COORDINATED WITH ARCHITECT.
F. ELEVATIONS ARE NOT ORTHAGONAL TO ALL BUILDING FACES, SEE PLANS.

MATERIALS LEGEND:

- THIN FACE BRICK - 1 (PEWTER) (BRICK-1)
- THIN FACE BRICK - 2 (WHITE - GLAZED) (BRICK-2)
- COMPOSITE METAL PANEL - 1 (CMP-1)
- PREFINISHED METAL PANEL SYSTEM-3 (MP-3)
- PREFINISHED METAL PANEL SYSTEM-4 (MP-4)
- PERFORATED METAL PANEL (PMP-1)
- PREFINISHED METAL PANEL SYSTEM-3 PERFORATED (MP-3)
- PREFINISHED METAL PANEL SYSTEM-4 PERFORATED (MP-4)
- STUCCO
- CMU

KEYNOTES

505 LOUVER - COORDINATE W/ MECHANICAL.

This plan matches that approved by Planning and includes all notes from other reviews.

T. BOREN-KING 11/21/17
(name) DK (date) 12/4/17

ZONING COMPLIANCE PAGE
CASE FILE LU-16-287887 DZM
REQUIRED - NO FIELD CHANGES ALLOWED

LRS ARCHITECTS
720 NW Davis 503.221.1121
Suite 300 503.221.2077
Portland OR 97209 www.lrsarchitects.com

REGISTERED ARCHITECT
THOMAS PAUL FRANK
PORTLAND, OR
STATE OF OREGON

LEVERARCHITECTURE
4713 N ALBINA AVE, PDX OR 97217
T 503 928 6040
www.leverarchitecture.com

CONSULTANT:

PROJECT NUMBER: 215349

GRAND AVENUE APARTMENTS

1010 NE GRAND AVE. PORTLAND, OR 97232

SHEET TITLE:

EXTERIOR ELEVATIONS

KEY PLAN:

DRAWN BY: Author
DATE CREATED: 07/25/16

1	ADDENDUM #01	08/11/2017
A	PLAN CHECK	09/01/2017

City of Portland
REVIEWED FOR CODE COMPLIANCE
DEC 22 2017
Permit Director

RECEIVED
SEP 06 2017
BDS
DOCUMENT SERVICES

SHEET:

A504

PERMIT SET
07-14-2017

LRS Architects, Inc. ©2017

C:\300 Revit Local Files\BIM Support\215349_Grand Ave Apts_Arch_R17_kschneider.rvt
9/5/2017 3:30:04 PM



1 OVERALL EAST ELEVATION - WALL FRAMING

SCALE: 1/8" = 1'-0"

GENERAL NOTES:

A. PAINT ALL NON-NOTED MISCELLANEOUS ITEMS TO MATCH ADJACENT REFERENCED FINISH, UON.
B. SEE WALL SECTIONS FOR PARTIAL ELEVATIONS NOT SHOWN.
C. SEE FLOOR PLANS, DOOR SCHEDULE & WINDOW TYPES FOR SIZES.
D. WINDOWS TO ALIGN VERTICALLY, TYPICAL, UON.
E. LOUVER & VENT LOCATIONS TO BE COORDINATED WITH ARCHITECT.
F. ELEVATIONS ARE NOT ORTHAGONAL TO ALL BUILDING FACES, SEE PLANS.

MATERIALS LEGEND:

- THIN FACE BRICK - 1 (PEWTER) (BRICK-1)
- THIN FACE BRICK - 2 (WHITE - GLAZED) (BRICK-2)
- COMPOSITE METAL PANEL - 1 (CMP-1)
- PREFINISHED METAL PANEL SYSTEM-3 (MP-3)
- PREFINISHED METAL PANEL SYSTEM-4 (MP-4)
- PERFORATED METAL PANEL (PMP-1)
- PREFINISHED METAL PANEL SYSTEM-3 PERFORATED (MP-3)
- PREFINISHED METAL PANEL SYSTEM-4 PERFORATED (MP-4)
- STUCCO
- CMU

KEYNOTES

505 LOUVER - COORDINATE W/ MECHANICAL.

This plan matches that approved by Planning and includes all notes from other reviews.
T. BOREN-KING (name) DK (date) 11/28/17 12/4/17

LRS ARCHITECTS
720 NW Davis 503.221.1121
Suite 300 503.221.2077
Portland OR 97209 www.lrsarchitects.com

REGISTERED ARCHITECT THOMAS PAUL CARR PORTLAND, OR STATE OF OREGON

LEVERARCHITECTURE
4713 N ALBINA AVE, PDX OR 97217
T 503 928 6040
www.leverarchitecture.com

CONSULTANT:

PROJECT NUMBER: 215349

GRAND AVENUE APARTMENTS

1010 NE GRAND AVE. PORTLAND, OR 97232

SHEET TITLE:
EXTERIOR ELEVATIONS

KEY PLAN:

DRAWN BY: Author
DATE CREATED: 03/21/17

1	ADDENDUM #01	08/11/2017

City of Portland BUREAU OF DEVELOPMENT SERVICES DEC 22 2017 Plans Review

RECEIVED SEP 06 2017 BDS DOCUMENT SERVICES

SHEET: **A505**

PERMIT SET 07-14-2017

LRS Architects, Inc. ©2017

C:\300 Revit Local Files\BIM Support\215349_Grand Ave Apts_Arch_R17_kschneider.rvt
9/5/2017 3:30:24 PM

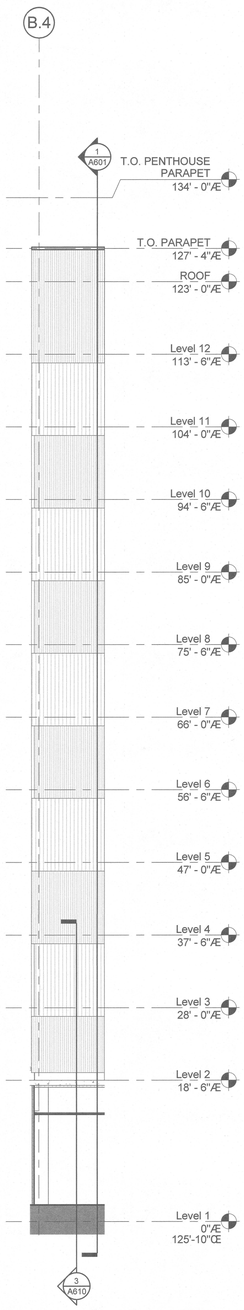

4 S. COURTYARD RECESS - S. ELEV

SCALE: 1/8" = 1'-0"

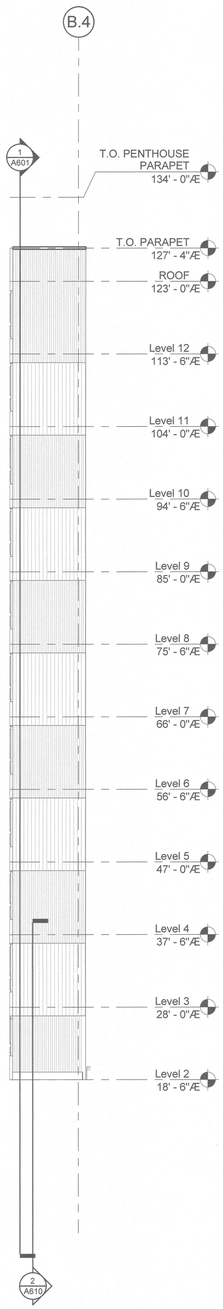

3 N. COURTYARD RECESS - N. ELEV.

SCALE: 1/8" = 1'-0"

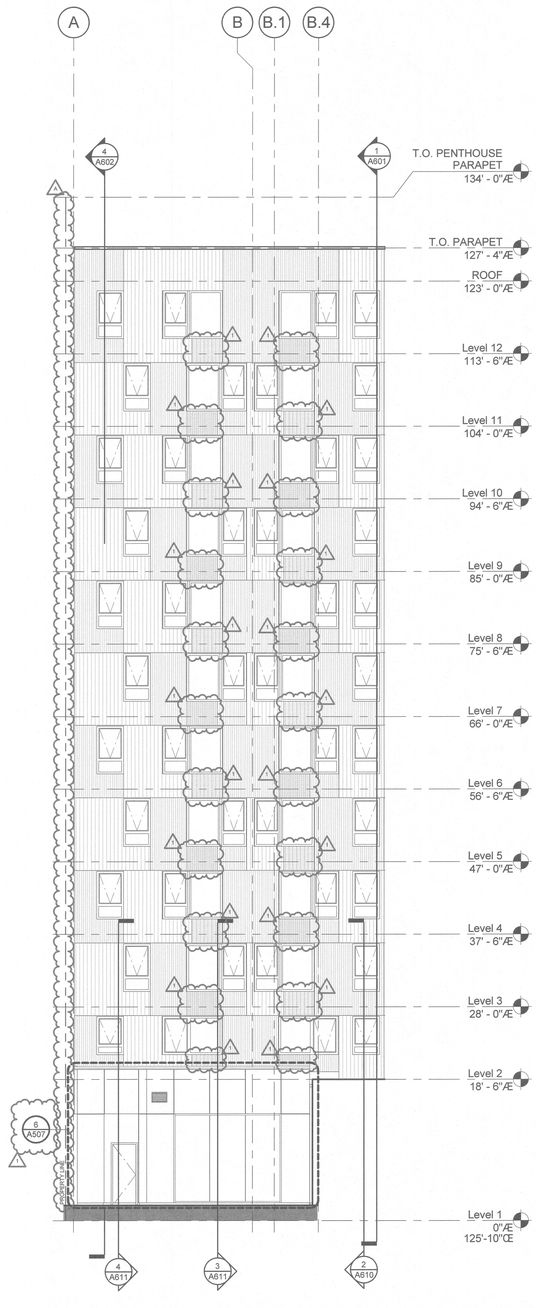

2 COURTYARD NORTH ELEVATION

SCALE: 1/8" = 1'-0"

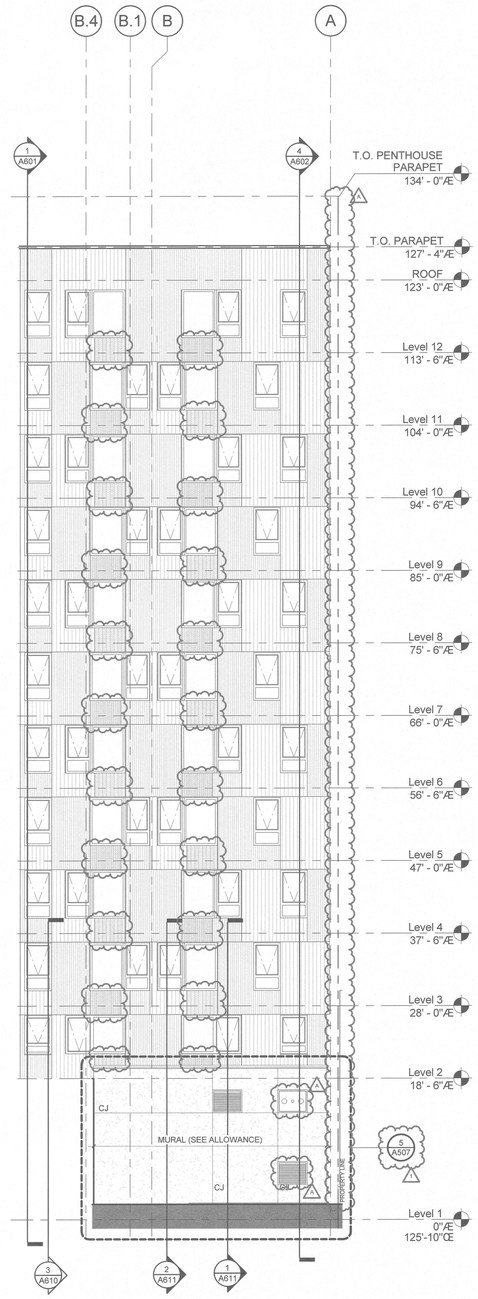

1 COURTYARD SOUTH ELEVATION

SCALE: 1/8" = 1'-0"

GENERAL NOTES:

A. PAINT ALL NON-NOTED MISCELLANEOUS ITEMS TO MATCH ADJACENT REFERENCED FINISH, UON.
B. SEE WALL SECTIONS FOR PARTIAL ELEVATIONS NOT SHOWN.
C. SEE FLOOR PLANS, DOOR SCHEDULE & WINDOW TYPES FOR SIZES.
D. WINDOWS TO ALIGN VERTICALLY, TYPICAL, UON.
E. LOUVER & VENT LOCATIONS TO BE COORDINATED WITH ARCHITECT.
F. ELEVATIONS ARE NOT ORTHAGONAL TO ALL BUILDING FACES, SEE PLANS.

MATERIALS LEGEND:

- THIN FACE BRICK - 1 (PEWTER) (BRICK-1)
- THIN FACE BRICK - 2 (WHITE - GLAZED) (BRICK-2)
- COMPOSITE METAL PANEL - 1 (CMP-1)
- PREFINISHED METAL PANEL SYSTEM-3 (MP-3)
- PREFINISHED METAL PANEL SYSTEM-4 (MP-4)
- PERFORATED METAL PANEL (PMP-1)
- PREFINISHED METAL PANEL SYSTEM-3 PERFORATED (MP-3)
- PREFINISHED METAL PANEL SYSTEM-4 PERFORATED (MP-4)
- STUCCO
- CMU

This plan matches that approved by Planning and includes all notes from other reviews.
T. BOWEN-KING (name) DK (initials) 11/21/17 (date) 12/4/17

LRS ARCHITECTS
720 NW Davis 503.221.1121
Suite 300 503.221.2077
Portland OR 97209 www.lrsarchitects.com

REGISTERED ARCHITECT THOMAS PAUL KING PORTLAND, OR STATE OF OREGON

LEVERARCHITECTURE
4713 N ALBINA AVE, PDX OR 97217
T 503 928 6040
www.leverarchitecture.com

CONSULTANT:

PROJECT NUMBER: 215349

GRAND AVENUE APARTMENTS

1010 NE GRAND AVE. PORTLAND, OR 97232

SHEET TITLE:
PARTIAL EXTERIOR ELEVATIONS

KEY PLAN:

DRAWN BY: Author
DATE CREATED: 07/25/16

1	ADDENDUM #01	08/11/2017
A	PLAN CHECK	09/01/2017

City of Portland BUREAU OF DEVELOPMENT SERVICES DEC 22 2017 Permit Attached

RECEIVED SEP 06 2017 BDS DOCUMENT SERVICES

SHEET: **A506**
PERMIT SET 07-14-2017

LRS Architects, Inc. ©2017

C:\300 Revit Local Files\BIM Support\215349_Grand Ave Apts_Arch_R17_kschneider.rvt
9/5/2017 3:30:32 PM

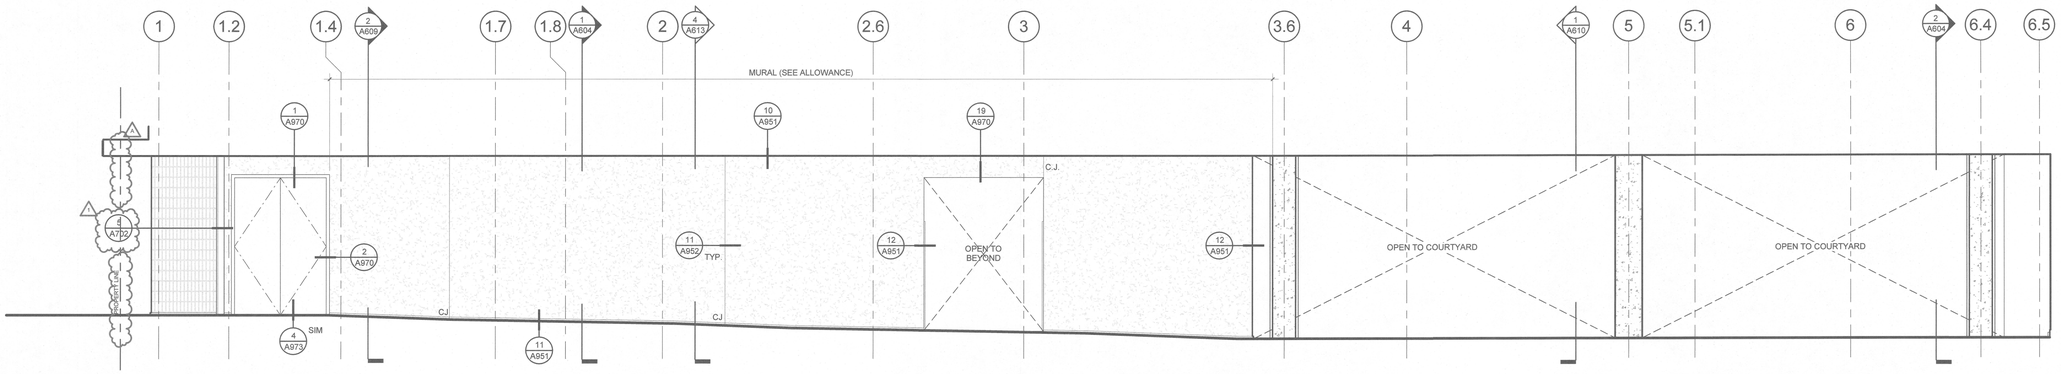

1 ALLEYWAY - EAST ELEVATION

SCALE: 1/4" = 1'-0"

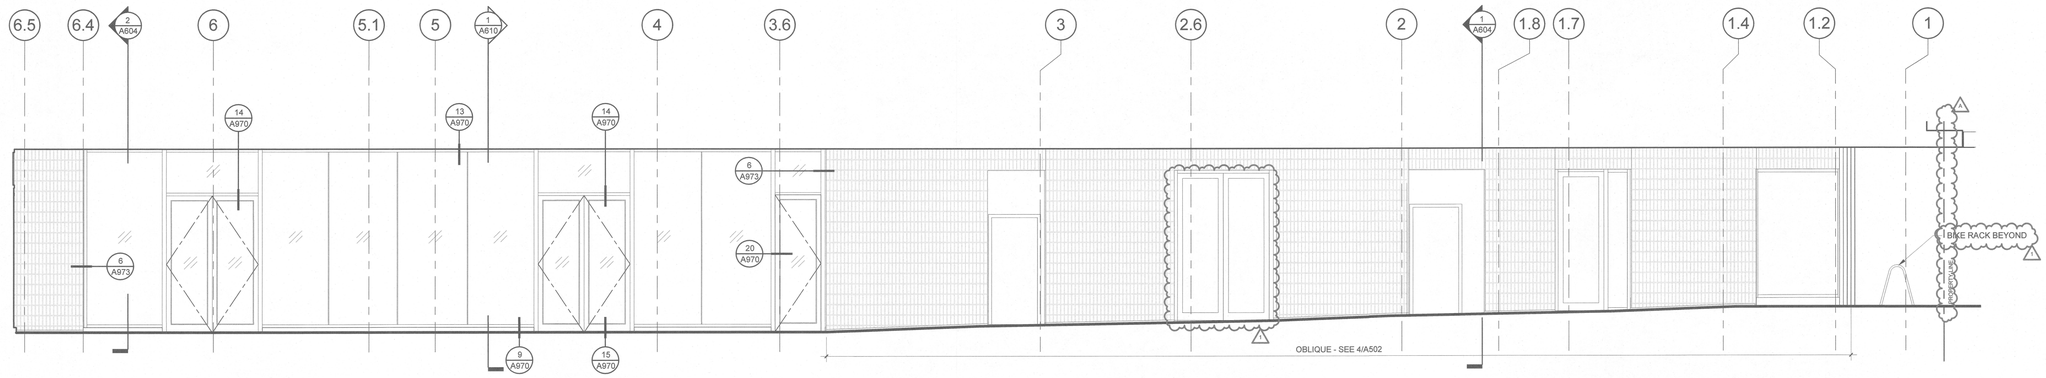

2 ALLEYWAY - WEST ELEVATION

SCALE: 1/4" = 1'-0"

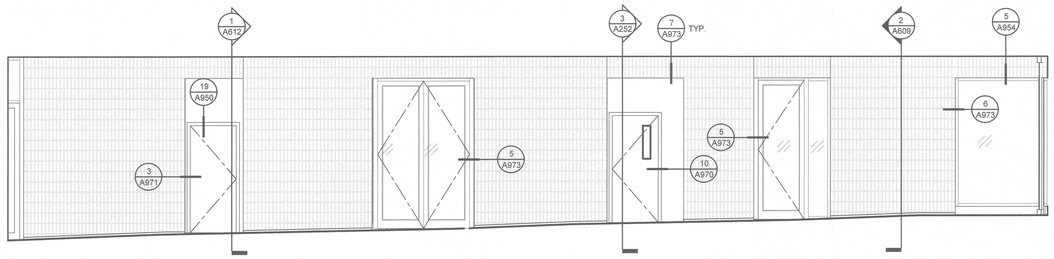

4 ALLEYWAY BRICK FACADE

SCALE: 1/4" = 1'-0"

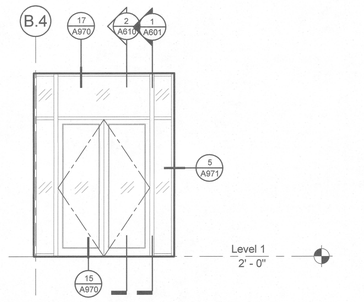

3 ALLEYWAY - SOUTH ELEVATION

SCALE: 1/4" = 1'-0"

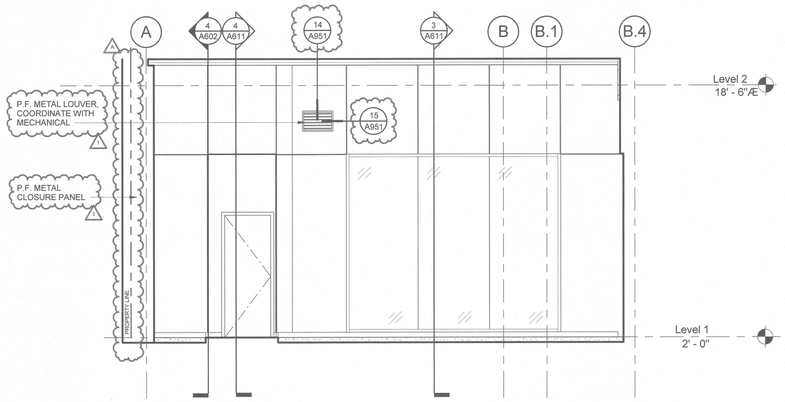

6 COURTYARD - NORTH ELEVATION

SCALE: 1/4" = 1'-0"

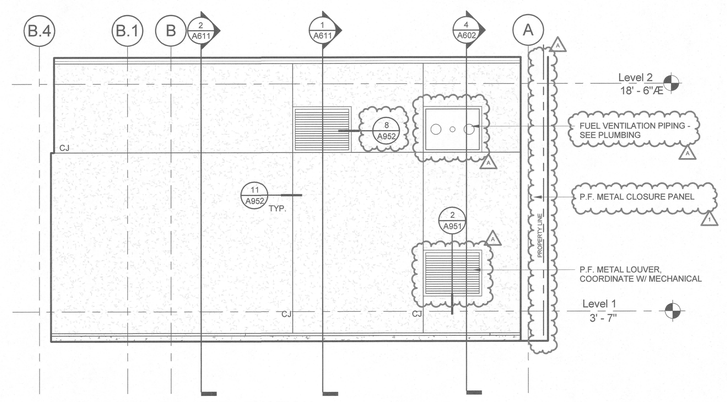

5 COURTYARD - SOUTH ELEVATION

SCALE: 1/4" = 1'-0"

MATERIALS LEGEND:

- THIN FACE BRICK - 1 (PEWTER) (BRICK-1)
- THIN FACE BRICK - 2 (WHITE - GLAZED) (BRICK-2)
- COMPOSITE METAL PANEL - 1 (CMP-1)
- PREFINISHED METAL PANEL SYSTEM-3 (MP-3)
- PREFINISHED METAL PANEL SYSTEM-4 (MP-4)
- PERFORATED METAL PANEL (PMP-1)
- PREFINISHED METAL PANEL SYSTEM-3 PERFORATED (MP-3)
- PREFINISHED METAL PANEL SYSTEM-4 PERFORATED (MP-4)
- STUCCO
- CMU

LRS ARCHITECTS
720 NW Davis 503.221.1121
Suite 300 503.221.2077
Portland OR 97209 www.lrsarchitects.com

REGISTERED ARCHITECT THOMAS PAUL SCHNEIDER PORTLAND, OR STATE OF OREGON

LEVERARCHITECTURE
4713 N ALBINA AVE, PDX OR 97217
T 503 928 6040
www.leverarchitecture.com

CONSULTANT:

PROJECT NUMBER: 215349

GRAND AVENUE APARTMENTS

1010 NE GRAND AVE. PORTLAND, OR 97232

SHEET TITLE:

PARTIAL EXTERIOR ELEVATIONS

KEY PLAN:

DRAWN BY: Author
DATE CREATED: 09/02/16

1	ADDENDUM #01	08/11/2017
2	ADDENDUM #02	XX/XX/XXXX
A	PLAN CHECK	09/01/2017

City of Portland REVIEWED FOR CODE COMPLIANCE DEC 22 2017
RECEIVED SEP 06 2017 BDS DOCUMENT SERVICES

SHEET: **A507**

PERMIT SET 07-14-2017

LRS Architects, Inc. ©2017

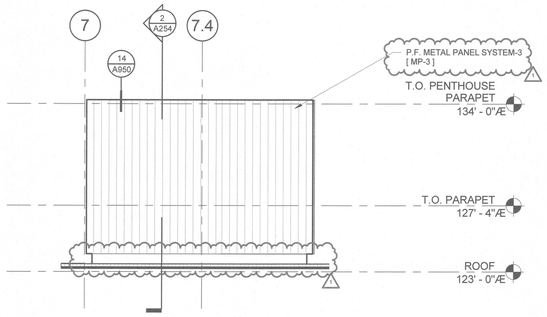

4 ELEV #01 - MACH ROOM - WEST ELEVATION

SCALE: 1/4" = 1'-0"

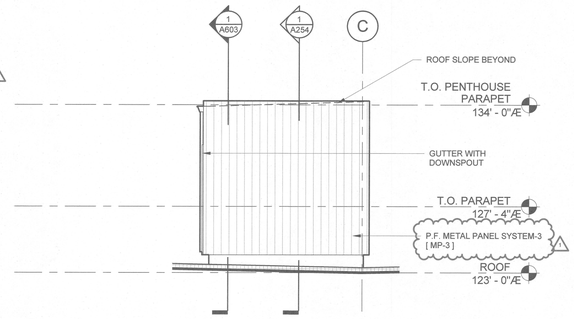

3 ELEV #01 - MACH ROOM - SOUTH ELEVATION

SCALE: 1/4" = 1'-0"

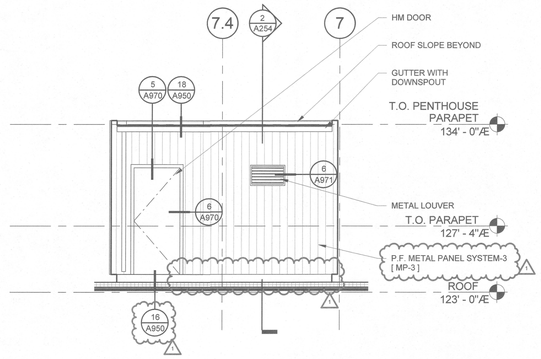

2 ELEV #01 - MACH ROOM - EAST ELEVATION

SCALE: 1/4" = 1'-0"

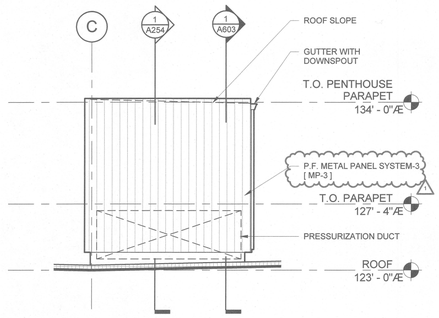

1 ELEV #01 - MACH ROOM - NORTH ELEVATION

SCALE: 1/4" = 1'-0"

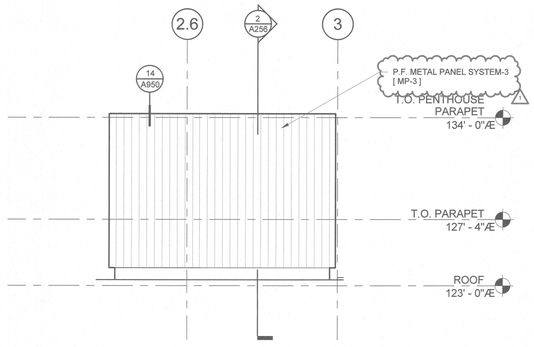

9 ELEV #02 - MACH ROOM - WEST ELEVATION

SCALE: 1/4" = 1'-0"

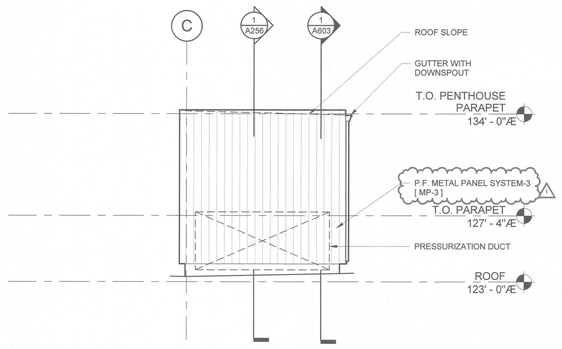

8 ELEV #02 - MACH ROOM - SOUTH ELEVATION

SCALE: 1/4" = 1'-0"

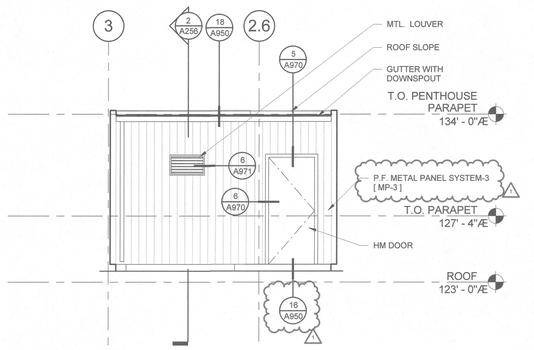

7 ELEV #02 - MACH ROOM - EAST ELEVATION

SCALE: 1/4" = 1'-0"

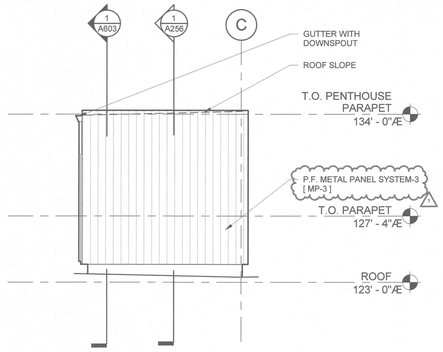

6 ELEV #02 - MACH ROOM - NORTH ELEVATION

SCALE: 1/4" = 1'-0"

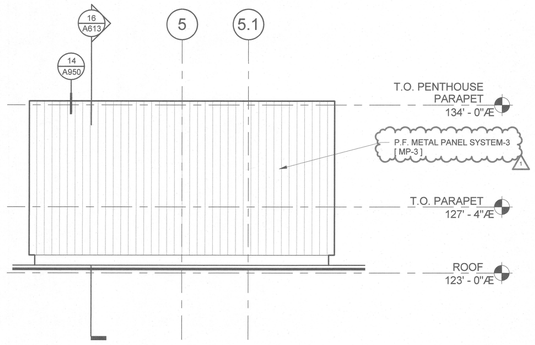

14 MECHANICAL ROOM - WEST ELEVATION

SCALE: 1/4" = 1'-0"

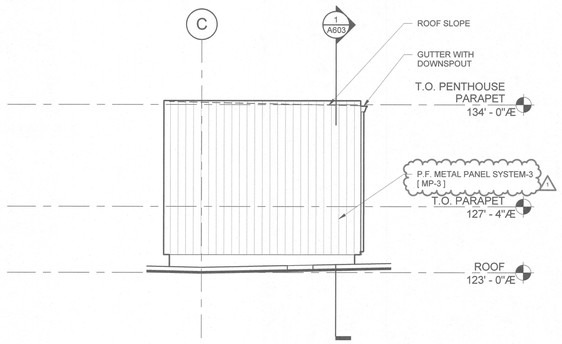

13 MECHANICAL ROOM - SOUTH ELEVATION

SCALE: 1/4" = 1'-0"

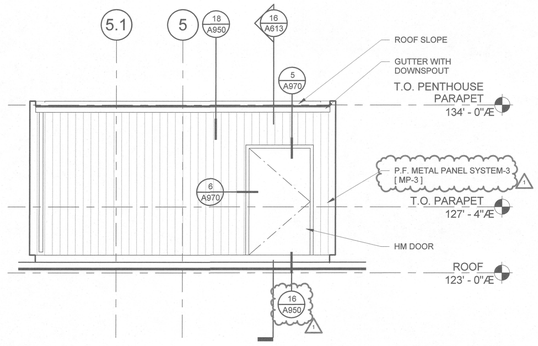

12 MECHANICAL ROOM - EAST ELEVATION

SCALE: 1/4" = 1'-0"

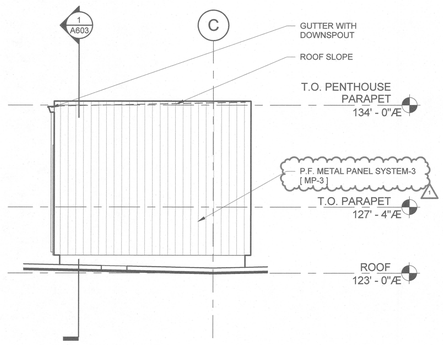

11 MECHANICAL ROOM - NORTH ELEVATION

SCALE: 1/4" = 1'-0"

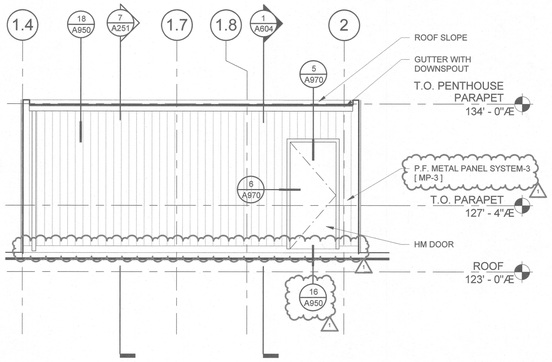

17 STAIR #02 - ROOF ACCESS - WEST ELEVATION

SCALE: 1/4" = 1'-0"

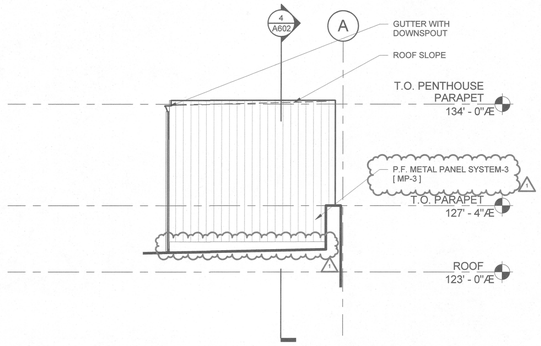

16 STAIR #02 - ROOF ACCESS - SOUTH ELEVATION

SCALE: 1/4" = 1'-0"

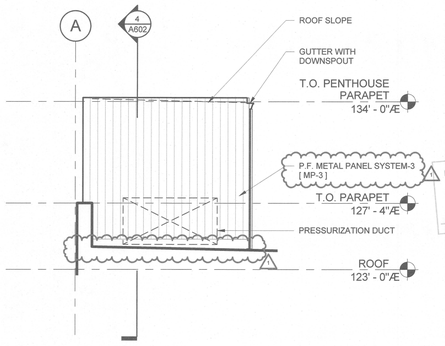

15 STAIR #02 - ROOF ACCESS - NORTH ELEVATION

SCALE: 1/4" = 1'-0"

LRS ARCHITECTS
720 NW Davis 503.221.1121
Suite 300 503.221.2077
Portland OR 97209 www.lrsarchitects.com

REGISTERED ARCHITECT
THOMAS PAUL KUEST
PORTLAND, OR
STATE OF OREGON

LEVERARCHITECTURE
4713 N ALBINA AVE, PDX OR 97217
T 503 928 6040
www.leverarchitecture.com

CONSULTANT:

PROJECT NUMBER: 215349

GRAND AVENUE APARTMENTS

1010 NE GRAND AVE. PORTLAND, OR 97232

SHEET TITLE:

PARTIAL EXTERIOR ELEVATIONS

DRAWN BY: KS,SB
DATE CREATED: 04/27/17

1 ADDENDUM #01 08/11/2017

City of Portland REVIEWED FOR CODE COMPLIANCE DEC 22 2017 Permit Technician

RECEIVED SEP 06 2017 BDS DOCUMENT SERVICES

SHEET: **A508**

PERMIT SET 07-14-2017

LRS Architects, Inc. ©2017

C:\300 Revit Local Files\BIM Support\215349_Grand Ave Apts_Arch_R17_kschneider.rvt
9/5/2017 3:30:47 PM

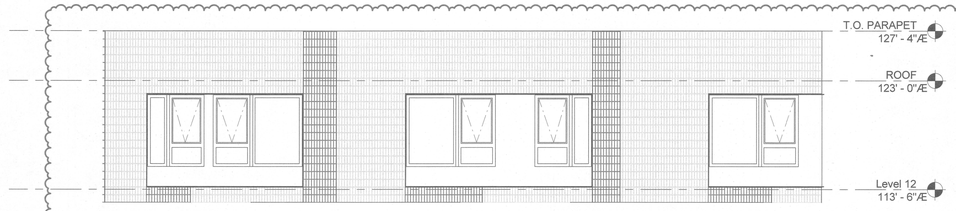

2 MODULE 4

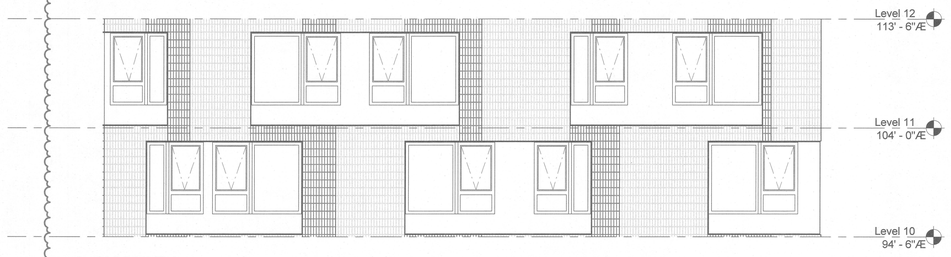

3 MODULE 3

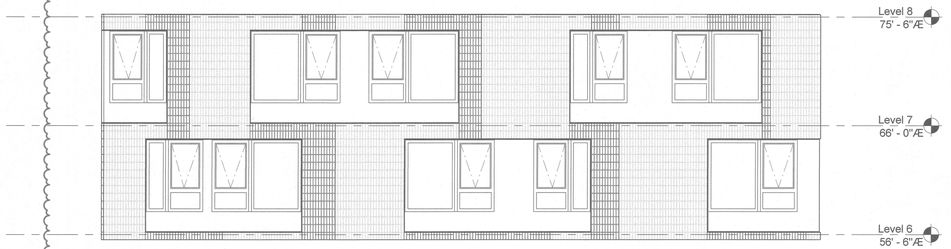

4 MODULE 2

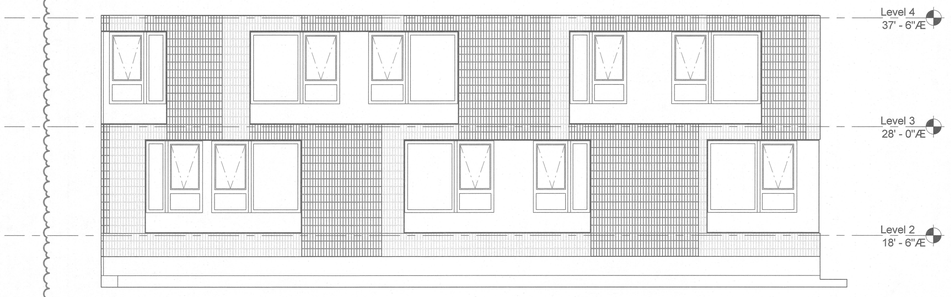

5 MODULE 1

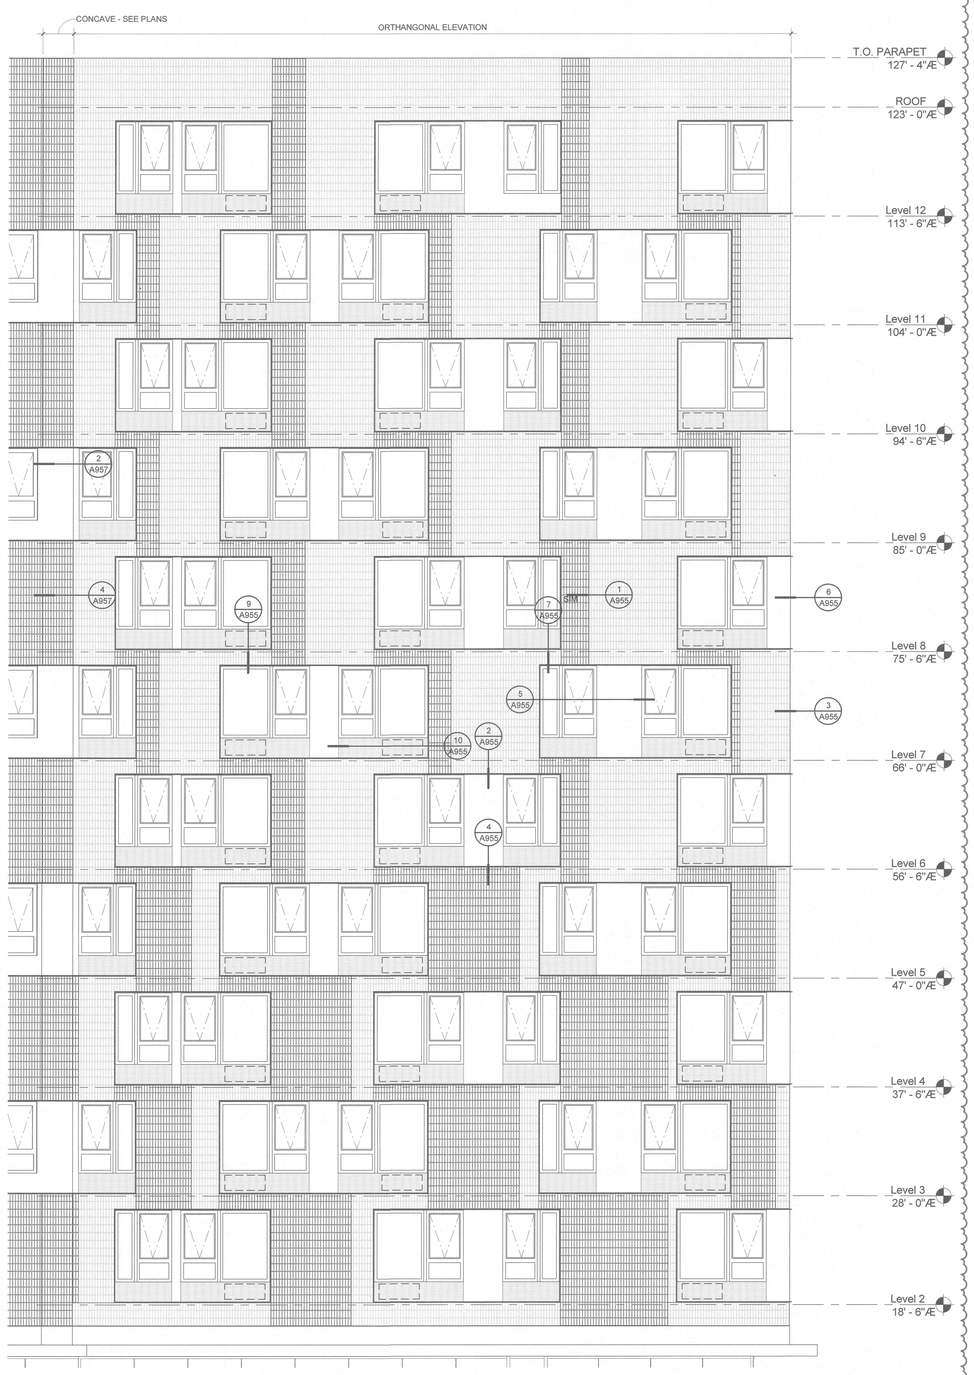

1 WEST FACADE - SW CORNER

SCALE: 3/16" = 1'-0"

LRS ARCHITECTS
720 NW Davis 503.221.1121
Suite 300 503.221.2077
Portland OR 97209 www.lrsarchitects.com

REGISTERED ARCHITECT
THOMAS PAUL CHARLES
PORTLAND, OR
STATE OF OREGON

LEVERARCHITECTURE
4713 N ALBINA AVE, PDX OR 97217
T 503 928 6040
www.leverarchitecture.com

CONSULTANT:

PROJECT NUMBER: 215349

GRAND AVENUE APARTMENTS

1010 NE GRAND AVE. PORTLAND, OR 97232

SHEET TITLE:
ENLARGED EXTERIOR ELEVATIONS

KEY PLAN:

DRAWN BY: Author
DATE CREATED: 04/03/17

1	ADDENDUM #01	08/11/2017

City of Portland
REVIEWED FOR CODE COMPLIANCE
DEC 22 2017
Permit Number

RECEIVED
SEP 06 2017
BDS
DOCUMENT SERVICES

SHEET:
A510
PERMIT SET
07-14-2017

LRS Architects, Inc. ©2017

C:\300 Revit Local Files\BIM Support\215349_Grand Ave Apts_Arch_R17_kschneider.rvt
9/5/2017 3:31:02 PM

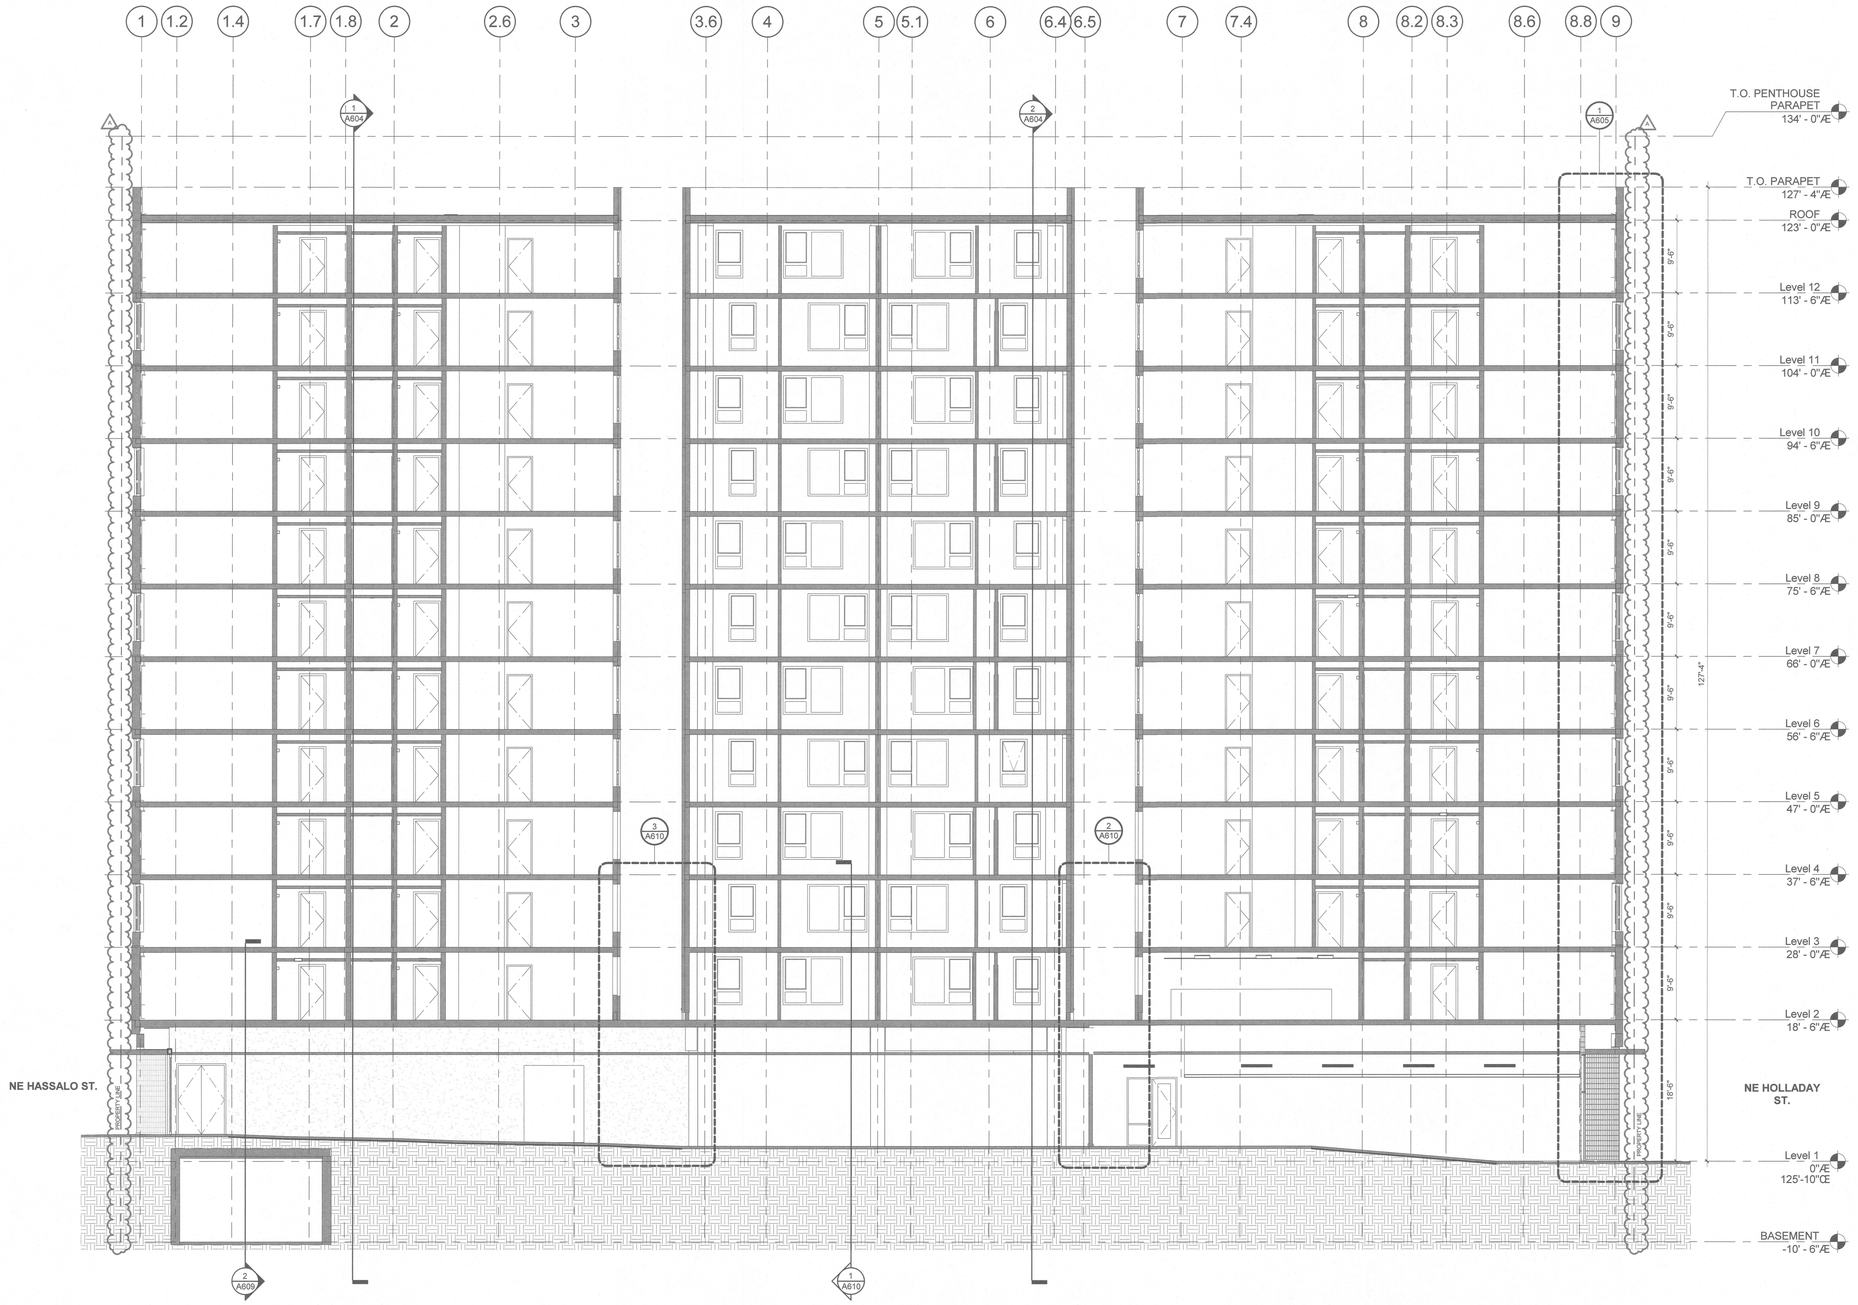

1 BUILDING SECTION N/S AT INTERIOR ALLEY - VIEW EAST

SCALE: 1/8" = 1'-0"

LRS ARCHITECTS
720 NW Davis 503.221.1121
Suite 300 503.221.2077
Portland OR 97209 www.lrsarchitects.com

REGISTERED ARCHITECT
THOMAS PAUL FRANK, JR.
PORTLAND, OR
STATE OF OREGON

LEVERARCHITECTURE
4713 N ALBINA AVE, PDX OR 97217
T 503 928 6040
www.leverarchitecture.com

CONSULTANT:

PROJECT NUMBER: 215349

GRAND AVENUE APARTMENTS

1010 NE GRAND AVE. PORTLAND, OR 97232

SHEET TITLE:

BUILDING SECTIONS

KEY PLAN:

DRAWN BY: KWS
DATE CREATED: 08/30/2016

A PLAN CHECK 09/01/2017

City of Portland
REVIEWED FOR CODE COMPLIANCE
DEC 22 2017
Permit Number

RECEIVED
SEP 06 2017
BDS
DOCUMENT SERVICES

SHEET:

A601

PERMIT SET
07-14-2017

LRS Architects, Inc. ©2017

C:\300 Revit Local Files\BIM Support\215349_Grand Ave Apts_Arch_R17_kschneider.rvt
9/5/2017 3:31:07 PM

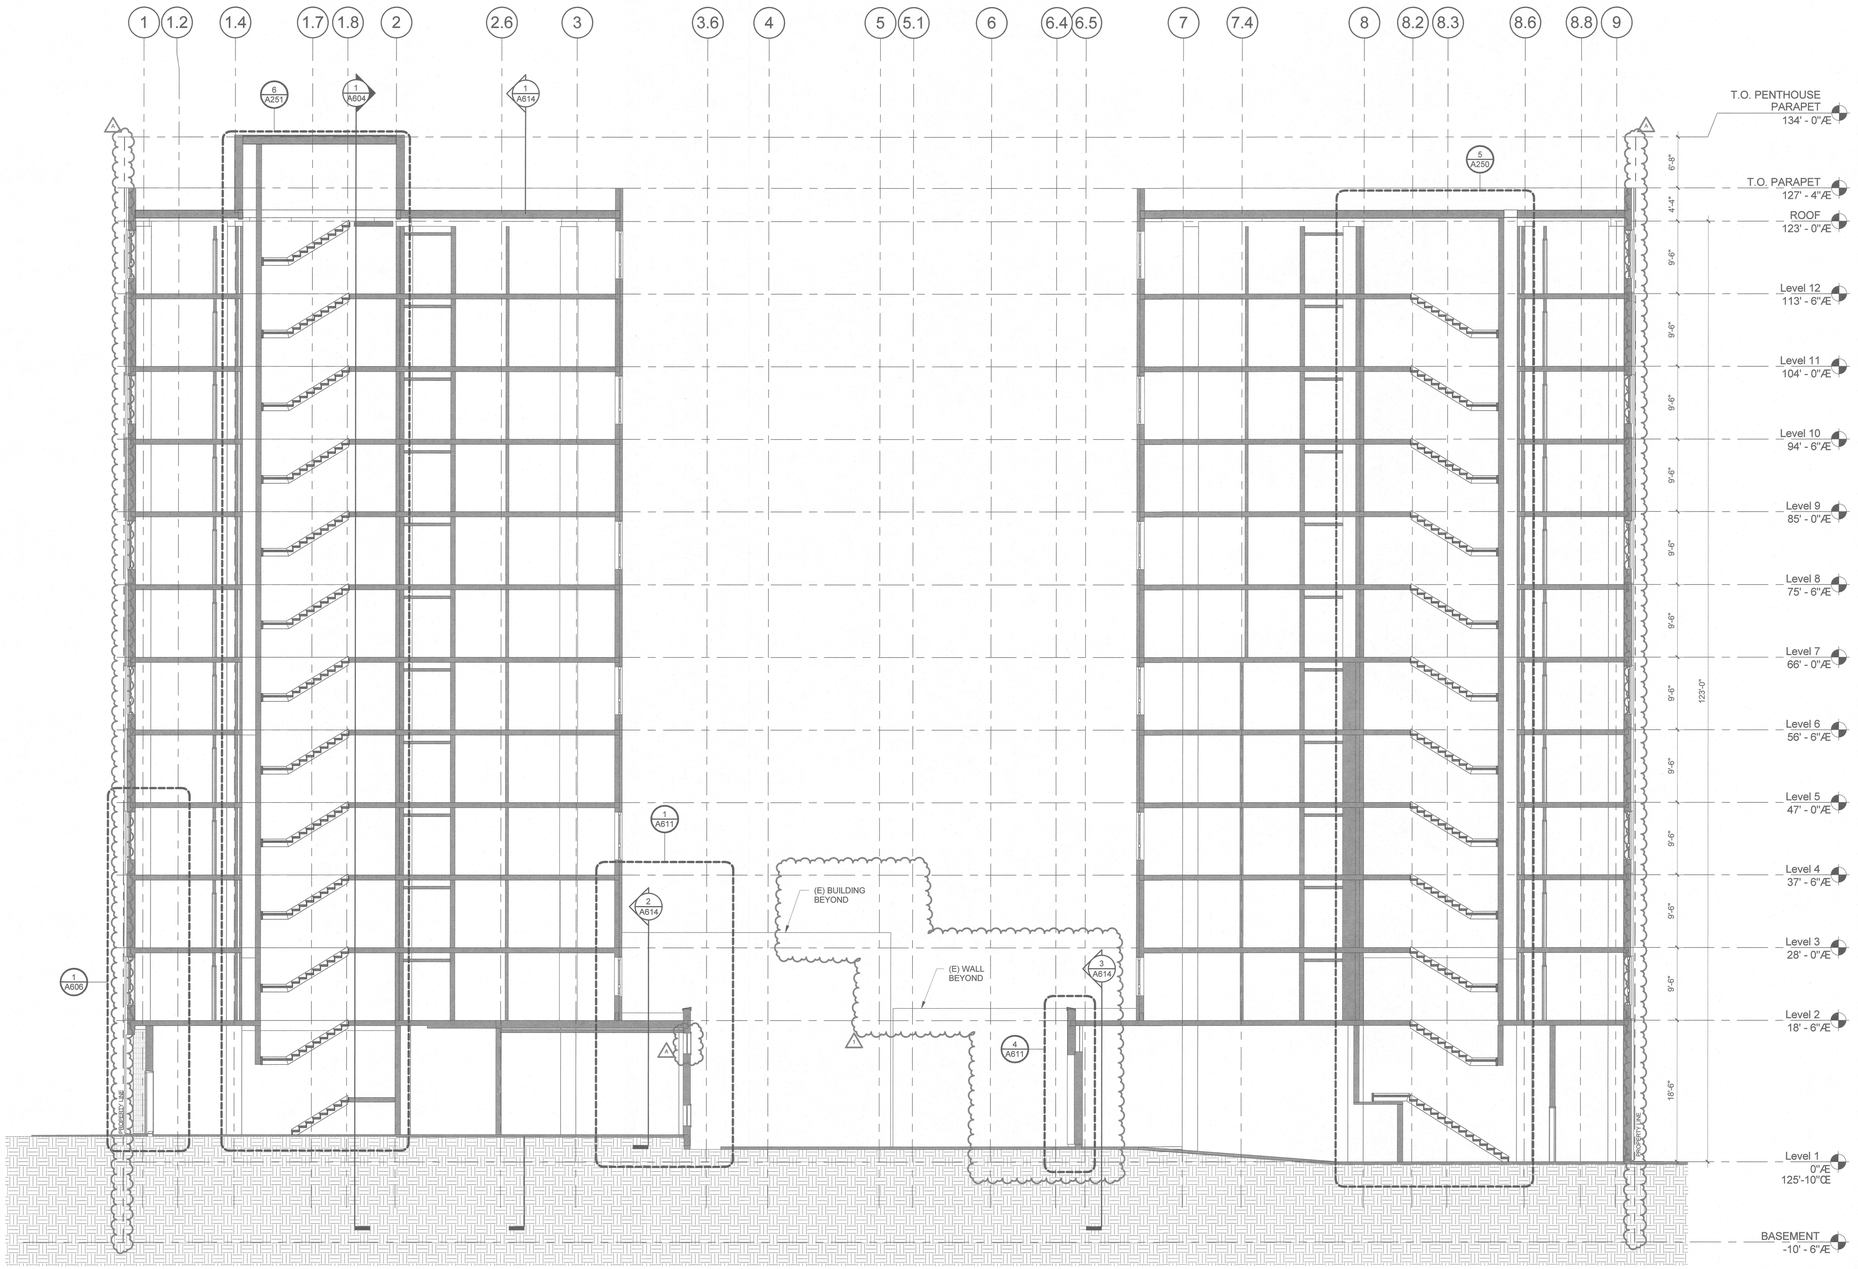

4 BUILDING SECTION N/S AT COUTYARD - VIEW EAST

SCALE: 1/8" = 1'-0"

LRS ARCHITECTS
720 NW Davis 503.221.1121
Suite 300 503.221.2077
Portland OR 97209 www.lrsarchitects.com

REGISTERED ARCHITECT THOMAS PAUL FRANK, AIA PORTLAND, OR STATE OF OREGON

LEVERARCHITECTURE
4713 N ALBINA AVE, PDX OR 97217
T 503 928 6040
www.leverarchitecture.com

CONSULTANT:

PROJECT NUMBER: 215349

GRAND AVENUE APARTMENTS

1010 NE GRAND AVE. PORTLAND, OR 97232

SHEET TITLE:

BUILDING SECTIONS

KEY PLAN:

DRAWN BY: KWS
DATE CREATED: 08/30/2016

1	ADDENDUM #01	08/11/2017
A	PLAN CHECK	09/01/2017

COPY OF RECORD REVIEWED FOR COMPLIANCE DEC 22 2017 Permit Number
RECEIVED SEP 06 2017 BDS DOCUMENT SERVICES

SHEET:

A602

PERMIT SET 07-14-2017

LRS Architects, Inc. ©2017

C:\300 Revit Local Files\BIM Support\215349_Grand Ave Apts_Arch_R17_kschneider.rvt
9/5/2017 3:31:11 PM

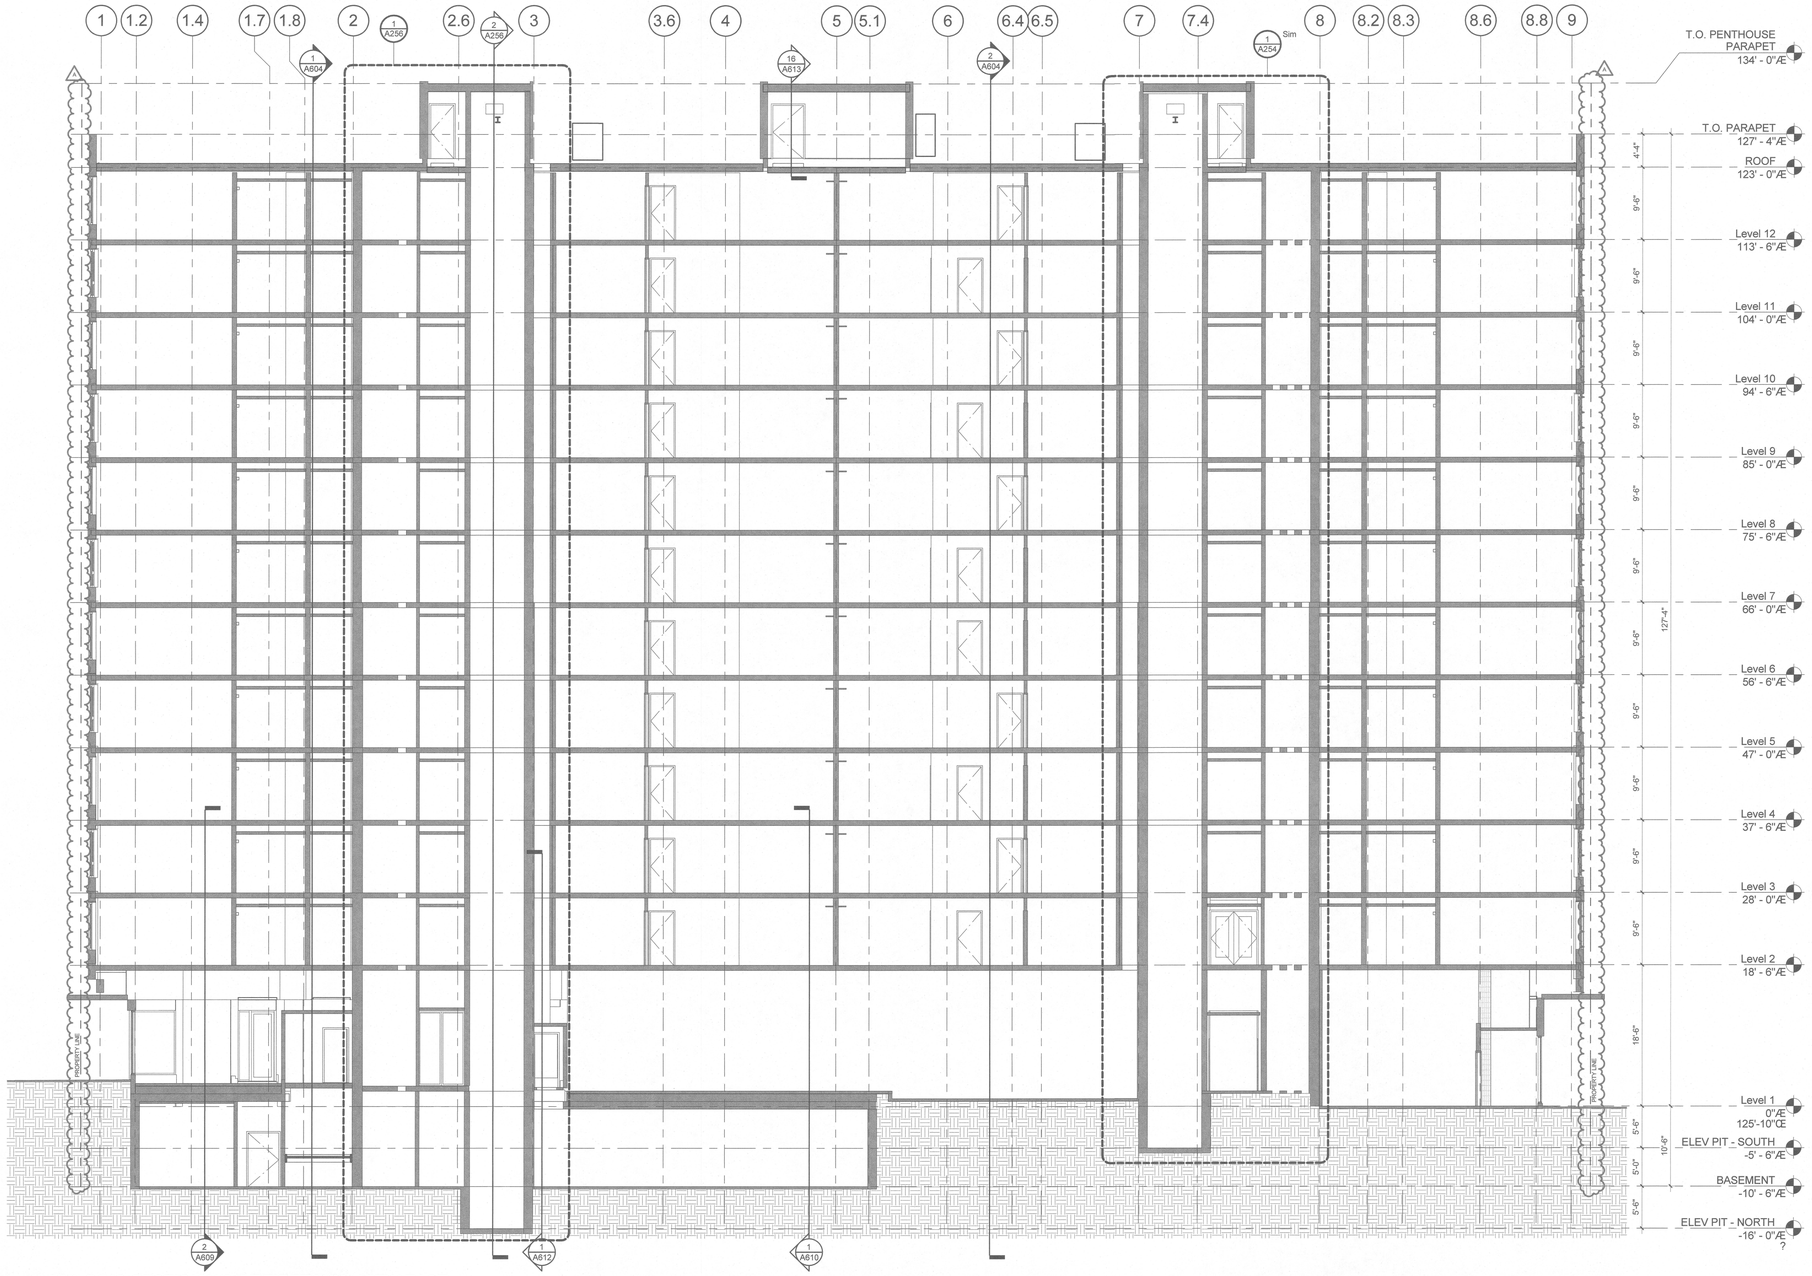

1 BUILDING SECTION N/S AT FIRETANK - VIEW EAST

SCALE: 1/8" = 1'-0"

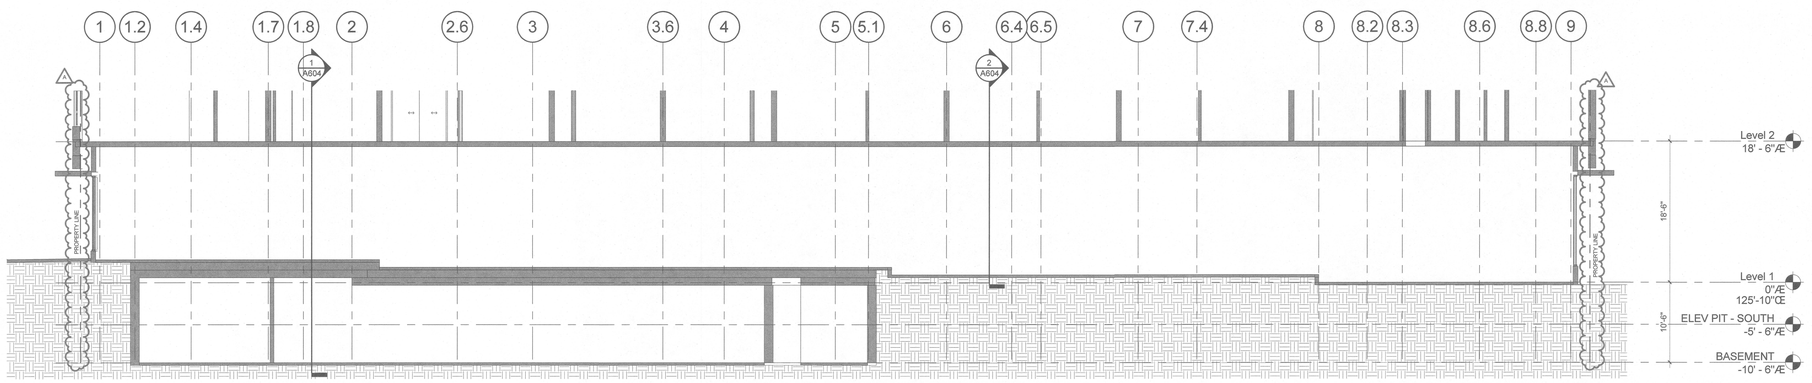

2 BUILDING SECTION N/S AT BASEMENT - VIEW EAST

SCALE: 1/8" = 1'-0"

LRS ARCHITECTS
720 NW Davis 503.221.1121
Suite 300 503.221.2077
Portland OR 97209 www.lrsarchitects.com

REGISTERED ARCHITECT
THOMAS PAUL FRANK, JR.
PORTLAND, OR
STATE OF OREGON

LEVERARCHITECTURE
4713 N ALBINA AVE, PDX OR 97217
T 503 928 6040
www.leverarchitecture.com

CONSULTANT:

PROJECT NUMBER: 215349

GRAND AVENUE APARTMENTS

1010 NE GRAND AVE. PORTLAND, OR 97232

SHEET TITLE:

BUILDING SECTIONS

KEY PLAN:

DRAWN BY: Author
DATE CREATED: 01/16/17

A PLAN CHECK 09/01/2017

CITY OF PORTLAND
REVIEWED FOR CODE COMPLIANCE
DEC 22 2017
Permit Number

RECEIVED
SEP 06 2017
BDS
DOCUMENT SERVICES

SHEET:

A603

PERMIT SET
07-14-2017

LRS Architects, Inc. ©2017

C:\300 Revit Local Files\BIM Support\215349_Grand Ave Apts_Arch_R17_kschneider.rvt
9/5/2017 3:31:16 PM

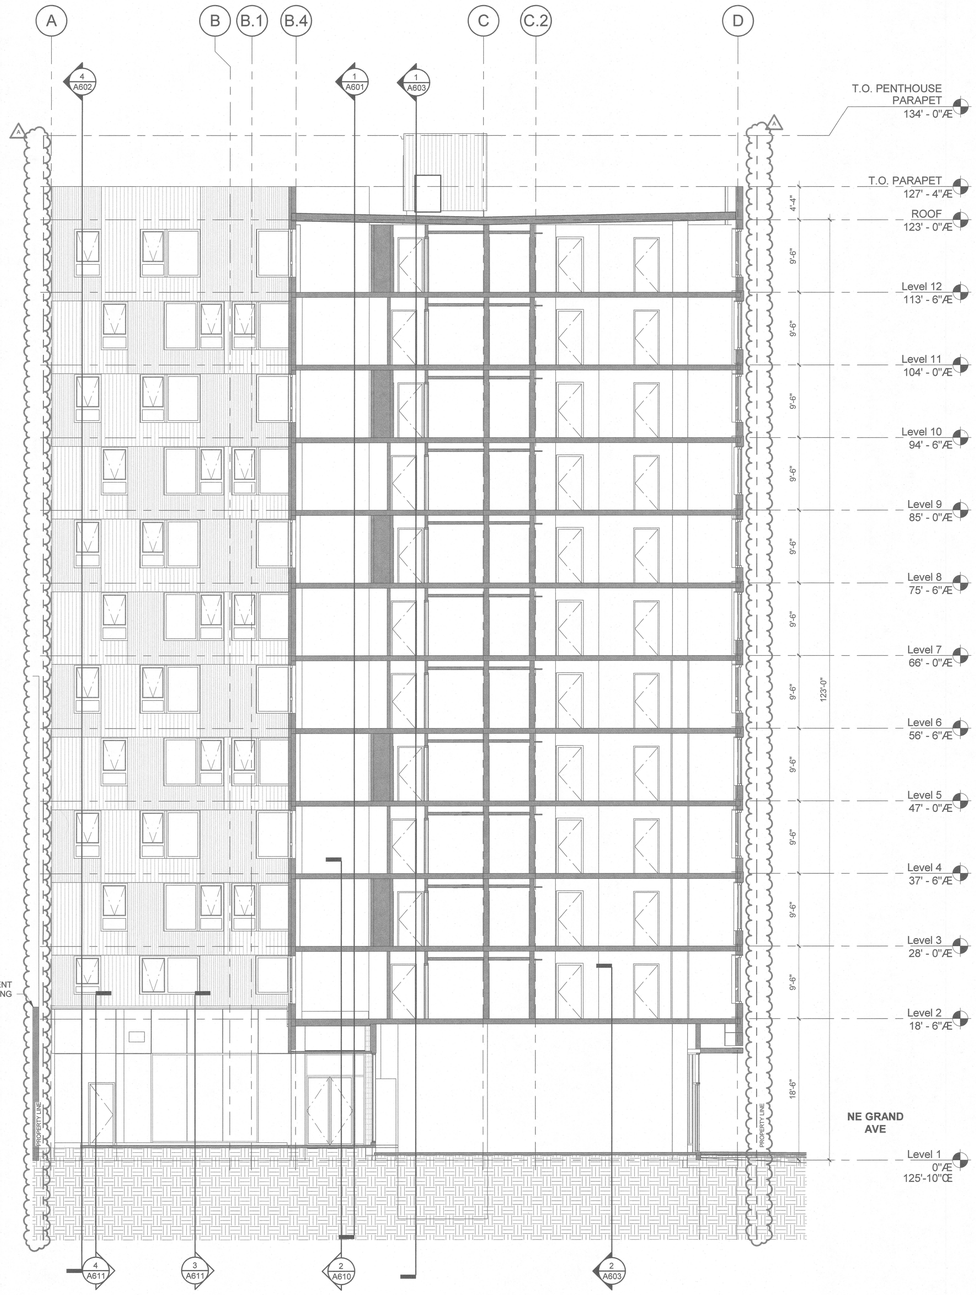

2 BUILDING SECTION E/W AT COURTYARD - VIEW SOUTH

SCALE: 1/8" = 1'-0"

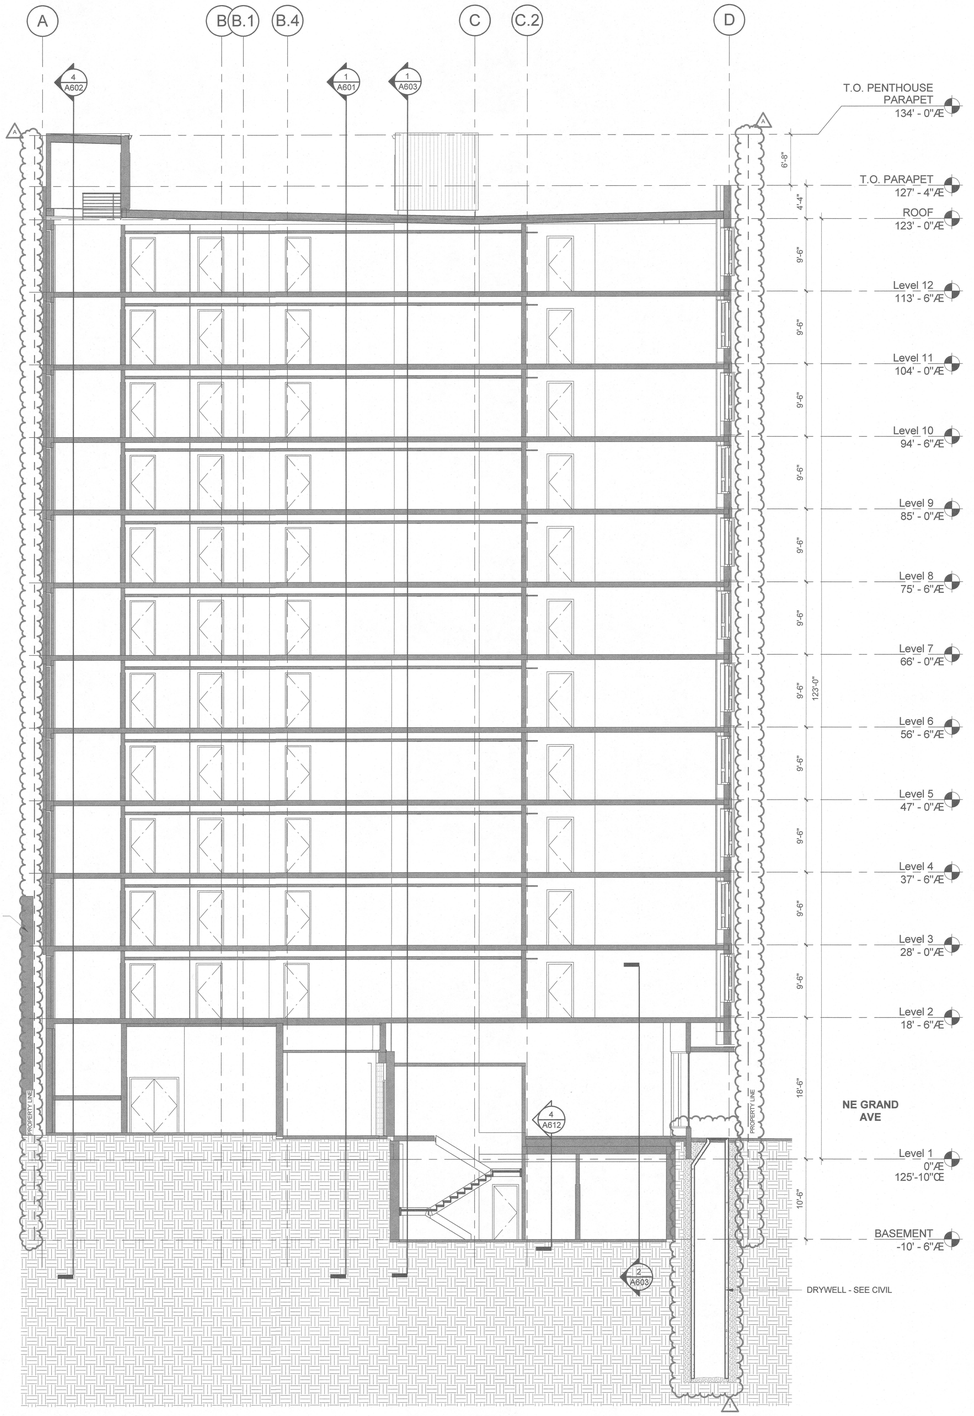

1 BUILDING SECTION E/W AT BASEMENT - VIEW SOUTH

SCALE: 1/8" = 1'-0"

C:\300 Revit Local Files\BIM Support\215349_Grand Ave Apts_Arch_R17_kschneider.rvt
9/5/2017 3:31:22 PM

LRS ARCHITECTS
720 NW Davis 503.221.1121
Suite 300 503.221.2077
Portland OR 97209 www.lrsarchitects.com

REGISTERED ARCHITECT
THOMAS PAUL FRANK
PORTLAND, OR
STATE OF OREGON

LEVERARCHITECTURE
4713 N ALBINA AVE, PDX OR 97217
T 503 928 6040
www.leverarchitecture.com

CONSULTANT:

PROJECT NUMBER: 215349

GRAND AVENUE APARTMENTS

1010 NE GRAND AVE. PORTLAND, OR 97232

SHEET TITLE:
BUILDING SECTIONS

KEY PLAN:

DRAWN BY: KWS
DATE CREATED: 08/30/2016

1	ADDENDUM #01	08/11/2017
A	PLAN CHECK	09/01/2017

CITY OF PORTLAND, OREGON BUREAU OF DEVELOPMENT SERVICES COMMERCIAL DEC 22 2017 APPROVED

RECEIVED SEP 06 2017 BDS DOCUMENT SERVICES

SHEET: **A604**
PERMIT SET
07-14-2017

LRS Architects, Inc. ©2017

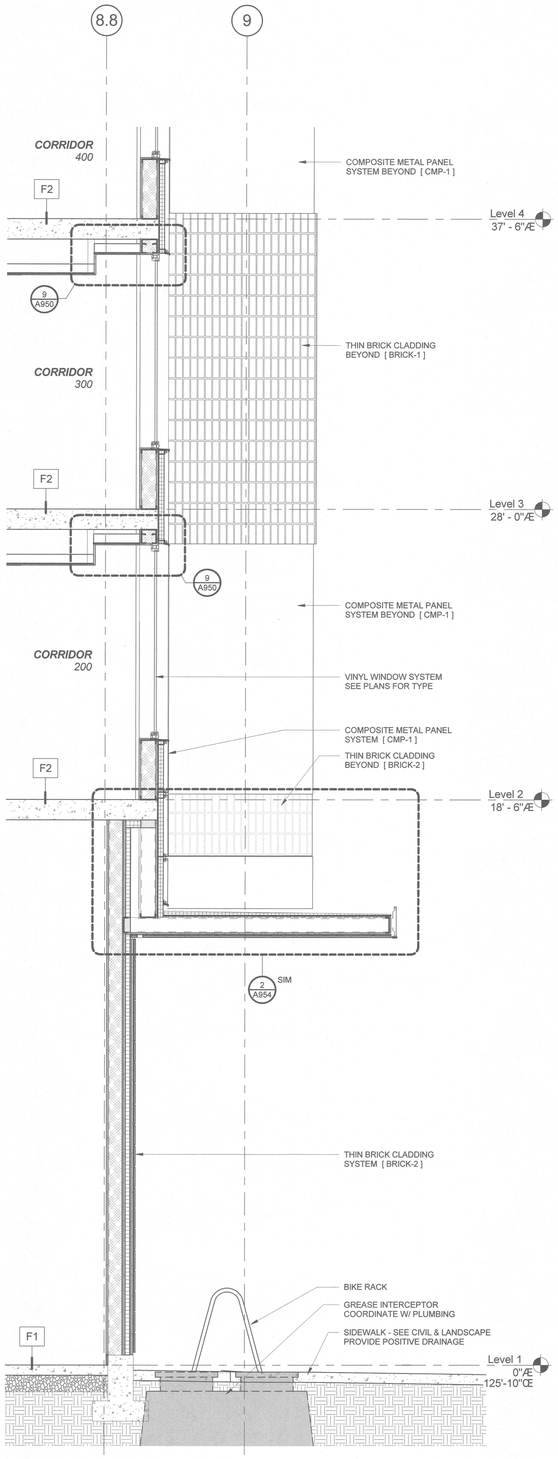

4 WALL SECTION @ CORRIDOR WINDOW INSET

SCALE: 1/2" = 1'-0"

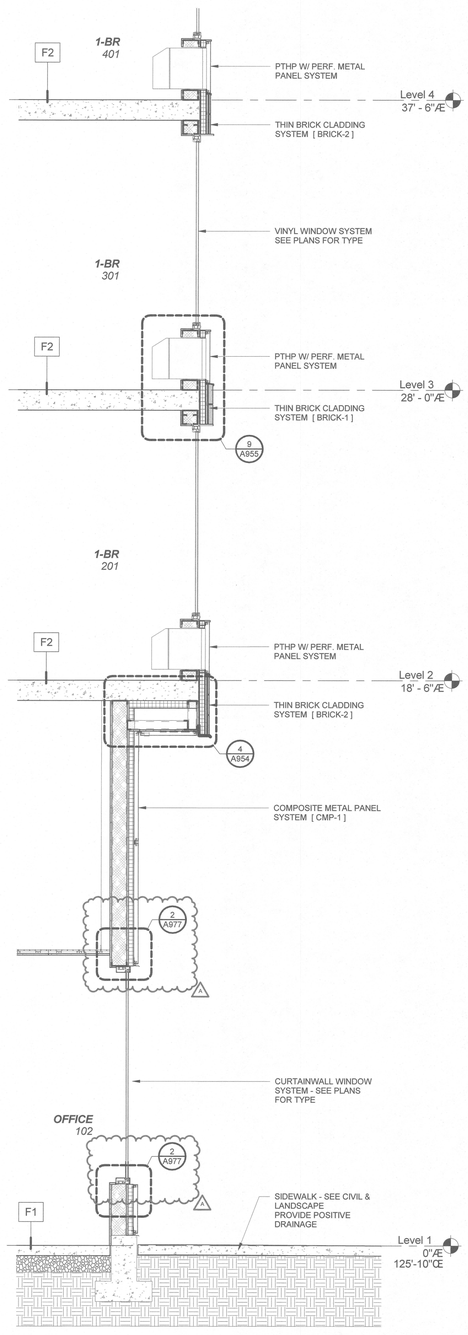

3 WALL SECTION @ OFFICE WINDOW

SCALE: 1/2" = 1'-0"

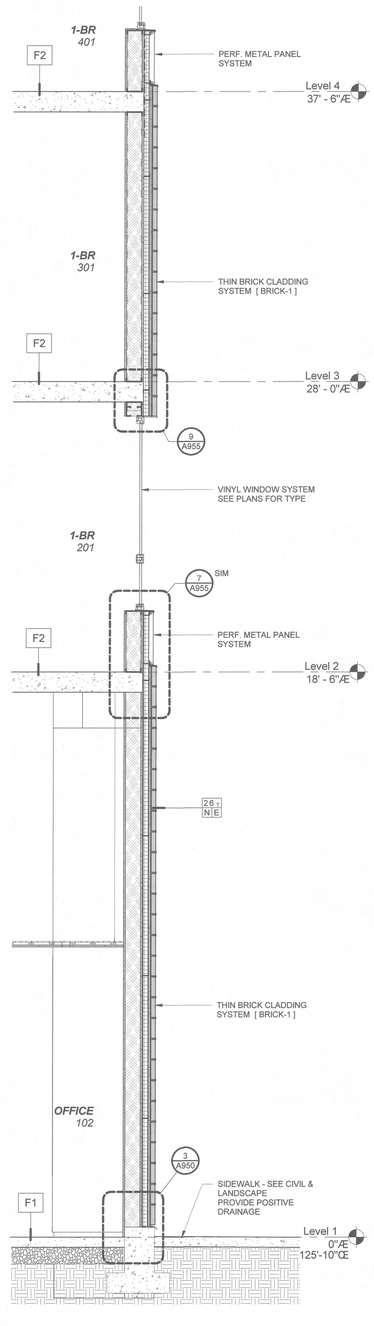

2 WALL SECTION @ THIN BRICK

SCALE: 1/2" = 1'-0"

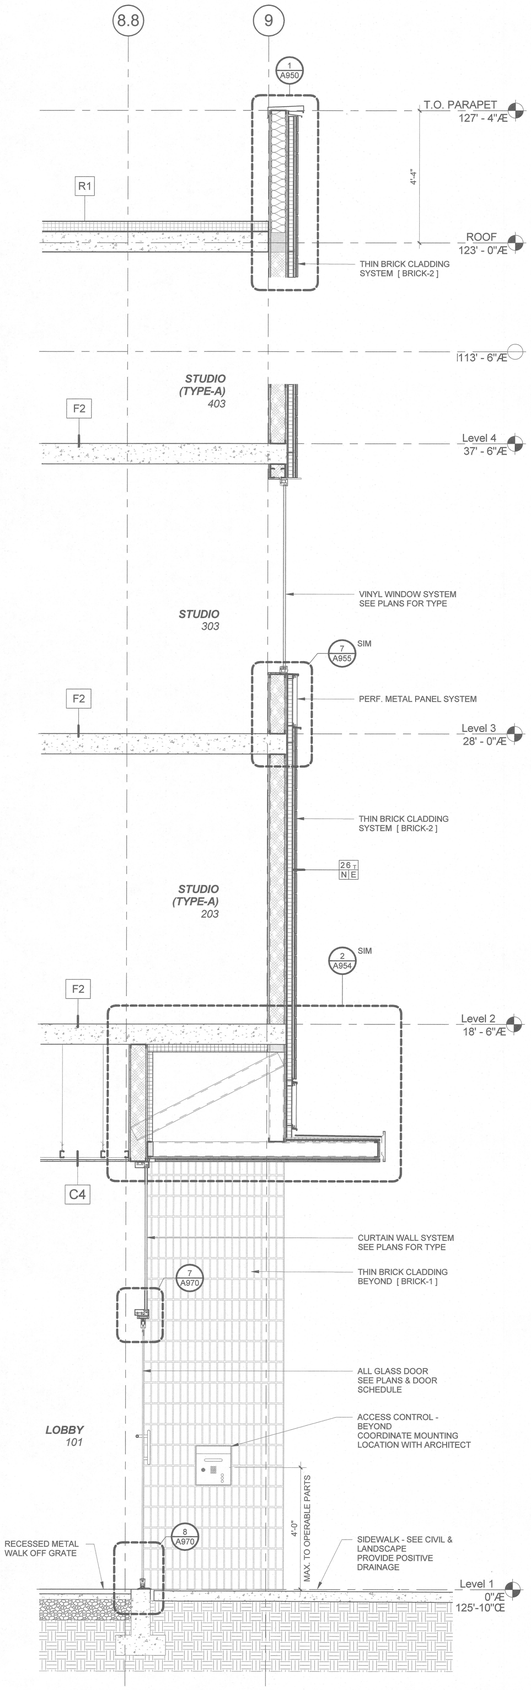

1 WALL SECTION @ MAIN ENTRY

SCALE: 1/2" = 1'-0"

LRS ARCHITECTS
720 NW Davis 503.221.1121
Suite 300 503.221.2077
Portland OR 97209 www.lrsarchitects.com

REGISTERED ARCHITECT
THOMAS PAUL CARR
PORTLAND, OR
STATE OF OREGON

LEVERARCHITECTURE
4713 N ALBINA AVE, PDX OR 97217
T 503 928 6040
www.leverarchitecture.com

CONSULTANT:

PROJECT NUMBER: 215349

GRAND AVENUE APARTMENTS

1010 NE GRAND AVE. PORTLAND, OR 97232

SHEET TITLE:

WALL SECTIONS

DRAWN BY: LRS
DATE CREATED: 06/14/17

1	ADDENDUM #01	08/11/2017
A	PLAN CHECK	09/01/2017

DEC 22 2017
Portland, Oregon

RECEIVED
SEP 06 2017
BDS
DOCUMENT SERVICES

SHEET:
A605
PERMIT SET
07-14-2017

LRS Architects, Inc. ©2017

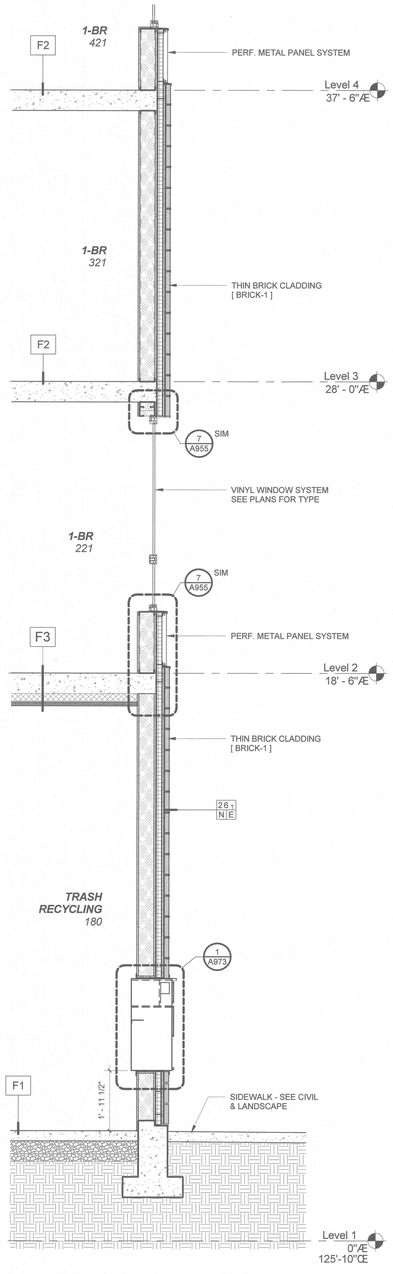

4 WALL SECTION @ GENERATOR FILL STATION

SCALE: 1/2" = 1'-0"

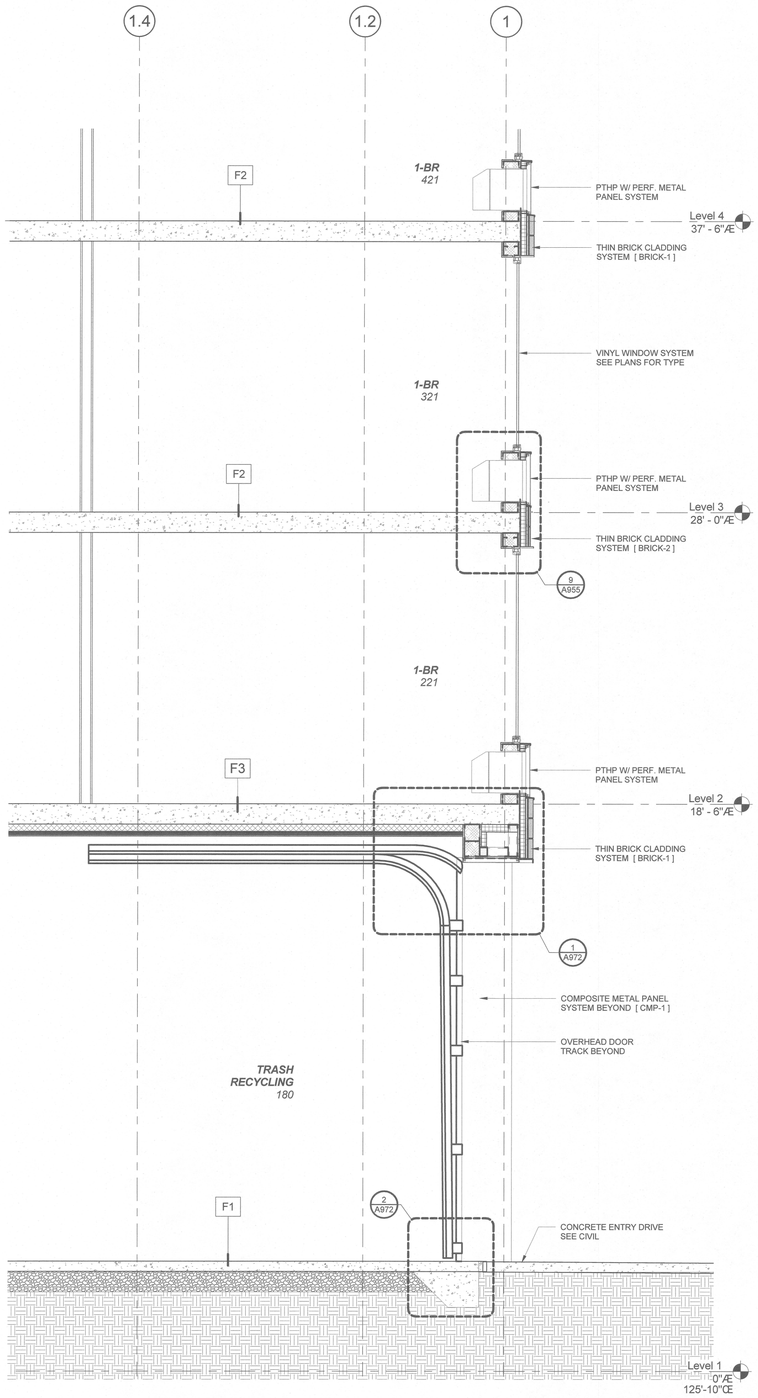

3 WALL SECTION @ SECTIONAL DOOR

SCALE: 1/2" = 1'-0"

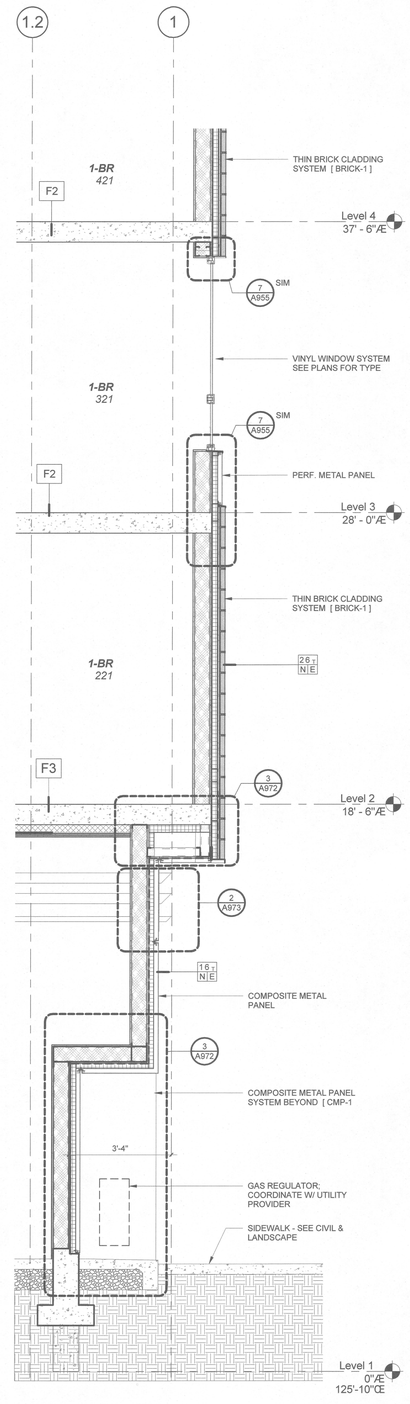

2 WALL SECTION @ GAS REGULATOR

SCALE: 1/2" = 1'-0"

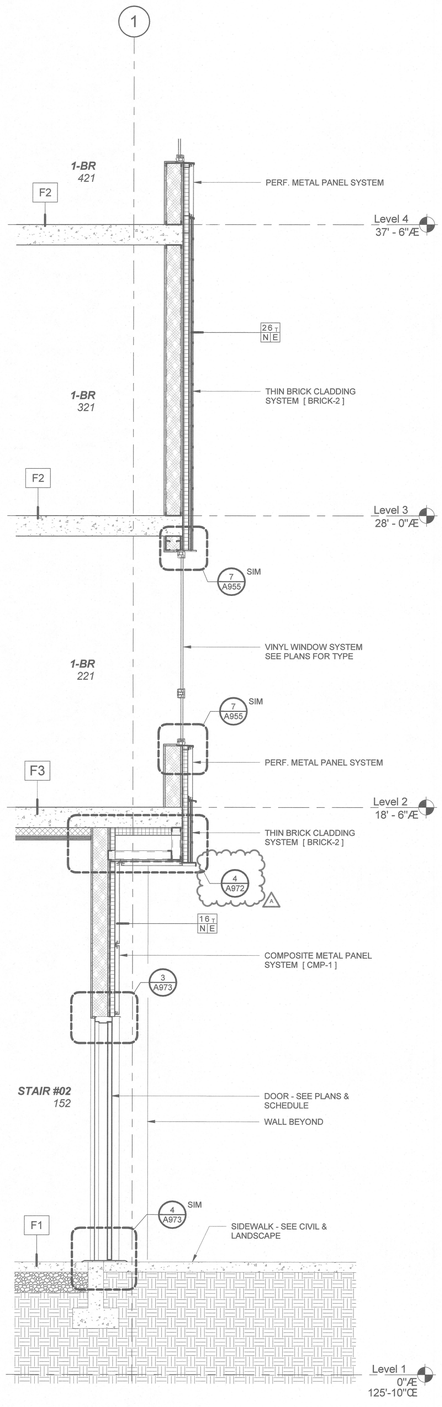

1 WALL SECTION @ EXIT DOOR

SCALE: 1/2" = 1'-0"

LRS ARCHITECTS
720 NW Davis 503.221.1121
Suite 300 503.221.2077
Portland OR 97209 www.lrsarchitects.com

REGISTERED ARCHITECT
THOMAS PAUL EVANS
PORTLAND, OR
STATE OF OREGON

LEVERARCHITECTURE
4713 N ALBINA AVE, PDX OR 97217
T 503 928 6040
www.leverarchitecture.com

CONSULTANT:

PROJECT NUMBER: 215349

GRAND AVENUE APARTMENTS

1010 NE GRAND AVE. PORTLAND, OR 97232

SHEET TITLE:
WALL SECTIONS

DRAWN BY:		LRS
DATE CREATED:		05/16/2017
1	ADDENDUM #01	08/11/2017
A	PLAN CHECK	09/01/2017

CITY OF PORTLAND
BUREAU OF DEVELOPMENT SERVICES
DEC 22 2017
BUILDING

RECEIVED
SEP 06 2017
BDS
DOCUMENT SERVICES

SHEET:
A606
PERMIT SET
07-14-2017

LRS Architects, Inc. ©2017

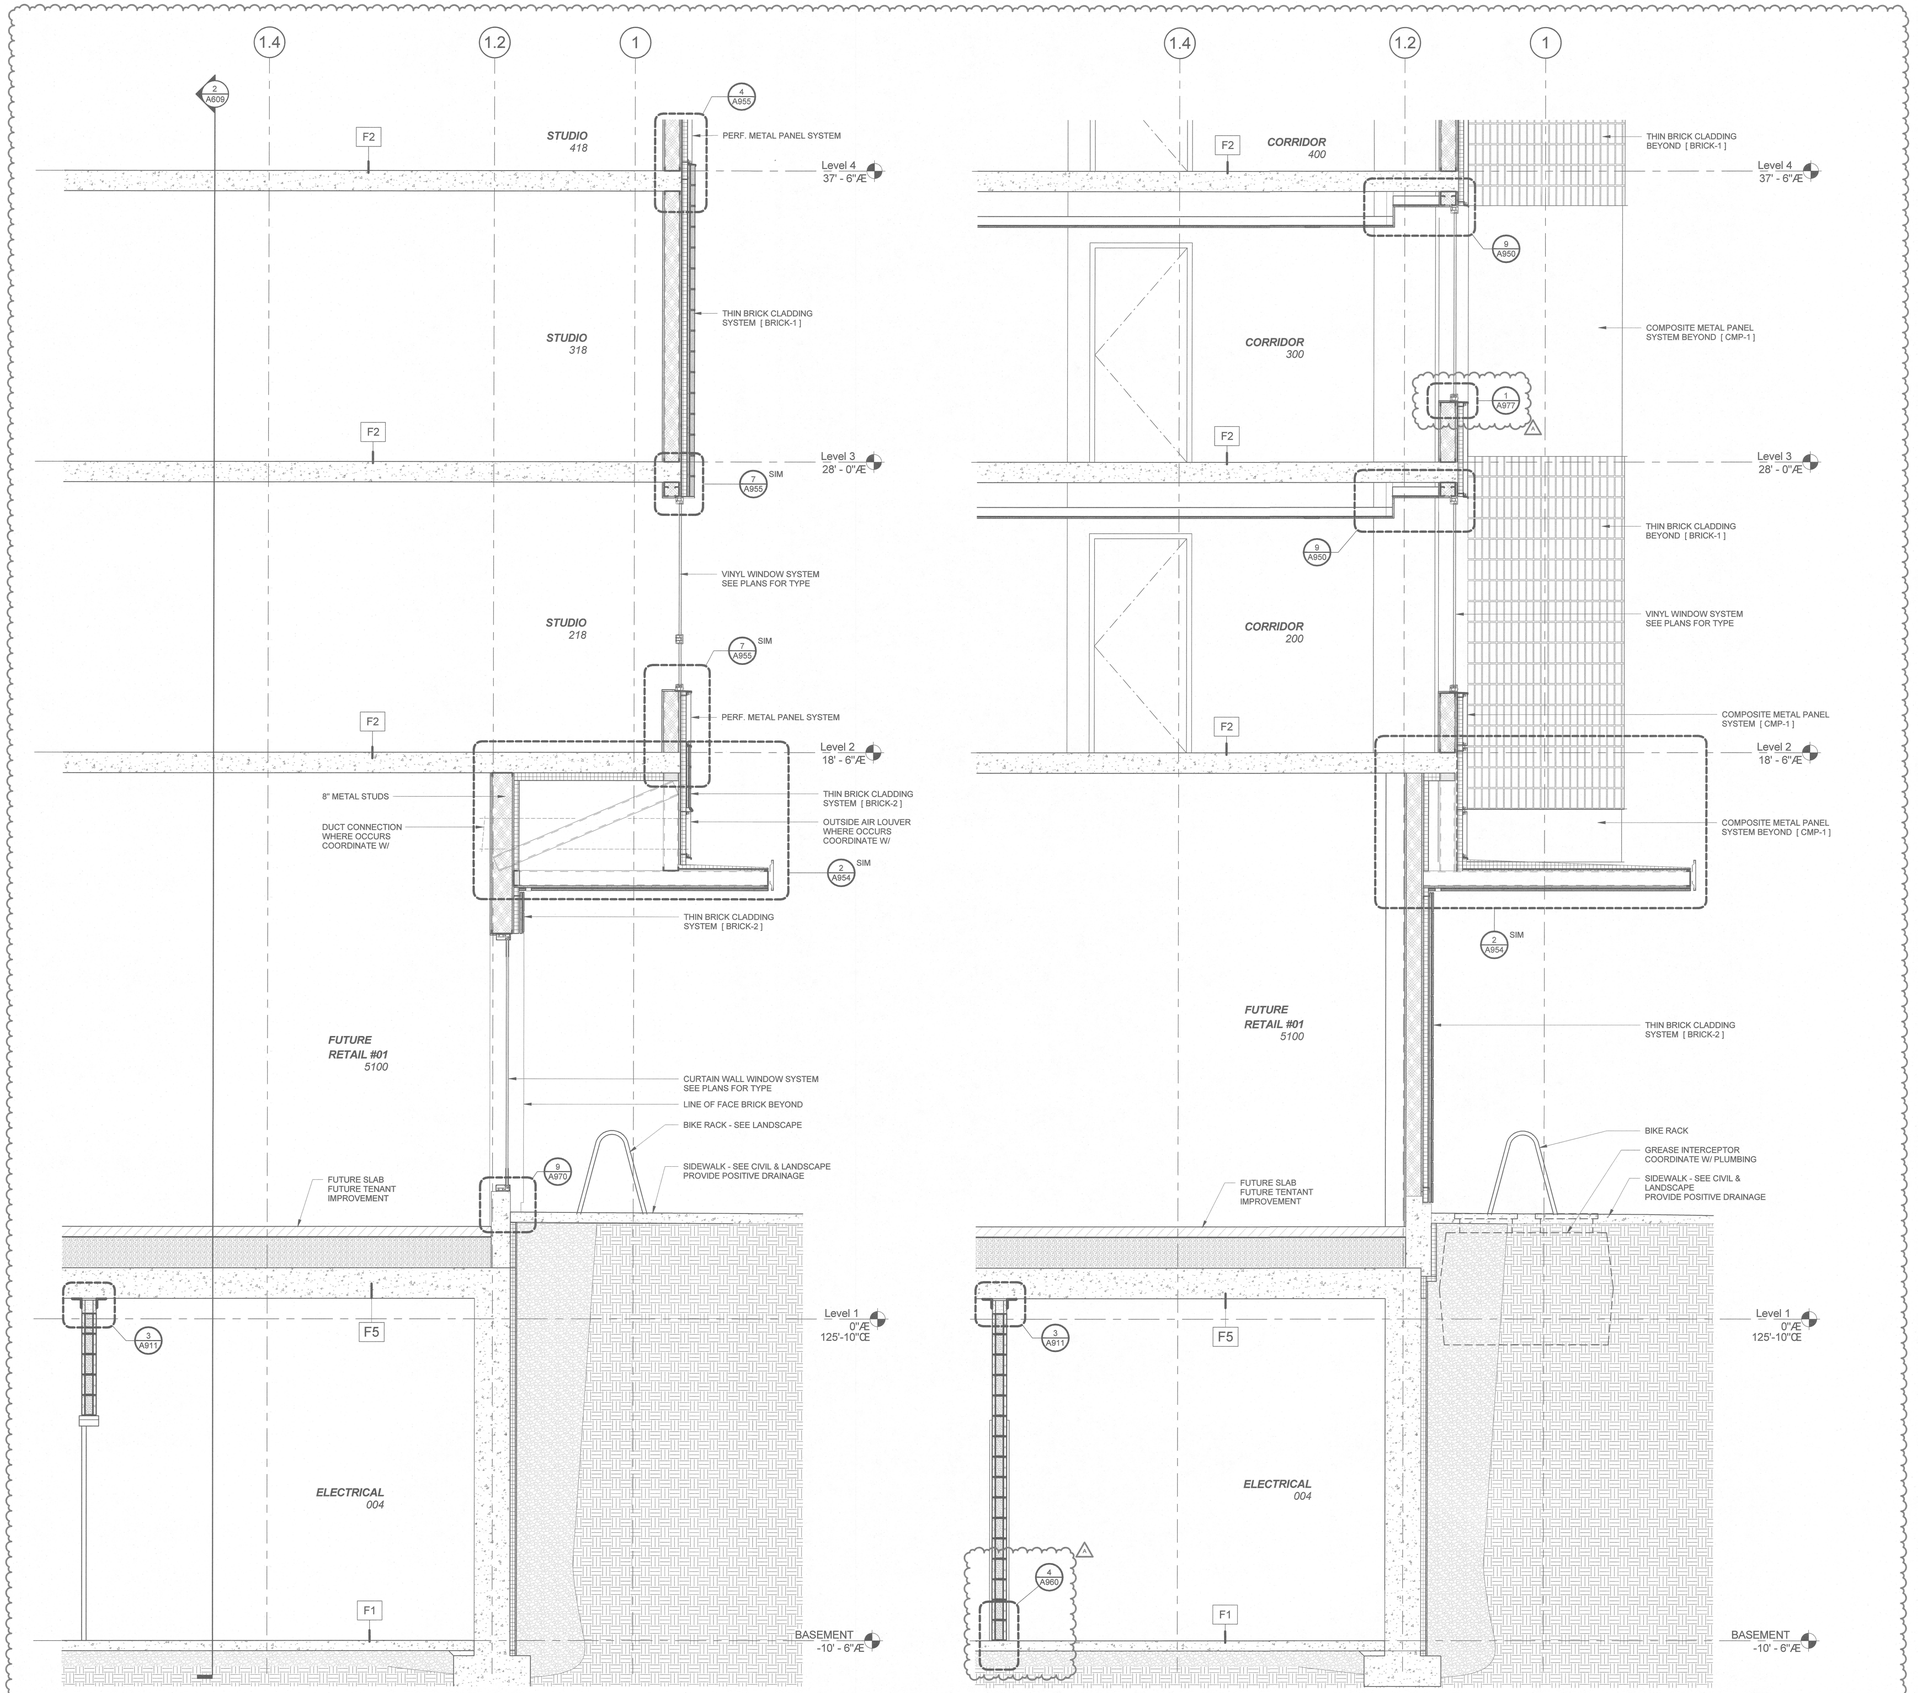

2 WALL SECTION @ FUTURE RETAIL OUTSIDE AIR LOUVER

SCALE: 1/2" = 1'-0"

1 WALL SECTION @ N. CORRIDOR INSET

SCALE: 1/2" = 1'-0"

LRS ARCHITECTS
720 NW Davis 503.221.1121
Suite 300 503.221.2077
Portland OR 97209 www.lrsarchitects.com

REGISTERED ARCHITECT THOMAS PAUL CLARK PORTLAND, OR STATE OF OREGON

LEVERARCHITECTURE
4713 N ALBINA AVE, PDX OR 97217
T 503 928 6040
www.leverarchitecture.com

CONSULTANT:

PROJECT NUMBER: 215349

GRAND AVENUE APARTMENTS

1010 NE GRAND AVE. PORTLAND, OR 97232

SHEET TITLE:
WALL SECTIONS

DRAWN BY: LRS
DATE CREATED: 04/26/17

1	ADDENDUM #01	08/11/2017
A	PLAN CHECK	09/01/2017

CITY OF PORTLAND REVIEWED FOR CODE COMPLIANCE DEC 22 2017 Bureau of Development Services

RECEIVED SEP 06 2017 BDS DOCUMENT SERVICES

SHEET:
A607
PERMIT SET 07-14-2017

LRS Architects, Inc ©2017

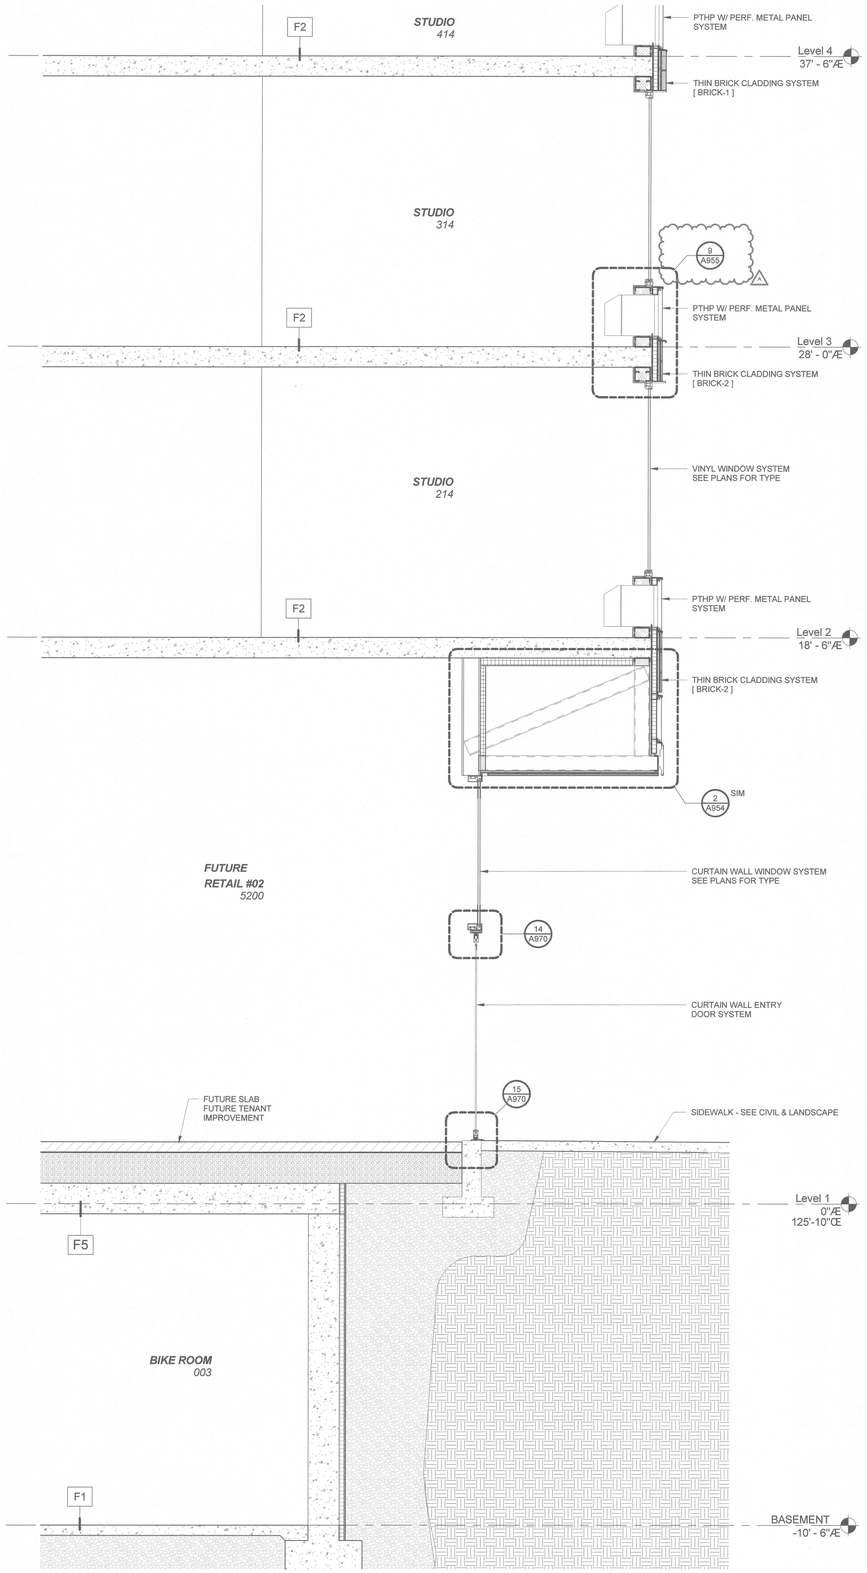

2 WALL SECTION @ CURTAIN WALL RETAIL ENTRY DOOR SYSTEM

SCALE: 1/2" = 1'-0"

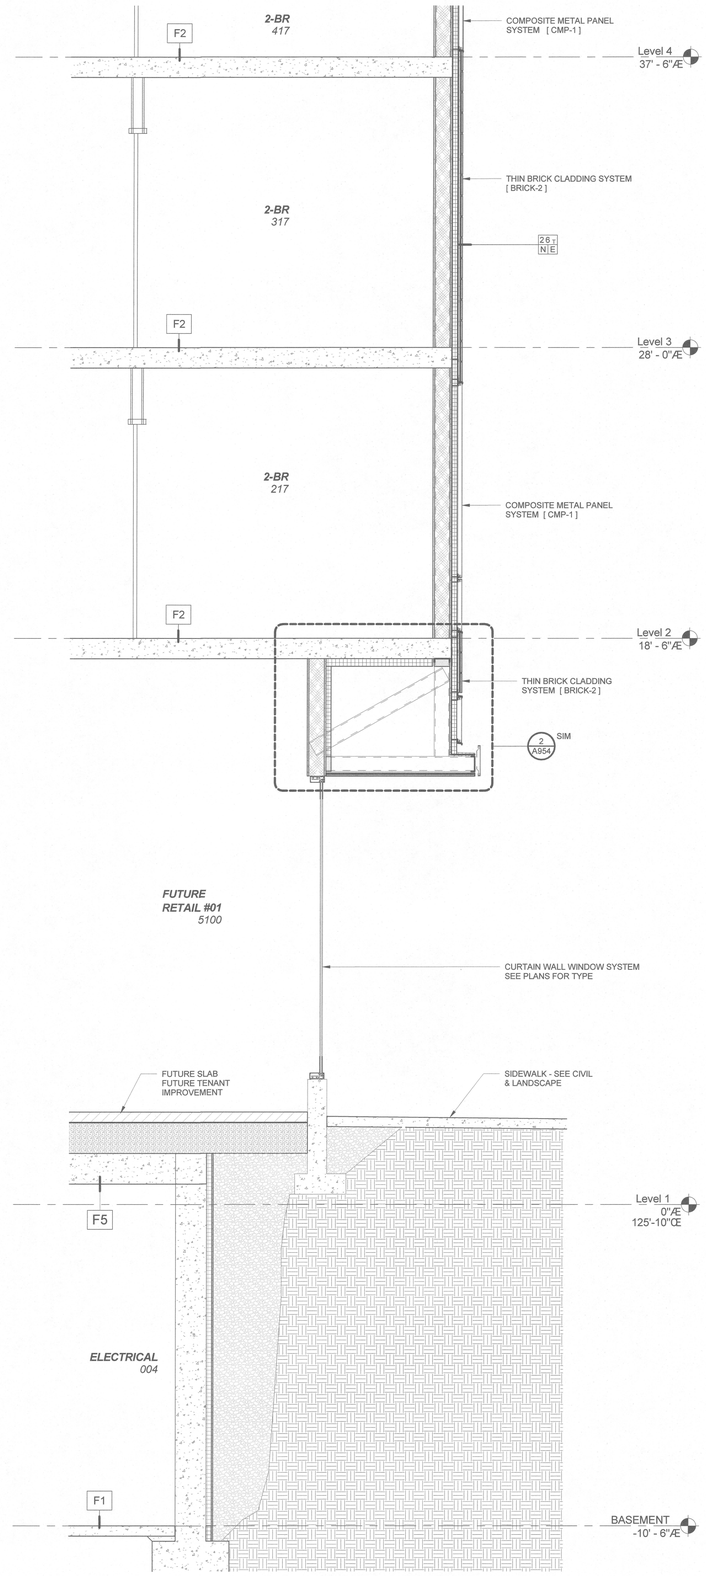

1 WALL SECTION @ RETAIL CURTAIN WALL WINDOW SYSTEM

SCALE: 1/2" = 1'-0"

LRS ARCHITECTS
720 NW Davis 503.221.1121
Suite 300 503.221.2077
Portland OR 97209 www.lrsarchitects.com

REGISTERED ARCHITECT
THOMAS PAUL LEVER
PORTLAND, OR
STATE OF OREGON

LEVERARCHITECTURE
4713 N ALBINA AVE, PDX OR 97217
T 503 928 6040
www.leverarchitecture.com

CONSULTANT:

PROJECT NUMBER: 215349

GRAND AVENUE APARTMENTS

1010 NE GRAND AVE. PORTLAND, OR 97232

SHEET TITLE:
WALL SECTIONS

DRAWN BY: LRS
DATE CREATED: 05/02/17

1	ADDENDUM #01	08/11/2017
A	PLAN CHECK	09/01/2017

CITY OF PORTLAND BUREAU OF DEVELOPMENT SERVICES REVIEWED FOR CODE COMPLIANCE DEC 22 2017

RECEIVED SEP 06 2017 BDS DOCUMENT SERVICES

SHEET:
A608
PERMIT SET
07-14-2017

LRS Architects, Inc. ©2017

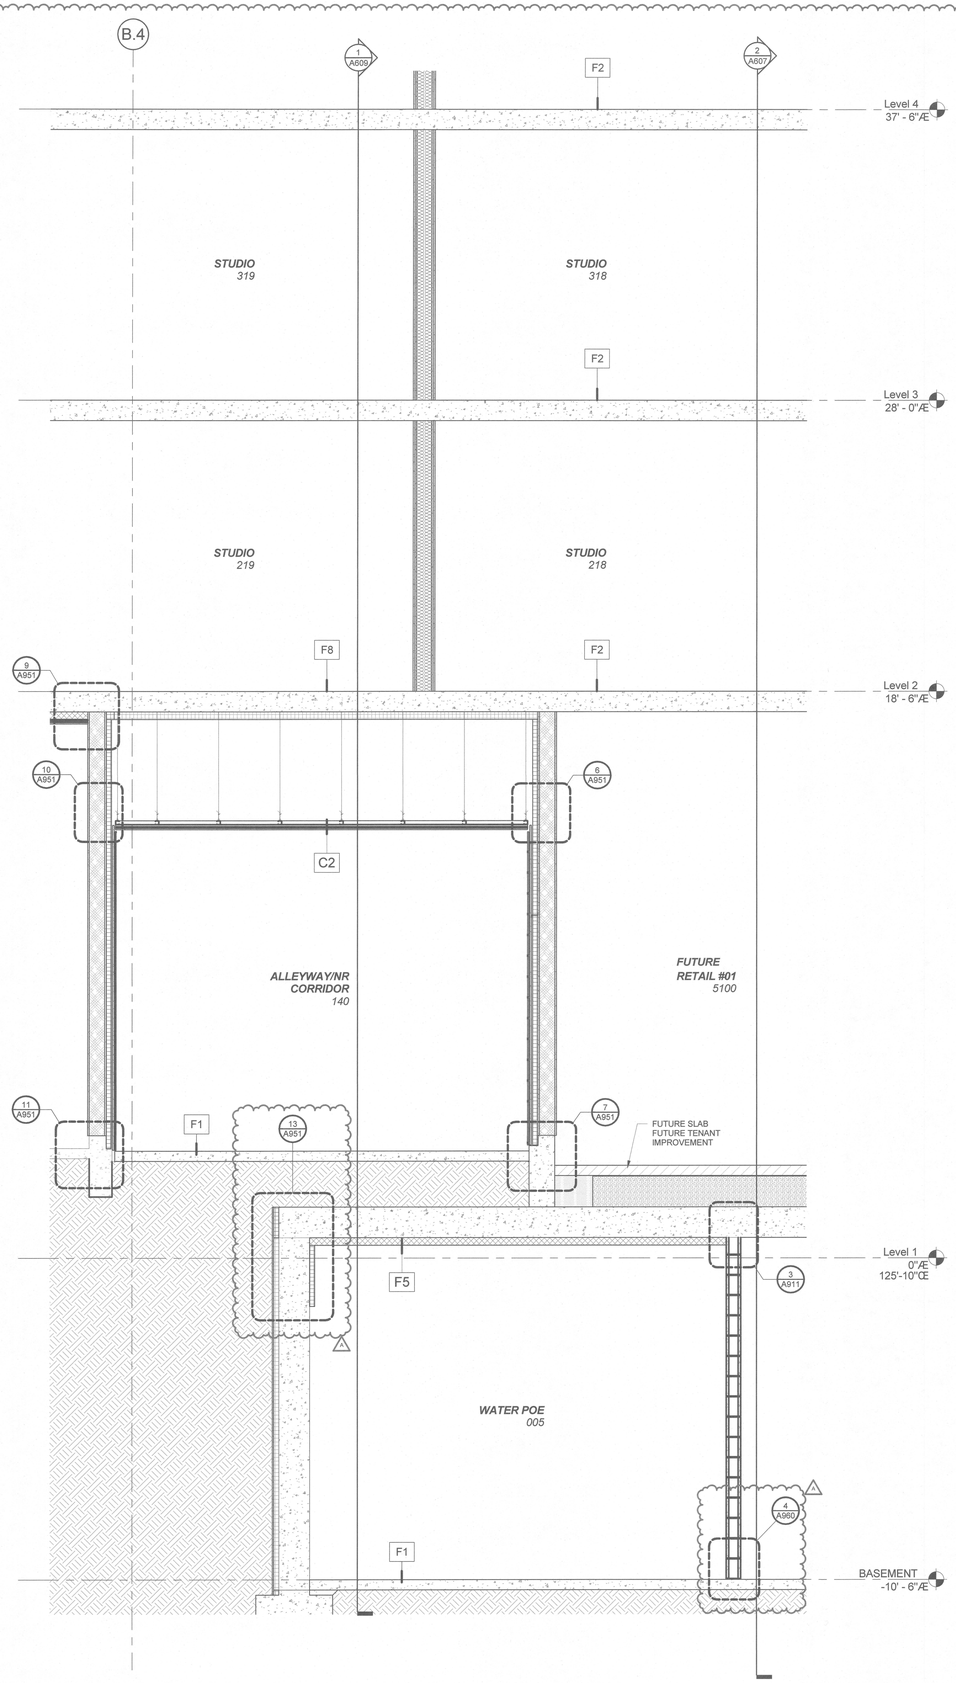

2 SECTION AT BSMT W/ ALLEY ABOVE

SCALE: 1/2" = 1'-0"

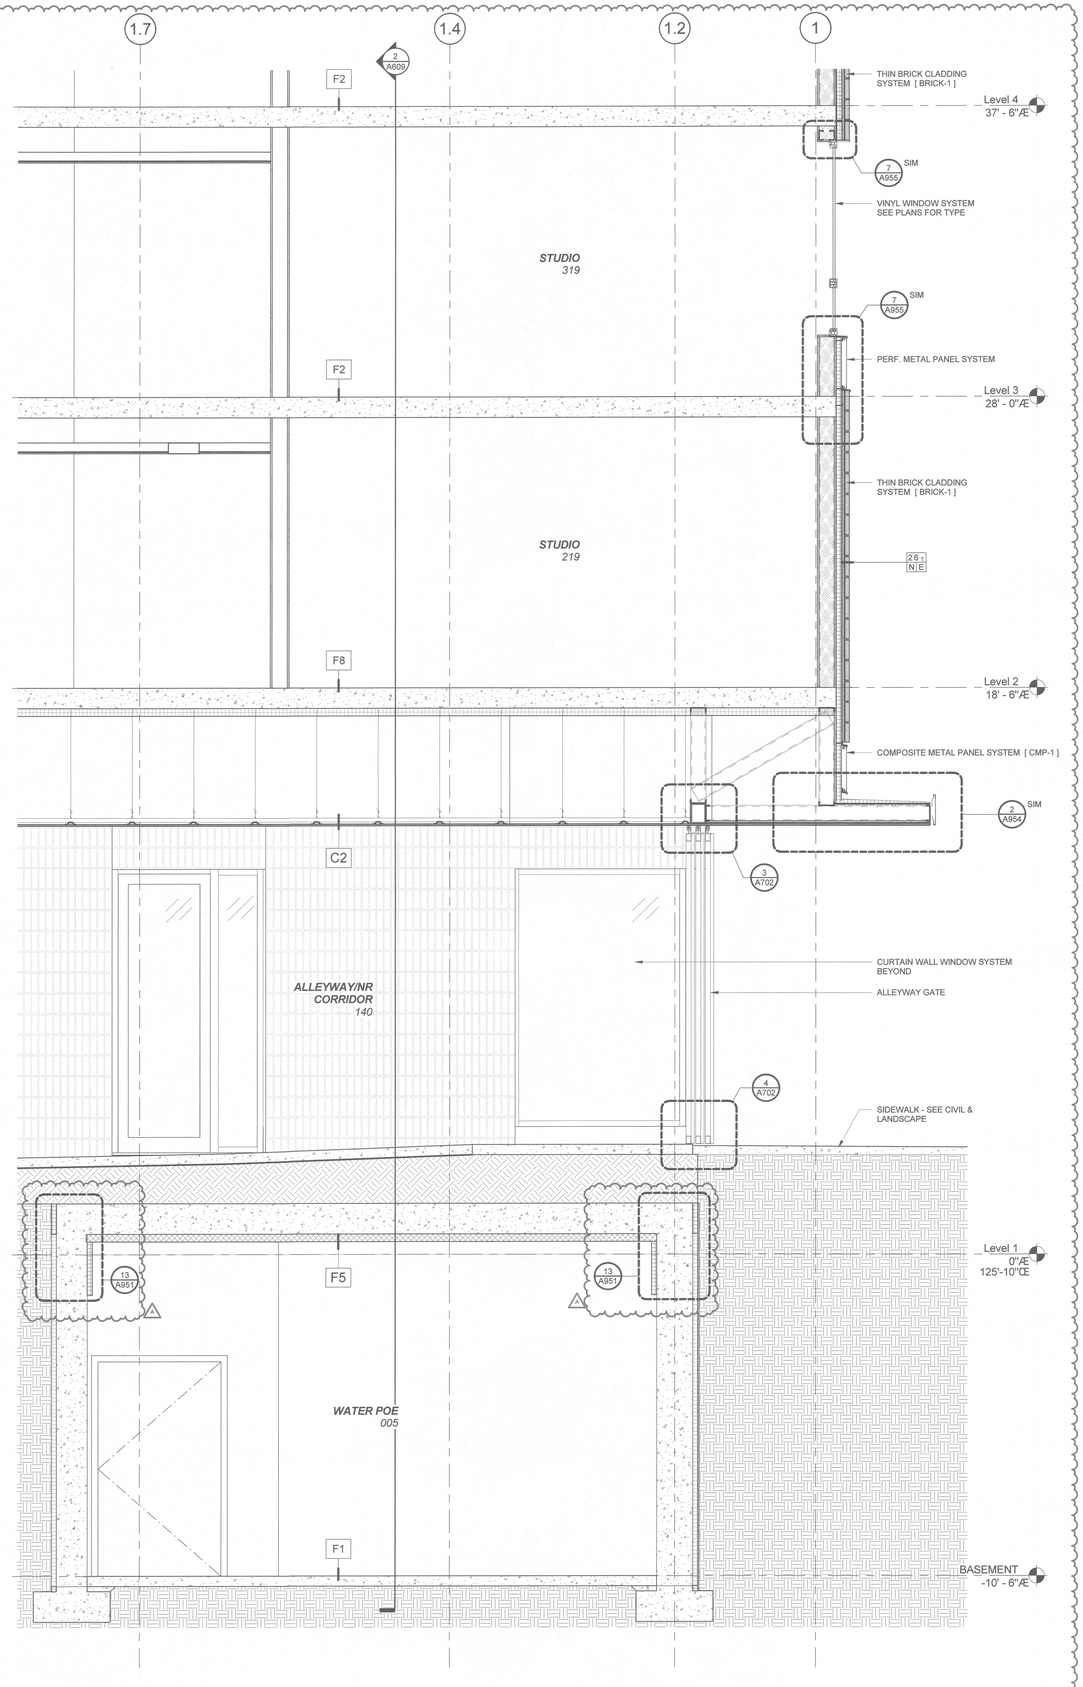

1 SECTION @ NORTH ALLEY ENTRY

SCALE: 1/2" = 1'-0"

LRS ARCHITECTS
720 NW Davis 503.221.1121
Suite 300 503.221.2077
Portland OR 97209 www.lrsarchitects.com

REGISTERED ARCHITECT
THOMAS PAUL FRANK, JR.
PORTLAND, OR
STATE OF OREGON

LEVERARCHITECTURE
4713 N ALBINA AVE, PDX OR 97217
T 503 928 6040
www.leverarchitecture.com

CONSULTANT:

PROJECT NUMBER: 215349

GRAND AVENUE APARTMENTS

1010 NE GRAND AVE. PORTLAND, OR 97232

SHEET TITLE:

WALL SECTIONS

DRAWN BY: LRS
DATE CREATED: 01/27/17

1	ADDENDUM #01	08/11/2017
A	PLAN CHECK	09/01/2017

CITY OF PORTLAND
REVIEWED FOR CODE COMPLIANCE
DEC 22 2017
PERMIT NUMBER

RECEIVED
SEP 06 2017
BDS
DOCUMENT SERVICES

SHEET:

A609

PERMIT SET
07-14-2017

LRS Architects, Inc. ©2017

C:\300 Revit Local Files\BIM Support\215349_Grand Ave Apts_Arch_R17_kschneider.rvt
9/5/2017 3:32:05 PM

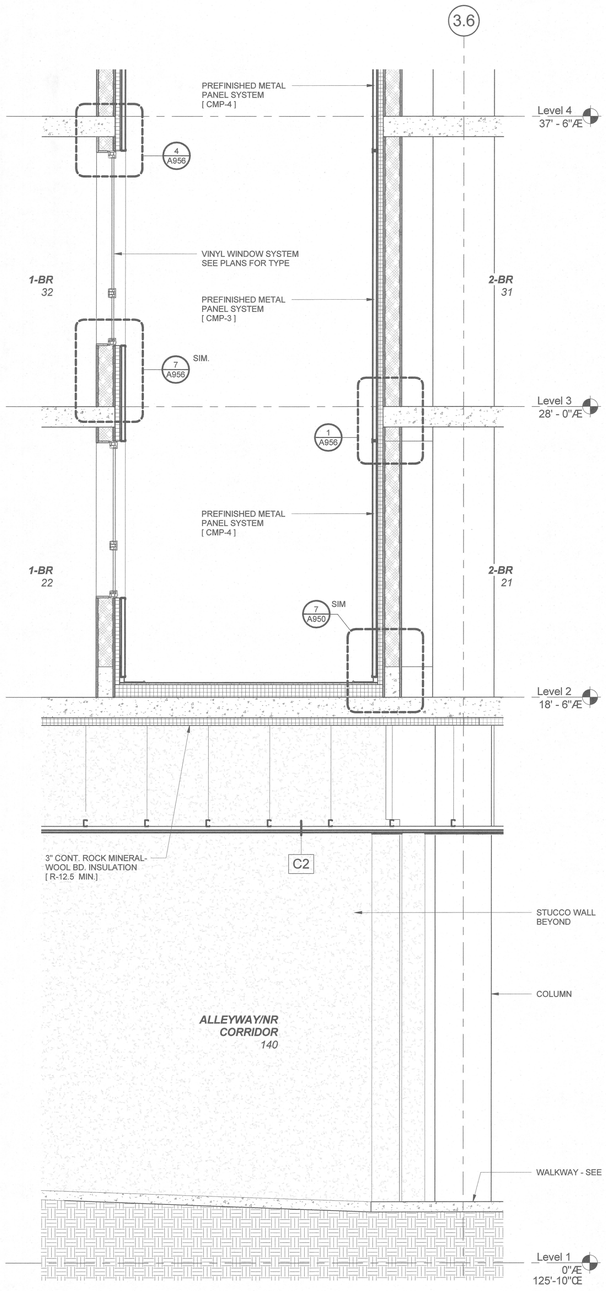

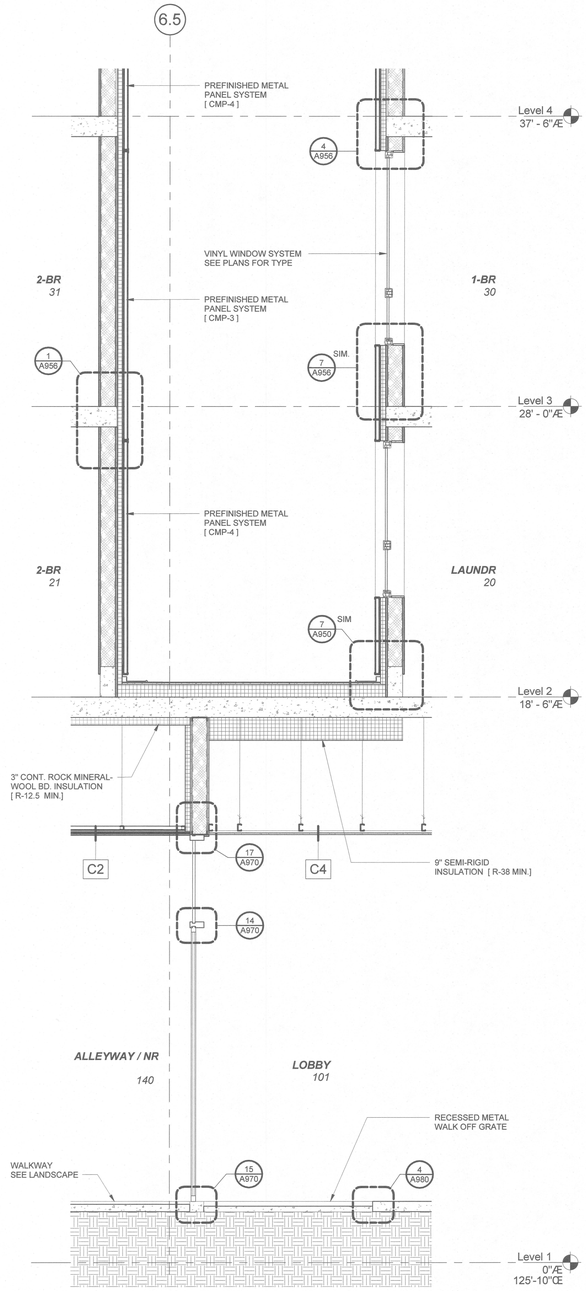

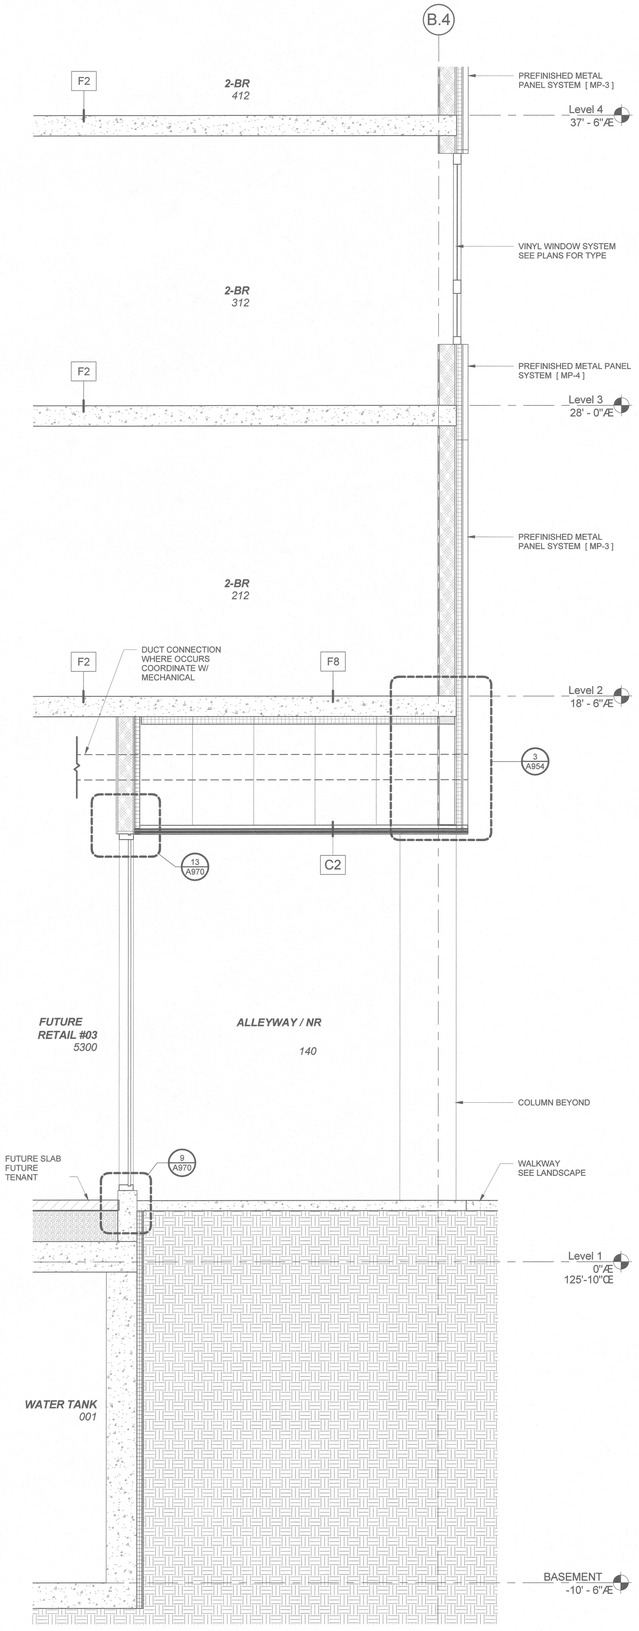

3 WALL SECTION @ LEVEL-2 ROOF CURB - NORTH

SCALE: 1/2" = 1'-0"

2 WALL SECTION @ LEVEL-2 ROOF CURB - SOUTH

SCALE: 1/2" = 1'-0"

1 WALL SECTION @ COURTYARD AND ALLEY

SCALE: 1/2" = 1'-0"

C:\300 Revit Local Files\BIM Support\215349_Grand Ave Apts_Arch_R17_kschneider.rvt
9/5/2017 3:32:10 PM

LRS ARCHITECTS
720 NW Davis 503.221.1121
Suite 300 503.221.2077
Portland OR 97209 www.lrsarchitects.com

REGISTERED ARCHITECT THOMAS PAUL KARNS PORTLAND, OR STATE OF OREGON

LEVERARCHITECTURE
4713 N ALBINA AVE, PDX OR 97217
T 503 928 6040
www.leverarchitecture.com

CONSULTANT:

PROJECT NUMBER: 215349

GRAND AVENUE APARTMENTS

1010 NE GRAND AVE. PORTLAND, OR 97232

SHEET TITLE:
WALL SECTIONS

DRAWN BY: LRS
DATE CREATED: 01/16/17

1	ADDENDUM #01	08/11/2017

City of Portland, Oregon FIRE BUREAU APPROVED DEC 22 2017

RECEIVED SEP 06 2017 BDS DOCUMENT SERVICES

SHEET: **A610**

PERMIT SET 07-14-2017

LRS Architects, inc ©2017

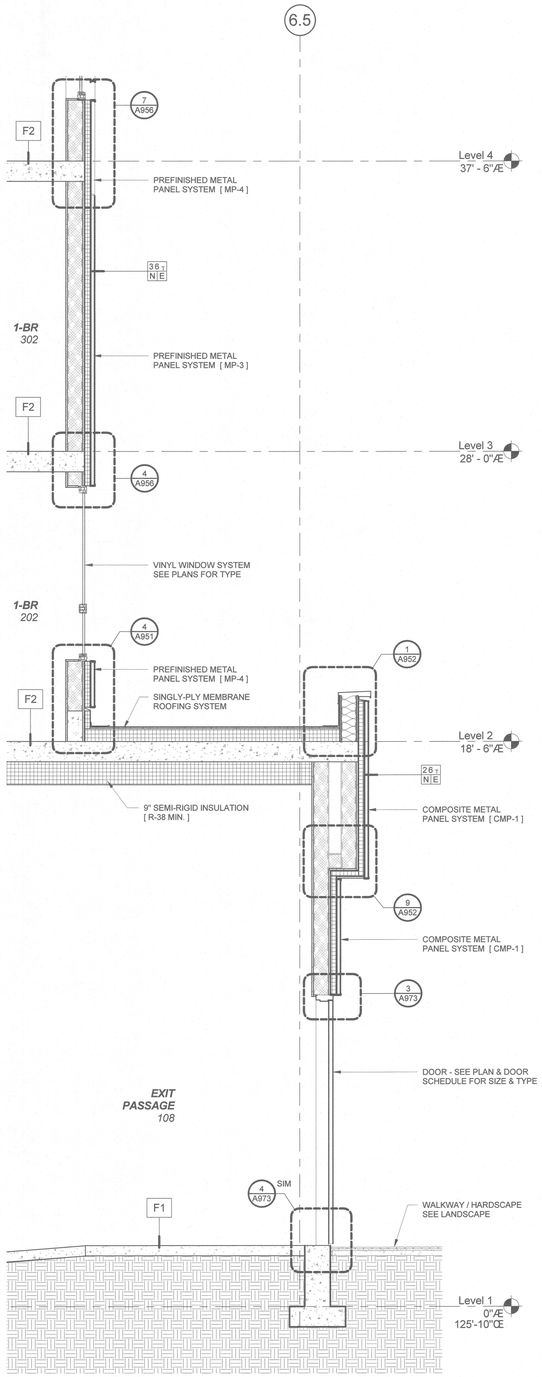

4 SOUTH COURTYARD @ WALL DOOR RECESS

SCALE: 1/2" = 1'-0"

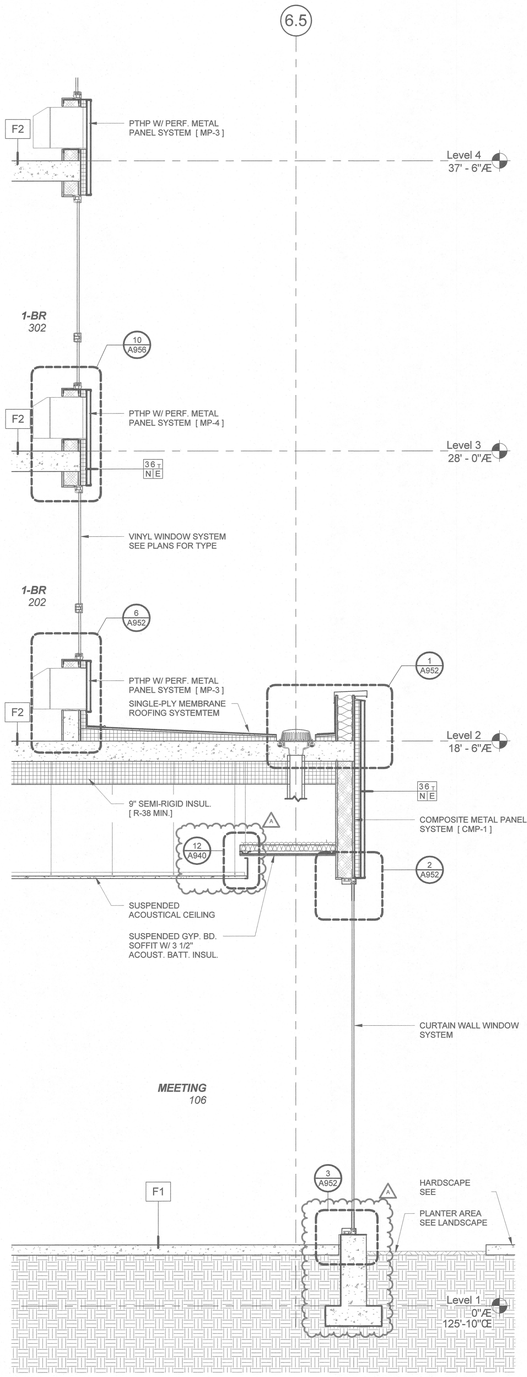

3 SOUTH COURTYARD WALL @ MEETING ROOM

SCALE: 1/2" = 1'-0"

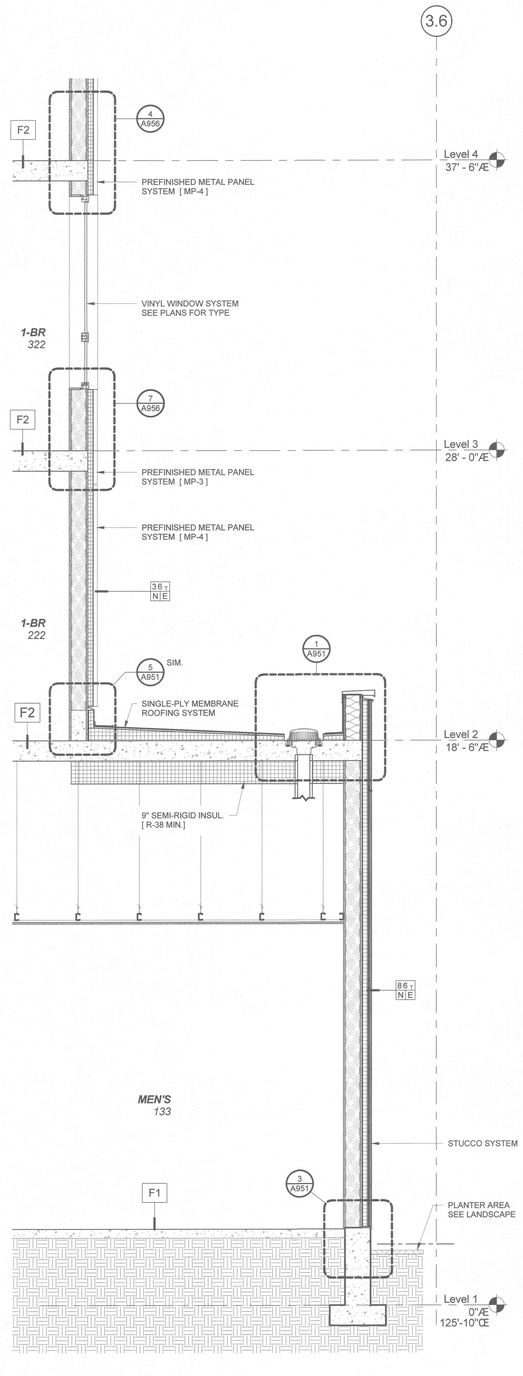

2 NORTH COURTYARD WALL @ RESTROOM

SCALE: 1/2" = 1'-0"

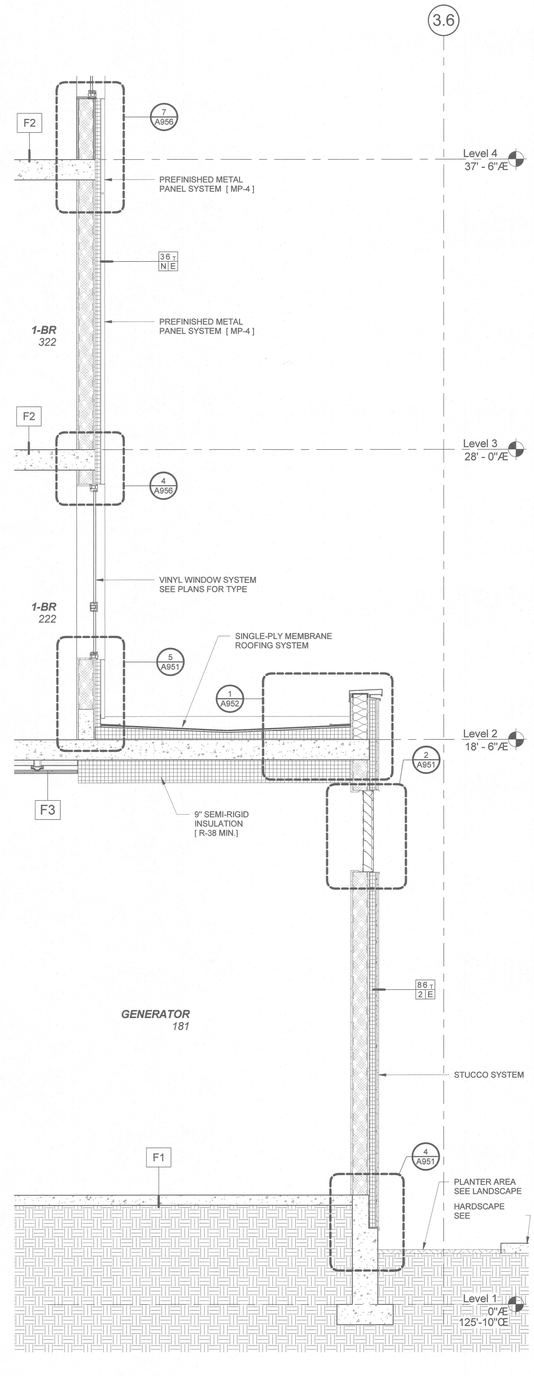

1 NORTH COURTYARD WALL @ GENERATOR ROOM

SCALE: 1/2" = 1'-0"

LRS ARCHITECTS
720 NW Davis 503.221.1121
Suite 300 503.221.2077
Portland OR 97209 www.lrsarchitects.com

REGISTERED ARCHITECT THOMAS PAUL LEVER PORTLAND, OR STATE OF OREGON

LEVERARCHITECTURE
4713 N ALBINA AVE, PDX OR 97217
T 503 928 6040
www.leverarchitecture.com

CONSULTANT:

PROJECT NUMBER: 215349

GRAND AVENUE APARTMENTS

1010 NE GRAND AVE. PORTLAND, OR 97232

SHEET TITLE:

WALL SECTIONS

DRAWN BY:		LRS
DATE CREATED:		01/17/17
1	ADDENDUM #01	08/11/2017
A	PLAN CHECK	09/01/2017

CITY OF PORTLAND BUREAU OF DEVELOPMENT SERVICES DEC 22 2017 APPROVED

RECEIVED SEP 06 2017 BDS DOCUMENT SERVICES

SHEET: **A611**

PERMIT SET 07-14-2017

LRS Architects, Inc. ©2017

C:\300 Revit Local Files\BIM Support\215349_Grand Ave Apts_Arch_R17_kschneider.rvt
9/5/2017 3:32:16 PM

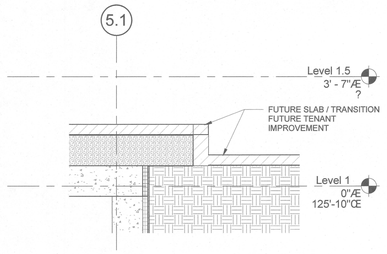

3 LEVEL 1 - FLOOR SLAB TRANSITION

SCALE: 1/2" = 1'-0"

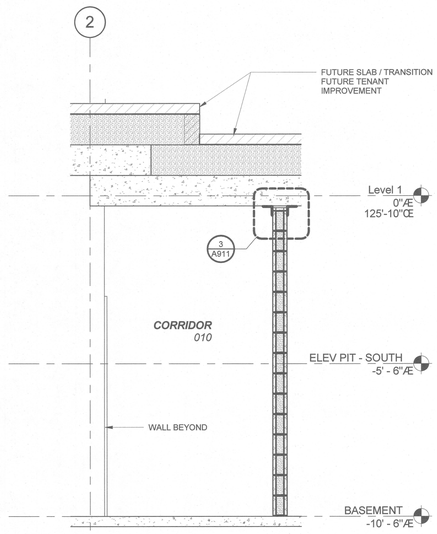

4 BASEMENT CORRIDOR @ RETAIL SLAB TRANSITION

SCALE: 1/2" = 1'-0"

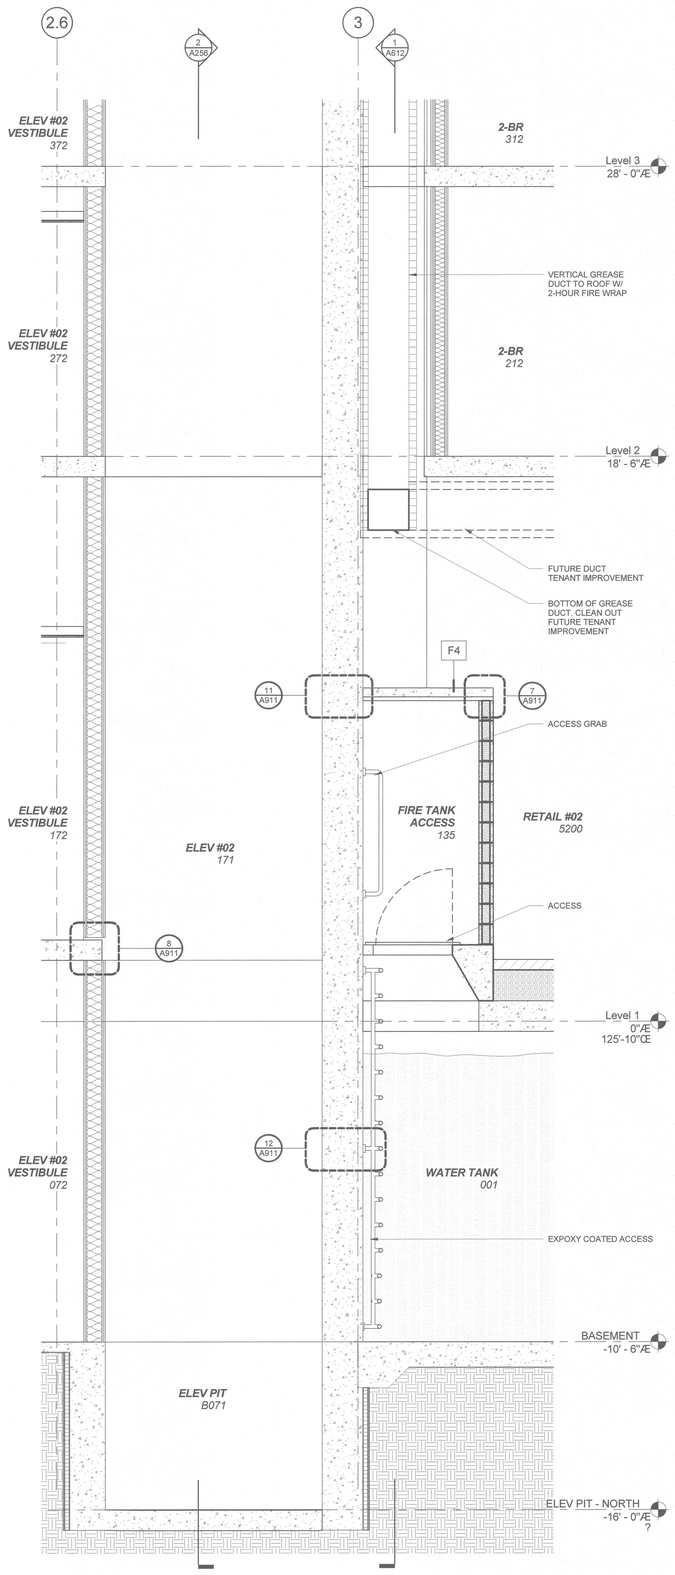

2 N/S SECTION @ ELEVATOR #02 SHAFT & FIRE TANK ACCESS

SCALE: 1/2" = 1'-0"

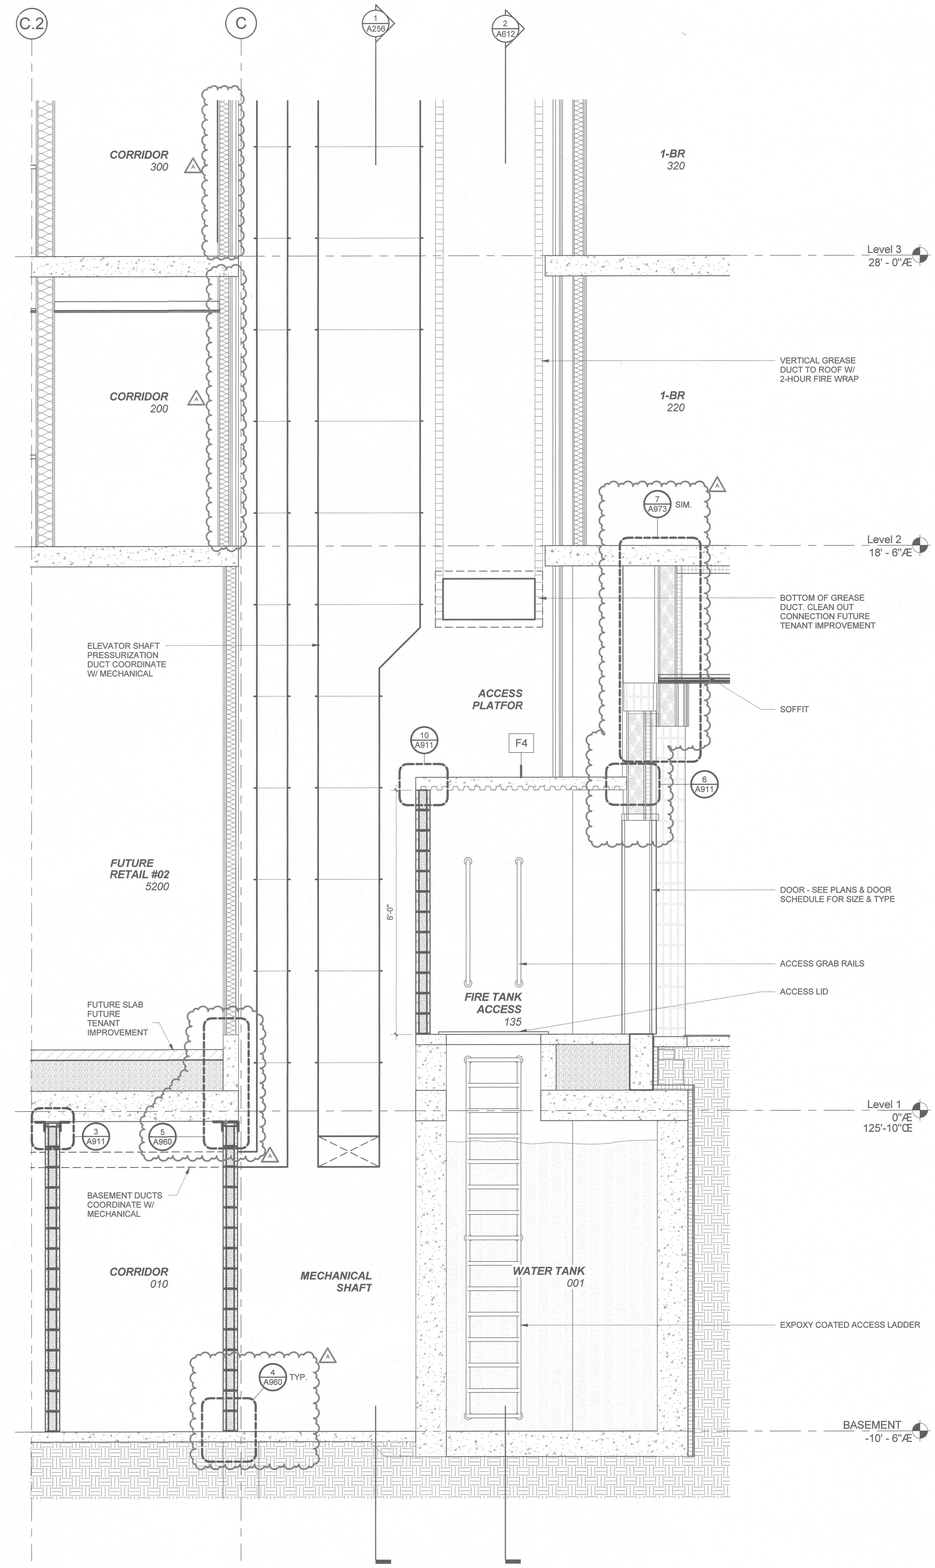

1 SECTION AT FIRE TANK ACCESS

SCALE: 1/2" = 1'-0"

LRS ARCHITECTS
720 NW Davis 503.221.1121
Suite 300 503.221.2077
Portland OR 97209 www.lrsarchitects.com

REGISTERED ARCHITECT
THOMAS PAUL LEVER
PORTLAND, OR
STATE OF OREGON

LEVERARCHITECTURE
4713 N ALBINA AVE, PDX OR 97217
T 503 928 6040
www.leverarchitecture.com

CONSULTANT:

PROJECT NUMBER: 215349

GRAND AVENUE APARTMENTS

1010 NE GRAND AVE. PORTLAND, OR 97232

SHEET TITLE:
WALL SECTIONS

KEY PLAN:

DRAWN BY: LRS
DATE CREATED: 01/26/17

1	ADDENDUM #01	08/11/2017
A	PLAN CHECK	09/01/2017

City of Portland
BUREAU OF DEVELOPMENT SERVICES
DEC 22 2017
Plan Number

RECEIVED
SEP 06 2017
BDS
DOCUMENT SERVICES

SHEET:
A612
PERMIT SET
07-14-2017

LRS Architects, Inc. ©2017

C:\300 Revit Local Files\BIM Support\215349_Grand Ave Apts_Arch_R17_kschneider.rvt
9/5/2017 3:32:27 PM

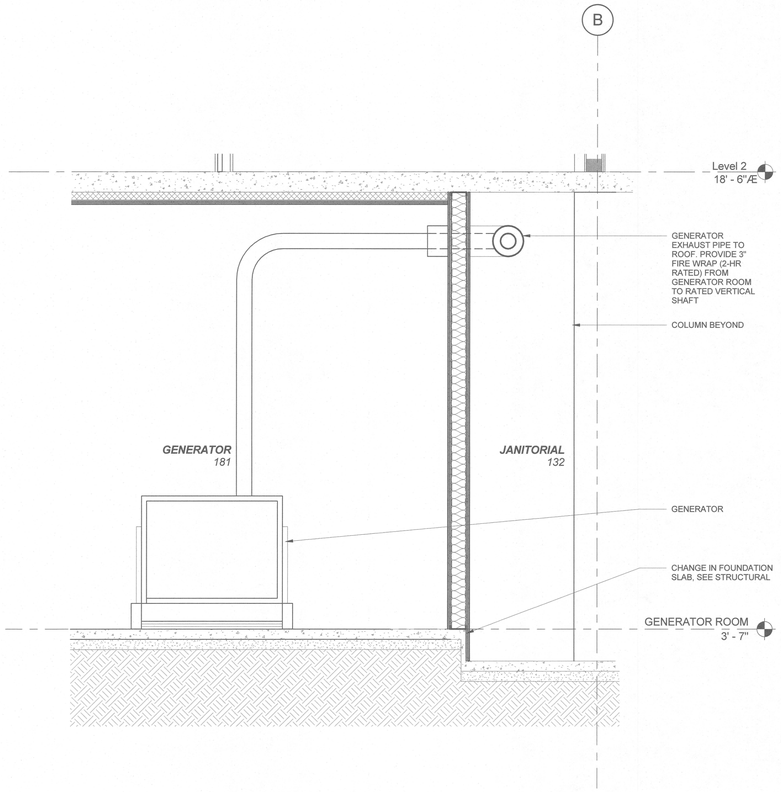

14 GROUND FLOOR RESTROOM SLAB CHANGE

SCALE: 1/2" = 1'-0"

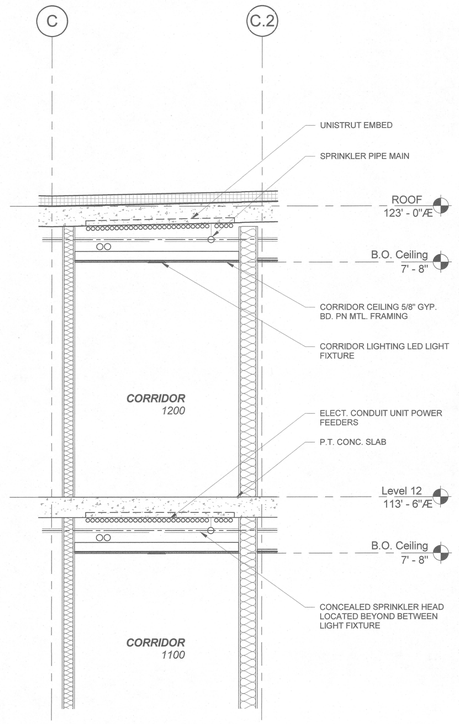

6 LEVEL 12 - CORRIDOR / CEILING - SECTION

SCALE: 1/2" = 1'-0"

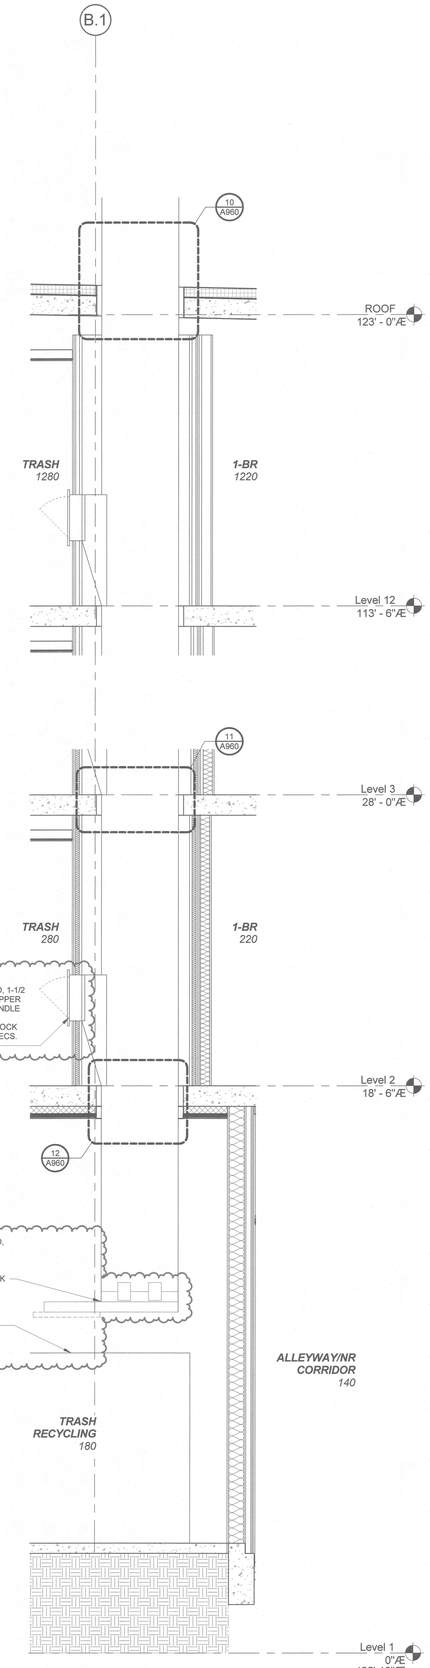

4 SECTION - TRASH CHUTE

SCALE: 1/2" = 1'-0"

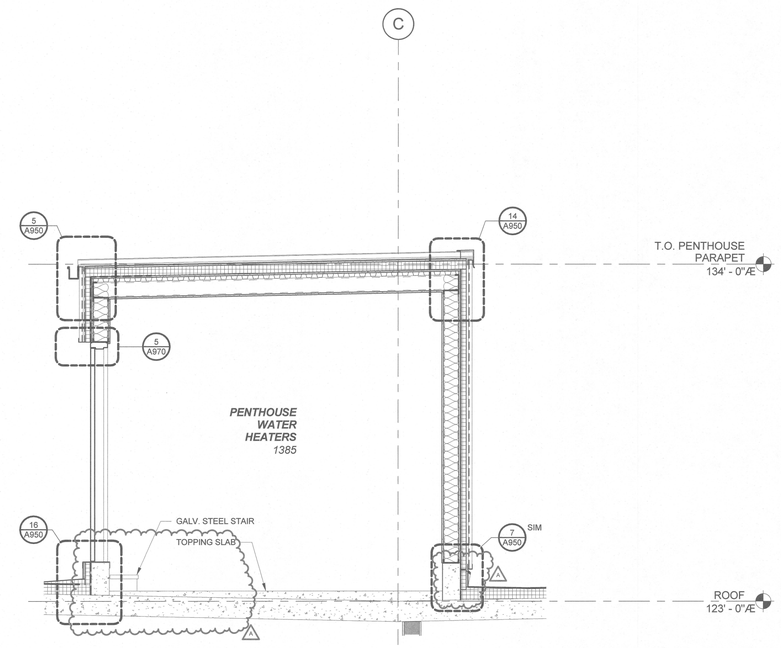

16 MECHANICAL PENTHOUSE - SECTION

SCALE: 1/2" = 1'-0"

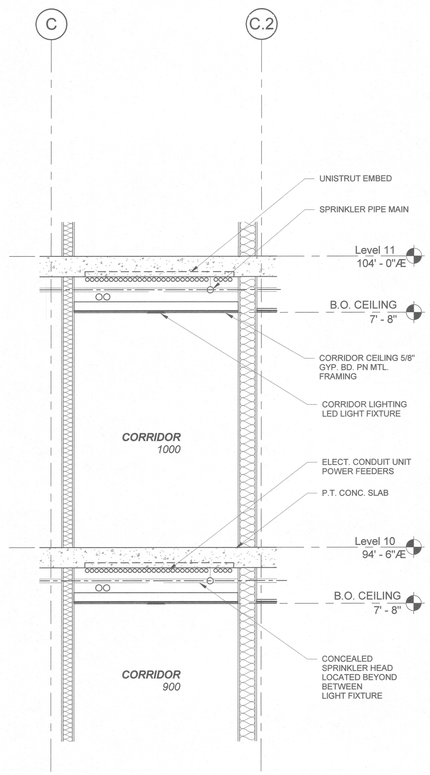

8 LEVELS 2 THRU 11 - CORRIDOR - SECTION

SCALE: 1/2" = 1'-0"

LRS ARCHITECTS
720 NW Davis 503.221.1121
Suite 300 503.221.2077
Portland OR 97209 www.lrsarchitects.com

REGISTERED ARCHITECT
THOMAS PAUL CLARK
PORTLAND, OR
STATE OF OREGON

LEVERARCHITECTURE
4713 N ALBINA AVE, PDX OR 97217
T 503 928 6040
www.leverarchitecture.com

CONSULTANT:

PROJECT NUMBER: 215349

GRAND AVENUE APARTMENTS

1010 NE GRAND AVE. PORTLAND, OR 97232

SHEET TITLE:

WALL SECTIONS

KEY PLAN:

DRAWN BY: Author
DATE CREATED: 05/17/17

1	ADDENDUM #01	08/11/2017
A	PLAN CHECK	09/01/2017

City of Portland
REVIEWED FOR CODE COMPLIANCE
DEC 22 2017
Permit Number

RECEIVED
SEP 06 2017
BDS
DOCUMENT SERVICES

SHEET:

A613

PERMIT SET
07-14-2017

LRS Architects, Inc. ©2017

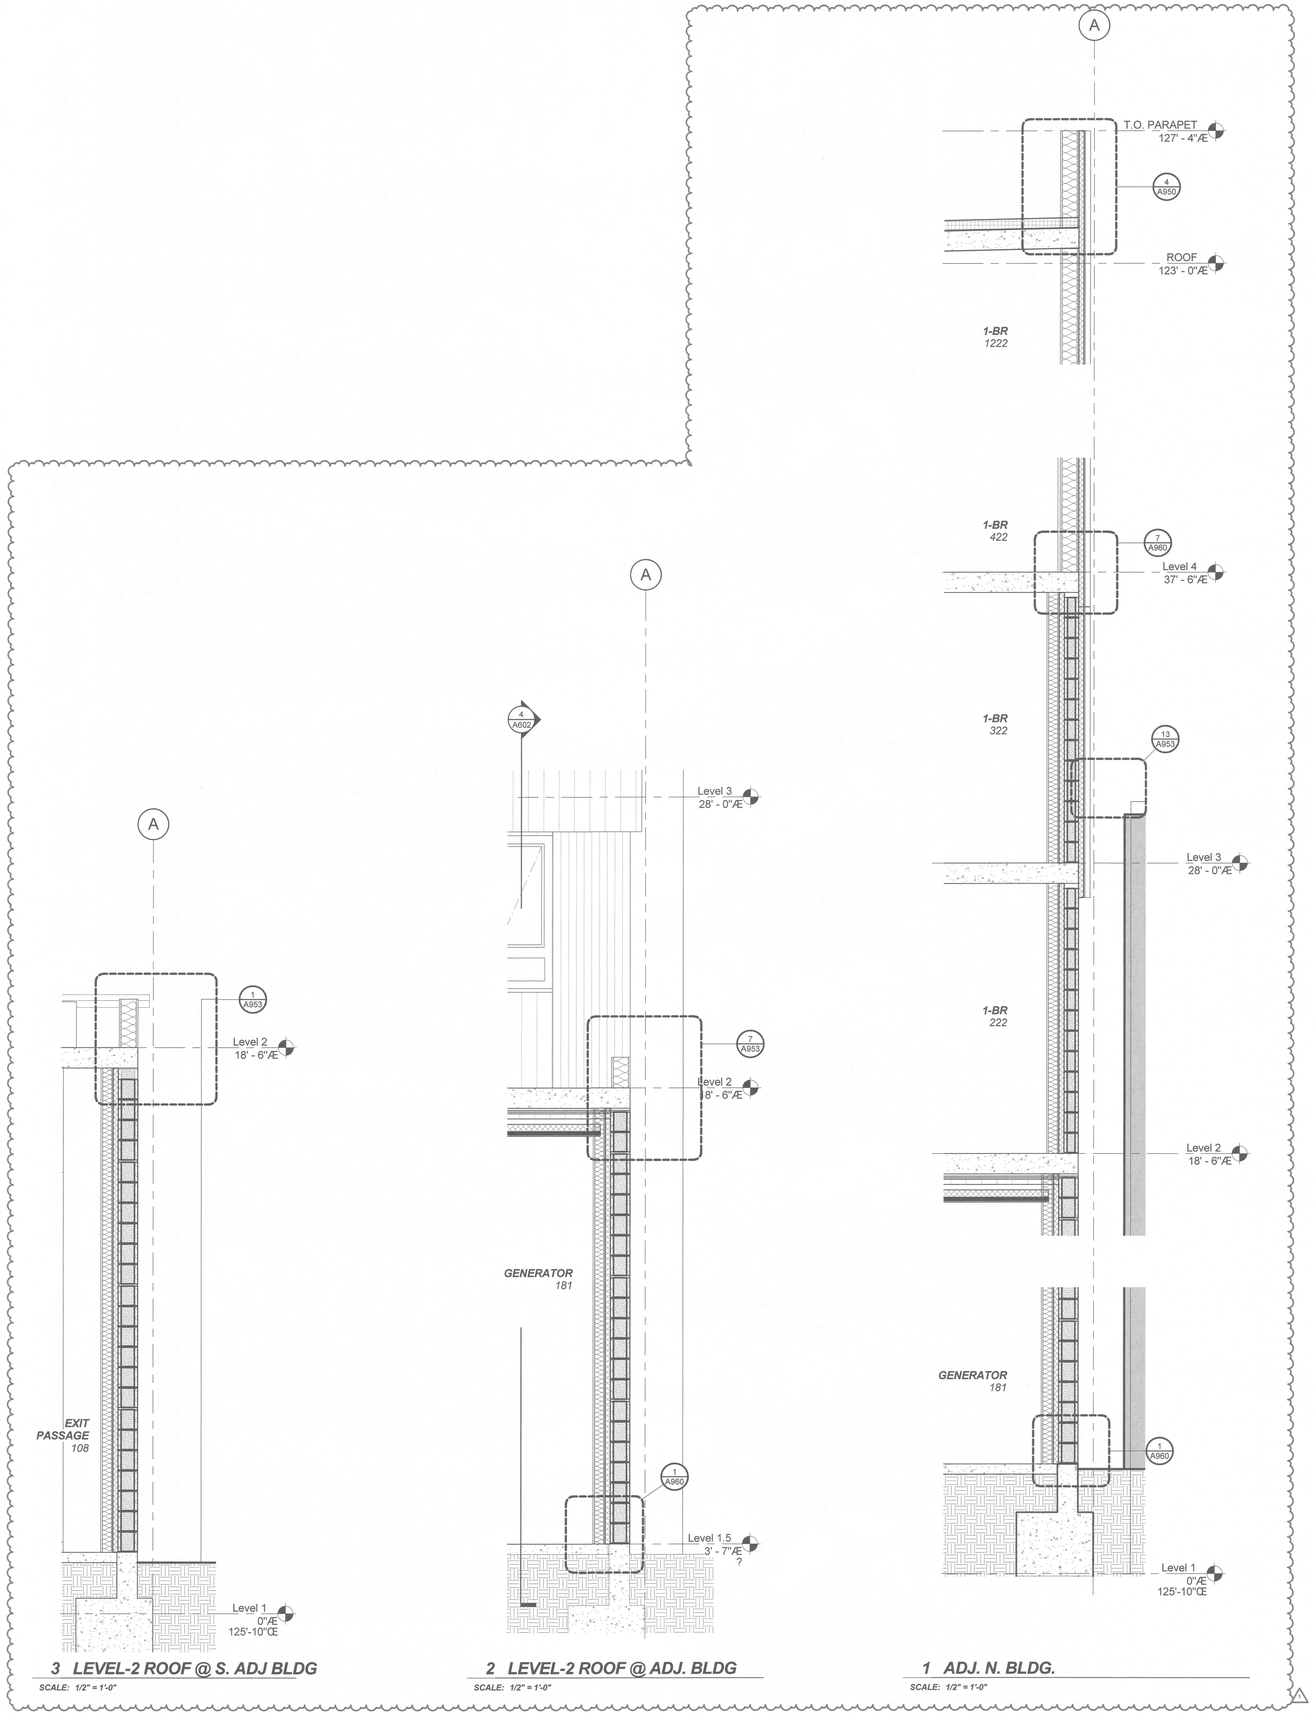

3 LEVEL-2 ROOF @ S. ADJ BLDG

SCALE: 1/2" = 1'-0"

2 LEVEL-2 ROOF @ ADJ. BLDG

SCALE: 1/2" = 1'-0"

1 ADJ. N. BLDG.

SCALE: 1/2" = 1'-0"

LRS ARCHITECTS
720 NW Davis 503.221.1121
Suite 300 503.221.2077
Portland OR 97209 www.lrsarchitects.com

REGISTERED ARCHITECT
THOMAS PAUL EARLY
PORTLAND, OR
STATE OF OREGON

LEVERARCHITECTURE
4713 N ALBINA AVE, PDX OR 97217
T 503 928 6040
www.leverarchitecture.com

CONSULTANT:

PROJECT NUMBER: 215349

GRAND AVENUE APARTMENTS

1010 NE GRAND AVE. PORTLAND, OR 97232

SHEET TITLE:

WALL SECTIONS

DRAWN BY: Author
DATE CREATED: 06/02/17

1 ADDENDUM #01 08/11/2017

CITY OF PORTLAND
REVIEWED FOR CODE COMPLIANCE
DEC 22 2017
DEVELOPMENT SERVICES

RECEIVED
SEP 06 2017
BDS
DOCUMENT SERVICES

SHEET:
A614
PERMIT SET
07-14-2017

LRS Architects, Inc ©2017